


FOREST HIGHWAY CONSTRUCTION RECORD

STATE Colorado ROUTE NO. 26
ROUTE NAME South St. Vrain
LENGTH 35.3 miles CLASS 2

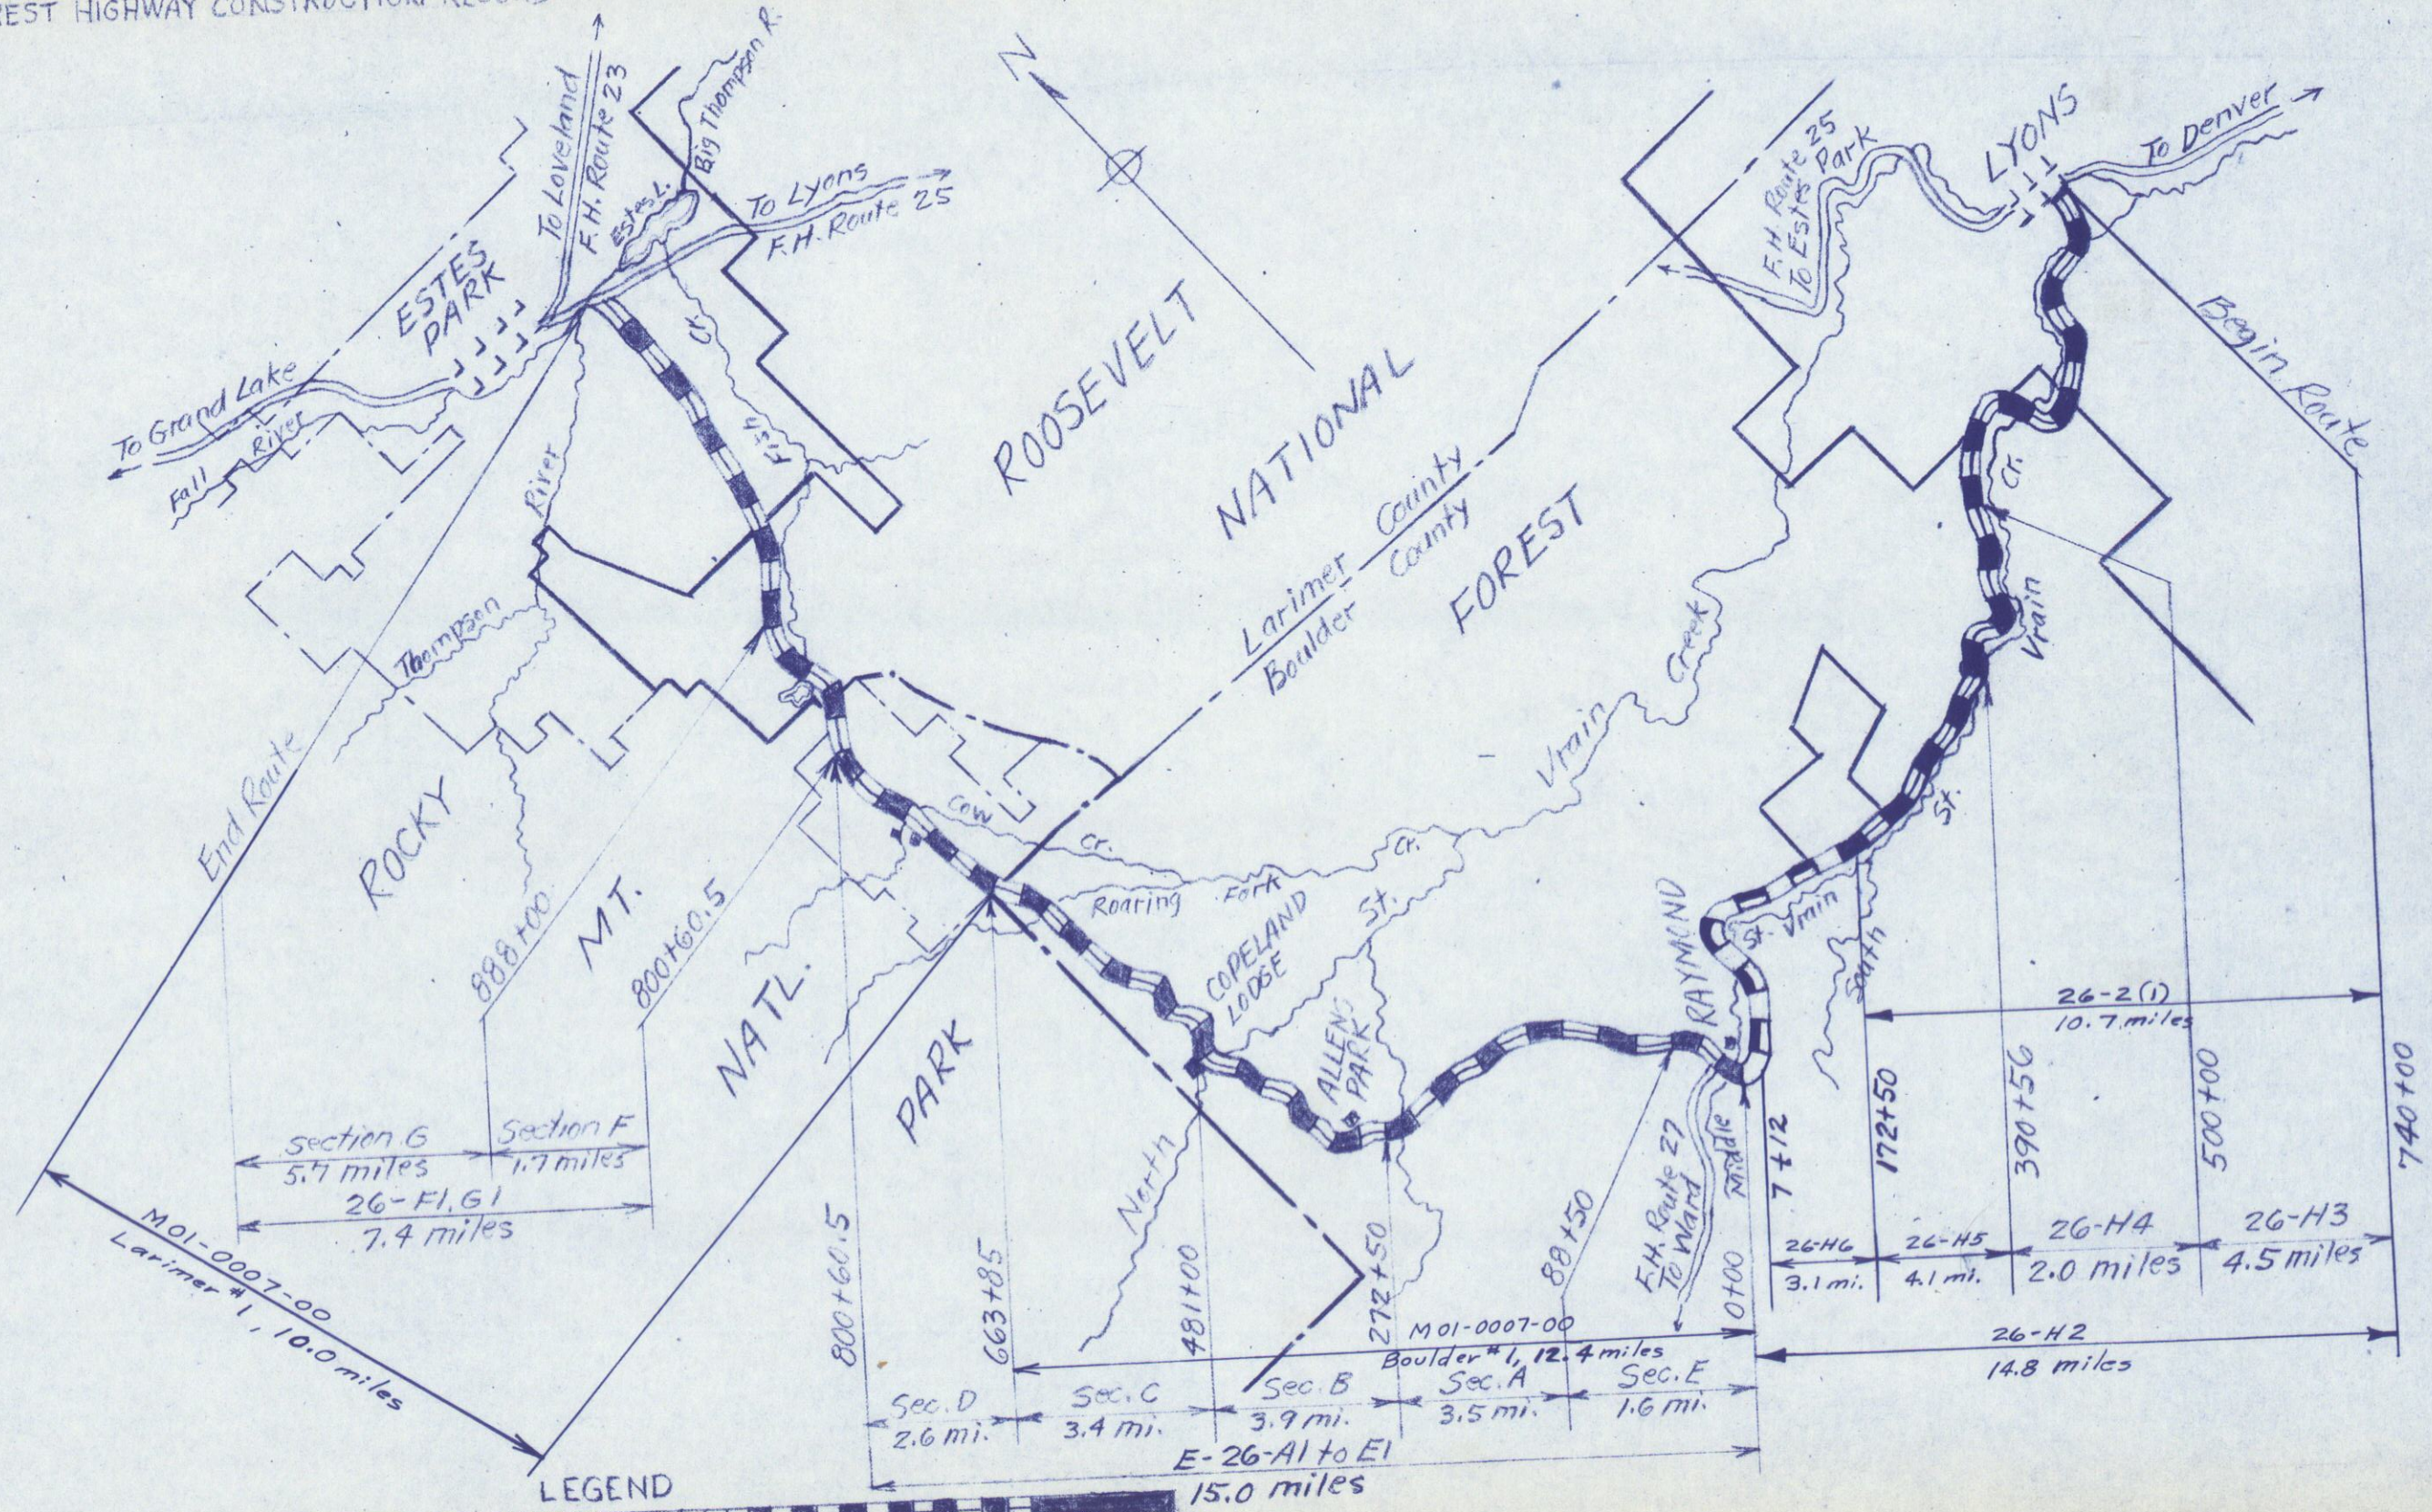

FOREST HIGHWAY CONSTRUCTION RECORD

Colorado Forest Highway Route 26, South St. Vrain


DIRECT CONSTRUCTION BY B. P. R.

PROJECT	TYPE	LENGTH MILES	GRADED ROADWAY SH. TO SH.	COMPACTED SURFACING				CONSTRUCTION DATE MONTH AND YEAR		FOREST HIGHWAY FUNDS		OTHER FUNDS	
				WIDTH		THICKNESS		BEGAN	COMPLETED	FOREST HIGHWAY	B. P. R. ACTIVE PROJECTS	OTHER FEDERAL	STATE & LOCAL
				BASE	TOP	BASE	TOP						
26-A	Cont. Grad. & sel. mat'l. surf.	(3.462)	20'					8-1925	12-1925	29,180.40			
26-B	Cont. Grad. & sel. mat'l. surf.	(3.953)	20'					7-1926	12-1926	65,700.39			
26-C	Cont. Grad. & sel. mat'l. surf.	(3.450)	20'					7-1927	6-1928	67,544.12			
26-D	Cont. Grad. & sel. mat'l. surf.	(2.573)	20'					8-1928	5-1929	26,531.86			
26-E	Cont. Grad. & sel. mat'l. surf.	(1.591)	20'					3-1931	7-1931	36,448.10			
E-26-A1 - E1	Cont. Bit. surf. (plant-mix)	(15.029)			20'		2"	9-1932	7-1933	77,258.99			
NR-26-F	Cont. Grad. & sel. mat'l. surf.	(1.647)	24'					4-1934	10-1934	72,276.34			
26-G	Cont. Grad. & sel. mat'l. surf.	(5.725)*	24'					10-1934	7-1935	152,757.00			
26-H and H1	Cont. Betterments & base treatment	(14.793)	20'		16'		1"	2-1936	10-1936	67,464.73			
26-F1, G1	Cont. Bit. surf. (road-mix)	(7.372)*	24'		20'		2 1/8"	8-1936	10-1936	54,750.00			
26-H2	D.L. Betterments	(14.793)						11-1939	9-1940	42,500.00			
26-I (Transferred to F.H. Route 25)													
26-H3	Cont. Grad. & bit. stab. base	4.547	30'	24'		4"		3-1955	8-1955	444,017.65			
26-H4	Cont. Grad. & bit. stab. base	2.026	32'	26'		4"		4-1956	10-1956	365,653.82			
26-Post Construction--Fiscal Year 1957		(4.546)						2-1956	2-1958	13,798.65			
26-Post Construction--Fiscal Year 1958		(10.644)						8-1957	6-1958	18,696.82			
26-H5	Cont. Grading & bit. stab. base	4.144	32'	26'		4"		1-1960	11-1960	763,367.16			
26-H6	Cont. Grading & bit. stab. base	3.125	36'	32'		4"		6-1962	7-1963	999,523.14			
26-2(1)	Bit. surf.	10.716						4-1965			9,265.00		
SURVEY COSTS										102,490.83			
* 0.152 mile transferred to F.H. Route 25 due to change in Forest Highway System.										3,397,960.00	9,265.00		

ORIGINAL SCALE 1" = 20'

SECTION 20 RANGE 71 W TOWNSHIP 1 N

AS CONSTRUCTED		NO REVISIONS	REVISED	VL 3
DATE	BY	DATE	BY	DATE
10/10/00	GRADCO	10/10/00	GRADCO	10/10/00
REVISIONS				
NO.	DESCRIPTION	DATE	BY	DATE
1	15' C.P.C. MANHOLE SLAB BASE WITH 15" R.C. SP3 IN 12" SECTION LT OUTLET	10/10/00	GRADCO	10/10/00

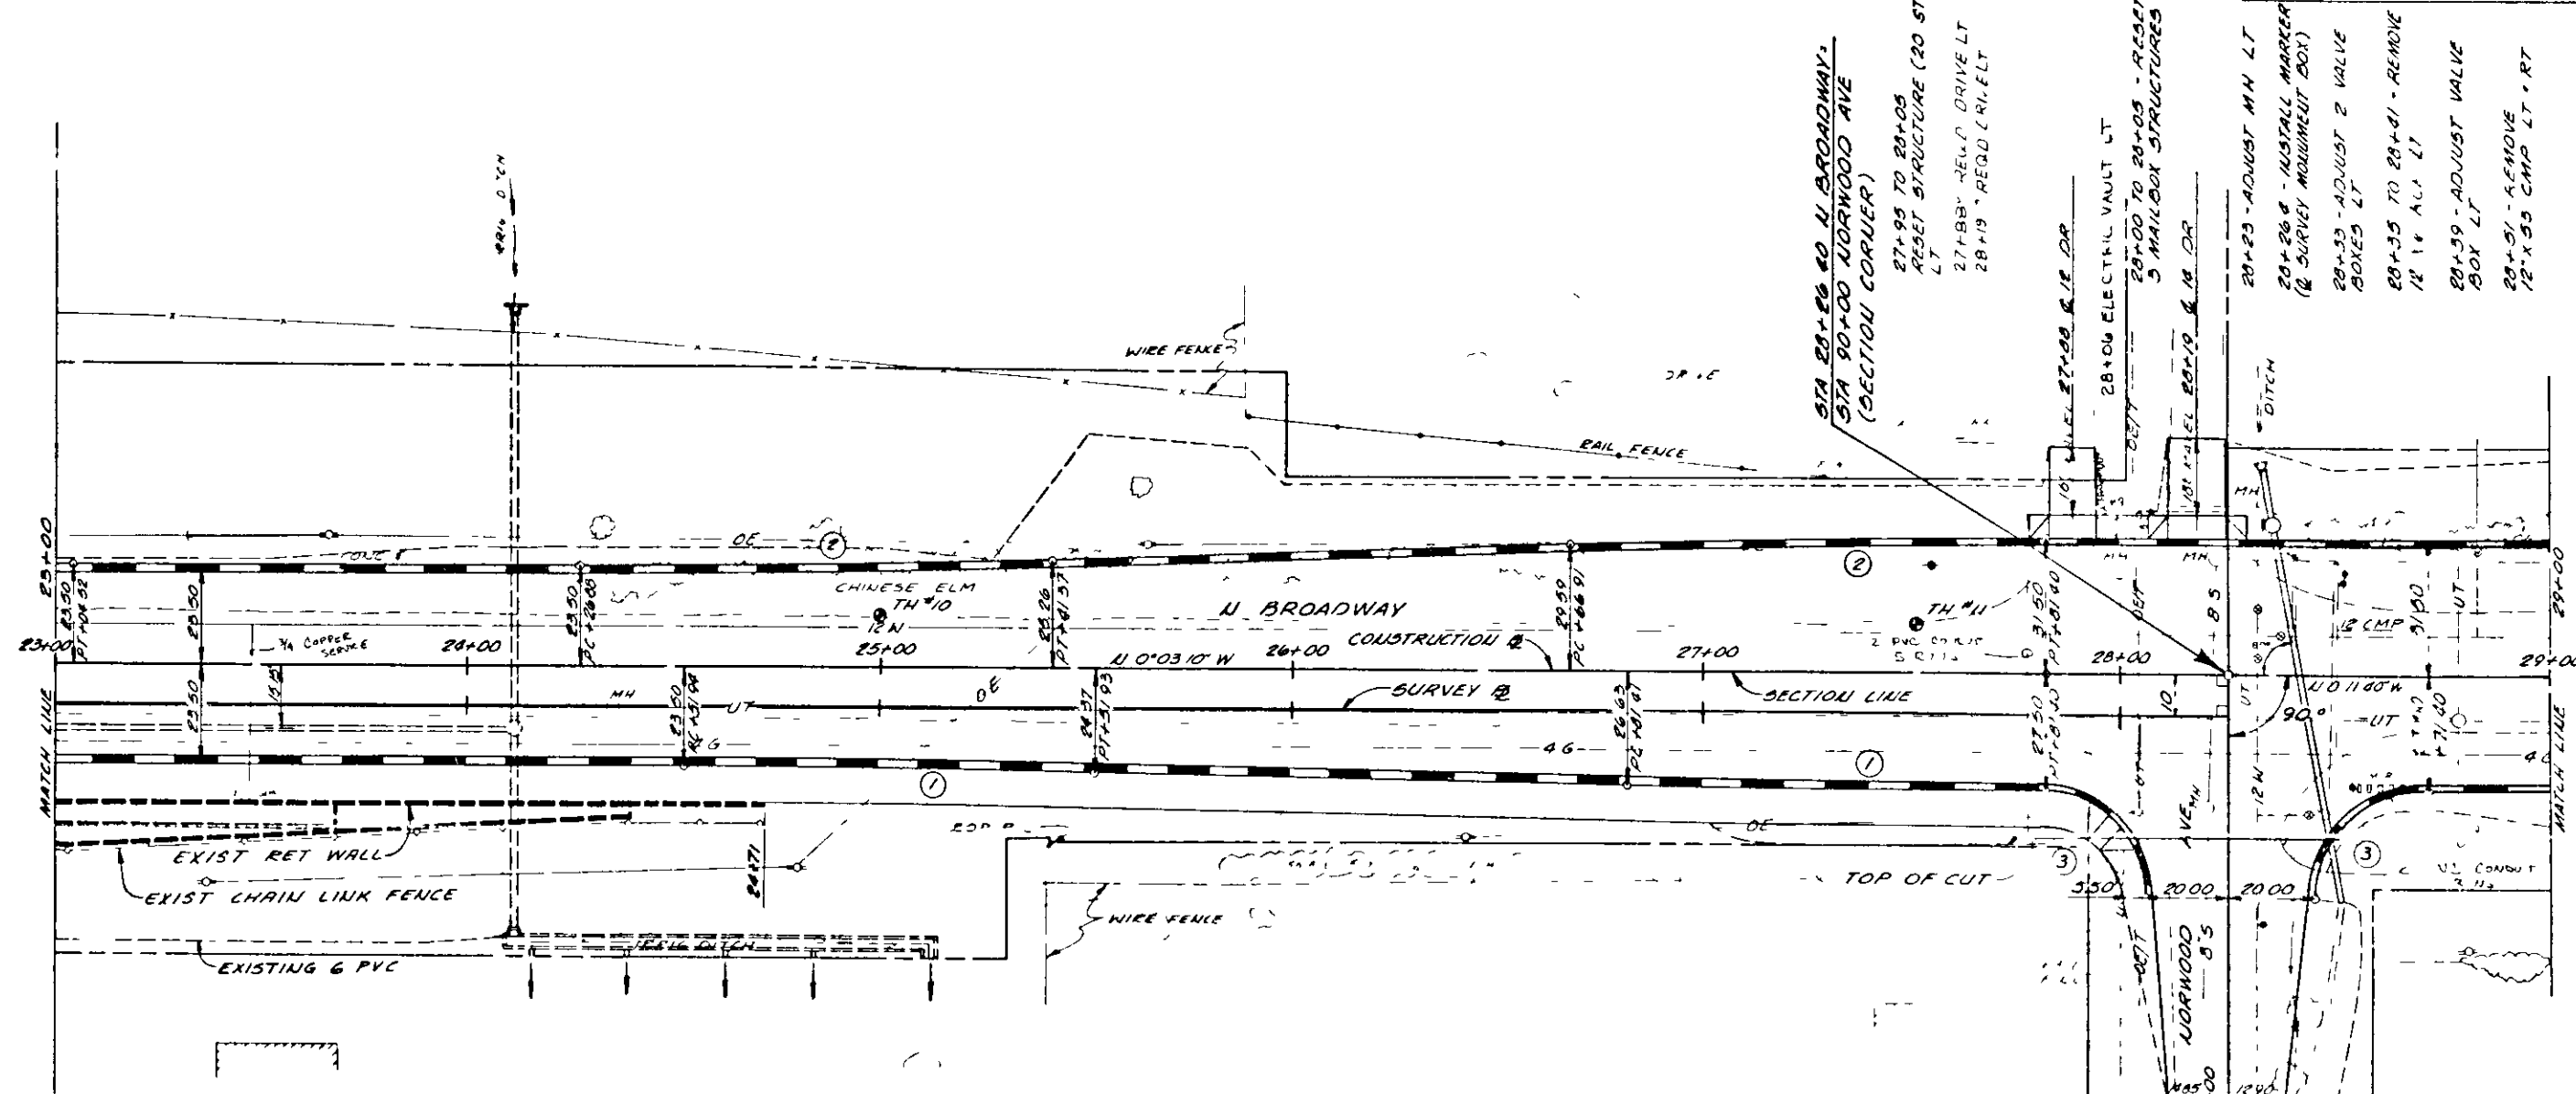

CURVE DATA

①	Δ 100.00 R 5729.58 T 50.00 L 100.00	②	Δ 1°58'33" R 3436.35 T 57.26 L 114.51	③	Δ 90.0000 R 25.00 T 25.00 L 39.27
---	--	---	--	---	--

SECTION 19, RANGE 70 W TOWNSHIP 1 N

STA 91+00 - END FULL DEPTH PAVT MATCH EXIST PAVT BEGIN PAVT TAPERS

29+21 ADJUST MANHOLE RT

29+47 - REMOVE 12" X 20" CMP LT & RT

STA 91+50 - END PAVT TAPERS

29+40 - 15' C.P.C. MANHOLE SLAB BASE WITH 15" R.C. SP3 IN 12" SECTION LT OUTLET

29+55 ADJUST VALVE BOX RT 29+56 TO 29+70 - REMOVE 12" X 20" STRUCTURE

29+71 - REMOVE 12" X 20" CMP LT & RT


AS CONSTRUCTED		
NO REVISIONS	REVISED 0-2-64	VOID

FEDERAL ROAD DISTRICT NO.	DIVISION	PROJECT NO.	SHEET NO.	TOTAL SHEETS
VIII	COLORADO	M 0007 (5)	17	28

REVISIONS	

ORIGINAL SCALE: 1"=20'

SECTION 13, RANGE 71 W, TOWNSHIP 1 N

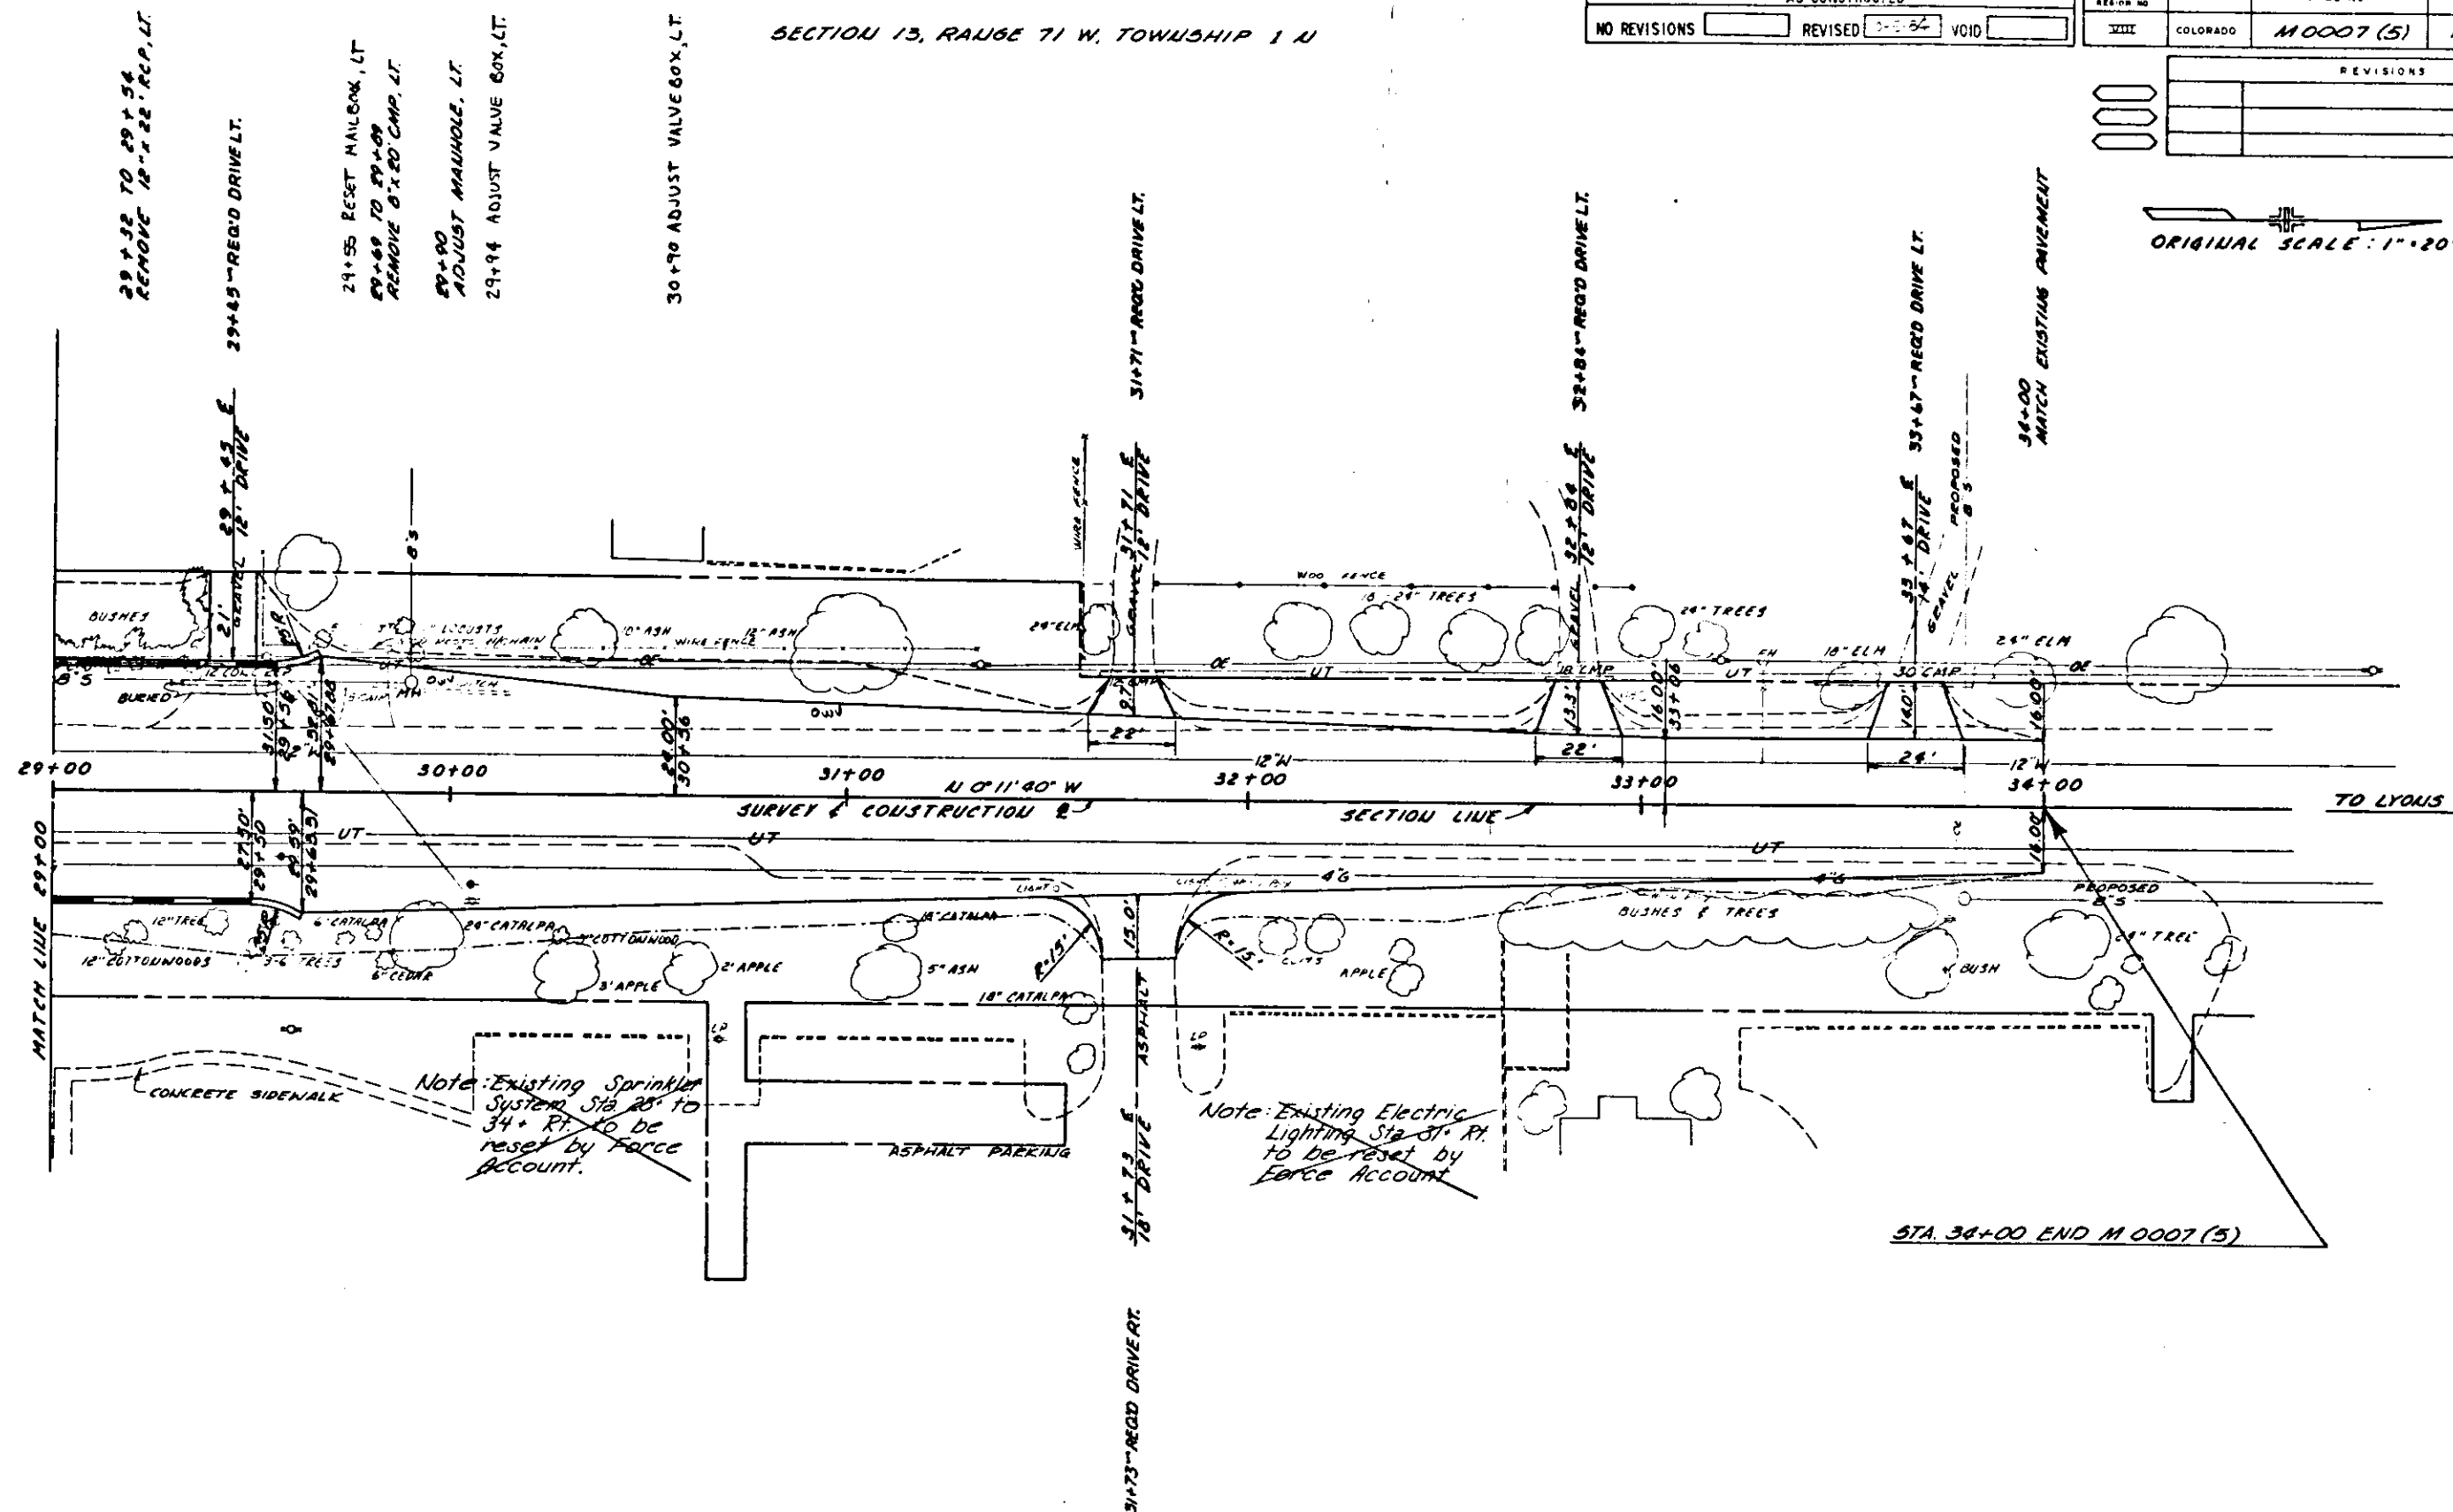

SECTION 18, RANGE 70 W, TOWNSHIP 1 N


SECTION 24, TIN, RTIW

CURVE DATA

CURVE ①	R=2000'
	$\Delta=2^{\circ}51'45"$
	T=49.97'
	L=99.92'
CURVE ②	R=35'
	$\Delta=90^{\circ}14'57"$
	T=35.15'
	L=55.15'

ORIGINAL SCALE: 1"=20'

- FOR & PROFILE OF IRIS AVENUE SEE SHEET NO. 16
- ▲ FOR PIPE EXTENSIONS & HEADWALL DETAIL SEE SHEET NO. 12
- FOR SECTION A-A SEE SHEET NO. 14
- FOR SECTION B-B SEE SHEET NO. 14
- FOR SECTION C-C SEE SHEET NO. 16
- FOR TRAFFIC SIGNAL PLAN SEE SHEET NO. 20
- FOR HEADWALL DETAIL SEE SHEET 11

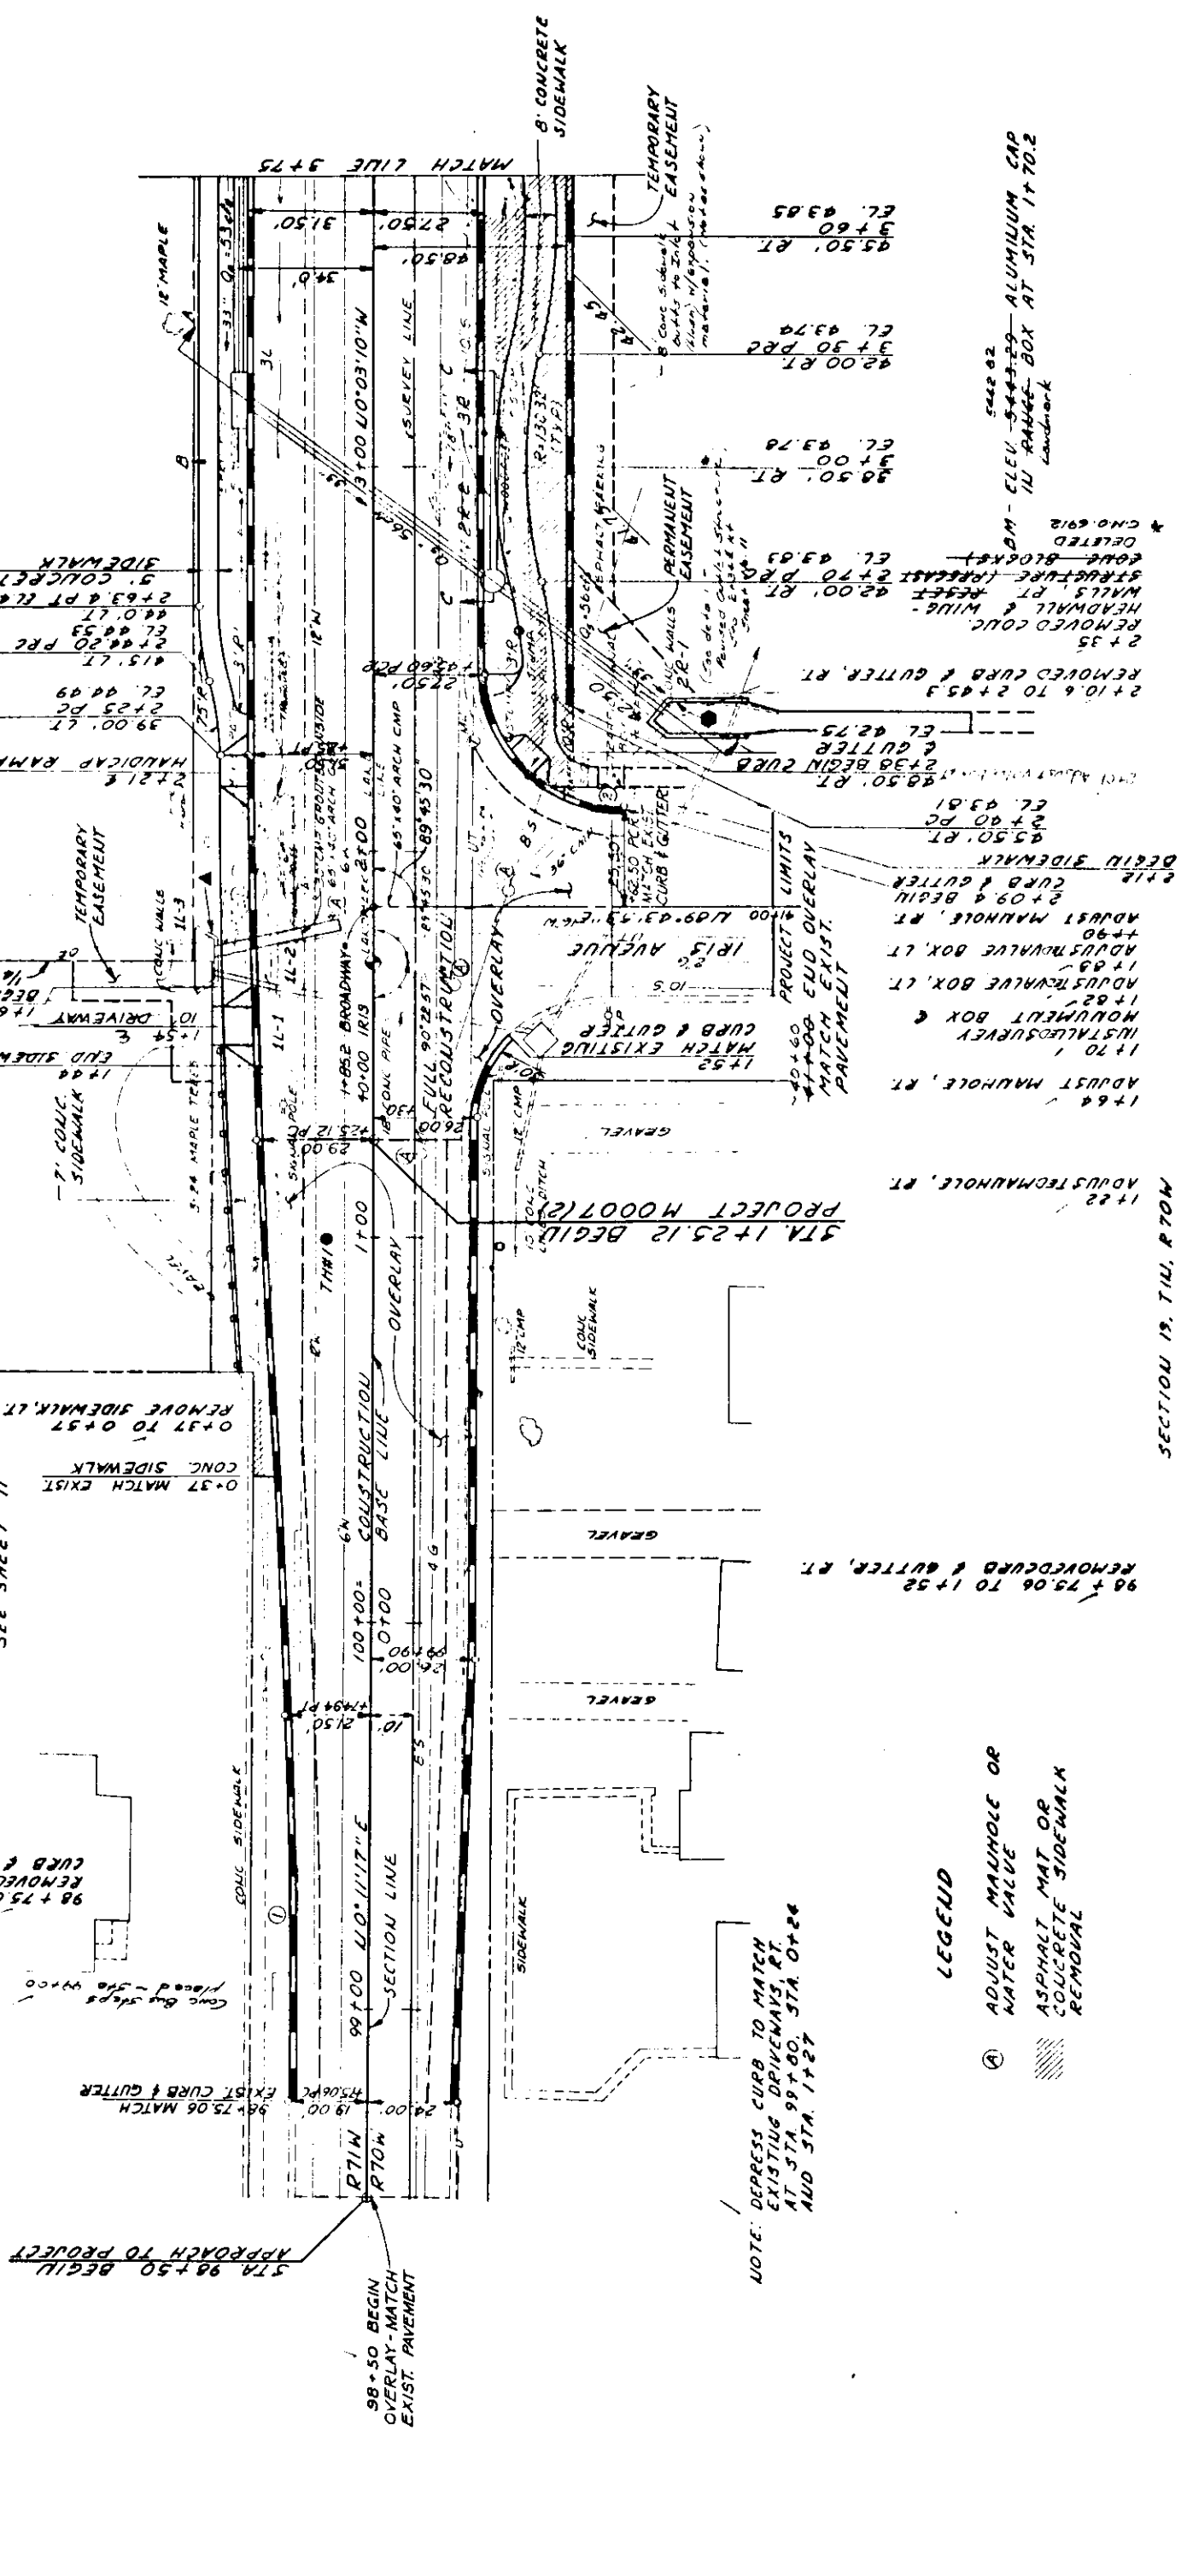

LEGEND

- ① ADJUST MAINTENANCE OR WATER VALVE
- ASPHALT MAT OR CONCRETE SIDEWALK REMOVAL

NOTE: DEPRESS CURB TO MATCH EXISTING DRIVEWAYS, RT. AT STA. 99+00, STA. 0+24 AND STA. 1+27

NO REVISIONS

AS CONSTRUCTED

REVISED 10-22-81

VOID

PROJECT NO.	00007(2)
DIVISION	00000
DATE	1/3
TOTAL SHEETS	27

UTILITY OWNERS

GAS AND ELECTRIC
 TELEPHONE
 WATER
 SANITARY SEWERS
 IRRIGATION FACILITIES

PUBLIC SERVICE CO. OF COLORADO	MOUNTAIN BELL	CITY OF BOULDER	CITY OF BOULDER	SILVER LAKE DITCH	AND RESERVOIR CO.

REVISIONS

ORIGINAL SCALE: 1" = 20'

N