


U.S. DEPARTMENT OF COMMERCE
BUREAU OF PUBLIC ROADS

AS CONSTRUCTED
PROJECT 26-A(1069)
ROUTE 26 SOUTH ST. VRAIN HIGHWAY
LYONS VIA RAYMOND TO ESTES PARK
37 MILES CLASS 2
COLORADO FOREST HIGHWAY SYSTEM


ROOSEVELT NATIONAL FOREST
BOULDER & LARIMER COUNTIES
COLORADO

DAY	STATE	ROUTE	SECTION	SCALE	DATE
3	COLO.	26	A		

INDEX TO SHEETS		
SHEET NO.	DESCRIPTION	SCALE
1	Plan Sheet	
2	Typical Sections	
3	Summary	
4	Plan & Profile	
5	C.R.M. Plans for Pipe Culverts	
6	S&B Masonry Structures	
7		
8		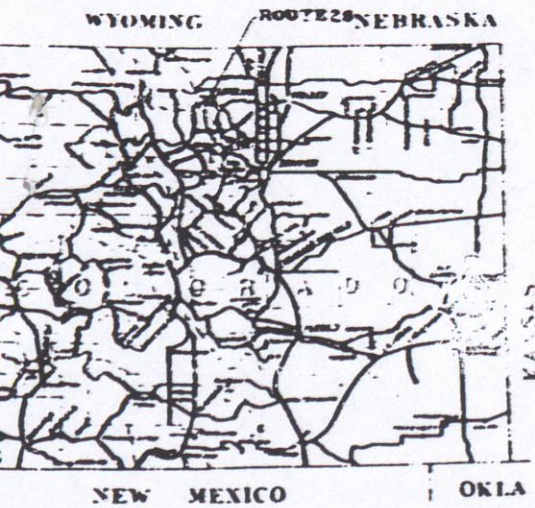
Federal Aid Highway System
Primary
Secondary
Forest Highway System
National Forests

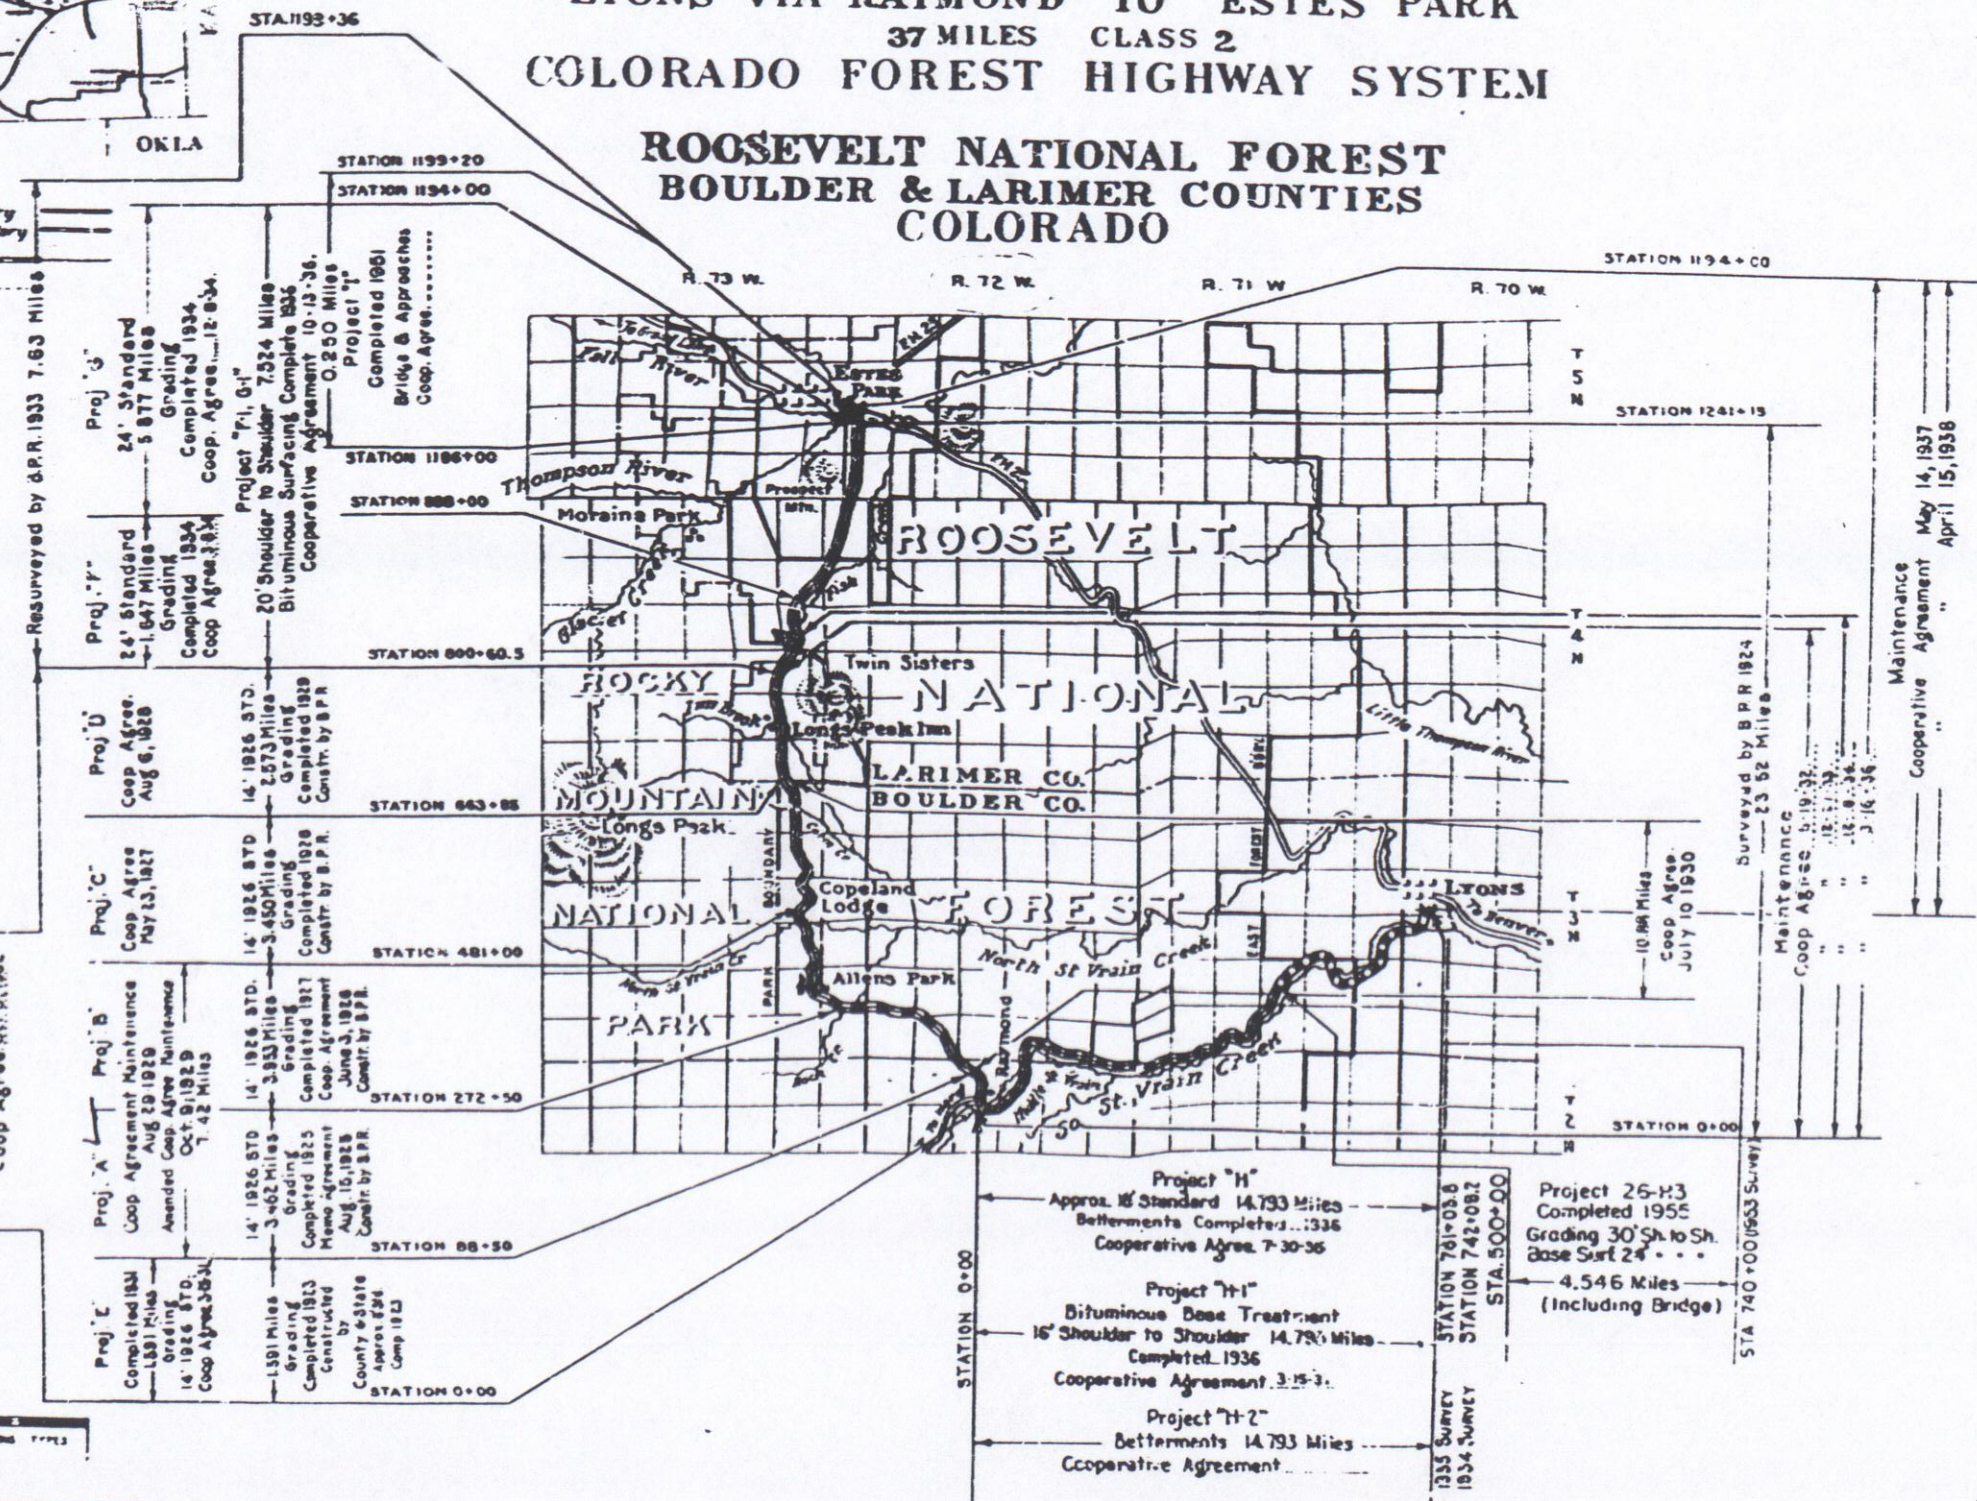


Surveyed by B.P.R. 1924
23.52 Miles
Maintenance
Coop. Agrec. 5-19-32
" " " " 12-1-34
" " " " 3-16-36
Coop. Agrec. July 10 1930
Maintenance
Coop. Agrec. May 14, 1937
" " " " April 15, 1938





4-15-25

U.S. DEPARTMENT OF COMMERCE
BUREAU OF PUBLIC ROADS
DIVISION NO. 9 DENVER, COLORADO

APPROVED _____ DATE _____
ACTING DIVISION ENGINEER
BY DES. ENGR.
APPROVED _____ DATE _____
DISTRICT ENGINEER
APPROVED _____ DATE _____
REGIONAL FORESTER
APPROVED _____ DATE _____
CHIEF ENGINEER
COLORADO DEPARTMENT OF HIGHWAYS

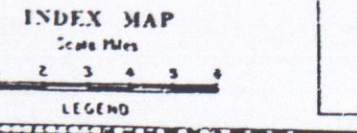

SYMBOL	DESCRIPTION
[Symbol]	Primary Highway
[Symbol]	Secondary Highway
[Symbol]	Forest Highway
[Symbol]	National Forest
[Symbol]	County Boundary
[Symbol]	Range Boundary
[Symbol]	Township Boundary
[Symbol]	Water
[Symbol]	Settlement
[Symbol]	Other

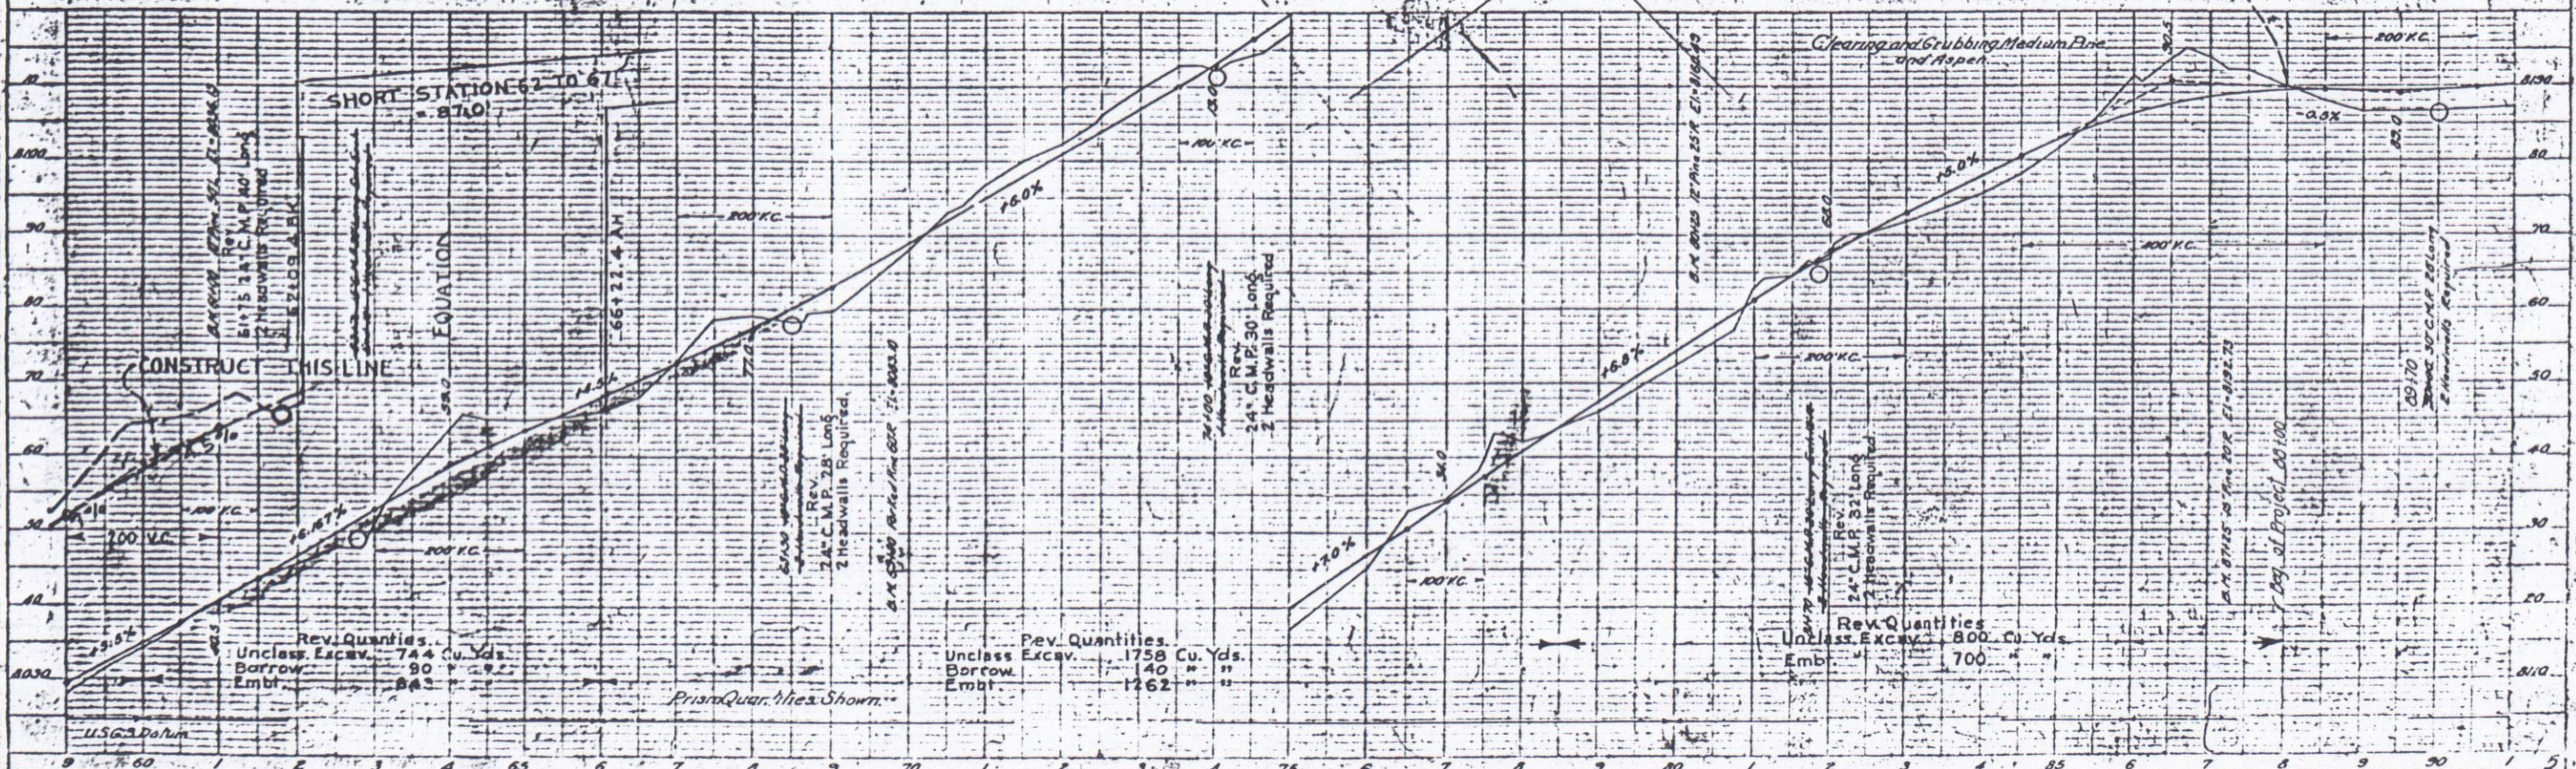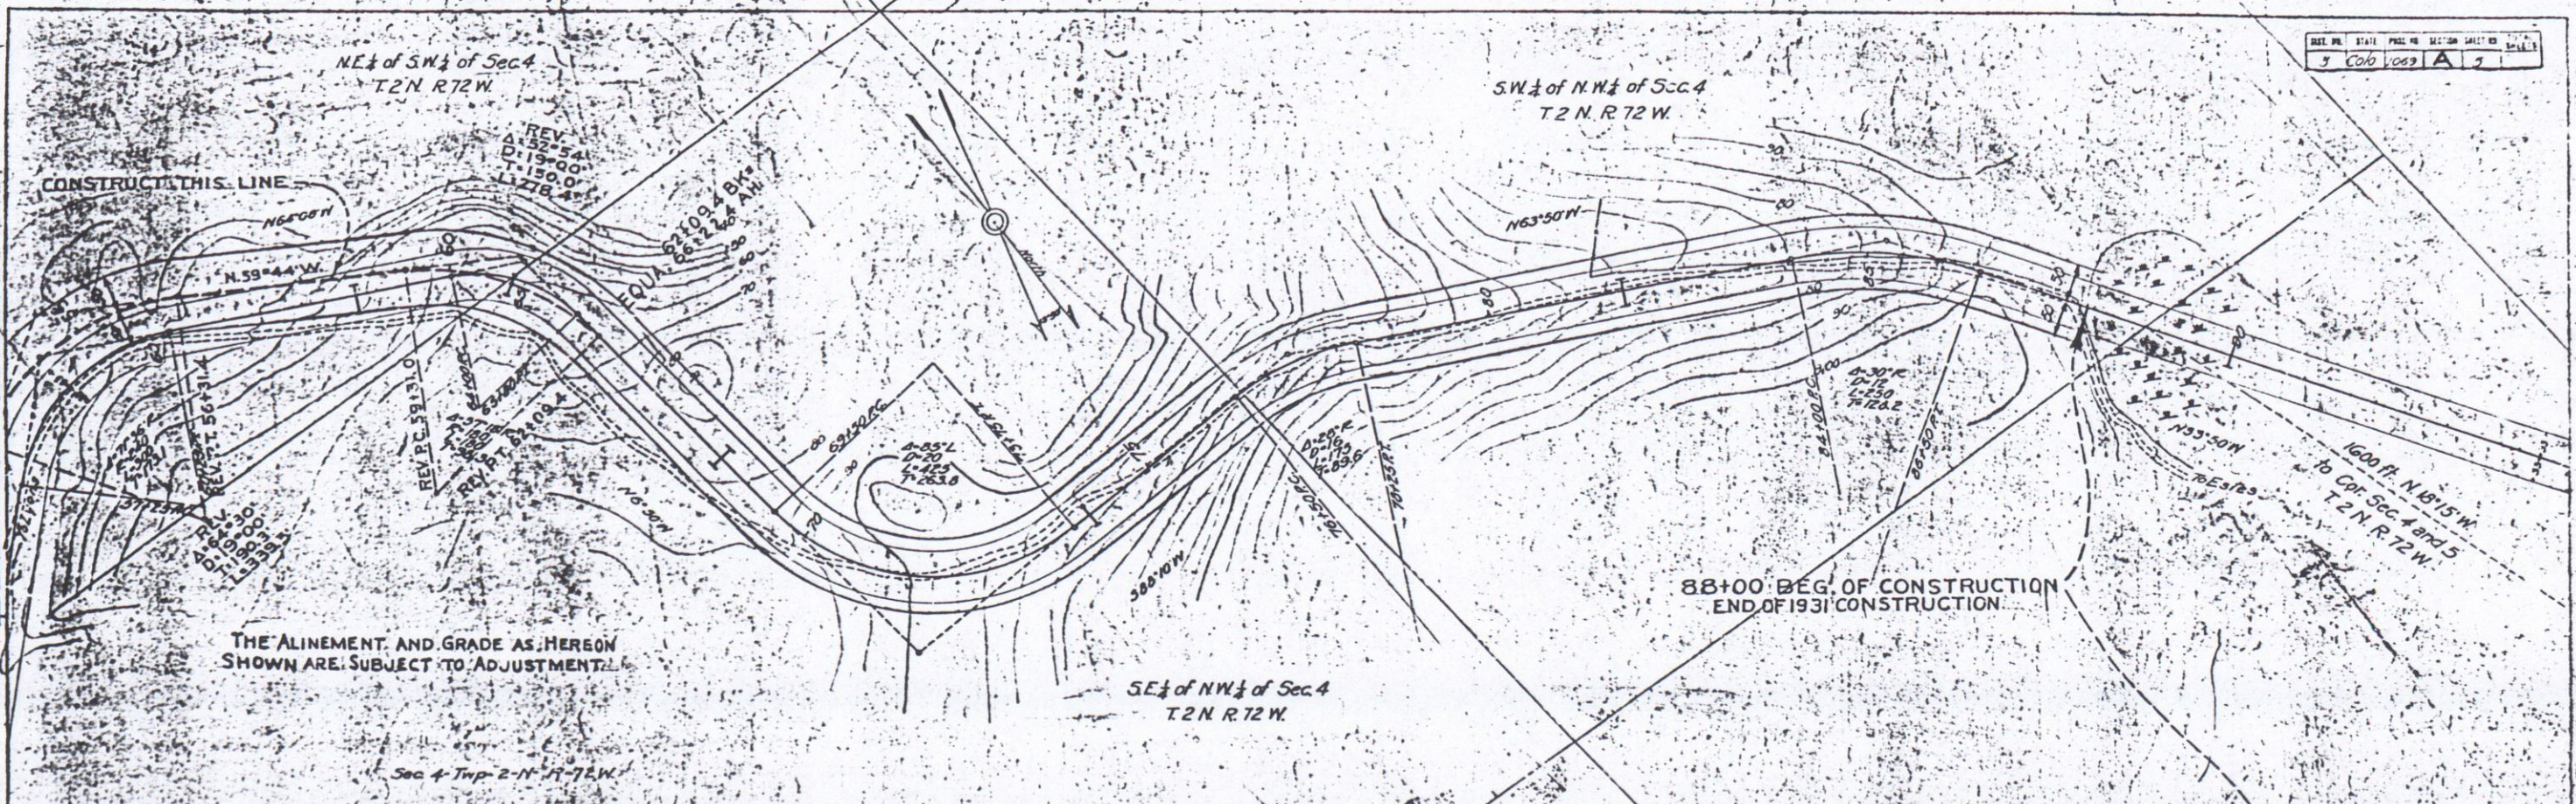


Rev. Quantities
 Unclass. Excav. 744 Cu. Yds.
 Borrow 90 " "
 Embt. 843 " "

Rev. Quantities
 Unclass. Excav. 1758 Cu. Yds.
 Borrow 140 " "
 Embt. 1262 " "


Rev. Quantities
 Unclass. Excav. 800 Cu. Yds.
 Embt. 700 " "

PLAN
 DRAWN BY
 CHECKED BY
 DATE

PROFILE
 DRAWN BY
 CHECKED BY
 DATE

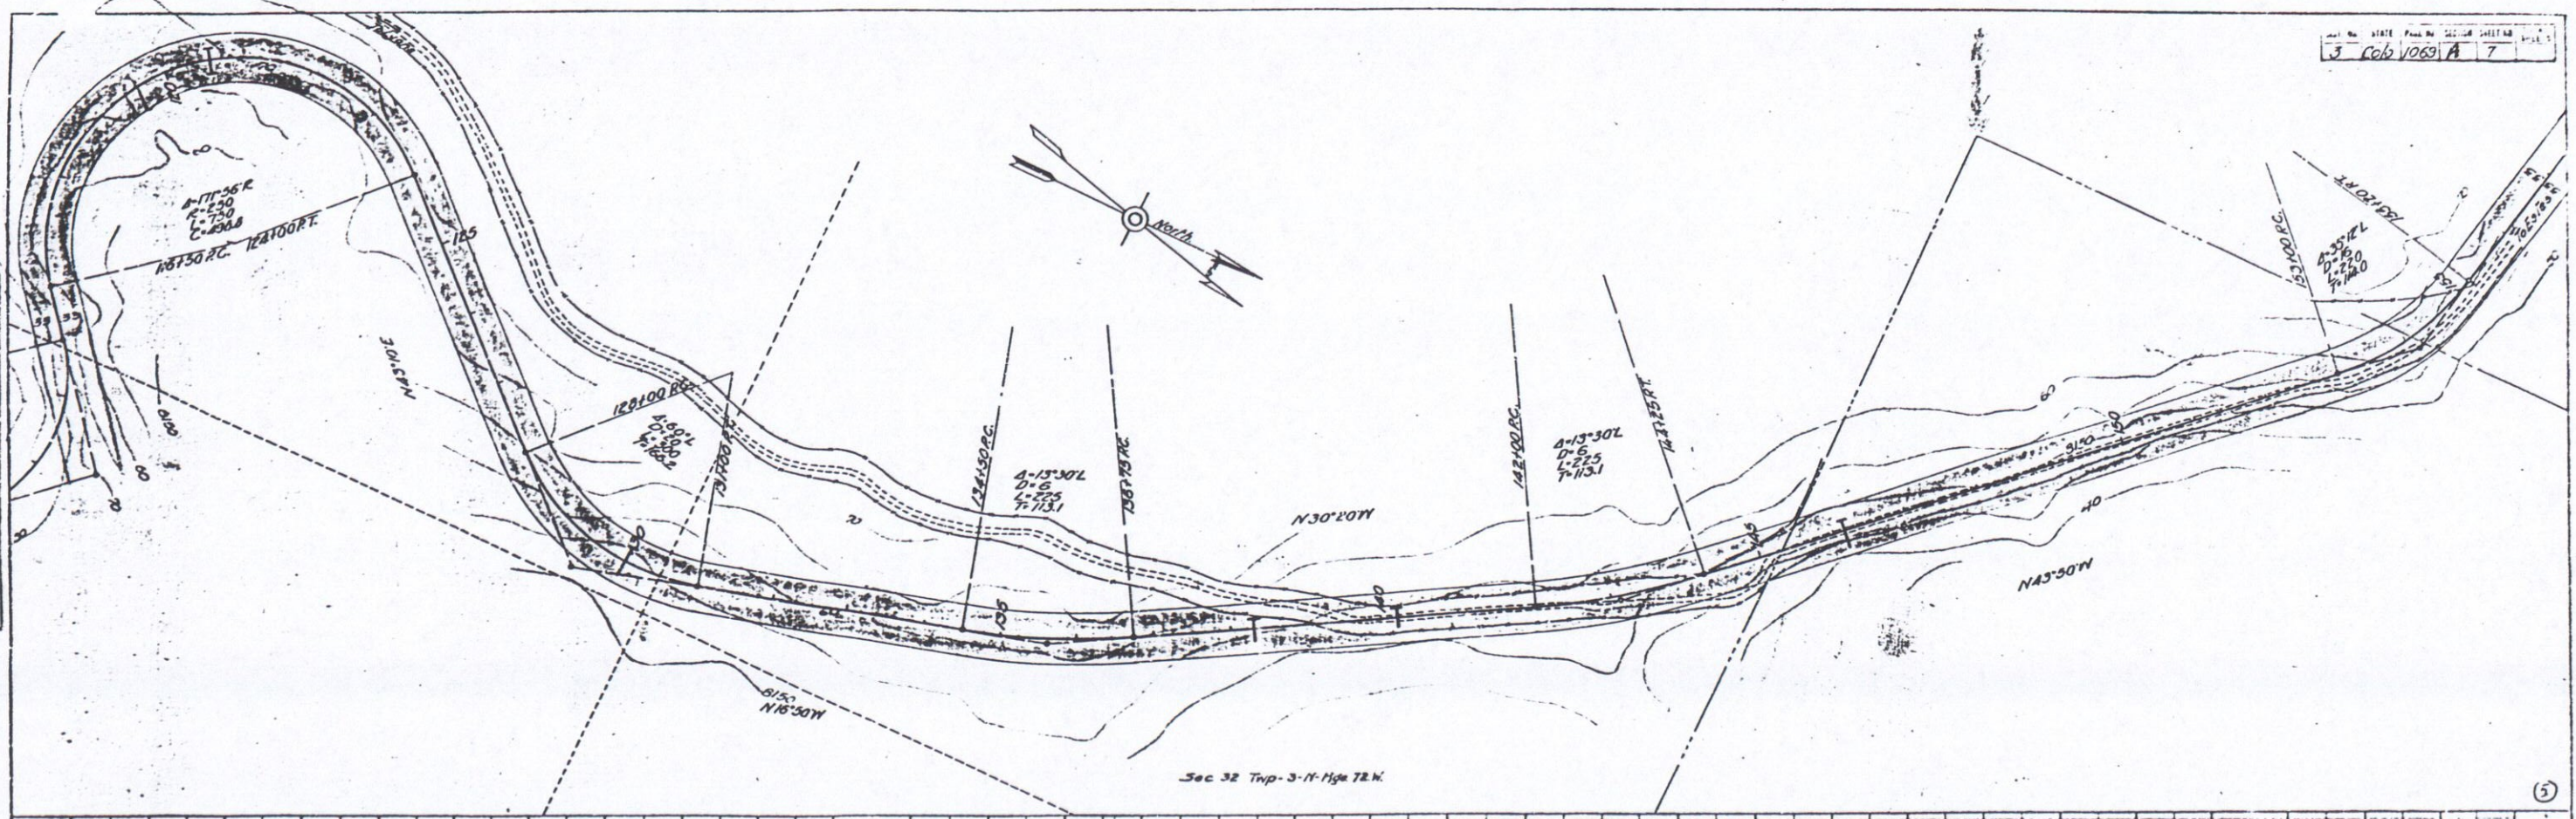

Sec 32 Twp-3-N Rge 7E

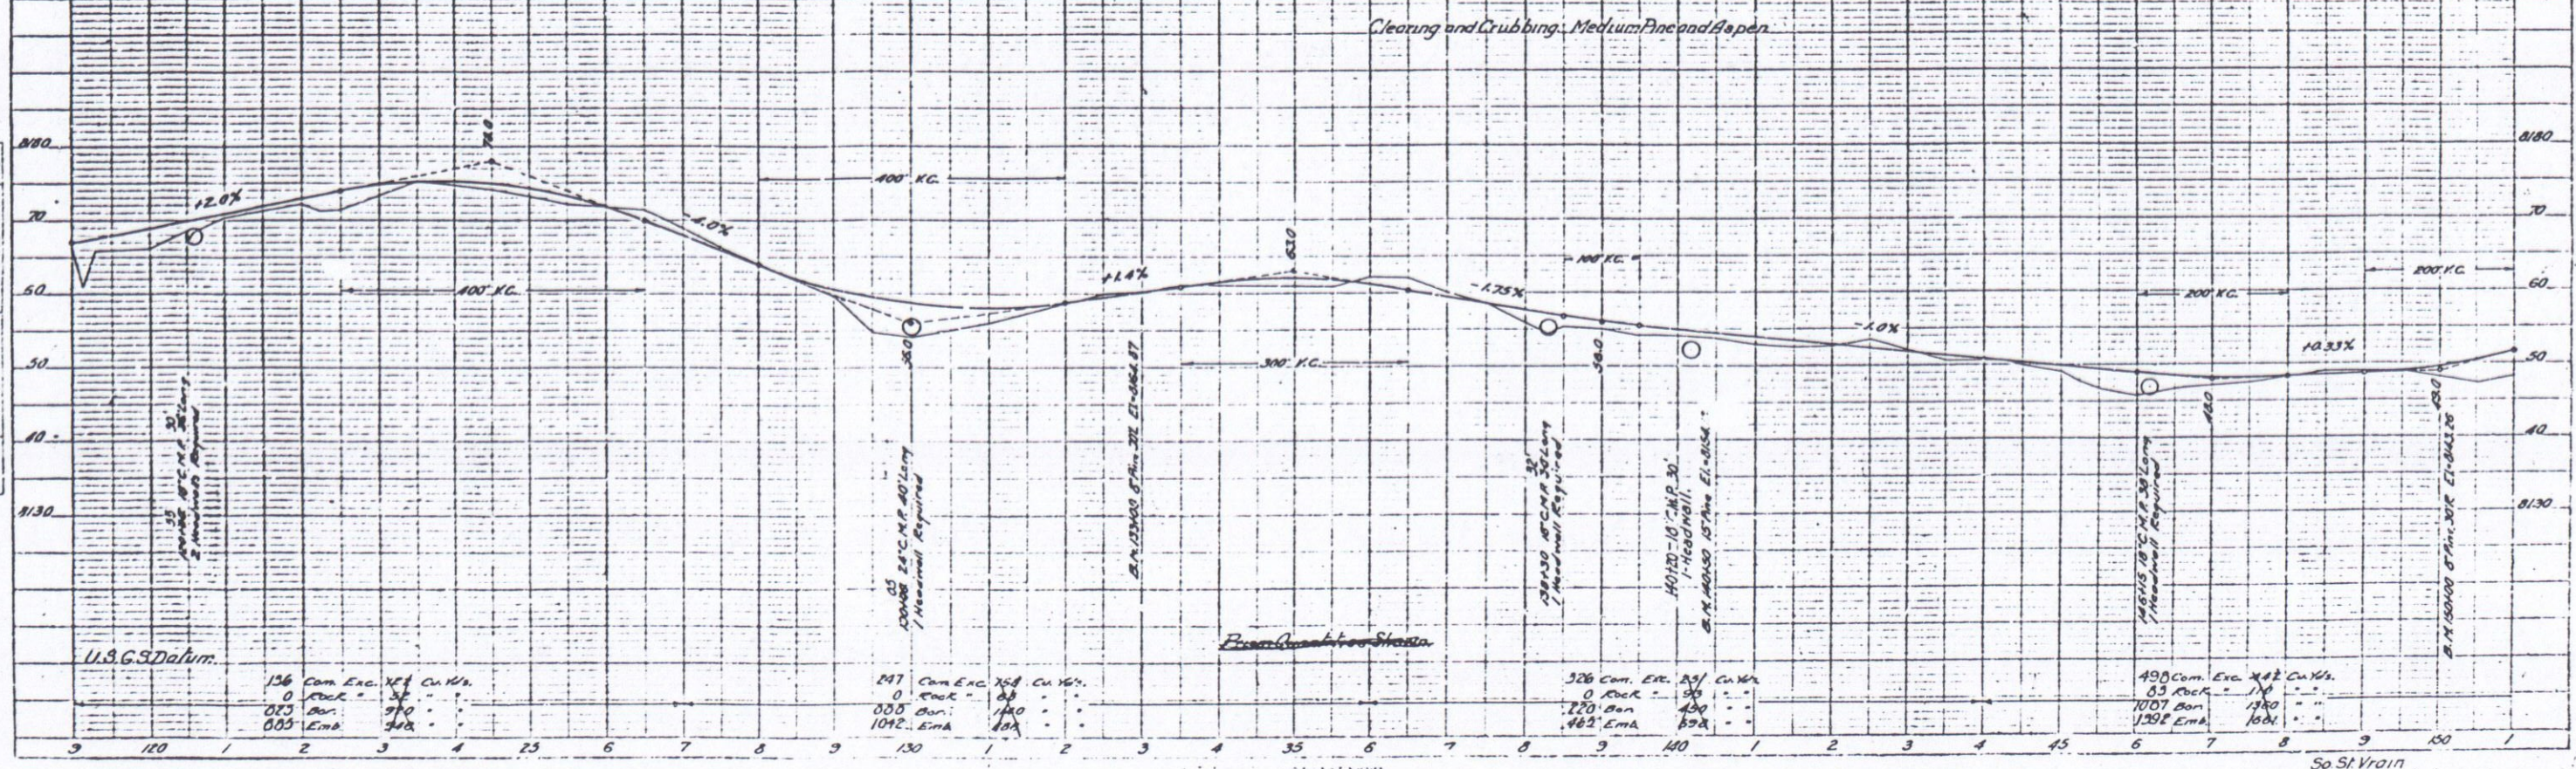

U.S.G.S Datum

136	Com. Exc.	1.4	Cu Yds.
0	Rock	50	
083	Bar.	90	
003	Emb.	40	

247	Com. Exc.	3.5	Cu Yds.
0	Rock	0	
005	Bar.	10	
1042	Emb.	100	



326	Com. Exc.	2.5	Cu Yds.
0	Rock	50	
220	Bar.	100	
462	Emb.	50	

498	Com. Exc.	4.2	Cu Yds.
83	Rock	100	
1007	Bar.	100	
1292	Emb.	100	

So St. Vrain

PROFILE	DATE	SA Wallace	1924
PLANNED	BY	J. F. Smith	
CHECKED			
BY			
DATE			


PLAN	DATE	SA Wallace	1924
PLANNED	BY	J. F. Smith	
CHECKED			
BY			
DATE			

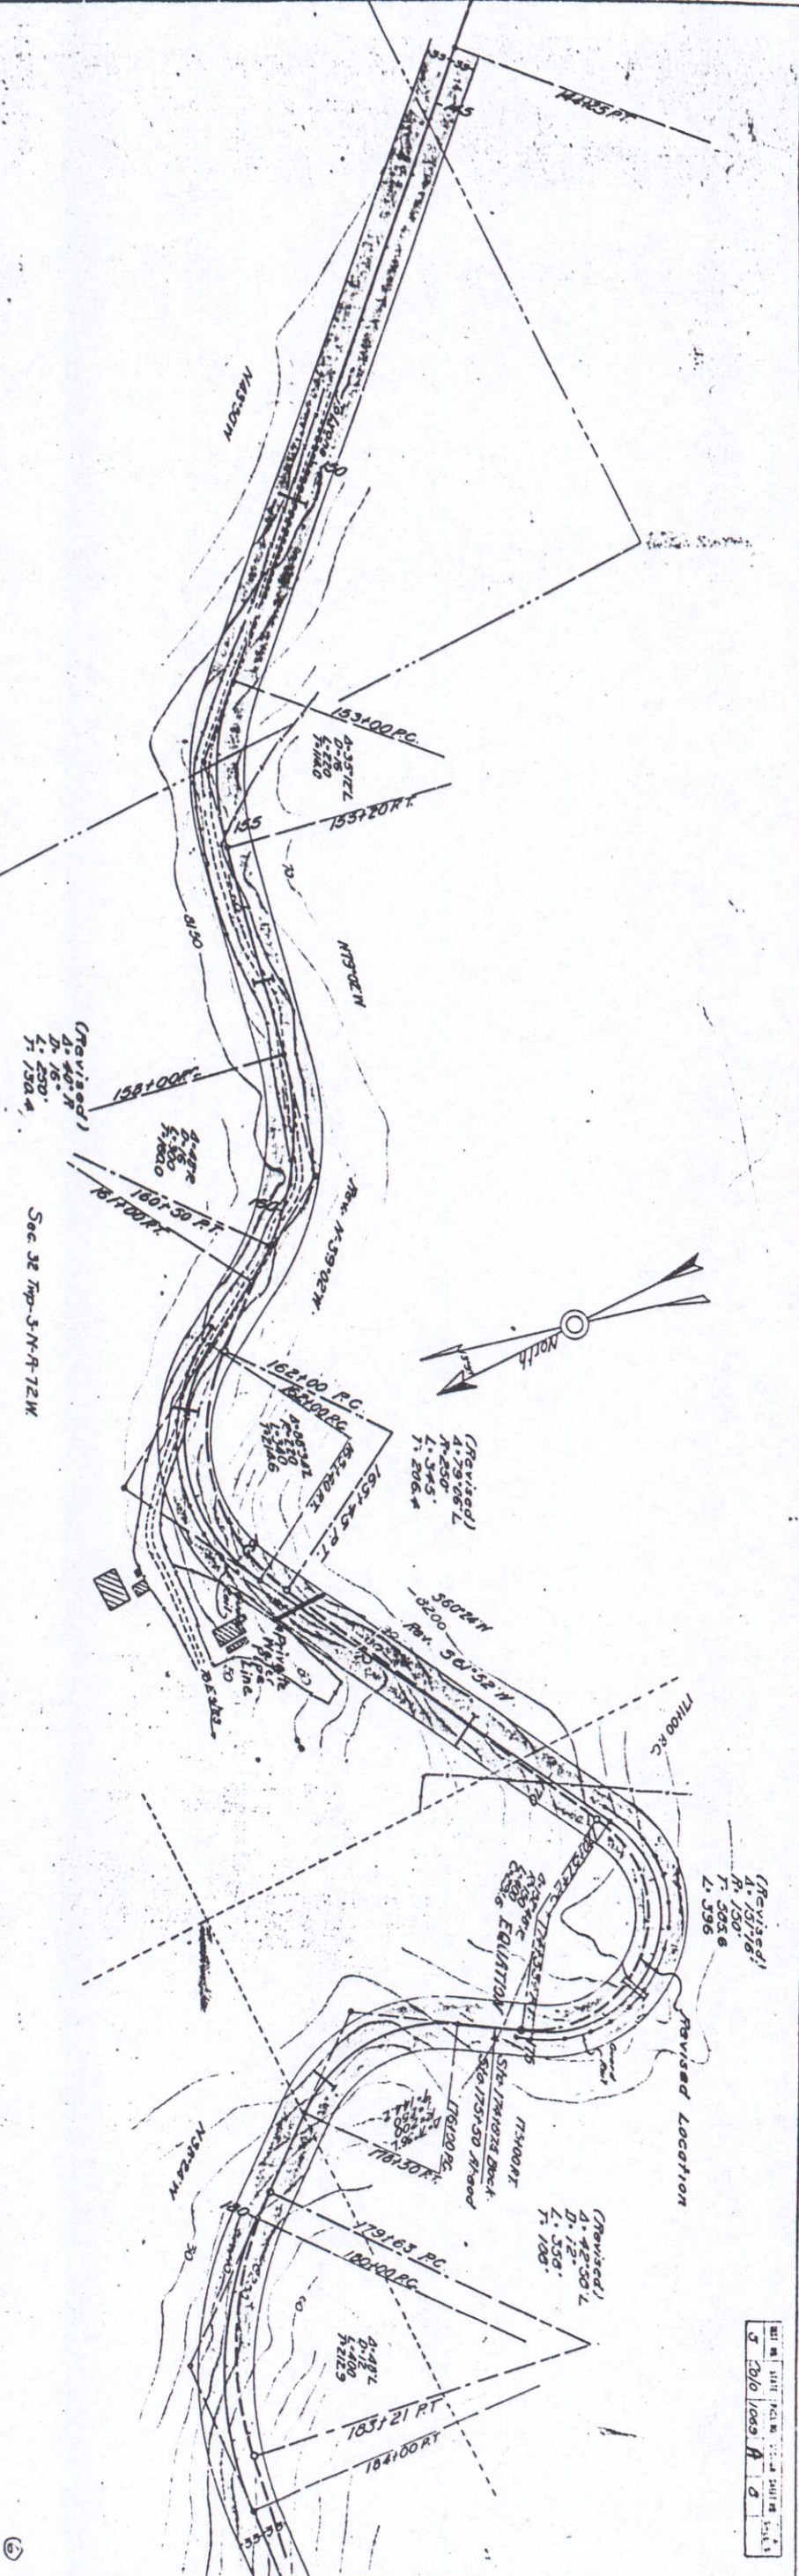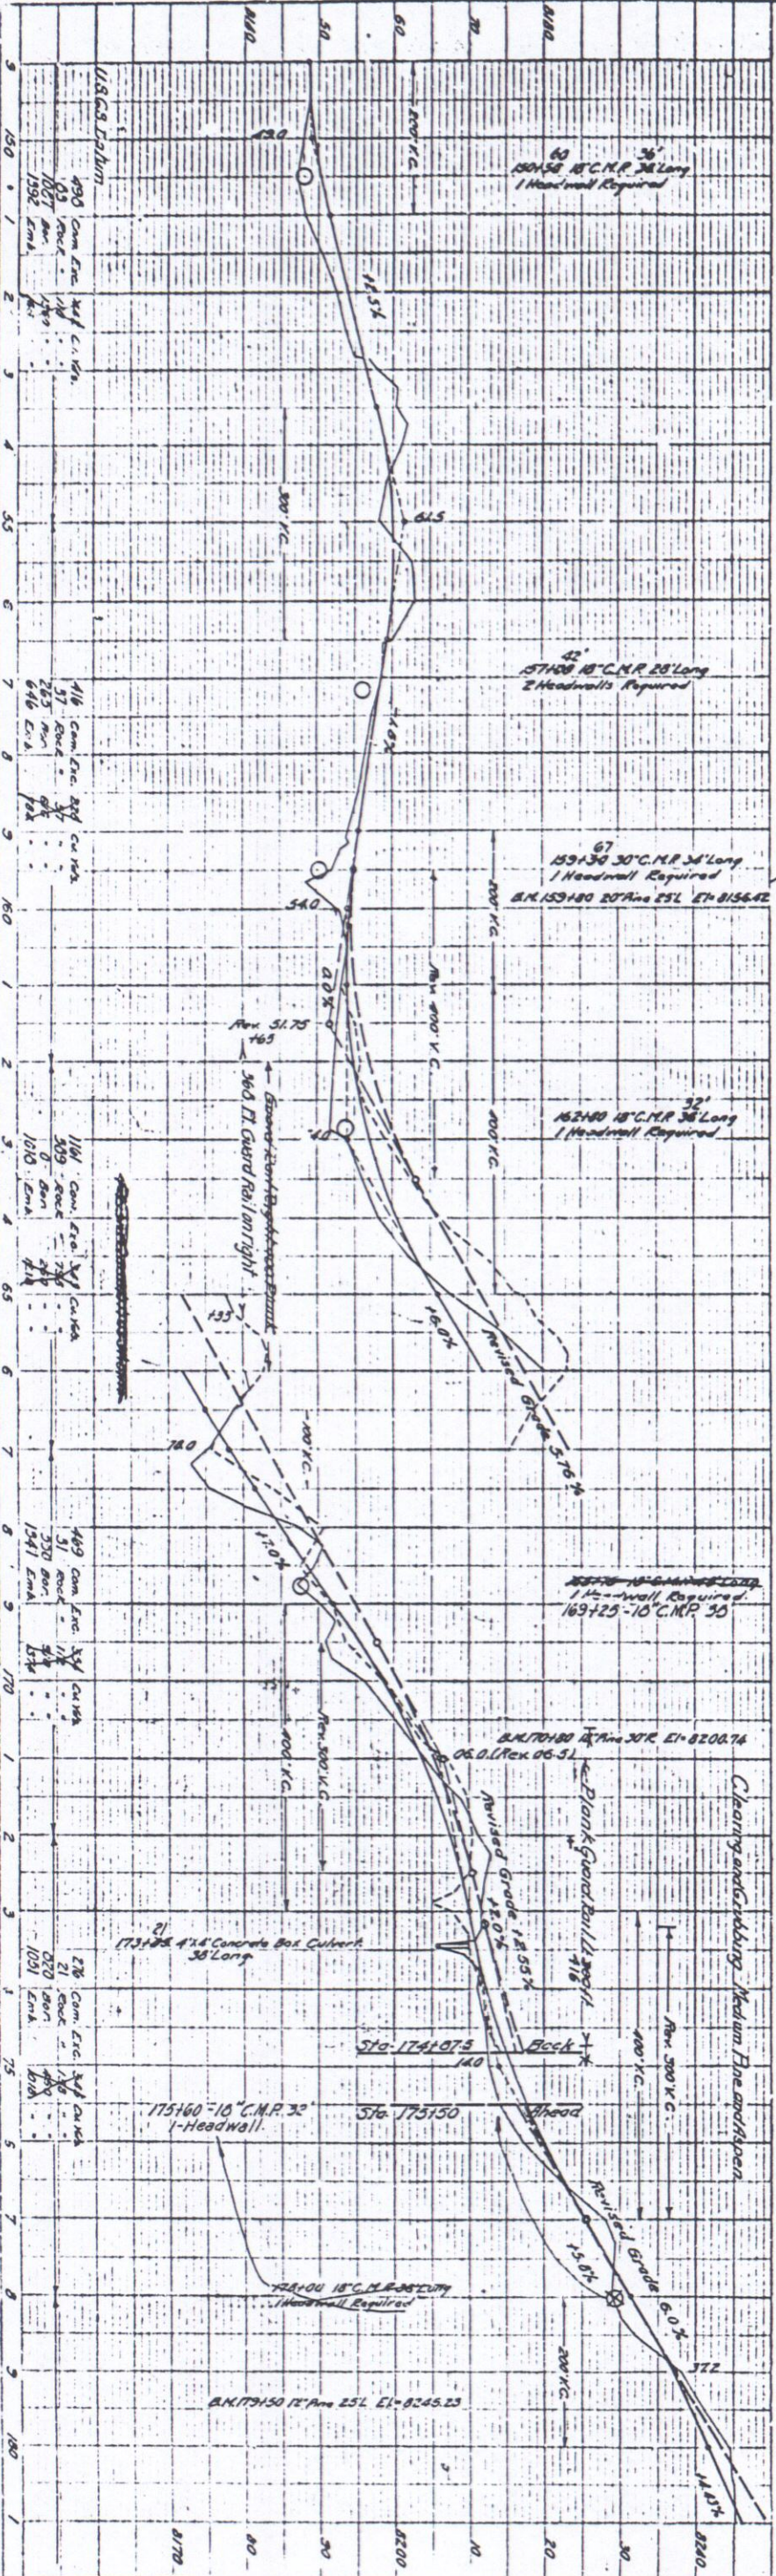


As constructed

SEE SHEET 10009 A

PLAN
 DRAWN BY
 CHECKED BY
 DATE

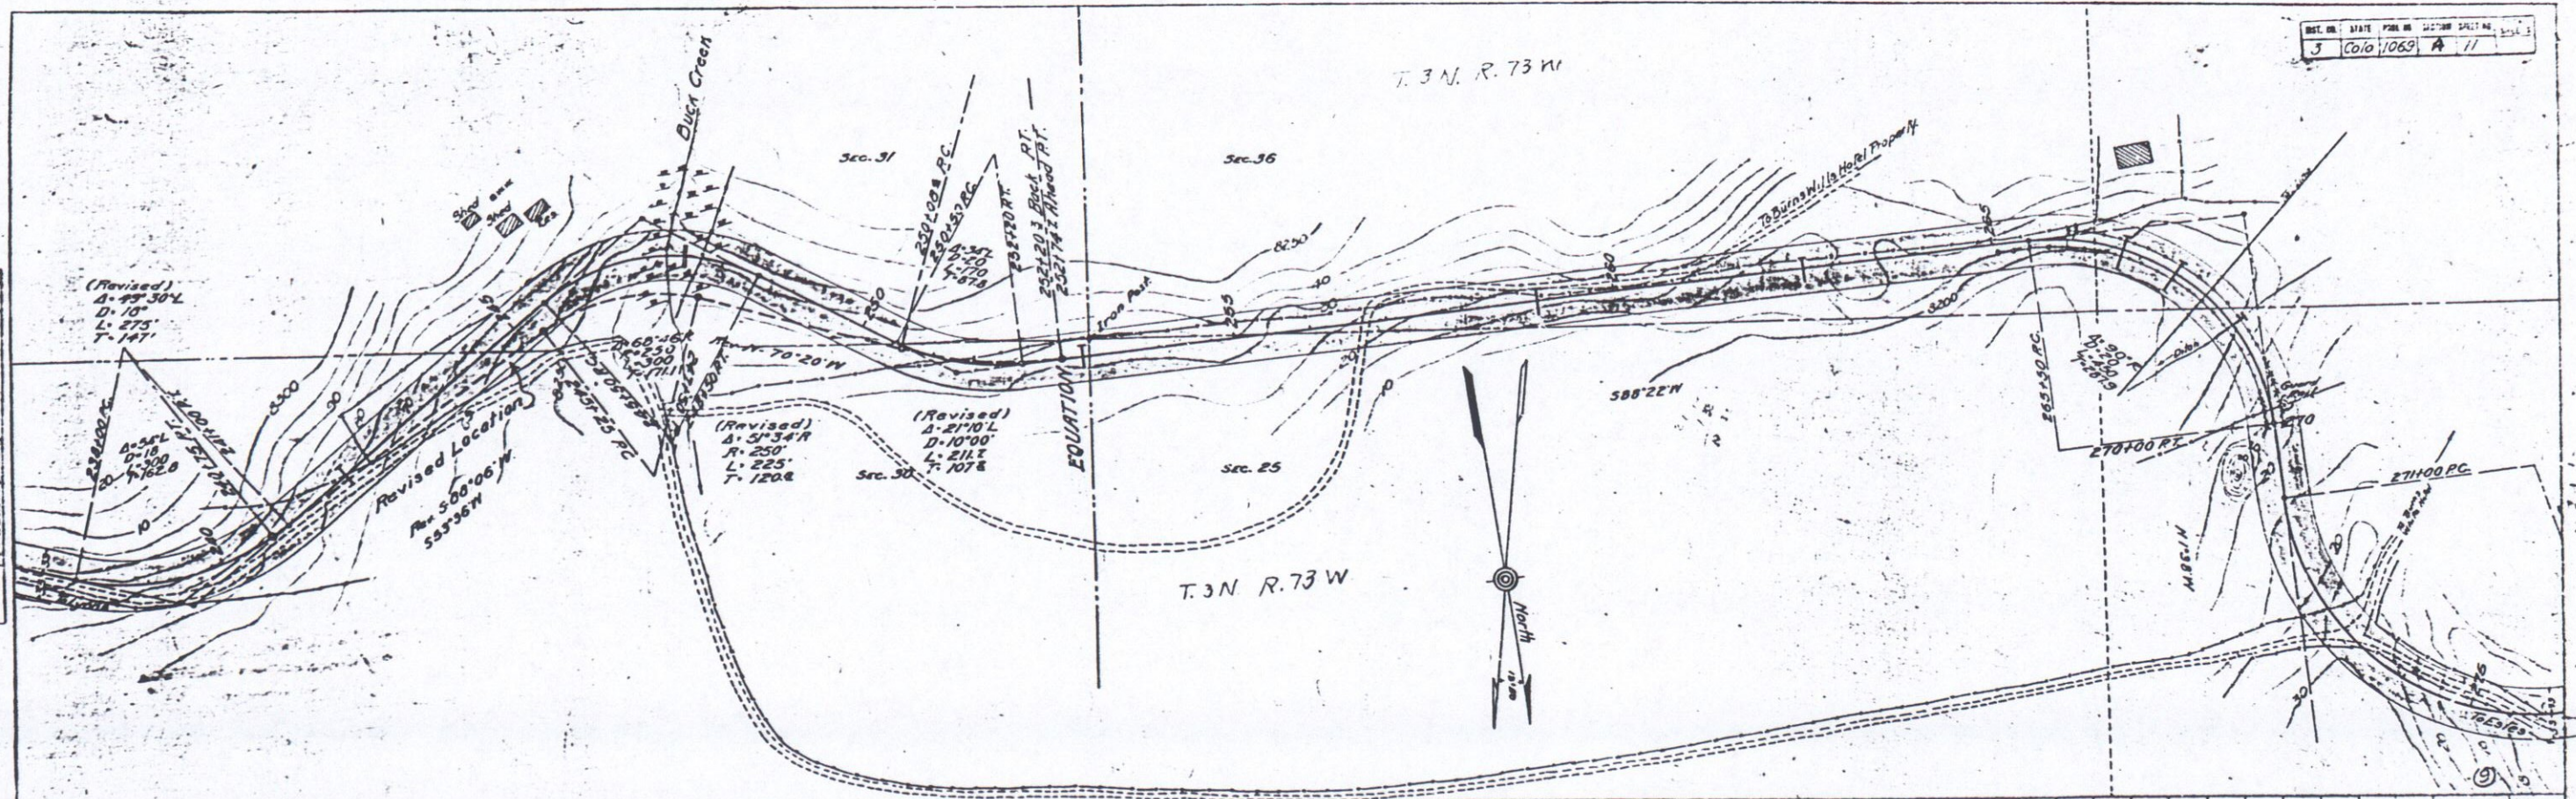


PROFILE
 DRAWN BY
 CHECKED BY
 DATE

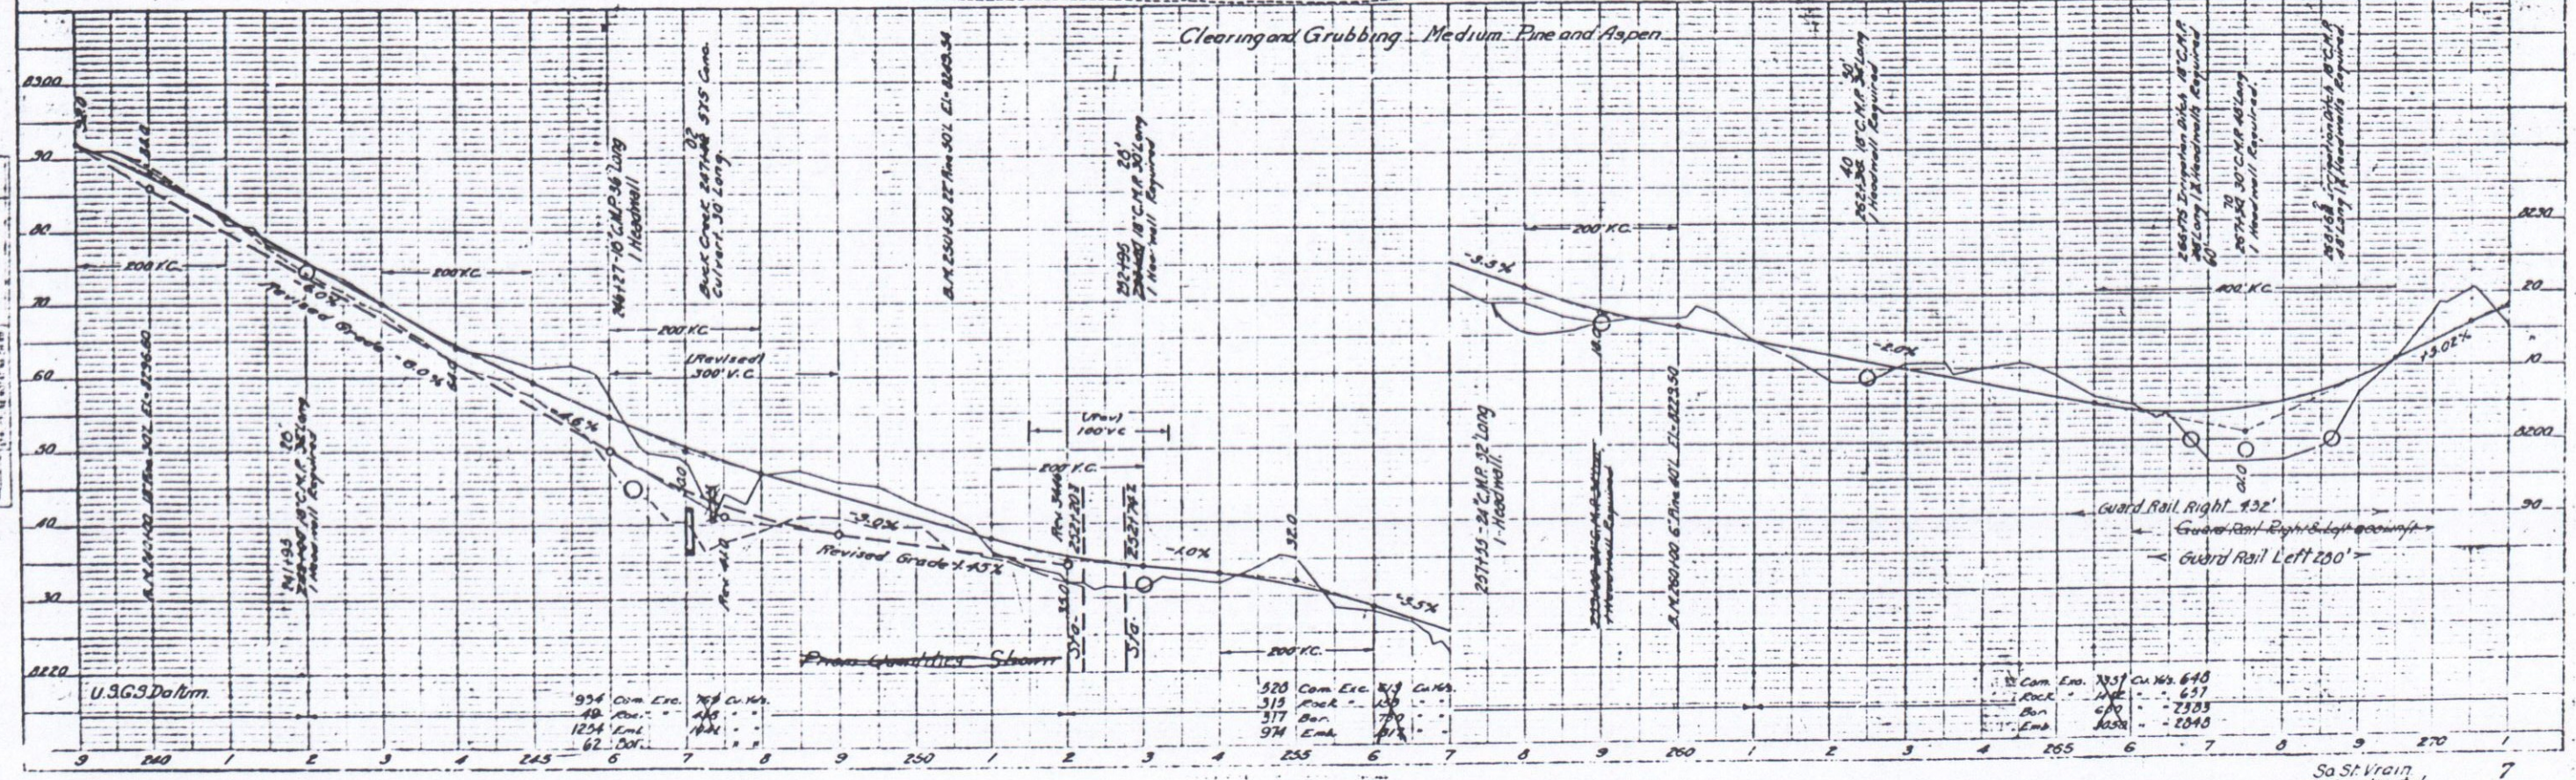

PLAN

DATE	10/12/59
BY	J. H. ...
CHECKED	...
APPROVED	...

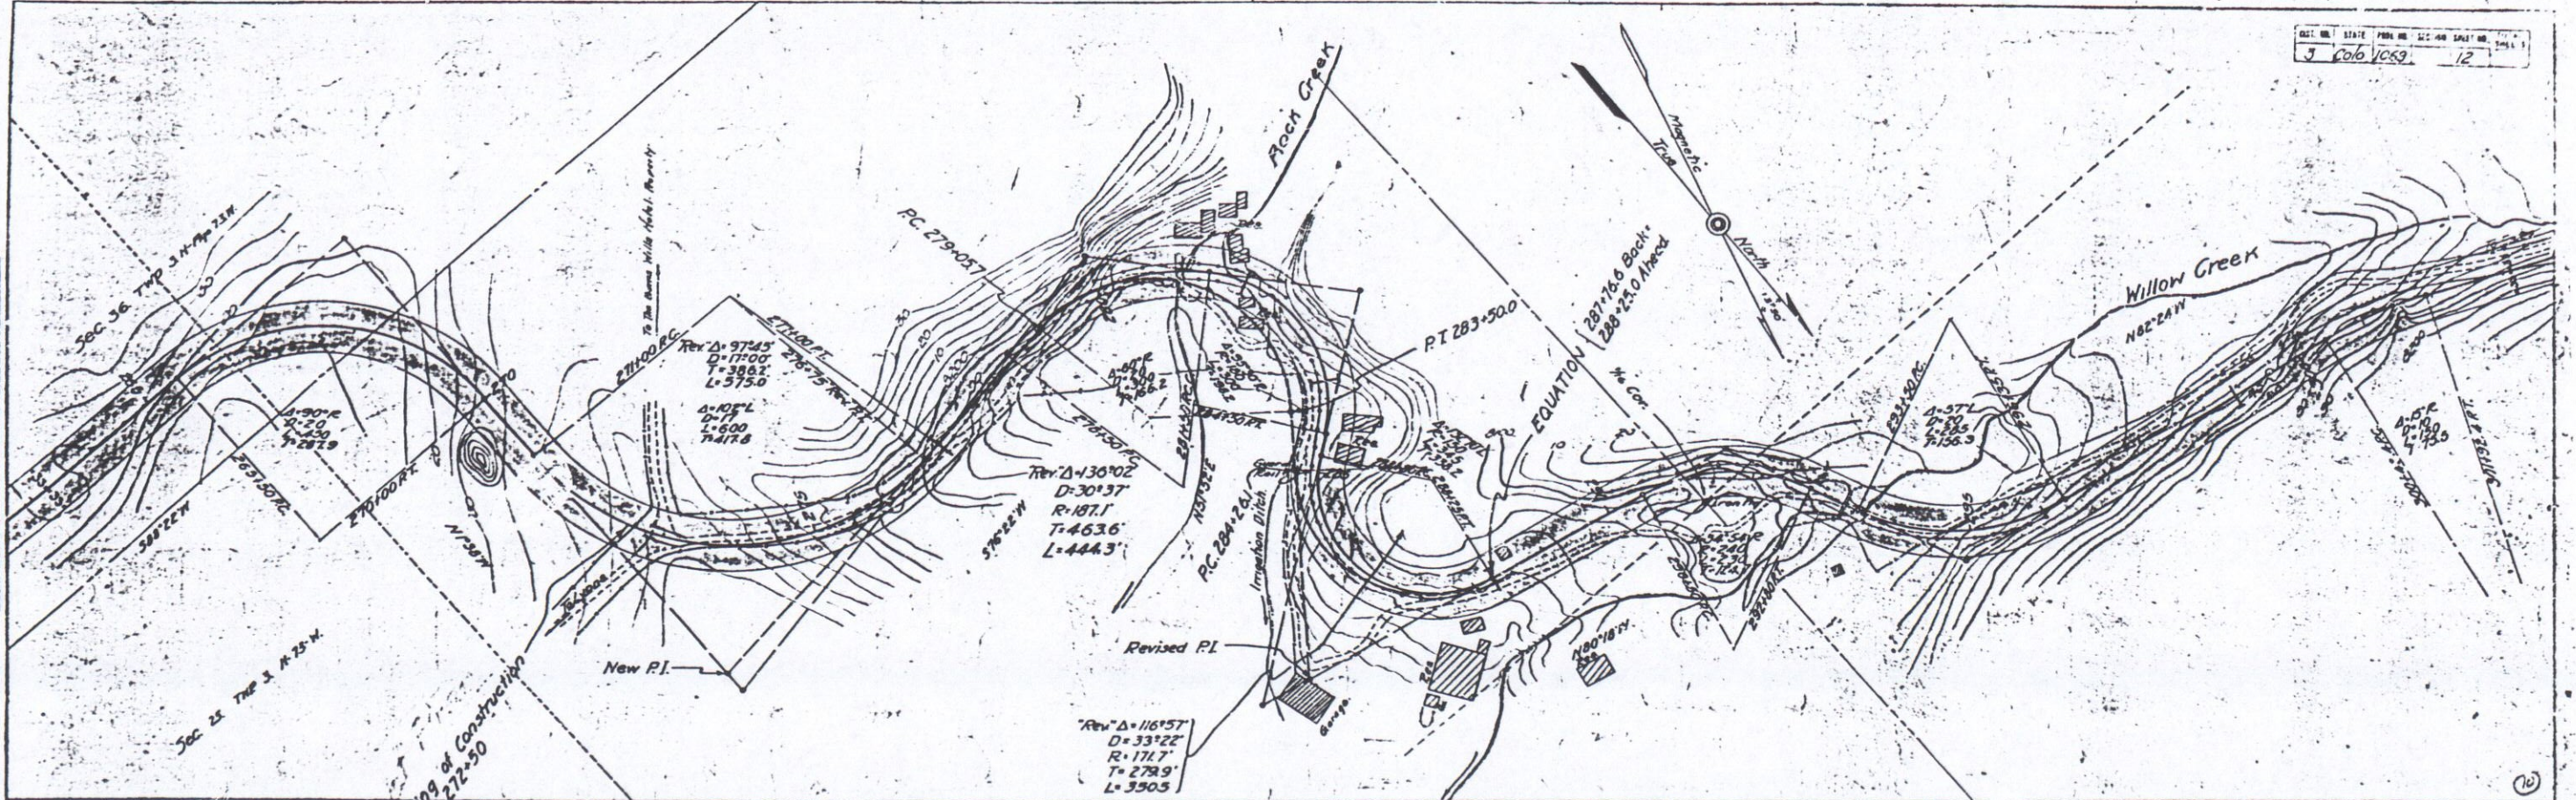

PROFILE

DATE	10/12/59
BY	J. H. ...
CHECKED	...
APPROVED	...

