
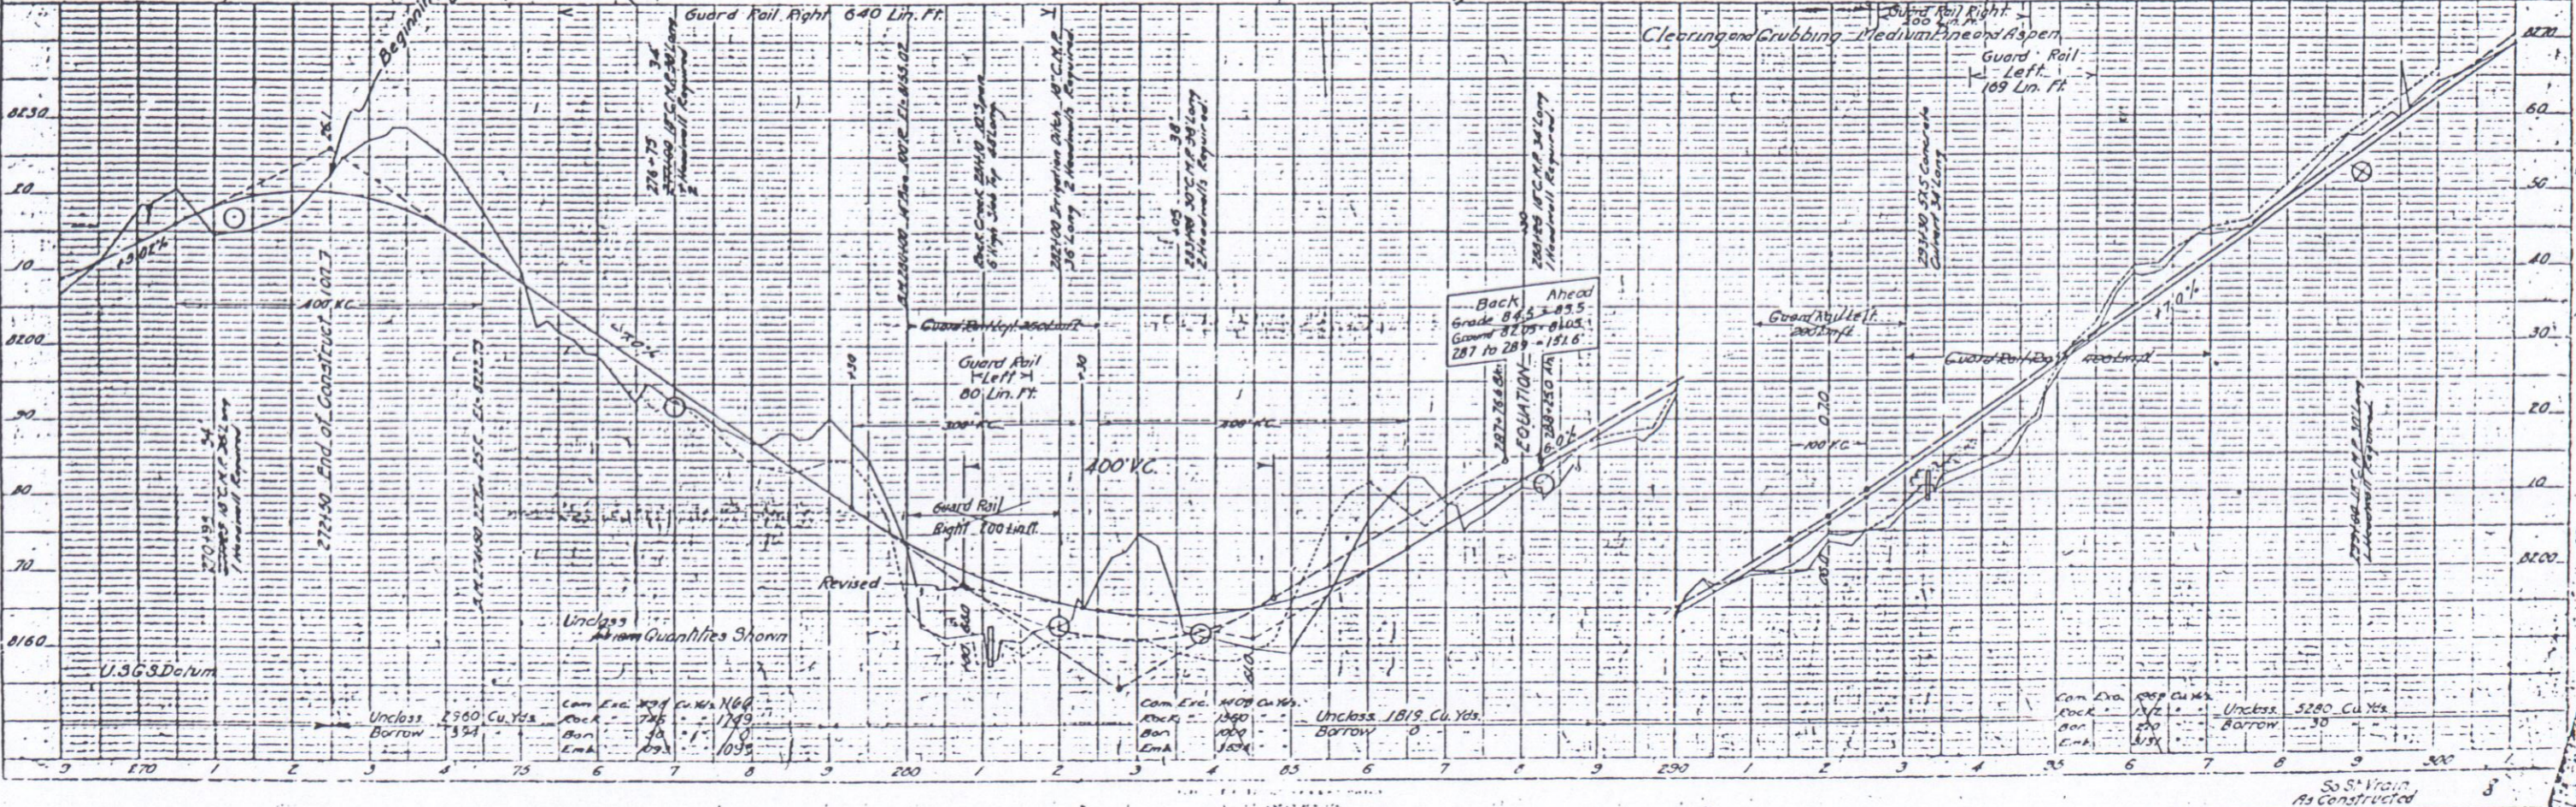


PLAN



DATE	10/13/53
BY	J. H. ...
CHECKED	J. H. ...
SCALE	AS SHOWN

PROFILE


DATE	10/13/53
BY	J. H. ...
CHECKED	J. H. ...
SCALE	AS SHOWN

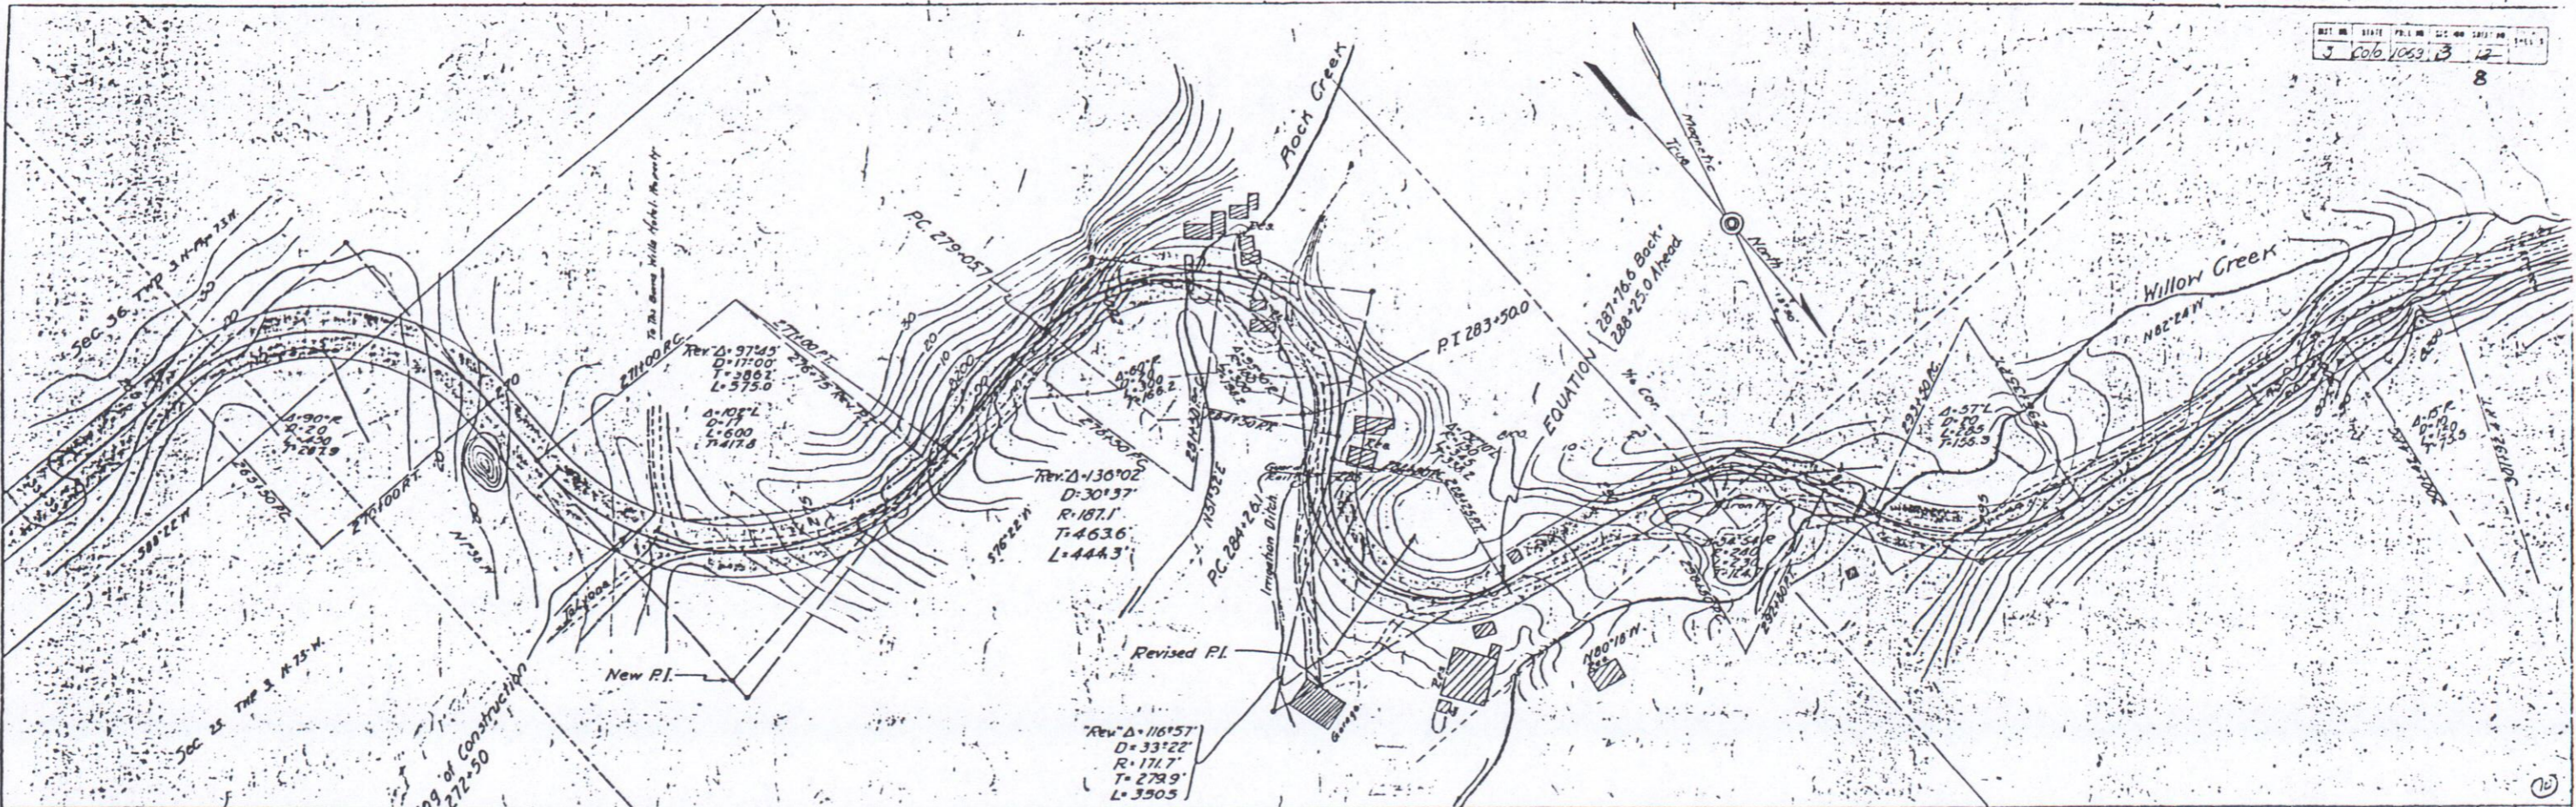

PLAN
 SHEET NO. 1059 B
 DATE: 10/10/1910
 DRAWN BY: [illegible]
 CHECKED BY: [illegible]

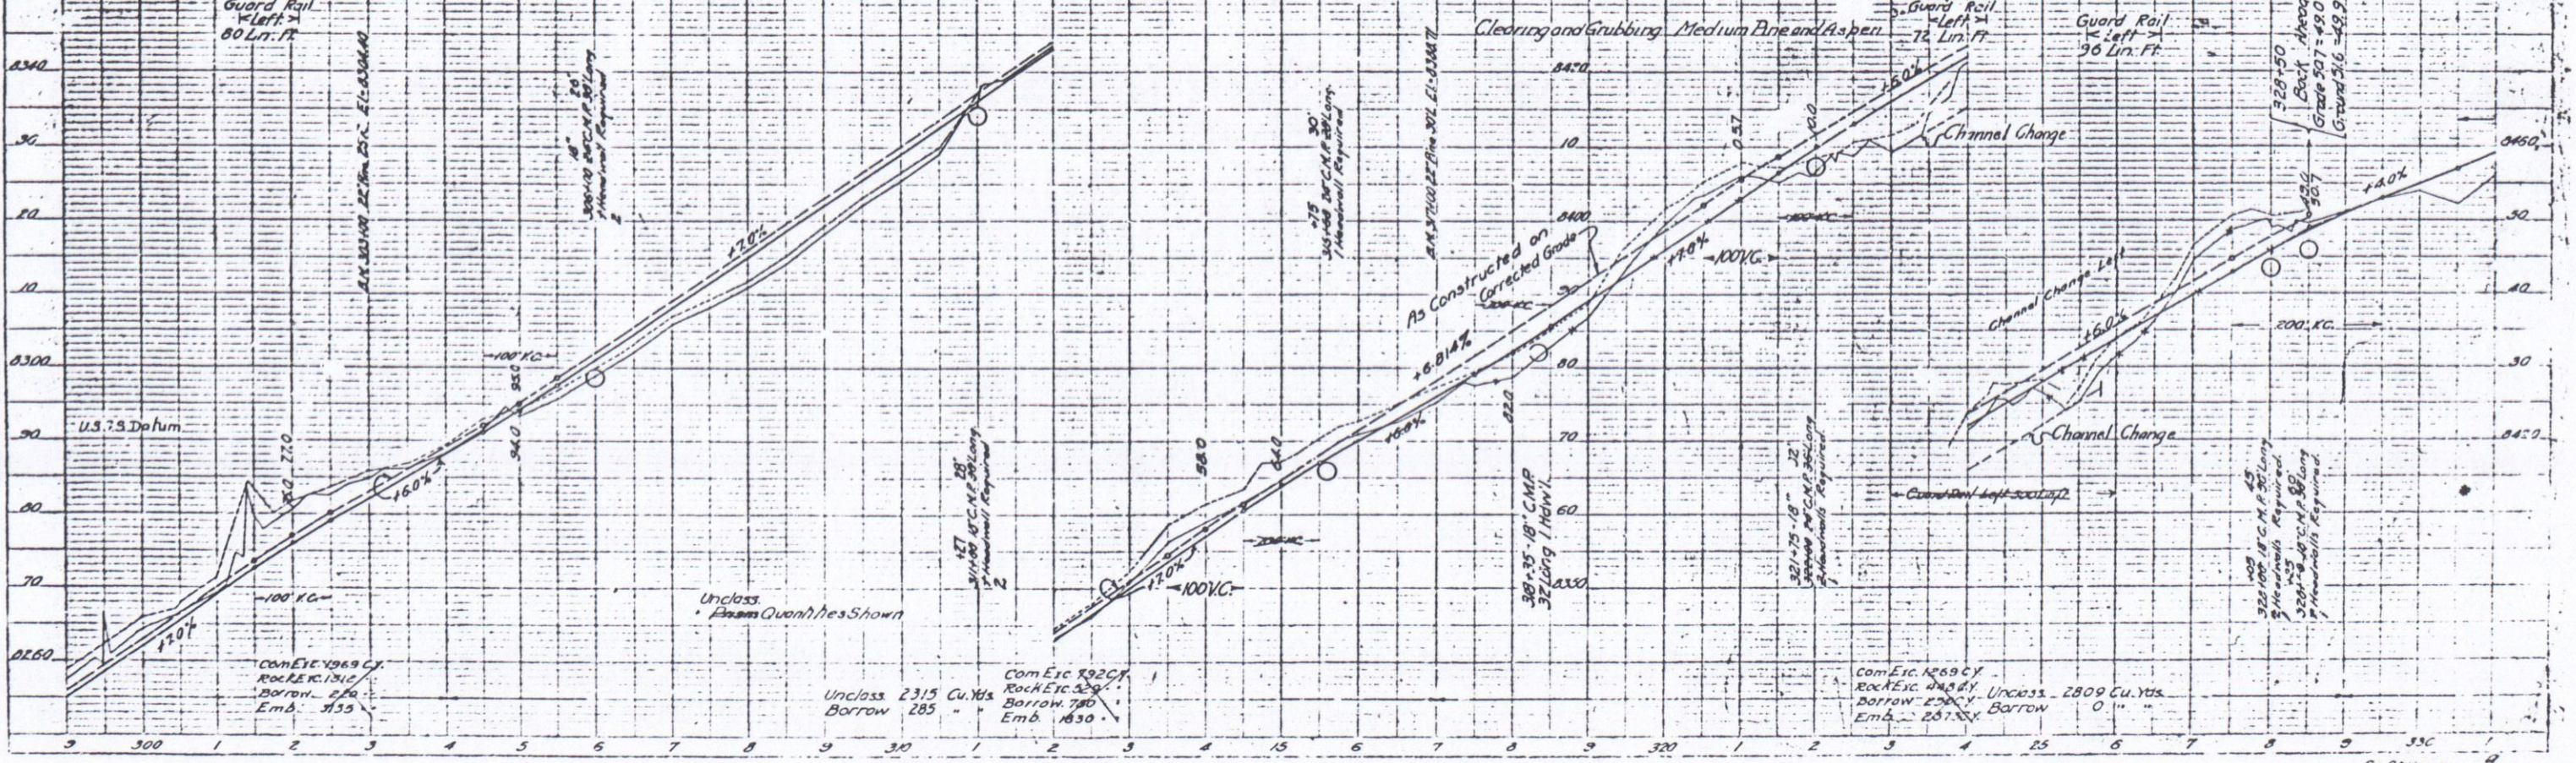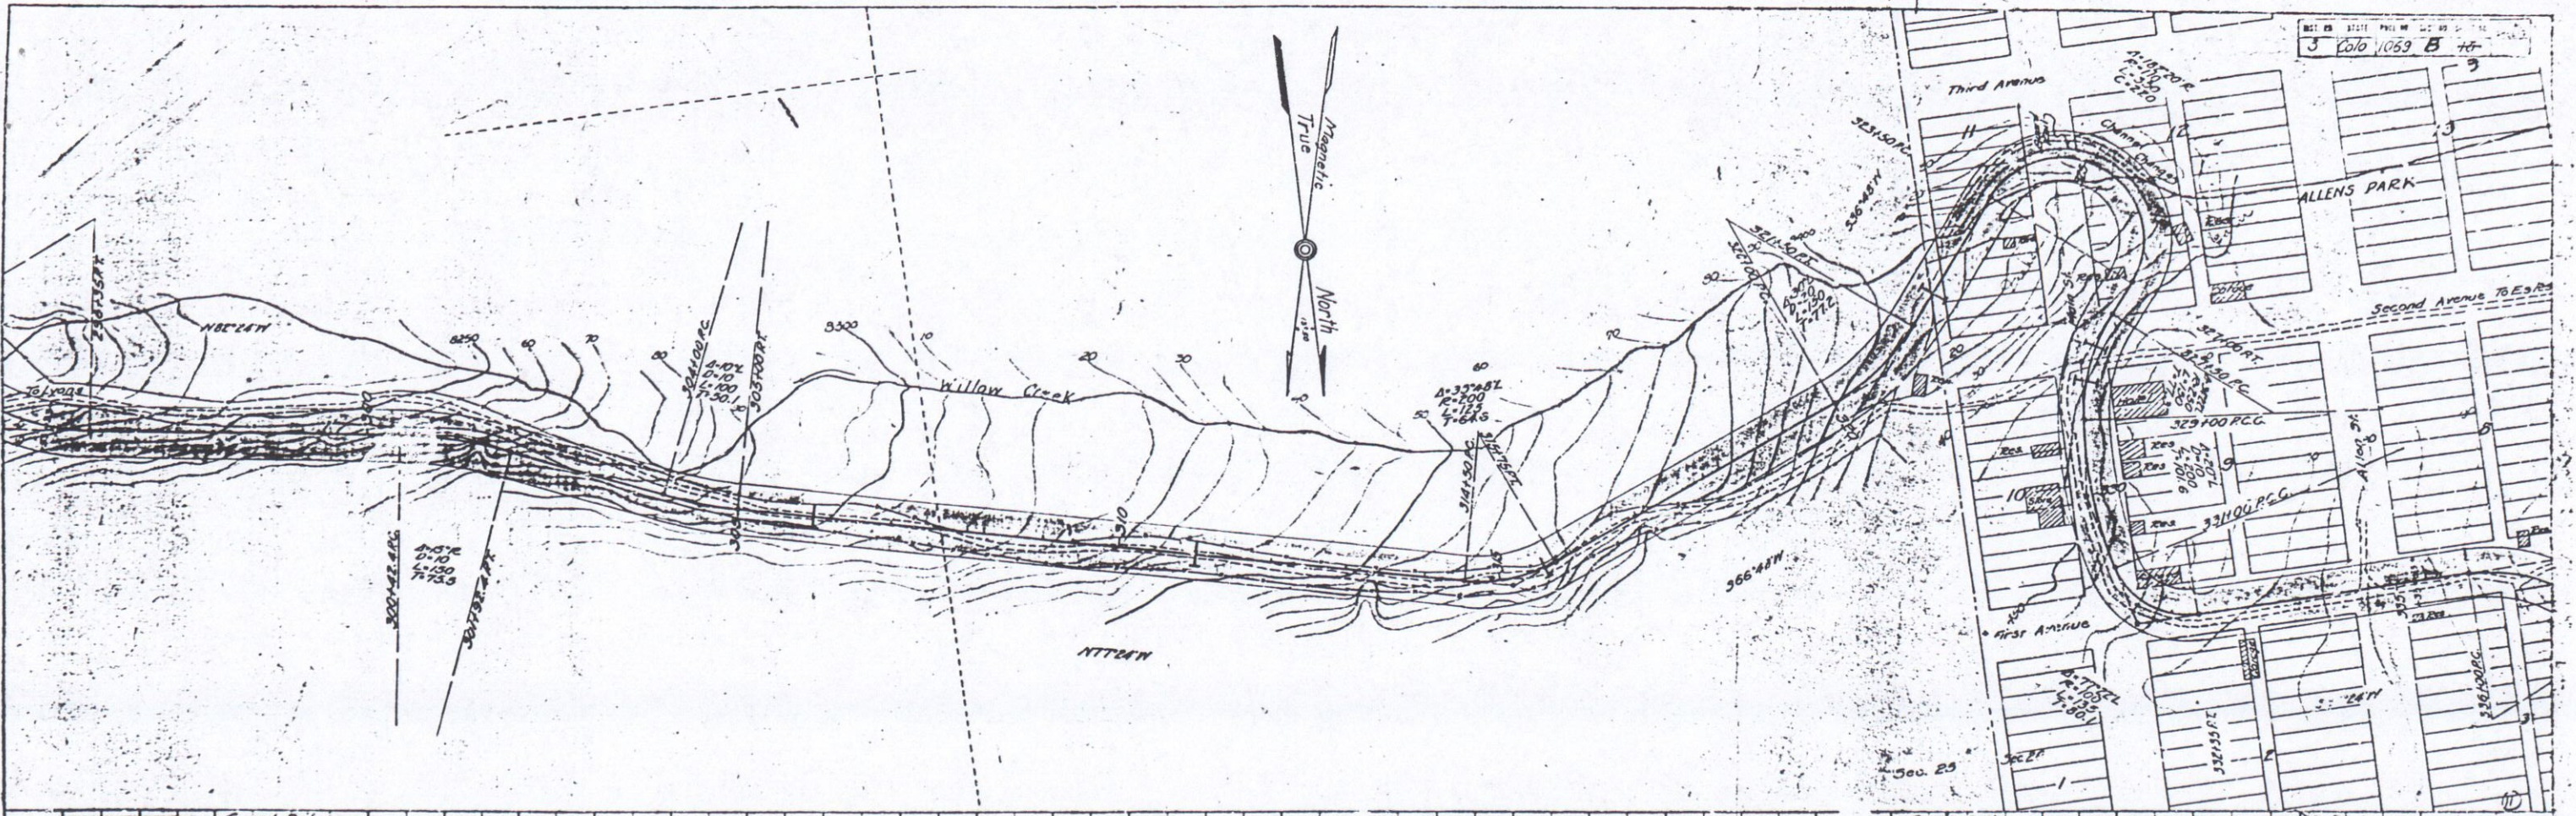

3 Colo 1059 B

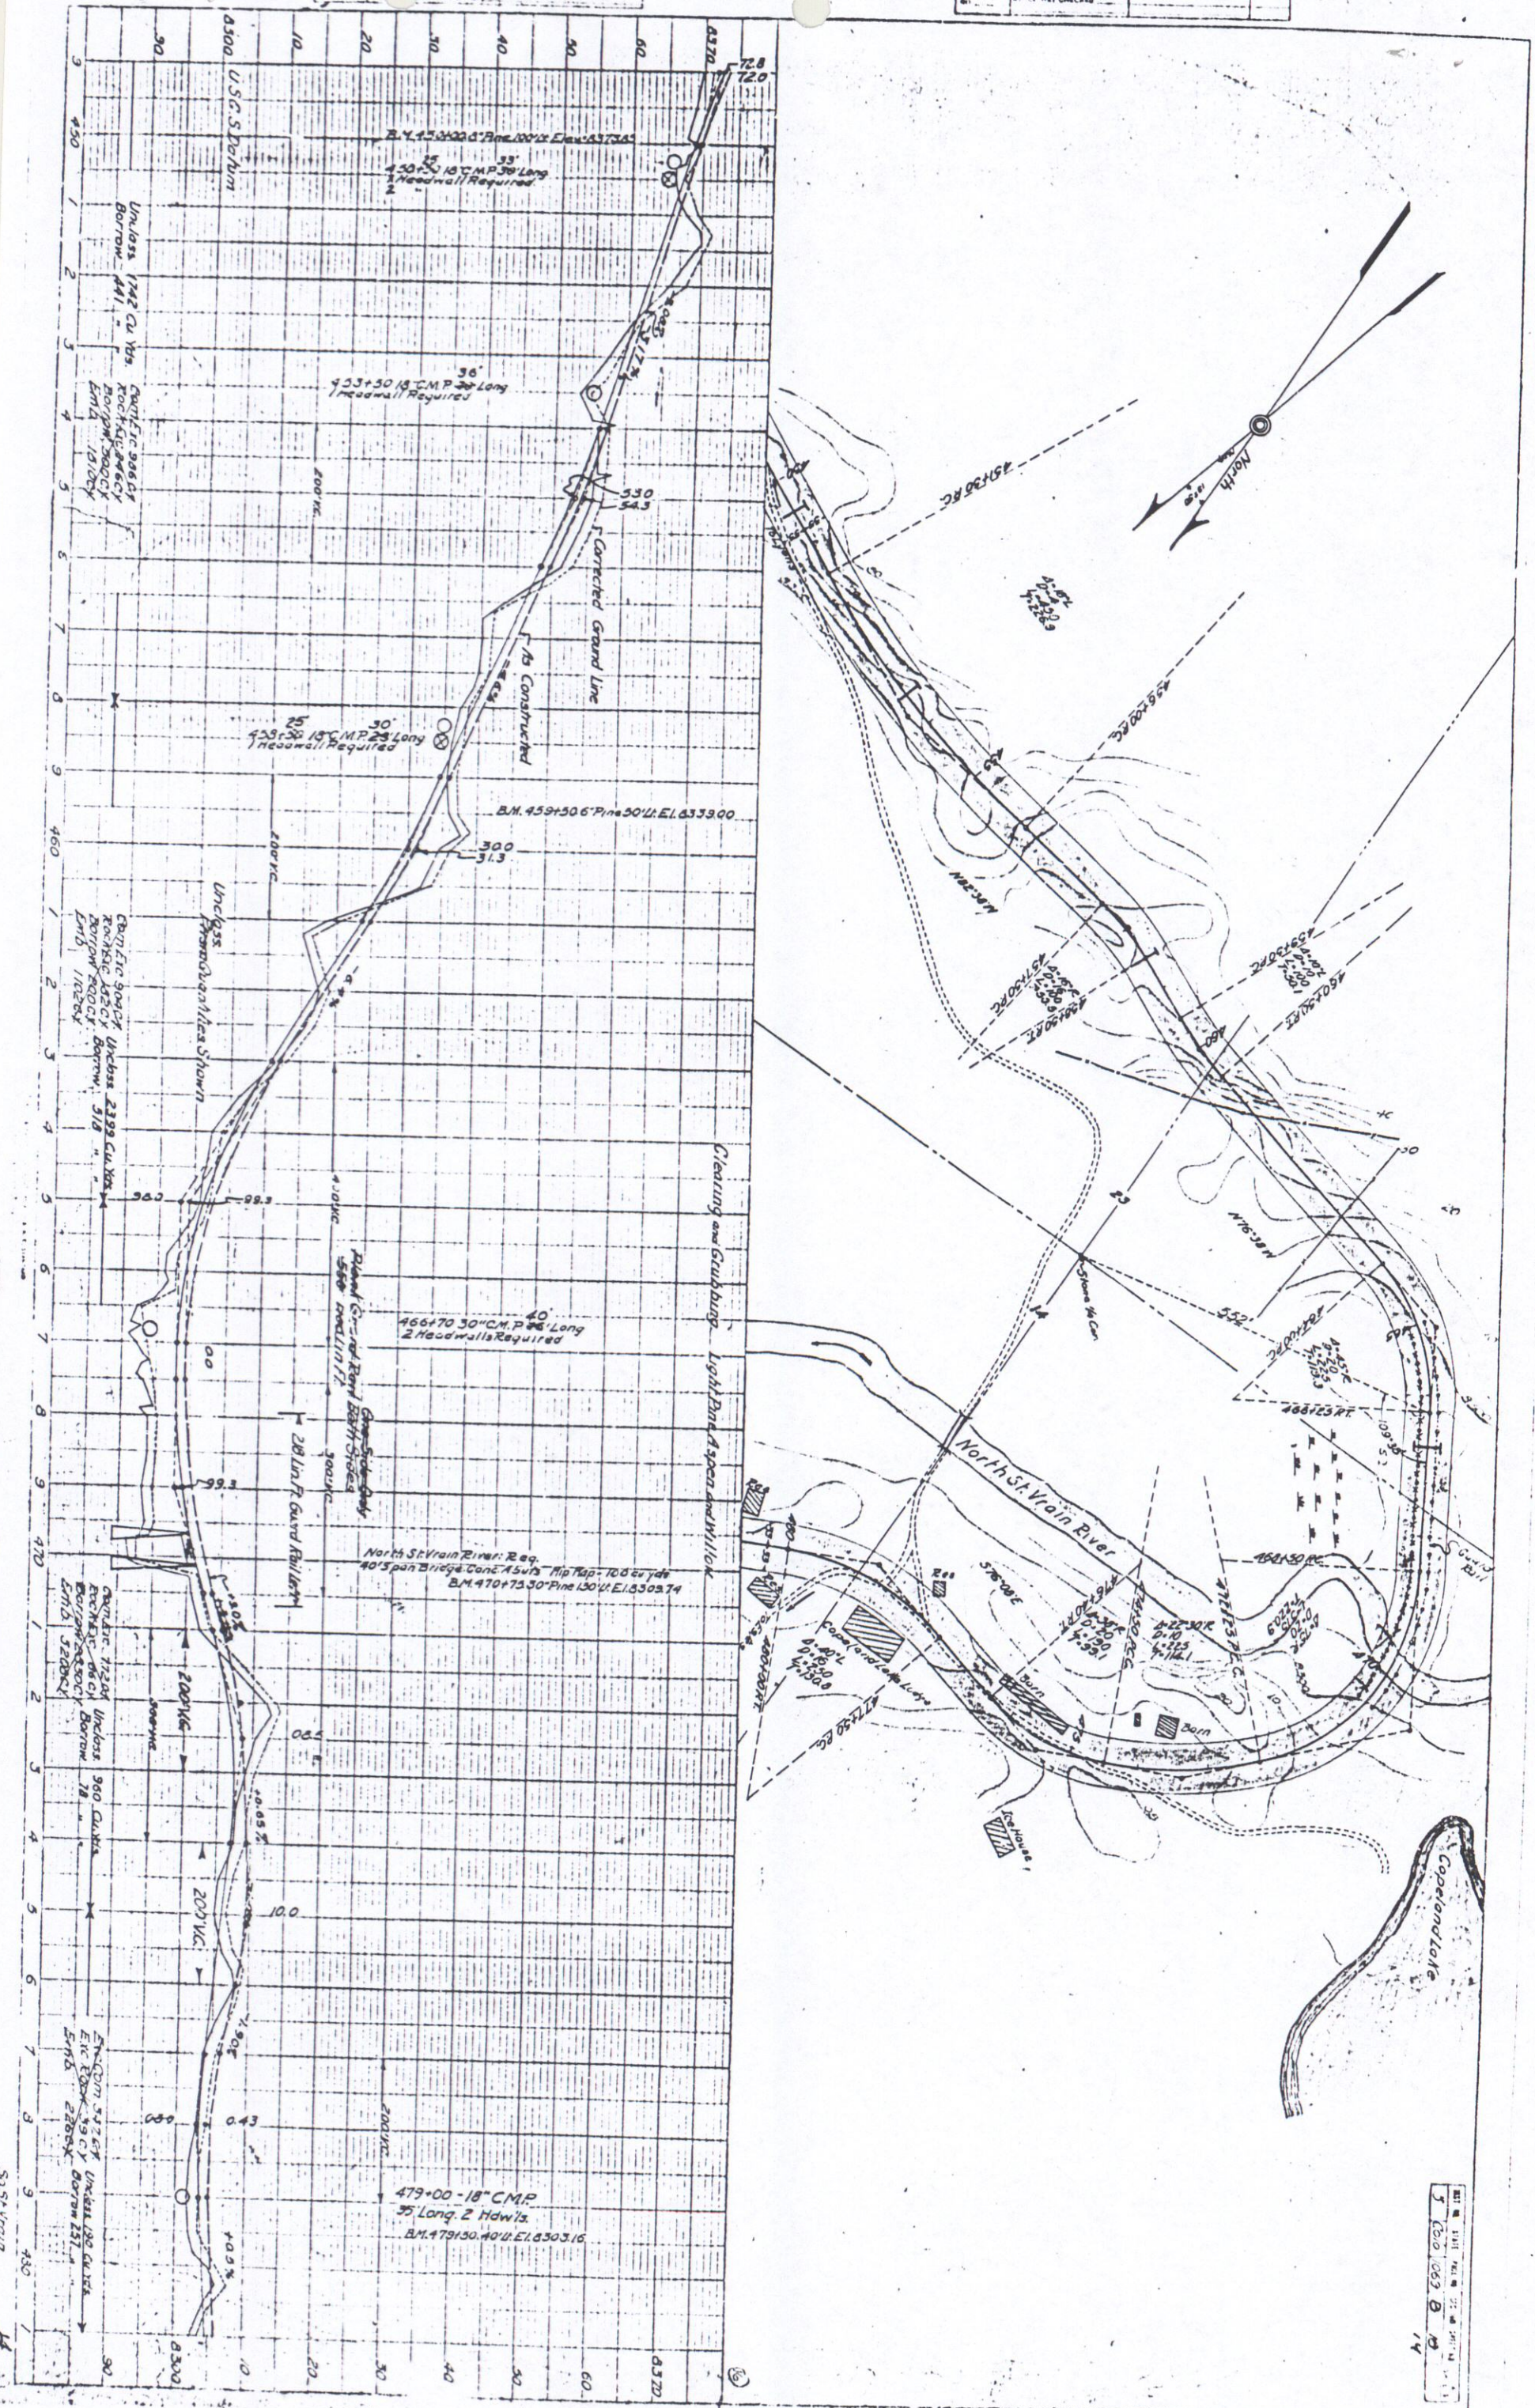

Unless 1742 Cu Yds. Borrows 441 -
 Concrete 908.57
 Rock 45.86 CY
 Borings 200 CY
 Emb. 13.0 CY

Unless 904.97 Cu Yds. Borrows 2399 Cu Yds -
 Concrete 453.07
 Rock 200 CY
 Emb. 11.28 CY

Unless 712.04 Cu Yds. Borrows 960 Cu Yds -
 Concrete 78.00
 Rock 19.00
 Emb. 2.88 CY

Unless 342.67 Cu Yds. Borrows 257.17 -
 Concrete 280.00
 Rock 19.00
 Emb. 2.88 CY

SHEET NO. 14
 5 (50) 069 B 14

St. Vrain
 As Constructed