

19-1-1951-1-1952

FEDERAL ROAD DISTRICT NO.	9	DISTRICT	COLORADO	PROJ. NO.		SHEET NO.	1	TOTAL SHEETS	18
---------------------------	---	----------	----------	-----------	--	-----------	---	--------------	----

COLORADO STATE HIGHWAY DEPARTMENT


PLAN AND PROFILE AS CONSTRUCTED
STATE PROJECT NO. 39-166-501
STATE HIGHWAY NO. 166
SEDGWICK COUNTY

INDEX OF SHEETS

- SHEET NO. 1 SKETCH MAP AND TITLE PAGE
2 TYPICAL CROSS SECTION & DESIGN DATA
3 PLAN OF THE PROJECT
4-9 STRAIGHT TIE
10-16 ALIGNMENT PLAN & PROFILE
17-18 FINAL CROSS SECTIONS

CONVENTIONAL SIGNS
CENTER LINE
RIGHT OF WAY LINE
COUNTY LINE
TOWNSHIP OR RANGE LINE
LAND LINES
RAILROAD
BARBED WIRE FENCE
COMBINATION WIRE FENCE
SNOW FENCE
TELEPHONE & TELEGRAPH LINES
POWER LINE
DETOUR
PRESENT ROAD (Pon Sheets)

SCALES OF ORIGINAL DRAWINGS
ON PLAN. 1 IN. = 100 FT.
ON PROFILE 1 IN. = 100 FT. HORIZONTAL
1 IN. = 10 FT. VERTICAL
GRADE LINE ON PROFILE IS SHOWN AS GRADE OF FINISHED ROAD
GROSS LENGTH OF PROJECT } 20.98 1/2 FT. = 3.974 MILES
NET LENGTH OF PROJECT }

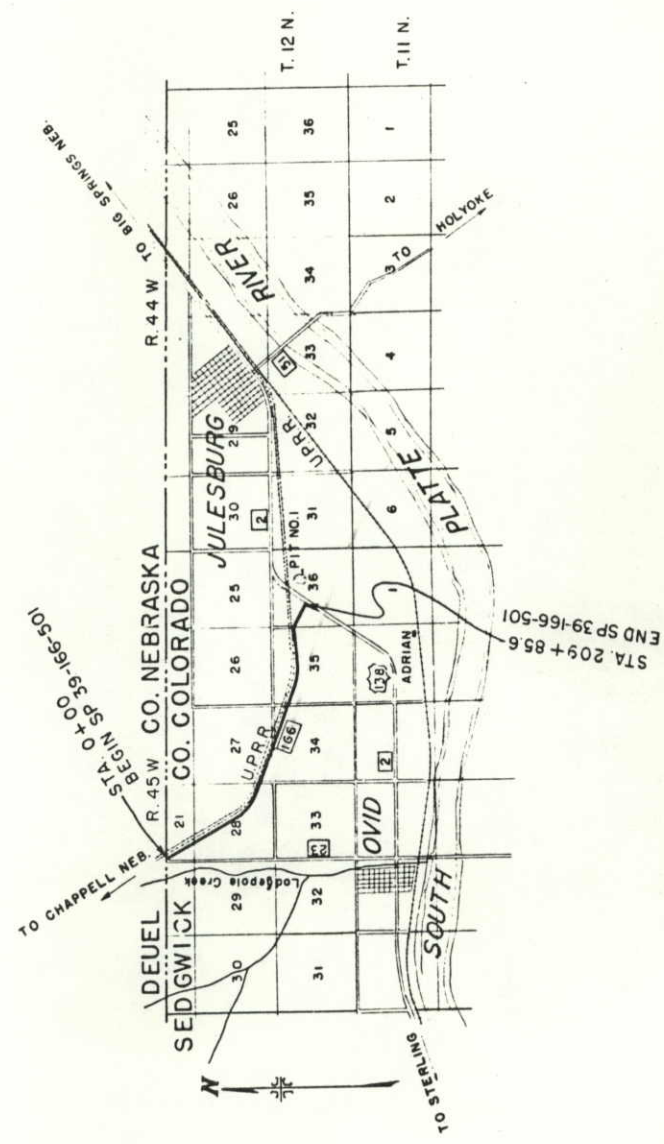


NOTICE TO BIDDERS
IT IS RECOMMENDED THAT BIDDERS ON THIS PROJECT GO TO THE PLAN DETAILS WITH ONE OF THE FOLLOWING FIELD REPRESENTATIVES OF THIS DEPARTMENT:

HIGHWAY DEPARTMENT STATE OF COLORADO	RECOMMENDED FOR APPROVAL:	DATE
ASSISTANT ENGINEER	APPROVED:	DATE
STATE HIGHWAY ENGINEER	APPROVED:	DATE

DEPARTMENT OF COMMERCE BUREAU OF PUBLIC ROADS	RECOMMENDED FOR APPROVAL:	DATE
DISTRICT ENGINEER	APPROVED:	DATE
DIVISION ENGINEER	APPROVED:	DATE

PED. ROAD DIST. NO.	STATE	PROJ. NO.	SHEET NO.	TOTAL SHEETS
3	COLO.		10	15

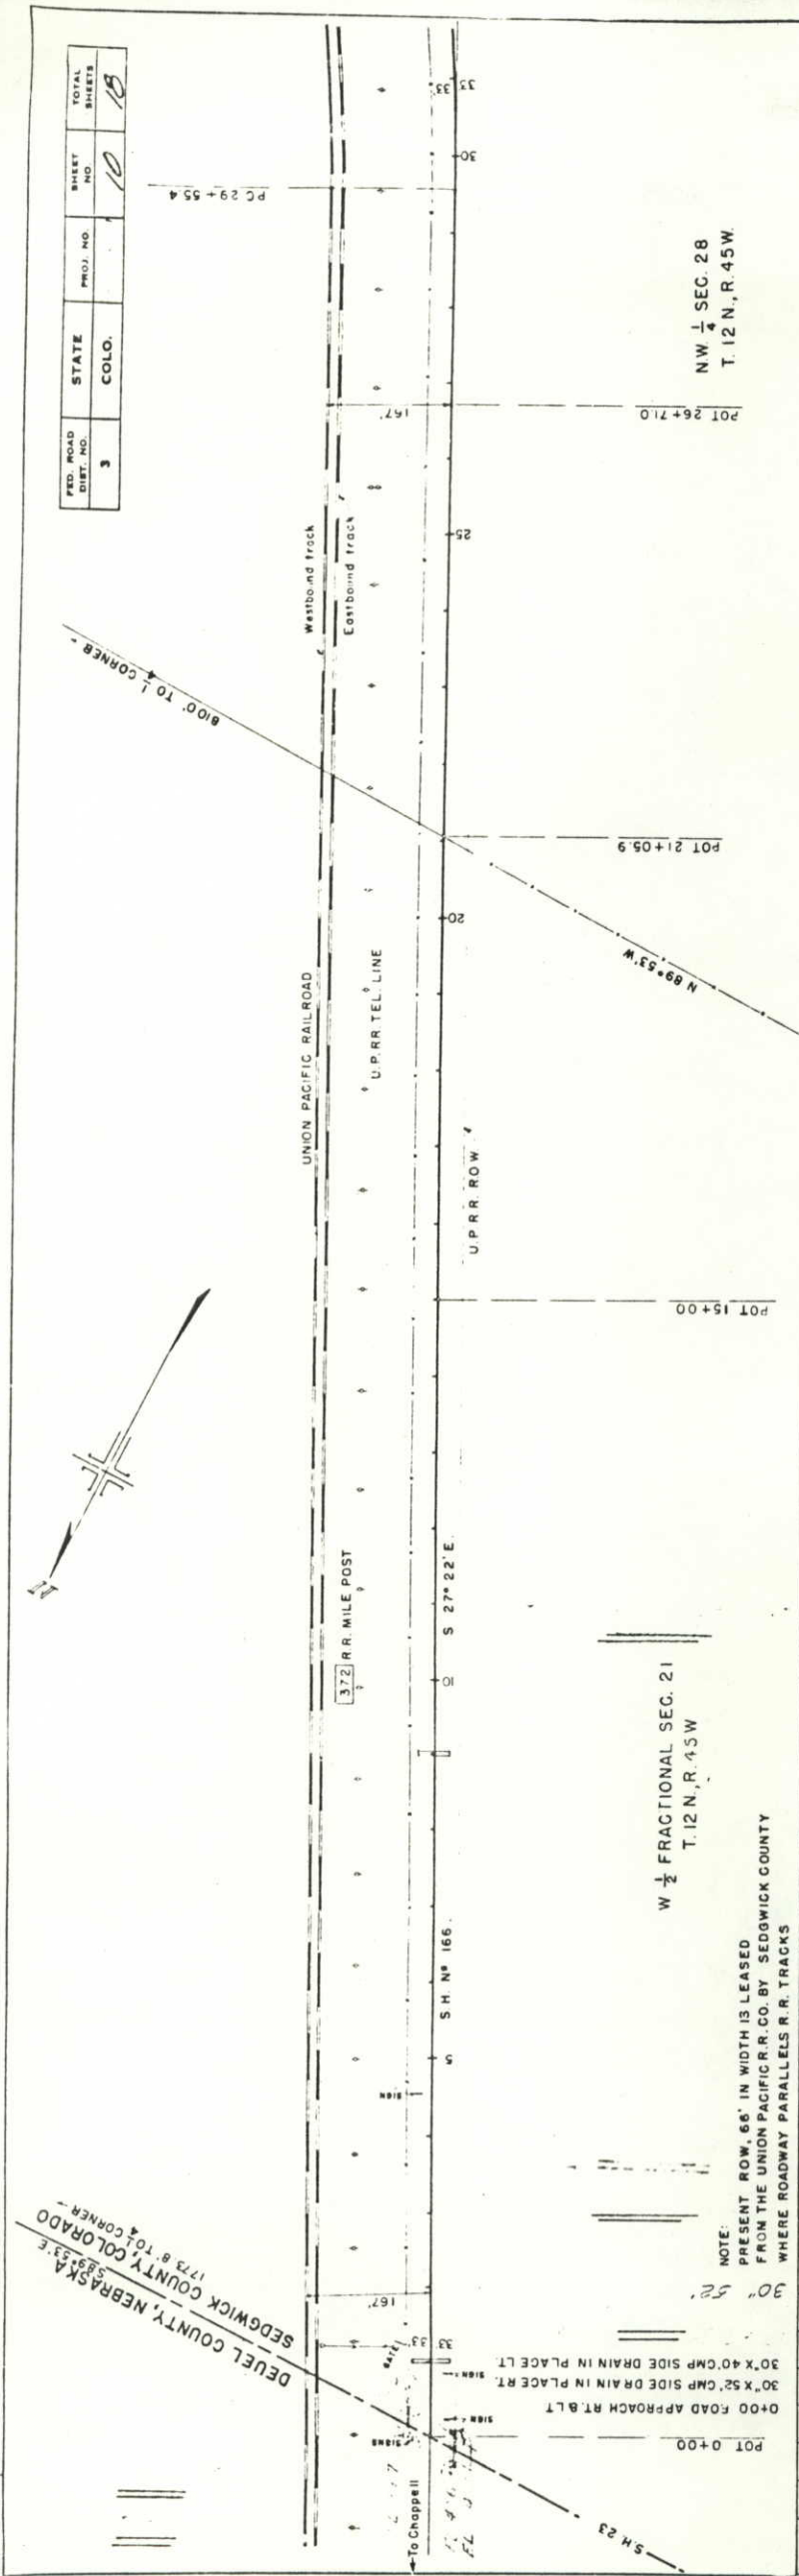

W 1/2 FRACTIONAL SEC. 21
T. 12 N., R. 45 W

NOTE:
PRESENT ROW, 66' IN WIDTH IS LEASED
FROM THE UNION PACIFIC R.R. CO. BY SEDGWICK COUNTY
WHERE ROADWAY PARALLELS R.R. TRACKS

DEUEL COUNTY, NEBRASKA
1773 B. TO 1st CORNER -
SEDGWICK COUNTY, COLORADO
5839.53 E.

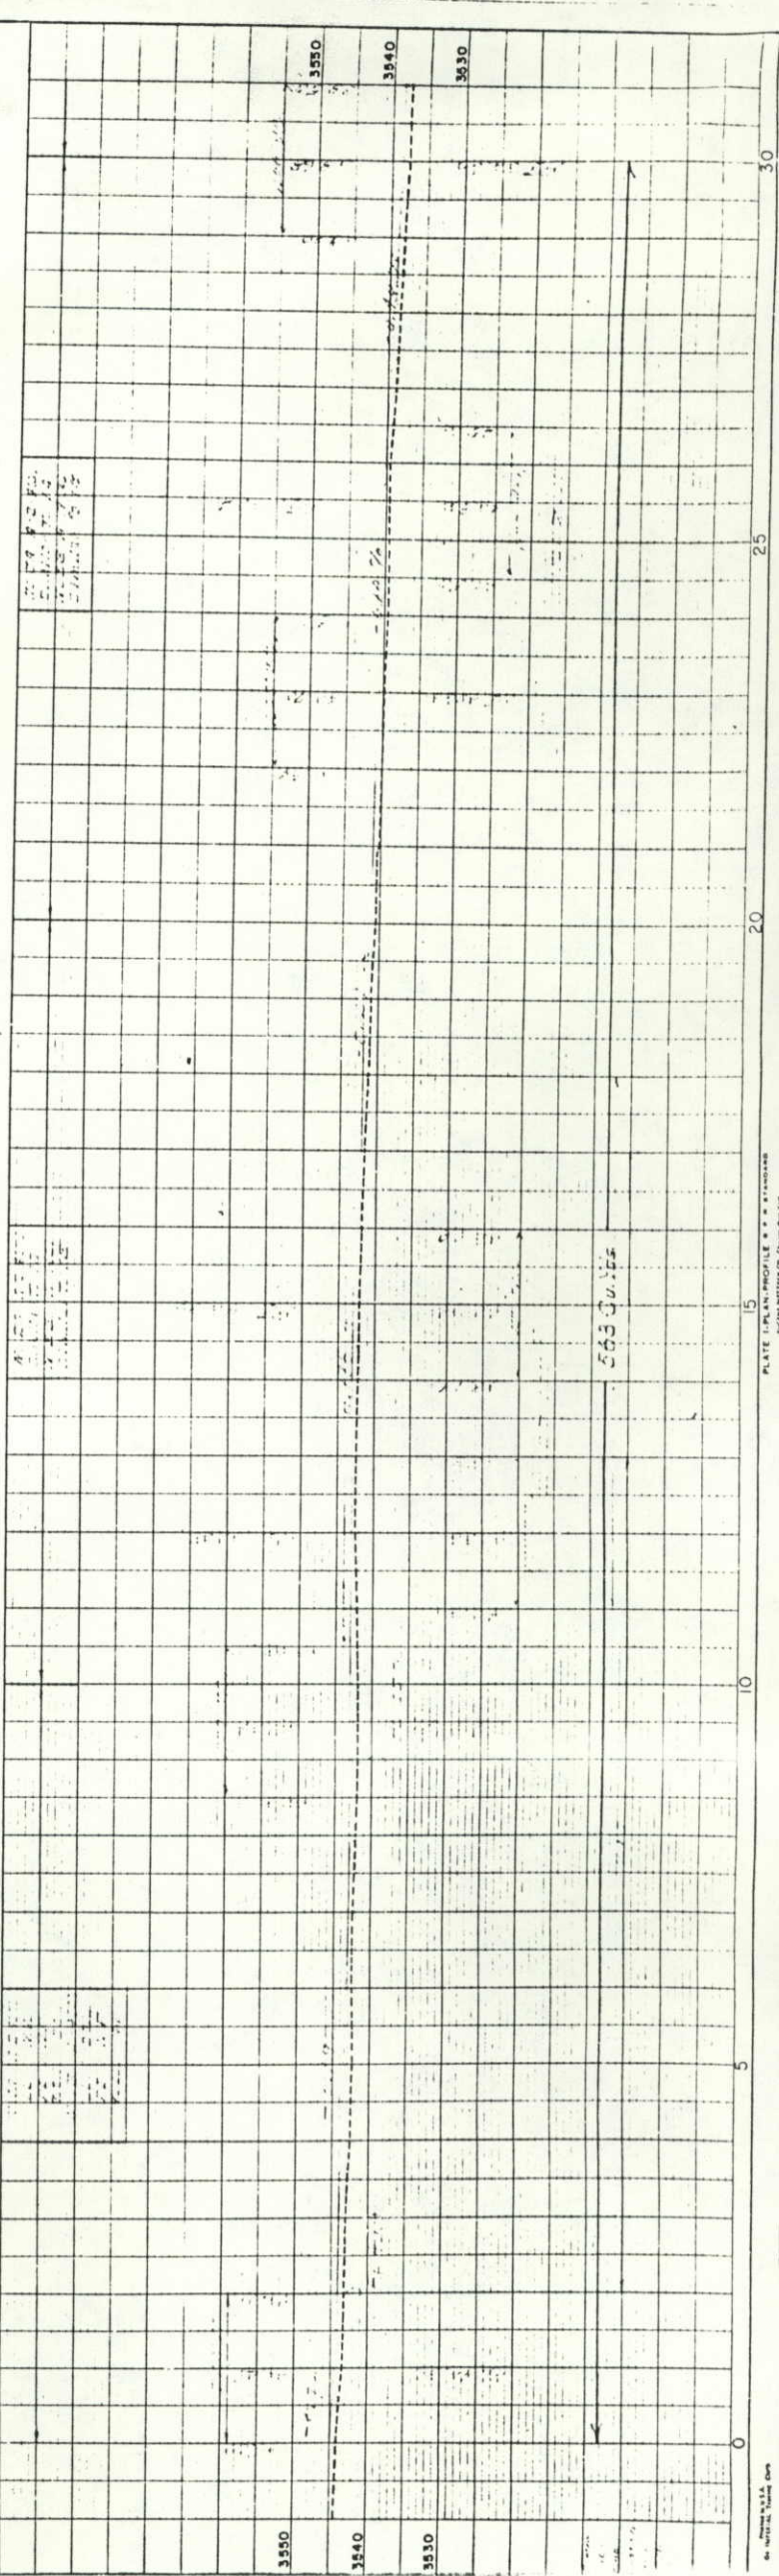


PLATE UPRR PROFILE * * * * *

BY SURVEYOR

FED. ROAD DIST. NO.	STATE	PROJ. NO.	SHEET NO.	TOTAL SHEETS
3	COLO.		11	18

Δ 28°39' LT.
 D 97168'
 T 1505.9'
 L 2948.5'
 R 5897'


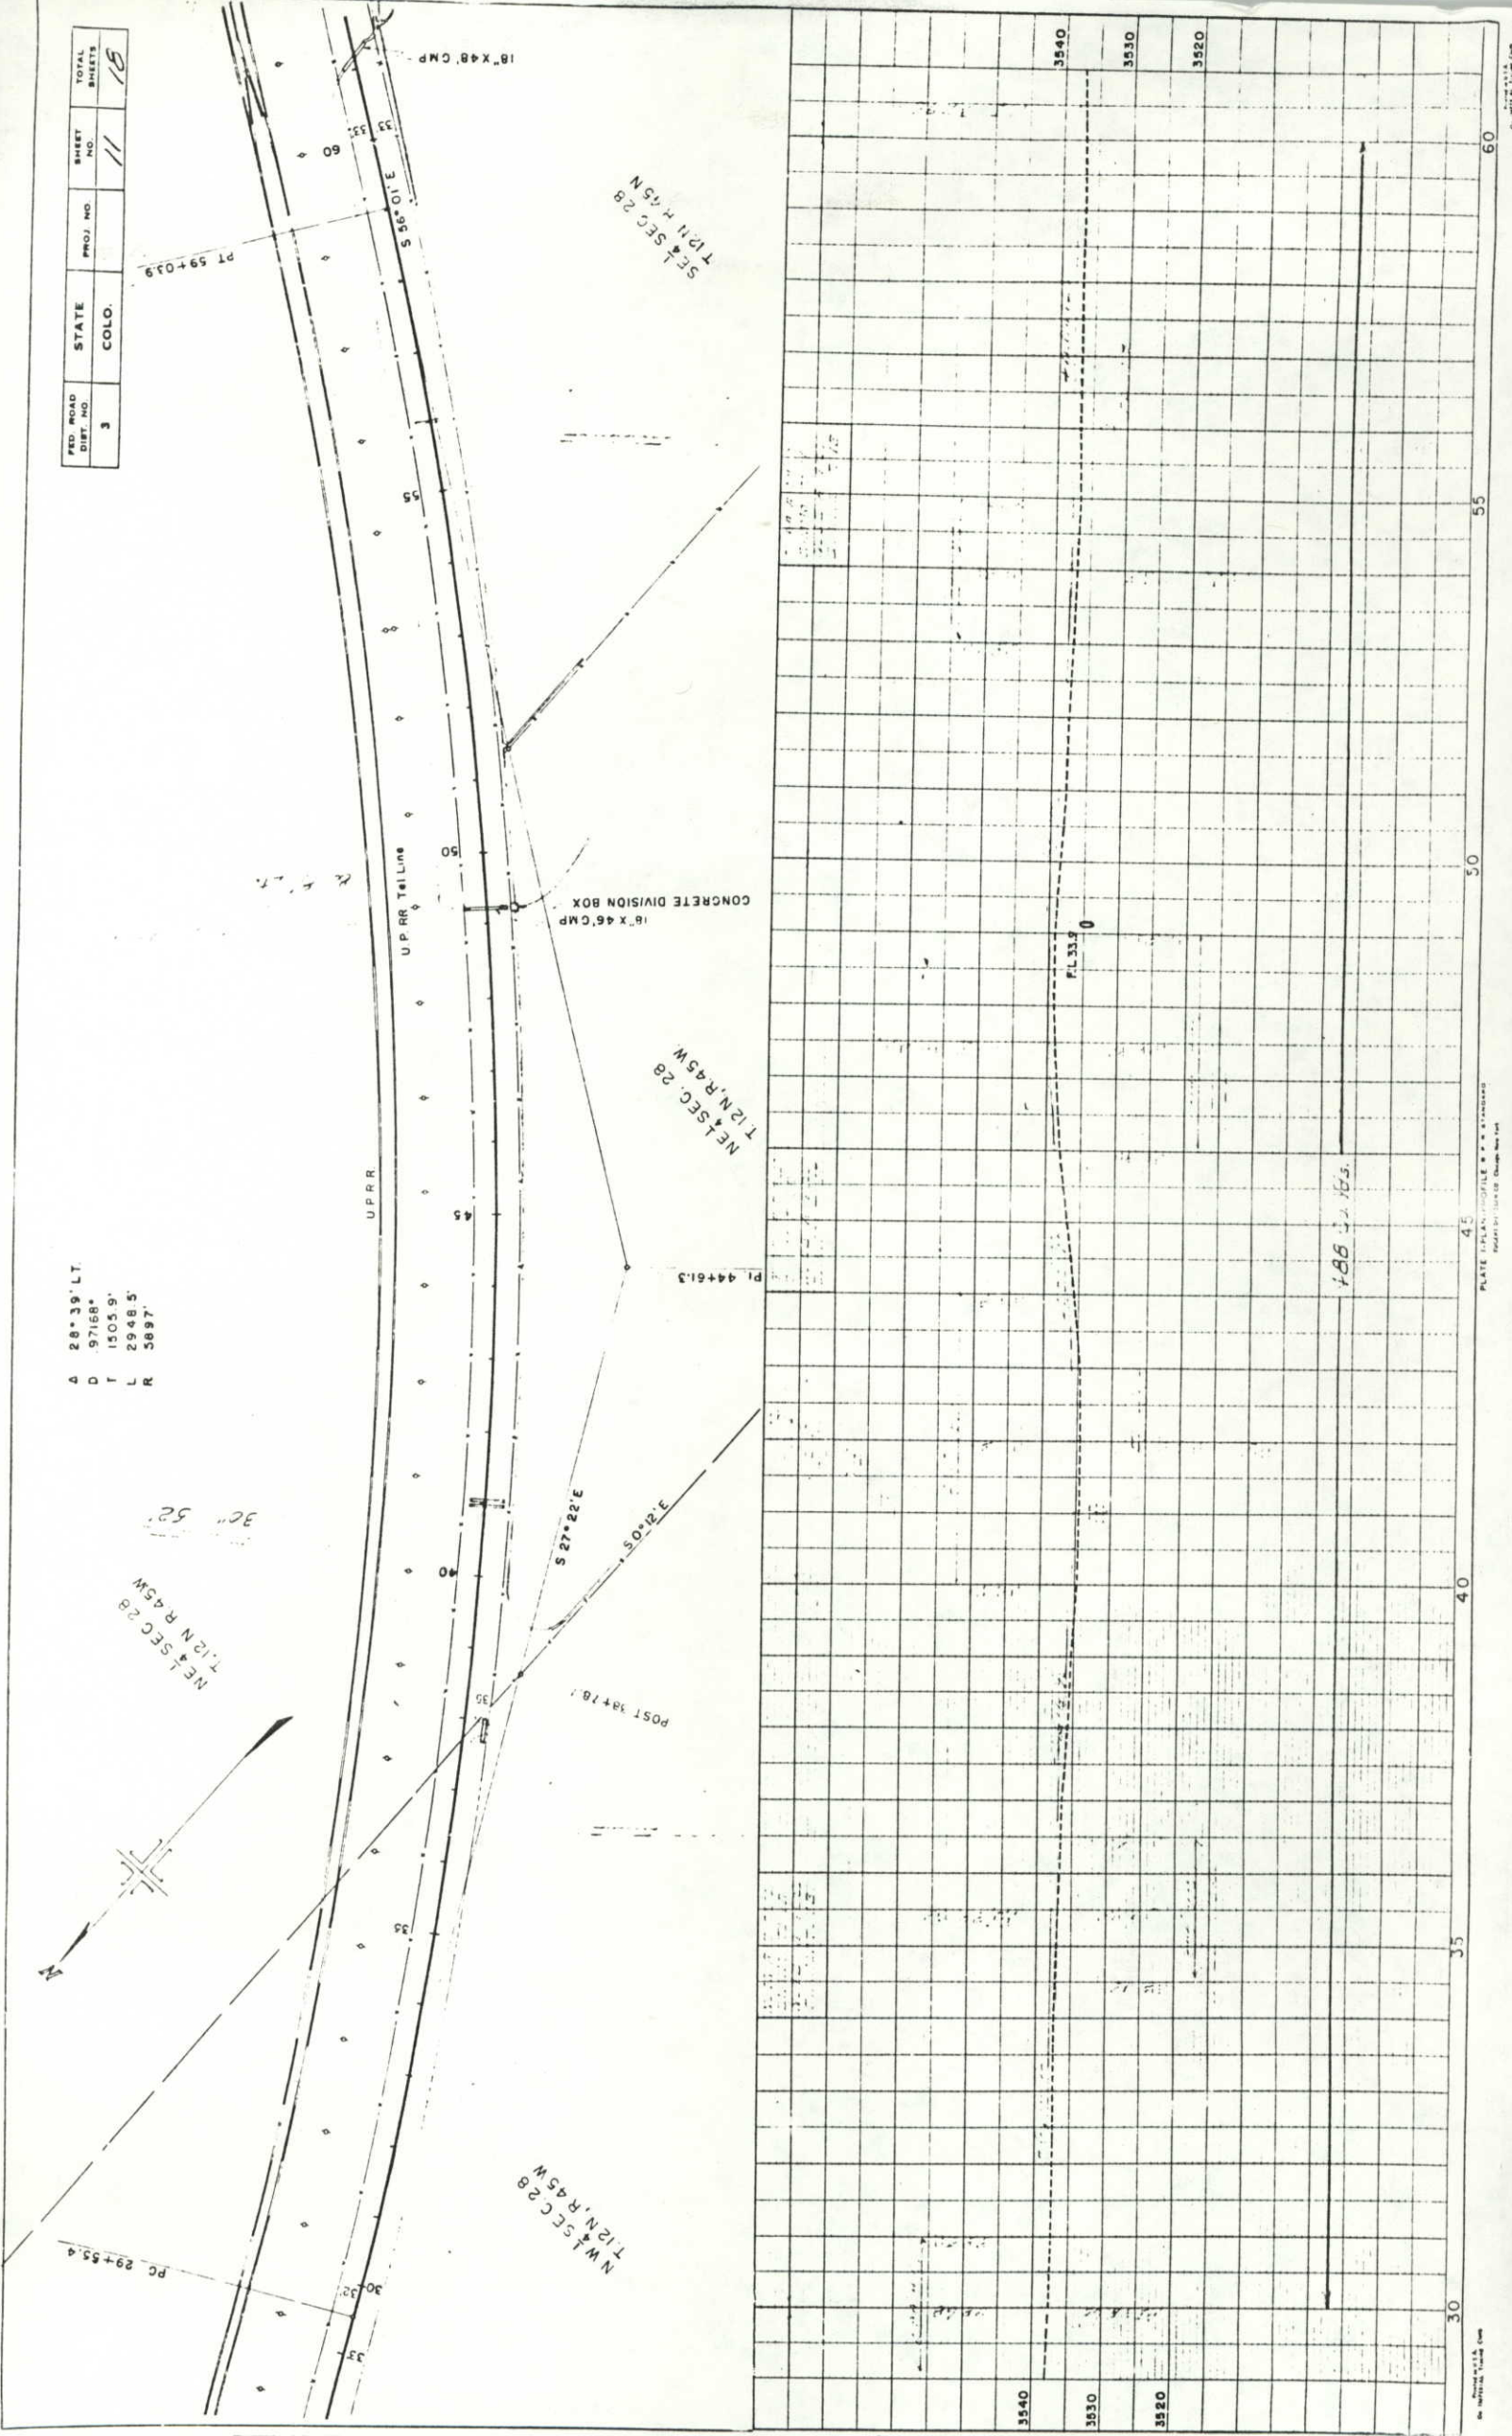


PLATE 1 PLAN PROFILE & ELEVATIONS
 ROAD DIST. NO. 3 COLO. PROJ. NO. 11 SHEET NO. 11 TOTAL SHEETS 18


3540
 3530
 3520

30 35 40 45 50 55 60

FED. ROAD DIST. NO.	STATE	PROJ. NO.	SHEET NO.	TOTAL SHEETS
3	COLO.		13	18

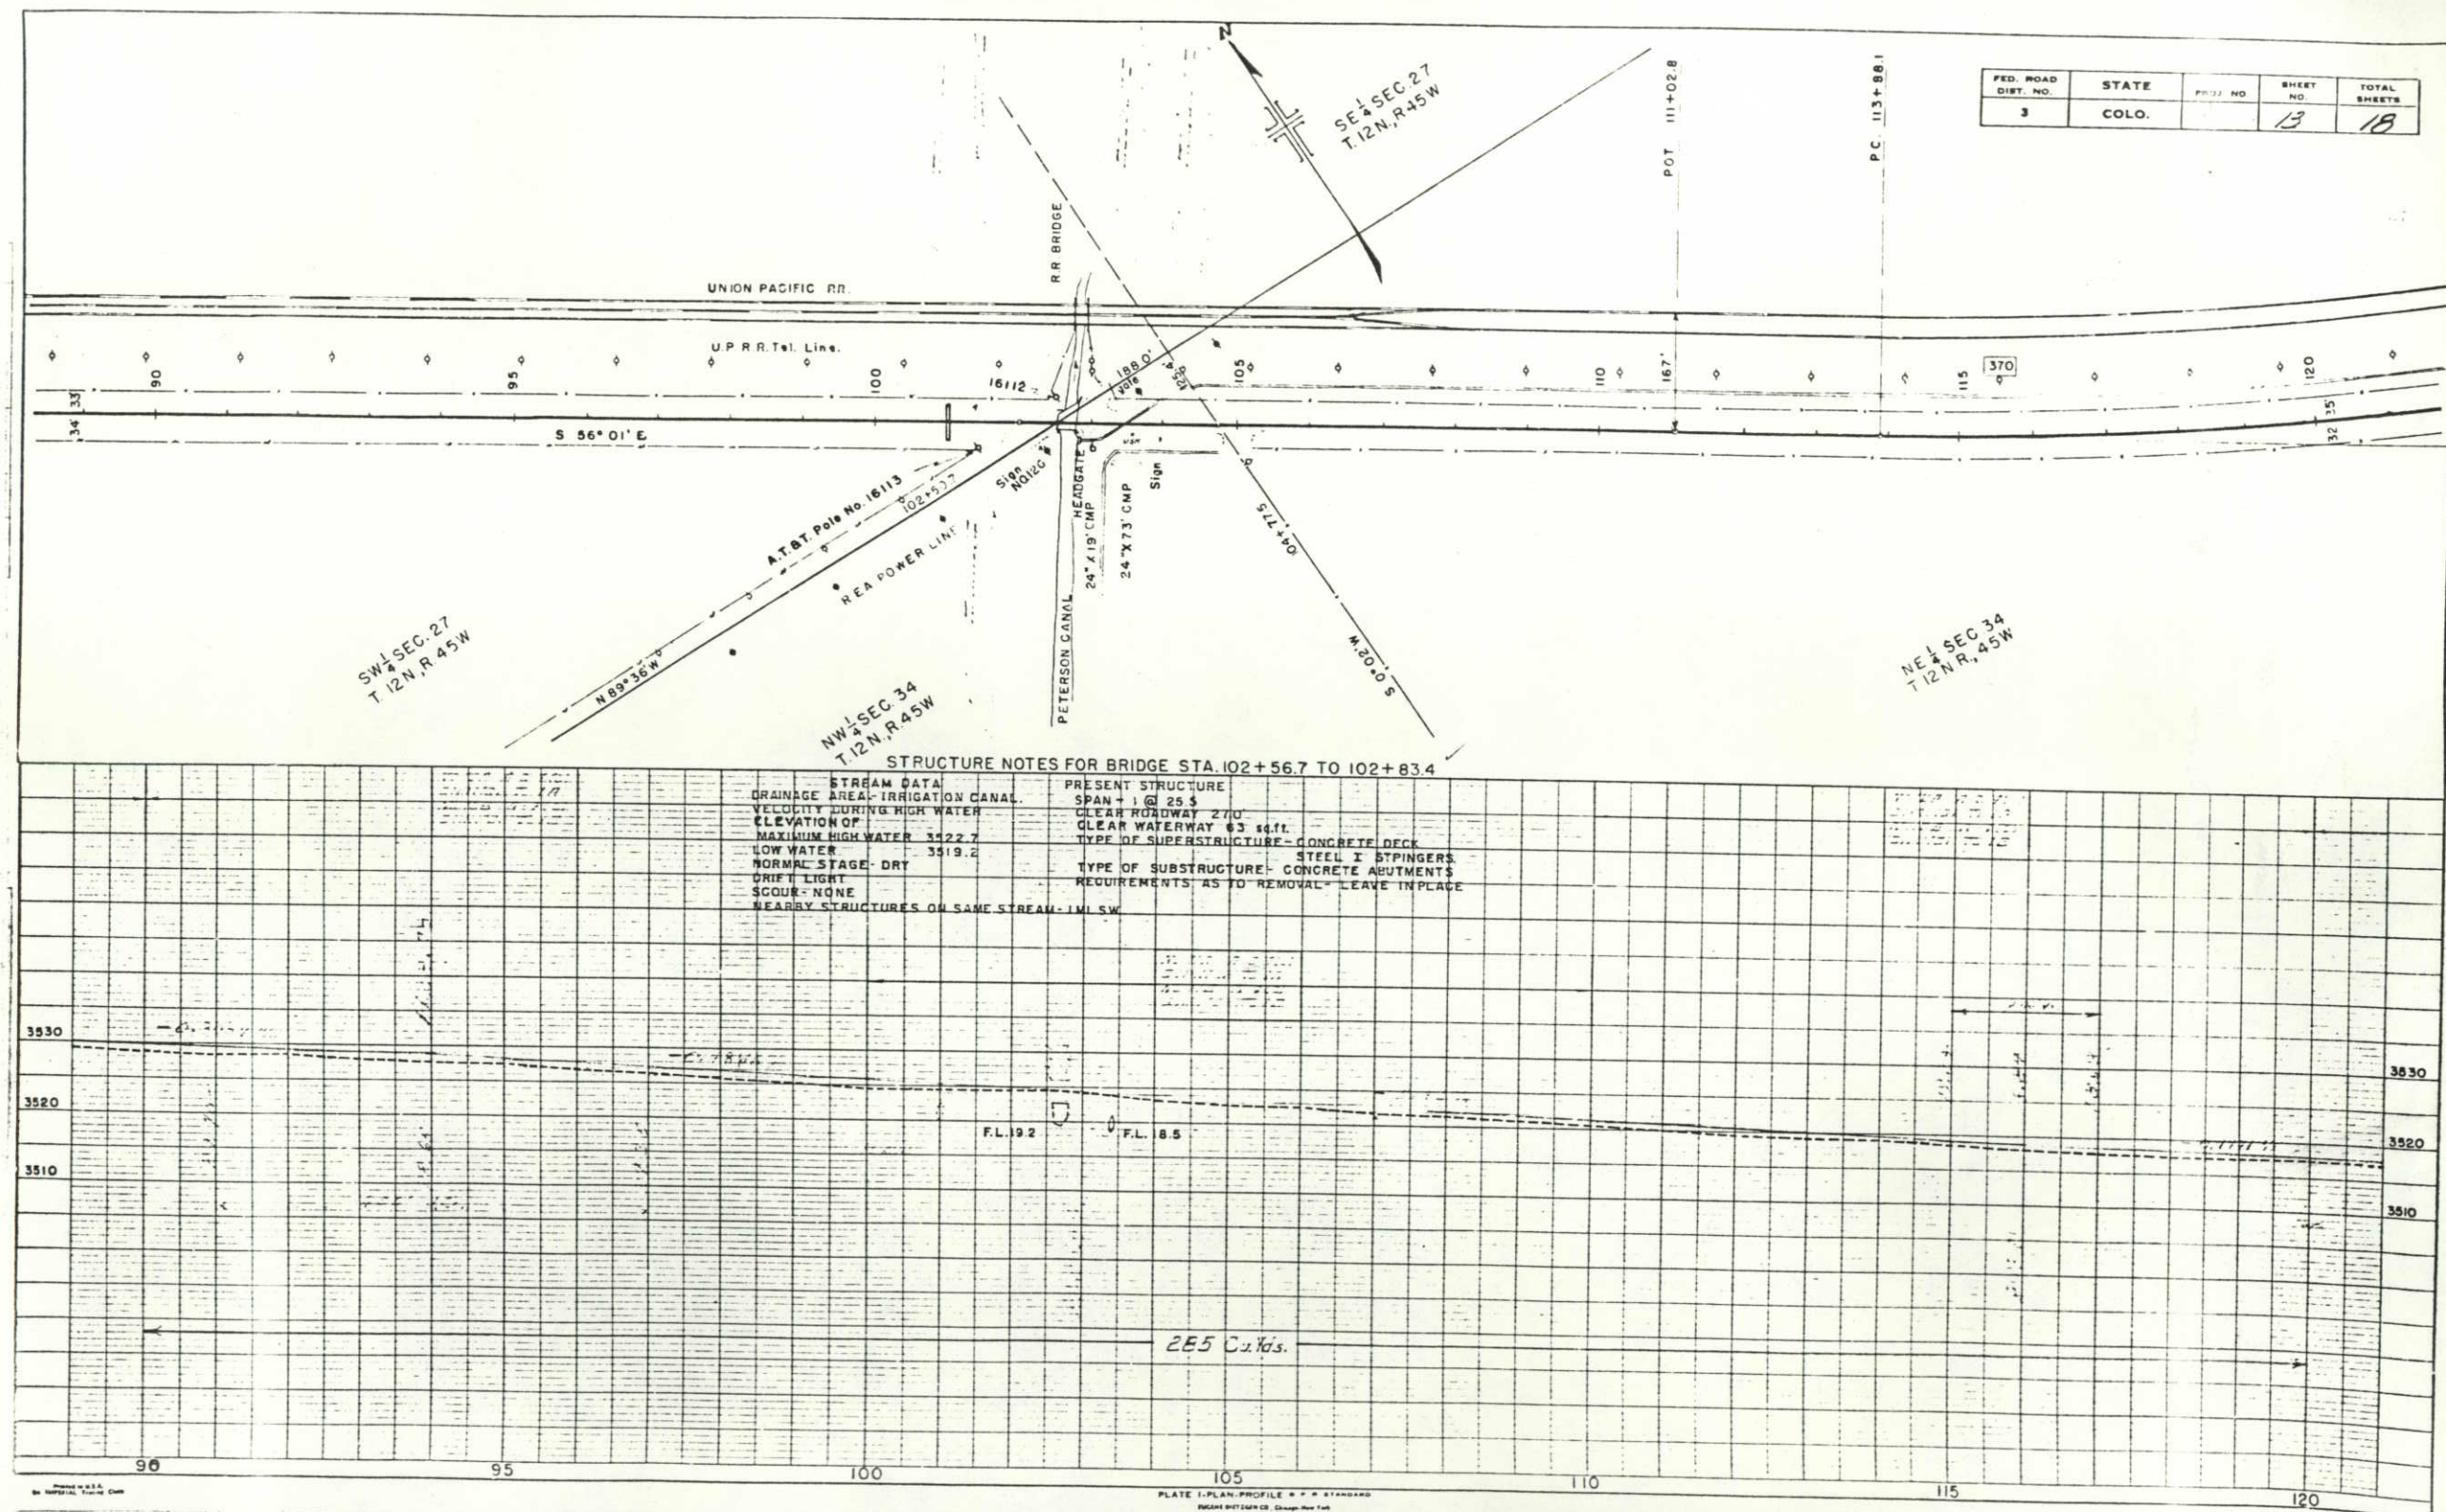

FED. ROAD DIST. NO.	STATE	PROJ. NO.	SHEET NO.	TOTAL SHEETS
3	COLO.	1-2-6-1-2	14	18

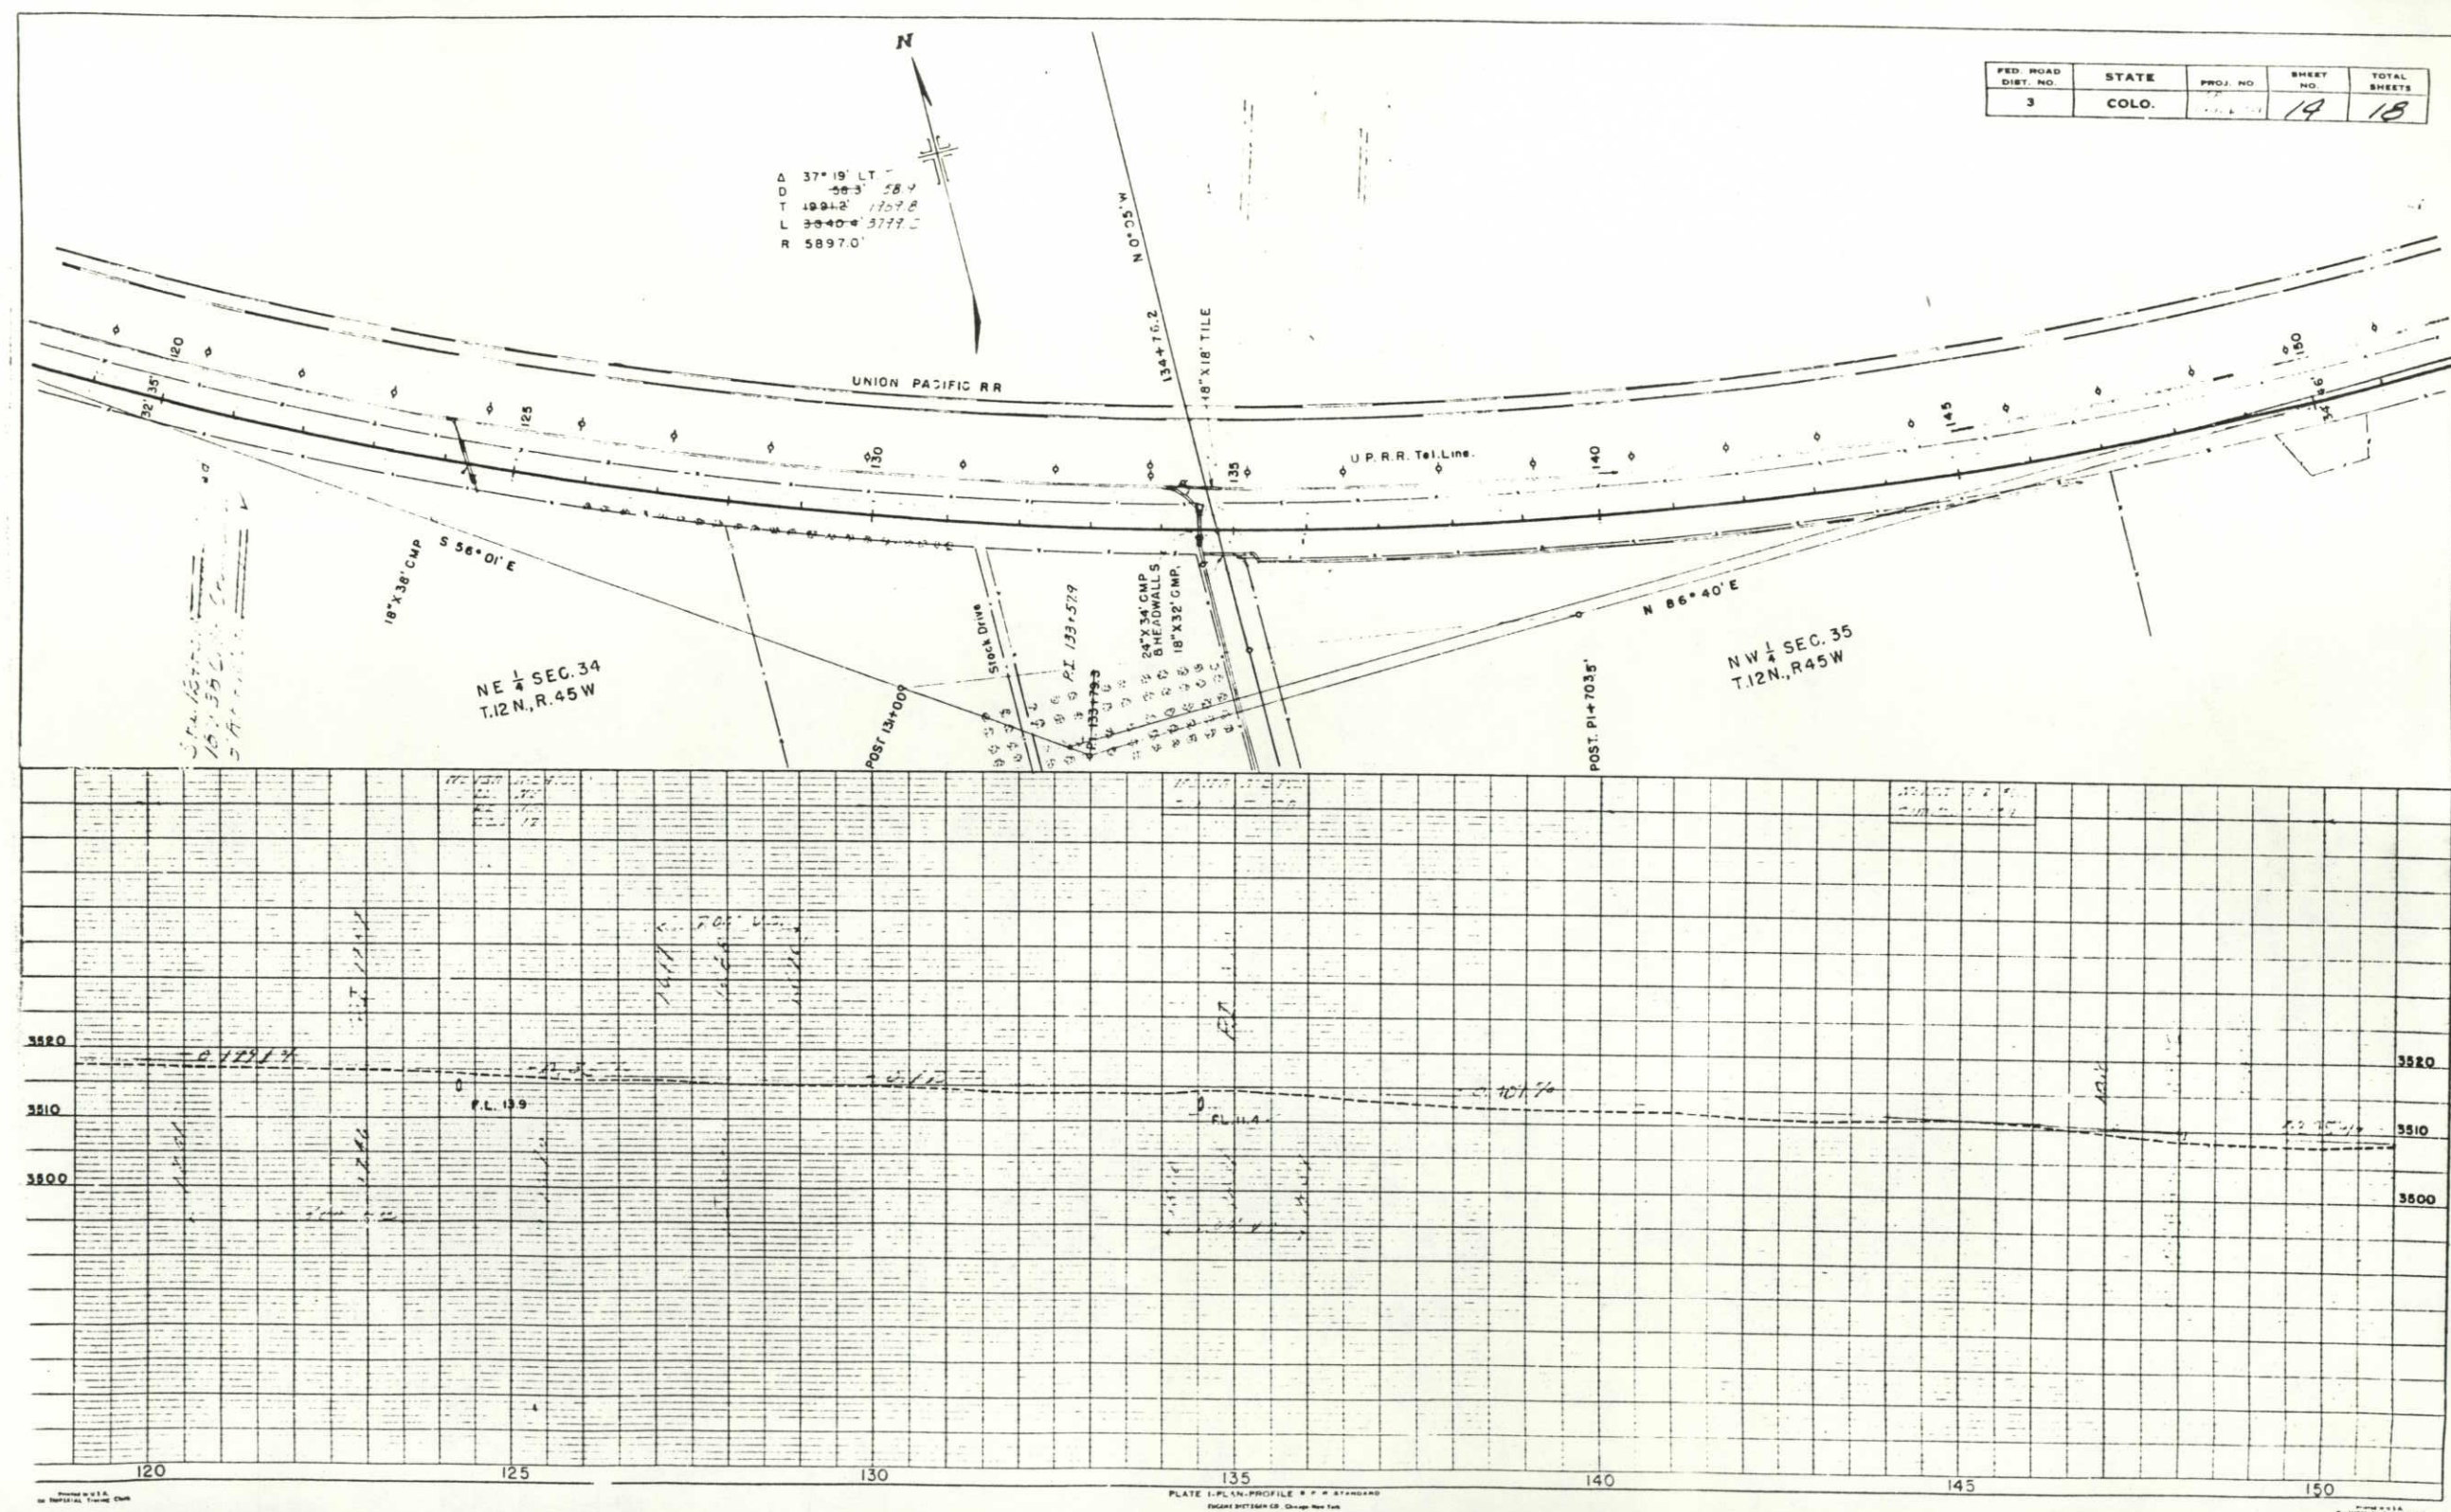

FED. ROAD DIST. NO.	STATE	PROJ. NO.	SHEET NO.	TOTAL SHEETS
3	COLO.		15	18

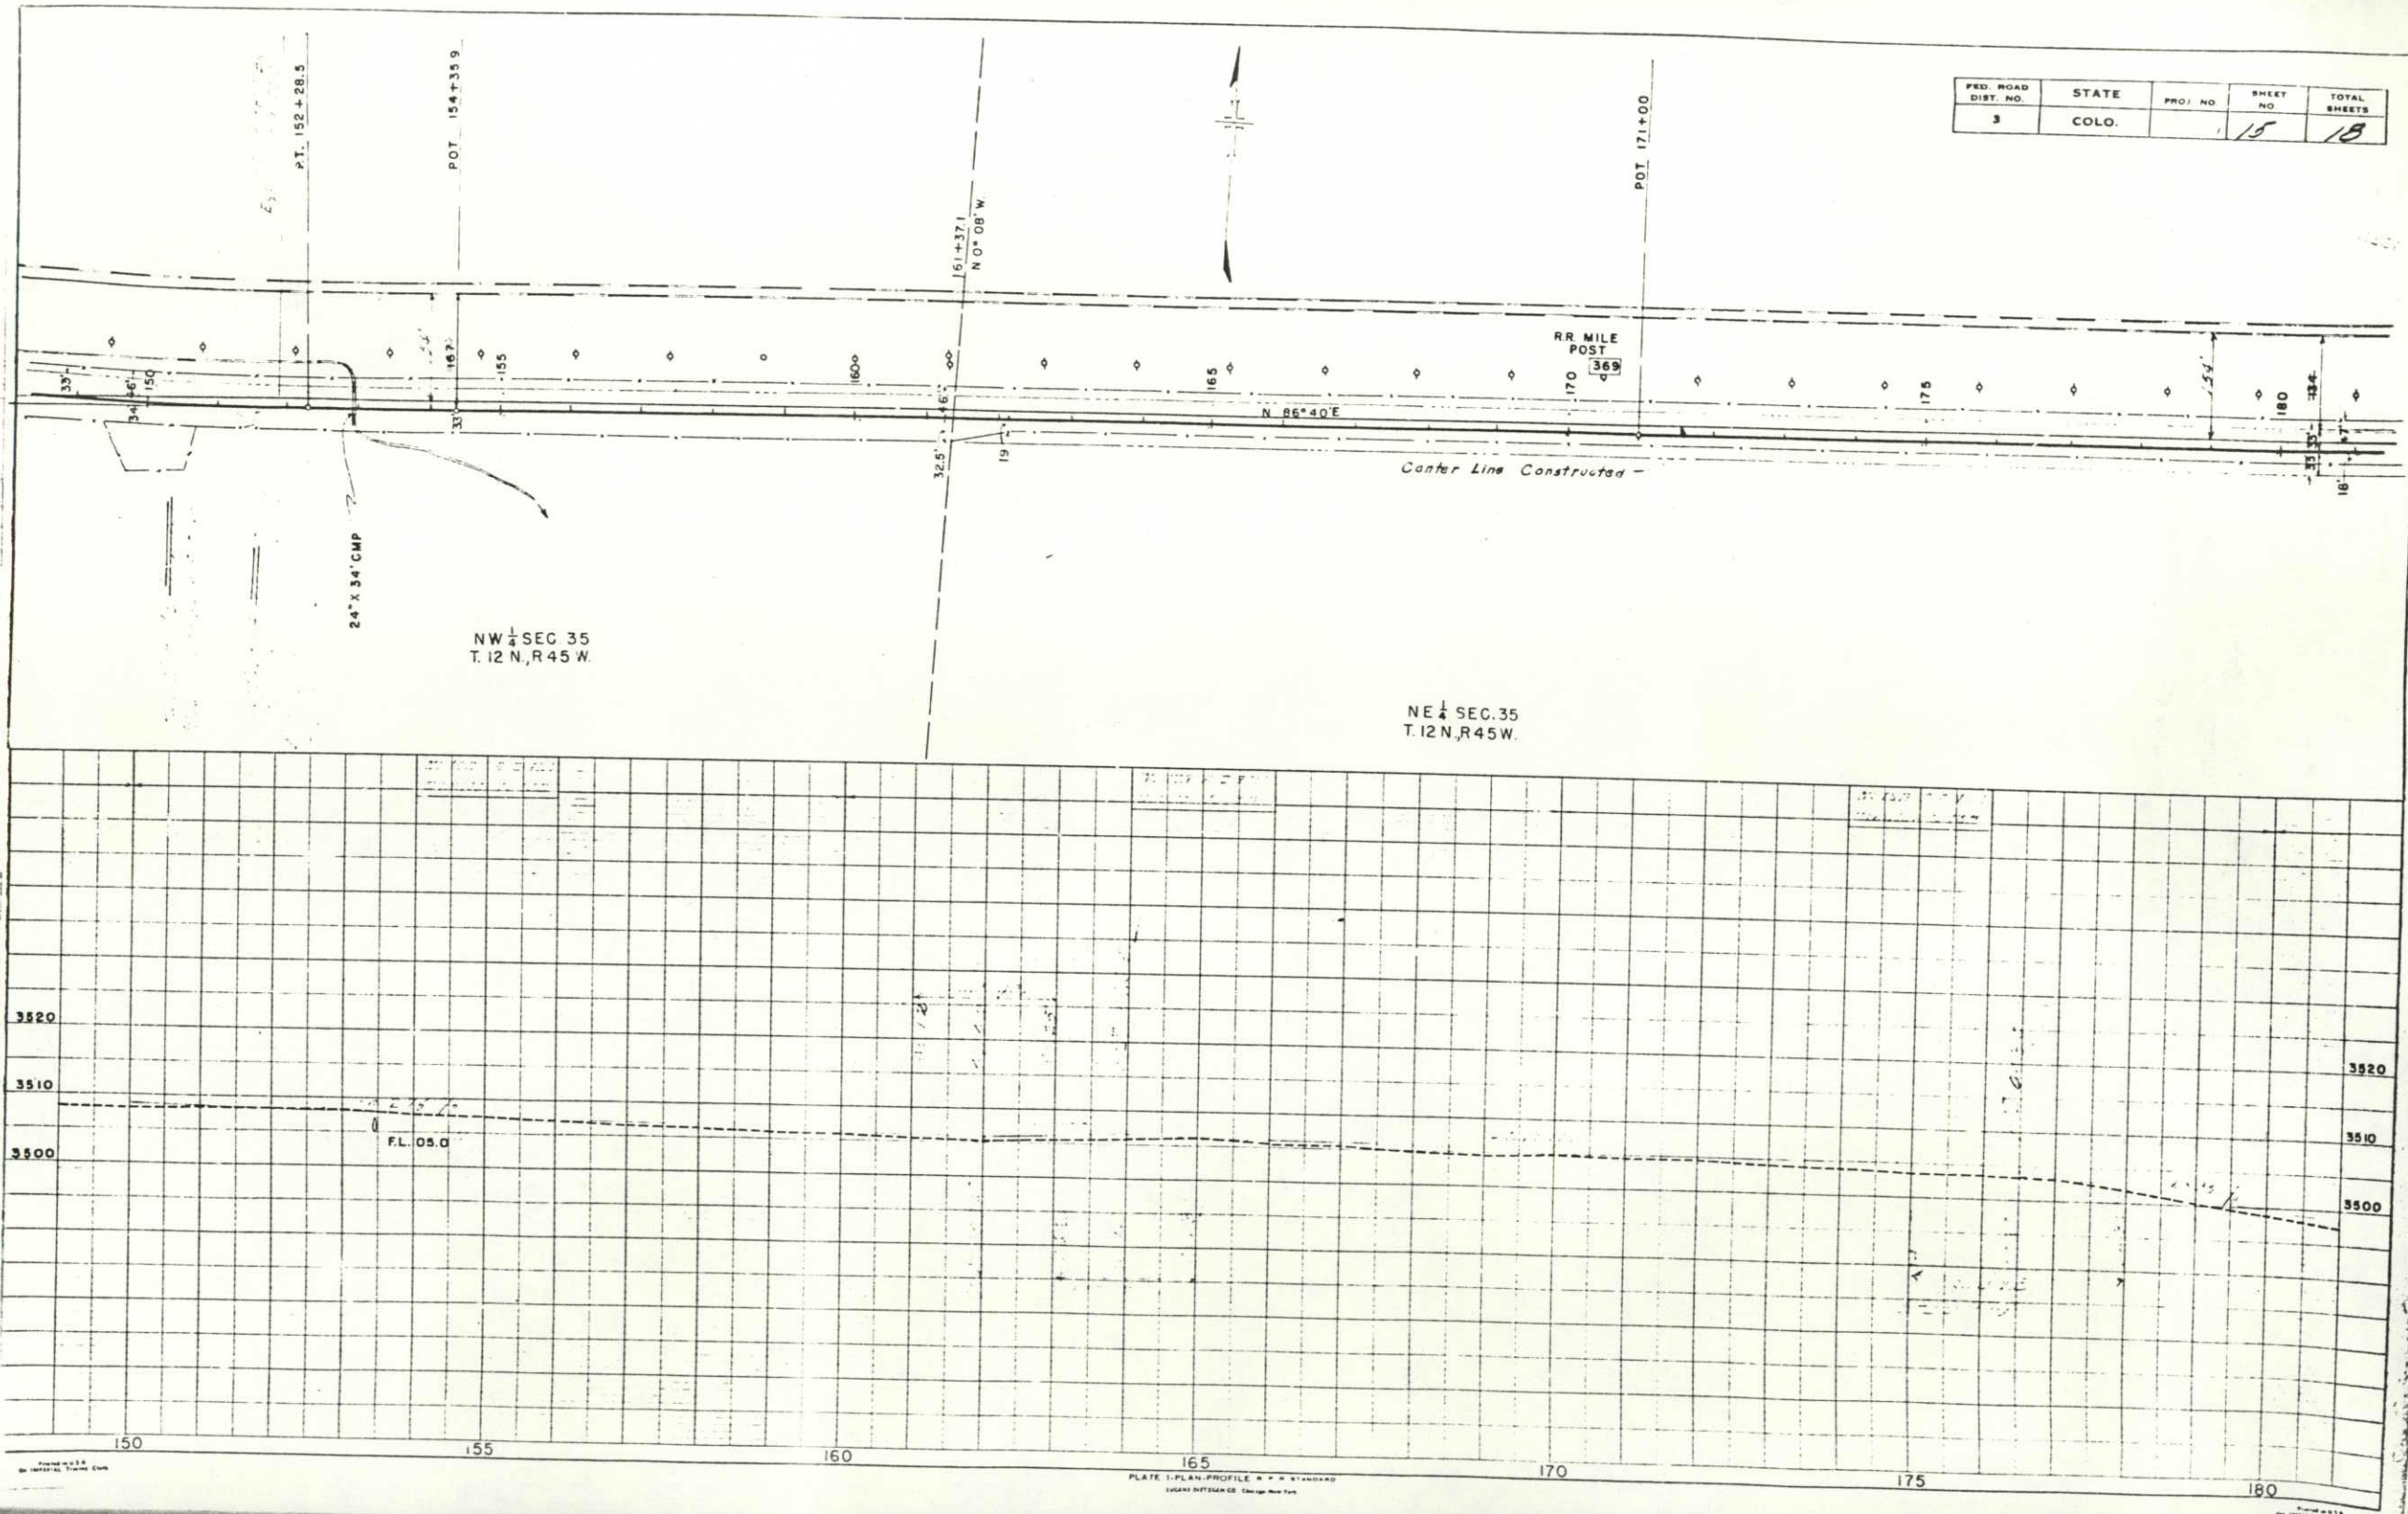


PLATE 1-PLAN-PROFILE - 1/4" = 1' STANDARD
 100' HORIZONTAL CURVE - Chicago and New York

FED. ROAD DIST. NO.	STATE	PROJ. NO.	SHEET NO.	TOTAL SHEETS
3	COLO.		16	18

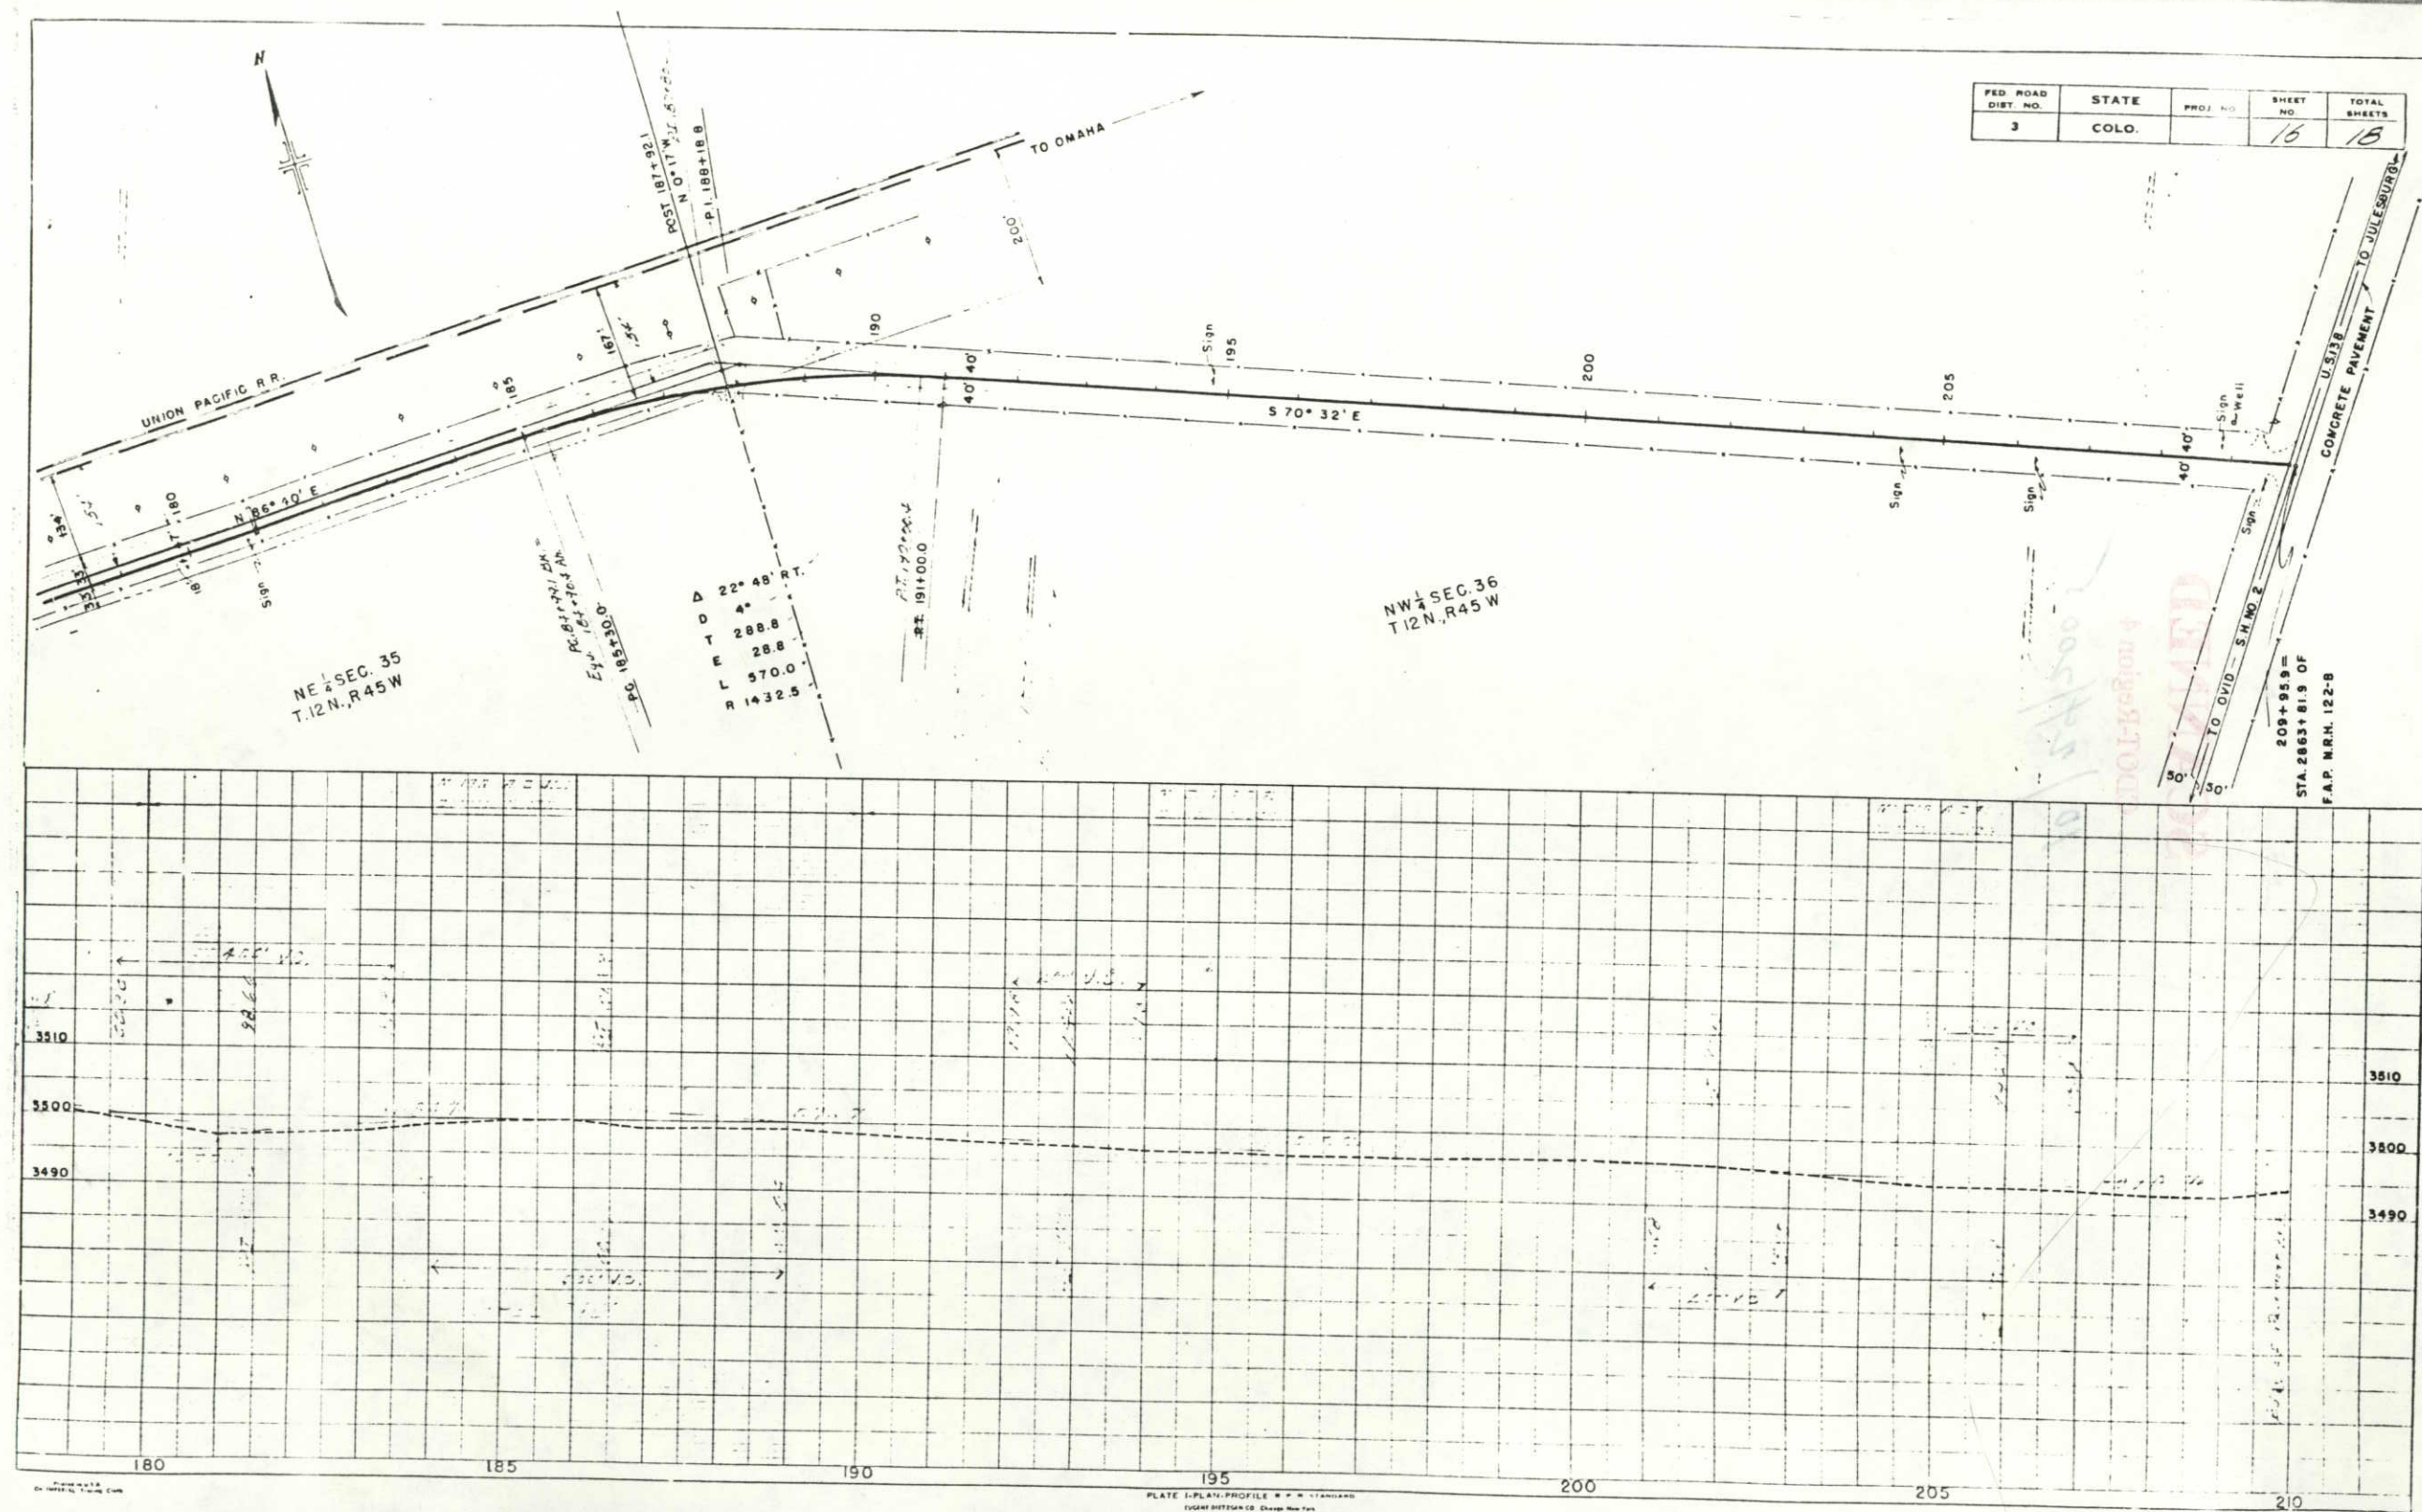


PLATE 1-PLAN, PROFILE & STANDARD
 EIGHT HITCH CO. Chicago, New York

PLATE 1-PLAN, PROFILE & STANDARD
 EIGHT HITCH CO. Chicago, New York