


INDEX OF SHEETS

- 1 SKETCH MAP AND TITLE PAGE
- 2 TYPICAL CROSS SECTION, SURFACING AND SELECT MATERIAL PLANS
- 3 SUMMARY OF QUANTITIES, AND LIST OF FENCING AND GATES
- 4-7 LIST OF STRUCTURES
- 7 LIST OF RIGHT OF WAY MARKERS AND GUARD POSTS
- 8-9 DETAILS OF BRIDGE, STA. 2565+
- 11 DETAILS OF BRIDGE, STA. 2278+
- 12 DETAILS OF DIVISION BOXES, STAS. 2271+ AND 2465+
- 13 DETAILS OF DIVISION BOX, STA. 2597+, AND DETAILS OF TRASH GUARDS, STAS. 2269+ AND 2271+
- 14 DETAILS OF SPECIAL INLET BOX FOR SIPHON, STA. 2541+, AND DETAILS OF GROUTED RUBBLE SLOPE & DITCH PAVING, STA. 2565+
- 15 DETAILS OF DIVISION BOX, STA. 2487+, & DETAIL OF C.M.P. UNDERDRAIN
- 16 DETAILS OF TIMBER DITCH CHECKS, STA. 2499+ TO 2504+
- 17 DETAILS OF HEAD AND DIVISION BOX, STA. 2597+
- 18 STANDARD HEADWALLS FOR C.M.P. CULVERTS
- 19 SPECIAL 6'x7' CONCRETE BOX CULVERT
- 20 CONCRETE BOX CULVERTS
- 21 CONCRETE BOX CULVERT
- 22 STANDARD SIPHON CORRUGATED GALVANIZED IRON PIPE WITH CONCRETE INLET AND OUTLET BOXES (SPEC. REV. FOR VAR. RISER SL.)
- 23 STANDARD TIMBER GUARD POSTS
- 24 STANDARD WIRE FENCES WITH METAL POSTS
- 25 CHAIN LINK WIRE MESH (SCHOOL) FENCE
- 26 STANDARD STRUCTURE NUMBER LETTERING
- 27 STANDARD STRUCTURE YEAR NUMBER MARKING
- 28 STANDARD METHODS FOR SUPERELEVATION & WIDENING OF CURVES
- 29 TYPICAL SIDE APPROACH ROADS/ROADWAY CONSTRUCTION TRAFFIC SIGNS
- 30 STANDARD MARKER POST
- 31 STANDARD C.M.P. CULVERT HEADWALLS
- 32 STANDARD CONTOUR, INTERCEPTING, AND DRAINAGE DITCHES
- 33-47 PLAN AND PROFILE
- 48-145 CROSS SECTIONS

- M-102-F
- M-101-B
- M-103-E
- M-104-E
- M-123-AX
- M-19-B
- M-27-B
- M-26-A
- M-10-A
- M-14-A
- M-1-B
- M-2-B
- M-7-B
- M-115-AX
- M-107-B

SCALES OF ORIGINAL TRACINGS  
 ON PLAN, 1 IN. = 100 FT.  
 ON PROFILE 1 IN. = 100 FT. HORIZONTAL  
 1 IN. = 10 FT. VERTICAL  
 GRADE LINE ON PROFILE IS SHOWN AS GRADE OF FINISHED ROAD  
 GROSS LENGTH OF PROJECT } 41,700.0 FT. = 7.897 MI.  
 NET LENGTH OF PROJECT }

CONVENTIONAL SIGNS

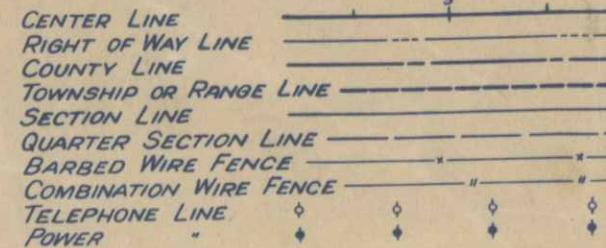

NOTE:  
 It is recommended that bidders on this Project go over the plan details with one of the following field representatives of this Department.  
 R.J. Randall Division Engineer Greeley  
 H.J. Winter Resident

# COLORADO

## STATE HIGHWAY DEPARTMENT

### PLAN AND PROFILE OF PROPOSED

#### S N FEDERAL AID PROJECT NO. F.A.P. 44-B (I)


#### STATE HIGHWAY NO. 185

#### LARIMER COUNTY

FED. ROAD DIST. NO.	STATE	SN FED. AID PROJ. NO.	SHEET NO.	TOTAL SHEETS
3	COLO.	44-B (I)	1	1

LENGTH OF PROJECT

STATIONS	ROADWAY BRIDGES	
	LIN. FT.	LIN. FT.
2263+00.0 - Begin		
2278+71.0 - Bridge End	1,571.0	26.1
278+97.1 - Bridge End		
55+55.0 - " "	28,657.9	26.1
565+81.1 - Bridge End	11,418.9	
1690+00.0 - End	41,647.8	52.2
Totals	7,887 MI. (41,010 MI.)	
	41,700.0	
	(7,897 MI.)	

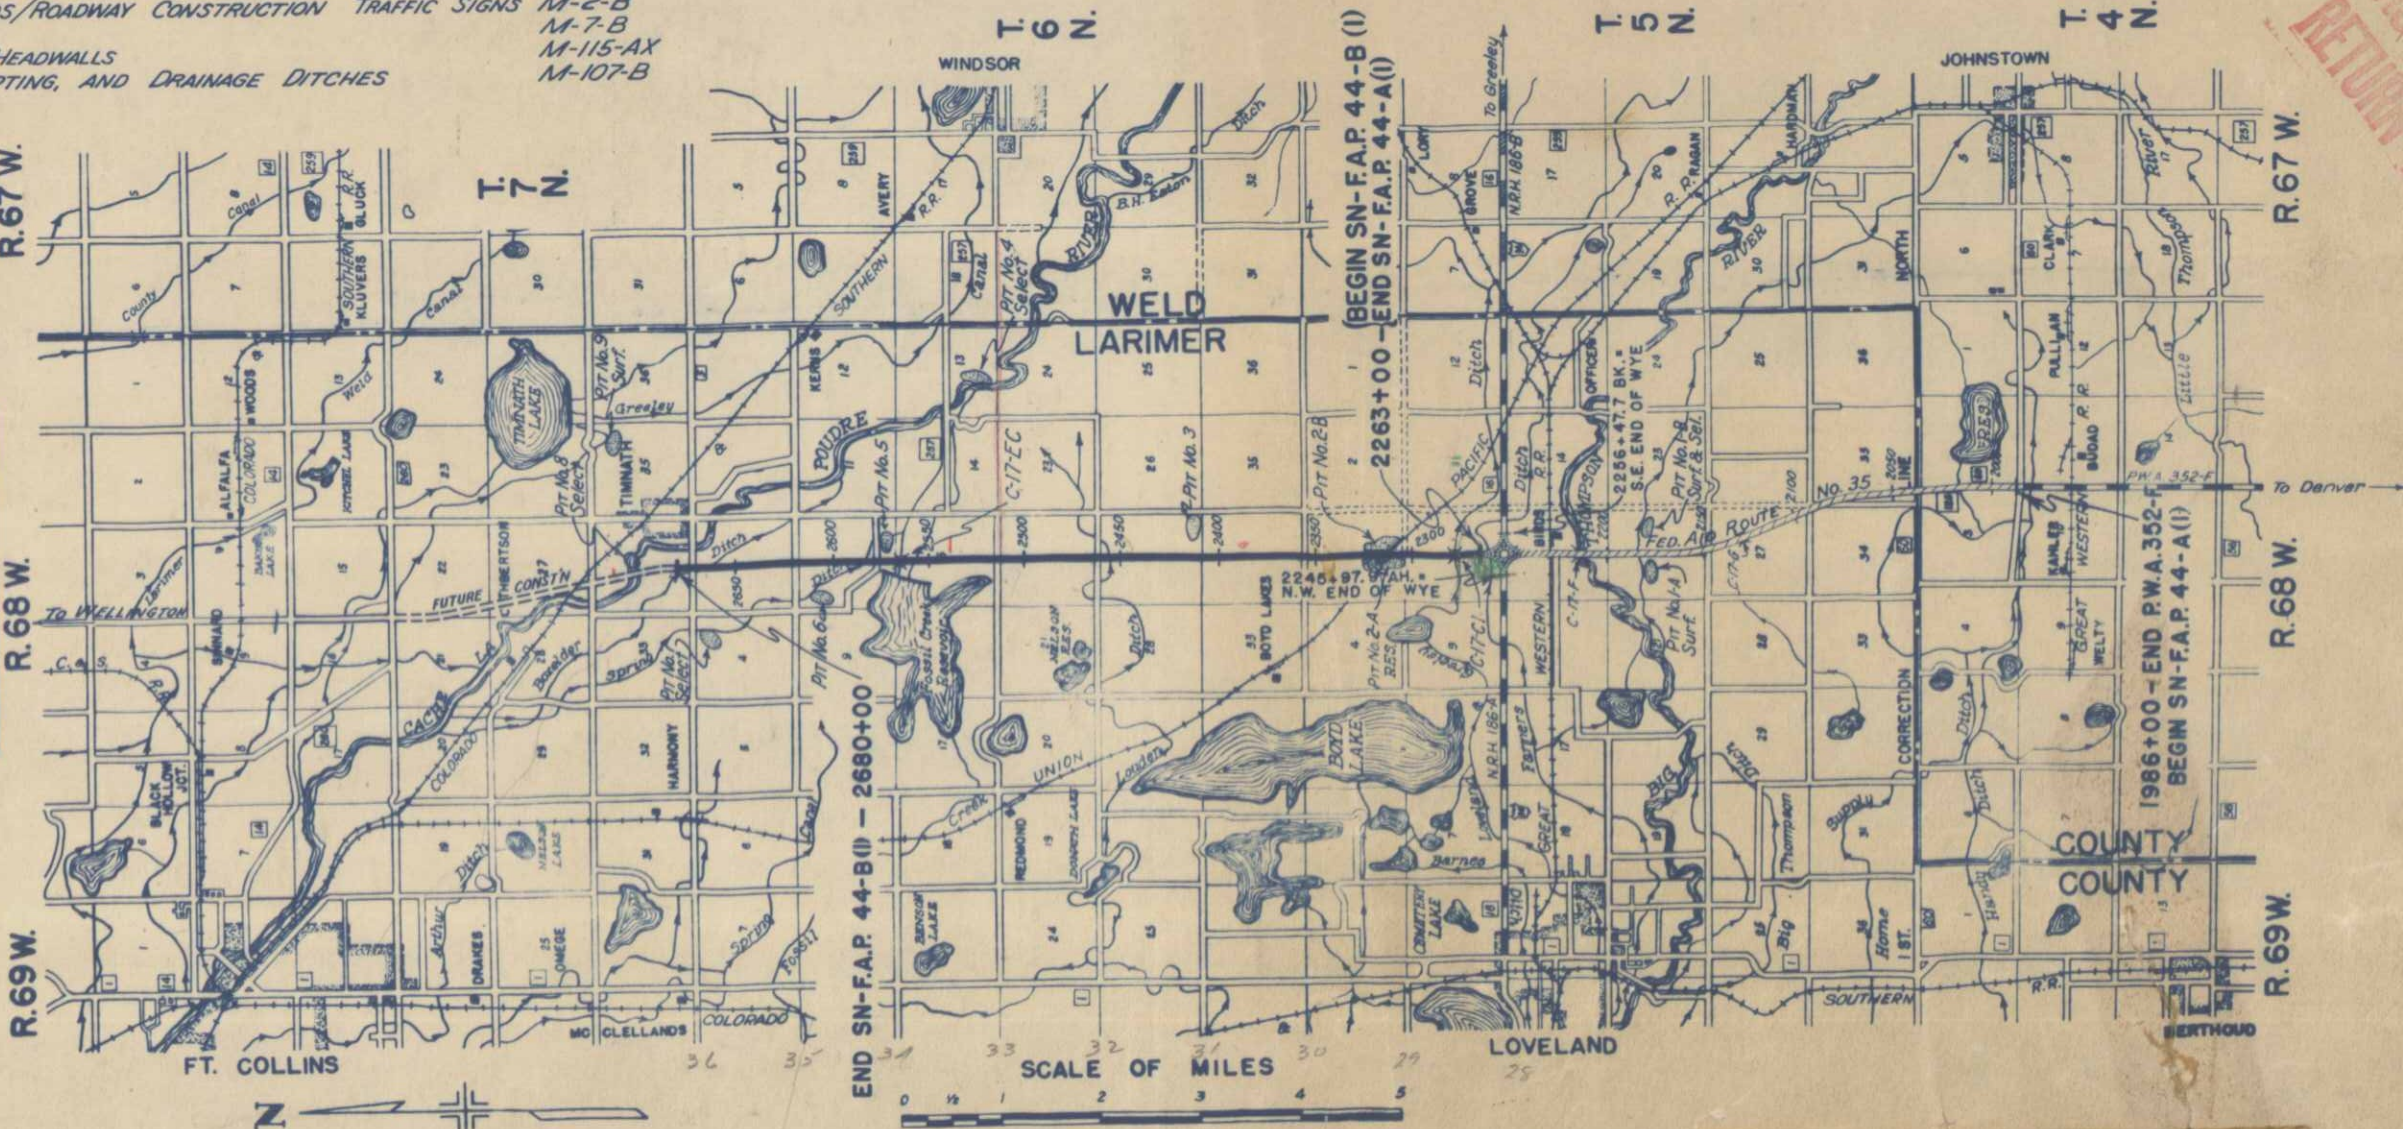

AS CONSTRUCTED PLANS RETURN TO DIST. 4 DESIGN

RECOMMENDED FOR APPROVAL

*[Signature]*  
 ASSISTANT ENGINEER  
 11-15-44

APPROVED

*[Signature]*  
 STATE HIGHWAY ENGINEER

RECOMMENDED FOR APPROVAL

DISTRICT ENGINEER  
 PUBLIC ROADS ADMINISTRATION  
 FEDERAL WORKS AGENCY


RECOMMENDED FOR APPROVAL

CHIEF, WESTERN REGION  
 PUBLIC ROADS ADMINISTRATION  
 FEDERAL WORKS AGENCY


APPROVED

COMMISSIONER  
 PUBLIC ROADS ADMINISTRATION  
 FEDERAL WORKS AGENCY

# TYPICAL CROSS SECTION OF IMPROVEMENT SECTION

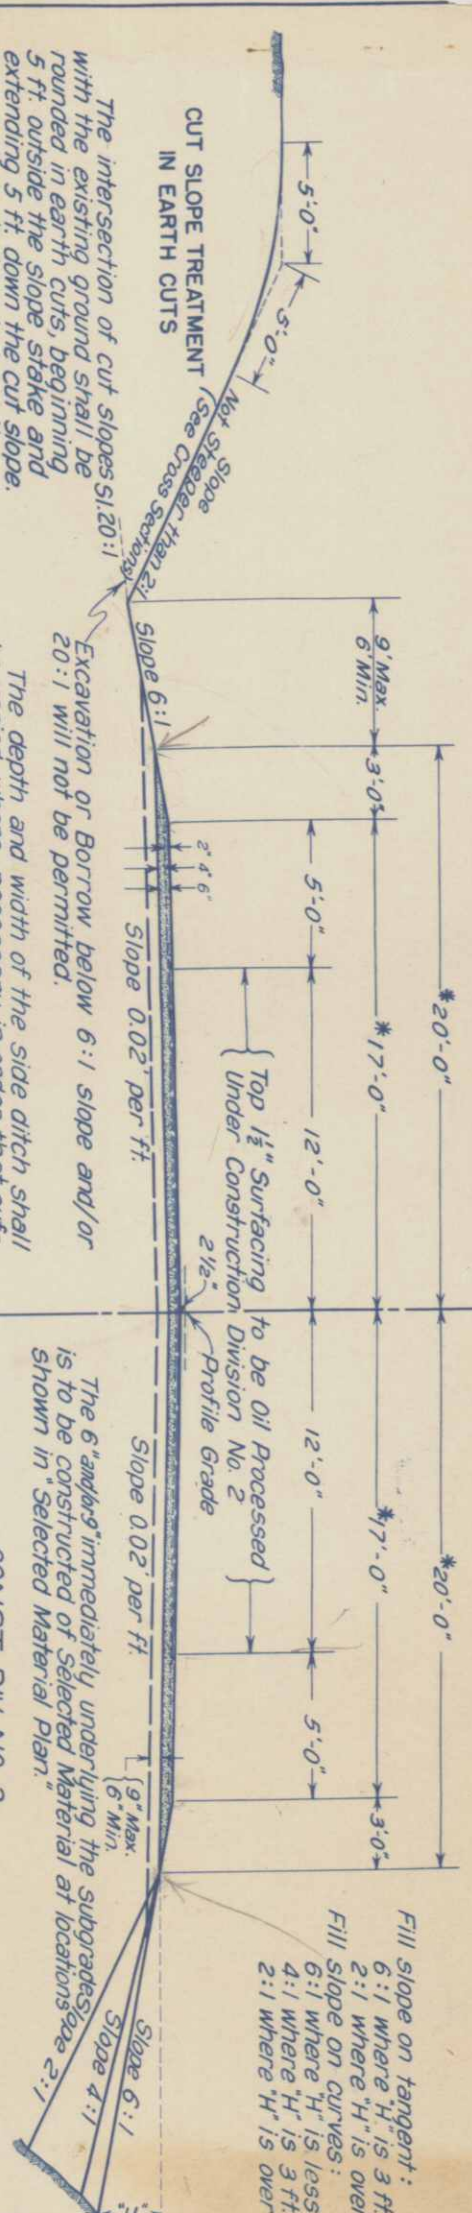

# TYPICAL SECTION OF DITCHES

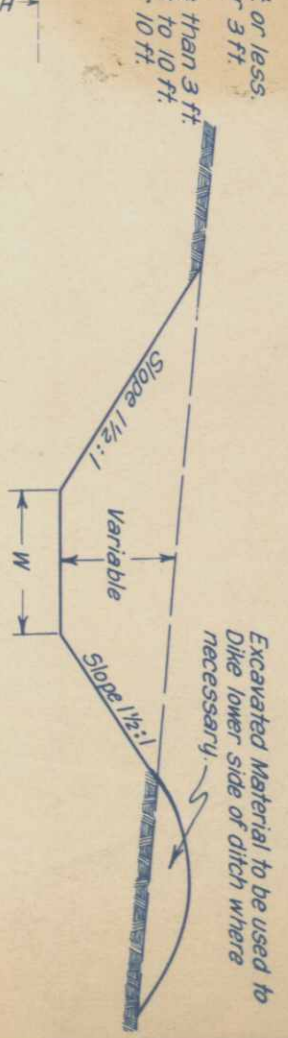

# SURFACING PLAN.

It is estimated that material for Gravel Surfacing for the Project is available in the vicinity of the pits indicated in the following tabulation. Estimated quantities involved in this operation are shown below.

No alteration of the Surfacing Plan as here outlined will be allowed without written permission from the Department.

MATERIAL TO BE PLACED	SOURCE	QUANTITY		OVERHAUL TON MILES
		TONS AVAIL.	TONS USED	
2263+00 to 2278+71	Pit #1-A 1000 FT. LT. Sta 2181+00	Ample	565	1226
2278+921 to 2486+45	1/2 Sec. 22, T. 5N, R. 68W	Ample	7469	16184
2486+45 to 2565+55	Pit #9, 1/2 Miles RT. Sta. 2727+00	Ample	2848	6170
2565+811 to 2680+00	NE 1/4 Sec. 35, T. 7N, R. 68W	Ample	4111	8907
Accel. & Decel. Lanes for Major Rd. Appt. 2673+15			100	200
Road Approaches Road Approaches	Pit #1-A Pit #9			520 @ 810
<b>TOTAL</b>			<b>15093</b>	<b>34,017</b>
				<b>150,467</b>

# SELECTED MATERIAL PLAN.

All the locations shown below, the 6" and/or 9" immediately underlying the surfacing, is to be constructed of Selected Material. Approximate quantities involved in this operation are shown below.

No alteration of the Selected Material Plan as here outlined will be allowed without written permission from the Department.

MATERIAL TO BE PLACED	SOURCE	QUANTITY		OVERHAUL	
		CUL YDS. AVAIL.	CUL YDS. USED	STA. YD.	YD. MI.
2263+00 to 2278+71	Pit #1-B 1000 FT. RT. Sta. 2181+00	Ample	2121	23,331	3542
2278+921 to 2407+00	E 1/2 Sec. 22, T. 5N, R. 68W		11,523	126,753	34,981
2407+00 to 2467+00	Pit #4, 1/2 Miles RT. Sta. 2542+00	15,000	5400	59,400	19,944
2467+00 to 2565+55	Pit #7, 3/700 FT. LT. Sta. 2823+20	15,000+	13,304	146,344	44,832
2465+811 to 2578+00	NE 1/4 Sec. 4, T. 6N, R. 68W		1646	18,106	3,813
2478+00 to 2606+50	Pit #8, Channel Improvement	18,000	3648	42,328	7057
2606+50 to 2680+00	300 FT. RT. Sta. 2702+00 NW 1/4		6615	72,765	5732
Accel. & Decel. Lanes for Major Rd. Appt. 2673+15	Sec. 34, T. 7N, R. 68W		200	2,200	60
<b>TOTAL</b>			<b>44,657</b>	<b>491,227</b>	<b>119,947</b>

# GENERAL NOTES (CONST. DIV. NO. 1)

This project is to be constructed in conformity with the standard specifications of the Colorado State Highway Department adopted June 1, 1940.

All quantities on preliminary plans are to be considered approximate only.

All roadway excavation required to construct this project is to be obtained as indicated on the plans. Quantities involved beyond the limits of the Typical Section, as shown on the Typical Section, either noted on the Profile as "Borrow" or on the List of Structures as "Embankment", are to be classified and paid for as "Unclassified Excavation".

These quantities are to be staked as part of the original Excavation at location indicated on the plans. Slope stakes beyond the limits of the Typical Section, as shown, are subject to change by the Engineer, to fit conditions actually met in construction.

All poles encroaching on construction are to be moved by the owners.

All corrugated metal pipe Culverts shall be laid without headwalls unless otherwise noted on the plans.

The ends of the Corrugated Metal Pipe Culverts shall be covered with approximately 6 inches of embankment material in such a manner that a minimum of metal shall be exposed in the completed work. This shall be accomplished by warping embankment slopes around and adjacent to the culvert.

All side approach roads to the Project shall be gravel surfaced with a 4 inch thickness of Gravel or Crushed Rock Surfacing extending approximately 30 ft. from the edge of the Highway. Estimated tonnage of Surfacing Material required in this operation is shown in the List of Structures.

Except as otherwise noted on the plans, payment for overhaul will be based on measurement along the centerline of the Project.

The entire project shall be cleared in conformity with the requirements of the Standard Specifications except that such trees or shrubs, as the Engineer may designate, shall be left in place and protected from damage during construction operations.

Right of Way fences for this project shall be constructed entirely within the Highway Right of Way as shown on the plans.

Intercepting ditches shall be placed on light grades following the ground contour and where possible shall be so constructed that the direction of flow will be away from the roadway, in order to spread runoff and thereby avoid erosion. This work shall be done in accordance with the methods shown on Standard Sheet No. M-107-B included in the plans. These ditches shall be constructed at locations indicated and as staked by the Engineer.

All curves are to be super-elevated and widened as provided for by the Standard Super-elevation Sheet included with the plans.

The ends of all cuts shall be flattened and back-slopes flattened to discharge side ditch drainage away from the base of adjacent fill slopes. The transition of flattened back-slopes and ditch shall be done in such a manner that a uniform appearance of slope and ditch results, and so as to promote the growth of native groundcover.

# ROAD APPROACHES (CONST. DIV. NO. 2)

All side approach roads of the Project shall be Oil Processed a distance approximately 20 ft. from the edge of the Highway. Quantities involved in this operation are tabulated below.

NO.	ITEM	DWT	*QUANTITY
30a	Asphaltic Road Material, RC-4	Gal.	1580
30g	Asphaltic Road Material, MC-O	Gal.	1,470
30p	Asphaltic Road Material, SC-3	Gal.	7,060
31x	Road Mix Oil Processing	Sq. Yd.	6,300
31c	Rolling Surfacing	Hr.	15
32b	Stone Screenings	Ton	80

\*Includes Quantities for Accel. & Decel. Lanes on Rt. Sta. 2668+00 to 2678+30.

FENCING REQUIREMENTS

STATION	SIDE	REMOVE FENCE LIN. FT.	REBUILD FENCE LIN. FT.	BARBED WIRE FENCE LIN. FT.	COMB WIRE FENCE LIN. FT.	CHAIN LINK FENCE LIN. FT.	GATES NO.			STATION	SIDE	REMOVE FENCE LIN. FT.	REBUILD FENCE LIN. FT.	BARBED WIRE FENCE LIN. FT.	COMB WIRE FENCE LIN. FT.	CHAIN LINK FENCE LIN. FT.	GATES NO.		
							WALK	DRIVE	DOUBLE DRIVE								WALK	DRIVE	DOUBLE DRIVE
2263+00 to 2276+43	Lt.	1515		1343						2474+40 to 2487+35	Rt.	1295							
2276+43 to 2288+30	"	1590		650						2487+35 to 2498+05	Lt.	205							
2288+30 to 2307+40	Rt.		220							2498+05 to 2513+75	Lt.	2650							
2307+40 to 2328+25	"			775						2513+75 to 2529+50	Rt.	790							
2328+25 to 2353+20	Lt.	970								2529+50 to 2544+00	Lt.	1580							
2353+20 to 2381+80	"	45								2544+00 to 2567+70	Rt.	6110							
2381+80 to 2407+75	Rt.	2760		1207						2567+70 to 2572+35	Lt.	3195							
2407+75 to 2460+10	"			2615						2572+35 to 2579+90	Rt.								
2460+10 to 2484+90	Lt.	40		1970						2579+90 to 2580+55	Lt.								
2484+90 to 2499+88	"	100								2580+55 to 2620+00	Rt.	3945							
2499+88 to 2529+50	Rt.	20		4765						2620+00 to 2672+95	Lt.	2610							
2529+50 to 2572+35	"	135		4685						2672+95 to 2680+00	Rt.								
2572+35 to 2607+50	Lt.	890		20,860						2680+00 to 2687+80	Lt.	5235							
2607+50 to 2620+60	Rt.	5270								2687+80 to 2699+80	"								
2620+60 to 2645+70	Lt.	890		2420						2699+80 to 2709+80	Lt.								
2645+70 to 2655+85	"	20								2709+80 to 2719+80	Rt.								
2655+85 to 2672+95	Rt.	5270		890						2719+80 to 2729+80	Lt.								
2672+95 to 2680+00	Lt.	890		890						2729+80 to 2739+80	Rt.								
2680+00 to 2687+80	"	2500		2420						2739+80 to 2749+80	Lt.								
2687+80 to 2699+80	Rt.	980		890						2749+80 to 2759+80	"								
2699+80 to 2709+80	Lt.	405								2759+80 to 2769+80	Lt.								
2709+80 to 2719+80	"			480						2769+80 to 2779+80	Rt.								
2719+80 to 2729+80	Lt.	1790								2779+80 to 2789+80	Lt.								
2729+80 to 2739+80	"									2789+80 to 2799+80	Rt.								
2739+80 to 2749+80	Lt.									2799+80 to 2809+80	Lt.								
2749+80 to 2759+80	"									2809+80 to 2819+80	Rt.								
2759+80 to 2769+80	Lt.									2819+80 to 2829+80	Lt.								
2769+80 to 2779+80	"									2829+80 to 2839+80	Rt.								
2779+80 to 2789+80	Lt.									2839+80 to 2849+80	Lt.								
2789+80 to 2799+80	"									2849+80 to 2859+80	Rt.								
2799+80 to 2809+80	Lt.									2859+80 to 2869+80	Lt.								
2809+80 to 2819+80	"									2869+80 to 2879+80	Rt.								
2819+80 to 2829+80	Lt.									2879+80 to 2889+80	Lt.								
2829+80 to 2839+80	"									2889+80 to 2899+80	Rt.								
2839+80 to 2849+80	Lt.									2899+80 to 2909+80	Lt.								
2849+80 to 2859+80	"									2909+80 to 2919+80	Rt.								
2859+80 to 2869+80	Lt.									2919+80 to 2929+80	Lt.								
2869+80 to 2879+80	"									2929+80 to 2939+80	Rt.								
2879+80 to 2889+80	Lt.									2939+80 to 2949+80	Lt.								
2889+80 to 2899+80	"									2949+80 to 2959+80	Rt.								
2899+80 to 2909+80	Lt.									2959+80 to 2969+80	Lt.								
2909+80 to 2919+80	"									2969+80 to 2979+80	Rt.								
2919+80 to 2929+80	Lt.									2979+80 to 2989+80	Lt.								
2929+80 to 2939+80	"									2989+80 to 2999+80	Rt.								
2939+80 to 2949+80	Lt.									2999+80 to 3009+80	Lt.								
2949+80 to 2959+80	"									3009+80 to 3019+80	Rt.								
2959+80 to 2969+80	Lt.									3019+80 to 3029+80	Lt.								
2969+80 to 2979+80	"									3029+80 to 3039+80	Rt.								
2979+80 to 2989+80	Lt.									3039+80 to 3049+80	Lt.								
2989+80 to 2999+80	"									3049+80 to 3059+80	Rt.								
2999+80 to 3009+80	Lt.									3059+80 to 3069+80	Lt.								
3009+80 to 3019+80	"									3069+80 to 3079+80	Rt.								
3019+80 to 3029+80	Lt.									3079+80 to 3089+80	Lt.								
3029+80 to 3039+80	"									3089+80 to 3099+80	Rt.								
3039+80 to 3049+80	Lt.									3099+80 to 3109+80	Lt.								
3049+80 to 3059+80	"									3109+80 to 3119+80	Rt.								
3059+80 to 3069+80	Lt.									3119+80 to 3129+80	Lt.								
3069+80 to 3079+80	"									3129+80 to 3139+80	Rt.								
3079+80 to 3089+80	Lt.									3139+80 to 3149+80	Lt.								
3089+80 to 3099+80	"									3149+80 to 3159+80	Rt.								
3099+80 to 3109+80	Lt.									3159+80 to 3169+80	Lt.								
3109+80 to 3119+80	"									3169+80 to 3179+80	Rt.								
3119+80 to 3129+80	Lt.									3179+80 to 3189+80	Lt.								
3129+80 to 3139+80	"									3189+80 to 3199+80	Rt.								
3139+80 to 3149+80	Lt.									3199+80 to 3209+80	Lt.								
3149+80 to 3159+80	"									3209+80 to 3219+80	Rt.								
3159+80 to 3169+80	Lt.									3219+80 to 3229+80	Lt.								
3169+80 to 3179+80	"									3229+80 to 3239+80	Rt.								
3179+80 to 3189+80	Lt.									3239+80 to 3249+80	Lt.								
3189+80 to 3199+80	"									3249+80 to 3259+80	Rt.								
3199+80 to 3209+80	Lt.									3259+80 to 3269+80	Lt.								
3209+80 to 3219+80	"									3269+80 to 3279+80	Rt.								
3219+80 to 3229+80	Lt.									3279+80 to 3289+80	Lt.								
3229+80 to 3239+80	"									3289+80 to 3299+80	Rt.								
3239+80 to 3249+80	Lt.									3299+80 to 3309+80	Lt.								
3249+80 to 3259+80	"									3309+80 to 3319+80	Rt.								
3259+80 to 3269+80	Lt.									3319+80 to 3329+80	Lt.								
3269+80 to 3279+80	"									3329+80 to 3339+80	Rt.								
3279+80 to 3289+80	Lt.									3339+80 to 3349+80	Lt.								
3289+80 to 3299+80	"									3349+80 to 3359+80	Rt.								
3299+80 to 3309+80	Lt.									3359+80 to 3369+80	Lt.								
3309+																			

### LIST OF STRUCTURES

LOCATION	DESCRIPTION	REMOVE NO.	EXCAVATION		STRUCTURAL EXCAVATION		GRAVEL SURFACING TON	CONCRETE		REINF. STEEL LB.	CORRUGATED METAL CULVERT PIPE				CORR. METAL SIPHON PIPE LIN. FT.	TRASH GUARDS EACH	CIVILIAN & VALVE BOX EACH	METAL DRAIN PIPE LIN. FT.	MISC. UNTRATED TIMBER BRD. FT.	SELECT BACKFILL MATERIAL CU YDS	MISCELLANEOUS	
			UNCL.	EMBRANK. UNCL.	CL. YD.	EMBRANK. UNCL.		CL. YD.	CLASS "A"		CLASS "B"	18"	24"	30"								36"
2263+00 2265+65	Project Marker Remove 15x20 C.M.P. Side Drain Rt. C.M.P. Side Drain and Road Approach Rt. C.M.P. Culvert Rt., 2 Type B Hdws., Trash Guards, and ditches.	1		35		5	60															1- Project Marker
2269+60	Remove 15x20 C.M.P. and 18x12' V.C.P. Rt. C.M.P. Side Drain and Road Approach Rt. Move School Merry Go Round from RdW. Rt. C.M.P. Side Drain Lt.	2		15		5	15															2-18" Trash Guards (C.M.P. only)
2270+79 2271+57 - 2272+13	C.M.P. Side Drain Lt.																					
2271+70 2271+85	Road Approach Lt. Corr. Metal Pipe Arch Culv. and ditches. Remove Concrete Division Box Rt. Concrete Division Box Rt.	1		25		15	10															Move School Merry Go Round
2271+75																						
2271+93 2272+00 2276+35 2276+43	Remove 18x22' C.M.P. Road Approach Lt. Remove 12x20' C.M.P. Lt. C.M.P. Side Drain Lt. & double Road Appro. Lt. & Rt. C.M.P. Side Drain Lt. & double Road Appro. Lt. & Rt. Bridge. Remove Bridge.	1		25		5	15															30x17'x62' C.M.P. Arch Culvert
2278+71.0 - 2278+97.1 2279+32 2280+00 2281+20	Remove 14x17' Wood Box Side Drain Lt. C.M.P. Side Drain and Road Approach Lt. Double Road Approach Rt.	1		300		300	5															100 cu yds. Detour Surfacing
2282+25 2282+35 - 2282+83 2283+25 2288+70 2289+00	Walk Approach Rt. Rem. & Relay portion of 2" pipe line Rt. Road Approach Rt. Road Approach Lt. C.M.P. Cross Culvert and ditches.			15		Force Account	5															Rem. & Rebuild 2 Cattle Guards
2302+95 2307+86	C.M.P. Side Drain and Road Approach Rt. Rem. & Rebuild R.R. Cattle Guards Rt. & Lt. Rail Road Grade Crossing			15		Force Account	5															
2315+00	Road Approaches Lt. & Rt.																					
2317+00 2335+00 2355+50	C.M.P. Cross Culvert and ditches. C.M.P. Cross Culvert, inlet ditch, Dikes of inlet & outlet. Road Approaches Lt. & Rt. & 2-18" C.M.P. Side Drains			20		90	30															
2364+00 2381+80 2382+00 2382+25	C.M.P. Cross Culvert and ditches. Double Road Approach Lt. Road Approach Rt. C.M.P. Cross Culvert and ditches			100		5	10															
2407+90 2420+00 2423+00 2432+00	Road Approaches Rt. & Lt. C.M.P. Cross Culvert and ditches. Fill Hole Rt. C.M.P. Cross Culvert and ditches.			80		15	10															
2455+85 2457+80 2458+33	C.M.P. Side Drain and Road Approach Lt. Remove 12x22' C.M.P. Rt. C.M.P. Side Drain and Road Approach Rt. Remove Present Bridge 8x4x60' C.B.C. (Type B J)	1		80		30	5															Remove Bridge
2459+88 2460+01 2460+40	Road Approach Lt. Remove 12x32' C.M.P. Lt. Remove 12x34' C.M.P. Lt. C.M.P. Side Drains & Road Approaches Rt. & Lt.	1		90		15	25															
2460+70 - 2467+00 2460+80	Irrigation Ditch Change Lt. (W-2) Remove 12x25' C.M.P. Lt.	1		375		90	25															
<b>SHEET TOTAL</b>		<b>12</b>	<b>315</b>	<b>1940</b>	<b>305</b>	<b>485</b>	<b>445</b>	<b>84.6</b>	<b>1.1</b>	<b>8,279</b>	<b>660,436</b>	<b>68</b>	<b>40</b>	<b>7</b>	<b>120</b>							

LIST OF STRUCTURES

LOCATION	DESCRIPTION	REMOVE STRUCTURE NO.	EXCAVATION		STRUCTURAL EXCAVATION		GRAVEL SURFACING TON	CONCRETE		REINF. STEEL LB.	CORRUGATED METAL CULVERT PIPE					CORR. METAL SIPHON PIPE LIN. FT.	TRASH GUARDS EACH	CL VALVE & BOX EACH	METAL DRAIN PIPE LIN. FT.	MISC. UNTREATED TIMBER BRD. FT.	SELECT BENTONITE MATERIAL CU. YDS.	MISCELLANEOUS
			CU. YD.	EMBANK. DITCH	CU. YD.	CU. YD.		CLASS "A"	CLASS "B"		18"	24"	30"	36"	48"							
2463+85 2463+00-2470+00 2465+32	C.M.P. Side Drain and Road Approach Rt. Drain Ditch Lt. (W+2) Remove Concrete Ditch Check Lt.	1 ✓	60	240 185			15				30											
2465+46 2465+63 2465+75-2494+35	Remove 15"x25" V.C.P. C.M.P. Cross Culvert for Irrigation Concrete Division Box Lt. Remove Concrete Ditch Check Lt. Irrigation Ditch Change Rt. (W-2)	1 ✓ 1 ✓ 1 ✓		1300				1.6		142	102								12			
2465+75-2470+80 2465+85 2467+35	Irrigation Ditch change Rt. (W-2) Remove 3x11 Timber Ditch Crossing Lt. 2 C.M.P. Side Drains and Road Approach Lt. C.M.P. Side Drain and Road Approach Lt.	1 ✓ 1 ✓ 1 ✓		50 40	50		15 15				30 20 30											
2469+60-2470+72 2470+25 2470+50	C.M.P. Side Drain in Irrigation Ditch Rt. Rem. 18x24 C.M.P. & 3x16 Timber Ditch Crossing Rt. C.M.P. Side Dr. in Irrig. ditch & Road Appr. Rt. Rem. and Restore Well and Appurtenances Rt.	2 ✓ 1 ✓ 1 ✓		35			15				24											
2475+65	Remove and Relay 15x16 Metal Pipe Rt. Remove 6"x100 Clay Tile under drain Perforated C.M.P. under drain Drain Ditch Lt. (W-1)	1 ✓																				
2478+00-2484+00	C.M.P. Side Dr. in Irrig. ditch & Road Appr. Rt. C.M.P. Side Dr. and Walk Approach Lt. Drain Ditch Lt. (W+1)	1 ✓		120 5			15 5				30 10											
2486+60-2491+00 2487+10	Remove 12"x20 C.M.P. Lt. C.M.P. Side Drain and Road Approach Lt.	1 ✓		25			15				28											
2487+15	Remove 4x12 Timber Ditch Crossing Rt. C.M.P. Side Dr. in Irrig. ditch & Road Appr. Rt. Remove Concrete Division Box Rt. Concrete Division Box Rt.	1 ✓ 1 ✓ 1 ✓		25			15	2.3		220	24								9			
2487+35 2488+80 2491+60	Rem. and Restore Well and Appurtenances Lt. C.M.P. Side Drain and Road Approach Lt. Remove 12"x20 C.M.P. Rt. C.M.P. Side Dr. in Irrig. ditch & Road Appr. Rt.	1 ✓ 1 ✓ 1 ✓		Force ACCOUNT 25			15 15				28 24											
2491+79 2494+35 2494+45	Remove Outhouse Lt. C.M.P. Cross Culvert Irrigation Ditch Change Lt. (W+1.5) Remove 15x21x29 Culvert Rt.	1 ✓ 1 ✓ 1 ✓			25						74											
2494+60 2495+75 2497+00-2498+30 2499+ - 2505+	C.M.P. Side Drain and Walk Approach Rt. C.M.P. Side Drain and Road Approach Rt. C.M.P. Side Drain and Road Approach Rt. 8 Timber Ditch Checks in Irrig. ditch Lt.	1 ✓ 1 ✓ 1 ✓ 1 ✓		5 35 110			5 25 80				10 40 138											
2500+80 2500+85 2501+05 2501+80	Remove 4x12 Timber Ditch Crossing Lt. C.M.P. Side Dr. in Irrig. ditch & Road Appr. Lt. Remove Concrete Ditch Check Lt. Remove 12"x20 C.M.P. Rt. C.M.P. Side Drain and Road Approach Rt.	1 ✓ 1 ✓ 1 ✓ 1 ✓		70			15				28											
2502+00-2509+00 2509+00	Irrigation Ditch Change Rt. (W+1.5) C.M.P. Cross Culvert, ditches, Grouted Rubble Slope and Ditch Paving (6" Thick) & Dike at Inlet. Waste Ditch Rt. (W+1.5)			30							70											
2509+00-2513+50 2509+30 2513+60	Remove 15"x28 C.M.P. Rt. Remove 12"x34 C.M.P. Rt.	1 ✓ 1 ✓		700			280	3.9		362	808 70											
SHEET TOTAL		18																				

# LIST OF STRUCTURES

FED. ROAD DIST. NO. 3 STATE COLO. SH- FED. AID PROJ. NO. 44-B(1) SHEET NO. 7 TOTAL SHEETS

LOCATION	DESCRIPTION	REMOVE STRUCTURE		EXCAVATION			STRUCTURAL EXCAVATION		GRAVEL SURFACING	CONCRETE		REINF. STEEL	CORRUGATED METAL CULVERT PIPE				CORR. METAL SIPHON PIPE	TRASH GUARDS	C.I. VALVE & VALVE BOX	METAL DRAIN PIPE	MISC. UNTREATED TIMBER	SELECT BACKFILL MATERIAL	MISCELLANEOUS			
		NO.	NO.	CU. YD.	UNCL. EMBANK.	UNCL. DITCH	CU. YD.	TON		CLASS "A"	CLASS "B"		LB.	18"	24"	30"								36"	48"	60"
2642+20-2645+90 2645+70 2646+35 2646+55	Waste Ditch Lt.(W-1) C.M.P. Side Dr. in Waste Ditch & Road Appro. Lt. C.M.P. Cross Culvert, ditch changes Rt.&Lt.(W-1) C.M.P. Side Dr. in Irrig. Ditch Lt. Road Appro. Rt.&Lt.			60	60	40	10	15					18"	20												
2646+75 - 2648+50 2652+00 2654+00 2655+00 - 2656+95 2655+00 - 2656+95	Vary roadway ditch Lt. C.M.P. Cross Culvert and ditches. C.M.P. Side Dr. Lt. and Road Approaches Rt.&Lt. Irrigation Ditch Change Lt.(W-1) Irrigation Ditch Change Lt. (W-2)			60	50	5	10	30	30				18"	20	66											
2656+30 2656+95 2658+00	Rem. & Reset 23'x9'x4' Wood Flume Lt. C.M.P. Cross Culvert and ditches. C.M.P. Cross Culvert, C.M.P. under irrigation ditch Lt. and ditches.					10	10	15					18"	70												
2668+00 - 2678+30 2672+60 2673+15 2673+80 2676+60 2678+00	Accel. & Decel. Lanes for Major Road Appro. Rt. Road Approach Lt. Major Road Approach Rt., Road Approach Lt. Road Approach Lt. 10'x3'x63' C.B.C. (Type 10-1) & ditches (W-10) C.M.P. Side Drain and Road Approach Lt.				* 440 60 280 55	360	215	15	300 15 70			9783	18"	28												
<b>SHEET TOTAL</b>				60	640	790	270	490	93.8		9,783	328	66													
<b>PROJECT TOTAL</b>			34	1820	5300	6280	2495	1630	340.65	3.35	32,100	2198	188	80	68	40	144	98	652	8	4	880	105	45	530	

\* Asphalt Coated  
\* Included for payment in profile quantities.  
© Structural Excavation is estimated to be 5% Rock 95% Common, each of which is estimated to be 60% Dry and 40% Wet.


## R.O.W. MARKERS

STATION	SIDE	NO.	STATION	SIDE	NO.	STATION	SIDE	NO.
2276+43	Lt.&Rt.	2	2511+00	Lt.	1	2620+00	Lt.	1
2303+10	" "	2	2514+25	Lt.&Rt.	2	2620+60	Rt.	1
2355+20	Lt.	1	2516+50	" "	2	2645+87	Rt.	2
2355+80	Rt.	1	2518+00	" "	2	2645+87	Lt.	1
2381+80	Lt.&Rt.	2	2537+00	" "	2	2672+85	Lt.&Rt.	2
2407+77	Lt.&Rt.	2	2538+50	Lt.&Rt.	2			
2433+27	" "	2	2544+50	Rt.	1			
2460+10	Lt.	1	2546+00	" "	1			
2460+70	Rt.	1	2548+00	Lt.	1			
2487+35	Lt.&Rt.	2	2549+00	Lt.	1			
2501+00	Rt.	1	2567+31	Lt.&Rt.	2			
2502+50	" "	1	2576+50	Lt.	2			
2509+50	Lt.	1	2593+90	Lt.&Rt.	2			
<b>TOTAL</b>			<b>TOTAL</b>			<b>47</b>		

## TIMBER GUARD POSTS

STATION	SIDE	SPACING	NO.	STATION	SIDE	SPACING	NO.	
2271+85	Lt.&Rt.	Minor Str.	2	2564+91 to 2565+52	Lt.&Rt.	Major Str.	10	
2278+07 to 2278+68	" "	Major Str.	10	2565+84 to 2566+45	" "	" "	10	
2279+00 to 2279+61	" "	" "	10	2586+45	" "	Minor Str.	2	
2317+00	" "	Minor Str.	2	2597+15	" "	" "	2	
2382+25	Lt.&Rt.	Minor Str.	2	2617+90 to 2619+90	Rt.	50 ft.	5	
2432+00	" "	" "	2	2619+80	Lt.	Minor Str.	1	
2458+33	" "	" "	2	2624+00	Lt.&Rt.	" "	2	
2509+00	" "	" "	2	2620+80 to 2622+80	Rt.	50 ft.	5	
2521+00	Lt.&Rt.	Minor Str.	2	2630+90	Lt.&Rt.	Minor Str.	2	
2555+60 to 2556+20	" "	30 ft.	6	2646+35	" "	" "	2	
2561+91 to 2564+41	" "	50 ft.	12	2676+60	" "	" "	2	
<b>TOTAL</b>			<b>TOTAL</b>			<b>95</b>		

Scale 1"=20'

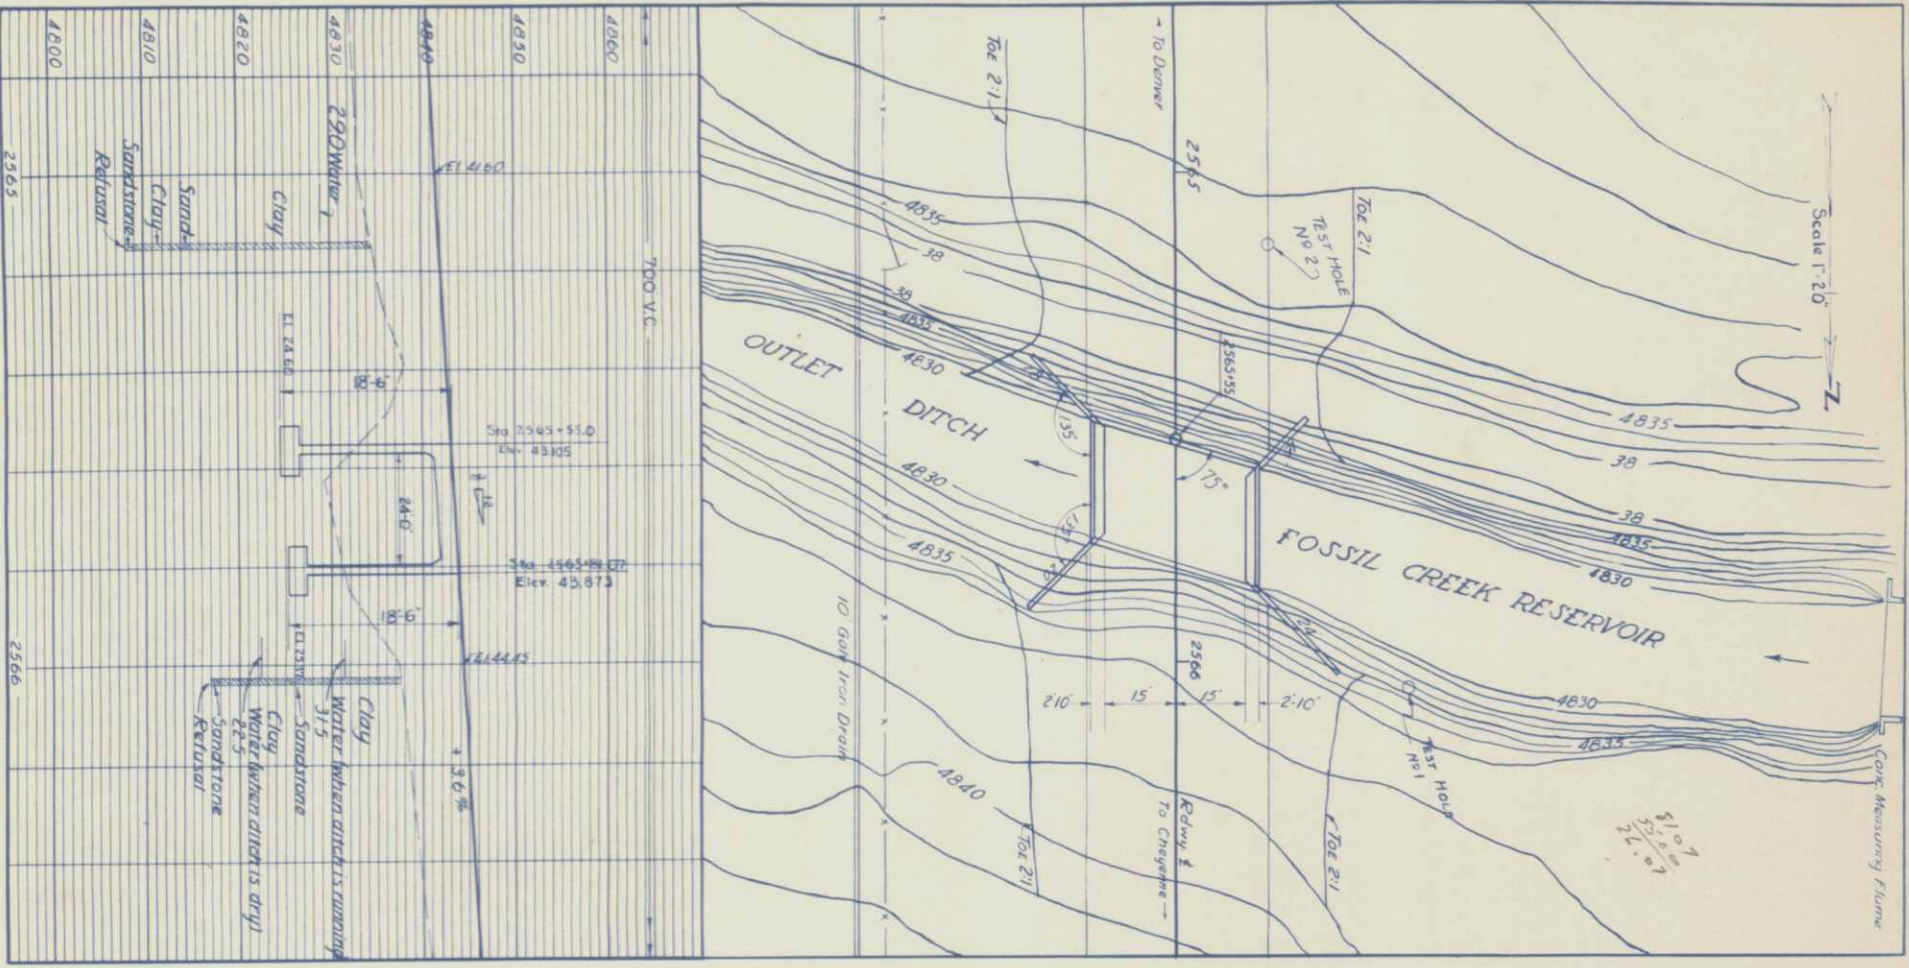

GENERAL LAYOUT









BAR LIST - ABUT. NO. 1

Mark	Size	No.	Length	Type	L	m	n	r	t	Mark	Size	No.	Length	Type	L	m	r	t
A1	1"	4	7'-2"	I	5'-6"			4"	7 1/2"	B5	1"	1	2'-0"	I				
A2	1"	38	8'-2"	I	6'-6"			4"	7 1/2"	B19	1"	1	of 10'-2'-0"	Str.				
A3	1"	4	10'-2"	I	8'-6"			4"	7 1/2"	B20	1"	1	7'-11"	Str.				
A4	1"	38	11'-9"	I	10'-1"			4"	7 1/2"	B21	1"	1	of 9'-0"	Str.				
A5	1"	1	18'-8"	I	13'-1"			4"	7 1/2"	B22	1"	1	of 10'-3'-6"	Str.				
A6	1"	of 10'-3'-6"	II	10'-11 1/2"	to 3'-6"			4"	3 1/2"	B23	1"	1	of 10'-3'-6"	Str.				
A7	1"	ea.	by 8 1/2"	II	by 6 1/2"	by 1 1/2"		4"	3 1/2"	B24	1"	1	of 9'-0"	Str.				
A8	1"	12	11'-8"	Str.				4"	3 1/2"	B25	1"	1	of 10'-3'-6"	Str.				
A9	1"	1	2'-4"	Str.				4"	3 1/2"	B26	1"	1	of 10'-3'-6"	Str.				
A10	1"	of 10'-1"	Str.					4"	3 1/2"	B27	1"	1	of 10'-3'-6"	Str.				
A11	1"	ea.	by 2'-7"	II	17'-4"	3'-8"		4"	3 1/2"	B28	1"	1	of 10'-3'-6"	Str.				
A12	1"	4	23'-11"	II	17'-4"	3'-8"		4"	3 1/2"	B29	1"	1	of 10'-3'-6"	Str.				
A13	1"	6	6'-0"	Str.				4"	3 1/2"	B30	1"	1	of 10'-3'-6"	Str.				
A14	1"	14	22'-11"	IV	17'-3"	5'-8"	2'-10"	4"	3 1/2"	B31	1"	1	of 10'-3'-6"	Str.				
A15	1"	14	22'-4"	IV	17'-3"	5'-1"	4'-4 1/2"	4"	3 1/2"	B32	1"	1	of 10'-3'-6"	Str.				
A16	1"	4	24'-3"	II	17'-8"	3'-8"		4"	3 1/2"	B33	1"	1	of 10'-3'-6"	Str.				
A17	1"	22	22'-9"	II	16'-2"	3'-8"		4"	3 1/2"	B34	1"	1	of 10'-3'-6"	Str.				
A18	1"	28	10'-6"	III	8'-6"			4"	3 1/2"	B35	1"	1	of 10'-3'-6"	Str.				
A19	1"	13	36'-0"	Str.				4"	3 1/2"	B36	1"	1	of 10'-3'-6"	Str.				
A20	1"	89	7'-10"	I	6'-10"			4"	3 1/2"	B37	1"	1	of 10'-3'-6"	Str.				
A21	1"	4	23'-11"	IV	17'-3"	5'-1"	4'-4 1/2"	4"	3 1/2"	B38	1"	1	of 10'-3'-6"	Str.				
A22	1"	4	24'-3"	II	17'-8"	3'-8"		4"	3 1/2"	B39	1"	1	of 10'-3'-6"	Str.				
A23	1"	22	22'-9"	II	16'-2"	3'-8"		4"	3 1/2"	B40	1"	1	of 10'-3'-6"	Str.				
A24	1"	28	10'-6"	III	8'-6"			4"	3 1/2"	B41	1"	1	of 10'-3'-6"	Str.				
A25	1"	13	36'-0"	Str.				4"	3 1/2"	B42	1"	1	of 10'-3'-6"	Str.				
A26	1"	89	7'-10"	I	6'-10"			4"	3 1/2"	B43	1"	1	of 10'-3'-6"	Str.				
A27	1"	4	23'-11"	IV	17'-3"	5'-1"	4'-4 1/2"	4"	3 1/2"	B44	1"	1	of 10'-3'-6"	Str.				
A28	1"	4	24'-3"	II	17'-8"	3'-8"		4"	3 1/2"	B45	1"	1	of 10'-3'-6"	Str.				
A29	1"	22	22'-9"	II	16'-2"	3'-8"		4"	3 1/2"	B46	1"	1	of 10'-3'-6"	Str.				
A30	1"	28	10'-6"	III	8'-6"			4"	3 1/2"	B47	1"	1	of 10'-3'-6"	Str.				
A31	1"	13	36'-0"	Str.				4"	3 1/2"	B48	1"	1	of 10'-3'-6"	Str.				
A32	1"	89	7'-10"	I	6'-10"			4"	3 1/2"	B49	1"	1	of 10'-3'-6"	Str.				
A33	1"	4	23'-11"	IV	17'-3"	5'-1"	4'-4 1/2"	4"	3 1/2"	B50	1"	1	of 10'-3'-6"	Str.				
A34	1"	4	24'-3"	II	17'-8"	3'-8"		4"	3 1/2"	B51	1"	1	of 10'-3'-6"	Str.				
A35	1"	22	22'-9"	II	16'-2"	3'-8"		4"	3 1/2"	B52	1"	1	of 10'-3'-6"	Str.				
A36	1"	28	10'-6"	III	8'-6"			4"	3 1/2"	B53	1"	1	of 10'-3'-6"	Str.				
A37	1"	13	36'-0"	Str.				4"	3 1/2"	B54	1"	1	of 10'-3'-6"	Str.				
A38	1"	89	7'-10"	I	6'-10"			4"	3 1/2"	B55	1"	1	of 10'-3'-6"	Str.				
A39	1"	4	23'-11"	IV	17'-3"	5'-1"	4'-4 1/2"	4"	3 1/2"	B56	1"	1	of 10'-3'-6"	Str.				
A40	1"	4	24'-3"	II	17'-8"	3'-8"		4"	3 1/2"	B57	1"	1	of 10'-3'-6"	Str.				
A41	1"	22	22'-9"	II	16'-2"	3'-8"		4"	3 1/2"	B58	1"	1	of 10'-3'-6"	Str.				
A42	1"	28	10'-6"	III	8'-6"			4"	3 1/2"	B59	1"	1	of 10'-3'-6"	Str.				
A43	1"	13	36'-0"	Str.				4"	3 1/2"	B60	1"	1	of 10'-3'-6"	Str.				
A44	1"	89	7'-10"	I	6'-10"			4"	3 1/2"	B61	1"	1	of 10'-3'-6"	Str.				
A45	1"	4	23'-11"	IV	17'-3"	5'-1"	4'-4 1/2"	4"	3 1/2"	B62	1"	1	of 10'-3'-6"	Str.				
A46	1"	4	24'-3"	II	17'-8"	3'-8"		4"	3 1/2"	B63	1"	1	of 10'-3'-6"	Str.				
A47	1"	22	22'-9"	II	16'-2"	3'-8"		4"	3 1/2"	B64	1"	1	of 10'-3'-6"	Str.				
A48	1"	28	10'-6"	III	8'-6"			4"	3 1/2"	B65	1"	1	of 10'-3'-6"	Str.				
A49	1"	13	36'-0"	Str.				4"	3 1/2"	B66	1"	1	of 10'-3'-6"	Str.				
A50	1"	89	7'-10"	I	6'-10"			4"	3 1/2"	B67	1"	1	of 10'-3'-6"	Str.				
A51	1"	4	23'-11"	IV	17'-3"	5'-1"	4'-4 1/2"	4"	3 1/2"	B68	1"	1	of 10'-3'-6"	Str.				
A52	1"	4	24'-3"	II	17'-8"	3'-8"		4"	3 1/2"	B69	1"	1	of 10'-3'-6"	Str.				
A53	1"	22	22'-9"	II	16'-2"	3'-8"		4"	3 1/2"	B70	1"	1	of 10'-3'-6"	Str.				
A54	1"	28	10'-6"	III	8'-6"			4"	3 1/2"	B71	1"	1	of 10'-3'-6"	Str.				
A55	1"	13	36'-0"	Str.				4"	3 1/2"	B72	1"	1	of 10'-3'-6"	Str.				
A56	1"	89	7'-10"	I	6'-10"			4"	3 1/2"	B73	1"	1	of 10'-3'-6"	Str.				
A57	1"	4	23'-11"	IV	17'-3"	5'-1"	4'-4 1/2"	4"	3 1/2"	B74	1"	1	of 10'-3'-6"	Str.				
A58	1"	4	24'-3"	II	17'-8"	3'-8"		4"	3 1/2"	B75	1"	1	of 10'-3'-6"	Str.				
A59	1"	22	22'-9"	II	16'-2"	3'-8"		4"	3 1/2"	B76	1"	1	of 10'-3'-6"	Str.				
A60	1"	28	10'-6"	III	8'-6"			4"	3 1/2"	B77	1"	1	of 10'-3'-6"	Str.				
A61	1"	13	36'-0"	Str.				4"	3 1/2"	B78	1"	1	of 10'-3'-6"	Str.				
A62	1"	89	7'-10"	I	6'-10"			4"	3 1/2"	B79	1"	1	of 10'-3'-6"	Str.				
A63	1"	4	23'-11"	IV	17'-3"	5'-1"	4'-4 1/2"	4"	3 1/2"	B80	1"	1	of 10'-3'-6"	Str.				
A64	1"	4	24'-3"	II	17'-8"	3'-8"		4"	3 1/2"	B81	1"	1	of 10'-3'-6"	Str.				
A65	1"	22	22'-9"	II	16'-2"	3'-8"		4"	3 1/2"	B82	1"	1	of 10'-3'-6"	Str.				
A66	1"	28	10'-6"	III	8'-6"			4"	3 1/2"	B83	1"	1	of 10'-3'-6"	Str.				
A67	1"	13	36'-0"	Str.				4"	3 1/2"	B84	1"	1	of 10'-3'-6"	Str.				
A68	1"	89	7'-10"	I	6'-10"			4"	3 1/2"	B85	1"	1	of 10'-3'-6"	Str.				
A69	1"	4	23'-11"	IV	17'-3"	5'-1"	4'-4 1/2"	4"	3 1/2"	B86	1"	1	of 10'-3'-6"	Str.				
A70	1"	4	24'-3"	II	17'-8"	3'-8"		4"	3 1/2"	B87	1"	1	of 10'-3'-6"	Str.				
A71	1"	22	22'-9"	II	16'-2"	3'-8"		4"	3 1/2"	B88	1"	1	of 10'-3'-6"	Str.				
A72	1"	28	10'-6"	III	8'-6"			4"	3 1/2"	B89	1"	1	of 10'-3'-6"	Str.				
A73	1"	13	36'-0"	Str.				4"	3 1/2"	B90	1"	1	of 10'-3'-6"	Str.				
A74	1"	89	7'-10"	I	6'-10"			4"	3 1/2"	B91	1"	1	of 10'-3'-6"	Str.				
A75	1"	4	23'-11"	IV	17'-3"	5'-1"	4'-4 1/2"	4"	3 1/2"	B92	1"	1	of 10'-3'-6"	Str.				
A76	1"	4	24'-3"	II	17'-8"	3'-8"		4"	3 1/2"	B93	1"	1	of 10'-3'-6"	Str.				
A77	1"	22	22'-9"	II	16'-2"	3'-8"		4"	3 1/2"	B94	1"	1	of 10'-3'-6"	Str.				
A78	1"	28	10'-6"	III	8'-6"			4"	3 1/2"	B95	1"	1	of 10'-3'-6"	Str.				
A79	1"	13	36'-0"	Str.				4"	3 1/2"	B96	1"	1	of 10'-3'-6"	Str.				
A80	1"	89	7'-10"	I	6'-10"			4"	3 1/2"	B97	1"	1	of 10'-3'-6"	Str.				
A81	1"	4	23'-11"															

REVISIONS

FED. ROAD DIST. NO.	STATE	SN. FAP NO.	SHEET NO.	TOTAL SHEETS
3	COLO.	AA BU)	9	

HANDRAIL ELEVATION

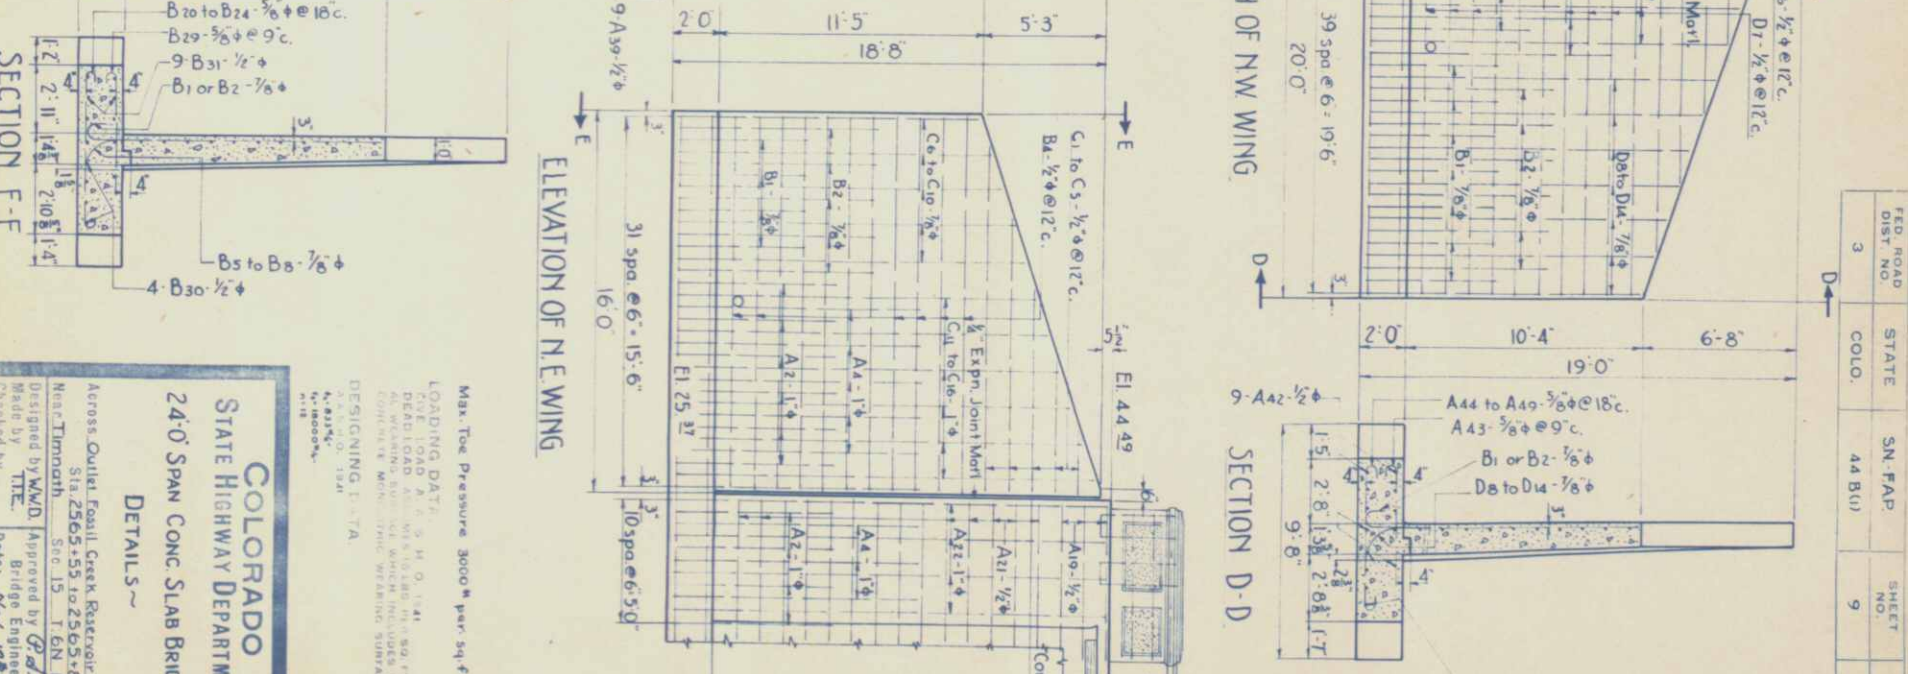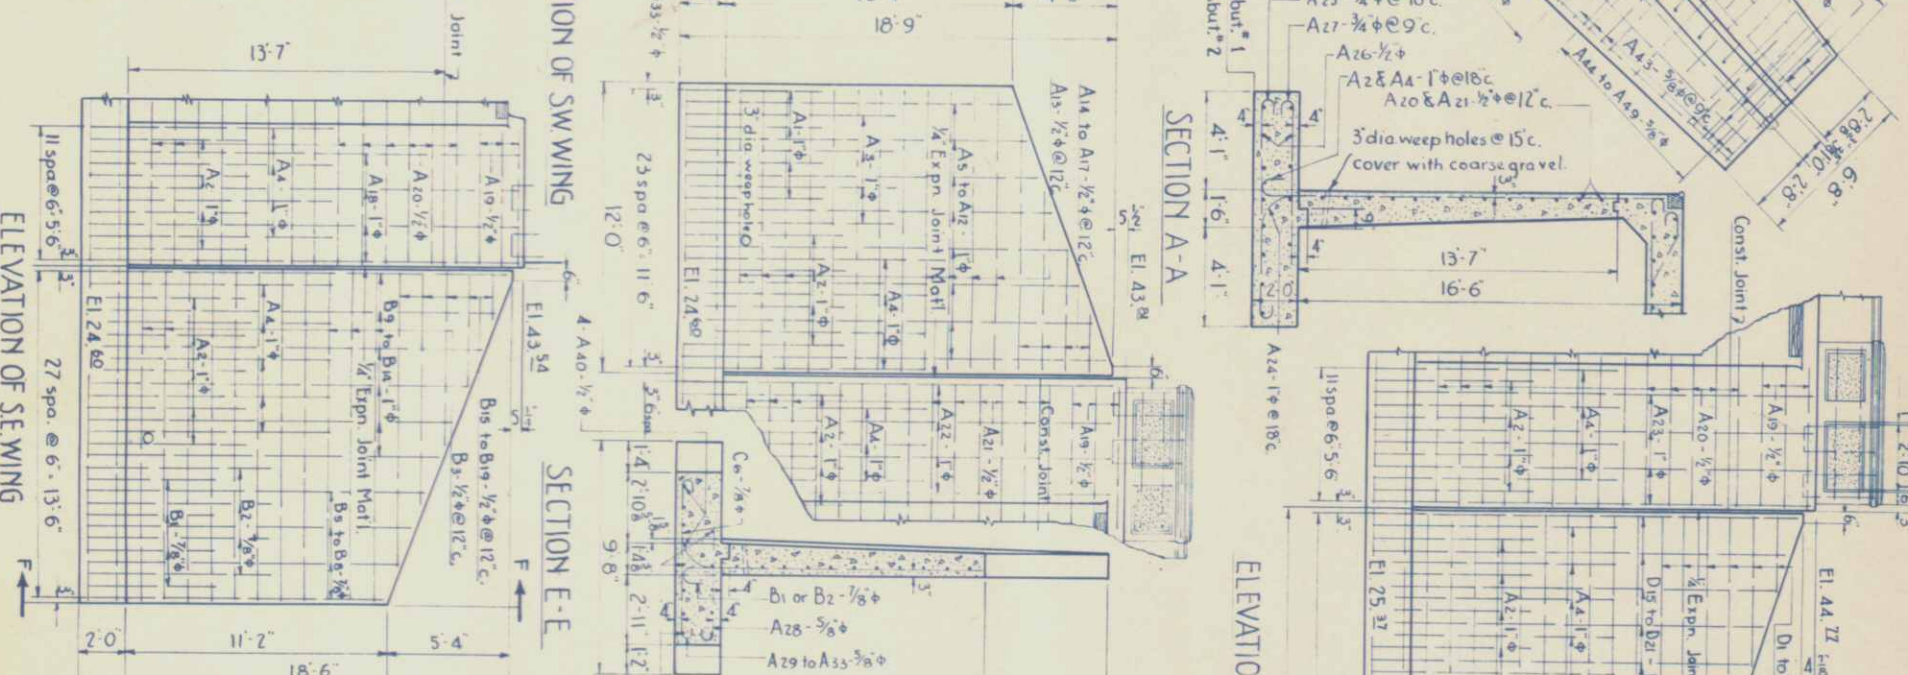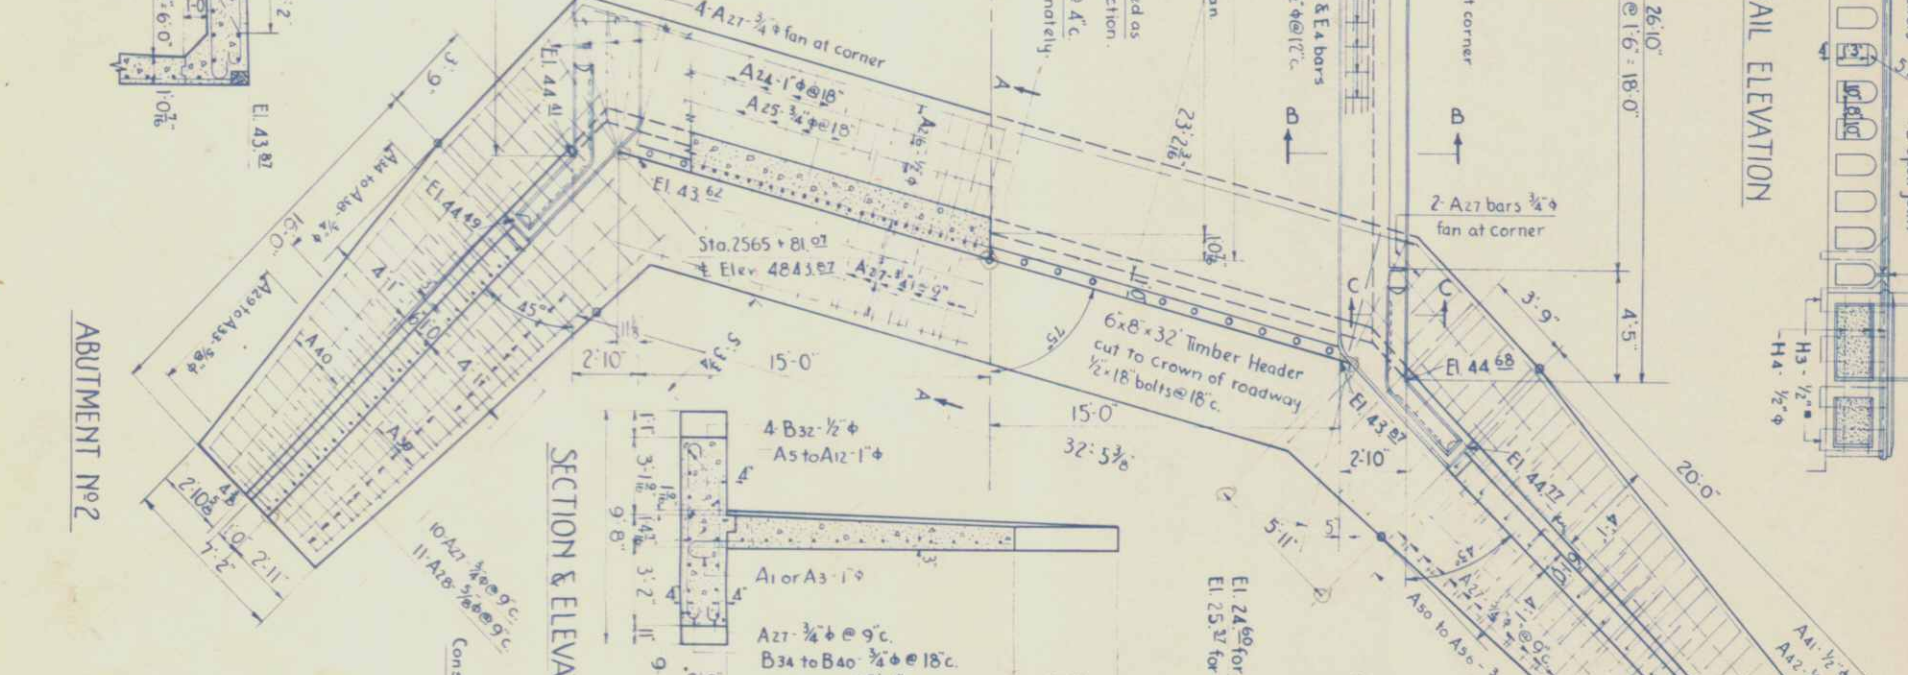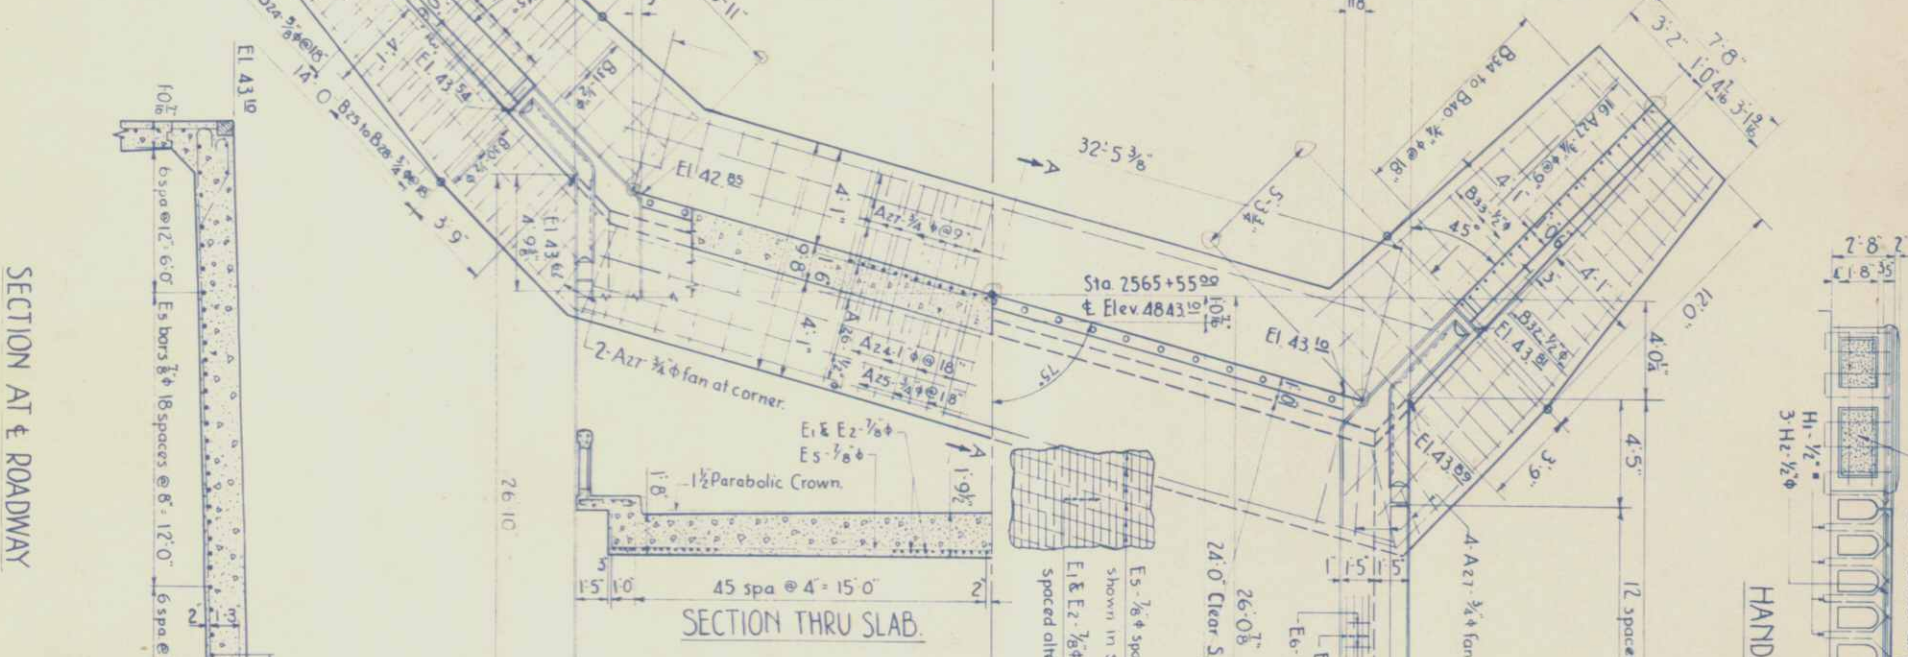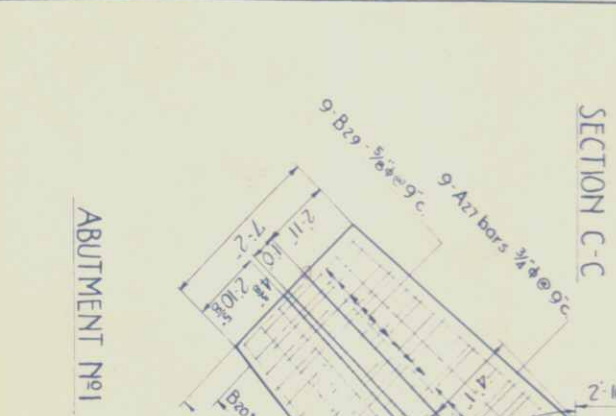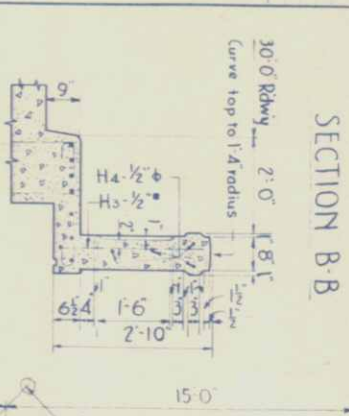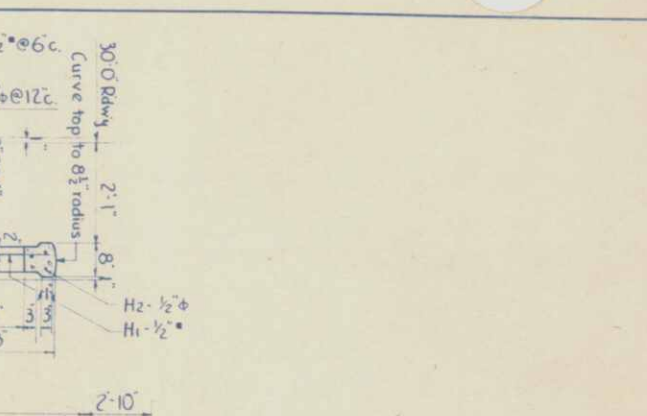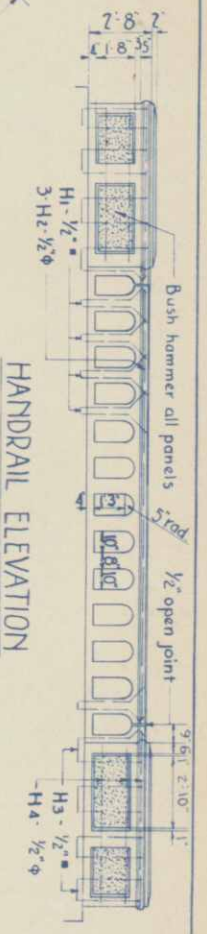



**COLORADO STATE HIGHWAY DEPARTMENT**  
**24'-0" SPAN CONC. SLAB BRIDGE**  
 DETAILS

Across Outlet Fossil Creek Reservoir  
 Sta. 2565+59 to 2565+81.07  
 Near Timnath, Sec. 15, T. 6N. R. 68W.  
 Designed by W.M.D. Approved by G.D. Beckley  
 Made by T.T.E. Bridge Engineering  
 Checked by T.T.E. Date: Nov. 12, 1961.

Max. Toe Pressure 3000# per sq. ft.  
 LOADING DATE: 2-1-61  
 CONCRETE: 4000#  
 DESIGNING: T.T.A.  
 DRAWING: T.T.A.

STRUCTURE NO. C-17-EC

FED. ROAD DIST. NO.	STATE	SN. FAP. (44 BU)	SHEET NO.	TOTAL SHEETS
3	COLO.	44 BU	9	

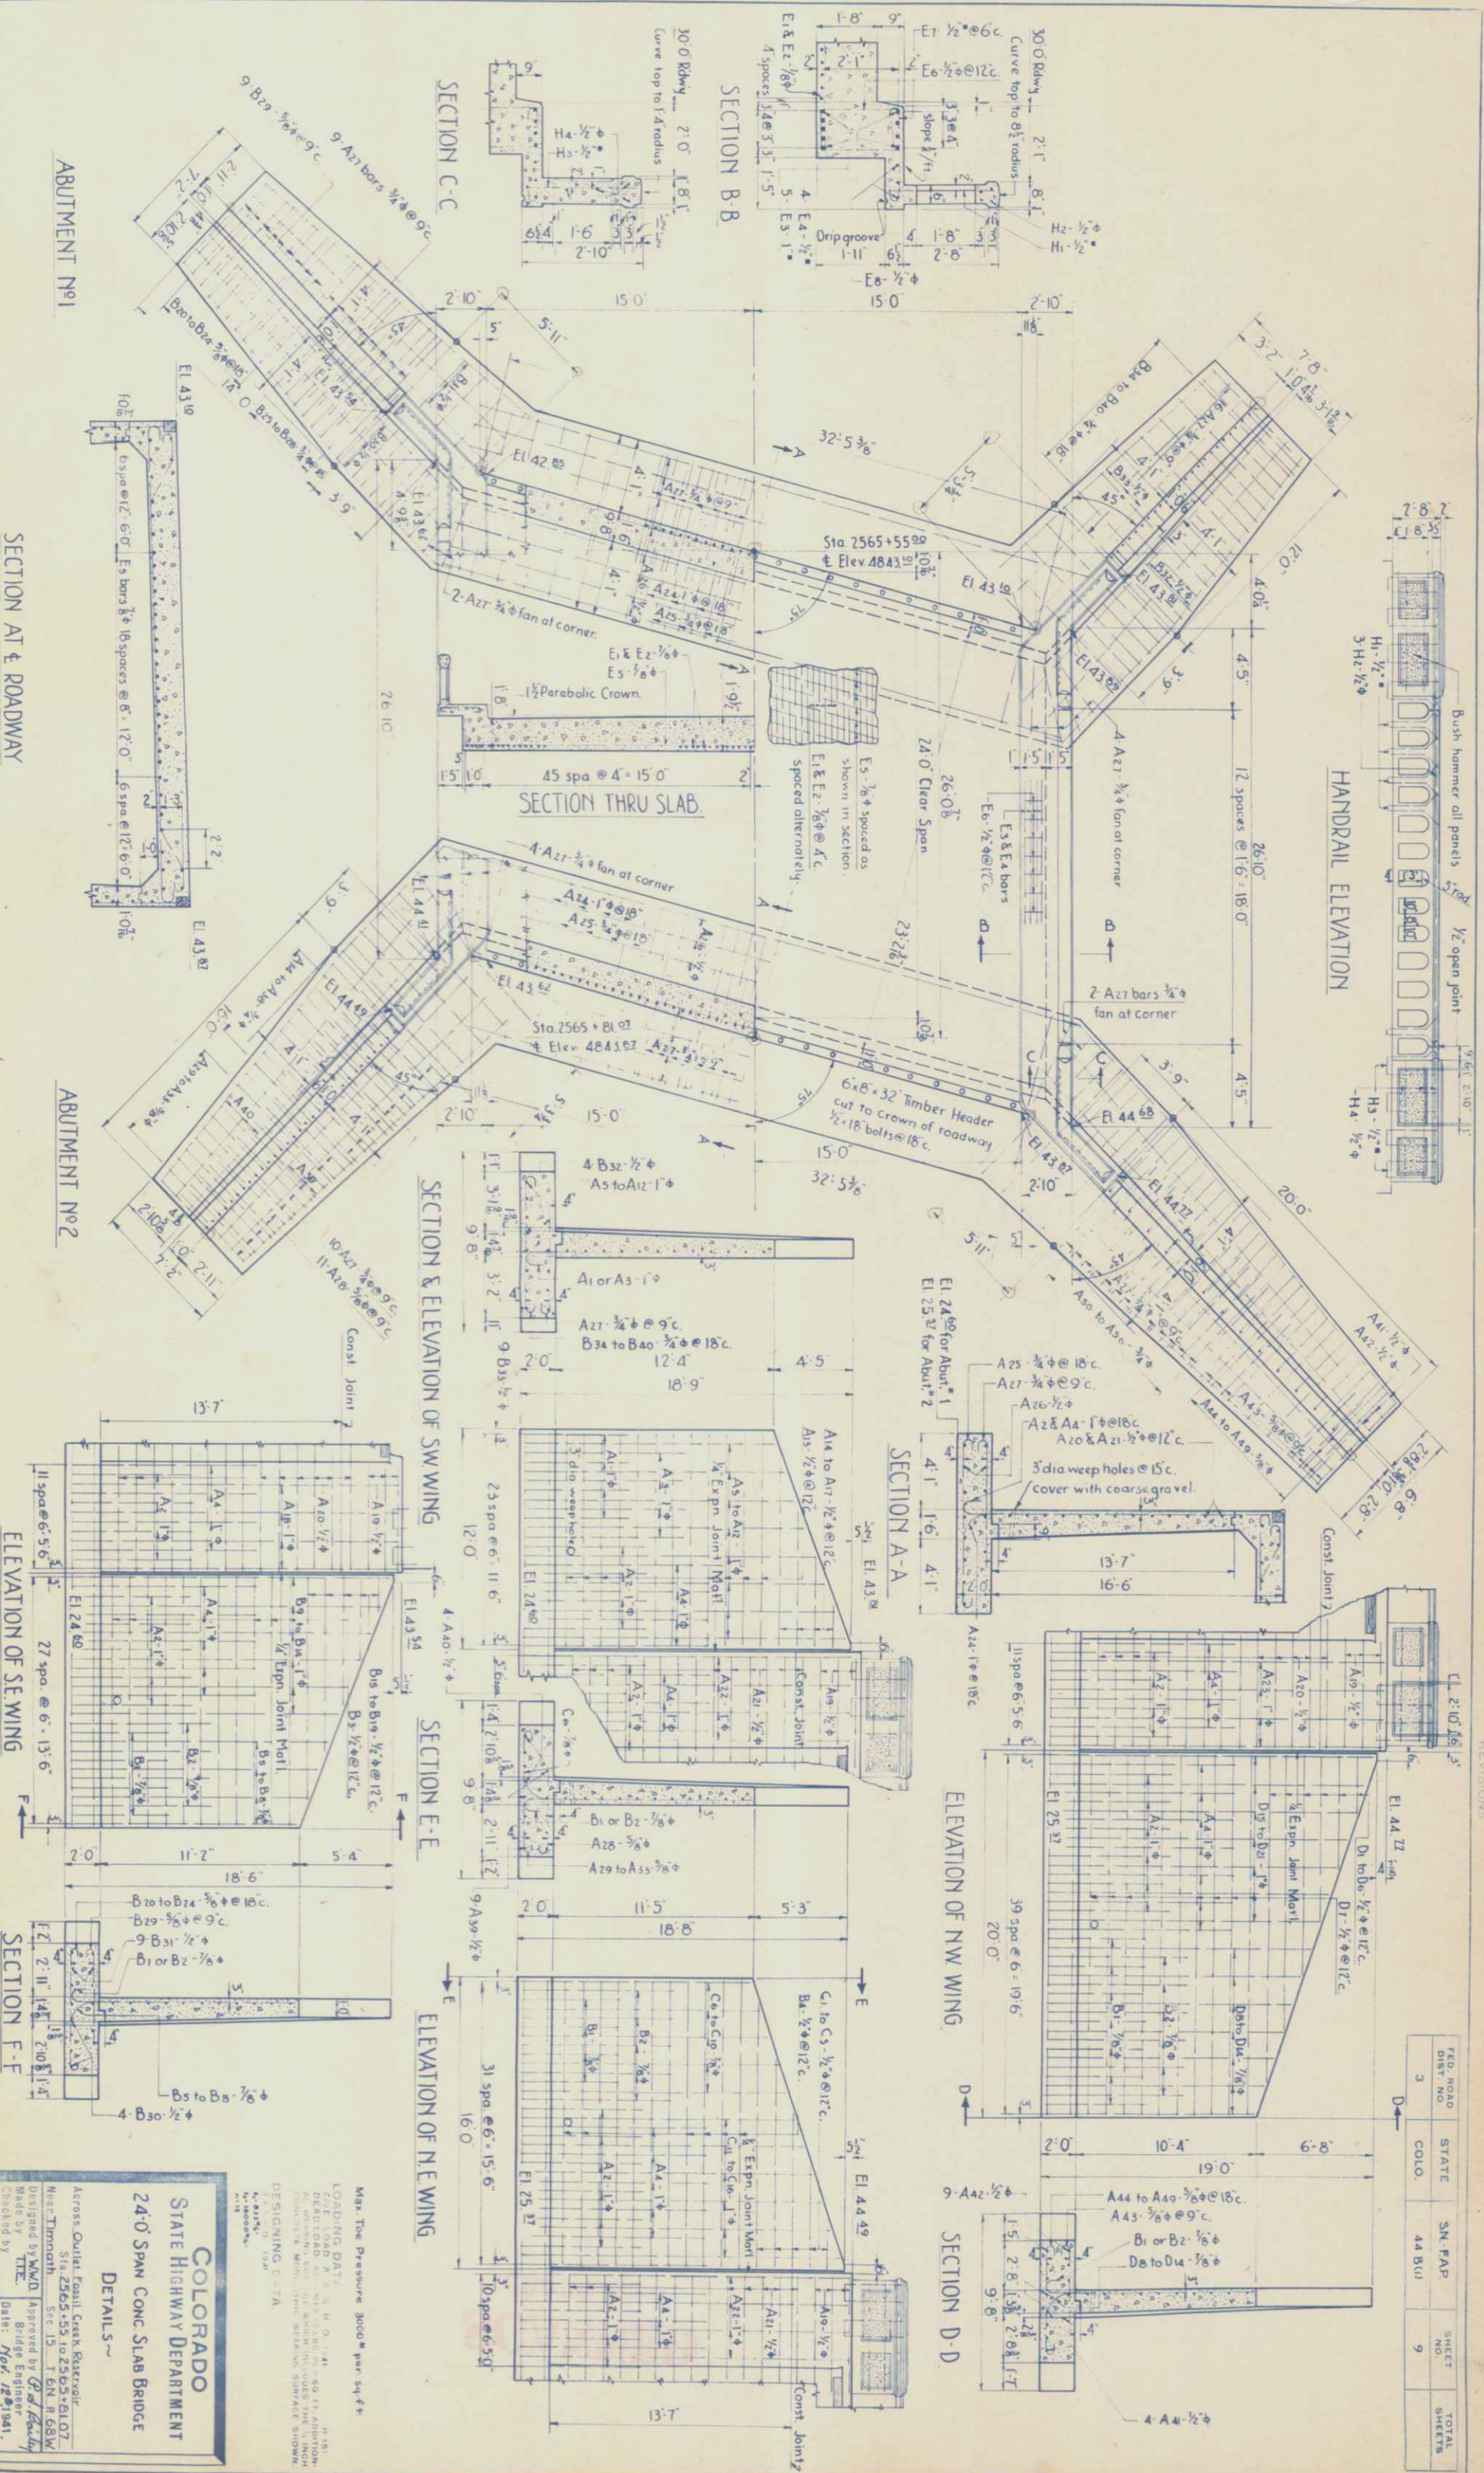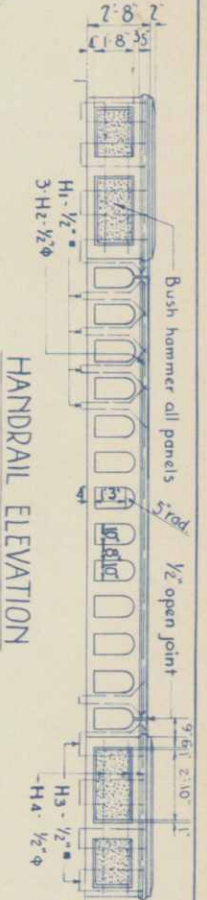

**COLORADO**  
**STATE HIGHWAY DEPARTMENT**  
**24'0" SPAN CONC. SLAB BRIDGE**  
 DETAILS

Across Outlet Front Creek, Ratonior,  
 Sta. 2565+55.10 to 2565+81.07  
 Near Timbath  
 Sec. 15 T. 6N. R. 68W.  
 Designed by W.M.D. Approved by G.P. Kelly  
 Made by T.E. Bridge Engineer  
 Checked by T.E. Date: Nov. 12, 1991

Max. Toe Pressure 3000# per sq.ft.  
 LOADING DATA:  
 LIVE LOAD AASHTO HS 20 (144)  
 DEAD LOAD AS PER SECTION 101-10.1  
 ALL WEARING SURF OR WHICH INCLUDES THE 1/4" INCH  
 2000 PSI MINIMUM MIXING STRENGTH SHOWS  
 DESIGNING D.T.A.  
 12/19/91

STRUCTURE NO. C-172C

ELEVATION OF SE WING


ABUTMENT NO. 2

SECTION AT ROADWAY

ABUTMENT NO. 1

REVISIONS

FED. ROAD DIST. NO.	STATE	S.N. F.A.P.	SHEET NO.	TOTAL SHEETS
3	COLO.	44 B111	10	

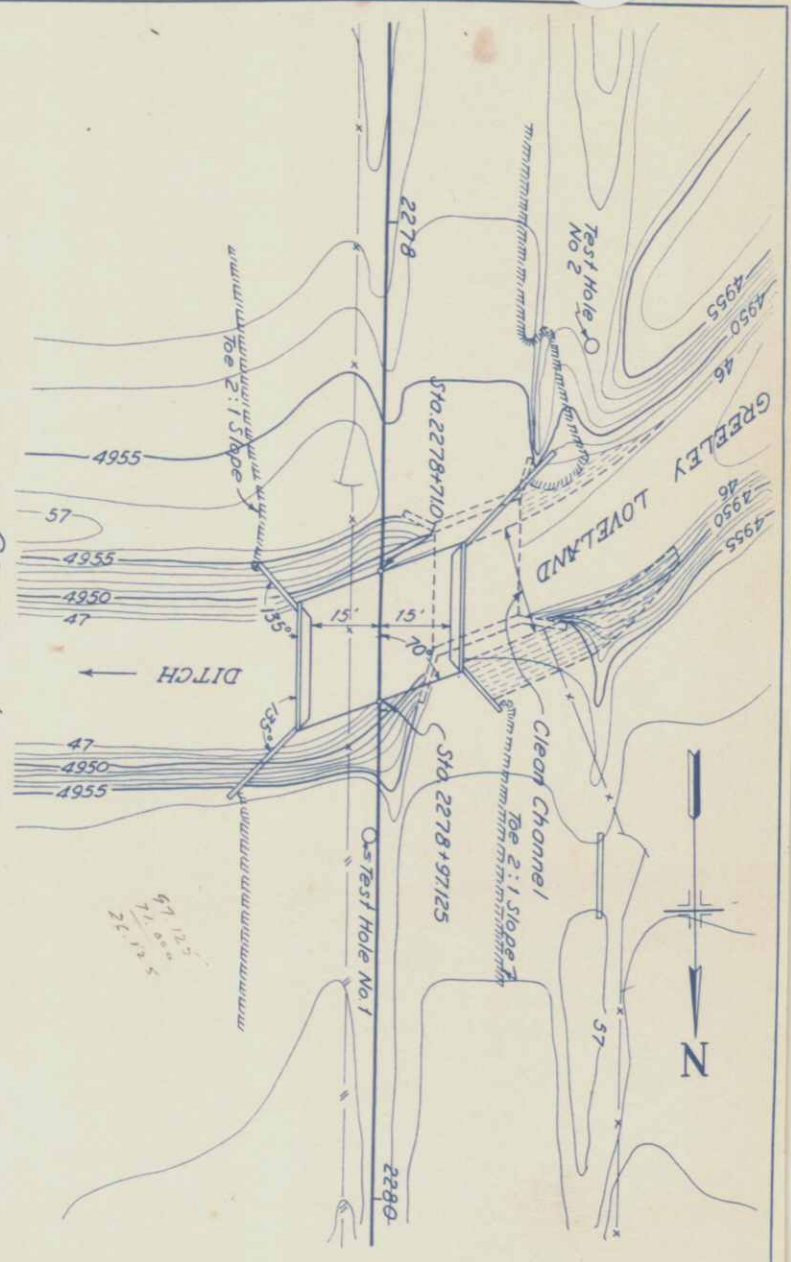





MARK	SIZE	NO.	LENGTH	TYPE	ℓ	m	r	t
H1	1/2"	44	6'-8"	I				
H2	1/2"	16	6'-3"	STRAIGHT FIELD BEND				
H3	1/2"	4	3'-9"					
H4	1/2"	16	10'-2"					
E1	3/8"	45	27'-4"	II	25'-0"		3 1/2	3"
E2	3/8"	45	26'-11"	III			3 1/2	3"
E3	1"	10	27'-7"	IV	24'-11"	4"	3 1/2	3"
E4	3/4"	8	7'-3"	IV			3 1/2	3"
E5	3/4"	8	24'-0"	STN			2'-2"	2"
E6	1/2"	108	3'-6"	II			2"	2"
E7	1/2"	4	27'-0"	STN				
D1	3/8"	29	34'-6"	STN				

MARK	SIZE	NO.	REGRD.	LENGTH	TYPE	ℓ	m	r	t
A1	1"	2	22	19'-7"	V	16'-2"	0'-6"	4"	3 1/2
A2	1"	30	30	13'-11"	V	9'-2"	1'-10"	4"	3 1/2
A3	1"	30	30	12'-1"	V	3'-6"	3'-8"	4"	3 1/2
A4	3/4"	15	15	23'-3"	VII				
A5	3/4"	15	15	23'-5"	VII				
A6	1"	7	7	20'-10"	V	17'-5"	0'-6"	4"	3 1/2
A7	3/4"	7	7	5'-0"	STN				
A8	3/4"	9	9	5'-0"	STN				
A9	1"	1	1	20'-4"		16'-11"			
A10	1"	1	1	18'-7"	V	16'-7"	0'-6"	4"	3 1/2
A11	3/4"	2	2	15'-2"	V	14'-7"	0'-6"	3 1/2	3"
A12	3/4"	2	2	13'-8"	V	9'-0"	1'-9"	4"	3 1/2
A13	3/4"	3	3	11'-10"	V	7'-0"	1'-9"	3 1/2	3"
A14	3/4"	1	1	10'-11"	V	5'-3"	3'-7"	4"	3 1/2
A15	3/4"	1	1	10'-9"	V	4'-8"	3'-6"	3 1/2	3"
A16	3/4"	1	1	10'-7"	V	4'-8"	3'-4"	3 1/2	3"
A17	3/4"	1	1	10'-7"	V	4'-8"	3'-2"	3 1/2	3"
A18	3/4"	1	1	6'-8"	STN				
A19	3/4"	1	1	2'-0"					
A20	3/4"	1	1	6'-8"					
A21	3/4"	1	1	20'-4"					
A22	3/4"	1	1	18'-7"	V	16'-7"	0'-6"	4"	3 1/2
A23	3/4"	2	2	15'-2"	V	14'-7"	0'-6"	3 1/2	3"
A24	3/4"	2	2	13'-8"	V	9'-0"	1'-9"	4"	3 1/2
A25	3/4"	3	3	11'-10"	V	7'-0"	1'-9"	3 1/2	3"
A26	3/4"	1	1	10'-9"	V	5'-3"	3'-7"	4"	3 1/2
A27	3/4"	1	1	10'-7"	V	4'-8"	3'-6"	3 1/2	3"
A28	3/4"	1	1	10'-7"	V	4'-8"	3'-4"	3 1/2	3"
A29	3/4"	1	1	6'-8"	STN				
A30	3/4"	1	1	2'-0"					
A31	3/4"	1	1	6'-8"					
A32	3/4"	1	1	20'-4"					
A33	3/4"	1	1	18'-7"	V	16'-7"	0'-6"	4"	3 1/2

MARK	SIZE	NO.	REGRD.	LENGTH	TYPE	ℓ	m	r	t
C2	3/8"	1	1	13'-0"	I	10'-11"	0'-6"	2 1/2	2
C3	3/8"	1	1	13'-4"	I	10'-5"	0'-6"	2 1/2	2
C4	1"	1	1	12'-9"	I	9'-10"	0'-6"	2 1/2	2
C5	1"	3	3	13'-10"	I	9'-2"	1'-9"	4"	3 1/2
C6	3/8"	4	4	11'-10"	I	7'-7"	1'-6"	3 1/2	3
C7	3/8"	4	4	10'-3"	V	6'-5"	1'-0"	3"	2 1/2
C8	3/8"	3	3	9'-1"	V	5'-8"	1'-0"	3"	2 1/2
C9	1"	2	2	11'-11"	I	5'-6"	3'-6"	4"	3 1/2
C10	3/8"	2	2	10'-6"	I	4'-8"	3'-6"	3 1/2	3"
C11	3/8"	2	2	9'-7"	I	4'-1"	2'-11"	3"	2 1/2
C12	3/8"	2	2	8'-2"	I	3'-6"	2'-8"	3"	2 1/2
C13	3/8"	3	3	9'-1"	I	3'-6"	2'-8"	3"	2 1/2
C14	3/8"	2	2	7'-11"	I	3'-6"	2'-0"	2 1/2	2
C15	3/8"	2	2	20'-8"	STN				
C16	3/8"	9	9	20'-8"	STN				
C17	1/2"	1	1	10'-6"	I	10'-3"			
C18	1/2"	1	1	13'-0"	I	10'-3"			
C19	1/2"	1	1	15'-9"	I	12'-8"			
C20	1/2"	1	1	18'-8"	I	16'-11"			
C21	3/8"	67	67	7'-11"	I	6'-11"			
C22	3/8"	30	30	7'-3"	I	6'-5"			
C23	3/8"	7	7	7'-8"	I	6'-8"			
C24	3/8"	3	3	7'-5"	I	6'-5"			
C25	3/8"	3	3	7'-2"	I	6'-2"			
C26	3/8"	3	3	7'-2"	I	6'-2"			
C27	3/8"	3	3	6'-2"	I	5'-4"			
C28	3/8"	3	3	5'-11"	I	5'-1"			
C29	3/8"	3	3	5'-8"	I	4'-10"			
C30	3/8"	4	4	6'-10"	I	6'-3"			
C31	3/8"	4	4	6'-10"	I	5'-9"			
C32	3/8"	3	3	6'-4"	I	5'-6"			
C33	3/8"	2	2	6'-4"	I	5'-6"			
C34	3/8"	2	2	6'-1"	I	5'-9"			
C35	3/8"	2	2	6'-1"	I	5'-9"			
C36	3/8"	2	2	5'-7"	I	5'-10"			
C37	3/8"	2	2	5'-7"	I	4'-9"			
C38	3/8"	2	2	5'-7"	I	4'-9"			
C39	3/8"	2	2	6'-8"	I	5'-10"			
C40	3/8"	2	2	6'-8"	I	5'-10"			
DETAIL OF CONCRETE DIVISION BOX, RT. OF STA. 2271+

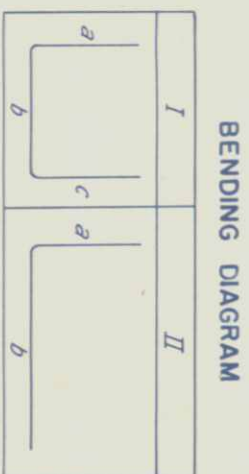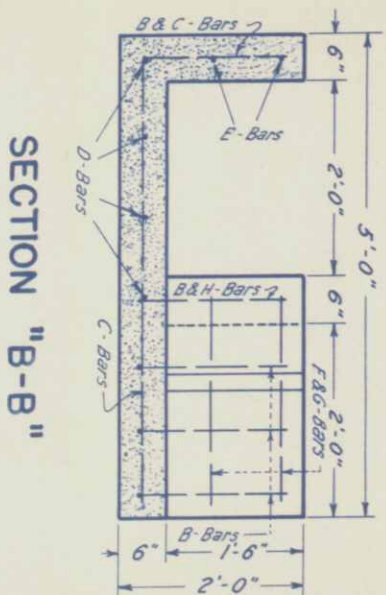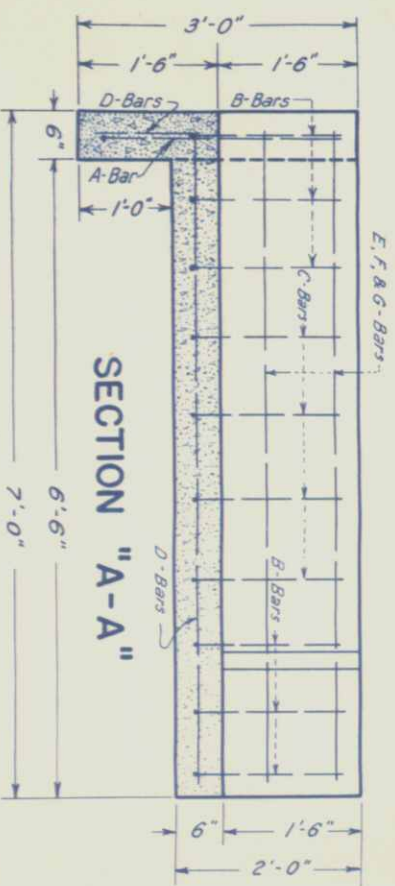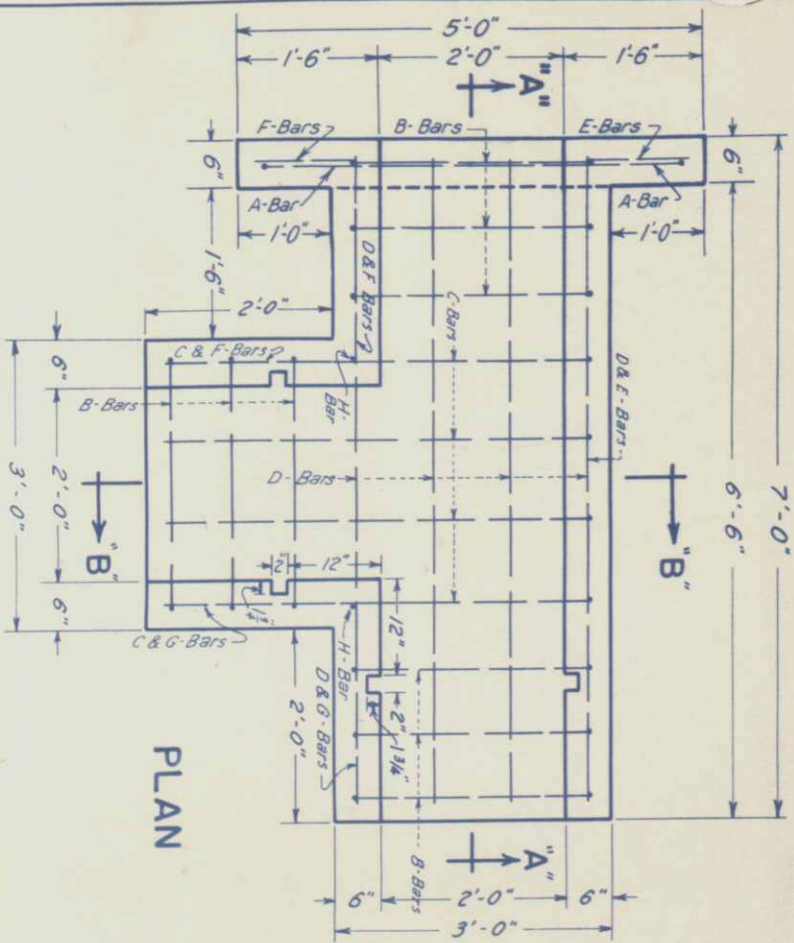

All Dimensions are to  $\phi$  of Bars

MARK	TYPE	SPACING	DIMENSION			NO. OF BARS	LENGTH OF ONE BAR	TOTAL LENGTH
			a	b	c			
A	I	8"	2'-7"	4'-6"	2'-7"	1	9'-8"	9'-8"
B	I	10"	1'-7"	2'-6"	1'-7"	4	51'-0"	51'-0"
C	II	10"	1'-7"	4'-7"	1'-7"	4	24'-8"	24'-8"
D	II	10"	1'-1"	6'-7"	1'-1"	4	7'-8"	30'-8"
E	II	9"	1'-1"	6'-7"	1'-1"	2	15'-4"	15'-4"
F	I	9"	1'-1"	2'-0"	2'-1"	2	5'-2"	10'-4"
G	II	9"	2'-1"	2'-1"	2'-1"	2	4'-2"	8'-4"
H	STRAIGHT					2	1'-8"	3'-4"
TOTAL							153'-4"	153'-4"

All bars  $\frac{1}{2} \phi @ 0.668$  lbs. per lin. ft.  
 153'-4" x 0.668 lbs. per lin. ft. = 103 lbs.  
 Plus 1%  $\frac{1}{2}$  for over-run = 1 lb.

Total Reinforcing Steel = 104 lbs.




3 pcs. 2" x 6" x 2'-3" Misc. Unfr. Timber for Flash Boards = 6.75 Bd. Ft.

1.1 Cu Yd. Class "A" Concrete

Note: All Reinforcing Bars are to be placed in center of Walls and Slabs.

FED. ROAD DIST. NO.	STATE	SN-FED/AID PROJ. NO.	SHEET NO.	TOTAL SHEETS
3	COLO.	44-8(1)	12	

DETAIL OF CONCRETE DIVISION BOX, LT. OF STA. 2465+

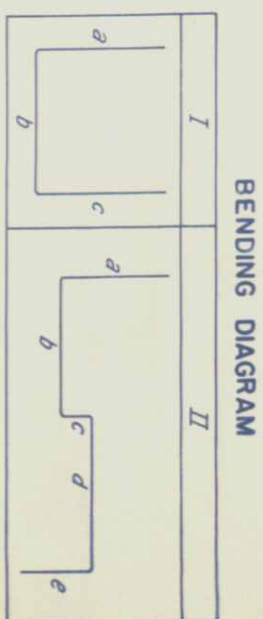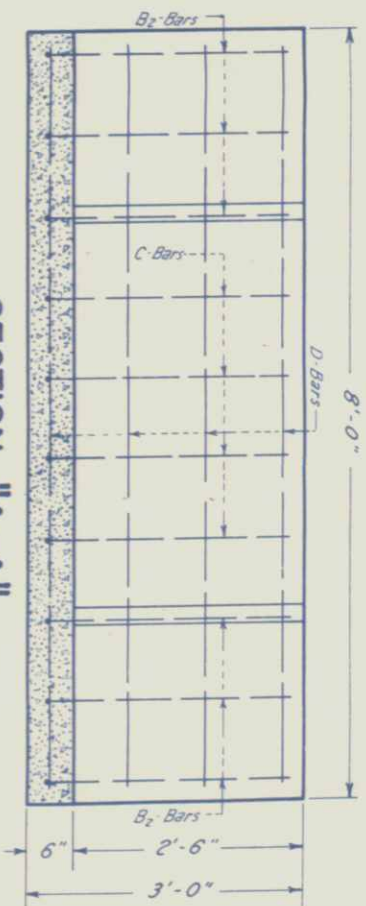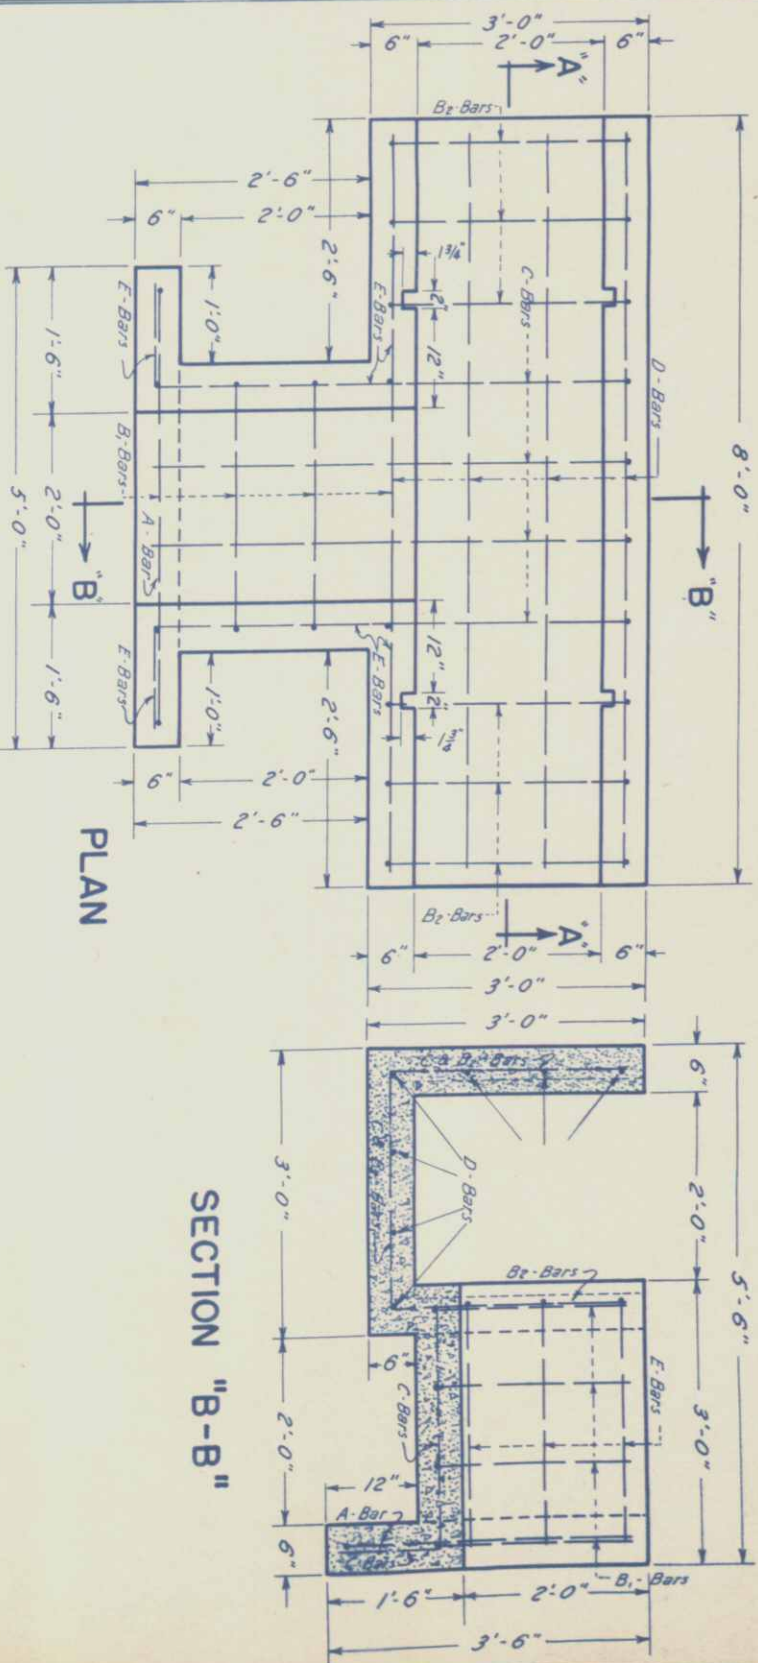

All Dimensions are to  $\phi$  of Bars

MARK	TYPE	SPACING	DIMENSION					NO. OF BARS	LENGTH OF ONE BAR	TOTAL LENGTH
			a	b	c	d	e			
A	I	see detail	3'-1"	4'-6"	3'-1"			1	10'-8"	10'-8"
B	I	10"	2'-1"	2'-6"	2'-1"			4	6'-8"	26'-8"
B <sub>1</sub>	I	10"	2'-7"	2'-6"	2'-7"			6	7'-8"	46'-0"
B <sub>2</sub>	II	10"	2'-7"	2'-6"	2'-7"			4	9'-2"	36'-8"
C	II	10"	2'-7"	2'-6"	6"	2'-6"	1'-1"	7	7'-8"	53'-8"
D	STRAIGHT	10"						6	6'-2"	37'-0"
E	I	10"	2'-7"	2'-6"	1'-1"					
TOTAL									210'-8"	210'-8"

All bars  $\frac{1}{2} \phi @ 0.668$  lbs. per lin. ft.

210'-8" x 0.668 lbs. per lin. ft. = 141 lbs.

Plus 1%  $\frac{1}{2}$  for over-run = 1 lb.

Total Reinforcing Steel = 142 lbs.



5 pcs. 2" x 6" x 2'-3" Misc. Unfr. Timber for Flash Boards = 11.25 Bd. Ft.

1.6 Cu Yd. Class "A" Concrete


Note: All Reinforcing Bars are to be placed in center of Walls and Slabs.




DETAILS OF SPECIAL INLET BOX FOR 18" SIPHON LT. OF STA. 2541+ 75

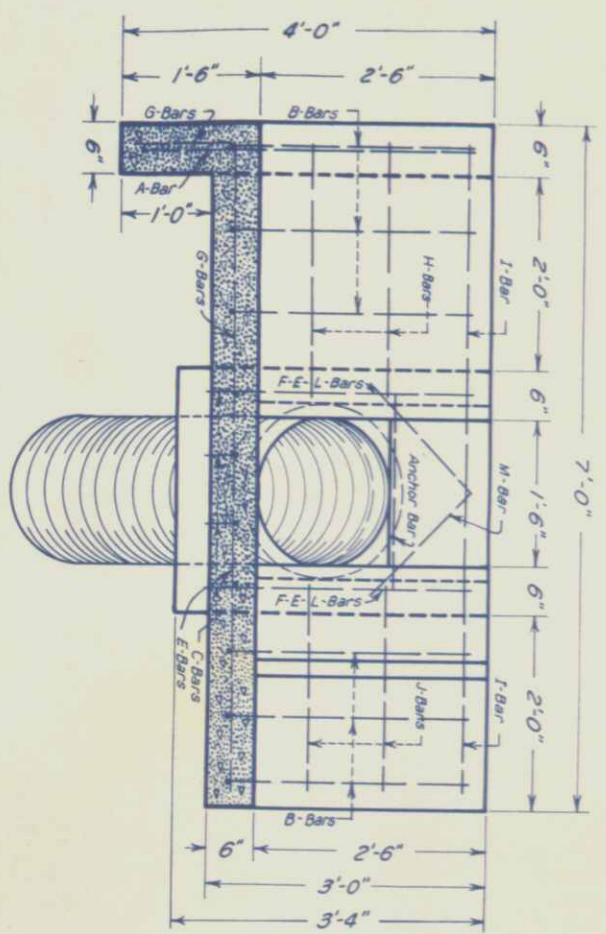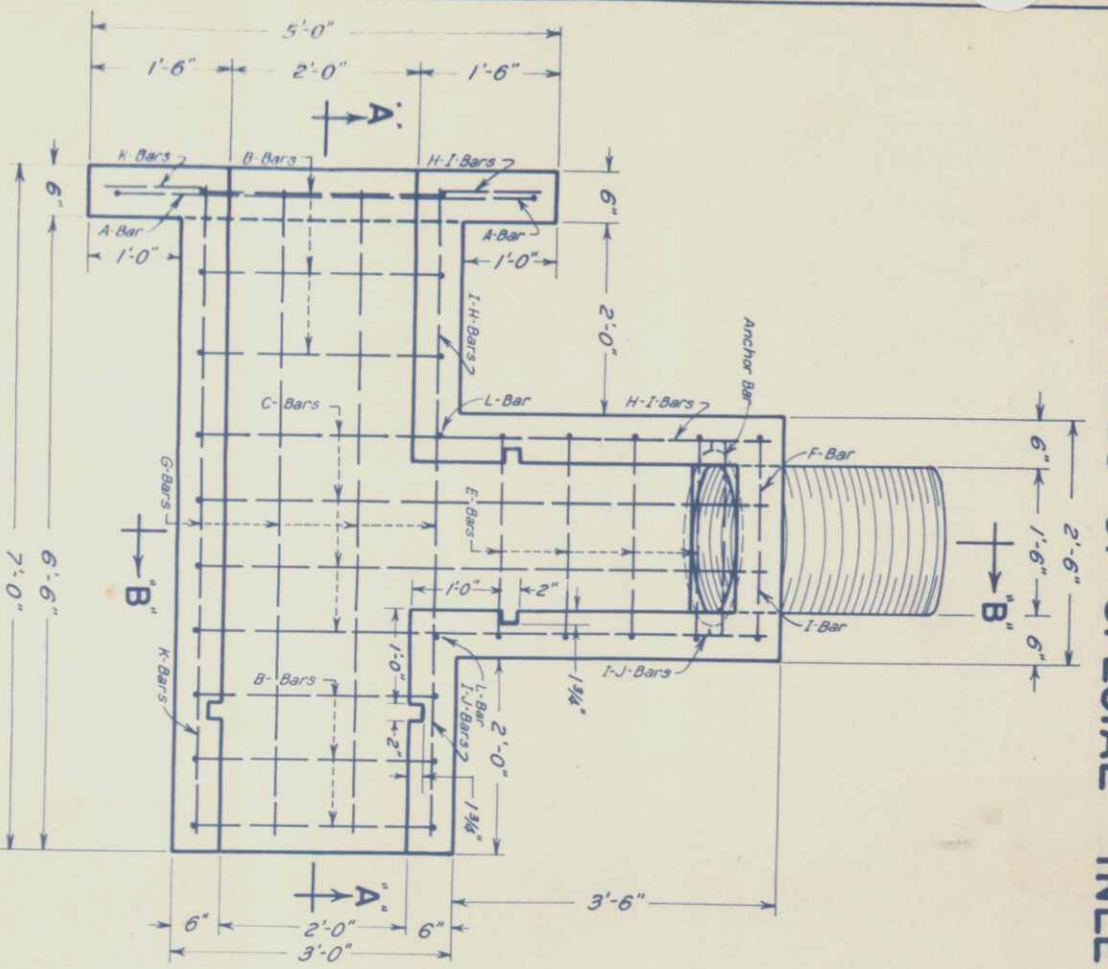

SECTION "A-A"

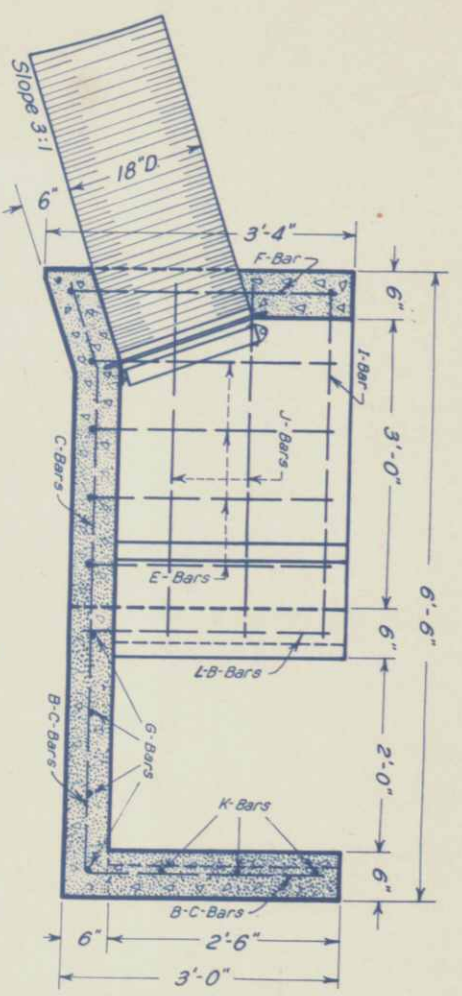

SECTION "B-B"

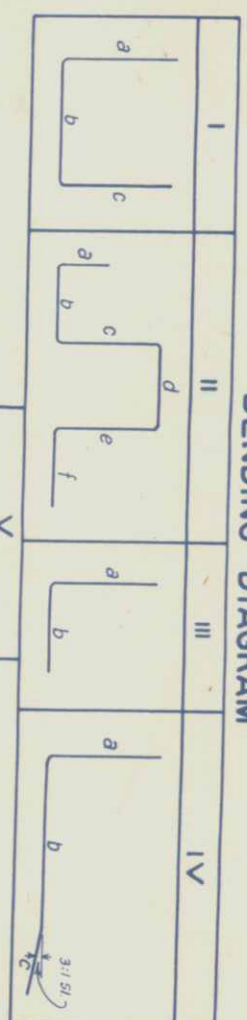

BAR LIST

All Dimensions are to  $\frac{1}{2}$  of Bars.

MARK	TYPE	DIMENSIONS						LENGTH ONE BAR	NO. REQD.	TOTAL LENGTH	SPACING	
		a	b	c	d	e	f					
A	I	3'-7"	4'-6"	3'-7"				11'-8"	1	11'-8"	See Detail	
B	I	2'-7"	2'-6"	2'-7"				7'-8"	6	46'-0"	9"	
C	IV	2'-7"	5'-2"	0'-11"				8'-8"	4	34'-8"	8"	
E	I	2'-7"	2'-0"	2'-7"				7'-2"	4	28'-8"	8"	
F	I	2'-10"	2'-0"	2'-10"				7'-8"	1	7'-8"	8"	
G	III	1'-1"	6'-7"	1'-1"				7'-8"	4	30'-8"	10"	
H	I	1'-1"	2'-6"	3'-7"				7'-2"	2	14'-4"	10"	
I	II	1'-1"	2'-6"	2'-6"				5'-8"	1	14'-8"	10"	
J	III	3'-7"	2'-1"	3'-6"				7'-8"	3	23'-0"	10"	
K	III	1'-1"	6'-7"	1'-1"				7'-8"	2	14'-4"	10"	
L	STRAIGHT							2'-8"	2	5'-4"	See Detail	
M	III	1'-6"	1'-6"					3'-0"	1	3'-0"		
ANCHOR	V	1'-6"	1'-6"					2'-10"	1	2'-10"		
TOTAL										233'-10"		

All bars  $\frac{1}{2}$ "  $\phi$  @ 0.668 lbs. per lin. ft.

233'-10" x 0.668 lbs. per lin. ft. = 157 lbs.

Plus 1% for Over-run = 2 lbs.


Total Reinf. Steel = 159 lbs.

5 pcs. 2"x6"x2'-3" Misc. Unfr. Timber for Flash Boards = 11.25 Bd. Ft.  
 5 pcs. 2"x6"x1'-9" Misc. Unfr. Timber for Flash Boards = 8.25 Bd. Ft.  
 Total = 20.00 Bd. Ft.


1.7 Cu. Yds. Class "A" Concrete

Note: All Reinforcing Bars are to be placed in center of Walls and Slabs.

DETAIL FOR GROUTED RUBBLE SLOPE & DITCH PAVING RT. OF STA. 2565+

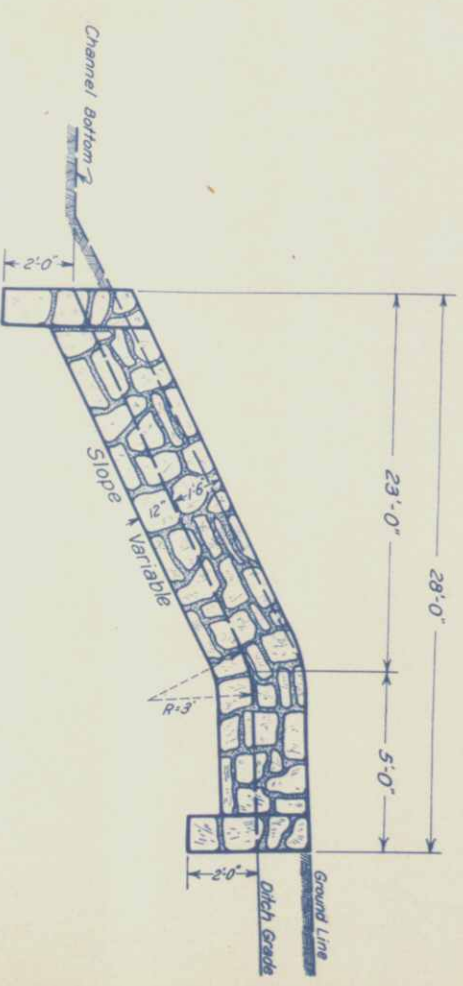

SIDE ELEVATION

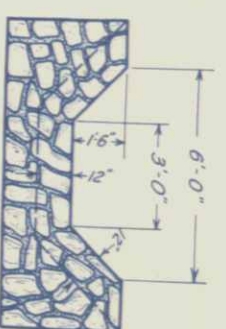





END VIEW

Excavation involved in the placement of Grouted Rubble Slope and Ditch Paving is to be classified and paid for as "Unclassified Ditch Excavation."

FED. ROAD DIST. NO.	STATE	SN-FED. AID PROJ. NO.	SHEET NO.	TOTAL SHEETS
3	COLO.	44-B(1)	14	

DETAIL OF CONCRETE DIVISION BOX WITH DROP RT. OF STA. 2487+

FED. ROAD DIST. NO.	STATE	SN-FED. AID PROJ. NO.	SHEET NO.	TOTAL SHEETS
3	COLO.	44-B(11)	15	

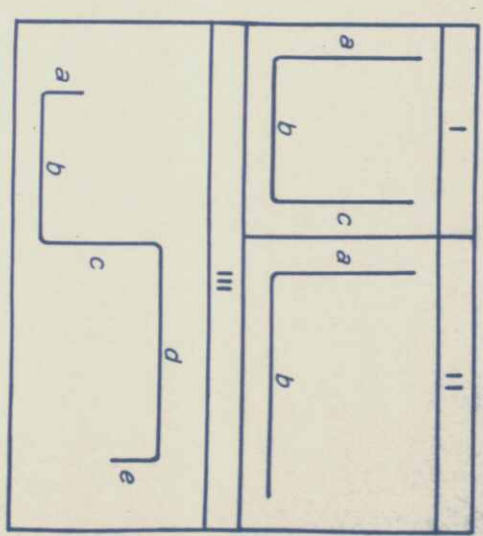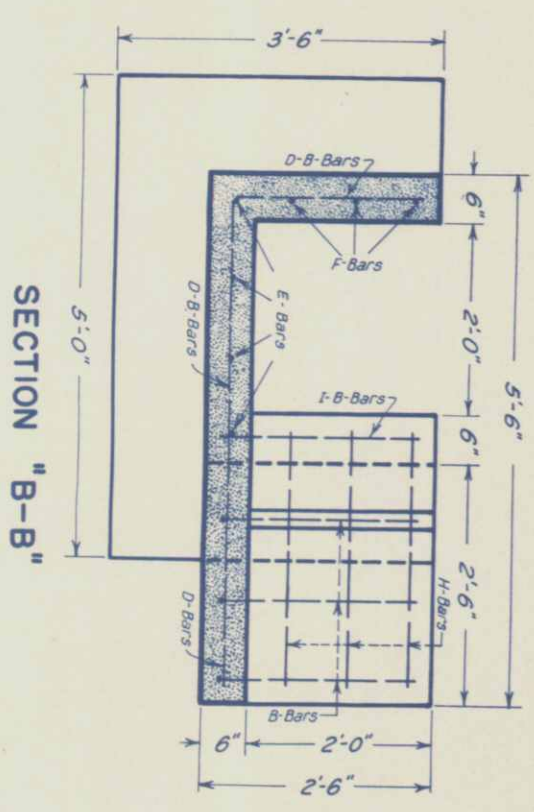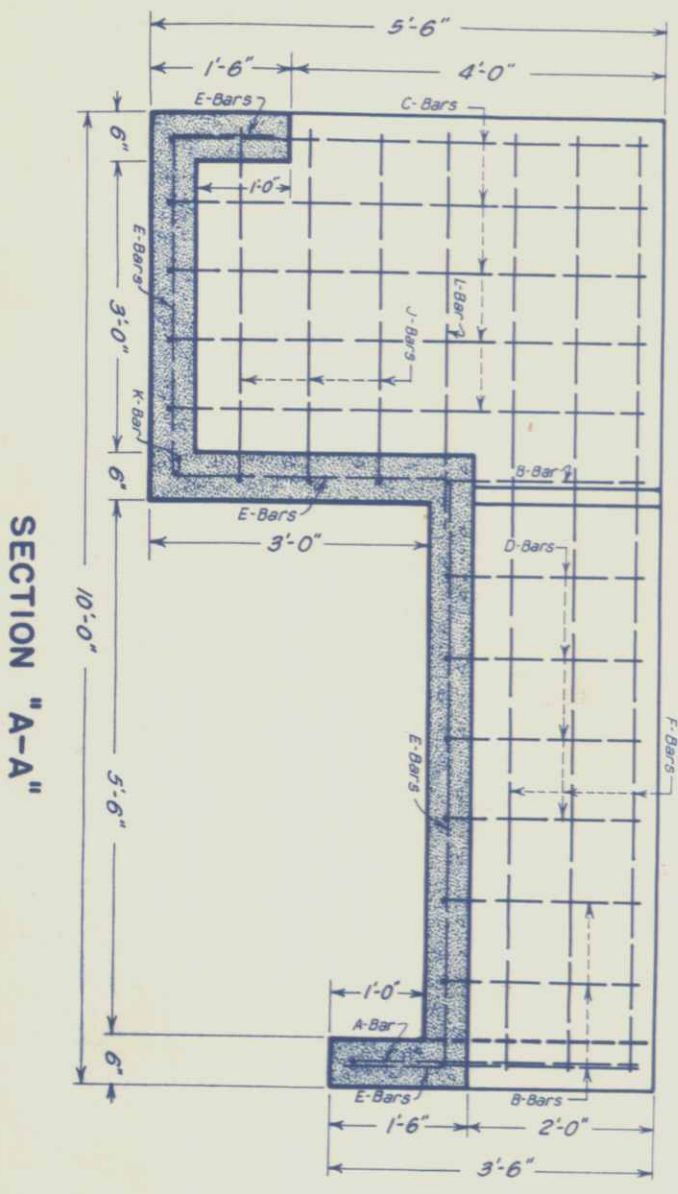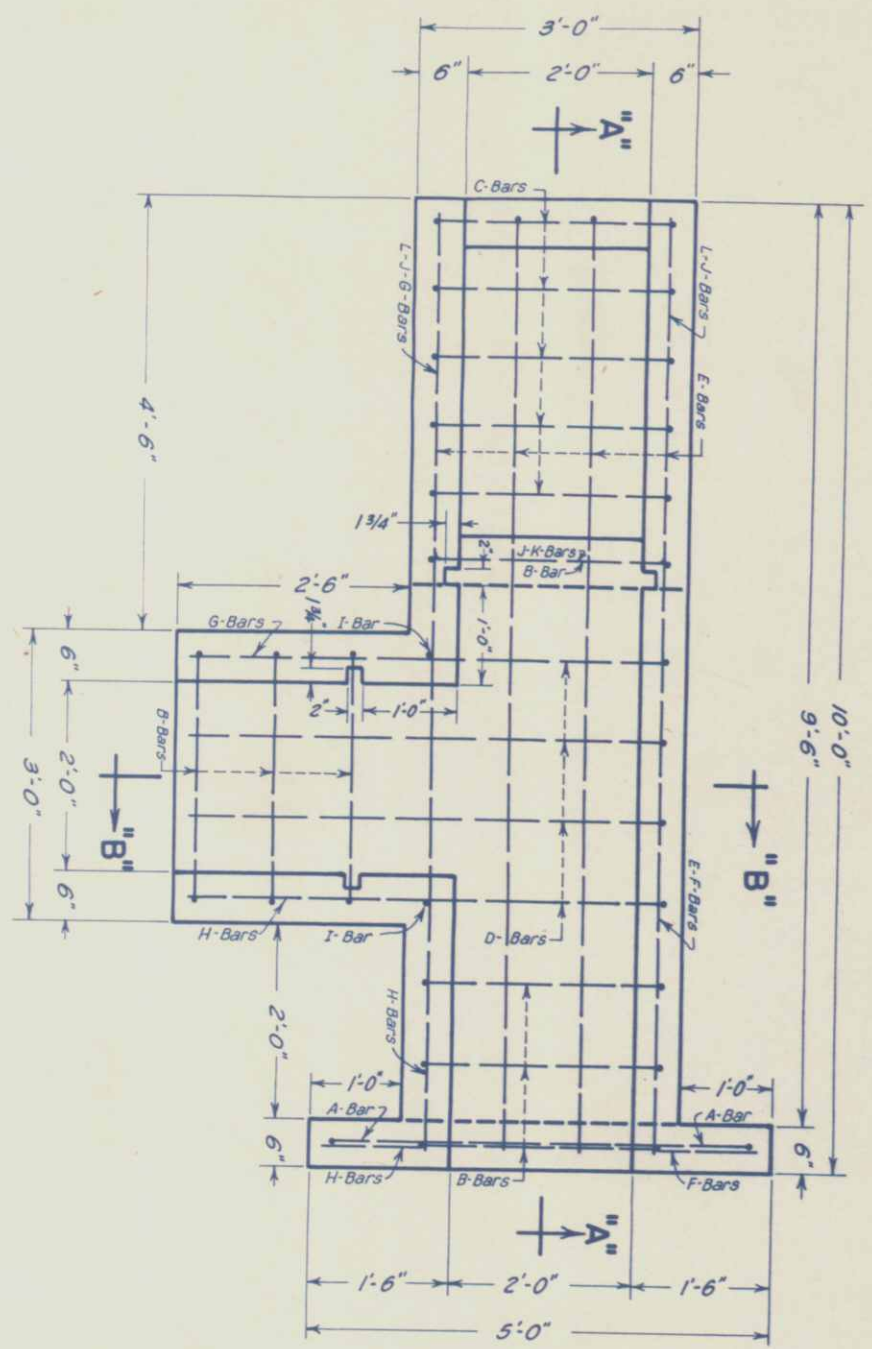

BAR LIST


All Dimensions are to  $\phi$  of Bars

MARK	TYPE	DIMENSIONS					LENGTH ONE BAR	NO. REED	TOTAL LENGTH	SPACING
		a	b	c	d	e				
A	I	3'-1"	4'-6"	3'-1"			10'-8"	1	10'-8"	SEE DETAIL
B	I	2'-1"	2'-6"	2'-1"			6'-8"	7	46'-8"	10"
C	I	5'-1"	2'-6"	5'-1"			12'-8"	5	63'-4"	8"
D	II	2'-1"	5'-1"				7'-2"	4	28'-8"	10"
E	III	1'-1"	3'-6"	3'-0"	6'-0"	1'-1"	14'-8"	4	58'-8"	10"
F	II	9'-7"	1'-1"				10'-8"	3	32'-0"	8"
G	II	4'-7"	2'-7"				7'-2"	3	21'-6"	8"
H	I	2'-7"	2'-6"	1'-1"			6'-2"	3	18'-6"	8"
I	STRAIGHT						2'-2"	2	4'-4"	SEE DETAIL
J	I	3'-7"	2'-6"	3'-7"			9'-8"	3	29'-0"	9"
K	STRAIGHT						2'-8"	1	2'-8"	SEE DETAIL
L	STRAIGHT						4'-1"	2	8'-2"	SEE DETAIL


All bars  $\frac{1}{2}$ " @ 0.668 lbs. per lin. ft.  
 324'-2" x 0.668 lbs. per lin. ft. = 217 lbs.  
 Plus 1% $\pm$  for Over-run = 3 lbs.  
 Total Reinf. Steel = 220 lbs.  
 4 pcs. 2" x 6" x 2'-3" Misc. Untr. Timber for Flash Boards = 9.00 Bd. Ft.  
 2.3 Class "A" Concrete.

Note: All Reinforcing Bars are to be placed in center of Walls and Slabs.



DETAIL OF UNDERDRAIN STA. 2475+

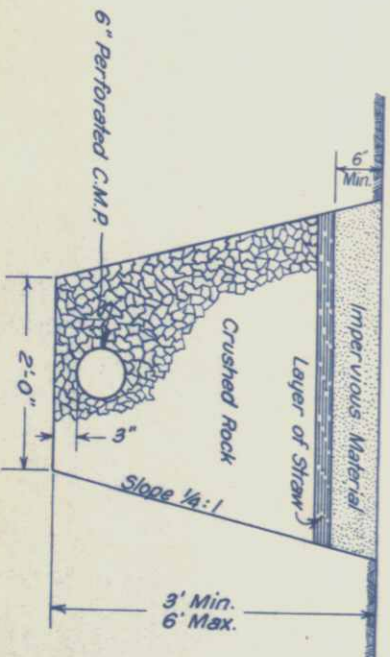

# DETAIL OF TIMBER DITCH CHECKS LT. OF STAS. 2499 + TO 2504 +

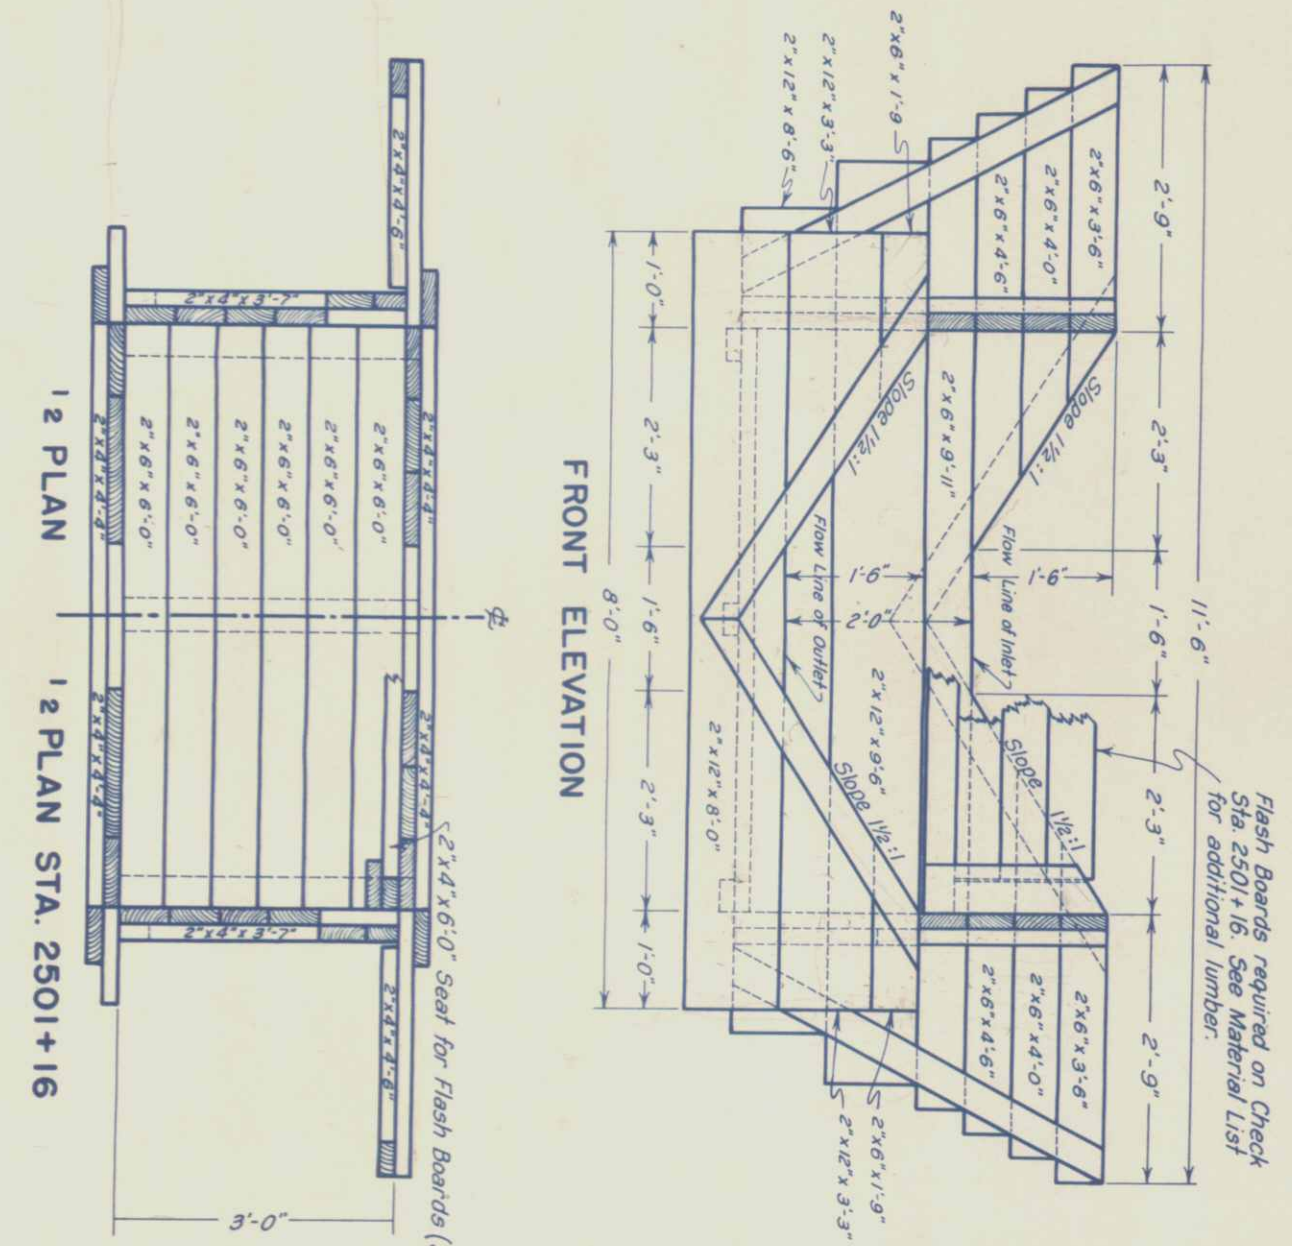

Flash Boards required on Check Sta. 2501+16. See Material List for additional lumber.

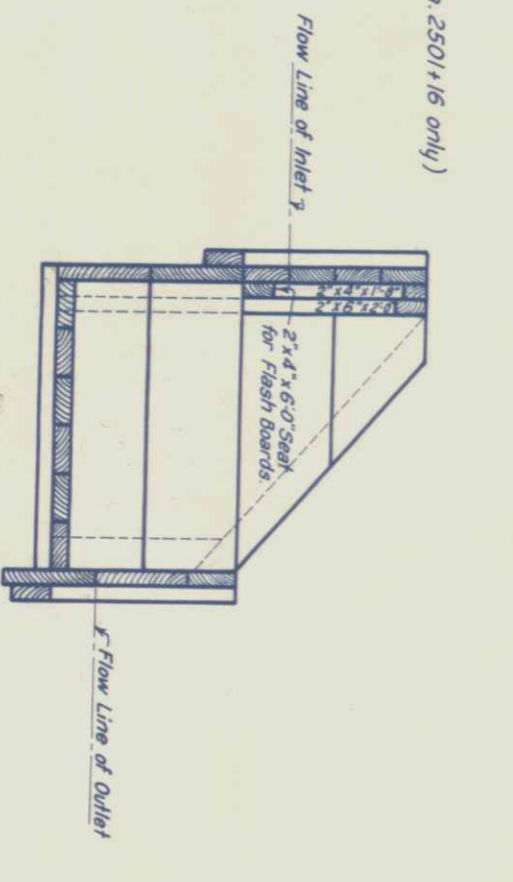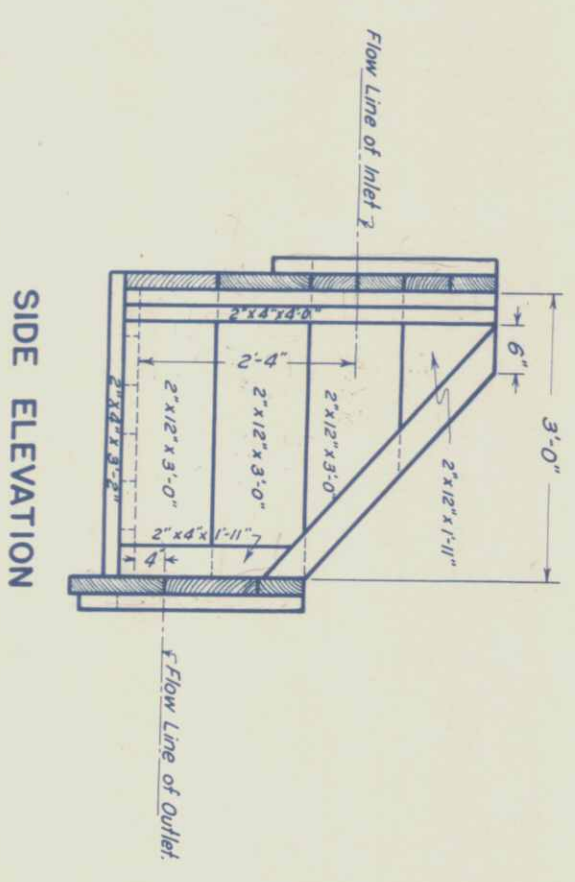

## MATERIAL LIST FOR ONE CHECK

NUMBER OF PIECES	SIZE	MISC. TREATED TIMBER FT. DIM.
MATERIAL REQUIRED FOR ONE CHECK (WITHOUT FLASH BOARDS)		
2	2" x 6" x 3'-6"	7.0
2	2" x 6" x 4'-0"	8.0
2	2" x 6" x 4'-6"	9.0
3	2" x 6" x 9'-11"	9.9
1	2" x 12" x 3'-6"	19.0
1	2" x 12" x 8'-6"	17.0
1	2" x 12" x 8'-0"	16.0
2	2" x 12" x 1'-11"	7.7
2	2" x 12" x 3'-0"	36.0
2	2" x 6" x 1'-9"	3.5
4	2" x 12" x 3'-3"	13.0
2	2" x 4" x 4'-4"	11.6
2	2" x 4" x 4'-6"	6.0
2	2" x 4" x 3'-7"	4.8
6	2" x 6" x 6'-0"	36.0
2	2" x 4" x 1'-11"	2.6
3	2" x 4" x 3'-2"	6.4
2	2" x 4" x 4'-0"	5.4
<b>TOTAL</b>		<b>218.9</b>
ADDITIONAL MATERIAL REQUIRED FOR FLASH BOARDS TO BE USED ON DITCH CHECK LT. OF STA. 2501+16		
1	2" x 4" x 6'-0"	4.0
2	2" x 6" x 2'-0"	4.0
2	2" x 4" x 1'-8"	2.2
3	2" x 6" x 5'-3"	15.8
<b>TOTAL FOR FLASH BOARDS</b>		<b>26.0</b>
<b>TOTAL FOR CHECK (NO FLASH BGS)</b>		<b>218.9</b>
<b>TOTAL FOR CHECK STA. 2501+16</b>		<b>244.9</b>
10 LBS. OF 6d NAILS		

All lumber to be "Full Sawn" surfaced or S-2-E. If S-2-E lumber is used, the dimensions of checks as hereon shown, are to be varied accordingly.

All Excavation involved in the placement of these Checks is to be paid for as "Unclassified Ditch Excavation."

