

FED. ROAD DIST. NO.	STATE	F.A.S. PROJ. NO.	SHEET NO.	TOTAL SHEETS
3	COLO.	4-B(I)	1	1

COLORADO

STATE HIGHWAY DEPARTMENT


PLAN AND PROFILE OF PROPOSED FEDERAL AID SECONDARY PROJECT NO. F.A.S. - 4-B(I) STATE HIGHWAY NO. 7 BOULDER COUNTY

INDEX OF SHEETS

- Sheet No. 1 Title Sheet
 2 Typical Cross Section and Summary
 3 List of Structures, Fencing, R.O.W. Markers and Guard Posts
 4-10 Details of Bridge, Sta. 88+
 11 Standard Name Plate
 12 " Headwalls for CMP Culverts
 13 " Timber Guard Posts
 14 " Wire Fences with Steel Posts and Marker Posts
 15 " Structure Number Lettering
 16 Typical Side Approach Roads and Roadway
 17-18 Plan and Profile Sheets
 19-26 Cross Section Sheets

- #### CONVENTIONAL SIGNS
- Center Line
 - Right-of-Way Line
 - County Line
 - Township or Range Line
 - Section Line
 - Quarter Section Line
 - Property or Tract Line
 - City Limits
 - Rail Road
 - Barbed Wire Fence
 - Combination Fence
 - Picket Fence
 - Board Fence
 - Telephone Line
 - Power Line
 - Water Main
 - Detour

SCALES OF ORIGINAL TRACINGS
 ON PLAN, 1 IN. = 100 FT.
 ON PROFILE, 1 IN. = 100 FT. HORIZONTAL
 1 IN. = 10 FT. VERTICAL
 GRADE LINE ON PROFILE IS SHOWN AS GRADE OF FINISHED ROAD
 GROSS LENGTH OF PROJECT } 2433.0 FT. = 0.460 MI.
 NET }


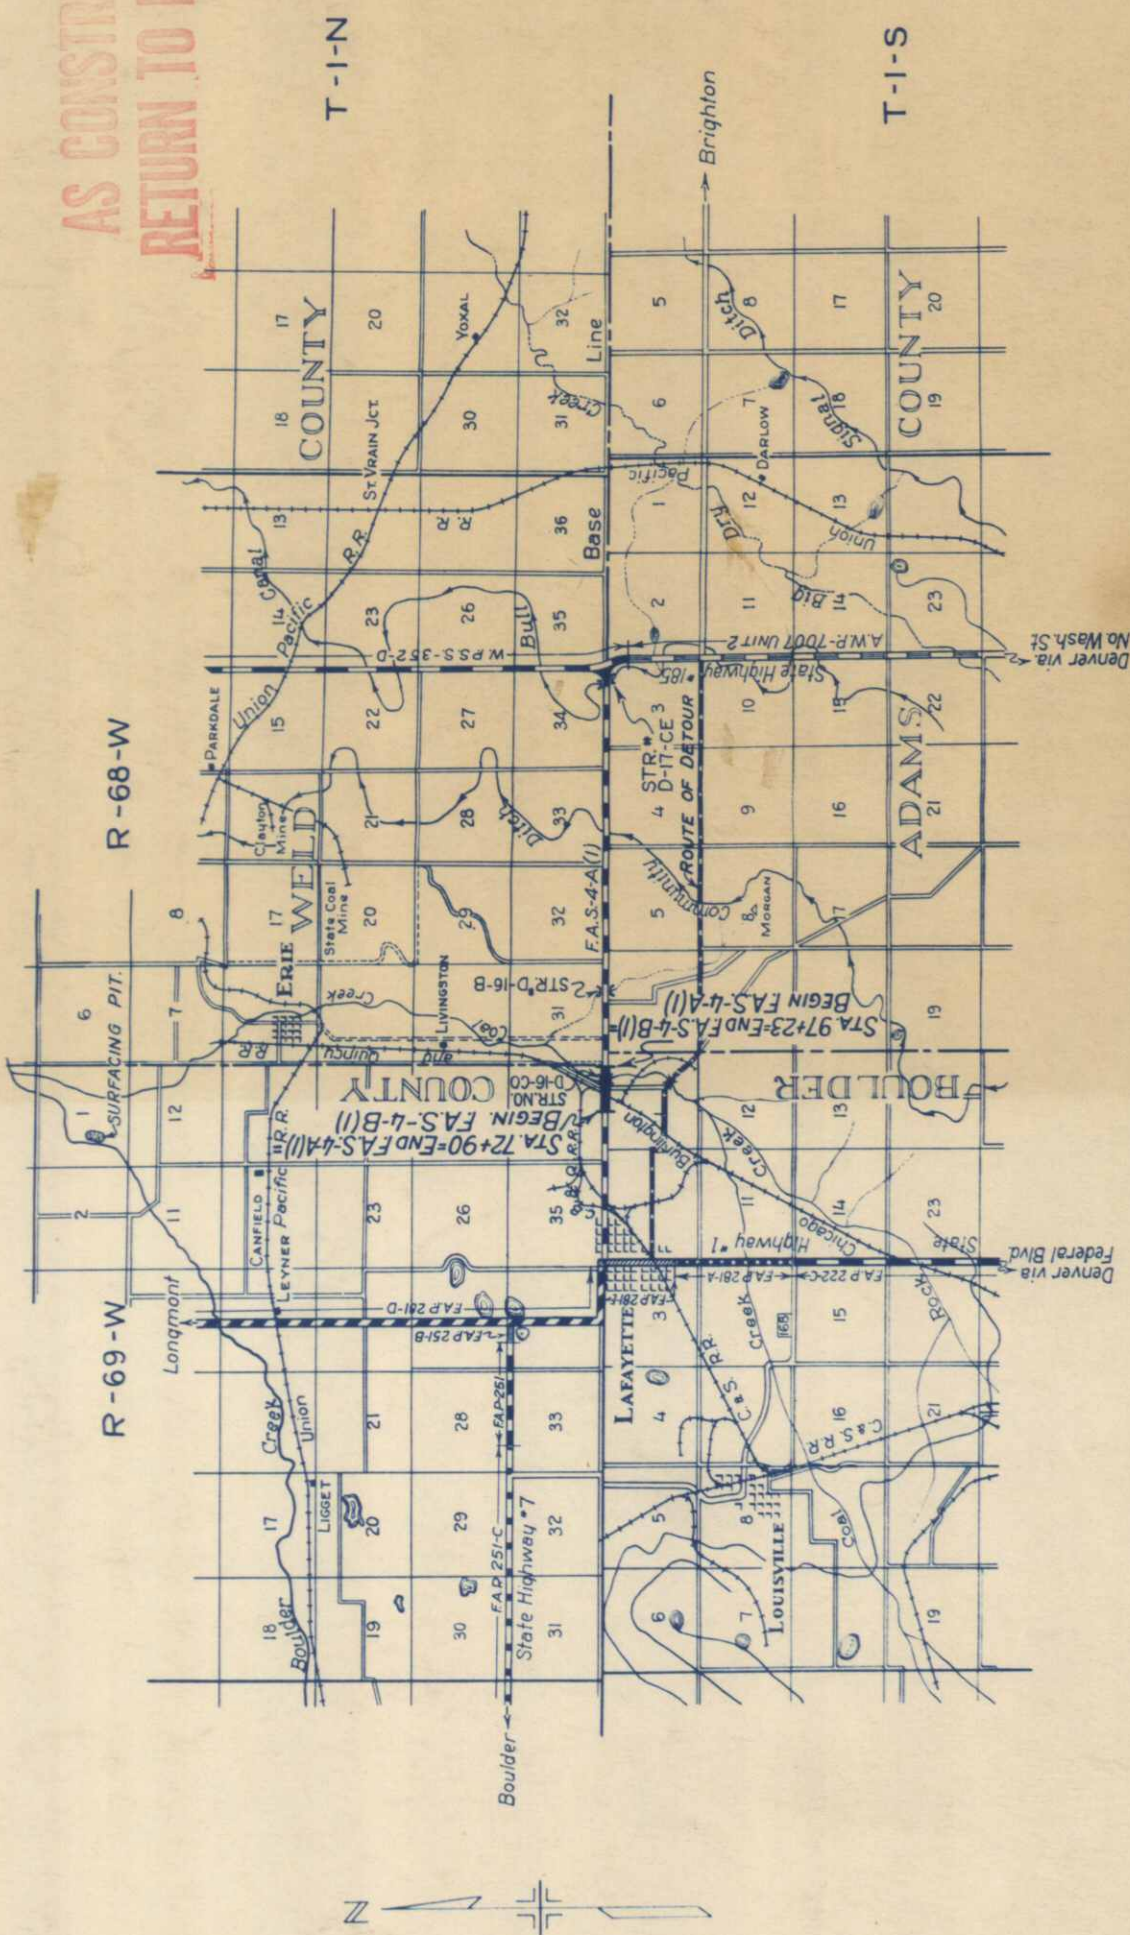


AS CONSTRUCTED PLANS
 RETURN TO DIST. 4 DESIGN

It is recommended that bidders on this project go over the plan details with one of the following field representatives of this department:
 R.J. Randall, Division Engineer Greeley,
 Clyde Walters, Resident Engineer Greeley.



RECOMMENDED FOR APPROVAL
 APPROVED
 DIST. ENG. BUREAU PUBLIC ROADS
 RECOMMENDED FOR APPROVAL
 CHIEF ENG. BUREAU PUBLIC ROADS
 APPROVED
 DIRECTOR BUREAU PUBLIC ROADS

Scale in Miles

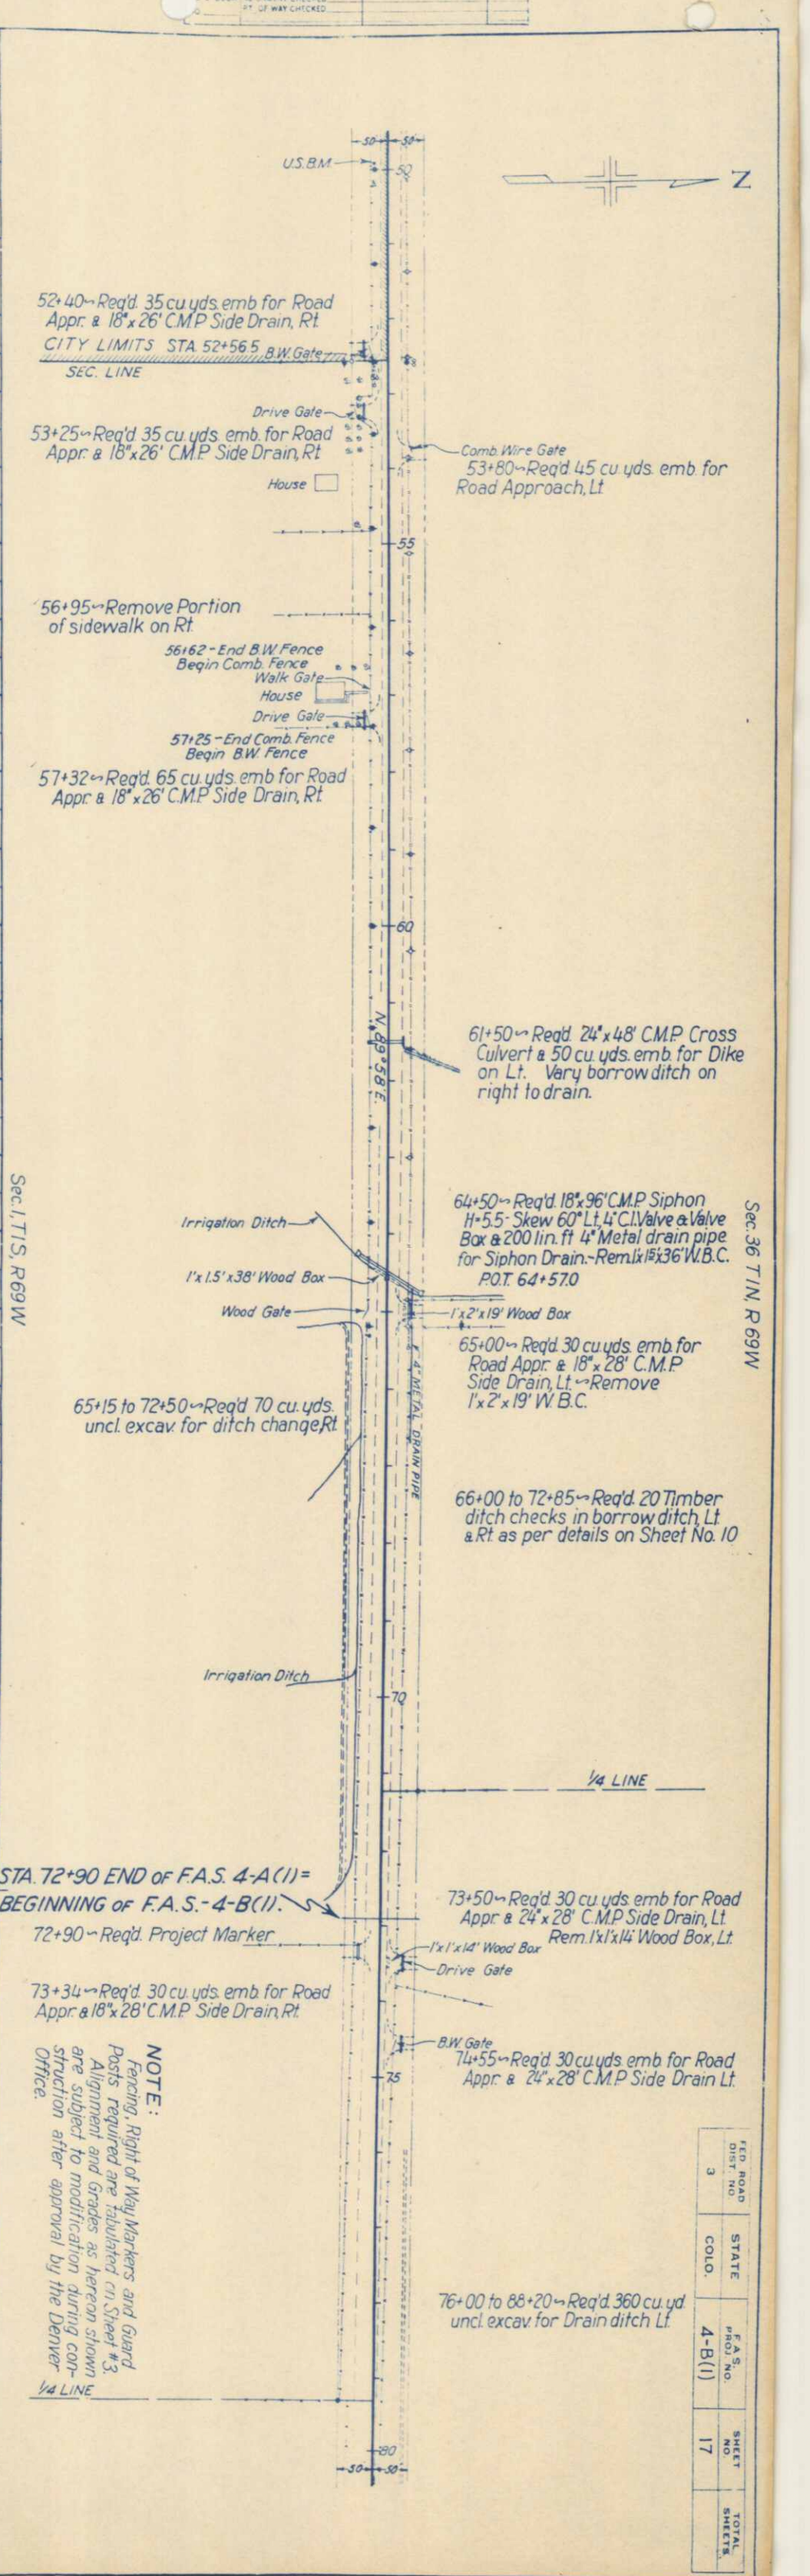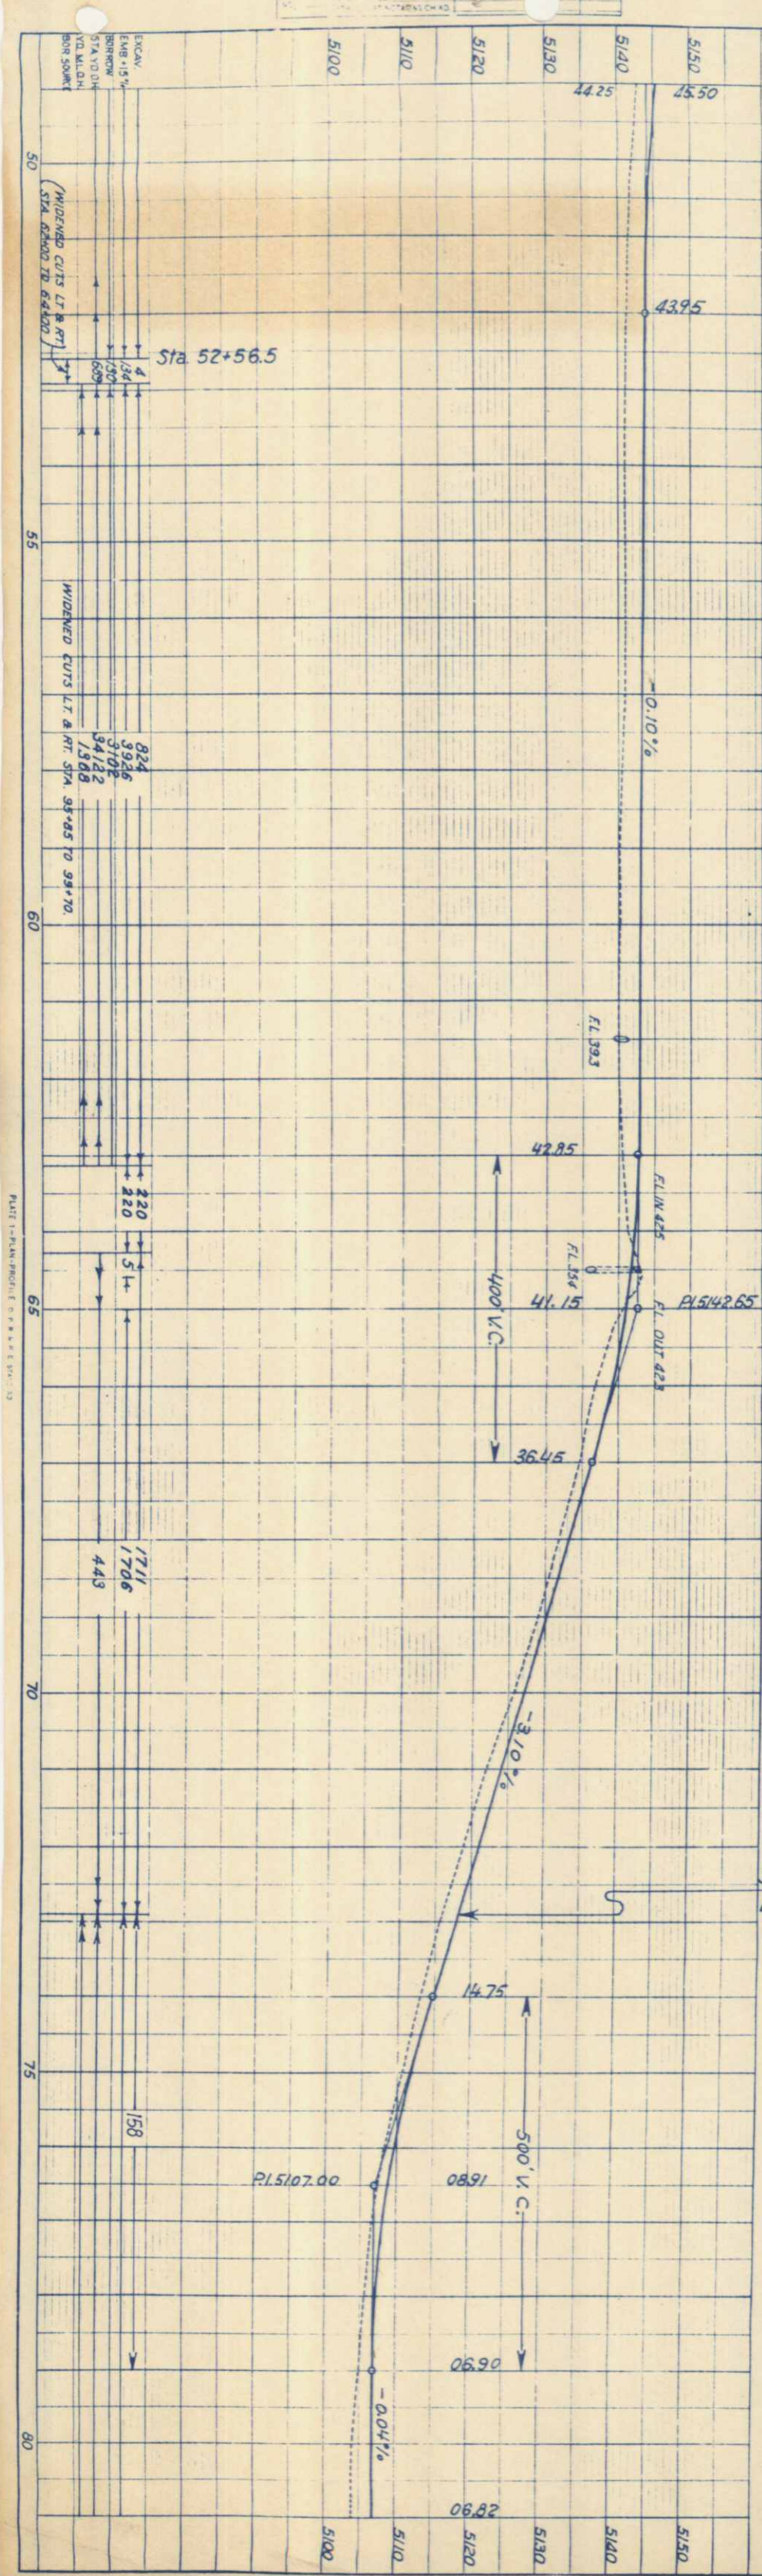

NOTE:
Fencing, Right of Way Markers and Guard Posts required are tabulated on Sheet #3. Alignment and grades as hereon shown are subject to modification during construction after approval by the Denver Office.

FED. ROAD DIST. NO.	STATE	COLO.	F.A.S. NO.	SHEET NO.	TOTAL SHEETS
3			4-B(1)	17	

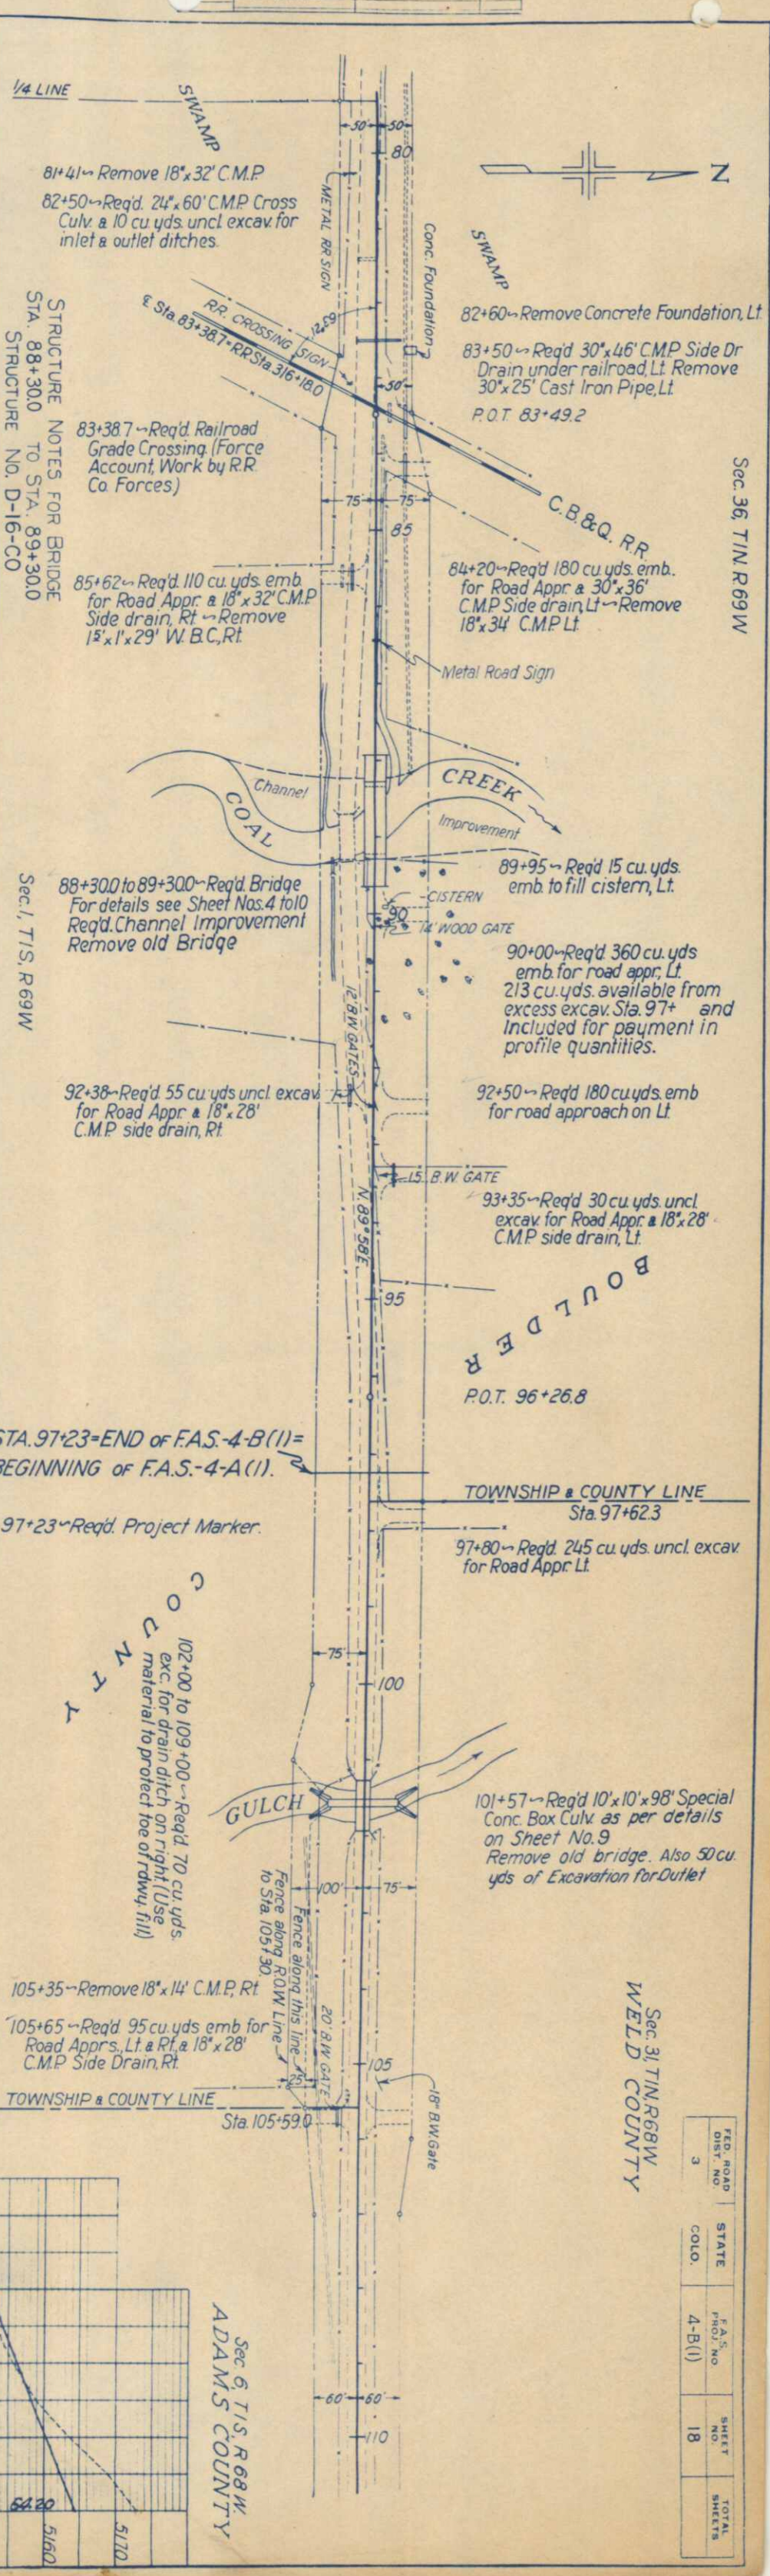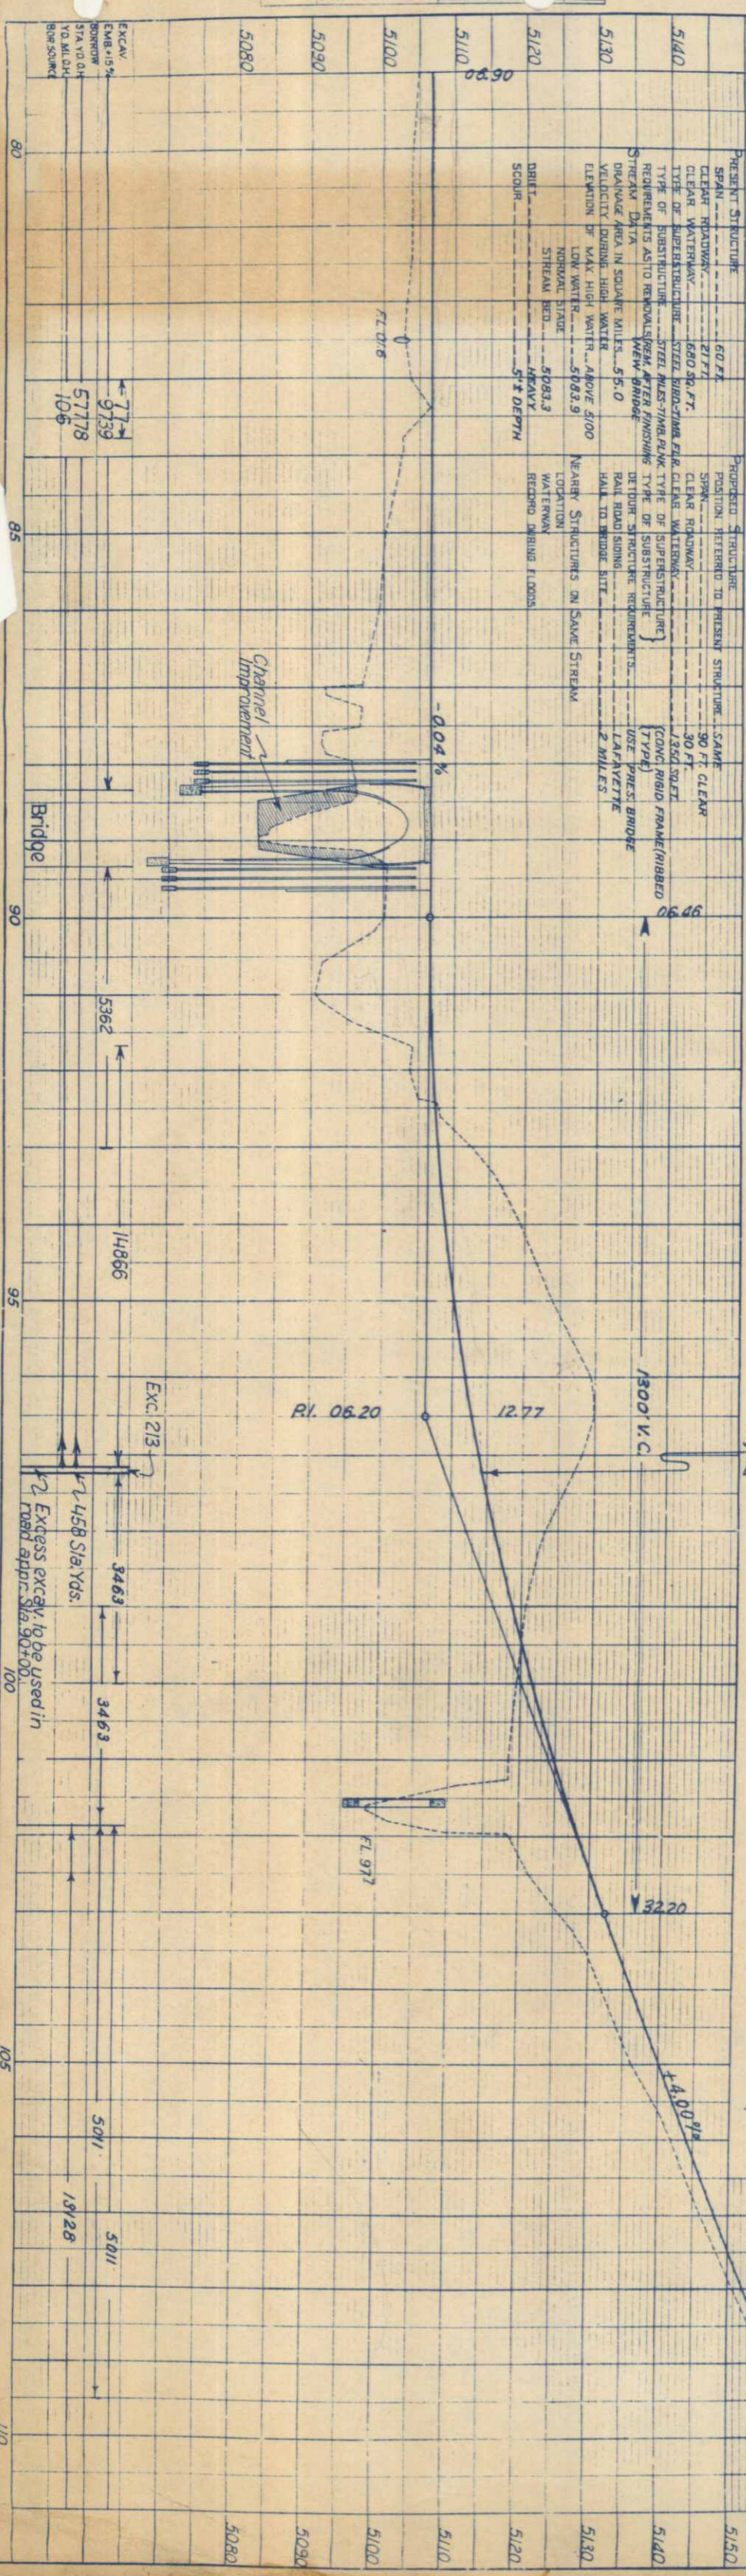

Sec. 36, T.1N, R.69W

Sec. 31, T.1N, R.68W
WELD COUNTY

Sec. 6, T.1S, R.68W
ADAMS COUNTY

FED. ROAD DIST. NO.	STATE	F.A.S. PROJ. NO.	SHEET NO.	TOTAL SHEETS
3	COLO.	4-B(1)	18	