


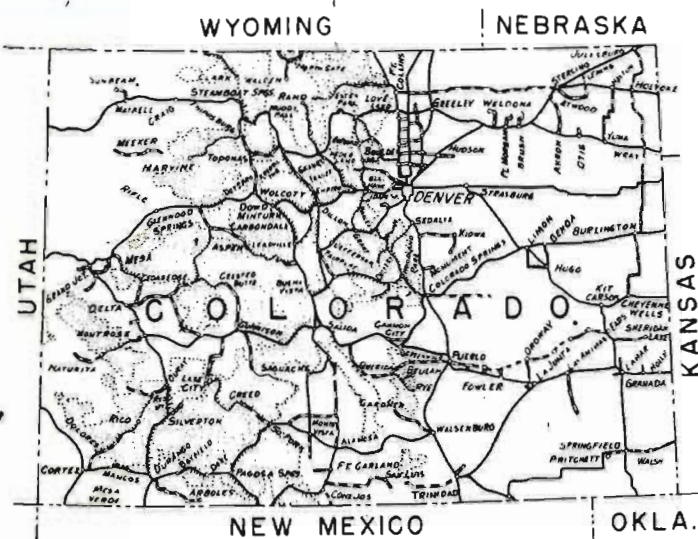

U.S. DEPARTMENT OF COMMERCE
BUREAU OF PUBLIC ROADS

AS CONSTRUCTED
COLORADO FOREST HIGHWAY PROJECT A.F.H. 10-1(I)
CUCHARAS PASS
LENGTH 3.580 MILES
CLASS ~~3~~ 2
SAN ISABEL NATIONAL FOREST
HUERFANO COUNTY


REGION 9 STATE COLORADO
PROJECT A.F.H. 10-1(I), Cucharas Pass
SHEET 1 OF 1 SHEETS

INDEX TO SHEETS		
SHEET NO.	DESCRIPTION	STATION TO STATION
1	Title Sheet	
2	Typical Sections	
	Summary (2 Sheets)	
4-10	Plan & Profile	0+00.48 189+00
Std. 107	Emb. Drains, Bit Curbs, Gutters & Rundowns	
Std. 113	Type "A" & "B" Conc. Headwalls	
Std. 116	Concrete Headwalls	
Std. 118	Concrete and Metal End Sections	
Std. 119	Underdrain	
Std. 121	Rock Structures	
Std. 131	Maintenance Posts and Delineators	
Std. 136	Wire Fences with Steel Posts	
Std. 143	Project Identification Signs	
R9-Std. 168	Straight Type Conc. Headwalls	
D3-Spl. 354	Bin Type Metal Cribbing (2 Sheets)	

Begin Proj. A.F.H. 10-1(I)
Sta. 0+00.48

Completed 1963

End Proj. A.F.H. 10-1(I)
Sta. 189+00

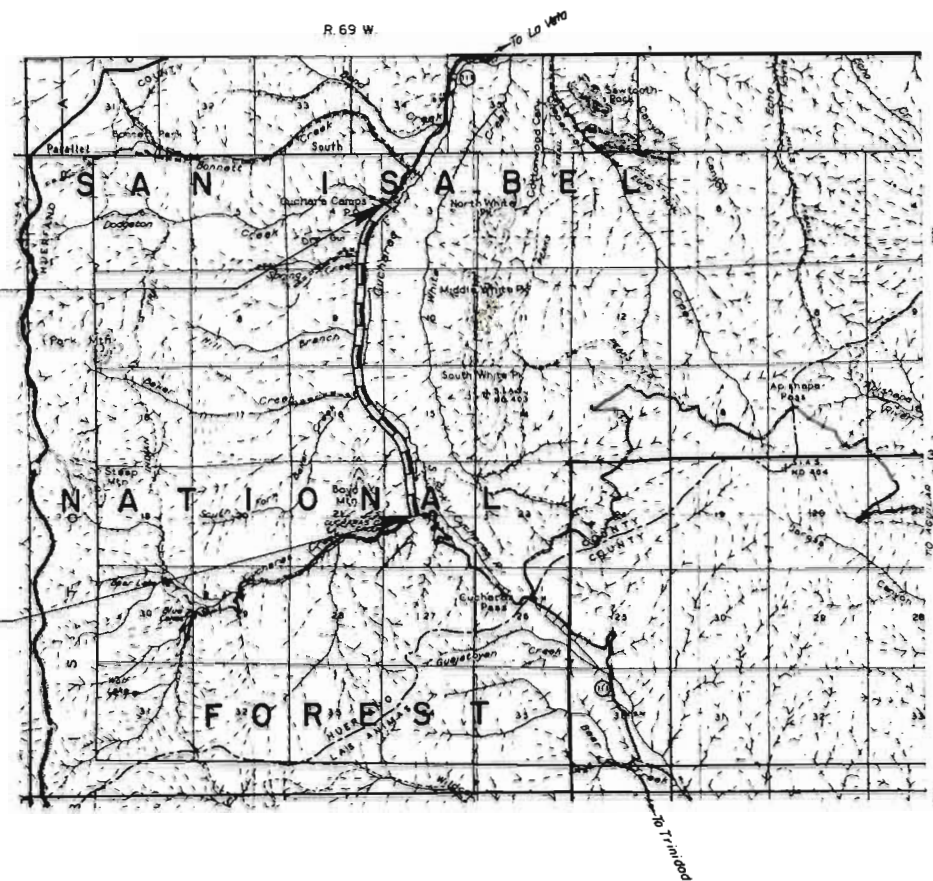

Plans prepared by: B.P.R.
Date: May, 1963

Description of Project
Improvement: Grading & Bit. Stab. Base
Roadbed Widths:
Grading: 30'
Base: 24'
Type Code: 2013

Traffic Volume:
A.D.T. (1961): 80
A.D.T. (1981): 250
D.H.V.: 40
D: 65%
T: 10%
V: 35


U.S. DEPARTMENT OF COMMERCE
BUREAU OF PUBLIC ROADS
REGION NO. 9 DENVER, COLORADO

APPROVED:


REGIONAL ENGINEER _____ DATE _____ 19__

LEGEND


EXISTING ROAD	UNIMPROVED GRADED	REINFORCED SUBGRADE	BASE COURSE	SURFACE TREATMENT	ROAD PLANT MIX BITUM.	CONCRETE
---------------	-------------------	---------------------	-------------	-------------------	-----------------------	----------

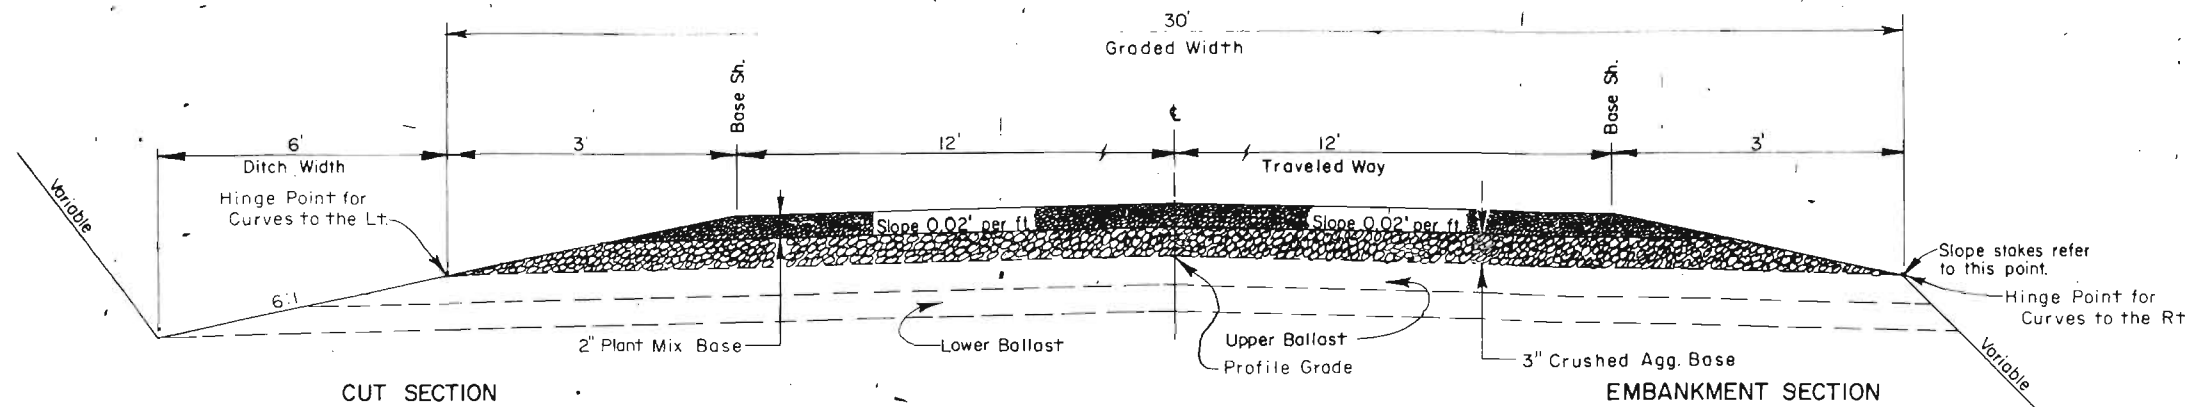


TYPICAL SECTION ON TANGENTS

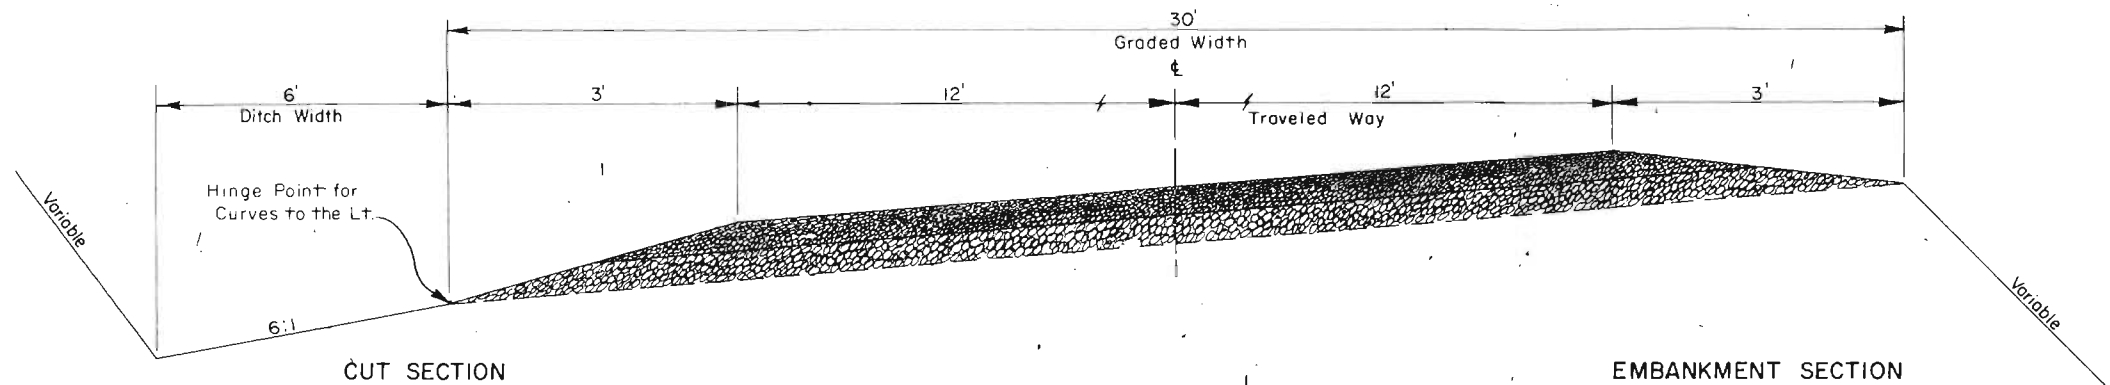

TYPICAL SECTION FOR CURVES LT.
(MAXIMUM SUPERELEVATION)

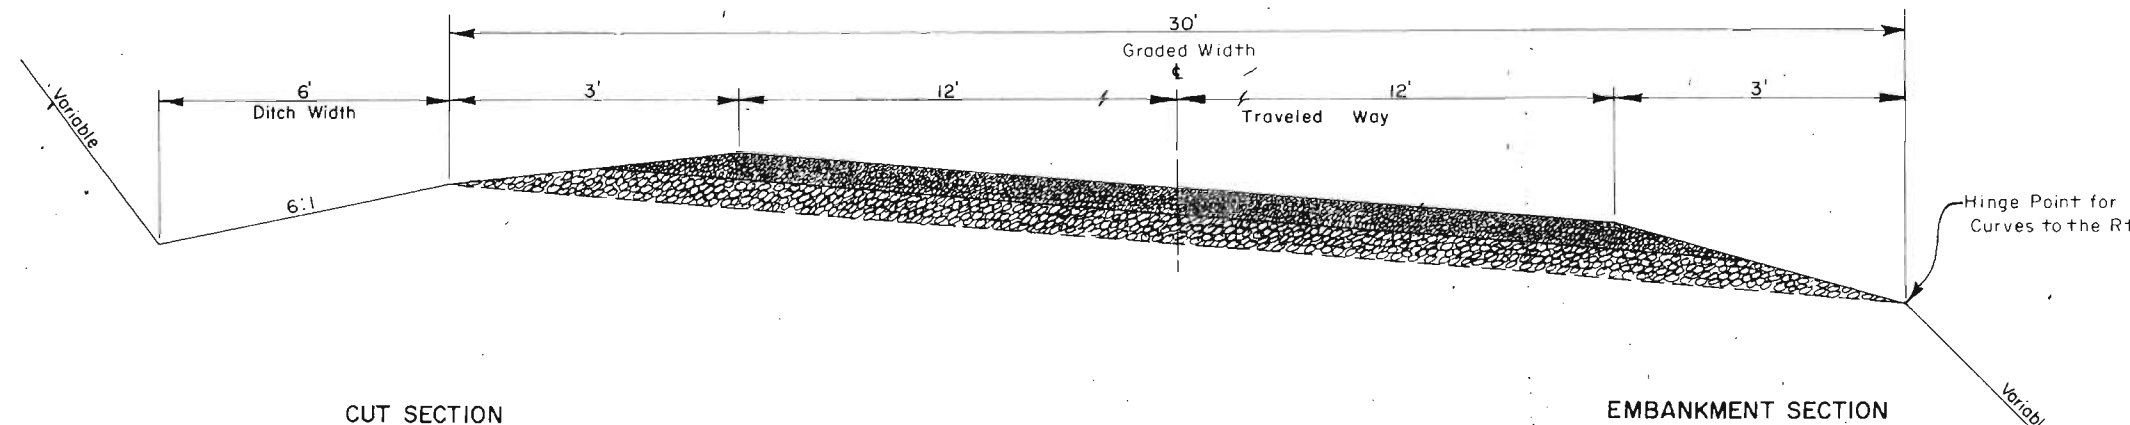

TYPICAL SECTION FOR CURVES RT.
(MAXIMUM SUPERELEVATION)

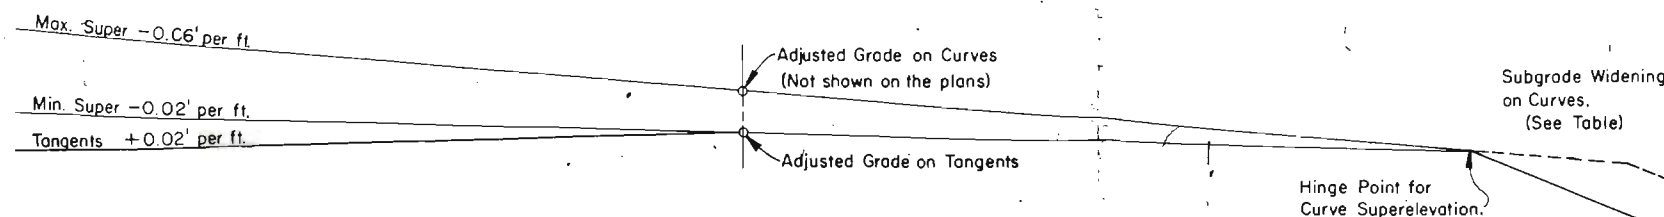


METHOD OF SUPERELEVATING ON CURVES

HEIGHT	EMBANKMENT SLOPE
0' to 3'	6:1
3' to 6'	4:1
6' to 12'	2:1
12' and up	2:1

HEIGHT	CUT SLOPE
0' to 5'	3:1
5' to 10'	2:1
10' and up	1 1/2:1

The above tables are to be used as a guide in the design and construction of the project. The designer or field engineer may vary from these to fit existing conditions.

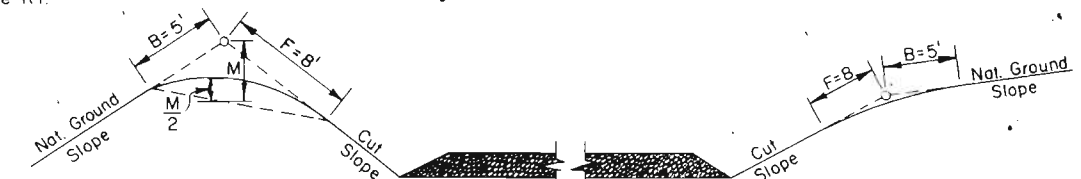

CUT SLOPE ROUNDING

When the cut slope is less than 8', reduce B & F distance to the actual slope distance.

Slope Rounding shall be considered as a subsidiary part of the work required in dressing the cut slopes and no allowance will be made for materials moved.

Rounding, Warping, and Finishing slopes shall be as provided in Standard Specifications and/or Special Provisions.

BALLAST MATERIALS

STA. TO STA.		UPPER BALLAST		LOWER BALLAST	
		Item	Depth	Item	Depth
0 + 00	20 + 00	104 (2)	8"	102 (7)	6"
20 + 00	30 + 00	104 (2)	6"	102 (7)	4"
30 + 00	60 + 00	104 (2)	8"	102 (7)	6"
60 + 00	189 + 00	104 (2)	14"		

GENERAL NOTES

If the Plans require the placing of lower ballast, the roadway section shall be constructed to accommodate the required thickness of upper and lower ballast below adjusted grade.

On Grades of 3% or less, where wet or unstable conditions exist, the engineer may increase the ditch width 3 feet or more.

Any subsurface data represented on these plans is limited to the specific locations shown and those locations alone.

The planned thickness of Ballast Materials is based on laboratory analysis of samples taken at random along the proposed improvement. During construction, the engineer will adjust the thickness as necessary to insure adequate Structural Stability.

CURVE WIDENING*

Degree of Curve	Pavement Width
5° - 10°	2' - 2' 24"
11° - 21°	3' - 2' -
22° & Up	4' - 3' - 2'

* Widen Subgrade, Base and Surfacing.



U.S. DEPARTMENT OF COMMERCE
BUREAU OF PUBLIC ROADS
REGION NO. 9 DENVER, COLORADO

TYPICAL CROSS SECTIONS

NATIONAL FOREST HIGHWAYS



ROUTE: A.F.H. 10 Cochran Pass
PROJECT: 10-1(1)
NATIONAL FOREST: San Isabel
COUNTY: Huerfano
STATE: Colorado


ROADBED WIDTHS
GRADED: 30' SH. to SH.
BASE: 24' SH. to SH.
SURFACE: SH to SH.

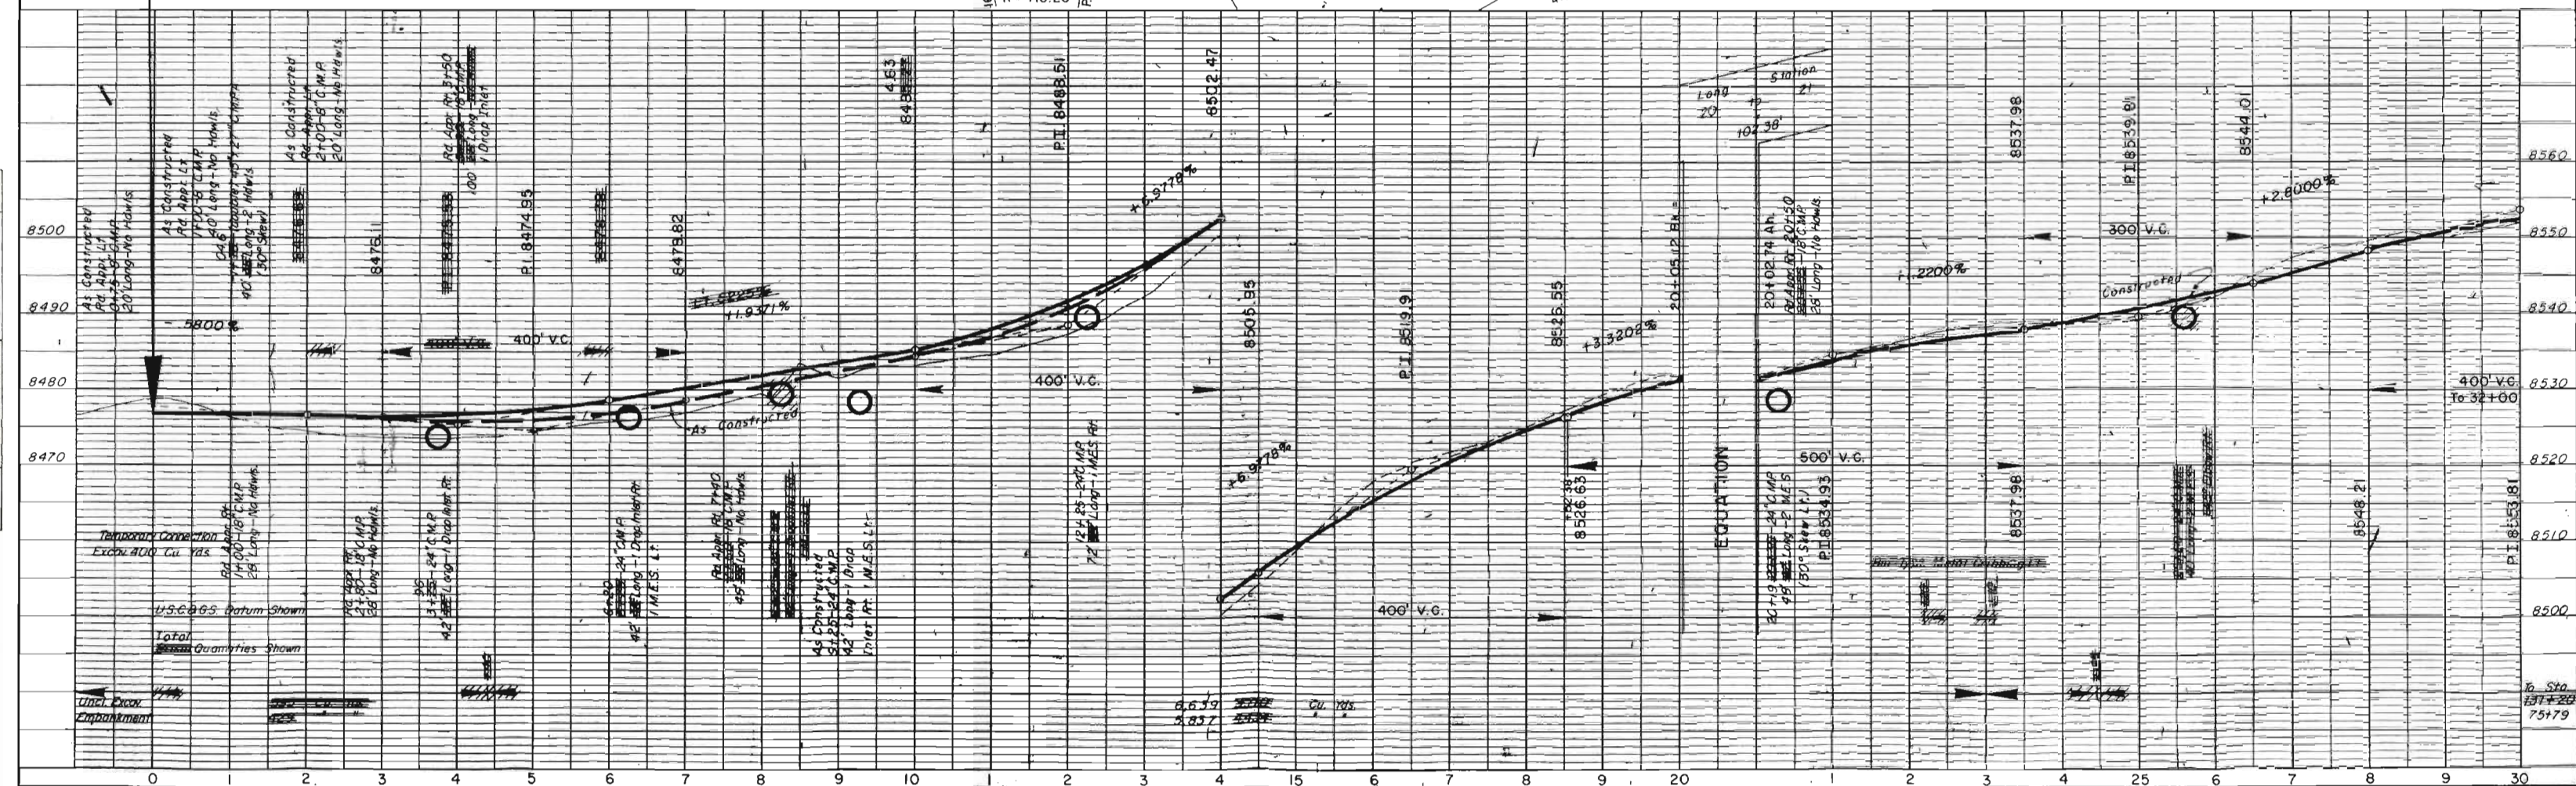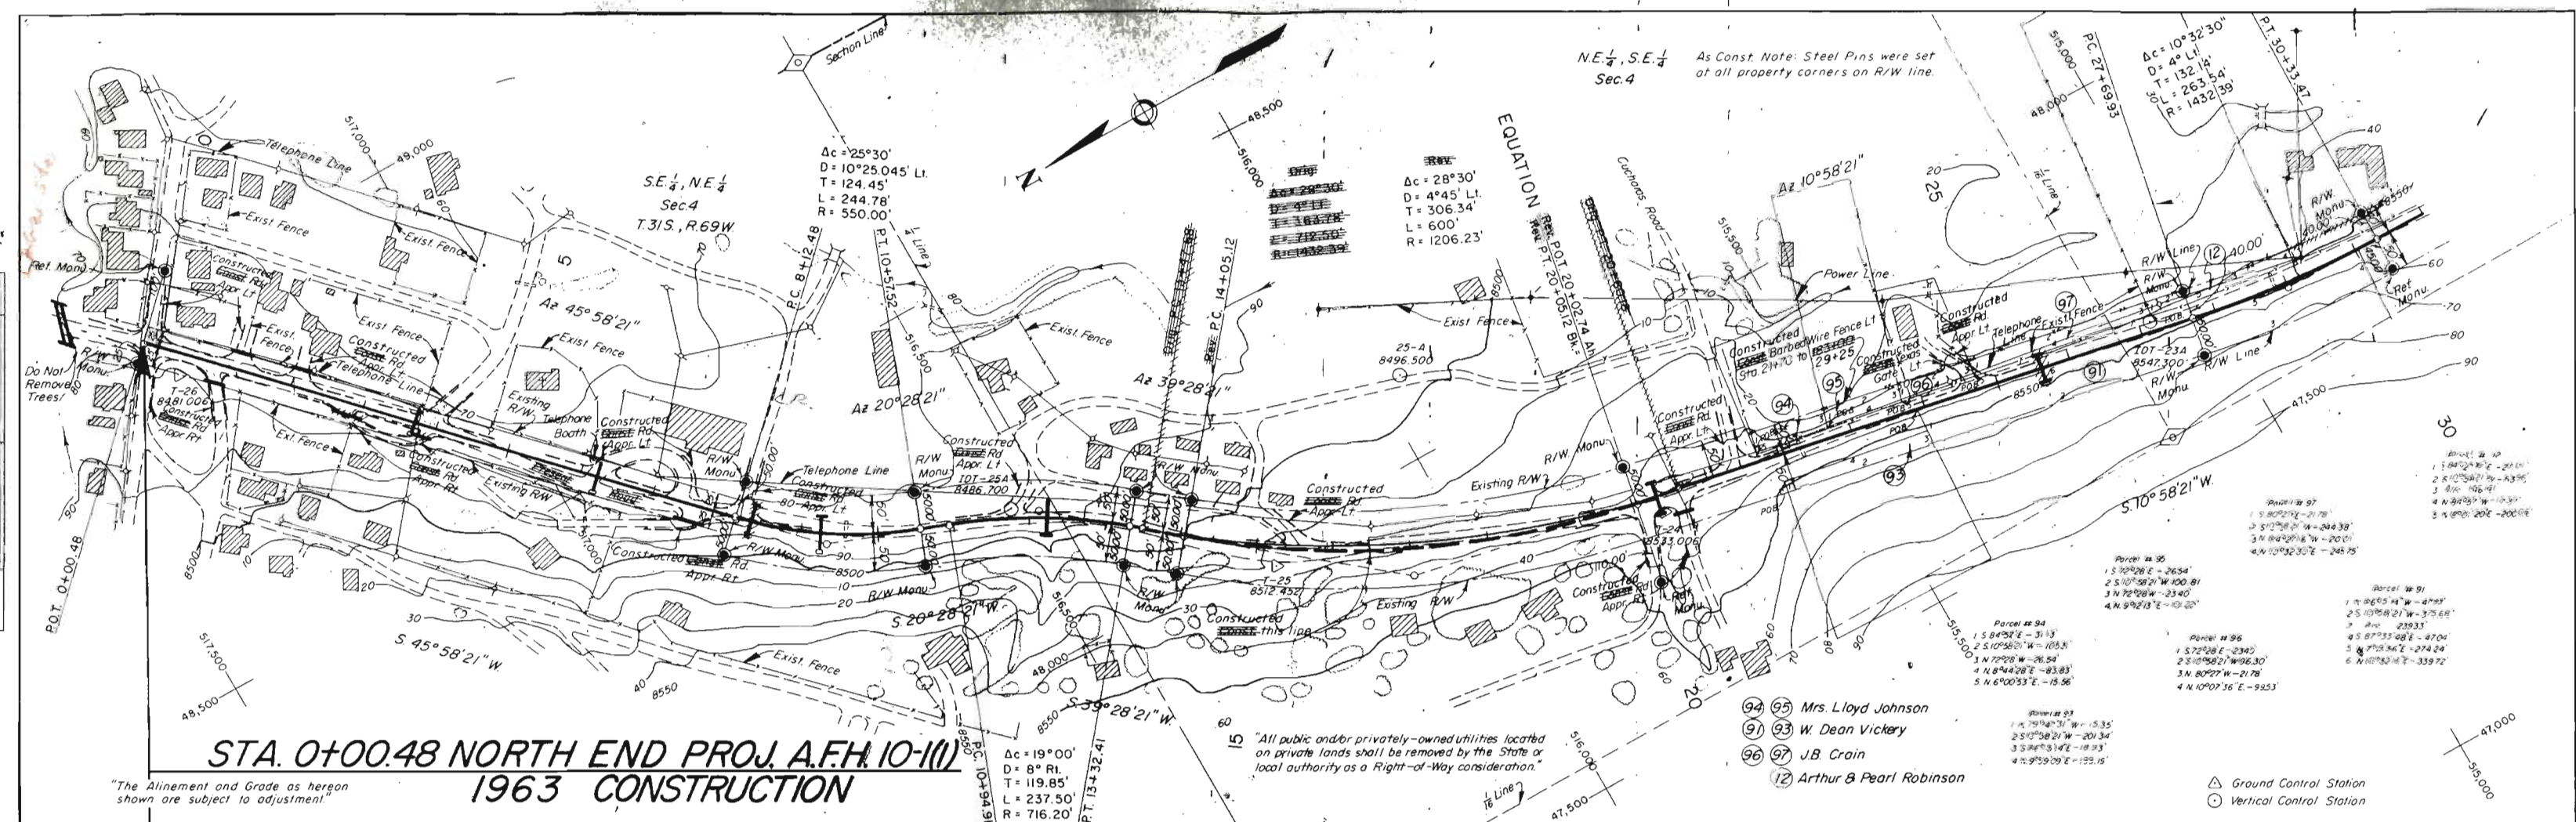



PLAN
NOTE BOOK
NO.



PROFILE
NOTE BOOK
NO.

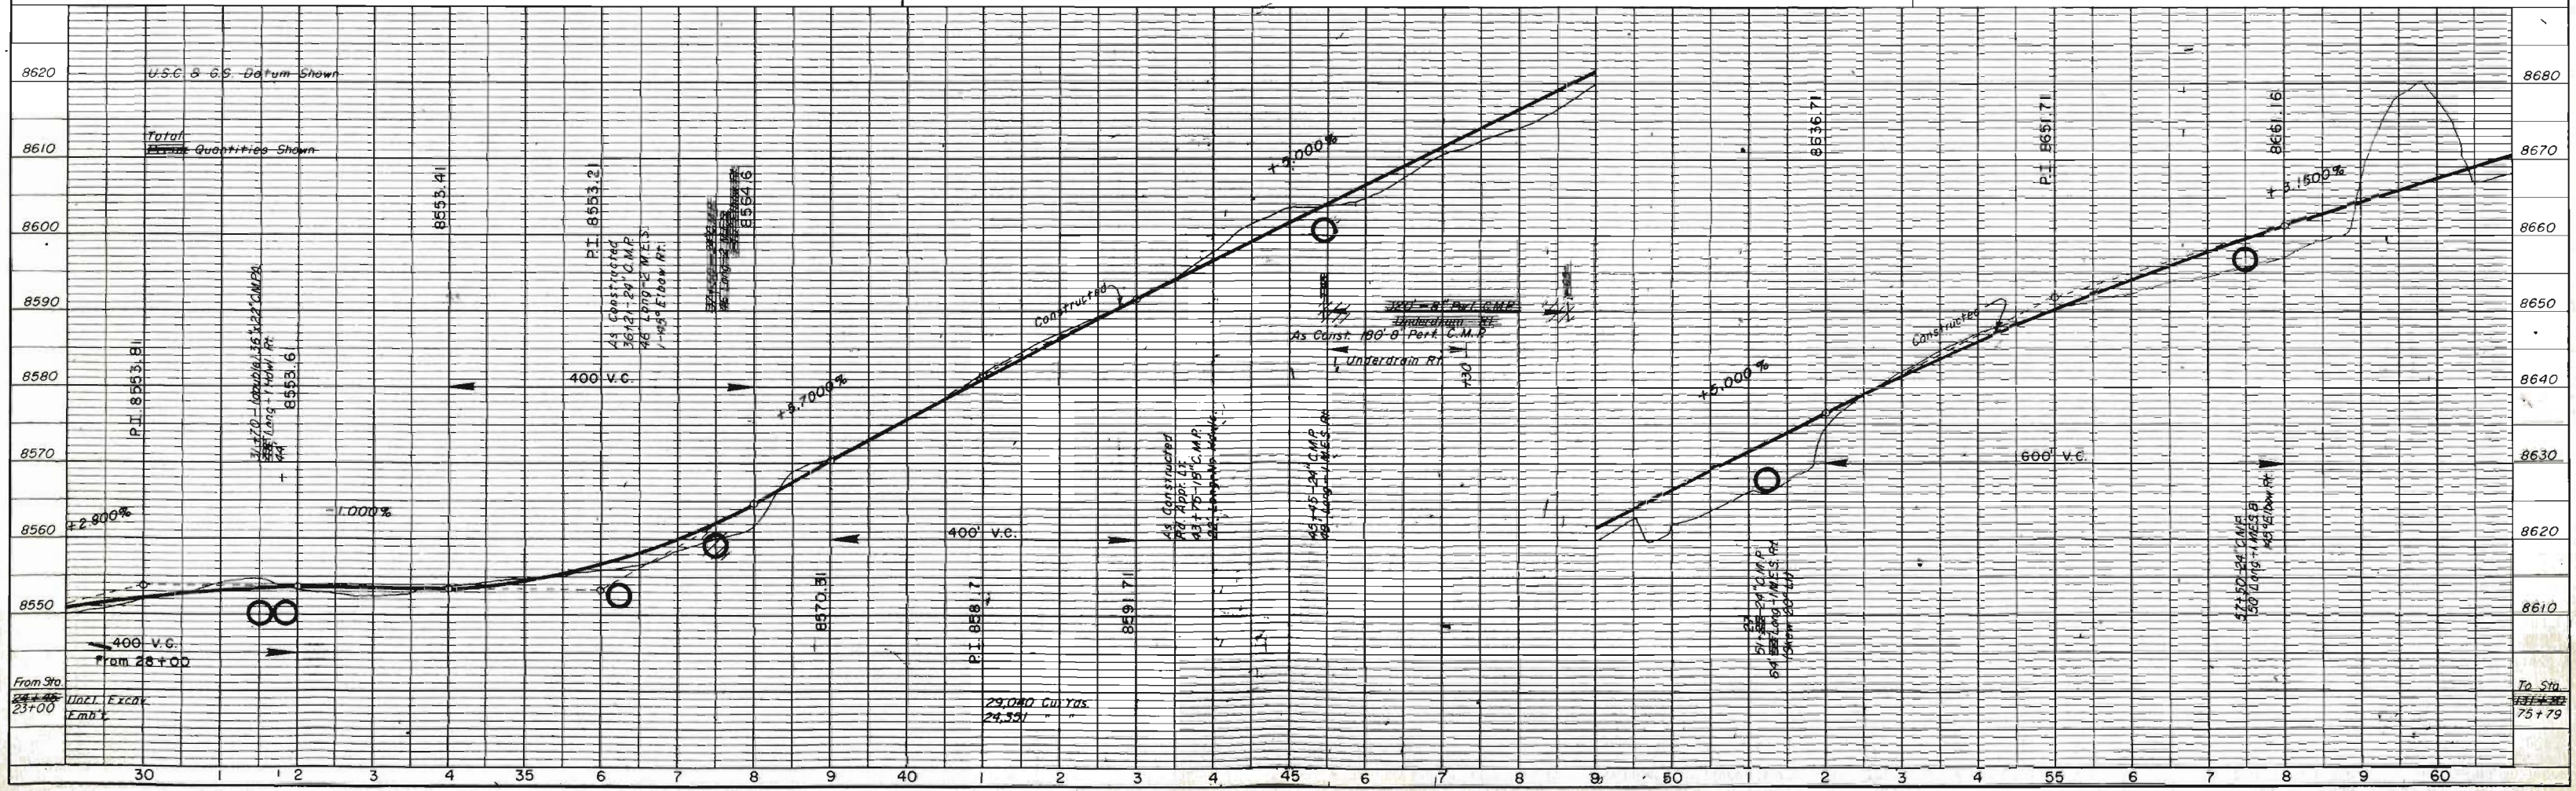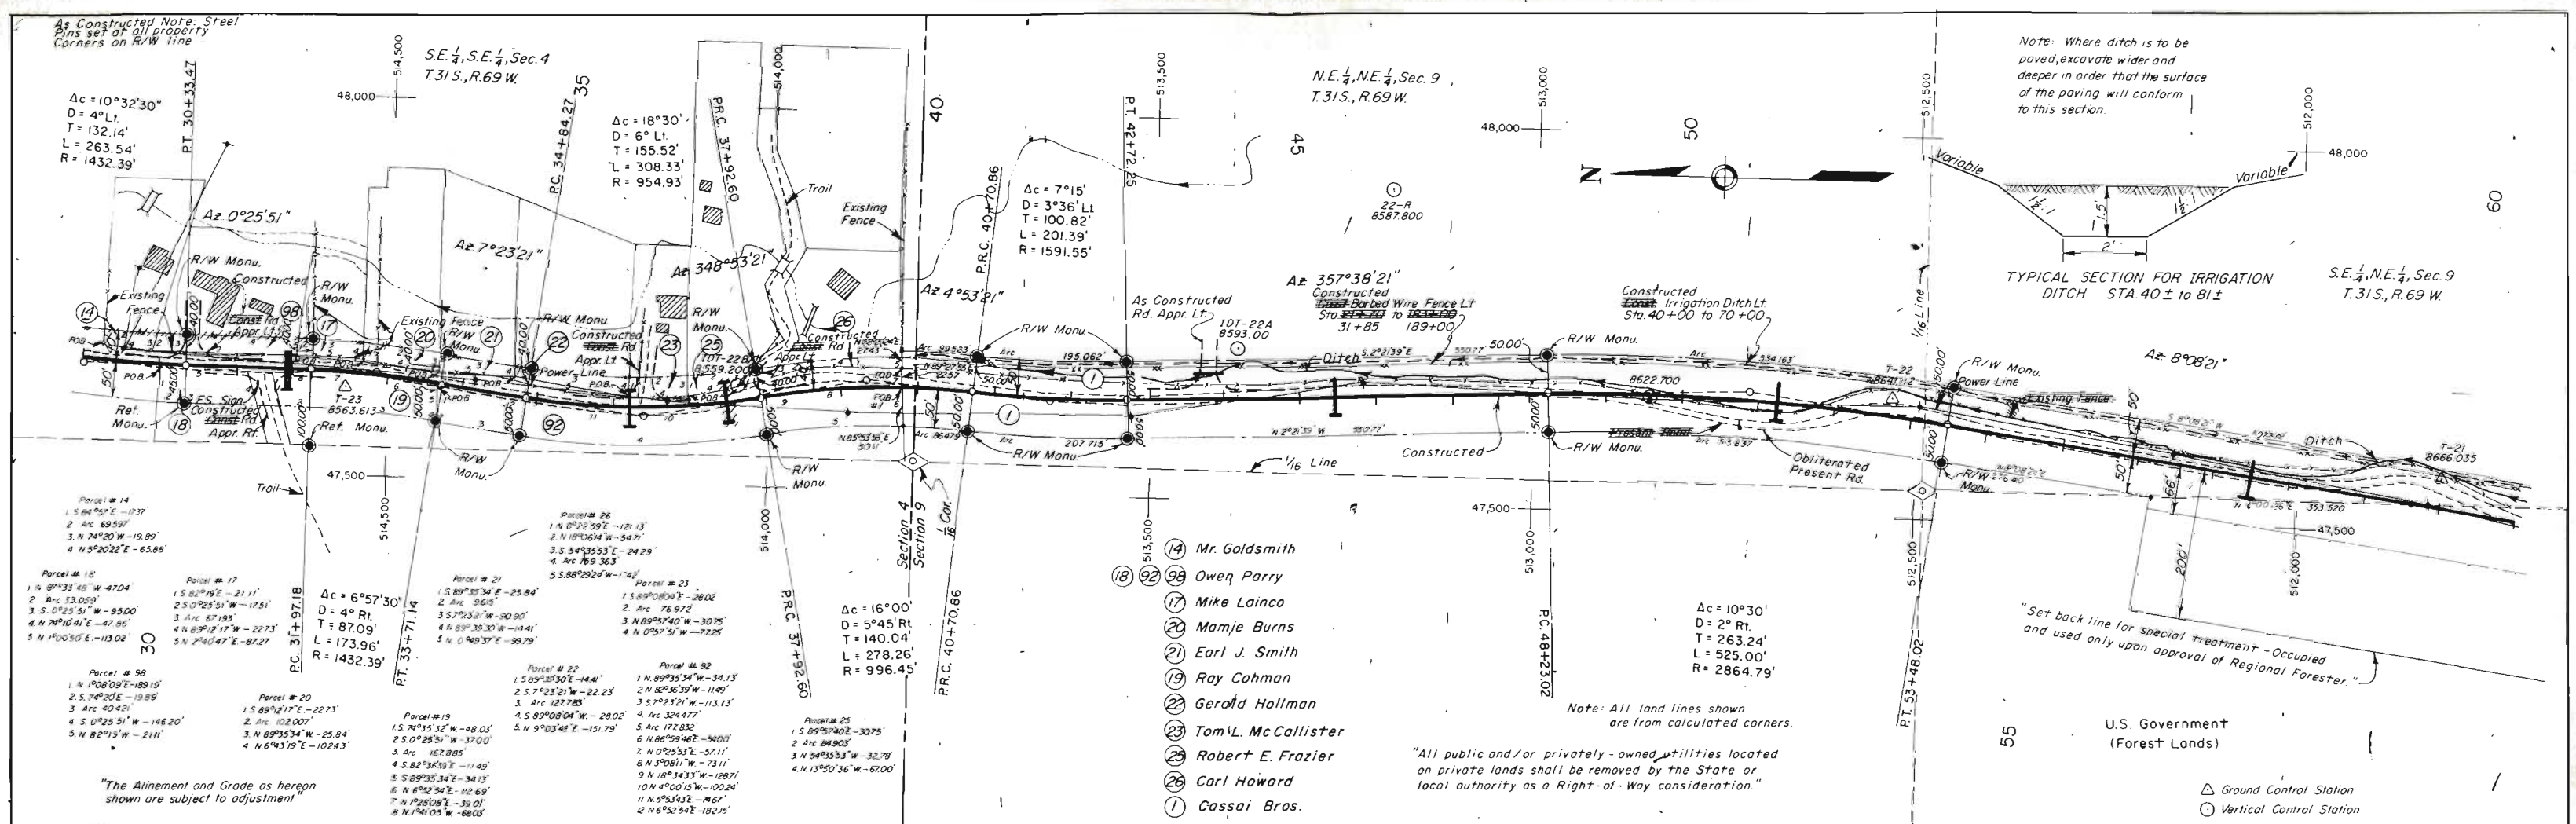







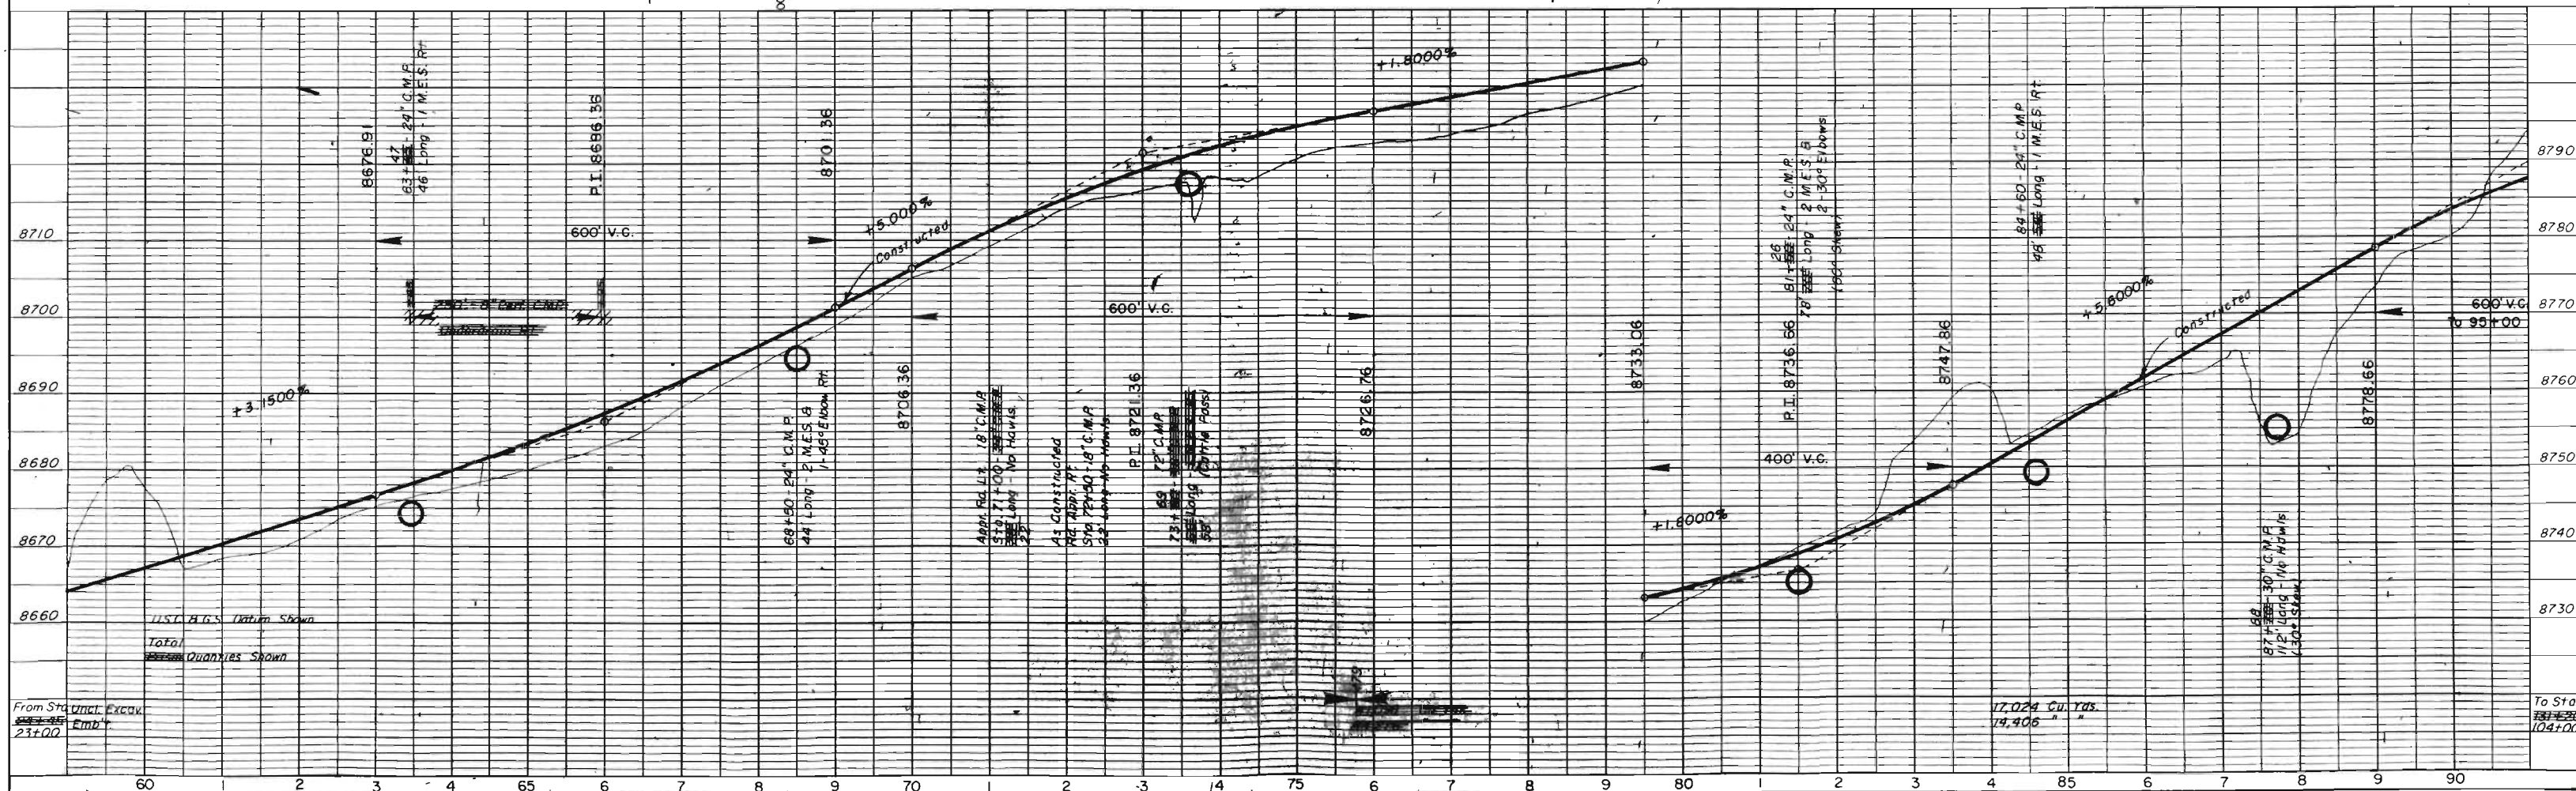


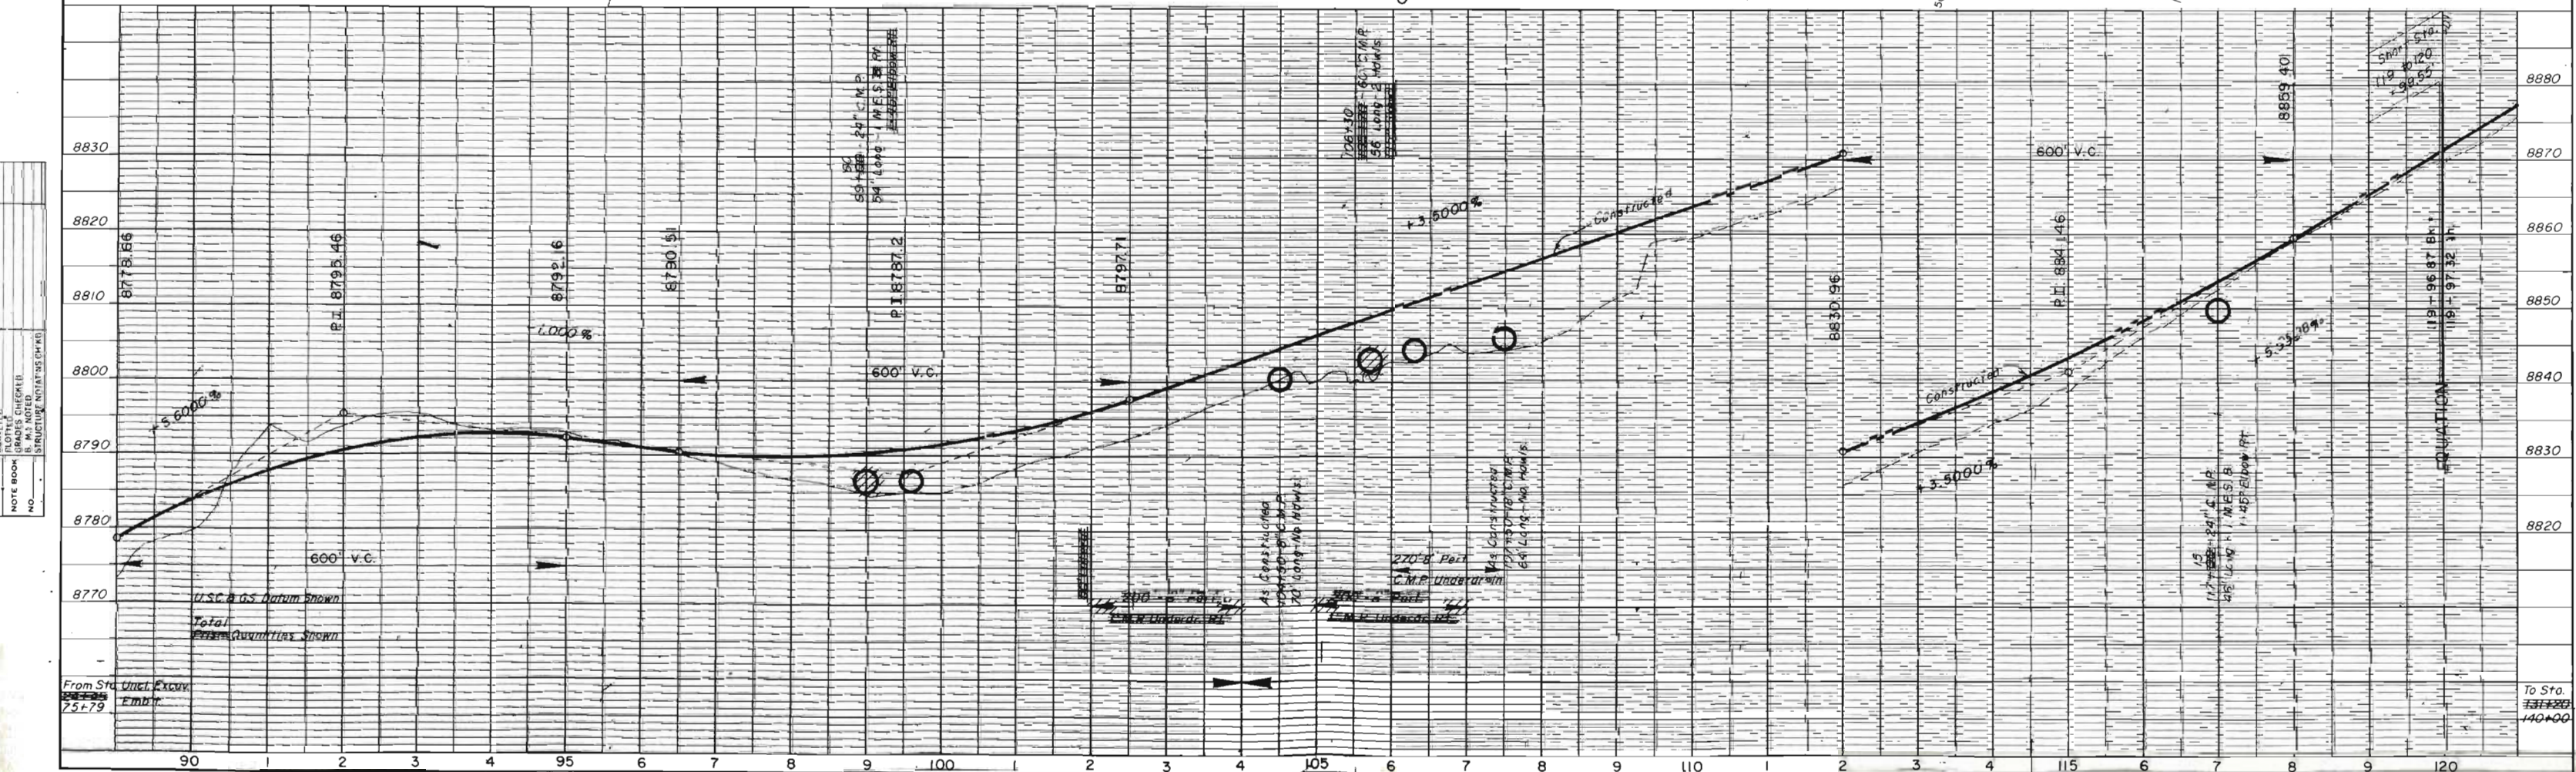

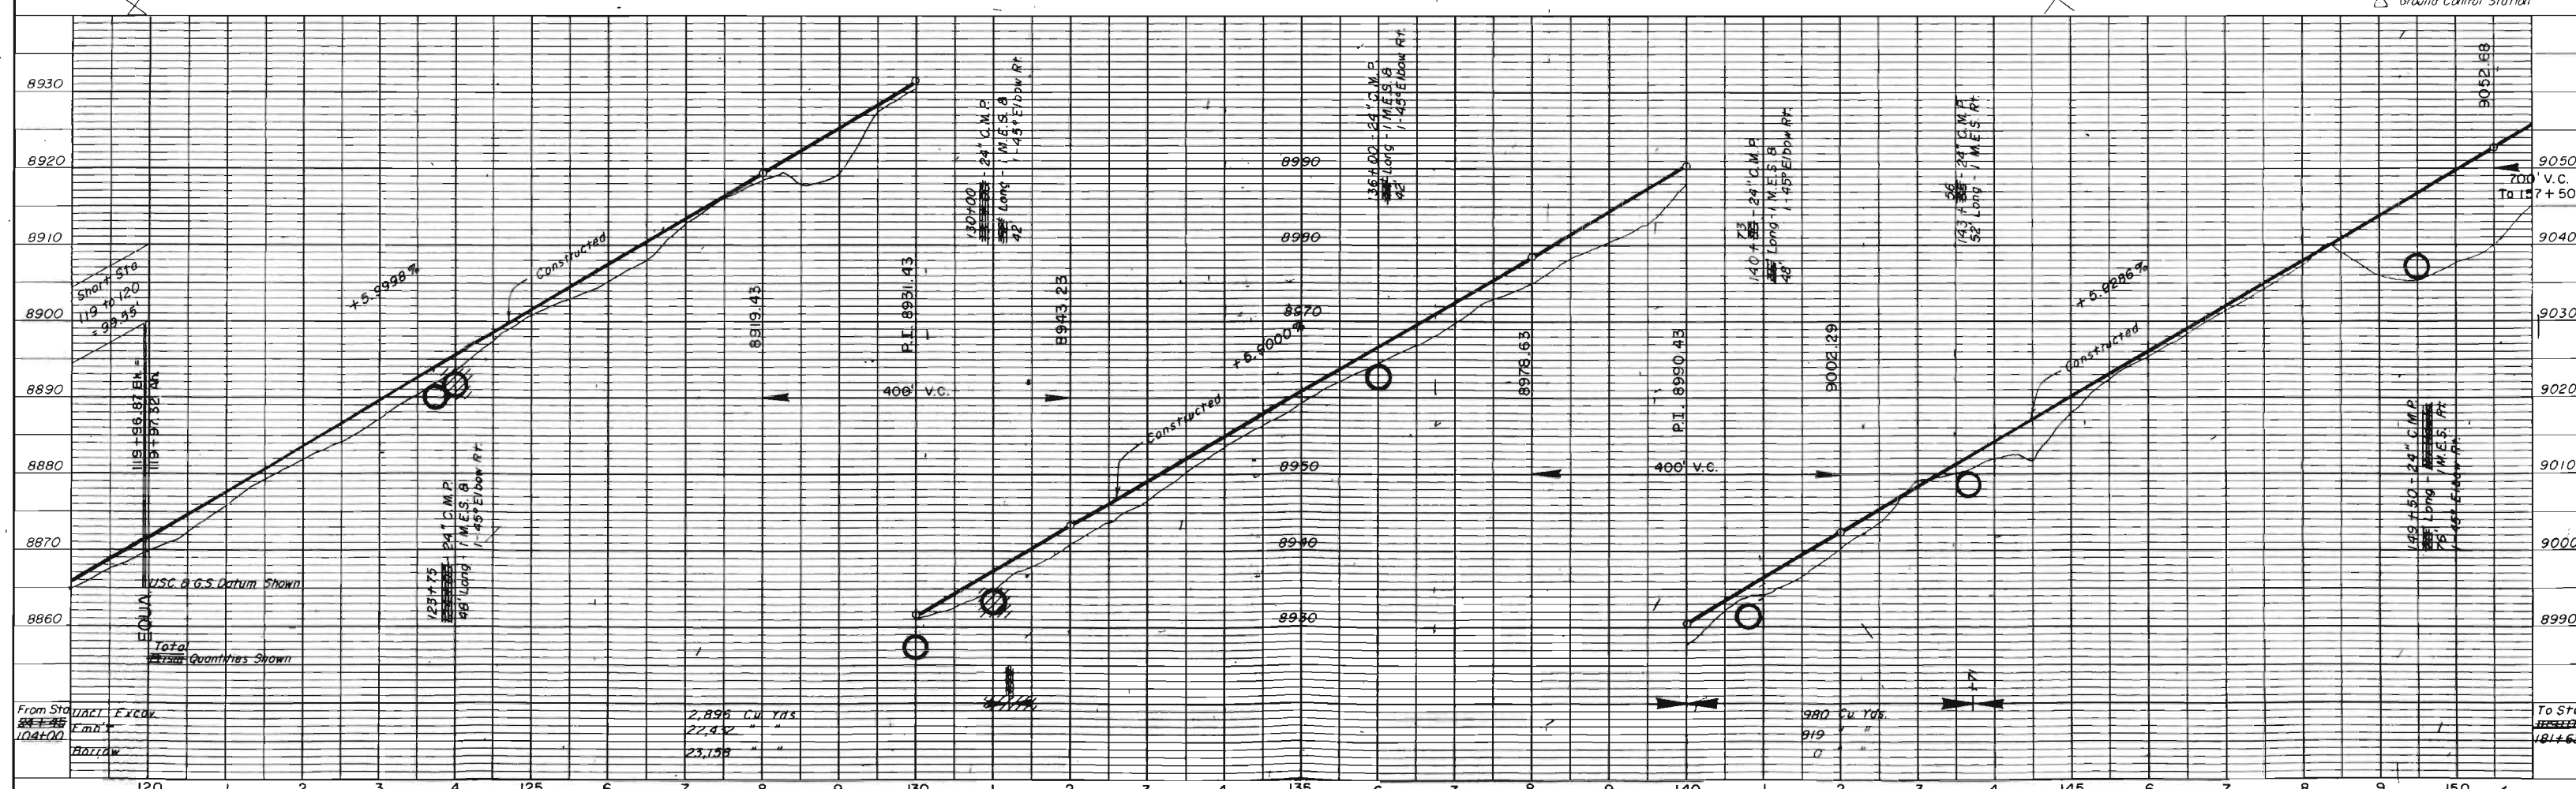

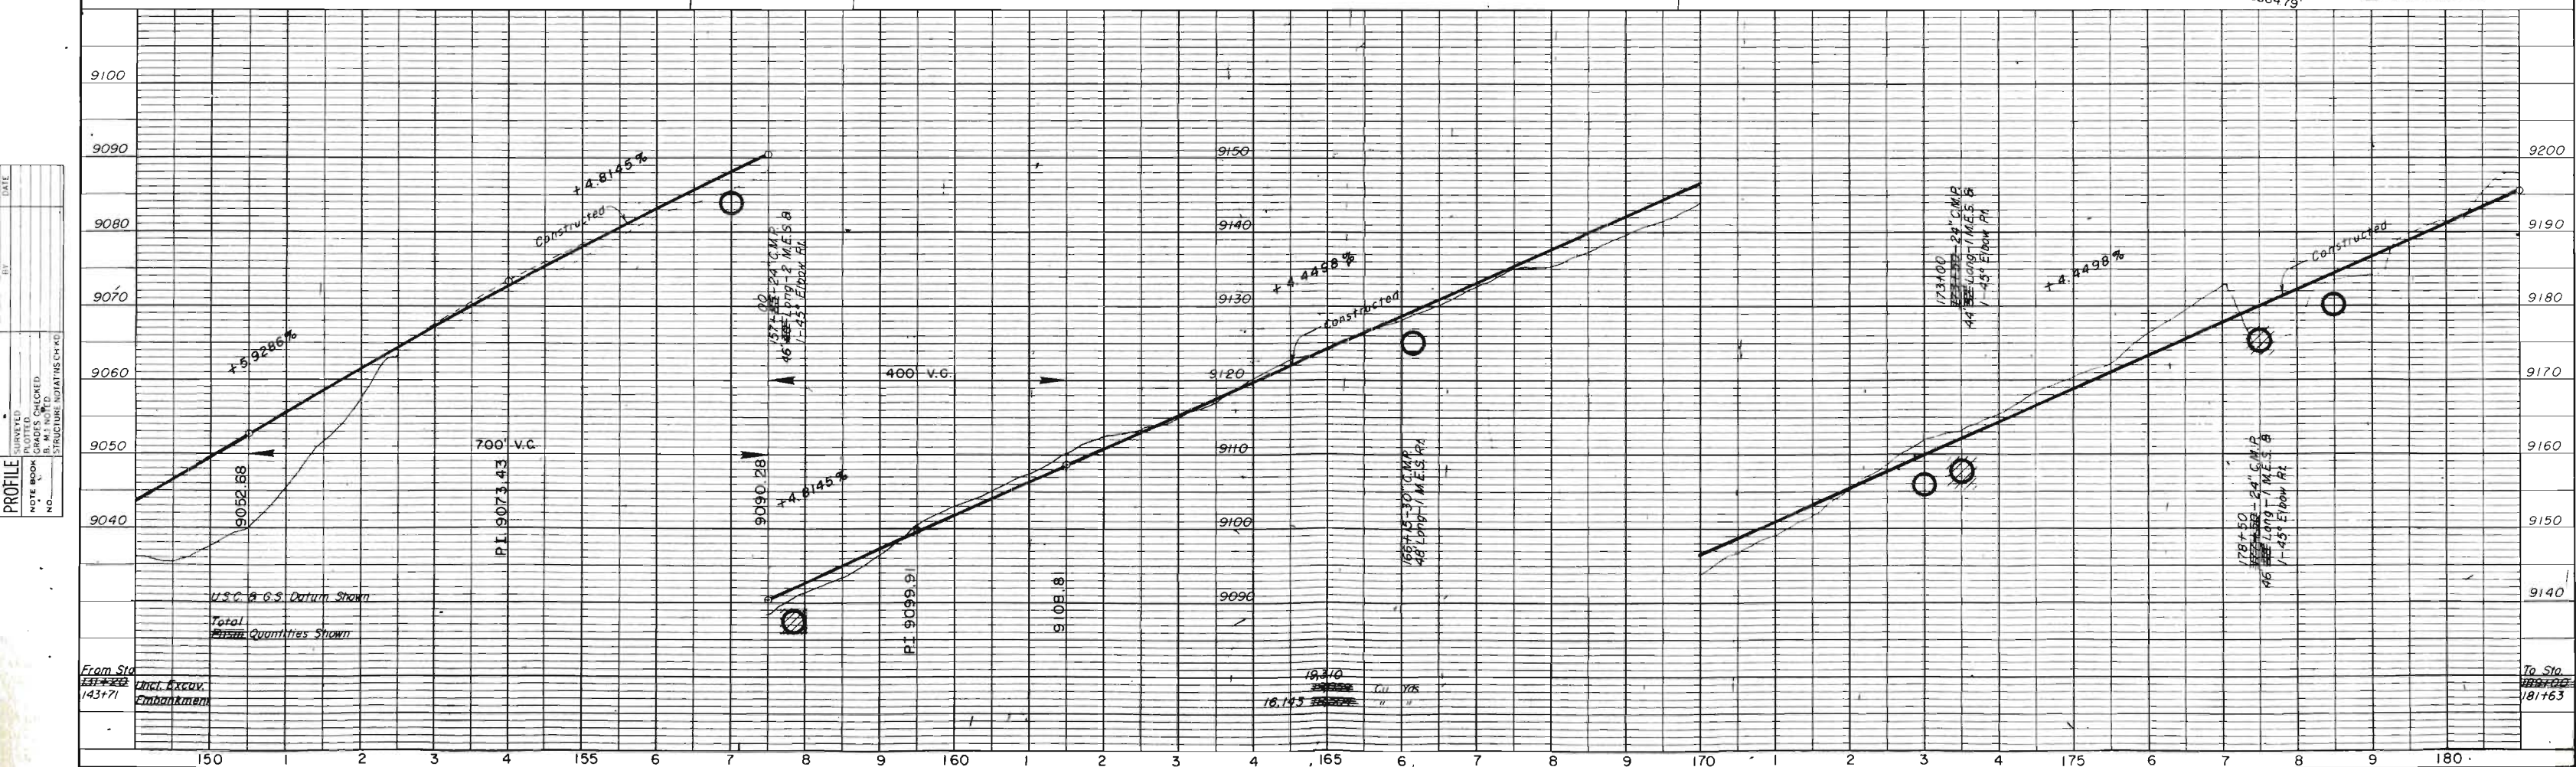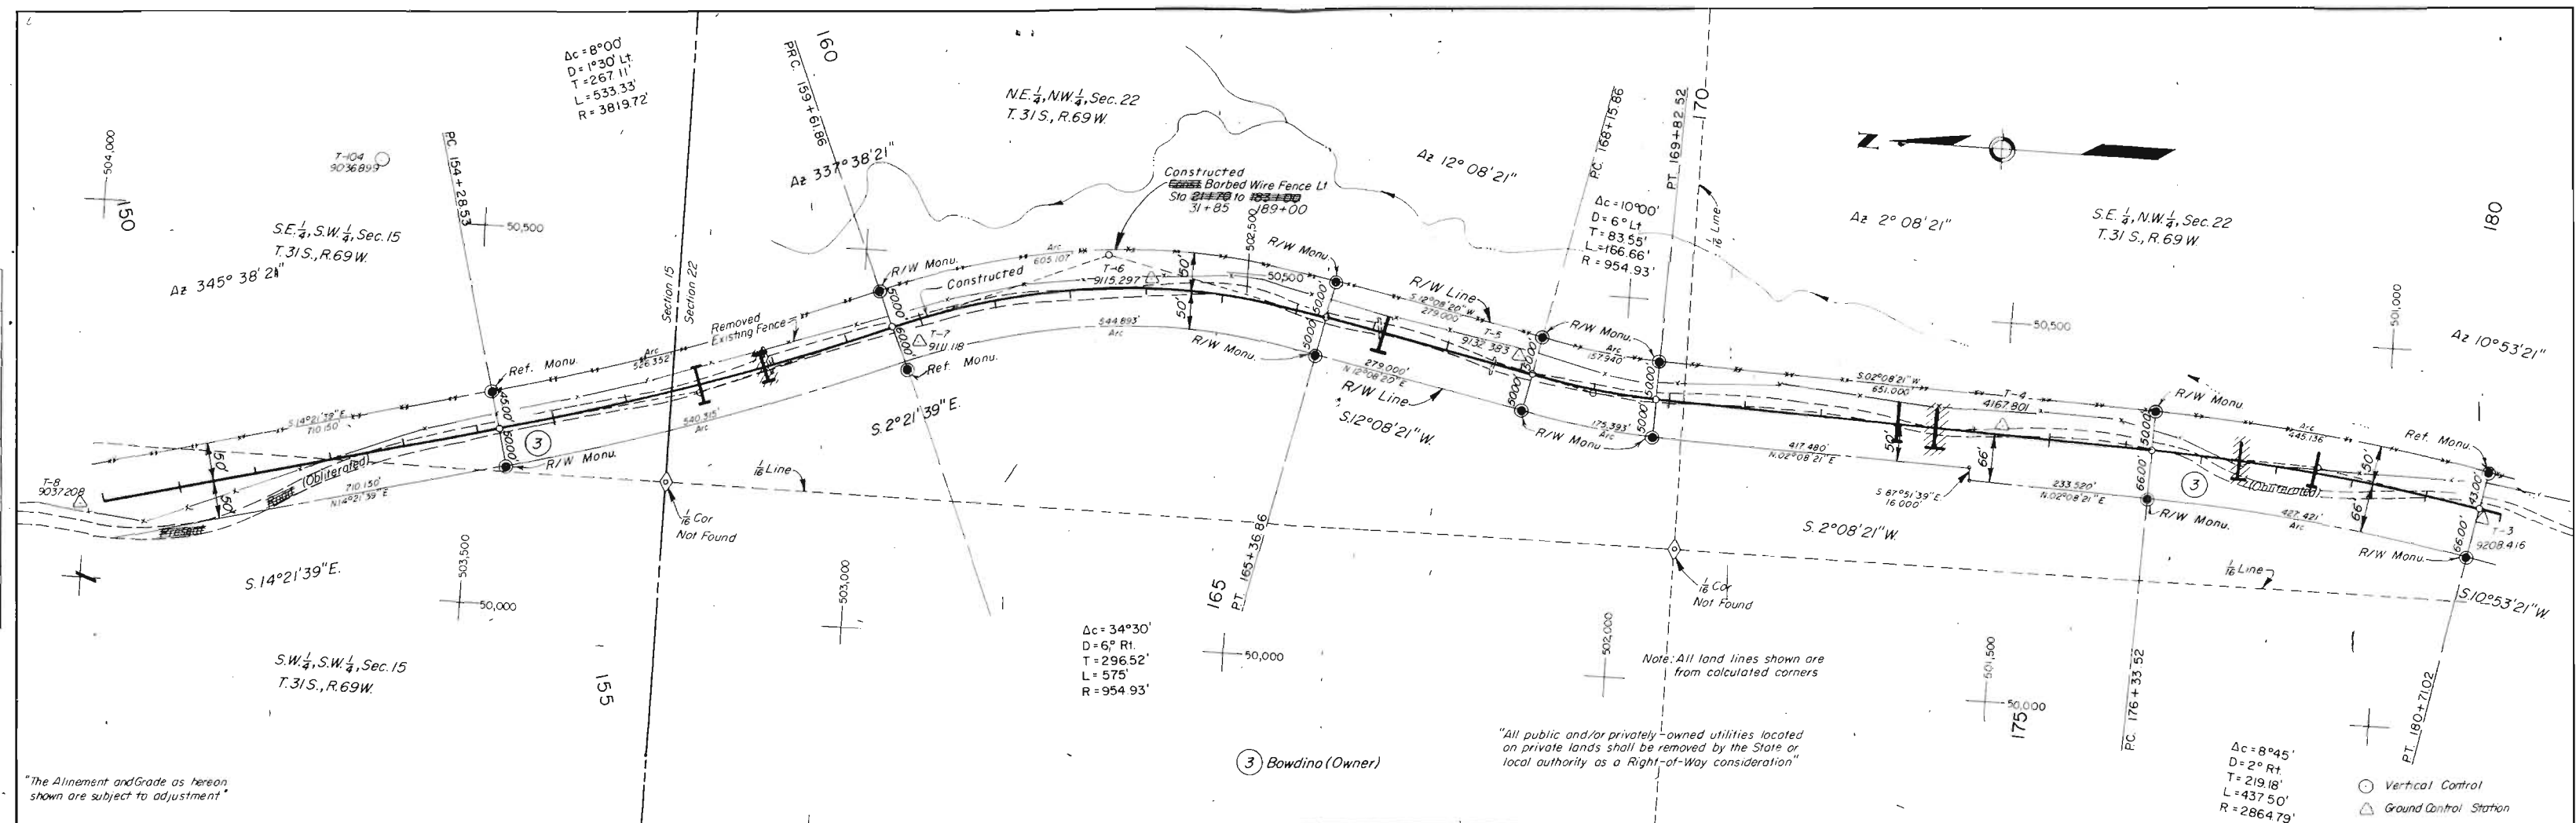



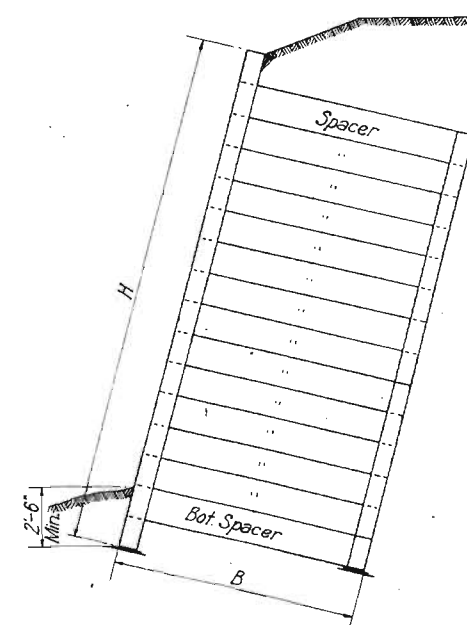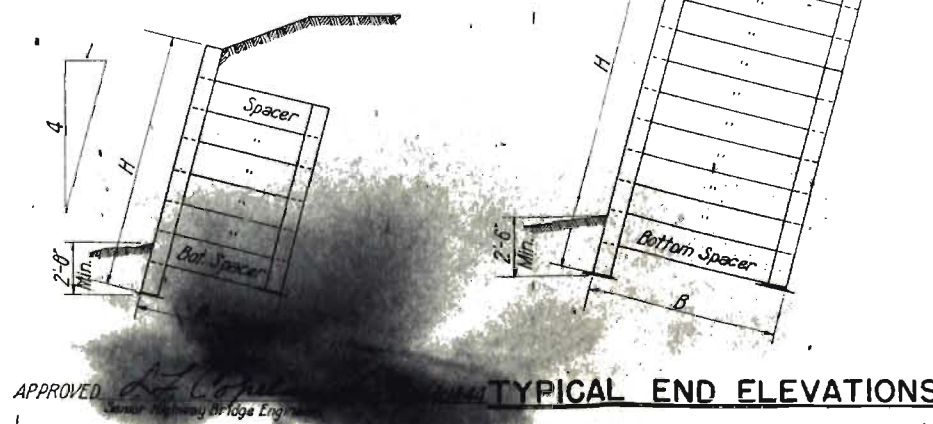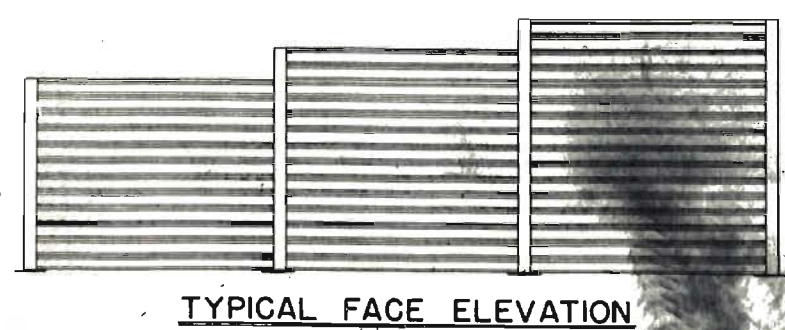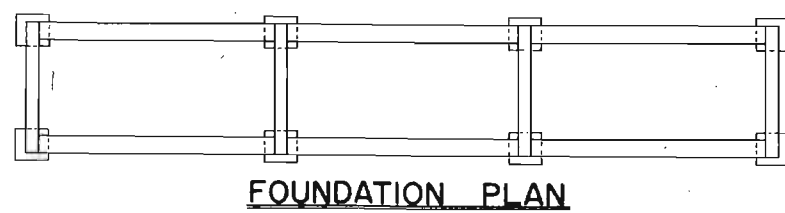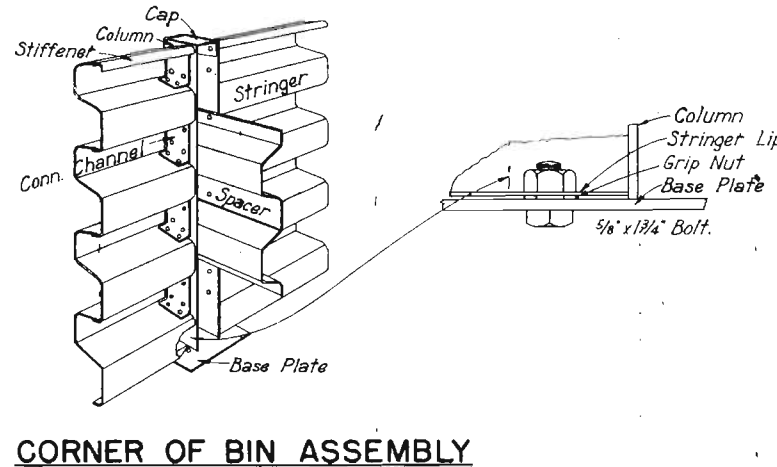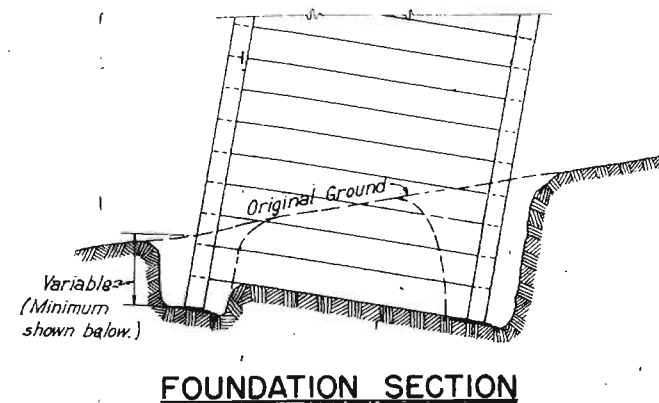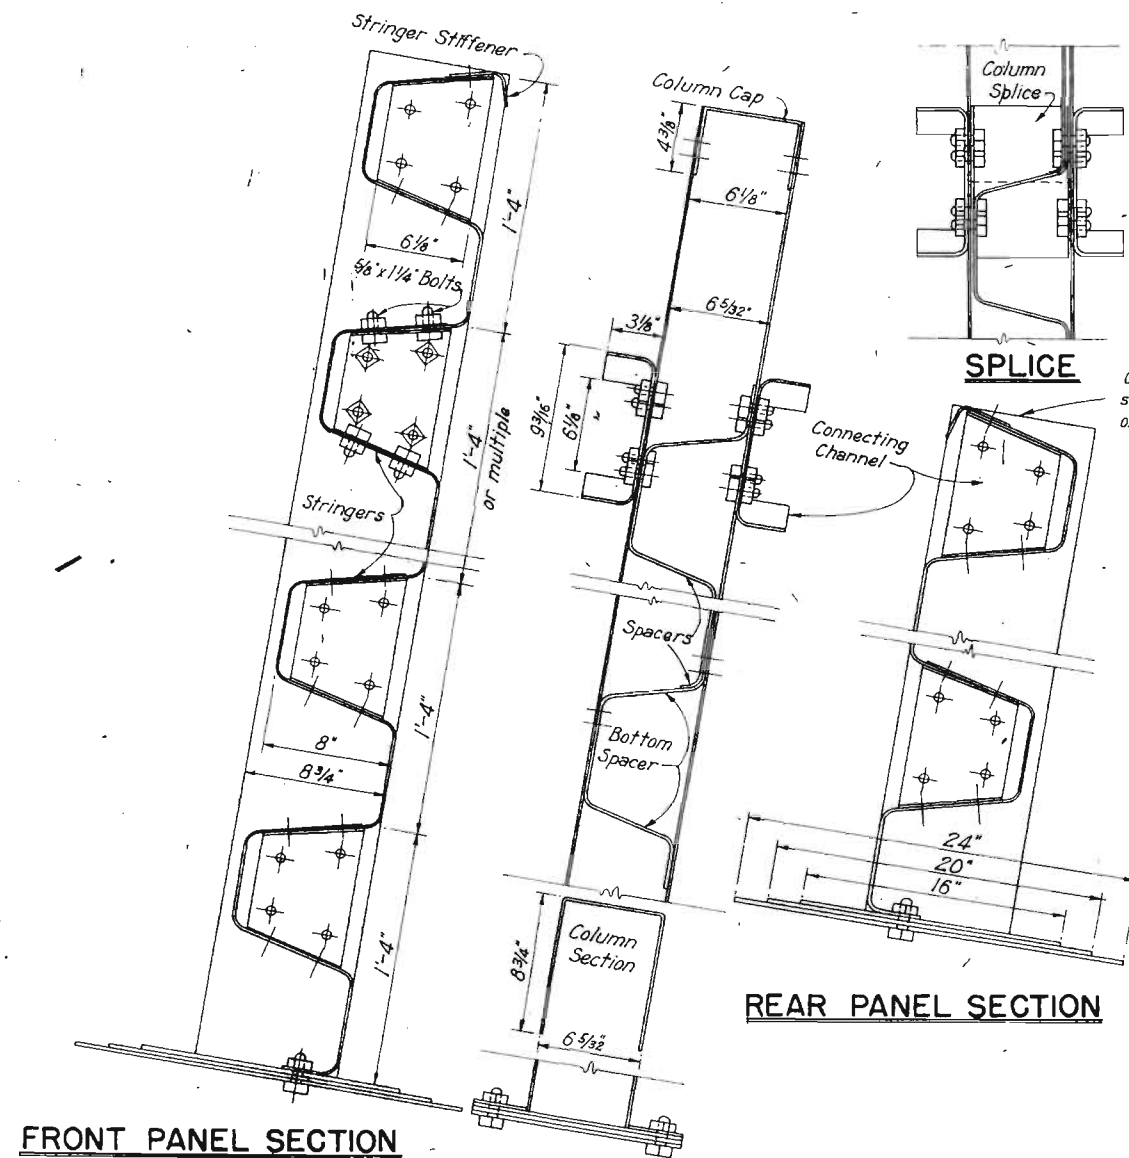

GENERAL NOTES

Generally in the design of Bin Type Metal Cribbing, a base width equal to approximately 45% of the wall height is to be used with level surcharge. Base width equal to approximately 50% of the wall height is to be used with slight surcharge when superimposed traffic loads are near the wall. Base width equal to approximately 55% of the wall height is to be used with high surcharge. The base width to be used will be shown on the plans.

In the construction of a wall on a curve the proper curvature for the face shall be obtained by the use of shorter stringers in the front or rear panels of Retaining Walls as designated on the plans or by the Engineer.

The wall height may be varied, but not to exceed the maximum height shown for the design selected. Two or more designs of Retaining Walls may be incorporated in the same wall by the use of special split columns to make the connection on the step-back.

All necessary stringer stiffeners, connecting channels, column splices, column caps, base plates, bolts, fittings, and any other parts required to make complete wall installation, shall be furnished and installed by the contractor and the cost included in the original contract unit price per square foot of Metal Cribbing.

Bin Type Metal Cribbing shall be backfilled in layers not exceeding 6 inches in depth and thoroughly compacted into place by hand tamping as construction progresses to insure stability of the bins. The cost of backfill to the top of the wall as indicated shall be included in the original contract unit price per square foot of Metal Cribbing.

For details of gauges see Sheet 2 of 2.

U.S. DEPARTMENT OF COMMERCE
BUREAU OF PUBLIC ROADS
REGION NO. 9 DENVER, COLO.

BIN TYPE METAL CRIBBING

DESIGN	WALL HEIGHT	UNITS REQUIRED IN PANEL SECTIONS (FRONT & REAR) AND TRANSVERSE SECTION																										
		UNIT	STRINGER					SPACER					BOTTOM SPACER					STR. ST.	COLUMN (FEET)	COL. CAP.	COL. SPL.	BEAR. PLATE						
			GAGE	16	14	12	10	16	16	14	12	12	16	16	14	12	12					8	8	12	14	1	1	1
			LENGTH	9.5	9.5	9.5	9.5	5.2	7.4	9.6	11.8	14.0	5.2	7.4	9.6	11.8	14.0					9.5	TOTAL	-	-	16"	20"	24"
A	4.00	P. SEC.	4														1	5.52	1		2							
		T. "	"														1											
	5.33	P. "	6														1				2							
		T. "	"														1											
	6.67	P. "	8														1				2							
		T. "	"														1											
	8.00	P. "	10														1				2							
	T. "	"														1												
	9.33	P. "	12														1				2							
		T. "	"														1											
	10.67	P. "	14														1				2							
		T. "	"														1											
B	9.33	P. "	12														1				2	2						
		T. "	"														1											
	10.67	P. "	14														1				2	2						
		T. "	"														1											
	12.00	P. "	14	2													1				2	2						
		T. "	"														1											
	13.33	P. "	14	4													1				2	2						
	T. "	"														1												
	14.67	P. "	14	6													1				2	2						
		T. "	"														1											
	16.00	P. "	14	8													1				2	2						
		T. "	"														1											
	17.33	P. "	14	8	2												1				2	2						
		T. "	"														1											
C	14.67	P. "	14	6													1				2	2						
		T. "	"														1											
	16.00	P. "	14	8													1				2	2						
		T. "	"														1											
	17.33	P. "	14	8	2												1				2	2						
		T. "	"														1											
	18.67	P. "	14	8	4												1				3	2						
	T. "	"														1												
	20.00	P. "	14	8	6												1				3	2						
		T. "	"														1											
	21.33	P. "	14	8	8												1				3	2						
		T. "	"														1											
D	18.67	P. "	14	8	4												1				3	2						
		T. "	"														1											
	20.00	P. "	14	8	6												1				3	2						
		T. "	"														1											
	21.33	P. "	14	8	8												1				3	2						
		T. "	"														1											
	22.67	P. "	14	8	10												1				3	2						
	T. "	"														1												
	24.00	P. "	14	8	12												1				4	2						
		T. "	"														1											
	25.33	P. "	14	8	14												1				5	2						
		T. "	"														1											
	26.67	P. "	14	8	14	2											1				5	2						
		T. "	"														1											
E	22.67	P. "	14	8	10												1				3	2						
		T. "	"														1											
	24.00	P. "	14	8	12												1				4	2						
		T. "	"														1											
	25.33	P. "	14	8	14												1				5	2						
		T. "	"														1											
	26.67	P. "	14	8	14	2											1				5	2						
	T. "	"														1												
	28.00	P. "	14	8	14	4											1				5	2						
		T. "	"														1											
	29.33	P. "	14	8	14	6											1				5	2						
		T. "	"														1											
	30.67	P. "	14	8	14	8											1				5	2						
		T. "	"														1											

COLUMN ARRANGEMENT FOR VARIOUS WALL HEIGHTS											
WALL HEIGHT (FT. IN.)	WALL HEIGHT (FEET)	FRONT COLUMN HEIGHT				TOTAL HEIGHT	REAR COLUMN HEIGHT				FRONT & REAR COL. HT.
		FIRST LIFT	SECOND LIFT	THIRD LIFT	FOURTH LIFT		FIRST LIFT	SECOND LIFT	THIRD LIFT	TOTAL HEIGHT	
4'-0"	4.00	4.09				4.09	1.43			1.43	5.52
5'-4"	5.33	5.43				5.43	2.76			2.76	8.19
6'-8"	6.67	6.76				6.76	4.09			4.09	10.85
8'-0"	8.00	8.09				8.09	5.43			5.43	13.52
9'-4"	9.33	9.43				9.43	6.76			6.76	16.19
10'-8"	10.67	10.76				10.76	8.09			8.09	18.85
12'-0"	12.00	12.09				12.09	9.43			9.43	21.52
13'-4"	13.33	6.33	7.09			13.43	10.76			10.76	24.19
14'-8"	14.67	6.33	8.43			14.76	12.09			12.09	26.85
16'-0"	16.00	6.33	9.76			16.09	10.33	3.09		13.43	29.52
17'-4"	17.33	6.33	8.00	3.09		17.43	10.33	4.43		14.76	32.19
18'-8"	18.67	6.33	8.00	4.43		18.76	10.33	5.76		16.09	34.85
20'-0"	20.00	6.33	8.00	5.76		20.09	10.33	7.09		17.43	37.62
21'-4"	21.33	6.33	8.00	7.09		21.43	10.33	8.43		18.76	40.19
22'-8"	22.67	6.33	8.00	8.43		22.76	10.33	9.76		20.09	42.85
24'-0"	24.00	6.33	8.00	9.76		24.09	10.33	8.00	3.09	21.43	45.52
25'-4"	25.33	6.33	8.00	8.00	3.09	25.43	10.33	8.00	4.43	22.76	48.19
26'-8"	26.67	6.33	8.00	8.00	4.43	26.76	10.33	8.00	5.76	24.09	50.85
28'-0"	28.00	6.33	8.00	8.00	5.76	28.09	10.33	8.00	7.09	25.43	53.52
29'-4"	29.33	6.33	8.00	8.00	7.09	29.43	10.33	8.00	8.43	26.76	56.19
30'-8"	30.67	6.33	8.00	8.00	8.43	30.76	10.33	8.00	9.76	28.09	58.85

U.S. DEPARTMENT OF COMMERCE
BUREAU OF PUBLIC ROADS
REGION NO. 9 DENVER, COLO.

BIN TYPE METAL CRIBBING