


INDEX OF SHEETS	
SHEET NO.	1 TITLE SHEET
"	" 2 TYPICAL CROSS SECTION, SUMMARY OF QUANTITIES AND GUARD FENCE.
"	" 3 LIST OF STRUCTURES, FENCING & R.O.W. MARKERS.
"	" 4 STANDARD REINF. CONC. CULV. PIPE. M-112-C
"	" 5 " HEADWALLS FOR C.M.P. CULVERTS M-102-E
"	" 6 " WIRE CABLE GUARD FENCE. M-20-A
"	" 7 " WIRE FENCES & MARKER POSTS. M-27-A
"	" 8 " SUPERELEVATION SHEET. M-1-A
"	" 9 " TRAFFIC SIGNS & APPROACH ROADS. M-2-B
"	" 10-15 PLAN AND PROFILE.
"	" 16-145 CROSS SECTIONS.


COLORADO STATE HIGHWAY DEPARTMENT PLAN AND PROFILE OF PROPOSED A. W. PROJECT NO. 6010 STATE HIGHWAY NO. 16 LARIMER COUNTY

SCALES ON ORIGINAL TRACINGS
ON PLAN, 1 IN. = 100 FT.
ON PROFILE 1 IN. = 100 FT. HORIZONTAL
1 IN. = 10 FT. VERTICAL
GRADE LINE ON PROFILE IS SHOWN AS GRADE OF FINISHED ROAD
GROSS LENGTH OF PROJECT } 14,360.0 FT. = 2.720 MI.
NET LENGTH OF PROJECT }

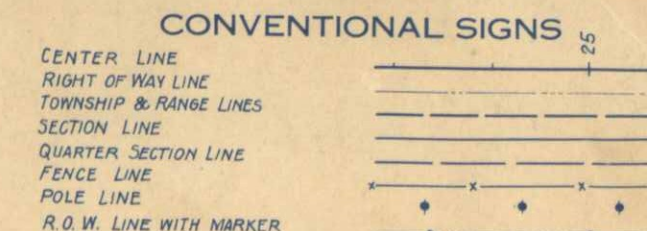

AS CONSTRUCTED PLANS
RETURN TO DIST. 4 DESIGN

NOTICE, these plans may not reflect
changes made during construction.

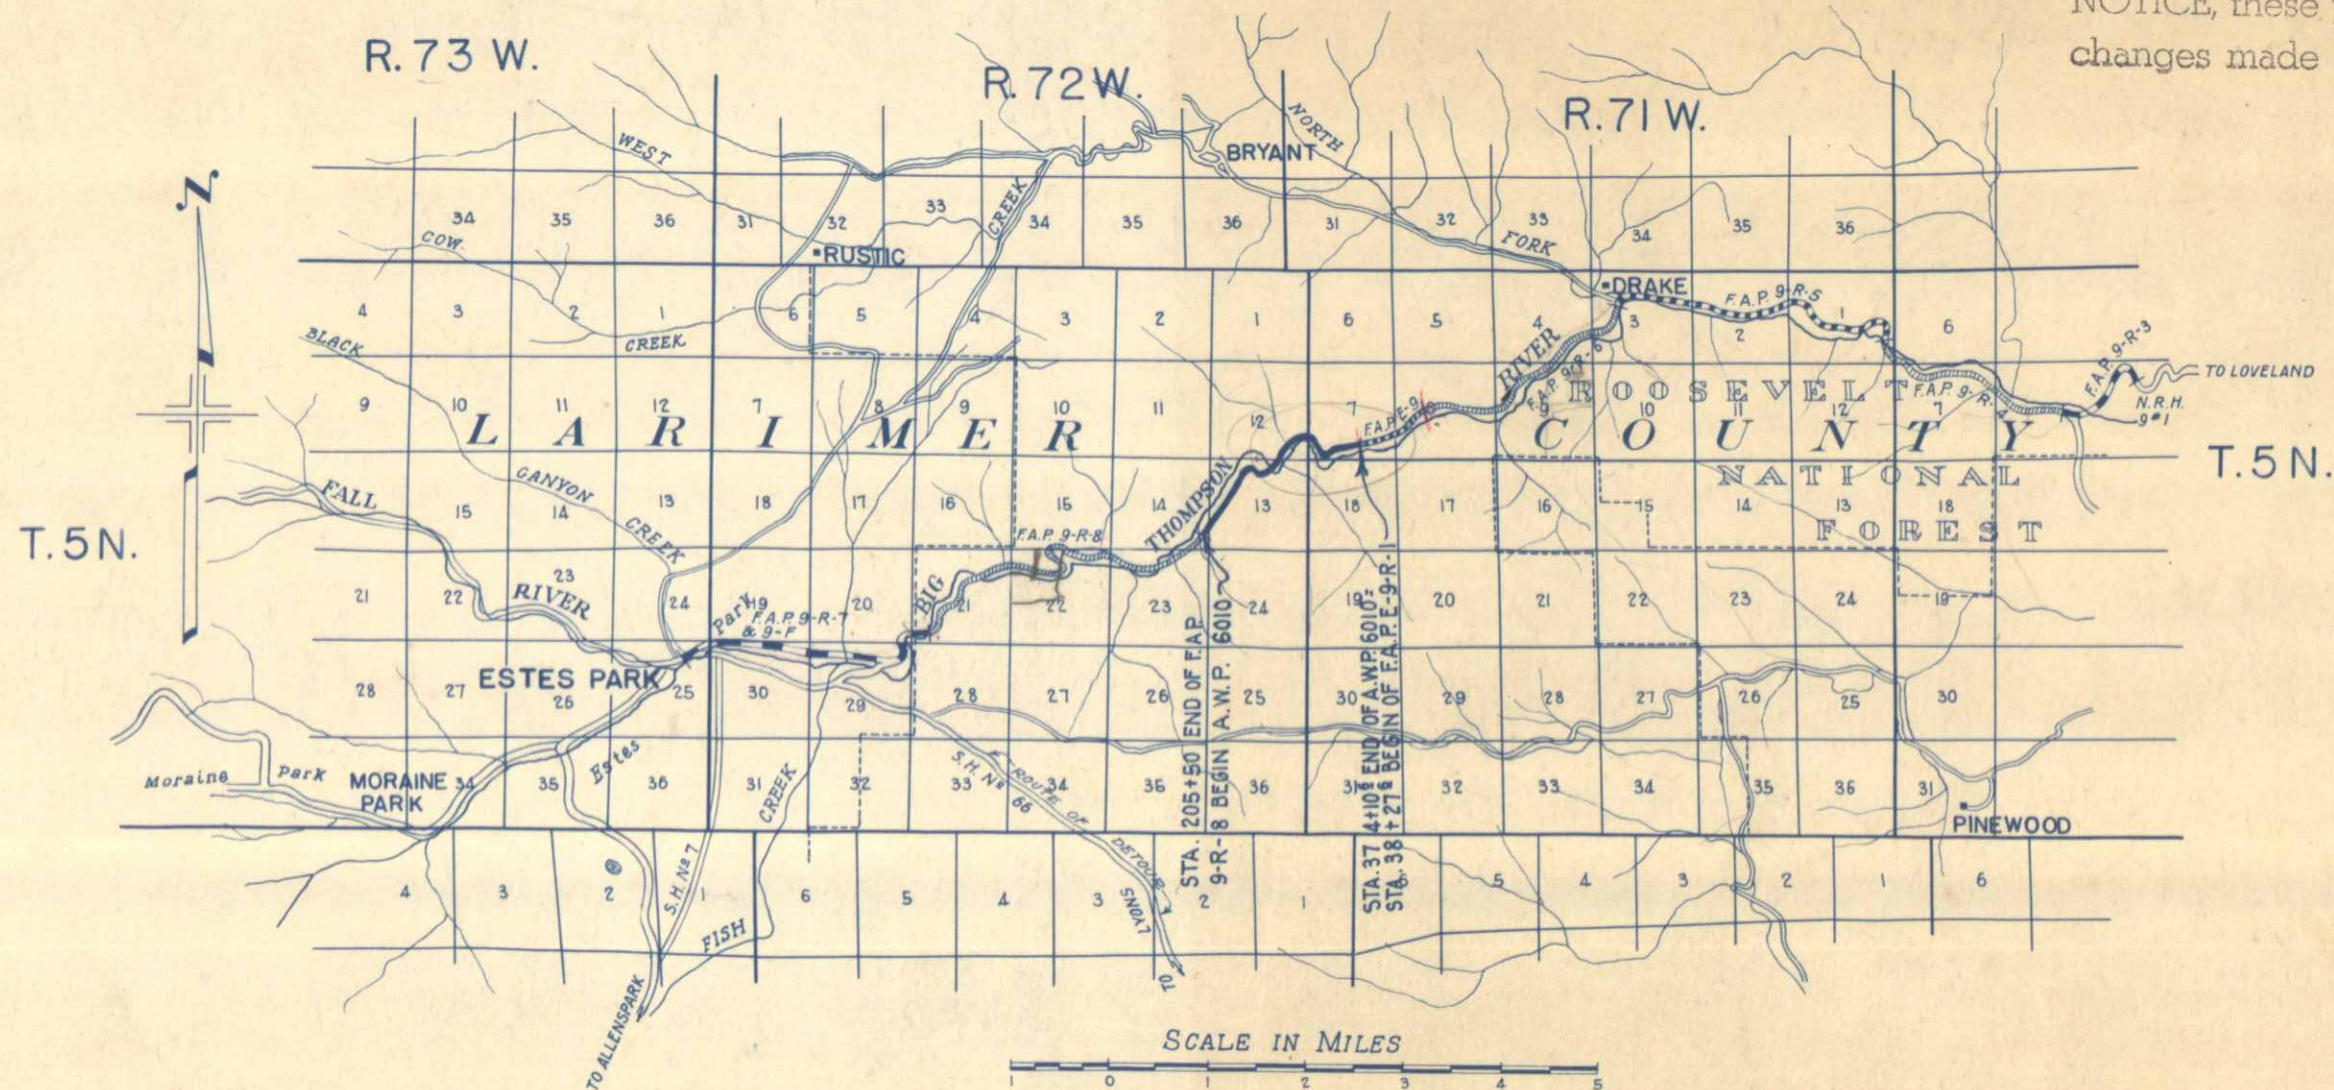



Note: The Department recommends that
prospective bidders on this project go
over the plan details with one of the
following field representatives of this
Department:
R.J. Randall - Div. Engr. - Greeley, Colo.
Clyde Walters - Res. Engr. - Loveland, "

RECOMMENDED FOR APPROVAL 11/12/36
APPROVED
Chas. D. Hall
STATE HIGHWAY ENGINEER
RECOMMENDED FOR APPROVAL
DIST. ENG. BUREAU PUBLIC ROADS
RECOMMENDED FOR APPROVAL
CHIEF ENG. BUREAU PUBLIC ROADS
APPROVED
DIRECTOR BUREAU PUBLIC ROADS

6010

Note: Poles encroaching on Construction are to be moved by owners.
Fencing & R.O.W. Markers required are tabulated on Sheet No. 3.
Guard Fence required is tabulated on Sheet No. 2
Alignment and grades as shown hereon are subject to modification during Construction.

FED. ROAD DIST. NO.	STATE	A. W. PROJ. NO.	SHEET NO.	TOTAL SHEETS
3	COLO.	6010	10	

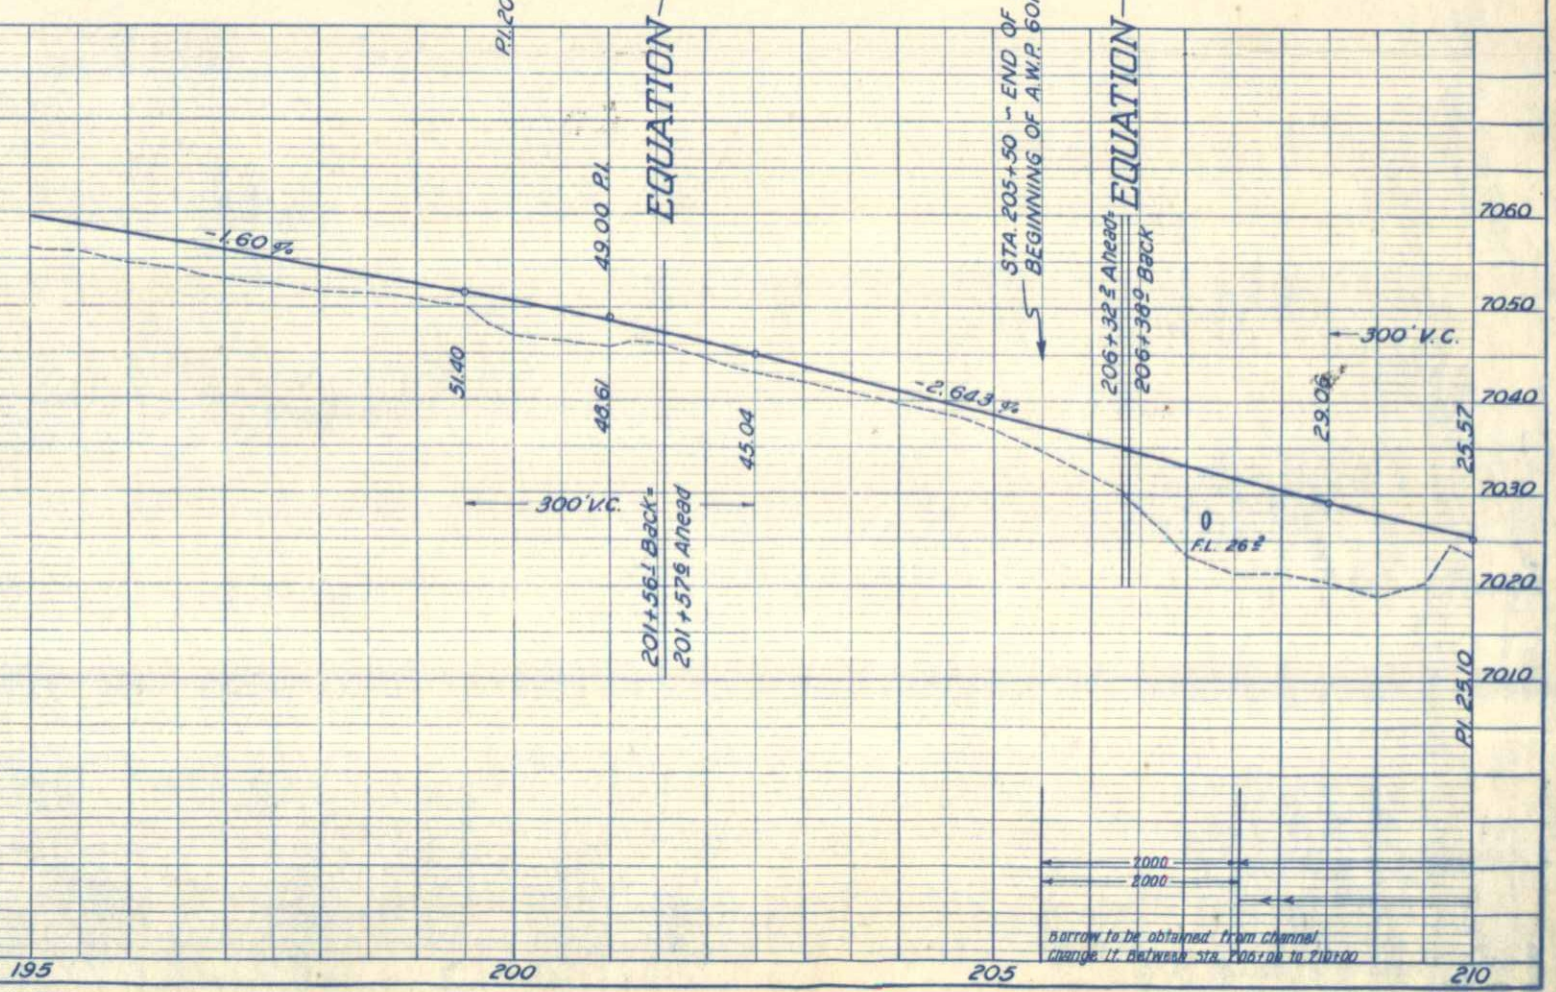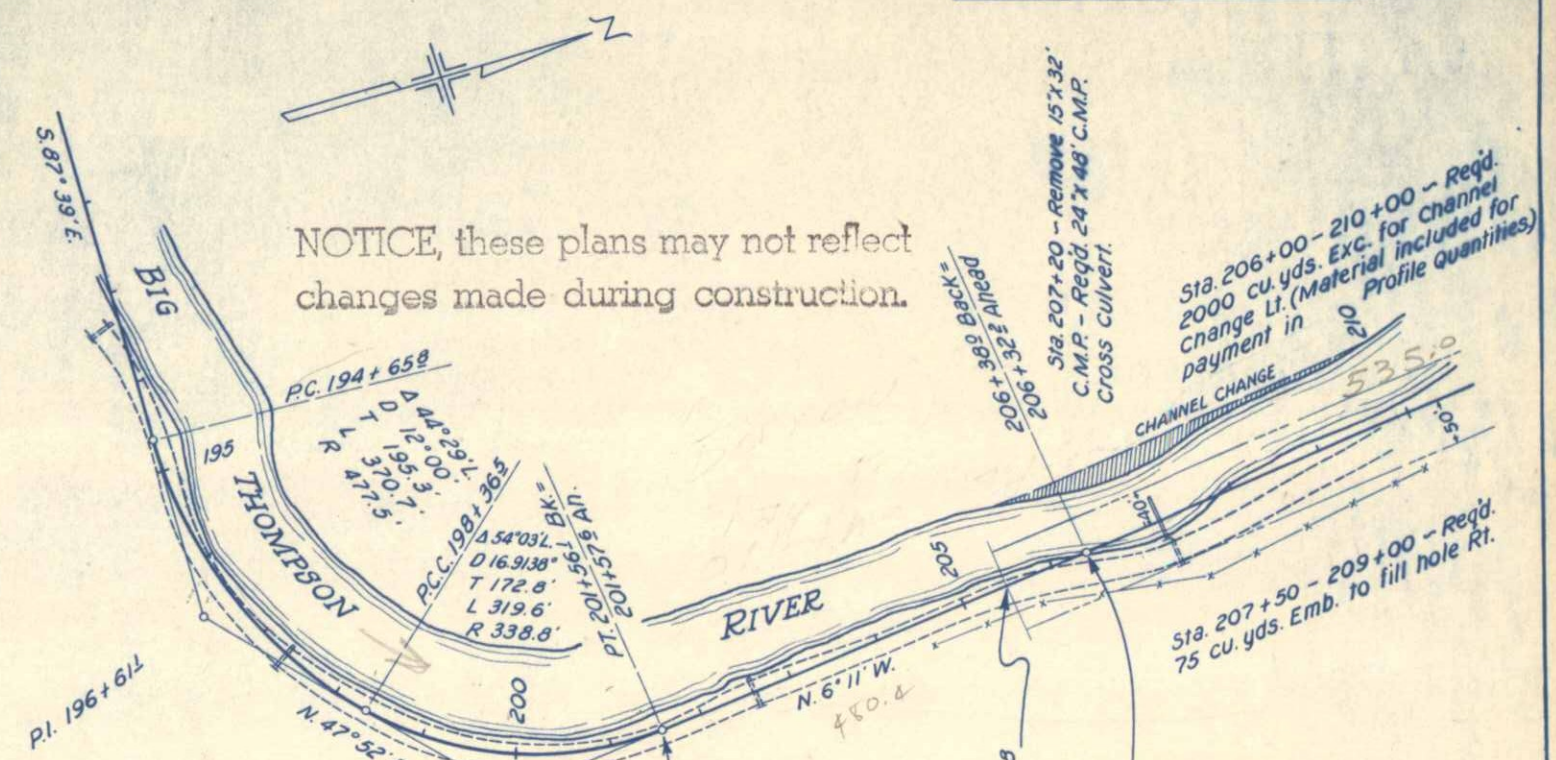


DATE	BY	REVIEWED	DATE	BY	REVIEWED

DATE	BY	REVIEWED	DATE	BY	REVIEWED

EXCAV.
EXC. FACTOR
EXC. X FACTOR
FMS
BORROW
STA. YDS. O.H.
YD. MI. D.H.
BORR. SOURCE

FED. ROAD DIST. NO.	STATE	A. W. PROJ. NO.	SHEET NO.	TOTAL SHEETS
3	COLO.	6010	//	

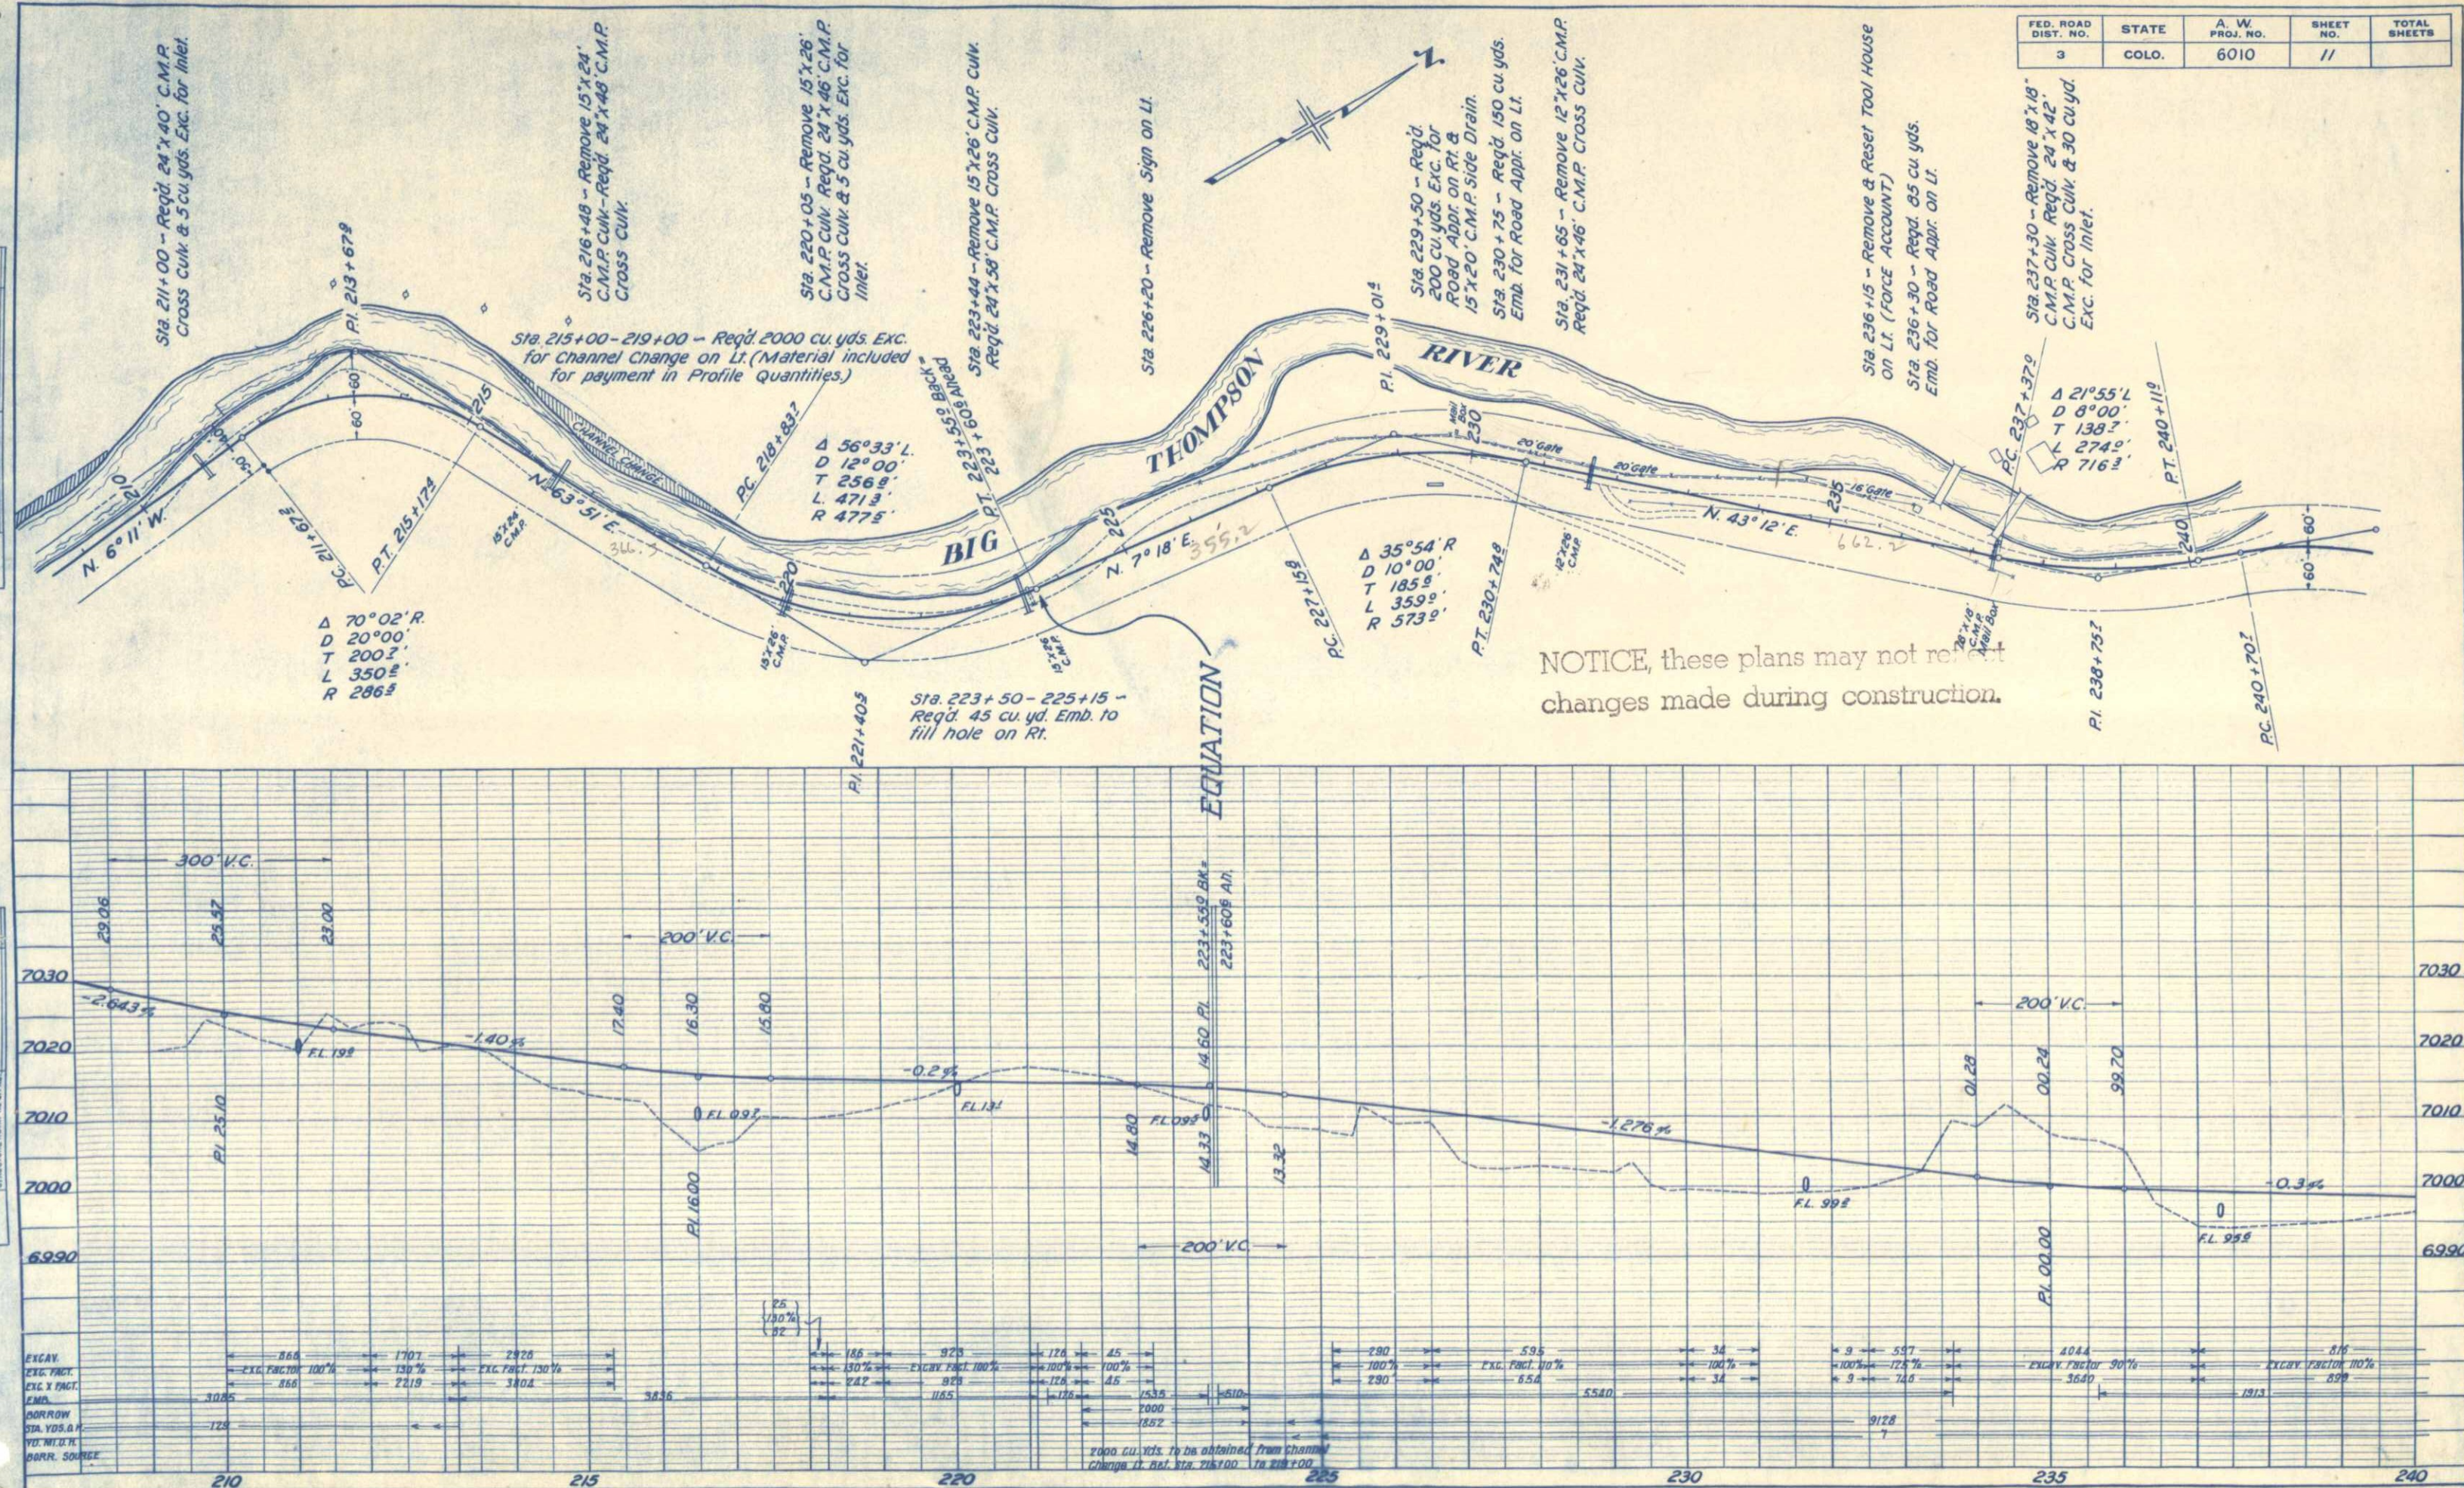

NOTICE, these plans may not reflect changes made during construction.

FED. ROAD DIST. NO.	STATE	A. W. PROJ. NO.	SHEET NO.	TOTAL SHEETS
3	COLO.	6010	12	



S.E. ¼ SEC. 12
T.5 N. R.72W.

NOTICE, these plans may not reflect changes made during construction.

Sta. 263+75 to 267+00 - Req'd.
2100 Cu. Yds. Excav. for Chan. Chge. on Lt.

Sta. 266+89 - Remove 1'x2'x22' Wd. Box Culv.
Req'd. 24"x44" C.M.P. Cross Culv. &
30 Cu. Yds. Exc. for Inlet.

Sta. 269+50 ~ Req'd. 80 Cu. Yds.
Emb. for Road Approach on Lt.

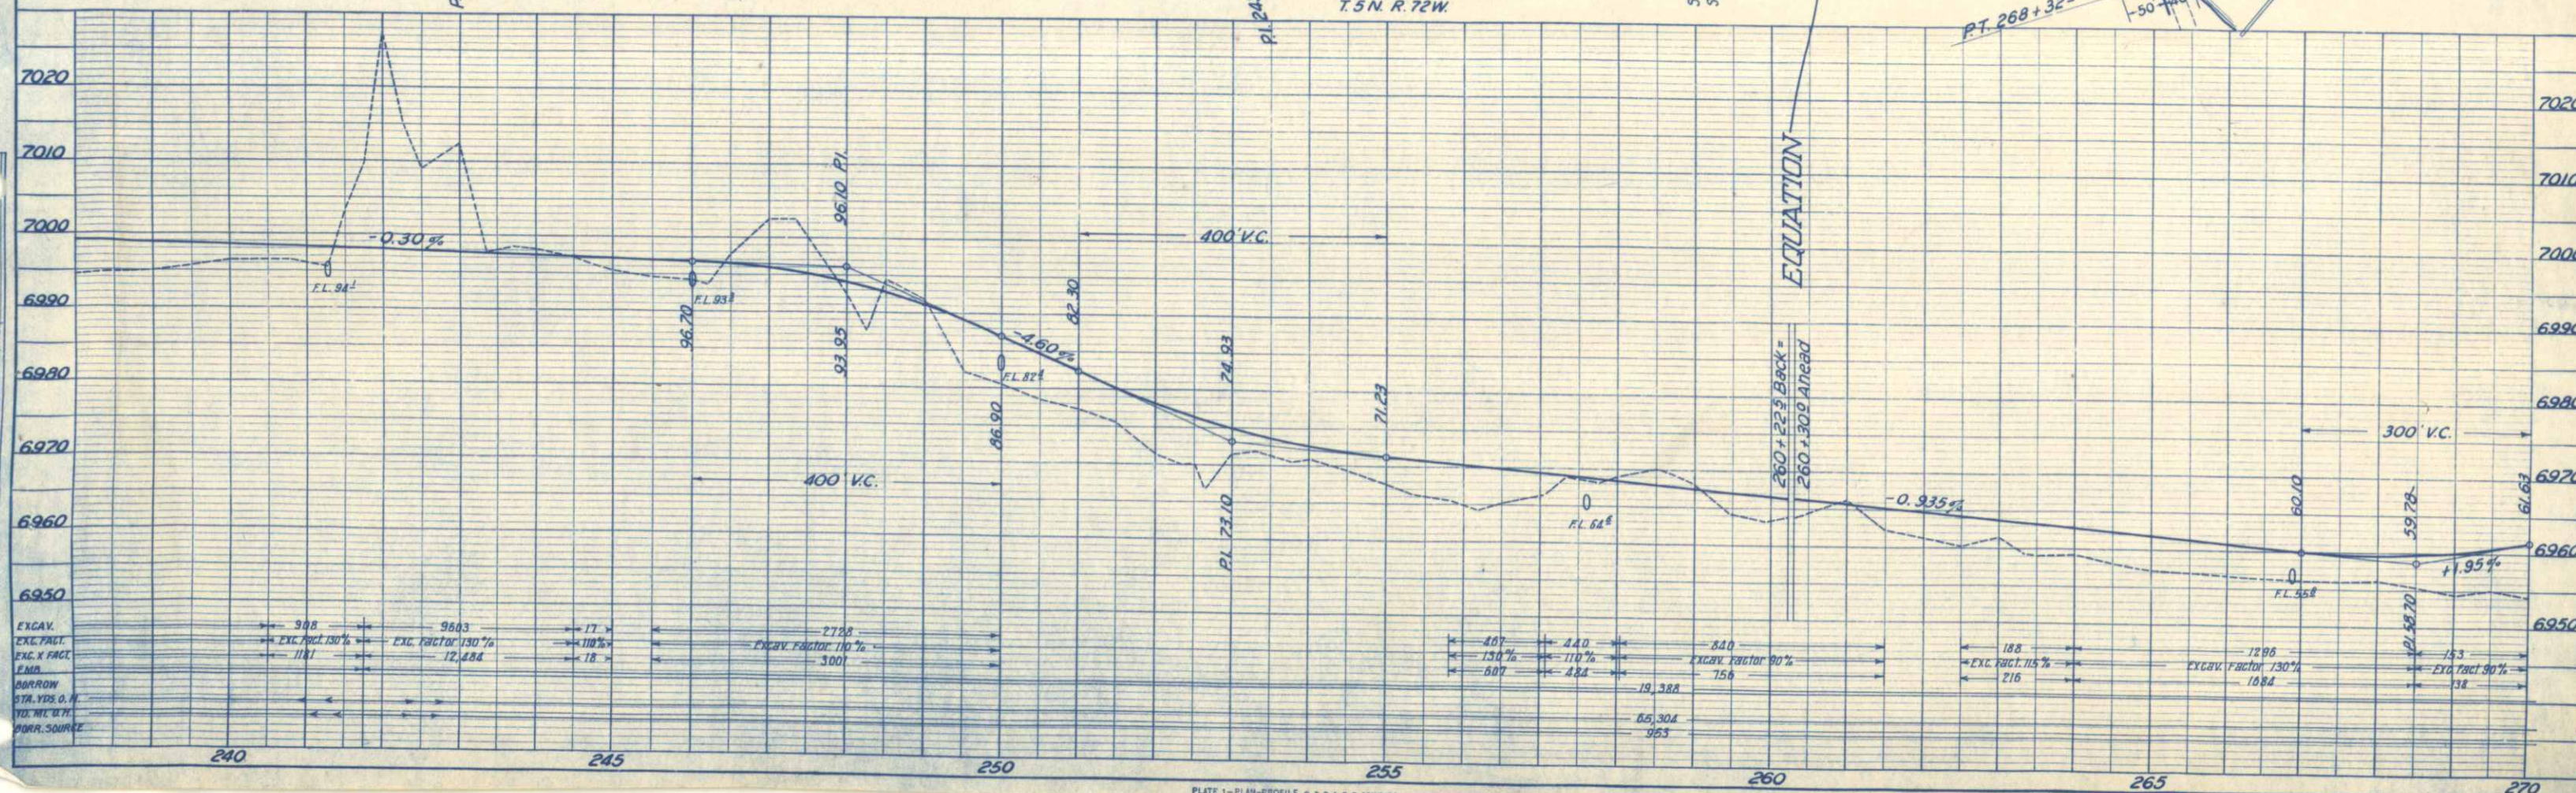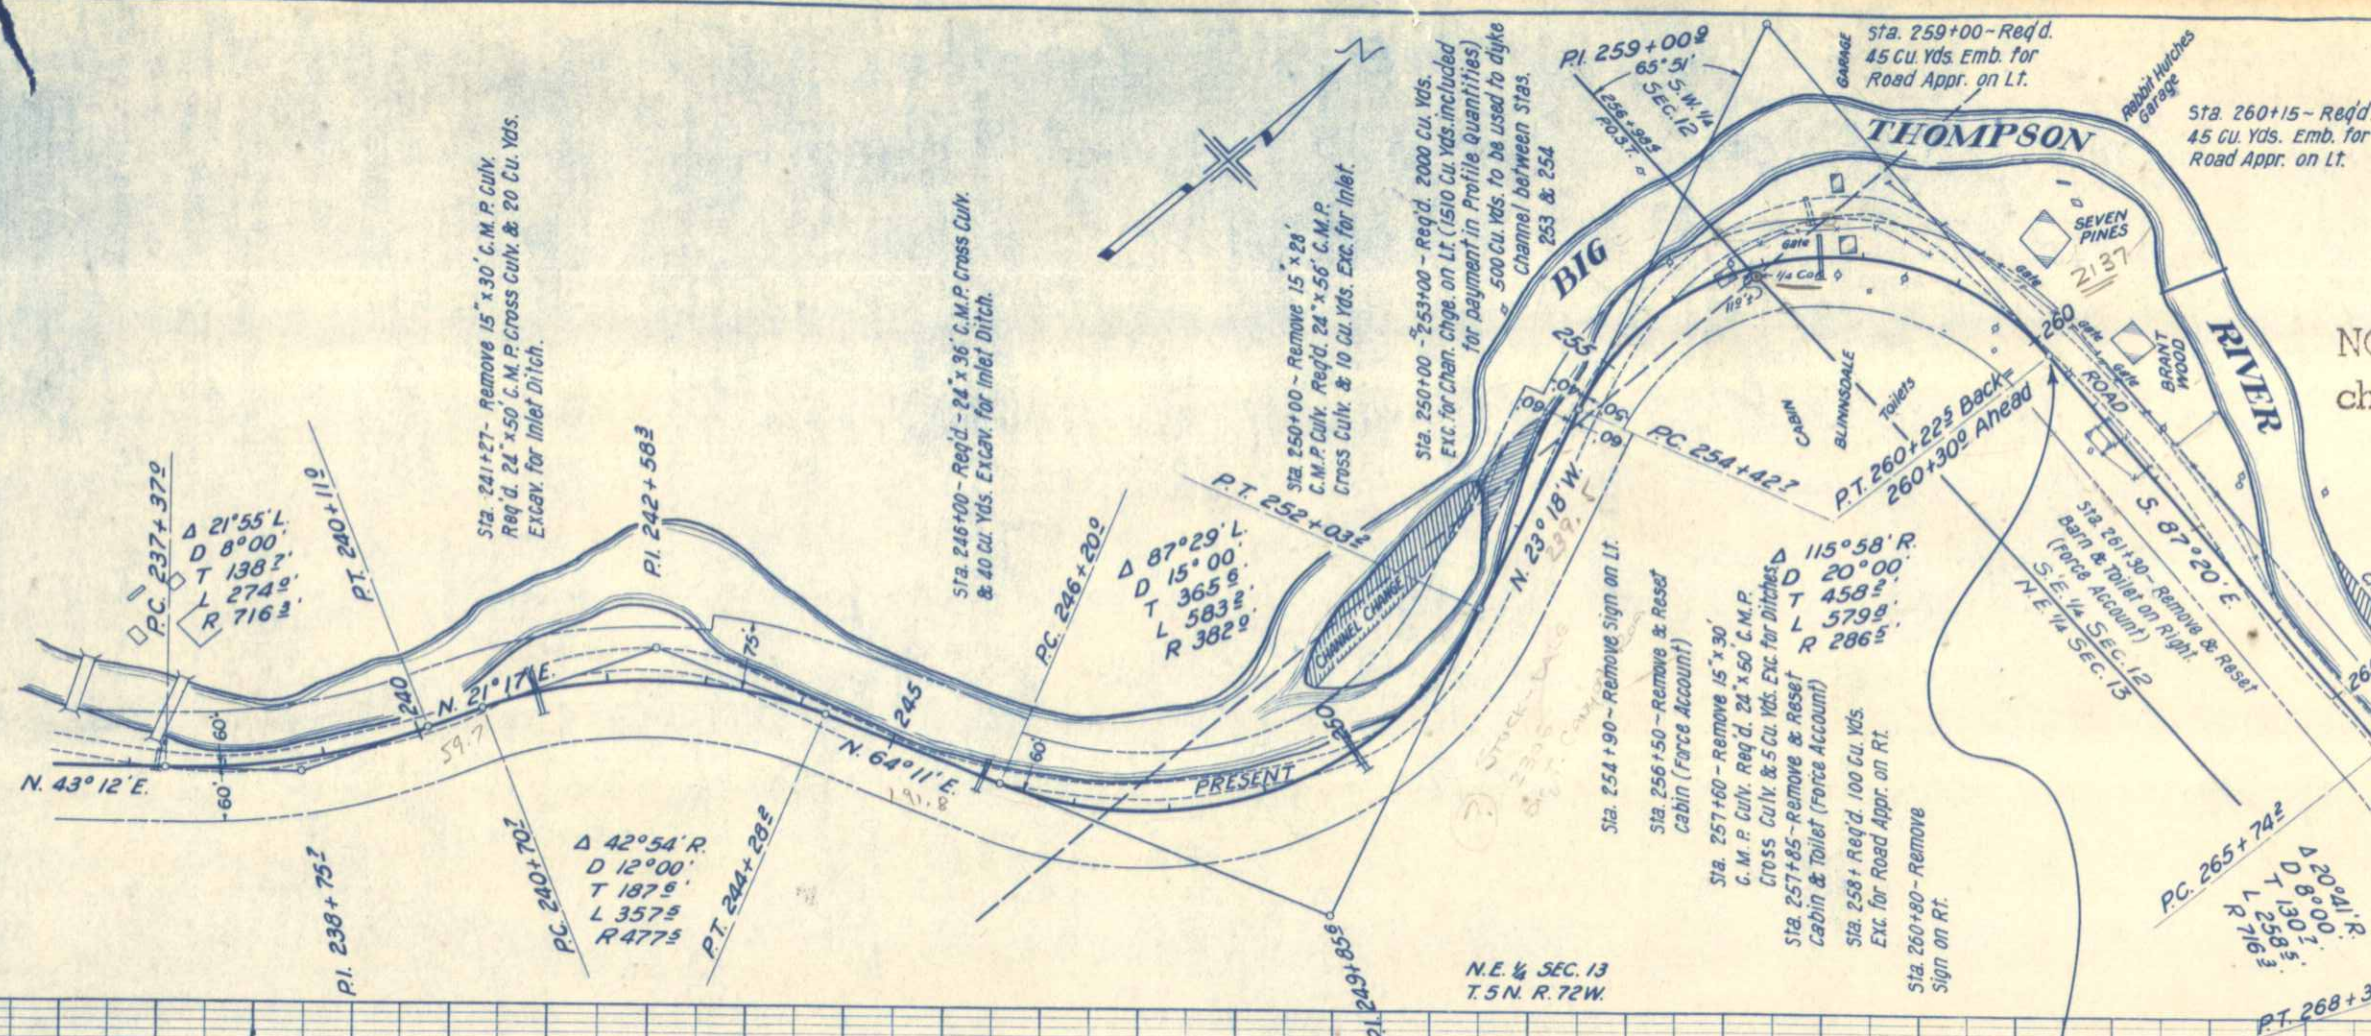


6010


FED. ROAD DIST. NO.	STATE	A.W. PROJ. NO.	SHEET NO.	TOTAL SHEETS
3	COLO.	6010	13	

PLAN	DATE
NO. 1	
NO. 2	
NO. 3	
NO. 100	

PROFILE	DATE
NO. 1	
NO. 2	
NO. 3	
NO. 100	

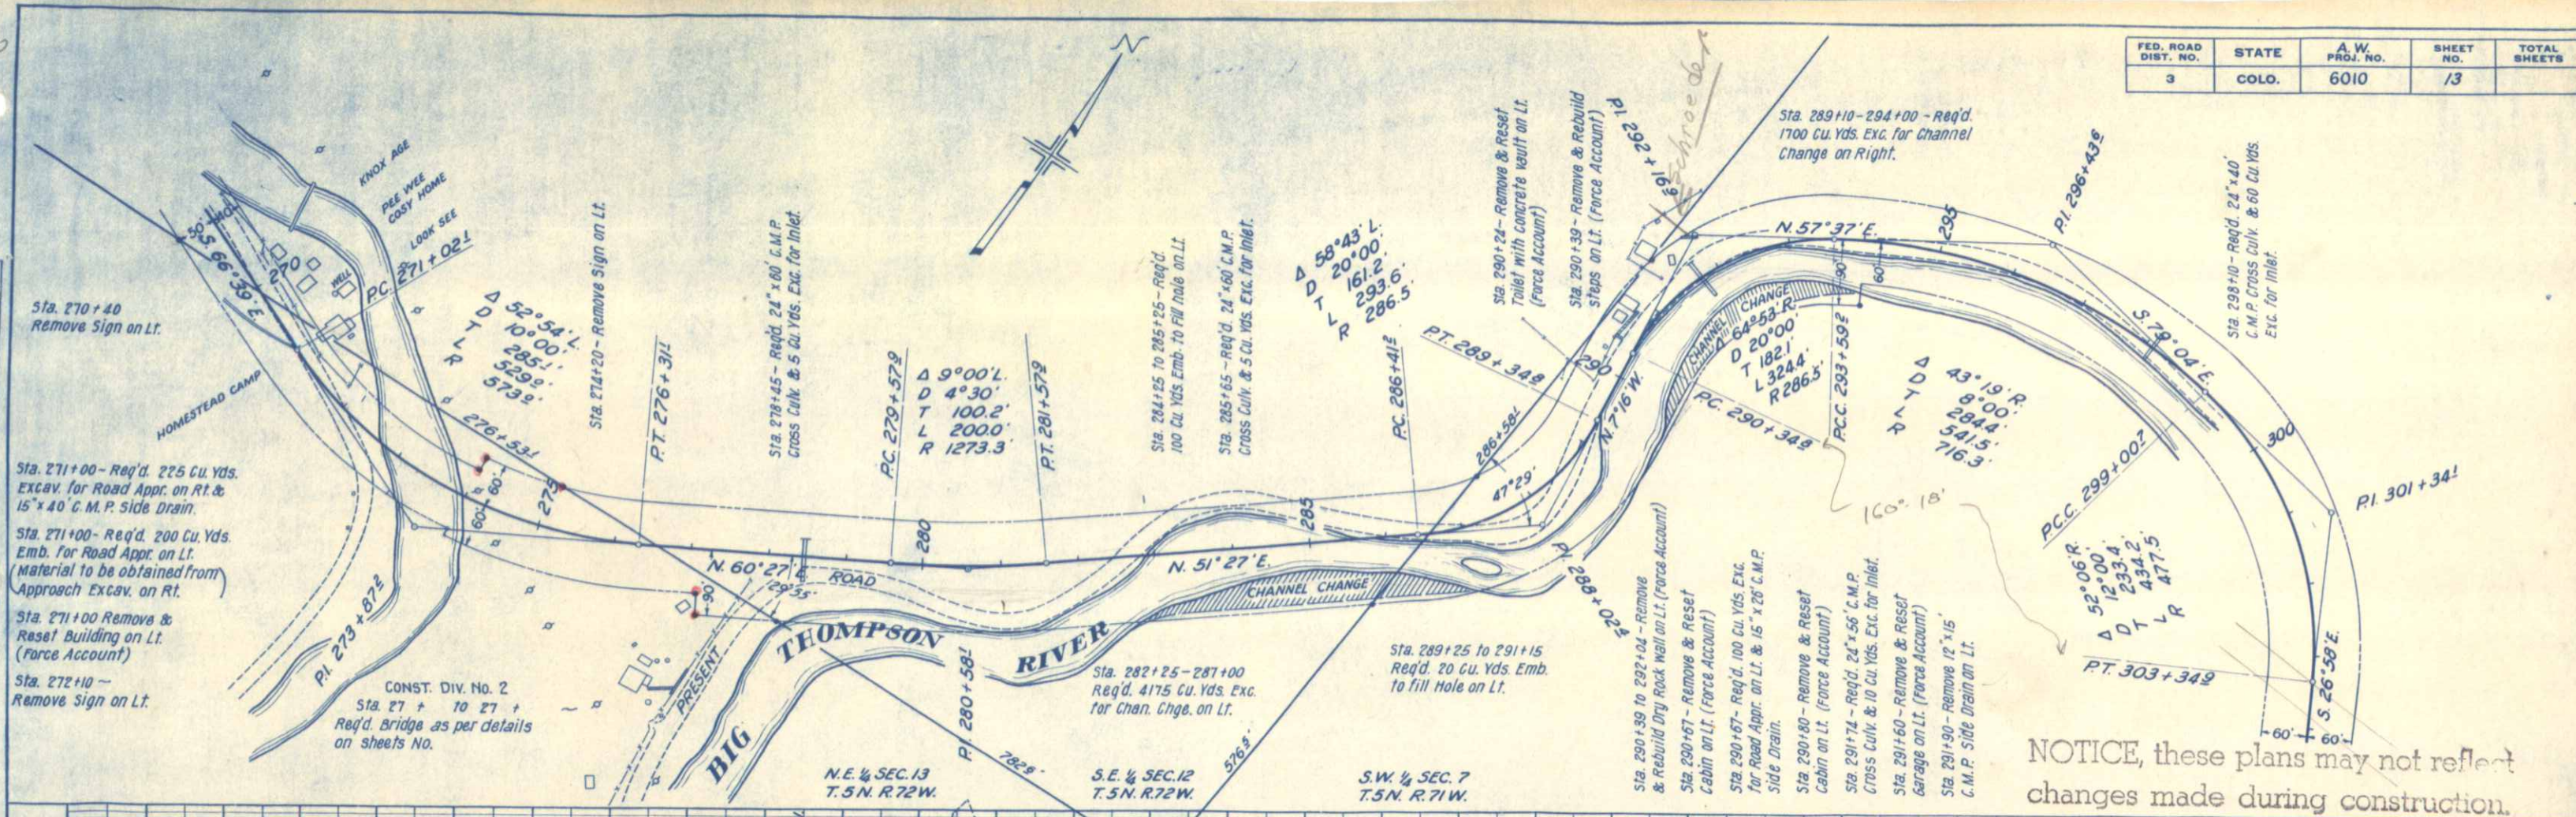

NOTICE, these plans may not reflect changes made during construction.

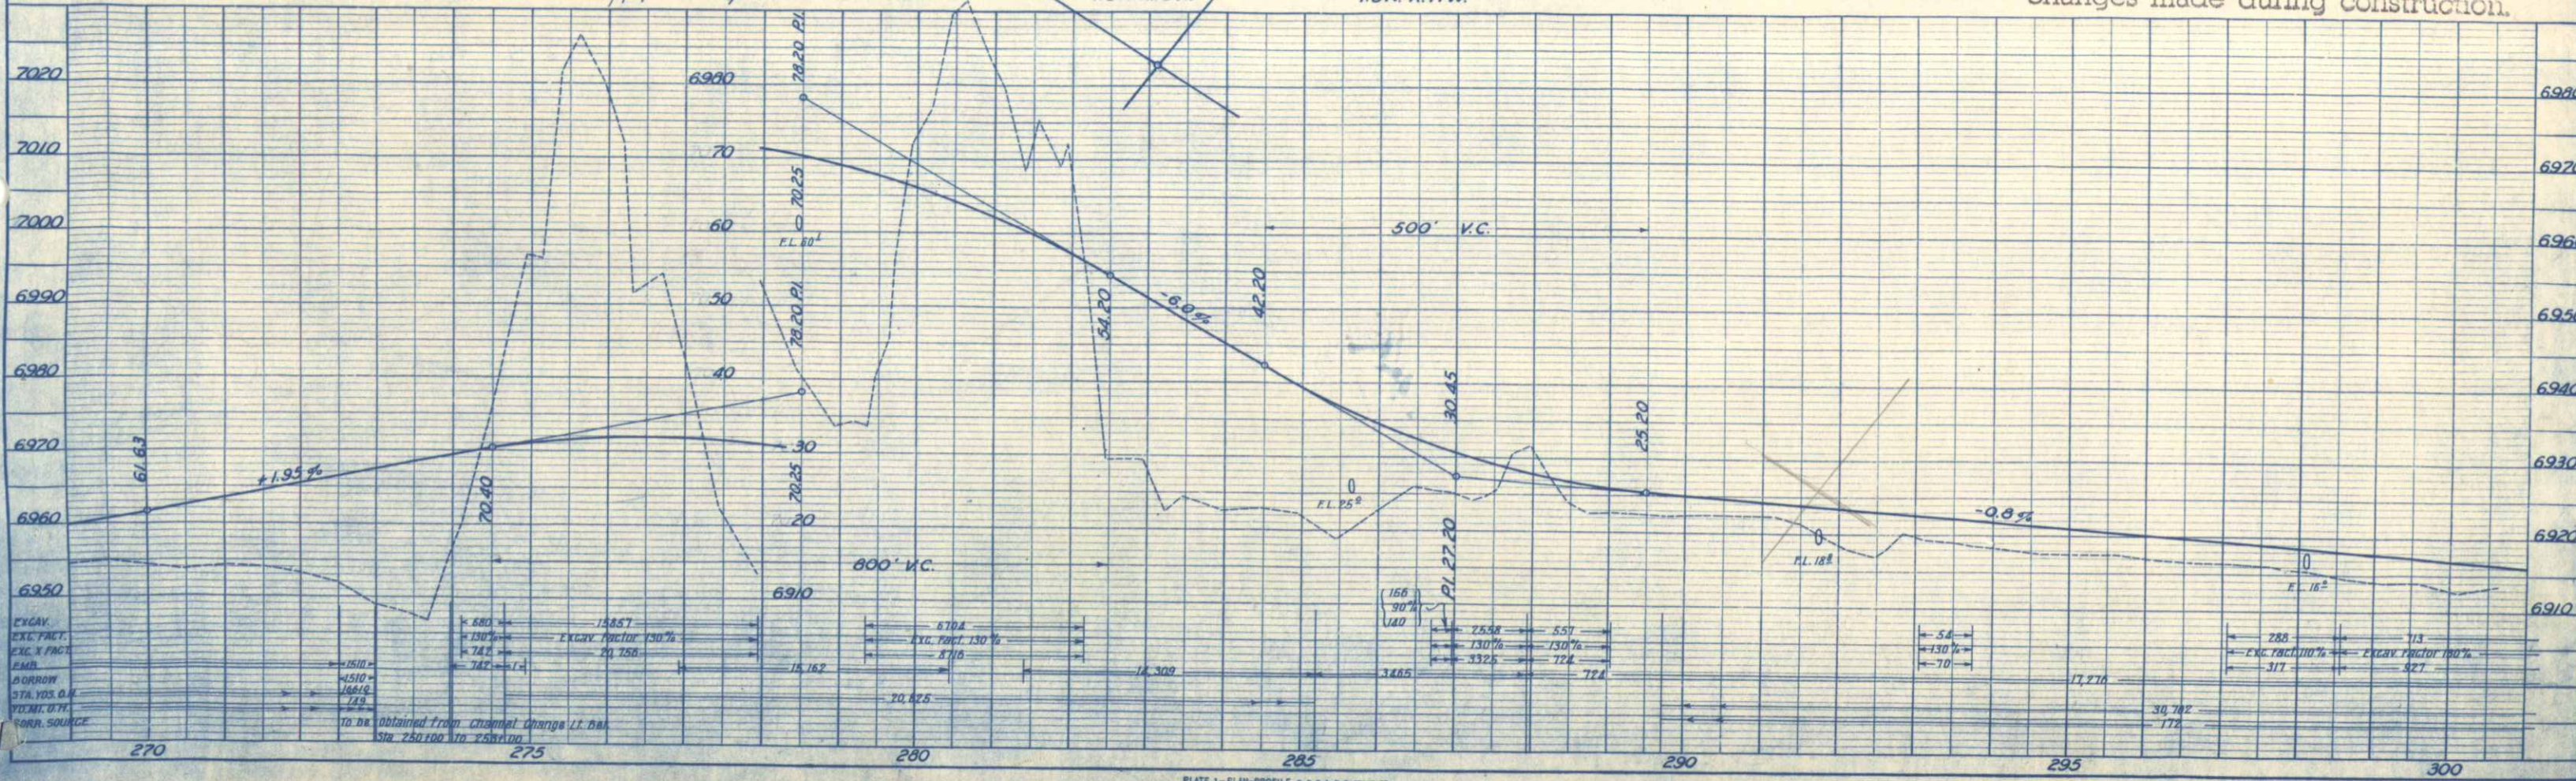

FED. ROAD DIST. NO.	STATE	A.W. PROJ. NO.	SHEET NO.	TOTAL SHEETS
3	COLO.	6010	14	

NOTICE, these plans may not reflect changes made during construction.

PLAN	DATE
SURVEYED	
DESIGNED	
CHECKED	
BY	

PROFILE	DATE
SURVEYED	
DESIGNED	
CHECKED	
BY	

