

COLORADO STATE HIGHWAY DEPARTMENT

PLAN AND PROFILE OF PROPOSED A.W. PROJECT NO. 7006. STATE HIGHWAY NO. 2

LOGAN COUNTY


SCALES OF ORIGINAL TRACINGS

ON PLAN, 1 IN. = 100 FT.
ON PROFILE 1 IN. = 100 FT. HORIZONTAL
1 IN. = 10 FT. VERTICAL

GRADE LINE ON PROFILE IS SHOWN AS GRADE OF FINISHED ROAD

GROSS LENGTH OF PROJECT 42,754.3 FT. = 8.097 MI.
NET LENGTH OF PROJECT 42,554.3 FT. = 8.059 MI.


CONVENTIONAL SIGNS

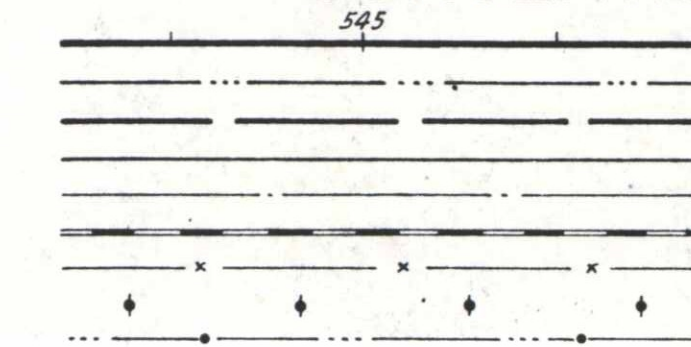

Center Line of Improvement
Right of Way Line
Township or Range Line
Section Line
1/4 Section Line
Railroad Track
Fence Line
Pole Line
R.O.W. Line with Marker.

INDEX OF SHEETS

- Sheet No. 1. TITLE SHEET.
" 2. TYPICAL SECTION & SUMMARY
" 3. LIST OF STRUCTURES & SPECIAL DETAILS
" 4. DETAILS OF APPROACH SLABS.
" 5. STANDARD CONCRETE BOX CULVERT M-103-D
" 6. C.M.P. SIPHON M-123-A
" 7. WIRE CABLE GUARD FENCE M-20-A
" 8. SUPERELEVATION SHEET M-1-A
" 9. APPROACH ROADS & TRAFFIC SIGNS M-2-B
" 10-16. PLAN & PROFILE

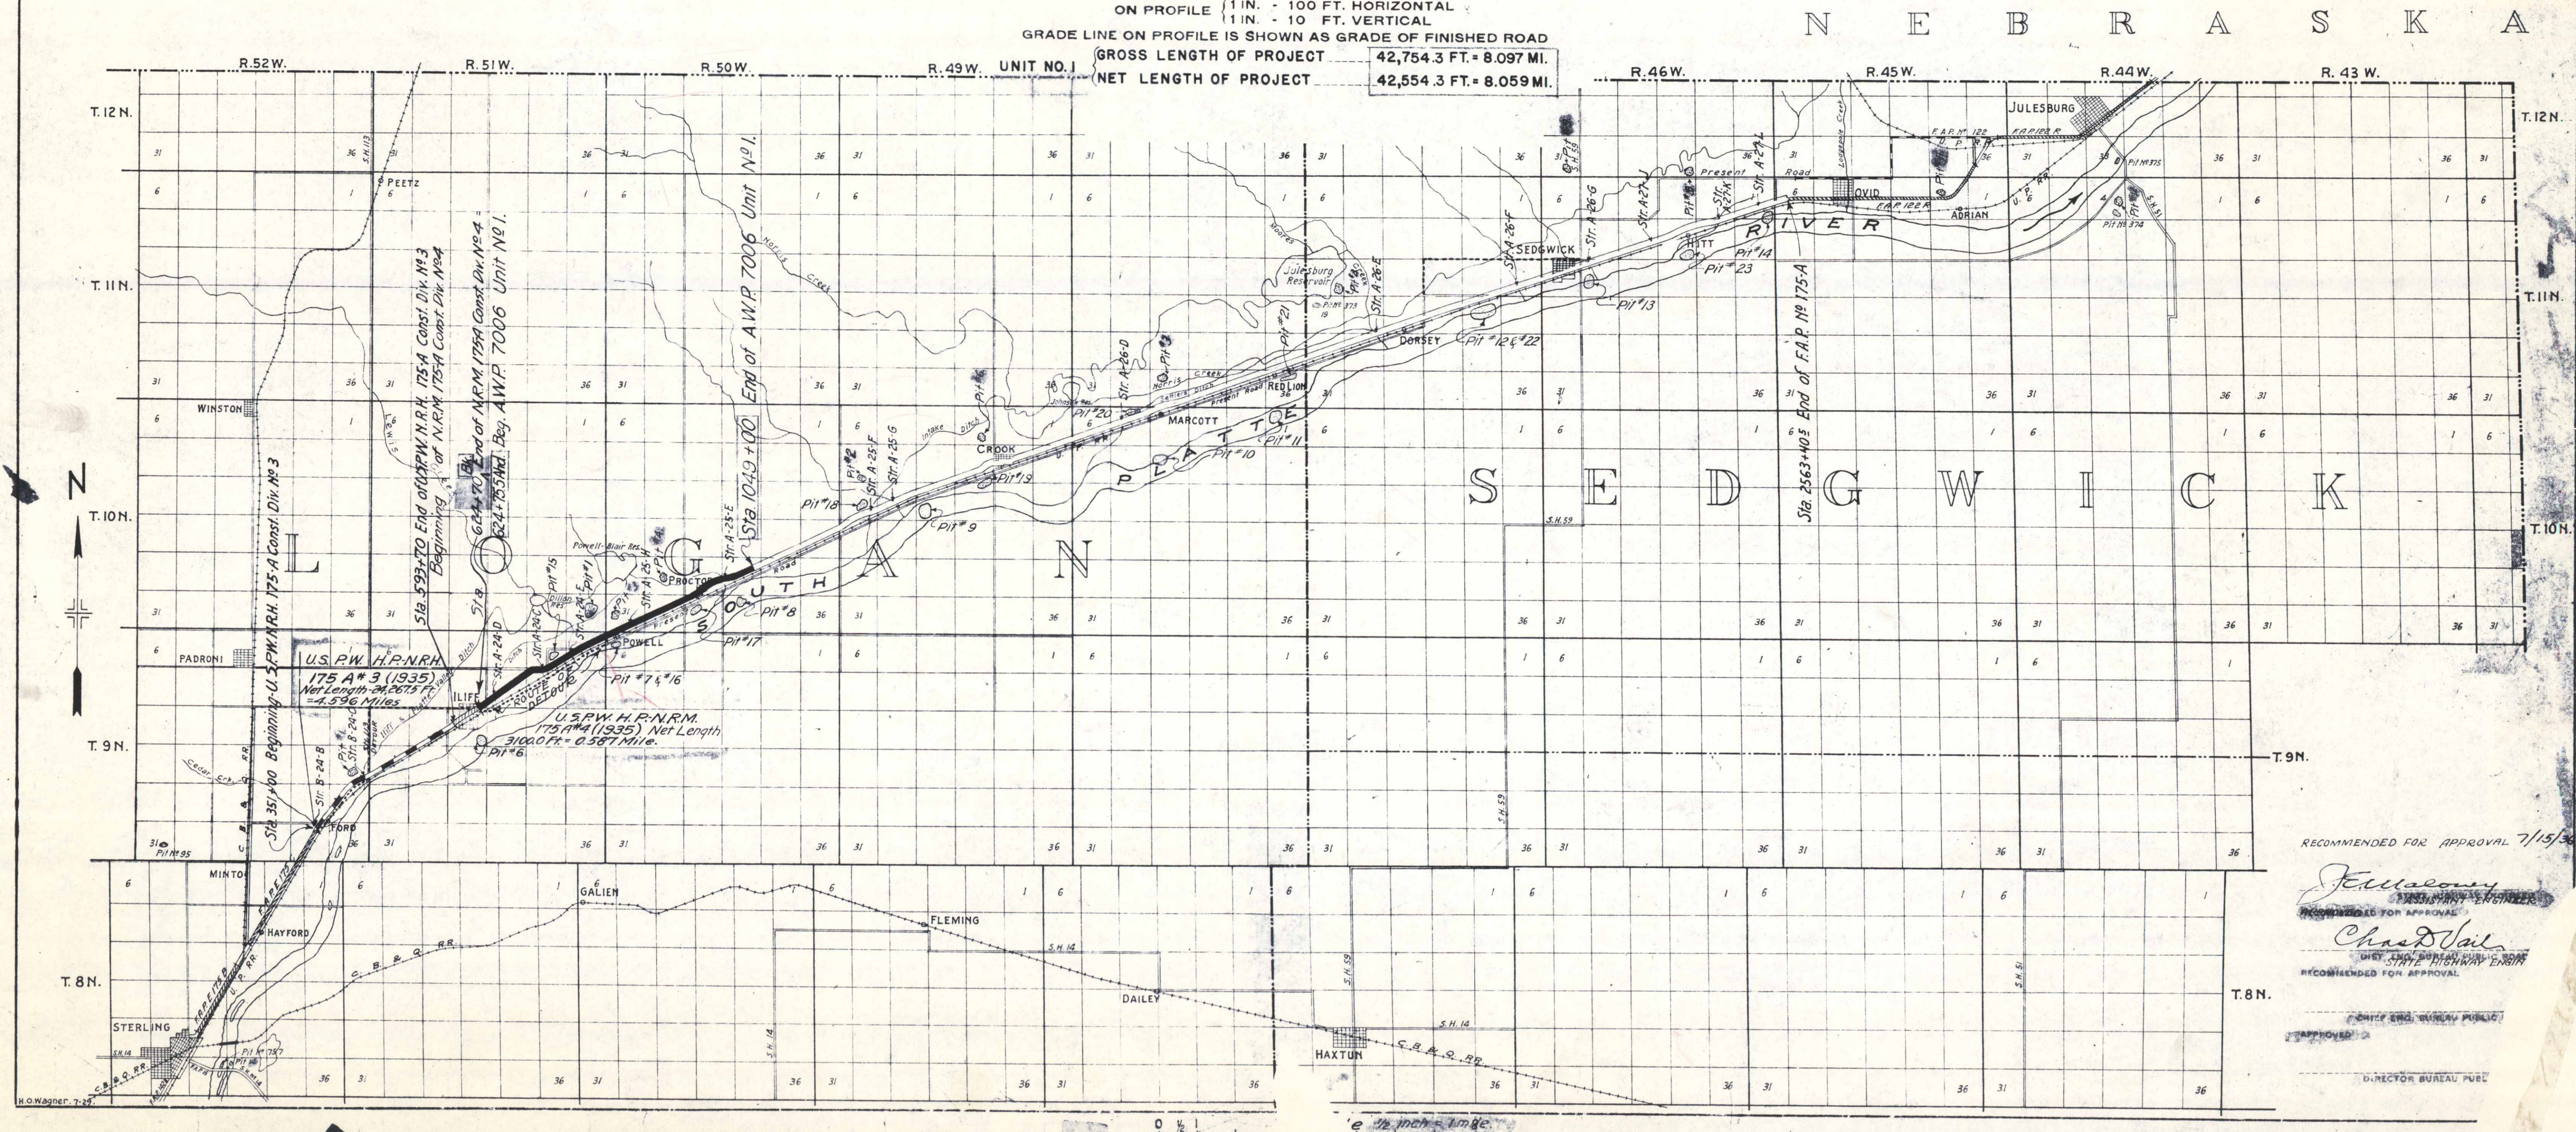

RECOMMENDED FOR APPROVAL 7/15/36

Chas. D. Vail
DISTRICT ENGINEER


Chas. D. Vail
DISTRICT ENGINEER

RECOMMENDED FOR APPROVAL

DIRECTOR BUREAU PUBL.




Rev. 7-24-29 S.B.L.
Rev. as const. 4-5-33 T.G.

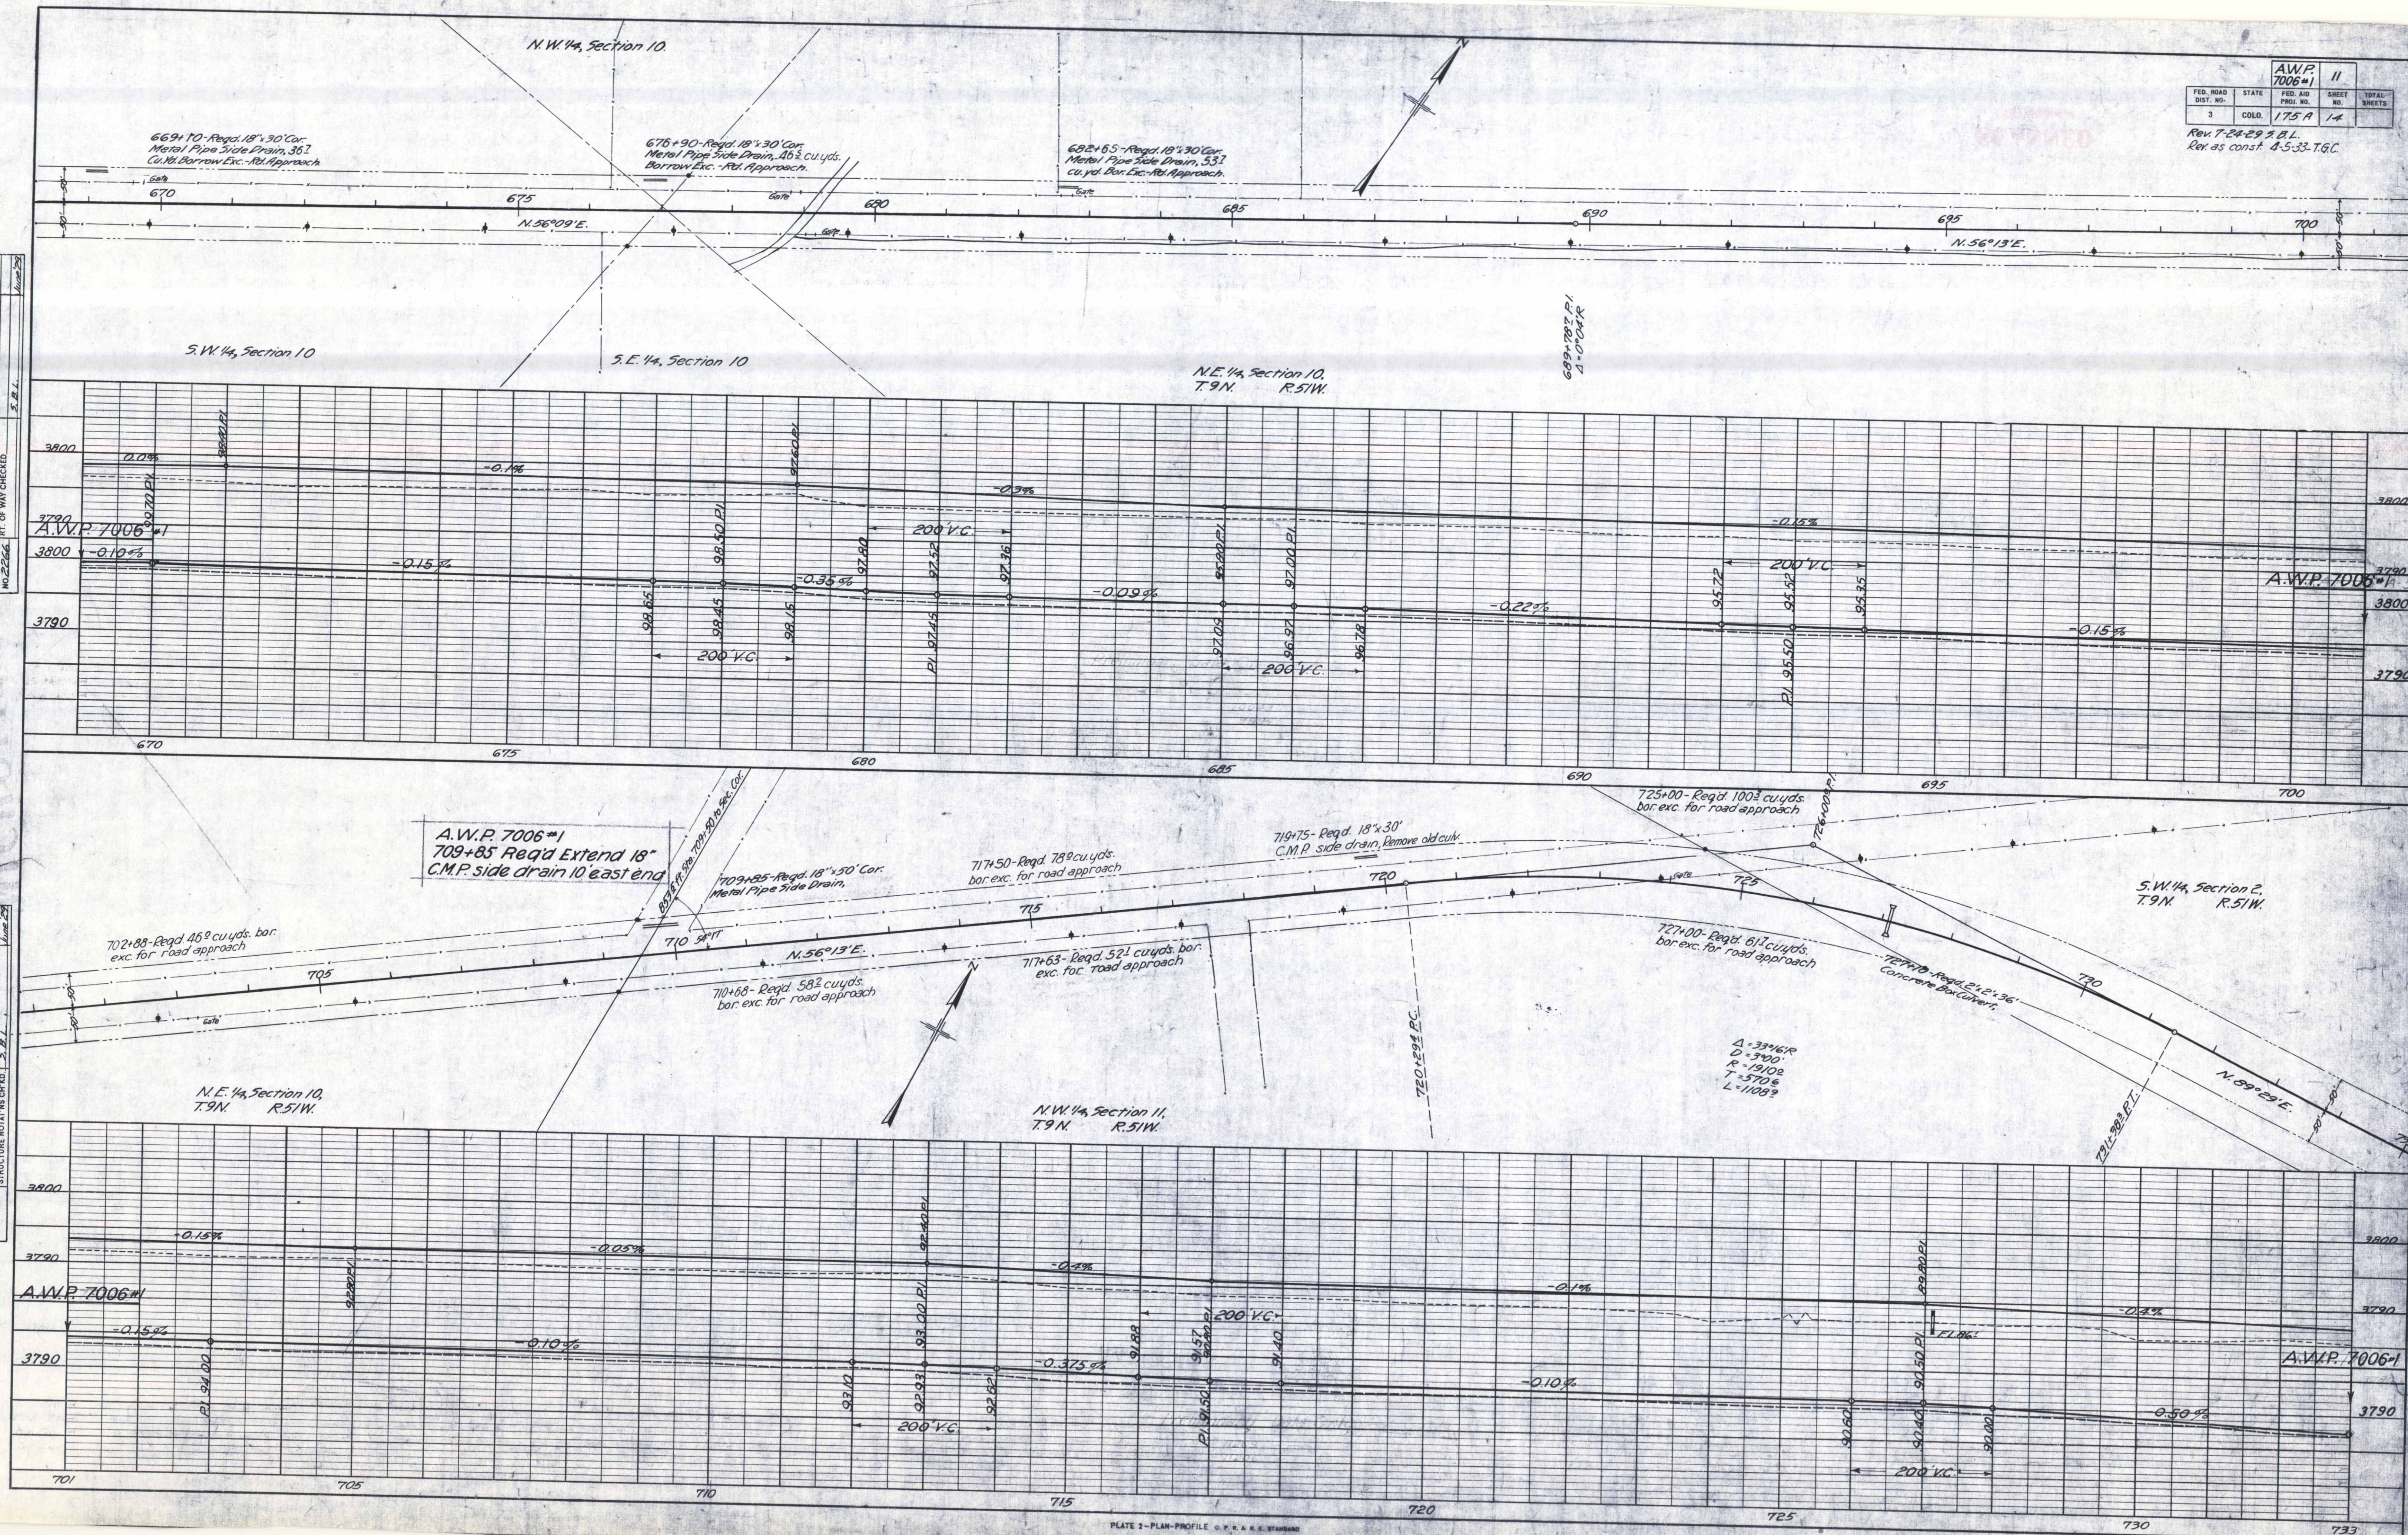


PLAN		BY	DATE
	SURVEYED		
	PLOTTED		
NOTE BOOK	ALIGNMENT CHECKED		
No. 2266	RT. OF WAY CHECKED		
		S.B.L.	June 23

PLAN		BY	DATE
	SURVEYED		
	PLOTTED		
NOTE BOOK	ALIGNMENT CHECKED		
NO 2266	RT. OF WAY CHECKED	S.B.L.	JUNE 2

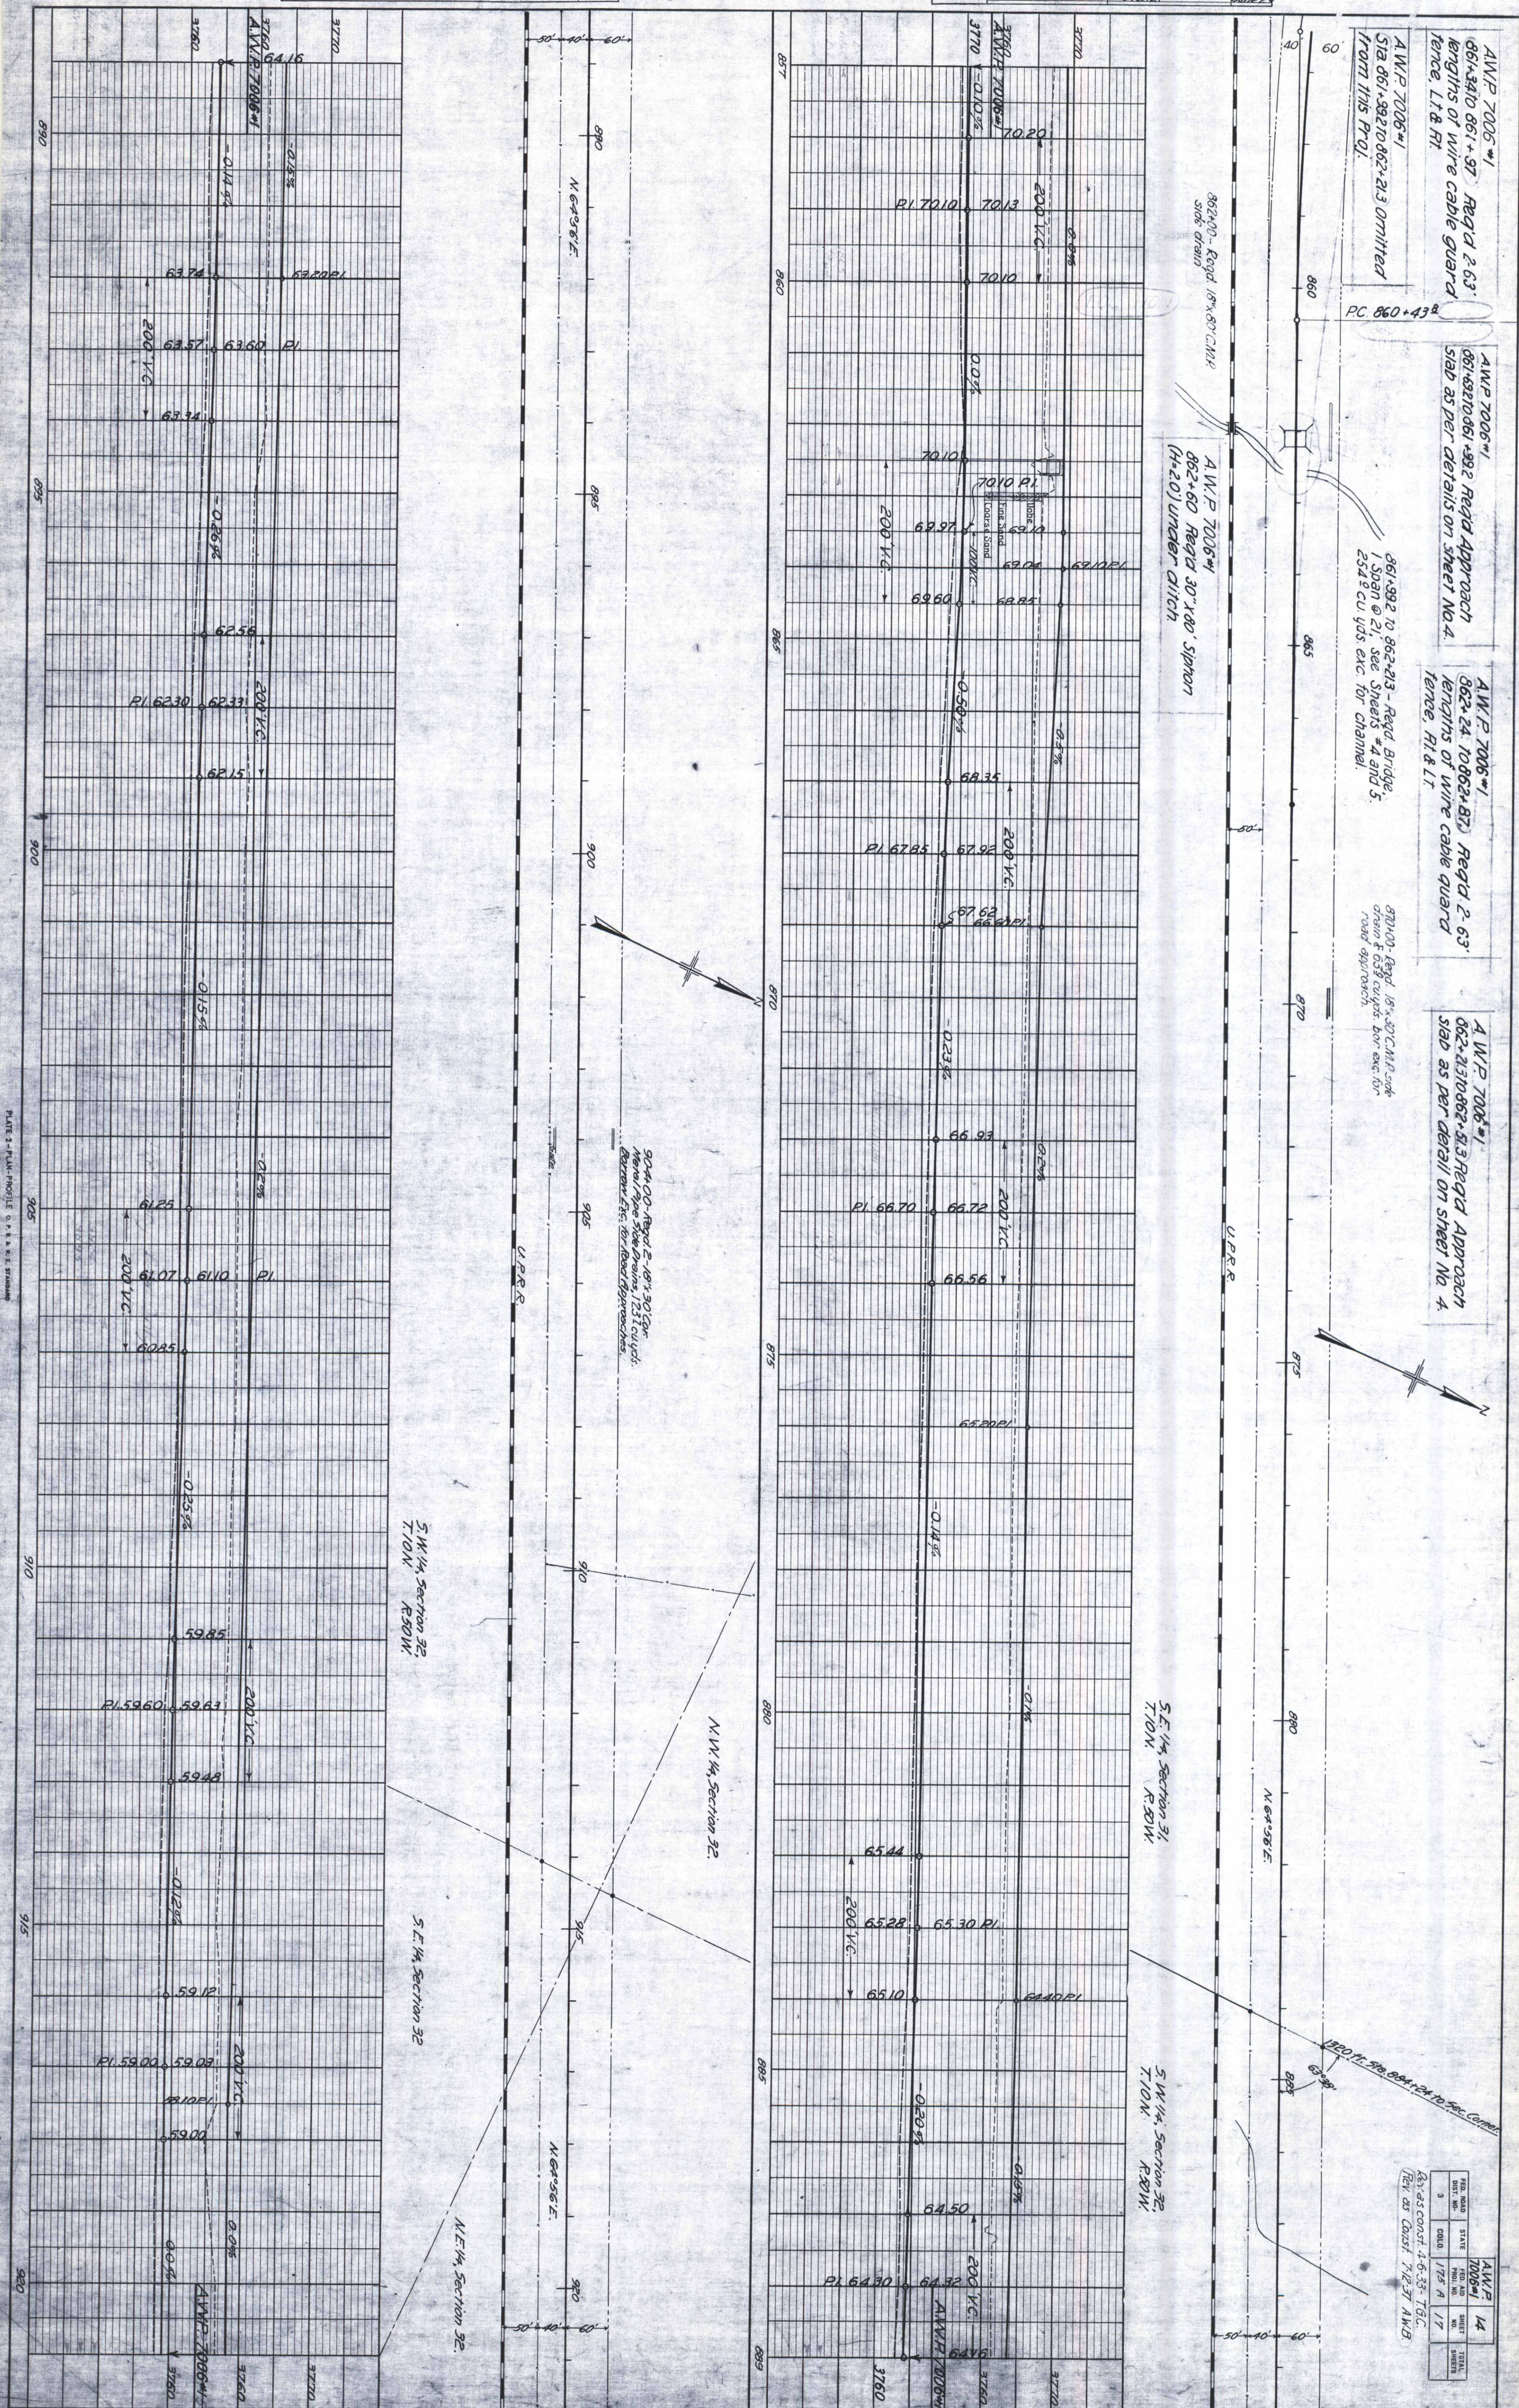


PLAN	SURVEYED	BY	DATE
	PLOTTED		
NOTE BOOK	ALIGNMENT CHECKED		
NO. 2266	RT. OF WAY CHECKED		

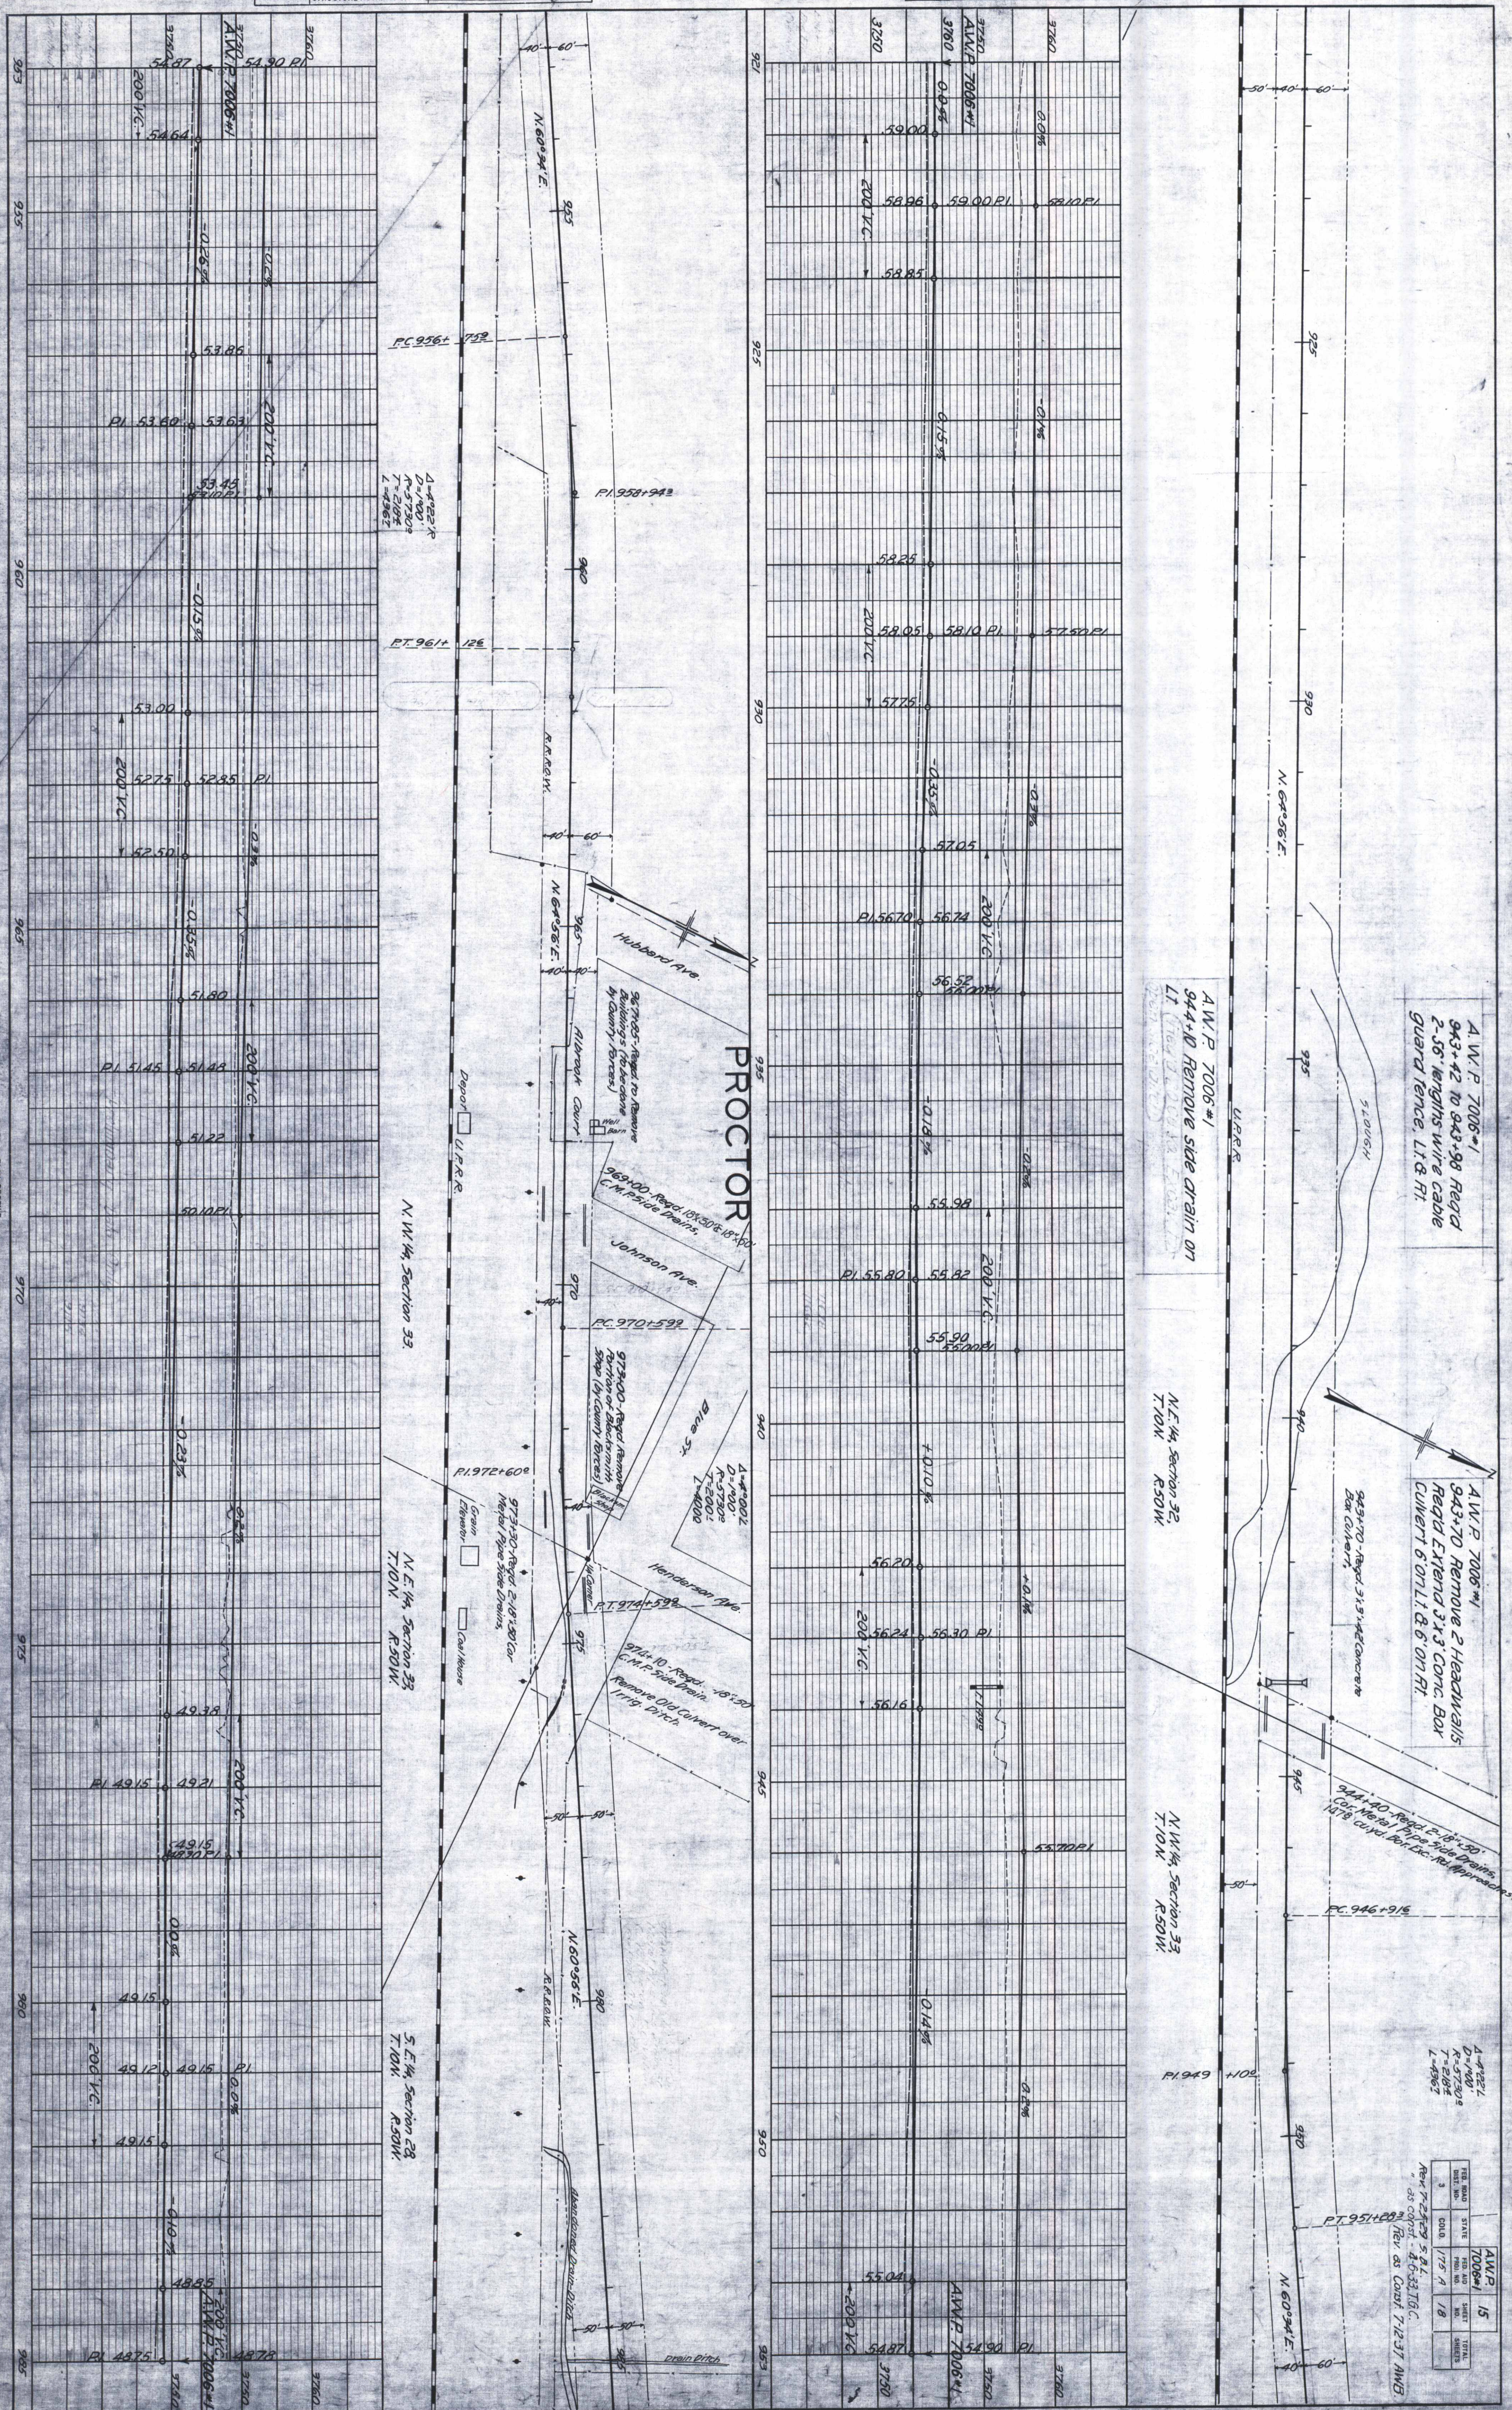

PROFILE	SURVEYED	BY	DATE
NOTE BOOK	PLOTTED		
NO.	GRADES CHECKED		
	B. M. S. NOTED		
	STRUCTURE NOTATIONS CH'KD		

PLAN	SURVEYED	BY	DATE
NOTE BOOK	PLOTTED		
NO.	ALIGNMENT CHECKED		
	RT. OF WAY CHECKED		

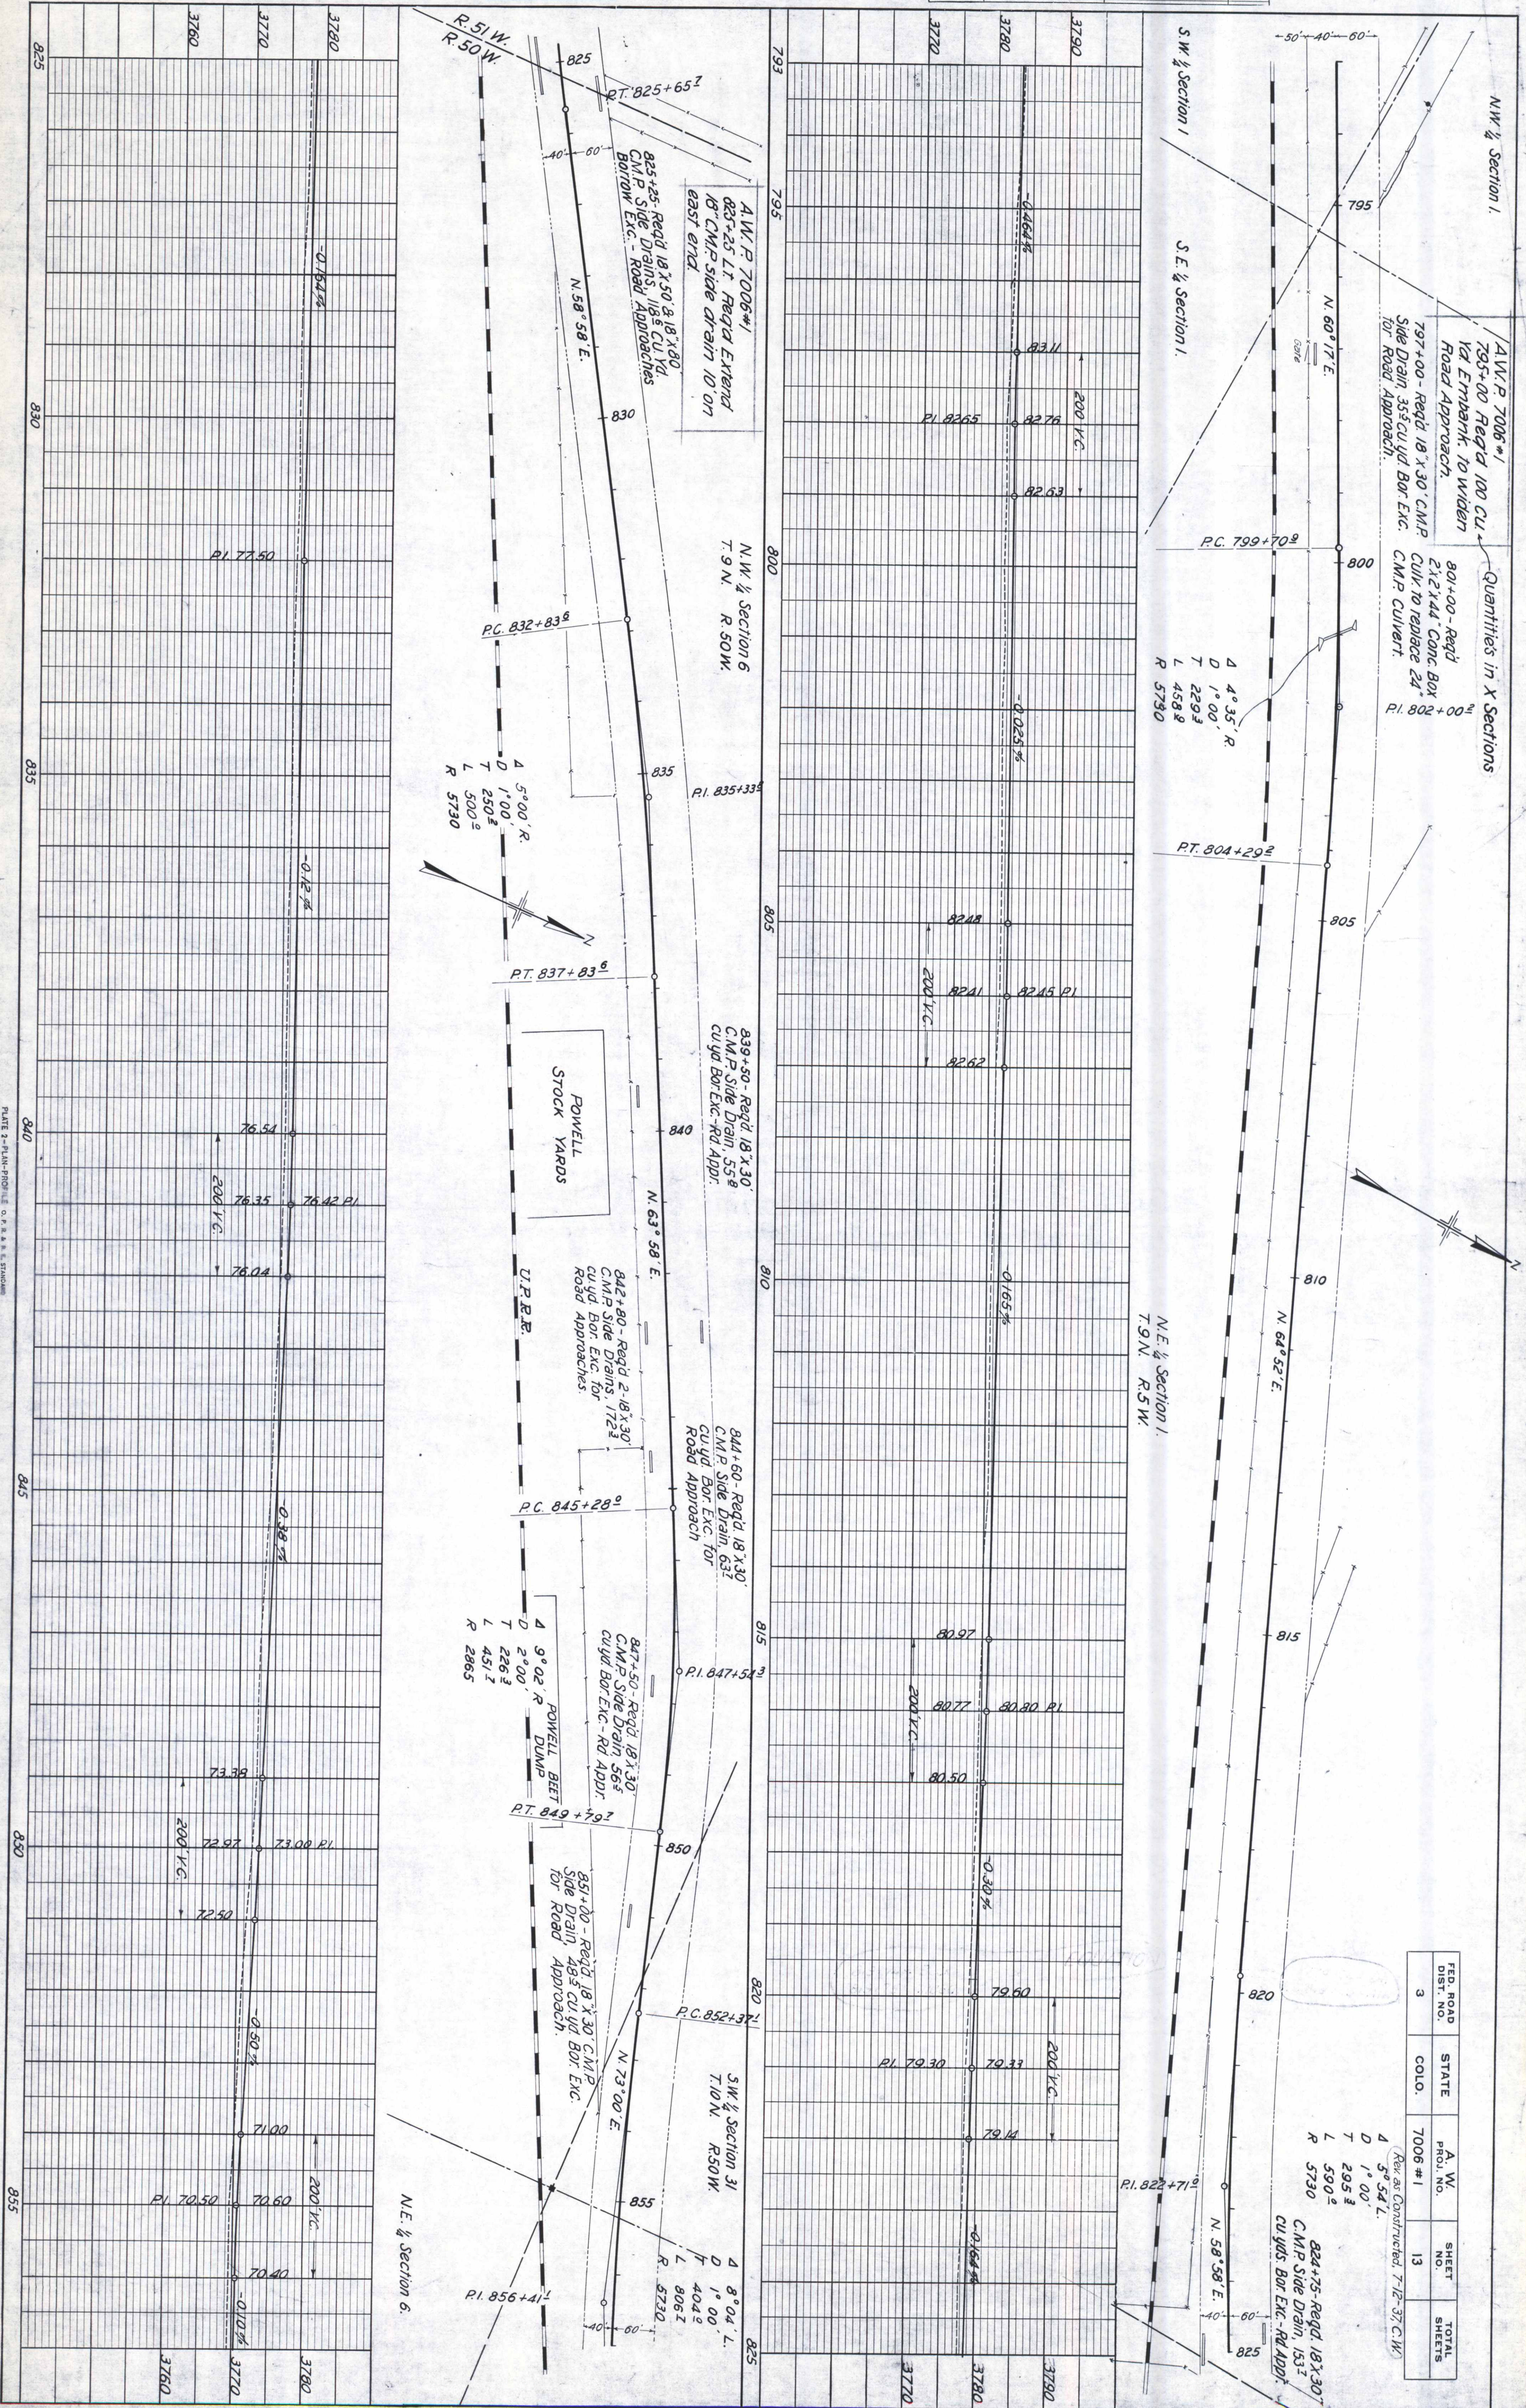

FED. ROAD DIST. NO.	STATE	COLO.	A. W. PROJ. NO.	SHEET NO.	TOTAL SHEETS
3			7006 #1	13	

Rev as Constructed 7-12-37 C.W.

824+75 - Reqd 18' x 30' C.M.P. Side Drain, 133' cu. yd. Bor. Exc. - Rd. Appr.

4 5' 54" L.
 D 1' 00"
 T 295.3
 L 590.2
 R 5730

200' V.C.

820

815

810

805

800

795

790

785

780

775

770

770

