


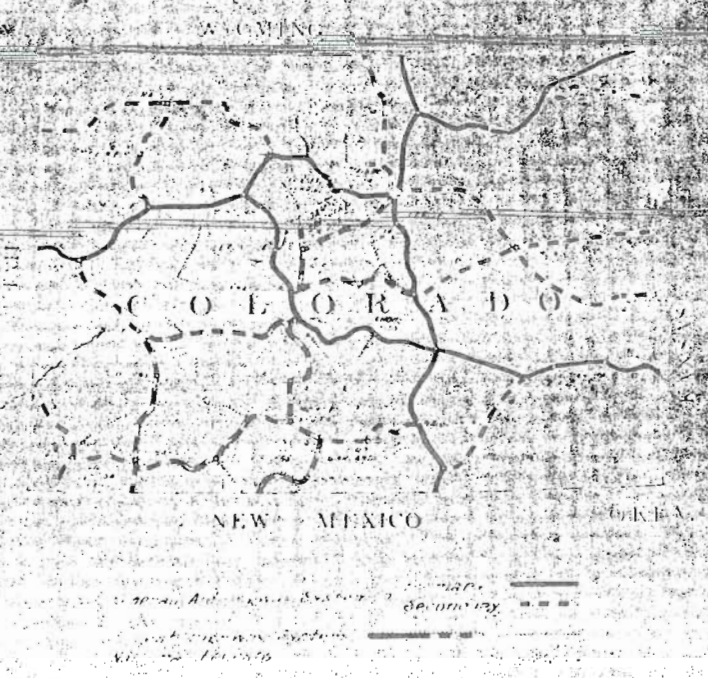


UNITED STATES DEPARTMENT OF AGRICULTURE BUREAU OF PUBLIC ROADS

AS CONSTRUCTED PROJECT 35-A ROUTE 35 GREENHORN HIGHWAY RYE TO A JCT. WITH NORTH HARDCRABBLE FOREST HIGHWAY NO. 43 35 MILES CLASS 2 COLORADO FOREST HIGHWAY SYSTEM SAN ISABEL NATIONAL FOREST CUSTER & PUEBLO COUNTIES COLORADO

INDEX TO SHEETS

No.	Description	Stationing
1	Title Sheet	
2	Plan Sections	
3	Summary	
4	Plan & Profile	335+75 to 435+10
5	Std. Cattle Guard	
6	Std. Concrete Manhole	
7	Std. Plain Pipe	
8	Std. 12" Red W.C.	
9	Std. 14" Std. Const. Signs	
10	Std. 24" Conc. Box Culvert	416+50
11	Std. 25" A.B. Conc. Box Culvert	436+00
12	Cross Section	335+75 to 435+10

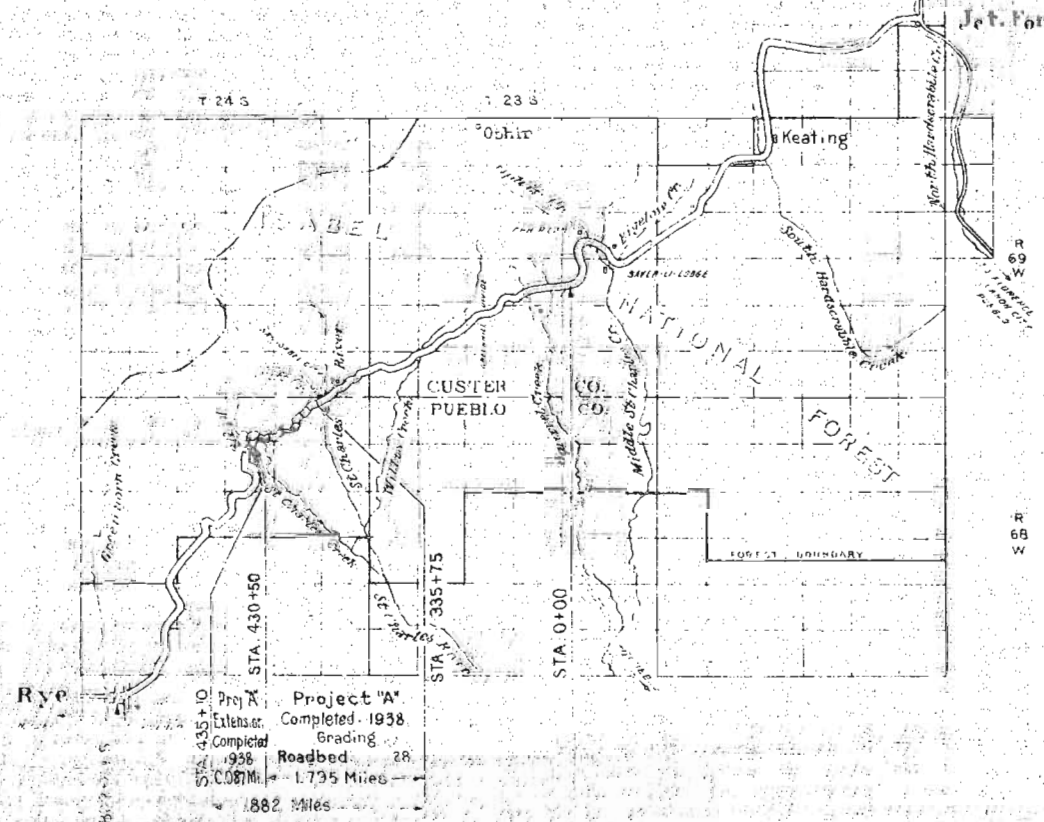


INDEX MAP
Scale Miles

APPROVED
DISTRICT ENGINEER
BUREAU OF PUBLIC ROADS
DATE


APPROVED
REGIONAL FORESTER
U.S. FOREST SERVICE
DATE

APPROVED
STATE HIGHWAY ENGINEER
DATE

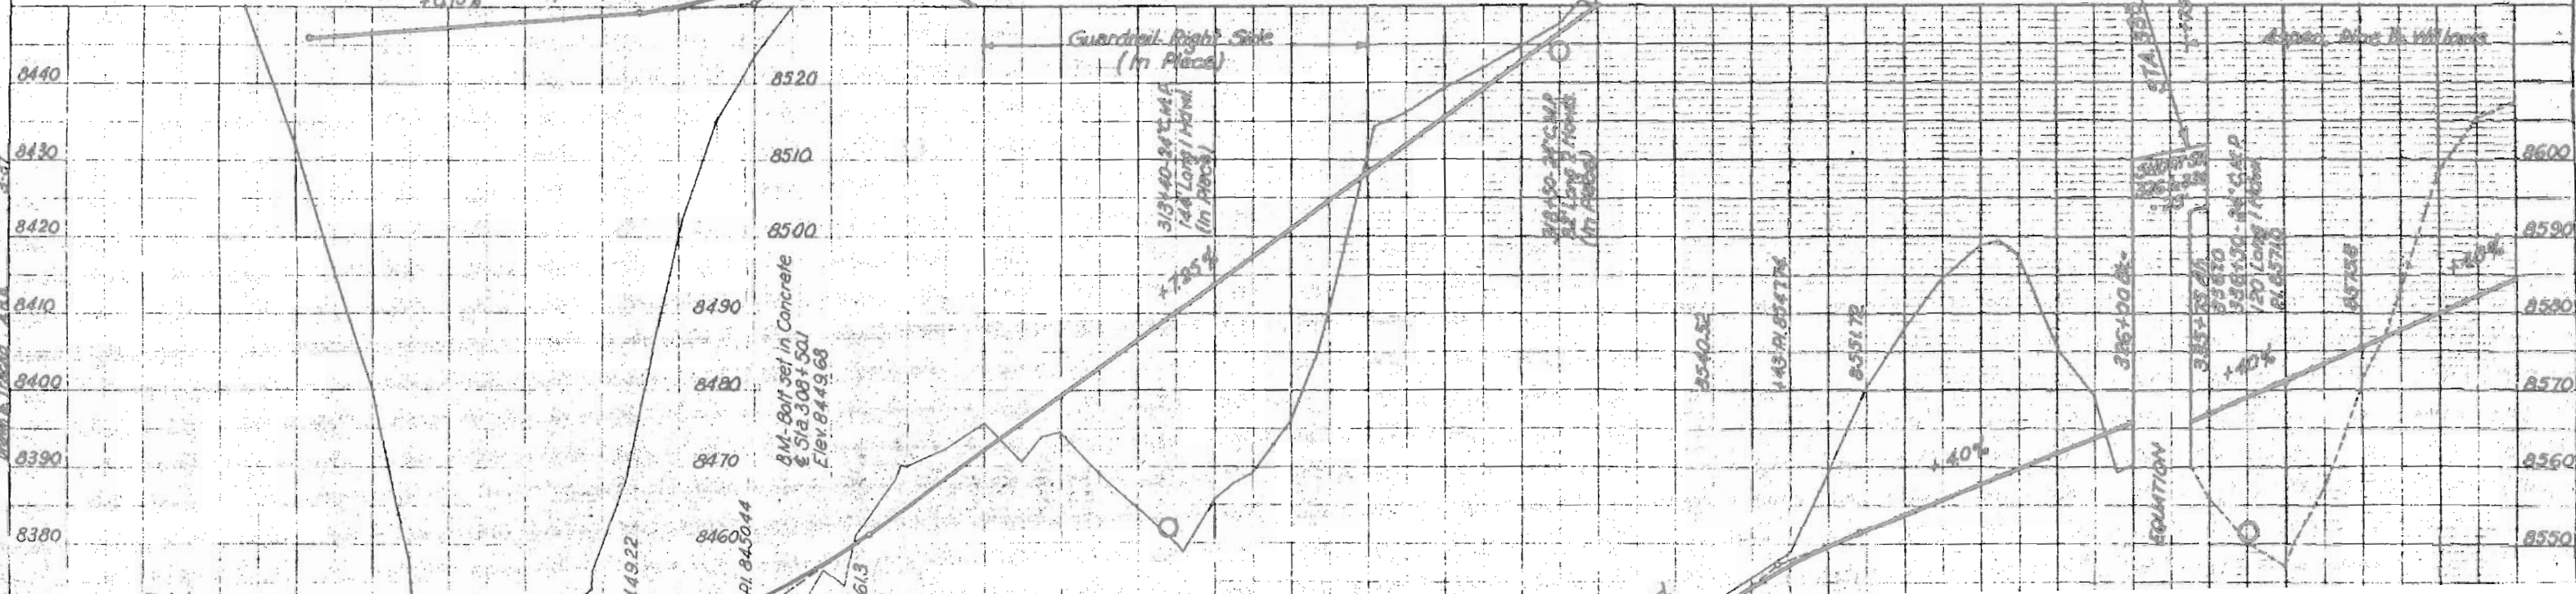

Greenhorn Highway, L20
340 to Sta 360
Sheet No. 15

PLAN
1" = 100'
1/100'
1/100'
1/100'

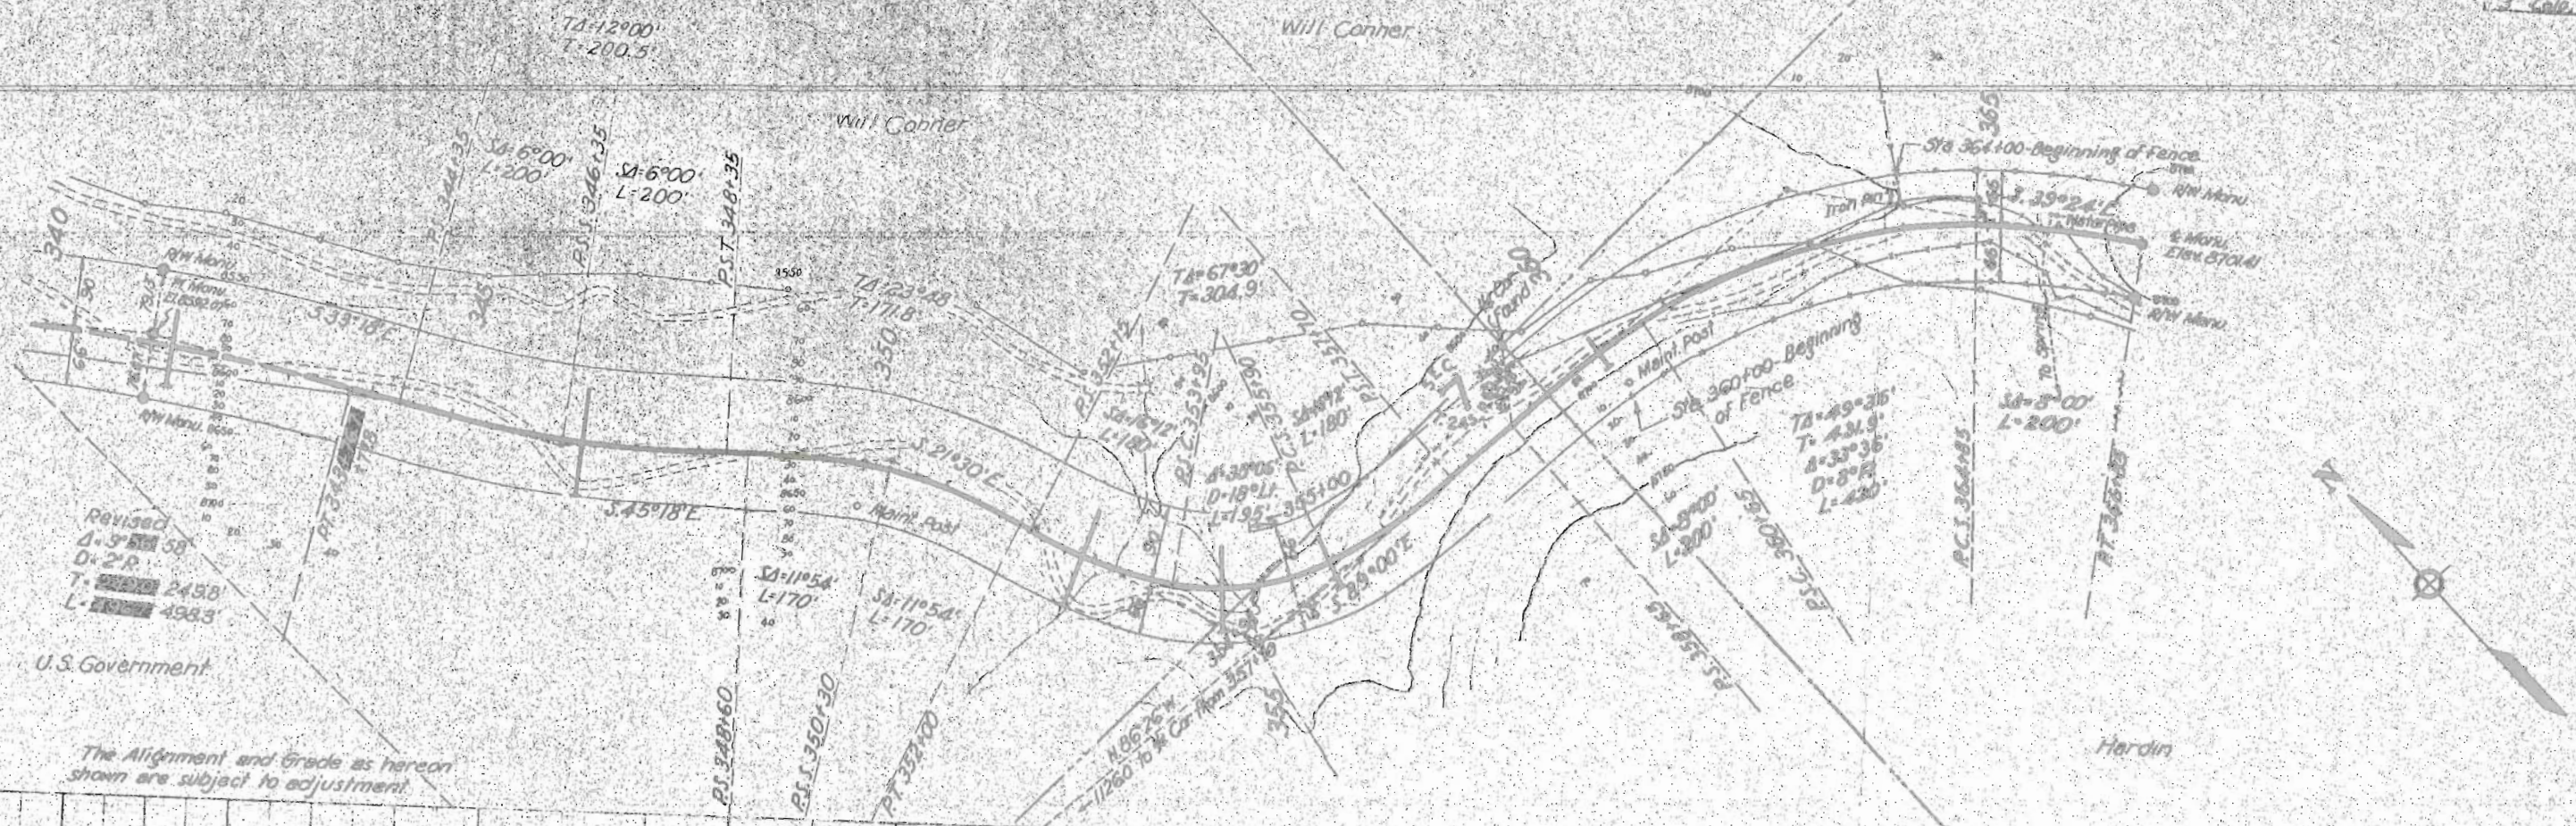

U.S. Government


The Alignment and Grade as hereon shown are subject to adjustment.




Greenhorn Highway, Corp. 35
Sta 360 to 390
Sheet No. 15



3 Comp. 35 A 16



PLAN
Scale 1" = 40'
North Arrow
Greenhorn Highway, Corp. 35
Sta 360 to 390
Sheet No. 15

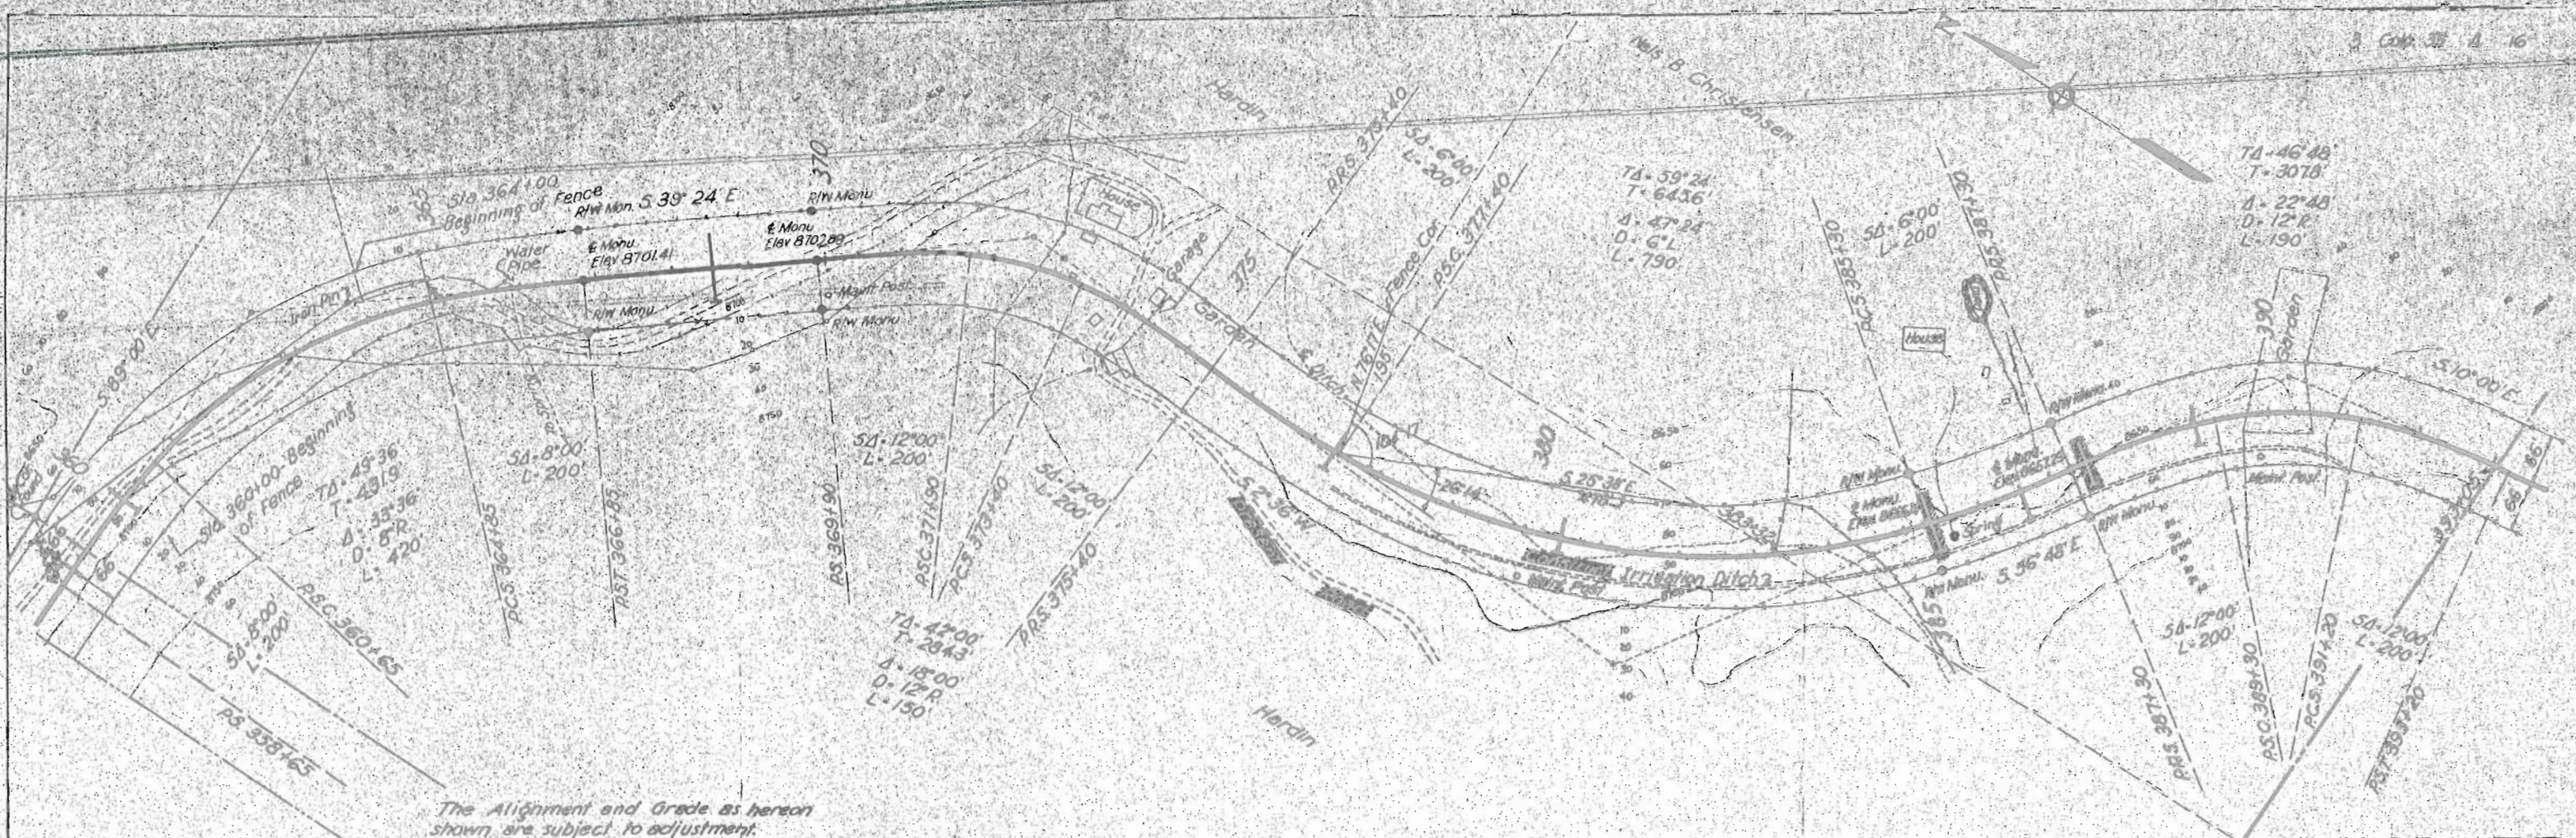

The Alignment and Grade as hereon shown are subject to adjustment.

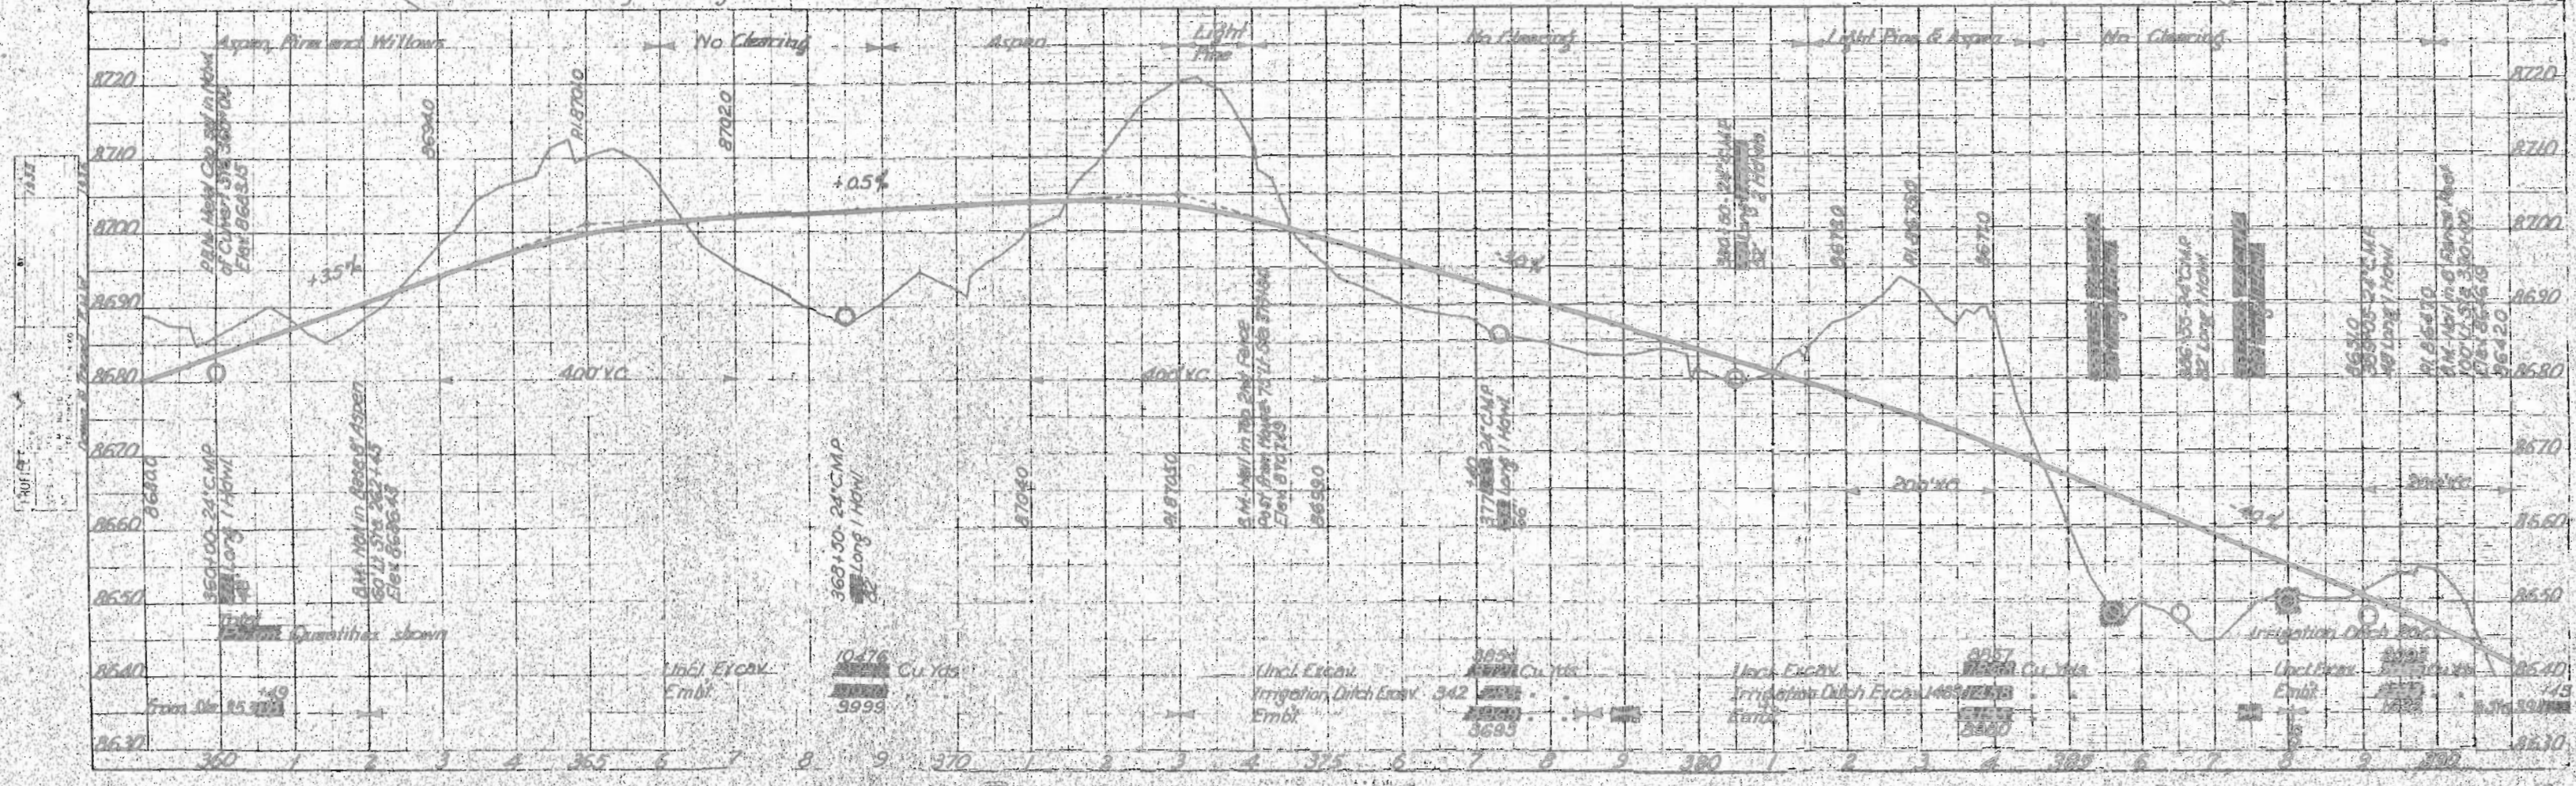

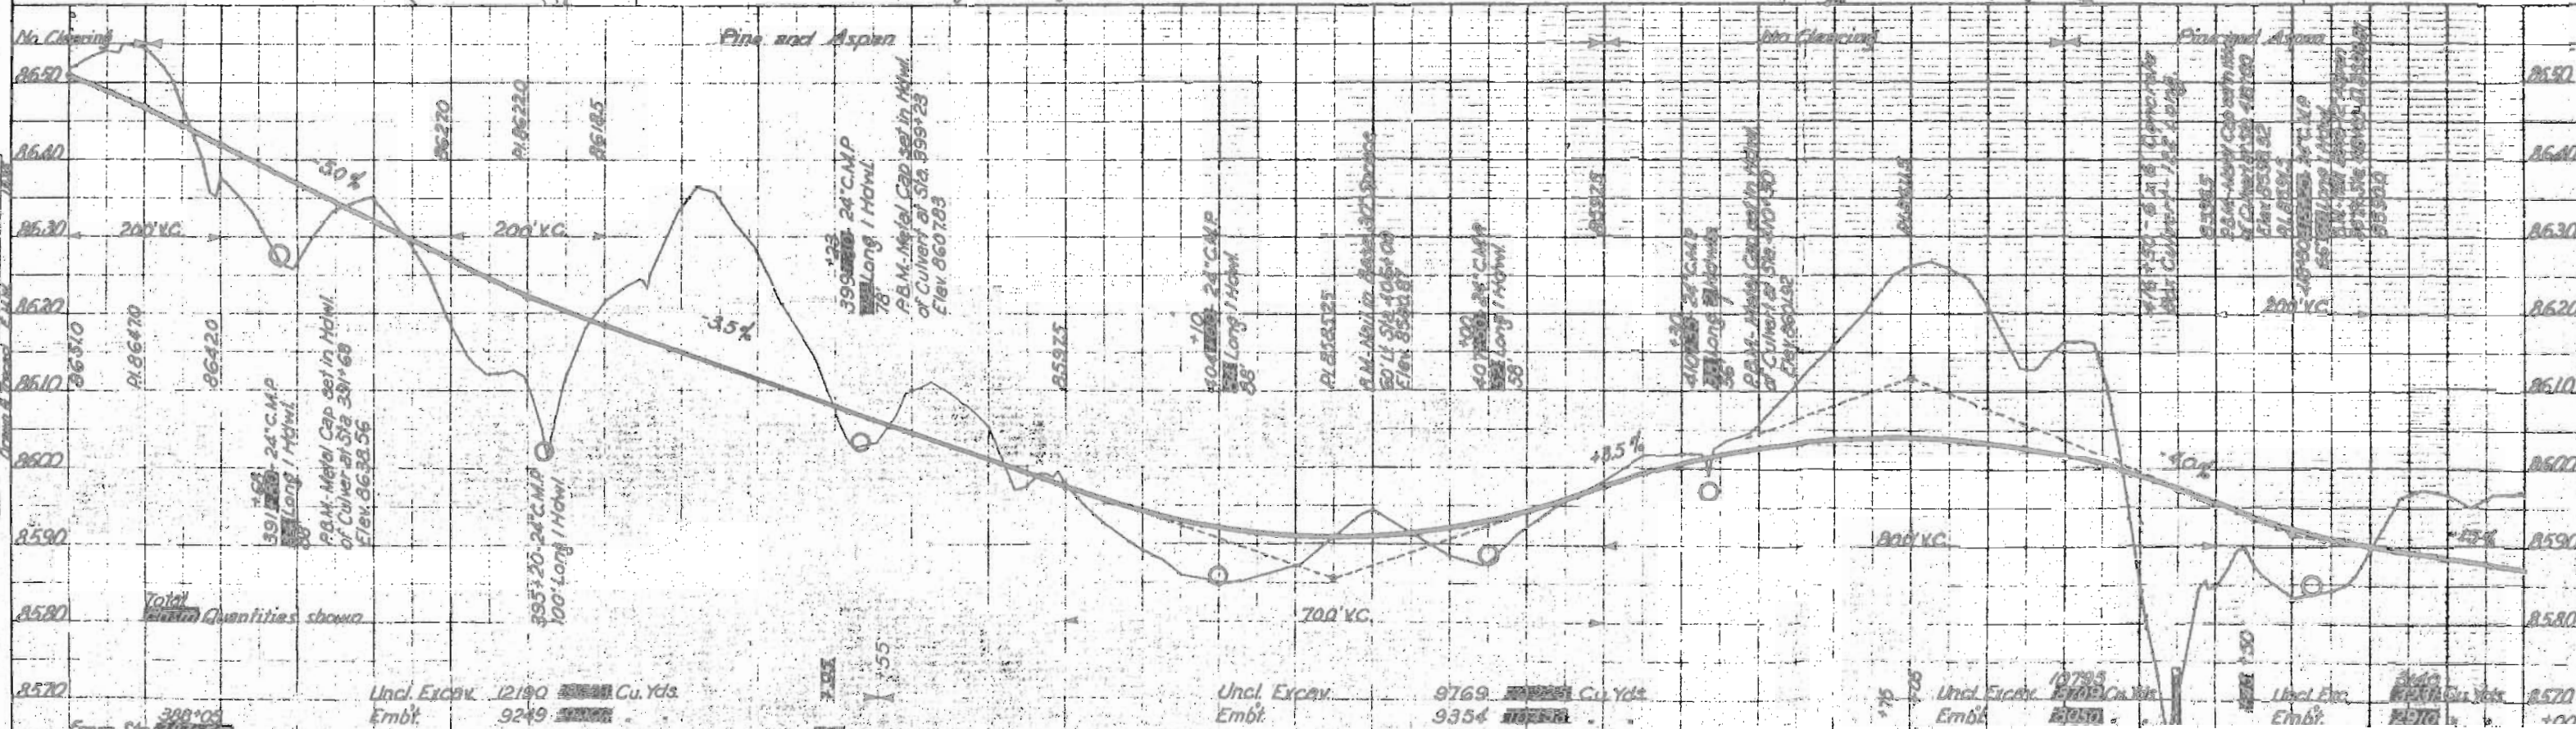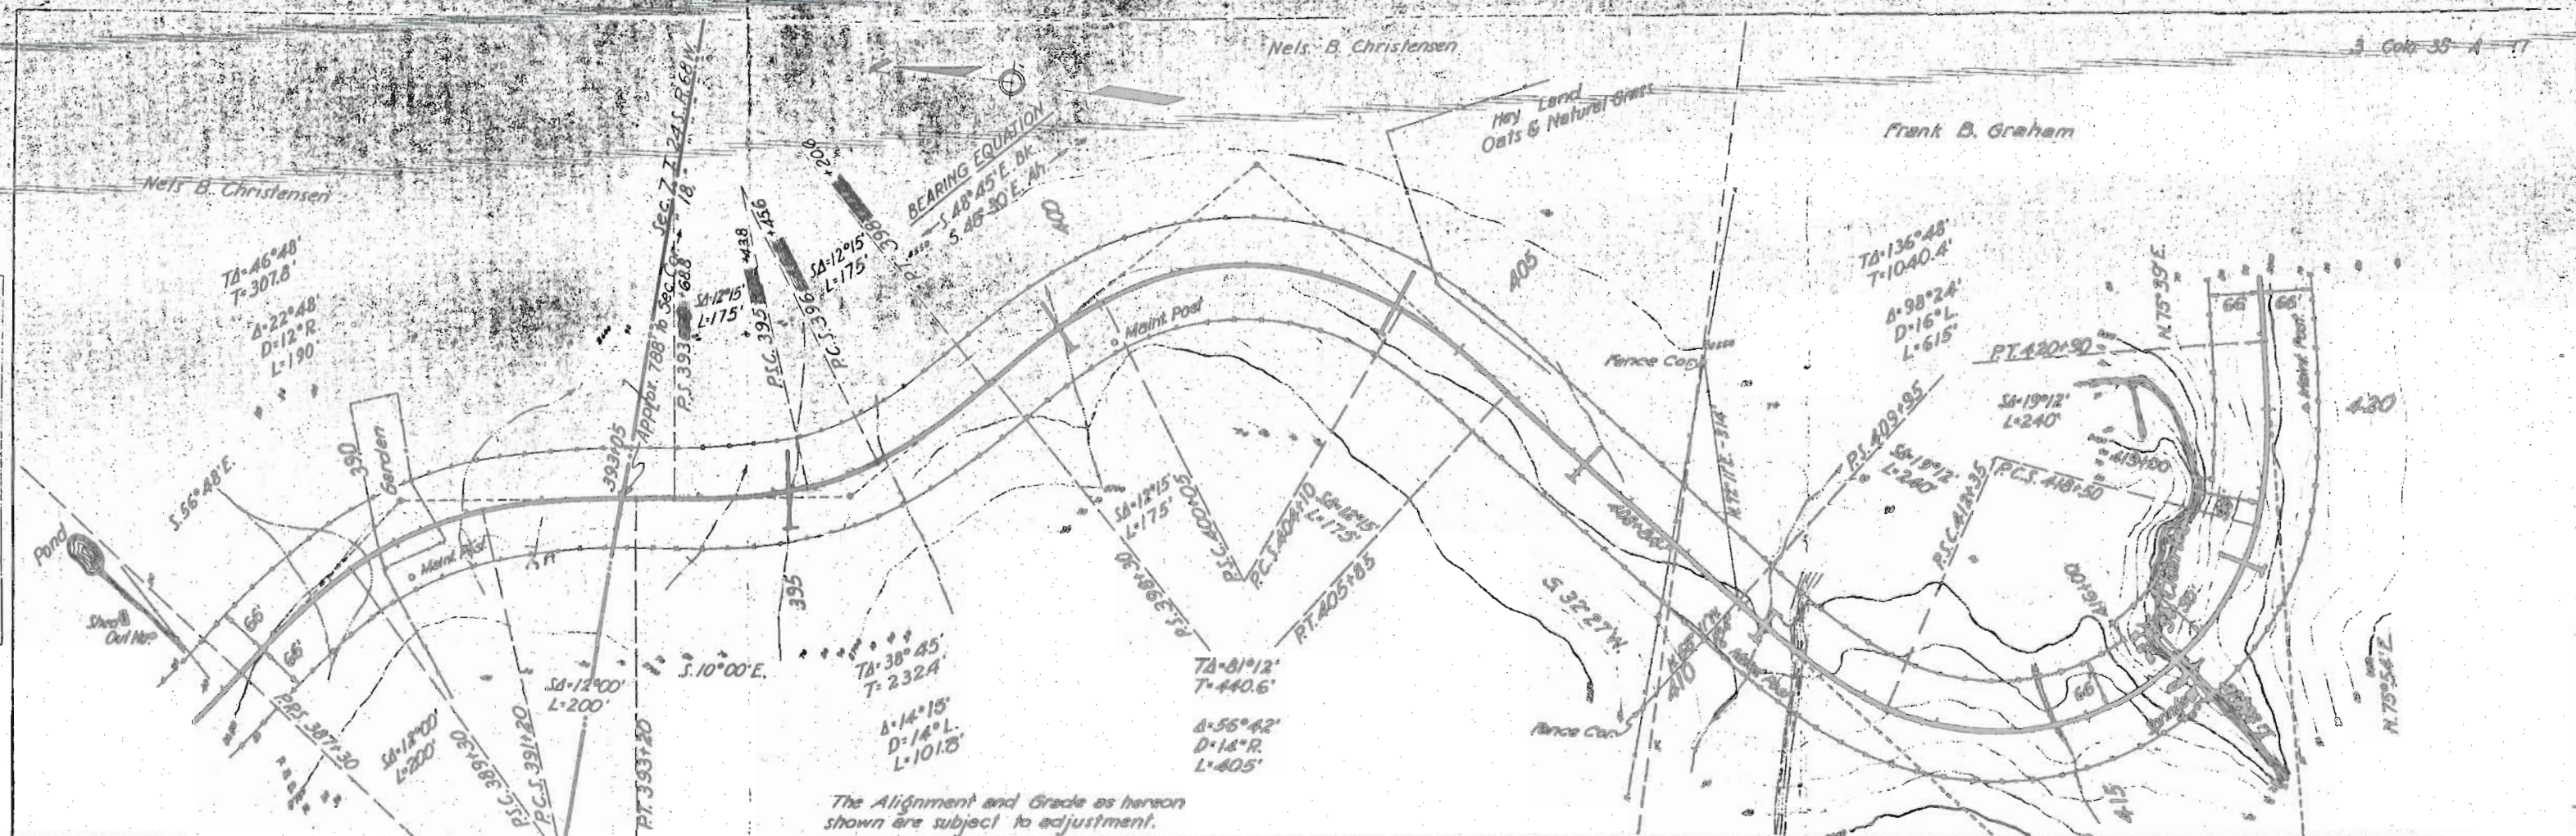

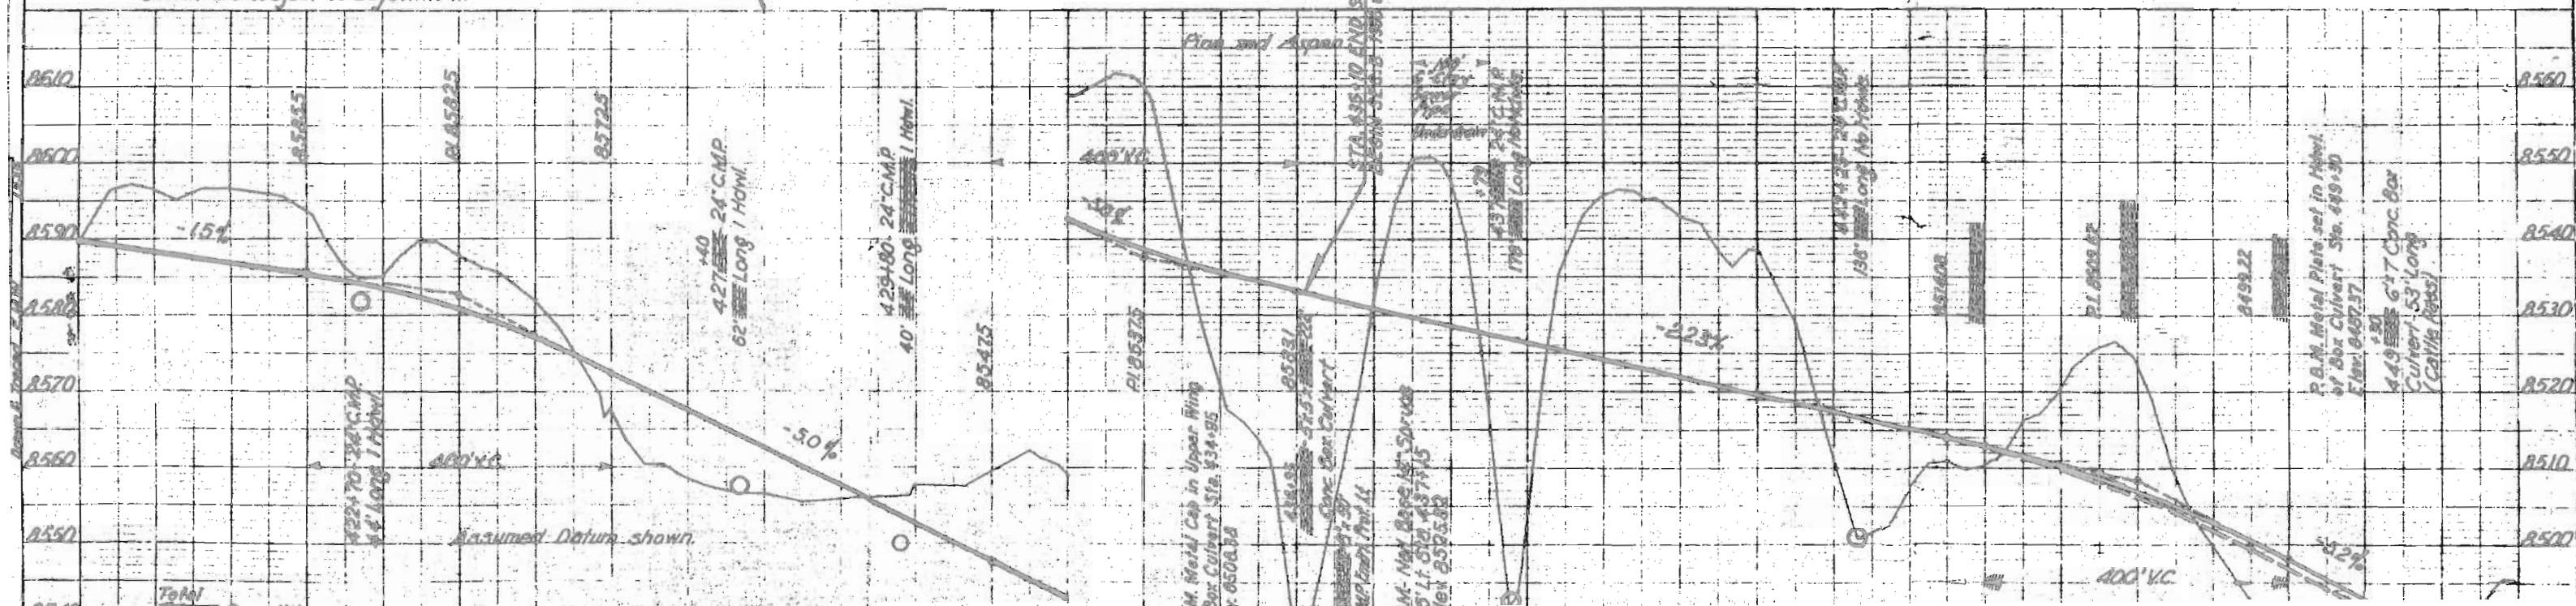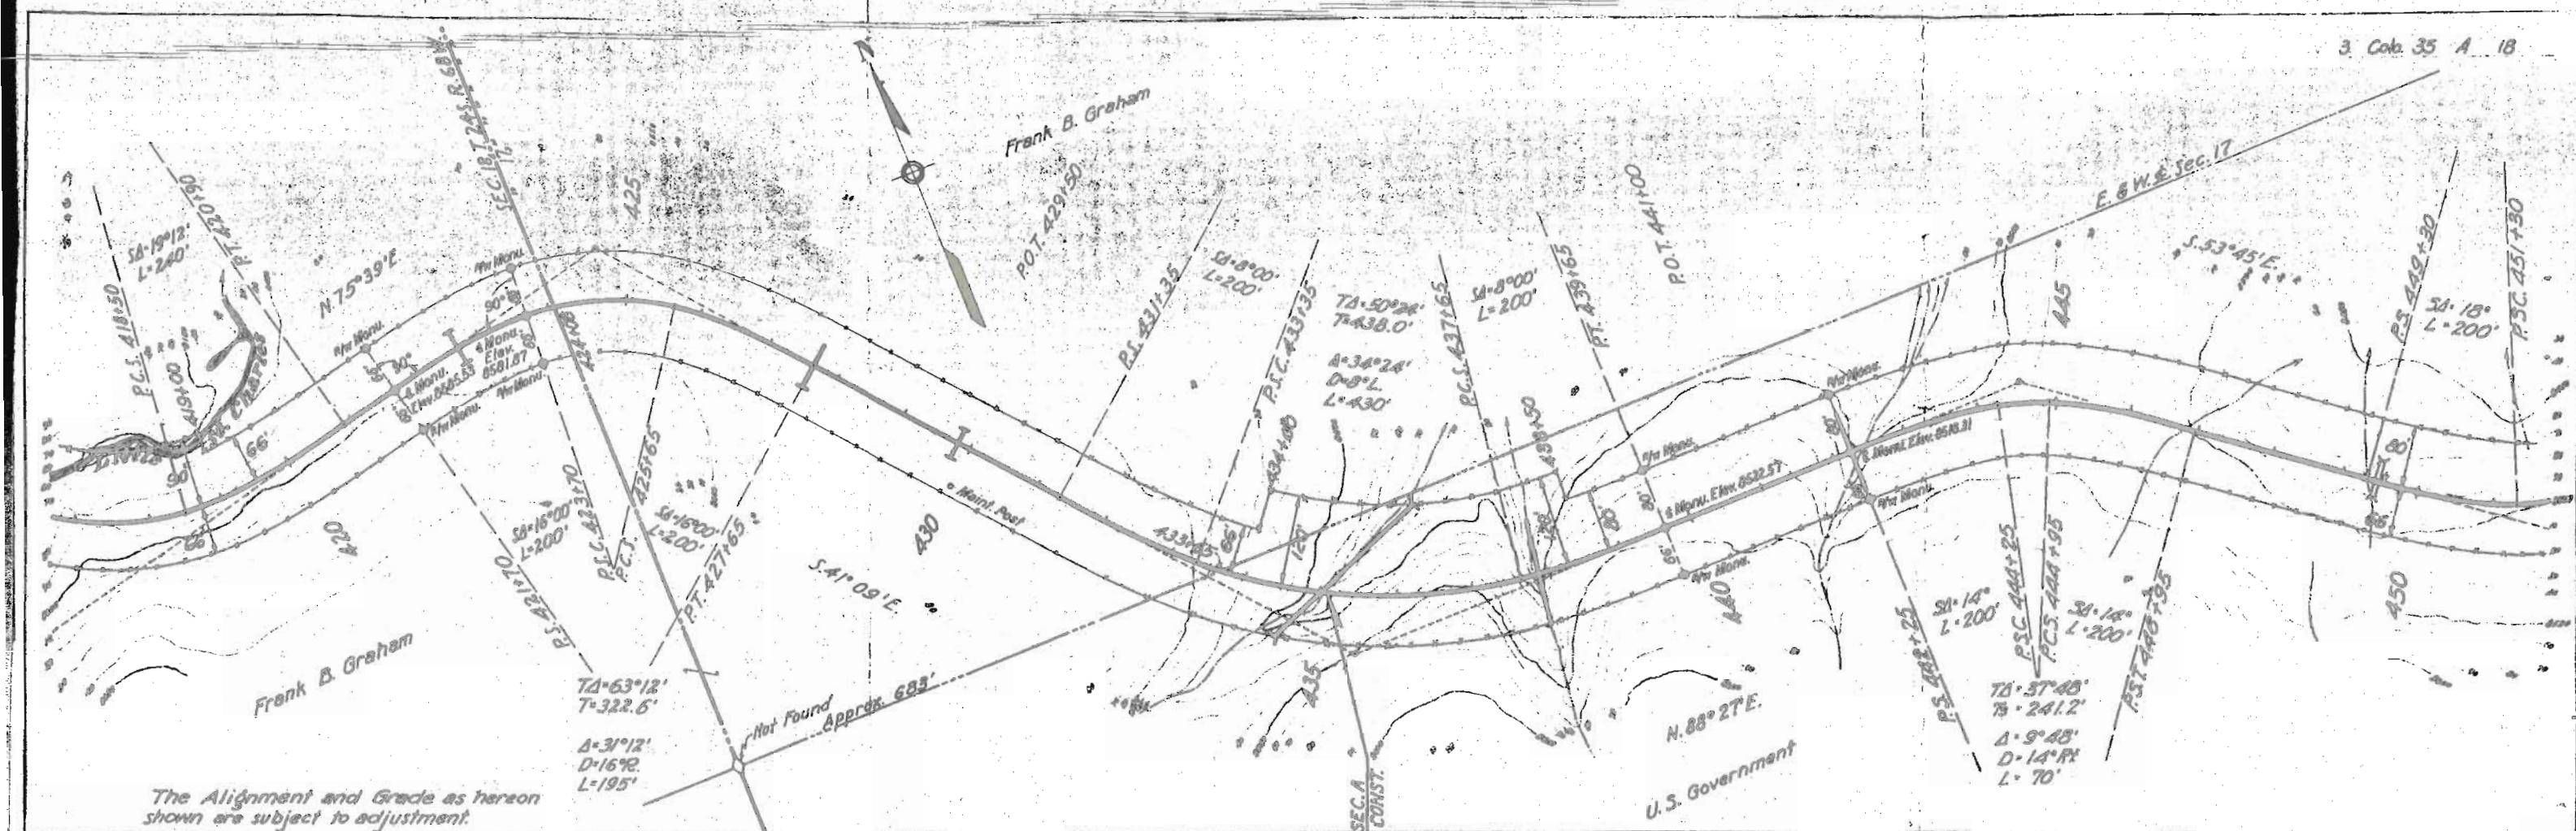

Total	100	100
-------	-----	-----