


UNITED STATES DEPARTMENT OF AGRICULTURE
BUREAU OF PUBLIC ROADS


STATE	ROUTE	SECTION	SHEET NO.	SHEET
COLORADO	35-B	1	1	1

SHEET NO.	DESCRIPTION	STATION	STATION
1	Title Sheet		
2	Typical Sections		
3	Summary		
4	Plan & Profile	435+10	574+21
5	3rd Masonry Hdwy. & Inlets		
6	Drop Inlets		
7	6th. Miscel. Structures		
8	Main Post & Ref. Mon.		
9	Std. Barbed Wire Fence		
10	Cont. Box Culv.	449+20	
11		513+00	
12		518+75	
13	Std. Signs (Construction)		
14	Std. Embl. Inlets & Drains		
15	Cross Sections	435+10	574+21

AS CONSTRUCTED
PROJECT 35-B
ROUTE 35 GREENHORN HIGHWAY
JCT. WITH NORTH HARDCRABBLE FOREST HIGHWAY NO. 13
35 MILES CLASS 2
COLORADO FOREST HIGHWAY SYSTEM
SAN ISABEL NATIONAL FOREST
CUSTER & PUEBLO COUNTIES
COLORADO

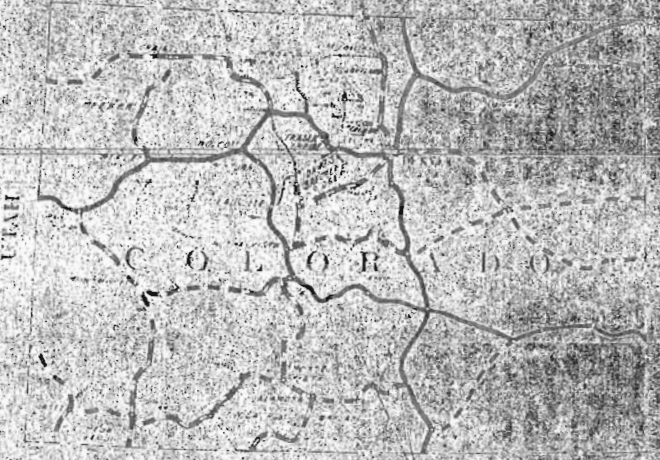

Special Aid Highway System
Forest Highway System
National Forests

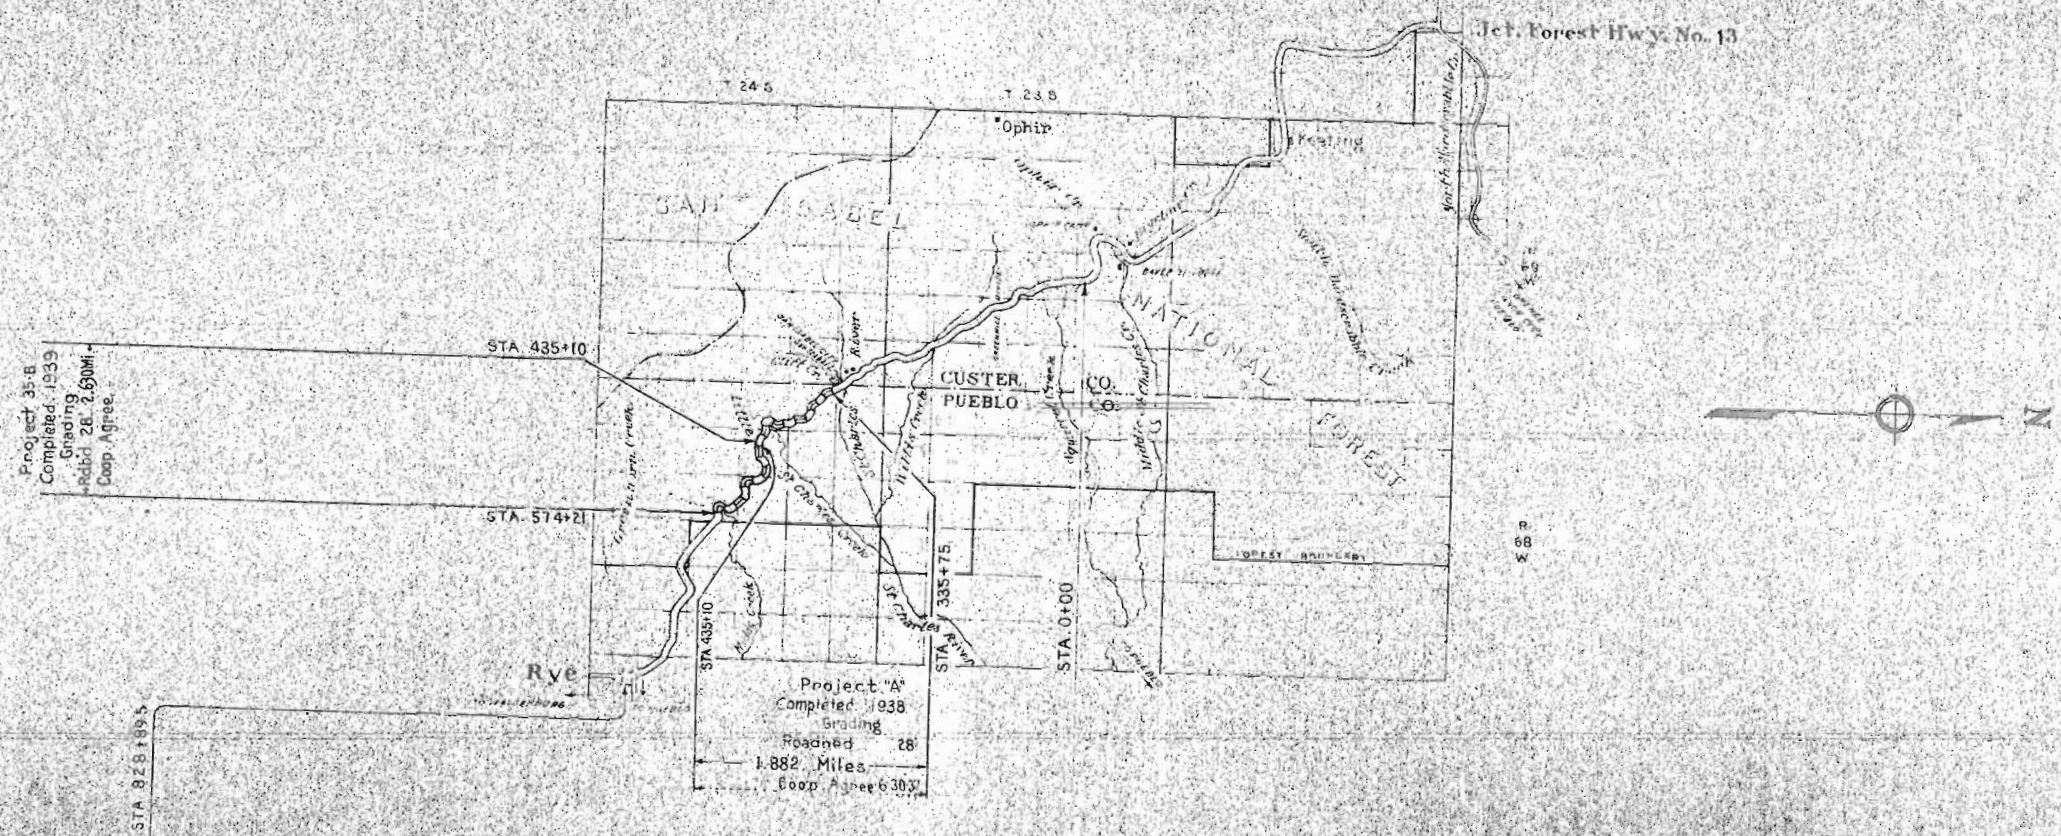

INDEX MAP
Scale Miles

LEGEND
EXISTING GRADE
IMPROVED GRADE
REINFORCED GRADE
PAVED GRADE
PAVED GRADE
PAVED GRADE

Surveyed to U.S.B.P.R. 1935 16.99 Miles

APPROVED _____ DATE _____ 19__
DISTRICT ENGINEER
U.S. BUREAU OF PUBLIC ROADS
APPROVED _____ DATE _____ 19__
REGIONAL FORESTER
U.S. FOREST SERVICE
APPROVED _____ DATE _____ 19__
STATE HIGHWAY ENGINEER
STATE OF COLORADO

