

UTILITIES

U.S. West Communication — Telephone
 Citizen Utilities — Gas
 Southern Colorado Power Association — Electric

T. 24 S., R. 57 W.
 6th P.M.


AS CONSTRUCTED
 NO REVISIONS ☐ REVISED ☒ VOID ☐

FEDERAL ROAD REGION NO.	DIVISION	COMBINED PROJ. NOS.	SHEET NO.
VIII	COLORADO	FR 010-1(19) BRF 010-1(20)	

RIGHT OF WAY

FOR INTERSECTION IMPROVEMENTS
 SEE "DETAIL OF INTERSECTION"

REVISIONS

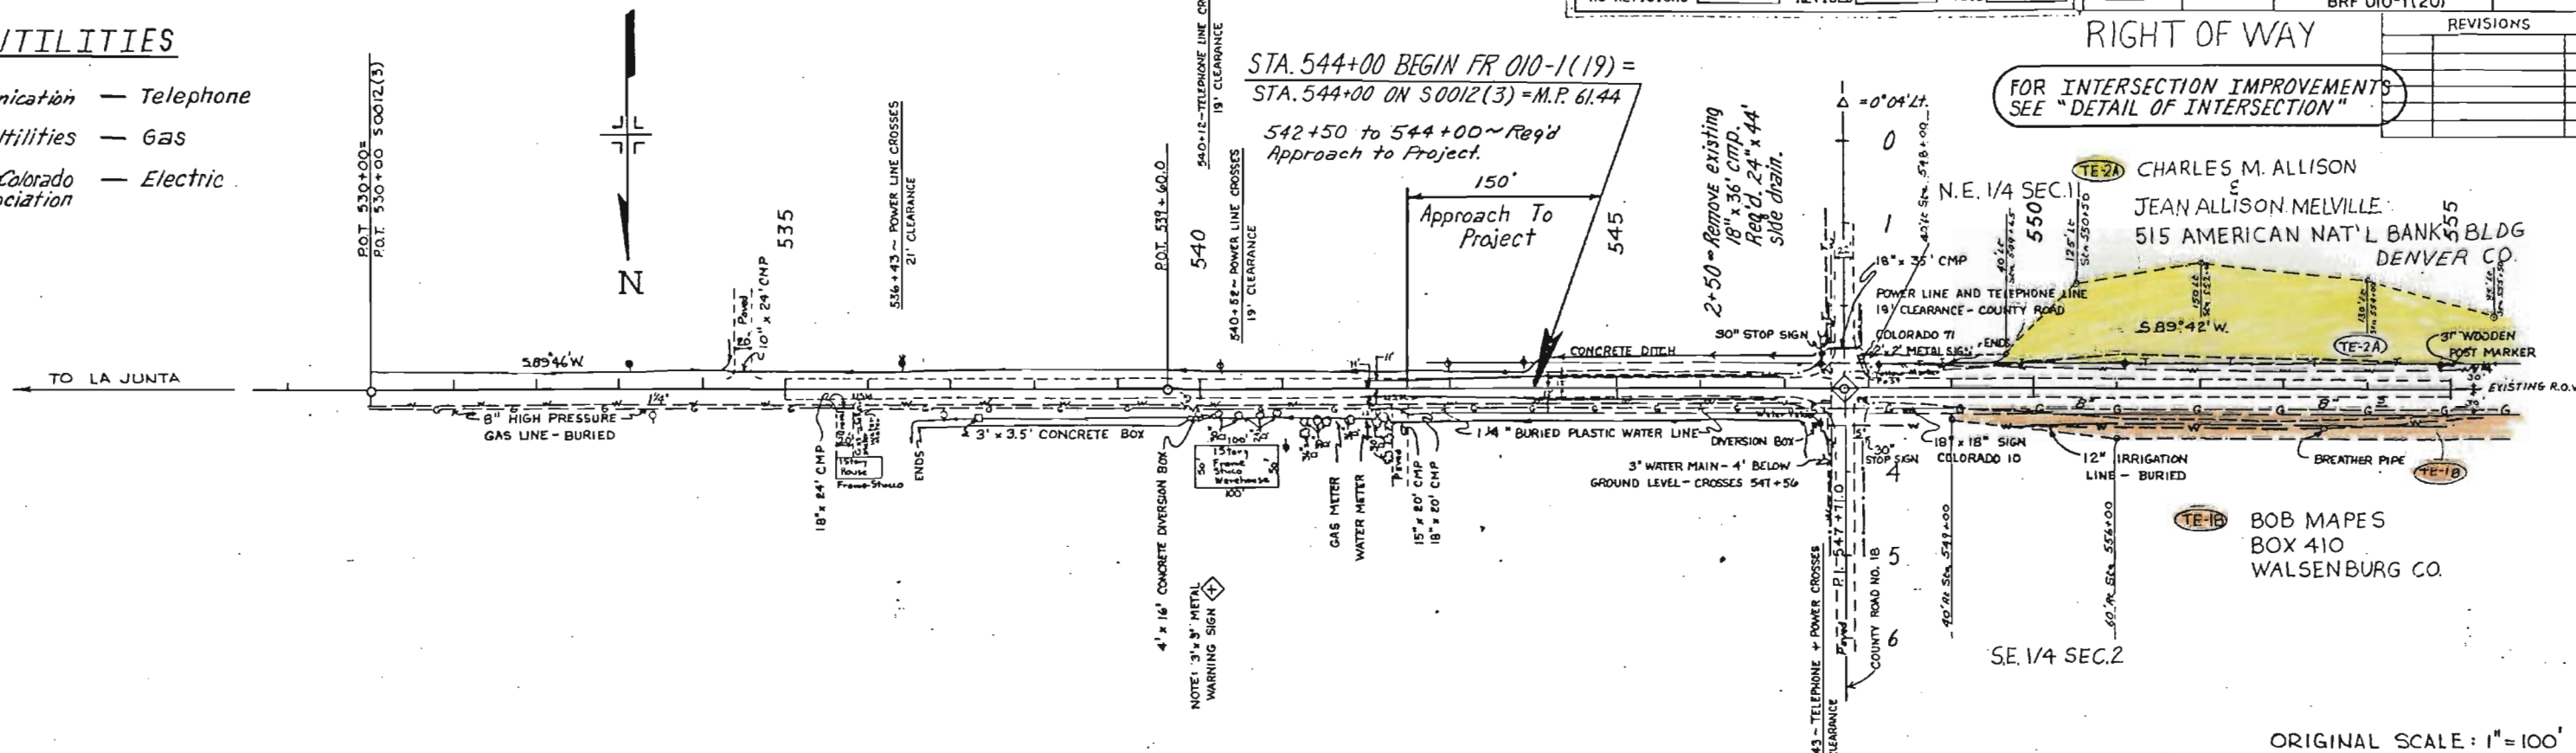

ORIGINAL SCALE: 1"=100'

Soil Survey No. 1790
 Project No. FR 010-1(19)
 Date:


STA. 544+00 BEGIN FR 010-1(19) =
 STA. 544+00 ON S0012(3) = M.P. 61.44

Test No. 3
 (No. Sample)
 Asphalt

Test No. 3A
 A-1-2(10)
 LL = NY
 PI = NP
 % 200 = 8
 "R" = 82

Test No. 3B
 A-2-4(10)
 LL = NY
 PI = NP
 % 200 = 25
 "R" = 69

Test No. 3C
 A-6(10)
 LL = 29
 PI = 14
 % 200 = 70
 "R" = 9

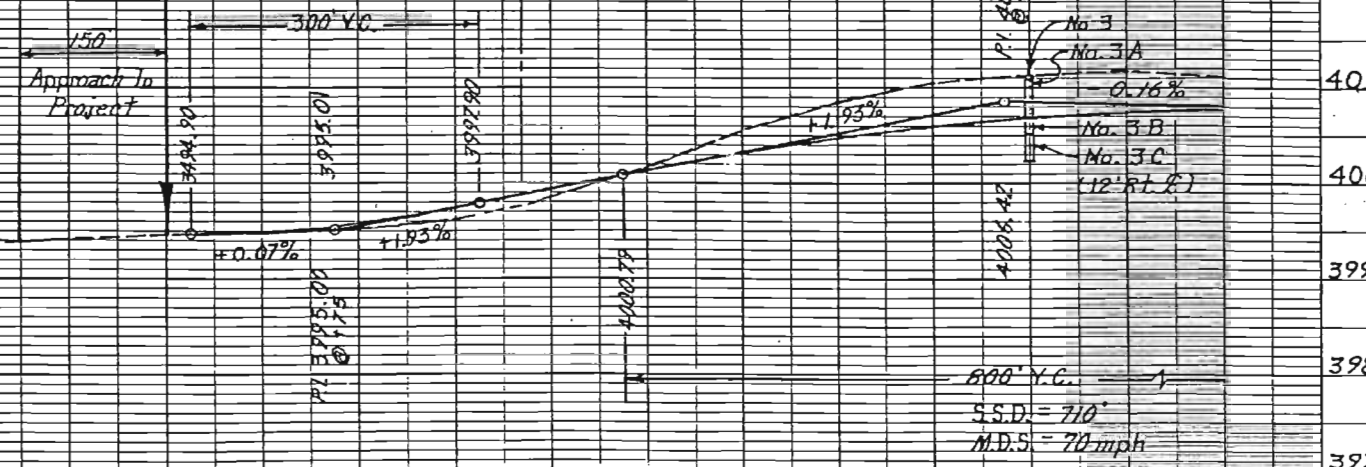


T. 24 S., R. 57 W., 6th P.M.

AS CONSTRUCTED		
NO REVISIONS	REVISED	VOID

FEDERAL ROAD REGION NO.	DIVISION	COMBINED PROJ. NOS.	SHEET NO.
XIII	COLORADO	FR 010-1(19) BRF 010-1(20)	

RIGHT OF WAY	
REVISIONS	

DETOUR DETAIL

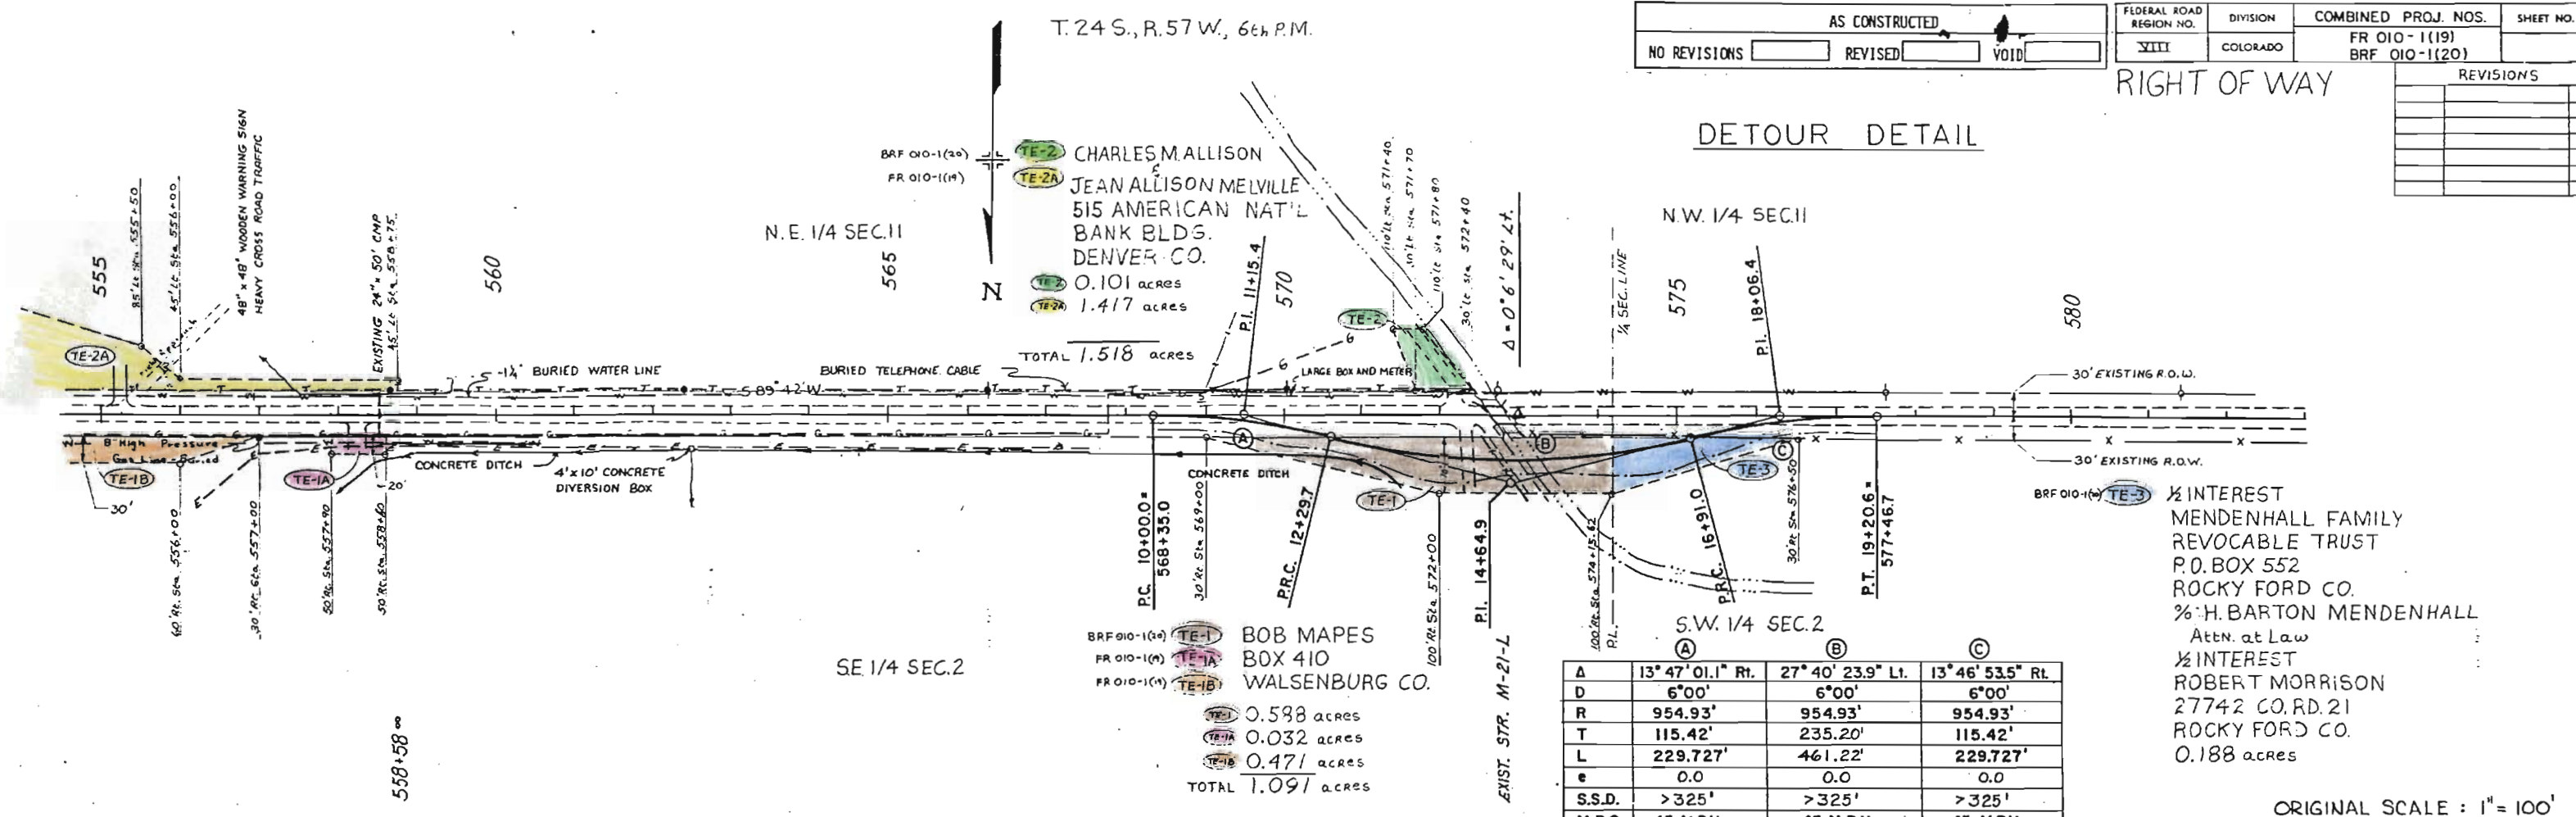

	A	B	C
A	13° 47' 01.1" Rt.	27° 40' 23.9" Lt.	13° 46' 53.5" Rt.
D	6° 00'	6° 00'	6° 00'
R	954.93'	954.93'	954.93'
T	115.42'	235.20'	115.42'
L	229.727'	461.22'	229.727'
e	0.0	0.0	0.0
S.S.D.	> 325'	> 325'	> 325'
M.D.S.	45 M.P.H.	45 M.P.H.	45 M.P.H.

1/2 INTEREST
MENDENHALL FAMILY
REVOCABLE TRUST
P.O. BOX 552
ROCKY FORD CO.
1/2 H. BARTON MENDENHALL
Attn. at Law
1/2 INTEREST
ROBERT MORRISON
27742 CO. RD. 21
ROCKY FORD CO.
0.188 acres

ORIGINAL SCALE: 1" = 100'

FORM 1-1-10110
NO. 253
FUNCTION: ROADWAY CH 10

