


TE3
Rev

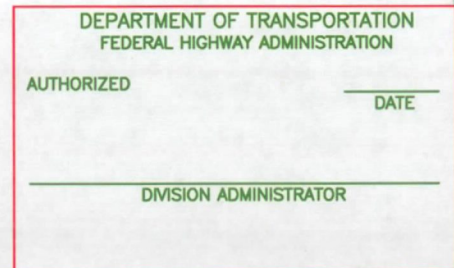

Computer File Information				Sheet Revisions			Colorado Department of Transportation			As Constructed		Porter Draw Plan View				Project No./Code	
Creation Date:	9/22/03	Initials:	drs	☐	7/29/05	TE3 revised	RQ	 Region 2 Design 905 Erie Avenue Pueblo, CO 81001 Phone: (719)546-5728 FAX: (719)546-5414 Region 2 Design & Construction DLM/drs	No Revisions:						BR 0251-162		
Last Modification Date:	12/19/03	Initials:	drs	☐			Revised:								Project Code: 14081		
Full Path:	c:\pcmoss i25 bridges\...			☐			Void:				Sheet Subset:		Subset Sheets:		Sheet Number 2		
Drawing File Name:	design plan.dwg			☐													
Acad Ver.: 2002	Scale: 1"= 50'	Units: English		☐													