

Oversight/NHS

FHWA REGION VIII OVERSIGHT?

☒ NO ☐ YES

NATIONAL HIGHWAY SYSTEM?

☒ NO ☐ YES

Related Projects:

P. E. UNDER PROJECT:

Project Number
BR 0361-064
Project Code
12811

R.O.W. Projects:

R.O.W Project Description:
BR 0361-064

DEPARTMENT OF TRANSPORTATION

STATE OF COLORADO

AS-CONSTRUCTED PLANS

HIGHWAY CONSTRUCTION-BID PLANS OF PROPOSED

FEDERAL AID PROJECT NO. BR 0361-064

STATE HIGHWAY NO. 36



WASHINGTON COUNTY

CONSTRUCTION PROJECT CODE NO. 12811

TABULATION OF LENGTH & DESIGN DATA

STATION	Feet
ROADWAY	
Sta. 106+00 ~ Beg. BR 0361-064 = Approx. Sta. xx+xx on Proj. xxx = Ref. Point 131.625	400
Sta. 110+00 ~ End BR 0361-064 = Approx. Sta. xx+xx on Proj. xxx = Ref. Point 131.701	
TOTAL	xxx
SUMMARY	Feet Miles
ROADWAY (NET LENGTH)	400 0.076
PROJECT GROSS LENGTH	400 0.076
DESIGN DATA	S.H. 36
MINIMUM RADIUS OF CURVE	N/A
MAXIMUM GRADE	4%
MINIMUM S.S.D. HORIZONTAL	< 1300'
MINIMUM S.S.D. VERTICAL	N/A
MAXIMUM DESIGN SPEED	65 MPH
2003 TRAFFIC	DHV = 74 ADT = 618
2023 DESIGN TRAFFIC	DHV = 118 ADT = 983
DHV TRUCKS %	44%
CLEAR ZONE DISTANCE (TANGENT)	42 FL

MP 131.625 - 131.701

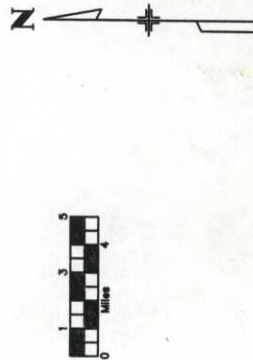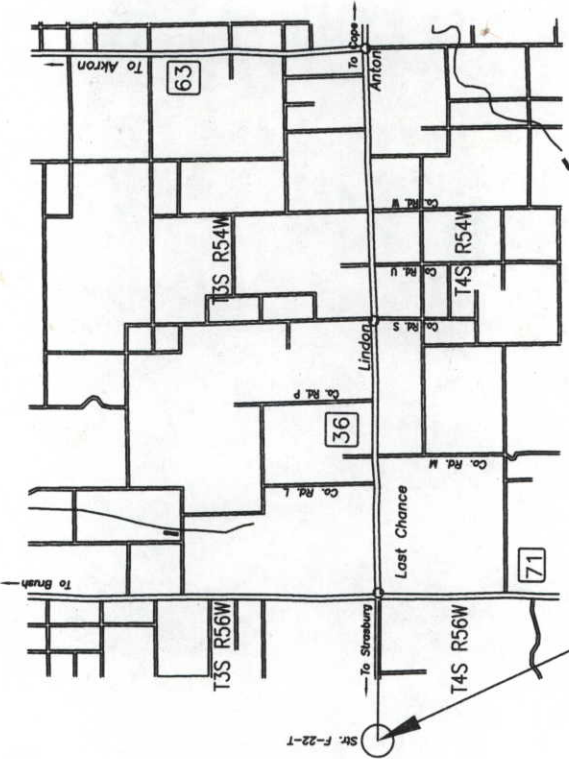

Project Location

Index of Sheets

- 1

Title Sheet
- 2

Standard Plans List
- 3-4

Typical Sections and Typical Notes
- 5

General Notes
- 6-7

Summary of Approximate Quantities
- 8

Structure Quantities
- 9

Summary of Earthwork Quantities, Removal of Asphalt Mat, Surfacing Plan, Detour Surfacing Plan
- 10

Tabulation of Delimiters, Tabulation of Fence, Removal of Guardrail
- 11

Roadway Plan Sheet
- 12

Roadway Profile Sheet
- 13

Detour Plan Sheet
- 14

Detour Profile Sheet
- 15

Construction Traffic Control Devices
- 16

Stormwater Management Plan
- 17

Survey Tabulation
- R.O.W. Plans (1 sheets)
- New & Revised Standards
- M-607-1, Wire Fences And Gates, 01/16/04, 3 Sheets
- M-627-1, Typical Pavement Markings, 03/23/04, 5 Sheets
- S-630-1, Traffic Controls For Highway Construction, 09/03/03, 10 Sheets

Computer File Information

Creation Date:

31/Jul/96

Initials:mcs

Last Modification Date:

27/Jul/04

14:34 Initials:mcs

Full Path:

C:\12811 Last Chance\Roadway\Plans\

Drawing File Name:

01title.dwg

Acad Ver.:

16.0s (LMS:techN)/A

Units:

English

Index of Revisions

10-07-04

Shts. 1,5,6,8,9,11,12

MCS

(R-1)

(R-2)

(R-3)

(R-4)

(R-5)

Colorado Department of Transportation

1420 2nd Street

Greeley CO 80631

Phone: 970-506-4949

FAX: 970-339-9530

DOT

Division of Transportation

Region 4

As Constructed

No Revisions:

07-13-05

Revised:

09-13-05

Void:

Contract Information

Contractor:

Argonne Utilities & Infrastructure Inc.

Resident Engineer:

Douglas W. Pearson

Project Engineer:

Glenn Friefer Greg Jones

PROJECT STARTED:

07/14/05

ACCEPTED:

09/13/05

Comments:

Project No./Code

BR 0361-064

12811

Sheet Number

1

PLAN NUMBER		M STANDARD TITLE		PAGE NUMBER	M STANDARD TITLE		PAGE NUMBER	S STANDARD TITLE		PAGE NUMBER
☒ M-100-1	STANDARD SYMBOLS			1	☐ M-607-1	WIRE FENCES AND GATES	(3 SHEETS)	☐ S-612-1	TYPICAL DELINEATOR INSTALLATIONS	(5 SHEETS)
☐ M-203-1	APPROACH ROADS			2	☐ M-607-2	CHAIN LINK FENCE	(3 SHEETS)	☐ S-614-1	TYPICAL GROUND SIGN PLACEMENT	114
☐ M-203-2	DITCH TYPES			3	☐ M-607-3	BARRIER FENCE	84	☐ S-614-2	CLASS I GROUND SIGN INSTALLATIONS	115
☐ M-203-10	SUPERELEVATION CROWNED HIGHWAYS			4	☐ M-607-4	DEER FENCE AND GATES	(2 SHEETS)	☐ S-614-3	CLASS II GROUND SIGN INSTALLATIONS	116
☐ M-203-11	SUPERELEVATION DIVIDED HIGHWAYS SHOULDER PIVOT			5	☐ M-607-10	PICKET SNOW FENCE	87	☐ S-614-4	CLASS III SIGNS, SHEET ALUMINUM PANELS	(3 SHEETS)
☐ M-203-12	SUPERELEVATION STREETS			6	☐ M-608-1	CURB RAMPS	88	☐ S-614-5	BREAK-AWAY SIGN SUPPORT DETAILS FOR GROUND SIGNS	(2 SHEETS)
☐ M-203-13	SUPERELEVATION DIVIDED HIGHWAYS CENTER PIVOT			7	☐ M-609-1	CURBS, GUTTERS, AND SIDEWALKS	(2 SHEETS)	☐ S-614-6	CONCRETE FOOTINGS AND SIGN ISLANDS FOR CLASS III SIGNS	(2 SHEETS)
☒ M-206-1	EXCAVATION AND BACKFILL FOR STRUCTURES	(2 SHEETS)	8-9	☐ M-611-1	CATTLE GUARD	(2 SHEETS)	91-92	☐ S-614-10	TYPICAL MARKER ASSEMBLY INSTALLATIONS	124
☐ M-206-2	EXCAVATION AND BACKFILL FOR BRIDGES	(2 SHEETS)	10-11	☐ M-613-1	CONVENTIONAL HIGHWAY LIGHTING	(3 SHEETS)	93-95	☐ S-614-11	MILEPOST SIGN AND INSTALLATION	125
☐ M-208-1	TEMPORARY EROSION CONTROL	(7 SHEETS)	12-18	☐ M-613-2	HIGH MAST LIGHTING	(2 SHEETS)	96-97	☒ S-614-12	STRUCTURE NUMBER INSTALLATION (BRIDGE INFORMATION SHEET)	126
☐ M-210-1	MAILBOX SUPPORTS	(2 SHEETS)	19-20	☐ M-614-1	RUMBLE STRIPS	(2 SHEETS)	98-99	☐ S-614-14	FLASHING BEACON AND SIGN INSTALLATION	(2 SHEETS)
☐ M-214-1	PLANTING DETAILS		21	☐ M-615-1	EMBANKMENT PROTECTOR, TYPE 3		100	☐ S-614-20	TYPICAL POLE MOUNT SIGN INSTALLATION	129
☐ M-412-1	CONCRETE PAVEMENT JOINTS	(3 SHEETS)	22-24	☐ M-615-2	EMBANKMENT PROTECTOR, TYPE 5		101	☐ S-614-21	CONCRETE BARRIER SIGN POST INSTALLATIONS	130
☐ M-506-1	GABIONS AND SLOPE MATRESS		25	☐ M-616-1	INVERTED SIPHON		102	☐ S-614-22	TYPICAL MULTI-SIGN INSTALLATIONS	131
☐ M-510-1	STRUCTURAL PLATE CULVERT PIPE H-20 LOADING		26	☐ M-620-1	FIELD LABORATORY, CLASS 1		103	☐ S-614-40	TYPICAL TRAFFIC SIGNAL INSTALLATION DETAILS	(5 SHEETS)
☐ M-601-1	SINGLE CONCRETE BOX CULVERT	(2 SHEETS)	27-28	☒ M-620-2	FIELD LABORATORY, CLASS 2		104	☐ S-614-50	OVERHEAD SIGNS MONOTUBE	(12 SHEETS)
☒ M-601-2	DOUBLE CONCRETE BOX CULVERT	(2 SHEETS)	29-30	☐ M-620-11	FIELD OFFICE, CLASS 1		105	☐ S-627-1	TYPICAL PAVEMENT MARKINGS	(5 SHEETS)
☐ M-601-3	TRIPLE CONCRETE BOX CULVERT	(2 SHEETS)	31-32	☒ M-620-12	FIELD OFFICE, CLASS 2		106	☐ S-630-1	TRAFFIC CONTROLS FOR HIGHWAY CONSTRUCTION	(10 SHEETS)
☐ M-601-10	HEADWALL FOR PIPE CULVERTS		33	☐ M-629-1	SURVEY MONUMENTS	(2 SHEETS)	107-108	☒ S-630-2	BARRICADES, DRUMS, CONCRETE BARRIERS (TEMP) & VERTICAL PANELS	164
☐ M-601-11	TYPE "S" SADDLE HEADWALL FOR PIPE CULVERTS		34					☒ S-630-3	FLASHING BEACON (PORTABLE) DETAILS	165
☐ M-601-12	HEADWALLS AND CULVERT OUTLET PAVING		35							
☒ M-601-20	WINGWALLS FOR PIPE OR BOX CULVERTS		36							
☐ M-603-1	METAL AND PLASTIC CULVERT PIPE	(2 SHEETS)	37-38							
☐ M-603-2	REINFORCED CONCRETE PIPE		39							
☐ M-603-3	PRECAST CONCRETE BOX CULVERT		40							
☐ M-603-10	CONCRETE AND METAL END SECTIONS	(2 SHEETS)	41-42							
☐ M-604-10	INLET, TYPE C		43							
☐ M-604-11	INLET, TYPE D		44							
☐ M-604-12	CURB INLET, TYPE R	(2 SHEETS)	45-46							
☐ M-604-13	CONCRETE INLET, TYPE 13		47							
☐ M-604-20	MANHOLES	(3 SHEETS)	48-50							
☐ M-604-25	VANE GRATE INLET WITH FRAME AND CONCRETE APRON	(5 SHEETS)	51-55							
☐ M-605-1	S/SURFACE DRAINS		56							
☐ M-606-1	GUARDRAIL, TYPE 3, W-BEAM	(15 SHEETS)	57-71							
☐ M-606-12	GUARDRAIL, TYPE 4, CONCRETE BARRIER	(2 SHEETS)	72-73							
☐ M-606-13	GUARDRAIL, TYPE 7, F-SHAPE BARRIER	(4 SHEETS)	74-77							

THE STANDARD PLAN SHEETS INDICATED HEREON BY A MARKED BOX ARE TO BE USED TO CONSTRUCT THIS PROJECT.

COLORADO
DEPARTMENT OF TRANSPORTATION

STANDARD PLANS LIST
M & S STANDARDS
OCTOBER 1, 2000

Computer File Information				Sheet Revisions		Colorado Department of Transportation		As Constructed		Standard Plans List		Project No./Code	
Credition Date:	31/Jul/96	Initials:mcs	(R-1)			 1420 2nd Street Greeley CO 80631 Phone: 970-350-2135 FAX: 970-339-9530 Region 4	RKP	No Revisions:	09-13-05	Designer: Detailer:		BR 0361-064	
Last Modification Date:	27/Jul/04	14:38 Initials:mcs	(R-2)					Revised:				12811	
Full Path:	C:\12811 Last Chance\Roadway\Plans\	02spl_2000.dwg	(R-3)					Void:					
Drawing File Name:			(R-4)					Sheet Subset:	Design	Subset Sheets:	of	Sheet Number	
Acad Ver.: 16.0s (LMScatch)/A		Units: English	(R-5)										

For preliminary plan quantities of surfacing materials, the following rates of applications were used:

- Emul. Asphalt (Slow Setting) (Tack Coat) @ 0.1 Gal./S.Y. (Diluted)
- Bituminous Pavement @ 115 Lbs./Sq. Yd./Inch Thick
- Aggregate Base Course @ 133 Lbs./Cu. Ft.

Diluted Emulsified Asphalt for tack coat shall consist of one part emulsified asphalt and one part water. Cost included in price of item 403—Hot Bituminous Pavement.

Rates of application shall be determined by the Engineer at the time of application.

Any layer of bituminous pavement that is to have a succeeding layer placed thereon shall be completed full width before succeeding layer is placed, unless approved otherwise by the Engineer.

Road approaches which require bituminous pavement shall be paved as follows:

Public approaches and entrances to buildings and residences shall be paved with a 2 inch thickness of bituminous pavement 50 feet out from edge of shoulder or to the Right of Way line, whichever is less.

Field entrances shall be paved with a 2 inch thickness of bituminous pavement 4 feet out from edge of shoulder.

Depth of moisture—density control for this project shall be as follows:
Full depth of all embankments.
Bases of cuts and fills – 6 inches.

Type of compaction for this project shall be AASHTO T-99.

Excavation required for compaction for bases of cuts and fills will be considered as subsidiary to that operation and will not be paid for separately.

It is estimated that 100 hours of Blading with a motor grader in the 125 to 150 flywheel horsepower range, will be required for use as directed.

It is estimated that 4 Acres of Soil Preparation (Special) will be required on mainline slopes prior to seeding. Detour slopes will not receive any special preparation prior to seeding.

Structure Excavation and Structure Backfill for concrete box culverts and culverts will not be measured and paid for separately, but shall be included in the work.

Removal of Culvert Pipe shall include removal of metal end sections and removal of bituminous curb and run-downs. This will not be measured and paid for separately.

The Contractor shall reference striping prior to construction, and shall place pavement marking in the same locations as existing striping. It is estimated that 18 Gal. of Epoxy Pavement Marking (11 white, 7 yellow) will be required to stripe existing roadway after detour is removed.

Rumble Strips will not be placed on this project.

Tree removal shall be completed before April 1st or after August 31st. Removal of trees or bushes outside the toe of slope will not be permitted, unless they are within the clear zone. Cut Trees shall be removed from the project within 24 hours from the start of removal. If work must take place between these dates a nesting bird survey must be completed before construction begins.

Bridge or box culvert work that may disturb nesting birds must be completed before April 1st or after August 31st. If this work must take place between these dates a nesting bird survey must be completed before construction begins.

(R-1)

Computer File Information				Colorado Department of Transportation				As Constructed		General Notes				Project No./Code	
Creation Date:		31/Jul/96		Initials:mcs		 1420 2nd Street Greeley CO 80631 Phone: 970-350-2135 FAX: 970-339-9530 Region 4		No Revisions: <u>09-13-05</u>		Designer: mcs		mcs		BR 0361-064	
Last Modification Date:		27/Jul/04 14:51		Initials:mcs											
Full Path:		C:\12811 Last Chance\Roadway\Plans\		Revised:											
Drawing File Name:		05gen_notes.dwg		Detailer:											
Acad Ver.:		16.0s (LMScalech)		Units: English		DWP		Void:		Sheet Subset:		Design		Subset Sheets: of	
				Sheet Revisions											
				10-07-04		Rev Gen Notes		MCS							

Summary of Earthwork Quantities

EMBANKMENT MATERIAL (COMPLETE IN PLACE) Roadway (From Computer) SH 36 Structure Quantities as Embankment		PROJECT TOTAL CY
		1478
Unclassified Excavation (For Information Only) Roadway (From Computer) SH 36 Structure Quantities as Excavation		582
		582
Compaction (AASHTO T-99) (For Information Only) Embankment (Net) Est. for Base Compaction		1033
		889
Total CY		1922
ROADWAY QUANTITIES BALANCE (For Information Only) Contractor Source of Borrow Material Embankment x Factor (1.4)		1447
		1447
Total CY		1447

Note:

Embankment Material (Complete in Place) will not be remeasured; plan quantity will be paid.

For Information Only:
It is estimated the following earthwork quantities will be required for the Detour:
Embankment ~ 5314 C.Y.
Excavation ~ 3145
No adjustment was made to these computer-generated quantities for adjusting grade of Detour ends to match grade and cross slope of existing roadway.

AS-CONST. Removal of Asphalt Mat

Location	Sq. Yd.
106+00 to 108+	284
108+ to 110+00	259
PROJECT TOTAL	543

Pavement shall be saw-cut to a neat line at Sta. 106+00 and Sta. 110+00, and new pavement placed flush.

Removal of bituminous curb and bituminous runoff will not be measured and paid for separately, but shall be included in the cost of Removal of Asphalt Mat.

Removal of Asphalt Mat will not be remeasured; plan quantity will be paid.

Surfacing Plan

Location	Typical Section	Length Sta.	Width Feet	Tons			Tons
				Top Layer	Middle Layer	Bottom Layer	Aggregate Base Course
106+00 to 108+50	A	2.5	40'	130	130	178	335
108+50 to 110+00	A	1.5	40' to 44.28'	82	82	112	212
Est. for Irregularities				11	11	44	
SUBTOTALS				223	223	334	547
PROJECT TOTALS					780		547

Notes:

All Layers shall be Hot Bituminous Pavement (Grading S) (75) (PG 64-22)

Base Course shall be Aggregate Base Course (Class 6).

Detour Surfacing Plan (For Information Only)


Location	Typical Section	Length Sta.	Width Feet	Tons		
				Top Layer	Middle Layer	Bottom Layer
502+55 to 513+79	B	11.24	32	461	461	461
Est. for Irregularities						47
SUBTOTALS				461	461	508
PROJECT TOTALS					1430	

Notes:


Hot Bituminous Pavement shall be as determined by the Contractor.

Stations shown are where Detour centerline crosses north edge of existing pavement.

Computer File Information			Sheet Revisions		Colorado Department of Transportation  1420 2nd Street Greeley CO 80631 Phone: 970-506-4949 FAX: 970-339-9530 Region 4	As Constructed	Summary of Earthwork Quantities			Project No./Code
Creation Date:	31/Jul/96	Initials:mcs	10-07-04	Rev Earthwork			MCS	No Revisions:	Surfacing Plan, Detour Surfacing Plan Removal of Asphalt Mat	
Last Modification Date:	27/Jul/04	14:54 Initials:mcs				Revised:	09-13-05	Design:	mcs	12811
Full Path:	C:\12811 Last Chance\Roadway\Plans\					Void:		Detailer:	mcs	
Drawing File Name:	09surfplan.dwg							Sheet Subset:		Sheet Number
Acad Ver.: 16.0s (LMS)	Scale: N/A							Design	Subset Sheets:	9
	Units: English									of

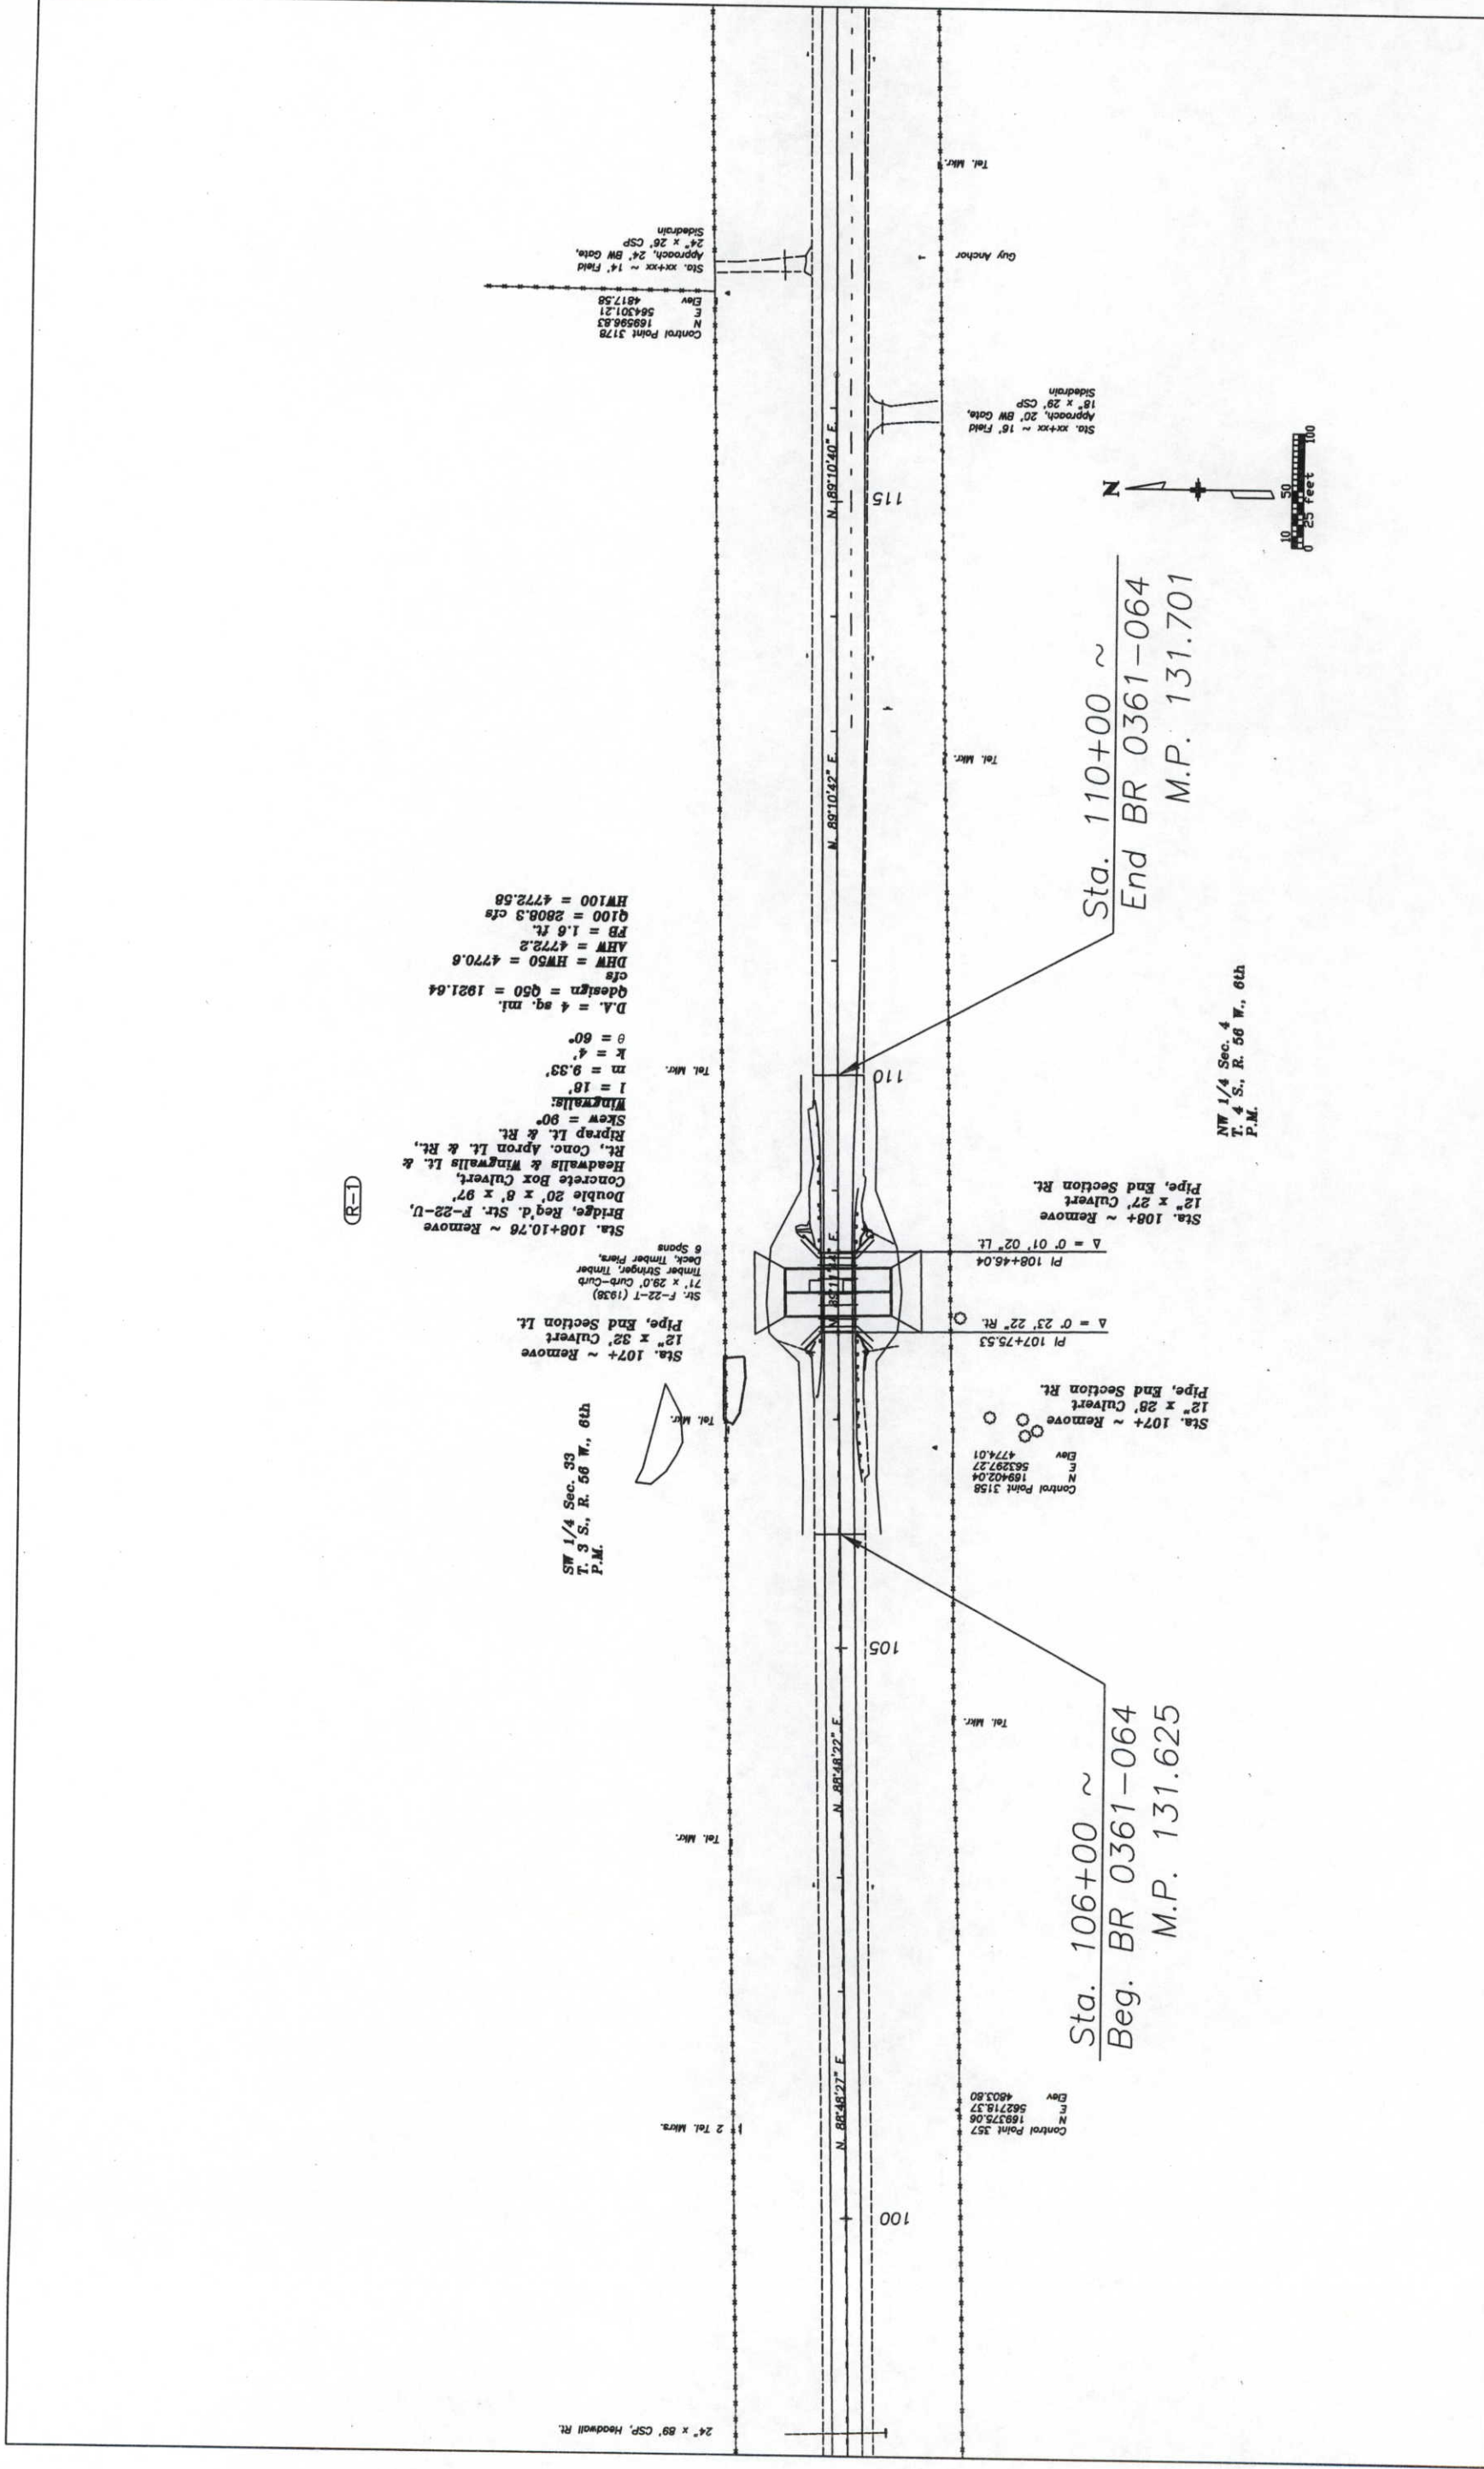

Computer File Information			Sheet Revisions		Colorado Department of Transportation		As Constructed		Roadway Plan Sheet		Project No./Code	
Creation Date:	31/Jul/96	Initials:mcs	(R-1)	10-07-04	CBC Station	MCS	No Revisions:				BR 0361-064	
Last Modification Date:	06/Oct/04	10:45 Initials:mcs	(R-2)				Revised:	09-13-05			12811	
Full Path:	C:\12811 Last Chance\Roadway\Plans\		(R-3)				Void:				Design	
Drawing File Name:	11plan_roadway.dwg		(R-4)								mcs	
Acad Ver.:	16.0s (LMSdtech)	Units: English	(R-5)								mcs	
											Design	
											Sheet Subsets:	
											of	
											Sheet Number	
											11	

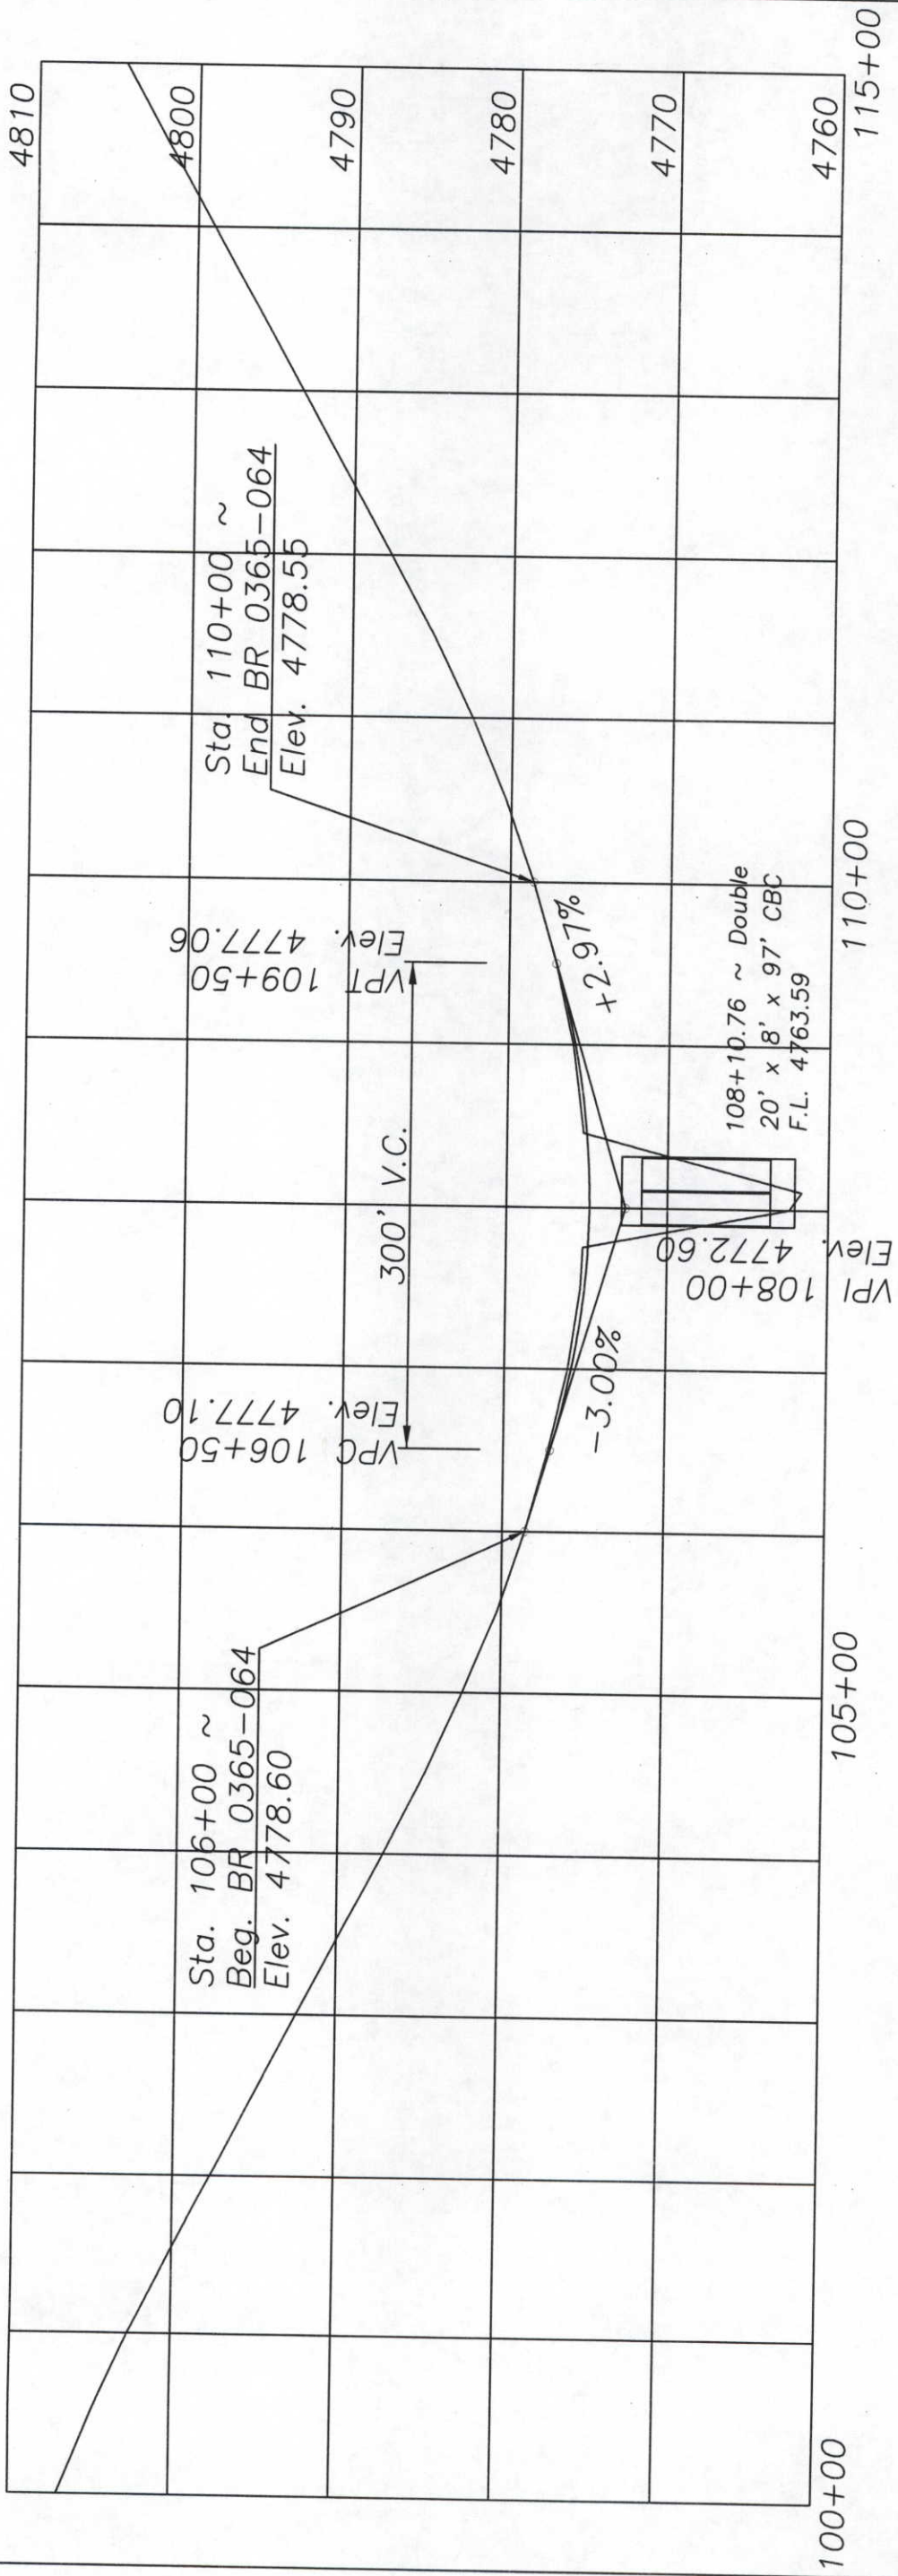


Adjust Profile Grade as and cross slopes
necessary to assure a smooth butt joint with
existing pavement at each end of the project.

Computer File Information				Sheet Revisions			Colorado Department of Transportation			As Constructed		Roadway Profile Sheet			Project No./Code	
Creation Date:	31/Jul/96	Initials:mcs	(R-1)	10-07-04	Profile Grade, Vert Curve	MCS	 1420 2nd Street Greeley CO 80631 Phone: 970-350-2135 FAX: 970-339-9530 Region 4			No Revisions: 09-05-05						
Last Modification Date:	27/Jul/04	14:59 Initials:mcs	(R-2)							Revised: 09-05-05						
Full Path:	C:\12811 Last Chance\Roadway\Plans\									Detailer: mcs						
Drawing File Name:	12profile_roadway.dwg									Sheet Subsets: Design						
Acad Ver.:	16.0s (LMScalech)	Units: English	(R-5)							Sheet Subsets: of						
													Sheet Number	12		

CONSTRUCTION SIGNING

SEE M&S TYPICAL APPLICATION CASE IV (S-630-1, SHEET 3),
GENERAL NOTES (S-630-1, SHEET 9), AND
TYPICAL CONSTRUCTION ZONE SIGNS (S-630-1, SHEET 10)

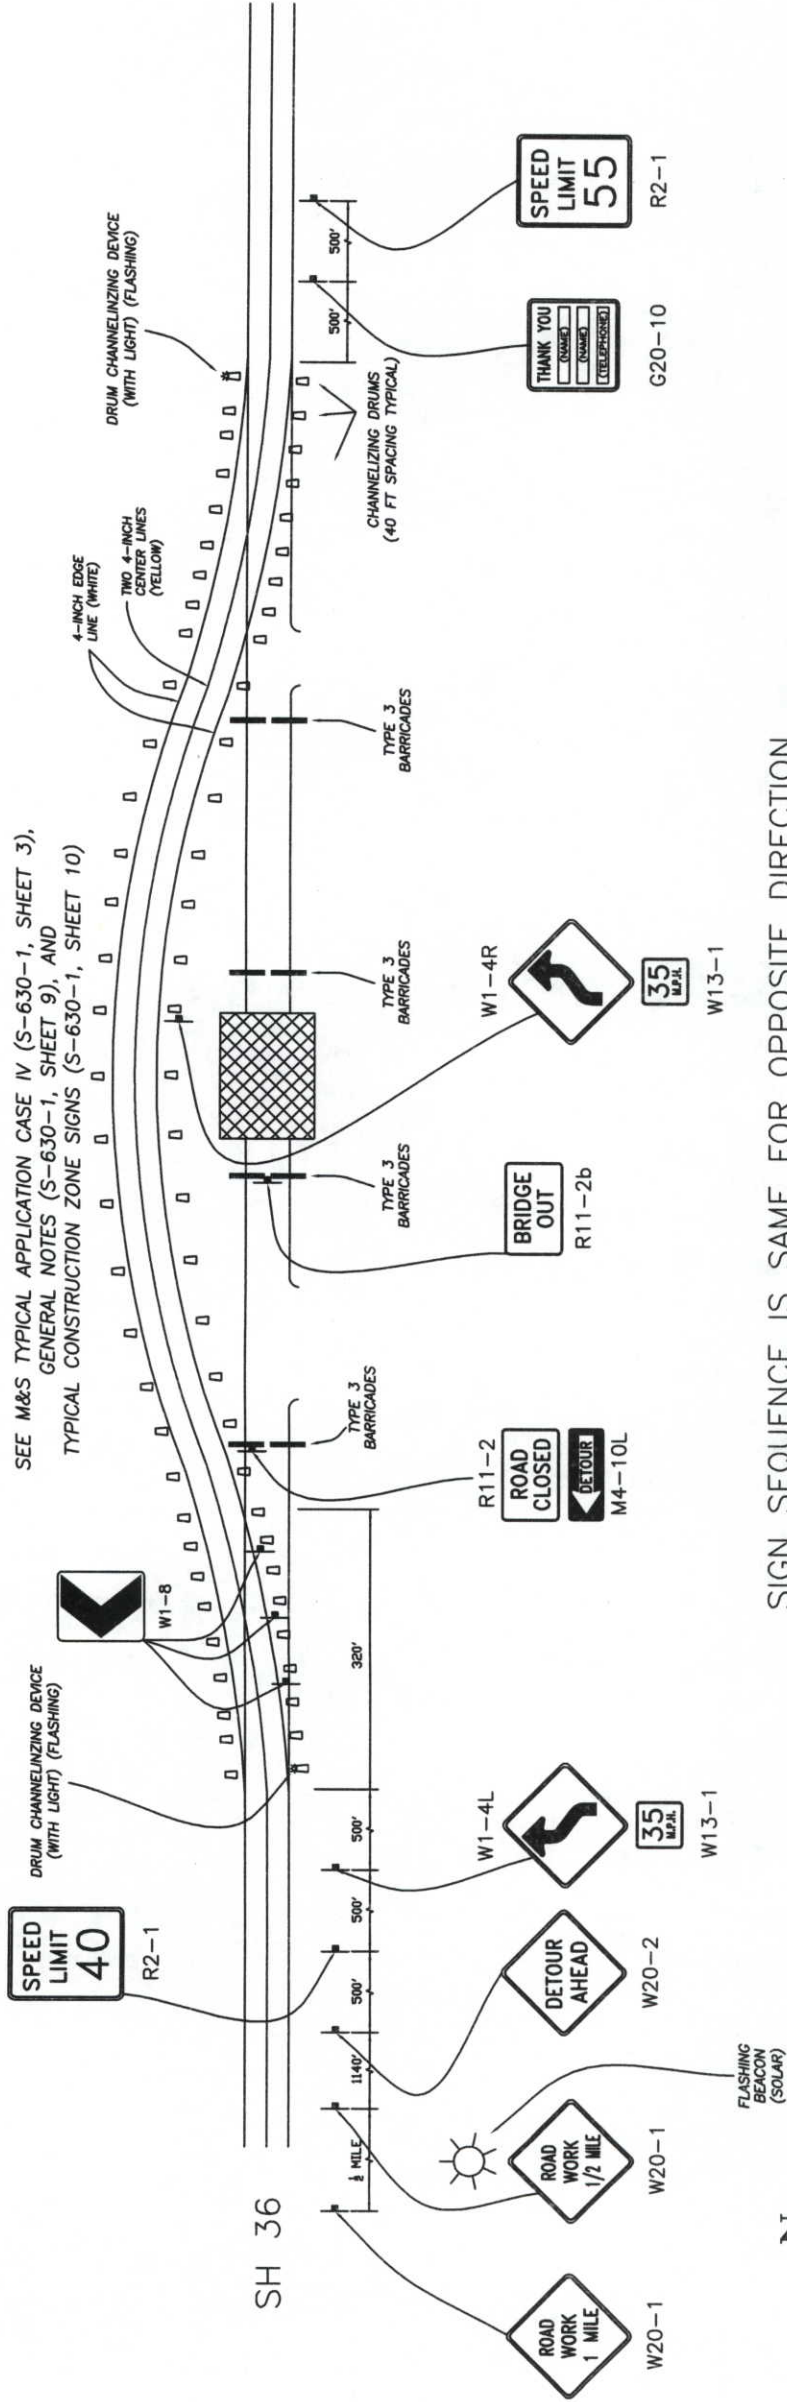

SIGN SEQUENCE IS SAME FOR OPPOSITE DIRECTION

SIGN CODE	LEGEND	SIGN PANEL SIZE	BACK- GROUND COLOR	QUANTITY		
				PANEL SIZE A	PANEL SIZE B	PANEL SIZE C
W20-1	ROAD / WORK / 1 MILE	48x48	ORANGE		2	
W20-1	ROAD / WORK / 1/2 MILE	48x48	ORANGE		2	
W20-1	DETOUR / AHEAD	48x48	ORANGE		2	
R2-1	SPEED / LIMIT / 40	36x48	WHITE		2	
W1-4L	(LEFT REVERSE CURVE)	48x48	ORANGE		2	
W13-1	(ADVISORY SPEED) 35	24x24	ORANGE	4		
W1-8	CHEVRON	18x24	ORANGE	6		
R11-2	ROAD / CLOSED	48x30	ORANGE		2	
M4-10L	DETOUR (IN ARROW) L	48x18	ORANGE	1		
M4-10R	DETOUR (IN ARROW) R	48x18	ORANGE	1		
R11-2b	BRIDGE / OUT	48x30	ORANGE		2	
W1-4R	(RIGHT REVERSE CURVE)	48x48	ORANGE		2	
G20-10	THANK YOU ...	48x48	ORANGE		2	
R2-1	SPEED / LIMIT / 55	36x48	WHITE		2	
W20-7a	FLAGGER AHEAD	48x48	ORANGE		2	
W20-4	ONE LANE / ROAD / AHEAD	48x48	ORANGE		2	
W8-9a	SHOULDER / DROPOFF	30x30	ORANGE	2		
W8-1	BUMP	30x30	ORANGE	2		
SIGN TOTALS				17	24	

OTHER DEVICES		
ITEM CODE	ITEM	AMOUNT
630	Flashing Beacon (Solar)	EACH 2
630	Barricade (Type 3 M-A) (Temporary)	EACH 8
630	Drum Channelizing Device	EACH 82
630	Drum Channelizing Device (With Light) (Flashing)	EACH 2

FOR INFORMATION ONLY

DETOUR STRIPING PAINT QUANTITIES			
LINE TYPE AND COLOR	TOTAL LENGTH (LF)	AREA (SF)	VOLUME OF PAINT (GAL)*
TWO 4-INCH WHITE EDGE LINES	1629	1086	10.86
TWO 4-INCH YELLOW CENTER LINES	1629	1086	10.86

* ASSUMES COVERAGE OF 100 SF/GAL

SIGN CODE	LEGEND	PANEL SIZE (INCHES)	QUANTITY	TOTAL S.F.
SPECIAL	CAUTION/STEEP GRADE/AHEAD	60 x 48	1	20
PROJECT TOTALS				20

Computer File Information		Sheet Revisions		Colorado Department of Transportation		As Constructed		Construction Signing		Project No./Code	
Creation Date:	31/Jul/96 Initials:mcs					No Revisions:	09-13-05				BR 0361-064
Last Modification Date:	27/Jul/04 15:02 Initials:dpt					Revised:					12811
Full Path:	C:\12811 Last Chance\Traffic\Plans\					Designer:					
Drawing File Name:	CONSTRUCTION SIGNING02.dwg					Detailer:					
Acad Ver.:	16.0s (LMS:tech)/A					Sheet Subset:	Traffic	Subset Sheets:	of		Sheet Number 15

STORMWATER MANAGEMENT PLAN – ADDITIONAL INFORMATION

Estimated Runoff coefficient
Pre-construction: 0.65 Post-construction: 0.65
Existing data describing soil or quality of discharge: Lean soil

Existing vegetation: Native upland grasses
Proposed sequence for major activities, location of any other potential pollution source, areas used for storage of building materials, soils or wastes, and location of any dedicated asphalt or concrete batch plants: see water quality and erosion control specifications, and documents submitted by the contractor at the preconstruction conference.
100-year Flood plain boundaries: see bridge hydraulic information sheet (if existent)
Description of the construction activity, and of the area expected to undergo excavation, and name of the receiving water: see CDPS stormwater permit application.
Contract Document location of erosion control and stormwater quality management measures not referenced above nor included on the Stormwater Management Plan Sheet(s):

Site map and construction site boundaries: see title sheet
Areas of cuts and fills and areas of soil disturbance: see plan and profile sheets and roadway cross sections.
Surface waters: see title sheet and bridge hydraulic information sheet (if existent)
Materials handling and spill prevention: see water quality specification (107.25).
Inspection and maintenance: see erosion control specifications (107.25 or 208).

NOTES

The Erosion control supervisor shall be a person other than the Project superintendent
Washing out concrete trucks shall be limited to specific sites pre-approved by the Engineer. Concrete saw water shall not be allowed to enter any waterways, wetlands or inlets. Water shall be collected, contained and disposed of as directed by the Engineer.
Disturbed surfaces shall be left in a roughened condition at all times.
Placement of seed, mulch and mulch tackifier will not be done in a single operation, but shall be completed after each construction phase. It is estimated that 2 or more mobilizations shall be required and shall be included in the price of the work.
If dewatering is required, the contractor will be responsible for obtaining a dewatering or infiltration permit from the Colorado Department of Health.
DETOUR
Upon completion of detour, side slopes shall be stabilized by seeding oats (Avena sativa) onto the slope. Seeding and mulching application shall be per the native seeding plan. Addition of soil preparation will not be required for temporary seeding. It is estimated that 2.5 acres of seeding (temporary) will be required.
It is estimated that 200 LF of silt fence will be required at detour toe of slopes to prevent sediment from entering drainage.
Inspections shall be frequent and repairs/or replacements of erosion control measures shall be made promptly as needed or as directed by the Engineer. All silt fence shall be inspected following each rainfall and silt shall be cleaned out when the silt depth exceeds 50% of the silt fence height.
The cost for silt removal shall be included in the price of the work.
NOXIOUS WEEDS
Contractor's vehicles shall be inspected prior to construction to ensure that they are free of soil and debris capable of transporting noxious weed seeds or roots onto the site.


NATIVE SEEDING

Soil preparation, seeding, mulching and mulch tackifier will be required for an estimated 8.0 acres of disturbed area within the right-of-way limits which are not surfaced. The following types and rates shall be used:

COMMON NAME	BOTANICAL NAME	LBS PLS./ACRE
Western wheatgrass	Pascopyrum smithii "Arriba"	8.0
Buffalograss	Buchloe dactyloides "Texoka"	5.0
Blue grama	Bouteloua gracilis "Hachita"	1.5
Sideoats grama	Bouteloua curtipendula "Vaughn"	1.0
Green needlegrass	Nassella viridula "Lodorm"	3.0
Sand dropseed	Sporobolus cryptandrus	0.1
Little bluestem	Schizachyrium scoparium "Pastura"	1.0
Narrowleaf penstemon	Penstemon angustifolius	0.2
Purple prairie clover	Dalea purpureum var. purpureum	1.0
Gaillardia	Gaillardia aristata	1.0
Blue flax	Linum lewisii	0.5
Dotted gayfeather	Liatrus punctata	0.3
Oats	Avena sativa	3.0
TOTAL		25.6

SEEDING APPLICATION: Drill seed .25" to .5" into the topsoil where possible. In areas not accessible to a drill hand broadcast at triple the above rate and rake .25" to .5" into the topsoil.

MULCHING APPLICATION: 1.5 tons of certified weed free hay per acre mechanically crimped into the topsoil in combination with an organic mulch tackifier per special provision 213. Due to high failure rates, hydromulching and hydroseeding will not be allowed. Fertilizer will not be used on the project site.

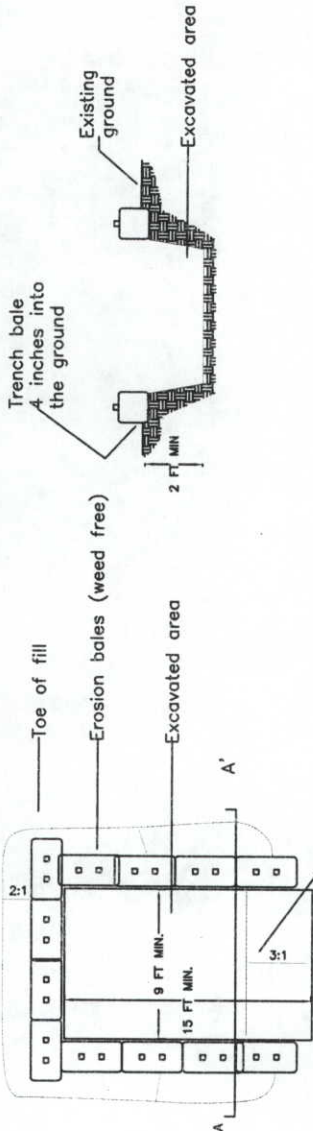

PLAN VIEW
CONCRETE WASHOUT STRUCTURE
CROSS-SECTION A-A'

PAY ITEM	DESCRIPTION	UNIT	QUANTITY ROADWAY	DETOUR*
208	CONCRETE WASHOUT STRUCTURE	EACH	1	
208	EROSION CONTROL SUPERVISOR	EACH	1	
208	SILT FENCE	LF	200	235
212	SEEDING (NATIVE)	ACRE	4.0	3.6
212	SEEDING (TEMPORARY)	ACRE	0	4.0
213	MULCHING (WEED FREE HAY)	ACRE	4.0	3.6
213	MULCH TACKIFIER	LB	800	720
700	EROSION CONTROL	FA	1	0.485

*Items included in the cost of the detour.

Computer File Information		Sheet Revisions		Colorado Department of Transportation		Stormwater Management Plan		Project No./Code	
Creation Date: July 04	Initials: CVC	(R-1)		 1420 2nd Street Greeley, CO 80631 Phone: 970-350-2135 FAX: 970-339-9530		No Revisions: 09-12-05		BR 0361-064	
Last Modification Date:	Initials:	(R-2)							
Full Path: Region 4\Washington		(R-3)							
Drawing File Name: 12811slstchance		(R-4)							
Acad Ver.: 2004	Scale: English	(R-5)		Region 4		Revised: 09-13-05		12811	
				DWP		Void:		Sheet Number	
						Sheet Subset:		16	
						Subset Sheets:		of	

TO ESTABLISH GEOMETRIC CONTROL FOR THE CONSTRUCTION OF THIS PROJECT, THE DEPARTMENT HAS PROVIDED THE FOLLOWING INFORMATION:

Format*		Computer files
Horizontal Control	■	11
Vertical Control	■	11
Roadway Alignment	■	11
Original Terrain Data	■	11
Other:	□	

*Specify the information format, ie., plan sheet, computer disk, computer printout, or other.

The information marked is either contained on the plans or is available from the Engineer.

TYPE OF PROJECT

Landscaping	☐
Signalization	☐
Safety Improvement	☐
Asphalt Overlay	☐
Concrete Overlay	☐
Minor Widening	☐
Major Reconstruction	☐
New Roadway Construction	☒
Bridge Replacement	☐
Bridge Widening	☐
New Bridge	☐
Other:	☐

SURVEY WORK TO BE PERFORMED BY OTHERS:

WORK PERFORMED BY THE CONTRACTOR'S SURVEYOR UNDER ITEM 625:

☒	Establish and Maintain Project Centerline or Engineer Approved Offset Line(s)
☒	Verification and Maintenance of Horizontal and Vertical Control
☒	Verify or Determine existing grades and alignments
☐	Verify or Determine existing topography
☒	Clearing and Grubbing Limits
☒	Removal Limits
☐	Reset Items

SLOPE STAKING	GRID (Y/N)	GRADE STAKES	SPECIAL INTERVAL
		X	
Excavation			
Embankment			

As Staked Earthwork Quantities	☐	(See General Notes)
Landscaping	☐	
Top Soil	☐	
Seeding	☐	
Mulching	☐	
Planting	☐	
Herbicide	☐	
Other:	☐	
Erosion Control	☐	
Seeding (Temp)	☐	
Silt Fences	☐	
Straw Bales	☐	
Temporary Berm	☐	
Riprap (Temp)	☐	
Other (Temp)	☐	

Roadway Bases	
☐	Untreated Subgrade
☐	Treated Subgrade
☐	Aggregate Base Course
☐	Reconditioning
☐	PMBB – Plant Mix Bituminous Base
☐	Other: _____
Pavements	
☐	HGB – Hot Bituminous Pavement
☐	Concrete
☐	Overlay
☐	Heating & Scarifying Treatment
☐	Prime Coat, Tack Coat & Rejuvenating
☐	Seal Coat or Chip Seal
☐	Other: _____

☐	☐	Roadway Elements
☐	☐	Curb and Gutter
☐	☐	Drop inlets – alignment and grades
☐	☐	Retaining Walls
☐	☐	Guard Rail
☐	☐	Sidewalk
☐	☐	Other: _____
☐	☐	Riprap (Perm)
☐	☐	Slope and Ditch Paving
☐	☐	Minor Structures
☐	☐	Structure
☐	☐	Culverts
☐	☐	Culverts w/ Headwalls and Wingwalls
☐	☐	Concrete Box Culverts w/ Headwalls
☐	☐	Pipes
☐	☐	Sanitary Sewer
☐	☐	Storm Sewer
☐	☐	Water
☐	☐	Irrigation
☐	☐	Miscellaneous

☐	☐	☐	☐	☐	Major Structures	Overhead Signs, Concrete Box Culverts, Bridges — and all other structures assigned a structure number
☐	☐	☐	☐	☐	Other:	
☒	☐	☐	☐	☐	Structure	Excavation limits
☒	☐	☐	☐	☐	Concrete Box Culverts w/	Headwalls and Wingwalls
☐	☐	☐	☐	☐	Piling	locations and cut off elevations
☐	☐	☐	☐	☐	Caisson	locations and elevations
☐	☐	☐	☐	☐	Footing	locations, alignment, and elevations
☐	☐	☐	☐	☐	Abutment/Pier	locations, alignment, and elevations
☒	☐	☐	☐	☐	Wingwall	skew angles/offsets
☐	☐	☐	☐	☐	Structural concrete	form locations
☐	☐	☐	☐	☐	Substructure As-constructed	survey (Required by Subsection 601.12 for Bridges and S-614-50 for Overhead signs)
☐	☐	☐	☐	☐	Bridge expansion joint(s)	alignment and grade
☐	☐	☐	☐	☐	(longitudinal and transverse)	
☐	☐	☐	☐	☐	Deck grades at Girder	10th or "n" th point locations and elevations
☐	☐	☐	☐	☐	Slope and Ditch	Paving
☐	☐	☐	☐	☐	Other:	

—		Fencing	—		Temporary
—		Permanent	—		Sound Barriers
—		Other:	—		Delimiters
—		Temporary	—		Temporary
—		Permanent	—		
—		Lighting and Traffic Control Devices	—		Signal pole locations
—		Light pole locations	—		Signs
—		Field verify sign post before fabrication.	—		Other:
—		Other:	—		

Roadway Bases			
GRID (Y/N)	SPECIAL INTERVAL	SPECIAL OFFSET	GRADE (Y/N)
			Y
			Y

Pavements				

Curb & Gutter	Tangent Interval	Curve Interval	Special Offset

☐	Pavement		Marking	(Temp)	
☒	Striping	☒	Striping	(Perm)	
☐	Striping	☐	Symbols		
☐	Other:	☐			
☐	Temporary Lighting and Construction Traffic Control Devices				
☐	Signal pole locations and elevations	☐	Light pole locations and elevations	(Temp)	
☐	Signs	☐	Signs	(Temp)	
☐	Other:	☐			
☒	Easement	☐	(Temp/Staking)	(P.L.S. Only)	
☐	Right of Way	☐	(Temp)	(Staking)	(P.L.S. Only)

WORK PERFORMED BY THE CONTRACTOR'S SURVEYOR UNDER ITEM 629:

☐	Monumentation
—	Control
—	Right of Way
—	Land corners, Aliquot corners
—	Easement (Perm)
—	Reference the specified existing
—	Relocate the specified existing
—	Locate monuments. It is est

****** A Tabulation of Survey Monuments may be provided on the plans.

GENERAL NOTES:

Unless indicated otherwise on this Survey Tabulation Sheet, all survey work and staking intervals shall be done in accordance with the latest edition of the entire CDOT Survey Manual.

Adequate information for establishing lines, grades, and locations for all work items have been specified on the plans. Any additional information required to stake the item or element shall be generated by the Contractor's surveyor.

The Contractor's surveyor shall provide an estimate of the man-hours necessary to complete the work items indicated on this sheet. A copy of this sheet, with the estimated man-hours written on the blank line to the left of the specified items, shall be submitted with the Survey Schedule to the Engineer 3 days prior to Presurvey Conference Construction Survey.

Stakes and Monuments which are damaged or destroyed by the progress of construction shall be replaced by the Contractor at no additional cost to the Department.

The Contractor shall furnish an As Staked earthwork quantity to the Engineer prior to completion of twenty percent (20%) of the planned earthwork in any phase as per the CDOT Survey Manual. A printed copy of the As Staked earthwork data and a computer disk in the specified format shall be submitted to the Engineer. The Contractor shall field verify original ground cross sections at a maximum 500 feet intervals.

Prior to beginning work on any subsequent operation, such as placing base course or paving, the Contractor shall certify in writing to the Engineer that the final grade is within specified tolerance.

The Contractor's surveyor shall perform all field surveying and calculations necessary to tie plan grades into field grades.

The Contractor shall coordinate construction staking on the project with any utility work.


The Contractor's surveyor shall submit the following fieldbooks to the Engineer:

☒ Horizontal Control (Primary & Secondary)
☒ Vertical Control (i.e. Benchmarks)
☐ Property Pin Ties
☒ Horizontal Alignment
☒ Grading
☒ Slope Staking
☐ Minor Structures
☒ Major Structures
☒ One fieldbook for each work category shown on this sheet
☐ Other Fieldbook(s): _____

Computer File Information		Sheet Revisions				As Constructed		Roadway Cross Sections		Project No./Code	
Creation Date:	31/Jul/96			(R-1)			No Revisions:	09-13-05		BR 0365--064	
Last Modification Date:	13/Aug/04 13:45			(R-2)			Revised:			12811	
Full Path:	C:\12811 Last Chance\Roadway\Plans\			(R-3)			Designer:	mcs			
Drawing File Name:	17Survtab.dwg			(R-4)			Detailer:	mcs			
Acad Ver:	16.0s (LMScriptN/A			(R-5)			Sheet Subst:	Design	Subset Sheets:	of	
	Units: English						Void:			Sheet Number 17	

DEPARTMENT OF TRANSPORTATION
STATE OF COLORADO

T. 3 S, R. 56 W. 6th P.M.
SW 1/4 SEC. 33

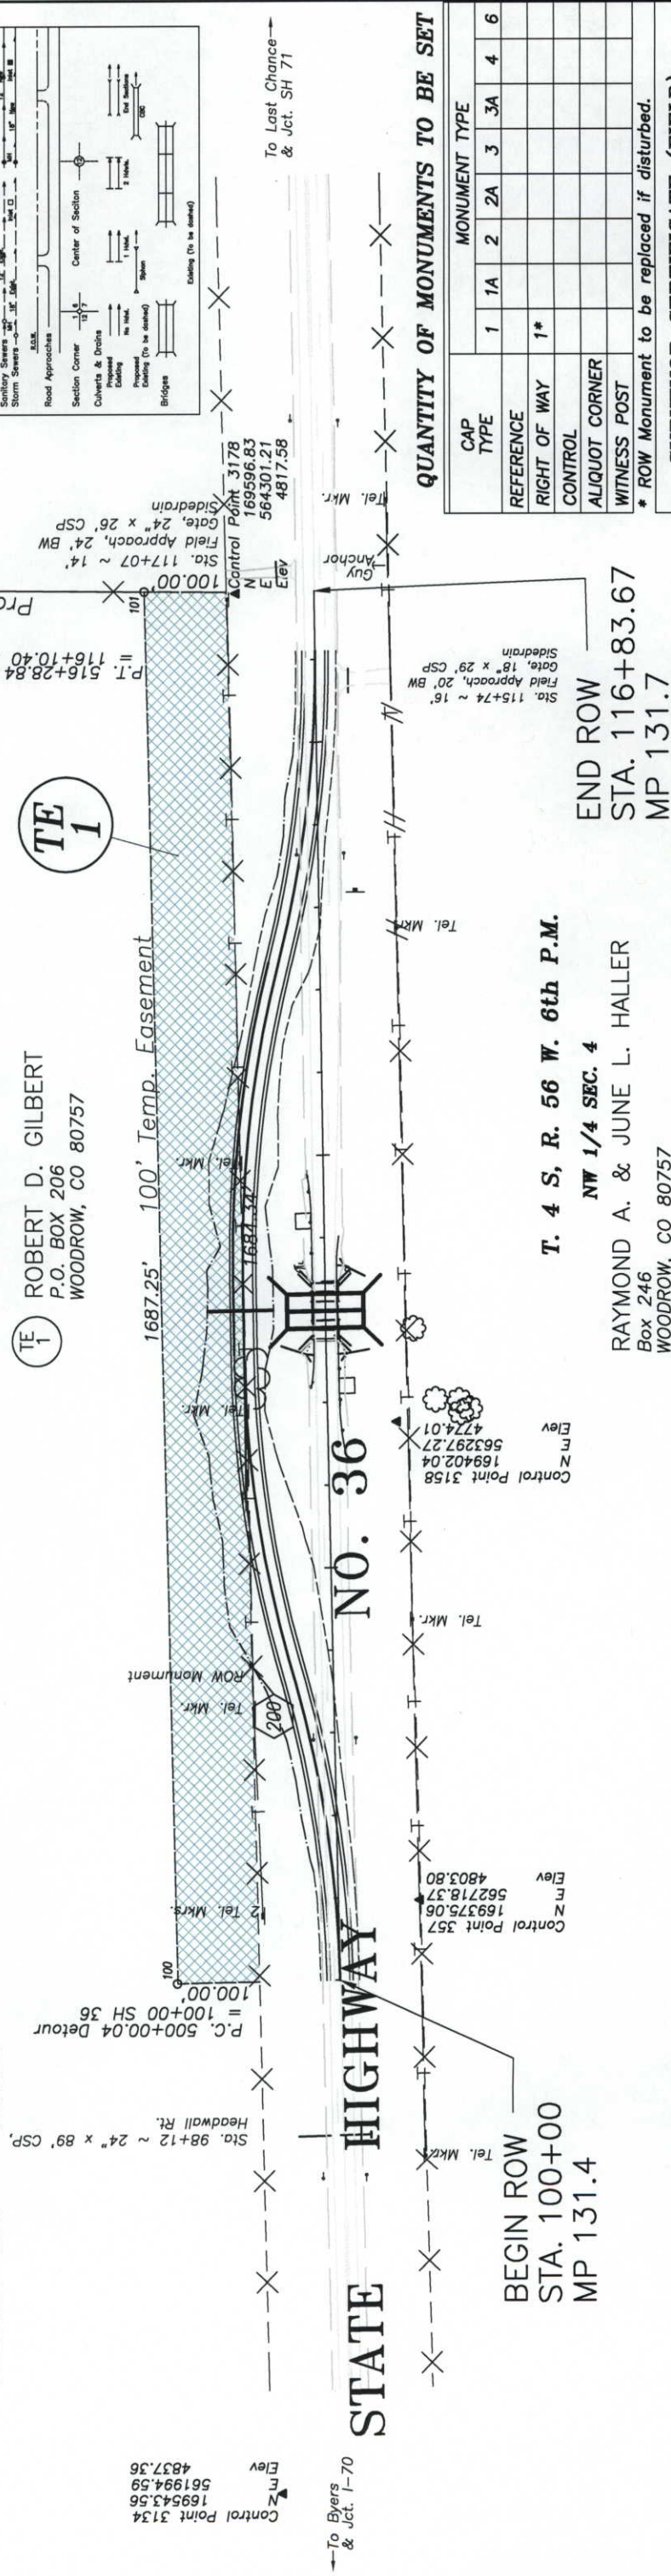

**TABULATION OF EASEMENT POINTS
FOR INFORMATION PURPOSES ONLY**

POINT NO.	NORTHING	EASTING
100	169670.4162	562616.7120
101	169707.8642	564303.5473
200*	169579.550	563001.9400

R.O.W. TABULATION OF PROPERTIES IN WASHINGTON COUNTY						S.H. 36	
PARCEL NO.	OWNER	ADDRESS	LOCATION	PARCEL AREA	REMARKS	RECORDING INFORMATION	
TE-1	ROBERT D. GILBERT	P.O. BOX 206 WOODROW, CO 80757	W 1/2 SW 1/4 SEC. 33 T. 3 S., R. 56 W.	168544 SF (3.87 ACRES)	FOR DETOUR		

QUANTITY OF MONUMENTS TO BE SET								
CAP TYPE	MONUMENT TYPE							
	1	1A	2	2A	3	3A	4	6
REFERENCE								
RIGHT OF WAY	1*							
CONTROL								
ALIQUOT CORNER								
WITNESS POST								

SURVEYOR CERTIFICATE (FIELD)

Control Survey and Monumentation was done under my supervision and checking.

NAME _____ P.L.S. NO. _____
DATE _____

SURVEYOR CERTIFICATE (OFFICE)

R.O.W. Plans and Legal Descriptions were prepared under my supervision and checking.

NAME _____ P.L.S. NO. _____
DATE _____