



PLAN	DATE
NOTED BY	
NOTED BY	

PROFILE	DATE
NOTED BY	
NOTED BY	

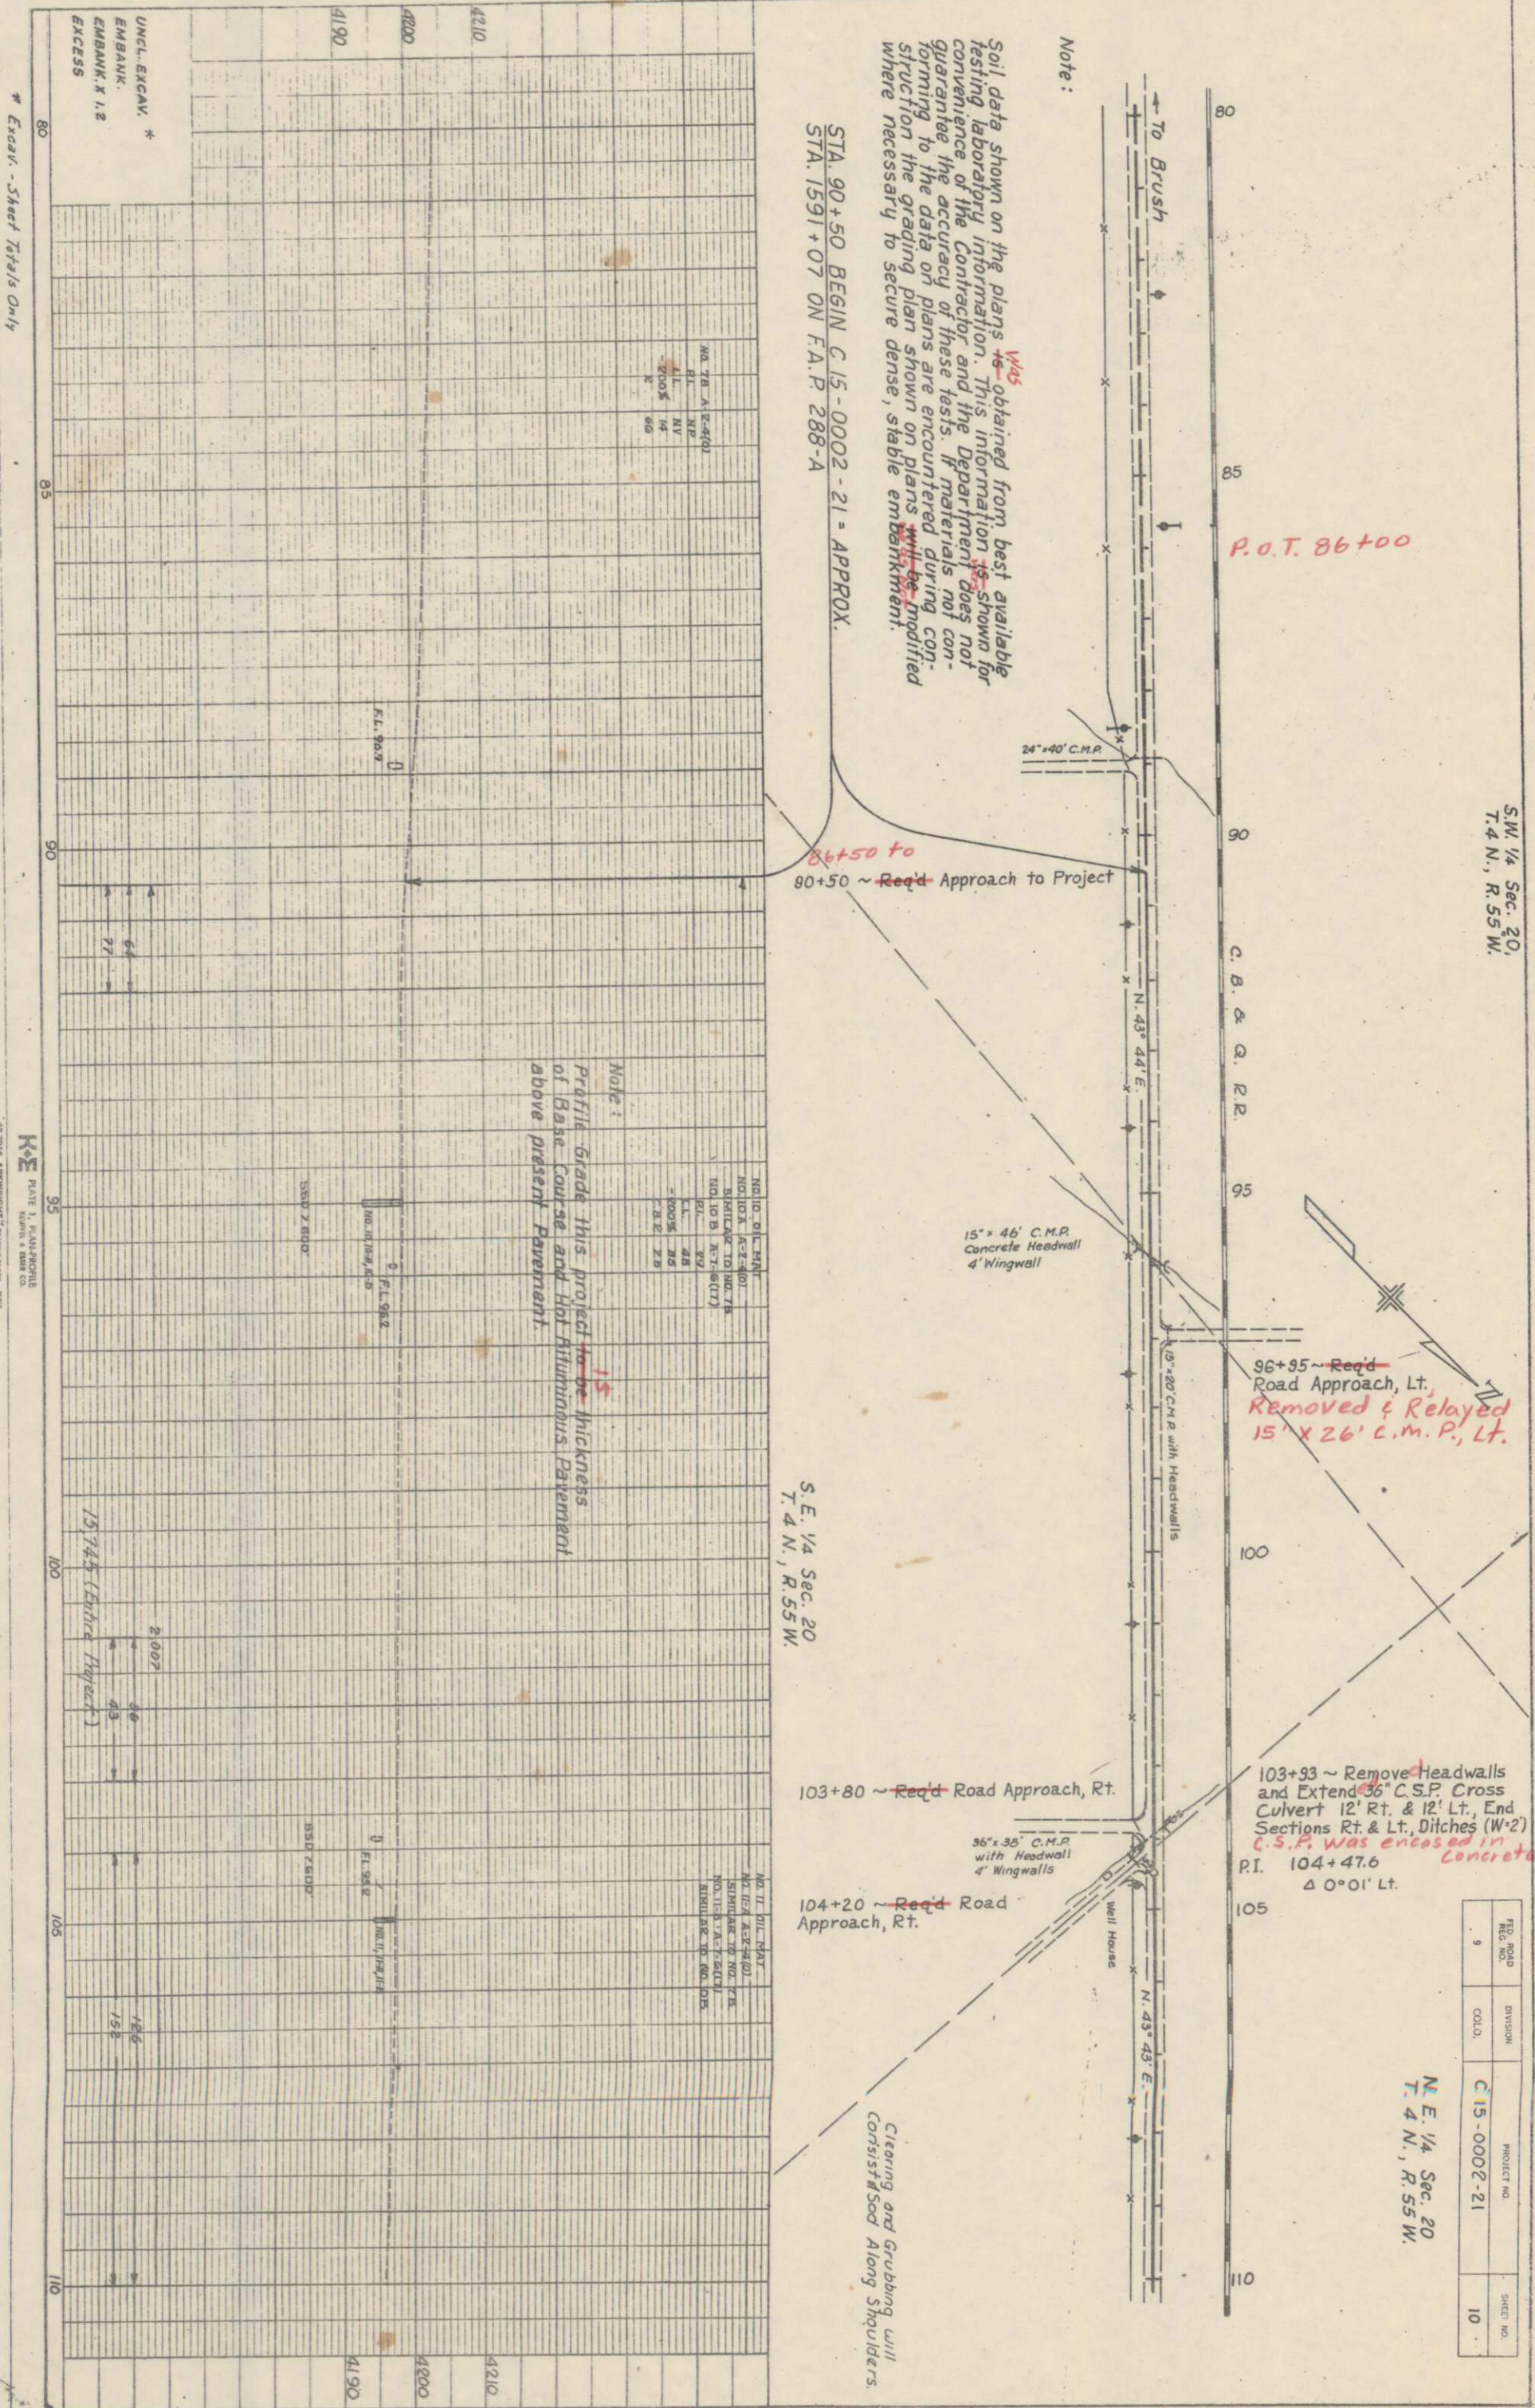

PLAN	SURVEYED	BY	DATE
NOTE BOOK	PLOTTED		
NO. 364	ALIGNED & CHECKED		
	RT. OF WAY CHECKED		

PROFILE	SURVEYED	BY	DATE
NOTE BOOK	PLOTTED		
NO. 2866	CHECKED		
	STRUCTURE NOTATION CHECKED		

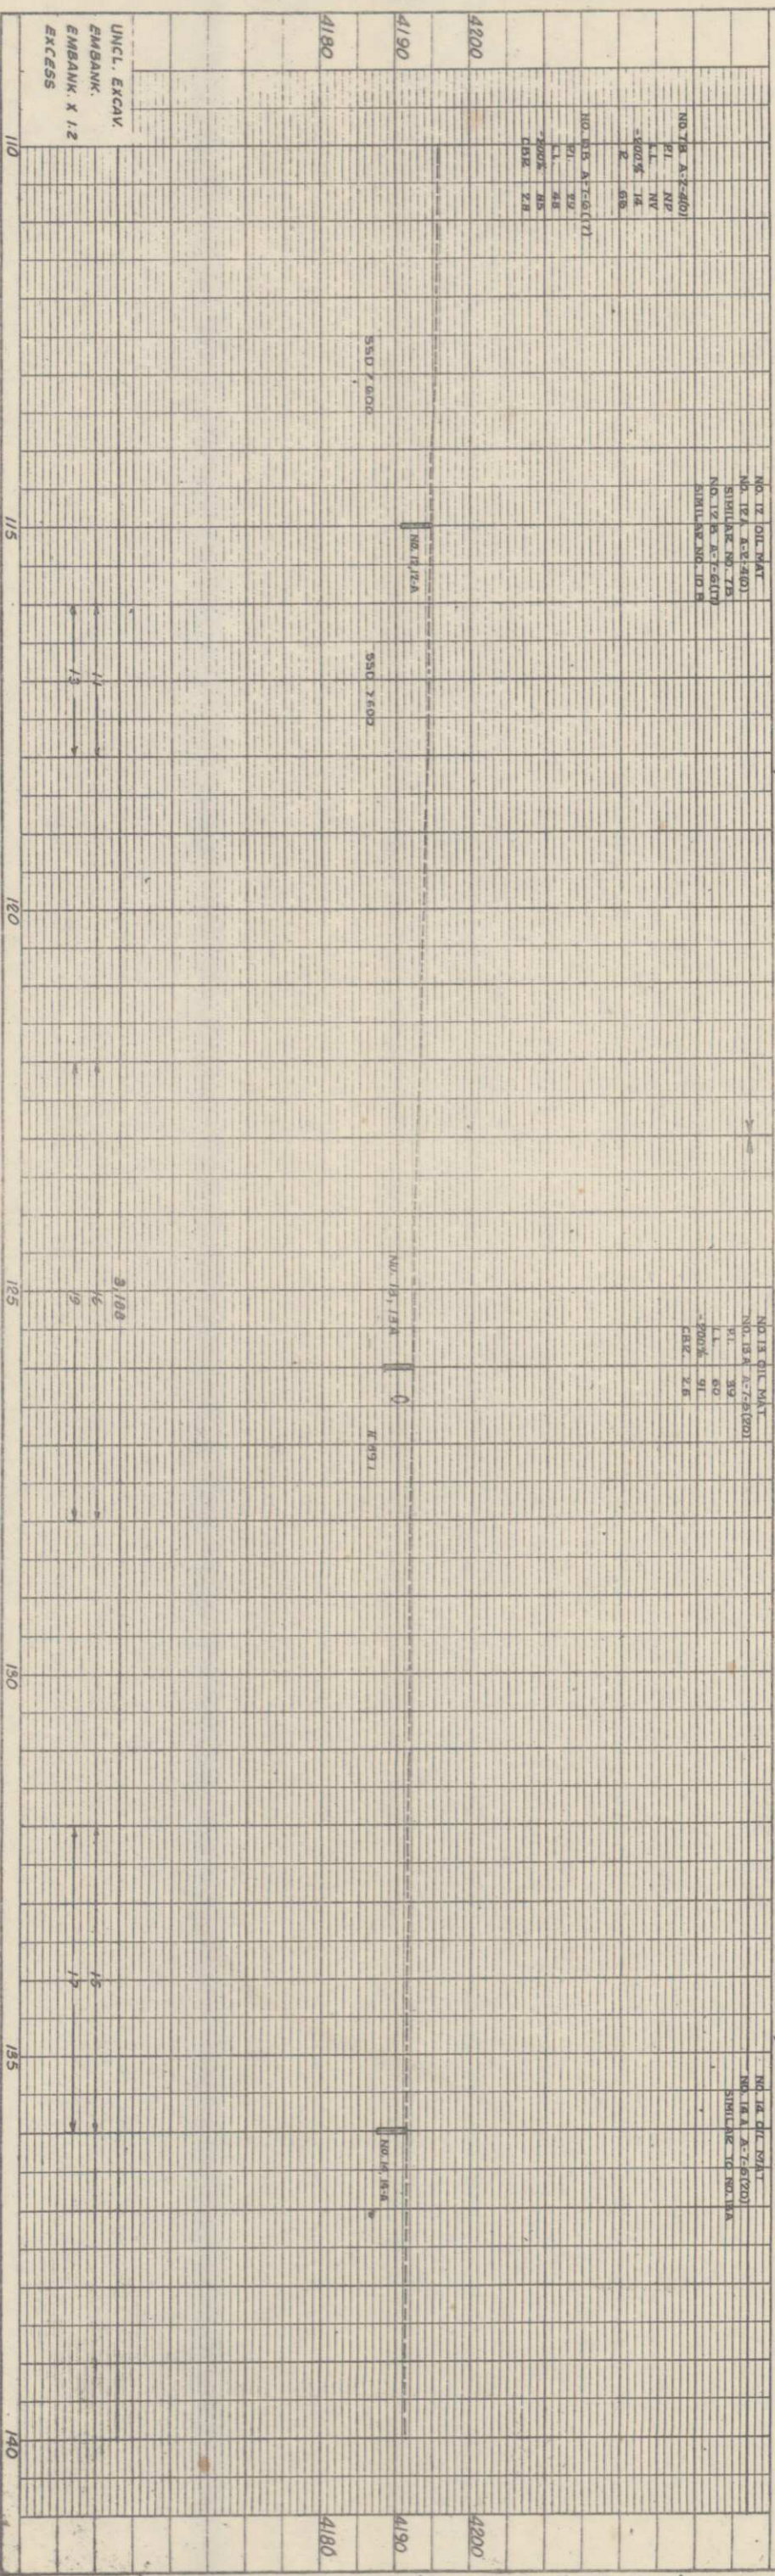


120+00 ~~Req'd~~ Road Approach, Rt. & Lt.

N.E. 1/4 Sec. 20, T. 4 N., R. 55 W.

128+15 ~~Req'd~~ Road Approach, Rt.

N.W. 1/4 Sec. 21, T. 4 N., R. 55 W.

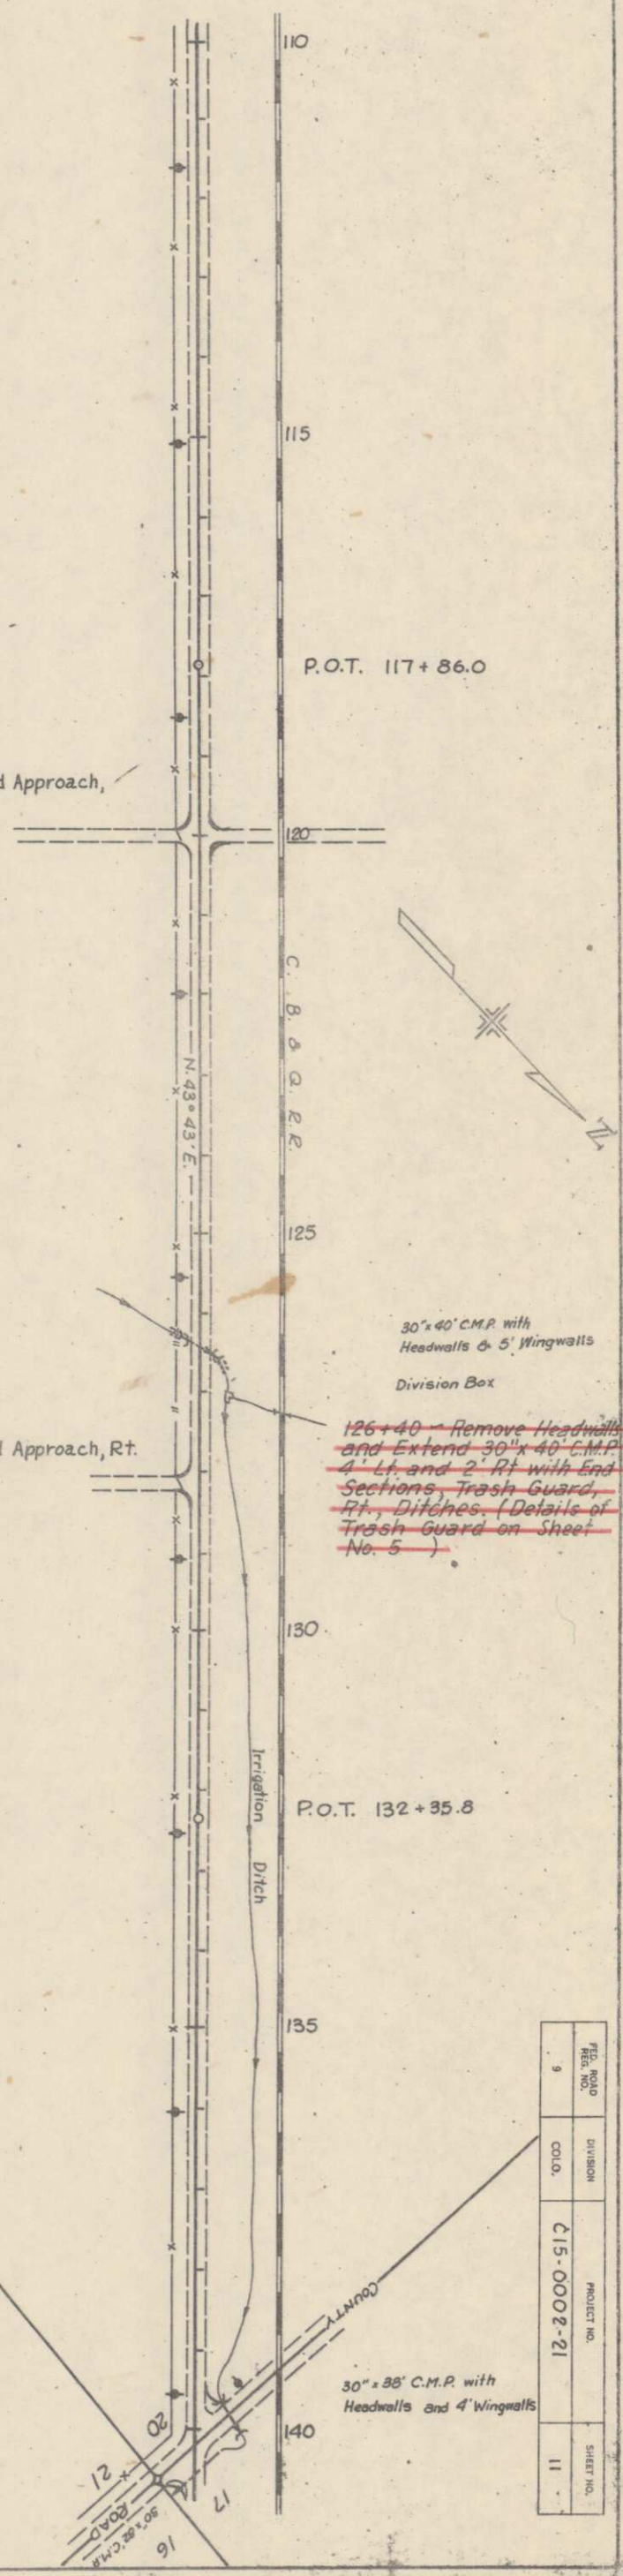

FILE NO.	DIVISION	PROJECT NO.	SHEET NO.
9	COLO.	C15-0002-21	11