




PL. TR. DIST. 3 DENVER COLO. 1933 W.E.W. 2-19-33

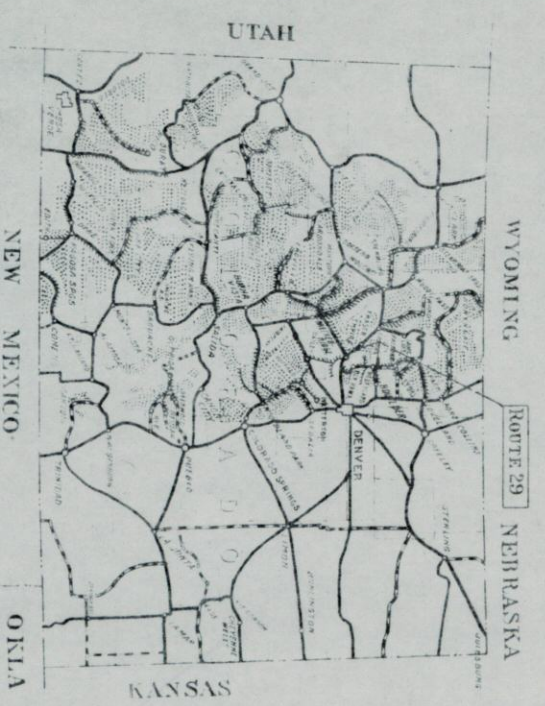

FEDERAL WORKS AGENCY
PUBLIC ROADS ADMINISTRATION

AS CONSTRUCTED
PROJECT 29-1
ROUTE 29 BOULDER-IDAHO SPRINGS
BOULDER VIA NEDERLAND & BLACKHAWK TO IDAHO SPRINGS
4.8 MILES CLASS 1
COLORADO FOREST HIGHWAY SYSTEM

ROOSEVELT & ARAPAHO NATIONAL FORESTS
BOULDER, GILPIN & CLEAR CREEK COUNTIES
COLORADO

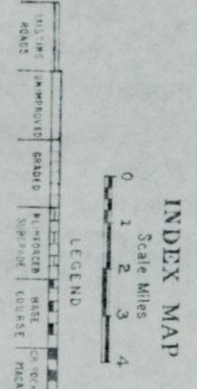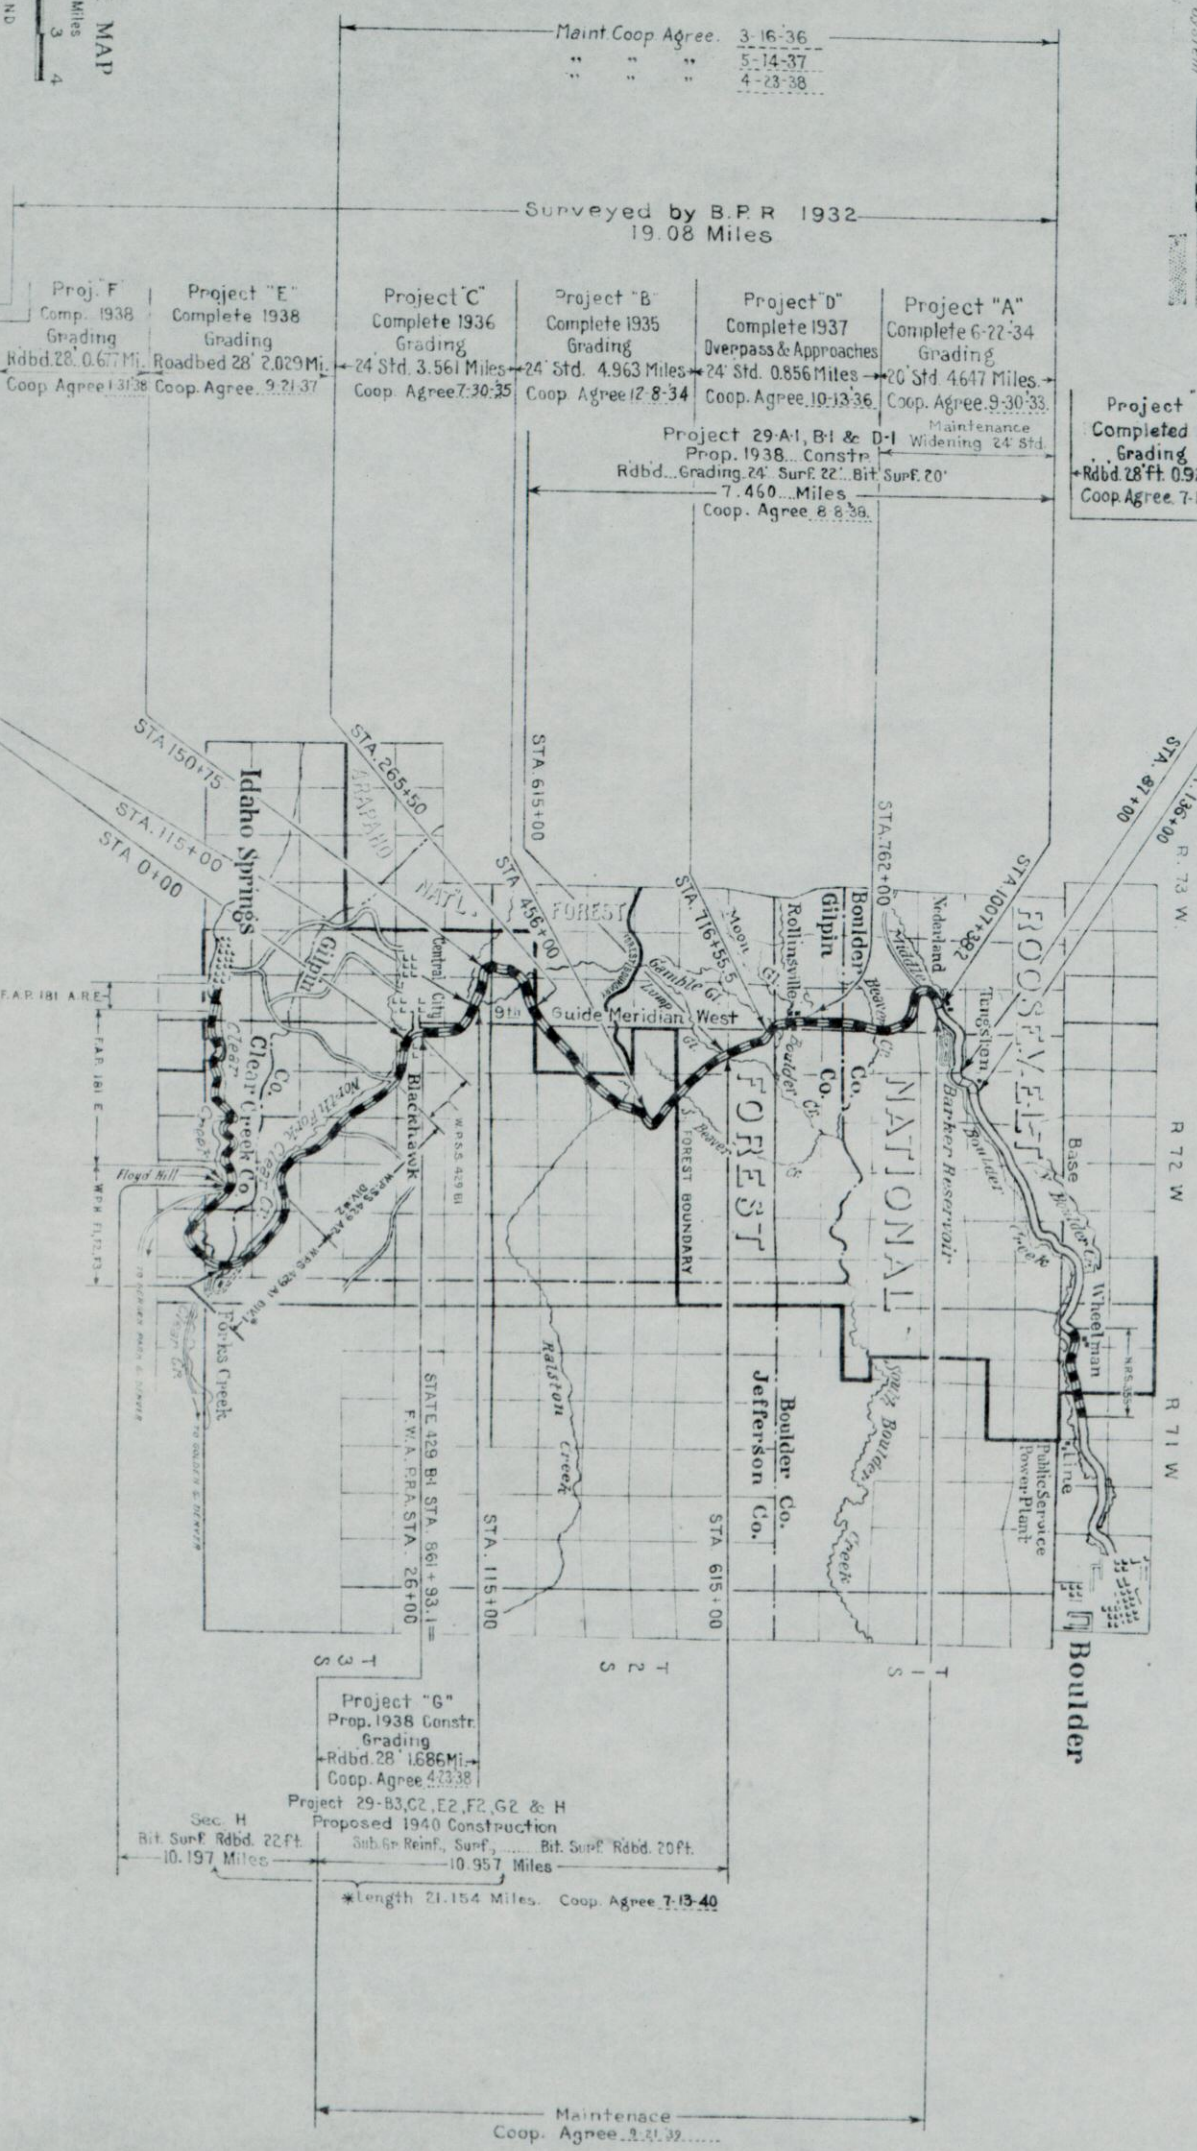

INDEX TO SHEETS

SHEET NO.	DESCRIPTION	STATIONING
1	Title Sheet	
2	Typical Sections	
3	Summary	
4	Plan & Profile	87+00 to 126+00
5	Plan & Profile	87+00 to 126+00
APPROVED: _____ DATE: _____
 DISTRICT ENGINEER
 FEDERAL WORKS AGENCY
 PUBLIC ROADS ADMINISTRATION
 DISTRICT 3 DENVER COLORADO

APPROVED: _____ DATE: _____
 REGIONAL FORESTER

APPROVED: _____ DATE: _____
 STATE HIGHWAY ENGINEER


APPROVED: _____ DATE: _____
 STATE OR GOVERNOR

*Length includes tunnels, bridges and structures.

PROFILE	SURVEYED	7.31	1934
	PLOTTED	J.F.H.	
	NOTES CHECKED		
	R.M. NOTED		
	STRUCTURE NOTED		
	Drawn & Traced	C.W.P.	4-36

PLAN	SURVEYED	7.31	1934
	PLOTTED	J.F.H.	
	NOTES CHECKED		
	R.M. NOTED		
	STRUCTURE NOTED		
	Drawn & Traced	C.W.P.	3-36

Boulder-Idaho Springs Colo 29
Sta 60 to Sta 90
Sheet No 6

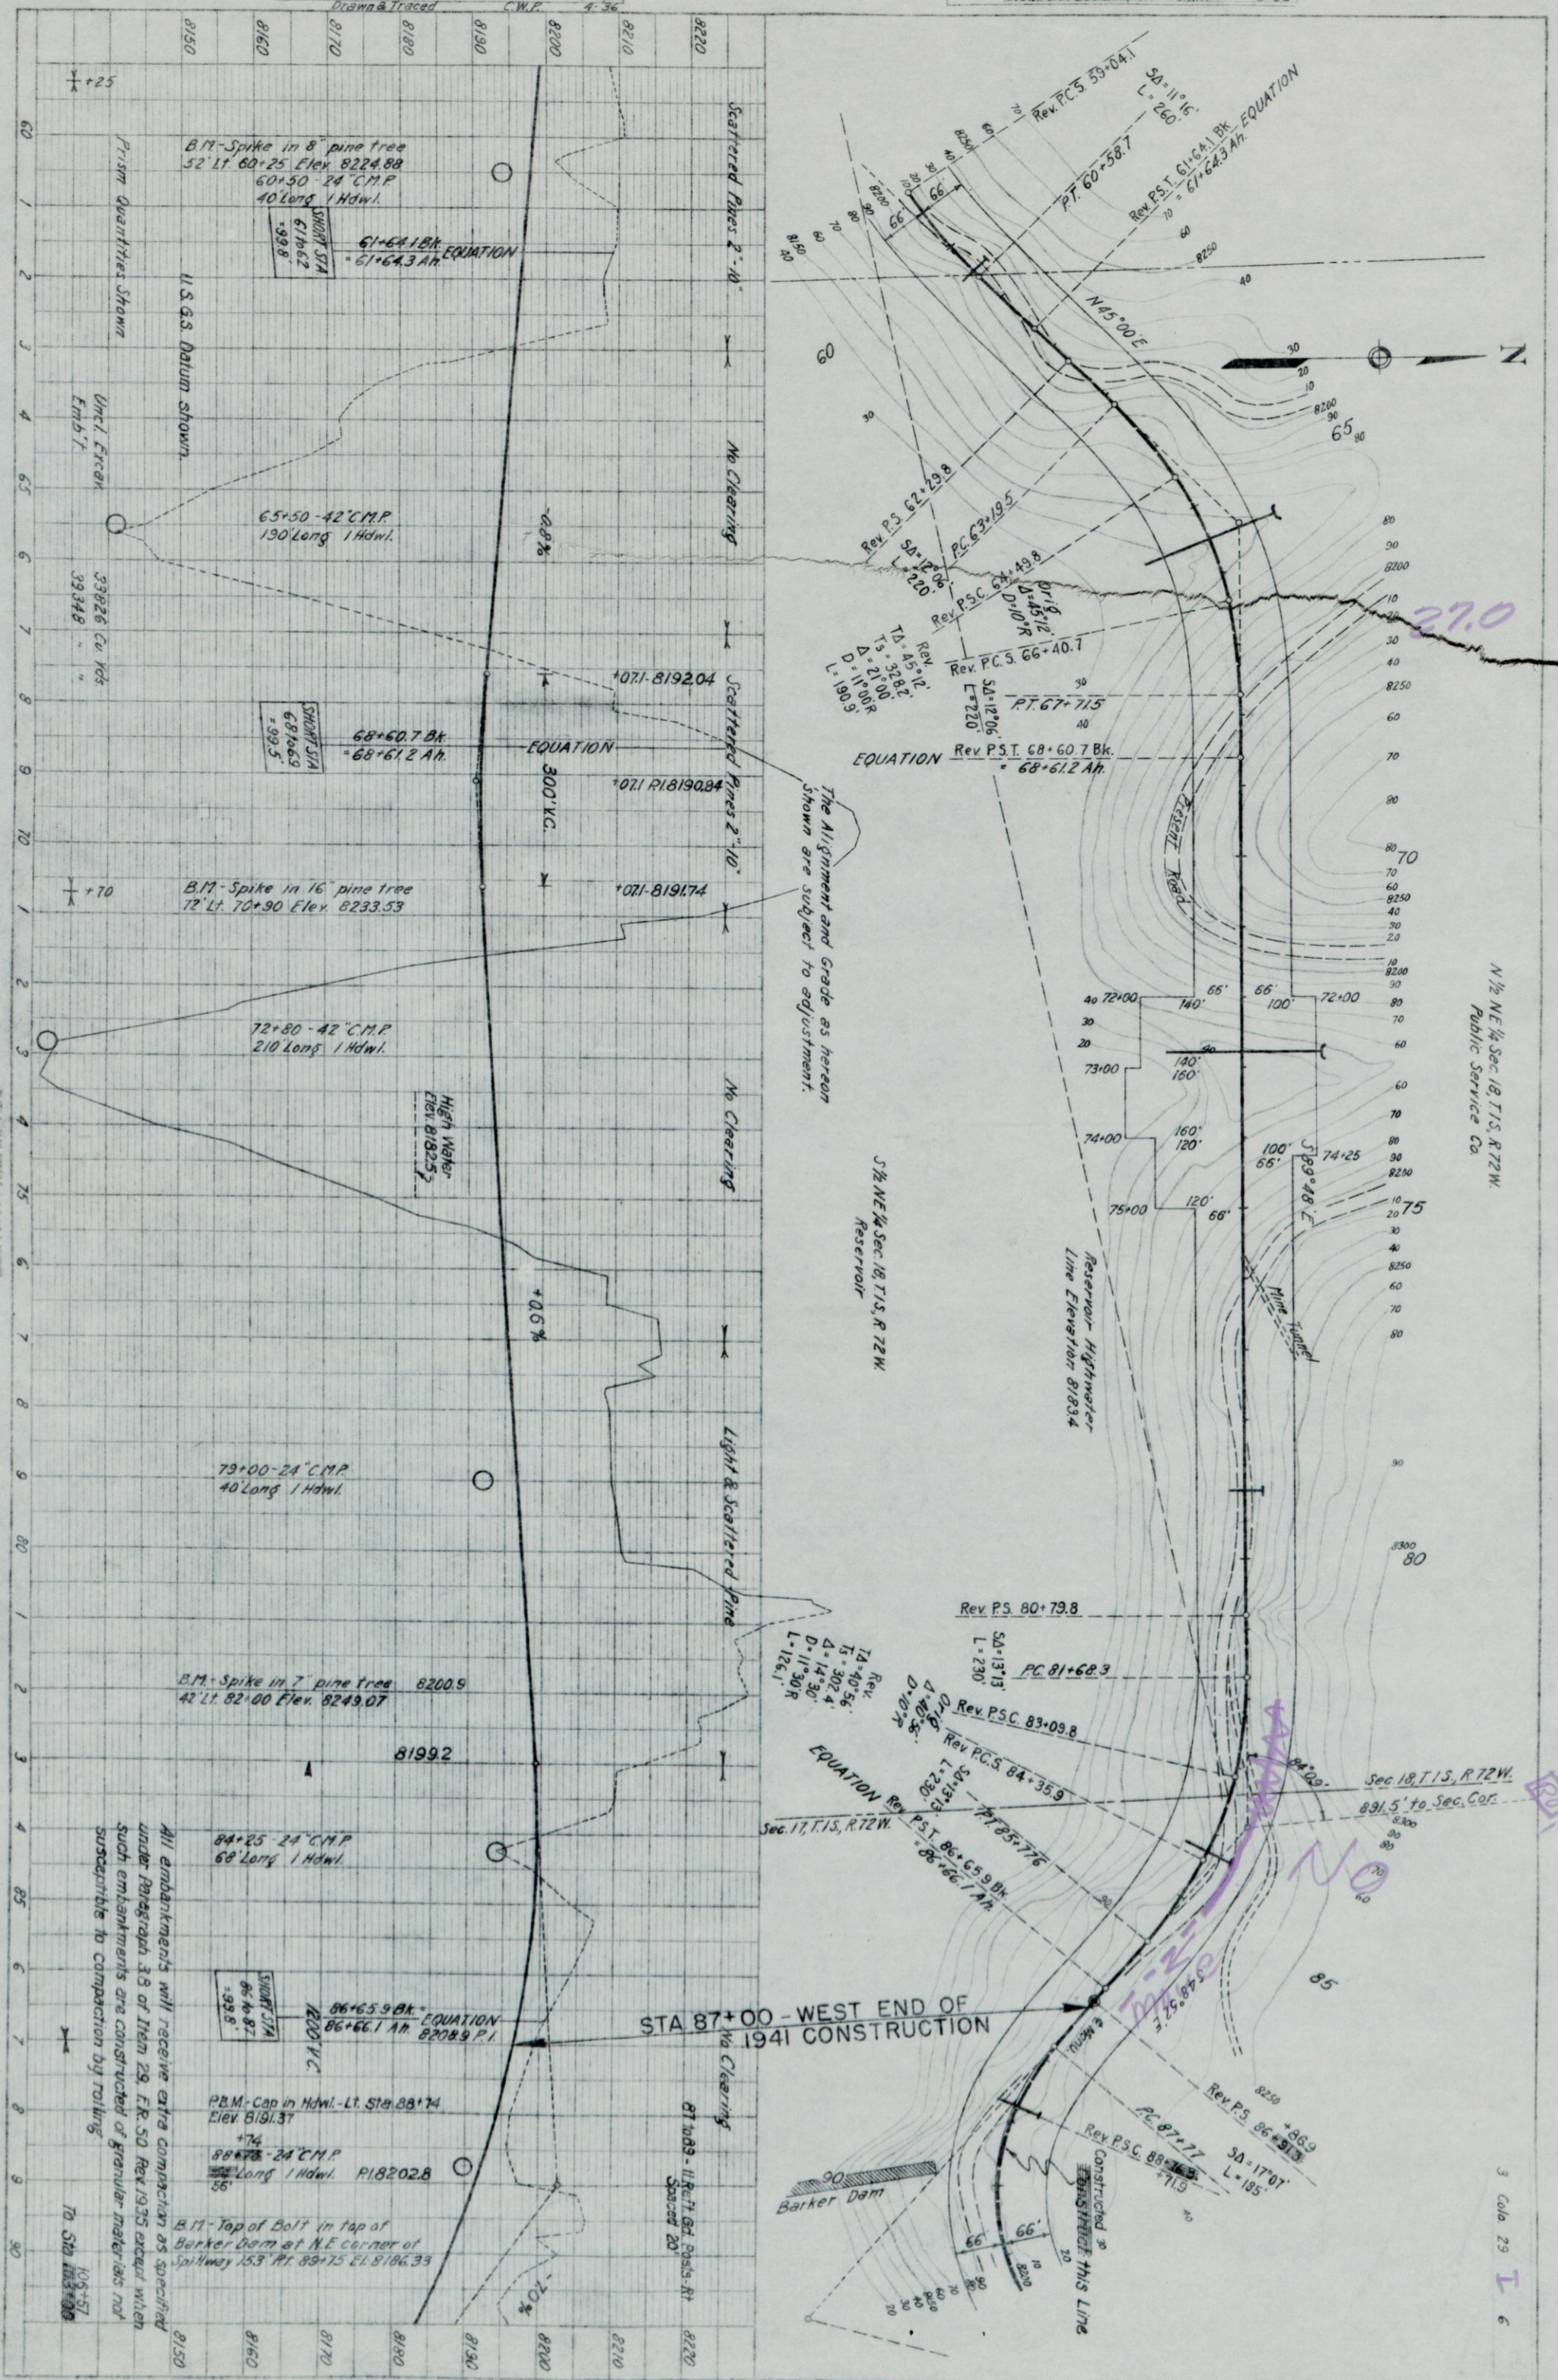

N 1/2 Sec 18, T1S, R72W
Public Service Co

3 Colo 29 L 6

AS CONSTRUCTED BOULDER-IDAHO SPRINGS


All embankments will receive extra compaction as specified under Paragraph 3.8 of Item 29 F.R. 50 Rev. 1935 except when such embankments are constructed of granular materials not susceptible to compaction by rolling.

STA 87+00 - WEST END OF 1941 CONSTRUCTION

PROJ. NO.	1124	1934
DATE	J.F.M.	
DESIGNED BY	C.W.P.	A.R.
DRAWN & TRACED	C.W.P.	A.R.

PLAN	PLAN	M.B.K.	1934
WRITE BOOK	ALIGNED CHECKED	J.F.M.	
DATE	DATE		
DRAWN & TRACED	C.W.P.	3-36	

Boulder-Idaho Springs Colo. 29
Sta 90 to Sta 120
Sheet No. 7

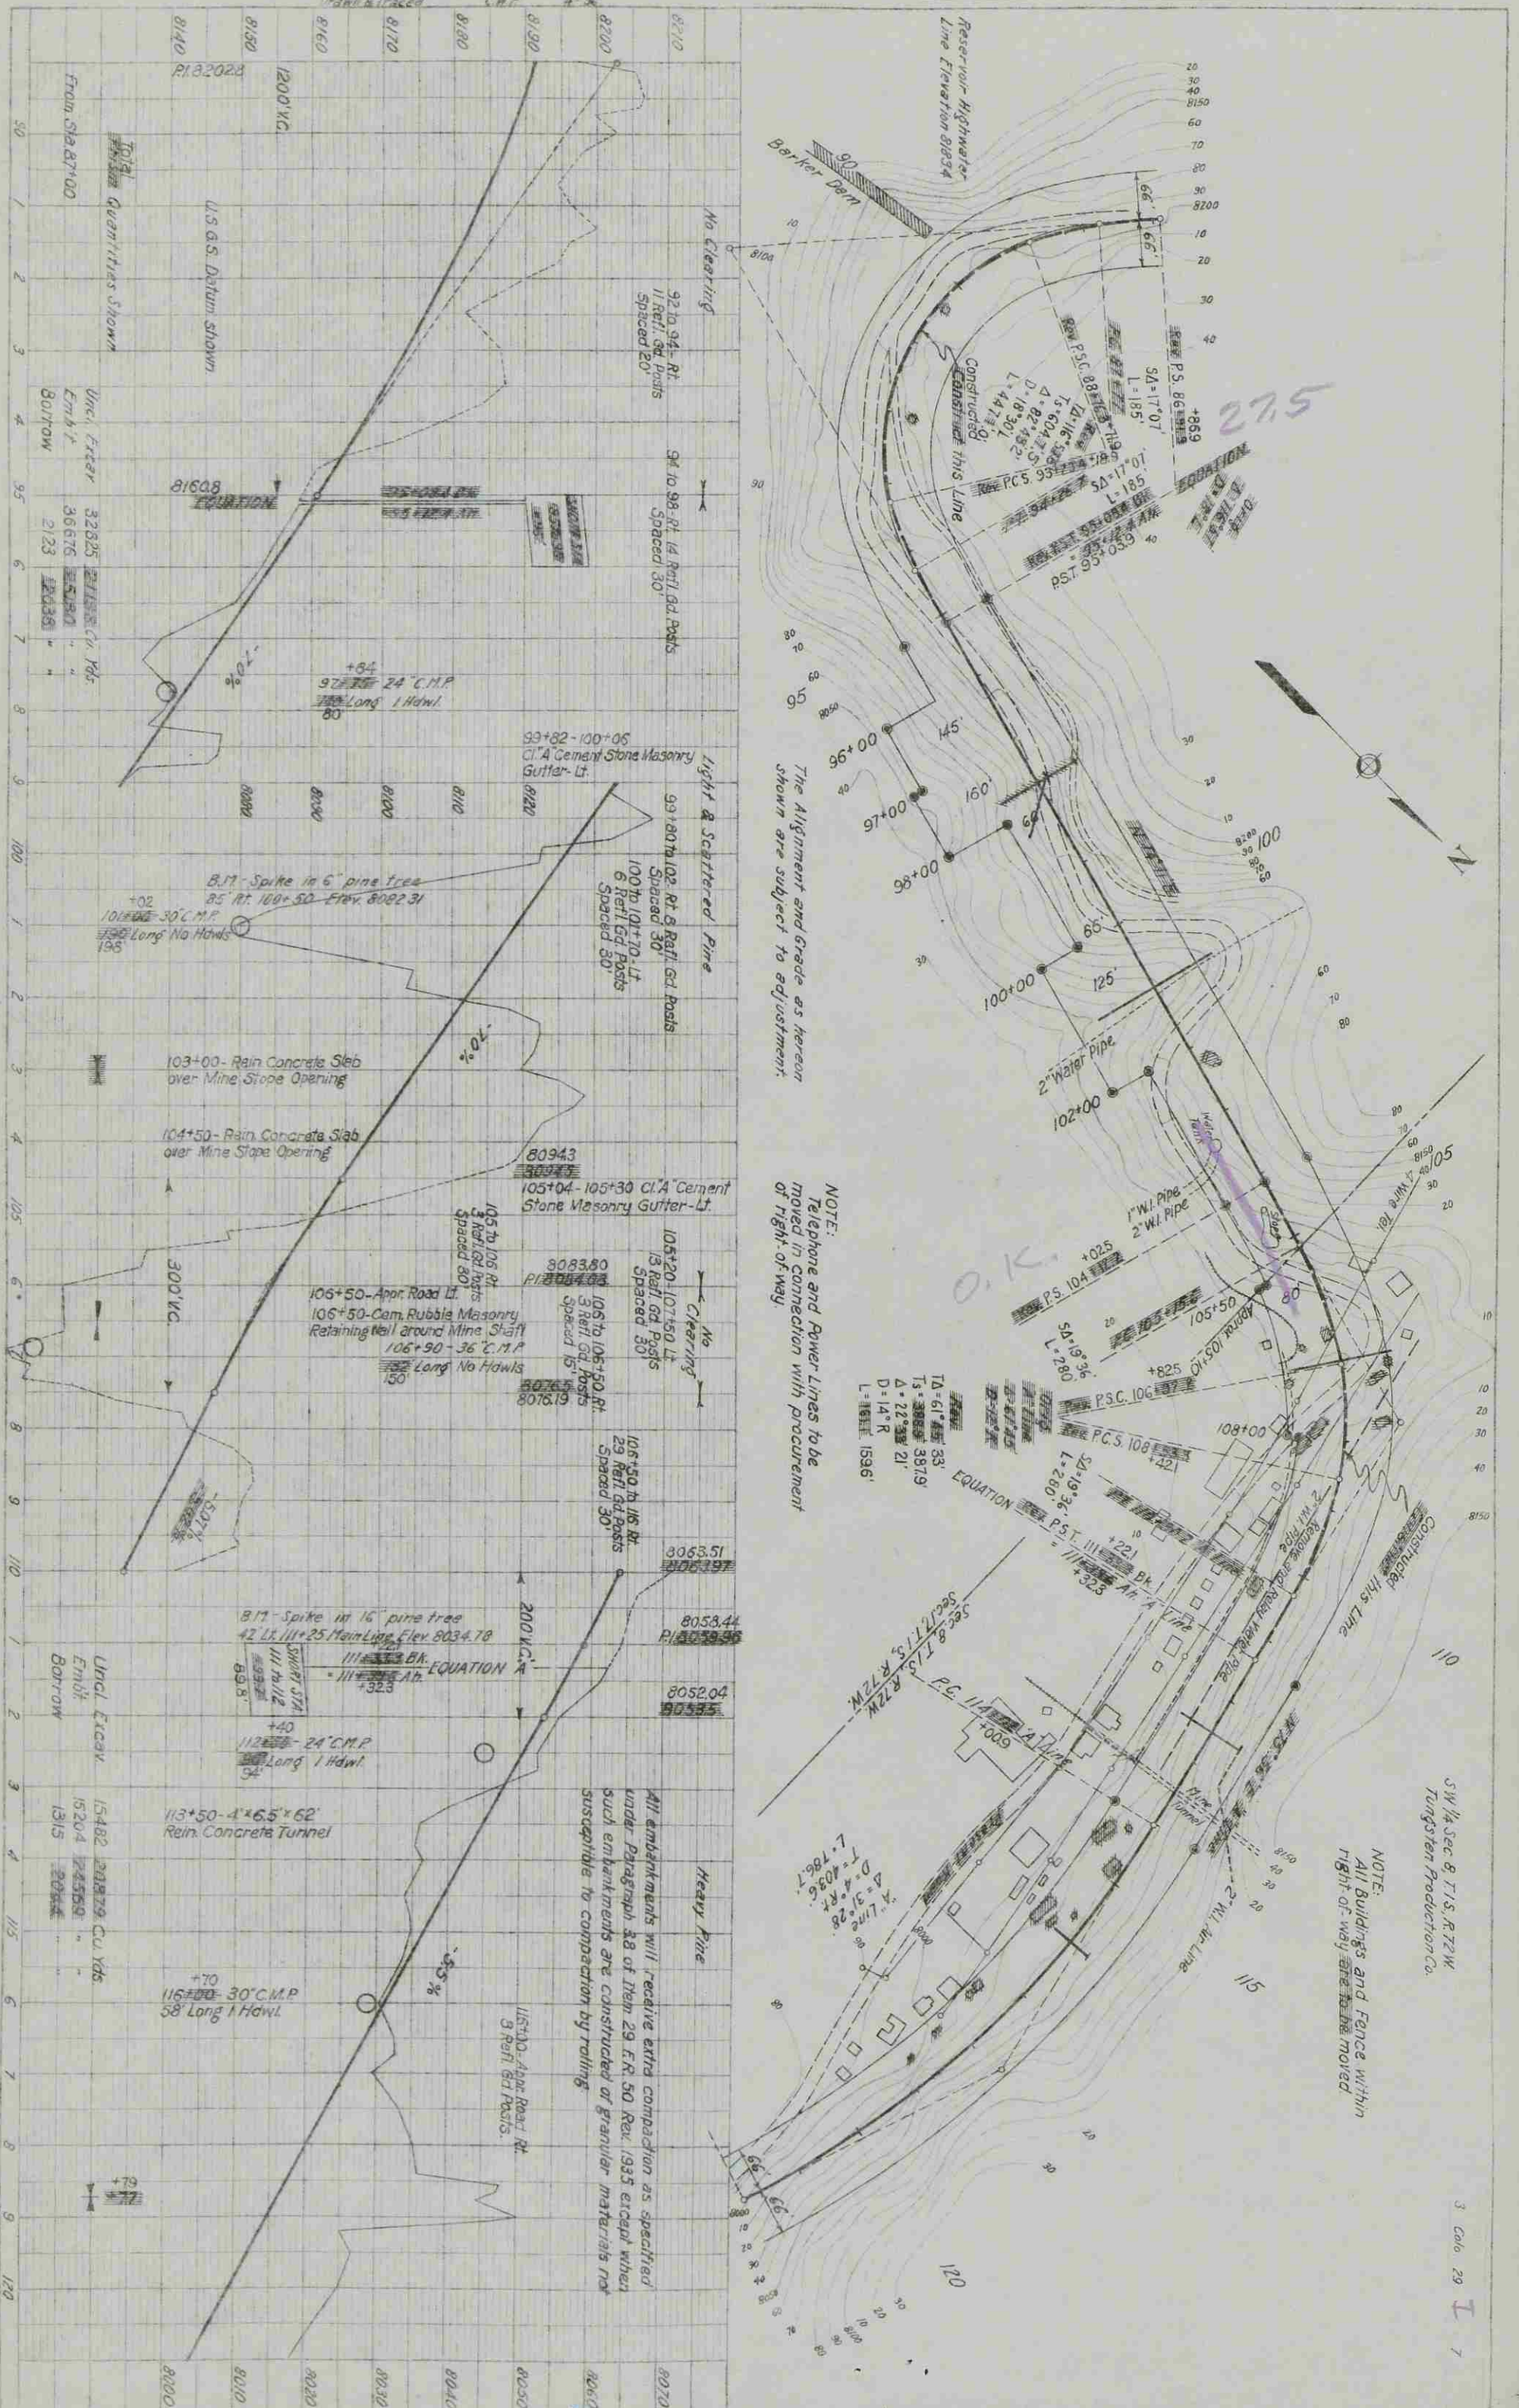

From Sta 87+00

Uncol. Excav	32825	2158	Cu. Yds.
Emb'd	36676	558	sq. ft.
Borrow	2123	2035	cu. yds.

U.S.G.S. Datum shown

81608	ELEVATION
-------	-----------

81608

81608	ELEVATION
-------	-----------

81608

81608	ELEVATION
-------	-----------

The Alignment and Grade as hereon shown are subject to adjustment.



NOTE: Telephone and Power Lines to be moved in connection with procurement of Right-of-way.

NOTE: All Buildings and Fence within Right-of-way are to be moved.

SW 1/4 Sec 8 T.15. R.72W
Tungsten Production Co.

PLAN	SURVEY	A.B.K.	1934
	PLOTTED	J.T.M.	
	ALIGNED	J.T.M.	
	CHECKED	J.T.M.	
	BY	J.T.M.	
	DATE		
	STRUCTURE NOTATION CHECKED		
	NO.		
	Drawn & Traced	C.W.R.	9-36

PROFILE	SURVEY	A.B.K.	1934
	PLOTTED	J.T.M.	
	GRADES CHECKED	J.T.M.	
	BY	J.T.M.	
	DATE		
	STRUCTURE NOTATION CHECKED		
	NO.		
	Drawn & Traced	C.W.R.	9-36

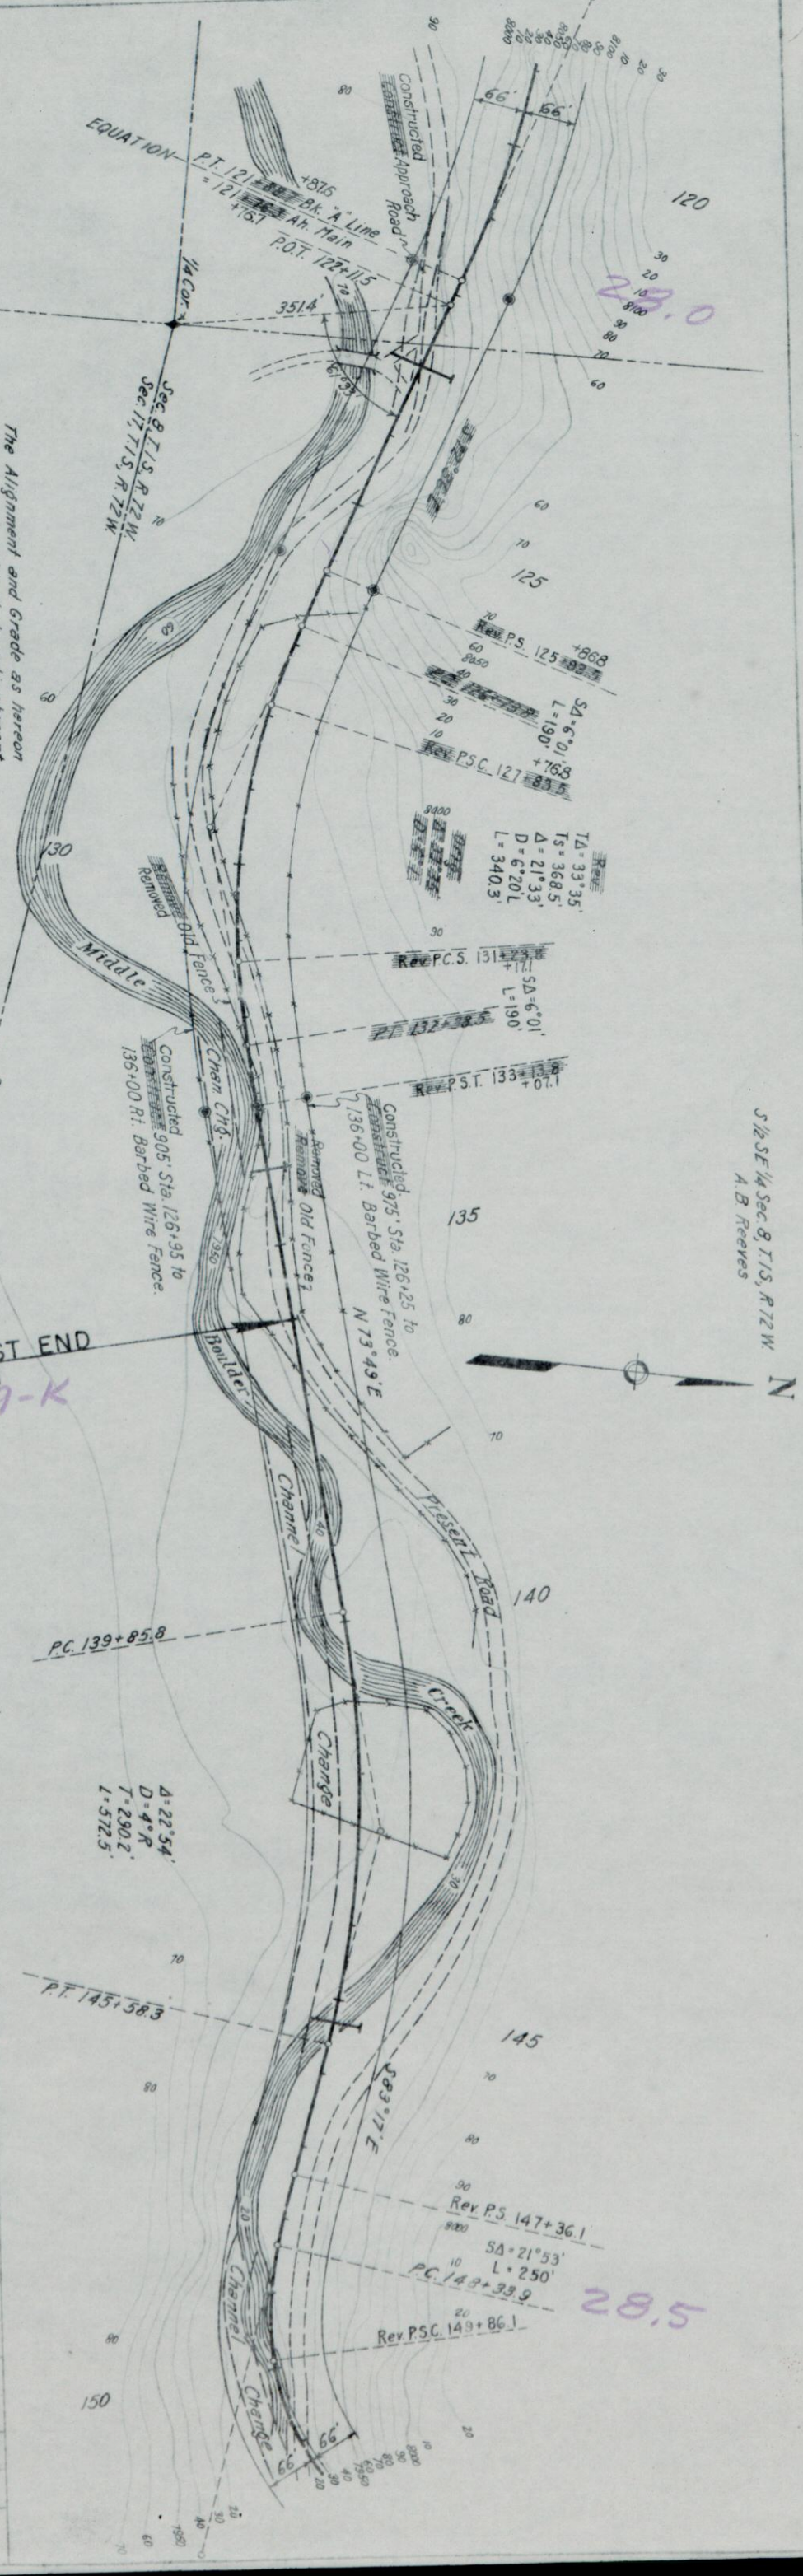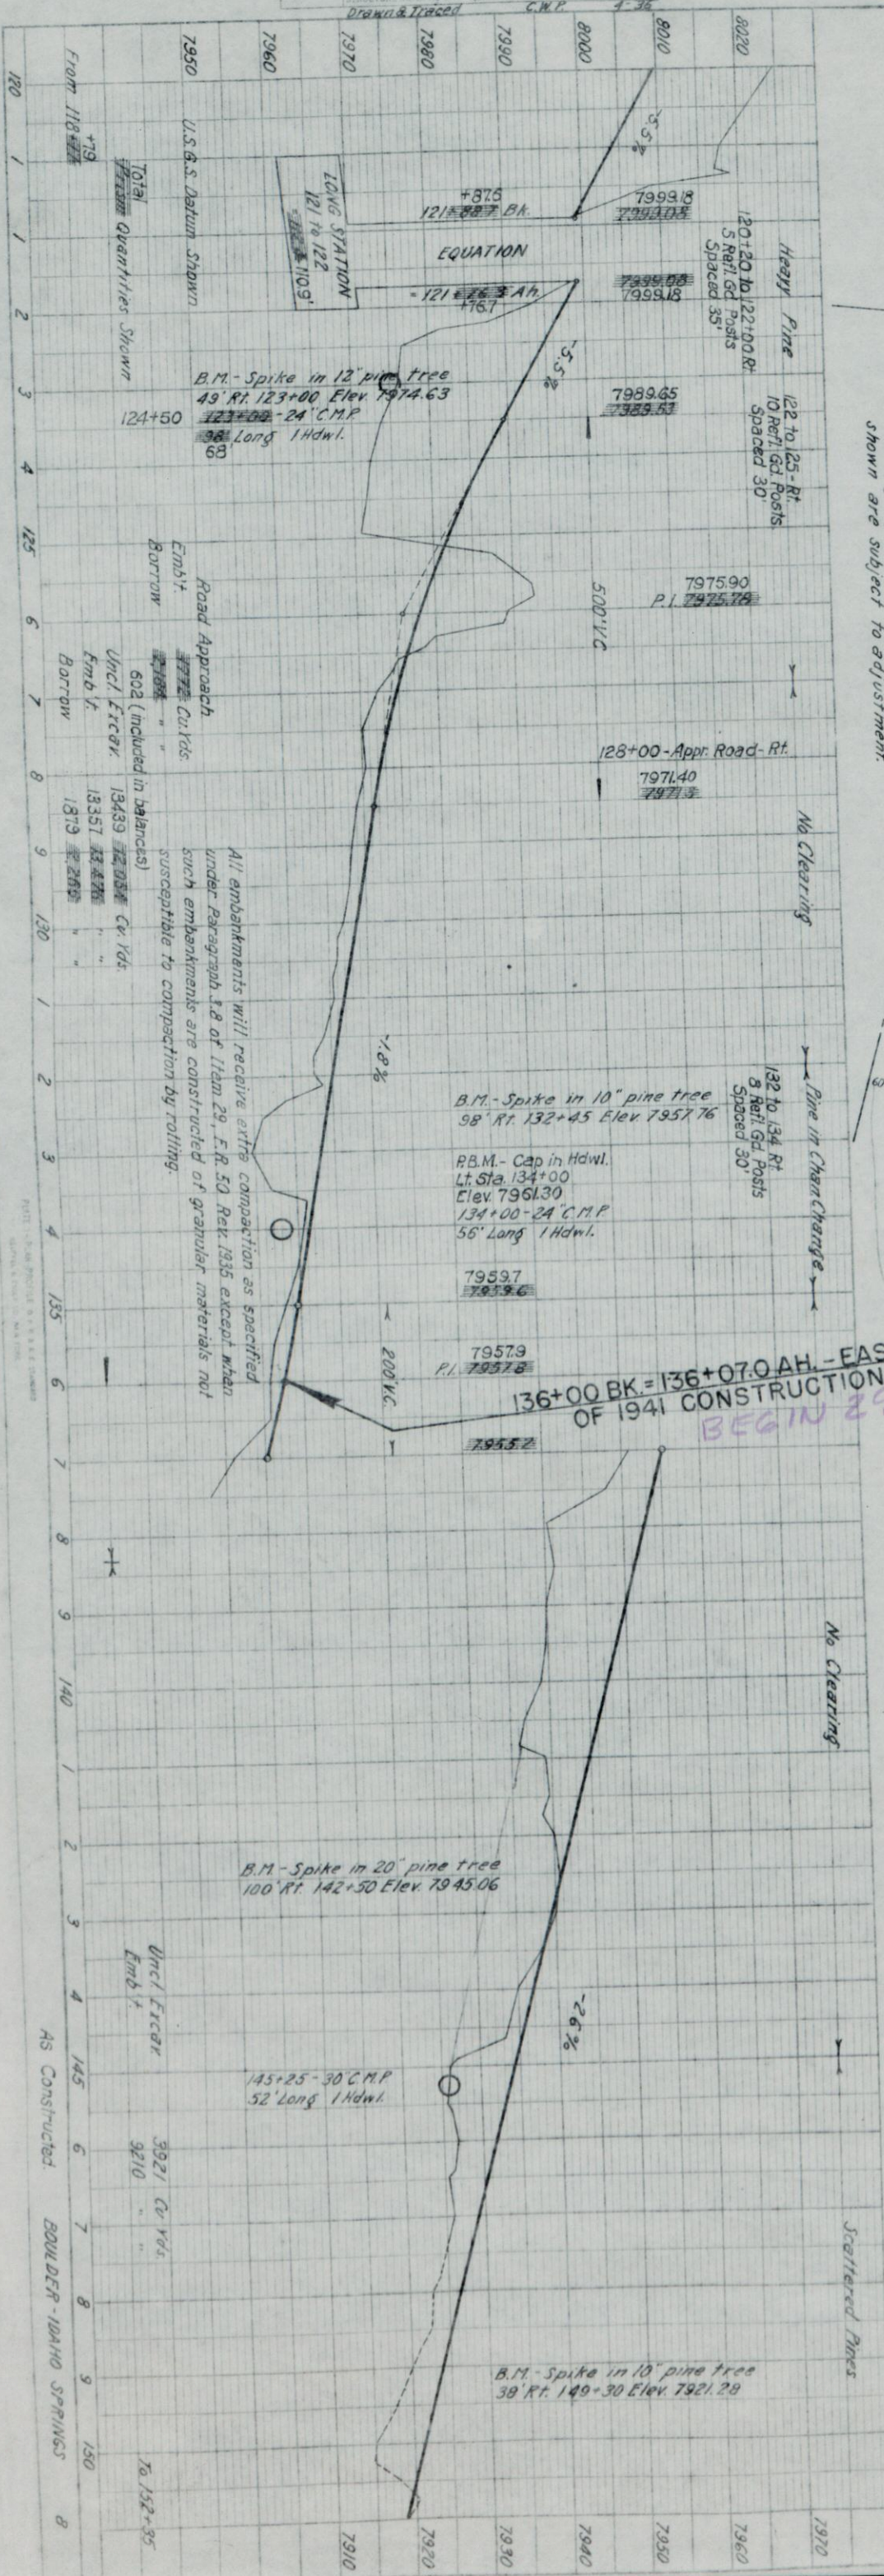

AS Constructed. BOULDER-IDAHO SPRINGS