



FEDERAL WORKS AGENCY  
PUBLIC ROADS ADMINISTRATION

AS CONSTRUCTED  
PROJECT 29-J  
ROUTE 29 BOULDER-IDAHO SPRINGS  
BOULDER VIA NEDERLAND & BLACKHAWK TO IDAHO SPRINGS  
42 MILES CLASS 2  
COLORADO FOREST HIGHWAY SYSTEM  
ROOSEVELT & ARAPAHO NATIONAL FORESTS  
BOULDER, GILPIN & CLEAR CREEK COUNTIES  
COLORADO

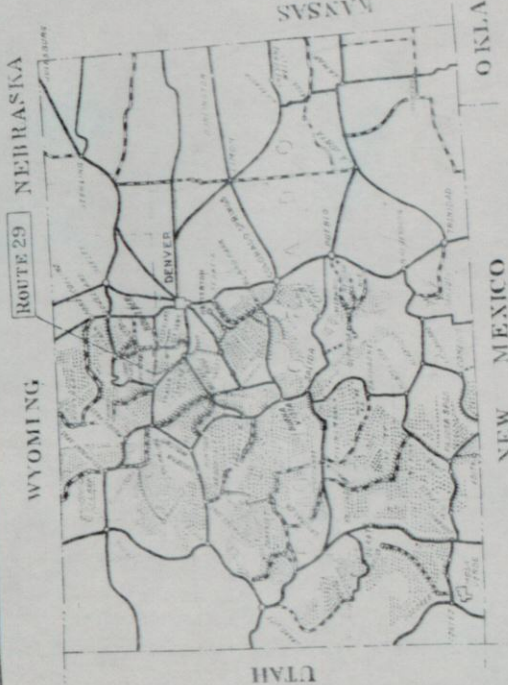

INDEX TO SHEETS	
SHEET NO.	DESCRIPTION
1	Title Sheet
2	Typical Sections
3	Summary
4-6	Plan & Profile
7	Rev. 03/34/37 Gen'l. Masonry Headwalls
8	Rev. 03/34/37 Sid. Fence with Wood Posts
9	Rev. 03/34/37 Typical Signs for Use on Construction
10	Rev. 03/34/37 Sid. Miscellaneous Structures
11	Rev. 03/34/37 Rel. Timber, Guide Posts
12	Rev. 03/34/37 Sid. Conc. & C&M Drop Inlets
13	Cross Sections

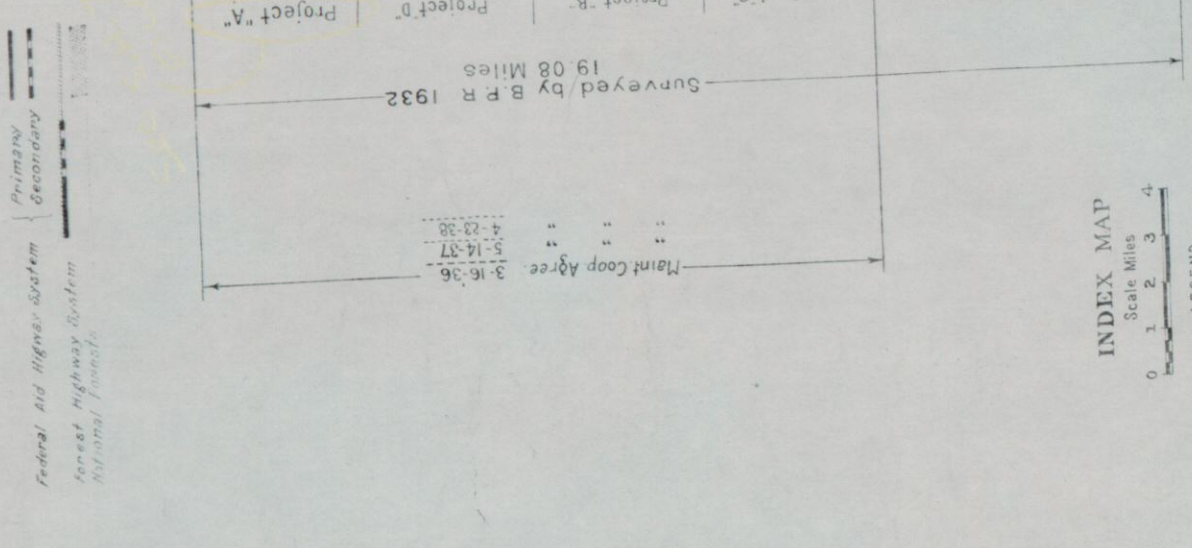

FEDERAL WORKS AGENCY  
PUBLIC ROADS ADMINISTRATION  
DISTRICT 3 DENVER COLORADO

APPROVED \_\_\_\_\_ DATE \_\_\_\_\_  
DIVISION ENGINEER  
BY DESIGN ENGINEER

APPROVED \_\_\_\_\_ DATE \_\_\_\_\_  
REGIONAL FORESTER

APPROVED \_\_\_\_\_ DATE \_\_\_\_\_  
STATE HIGHWAY ENGINEER  
STATE OF COLORADO

\* Length includes tunnels, bridges and bar curves












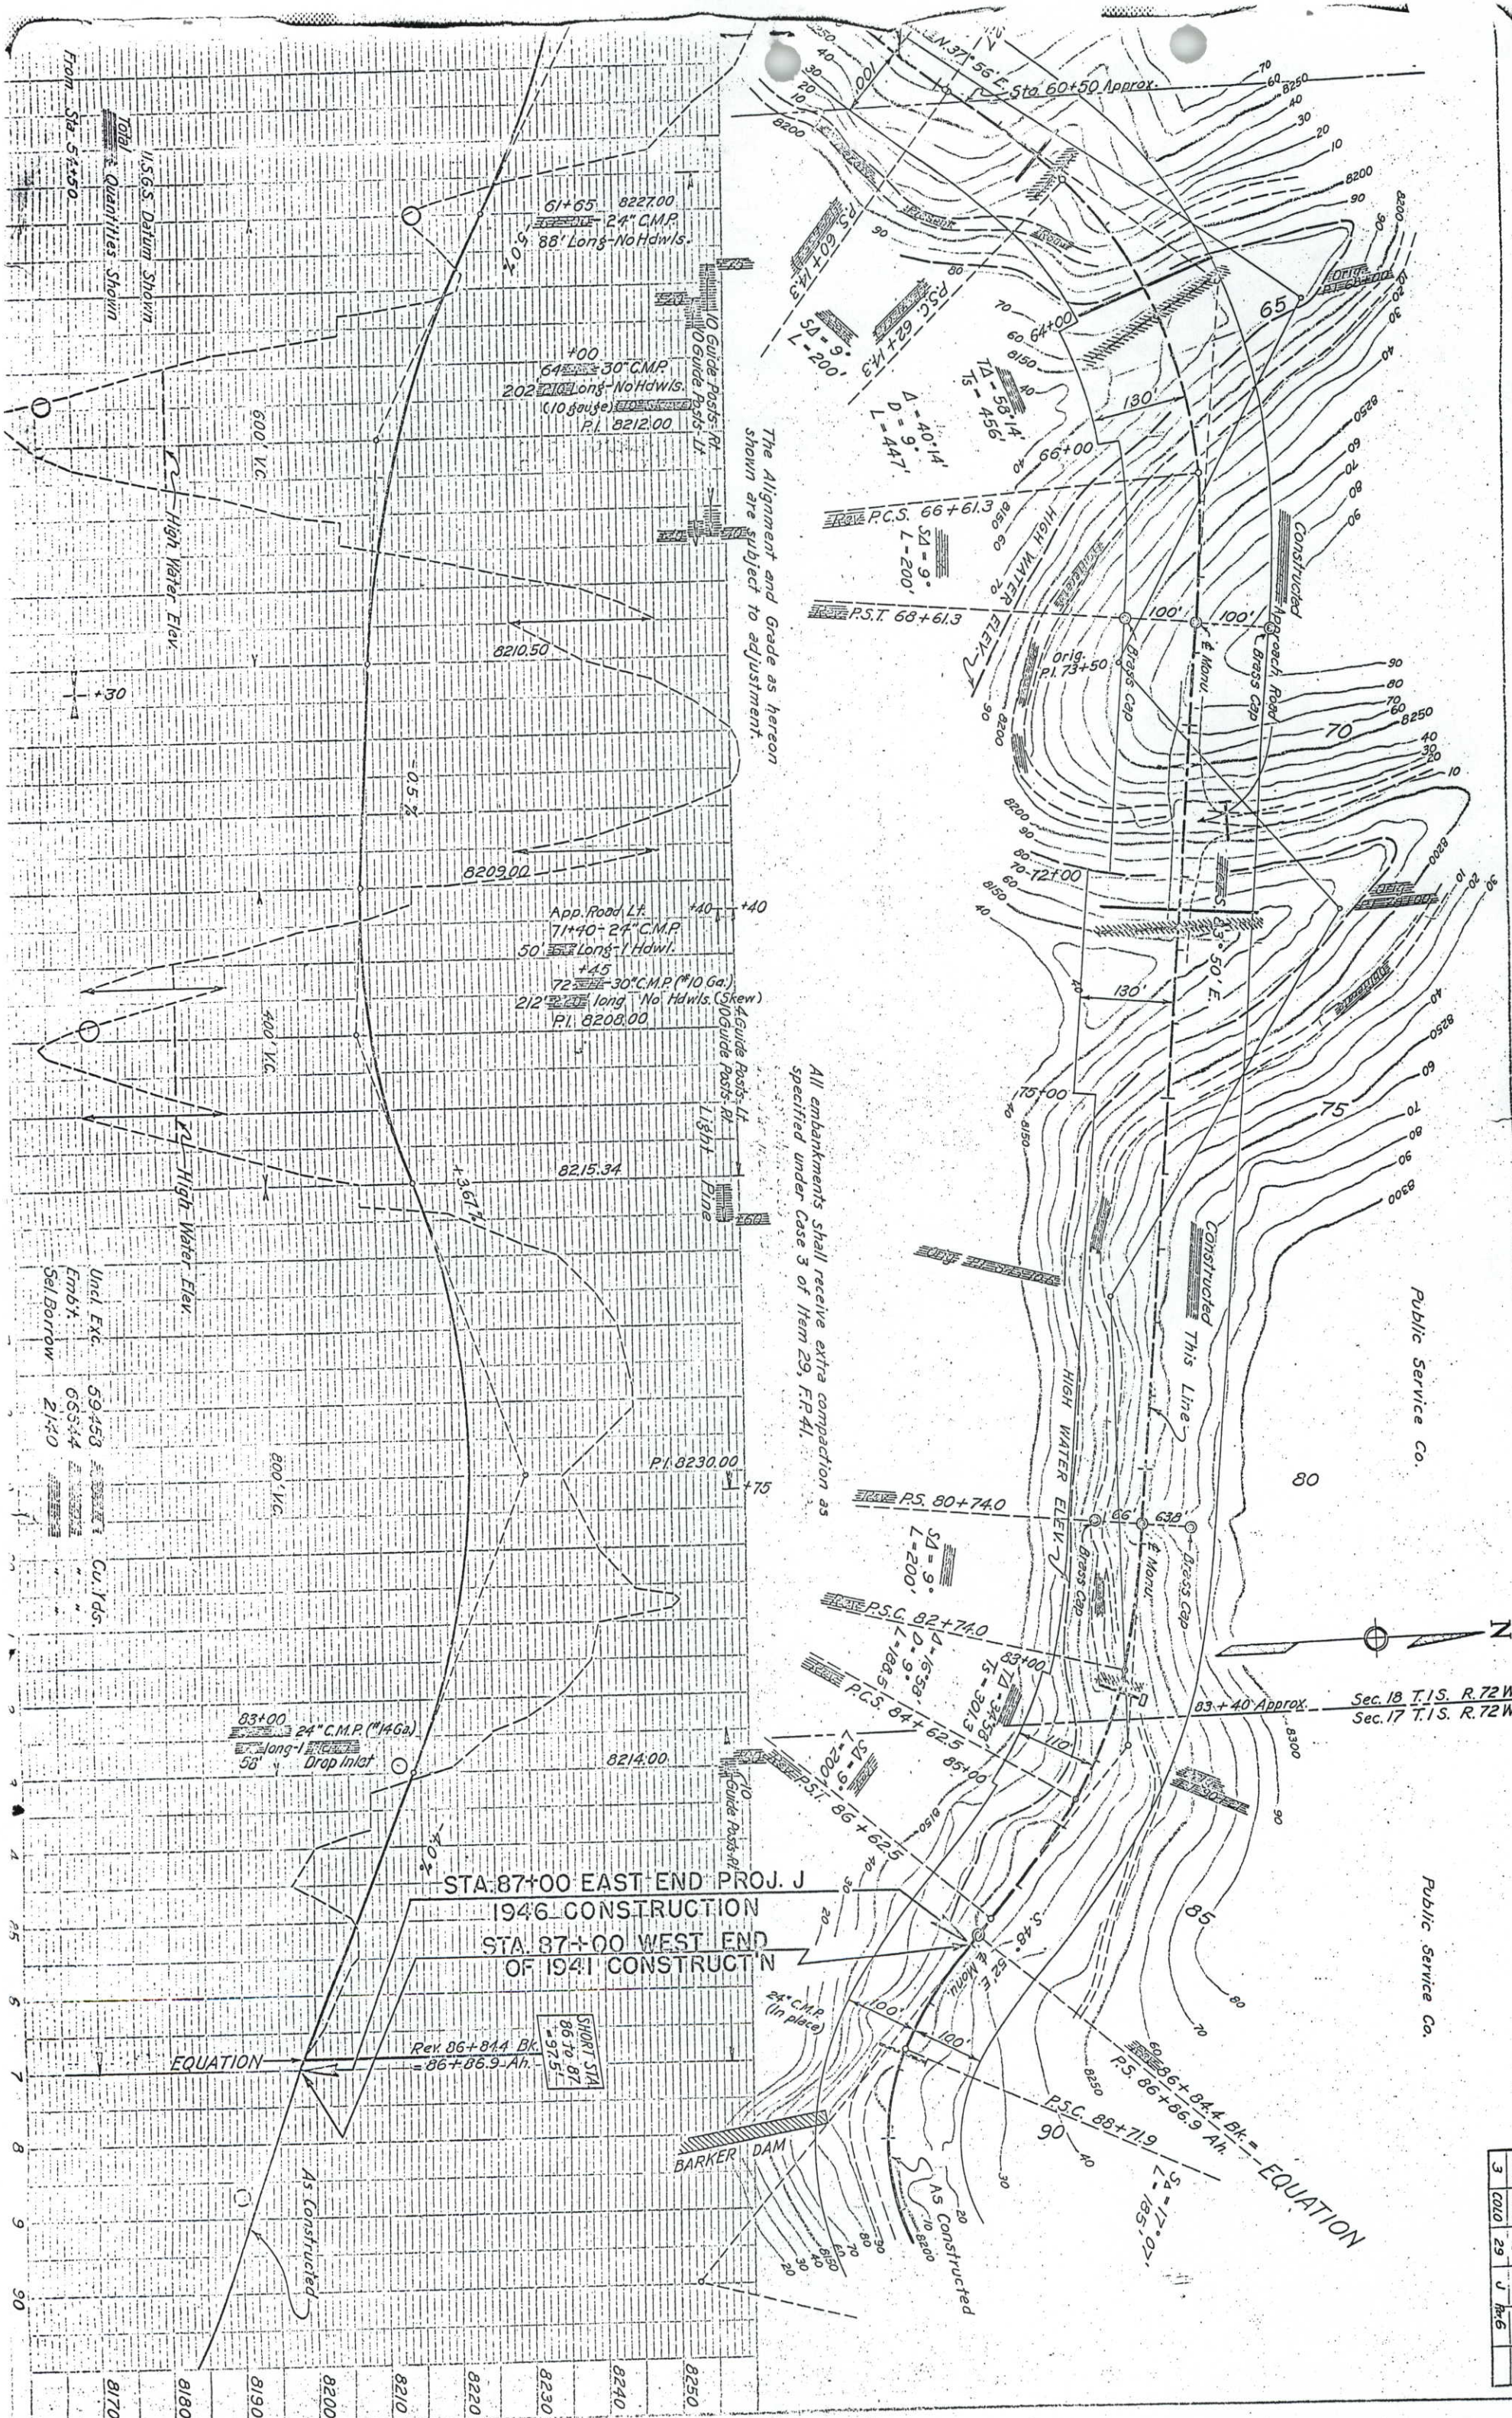

Public Service Co.

Public Service Co.


POST No.	STATE	SECTION	SHEET No.	TOTAL
3	COLORADO	29	J	6



PLAN	DATE	BY	CHECKED
1934	3-36	J.H.	J.H.
1934	3-36	J.H.	J.H.
1934	3-36	J.H.	J.H.
1934	3-36	J.H.	J.H.

SW 1/4 Sec. 8, T.15, R.72W.  
Tungsten Production Co.


NOTE:  
All Buildings and Fence within  
right-of-way moved.

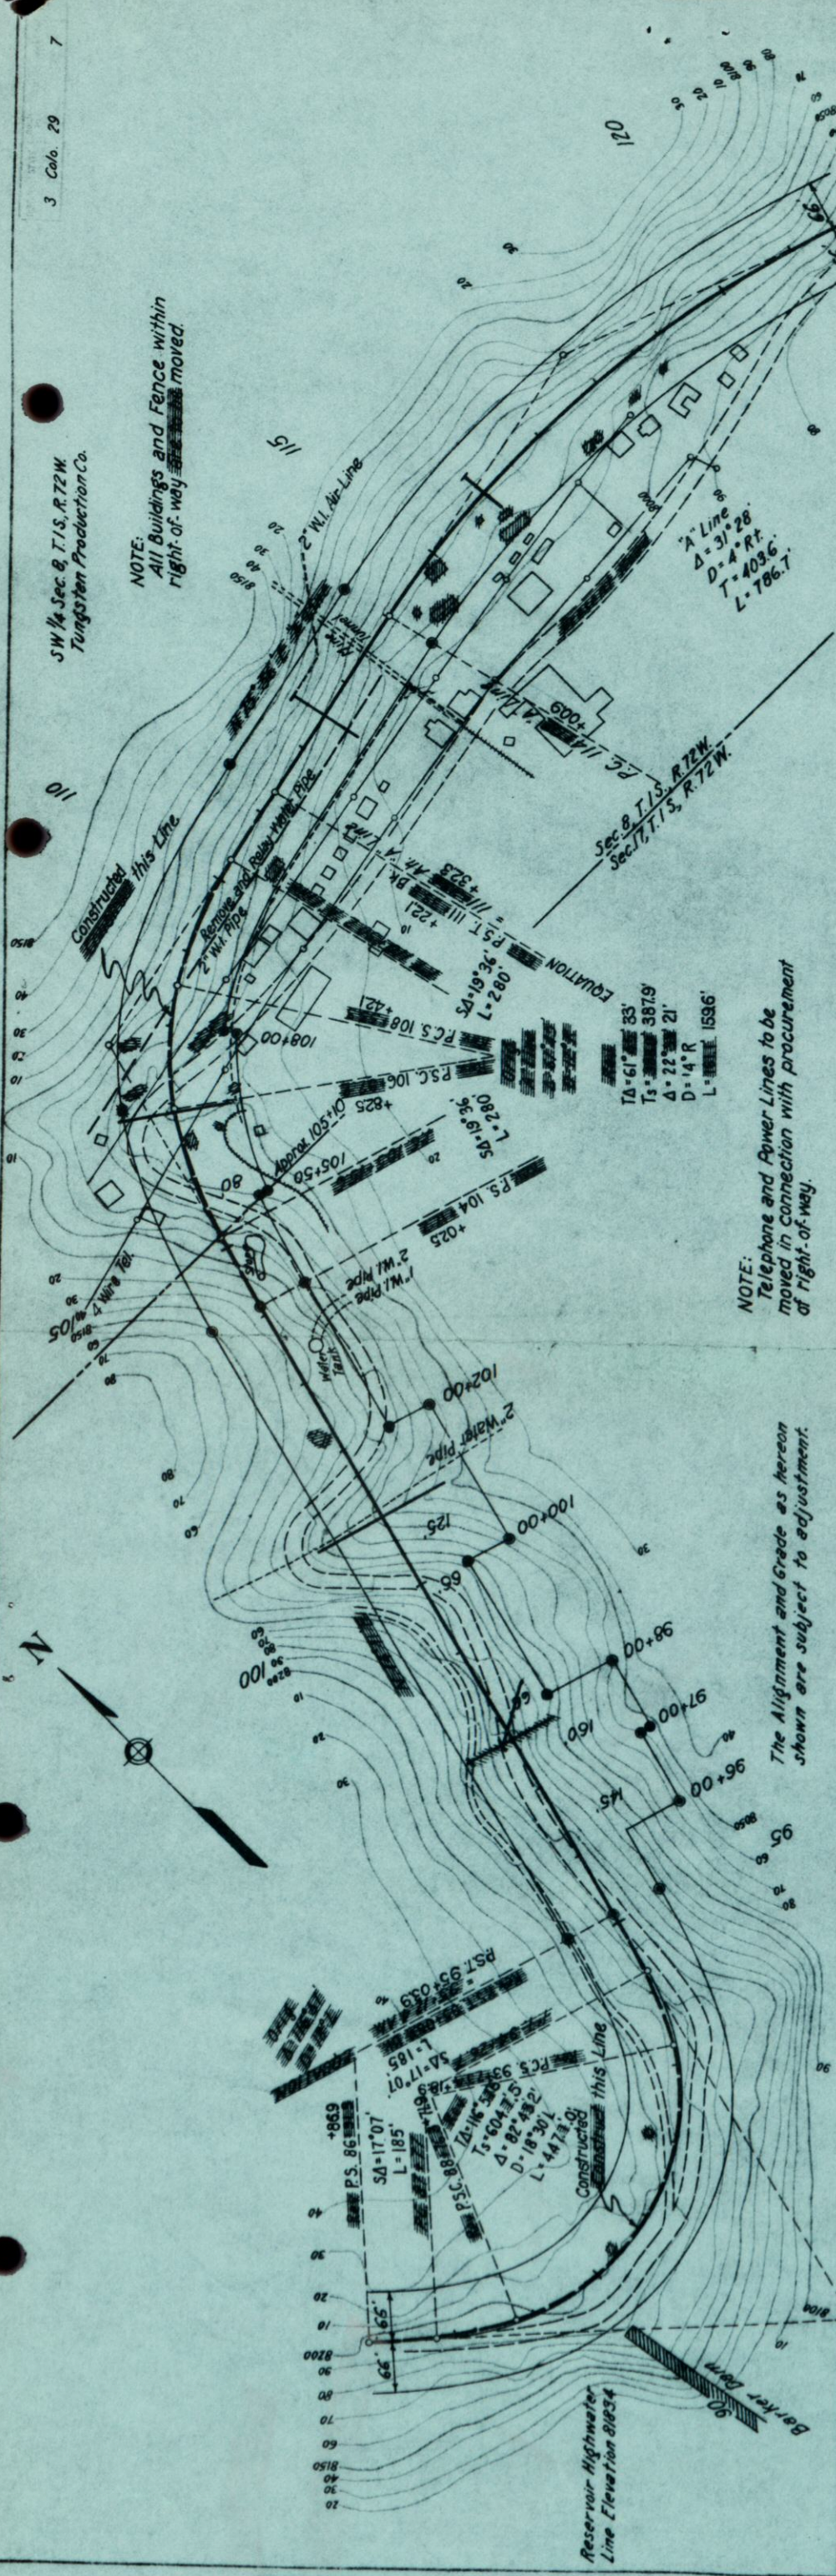

NOTE:  
Telephone and Power Lines to be  
moved in Connection with procurement  
of right-of-way.

The Alignment and Grade as hereon  
shown are subject to adjustment.

PROFILE	DATE	BY	CHECKED
1934	3-36	J.H.	J.H.
1934	3-36	J.H.	J.H.
1934	3-36	J.H.	J.H.
1934	3-36	J.H.	J.H.

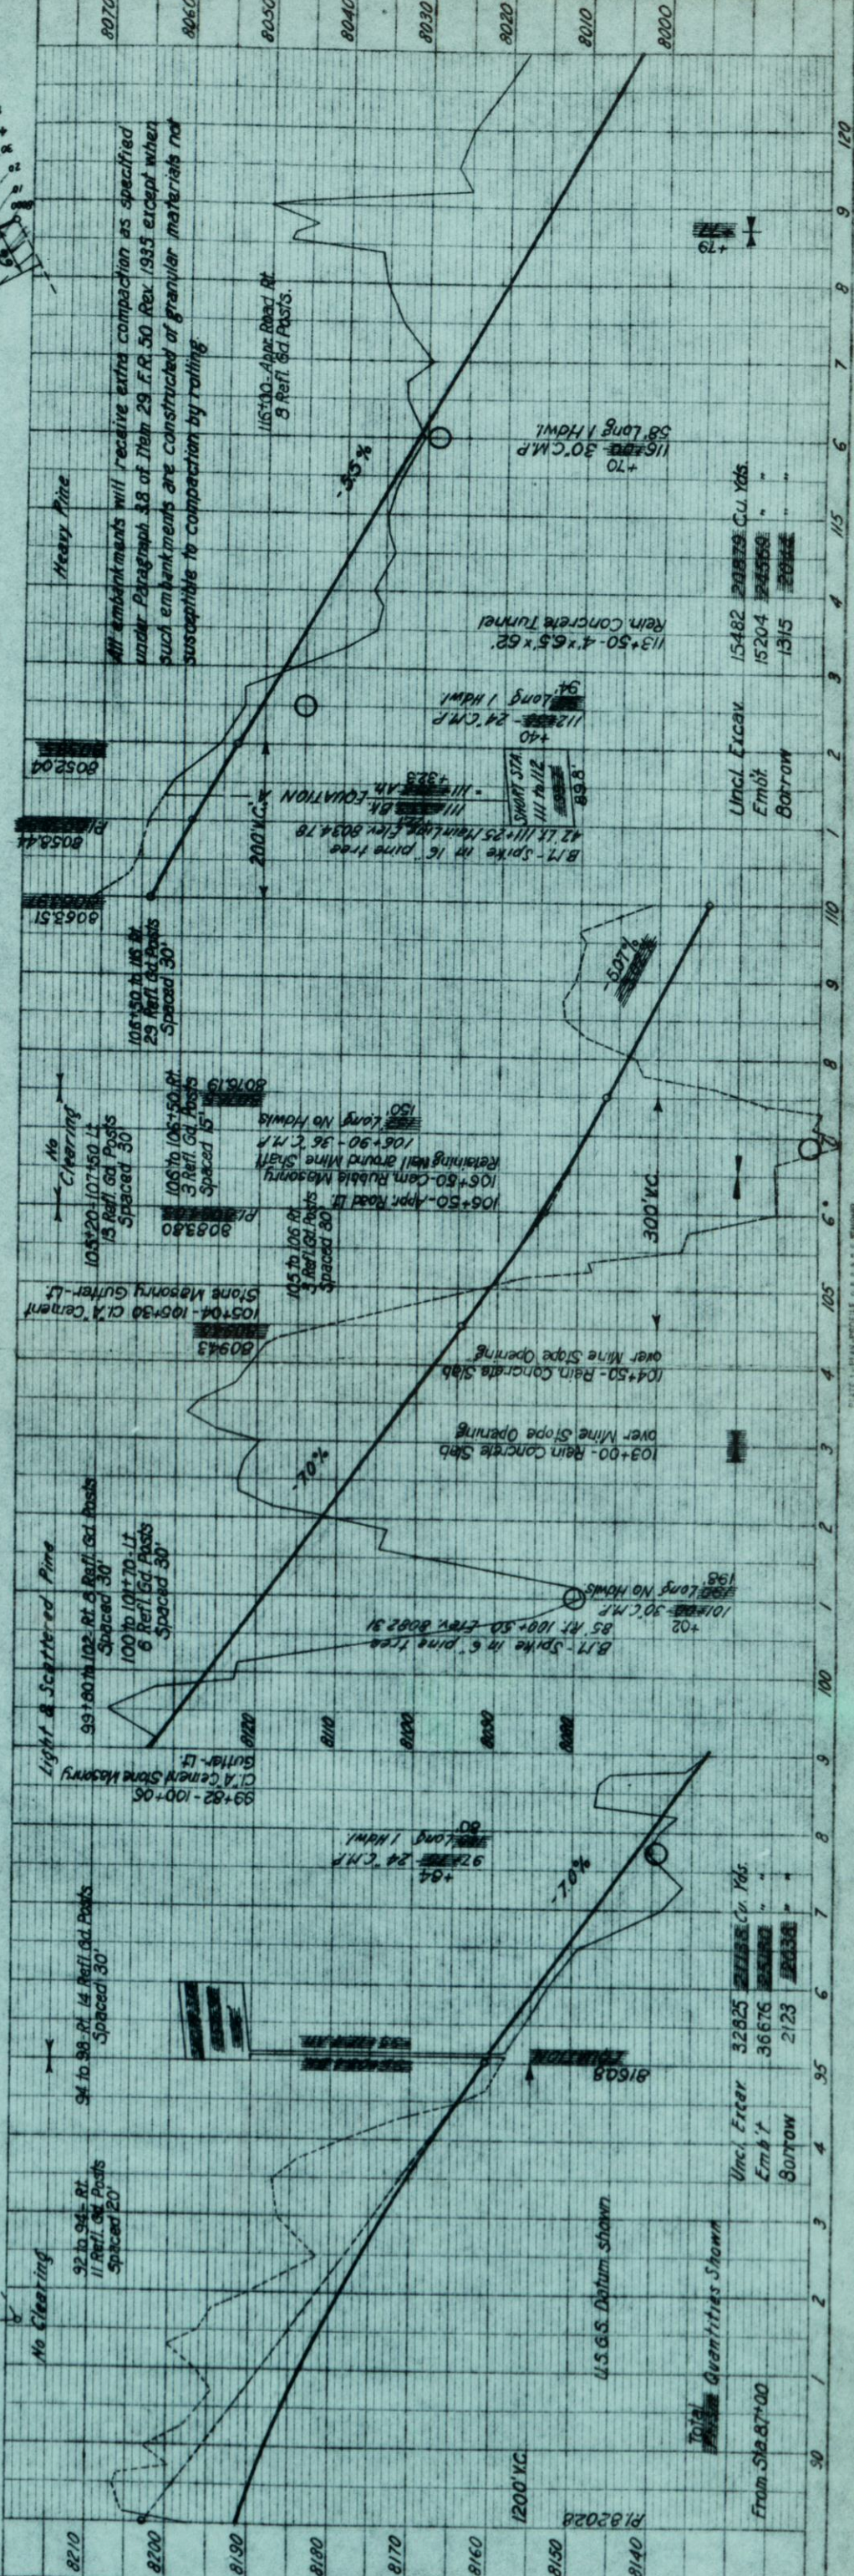

All embankments will receive extra compaction as specified  
under Paragraph 3.8 of Item 29 F.R. 50 Rev. 1935 except when  
such embankments are constructed of granular materials not  
susceptible to compaction by rolling.



As Constructed



PROFILE	SURVEYED	DATE
NOTED	BY	1934
GRADES CHECKED	J.B.H.	
B.M. NOTED		
STRUCTURE NOTATION	C.W.P.	4-36
Drawn & Traced		

PLAN	SURVEYED	DATE
NOTED	BY	1934
ALIGNMENT CHECKED	J.B.H.	
RT. OF WAY CHECKED		
Drawn & Traced	C.W.P.	5-36

Boulder-Idaho Springs Colo. 29  
Sta. 120 to Sta. 150  
Sheet No. 8

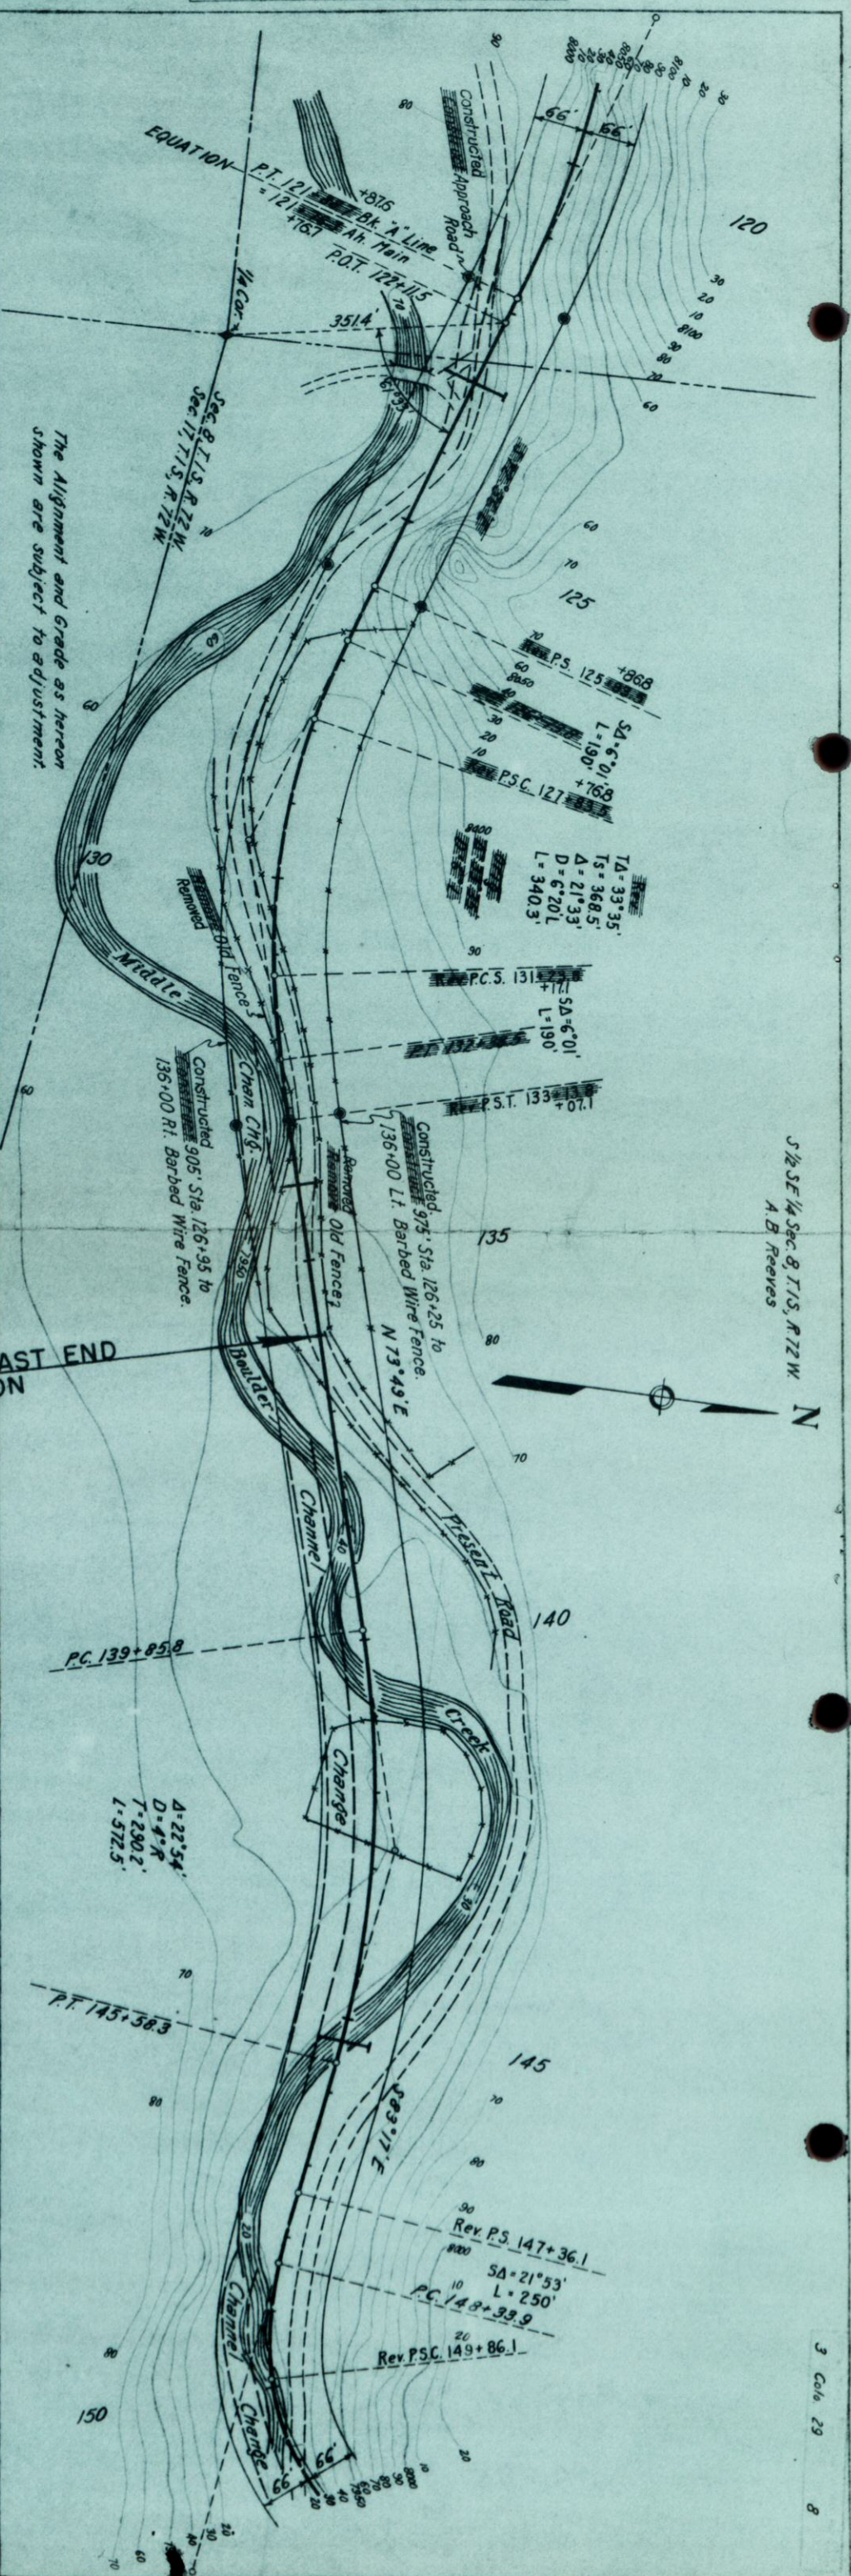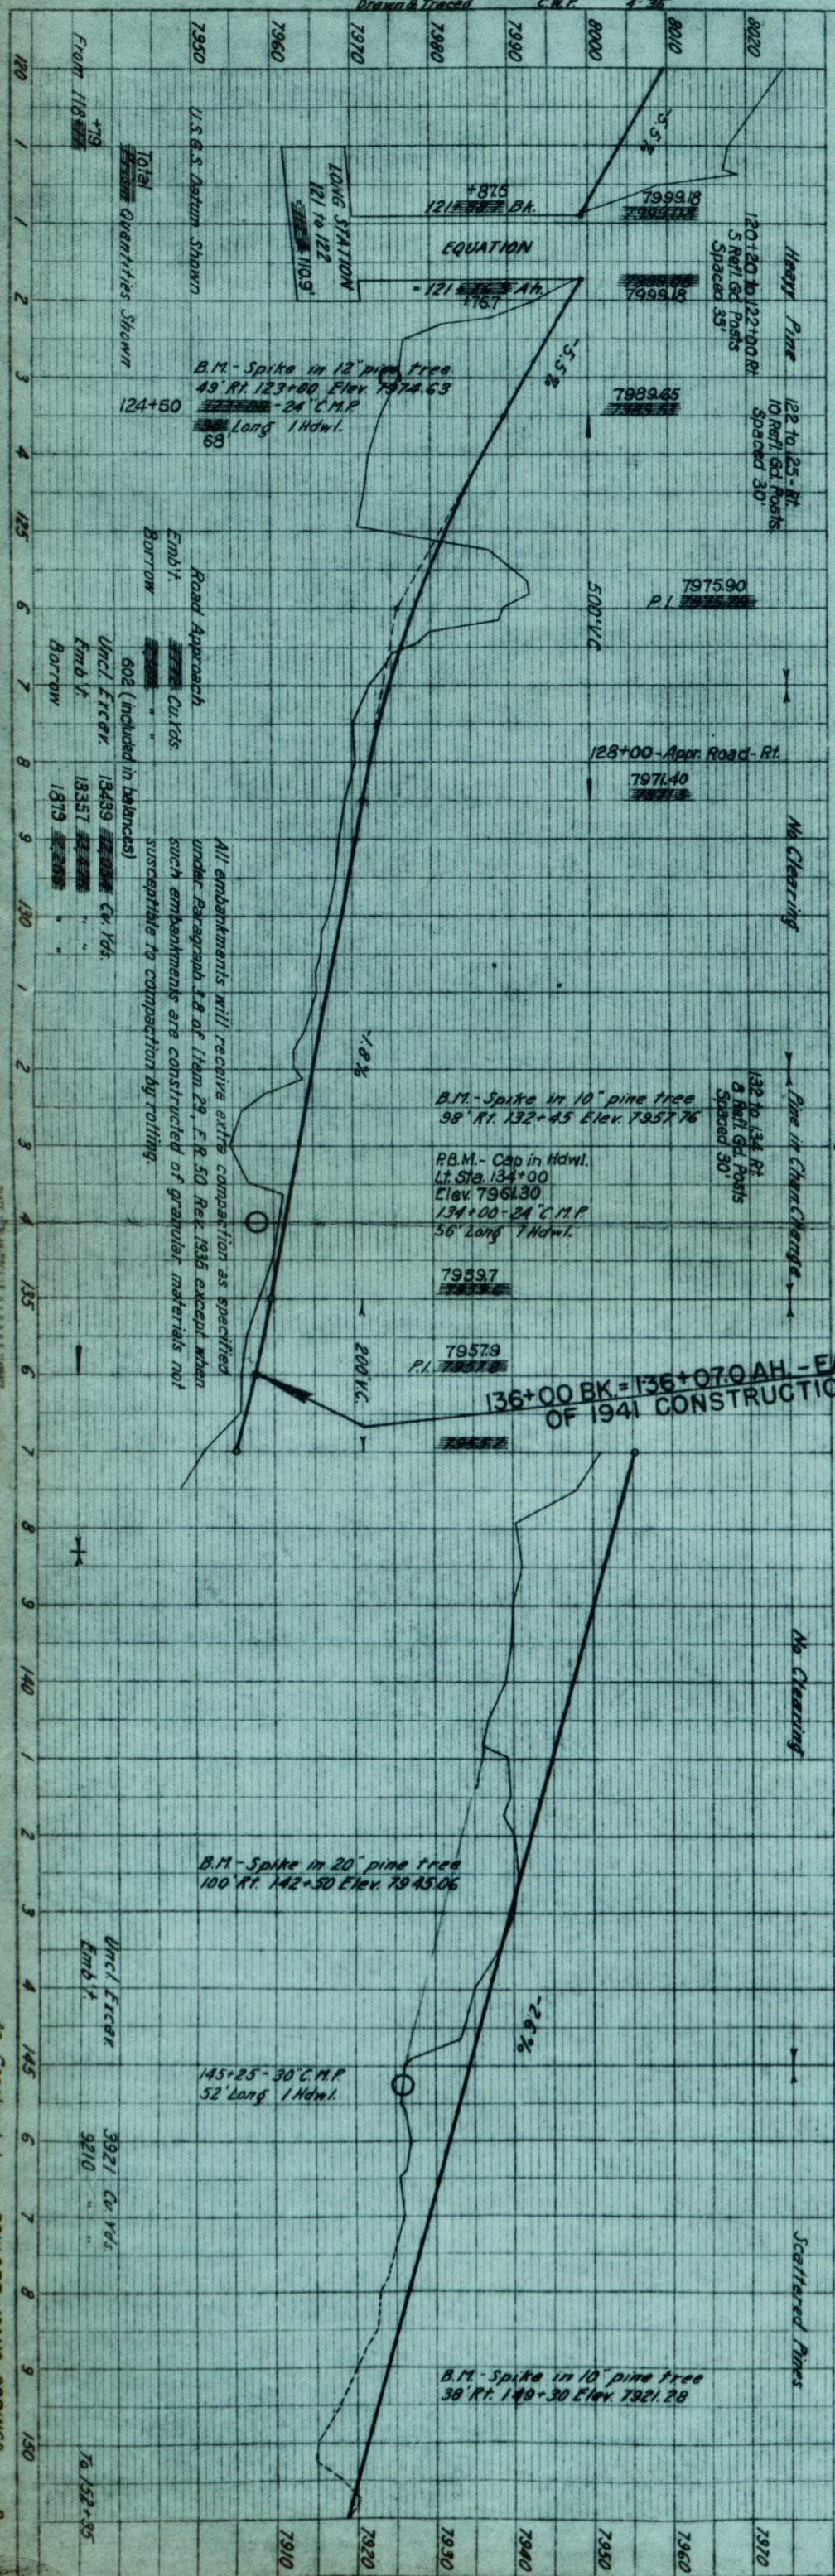

S 1/2 Sec. 14, T. 15, R. 72 W.  
A. B. Reeves