

STATE DEPARTMENT OF HIGHWAYS

DIVISION OF HIGHWAYS—STATE OF COLORADO








P.E. & R.O.W. PRELIM.
UNDER BRF 040-8(11)
BRF 040-8(12)

FEDERAL ROAD REGION NO.	DIVISION	COMBINED PROJECT NOS.	SHEET NO.
VIII	COLORADO	CX BRF 33-0040-06 CX BRF 33-0040-07	1

RIGHT OF WAY
S.E. OF HUGO

REVISIONS	
116-87	Added basis of bearing note. D-1

CONVENTIONAL SIGNS

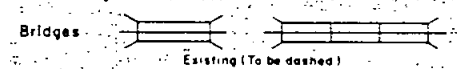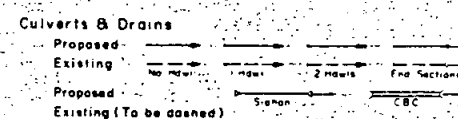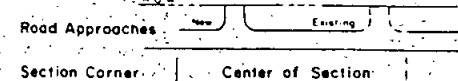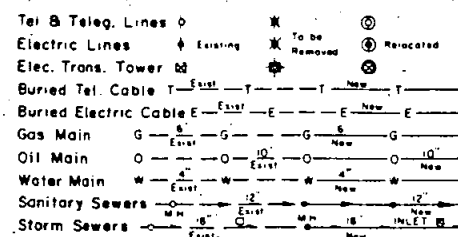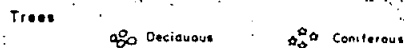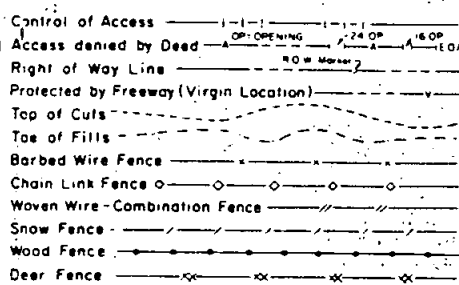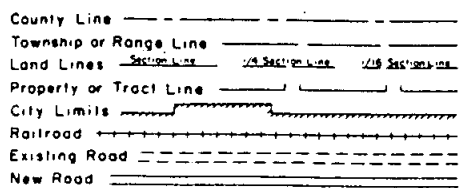

RIGHT OF WAY PLAN OF PROPOSED FEDERAL AID PROJECT NO. COMB. CX BRF 33-0040-06 CX BRF 33-0040-07 STATE HIGHWAY NO. 40 LINCOLN COUNTY

RIGHT OF WAY

SCALE OF ORIGINAL DRAWINGS

PLAN SHEETS 1" = 100'

DETAIL SHEETS 1" = 100'

OWNERSHIP MAPS 1" = 500'

R.O.W. LENGTH OF PROJECT = 600' on CX BRF 33-0040-06
= 2950' on CX BRF 33-0040-07


Note: Centerline (stationing and bearings) shown on this R.O.W. plan is from previous project FAP 278-G unless otherwise noted.

Reg. R.O.W. Sta. 1290+50
On Proj. No. CX BRF 33-0040-06 =
Sta. 1290+50 On Proj. No. FAP 278 G
Str. No. H-23-A0 M.P. 408.52

End R.O.W. Sta. 1296+50
On Proj. No. CX BRF 33-0040-06 =
Sta. 1296+50 On Proj. No. FAP 278 G


Reg. R.O.W. Sta. 1349+00
On Proj. No. CX BRF 33-0040-07 =
Sta. 1349+00 On Proj. No. FAP 278 G
Str. No. H-23-AP M.P. 409.73
Str. No. H-23-AQ M.P. 410.11

End R.O.W. Sta. 1378+50
On Proj. No. CX BRF 33-0040-07 =
Sta. 1378+50 On Proj. No. FAP 278 G

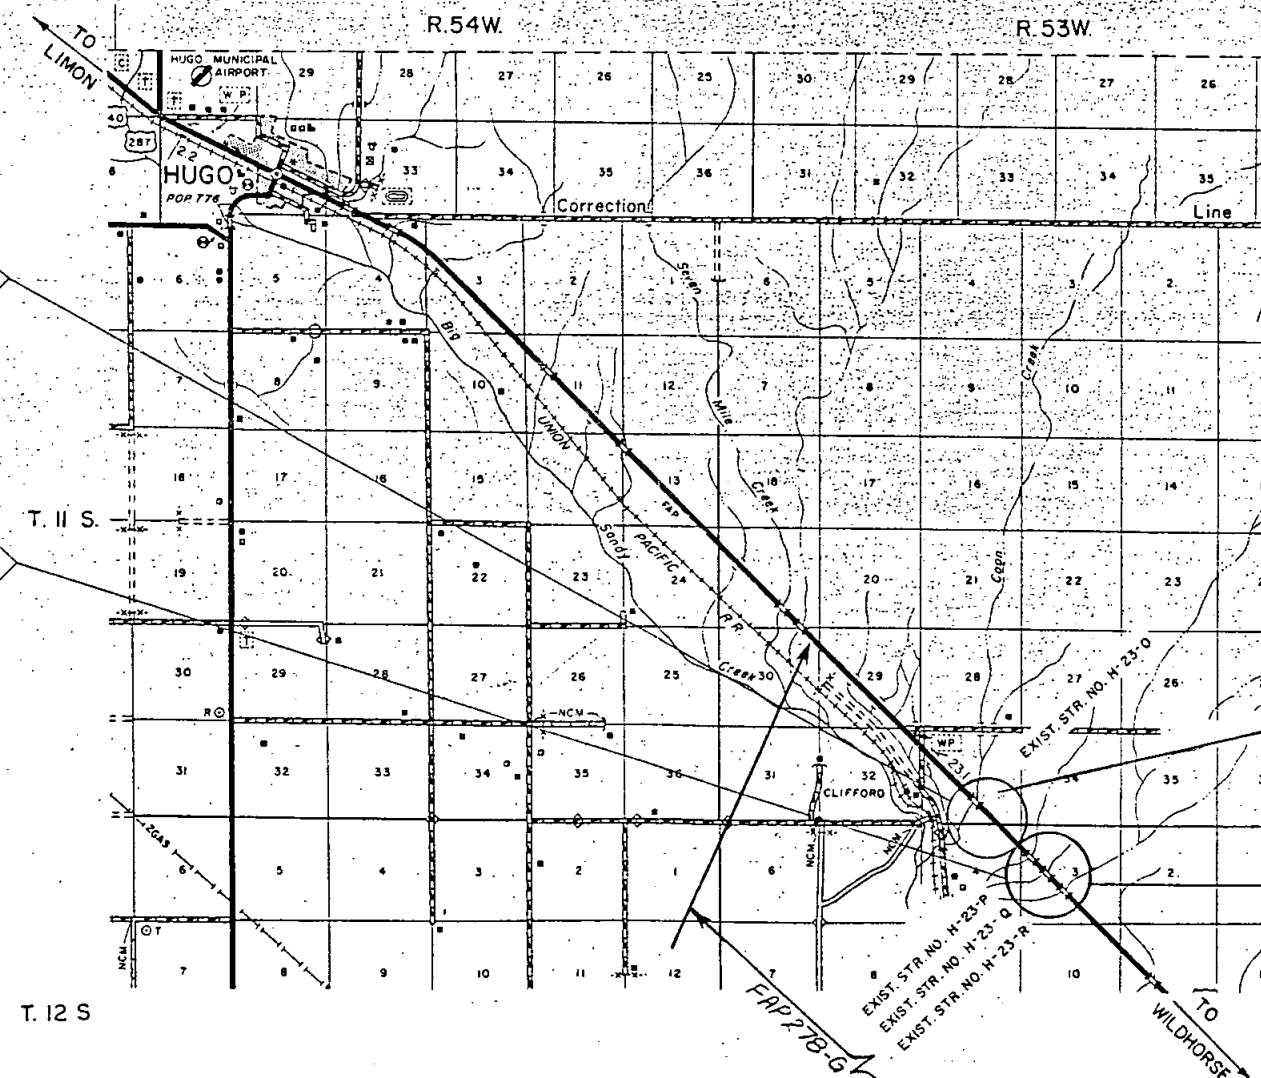

CONST. PROJ. CX BRF 33-0040-06
DESIGN PROJECT BRF 040-8 (11)
STR. No. H-23-A0
M.P. 408.52

CONST. PROJ. CX BRF 33-0040-07
DESIGN PROJECT BRF 040-8 (12)
STR. No. H-23-AP
M.P. 409.61
STR. No. H-23-AQ
M.P. 410.11

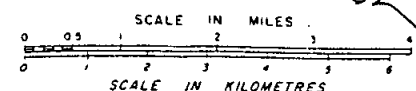

DIST. NO. 1
PE & R.O.W. PRELIM. ON BRF 040-8(11)
SUBACCOUNT NO. 85092
CONST. & ACQUISITION OF R.O.W. ON CX BRF 33-0040-06
SUBACCOUNT NO. 87403
PE & R.O.W. PRELIM. ON BRF 040-8(12)
SUBACCOUNT NO. 85093
CONST. & ACQUISITION OF R.O.W. ON CX BRF 33-0040-07
SUBACCOUNT NO. 87404
DEC. 1986

DIVISION OF HIGHWAYS

APPROVED: *[Signature]* 12-23-86
DISTRICT ENGINEER DATE


DEPARTMENT OF TRANSPORTATION
FEDERAL HIGHWAY ADMINISTRATION

APPROVED: _____ DATE _____
DIVISION ADMINISTRATOR

PARCEL NO.	OWNER	ADDRESS	LOCATION	AREA IN ACRES & SQ. FT.				PARCEL NO.	REMARKS	REVISIONS		
				PARCEL	TO BE ACQUIRED	REMAINDER				1-16-87 Additional remarks	2-9-87 Rev. Per N.E. 4 to P.E. - 4	3-1-87
						LEFT	RIGHT					
1	JAMES D. WILL	HUGO, COLORADO	SEC. 33, T. 11 S., R. 53 W.	0.321 AC.	0.321 AC.		200 AC ±	1	Acquired under CX BRF 33-0040-06			
				14 000 SQ. FT.	14 000 SQ. FT.		9 000 000 SQ. FT. ±					
2	ALMEDA ANN CLAY	HUGO, COLORADO	SEC. 3, T. 12 S., R. 53 W.	0.276 AC.	0.276 AC.		200 AC ±	2	Acquired under CX BRF 33-0040-07			
				12 000 SQ. FT.	12 000 SQ. FT.		9 000 000 SQ. FT. ±					
3	ALMEDA ANN CLAY	HUGO, COLORADO	SEC. 3, T. 12 S., R. 53 W.	0.276 AC.	0.276 AC.		200 AC ±	3	Acquired under CX BRF 33-0040-07			
				12 000 SQ. FT.	12 000 SQ. FT.		9 000 000 SQ. FT. ±					
4	DELETED											
PE-4	ALMEDA ANN CLAY	HUGO, COLORADO	SEC. 3, T. 12 S., R. 53 W.	6.772 AC.	6.772 AC.	400 AC ±		PE-4	Acquired under CX BRF 33-0040-07			
				295 000 SQ. FT.	295 000 SQ. FT.							
TE-1	JAMES D. WILL	HUGO, COLORADO	SEC. 33, T. 11 S., R. 53 W.	1.443 AC.	1.443 AC.			TE-1	For Constructing a Temporary Detour. Acquired under CX BRF 33-0040-06			
				62 875 SQ. FT.	62 875 SQ. FT.							
TE-2	JAMES D. WILL	HUGO, COLORADO	SEC. 33, T. 11 S., R. 53 W.	0.124 AC.	0.124 AC.			TE-2	For Constructing a C.B.C. With Wingwalls. Acquired under CX BRF 33-0040-06			
				5 400 SQ. FT.	5 400 SQ. FT.							
TE-3	ALMEDA ANN CLAY	HUGO, COLORADO	SEC. 3, T. 12 S., R. 53 W.	5.432 AC.	5.432 AC.			TE-3	For Constructing a Temporary Detour. Acquired under CX BRF 33-0040-07			
				236 625 SQ. FT.	236 625 SQ. FT.							
TE-4	DELETED											
TE-5	ALMEDA ANN CLAY	HUGO, COLORADO	SEC. 3, T. 12 S., R. 53 W.	0.138 AC.	0.138 AC.			TE-5	For Constructing a C.B.C. With Wingwalls. Acquired under CX BRF 33-0040-07			
				6 000 SQ. FT.	6 000 SQ. FT.							

PLAN	SURVEYED	BY	DATE
NOTE BOOK	PLOTTED ALIGNMENT CHECKED RT. OF WAY CHECKED		
NO. _____			

DRAWING		BY		DATE	
PROJECT					
SHEET NO.					
TITLE					
REVISION					
APPROVED					
CHECKED					
NOTED					
DATE					

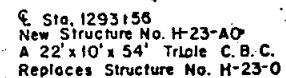

AS CONSTRUCTED

NO REVISIONS REVISED



P.E. & ROW PRELIM. UNDER BR# 040-8(II) &
BR# 040-8(12)

FED. ROAD REGION	DIVISION	COMBINED PROJ. NO.	SHEET NO.
VIII	COLO.	CX BRF 33-0040-06 CX BRF 33-0040-07	3

305

REVISIONS	
1-5-87	Rev TE lies

310

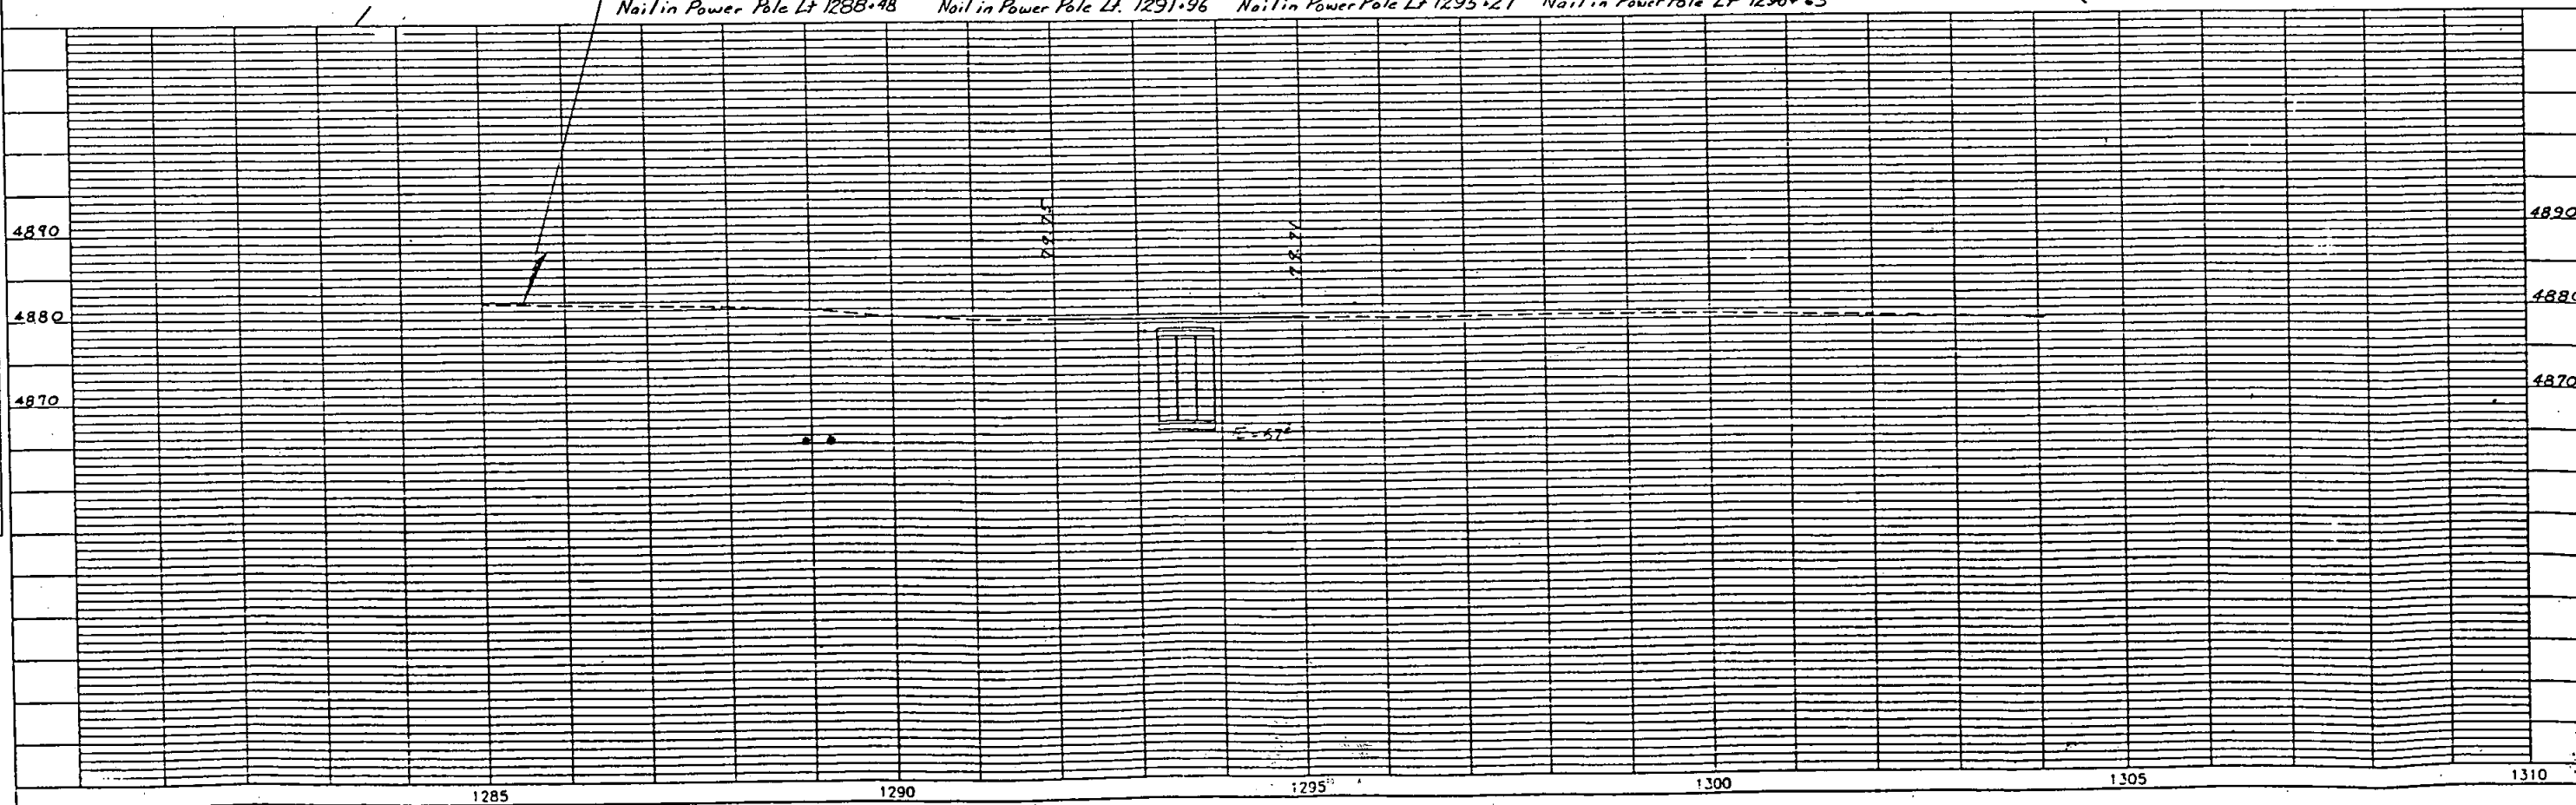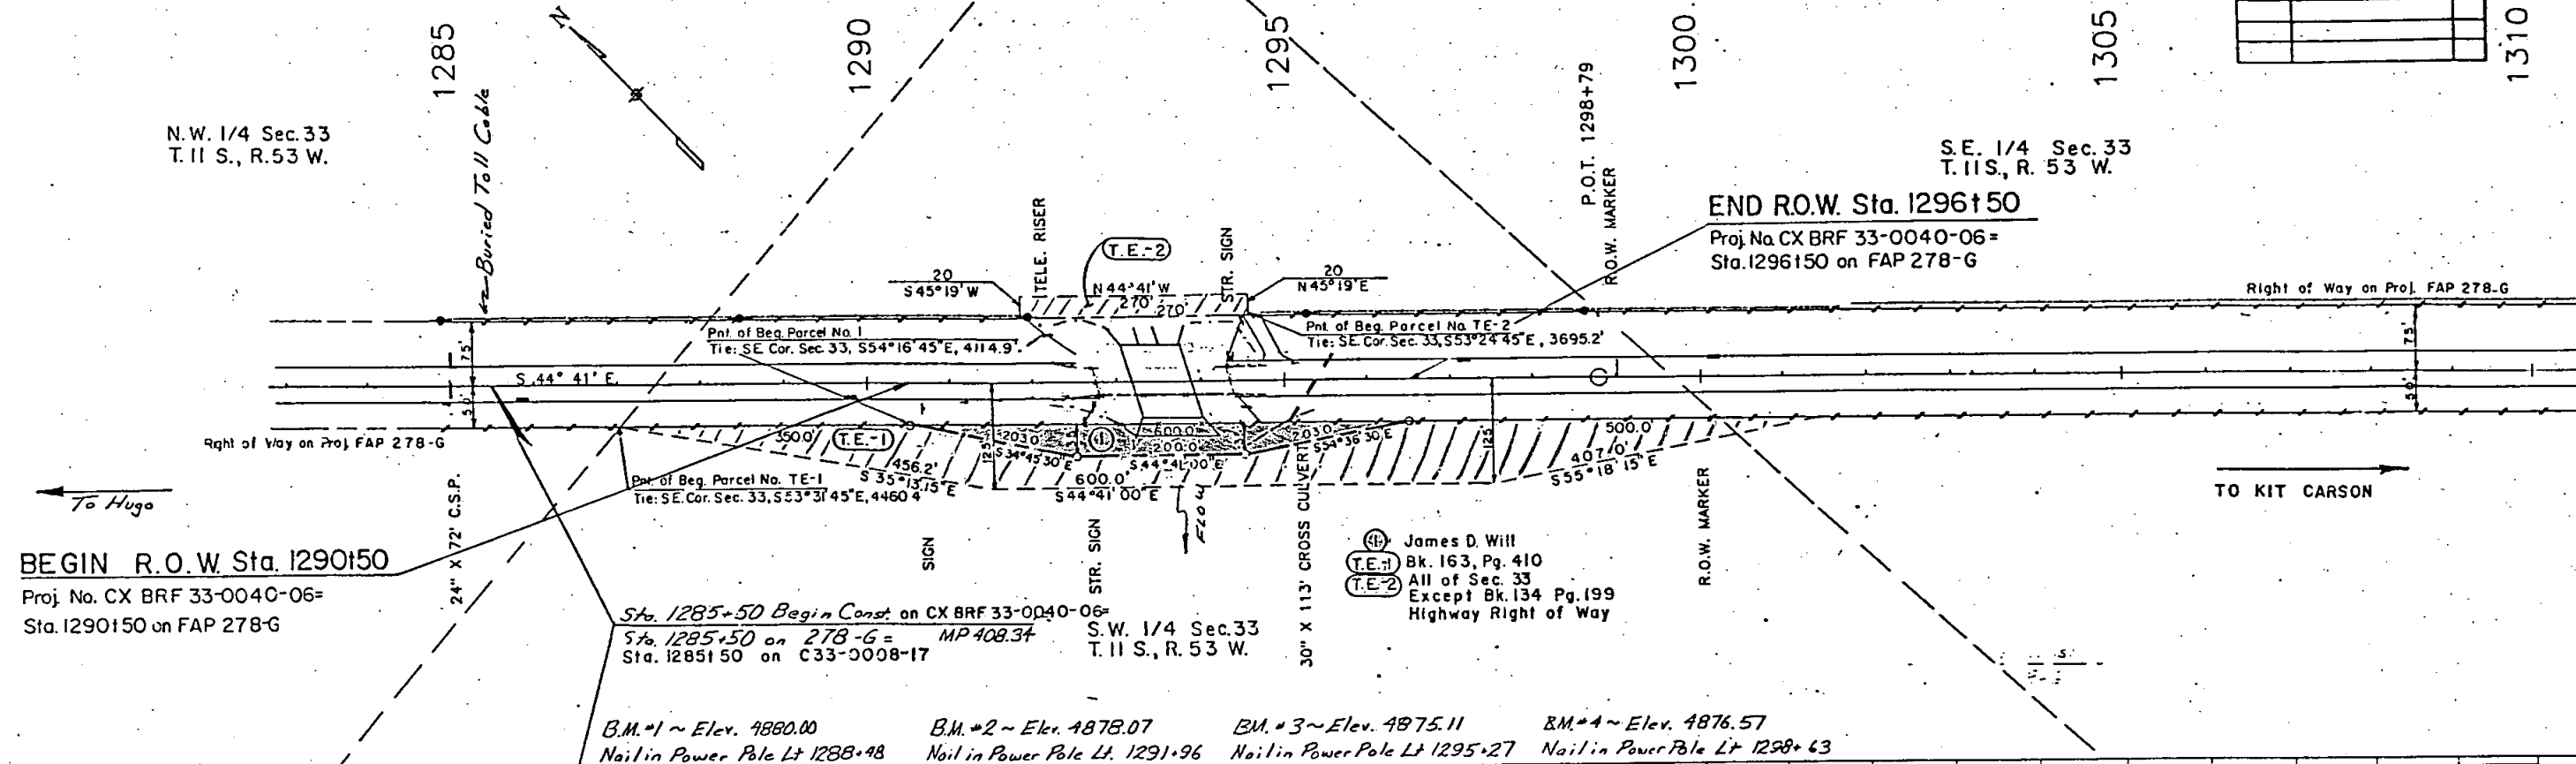


PROJ. NO. 134-07
SHEET NO. 4
DATE
BY
SURVEYED
PLANNED
NOTED
NO.

NO. 09/19/85 11:11:08
D.J.M. : (U)XIN P.J. 85092 RONY H.06 PPS) BRF-073
DATE
BY
SURVEYED
PLANNED
NOTED
NO.

P.E. & R.O.W. PRELIM. UNDER
BRF 040-8(1) 8
SRFG 40-8 (12)

AS CONSTRUCTED
NO REVISIONS ☐ REVISED ☐ VOID ☐

FED. ROAD REGION	DIVISION	COMBINED PROJ. NO.	SHEET NO.
VIII	COL.	CX BRF 33-0040-06 CX BRF 33-0040-07	4

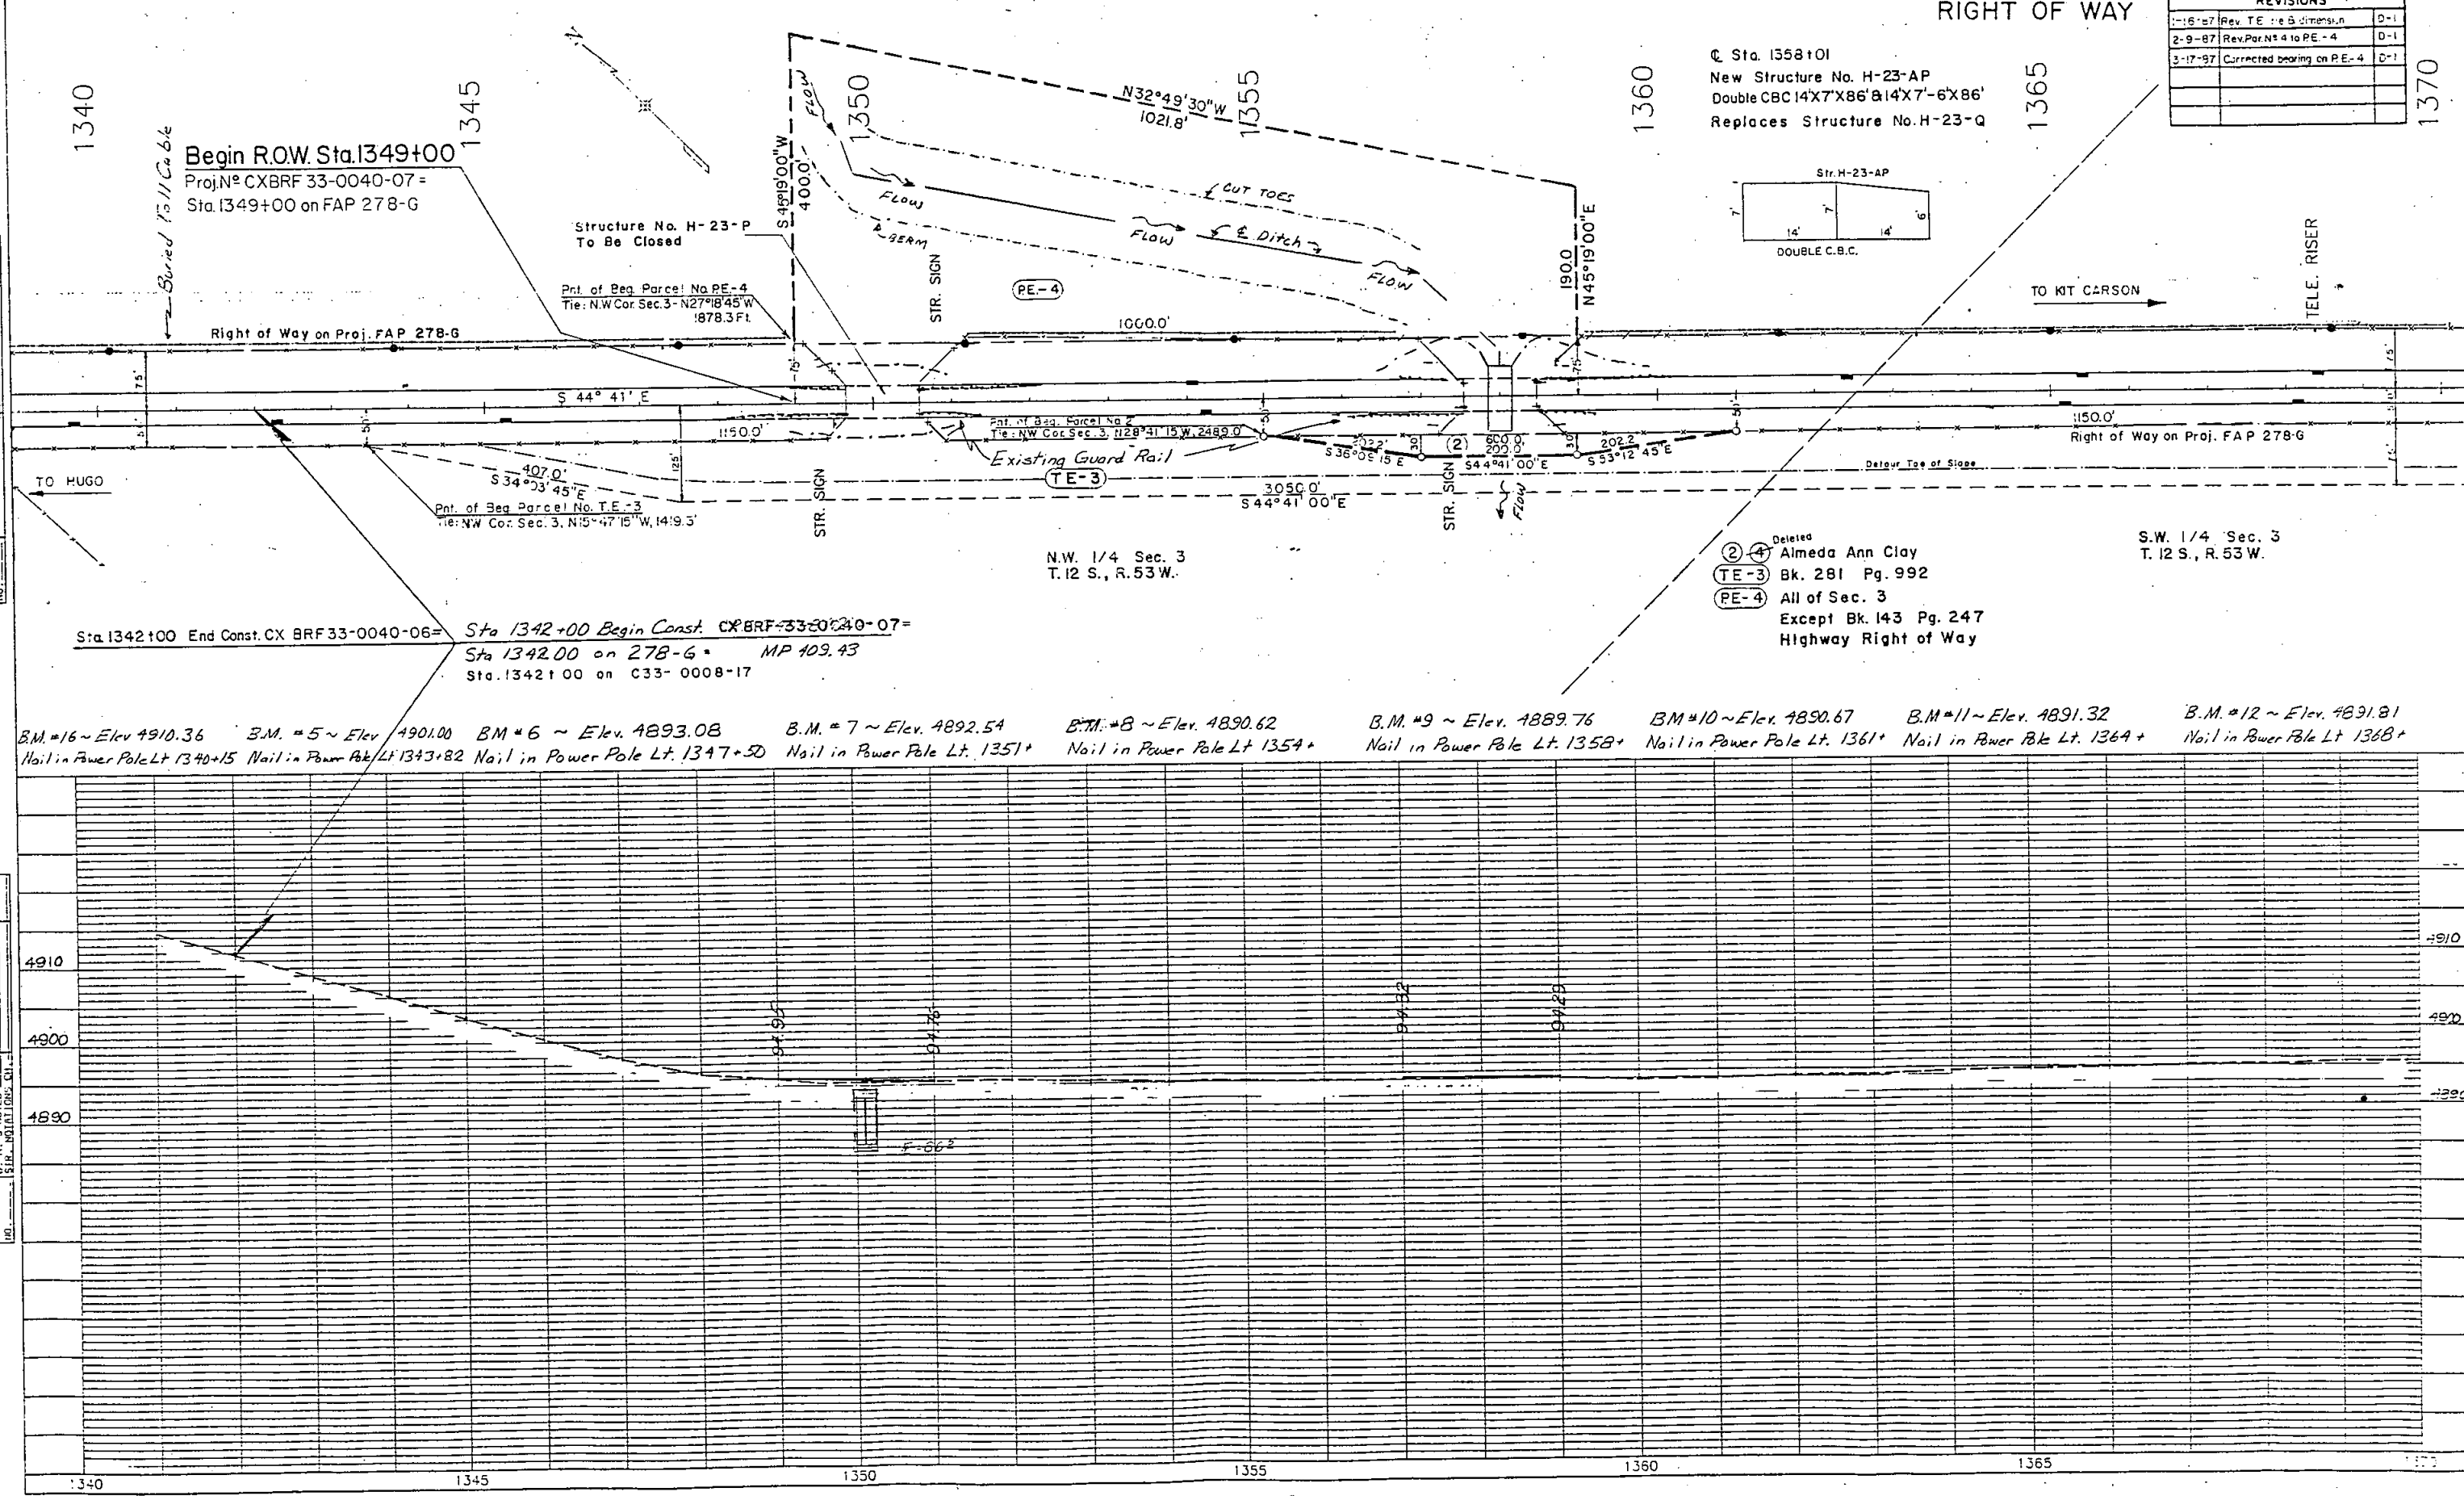

STATE HIGHWAY NO. 40
LINCOLN COUNTY

FEDERAL ROAD REGION NO.	DIVISION	COMB. PROJ. NO.	SHEET NO.	TOTAL SHEETS
VIII	COLORADO	CX BRF 33-0040-06 CX BRF 33-0040-07	6	6

REVISIONS		
2-9-87	Rev. For N° 4 to PE-4	D-1

RIGHT OF WAY
OWNERSHIP MAP
SCALE: 1" = 500'

0 250 500 750 1000 1250



JAMES D. WILL
ALL OF SECTIONS
27, 29, AND 33
T. 11 S., R. 53 W.

STANBERT E. CLAY AND
ALICE A. CLAY
ALL OF SECTION 34
T. 11 S., R. 53 W.

NOTE: Field ties are from
proj. FAP 278-G

Begin Construction
Sta. 1285+50 on CX BRF 33-0040-06

End Construction
Sta. 1342+00.0 on CX BRF 33-0040-06

Begin Right Of Way
Sta. 1290+50 on CX BRF 33-0040-06=
Sta. 1290+50 on FAP 278 G=
Sta. 1290+50 on C33-0008-17

End Right Of Way
Sta. 1296+50 on CX BRF 33-0040-06=
Sta. 1296+50 on FAP 278 G=
Sta. 1296+50 on C33-0008-17

ALMEDA ANN CLAY
ALL OF SECTION 3
T. 12 S., R. 53 W.

Begin Construction
Sta. 1342+00 on CX BRF 33-0040-07

End Construction
Sta. 1383+75.10 on CX BRF 33-0040-07

Begin Right Of Way
Sta. 1349+00 on CX BRF 33-0040-07=
Sta. 1349+00 on FAP 278 G=
Sta. 1349+00 on C33-0008-17

End Right Of Way
Sta. 1378+50 on CX BRF 33-0040-07=
Sta. 1378+50 on FAP 278 G=
Sta. 1378+50 on C33-0008-17

