

AS CONSTRUCTED

NO. REVISIONS 5-20-84

REVISED

VOID

FEDERAL ROAD REGION NO.	DIVISION	PROJECT NO.	SHEET NO.	TOTAL SHEETS
VIII	COLORADO	CXFC 06-0036-05	2	

Plan No.	Title	Page
☒ M-100-1	STANDARD SYMBOLS.....	1
☐ M-107-1	TEMPORARY EROSION CONTROL.....	2
☒ M-203-1	APPROACH ROADS, FLARING, CUT SLOPE TREATMENT, BRIDGE & CREST WIDENING.....	3
☐ M-203-2	DITCH TYPES.....	4
☐ M-203-10	SUPERELEVATION OF CURVES - CROWNED HIGHWAYS.....	5
☐ M-203-11	SUPERELEVATION OF CURVES - DIVIDED HIGHWAYS - SHOULDER PIVOT.....	6
☐ M-203-12	SUPERELEVATION OF CURVES - STREETS.....	7
☐ M-203-13	SUPERELEVATION OF CURVES - DIVIDED HIGHWAYS - CENTER PIVOT.....	8
☒ M-206-1	EXCAVATION AND BACKFILL FOR STRUCTURES.....(2 SHEETS)	9
☐ M-206-2	EXCAVATION AND BACKFILL FOR BRIDGES.....	11
☐ M-214-1	PLANTING DETAILS.....	12
☐ M-412-1	CONCRETE PAVEMENT JOINTS.....	13
☐ M-504-1	STEEL CRIBBING.....	14
☐ M-506-1	GABIONS AND SLOPE MATTRESS.....	15
☐ M-510-1	STRUCTURAL PLATE CULVERT PIPE - H-20 LOADING.....(2 SHEETS)	16
☐ M-601-1	SINGLE CONCRETE BOX CULVERT.....	18
☐ M-601-2	DOUBLE CONCRETE BOX CULVERT.....	19
☐ M-601-3	TRIPLE CONCRETE BOX CULVERT.....	20
☐ M-601-10	HEADWALL FOR PIPE CULVERTS.....	21
☐ M-601-11	TYPE "S" SADDLE HEADWALL FOR PIPE CULVERTS.....	22
☐ M-601-12	HEADWALL, INTERCEPTING HEADWALL AND CULVERT OUTLET PAVING.....	23
☐ M-601-20	WINGWALLS FOR PIPE OR BOX CULVERTS.....	24
☒ M-603-1	METAL CULVERT PIPE - H-20 LOADING.....(2 SHEETS)	25
☒ M-603-2	REINFORCED CONCRETE PIPE.....	27
☐ M-603-3	PRECAST CONCRETE BOX CULVERT.....	28
☐ M-603-10	CONCRETE AND METAL END SECTIONS.....	29
☐ M-604-1	PIPE SEWER IN TRENCH.....	30
☒ M-604-10	INLET, TYPE C.....	31
☐ M-604-11	INLET, TYPE D.....	32
☐ M-604-12	CURB INLET, TYPE R.....(2 SHEETS)	33
☐ M-604-13	CONCRETE INLET, TYPE 13.....	35
☐ M-604-20	MANHOLES.....	36
☒ M-604-21	STEPS FOR MANHOLES & INLETS.....	37
☐ M-606-1	GUARD RAIL, TYPE 3, W-BEAM.....(8 SHEETS)	38
☐ M-606-2	GUARD RAIL, TYPE 3, W-BEAM FOR LOCAL ROADS & STREETS.....(4 SHEETS)	46
☐ M-606-10	GUARD RAIL, TYPE 4, CONCRETE BARRIER, CAST-IN-PLACE.....	50
☐ M-606-11	GUARD RAIL, TYPE 4, CONCRETE BARRIER, PRECAST-PORTABLE.....	51

Plan No.	Title	Page
☐ M-607-1	WIRE FENCES AND GATES.....	(2 SHEETS) 52
☐ M-607-2	CHAIN LINK FENCE.....	(3 SHEETS) 54
☐ M-607-3	BARRIER FENCE.....	57
☐ M-607-4	DEER FENCE AND GATE.....	(2 SHEETS) 58
☐ M-607-10	PICKET SNOW FENCE.....	60
☒ M-608-1	CURB RAMPS.....	61
☒ M-609-1	CURBS AND GUTTERS.....	62
☐ M-611-1	CATTLE GUARD - WELDED GRILL UNITS - 10' THRU 42' ROADWAYS.....	(2 SHEETS) 63
☐ M-613-1	HIGHWAY LIGHTING.....	(2 SHEETS) 65
☐ M-615-1	EMBANKMENT PROTECTOR, TYPES 3 & 4.....	67
☐ M-615-2	EMBANKMENT PROTECTOR, TYPE 5.....	68
☐ M-616-1	INVERTED SIPHON.....(ALSO USE M-603 OR M-604 AS REQUIRED)	69
☐ M-620-1	FIELD LABORATORY - CLASS 1.....	70
☐ M-620-2	FIELD LABORATORY - CLASS 2.....	71
☐ M-620-11	FIELD OFFICE - CLASS 1.....	72
☐ M-620-12	FIELD OFFICE - CLASS 2.....	73

Plan No.	Title	Page
☐ S-612-1	TYPICAL DELINEATOR INSTALLATIONS.....	(4 SHEETS) 75
☒ S-614-1	TYPICAL GROUND SIGN PLACEMENT.....	79
☒ S-614-2	CLASS I GROUND SIGN INSTALLATIONS.....	80
☒ S-614-3	CLASS II GROUND SIGN INSTALLATIONS.....	81
☒ S-614-4	CLASS III SIGNS, LAMINATED ALUMINUM PANELS AND POST SPACING TABLE.....(2 SHEETS)	82
☐ S-614-5	BREAK-AWAY SIGN SUPPORT DETAILS FOR GROUND SIGNS.....(2 SHEETS)	84
☐ S-614-6	CONCRETE FOOTINGS AND SIGN ISLANDS FOR CLASS III SIGNS.....(2 SHEETS)	86
☒ S-614-10	TYPICAL MARKER ASSEMBLY INSTALLATIONS.....	88
☐ S-614-11	MILEPOST SIGN AND INSTALLATION.....	89
☐ S-614-12	STRUCTURE NUMBER INSTALLATION (BRIDGE INFORMATION SHEET).....	90
☐ S-614-13	STANDARD RAILROAD CROSSING SIGNS AND MARKINGS.....	91
☐ S-614-20	TYPICAL POLE MOUNT SIGN INSTALLATION.....	92
☐ S-614-21	CONCRETE BARRIER SIGN POST INSTALLATIONS.....	93
☐ S-614-22	TYPICAL MULTI-SIGN INSTALLATIONS.....	94
☐ S-614-30	INTERSTATE ROUTE MARKERS.....	95
☒ S-614-31	U. S. & COLORADO ROUTE MARKERS.....	96
☒ S-614-32	AUXILIARY MARKERS.....	97
☒ S-614-40	TRAFFIC SIGNAL INSTALLATION DETAILS...(3 SHEETS)	98
☒ S-614-50	TRAFFIC CONTROLS FOR HIGHWAY CONSTRUCTION.....(4 SHEETS)	101
☒ S-614-51	BARRICADES, DRUMS, CONCRETE BARRIER (TEMP) & VERTICAL PANELS.....	105
☒ S-627-1	TYPICAL PAVEMENT MARKINGS.....(3 SHEETS)	106

THE STANDARD PLAN SHEETS INDICATED HEREON BY A MARKED BOX ARE TO BE USED TO CONSTRUCT THIS PROJECT.

DEPARTMENT OF HIGHWAYS
STATE OF COLORADO
DIVISION OF HIGHWAYS

STANDARD PLANS LIST


M & S STANDARDS ~ JANUARY, 1982

TYPICAL SECTION

THE DEPTH AND WIDTH OF THE SIDE DITCH SHALL BE VARIED WHERE NECESSARY IN ORDER TO PROVIDE PROPER DRAINAGE.


S.H. 36

Section A - Sta. 1110+00 TO 1123+00

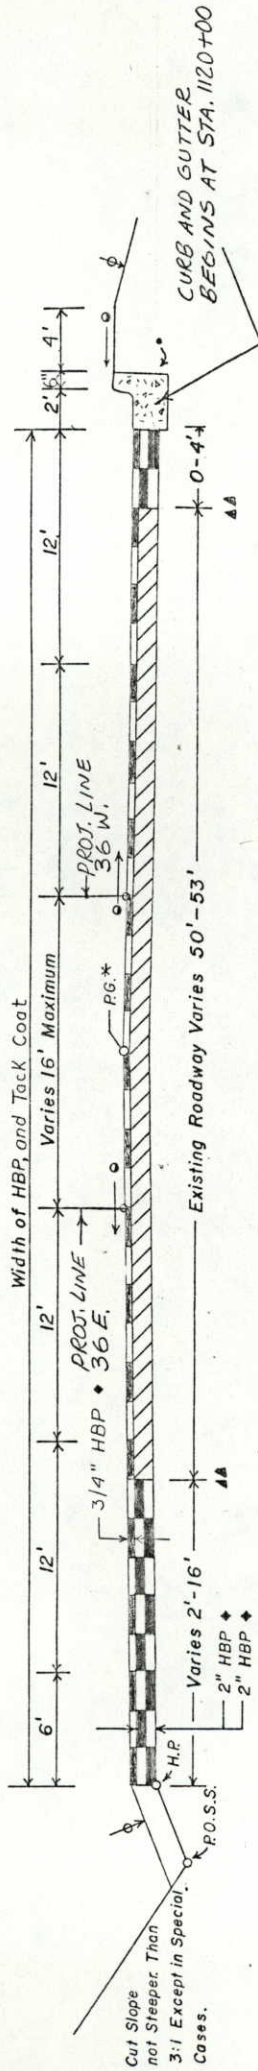


S. H. 36

Section B Sta. 1123+00 TO 1127+00 AND
1133+00 TO 1138+00

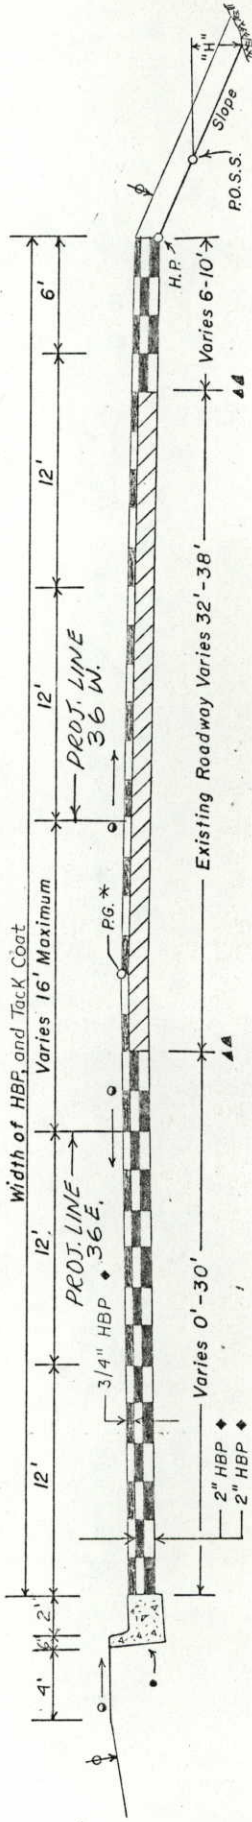


S.H. 36

Section C Sta. 1127+00 TO 1130+20
Sta. 1127+00 TO 1133+00 Tapers to Sect. B

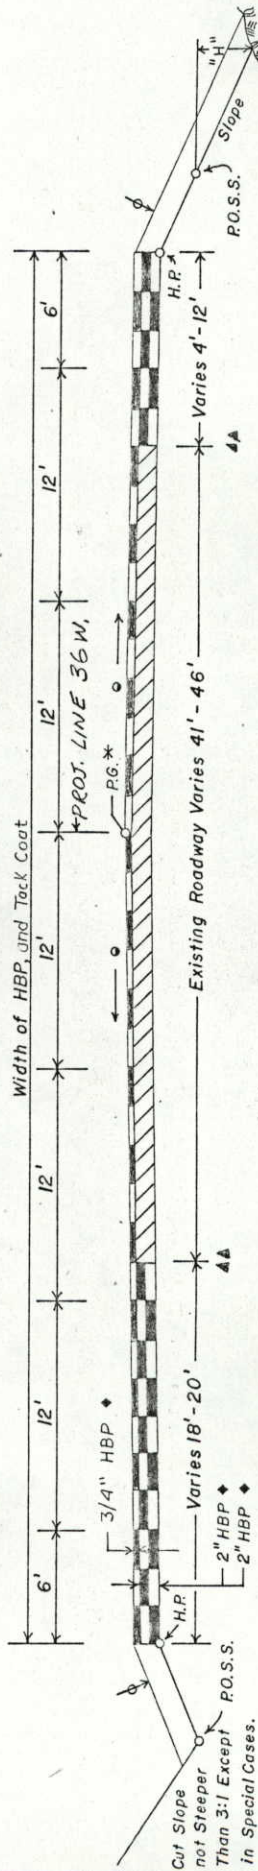

S. H. 7

Section D Sta. 2103+00-2105+45

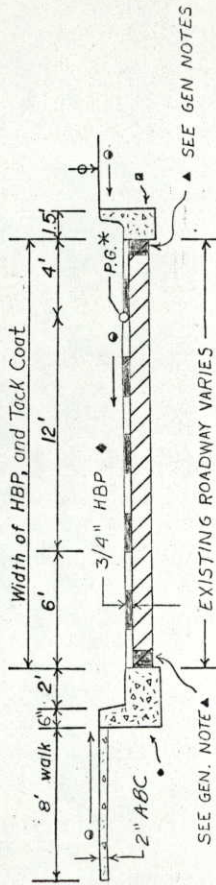

SEE GEN NOTES

P.G.	-	PROFILE GRADE
H.P.	-	HINE POINT
P.O.S.S.	-	POINT OF SLOPE SELECTION.
◆		APPROXIMATE THICKNESS
◆		SLOPE 0.02 FT./FT. OR MATCH EXISTING SLOPE
□		CURB AND GUTTER (TYPE 2) (SECTION IB)
●		CURB AND GUTTER (TYPE 2) (SECTION IIB)

THE CONTRACTOR WILL BE REQUIRED TO PLACE TOPSOIL TO THIS LINE AFTER COMPLETION OF THE PAVING OPERATION.

LOCATION OF CROWN POINT VARIES. ELEVATION TO BE THICKNESS OF TOP LIFT ABOVE EXISTING PAVEMENT.

FILL SLOPES:
SLOPE 6:1 WHERE "H" IS LESS THAN 4'
SLOPE 4:1 WHERE "H" IS 4' TO 10'
SLOPE 3:1 WHERE "H" IS OVER 10'
IN SPECIAL CASES, SLOPE MAY BE STEEPENED.

IT IS ESTIMATED THAT 80 GALLONS OF PAVEMENT MARKING PAINT WILL BE REQUIRED FOR THIS PROJECT AS FOLLOWS:

WHITE:	45 GALLONS
YELLOW:	35 GALLONS

	LAYER	THICKNESS	SECTION				TENS
			A	B	C	D	
	LIFT 3	3/4" HBP	35	23	23	11	
	LIFT 2	2" HBP	VARIABLES	VARIABLES	VARIABLES	VARIABLES	
	LIFT 1	2" HBP	VARIABLES	VARIABLES	VARIABLES	VARIABLES	

THE RATES SHOWN HAVE BEEN DETERMINED FROM INFORMATION AVAILABLE AT THE TIME OF DESIGN. RATES SHOULD BE ADJUSTED DURING CONSTRUCTION TO OBTAIN THE DESIRED APPROXIMATE THICKNESS.

SUMMARY OF APPROXIMATE QUANTITIES

AS CONSTRUCTED		FED. ROAD REGION		DIVISION		PROJ. NO.		SHEET NO.	
NO REVISIONS		XVIII		COLD.		CXFC 06-0036-05		4	
REVISED 5-20-89		VOID							

INDEX	CONTRACT ITEM NO.	CONTRACT ITEM	UNIT													PROJECT TOTALS		DIFF. +/- PLAN
																PLAN	AS CONST.	
FORM 305's	202	REMOVAL OF STRUCTURE	EACH													1	1	- 100
	202	REMOVAL OF PIPE	EACH													1	1	- 100
	202	REMOVAL OF CURB AND GUTTER	LIN.FT.													1117	1117	- 100
	202	REMOVAL OF PAVEMENT MARKING	SQ.FT.													2698	1120	-578 42
	202	REMOVAL OF GROUND SIGN	EACH													43	55	+12 128
	202	REMOVAL OF GUARD RAIL TYPE 3	LIN.FT.													54	0	-54 0
	203	UNCLASSIFIED EXCAVATION (COMPLETE IN PLACE)	CU.YD.													1592	1007	-585 63
	207	TOPSOIL (HAUL)	CU.YD.													932	1239	+307 133
	210	RESET GROUND SIGN	EACH													1	2	+1 200
	212	SEEDING (NATIVE)	ACRE													0.5	1.3	+8 260
	213	MULCHING DELETED BY M.C.R. LINE 5 (CMO #1)	ACRE													0.5	0	-5 0
	304	AGGREGATE BASE COURSE (CLASS 6) (HAUL) CMO #1	TON													70	0	-70 0
	403	HOT BITUMINOUS PAVEMENT (GRADING EX) (HAUL AND ASPHALT)	TON													2467	2838	+371 115
	411	EMULSIFIED ASPHALT (SLOW-SETTING)	GAL.													1444	873	-571 60
	604	INLET TYPE C (5 FOOT)	EACH													2	2	- 100
	608	CONCRETE CURB RAMP	SQ.YD.													4	17	+13 425
	609	CURB AND GUTTER TYPE 2 (SECTION I-B)	LIN.FT.													485	737	+252 152
	609	CURB AND GUTTER TYPE 2 (SECTION II-B)	LIN.FT.													2479	2069	-410 83

SUMMARY OF APPROXIMATE QUANTITIES

AS CONSTRUCTED		DIVISION		PROJ. NO.		SHEET NO.	
NO. REVISIONS		COLLO.		CXFC 06-0036-05		5	
REVISED 15-20-89		VIII					
VOID							

INDEX	CONTRACT ITEM NO.	CONTRACT ITEM	UNIT	PROJECT TOTALS			DIFF. +/-	% PLAN
				PLAN	AS CONST.			
FORM 305's	613	1-1/2 INCH ELECTRICAL CONDUIT	LIN.FT.	350	318	-32	91	
	613	3 INCH ELECTRICAL CONDUIT	LIN.FT.	400	230	-170	58	
	614	FLAGGING	HR.	750	410.5	-339.5	55	
	614	TRAFFIC CONTROL SUPERVISOR	DAY	30	35	+5	117	
	614	SIGN PANEL (CLASS I)	SQ.FT.	121	131	+10	108	
	614	SIGN PANEL (CLASS II)	SQ.FT.	78	77	-1	99	
	614	SIGN PANEL (CLASS III)	SQ.FT.	165	165	-	100	
	614	TIMBER SIGN POST 4 x 4 INCH	LIN.FT.	275	355	+80	129	
	614	TIMBER SIGN POST 6 x 6 INCH	LIN.FT.	327	302	-25	92	
	614	LOOP DETECTOR WIRE	LIN.FT.	2750	2558	-192	93	
	614	TRAFFIC SIGNAL FACE (12-8-8) (INSTALL ONLY)	EACH	4	4	-	100	
	614	TRAFFIC SIGNAL FACE (12-12-12) (INSTALL ONLY)	EACH	6	6	-	100	
	614	TRAFFIC SIGNAL FACE (12-12-12-12) (INSTALL ONLY)	EACH	1	1	-	100	
	614	TRAFFIC SIGNAL CONTROLLER (INSTALL ONLY)	EACH	1	1	-	100	
	614	PEDESTRIAN PUSH BUTTON (INSTALL ONLY)	EACH	4	4	-	100	
	614	CONSTRUCTION TRAFFIC SIGN (PANEL SIZE A)	EACH	2	0	-2	0	
614	CONSTRUCTION TRAFFIC SIGN (PANEL SIZE B)	EACH	18	14	-4	78		
614	DRUM CHANNELIZING DEVICE (WITH LIGHT) (STEADY BURN)	EACH	50	50	-	100		
614	TRAFFIC CONE	EACH	100	100	-	100		

SEEDING PLAN

SEEDING, SOIL PREPARATION, FERTILIZING WITH COMMERCIAL FERTILIZER, AND MULCHING WILL BE REQUIRED FOR APPROXIMATELY 0.5 ACRES WILL BE REQUIRED. THE FOLLOWING TYPES AND RATES SHALL BE USED:

COMMON NAME	BOTANICAL NAME	RATE PLS/ACRE POUNDS
SHEEP FESCUE	FESTUCA OVINA	1.0
BLUE GRAMA	BOUTELOUCA GRACILIS	1.0
ALKALI SACATON	SPOROBOLUS AIROIDES	0.25
CORN POPPY	PAPAYER RHOEAS	0.25
COSMOS	COSMOS BIPINNATUS	0.50
TOTAL POUNDS/PLS/ACRE SEEDING		3.00

MIX GRASS, CORN POPPY AND COSMOS AND SEED ENTIRE MEDIAN AREAS EVENLY.

WILDFLOWER SEED APPLICATION

COMMON NAME	BOTANICAL NAME	RATE PLS/ACRE POUNDS
ROCKY MTL. PENSTEMON	PENSTEMON STRICTUS	0.50
PRAIRIE CONEFLOWER	RATIBIDA COLUMNIFERA	0.25
SWEET WILLIAM	DIANTHUS BARBATUS	0.25
BLUE FLAX	LINUM LEWISII	0.50
TOTAL POUNDS/PLS/ACRE SEEDING		1.50

DO NOT MIX THESE SEEDS, BUT APPLY IN INDIVIDUAL SWATHES BY HAND AS FOLLOWS:
SWEET WILLIAM CLOSEST TO CURBING
BLUE FLAX NEXT
PRAIRIE CONEFLOWER NEXT TO BLUE FLAX
PENSTEMON IN THE CENTER OF MEDIAN
RAKE ENTIRE MEDIAN, BURYING THE SEED TO A DEPTH OF .25" TO .50"

MULCHING MATERIAL	STRAW	1.5 TONS PER ACRE
-------------------	-------	-------------------

HAND PLACE 1 1/2 TONS/ACRE STRAW AND CRIMP WITH A SHOVEL

COMMERCIAL FERTILIZER	RATE LBS/ACRE AVAILABLE
AVAILABLE N	10
AVAILABLE P	10
AVAILABLE K	10

THIS SEEDING PLAN IS TO BE USED FOR THE ISLANDS.

PROJECT TOTALS	SEEDING	(4.75 LBS/ACRE)	2.5 LBS
	MULCHING	(1.50 TONS/ACRE)	0.75 TONS
TOTALS (FOR INFORMATION ONLY)			
	FERTILIZER	(AVAILABLE N)	5.0 LBS
	FERTILIZER	(AVAILABLE P)	5.0 LBS
	FERTILIZER	(AVAILABLE K)	5.0 LBS

REMOVAL OF GUARD RAIL

LOCATION	SIDE	GUARDRAIL TYPE 3 LIN. FT.
SH 36		
1127+77 TO 1128+31	L	54
TOTAL		540

SUMMARY OF EARTHWORK QUANTITIES

BOOK	PAGE	SHEET	INDEX	DESCRIPTION	PROJECT TOTALS
				UNCLASSIFIED EXCAVATION *	PLAN FINAL
				ROADWAY (FROM CROSS SECTIONS)	1592 1592
				TOTAL	
				TOPSOIL	
				TOPSOIL (HAUL)	932 1239
				FOR INFORMATION ONLY	
				EMBANKMENT MATERIAL (CIP) **	
				ROADWAY (FROM CROSS SECTIONS)	841 841
				TOTAL	
				ROADWAY QUANTITIES BALANCE	
				EXCAVATION	1592 1592
				UNCLASSIFIED	1592 1007
				TOTAL	
				EMBANKMENT (NET)	841 841
				ROADWAY (FROM CROSS SECTIONS)	
				TOTAL	
				EMBANKMENT X FACTOR (1.20)	1010 1010
				ROADWAY (FROM CROSS SECTIONS)	582 582
				EXCESS EXCAVATION	1592 1007
				TOTAL	1007 1007

* REMOVAL OF ASPHALT MAT INCLUDED IN COST OF UNCLASSIFIED EXCAVATION
** COMPACTION AASHTO T99

TABULATION OF CURB AND GUTTER

LOCATION	REMOVAL OF C&G		C&G TYPE 2 (SECT I B)		C&G TYPE 2 (SECT II B)	
	SIDE	LIN. FT.	SIDE	LIN. FT.	SIDE	LIN. FT.
SH 36 X *						
1119+50 TO 1130+00					RT.	1524
1123+37 TO 1125+10	LT.	280			LT.	1466
1123+45 TO 1126+29						170
1125+50 TO 1127+16					LT.	167
1126+20 TO 1126+40	LT.	82				165
SH 7						
2099+15 TO 2100+90					LT.	229
2101+40 TO 2103+30 *					LT.	186
2101+57 TO 2103+60					LT.	329
2101+83 TO 2104+77	RT.	305			RT.	240
2103+07 TO 2105+45			LT.	231		
2104+40 TO 2105+25	LT.	117		506		
WEST ISLAND RAMP (FROM SH 7)						
2101+55 TO 2102+88			RT.	245		
2101+88 TO 2102+76	RT.	265			LT.	135
2103+00 TO 2104+05						
2104+40 TO 2104+93	LT.	68				
SUBTOTAL		1117		737.85		2479
TOTAL		1117		737.85		5029

* BASED ON PROJ.36 W ALIGNMENT
** S.H. 36 ALIGNMENT

AS CONSTRUCTED

NO REVISIONS [] REVISED [5-20-87] VOID []

FED. ROAD REGION	DIVISION	PROJ. NO.	SHEET NO.	SHEET TOTALS
VIII	COLO.	CXFC 06-0036-05	7	

SURFACING PLAN




SOURCE	LOCATION	TYPICAL SECTION	LENGTH (STA.)	QUANTITY - TONS			
				LIFT 3	LIFT 2	LIFT 1	H/A
CONTRACTOR SOURCE	109+00	APPROACH	2.00	37	12	12	
	111+00	A	6.50	179	53	53	
	117+50	A	2.50	75	52	52	
	1120+00	A	1.20	36	9	9	
	1121+20	A	2.10	66	9	9	
	1123+30	B	3.70	112	142	142	
	1127+00	C	3.20	106	72	72	
	1130+20	C TO B	2.80	81	54	54	
	1133+00	B	5.00	97	49	49	
	1138+00						
	S.H. 7						
	2099+00	APPROACH	4.00	117			
	2103+00	D	2.00	21			
	2105+00						
RAMP TO EAST S.H. 36				47	39	39	
RAMP TO WEST S.H. 36				11	38	38	
EST. FOR ROAD APPR. *							
EST. FOR IRREGULARITIES				147			
SIDEWALK							
SUBTOTAL				1127	529	529	
TOTAL					2511	2838	

STABILIZATION BASED ON:
1. 18K ESAL SH 36 (INT. SH 7 WEST)
18K ESAL SH 36 (INT. SH 7 EAST)
18K ESAL SH 7
2. REGIONAL FACTOR
3. SERVICEABILITY INDEX
4. SUBGRADE "R" VALUE
STRENGTH COEFFICIENTS:
5. HBP GR. EX
* ESTIMATED FOR:
6 CITY ROAD APPR.
3 PRIVATE APPR.

TRAFFIC SIGNAL PLAN
S.H. 7 & S.H. 36
-Estes Park-


AS CONSTRUCTED
NO REVISIONS 5-20-84 REVISED 5-20-84 VOID 5-20-84

FED. ROAD REGION VIII
DIVISION COLO.
PROJ. NO. CXFC 06-0036-05
SHEET NO. 11
SHEET TOTALS

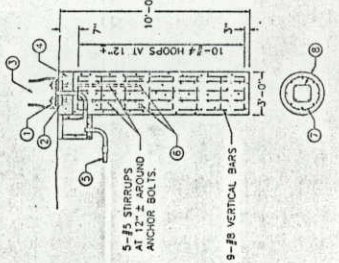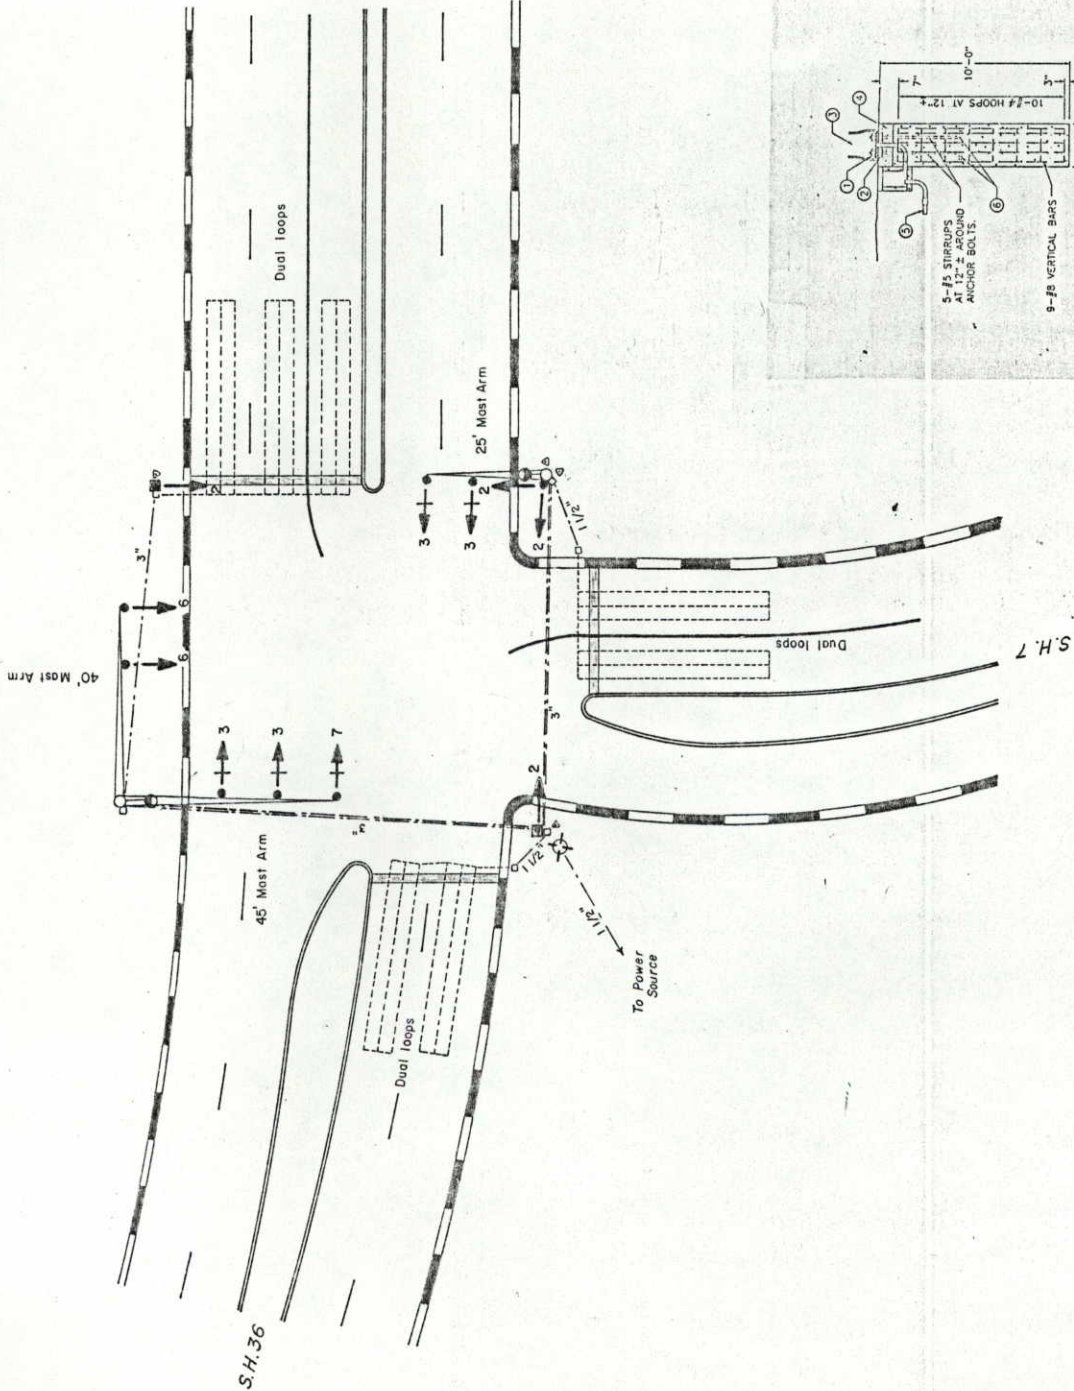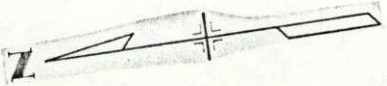

NOTE: THIS DETAIL SHALL BE USED FOR TRAFFIC SIGNAL POLE FOOTINGS IN LIEU OF DETAILS FROM STANDARD SPECIFICATIONS REFERRED TO STANDARD 3-614-90 FOR FOOTING NOTES.


PHASING

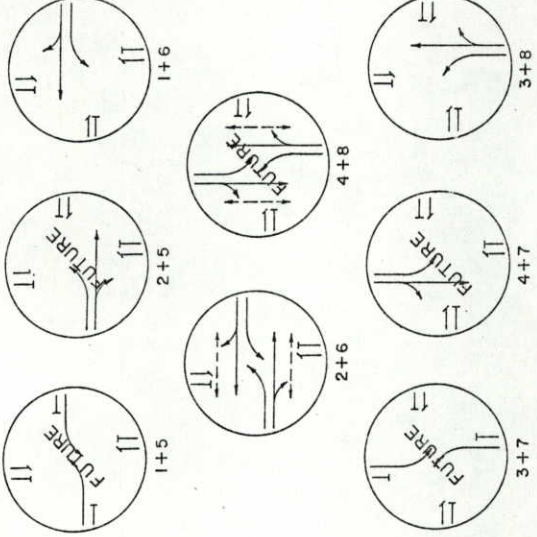

NOTES

1. Traffic signals mounted on mast arms shall be furnished with astro type mounting brackets (supplied by State).
2. Controller shall be a Type 170. Controller cabinet shall be a Model 332 (supplied by State)
3. Luminaires shall be 47,000 Lumen, 400 Watt HPS with cut-off lenses. (Supplied and installed by the town)
4. Conduit shall be Schedule 80 PVC.
5. Detector loops shall be installed prior to final lift.
6. Each signal pole shall have a pull box at the foundation of the pole (see typical footing detail). Conduit from pull box to pole base shall be 2".

FACES

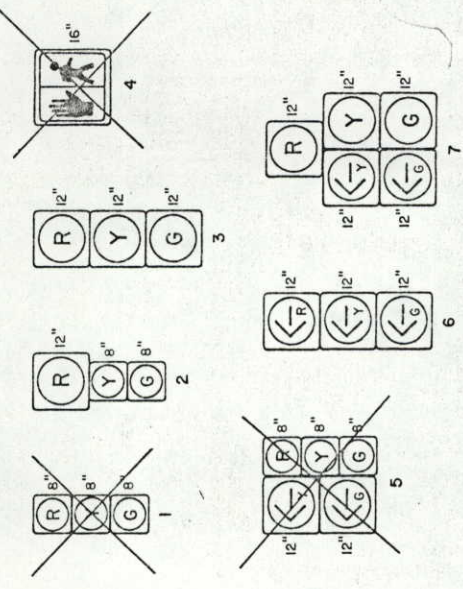


TABULATION OF QUANTITIES

ITEM NO.	ITEM DESCRIPTION	UNIT	QUANTITY
613	1-1/2 IN ELEC COND	LIN. FT.	318
613	3 IN ELEC COND	LIN. FT.	230
614	PEDESTRIAN PUSH BUTTON (INSTALL ONLY)	EACH	4
614	TRAF SIG (12-8-8) (INSTALL ONLY)	EACH	4
614	TRAF SIG (12-12-12) (INSTALL ONLY)	EACH	6
614	TRAF SIG (12-12-12-12) (INSTALL ONLY)	EACH	1
614	LOOP DETECTOR WIRE	LIN. FT.	2750
614	SIG-LIGHT POLE S (1) (INSTALL ONLY)	EACH	1
614	SIG-LIGHT POLE S (2) (INSTALL ONLY)	EACH	1
614	TRAF SIG PEDESTAL POLE S (INSTALL ONLY)	EACH	2
614	CONTROLLER (TYPE 170) (INSTALL ONLY)	EACH	1

LEGEND

- Existing
- New
- Traffic Signal Pole with Mast Arm
- Traffic Signal Span Wire Pole
- Pedestal Pole
- Traffic Signal Face
- Traffic Signal Face with Backplate
- Pedestrian Signal Face
- Controller and Cabinet
- Electrical Conduit and Pull Box
- Pull Box - Special
- Vehicle Loop Detector
- Pedestrian Push Button
- Luminaire

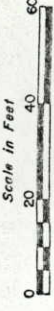

UTILITIES

CABLE SYSTEM INC.
PUBLIC SERVICE COMPANY
TOWN OF ESTES PARK ELECTRIC
TOWN OF ESTES PARK SANITARY SEWER
TOWN OF ESTES PARK WATER
U.S. BUREAU OF RECLAMATION
U.S. WEST
WESTERN AREA POWER ADMIN.

AS CONSTRUCTED

NO REVISIONS 5-20-84 REVISED

VOID

FED. ROAD REGION

VIII

DIVISION

COLO.

PROJ. NO.

CXFC 06-0036-05


SHEET NO.

12

SHEET TOTALS

Estes Park
SH 36 & SH 7
Roadway Plan Sheet

Plan
Orig. Scale 1"=50'

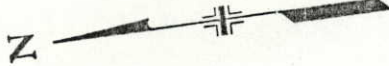

P.O.T. 120+00 BK =
P.O.T. 0+00 Ah
SURVEY 36 LINE

Match Line B
0211

PARKING ENTRANCE

Reg'd Widening to 30' Rt.
Sta. 1111+00 to 1137+00
Proj 36W Line

1115

Proj 36E
 $\Delta = 3^{\circ}00'$ Rt.
 $D = 1^{\circ}00'$
 $T = 150.03'$
 $L = 300.00'$
 $R = 5729.58'$

PC 1115+99.97 (Proj 36E)

3'x5' Inlet with Grate

115
1115
Third Street

PI 1117+50.00 (Proj 36E) =
30' Lt. Sta 117+50 (Surv 36)

P.T. 1119+05.61 (Proj 36E)

P.T. 1118+99.97 (Proj 36E)

120
1120

Match Line C
0012

First Street

100
2100

BEGIN APPROACH TO
Project CXFC 06-0036-05
Sta. 2099+00

95
2095
Business Approach

Water Valve

Business Approach

P.T. 2093+25.05 (Proj 7)

3'x5' Drop Inlet

Proj 7
 $\Delta = 2^{\circ}30'00"$ Lt.
 $D = 1^{\circ}00'$
 $T = 125.02'$
 $L = 250.00'$
 $R = 5729.58'$

Business Approach

Comanche Street

PC 2090+75.05 (Proj 7)

3'x3' Drop Inlet

90 (Surv)
2090 (Proj 7)

PI 2089+25.00 (Proj 7) =
52' Lt. Sta. 89+25.00

Service Line

SH 7 to Raymond

Proj. 7 Line

4' Sidewalk

Water Valve

Third Street

M.H.

2095

Second Street

Property Pin

PI 2092+00.07 (Proj 7) =
40' Lt. Sta. 91+99.85

PT 2090+49.98 (Proj 7)

110 (Surv 36)
1110 (Proj 36W)

3'x5' Inlet With Grate

Water Valve

Fourth Street

Reg'd. 200' Appr to Project

Begin
Project CXFC 06-0036-05
Sta. 1111+00
= Sta. 1048+00 Proj. 401-C#2

PC 2087+99.98 (Proj 7) =
52' Lt. Sta. 87+99.98

Manford Ave.

M.H.

Fourth Street

Proj 7
 $\Delta = 2^{\circ}30'00"$ Rt.
 $D = 1^{\circ}00'$
 $T = 125.02'$
 $L = 250.00'$
 $R = 5729.58'$

M.H.

M.H.


M.H.

M.H.

M.H.

M.H.

Roadway Plan Sheet

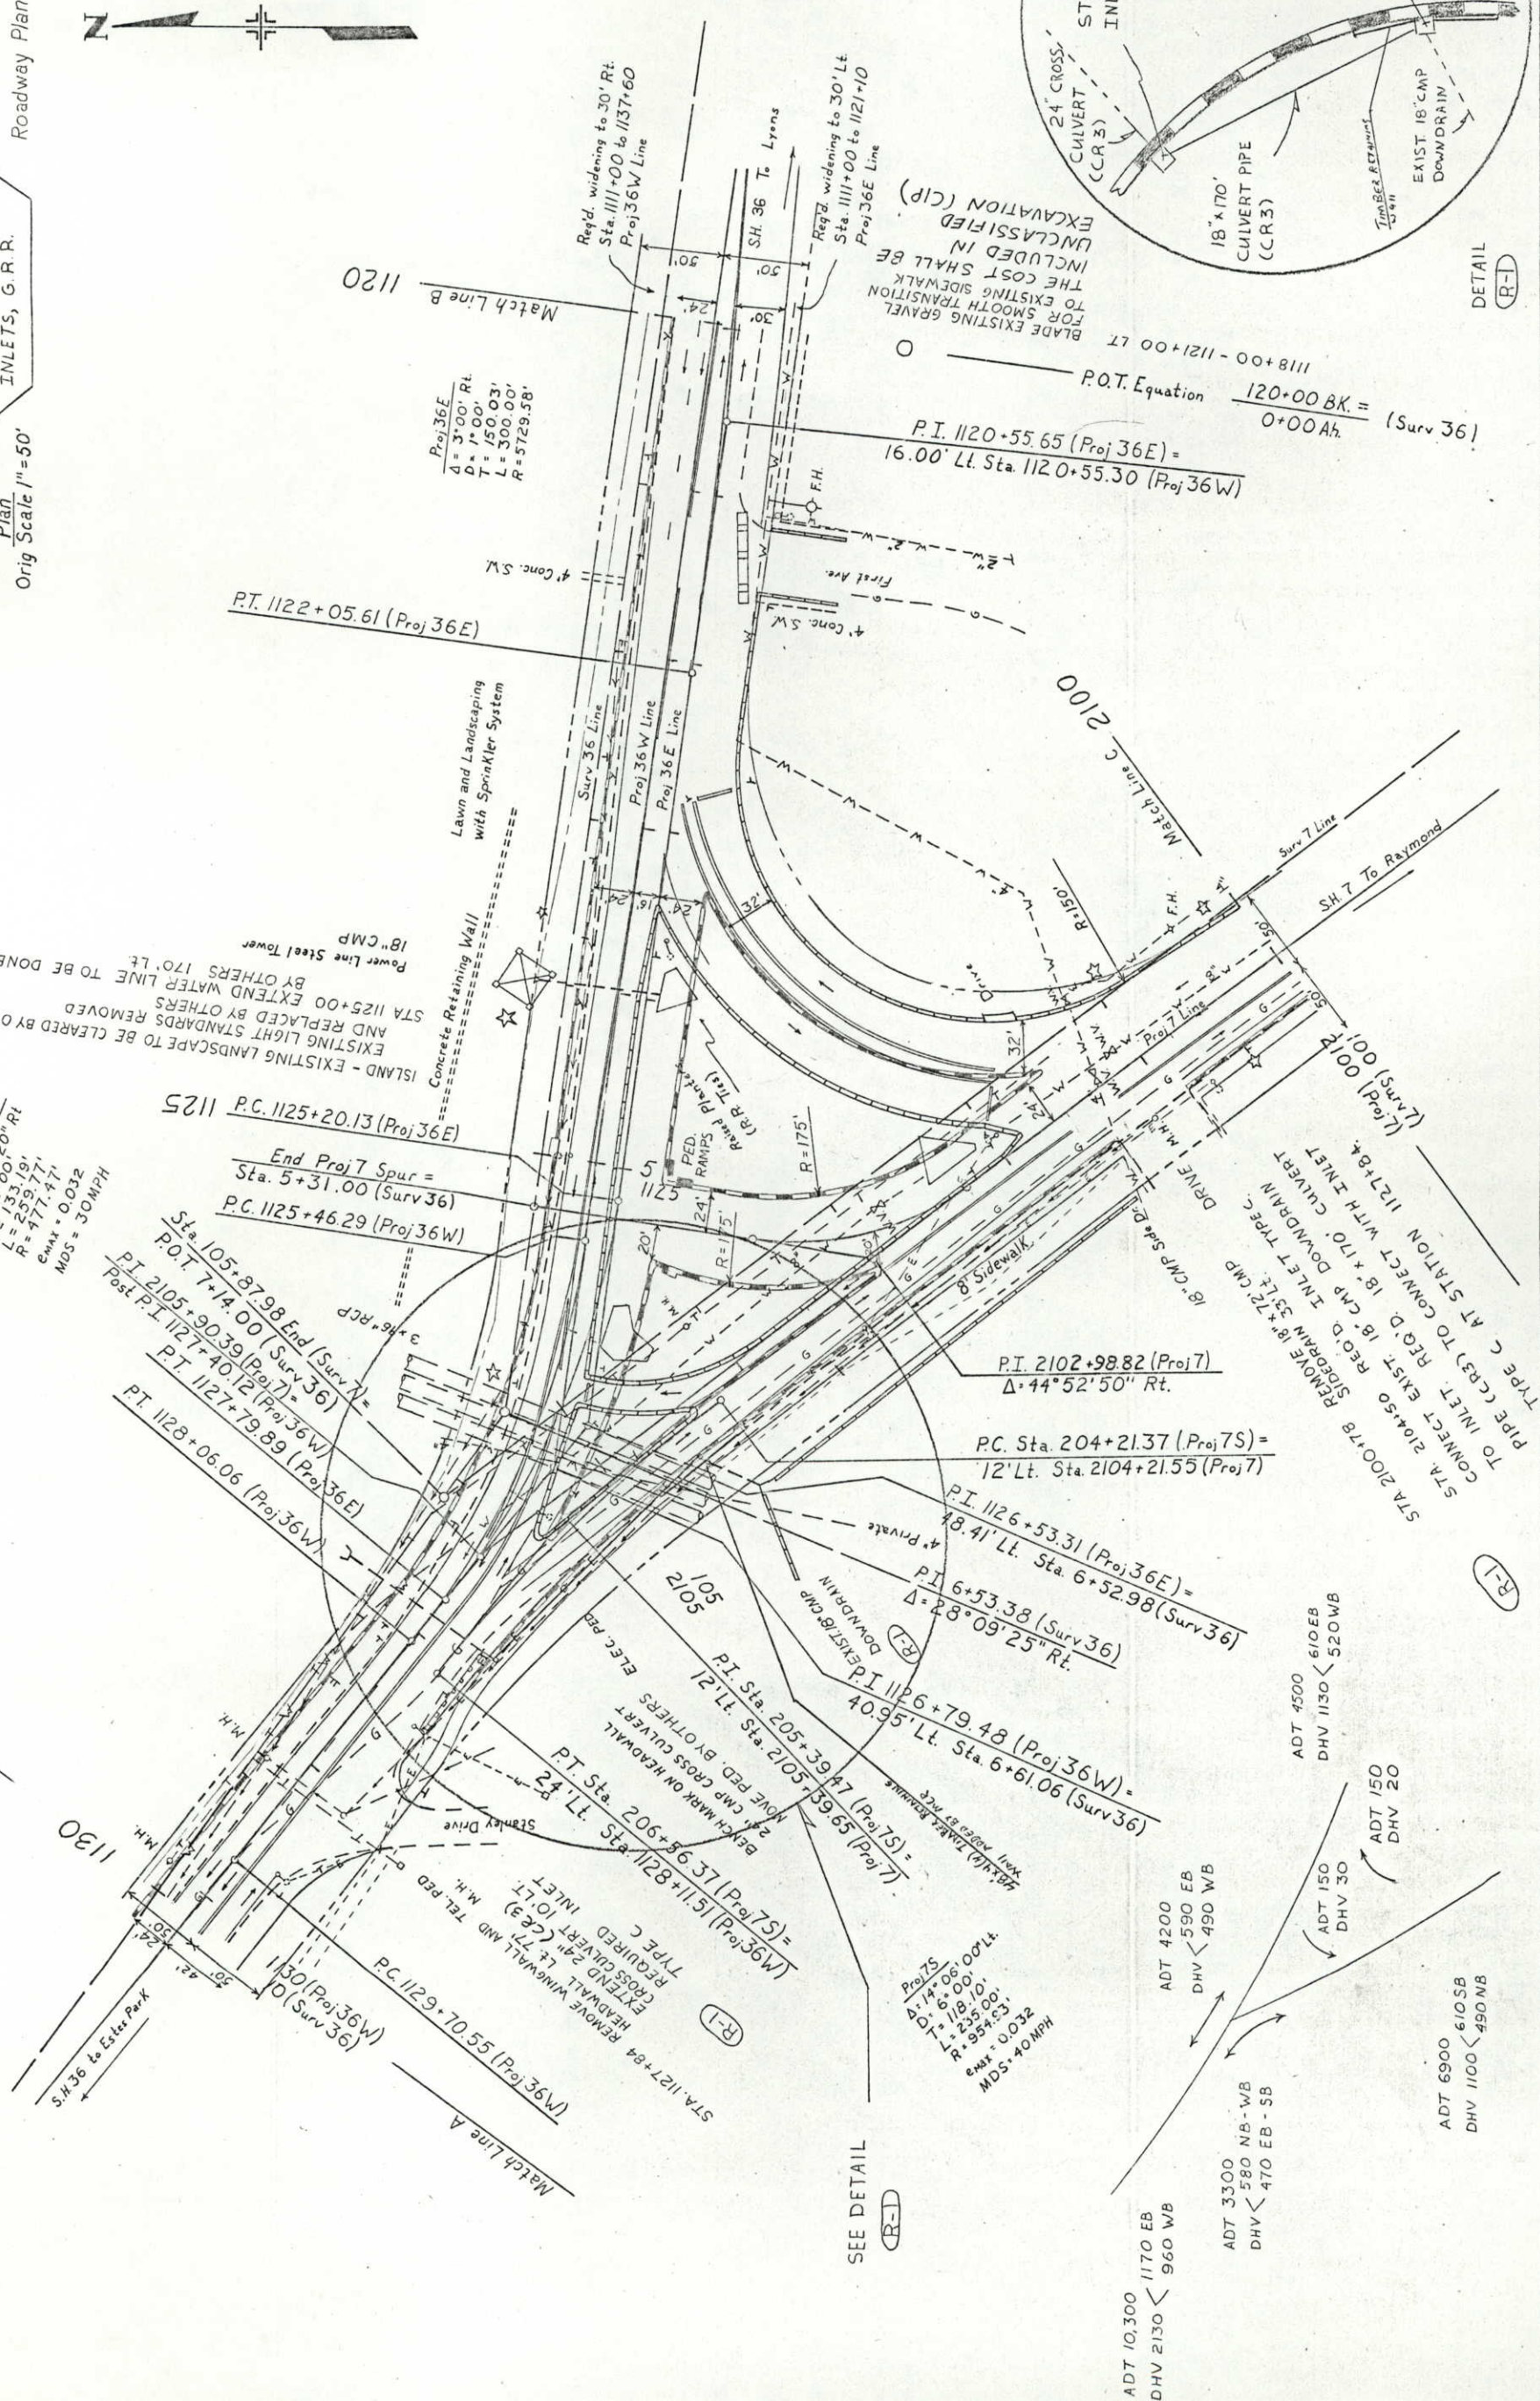

BLADE EXISTING GRAVEL
FOR SMOOTH TRANSITION
TO EXISTING SIDEWALK
THE COST SHALL BE
INCLUDED IN
UNCLASSIFIED
EXCAVATION (CIP)

2012


NOT TO SCALE

TIMBER RETAINING

STA 2104+50
INLET TYPE C


DETAIL (R-1)

Roadway Plan Sheet
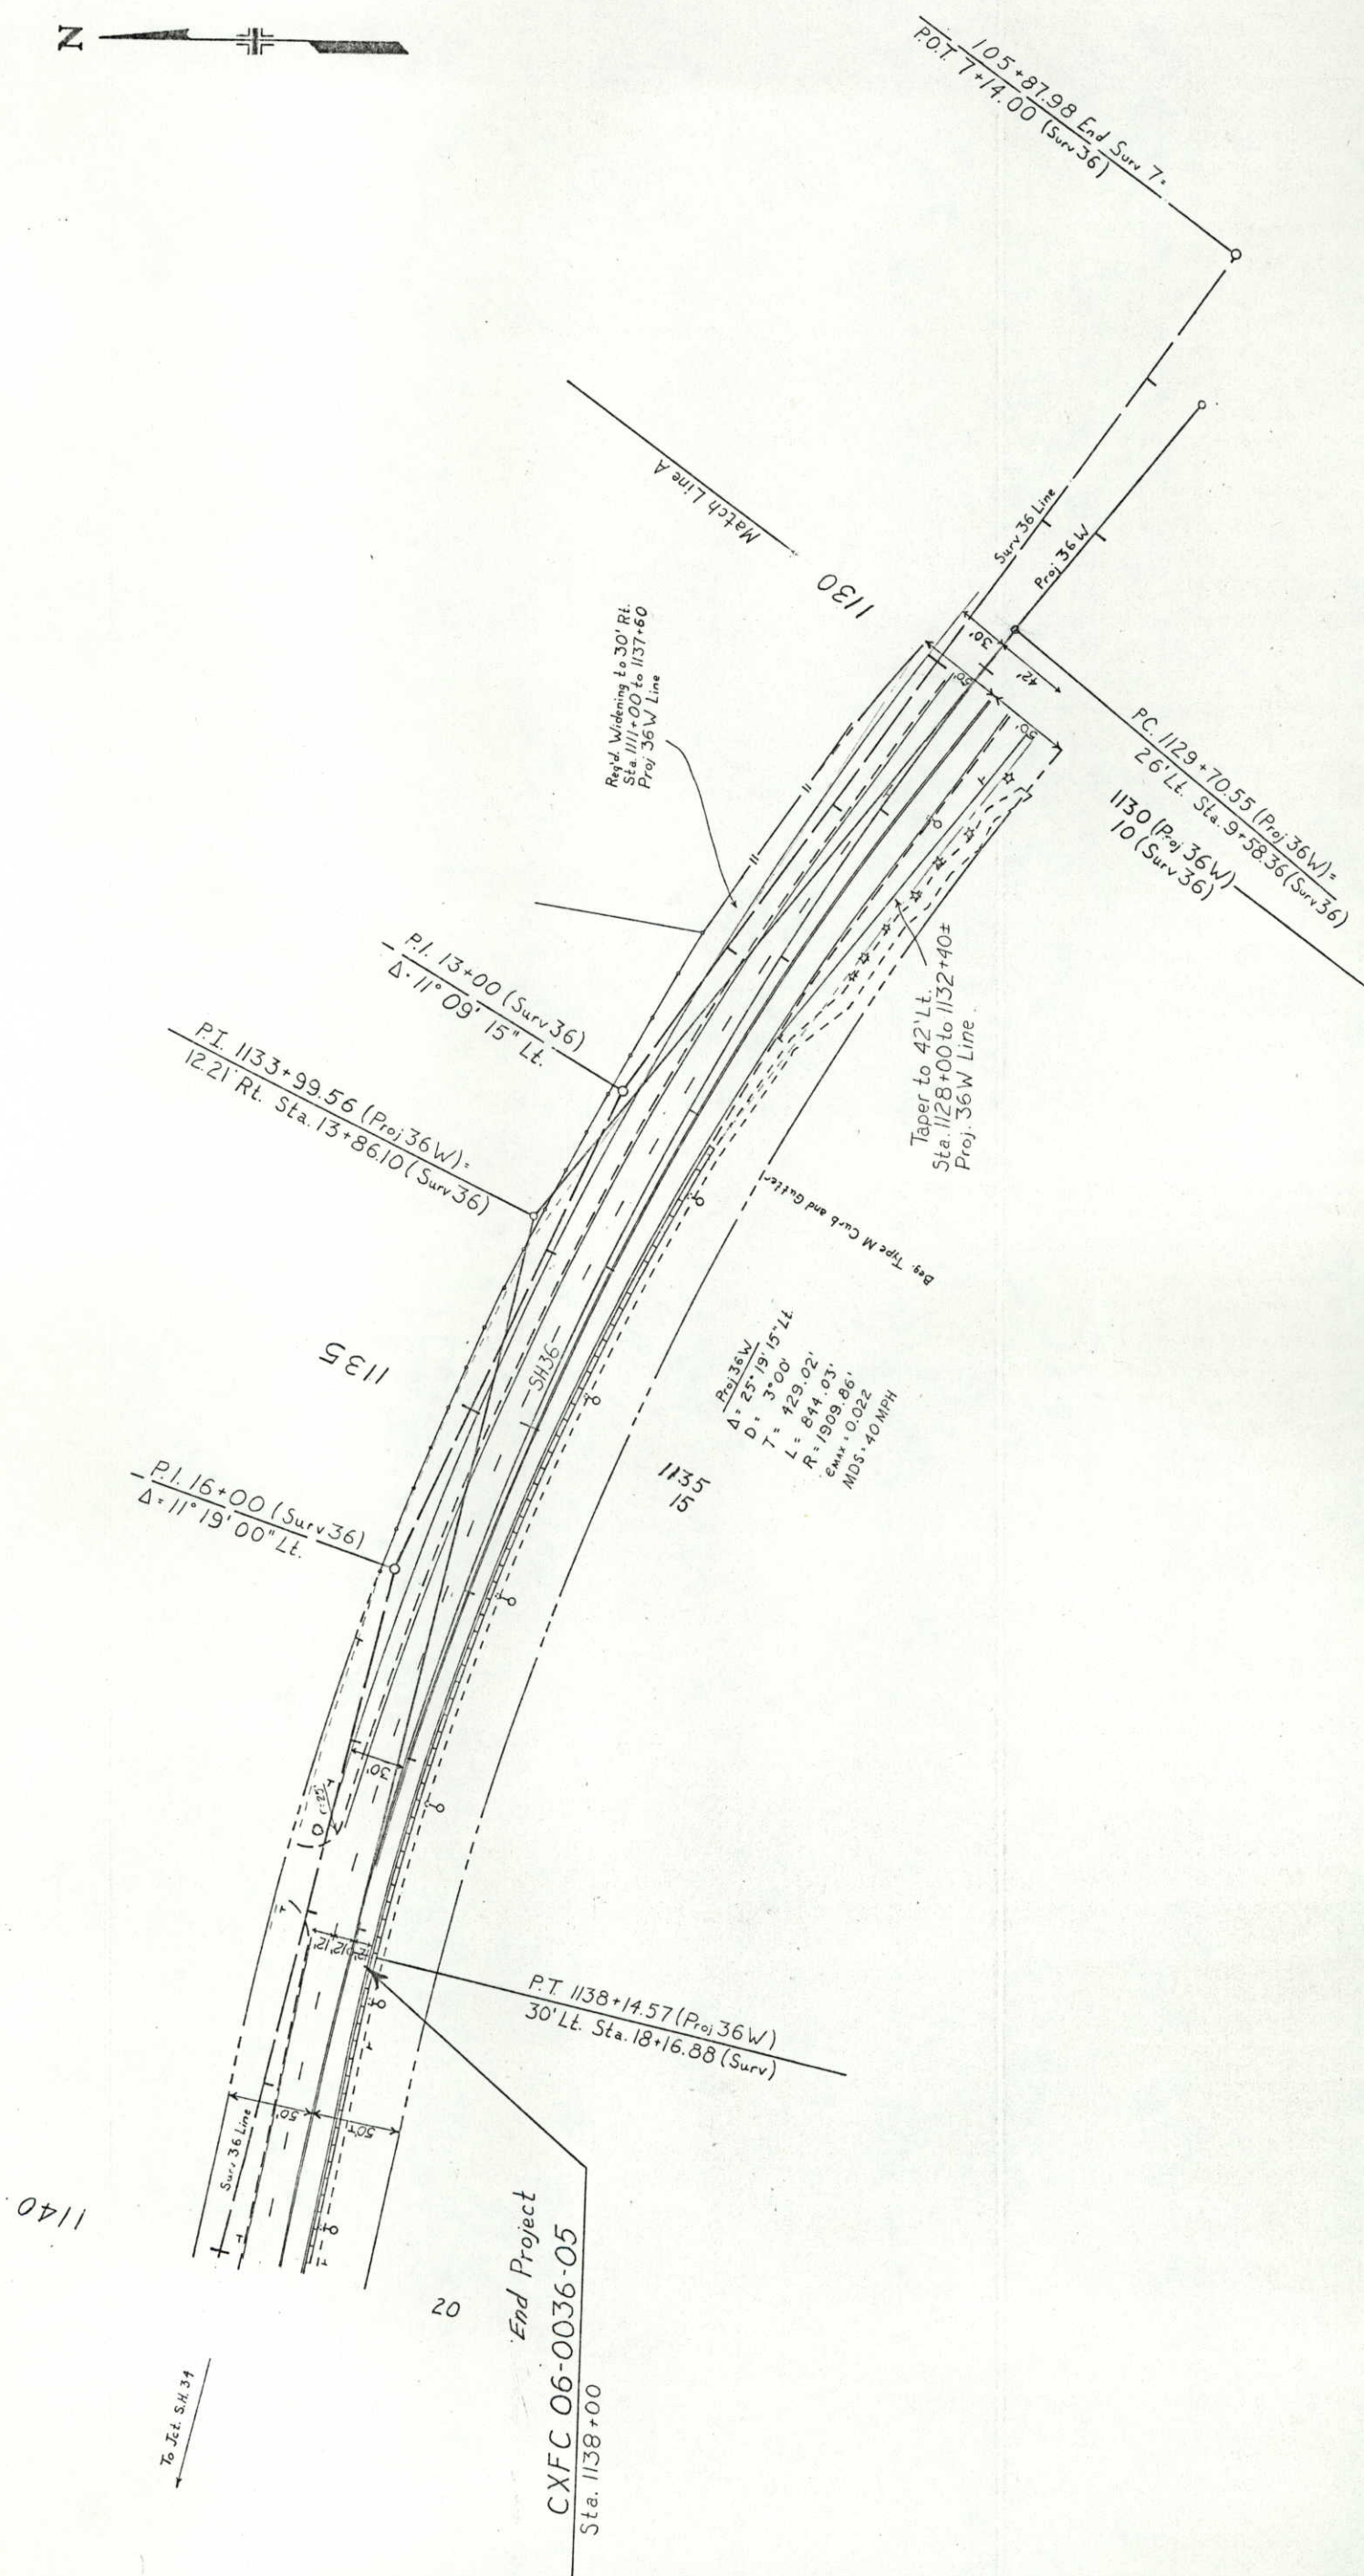
$$\frac{\text{Plan}}{\text{Orig Scale}} \frac{1''}{1'} = 50'$$


AS CONSTRUCTED		PROJ. NO.		SHEET NO.		SHEET TOTALS	
NO REVISIONS	5-20-89	REVISED		VOID			15
FED. ROAD REGION		DIVISION		COLO.		CXFC 06-0036-05	
VIII							

StaKing Plan
Orig. Scale 1"=50'

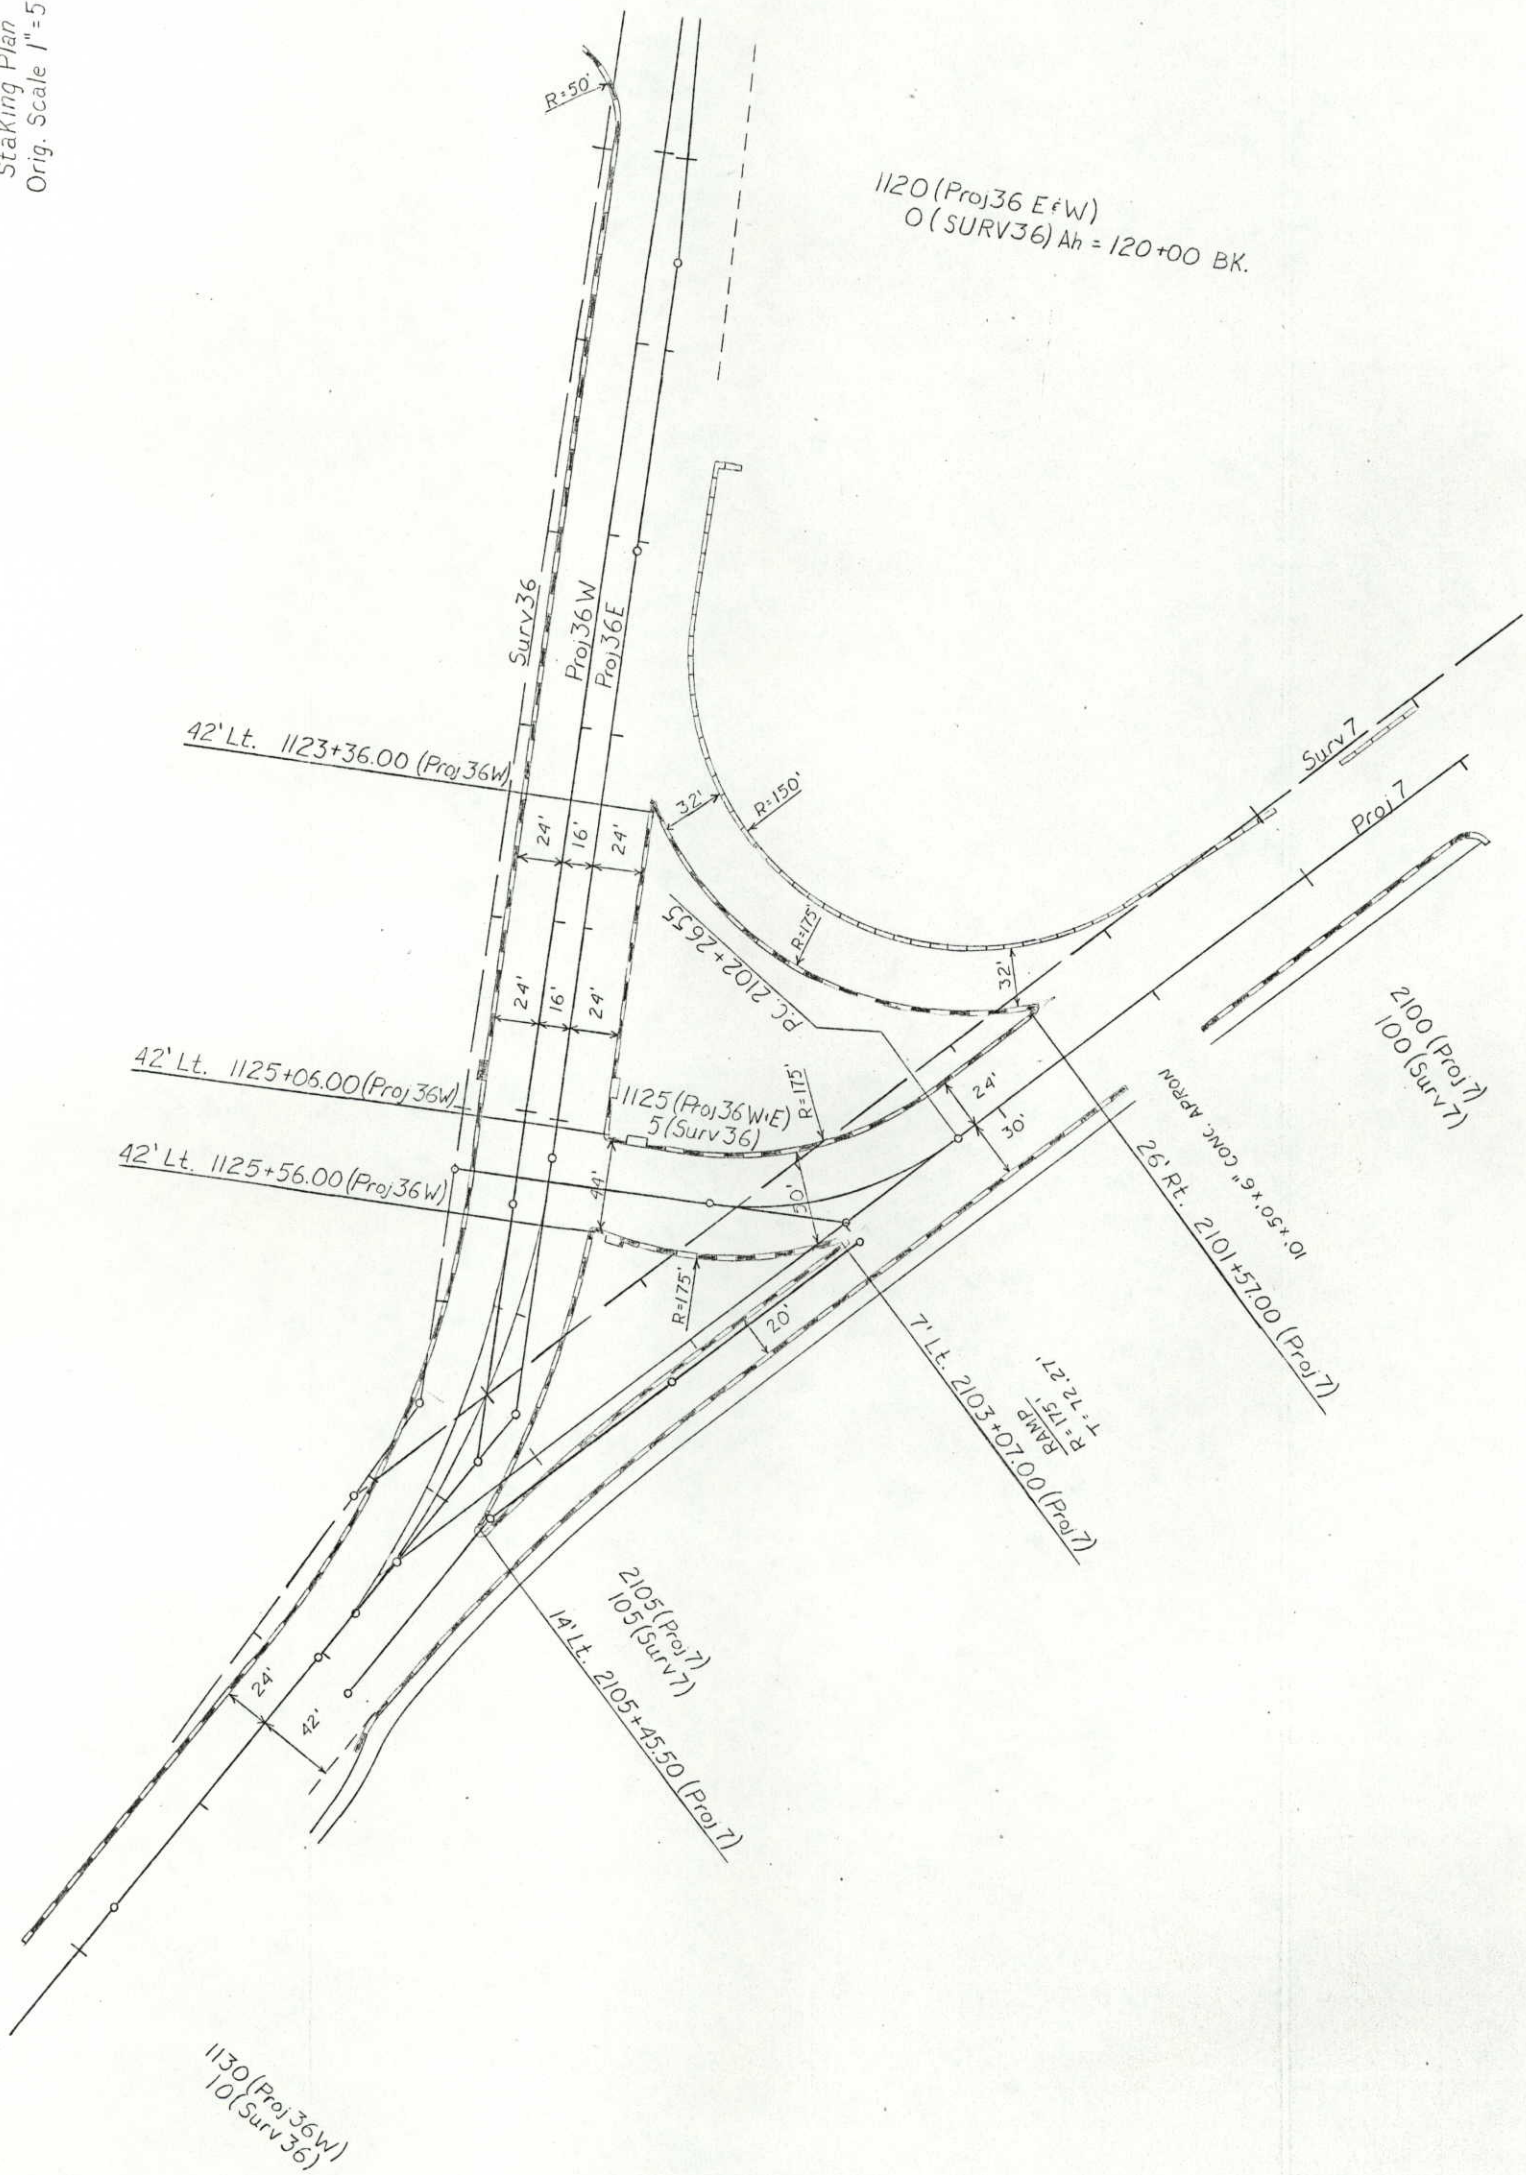


AS CONSTRUCTED


NO REVISIONS [5-20-89] REVISED [] VOID []

FED. ROAD REGION	DIVISION	PROJ. NO.	SHEET NO.	SHEET TOTALS
VIII	COLO.	CXFC 06-0036-05	16	

Striping Plan
Orig. Scale 1"=50'

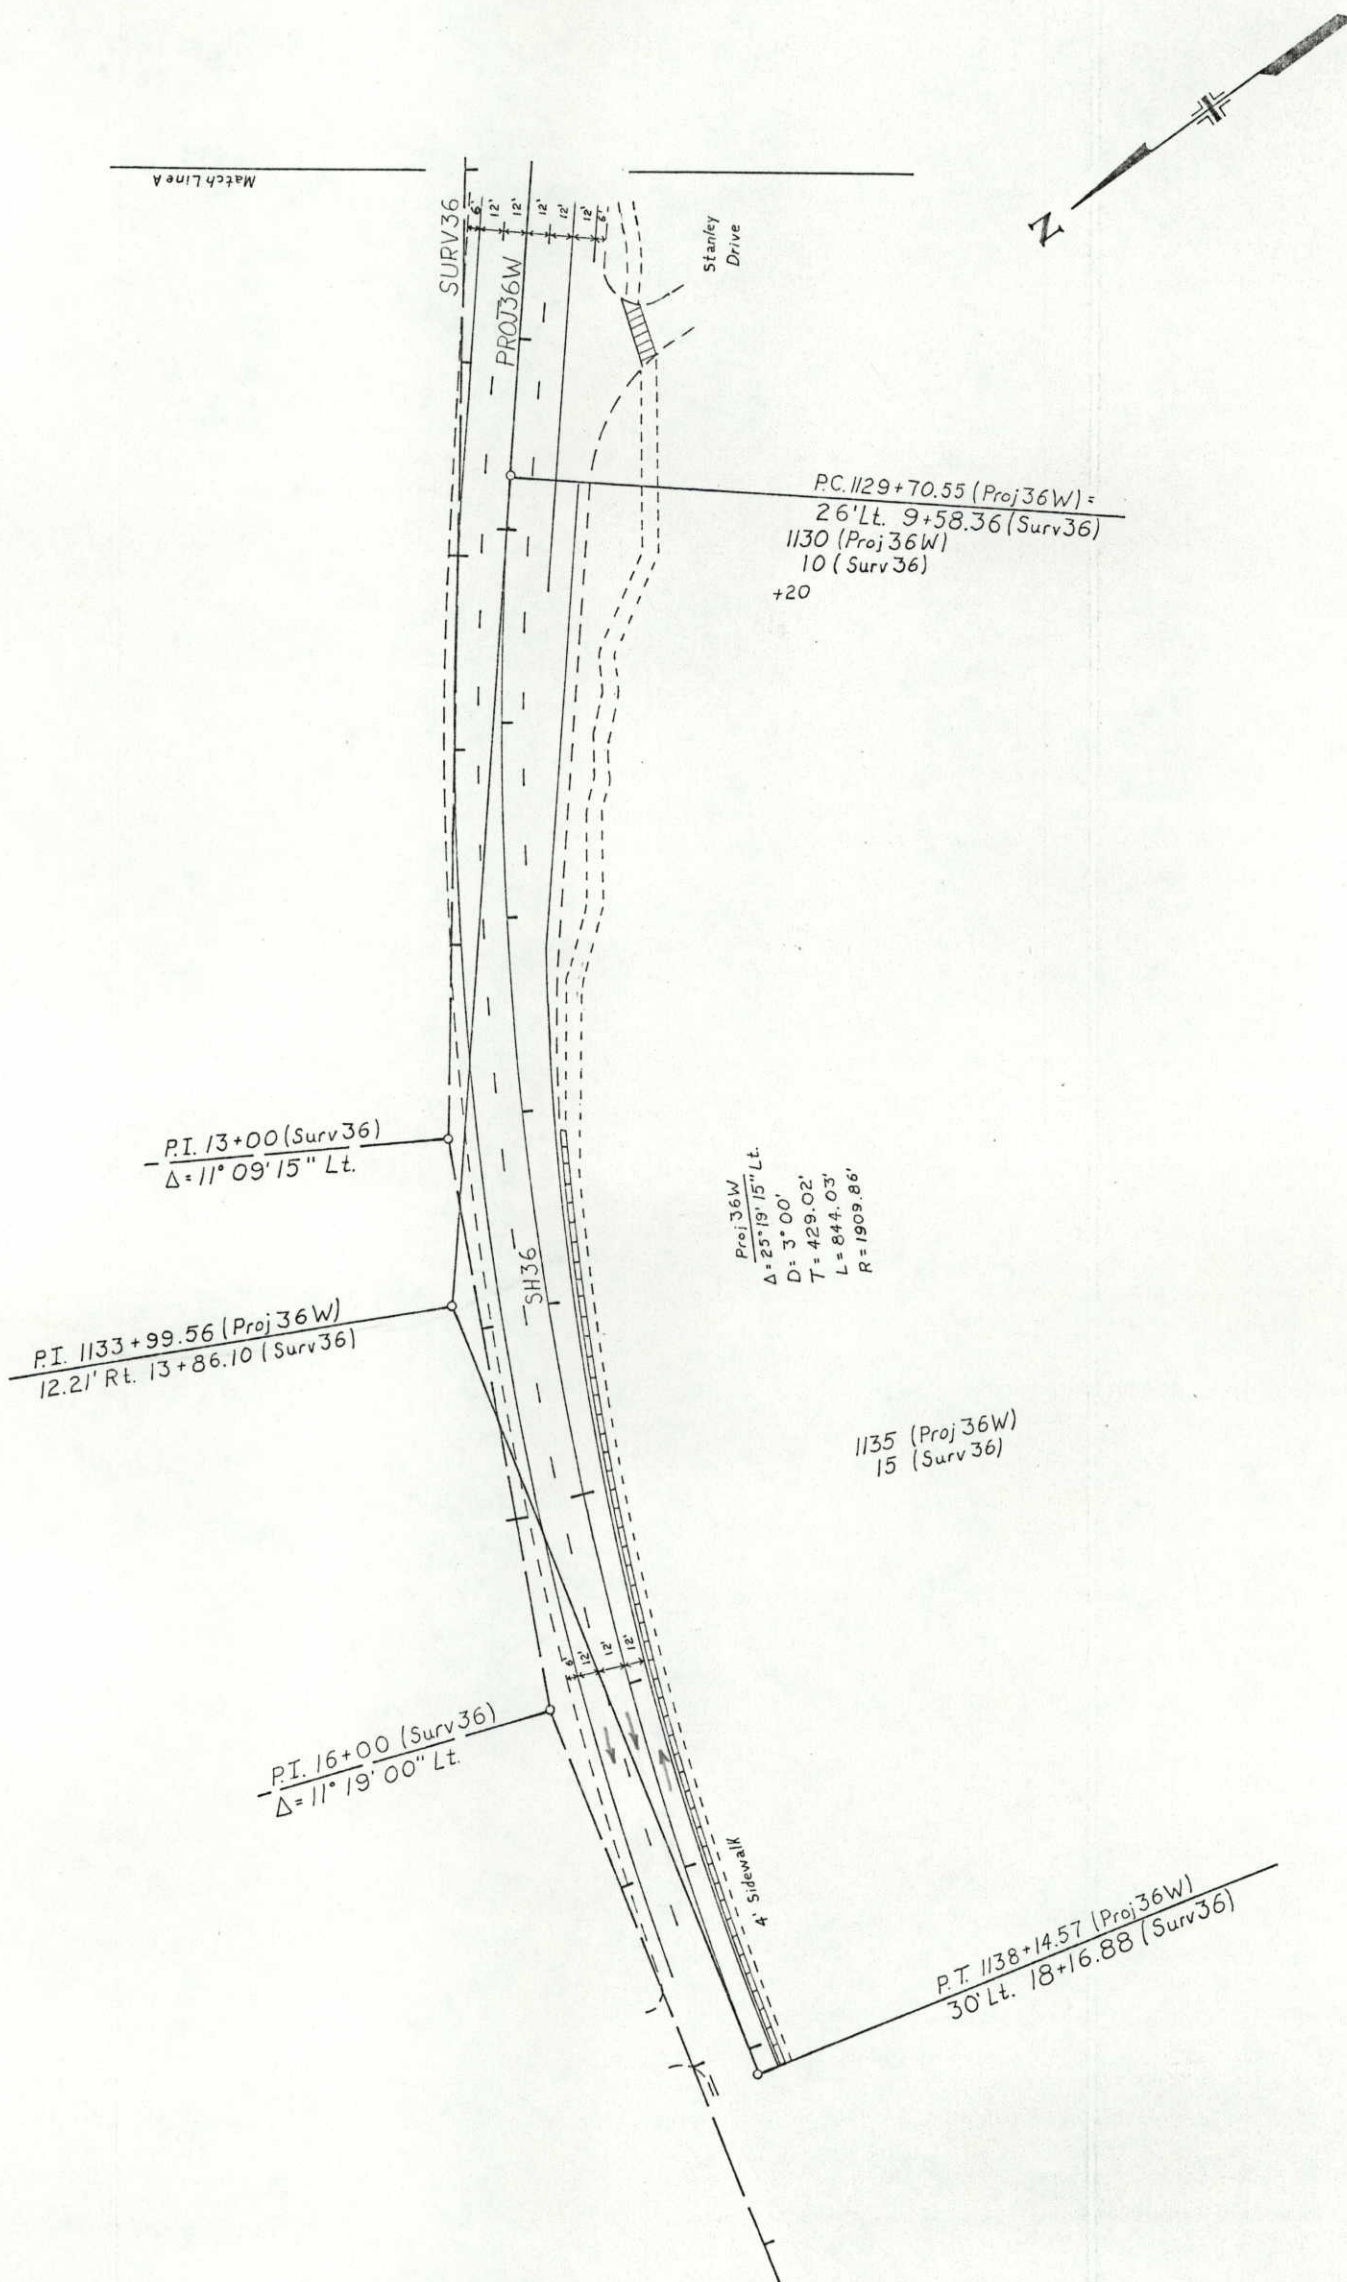


AS CONSTRUCTED		NO REVISIONS 5-20-99 REVISED VOID	
FED. ROAD REGION	DIVISION	PROJ. NO.	SHEET NO.
VIII	COLO.	CXFC 06-0036-05	17
		SHEET TOTALS	

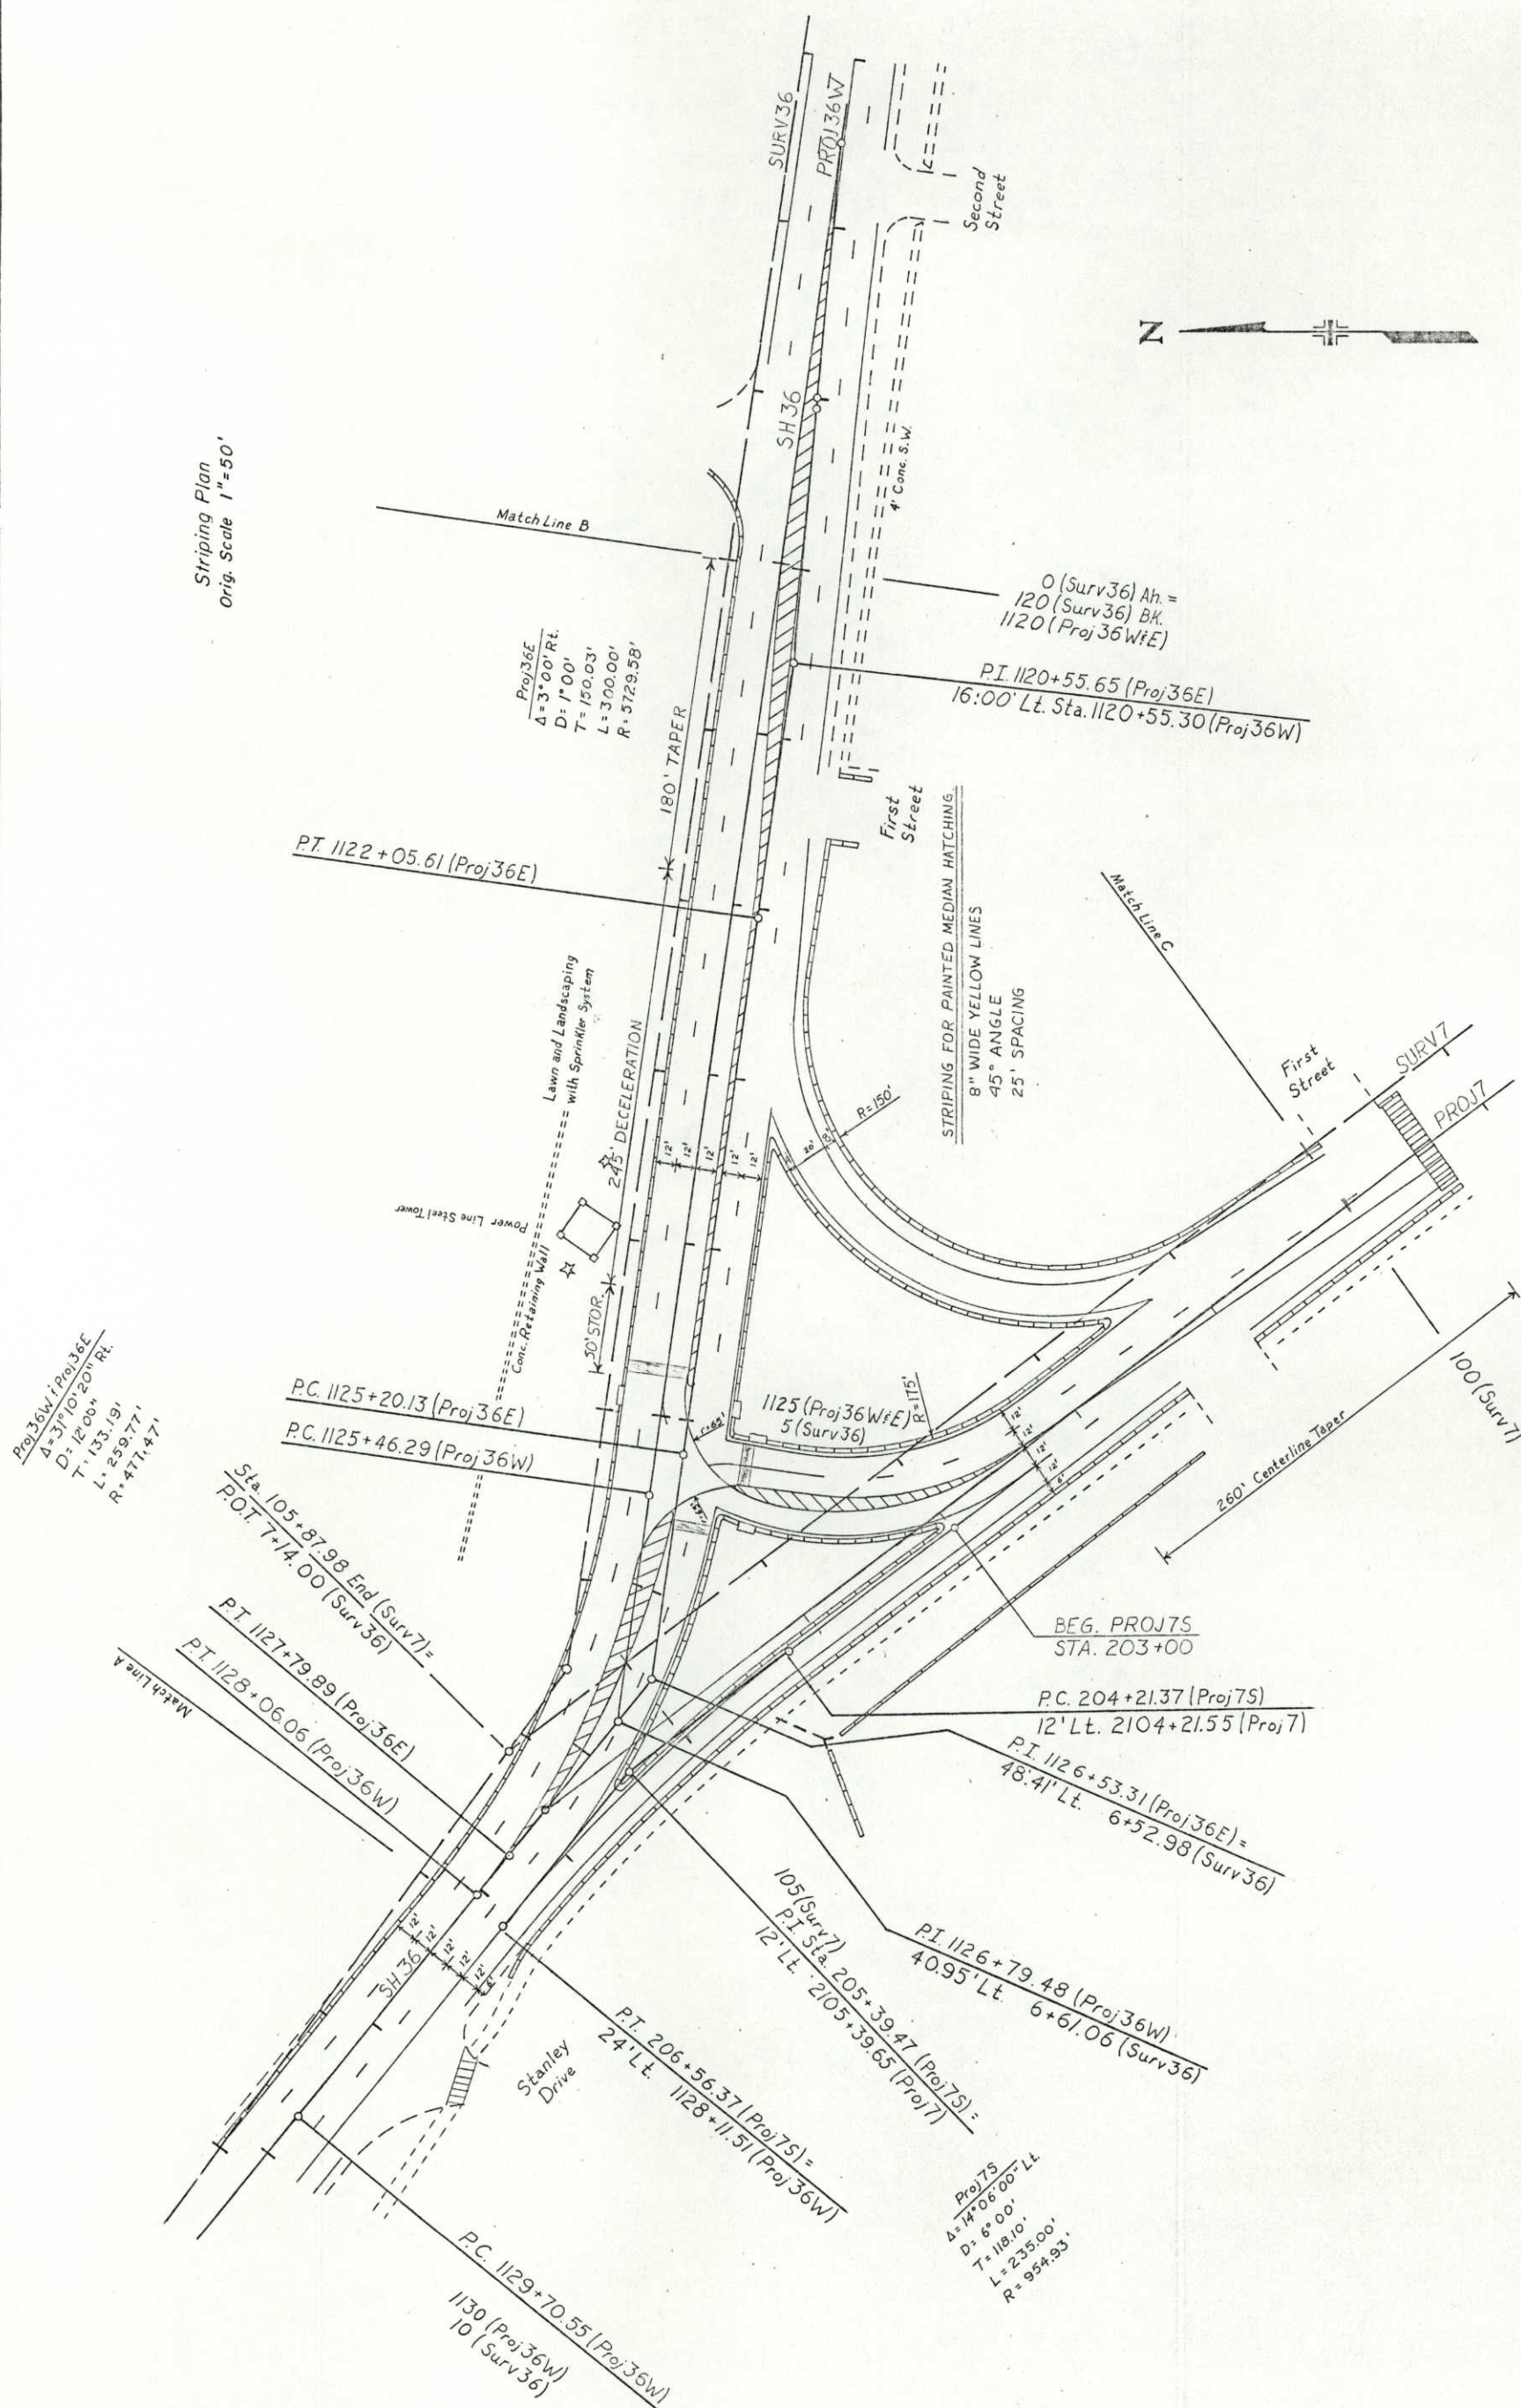

AS CONSTRUCTED		FED. ROAD REGION		DIVISION		PROJ. NO.		SHEET NO.		SHEET TOTALS	
NO REVISIONS		5-20-83		REVISED		VOID		VIII		COLO.	
										C-XFC 06-0036-05	
										18	

Striping Plan
Orig. Scale 1"=50'

200' TAPER

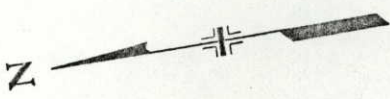

1110 (Proj 36W)
110 (Surv 36)

1115 (Proj 36W)
115 (Surv 36)

P.C. 1115+99.97 (Proj 36E)
30' Lt. 115+99.97 (Surv 36)

Proj 36E
 $\Delta = 3^{\circ}00'00''$
 $D = 1^{\circ}00'$
 $T = 150.03'$
 $L = 300.00'$
 $R = 5729.58'$

P.I. 1117+50.00 (Proj 36E)
30' Lt. 117+50.00 (Surv 36)

P.T. 1119+05.61 (Proj 36E)

P.T. 1118+99.97 (Proj 36E)

P.O.T. 120+00 BK=
P.O.T. 0+00 Ah.

Match Line B


1120 (Proj 36WtE)
120 (Surv 36)

Match Line C

90 (Surv 7)

95 (Surv 7)

100 (Surv 7)


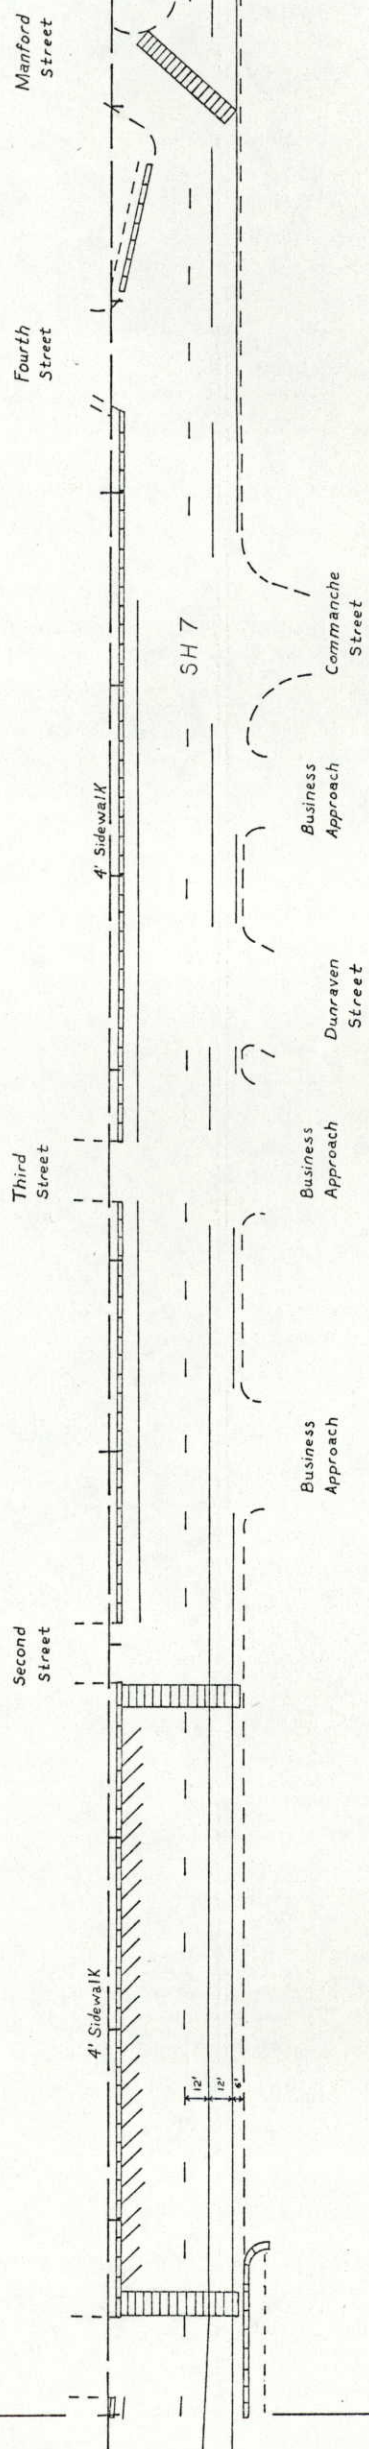


FED. ROAD REGION	DIVISION	PROJ. NO.	SHEET NO.	SHEET TOTALS
VIII	COLO.	CXFC 06-0036-05	19	

AS CONSTRUCTED

NO REVISIONS 5-20-89 REVISED ☐ VOID ☐



Signing Plan

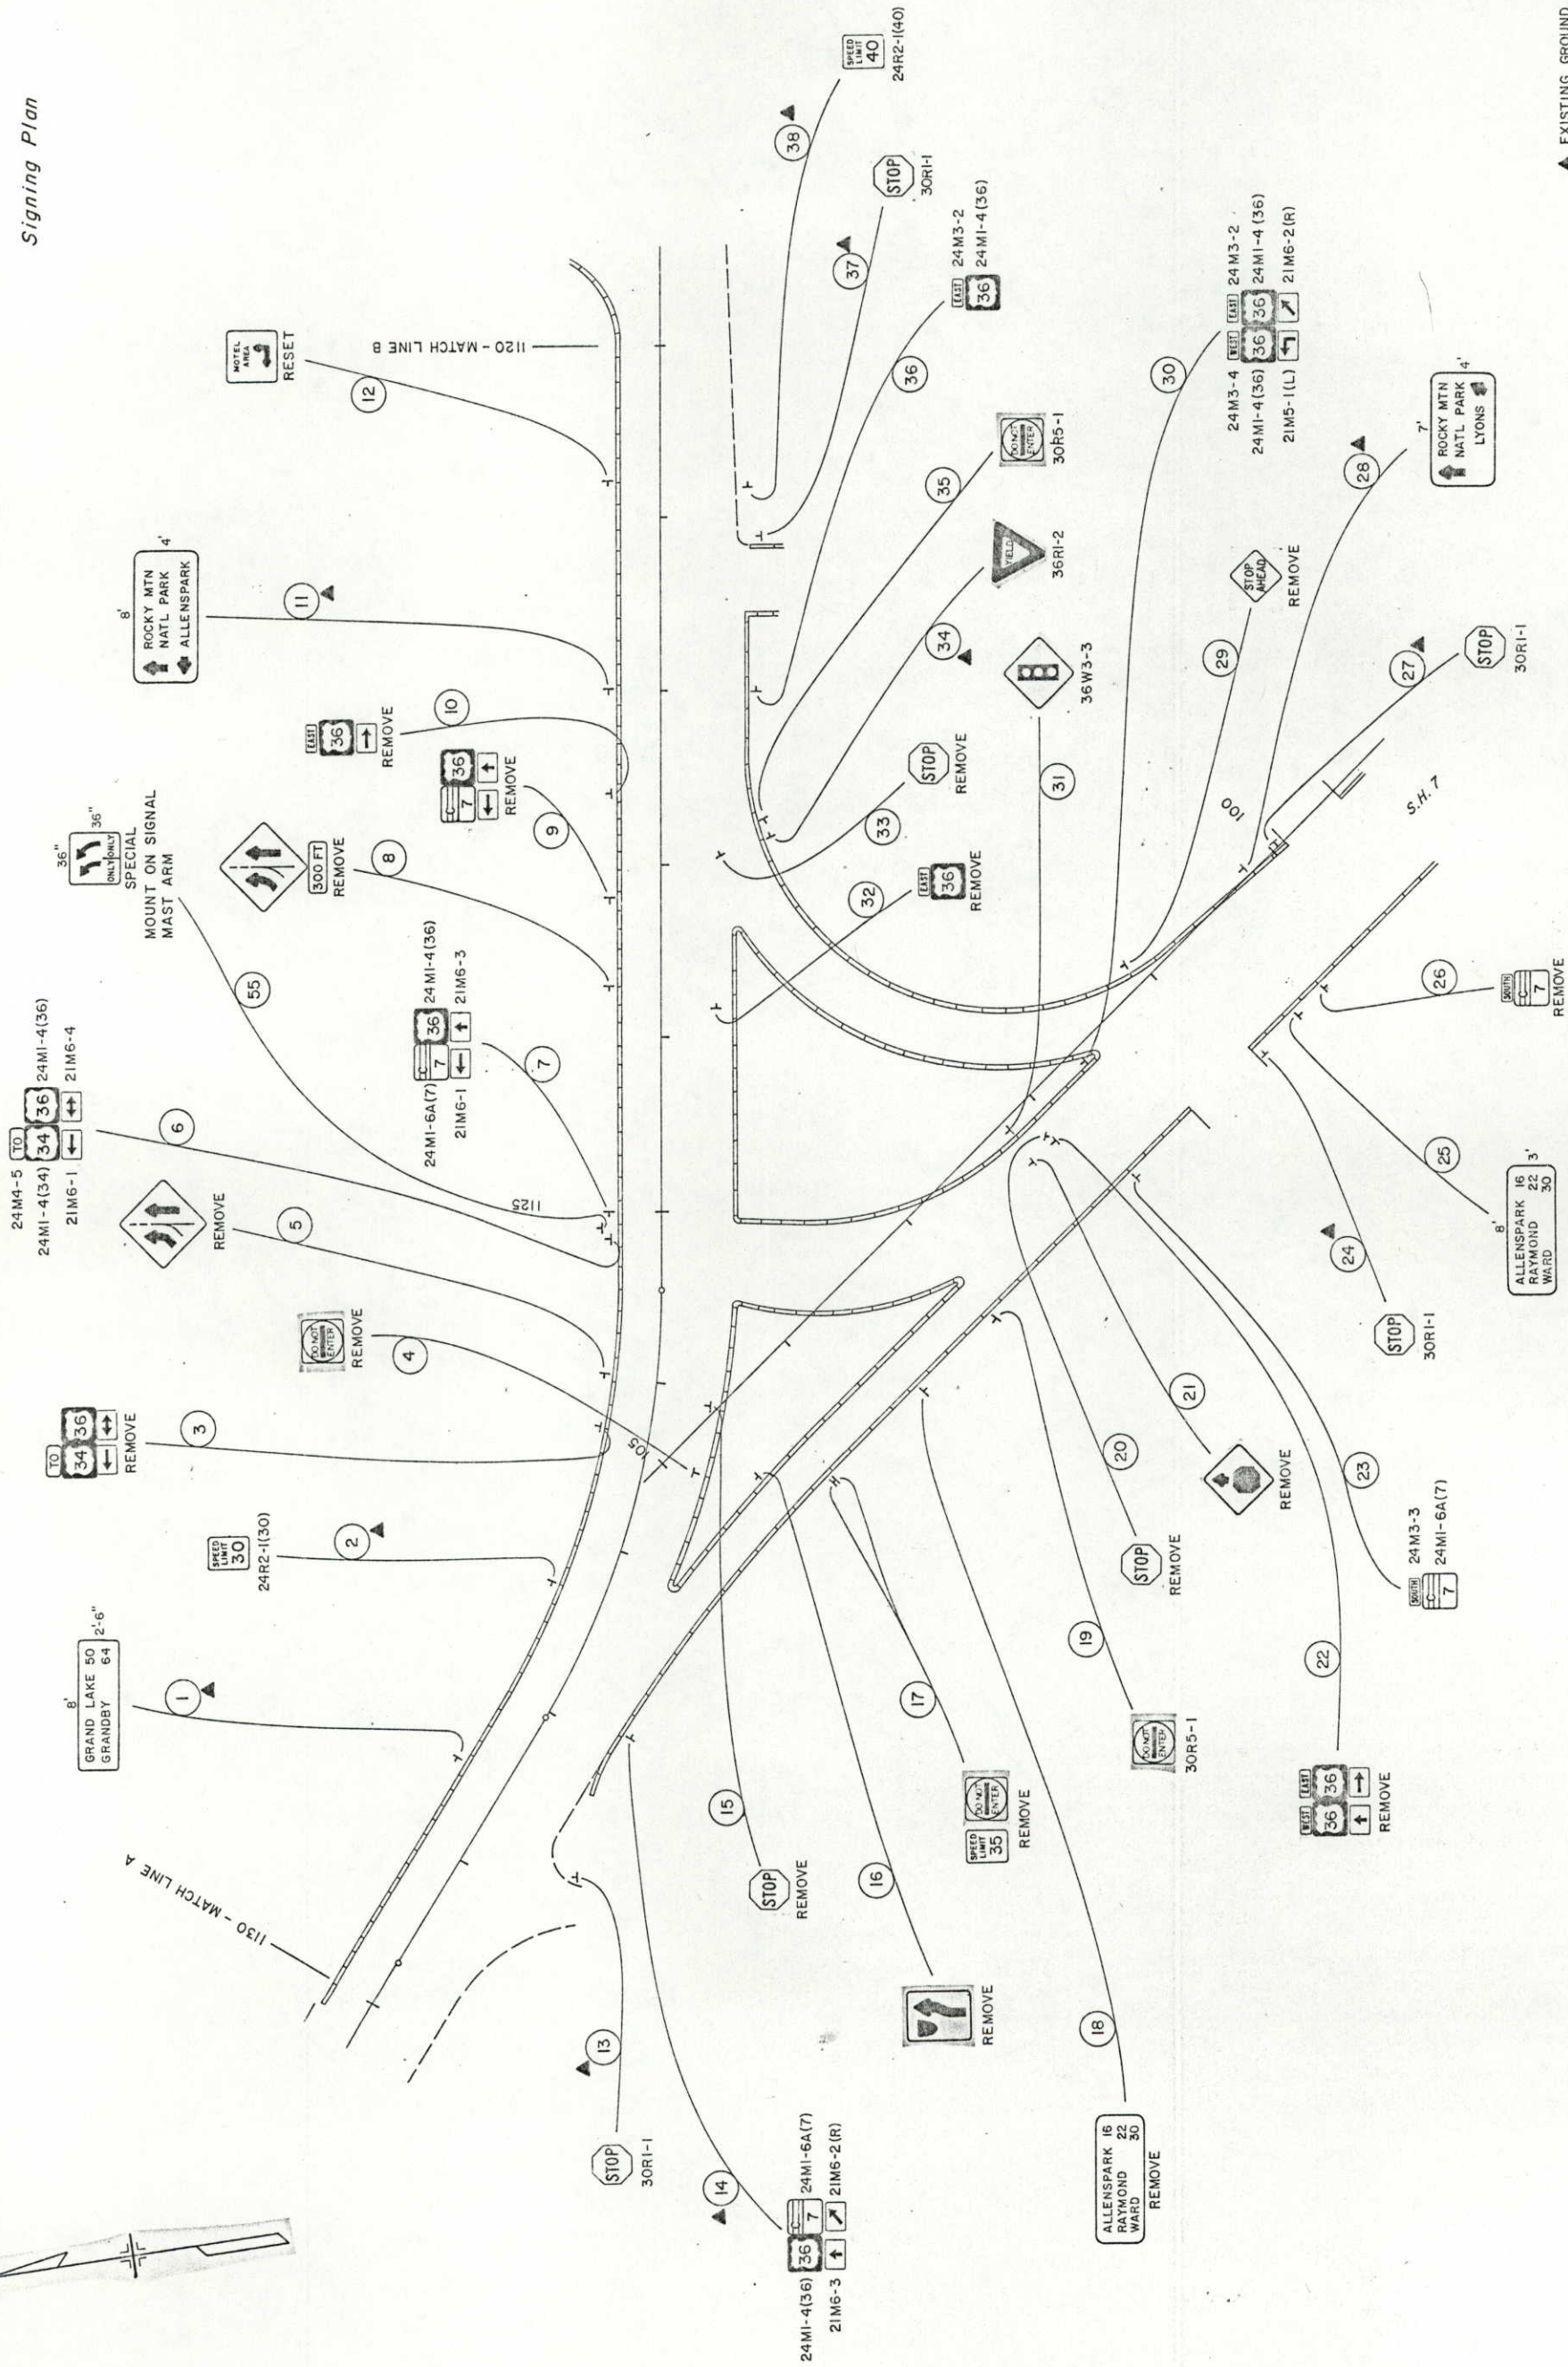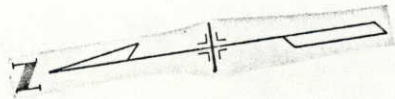



▲ EXISTING GROUND SIGN TO BE REMOVED

AS CONSTRUCTED		PROJ. NO.		SHEET NO.		SHEET TOTALS
NO REVISIONS	5-20-83	REVISED	VOID	CXFC 06-0036-05	20	
FED. ROAD REGION		DIVISION		COLD.		
VIII						

Signing Plan

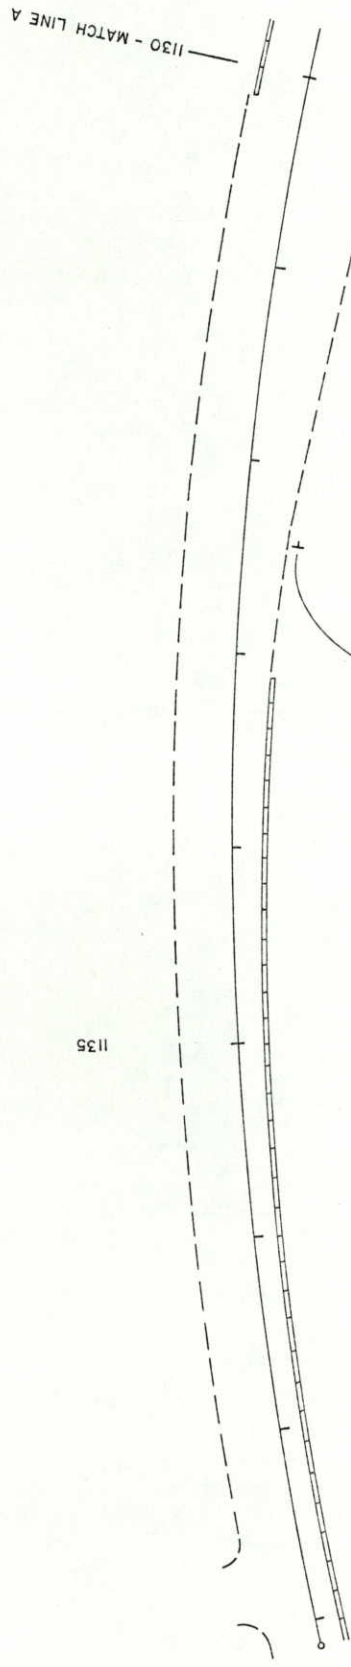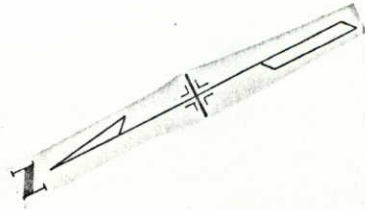

1135

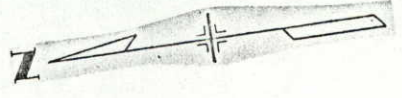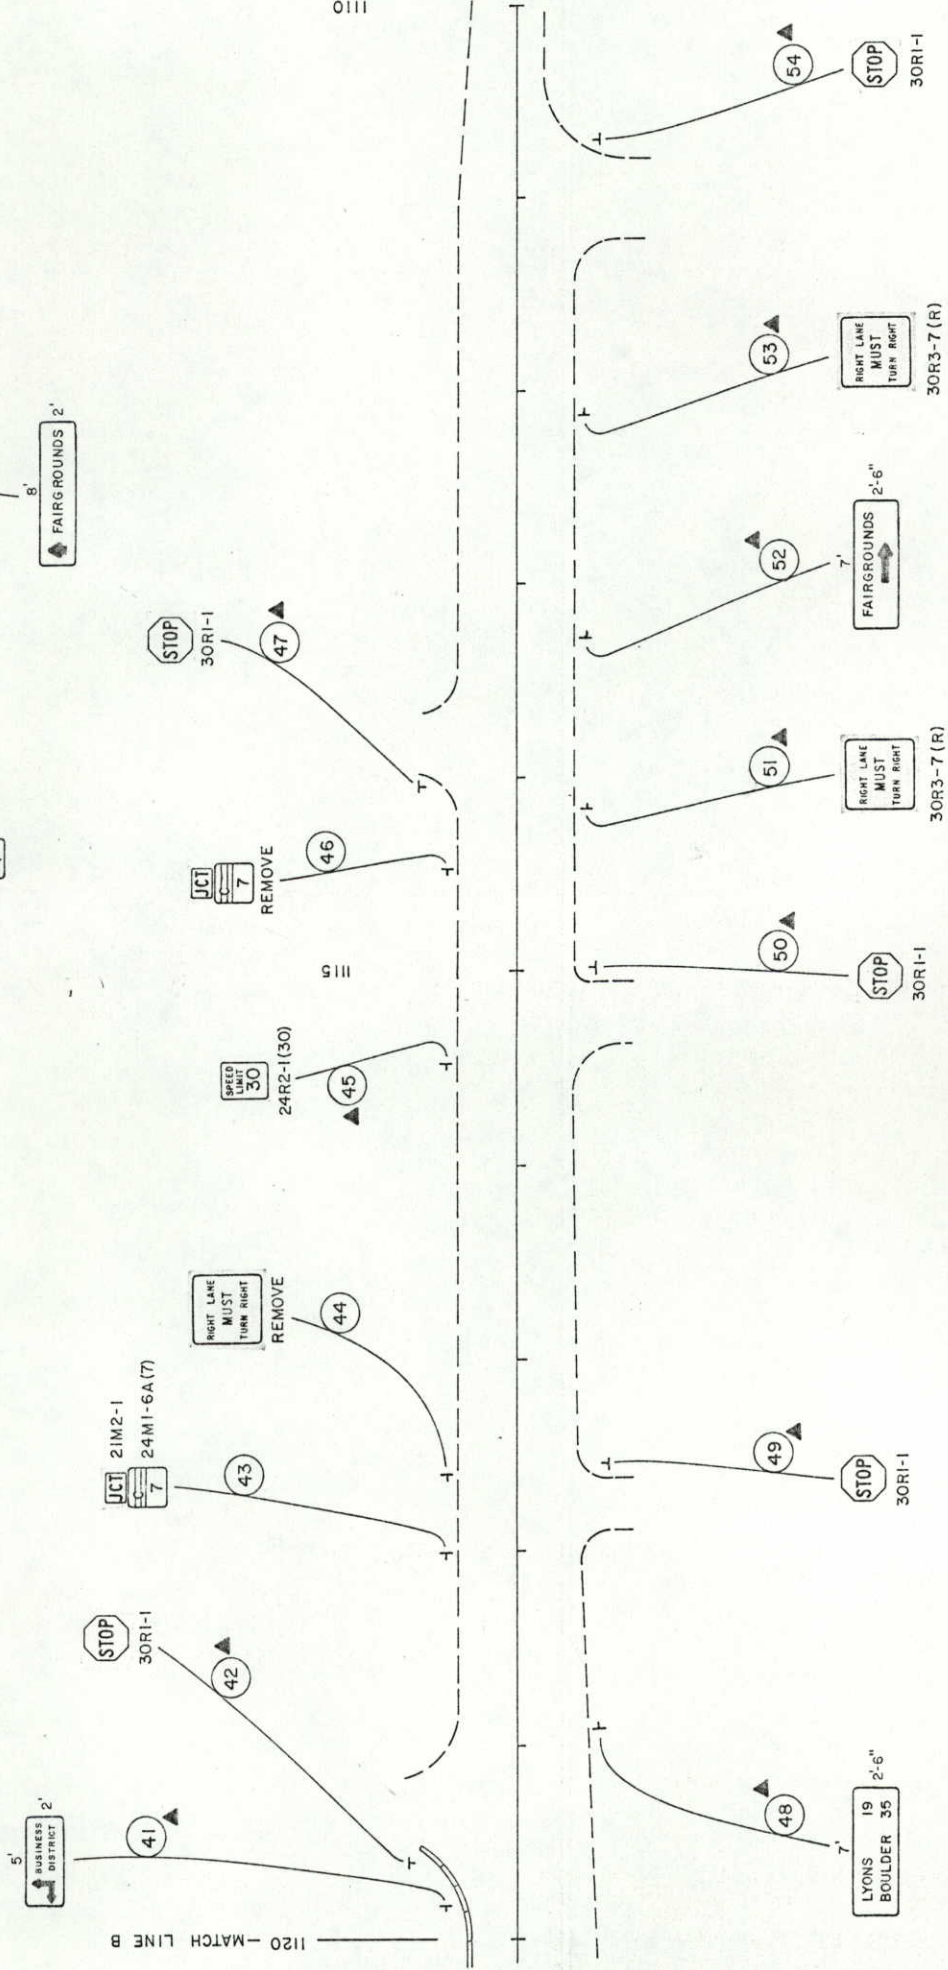

▲ EXISTING GROUND SIGN TO BE REMOVED


CLASS III SIGNS - SHEET 2

FED. ROAD REGION		DIVISION	PROJ. NO.	SHEET NO.	TOTAL SHEETS
VIII		COLO.	CXFC 06-0036-05	22	

AS CONSTRUCTED		NO REVISIONS		REVISED	VOID
5-20-81					

FABRICATION NOTES


- BACKING ZEE. See "SPACING TABLE". Aluminum Alloy 6061-T6. Each zee to be provided with a 9/16" x 2" horizontal slot for each post mounting bolt. The length of each zee to be 1'-0" less than the sign panel width.
- 3/8" Ø HEX-HEAD BOLT. With nut and washers: 2 per backing zee per post are required.
- 3/8" Ø (No. 6) 90° COUNTERSUNK ALUMINUM LOCKBOLT FASTENER.
- 2" x 0.080" ALUMINUM CLOSURE STRIP.
- 1/8" Ø x 3/8" UNIVERSAL-HEAD, HOLLOW SHANK ALUMINUM RIVET.
- SHEET ALUMINUM. 0.125" minimum thickness.
- NON-EXPOSED LENS REFLECTIVE SHEETING. To have a dry (heat-activated) adhesive backing.

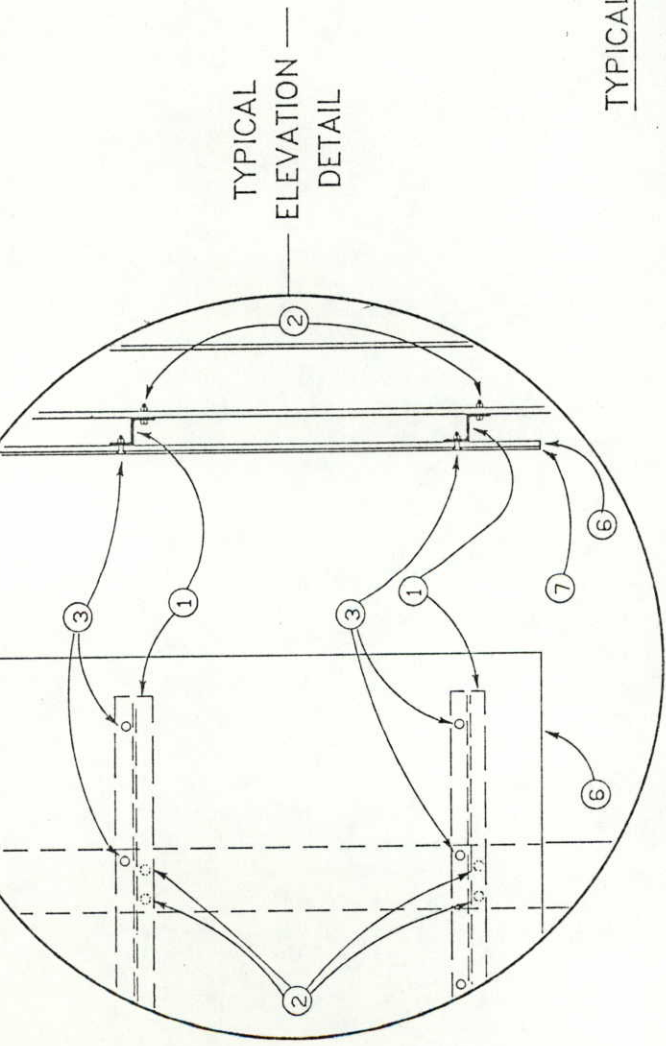


TYPICAL
ELEVATION -
DETAIL

TYPICAL TIMBER POST INSTALLATION

PANEL FABRICATION AND MOUNTING DETAILS

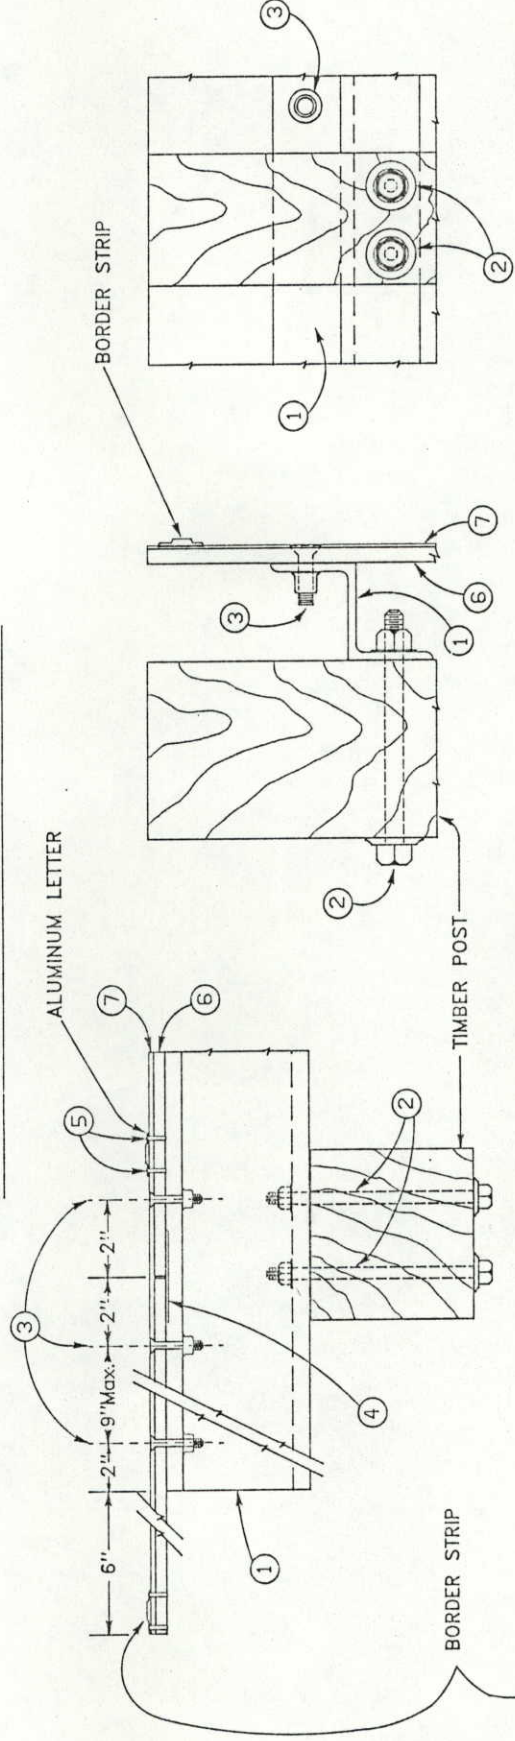


TYPICAL VIEW

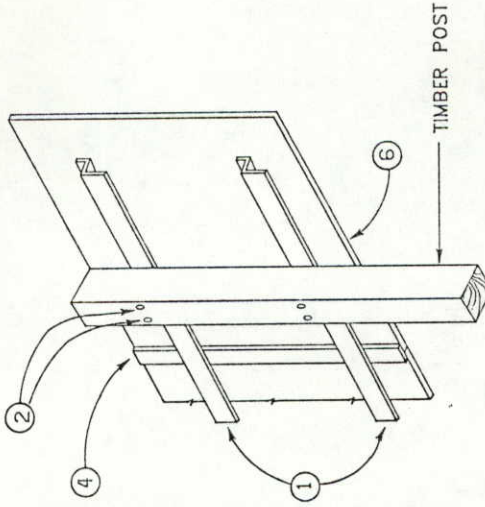


TYPICAL STEEL POST INSTALLATION


PANEL FABRICATION AND MOUNTING DETAILS

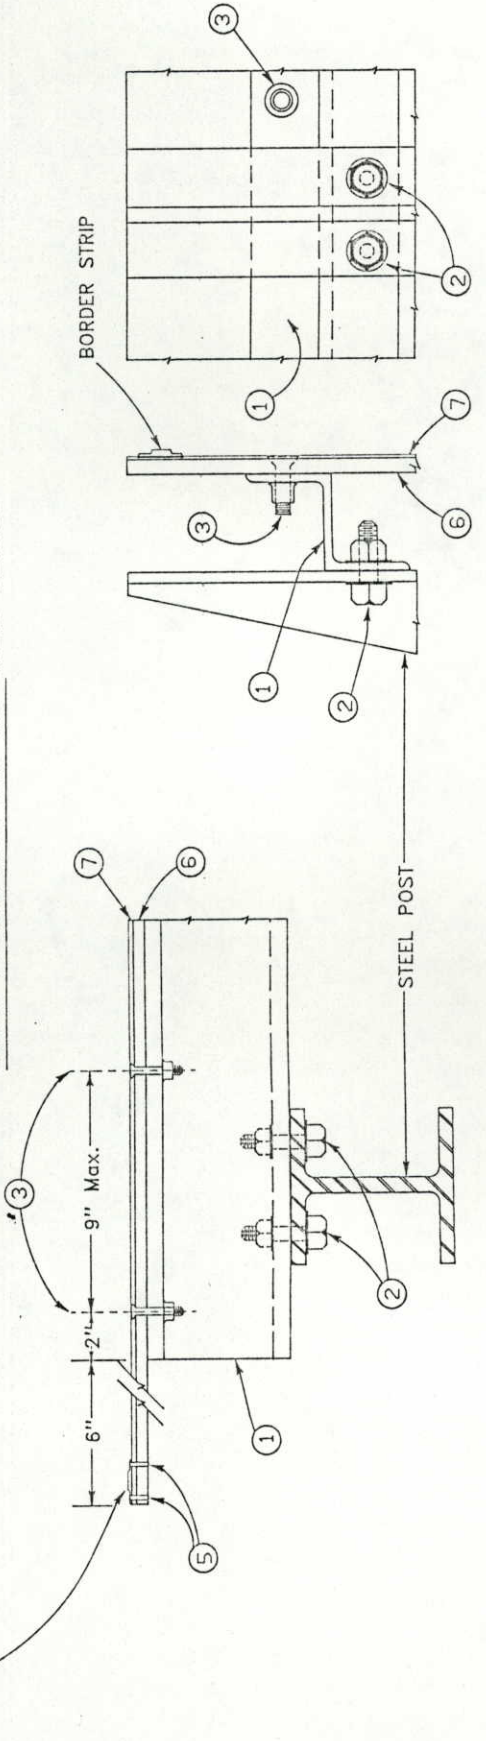

TYPICAL VIEW

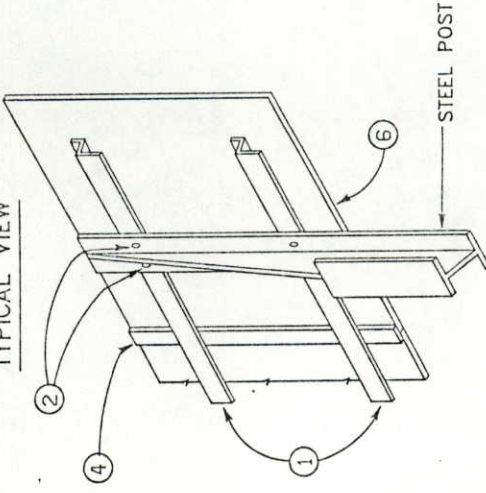


TYPICAL DETAIL SEAM CLOSURE ZEE

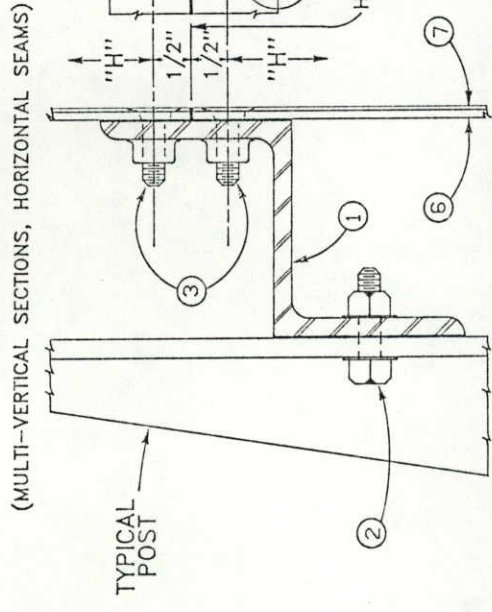

(MULTI-VERTICAL SECTIONS, HORIZONTAL SEAMS)

TYPICAL BORDER DETAILS WITH EXIT NUMBER

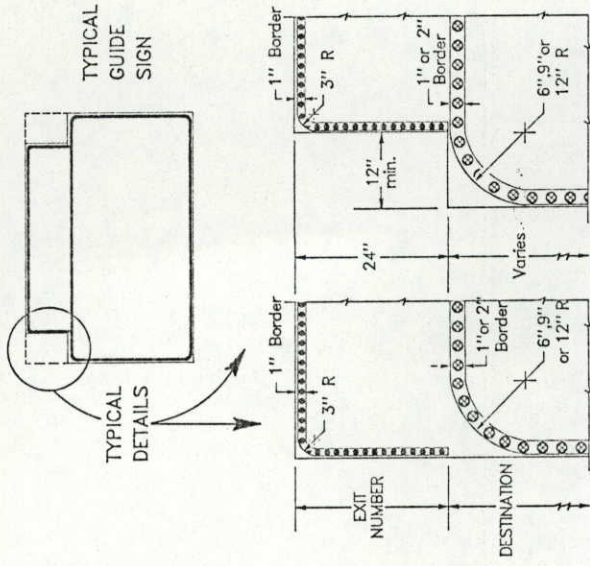

TYPICAL DETAIL
EXIT NUMBER
WITHOUT INDENTATION


TYPICAL DETAIL
EXIT NUMBER
WITH INDENTATION




STANDARD S-614-5

(SHEET 1 OF 2 SHEETS)
SPECIAL FOR THIS PROJECT


TYPICAL ELEVATION
STEEL POST ASSEMBLY

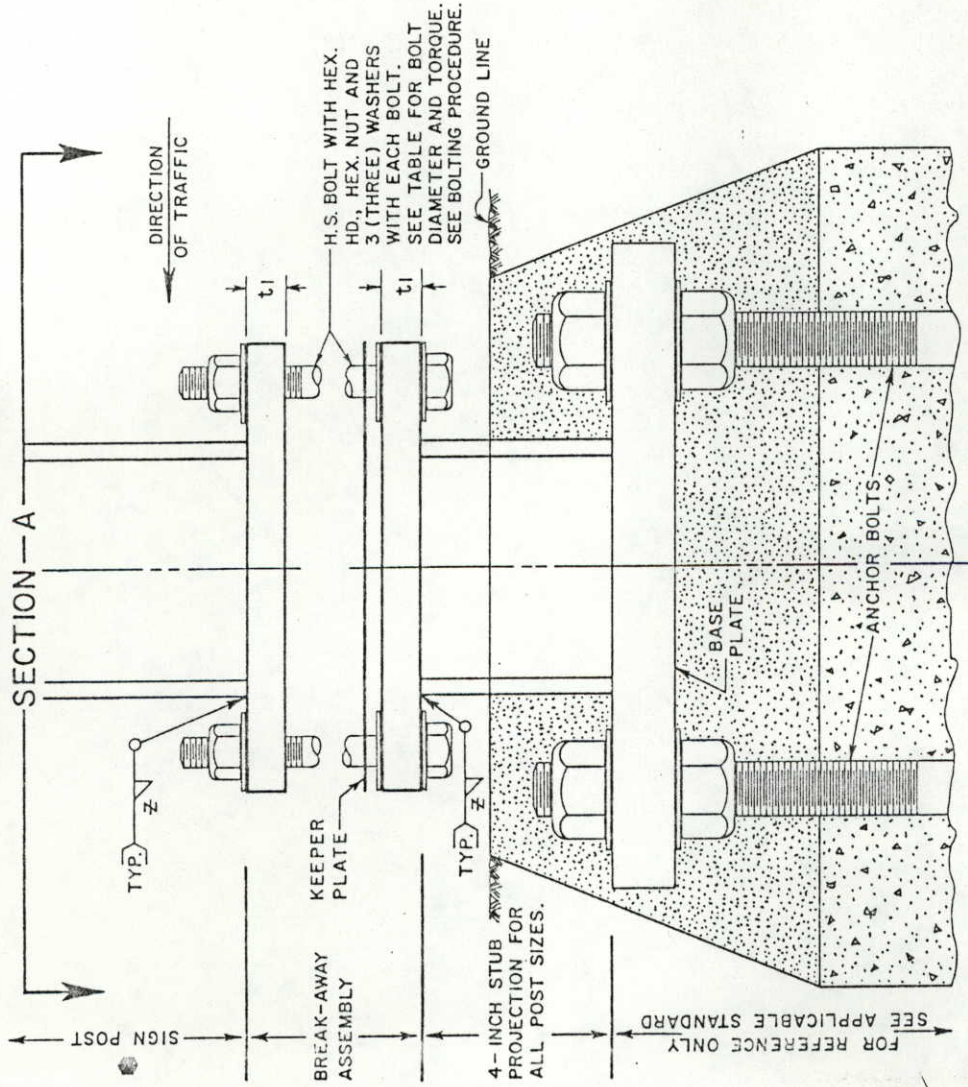


TYPICAL SECTION -A-

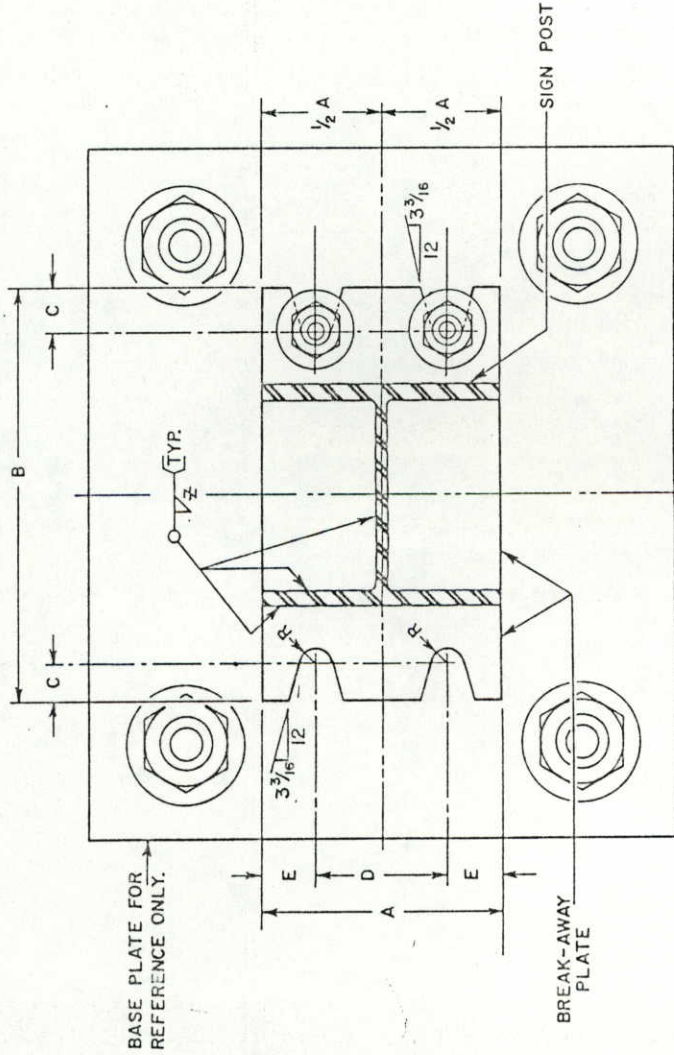

TYPICAL BREAK-AWAY SIGN SUPPORT INSTALLATIONS

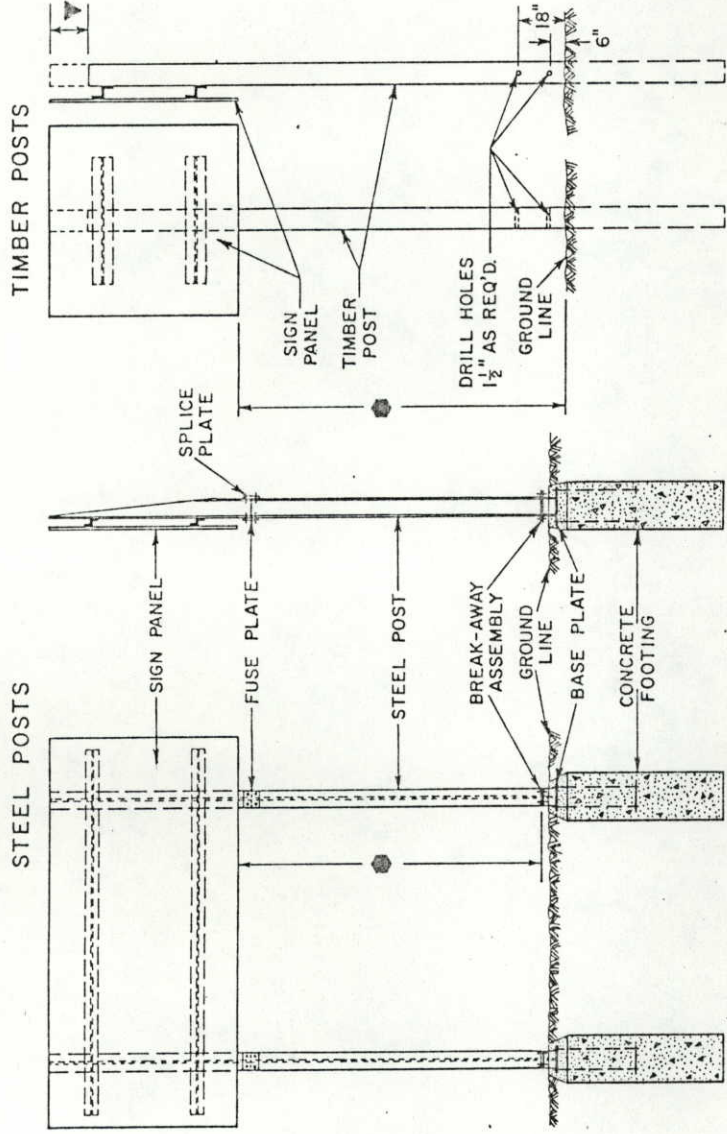

TYPICAL PROJECTED VIEW
STEEL POST ASSEMBLY

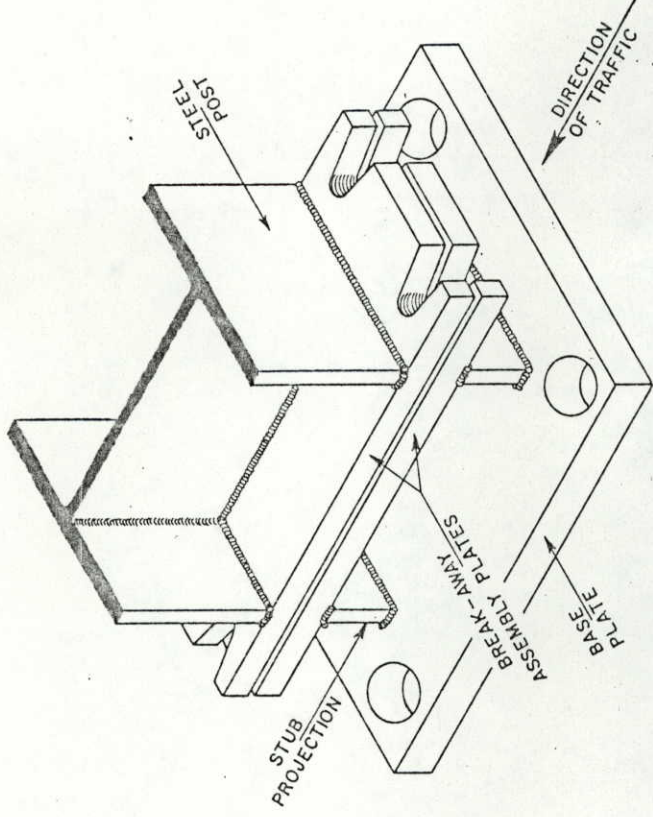

GENERAL NOTES

1. All work shall be done in accordance with the Standard Specifications applicable to the Project.
2. Design conforms with AASHTO "Specifications for the Design and Construction of Structural Supports for Highway Signs".
3. All structural steel shall conform to ASTM - A36 and Section 509 of the Standard Specifications.
4. Steel fuse plates and splice plates shall conform to ASTM - A36.
5. All high strength bolts, nuts and washers shall conform to ASTM - A325. Washers used in the Break-Away Plate and Fuse Plate assemblies shall be of sufficient strength to prevent any deflection or "cupping" into the slotted grooves under bolt torquing.
6. All bolts other than high strength bolts shall conform to ASTM - A307.
7. All bolts, nuts, and washers shall be galvanized as per ASTM-A153 or ASTM-A164.
8. All holes except for base plate may be drilled or sub-punched and reamed.
9. All steel cuts shall preferably be saw cuts; however, flame cutting will be permitted provided all edges are ground. Remove all burrs. Metal shall not project beyond the plane of the plate face.

10. A "Keeper Plate" of thin (28-gage) galvanized sheet metal, fabricated to match break-away plate dimensions but with holes rather than slots, shall be used to restrain bolt loosening due to wind vibration.
11. High strength bolts in the break-away assembly shall be tightened only to the torque shown in the table. DO NOT OVERTIGHTEN.
12. The "STUB POST" and one "BREAK-AWAY PLATE" are considered part of the footing. The other "BREAK-AWAY PLATE" and all nuts, bolts, washers and keeper plate for fastening the break-away plates are considered to be a part of the post.
13. Timber posts shall be in accordance with Section 614 of the Standard Specifications as to Size, Alternate Size, Grade, Species, Treatment, and Break-Away Holes.
14. For all base plate and footing work see the applicable Standard included in the plans.
15. For additional information, refer to "Tabulation of Signs" and "Cross Sections for Class III Signs" included in the plans.
16. Timber post flush with top of sign panel for direct mount and 3 3/8" minimum above bolt for backing zee mount.
17. Minimum post length from bottom of sign panel to break-away assembly or ground line shall be 7' (in no case shall a backing zee be placed below the fuse plates).

BOLTING PROCEDURE FOR
BREAK-AWAY PLATE ASSEMBLY

1. Assemble post to stub with bolts - one flat washer on each bolt top and bottom, and one flat washer on the keeper plate between the break-away plates.
2. Tighten all bolts to a "snug tight" condition with a 12" to 15" wrench to bed washers and to clean bolt threads, then loosen each bolt in turn and retighten in a systematic order to the prescribed torque. (See Break-Away Plate Data Table)
3. Burr threads at junction with nut to prevent nut loosening.

BREAK-AWAY PLATE DATA TABLE

DIMENSION	BOLT SIZE AND TORQUE	A	B	C	D	E	t1	WELD	R	STUB POST LENGTH
POST SIZE										
W 12 x 40	7/8" x 3 3/4" 1,135 In. Lb.	8"	19 1/4"	15 1/8"	4"	2"	1 1/4"	3/8"	15/32"	0'-4"
W 12 x 35		6 1/2"	17"	7 7/8"	3 1/2"	1 1/2"	1"	5/16"	13/32"	0'-4"
W 10 x 26	3/4" x 3 1/2" 750 In. Lb.	5 3/4"	14 7/8"	7 1/8"	3 1/4"	1 1/4"	1"	5/16"	13/32"	0'-4"
W 10 x 22		5 3/4"	14 7/8"	7 1/8"	3 1/4"	1 1/4"	1"	5/16"	13/32"	0'-4"
W 8 x 21		5 1/4"	12 5/8"	7 1/8"	2 3/4"	1 1/4"	1"	5/16"	13/32"	0'-4"
W 8 x 18		5 1/4"	12"	3 3/4"	3"	1 1/2"	3/4"	1/4"	11/32"	0'-4"
W 6 x 15	5/8" x 2 3/4" 450 In. Lb.	6"	10"	3 3/4"	3 3/4"	1 1/8"	3/4"	1/4"	11/32"	0'-4"
W 6 x 12		5"	10"	3 3/4"	2 3/4"	1 1/8"	3/4"	1/4"	11/32"	0'-4"

DEPARTMENT OF HIGHWAYS
STATE OF COLORADO
DIVISION OF HIGHWAYS
BREAK-AWAY SIGN
SUPPORT DETAILS
FOR GROUND SIGNS

Designed By: J.J.B.
Reviewed By: F.J.B.
Checked By: J.E.M.
Approved By: J.E.M.
Safety Projects Engineer
Date: January 1980