

AUG 10 1982
SMITH-CONYERS

See Standard M-100-1 for STANDARD SYMBOLS

STATE DEPARTMENT OF HIGHWAYS DIVISION OF HIGHWAYS—STATE OF COLORADO

R.O.W on Proj. F012-2(12)

FEDERAL ROAD REGION NO.	DIVISION	PROJECT NO.	SHEET NO.
801	COLORADO	C 01-0006-06	1

AS CONSTRUCTED		
NO REVISIONS	REVISED	VOID

PLAN AND PROFILE OF PROPOSED COLORADO PROJECT NO. C 01-0006-06 STATE HIGHWAY NO. 6 DENVER COUNTY

INDEX OF SHEETS

SHEET NO.	
1	TITLE PAGE
2	STANDARD PLANS LIST
3	GENERAL NOTES, LIST OF STRUCTURES, CONSTRUCTION TRAFFIC CONTROL DEVICES, TYPICAL PLACEMENT OF GUARD RAIL TYPE 4 AND MISCELLANEOUS DETAILS
4	SUMMARY OF APPROXIMATE QUANTITIES
5-6	GUARD RAIL - TYPE 4 CONCRETE BARRIER
7-9	PLAN AND PROFILE
10-12	UTILITY PLAN AND PROFILE

PRELIM.


SCALES OF ORIGINAL DRAWINGS


ON PLAN, 1 IN. = 50 FT.
ON PROFILE { 1 IN. = 50 FT. HORIZONTAL
1 IN. = 10 FT. VERTICAL


GRADE LINE ON PROFILE IS SHOWN AS GRADE OF FINISHED ROAD

TABULATION OF LENGTH

STATION	ROADWAY LIN. FT.
392+15 BEGIN PROJ. C01-0006-06 = 392+15 ON FCU 006-1(38)	2015
412+30 END PROJ. C01-0006-06 = 412+30 ON FCU 006-1(38)	2015
TOTAL	2015
SUMMARY	
ROADWAY NET & GROSS LENGTH	LIN. FT. 2015 MILES 0.362

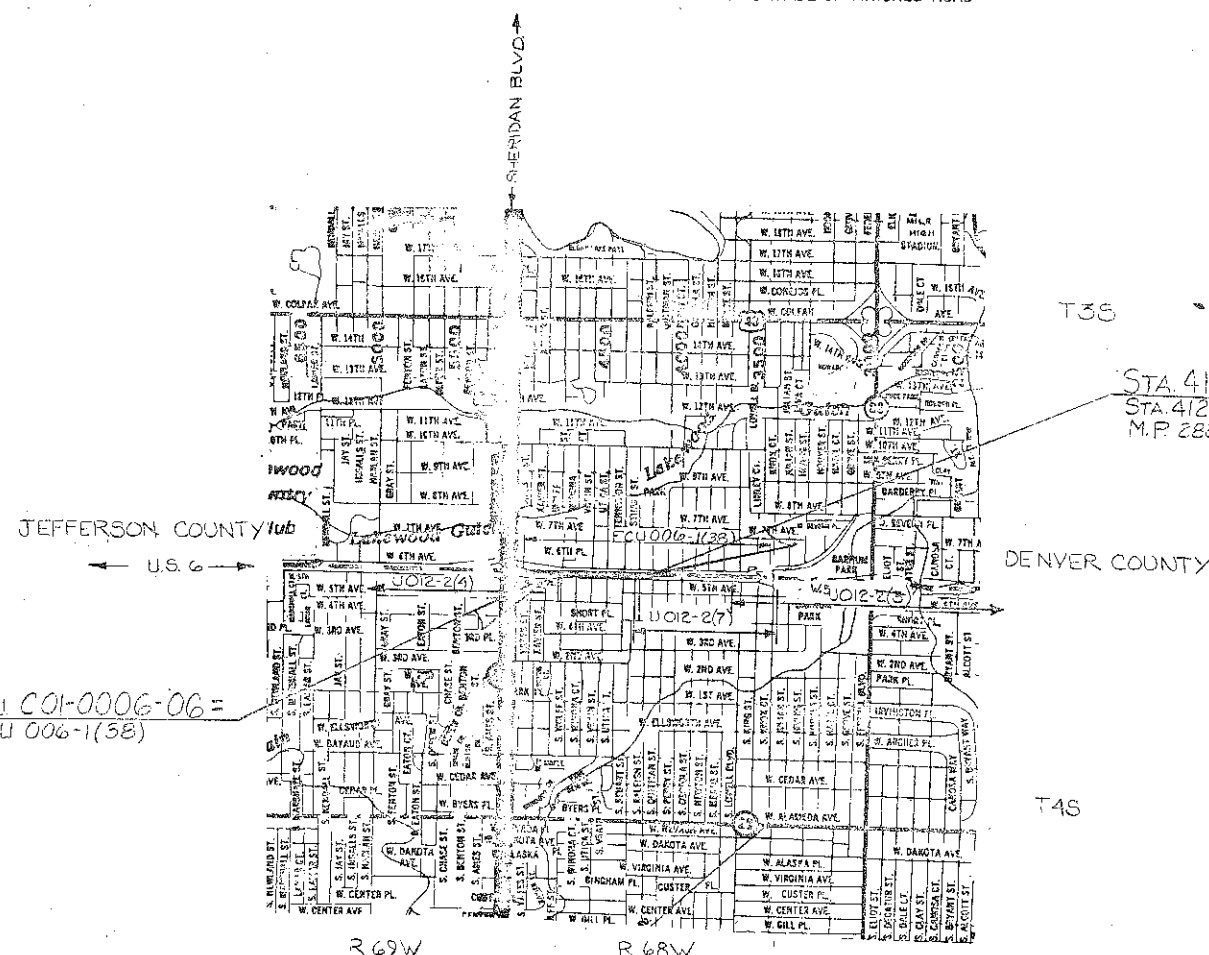

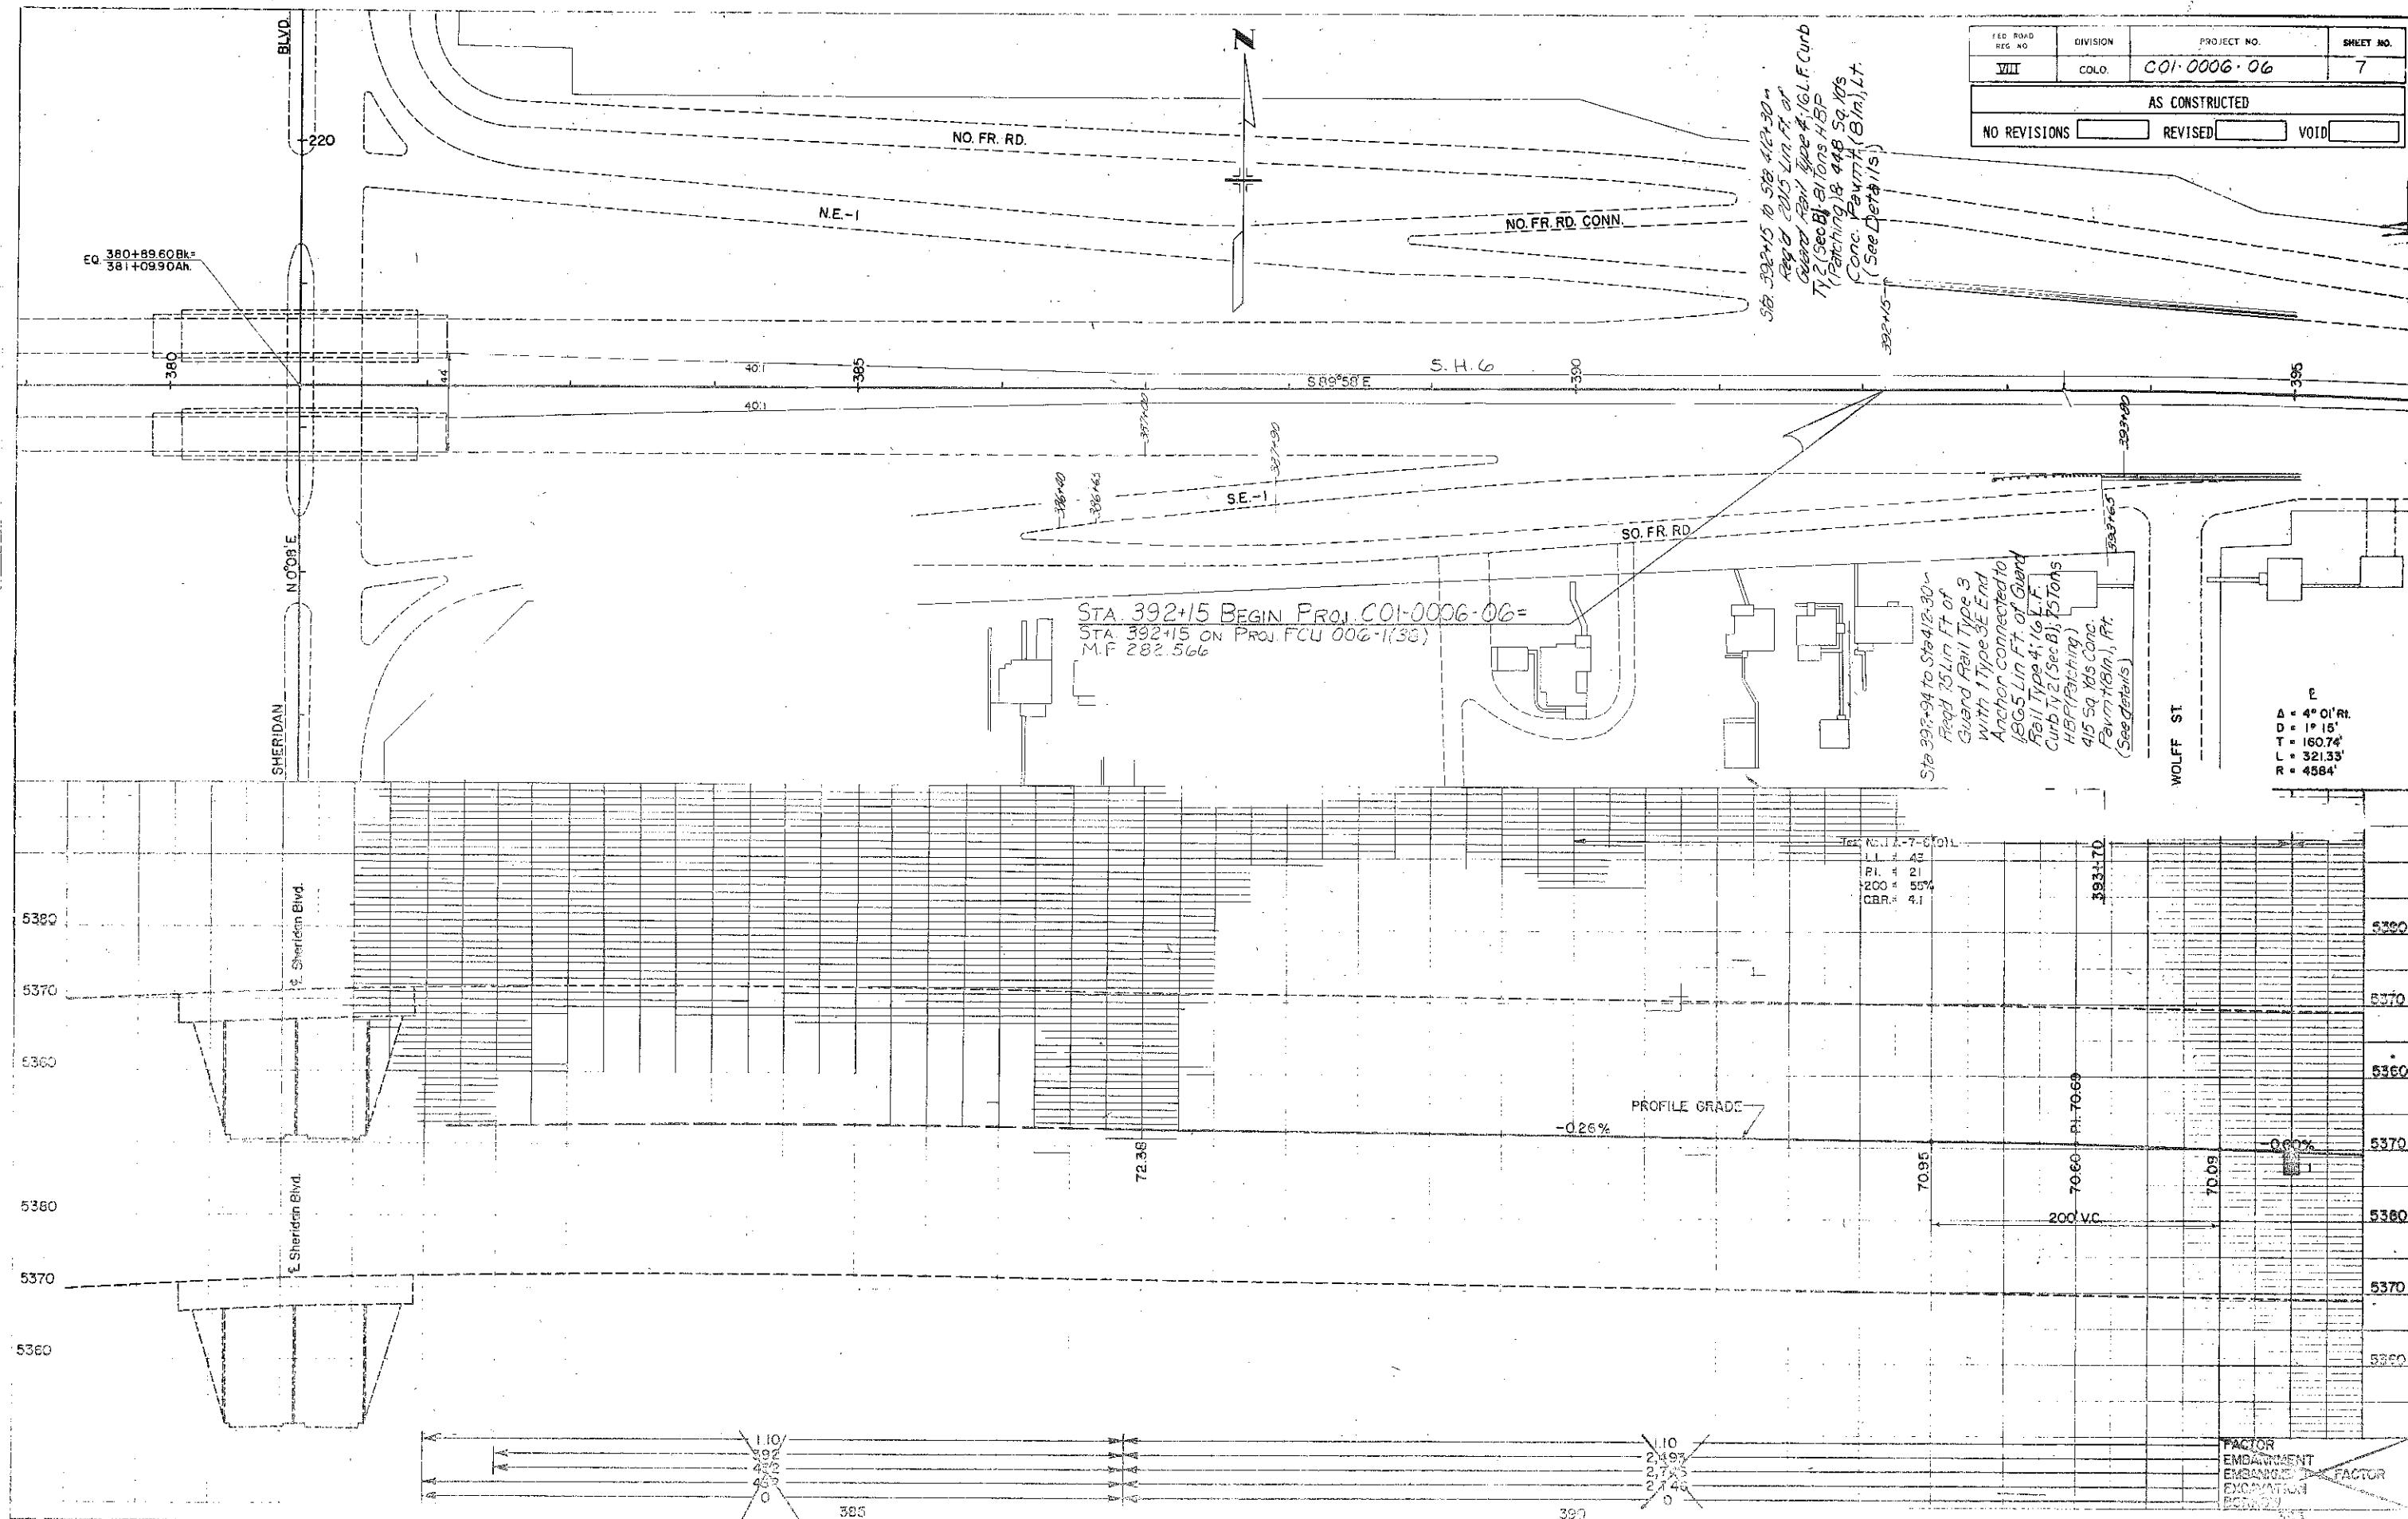

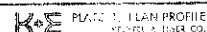

FED. ROAD REG. NO.	DIVISION	PROJECT NO.	SHEET NO.
VIII	COLO	C 01-0006-06	9

AS CONSTRUCTED

NO REVISIONS ☐ REVISED ☐ VOID ☐

STA. 412+30 END PROJ. C 01-0006-06=
STA. 412+30 ON PROJ. FOU 004-1(38)
M.P. 282.947

NO. FR. RD.

S.H. 6

S 89° 58' E

SO. FR. RD.


STUART

RALEIGH

QUITMAN

PERRY

OSCEOLA

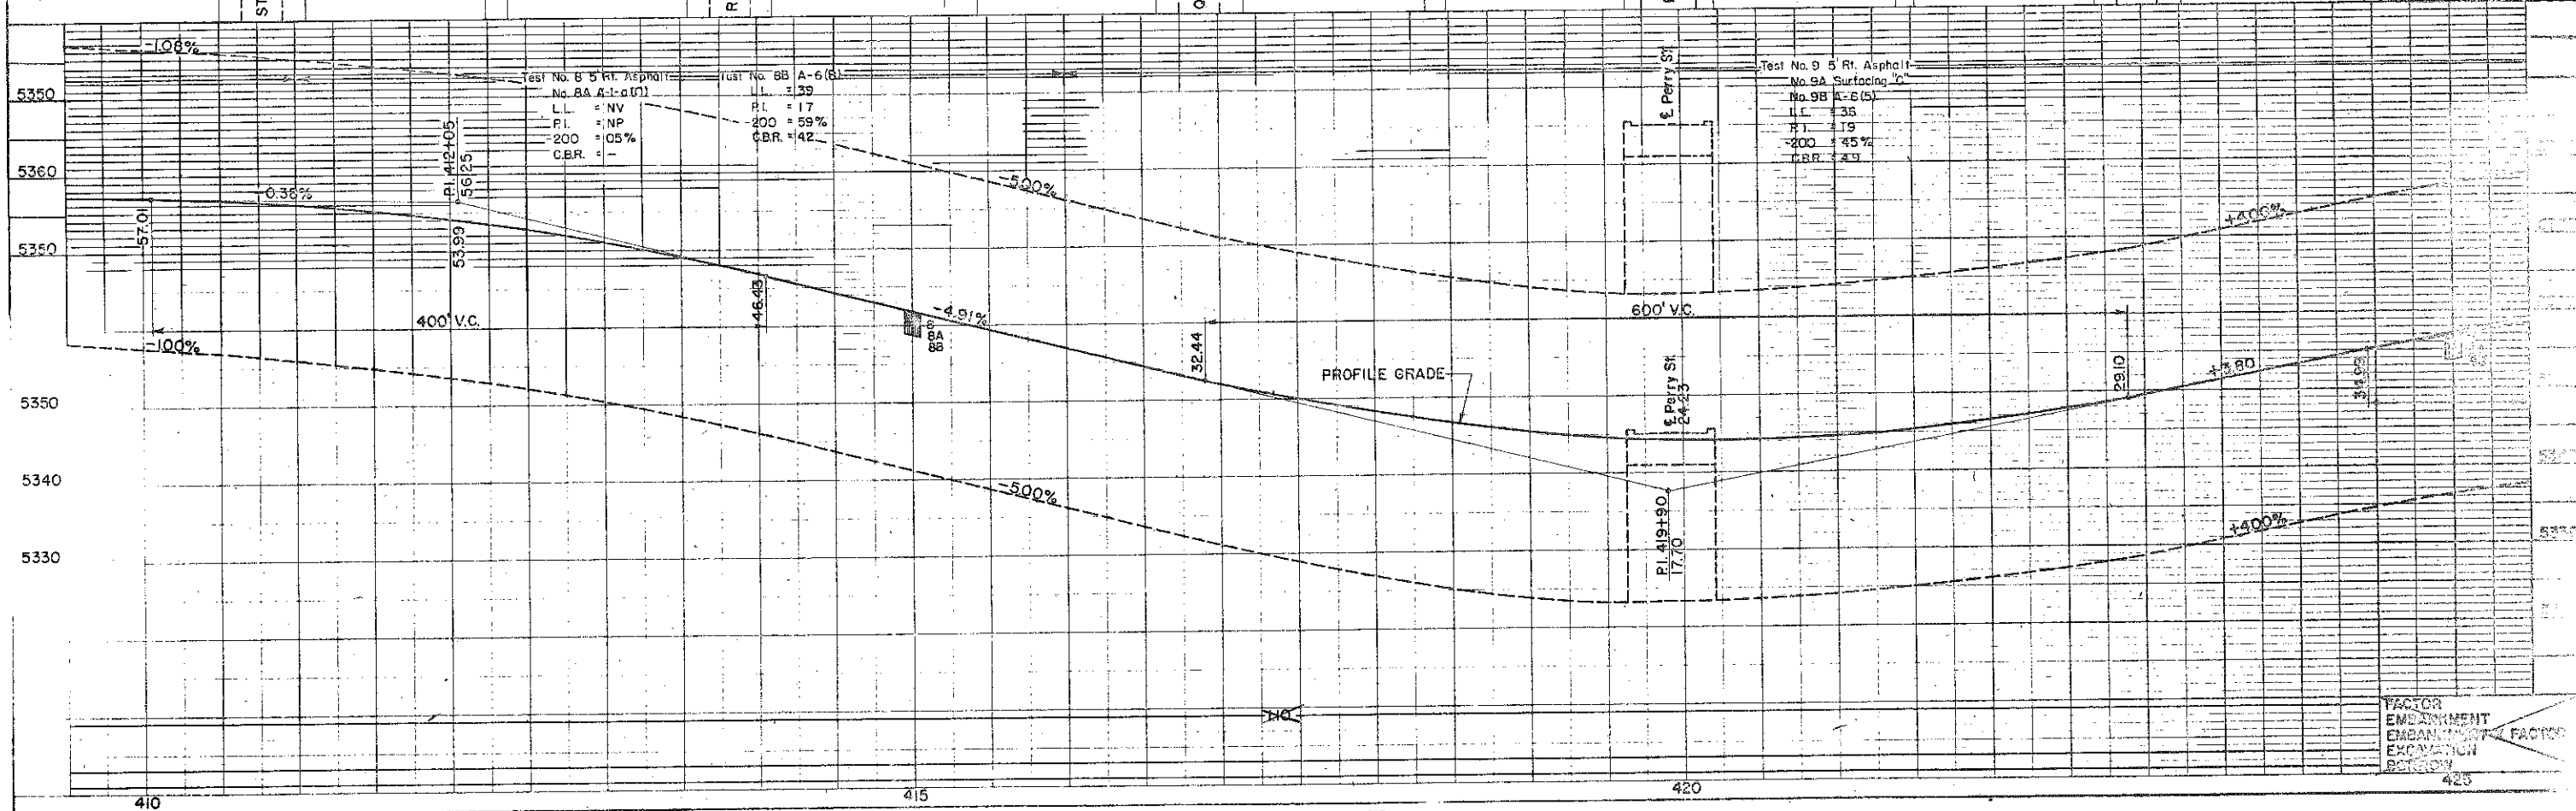



FACTOR
EMBANKMENT
EXCAVATION
BELOW

UTILITY PLANS
(FOR INFORMATION ONLY)


FED. ROAD LEG. NO.	DIVISION	PROJECT NO.	SHEET NO.
VIII	COLO	C01-0006-06	10

AS CONSTRUCTED

NO REVISIONS ☐ REVISED ☐ VOID ☐

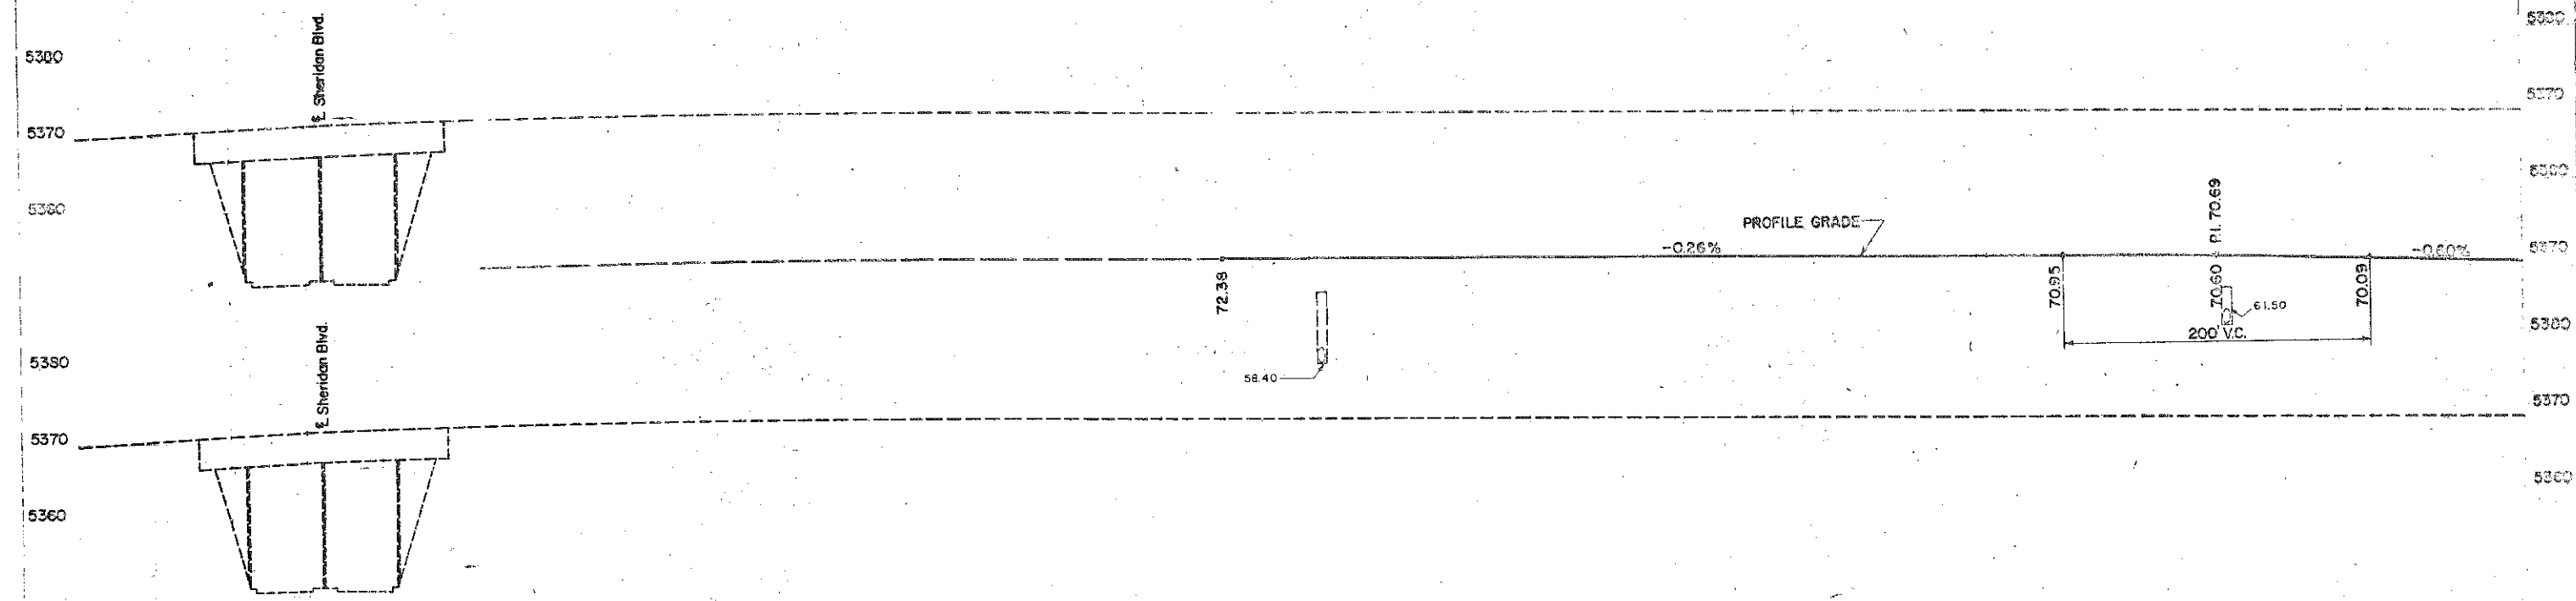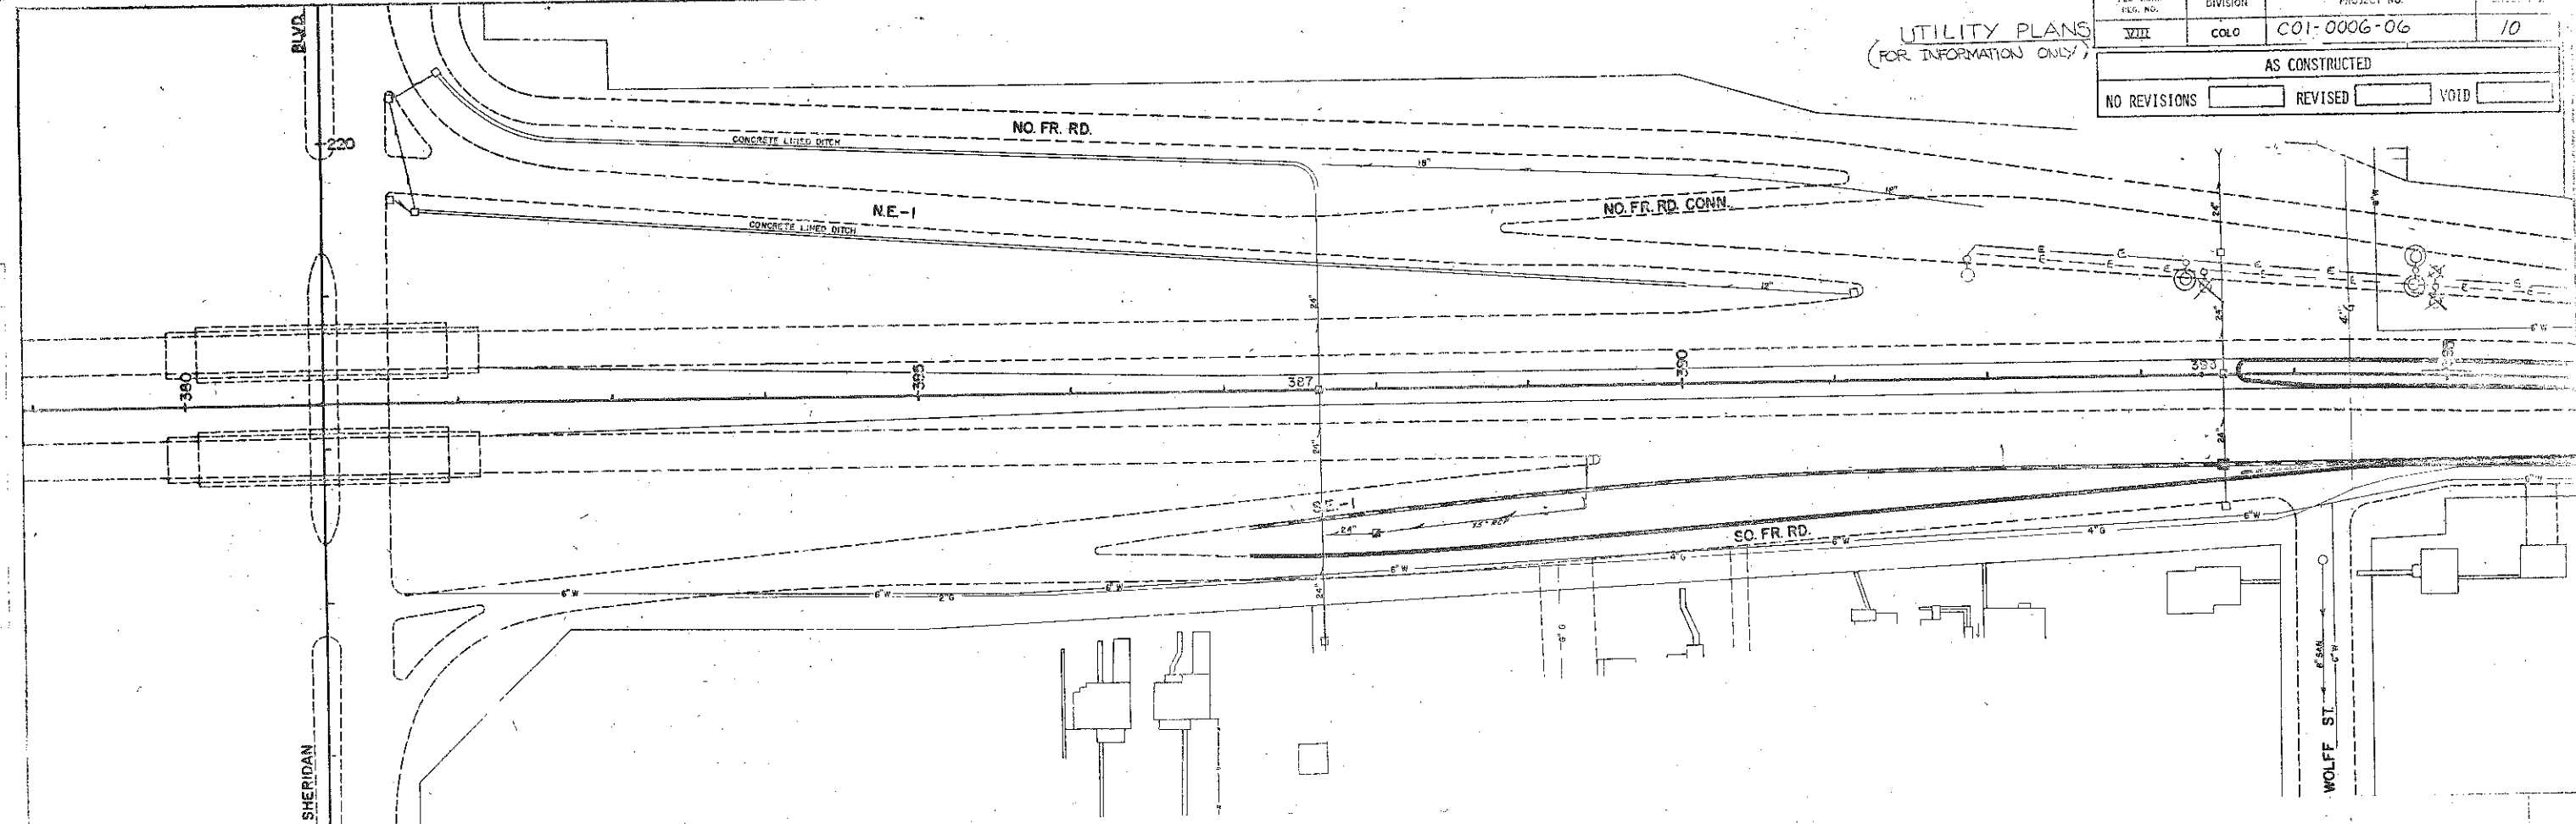

UTILITY PLANS (FOR INFORMATION ONLY)

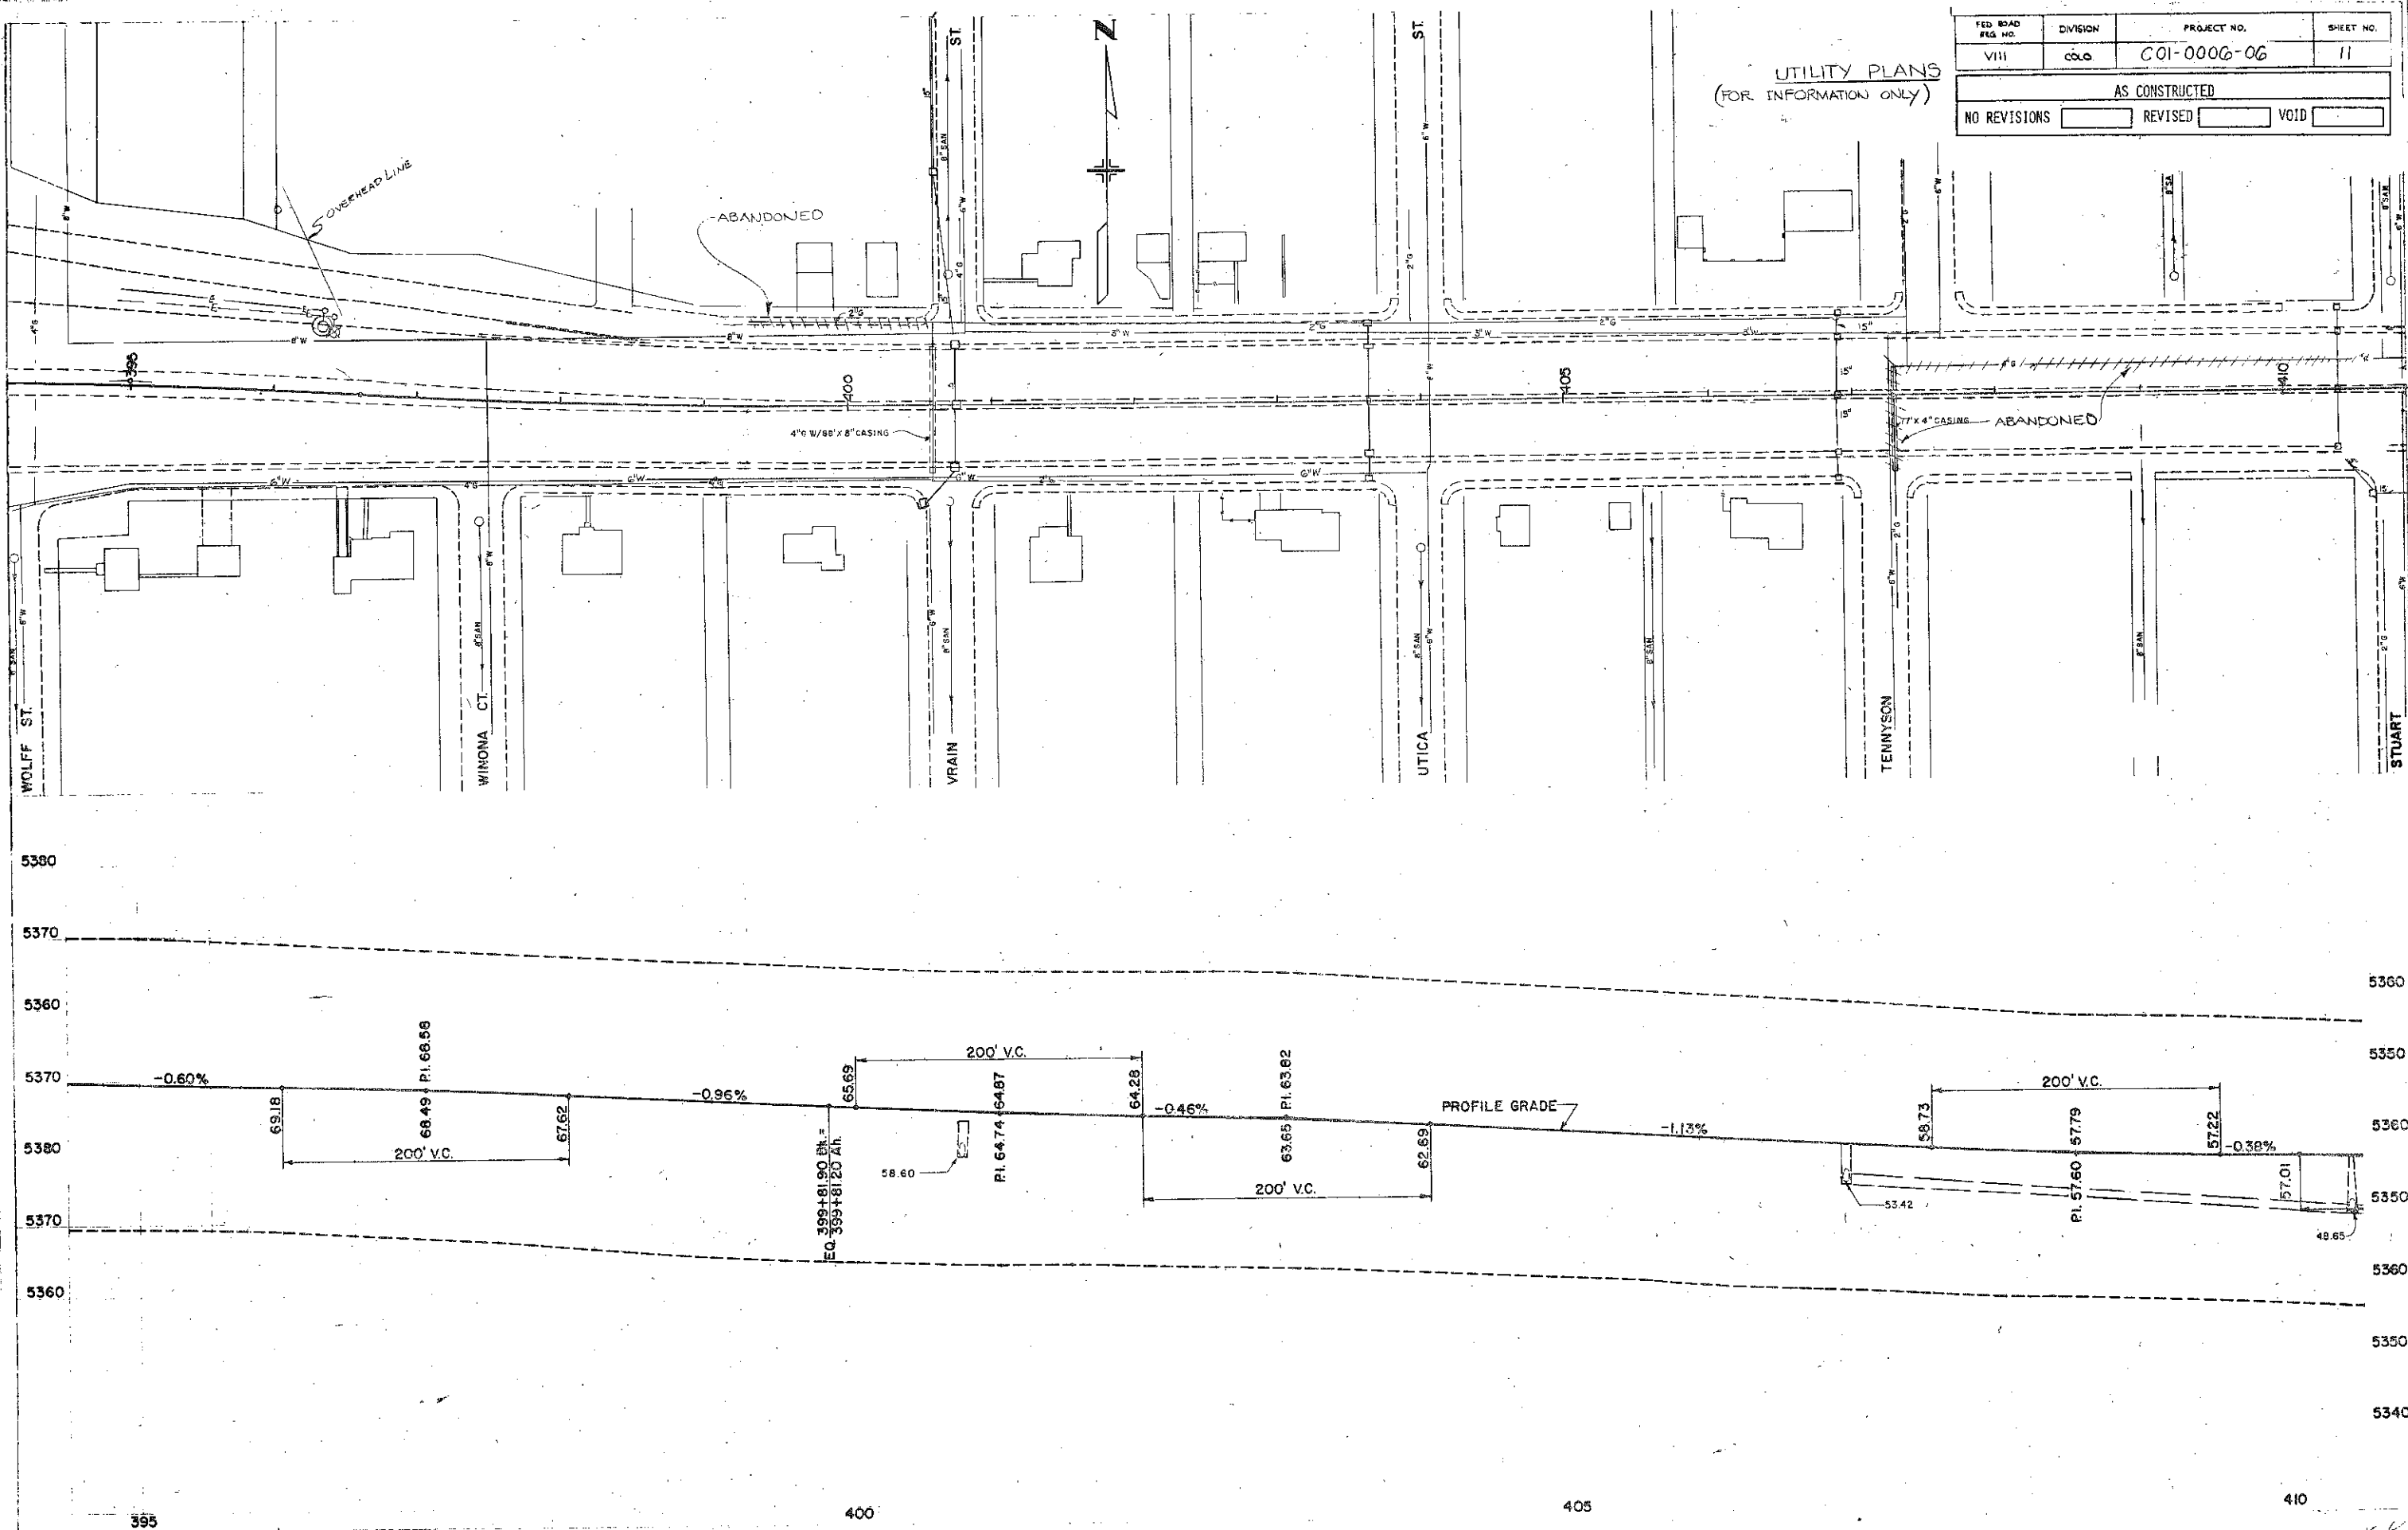

UTILITY PLANS
(FOR INFORMATION ONLY)

FED. ROAD DIST. NO.	DIVISION	PROJECT NO.	SHEET NO.
VIII	COLD	COI-0006-06	12
AS CONSTRUCTED			
NO REVISIONS ☐ REVISED ☐ VOID ☐			

