

INDEX OF SHEETS
SHEET NO. 1 TITLE SHEET
2 TABULATION OF PROPERTIES
3-7 PLAN AND PROFILE SHEETS
SHOWING RIGHT OF WAY

COLORADO
DEPARTMENT OF HIGHWAYS
PLAN AND PROFILE OF PROPOSED
STATE PROJECT NO. C 06-0001-14
STATE HIGHWAY NO. 1
LARIMER COUNTY

SCALES OF ORIGINAL DRAWINGS

ON PLAN, 1 IN. = 100 FT.
ON PROFILE, 1 IN. = 100 FT. HORIZONTAL
1 IN. = 10 FT. VERTICAL
GRADE LINE ON PROFILE IS SHOWN AS GRADE OF FINISHED ROAD.
GROSS LENGTH OF PROJECT: 35.0866 MI.
NET LENGTH OF PROJECT: 35.0866 MI.

INFORMATION OBTAINED FROM AVAILABLE COUNTY RECORDS

STA. 853+35.6 BEGIN C 06-0001-14 =
STA. 165+00 BK. ON C 06-0001-12
STA. 1205+50 END C 06-0001-14 =
STA. 1205+50 ON F.A.P. 283B


CONVENTIONAL SIGNS
RIGHT OF WAY LINE
COUNTY LINE
TOWNSHIP OR RANGE LINE
LAND LINES
RAILROAD
BARBED WIRE FENCE
COMBINATION WIRE FENCE
SNOW FENCE
TELEPHONE & TELEGRAPH LINES
POWER LINE
BOARD FENCE
PRESENT ROAD (FROM SHEETS)

FEDERAL ROAD DIVISION NO.	DISTRICT	PROJ. NO.	SHEET NO.	TOTAL SHEETS
8	COLORADO	C 06-0001-14	1	

RIGHT OF WAY Const. Engrs

FILE

AS CONSTRUCTED PLANS
RETURN TO DIST. 4 DESIGN

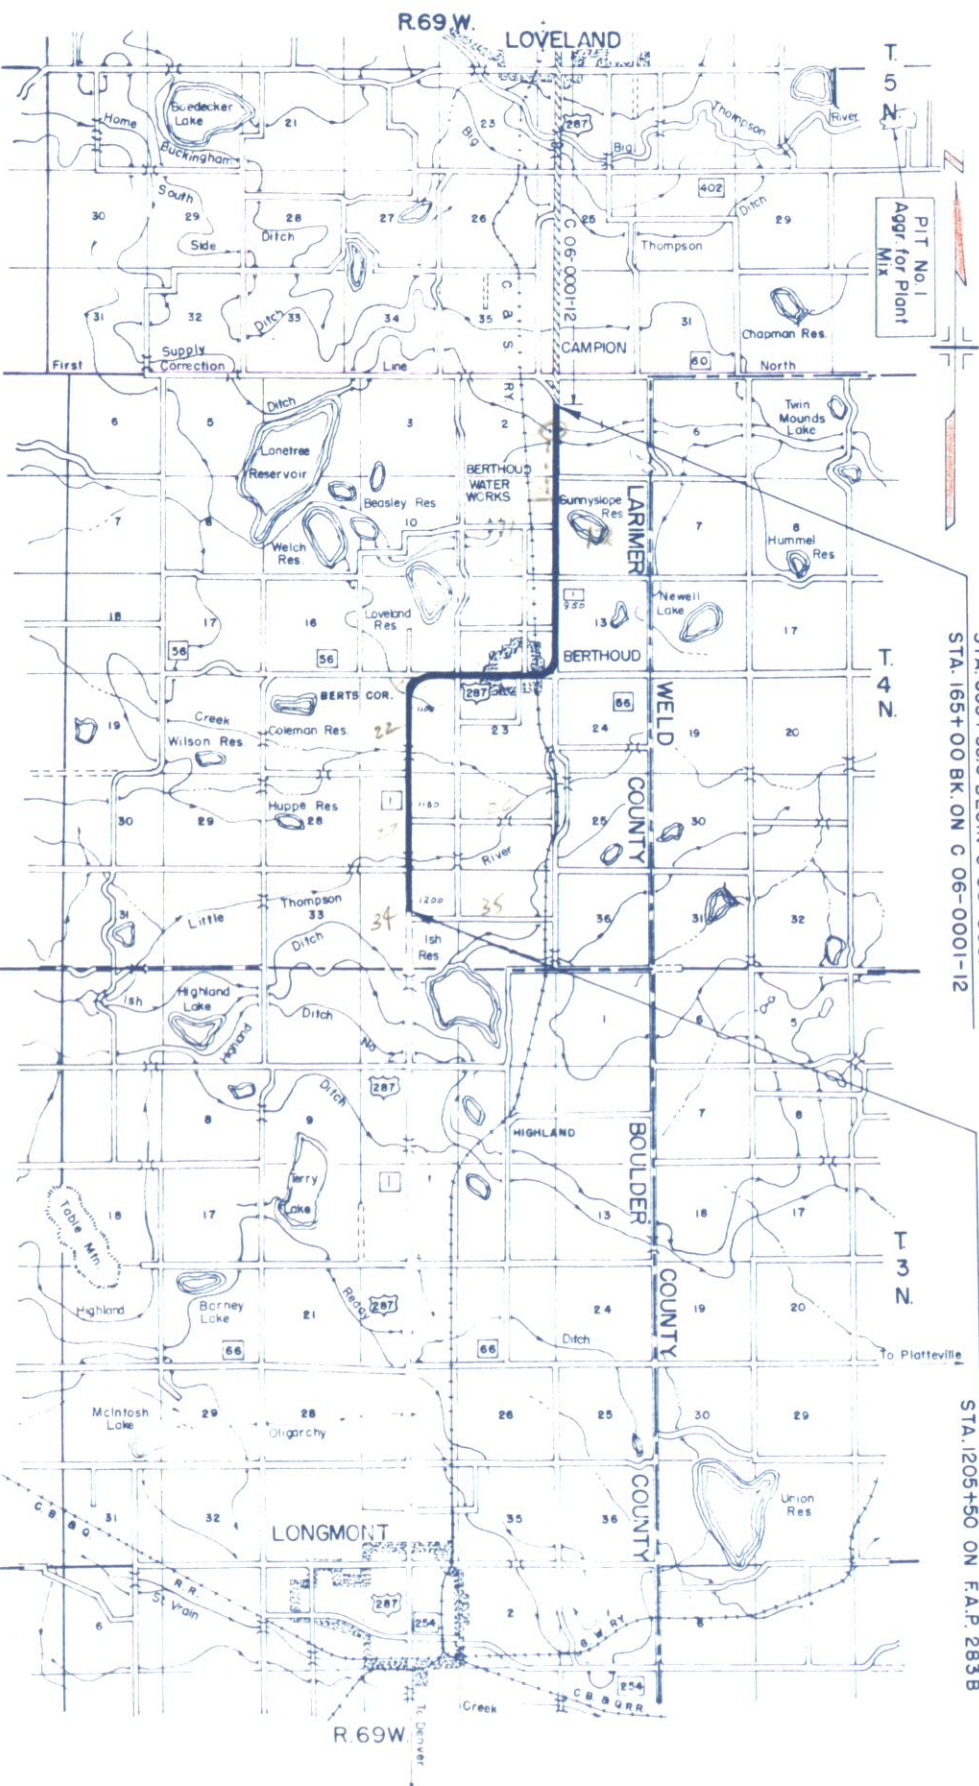

R.O.W.	TABULATION OF PROPERTIES IN	COUNTY	S.H.No. 1	PROJ. C 06-0001-14
	LARIMER			

FEDERAL ROAD DIVISION NO.	DISTRICT	PROJ. NO.	SHEET NO.	TOTAL SHEETS
9	COLORADO	C06-0001-14	2	

RIGHT OF WAY

PARCEL NO.	OWNER	ADDRESS	LOCATION	AREA		IN ACRES		REMARKS
				TOTAL LAND IN TRACT	PARCEL	TOTAL LAND IN TRACT	TO BE ACQUIRED	
			T 4 N., R 69 W					
1	IRVING T LUDLOW AND IDA FRANCES GRIFFITH	812 3rd Ave., Longmont, Colo.	W 1/2 SE 1/4 Sec. 22	160	1337	0.489		
2	ELMER E. STEPP AND CARRIE STEPP	Berthoud, Colo	N 3/4 NE 1/4 SW 1/4 Sec. 22	103	0.528	0.115		
3	EVERETT M HAWORTH	Berthoud, Colo	S 1/2 SW 1/4 Sec. 22	78	1.203	0.446		
4	HOWARD I MALCHOW AND BEATRICE NOBLE MALCHOW, JOHN C. MALCHOW AND ESSIE FITZ MALCHOW	Berthoud, Colo.	NE 1/4 NW 1/4 Sec. 27	232	0.661	0.227		
5	WILLIE JOHNSON	Berthoud, Colo.	SW 1/4 NE 1/4 Sec. 27	182	0.457	0.149		
6	JAMES MELLINGER, ESTATE	Longmont, Colo	SE 1/4 Sec. 27	158	1.597	0.558		
7	HOWARD I MALCHOW AND BEATRICE NOBLE MALCHOW, JOHN C. MALCHOW AND ESSIE FITZ MALCHOW	Berthoud, Colo	NE 1/4 SW 1/4 Sec. 27	232	0.449	0.092		
8	CHARLES J. O'BRIEN	2021 So. Holly, Denver, Colo.	SE 1/4 SW 1/4 Sec. 27	78	0.192	0.034		
9	PETE HAHN AND LUCILLE HAHN	Berthoud, Colo.	E 1/2 NW 1/4 Sec. 34	160	2.128	0.618		
				</				

NE 4 Sec 22, T4N, R69W

EQUATION

PT 1080+03.8 B.M. = 1080+828.45

Gate

House

1085

1080

1075

995

990

985

995

990

985

1

SE 1/4 Sec. 22, T.4N, R.69W

NE 1/4 Sec. 27, T.4N, R.69W

FED. ROAD DIV. NO.	DIST.	PROJ. NO.	SHEET NO.	TOTAL SHEETS
9	COLO.	C 06-0001-14	4	

RIGHT OF WAY



1 IRVING T. LUDLOW AND IDA FRANCES GRIFFITH
812 3rd AVE., LONGMONT, COLO.
W 1/2 SE 1/4 Sec. 22 160 ACRES

5 WILLIE JOHNSON
BERTHOUD, COLO.
NE 1/4 Sec. 27 182 ACRES

ELMER E. STEPP
AND CARRIE STEPP
BERTHOUD, COLO.
103 ACRES

LUELLA A. KNIGHT
BERTHOUD, COLO.
S 1/2 S 1/2 NE 1/4 SW 1/4 Sec. 22
129 ACRES

3 EVERETT M. HAWORTH
BERTHOUD, COLO.
S 1/2 SW 1/4 Sec. 22
78 ACRES


4 E1 HOWARD I. MALCHOW &
BEATRICE NOBLE MALCHOW,
JOHN C. MALCHOW &
ESSIE FITZ MALCHOW
BERTHOUD, COLO.
N 1/2 SW 1/4, NW 1/4 Sec. 27
232 ACRES

Point of beginning Parcel 3, & 4
100.0' N 89° 05' E to SE corner
of SW 1/4 Sec. 22.

Point of Beginning Easement E-1.
93.3' N 32° 07' 30" E to NE corner
NW 1/4 Section 27.

SW 1/4 Sec. 22, T.4N, R.69W

NW 1/4 Sec. 27, T.4N, R.69W

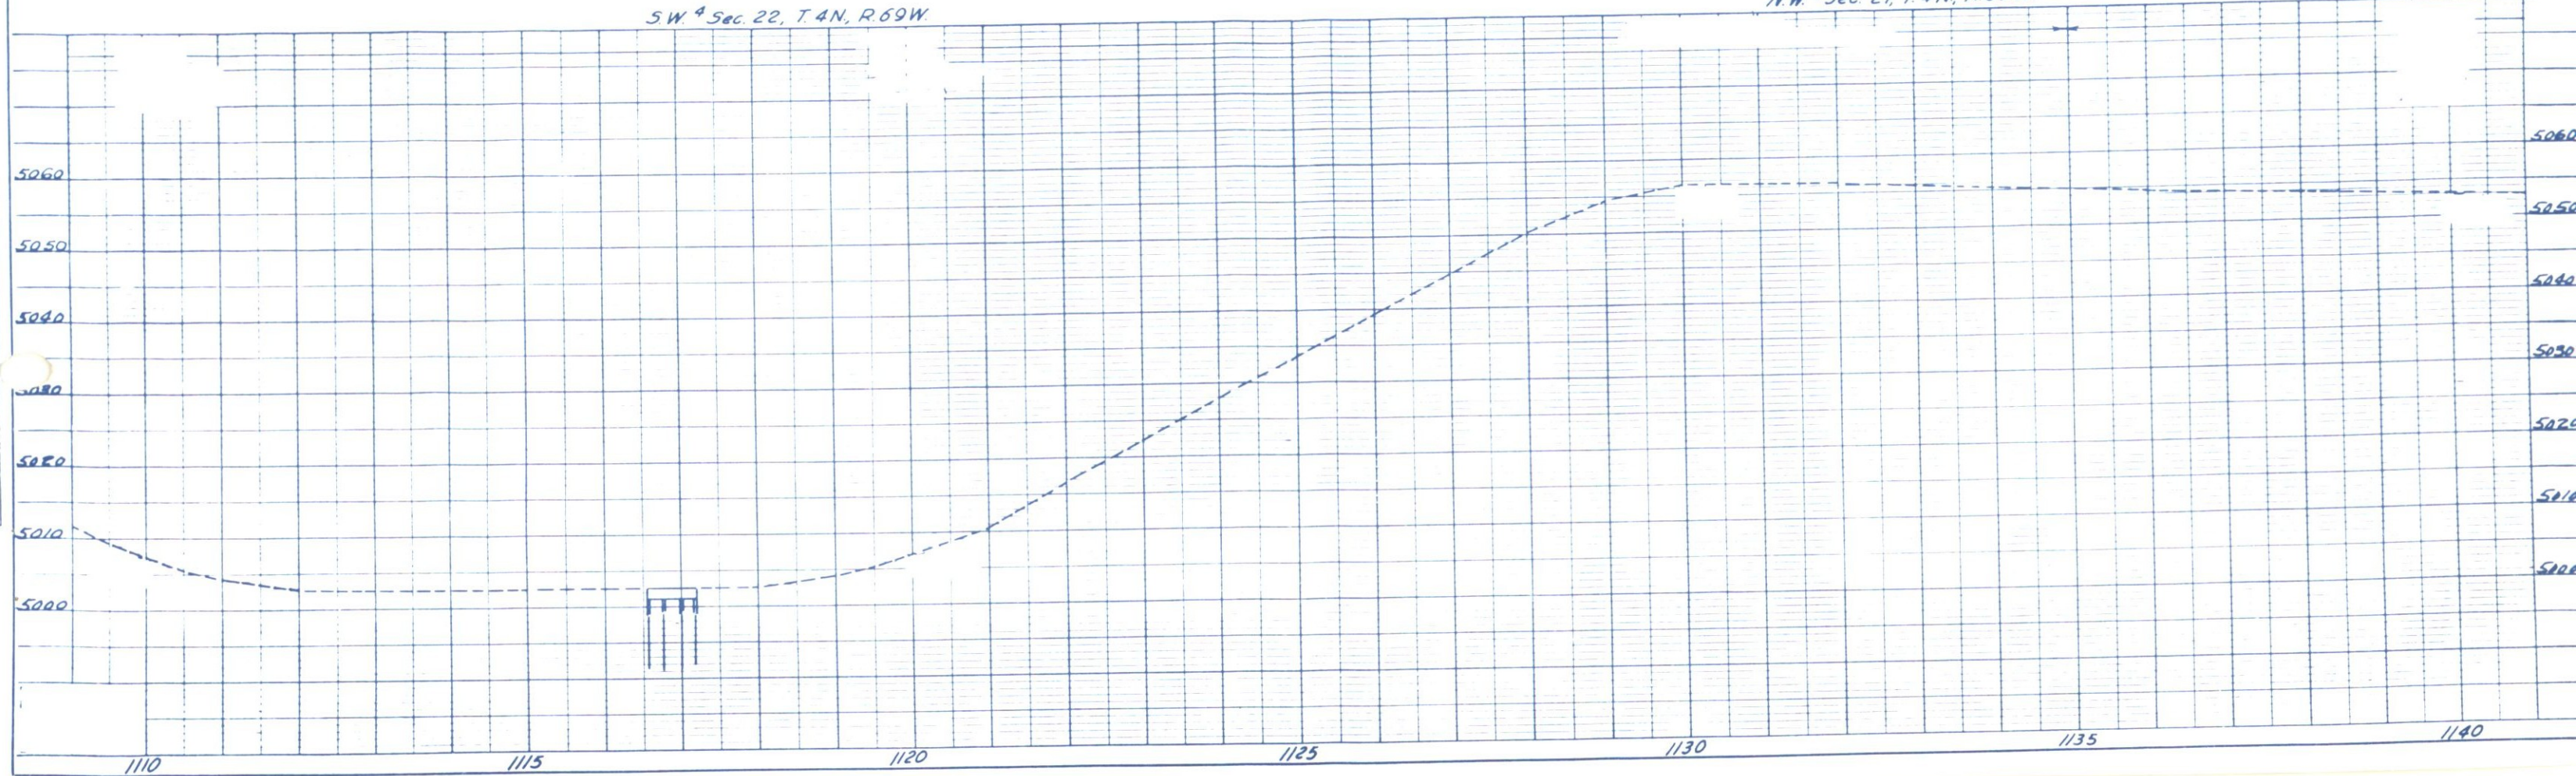


S.E. ⁴ Sec. 27, T.4 N, R. 69 W.

RIGHT OF WAY



S.W. ⁴ Sec. 27, T. 4 N., R. 69 W.

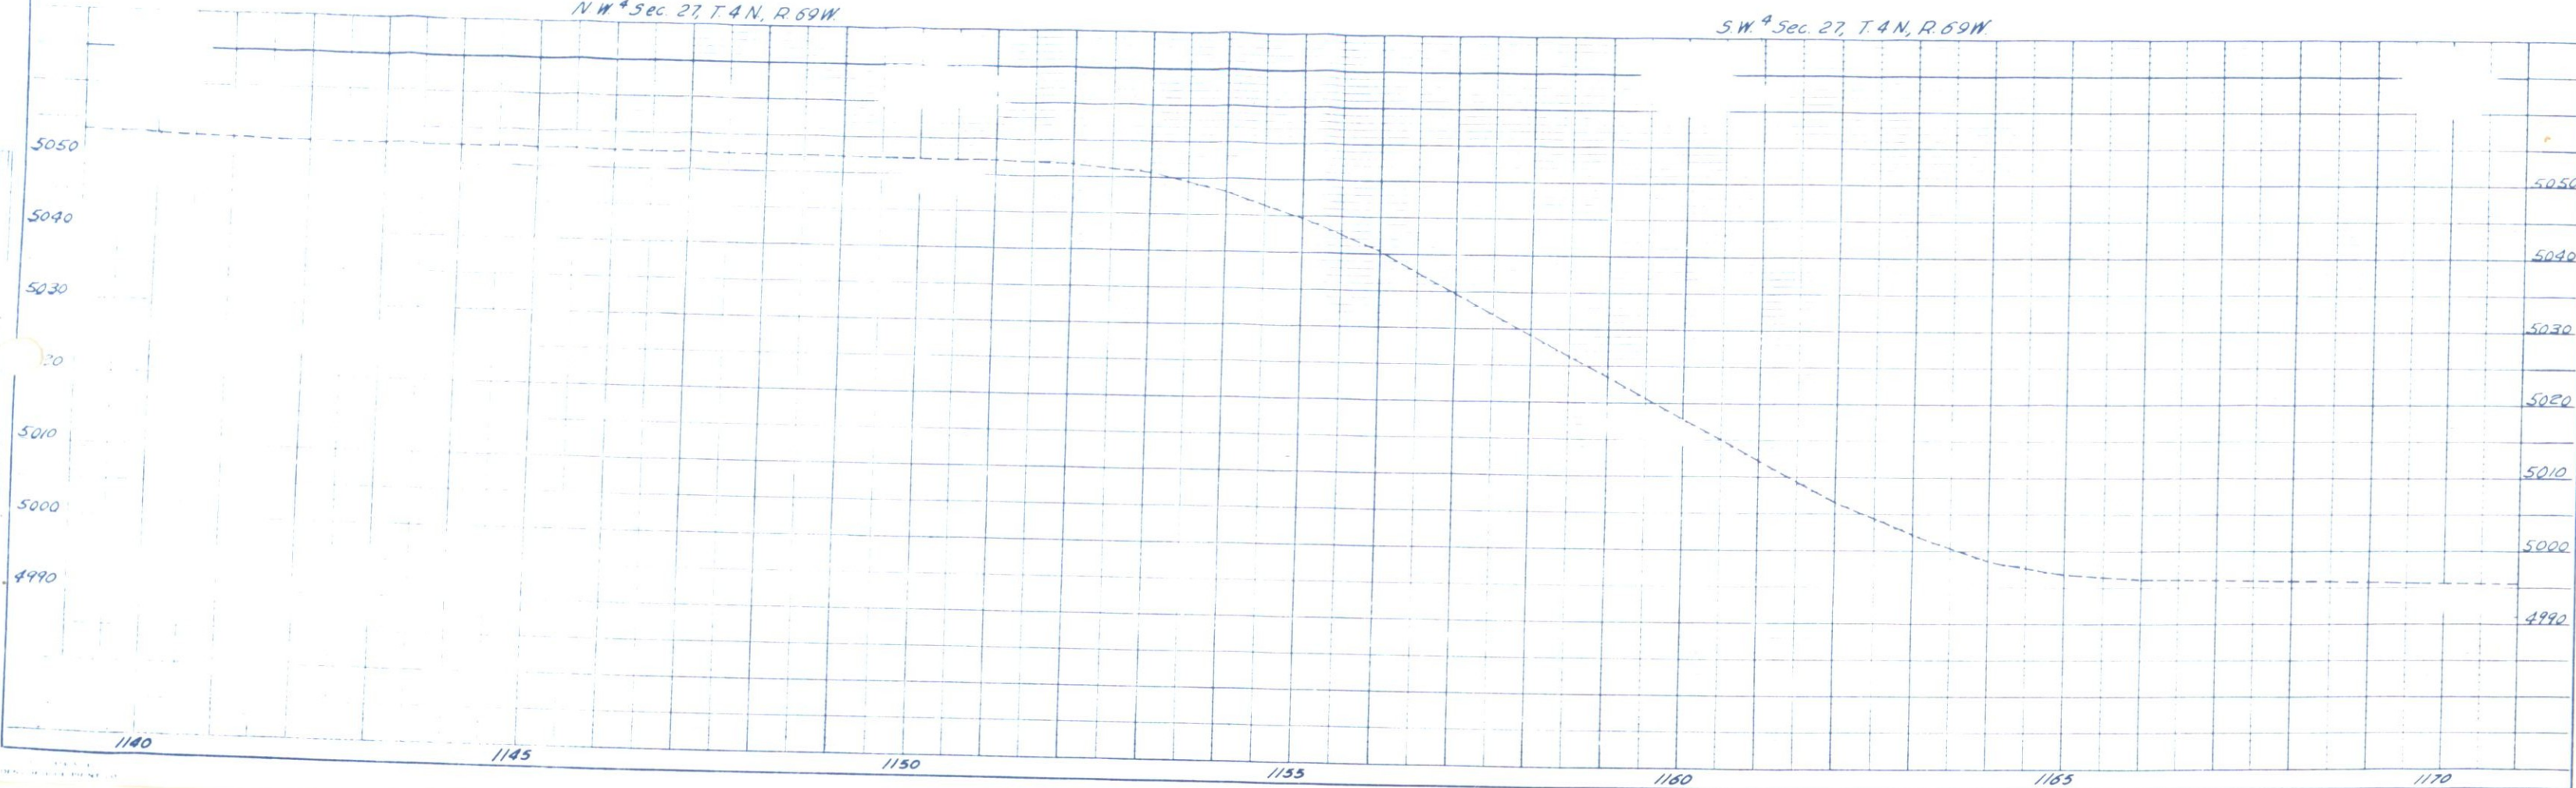

S.E. 1/4 Sec. 27, T.4N, R.69W.

6 JAMES MELLINGER, ESTATE
LAURA H. MELLINGER
FIRST NAT'L BANK OF LONGMONT
LONGMONT, COLO.
SE 1/4 Sec. 27 158 ACRES

8 CHARLES J. O'BRIEN
2021 So. Holly
DENVER, COLO.
S 1/2 SW 1/4 Sec. 27
78 ACRES

S.W. 1/4 Sec. 27, T.4N, R.69W.

N.E. 1/4 Sec. 34, T.4N, R.69W.

9 PETE HAHN & LUCILLE HAHN
BERTHOUD, COLO.
NW 1/4 Sec. 34 160 ACRES

N.W. 1/4 Sec. 34, T.4N, R.69W.



FED ROAD DIST	PROJ NO	SHEET NO	TOTAL SHEETS
9	COLO C 06-0001-14	6	

RIGHT OF WAY



