


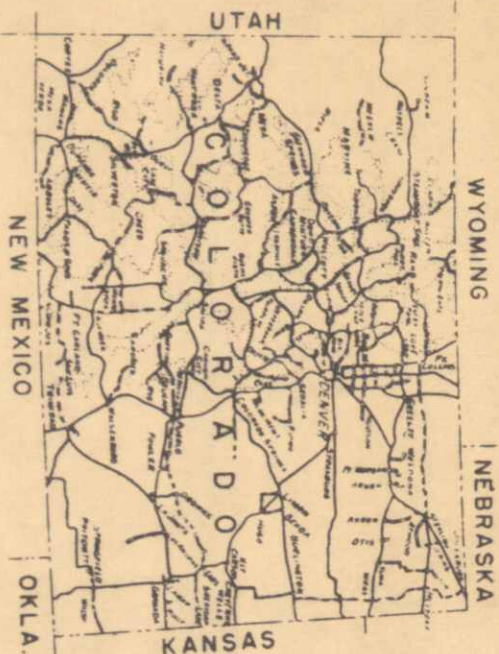

U.S. DEPARTMENT OF COMMERCE
BUREAU OF PUBLIC ROADS

PLANS FOR PROPOSED
COLORADO FOREST HIGHWAY PROJECT C 07-0160-01
WARD - RAYMOND


R.O.W. LENGTH=3.402 MILES

CLASS 2

ROOSEVELT NATIONAL FOREST
BOULDER COUNTY

REGION	9	STATE	COLORADO
PROJECT	C 07-0160-01	OF	SHEETS
SHEET	1	OF	SHEETS
RIGHT OF WAY	WARD-RAYMOND	REVISIONS	


INDEX OF SHEETS	TITLE PAGE
2	TABULATION OF PROPERTIES
3-9	PLAN & PROFILE SHEETS

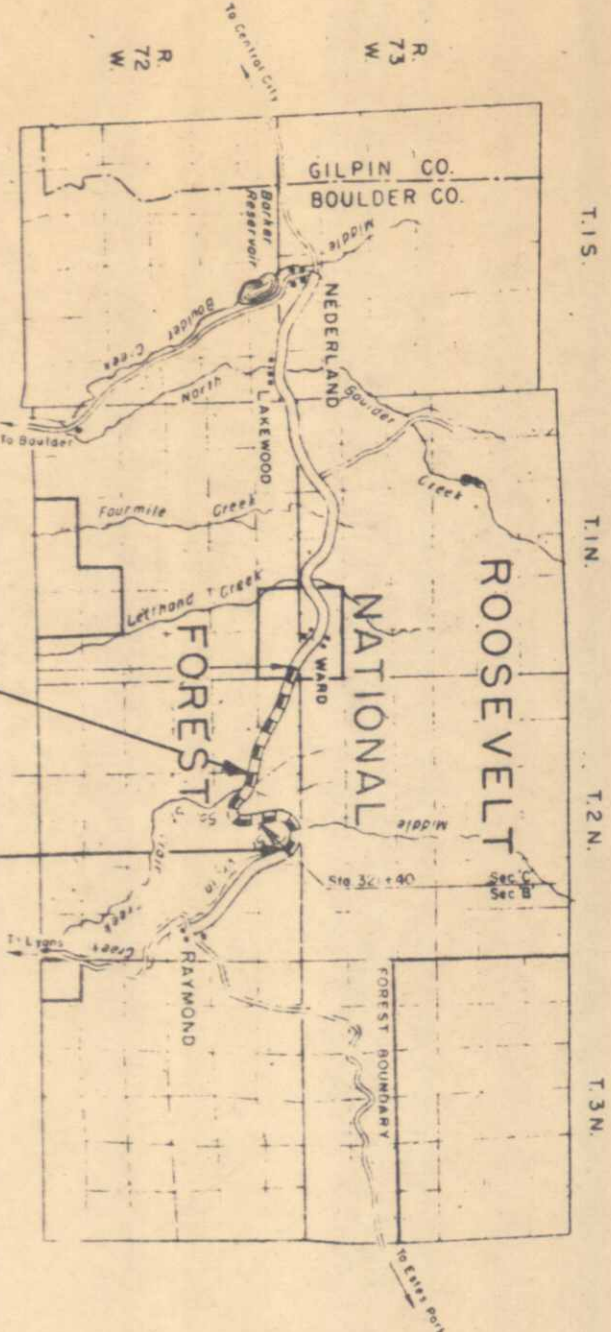

Begin R.O.W. C 07-0160-01
Sta. 238+10

End R.O.W. C 07-0160-01
Sta. 417+55

Completed 1960

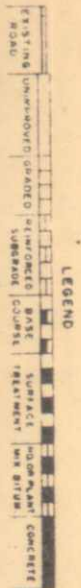

R. O. W. TABULATION OF PROPERTIES IN BOULDER


COUNTY S.H.No. 160 PROJ. C 07-0160-01

RECORD MAP SECTION NO. 9	DISTRICT COLORADO	PROJECT NO. C 07-0160-01	SHEET NO. 2
--------------------------------	----------------------	-----------------------------	----------------

RIGHT OF WAY: WARD - RAYMOND

PARCEL NO.	OWNER	ADDRESS	LOCATION T.2N.,R.72W.,6th P.M.	AREA IN ACRES			PURCHASE DATA					REMARKS	NO
				PARCEL	TO BE ACQUIRED	REMAINDER	LAND	IMPROV./W'TS	DAMAGE	MISC.	TOTAL		
1	Donald C. McKenna		SE 1/4 SW 1/4 SEC. 20	2.232	0.946								
2	Clarence Bullin		SE 1/4 SW 1/4 SEC. 20	1.788	0.502								
3	John S. & Maxine Roberts		SEC. 20 & SW 1/4 SEC. 17	21.088	16.161								
4	DELETED												
5	Peaceful Valley Recreation Center, Inc.		S 1/2 SEC. 18	13.439	5.744								
6	Ralph L. & Grace Lee Emmett		SW 1/4 SEC. 18	0.126	0.126								
			Sonder's Replot in SW 1/4 Sec. 18										
7	Caro E. Hoogland		Lot 8 Blk. 4	0.201	0.201								
8	Thomas M. & Regene Mae Small		Lot 7 Blk. 4	0.208	0.208								
9	E. U. & Andro R. Chorbonneau		Lot 6 Blk. 4	0.225	0.225								
10	Jessie L. & Ralph G. Chorbonneau		Lot 5 Blk. 4	0.186	0.186								
11	Lee & Laura Hoogland		Lot 4 Blk. 4	0.041	0.041								
12	Lee & Laura Hoogland		Lots 18, 2 Blk. 4	0.283	0.283								
13	Maxine E. McClean		Lots 3 & 4 Blk. 3	0.563	0.563								
14	Anno Best Joder		SW 1/4 SEC. 18	0.783	0.783								
14A	Anno Best Joder		SW 1/4 SEC. 18	0.077	0.077								
15	Charlotte B. Warren (aka Charlotte B. Fisher)		SW 1/4 SEC. 18	0.286	0.286								
15A	Charlotte B. & Robert E. Warren		SW 1/4 SEC. 18	0.100	0.100								
16 Rev.	Gerardus J. M. Bouricius		SW 1/4 SEC. 18	1.640	1.640								
17	Peaceful Valley Recreation Center, Inc.		SW 1/4 SEC. 18	4.802	4.802								
18	Waldo R. McNutt		SE 1/4 SEC. 18	0.529	0.529								
19	Waldo R. McNutt		SE 1/4 SEC. 18	1.249	1.249								
20	Howard K. Sinclair		SE 1/4 SEC. 18	2.346	2.346								
21	Peaceful Valley Recreation Center, Inc.		SE 1/4 NE 1/4 SEC. 18	1.871	0.641								

REVISIONS		SW 1/4, NW 1/4, Sec 29
NO.	DESCRIPTION	
1		
2		
3		
4		
5		
6		
7		
8		
9		
10		

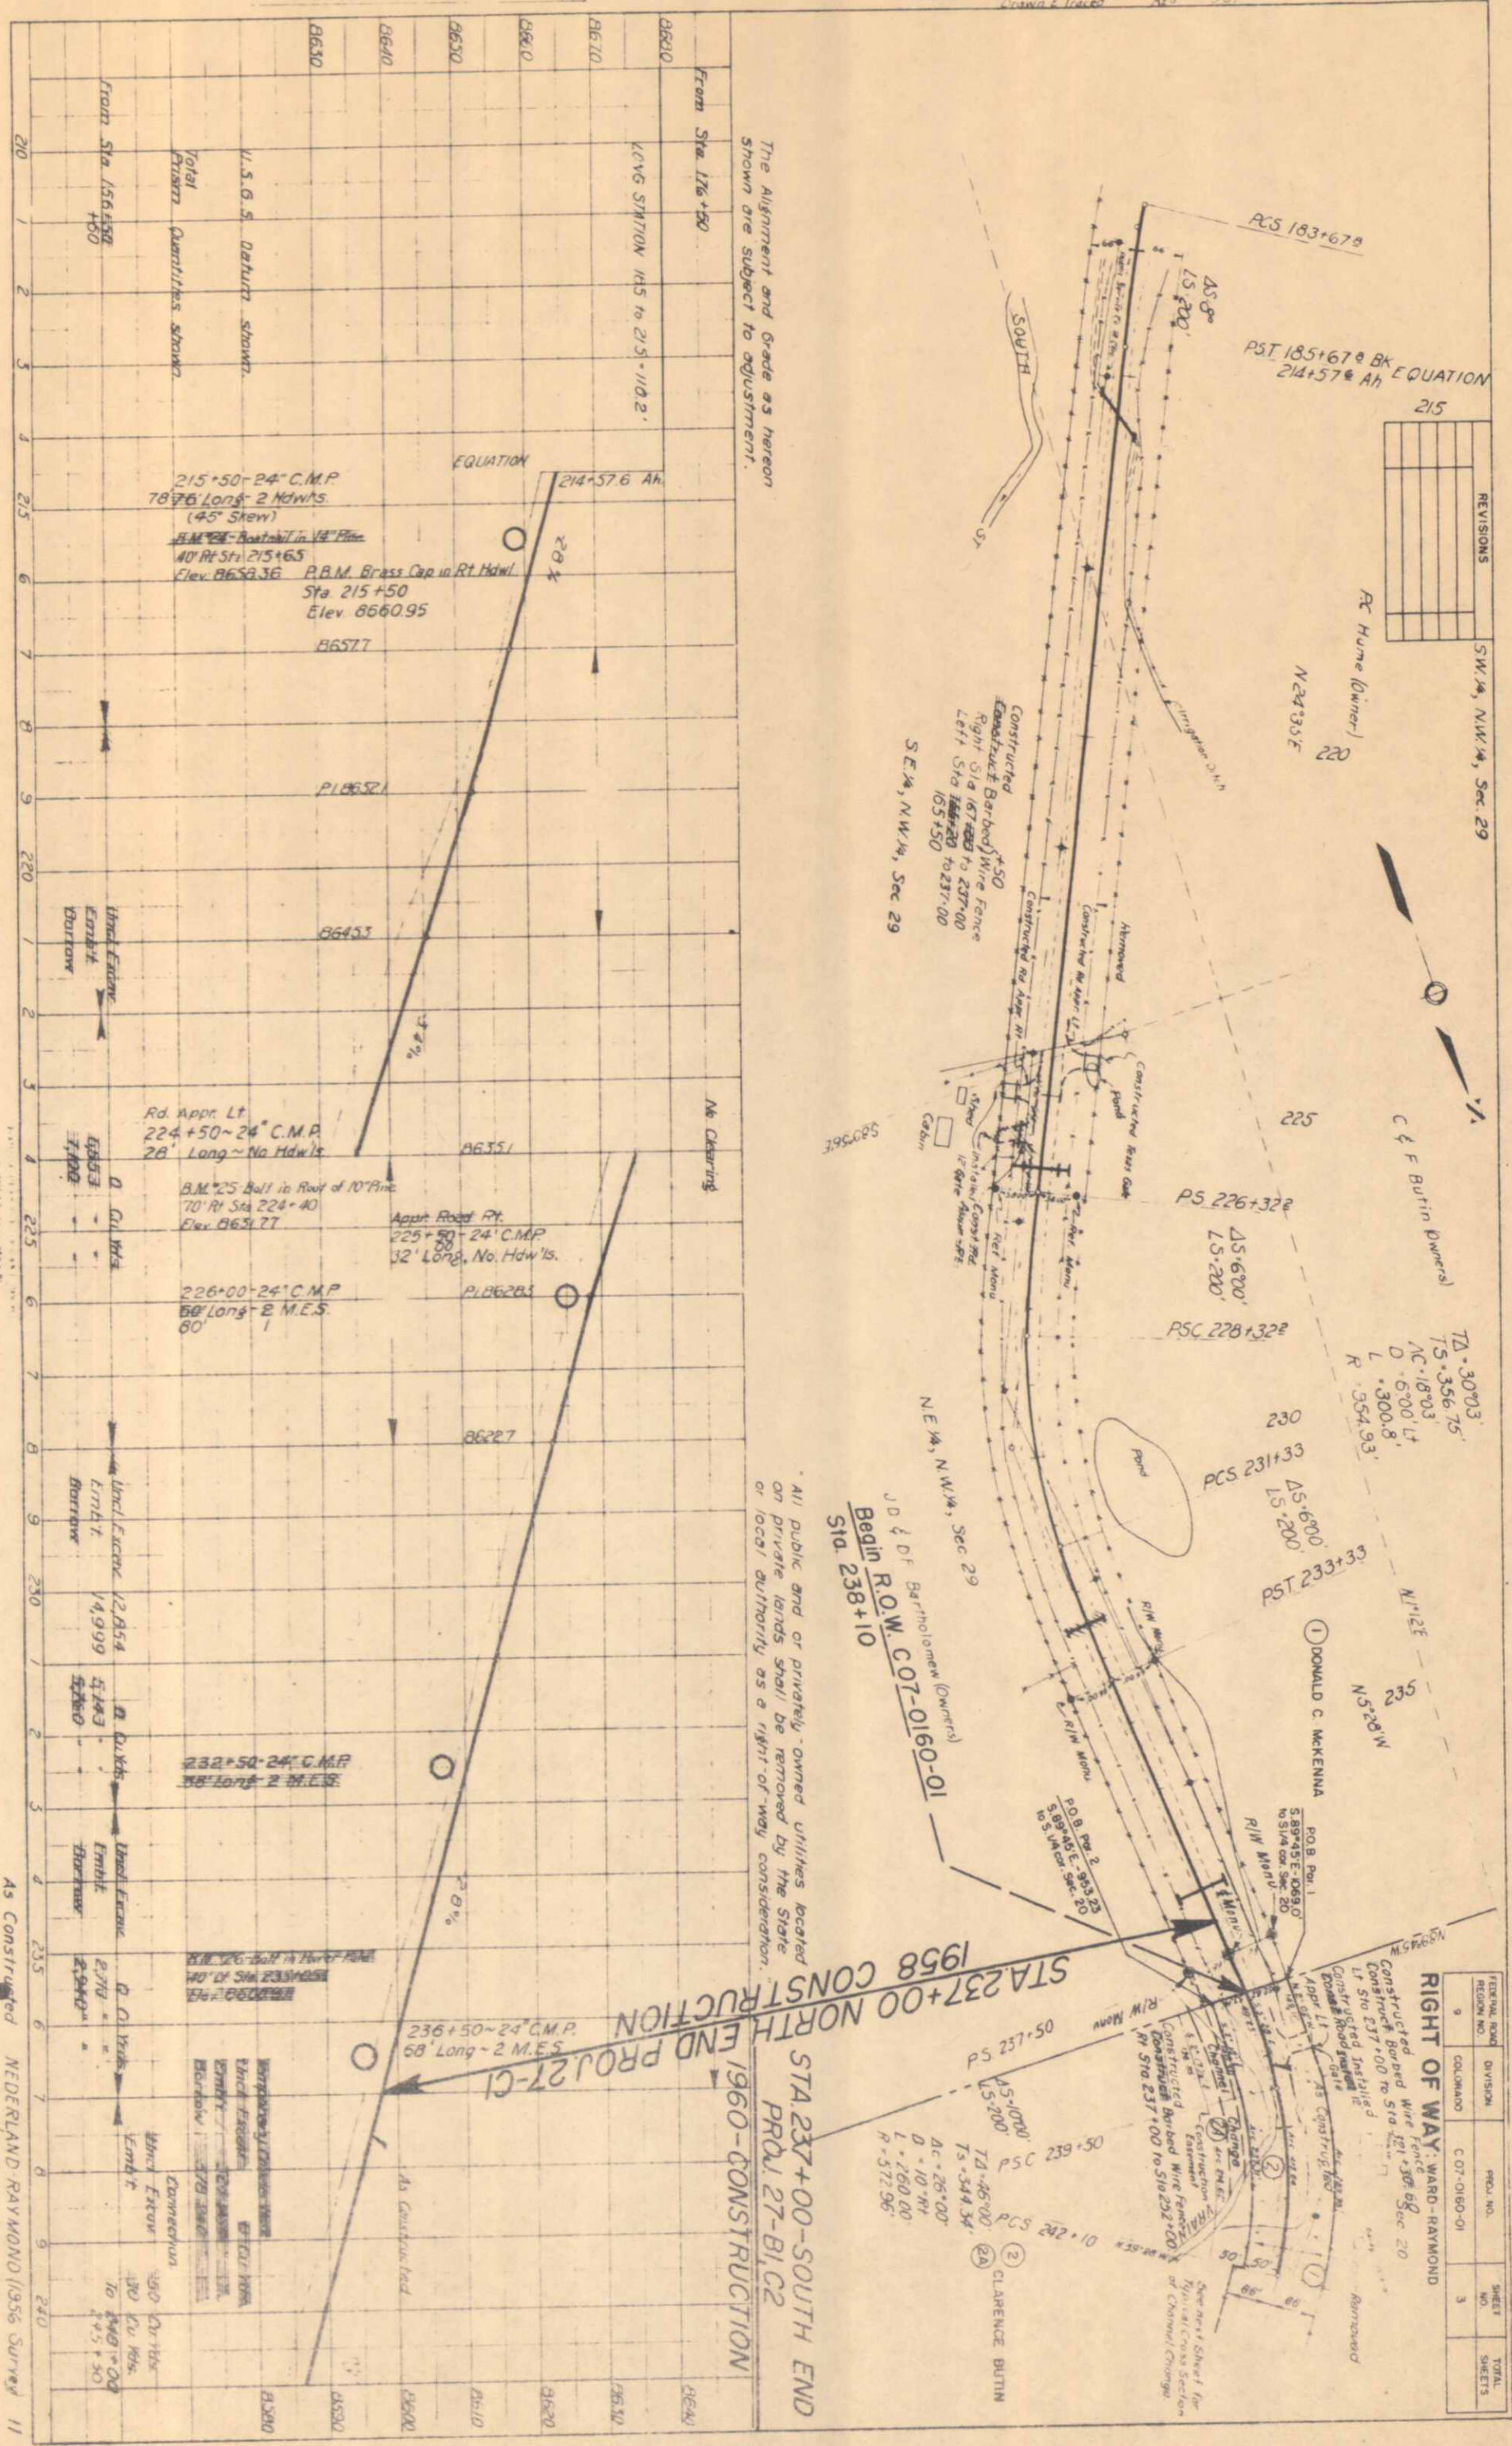

The Alignment and Grade as hereon
Shown are subject to adjustment.

All public and or privately owned utilities located
on private lands shall be removed by the State
or local authority as a right-of-way consideration.

PLAN	DATE	BY
ADJUSTED	5-58	W.H.T.
NOTE BOOK	ADJUSTED	
NO	ALIGNMENT CHECKED	
	AT OR WAY CHECKED	

PROFILE	DATE	BY
ADJUSTED	5-58	W.H.T.
NOTE BOOK	ADJUSTED	
NO	ALIGNMENT CHECKED	
	AT OR WAY CHECKED	

① Donald McKenna (Owner)

589.31'E


REVISIONS

NE 1/4 S.W. 1/4 Sec 20
T2N, R72W



NW 1/4 S.E. 1/4 Sec 20
T2N, R72W

③ J.S. & M. Roberts
(Owners)

FEDERAL ROAD DISTRICT NO.	DIVISION	PROJECT NO.	SHEET NO.	TOTAL SHEETS
9	CORRIDOR	COR-0160-01	4	
RIGHT OF WAY				
WARD-RAYMOND				
P5 265+50 AS 27+00 LS 200 PSC 267+50 TS 108+50 LS 1259.05 AS 94+50 D 7+15 L 1350 H 818.51				

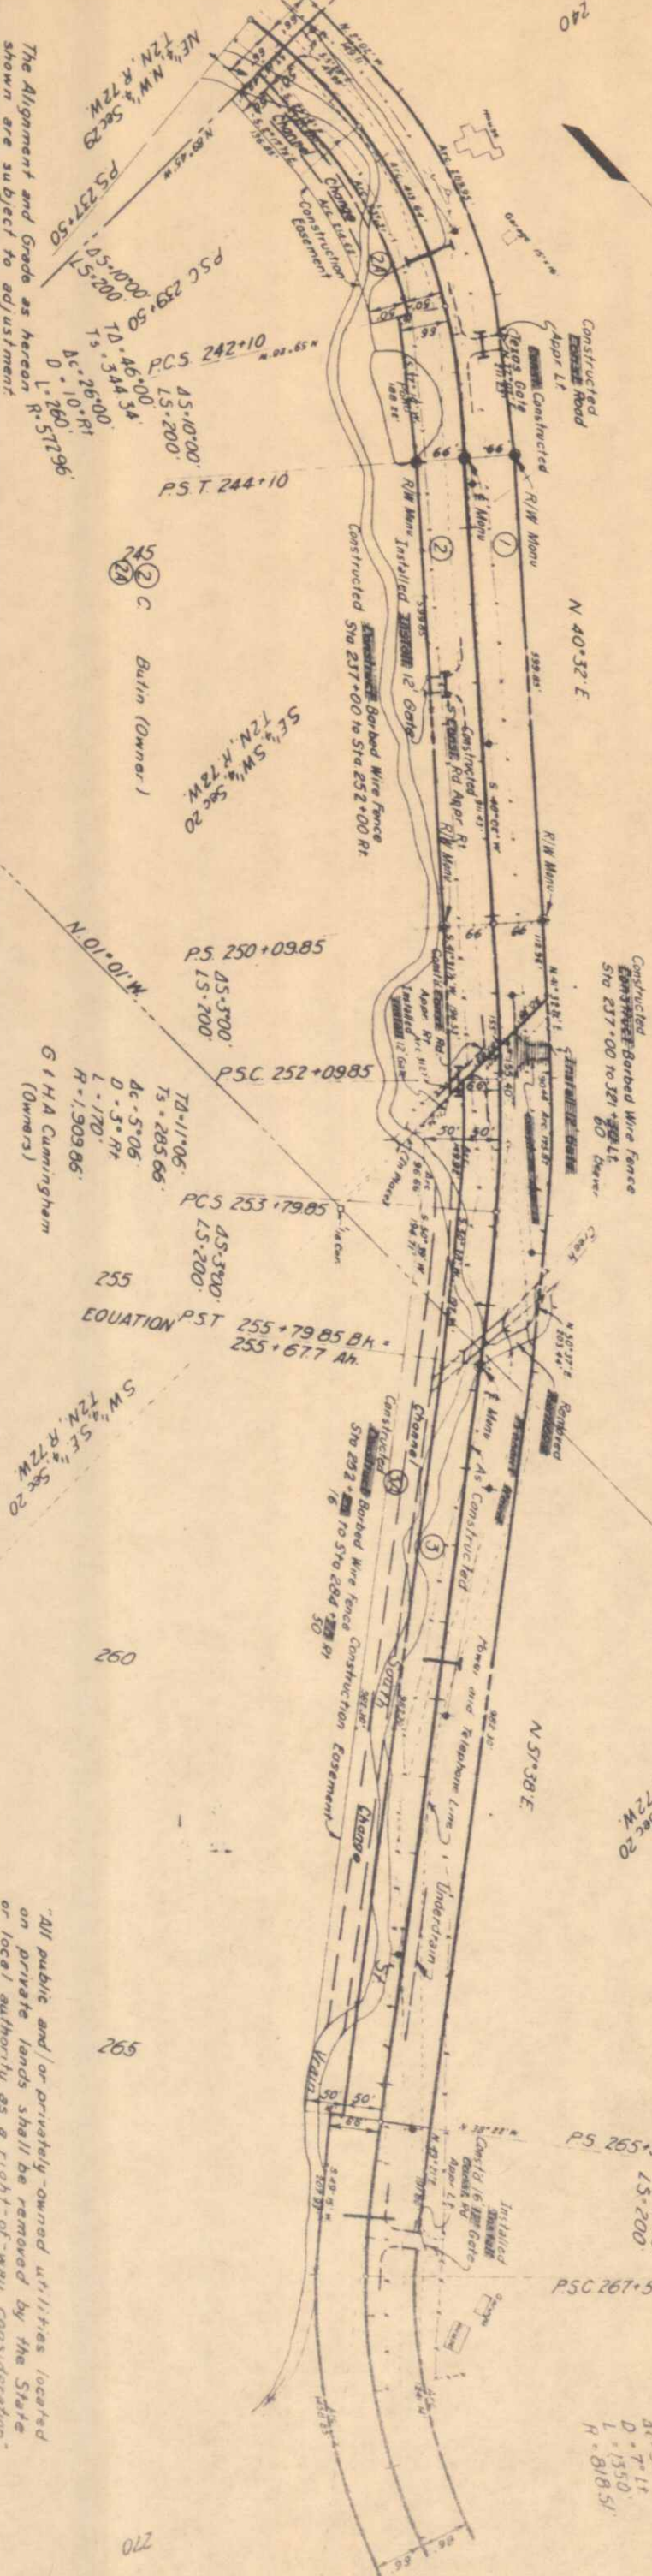

"All public and/or privately-owned utilities located on private lands shall be removed by the State or local authority as a right-of-way consideration."

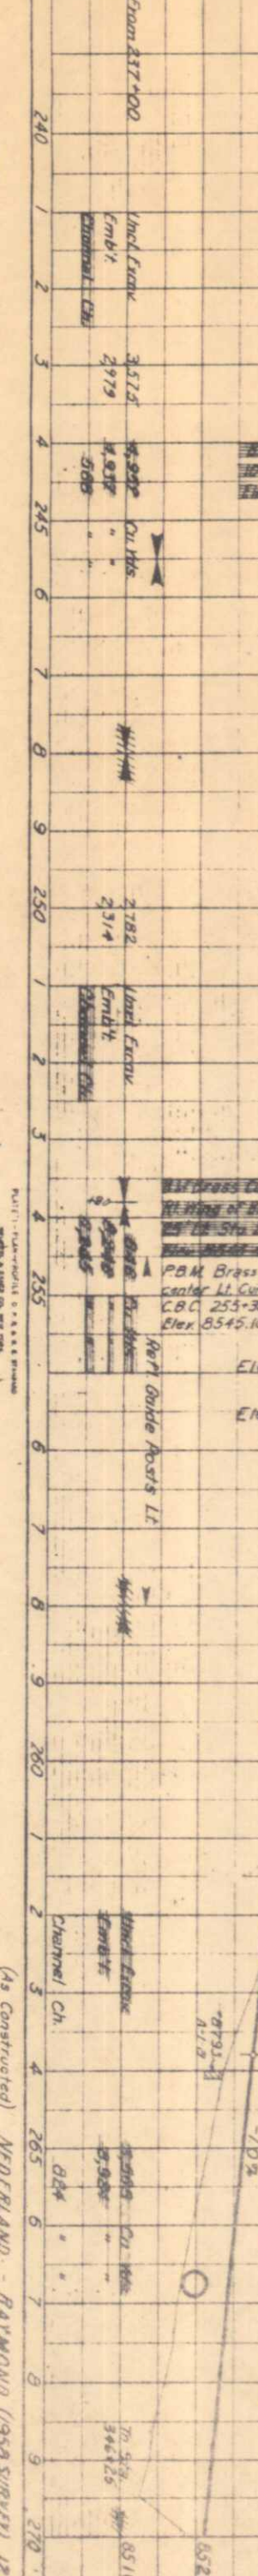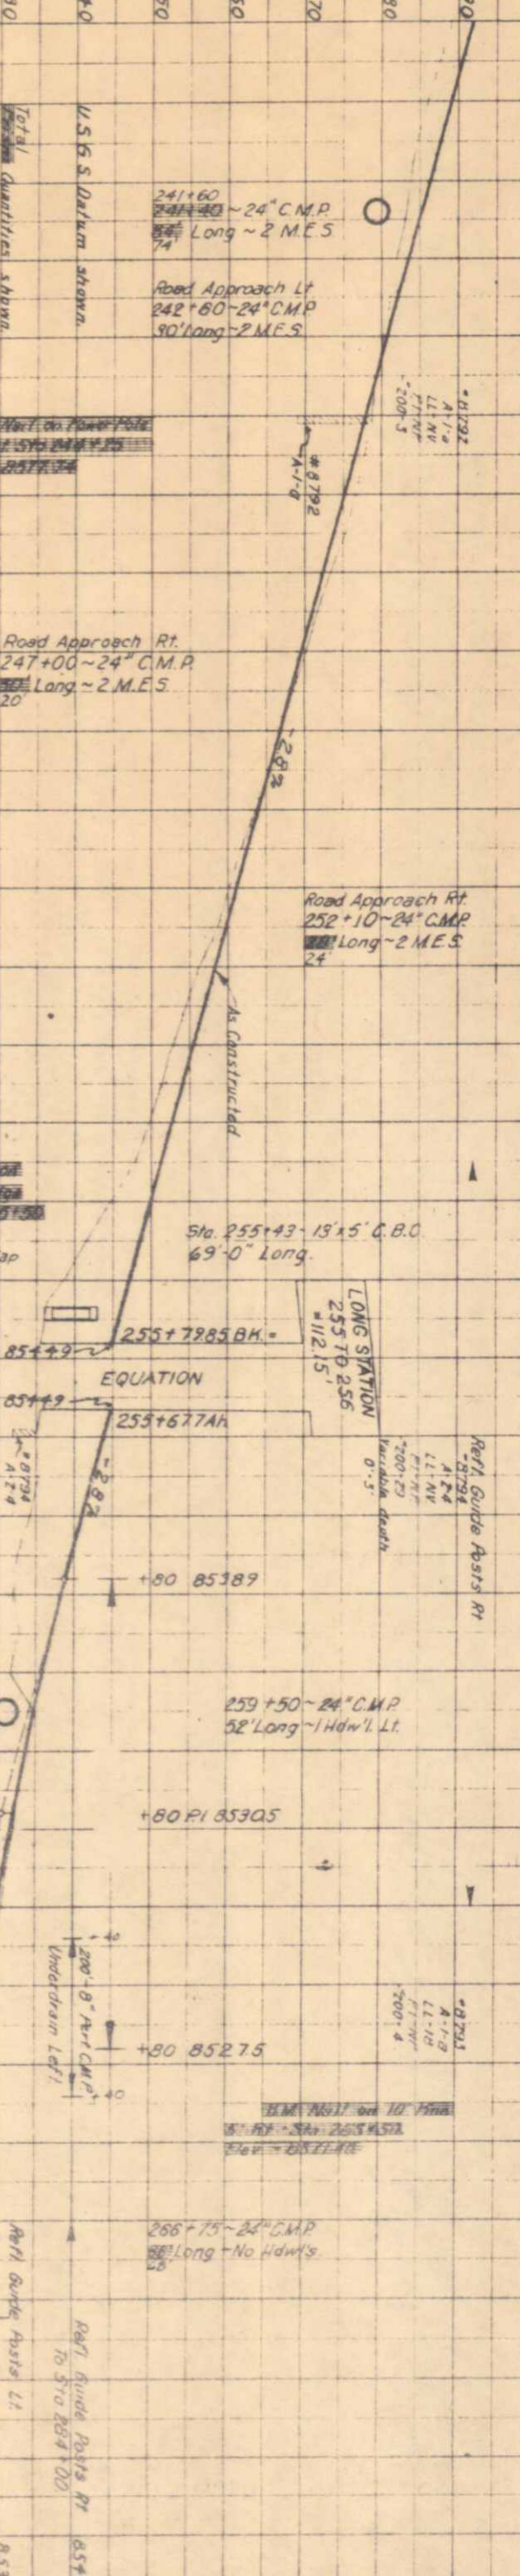



(As Constructed) NEUTRAL - RAYMOND (1950 SURVEY) 12

PROFILE	SURVEYED	BY	DATE
NOTE BOOK	GRADES CHECKED		
NO.	STRUCTURE NOTED		

Drawn & Traced B.L.P. 8-57

PLAN	SURVEYED	BY	DATE
NOTE BOOK	ALIGNED CHECKED		
NO.	RT. OF WAY CHECKED		

Drawn & Traced J.A.R. 8-57

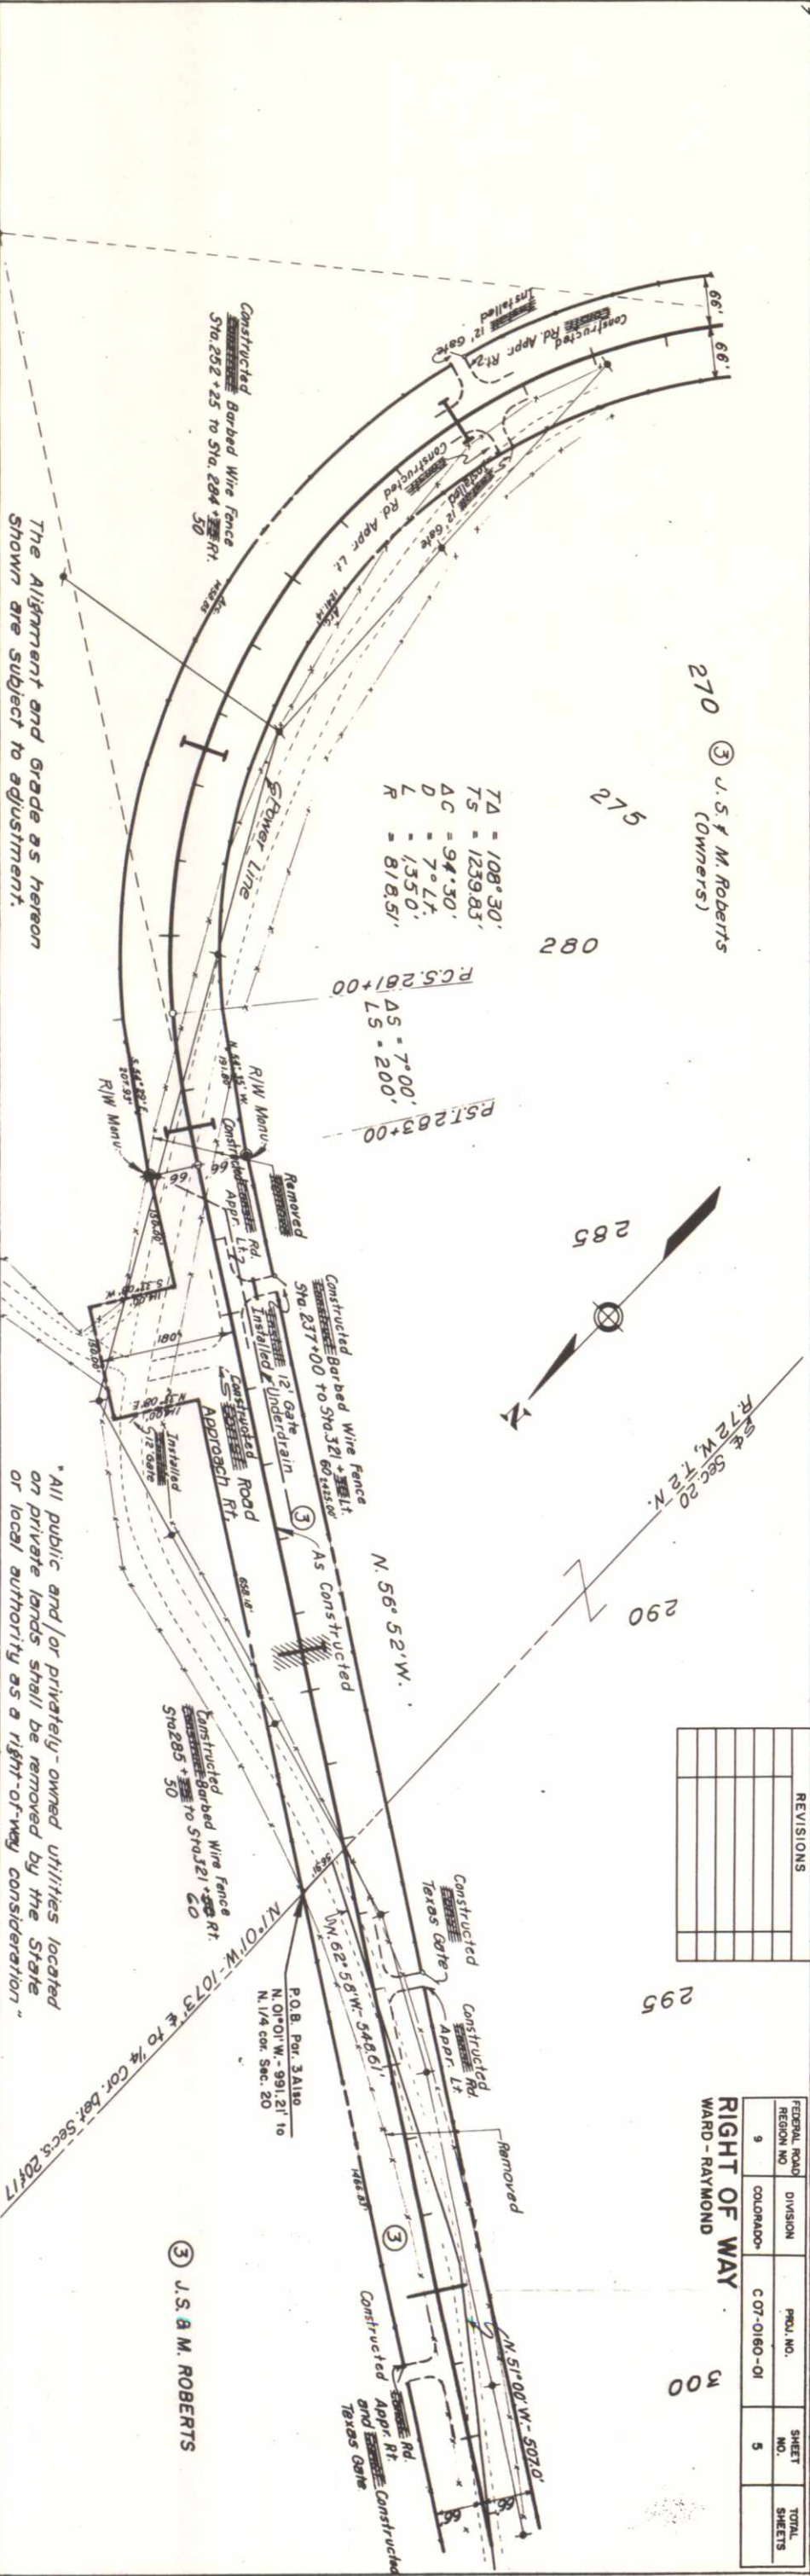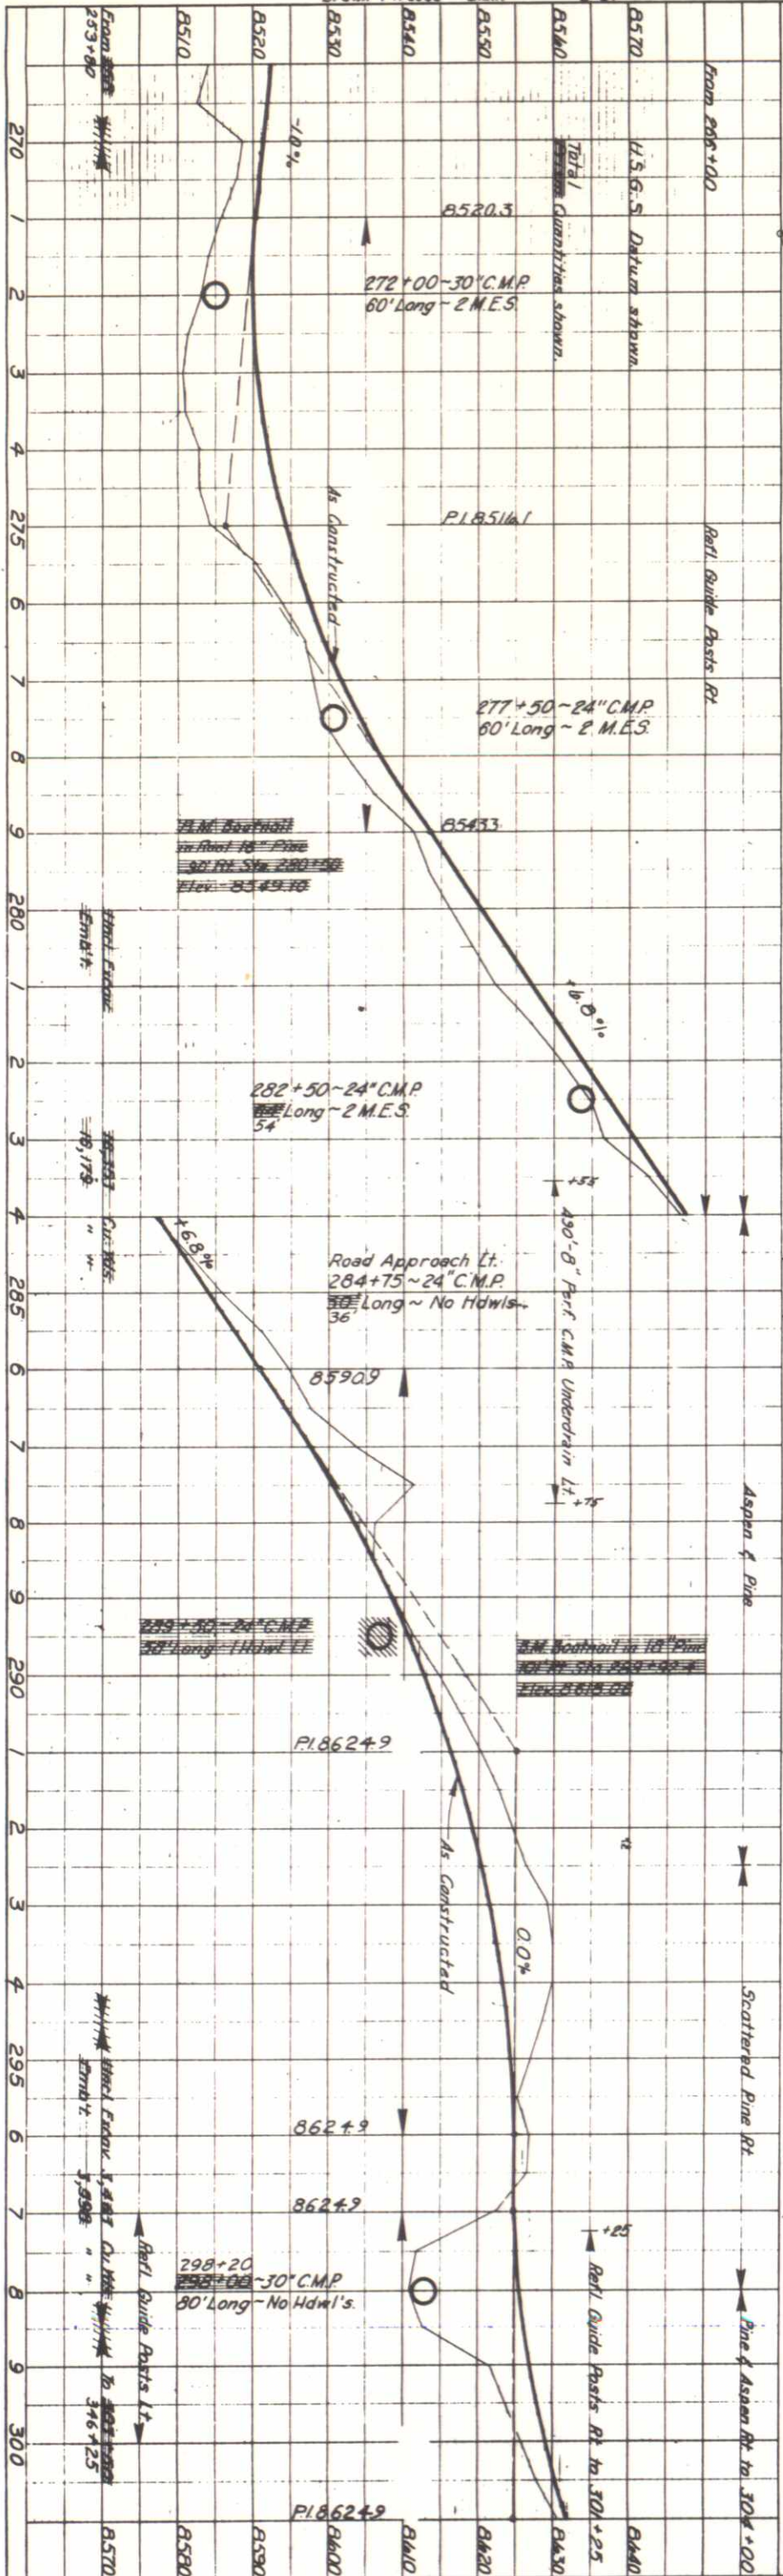

270 ③ J.S. & M. Roberts (Owners)

REVISIONS			
NO.	DESCRIPTION	DATE	BY

FEDERAL ROAD REGION NO.	DIVISION	PROJ. NO.	SHEET NO.	TOTAL SHEETS
9	COLUMBIA	C-07-0160-01	5	

RIGHT OF WAY
WARD - RAYMOND

"All public and/or privately-owned utilities located on private lands shall be removed by the State or local authority as a right-of-way consideration."

③ J.S. & M. ROBERTS

300 J.S. & M. Roberts (Owners)

305

310

315

320

325

R 72 W, T 2 N.


REVISIONS	

RIGHT OF WAY
WARD - RAYMOND

FEDERAL ROAD DISTRICT NO.	DIVISION	PROJECT NO.	SHEET NO.
9	COLORADO	C 07-0150-01	6

PLAN	DATE	BY
UNREVISED	1957	A.E.S.
NOTED		
NOTED		
NOTED		

PROFILE	DATE	BY
UNREVISED	6-58	F.F.O.
NOTED		
NOTED		
NOTED		

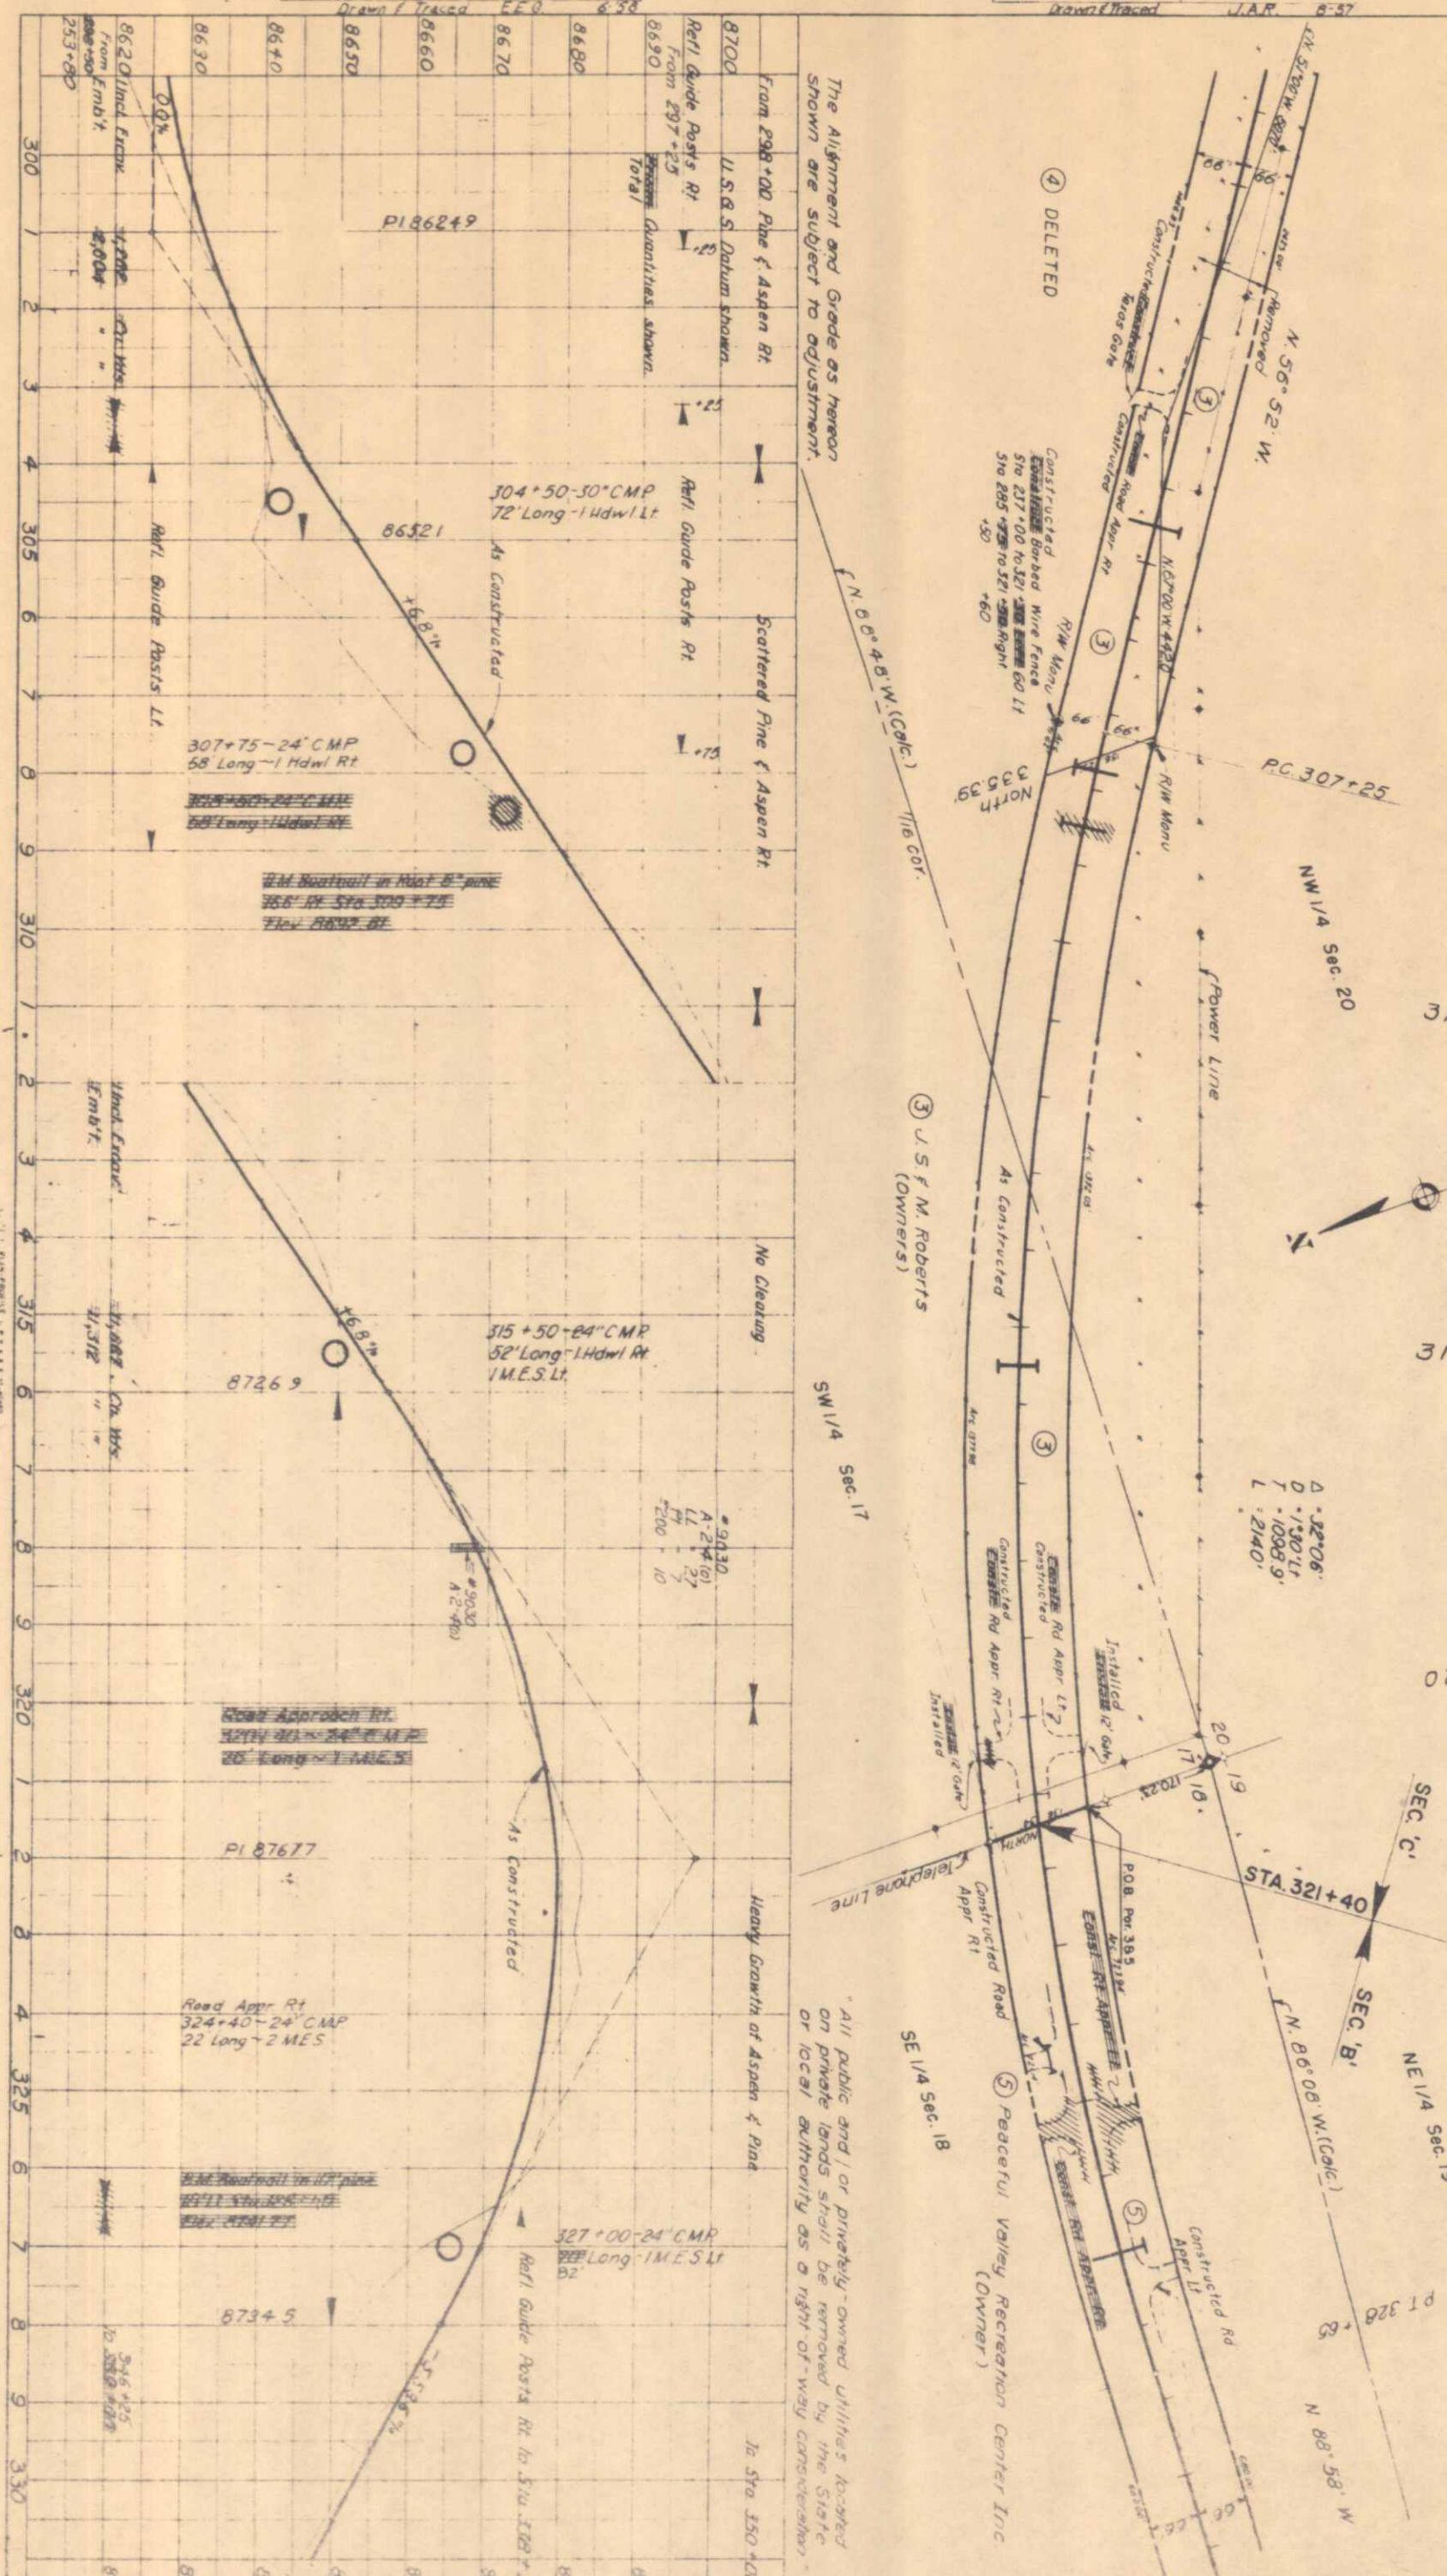


The Alignment and Grade as hereon shown are subject to adjustment.


All public and/or privately-owned utilities located on private lands shall be removed by the State or local authority as a right-of-way consideration.

As Constructed NEDERLAND - RAYMOND

PROFILE	SURVEYED	BY	DATE
	PLOTTED		
NOTE BOOK	GRANDES CHECKED		
NO.	B.M. & NOTED		
	STRUCTURE NOTED NO. CHKD.		
Drawn & Traced J.L.H. 6-58			

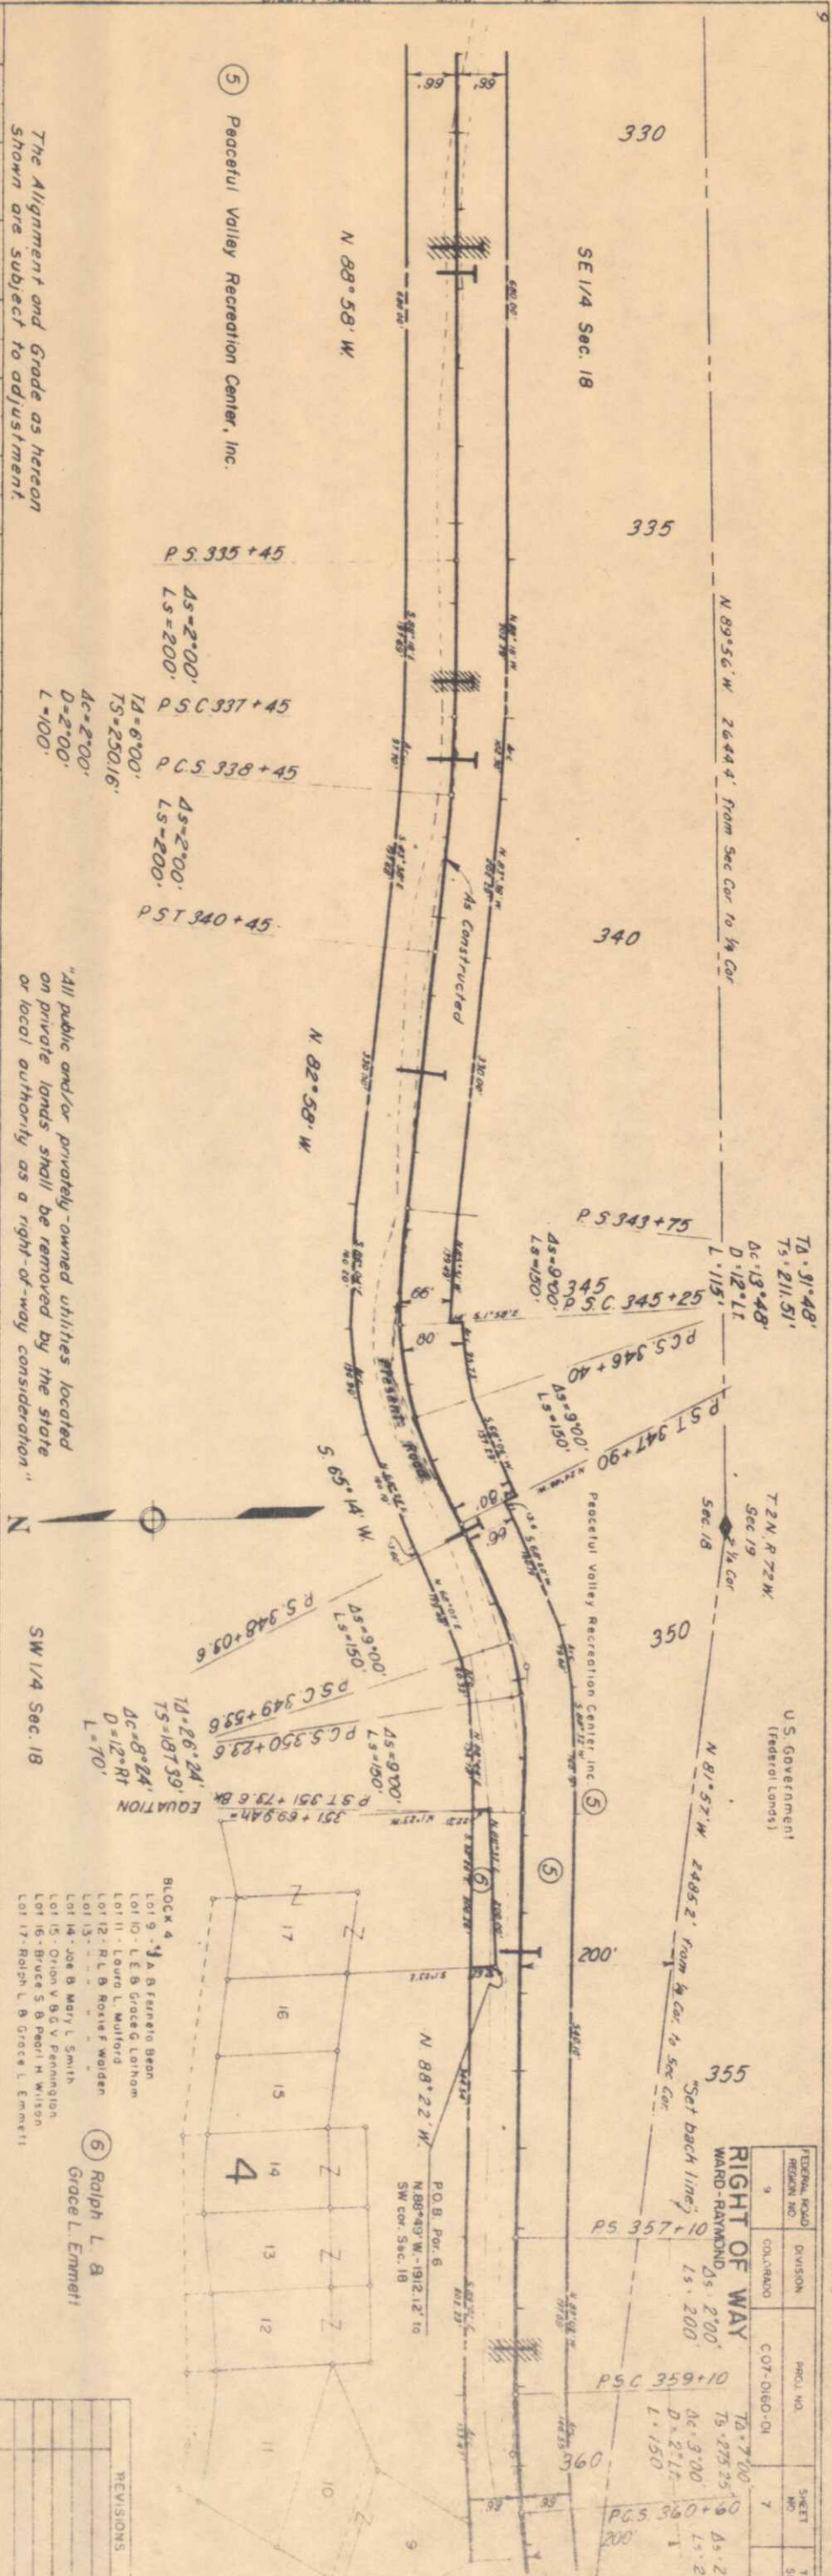


"All public and/or privately-owned utilities located on private lands shall be removed by the state or local authority as a right-of-way consideration"

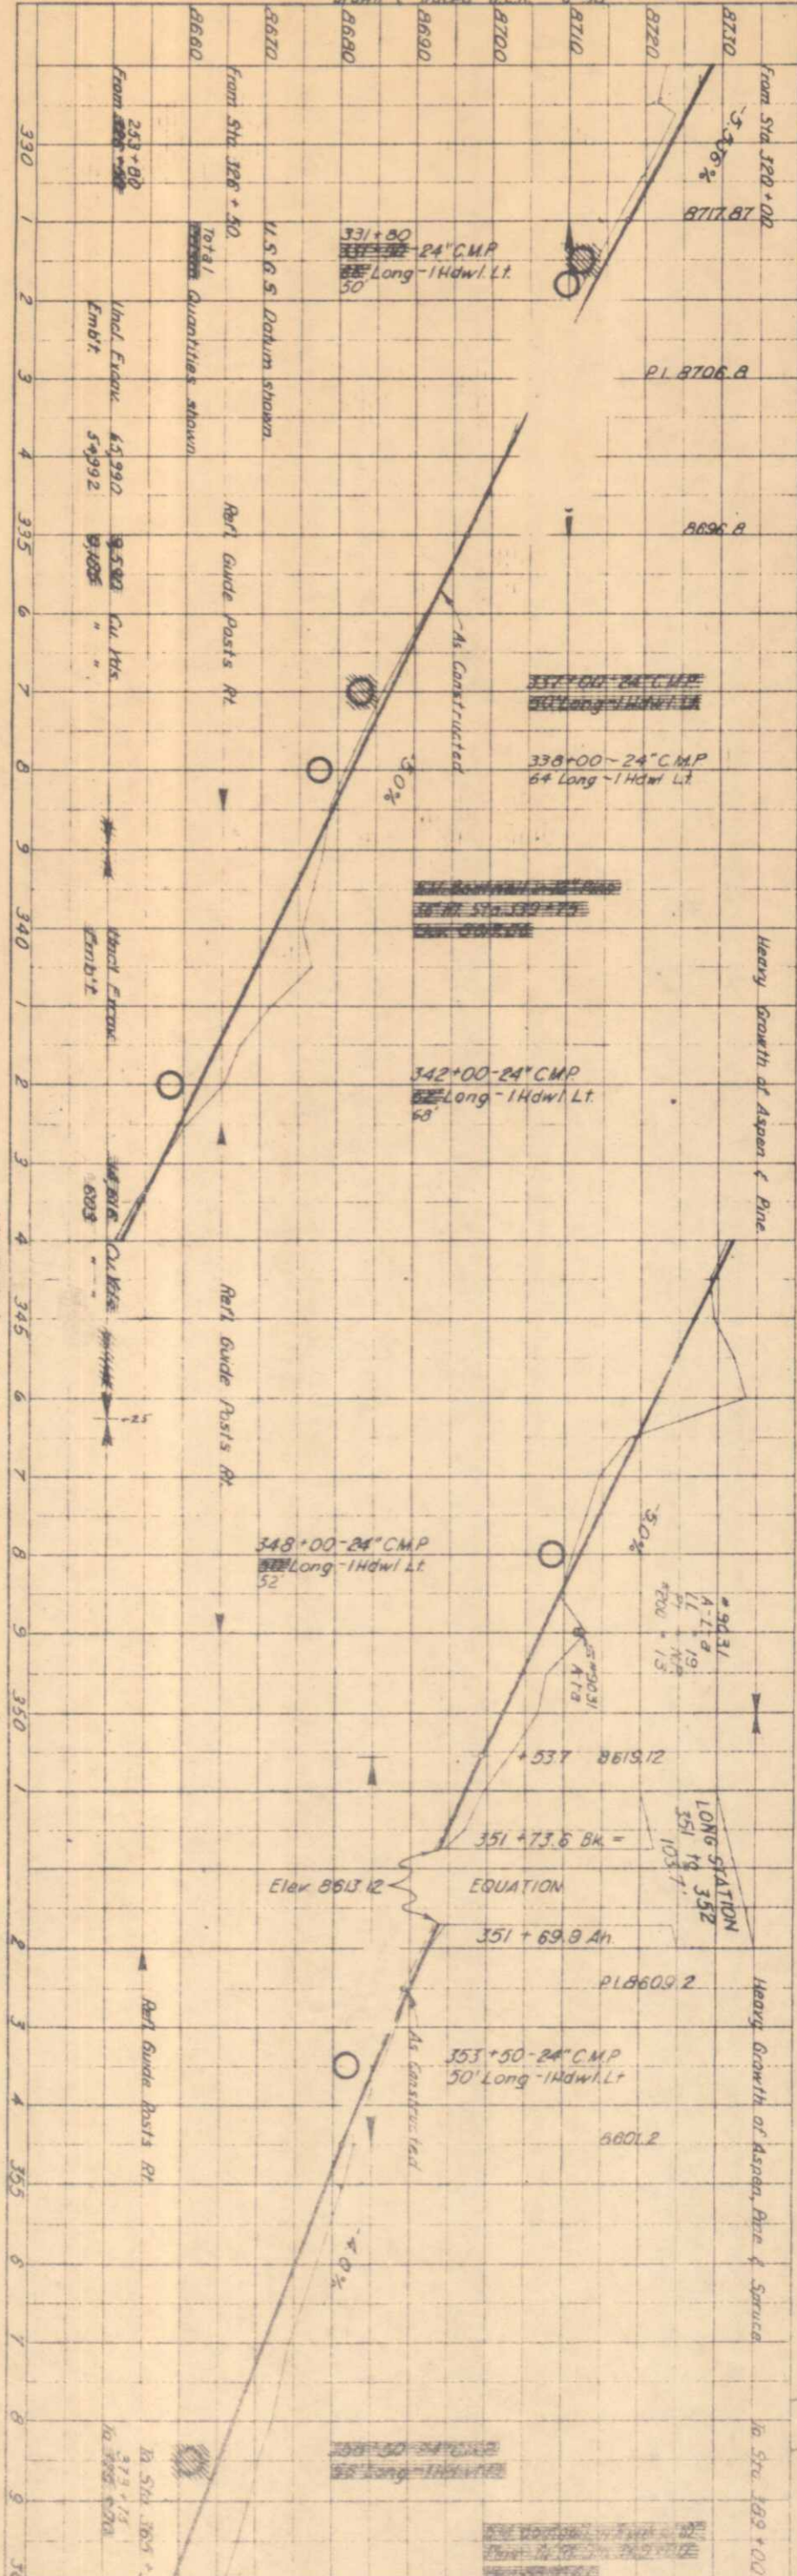

As Constructed NEDERLAND - RAYMOND

PLAN	SURVEYED	BY	DATE
	PLATTED	AIS	1957
NOTE BOOK	ALUMINUM CHECKED		
NO	BY OR WAY CHECKED		
	<i>Drawn & Traced</i>	<i>HAB</i>	<i>11 37</i>

PROFILE	SURVEYED	BY	DATE
NOTE BOOK	PLOTTED		
NO.	GRADES CHECKED		
	S. ME. NOTED		
	STRUCTURE NOTED		
	<i>Drain & Traced</i>	<i>RIP</i>	<i>11-3</i>

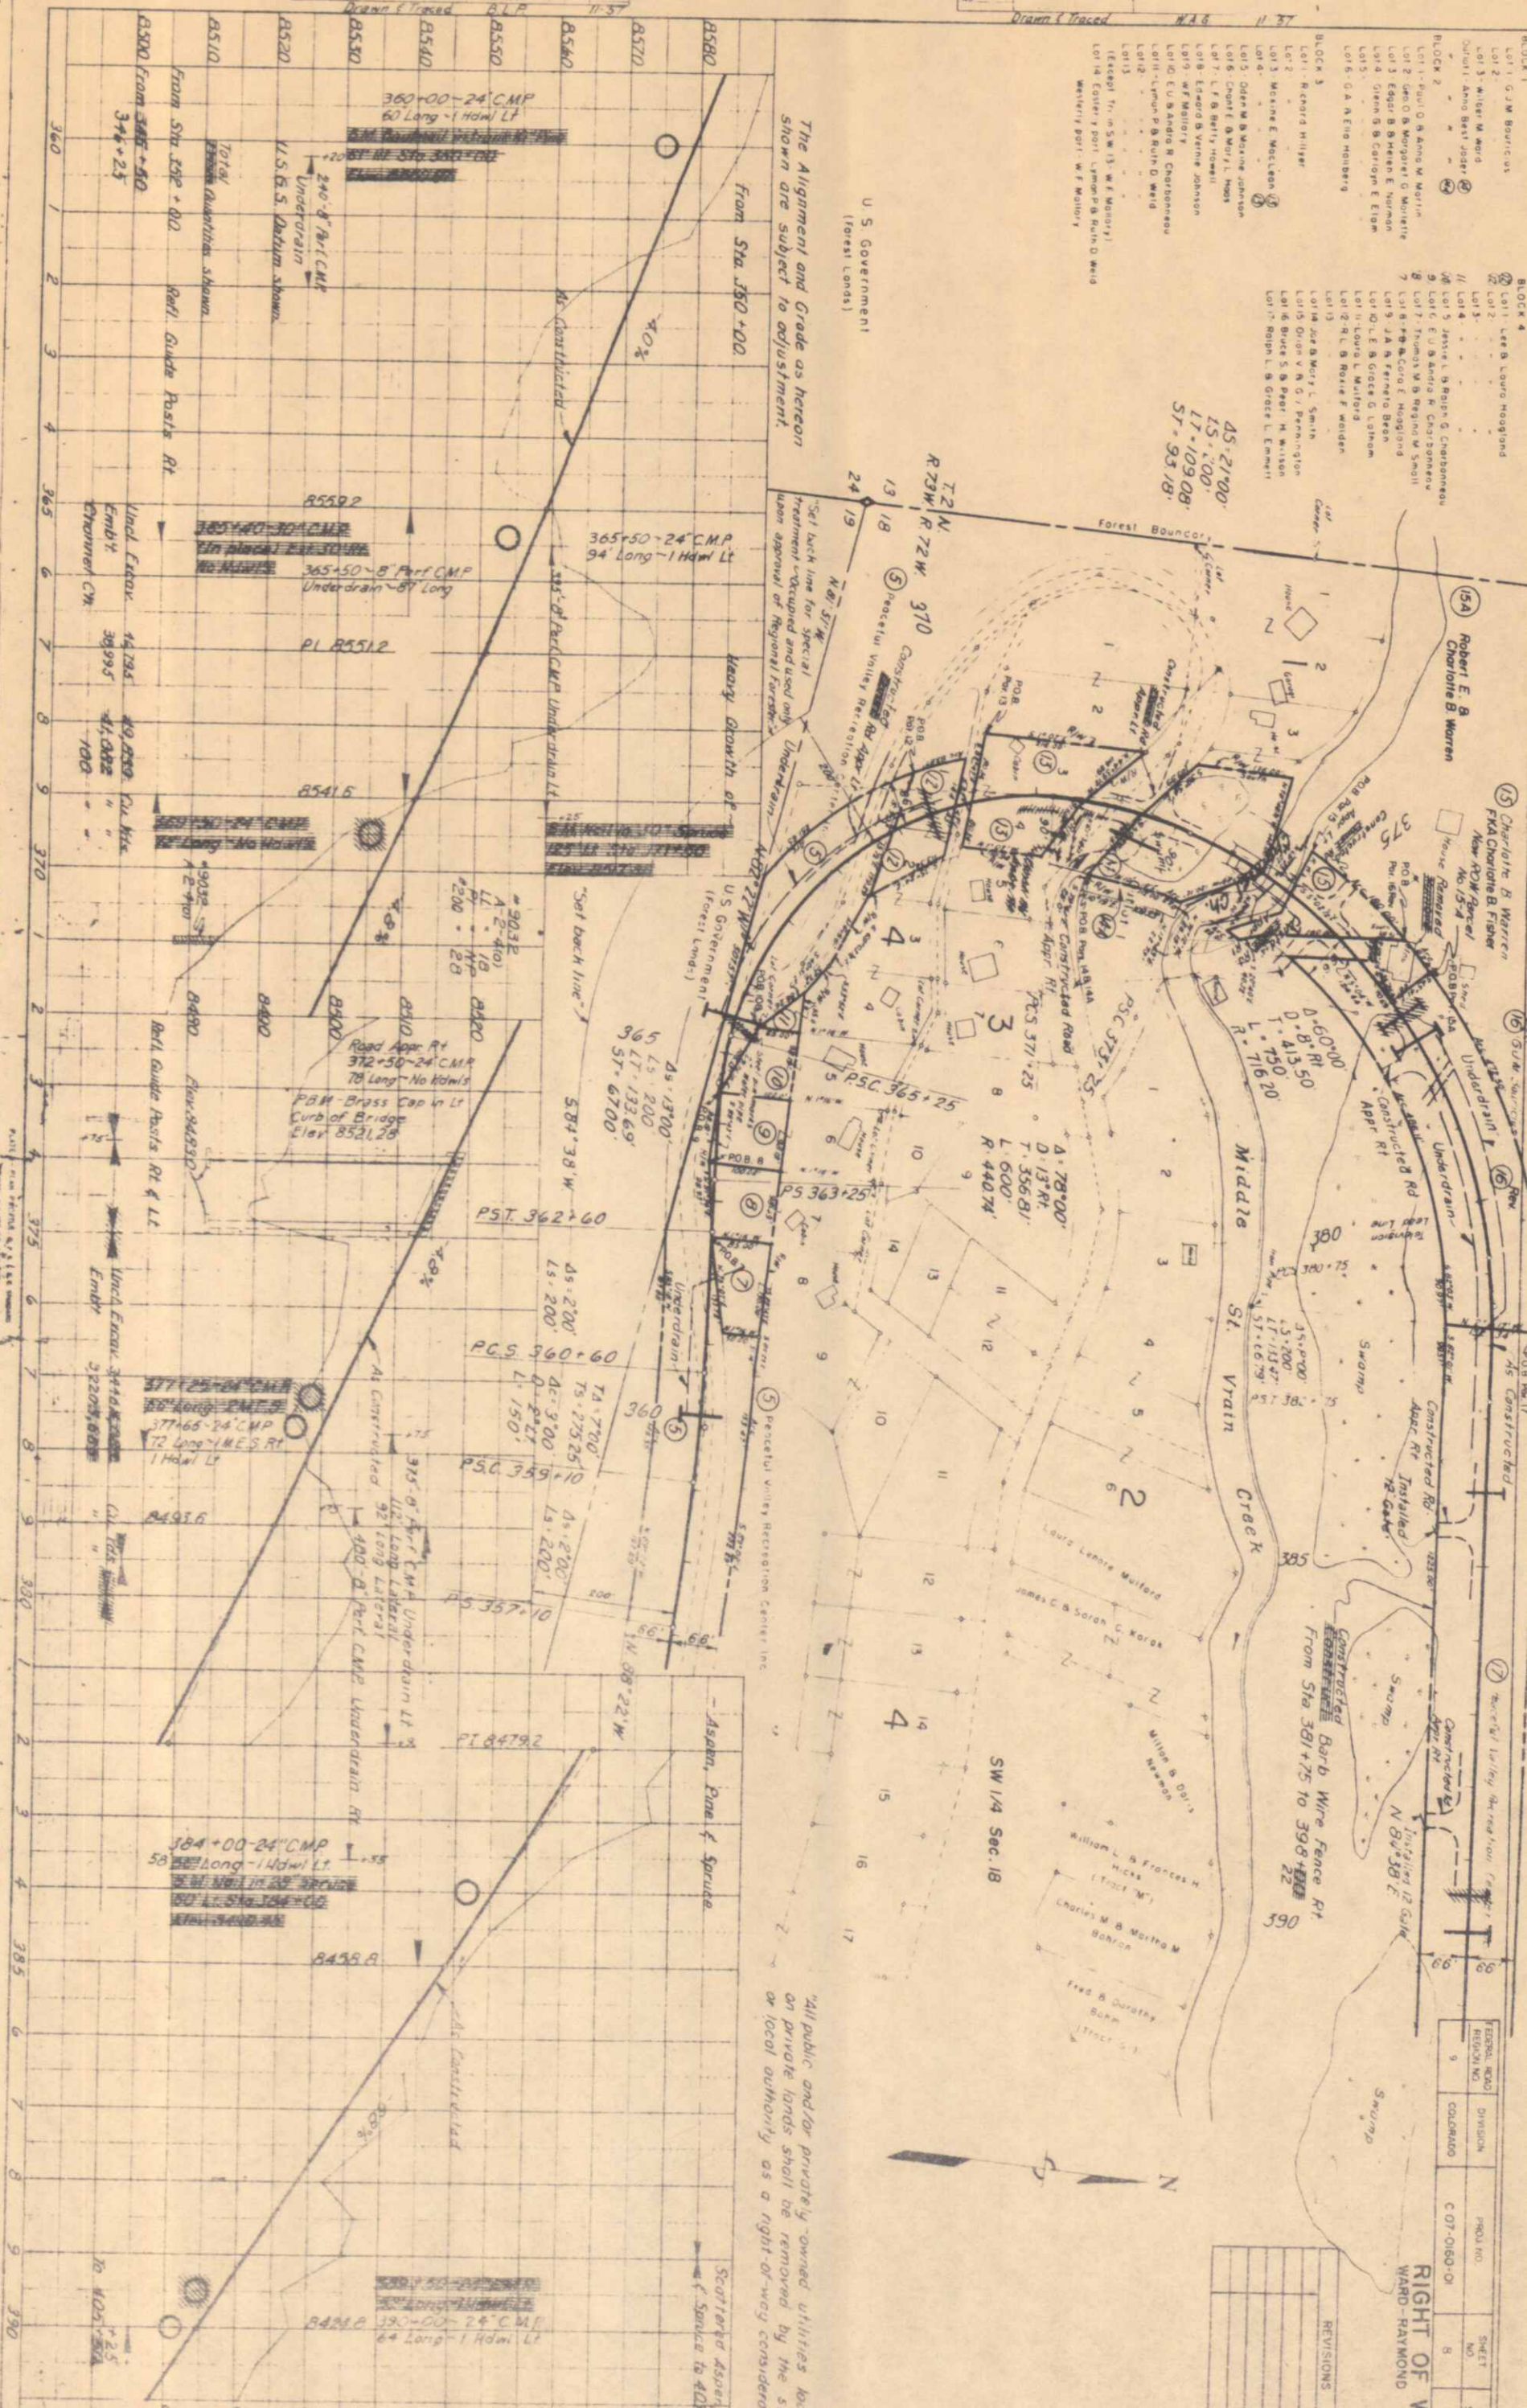

"All public and/or privately-owned utilities located on private lands shall be removed by the State or local authority as a right-of-way considered

FEDERAL ROAD FUNDING NO.	DIVISION	PROJ. NO.	SHEET NO.
9	COLORADO	C-07-0160-01	8

RIGHT OF WAY
WARD - RAYMOND

REVISIONS

As Constructed (REV 8-18-59) NEDERLAND - RAYMOND

