


CONVENTIONAL SIGNS

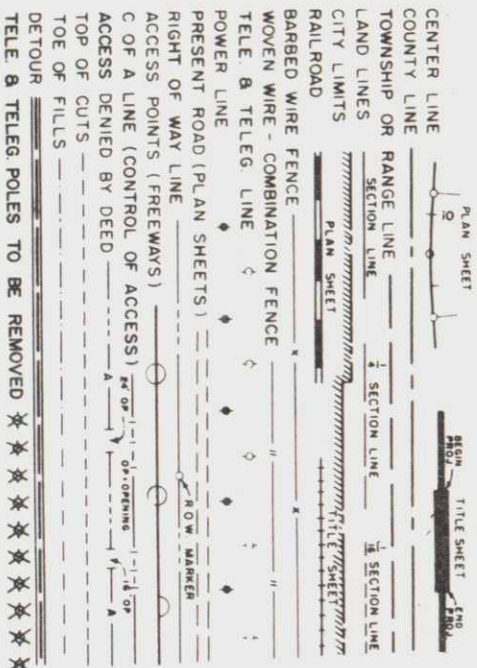

DEPARTMENT OF HIGHWAYS
STATE OF COLORADO

PLAN AND PROFILE OF PROPOSED
STATE PROJECT NO C13-0002-19
STATE HIGHWAY NO. 2
LOGAN COUNTY

ON PLAN, 1 IN. = 100 FT.
ON PROFILE, 1 IN. = 10 FT. VERTICAL
GRADE LINE ON PROFILE IS SHOWN AS GRADE OF EXISTING ROAD
CONTRACTOR: GOODELL BROS. INC.
PROJECT ENGINEER: DONALD B. ATKINS
PROJECT STARTED: FEB. 5 1968
PROJECT COMPLETED: MAY 10 1968

AS CONSTRUCTED
NO REVISIONS
SHEETS 10 THROUGH 14
and Sheet 16

INDEX OF SHEETS

SHEET NO	TITLE PAGE SKETCH MAP AND TABULATION OF LENGTH AND DESIGN DATA.
1	TYPICAL SECTION AND GENERAL NOTES.
2	SUMMARY OF APPROXIMATE QUANTITIES.
3-4	STRUCTURE QUANTITIES.
5-6	BASE COURSE AND SURFACE COURSE PLAN, SUBBASE PLAN, DELINEATORS AND ROADSIDE TREATMENT.
7	PIT LOCATIONS.
8	SUMMARY OF EARTHWORK QUANTITIES.
9	DETAILS OF CONCRETE CONNECTING COLLAR, CONCRETE LID AND CONCRETE HEADWALL.
10	ALIGNMENT PLAN AND PROFILE.
11-17	STRUCTURE CROSS SECTIONS.
18-19	BORROW PIT CROSS SECTIONS


TABULATION OF LENGTH & DESIGN DATA

STATION	ROADWAY	LIN. FT.
1175+000 BEGIN C13-0002-19-6' R. APPROX. STA. 482+357 ON FAP 256 A	16,817.0	
1343+178 BK. = } Equation 1343+193 AH.	2,165.0	
1364+84.3 END C13-0002-19-21' R. 337+40.0 END F003-2(3)		
TOTAL	18,982.0	
SUMMARY	LIN. FT.	MILES
ROADWAY (NET & GROSS)	18,982.0	3.595

DESIGN DATA

MAXIMUM DEGREE OF CURVE 1.20
* MAXIMUM GRADE 0.36%
MINIMUM SSD HORIZONTAL > 900'
MINIMUM SSD VERTICAL > 1300'
MAXIMUM DESIGN SPEED 70 MPH

* Estimated from Existing Profile
P.D.L.

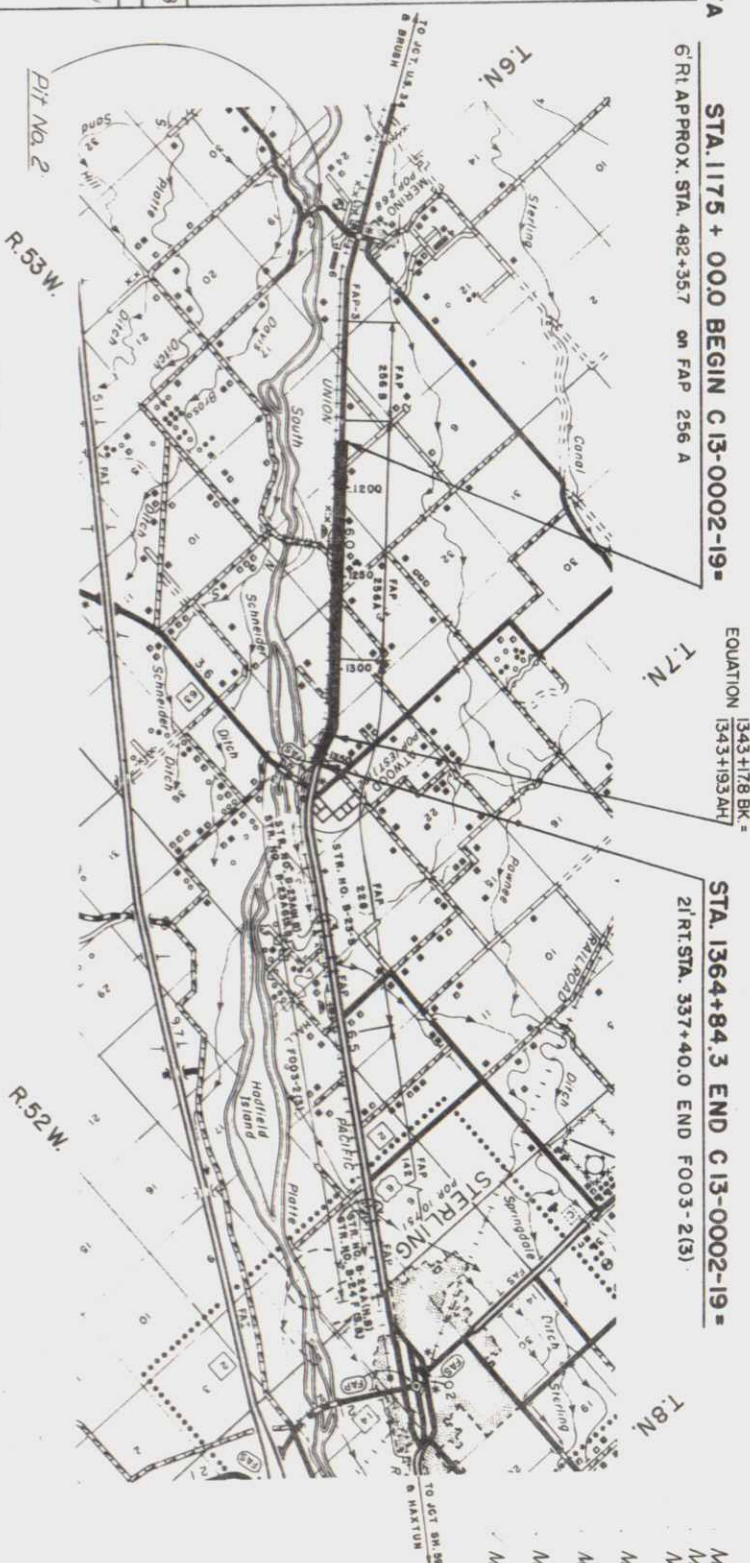

SCALE OF MILES
0 1 2 3

AS CONSTRUCTED
REVISED DATE 5-10-68

SEE SPECIAL PROVISIONS FOR
NOTICE TO BIDDERS

DEPARTMENT OF HIGHWAYS
STATE OF COLORADO

APPROVED: *John E. Shumate* 11-2-67
CHIEF ENGINEER DATE

By: *St. Brown* Deputy
Chief Engr.

DEPARTMENT OF HIGHWAYS
STATE OF COLORADO

FINAL APPROVAL
AS CONSTRUCTED PLANS
John E. Shumate 11-2-67
DIST. CONST. ENGINEER DATE

AS CONSTRUCTED PLANS
RETURN TO DIST. 4 DESIGN

FEDERAL ROAD DISTRICT NO.	DIVISION	PROJECT NO.	SHEET NO.
9	COLORADO	C13-0002-19	1

REC'D BIO. DIV.	DIVISION	PROJECT NO	SHEET NO.
9	COLO.	C13-0002-19	11



Test No.	56
Asphalt Mat	
Test No.	56-R-R-2-4(0)
Similar to	55-A
R ²	70


Test No.	55	
Asphalt Mat		
Test No.	55-A	A-E-4(10)
L.L.	N.Y.	
P.I.	N.P.	
% P200	18	
R.	70	

Test No. 55 Represents
Material from Sta. 1180
to Sta. 1200

4010

1104

NOTED
J. C.

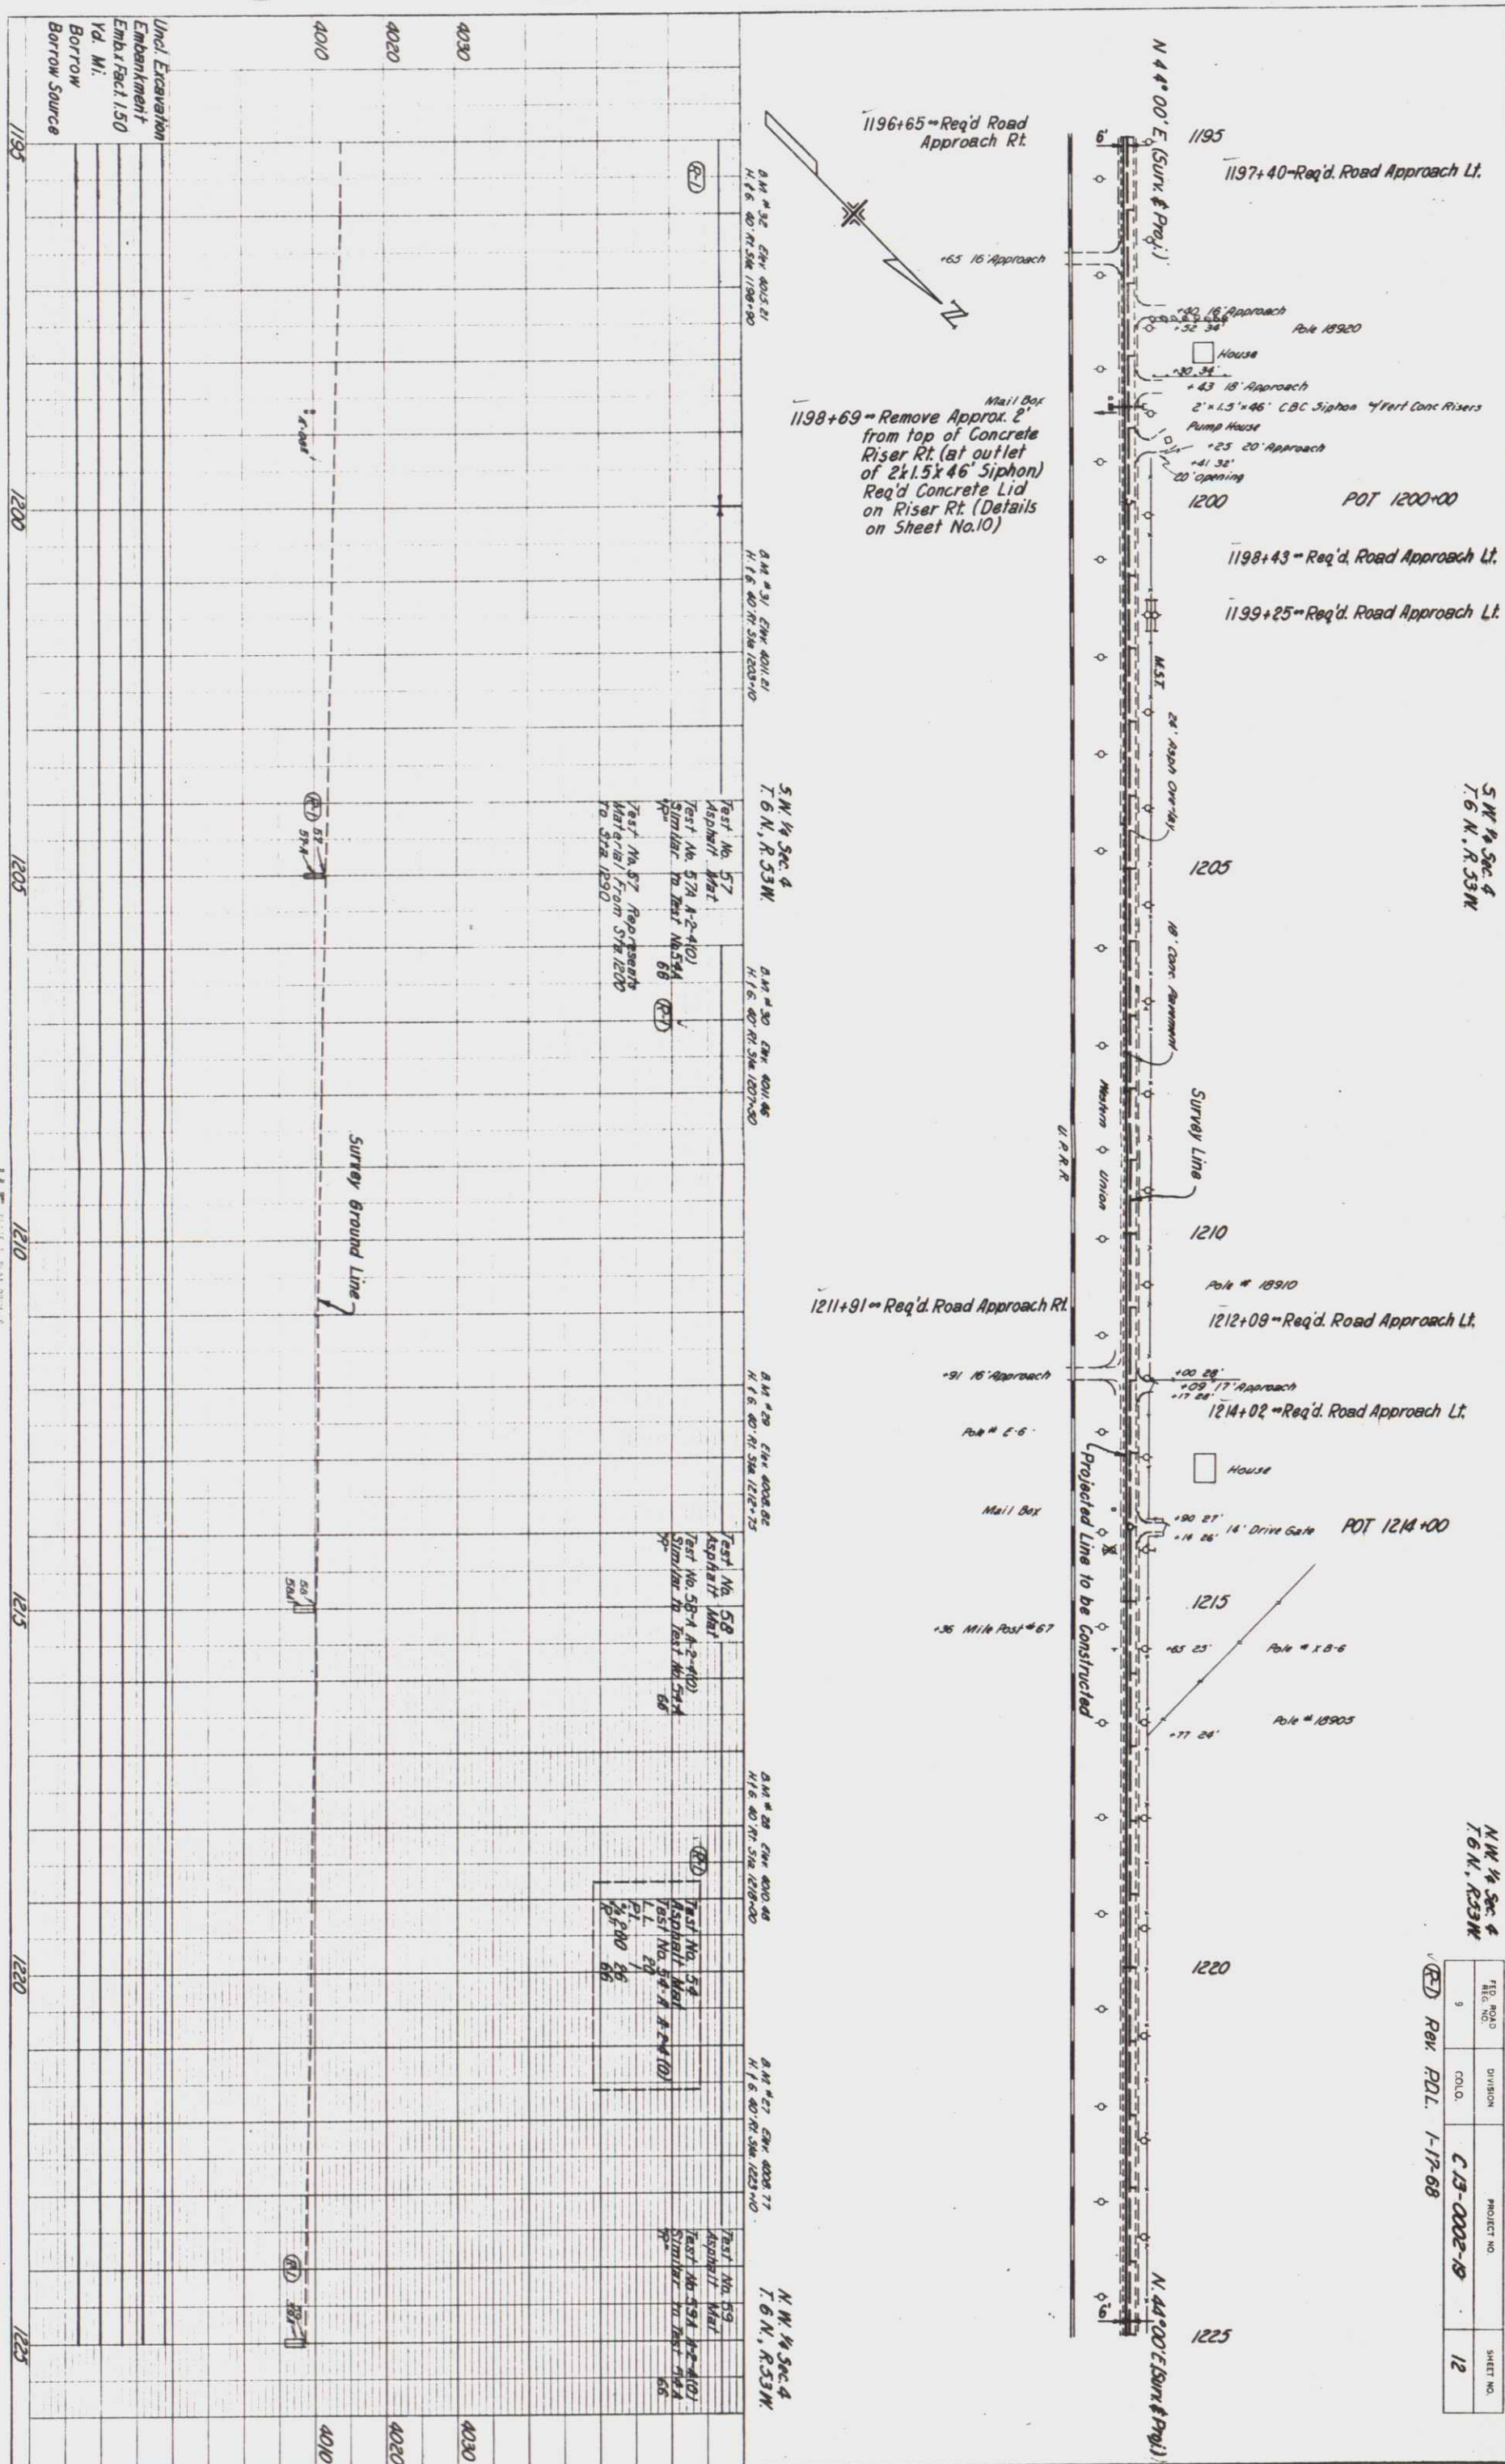PLAN
28793
28794

S.W. 1/4 Sec. 4
T. 6 N., R. 53 W.



N.W. 1/4 Sec. 4
T.6 N., R.53 W.

PROJECT NO.	C-13-0002-18	SHEET NO.	12
DIVISION	COLO.		
STD. ROAD REC. NO.	9		

Rev. P.D.L. 1-17-68



Rev. P.D.L. 1-17-68

PLAN

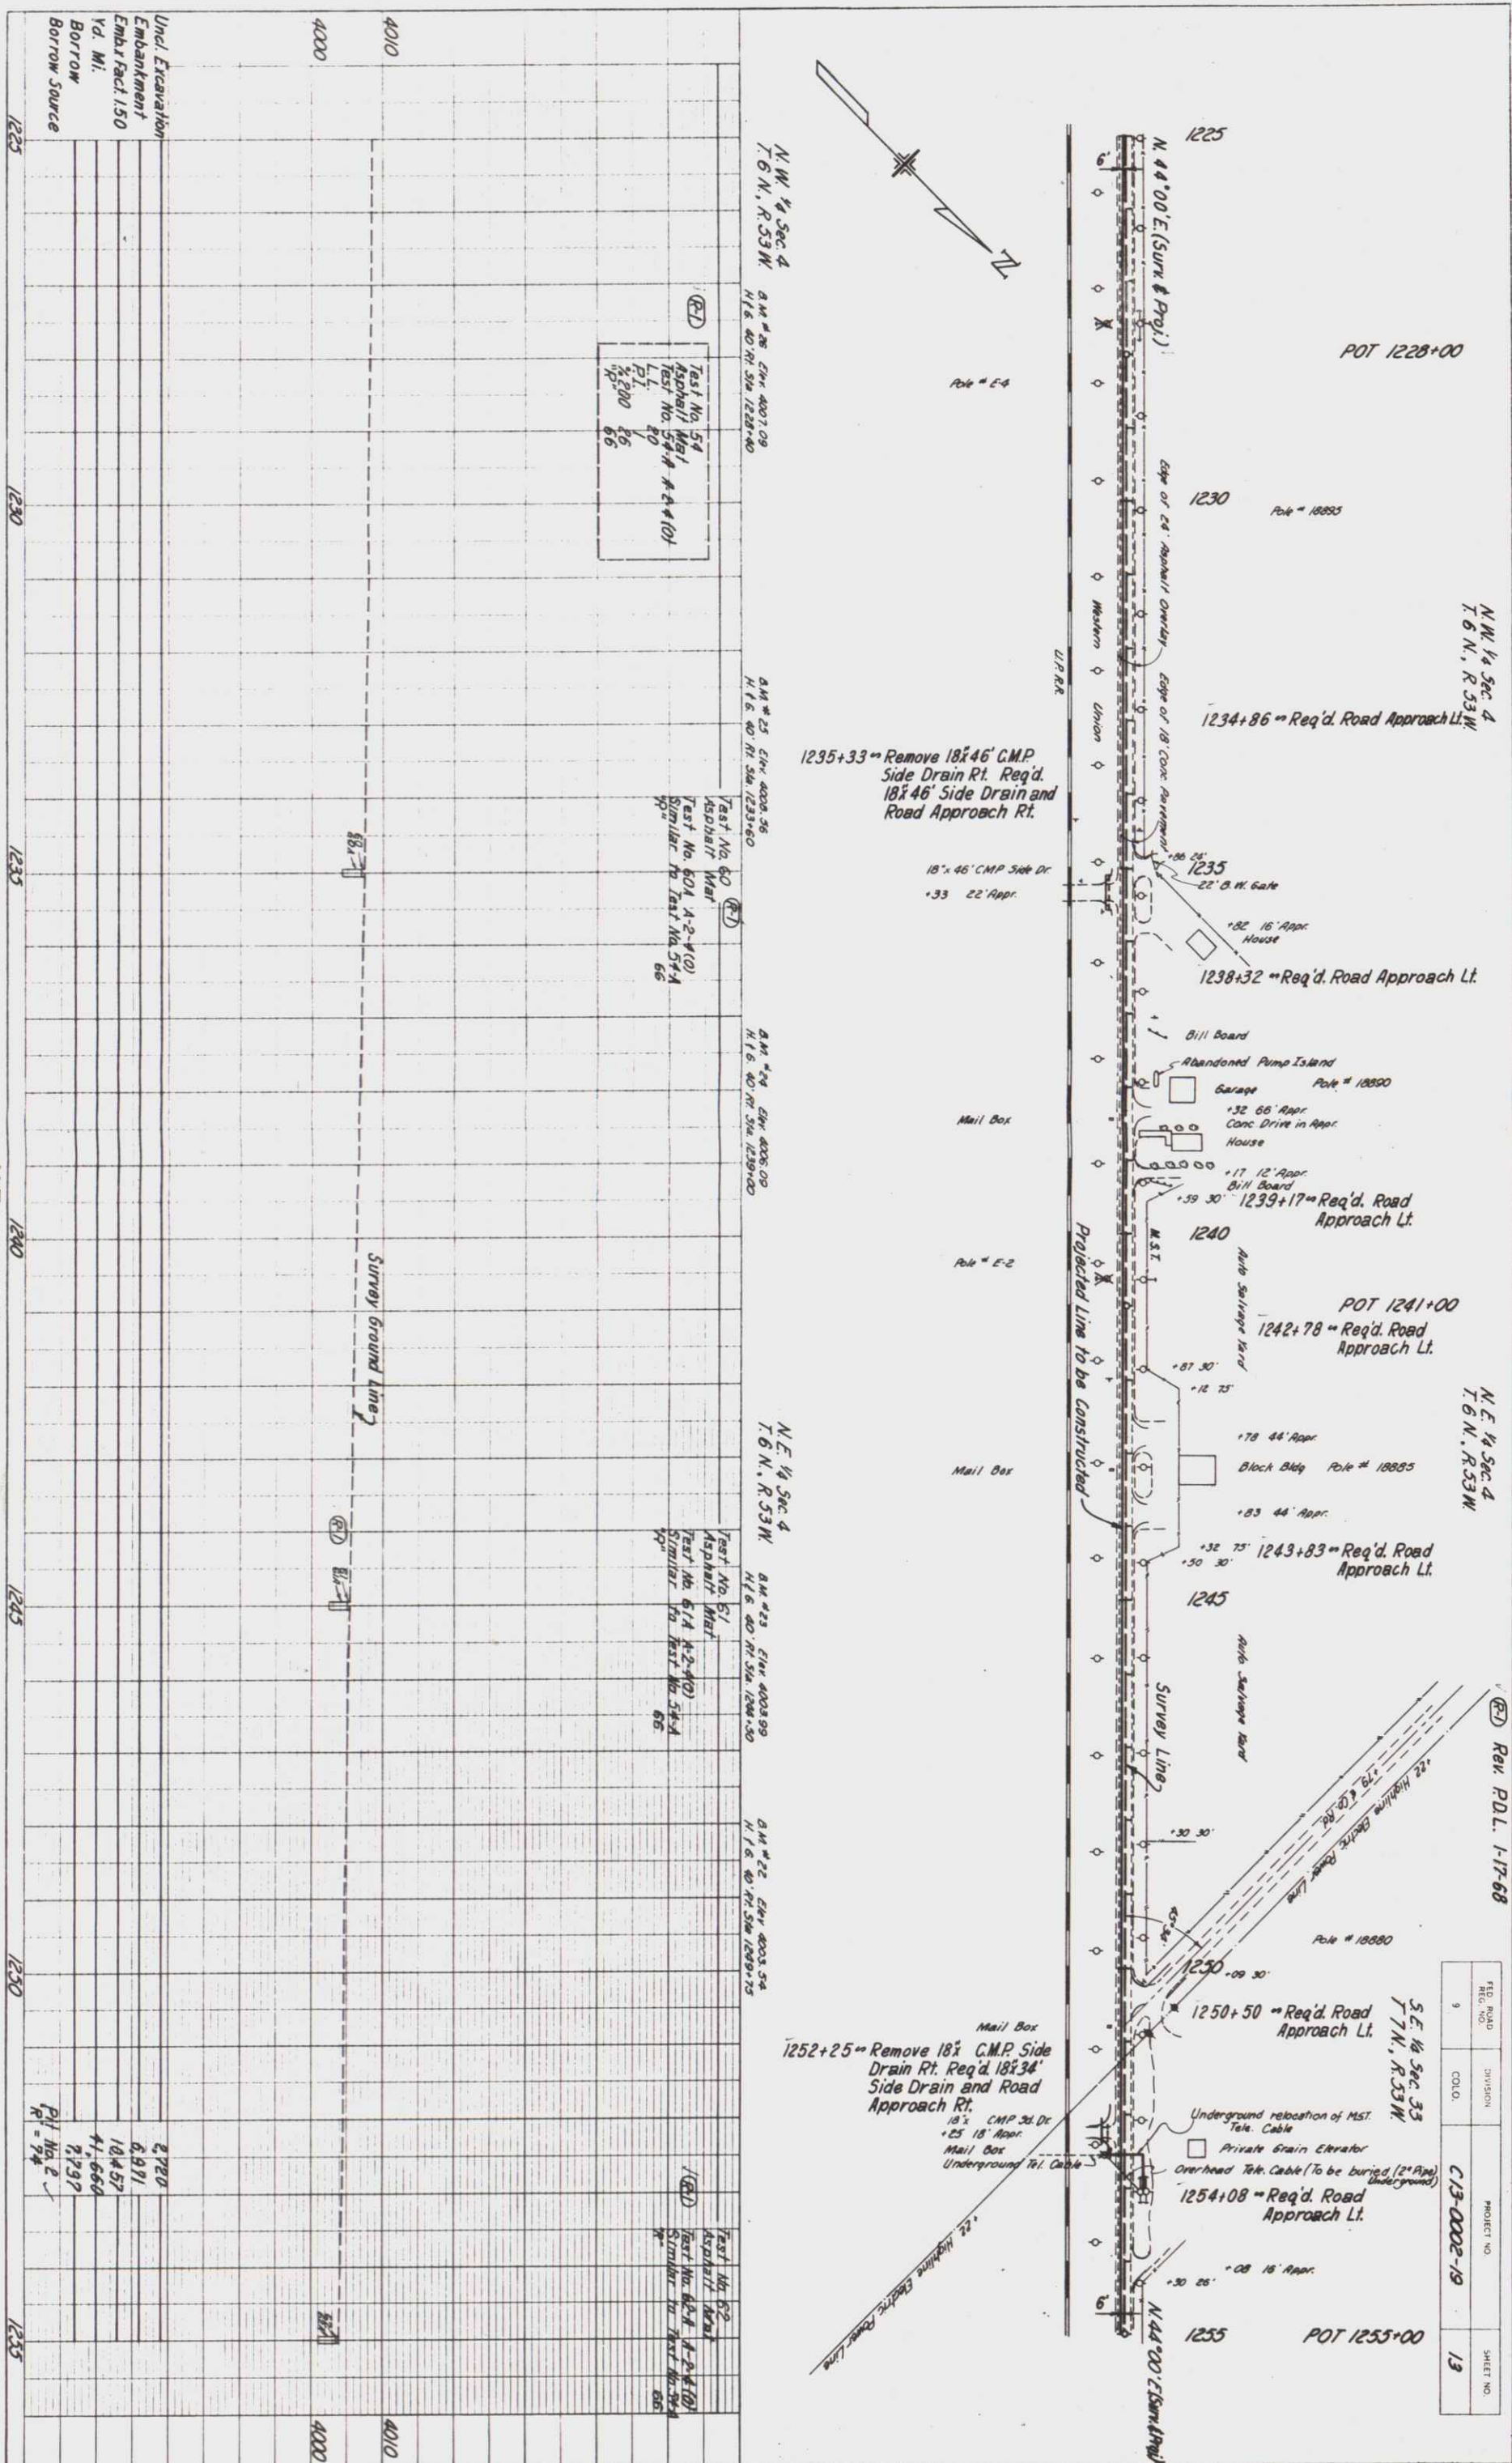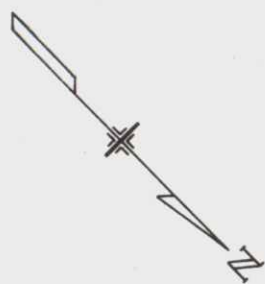

FED. ROAD REG. NO.	DIVISION	PROJECT NO.	SHEET NO.
9	COLO.	C13-0002-19	13

PLAN
26793
26794

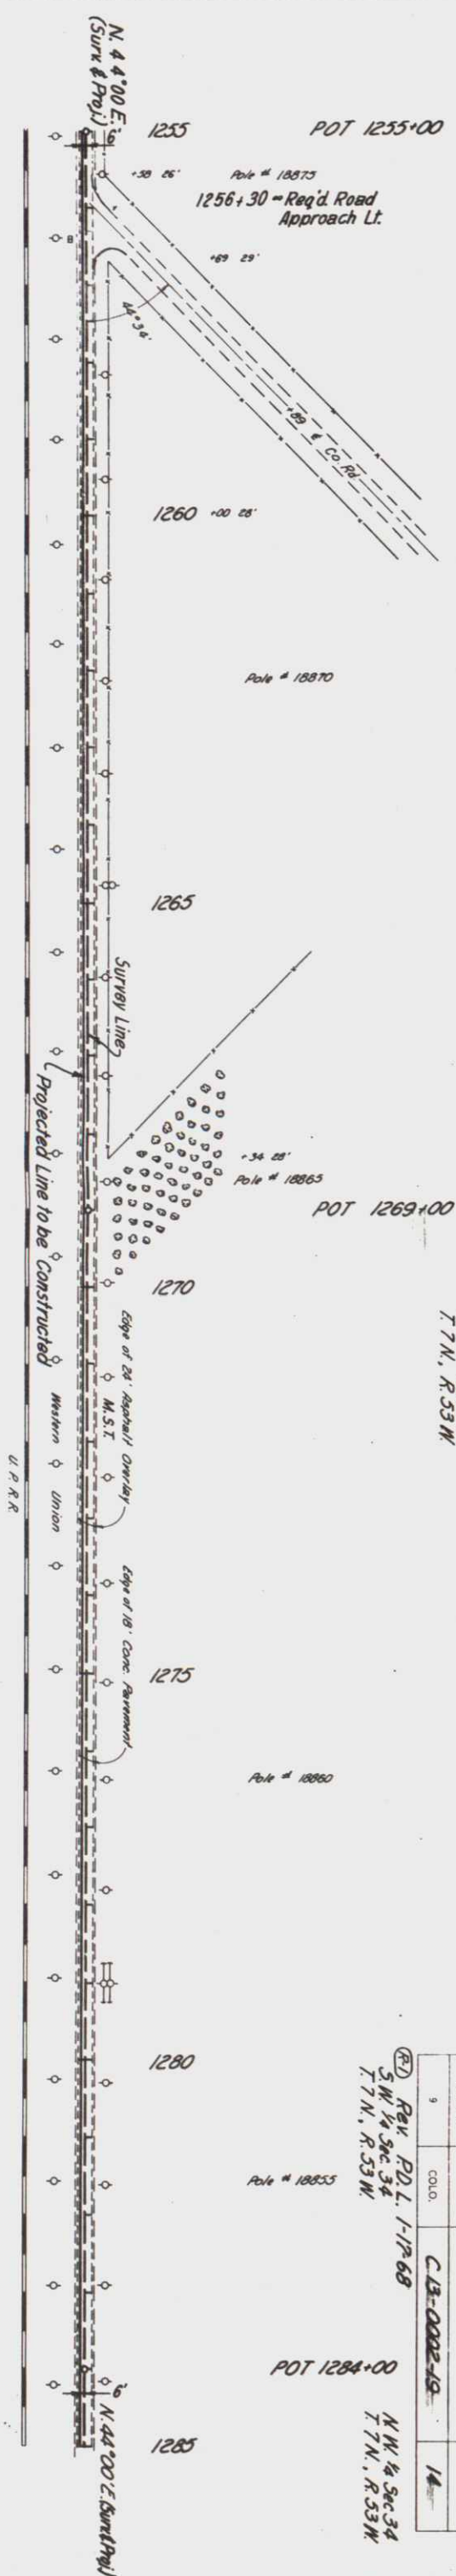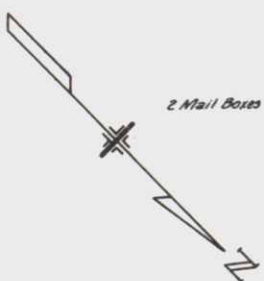

FED. ROAD REG. NO.	DIVISION	PROJECT NO.	SHEET NO.
9	COLO.	C-13-0002-19	14

(R-1) R₂₁, P.D.L. 1-17-68
5 W. 1/4 Sec 34
T. 7 N., R. 33 W.

POT 1284+00

5E 1/4 Sec 33
BM #20 Elev 4002.71, 7' N., R. 53W.
H & G. 40' R1. S1A 1260+40

B.M. #19 Elev. 4000.63
H.F.S. 40° Rt. Sta. 1265+60

B.M. #18 Elev. 4001.285
H. 16. 40' RT. Sta. 1270+94

S.W. $\frac{1}{4}$ Sec. 34
T. 7 N., R. 53 W.

B. M. #16 Elev. 4000.80
H. & G. 40' R.R. Sta. 1281+66

Test No. 54	Asphalt Mgt	Test No. 54-A A-2-410
-------------	-------------	-----------------------

Asphalt Mat
Test No. 63A A-2-4(10)
Similar to Test No. 54-
100"

D.M.# 17	EINE 8001.97
H.F.6.	40° RT. 51m. 12.76 + 25
-Test No.	64
Asphalt	MAT
Test No	64A-2-4(0)
Similar To Test No	54A
IP#	66

Test No. 65	
Asphalt Mat	
Test No. 65A A-2-4(10)	
Similar to Test No 94	
ppm	66

Survey Ground Line


24

527

Uncl. Excavation
Embankment
Emb. x Fac. 1.50
Yd. Mi.
Borrow
Borrow Source

THE UNIVERSITY OF CHICAGO

1070 JOURNAL OF POST KEYNESIAN ECONOMICS

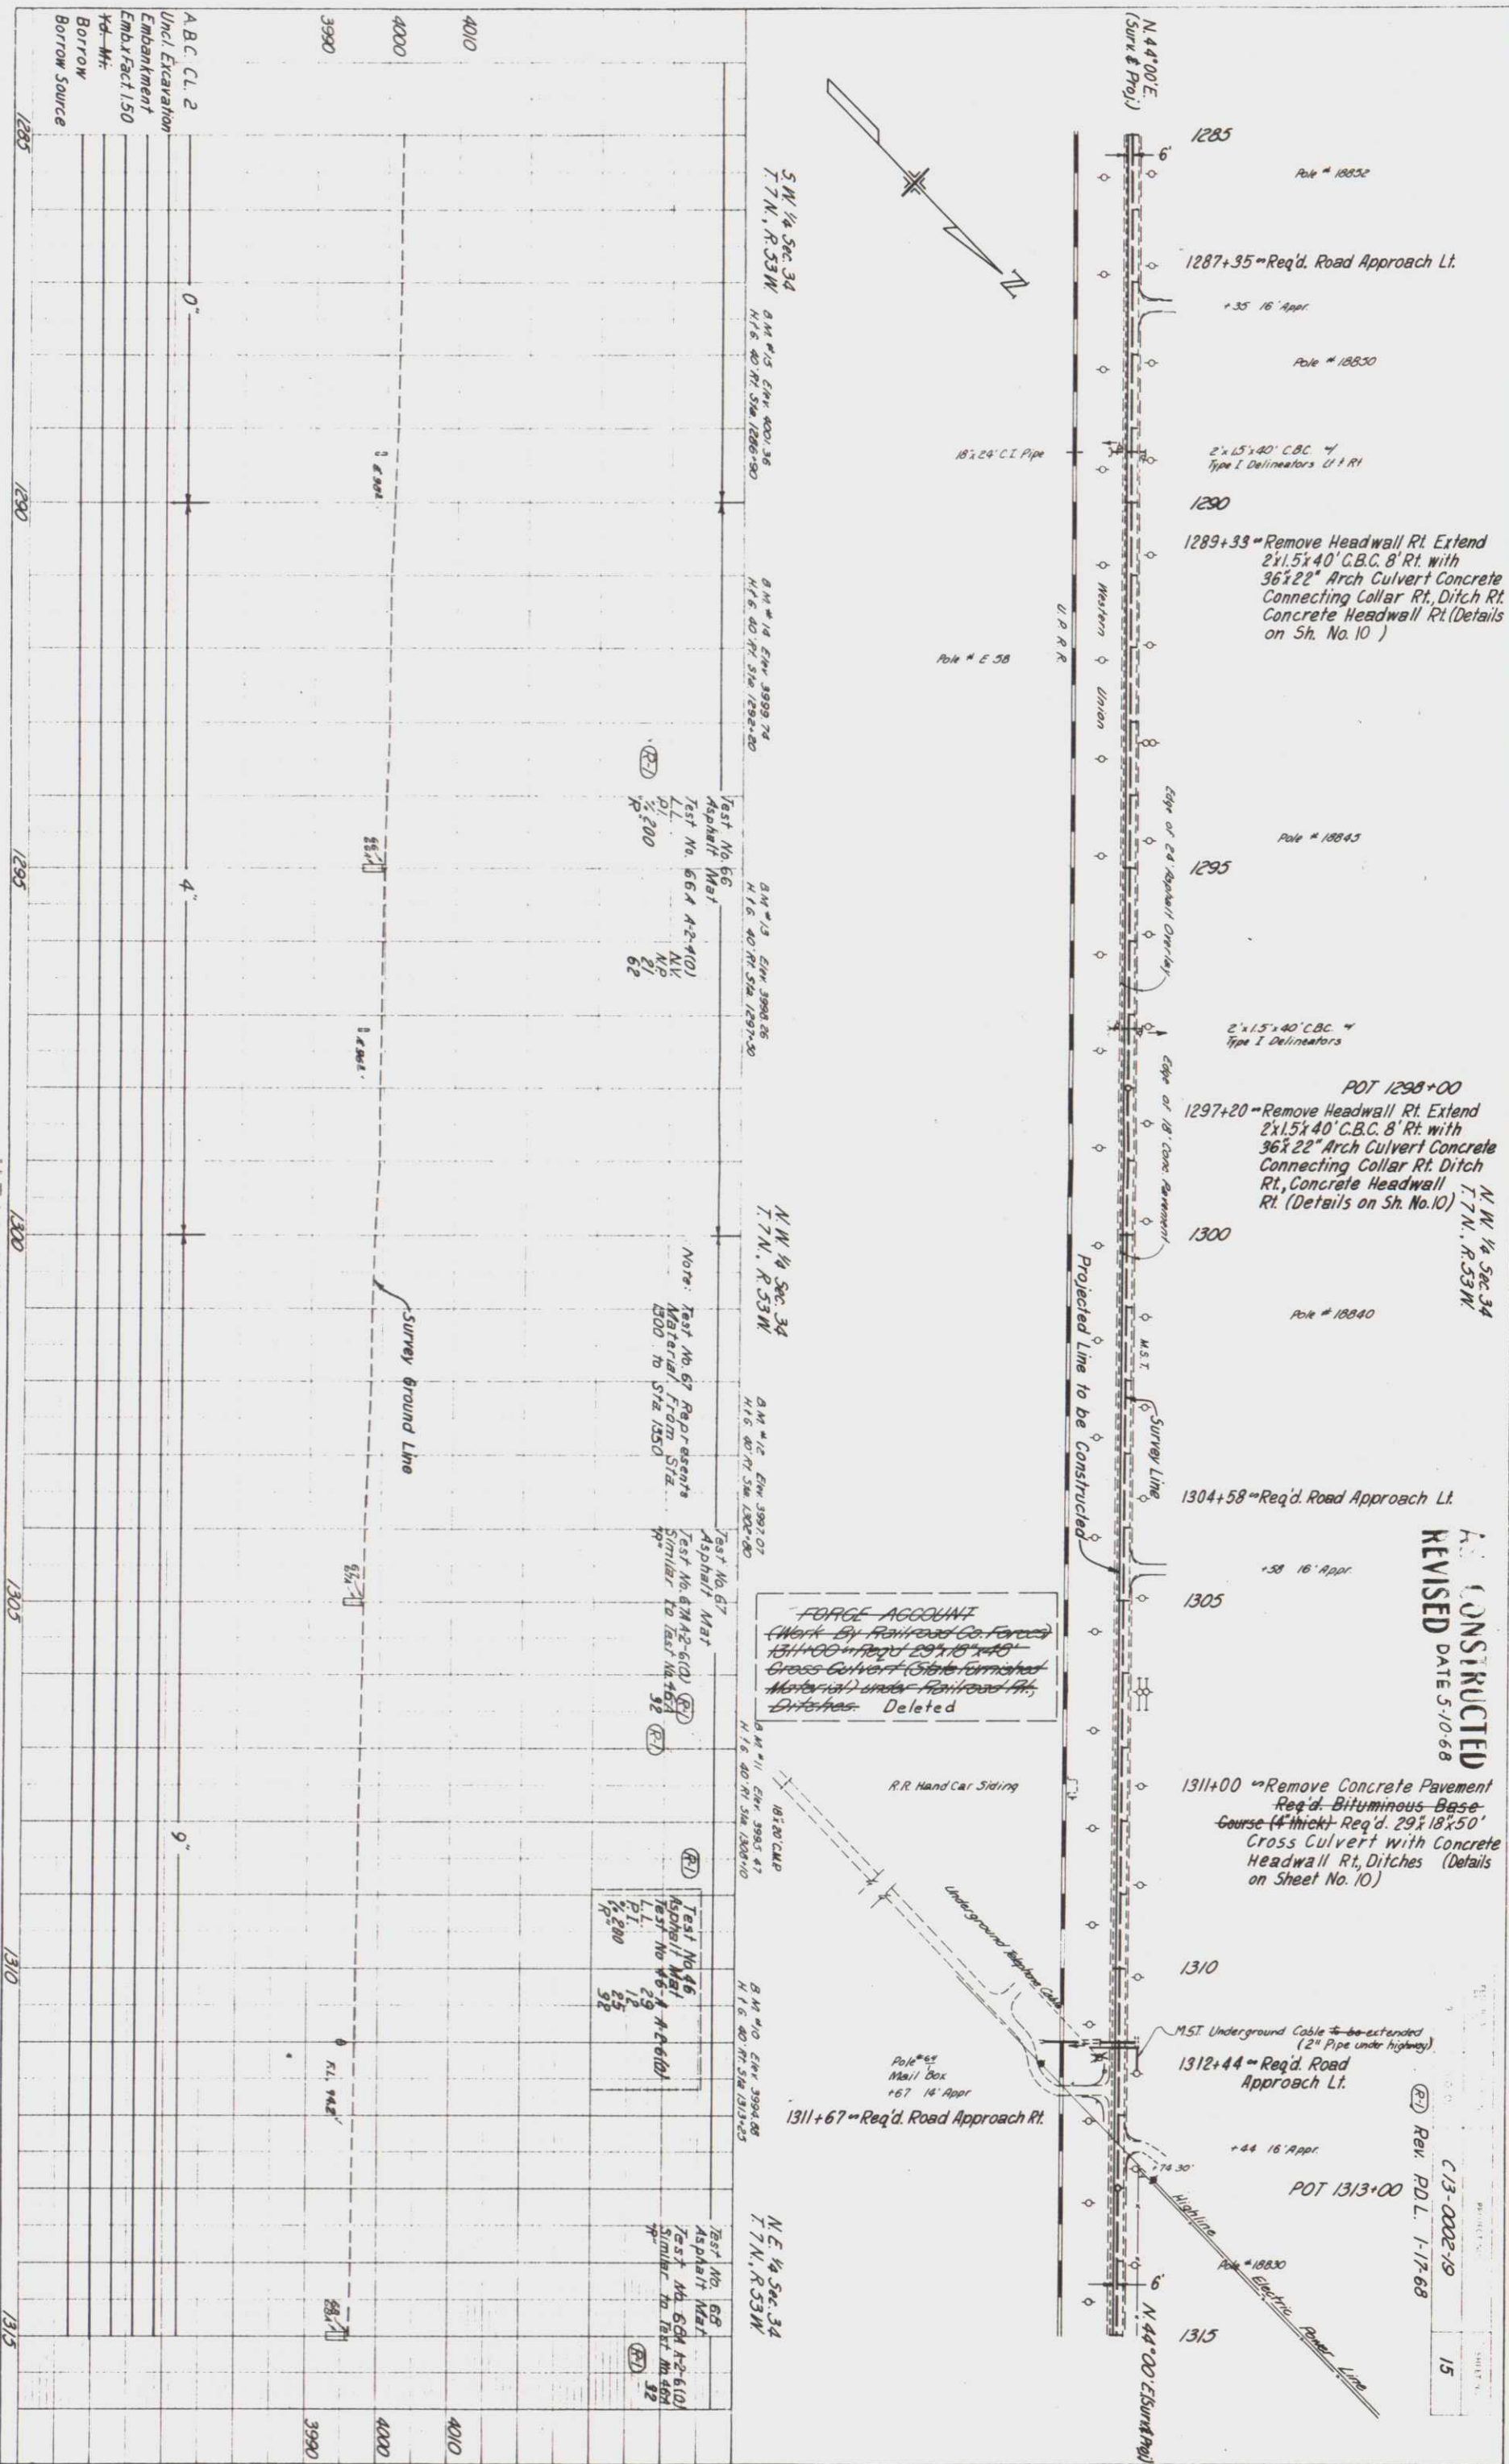

NOT CONSTRUCTED
REVISED DATE 5-10-68

C/3-0002-19
15

Rev. P.D.L. 1-17-68



주요 인물

