

## Oversight / NHS

FHWA REGION VIII OVERSIGHT? ☒ NO ☐ YESNATIONAL HIGHWAY SYSTEM? ☒ NO ☐ YES

## PROJECT DESCRIPTION:

THIS PROJECT IS LOCATED ALONG SH 131 BETWEEN WOLCOTT AND YAMPA.

IT IS A CULVERT REPAIR PROJECT, WHICH INCLUDES STRUCTURE EXCAVATION, REMOVAL OF ASPHALT MAT PLANING, CULVERT REPLACEMENTS, CULVERT LINING, EMBANKMENT, AGGREGATE BASE COURSE ASPHALT AND STRIPING.

DEPARTMENT OF TRANSPORTATION  
STATE OF COLORADOHIGHWAY CONSTRUCTION BID PLANS OF PROPOSED Constructed  
COLORADO PROJECT NO. C 131A-035  
STATE HIGHWAY NO. 131  
EAGLE & ROUTT COUNTY  
CONSTRUCTION PROJECT CODE NO. 18861R  
SH131 VARIOUS CULVERTS

## Related Projects:

P. E. UNDER PROJECT:  
Project Number  
Project Code:CR300-189  
19352

## TABULATION OF LENGTH


STATION	ROADWAY	
	SH 131 FEET	SH 131 MILES
BEGIN PROJECT C 131A-035 = STA 114+07 = MP 3.00		
MP 3.09 CULVERT WORK AREA = BEGIN: STA 115+22 = MP 3.03 END: STA 121+51 = MP 3.15	115.00	0.02
MP 5.13 CULVERT WORK AREA = BEGIN: STA 219+69 = MP 5.03 END: 233+49 = MP 5.29	629.00	0.12
	9,818.00	1.86
MP 5.13 CULVERT WORK AREA = BEGIN: STA 219+69 = MP 5.03 END: 233+49 = MP 5.29	1,380.00	0.26
NO WORK ZONE = BEGIN: STA 270+92 = MP 6.00 END: STA 291+31 = MP 35.50	154,704.00	29.30
	9,729.00	1.84
BEGIN NORTH CULVERTS WORK AREA = STA 338+60 = MP 36.40	6,640.00	1.31
END NORTH CULVERTS WORK AREA = STA 405+00 = MP 37.71	1,789.00	0.29
END PROJECT C 131A-035 = STA 422+89 = MP 38.00		
ROADWAY (NET LENGTH)	30,100.00	5.70
NO WORK ZONE	154,704.00	29.30
PROJECT GROSS LENGTH	184,804.00	35.00

## DESIGN DATA FOR SH 131

MP 3.09 DESIGN SPEED - 50 MPH
MP 5.13 DESIGN SPEED - 40 MPH
MP 36.42 DESIGN SPEED - 65 MPH
MP 37.08 DESIGN SPEED - 65 MPH
MP 37.11 DESIGN SPEED - 65 MPH
MP 37.34 DESIGN SPEED - 65 MPH
MP 37.79 DESIGN SPEED - 65 MPH

## TRAFFIC VOLUMES

	2012	2032
ADT: MP 3 - MP 6	1,400	2,086
DHV: MP 3 - MP 6	196	292
% TRUCKS	11.2%	11.2%
ADT: MP 35.5 - MP 38	900	1,233
DHV: MP 35.5 - MP 38	126	173
% TRUCKS	8.4%	8.4%

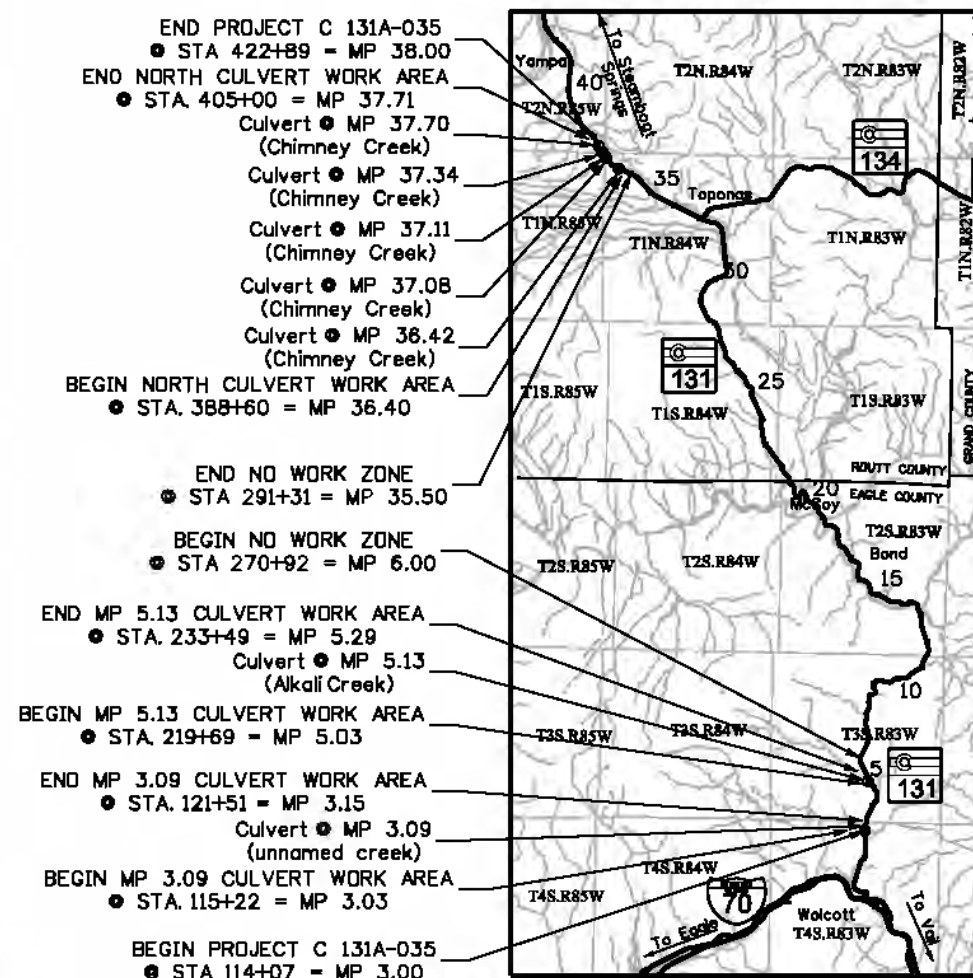

PROJECT LOCATION MAP

## SHEET NO.

## TITLE

1	TITLE SHEET
2	STANDARD PLANS LIST
3 - 4	TYPICAL SECTIONS
5 - 6	GENERAL NOTES
7 - 9	SUMMARY OF APPROXIMATE QUANTITIES
10	SUMMARY OF EARTHWORK QUANTITIES
11	TABULATIONS OF SURFACING AND CULVERTS
12	TABULATION OF CONCRETE
13	TABULATIONS OF RIPRAP, EPOXY PAVEMENT MARKING, OELINEATORS, & FENCE
14	TABULATIONS OF WETLAND QUANTITIES & TEMPORARY WETLAND VEGETATION PROTECTION DETAIL
15	SURVEY TABULATION SHEET
16 - 21	PROJECT CONTROL DIAGRAM
22 - 24	GEOMETRY SHEETS
25 - 26	MP 3.09 PLAN, PROFILE, & DETAILS
27 - 29	MP 5.13 PLAN, PROFILE, & DETAILS
30 - 31	MP 36.42 PLAN, PROFILE, & DETAILS
32 - 34	MP 37.08 & MP 37.11 PLAN, PROFILE & DETAILS
35 - 36	MP 37.34 PLAN, PROFILE, & DETAILS
37 - 38	MP 37.70 PLAN, PROFILE, & DETAILS
39 - 44	PERMANENT & TEMPORARY WETLAND IMPACTS
45 - 46	STORMWATER MANAGEMENT PLAN NOTES & TABULATIONS
47 - 52	STORMWATER MANAGEMENT PLAN SITE MAP
53	TABULATION OF CONSTRUCTION TRAFFIC CONTROL DEVICES
54 - 75	CROSS SECTIONS

Print Date: 4/26/2013

File Name: 18861DES\_TitleSht.dgn

Horiz. Scale: As Noted

Vert. Scale: N/A

Unit Information: GJ Design Unit Leader Initials: JSL

## Sheet Revisions

Date:	Comments	Init.

Colorado Department of Transportation



Region 03

714 Grand Ave.  
Eagle, CO, 81631  
Phone: 970-328-9962 FAX: 970-328-2368

P.J.L.

## As Constructed

No Revisions: 12/23/13

Revised:

Void:

## Contract Information

Contractor: Johnson Construction

Resident Engineer: Pete Lombardi

Project Engineer: Chad Phillips

PROJECT STARTED: 7/22/13 ACCEPTED: 12/23/13

Comments:

## Project No./Code

C 131A-035

18861R

Sheet Number 1



klishj 3:04:34 PM c:\projectwise\pwz\_working\0233335\1886IDES\_StandardPlansList.dgn

PLAN NUMBER	NEW OR REVISED	M STANDARD TITLE	PAGE NUMBER
M-100-1		STANDARD SYMBOLS (3 SHEETS).....	1-3
M-100-2		ACRONYMS AND ABBREVIATIONS (4 SHEETS).....	4-7
M-203-1		APPROACH ROADS .....	8
M-203-2		DITCH TYPES.....	9
M-203-11		SUPERELEVATION CROWNED AND DIVIDED HIGHWAYS (3 SHEETS).....	10-12
M-203-12		SUPERELEVATION STREETS (2 SHEETS).....	13-14
M-206-1		EXCAVATION AND BACKFILL FOR STRUCTURES (2 SHEETS).....	15-16
M-206-2		EXCAVATION AND BACKFILL FOR BRIDGES (2 SHEETS)....	17-18
M-208-1		TEMPORARY EROSION CONTROL (12 SHEETS).....	19-30
M-210-1		MAILBOX SUPPORTS (2 SHEETS) .....	31-32
M-214-1		PLANTING DETAILS.....	33
M-412-1	<input type="checkbox"/>	CONCRETE PAVEMENT JOINTS (5 SHEETS) (REVISED ON JULY 24, 2012).....	<del>34-38</del>
M-510-1		STRUCTURAL PLATE PIPE H-20 LOADING.....	39
M-601-1		SINGLE CONCRETE BOX CULVERT (2 SHEETS).....	40-41
M-601-2		DOUBLE CONCRETE BOX CULVERT (2 SHEETS).....	42-43
M-601-3		TRIPLE CONCRETE BOX CULVERT (2 SHEETS).....	44-45
M-601-10		HEADWALL FOR PIPES.....	46
M-601-11		TYPE "S" SADDLE HEADWALLS FOR PIPE.....	47
M-601-12		HEADWALLS AND PIPE OUTLET PAVING.....	48
M-601-20		WINGWALLS FOR PIPE OR BOX CULVERTS .....	49
M-603-1		METAL PIPE (4 SHEETS).....	50-53
M-603-2		REINFORCED CONCRETE PIPE .....	54
M-603-3		PRECAST CONCRETE BOX CULVERT.....	55
M-603-4		CORRUGATED POLYETHYLENE PIPE (AASHTO M294) .....	56
M-603-5		POLYVINYL CHLORIDE (PVC) PIPE (AASHTO M304) .....	57
M-603-10		CONCRETE AND METAL END SECTIONS (2 SHEETS) .....	58-59
M-604-10		INLET, TYPE C .....	60
M-604-11		INLET, TYPE D .....	61
M-604-12		CURB INLET TYPE R (2 SHEETS).....	62-63
M-604-13		CONCRETE INLET TYPE 13.....	64
M-604-20		MANHOLES (3 SHEETS).....	65-67
M-604-25		VANE GRATE INLET (5 SHEETS).....	68-72
M-605-1		SUBSURFACE DRAINS .....	73
M-606-1		GUARDRAIL TYPE 3 W-BEAM (19 SHEETS) .....	74-92
M-606-13		GUARDRAIL TYPE 7 F-SHAPE BARRIER (4 SHEETS).....	93-96
M-606-14		PRECAST TYPE 7 CONCRETE BARRIER (3 SHEETS).....	97-99

PLAN NUMBER	NEW OR REVISED	M STANDARD TITLE	PAGE NUMBER
M-607-1		WIRE FENCES AND GATES (3 SHEETS).....	100-102
M-607-2		CHAIN LINK FENCE (3 SHEETS).....	103-105
M-607-3		BARRIER FENCE.....	106
M-607-4		DEER FENCE AND GATES (3 SHEETS) .....	107-109
M-607-10		PICKET SNOW FENCE .....	110
M-607-15		ROAD CLOSURE GATE (9 SHEETS).....	111-119
M-608-1		CURB RAMPS (6 SHEETS) .....	120-125
M-609-1	<input type="checkbox"/>	CURBS, GUTTERS, AND SIDEWALKS (4 SHEETS) (REVISED ON JULY 24, 2012).....	<del>126-129</del>
M-611-1		CATTLE GUARD (2 SHEETS).....	130-131
M-613-1		ROADWAY LIGHTING (4 SHEETS).....	132-135
M-614-1		RUMBLE STRIPS (3 SHEETS).....	136-138
M-614-2		SAND BARREL ARRAYS (2 SHEETS).....	139-140
M-615-1		EMBANKMENT PROTECTOR TYPE 3 .....	141
M-615-2		EMBANKMENT PROTECTOR TYPE 5 .....	142
M-616-1		INVERTED SIPHON.....	143
M-620-1		FIELD LABORATORY CLASS 1.....	144
M-620-2		FIELD LABORATORY CLASS 2 (2 SHEETS) .....	145-146
M-620-11		FIELD OFFICE CLASS 1.....	147
M-620-12		FIELD OFFICE CLASS 2.....	148
M-629-1		SURVEY MONUMENTS (2 SHEETS).....	149-150

PLAN NUMBER	NEW OR REVISED	S STANDARD TITLE	PAGE NUMBER
S-612-1		DELINEATOR INSTALLATIONS (7 SHEETS) .....	151-157
S-614-1	<input type="checkbox"/>	GROUND SIGN PLACEMENT (2 SHEETS) (REVISED ON JULY 24, 2012)....	<del>158-159</del>
S-614-2		CLASS I SIGNS .....	160
S-614-3		CLASS II SIGNS .....	161
S-614-4		CLASS III SIGNS (3 SHEETS) .....	162-164
S-614-5		BREAK-AWAY SIGN SUPPORT DETAILS .....	165-166
S-614-6		CONCRETE FOOTINGS AND SIGN ISLANDS.....	167-168
S-614-8	<input type="checkbox"/>	TUBULAR STEEL SIGN SUPPORT DETAILS (5 SHEETS).....	<del>169-173</del>
S-614-9		PEDESTRIAN PUSH BUTTON POST ASSEMBLY .....	174
S-614-10		MARKER ASSEMBLY INSTALLATIONS .....	175
S-614-11		MILEPOST SIGN DETAIL FOR HIGH SNOW AREAS .....	176
S-614-12		STRUCTURE NUMBER INSTALLATION .....	177
S-614-14		FLASHING BEACON AND SIGN INSTALLATIONS (3 SHEETS)..	178-180
S-614-20		TYPICAL POLE MOUNT SIGN INSTALLATIONS.....	181
S-614-21		CONCRETE BARRIER SIGN POST INSTALLATIONS .....	182
S-614-22		TYPICAL MULTI-SIGN INSTALLATIONS.....	183
S-614-40		TYPICAL TRAFFIC SIGNAL INSTALLATION DETAILS .....	184-188
S-614-40A	<input type="checkbox"/>	ALTERNATIVE TRAFFIC SIGNAL INSTALLATION DETAILS.....	<del>189-192</del>
S-614-41		PEDESTAL POLE AND TEMPORARY SPAN WIRE SIGNALS.....	193
S-614-42		CABINET FOUNDATION DETAIL (4 SHEETS).....	194-197
S-614-43		TRAFFIC LOOP AND MISCELLANEOUS SIGNAL DETAILS.....	198-207
S-614-50	<input type="checkbox"/>	STATIC SIGN MONOTUBE STRUCTURES (12 SHEETS).....	<del>208-219</del>
S-614-60	<input type="checkbox"/>	DYNAMIC SIGN MONOTUBE STRUCTURES (14 SHEETS).....	<del>220-233</del>
S-627-1	<input checked="" type="checkbox"/>	PAVEMENT MARKINGS (5 SHEETS) (REVISED ON OCTOBER 18, 2012) .....	<del>234-238</del>
S-630-1	<input checked="" type="checkbox"/>	TRAFFIC CONTROLS FOR HIGHWAY CONSTRUCTION.....	<del>239-258</del>
S-630-2		BARRICADES, DRUMS, CONCRETE BARRIERS (TEMP).....	259
S-630-3		FLASHING BEACON (PORTABLE) DETAILS .....	260
S-630-4		STEEL SIGN SUPPORT (TEMPORARY) INSTALLATION.....	261-262
S-630-5	<input type="checkbox"/>	PORTABLE RUMBLE STRIPS (TEMPORARY) (2 SHEETS) .....	<del>263-264</del>
S-630-6		EMERGENCY PULL-OFF AREA (TEMPORARY) .....	265
S-630-7		ROLLING ROADBLOCKS FOR TRAFFIC CONTROL .....	266-268

COLORADO  
DEPARTMENT OF TRANSPORTATION  
M&S STANDARDS PLANS LIST  
July 04, 2012  
Revised on March 5, 2013

ALL OF THE M&S STANDARD PLANS, AS SUPPLEMENTED AND REVISED, APPLY TO THIS PROJECT WHEN USED BY DESIGNATED PAY ITEM OR SUBSIDIARY ITEM.


NEW OR REVISED STANDARD PLAN SHEETS APPLICABLE TO THIS PROJECT, INDICATED BY A MARKED BOX ☒, WILL BE ATTACHED TO THE PLANS.

Print Date: 3/15/2013	<div>0000</div>	Sheet Revisions			Colorado Department of Transportation		As Constructed		STANDARD PLANS LIST			Project No./Code	
File Name: 1886IDES_StandardPlansList.dgn		Date:	Comments	Init.			No Revisions: 12/23/13					C 131A-035	
Horiz. Scale: 1:1						714 Grand Ave Eagle, CO 81631 Phone: (970) 328-9962 FAX: (970) 328-2368	Revised:		Designer: J. Klish	Structure		18861R	
Unit Information: GJ Design							Void:		J. Klish	Numbers		Sheet Number 2	
					Region 03	PJL			Subset: StdPlanList	Subset Sheets: 1 of 1			



Sideslope Widening Typical Sections


Sta. 342+75 to Sta. 343+75, Sta. 375+20 to Sta. 376+20  
Sta. 387+70 to Sta. 388+70, Sta. 401+30 to Sta. 402+30

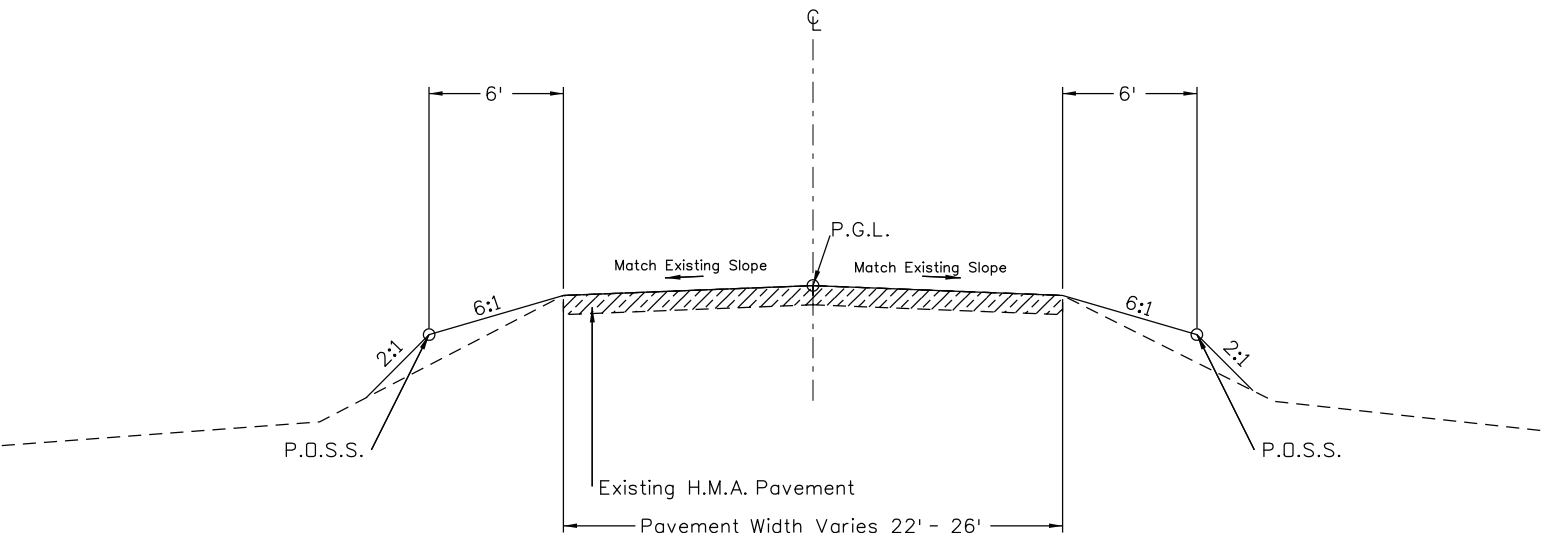

No Work Locations:  
Sta. 344+25 to Sta. 374+70  
Sta. 376+70 to Sta. 387+20  
Sta. 389+20 to Sta. 400+80

Sideslope Widening Transition Typical Sections

Sta. 342+25 to Sta. 342+75, Sta. 343+75 to Sta. 344+25  
Sta. 374+70 to Sta. 375+20, Sta. 376+20 to Sta. 376+70  
Sta. 387+20 to Sta. 387+70, Sta. 388+70 to Sta. 389+20  
Sta. 400+80 to Sta. 401+30, Sta. 402+30 to Sta. 402+80

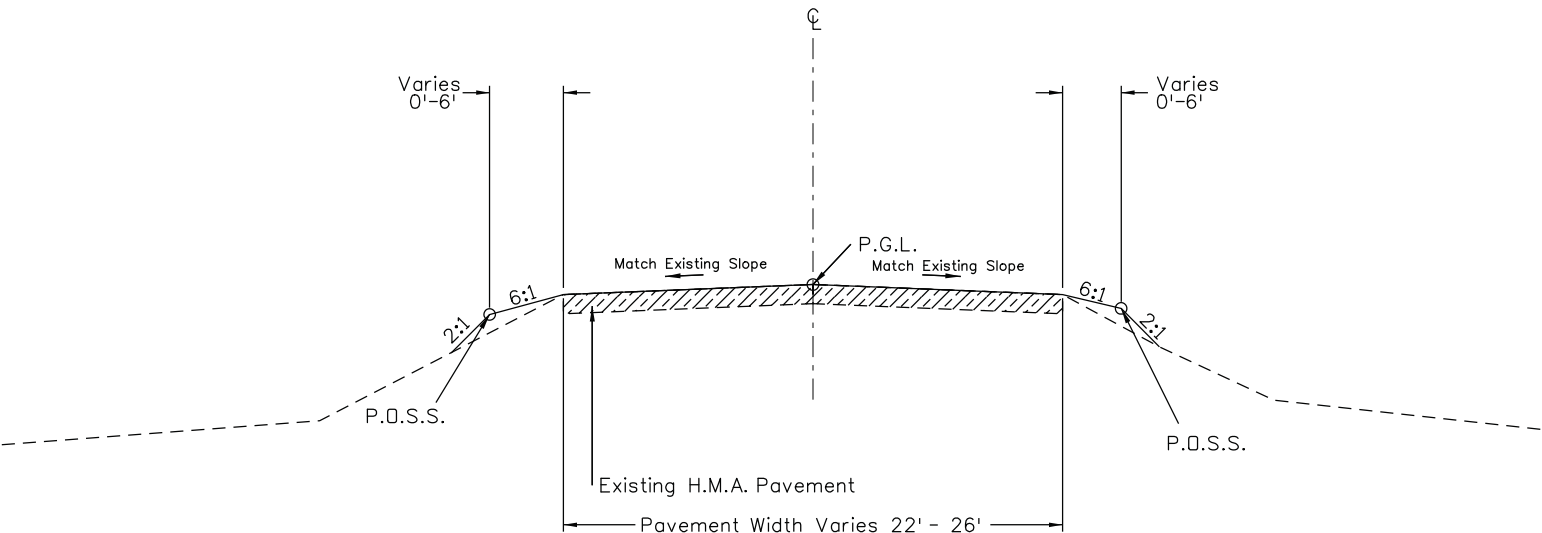


P.G.L. ~ Profile Grade Line  
H.M.A. ~ Hot Mix Asphalt  
P.O.S.S. ~ Point of Slope Selection

Print Date: 3/1/2013		<div><div></div><div></div><div></div><div></div><div></div></div>	Sheet Revisions			Colorado Department of Transportation		As Constructed		TYPICAL SECTIONS			Project No./Code	
File Name: 18861DES_TypSect02.dgn			Date:	Comments	Init.	<div> 714 Grand Ave. Eagle, CO 81631 Phone: (970) 328-9962 FAX: (970) 328-2368 Region 03</div>	P.J.L	No Revisions: 12/23/13					C 131A-035	
Horiz. Scale: NTS      Vert. Scale: NTS								Revised:	Designer: J. Klish	Structure Numbers	18861R			
Unit Information: GJ Design      JSL								Void:	Detailer: J. Klish	Subset Sheets: 1 of 2	Sheet Number 3			
									Subset: TS					




Milling & Widening Typical Section for MP 3.09

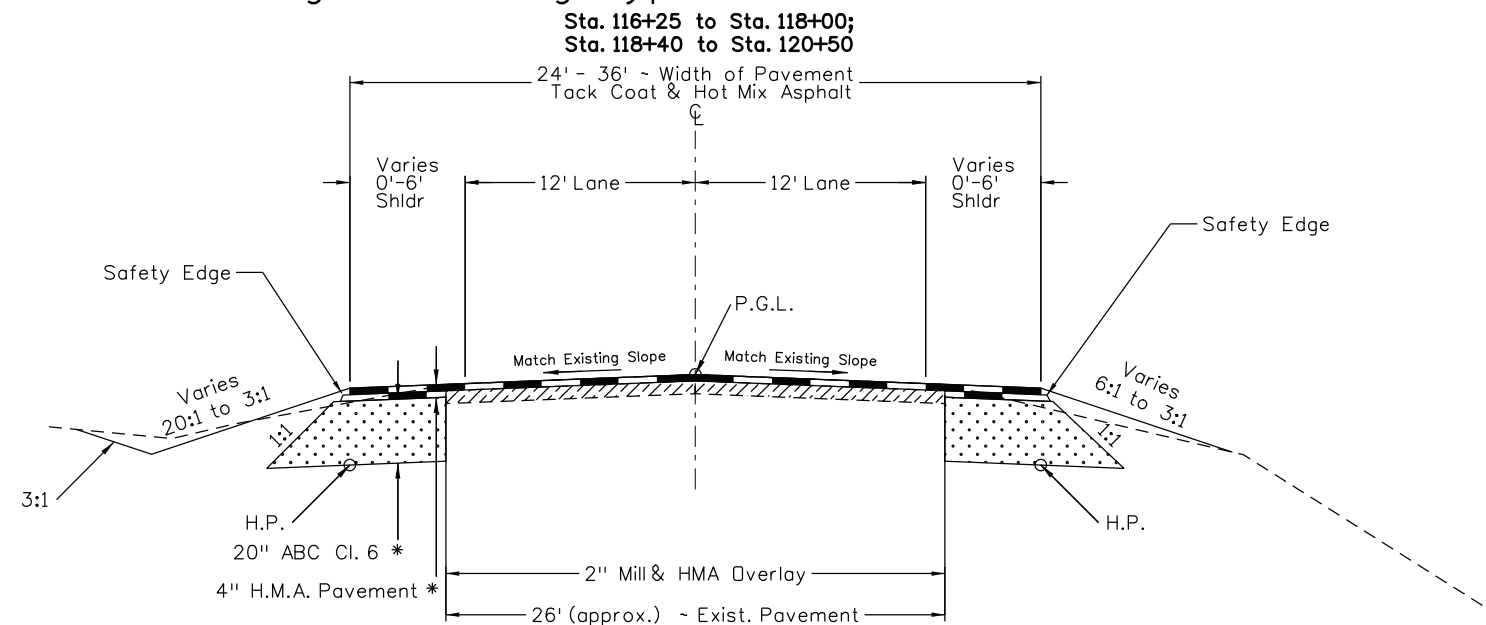


MILK CREEK ROAD SHOULDER DETAIL

Sta. 117+15 TO 117+40 LT  
(Facing east toward SH 131)

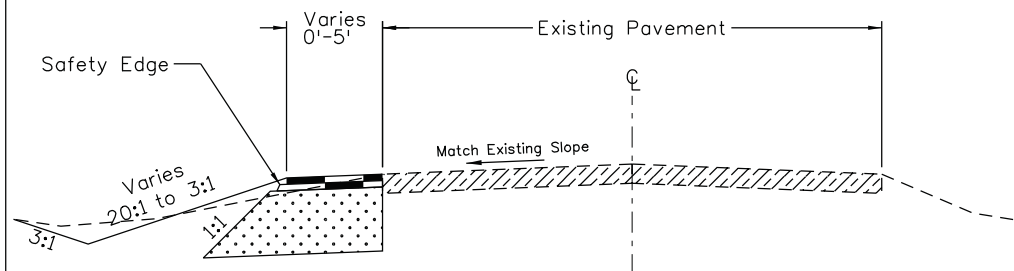

Full Depth Typical Section for MP 3.09


Sta. 118+00 to Sta. 118+40

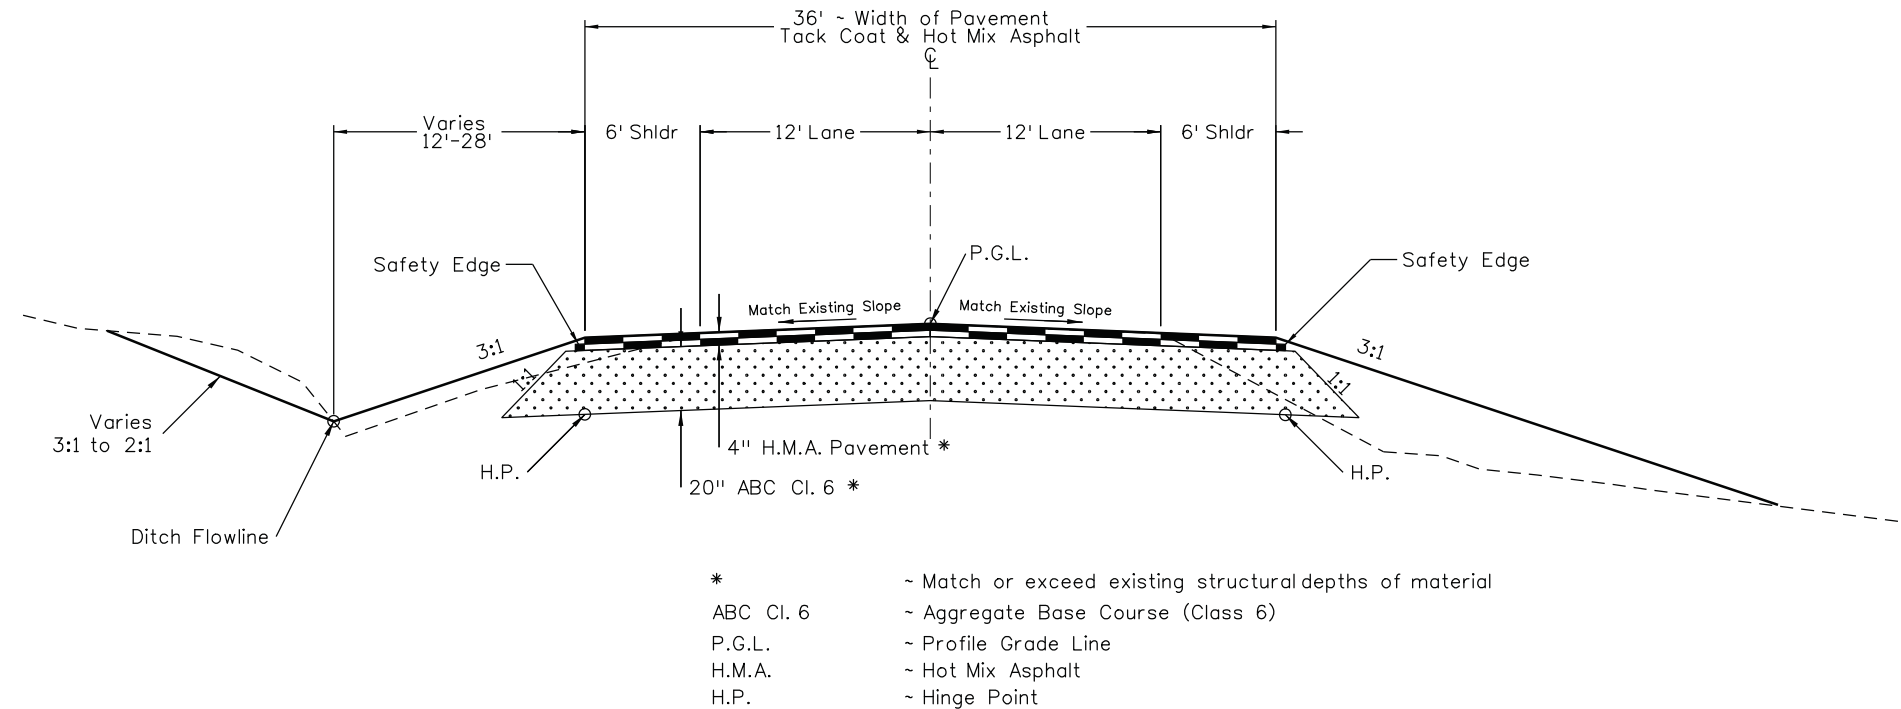

- \* ~ Match or exceed existing structural depths of material  
ABC Cl. 6 ~ Aggregate Base Course (Class 6)  
P.G.L. ~ Profile Grade Line  
H.M.A. ~ Hot Mix Asphalt  
H.P. ~ Hinge Point

SAFETY EDGE DETAIL

(NOT TO SCALE)

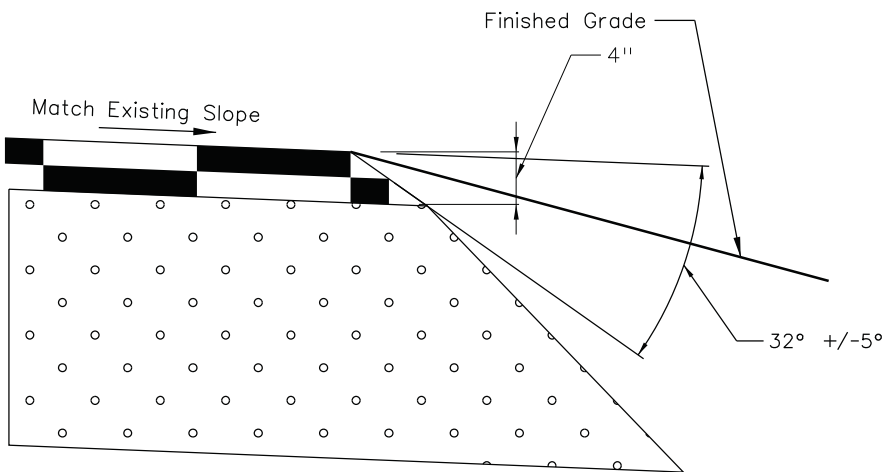

Print Date: 3/1/2013

File Name: 18861DES\_TypSect01.dgn

Horiz. Scale: NTS

Vert. Scale: NTS

Unit Information: GJ Design

NTS

JSL

Sheet Revisions

Date:	Comments	Init.

Colorado Department of Transportation



714 Grand Ave.  
Eagle, CO 81631  
Phone: (970) 328-9962 FAX: (970) 328-2368

Region 03

PJL

As Constructed

No Revisions: 12/23/13

Revised:

Void:

TYPICAL SECTIONS

Designer: J. Klish

Detailer: J. Klish

Subset: TS

Structure

Numbers

Subset Sheets: 2 of 2

Project No./Code

C 131A-035

18861R

Sheet Number 4



GENERAL NOTES

For preliminary plan quantities of pavement materials, the following rates of application were used:

Tack Coat Diluted Emulsified Asphalt.....@ 0.1 Gals./Sq. Yd.(Diluted)  
Hot Mix Asphalt .....@ 110 Lbs./Sq. Yd./Inch  
Aggregate Base Course Class 6.....@ 133 Lbs./Cu. Ft.

Diluted emulsified asphalt for tack coat shall consist of 1 part emulsified asphalt and 1 part water.

Water shall be used as a dust palliative where required. Application shall be as directed by the Project Engineer. Water as a dust palliative and any other wetting shall be included in the work and will not be paid separately.

The following shall be furnished with each bituminous paver:

- 1. A ski type device at least 30 Feet in length.
- 2. Short ski or shoe.
- 3. 50 Feet of control line and stakes.

Water source required for moisture/density control shall be the Contractor's responsibility and shall be free of excessive sediments or other contaminants that may be detrimental to embankments, subbases, and base course materials.

Any layer of hot mix asphalt that is to have a succeeding layer placed thereon shall be completed full width before succeeding layer is placed. The top lift of Hot Mix Asphalt shall be treated as an overlay; it shall not be placed until all other work, including widening and reconstruction that require a lower layer of hot mix asphalt, has been completed.

Asphalt joints shall fall on lines, shoulders lines or median lines, except where stated in the plans.

All slopes shall be roughened as directed by the Engineer. Costs associated with this order shall be incidental to the work.

No vertical slopes shall be left overnight unprotected. All unprotected vertical slopes shall be flattened to a 4:1 side slope prior to the end of the work day, or as directed by the Engineer.

The Contractor shall not stockpile material, park vehicles, or place equipment within 30 Ft of the edge of the traveled way.

Prior to placing hot mix asphalt, the paved surface shall be swept and cleaned. This will not be paid for separately, but shall be included in the cost of the Hot Mix Asphalt Pavement item.

The Contractor shall coordinate the shouldering operation such that full compliance to the existing grades is obtained on a daily basis following the paving operation for the affected area unless otherwise approved by the Project Engineer.

Overlay of planed areas shall commence within 5 working days following the planing unless otherwise approved by the Project Engineer.

Where it is required to cut the existing asphalt, the cutting shall be done to a neat work line with a saw or as approved by the Engineer. Cut faces shall not remain overnight. This work will not be paid for separately, but shall be considered subsidiary to the work.

Moisture-density control will be required for the full depth of all embankments and 6 inches in base of cuts and fills on this project.

Excavation required for compaction of bases of cuts and fills will be considered as subsidiary to that operation and will not be paid for separately.

Structure Backfill Class 1 shall be used in the backfilling of pipes to 1 foot above the pipe.

It is estimated that the following items will be required on this project for miscellaneous work as directed by the Project Engineer:

- (201-00000) Clearing and Grubbing - 1 LS
- (203-01500) Blading - 10 Hours with a motor grader in the 130 to 160 flywheel horsepower range
- (203-01510) Backhoe - 20 Hours
- (203-01550) Dozing - 10 Hours
- (203-01597) Potholing - 20 Hours
- (203-01620) Sweeping - 40 Hours
- (203-02330) Laborer - 20 Hours
- (206-01781) Shoring (Area 1) - 1 LS
- (206-01782) Shoring (Area 2) - 1 LS
- (206-01783) Shoring (Area 3) - 1 LS
- (625-00000) Construction Surveying - 1 LS
- (625-00001) Construction Surveying (Hourly) - 25 Hours
- (626-01000) Public Information Services - 1 LS

The Field Office (Class 2) and Field Laboratory (Class 2) shall be provided with a high speed internet connection compatible with the CDOT internet system. This will be considered subsidiary to the pay items for Field Office (Class 2) and Field Laboratory (Class 2) and will be paid for by the Contractor. Trailers will be parked at the Wolcott Maintenance Yard at 26773 HWY 6, Wolcott Colorado 81655.

Clearing and Grubbing shall include removal and disposal of all trees, logs, limbs, brush, and trash, etc. to an offsite location.

Final striping will begin at a point that matches the adjacent striping location and spacing.

The Contractor shall be required to log type, size, color and location of existing lane markings for duplication prior to paving operations. All lane markings shall be laid out by the contractor on the new surface for final striping. This work will not be measured and paid for separately but will be included in the cost of pavement marking.

The Contractor shall be required to field verify lengths, diameters, elevations, locations, and thickness before ordering materials.

The Contractor shall be responsible to obtain any additional boring logs and/or soil information. Contractor should anticipate cobble or boulders while digging.

No Right-Of-Way acquisition will be needed for this project. All work will be completed entirely within the existing Right-Of-Way.

Right-Of-Way lines shall be staked at each culvert location. Fence (Plastic) shall be placed to delineate right-of-way.

The following clear zone criteria shall be used during this project: 30'.

For extension of existing pipes and/or CBC's, the Contractor shall field verify all sizes and flow line elevations prior to ordering materials. The Contractor or his Subcontractor shall immediately notify the Engineer whenever field conditions or existing terrain would result in a less than optimal installation of said items.

Sulfate Resistant Concrete for this project shall be Class 2.

Contractor shall work with landowners prior to modifying accesses.

This project is designated as Non-Significant.

Print Date: 3/1/2013		<div>0000</div>	Sheet Revisions			Colorado Department of Transportation <div> 714 Grand Ave Eagle, CO 81631 Phone: (970) 328-9962 FAX: (970) 328-2368 Region 03</div> <div>PJL</div>		As Constructed	GENERAL NOTES			Project No./Code	
File Name: 1886IDES_GeneralNotes_01.dgn			Date:	Comments	Init.			No Revisions: 12/23/13				C 131A-035	
Horiz. Scale: N/A			Vert. Scale:	N/A				Revised:	Designer:	J. Klish	Structure	1886R	
Unit Information: GJ Design			JSL					Void:	Detailer:	J. Klish	Numbers	Sheet Number 5	
								Subset:	GenNotes	Subset Sheets: 1	of 2		

k:\hij 2\4455 PJ c:\project\new\proj\_working\023333\1886IDES\_GeneralNotes\_01.dgn



GENERAL NOTES

Livestock may be pastured in various fields adjacent to the project during the construction of this project. In order to protect and control livestock, the Contractor shall install and maintain temporary fence of a type and at locations approved by the Engineer as needed during construction. The Contractor shall maintain the temporary fence in such condition that it is capable of performing its intended function until such time as the permanent fence is completed. This will not be paid for separately, but shall be included in the cost of the fencing items.

The Contractor shall pay special attention to the protection of water quality and stormwater pollution prevention as shown in subsection 107.25 of the Standard Specifications and Special Provisions.

Stormwater Management will require multiple seeding operations. These multiple operations shall be included in the cost of Seeding and Mulching.

The Contractor must plan on at least three mobilizations for final stabilization of the sites as per the Stormwater Management Plan. This will not be paid for separately but included in the work.

Aquatic Invasive Species

Equipment and gear that were previously used in another stream, river, lake, pond, or wetland, and which are to be used in or near waters on the project, shall be treated to prevent the spread of aquatic invasive species. These species include, but are not limited to:

- (1) New Zealand Mud Snails
- (2) Zebra Mussels
- (3) Quagga Mussels
- (4) Whirling Disease
- (5) All other aquatic invasive species

Equipment that shall be treated includes all parts of machinery and vehicles of all types and sizes that came into contact with the live water. Gear that must be treated include boots, waders, tools, and all other materials and attire used previously in live water.

The Contractor shall use one of the following two treatments:

- (1) Remove all mud and debris from equipment and gear. Then spray or soak the equipment and gear with a 1:15 solution of Sparquat institutional cleaner and water. Equipment and gear shall be kept moistened with the solution for at least 10 minutes.
- (2) Remove all mud and debris from equipment and gear. Then spray or soak equipment and gear with water heated to a temperature greater than 140°F for at least 10 minutes.

Prior to moving such equipment onto the project, the Contractor shall submit to the Engineer a written list of the equipment and a signed certification that it was treated using one of the two methods specified above.

After project completion, this equipment shall be treated prior to its use in another stream, river, lake, pond, or wetland.

Utility Notes

The contractor shall comply with article 1.5 of title 9, CRS ("Excavation Requirements") when excavating or grading is planned in the area of underground utility facilities. The Contractor shall notify all affected utilities at least two (2) business days, not including the actual day of notice, prior to commencing such operations. The Contractor shall contact the Utility Notification Center of Colorado (UNCC) at 811 or 1-800-922-1987, to have locations of UNCC registered lines marked by member companies. All other underground facilities shall be located by contacting the respective owner. For CDOT owned utility facilities the contractor shall call the CDOT Region 3 Traffic section at 970-683-6271 to request locates. CDOT is not contacted when locates are requested through the UNCC. Utility service laterals shall also be located prior to beginning excavation or grading.

The Contractor shall be responsible for contacting and coordinating with the appropriate utility representatives to be onsite during potholing and shall likewise be responsible for determining the type and location of underground utilities as maybe necessary to avoid damage thereto. The Contractor shall refer to the utility specification for additional requirements.

Existing utility lines as shown on the plan sheets are plotted from the best available information (ACSE Standard Quality Level B). The Contractor shall be responsible for verifying the location and depth of all existing utilities as necessary to insure the utilities will not be impacted by the construction activities. It is also the responsibility of the Contractor to call for utility locates.

The Contractor's attention is directed to Subsection 105.11 of the Standard Specifications and the Utility Project Special Provisions concerning utilities. The Contractor shall coordinate and cooperate with the utility owners in their removal, adjustment, and/or relocation operations so that the utility work can be accomplished without impacting the construction schedule.

Location and notification of both UNCC member and non member utilities is the Contractor's responsibility.

Project Utility Contacts

CENTURYLINK Fiber and Tele MP 36-38	ANNA KENNER	970-879-3661
		Cell: 970-819-0776
CENTURYLINK Fiber and Tele MP 3-5	BARB DAVIS	970-328-8288
VARIOUS MEMBER UTILITIES - (Utilities Notification Center of Colorado)		1-800-922-1987

Print Date: 3/1/2013		<div>0000</div>	Sheet Revisions			<div> 714 Grand Ave Eagle, CO 81631 Phone: (970) 328-9962 FAX: (970) 328-2368 Region 03</div> <div>PJL</div>		As Constructed		GENERAL NOTES			Project No./Code		
File Name: 1886IDES_GeneralNotes_02.dgn			Date:	Comments	Init.			No Revisions: 12/23/13					C 131A-035		
Horiz. Scale: N/A			Vert. Scale:	N/A						Revised:	Designer: J. Klish	Structure		1886R	
Unit Information: GJ Design			JSL							Void:	Detailer: J. Klish	Numbers		Sheet Number 6	
								Subset: GenNotes	Subset Sheets: 2	of 2					




klishj 11:26:13 AM c:\projectwise\pwz\_working\023335\18861DES\_SAQ1.dgn

INDEX REF #			CONTRACT ITEM NO.	CONTRACT ITEM	UNIT	ROADWAY															PROJECT TOTALS	
BOOK	PAGE	SHEET				PLAN	AS CONST.														PLAN	AS CONST.
	00	05	201-00000	Clearing and Grubbing	L S	1	1														1	
	00	10	202-00001	Removal of Structure	EACH	1	1														1	
	00	15	202-00035	Removal of Pipe	LF	72	72														72	72
	00	20	202-00090	Removal of Delineator	EACH	10	10														10	10
	00	25	202-00220	Removal of Asphalt Mat	SY	107	119														107	119
	00	30	202-00240	Removal of Asphalt Mat (Planing)	SY	1,027	1196														1,027	1196
	00	35	202-00500	Removal of Portions of Present Structure	EACH	8	8														8	8
	00	40	202-01000	Removal of Fence	LF	550	52														550	52
	00	45	203-00060	Embankment Material (Complete In Place)	CY	1,982	1982														1,982	1982
	00	50	203-00100	Muck Excavation	CY	100	28														100	28
	00	55	203-01500	Blading	HOUR	10	2														10	2
	00	60	203-01510	Backhoe	HOUR	20	57														20	57
	00	65	203-01550	Dozing	HOUR	10	0														10	0
	00	70	203-01597	Potholing	HOUR	20	6														20	6
	00	75	203-01620	Sweeping	HOUR	40	22														40	22
	00	80	203-02330	Laborer	HOUR	20	79														20	79
	00	85	206-00000	Structure Excavation	CY	415	415														415	415
	00	90	206-00065	Structure Backfill (Flow-Fill)	CY	46	59														46	59
	00	95	206-00100	Structure Backfill (Class 1)	CY	116	299														116	299
	01	00	206-01781	Shoring (Area 1)	L S	1	1														1	1
	01	05	206-01782	Shoring (Area 2)	L S	1	1														1	1
	01	10	206-01783	Shoring (Area 3)	L S	1	1														1	1
	01	15	207-00305	Wetland Topsoil	CY	56	63														56	63
	01	20	207-00310	Stockpile Wetland Topsoil	CY	56	63														56	63
	01	25	208-00002	Erosion Log (12 Inch)	LF	2,360	2030														2,360	2030
	01	30	208-00045	Concrete Washout Structure	EACH	6	4														6	4
	01	35	208-00070	Vehicle Tracking Pad	EACH	6	1														6	1
	01	40	208-00103	Removal and Disposal of Sediment (Labor)	HOUR	30	0														30	0
	01	45	208-00105	Removal and Disposal of Sediment (Equipment)	HOUR	30	0														30	0
	01	50	209-00600	Dust Palliative (Magnesium Chloride)	GAL	500	0														500	0
	01	55	212-00006	Seeding (Native)	ACRE	2	2														2	2
	01	60	212-00032	Soil Conditioning	ACRE	2	2														2	2
	01	65	213-00003	Mulching (Weed Free)	ACRE	0.6	1.8														0.6	1.8

Print Date: 4/23/2013
File Name: 18861DES_SAQ1.dgn
Horiz. Scale: N/A      Vert. Scale: N/A
Unit Information: GJ Design      JSL

0000

Sheet Revisions		
Date:	Comments	Init.



Colorado Department of Transportation

Region 03

714 Grand Ave.  
Eagle, CO 81631  
Phone: (970) 328-9962 FAX: (970) 328-2368

PJL

As Constructed		SUMMARY OF APPROXIMATE QUANITIES			Project No./Code	
No Revisions: 12/23/13		Designer: J. Klish	Structure Numbers		C 131A-035	
Revised:		Detailer: C. Morgan			18861R	
Void:		Subset: SAQ	Subset Sheets: 1 of 3		Sheet Number 7	

klishj 11:26:17 AM c:\projectwise\pwz\_working\0233335\18861DES\_SAQ2.dgn

INDEX			CONTRACT ITEM NO.	CONTRACT ITEM	UNIT	ROADWAY															PROJECT TOTALS	
BOOK	PAGE	SHEET				PLAN	AS CONST.														PLAN	AS CONST.
	01	70	213-00061	Mulch Tackifier	LB	120	188														120	188
	01	75	216-00015	Soil Retention Blanket (Excelsior)	SY	6,776	1164														6,776	1164
	01	80	240-00000	Wildlife Biologist	HOUR	40	29														40	29
	01	85	304-03005	Aggregate Base Course (Class 3)	CY	85	37														85	37
	01	90	304-06007	Aggregate Base Course (Class 6)	CY	534	352														534	352
	01	95	403-34721	Hot Mix Asphalt (Grading SX) (75) (PG 58-28)	TON	283	280.32														283	280.32
	02	00	411-10255	Emulsified Asphalt (Slow-Setting)	GAL	86	50														86	50
	02	05	420-00133	Geotextile (Separator) (Class 2)	SY	356	130														356	130
	02	10	506-00212	Riprap (12 Inch)	CY	4	16														4	16
	02	15	601-01050	Concrete Class B (Wall)	CY	90	117.6														90	117.6
	02	20	601-06300	Cement Grout	CF	250	152.1														250	152.1
	02	25	602-00000	Reinforcing Steel	LB	6,354	7115														6,354	7115
	02	30	603-00001	Annular Space Grouting	CY	62	65.4														62	65.4
	02	35	603-00042	Culvert Lining (42 Inch)	LF	56	56														56	56
	02	40	603-00054	Culvert Lining (54 Inch)	LF	192	192														192	192
	02	45	603-00073	Culvert Lining (72 Inch)(Special)	LF	100	100														100	100
	02	50	607-01000	Fence Barbed Wire with Metal Posts	LF	450	57														450	57
	02	55	607-11525	Fence (Plastic)	LF	3,020	1986														3,020	1986
	02	60	612-00003	Delineator (Type III)	EACH	10	10														10	10
	04	05	620-00002	Field Office (Class 2)	EACH	1	1														1	1
	04	10	620-00012	Field Laboratory (Class 2)	EACH	1	0														1	0
	04	15	620-00020	Sanitary Facility	EACH	1	1														1	1
	02	65	624-24061	60 Inch Drainage Pipe (Class 4) (Complete In Place)	LF	25	25														25	25
			624-29061	60 Inch Drainage Pipe (Class 9) (Complete In Place)	LF	74	75														74	75
	02	75	625-00000	Construction Surveying	L S	1	1														1	1
	02	80	625-00001	Construction Surveying (Hourly)	HOUR	25	0														25	0
	02	85	626-00000	Mobilization	L S	1	1														1	1
	02	90	626-01000	Public Information Services	L S	1	1														1	1
	02	95	627-00005	Epoxy Pavement Marking	GAL	18	3														18	3
	03	00	630-00000	Flagging	HOUR	1,560	1527														1,560	1527
	03	05	630-00007	Traffic Control Inspection	DAY	40	33														40	33
	03	10	630-00012	Traffic Control Management	DAY	65	87														65	87

Print Date: 4/23/2013		<div>0000</div>	Sheet Revisions			Colorado Department of Transportation		As Constructed		SUMMARY OF APPROXIMATE QUANTITIES			Project No./Code	
File Name: 18861DES_SAQ2.dgn			Date:	Comments	Init.	<div> 714 Grand Ave Eagle, CO 81631 Phone: (970) 328-9962 FAX: (970) 328-2368 Region 03</div> <div>PJL</div>	No Revisions: 12/23/13				C 131A-035			
Horiz. Scale: N/A	Vert. Scale: N/A						Revised:	Designer: J. Klish	Structure Numbers	18861R				
Unit Information: GJ Design								Detailer: C. Morgan						
								Void:	Subset: SAQ	Subset Sheets: 2 of 3	Sheet Number 8			



klishj 11:26:22 AM c:\projectwise\pwz\_working\0233335\1886IDES\_SAQ3.dgn

INDEX			CONTRACT ITEM NO.	CONTRACT ITEM	UNIT	ROADWAY															PROJECT TOTALS	
BOOK	PAGE	SHEET				PLAN	AS CONST.														PLAN	AS CONST.
	03	15	630-80336	Barricade (Type 3 M-B) (Temporary)	EACH	4	1														4	1
	03	20	630-80341	Construction Traffic Sign (Panel Size A)	EACH	26	3														26	3
	03	25	630-80342	Construction Traffic Sign (Panel Size B)	EACH	60	46														60	46
	03	30	630-80344	Construction Traffic Sign (Special)	SF	25	0														25	0
	03	35	630-80355	Portable Message Sign Panel	EACH	2	2														2	2
	03	40	630-80360	Drum Channelizing Device	EACH	50	28														50	28
	03	45	630-80363	Drum Channelizing Device (With Light) (Flashing)	EACH	20	4														20	4
	03	50	630-80364	Drum Channelizing Device (With Light) (Steady	EACH	20	2														20	2
	03	55	630-80367	Burn)																		
	03	60	630-80370	Portable Traffic Speed Monitor	EACH	1	1														1	1
	03	60	630-80370	Concrete Barrier (Temporary)	LF	300	300														300	300
	03	65	630-80380	Traffic Cone	EACH	300	63														300	63
	03	70	630-85010	Impact Attenuator (Temporary)	EACH	2	2														2	2
	03	75	630-86800	Traffic Signal (Temporary)	L S	1	1														1	1
	03	80	700-70010	FORCE ACCOUNT =====	F A	1	0														1	0
	03	80	700-70010	F/A Minor Contract Revisions																		
	03	85	700-70011	F/A Partnering	F A	1	2,000														1	2,000
	03	90	700-70016	F/A Fuel Cost Adjustment	F A	1	0														1	0
	30	95	700-70019	F/A Asphalt Cement Cost Adjustment	F A	1	1,638.26														1	1,638.26
	04	00	700-70130	F/A Repair	F A	1	0														1	0
	05	00	900-00006	CMO Added Pumping Costs	006		26,634.57															26,634.57

Print Date: 4/23/2013		0000	Sheet Revisions			Colorado Department of Transportation		As Constructed		SUMMARY OF APPROXIMATE QUANTITIES				Project No./Code	
File Name: 1886IDES_SAQ3.dgn			Date:	Comments	Init.			No Revisions: 12/23/13						C 131A-035	
Horiz. Scale: N/A      Vert. Scale: N/A						Revised:		Designer: J. Klish		Structure Numbers		18861R			
Unit Information: GJ Design      JSL						Void:		Detailer: C. Morgan		Subset: SAQ		Subset Sheets: 3 of 3      Sheet Number 9			



714 Grand Ave.  
Eagle, CO 81631  
Phone: (970) 328-9962 FAX: (970) 328-2368

Region 03      PJL


klishj 4:10:04 PM c:\projectwise\pwz\_working\00233335\1886IDES\_Tab\_EMBANKMENT.dgn

SUMMARY OF EARTHWORK QUANTITIES

INDEX			PROJECT TOTAL	
Book	Page	Sheet		
			<b>STRUCTURE EXCAVATION (206-00000)</b>	
			ROADWAY & STRUCTURE: MP 3.09	CU. YD. 252 <i>As Const</i> 252
			WINGWALLS & HEADWALLS: MP 5.13	13 13
			MP 36.42	30 30
			MP 37.08	30 30
			MP 37.11	30 30
			MP 37.34	30 30
			MP 37.70	30 30
			TOTAL FOR PAY QUANTITIES	415 415
			<b>MUCK EXCAVATION (203-00100)</b>	
			QUANTITY APPROXIMATED:	CU. YD. 100 <i>As Const</i> 28
			TOTAL	100 28
			<b>WETTING (FOR INFORMATION ONLY)</b>	
			SURFACING (0.022 M GAL/TON)	M GAL. 38.1
			EMBANKMENT (CIP) (0.04 M GAL / CY)	79.28
			TOTAL	117.38
			<b>EMBANKMENT MATERIAL (CIP) (203-00060)</b>	
			QUANTITY CALCULATED FROM INROADS: MP 3.09	CU. YD. 336 <i>As Const</i> 336
			MP 5.13	0 0
			MP 36.42	235 235
			MP 37.08	0 0
			MP 37.11	469 469
			MP 37.34	285 285
			MP 37.70	380 380
			CARRIED FROM WETLAND QUANTITIES	277 277
			TOTAL FOR PAY QUANTITIES	1982 1982

INDEX			ROADWAY QUANTITIES BALANCE (FOR INFORMATION ONLY)		PROJECT TOTAL	
Book	Page	Sheet			CU. YD.	<i>As Const</i>
			Total Structure Excavation		415	415
			Total Embankment (net)		1982	1982
			EMBANKMENT TIMES FACTOR 1.15		2279	2279
			Import Embankment (Material to be Imported by Contractor)		1864	1864

NOTES:  
TOP 4 INCHES OF ALL EMBANKMENT SHALL BE FREE OF DEBRIS AND ROCKS OR CLODS GREATER THAN 3 INCHES IN DIAMETER, AND SHALL BE SUITABLE AS NATIVE TOPSOIL.  
ALL IMPORTED EMBANKMENT MATERIAL SHALL MEET A MINIMUM OF R-VALUE = 40.  
MUCK EXCAVATION SHALL BE AS DIRECTED BY THE PROJECT ENGINEER.

Print Date: 4/22/2013	0000	Sheet Revisions			Colorado Department of Transportation		As Constructed		SUMMARY OF EARTHWORK QUANTITIES		Project No./Code
File Name: 1886IDES_Tab_EMBANKMENT.dgn		Date:	Comments	Init.		714 Grand Ave. Eagle, CO 81631 Phone: (970) 328-9962 FAX: (970) 328-2368	No Revisions: 12/23/13		Designer: J. Klish	Structure	C 131A-035
Horiz. Scale: N/A Vert. Scale: N/A							Revised:		Detailer: J. Klish	Numbers	18861R
Unit Information: GJ Design JSL							Void:		Subset: EARTH	Subset Sheets: 1 of 1	Sheet Number 10
					Region 03	PJL					

## SURFACING TABULATION

STATION	LAYER	(304-06007) AGGREGATE BASE COURSE (CLASS 6) ◀	(403-34721) * HOT MIX ASPHALT (GRADING SX) (75) (PG 58-28) ◀	(411-10255) EMULSIFIED ASPHALT (SLOW-SETTING) ◀	(202-00220) REMOVAL OF ASPHALT MAT	(202-00240) REMOVAL OF ASPHALT MAT (PLANING)**	(209-00600) DUST PALLIATIVE (MAGNESIUM CHLORIDE)						
		CY		TON		GALLON		SY				GALLON	
		Plan	As Const	Plan	As Const	Plan	As Const	Plan	As Const	Plan	As Const	Plan	As Const
MP 3.00													
116+25.00 TO 118+00.00	TOP		77	77	35				467	549			
116+25.00 TO 118+00.00	BOTTOM	184	91.3	28	28								
118+00.00 TO 118+40.00	TOP		18	18	8	107	119				500	0	
118+00.00 TO 118+40.00	BOTTOM	101	56.4	18	18								
118+40.00 TO 120+50.00	TOP		93	93	42				560	647			
118+40.00 TO 120+50.00	BOTTOM	221		34	34								
Milk Creek Road													
117+15.00 to 117+40.00	FULL	14	6.7	3	0	1							
5% IRREGULARITIES		14		12	12								
PROJECT TOTAL		534	352*	283	280.32	86	50	107	119	1027	1196	500	0

\*\* REMOVAL OF ASPHALT MAT (PLANING) SHALL BE 2" DEEP.

\*304-06007 - 24 CV Added at MP 37.08

## TABULATION OF CULVERTS

Location	For Info Only	202-00001		202-00500		202-00035		206-00065		206-00100		304-03005		601-06300		603-00001		603-00042		603-00054		603-00073		624-24061		624-29061	
	Existing Pipe	Removal of Structure		Removal of Portions of Present Structure		Removal of Pipe		Structure Backfill (Flow-fill)		Structure Backfill (Class 1)		Aggregate Base Course (Class 3)		Cement Grout		Annular Space Grouting		Culvert Lining (42 Inch)		Culvert Lining (54 Inch)		Culvert Lining (72 Inch) (Special)		60 Inch Drainage Pipe (Class 4) (CIP)		60 Inch Drainage Pipe (Class 9) (CIP)	
	LF	EACH		EACH		LF		CY		CY		CY		CF		CY		LF		LF		LF		LF		LF	
	Plan	Plan	As Const	Plan	As Const	Plan	As Const	Plan	As Const	Plan	As Const	Plan	As Const	Plan	As Const	Plan	As Const	Plan	As Const	Plan	As Const	Plan	As Const	Plan	As Const	Plan	As Const
MP 3.09 Culvert STA. 118+20	72					72	72	46	46																	74	75
MP 5.13 Culvert STA. 224+00	100								13	30	65																
MP 36.42 Culvert STA. 343+25	41			2	2					15	42			50	13	10	11.20	56	56								
MP 37.08 Side STA. 372+42 LT	25	1	1							17	35													25	25		
MP 37.11 Culvert STA. 375+72	53			2	2					15	60.4			50	34	18	18.18			69	69						
MP 37.34 Culvert STA. 388+21	49			2	2					14	42.6			50	30	17	18.92			61	61						
MP 37.70 Culvert STA. 401+82	48			2	2					15	54.0			50	22	17	18.14			62	62						
To replace muck excavation														85	37												
PROJECT TOTAL		1	1	8	8	72	72	46	59	116	299	85	37	250	1521	62	68.4	56	56	192	192	100	100	25	25	74	75

**NOTES:**

1. The Contractor shall be responsible for diverting water, dewatering, and cleaning culverts during construction. This work will not be paid for separately, but included in the cost of the work.
2. Concrete from both Removal of Structure and Removal of Portions of Present Structure may be disposed of per Specification 203 in areas approved by the Project Engineer.
3. Structure Backfill (Class 1) shall be placed around headwalls and wingwalls.

Print Date: 4/24/2013		0000	Sheet Revisions			Colorado Department of Transportation		As Constructed		TABULATIONS OF SURFACING AND CULVERTS			Project No./Code	
File Name: 18861DES_Tab01.dgn			Date:	Comments	Init.	 714 Grand Ave. Eagle, CO 81631 Phone: (970) 328-9962 FAX: (970) 328-2368 Region 03	No Revisions:		Designer: J. Klisch Detailer: J. Klisch			C 131A-035		
Horiz. Scale: N/A      Vert. Scale: N/A							Revised: 12/23/13					Structure Numbers		
Unit Information: GJ Design      JSL							Void:		Subset: TAB      Subset Sheets: 1 of 4		18861R			
											Sheet Number 11			

c:\projectwise\pwz\_working\d02333335\1886IDES\_Tab01.dgn



klishj 2:46:06 PM c:\projectwise\pwrz\_working\00233335\1886IDES\_Tab02.dgn

TABULATION OF CONCRETE

Location		SIDE	601-01050		602-00000	
			CONCRETE CLASS B (WALL)		REINFORCING STEEL	
			CY		LB	
			Plan	As Const	Plan	As Const
MP 3.09						
MP 3.09 Headwalls	LT	2.5	2.53	248	253.6	
	RT	2.8	2.82	269	282.8	
MP 3.09 Wingwalls	LT	3.3	7.83	134	272.8	
	RT	5.6	11.75	256	426.4	
MP 3.09 Toewalls	LT	1.6	1.38	112	95.9	
	RT	1.9	1.96	133	136.0	
MP 3.09 Sub-Total =			17.7	28.28	1152	1467.5
MP 5.13						
MP 5.13 Headwall	RT	4.4	4.4	293	293	
MP 5.13 Sub-Total =			4.4	4.4	293	293
MP 36.42						
MP 36.42 Headwalls	LT	2.3	2.34	232	234.1	
	RT	2.2	2.24	231	223.5	
MP 36.42 Wingwalls	LT	2.0	4.02	82	162.6	
	RT	2.0	4.02	80	162.6	
MP 36.42 Apron	LT	0.5	0.84	74	40.4	
	RT	0.5	0.84	74	40.4	
MP 36.42 Toewalls	LT	1.1	1.01	74	69.7	
	RT	1.1	1.01	74	69.7	
MP 36.42 Sub-Total =			11.7	16.32	921	1003
MP 37.08						
MP 37.08 Headwalls	SOUTH	2.4	2.28	236	227.5	
	NORTH	2.4	2.28	236	227.5	
MP 37.08 Wingwalls	SOUTH	2.3	4.66	94	190	
	NORTH	2.3	4.66	94	190	
MP 37.08 Apron	LT	0.8	1.14	94	55	
	RT	0.8	1.14	94	55	
MP 37.08 Toewalls	LT	1.1	1.14	77	79	
	RT	1.1	1.14	77	79	
MP 37.08 Sub-Total =			13.2	18.44	1002	1103.1
SET #1 SUBTOTAL =			47.0	67.44	3368	3866.6

Location		SIDE	601-01050		602-00000	
			CONCRETE CLASS B (WALL)		REINFORCING STEEL	
			CY		LB	
			Plan	As Const	Plan	As Const
MP 37.11						
MP 37.11 Headwalls	LT	2.5	2.45	220	245.4	
	RT	2.5	2.55	227	254.6	
MP 37.11 Wingwalls	LT	2.0	4.01	82	162.5	
	RT	2.1	4.33	83	176.2	
MP 37.11 Apron	LT	1.4	0.95	113	45.8	
	RT	1.4	0.95	113	45.8	
MP 37.11 Toewalls	LT	1.1	1.05	77	73.1	
	RT	1.1	1.05	77	73.1	
MP 37.11 Sub-Total =			14.1	17.34	992	1076.5
MP 37.34						
MP 37.34 Headwalls	LT	2.3	2.34	212	233.6	
	RT	2.3	2.30	209	229.7	
MP 37.34 Wingwalls	LT	2.0	4.01	80	162.5	
	RT	2.0	4.01	79	162.5	
MP 37.34 Apron	LT	1.4	0.95	113	45.8	
	RT	1.4	0.95	113	45.8	
MP 37.34 Toewalls	LT	1.1	1.05	77	73.1	
	RT	1.1	1.05	77	73.1	
MP 37.34 Sub-Total =			13.6	16.66	960	102.61
MP 37.70						
MP 37.70 Headwalls	LT	2.8	2.82	247	282.1	
	RT	2.5	2.49	223	249.4	
MP 37.70 Wingwalls	LT	2.5	5.00	102	203.3	
	RT	2.0	4.01	82	162.5	
MP 37.70 Apron	LT	1.4	1.12	113	53.7	
	RT	1.4	0.95	113	45.8	
MP 37.70 Toewalls	LT	1.1	1.12	77	77.9	
	RT	1.1	1.05	77	73.1	
MP 37.70 Sub-Total =			14.8	18.56	1034	1147.8
SET #2 SUBTOTAL =			42.5	52.56	2986	3250.4
SET #1 SUBTOTAL =			47.0	67.44	3368	3866.6
PROJECT TOTAL			90	117.6	6354	7115

Print Date: 3/1/2013		<div>0000</div>			Sheet Revisions			<div> Colorado Department of Transportation 713 Grand Ave. Eagle, CO 81631 Phone: (970) 328-9962 FAX: (970) 328-2368 Region 03 P.J.L.</div>			As Constructed		TABULATION OF CONCRETE			Project No./Code					
File Name: 1886IDES_Tab02.dgn					Date:	Comments	Init.				No Revisions:					C 131A-035					
Horiz. Scale: 1:1					Vert. Scale:	N/A										Revised: 12/23/13	Designer: J. Klish	Structure		18861 <sup>R</sup>	
Unit Information: GJ Design					JSL											Void:	Detailer: J. Klish	Numbers		Sheet Number 12	
																	Subset: TAB	Subset Sheets: 2	of 4		

kishj 2:46:16 PM c:\projectwise\pwz\_working\0233335\1886DES\_Tab03.dgn

TABULATION OF RIPRAP

Location	SIDE	506-00212	
		Riprap (12 Inch)	
		Plan	As Const
MP 3.09 Culvert @ STA. 118+20	RT	2	16
MP 5.13 Culvert @ STA. 224+90	RT	2	0
PROJECT TOTAL		4	16

TABULATION OF DELINEATORS

STATION	DETAIL	SIDE	(202-00090) REMOVAL OF DELINEATOR		(612-00003) DELINEATOR (TYPE III)	
			EACH		EACH	
			Plan	As Const	Plan	As Const
118+20	TRIPLE YELLOW	BOTH	2	2	2	2
343+25	TRIPLE YELLOW	BOTH	2	2	2	2
375+75	TRIPLE YELLOW	BOTH	2	2	2	2
388+21	TRIPLE YELLOW	BOTH	2	2	2	2
401+70	TRIPLE YELLOW	LEFT	1	1	1	1
401+95	TRIPLE YELLOW	RIGHT	1	1	1	1
PROJECT TOTAL			10	10	10	10

TABULATION OF EPOXY PAVEMENT MARKING

STATION	SIDE	(627-00005) EPOXY PAVEMENT MARKING			
		CENTER	CENTER	CENTER	EDGE
		YELLOW SINGLE BROKEN	YELLOW DOUBLE LEFT BROKEN	YELLOW DOUBLE RIGHT BROKEN	WHITE SINGLE SOLID
MP 3.09		4 INCH	4 INCH	4 INCH	4 INCH
115+25.00 TO 120+28.90	CENTER	503.90			
120+28.90 TO 121+50.00	CENTER		121.1		
115+25.00 TO 121+50.00	RT				625.00
117+15.50 TO 121+50.00	LT				434.50
MP 36.42					
341+79.00 TO 344+75.00	CENTER	296.00			
341+79.00 TO 344+75.00	RT				296.00
341+79.00 TO 344+75.00	LT				296.00
MP 37.11					
374+21.00 TO 377+51.00	CENTER		330.00		
374+21.00 TO 377+51.00	RT				330.00
374+21.00 TO 377+51.00	LT				330.00
MP 37.34					
386+72.00 TO 389+74.00	CENTER			302.00	
386+72.00 TO 389+74.00	RT				302.00
386+72.00 TO 389+74.00	LT				302.00
MP 37.70					
400+29.00 TO 403+32.00	CENTER	303.00			
400+29.00 TO 403+32.00	RT				303.00
400+29.00 TO 403+32.00	LT				303.00
TOTAL (LF)		1102.90	451.10	302.00	3521.50
TOTAL (SF)		92	188	126	1174
TOTAL (GAL)		1.2	2.2	1.6	13
		PROJECT TOTAL (GAL)			
		PLAN		AS CONSTRUCTED	
		WHITE	YELLOW	WHITE	YELLOW
		13	5	2.53	0.47
		18.0		3.0	


TABULATION OF FENCE

STATION	SIDE	202-01000		607-01000	
		REMOVAL OF FENCE		FENCE BARBED WIRE WITH METAL POSTS	
		LF		LF	
		Plan	As Const	Plan	As Const
MP 5.13 Culvert					
224+00 to 226+00	LT	225	0	225	0
224+25 to 225+50	LT*	100	0		
224+00 to 226+00	RT	225	52	225	57
PROJECT TOTAL		550	52	450	57

\* REMOVAL OF FENCE POST IS PAID AS 10 LF EACH.

Print Date: 3/1/2013  
File Name: 18861DES\_Tab03.dgn  
Horiz. Scale: N/A      Vert. Scale: N/A  
Unit Information: GJ Design      JSL

Sheet Revisions		
Date:	Comments	Init.



Colorado Department of Transportation  
714 Grand Ave.  
Eagle, CO 81631  
Phone: (970) 328-9962 FAX: (970) 328-2368  
Region 03

PJL

As Constructed		TABULATIONS OF RIPRAP, PAINT, DELINEATORS, & FENCE		Project No./Code
No Revisions: 12/23/13				C 131A-035
Revised:		Designer: J. Klish	Structure Numbers	18861R
Void:		Detailer: J. Klish		
		Subset: TAB	Subset Sheets: 3 of 4	Sheet Number 13



klishj 2:46:26 PM c:\projectwise\pwrz\_working\002333335\1886IDES\_Tab04.dgn

TABULATIONS OF WETLAND QUANTITIES


LOCATION:		(FOR INFO ONLY)		203-00060		207-00305		207-00310		420-00133	
		Temporary Wetland Impacts	Permanent Wetland Impacts	Embankment (CIP)		Wetland Topsoil		Stockpile Wetland Topsoil		Geotextile (Separator) (Class 2)	
		SF		CY		CY		CY		SY	
				Plan	As Const.	Plan	As Const.	Plan	As Const.	Plan	As Const.
MP 3.09 @	LT	0	0	0		0	0	0	0	0	0
STA. 118+20	RT	0	0	0		0	0	0	0	0	0
MP 3.09 SUBTOTAL =		0	0	0		0	0	0	0	0	0
MP 5.13 @	LT	0	0	0		0	0	0	0	0	0
STA. 224+90	RT	21	0	2	2	0	0	0	0	5	0
MP 5.13 SUBTOTAL =		21	0	2	2	0	0	0	0	5	0
MP 36.42 @	LT	490	106	37	37	8	8	8	8	110	0
STA. 343+25	RT	534	75	40	40	6	6	6	6	119	0
MP 36.42 SUBTOTAL =		1024	181	77	77	14	14	14	14	119	0
MP 37.08 @	NORTH	466	40	35	35	3	3	3	3	104	0
STA. 372+42	SOUTH	595	44	45	45	4	4	4	4	133	0
MP 37.08 SUBTOTAL =		1061	84	80	80	7	7	7	7	133	0
MP 37.11 @	LT	880	50	66	66	4	8	4	8	196	96
STA. 375+72	RT	83	131	7	7	10	10	10	10	19	0
MP 37.11 SUBTOTAL =		963	181	73	73	14	18	14	18	19	96
MP 37.34 @	LT	123	28	10	10	3	3	3	3	28	0
STA. 388+21	RT	255	96	19	19	8	11	8	11	57	17
MP 37.34 SUBTOTAL =		378	124	29	29	11	14	11	14	57	17
MP 37.70 @	LT	99	49	8	8	4	4	4	4	23	17
STA. 401+82	RT	100	74	8	8	6	6	6	6	23	0
MP 37.70 SUBTOTAL =		199	123	16	16	10	10	10	10	23	17
PROJECT TOTAL =		3646	693	* 277	277	56	63	56	63	356	130

\* THIS EMBANKMENT (CIP) QUANTITY HAS BEEN CARRIED OVER TO THE SUMMARY OF EARTHWORK QUANTITIES SHEET.

NOTE FOR TEMPORARY WETLAND VEGETATION PROTECTION, PRIOR TO CONSTRUCTION:

All areas identified as "Temporary Wetland Impacts" shall be trimmed to 4"-6" from existing ground and be protected with a layer of Geotextile, followed by a 12-inch layer of loose, certified weed-free straw, another layer of Geotextile, and a minimum 24-inch layer of soil/embankment (See Temporary Wetland Vegetation Protection Detail). This installation work shall be paid for as Embankment (CIP) and Geotextile (Separator)(Class 2). The loose, certified weed-free straw and vegetation trimming shall not be paid for separately but be included in the cost of Geotextile (Separator)(Class 2). After construction all soil, straw, and geotextile shall be removed using a toothless backhoe. The removal of Temporary Wetland Vegetation Protection shall be included in the cost of the work.

TEMPORARY WETLAND VEGETATION PROTECTION

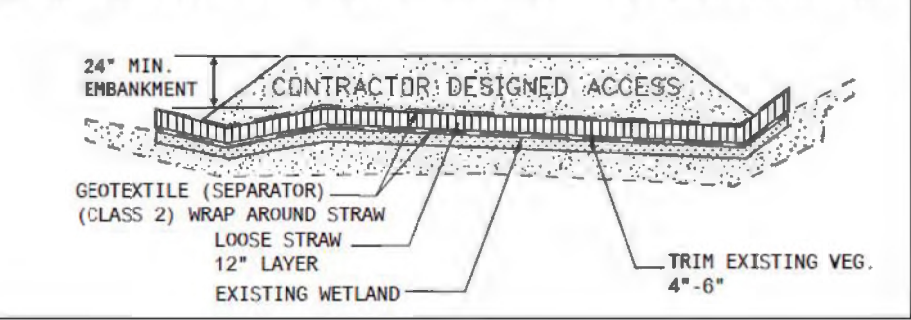

Print Date: 3/1/2013

File Name: 1886IDES\_Tab04.dgn

Horiz. Scale: N/A Vert. Scale: N/A

Unit Information: GJ Design JSL

Sheet Revisions		
Date:	Comments	Init.

Colorado Department of Transportation



714 Grand Ave.  
Eagle, CO 81631  
Phone: (970) 328-9962 FAX: (970) 328-2368

Region 03

PJL

As Constructed

No Revisions: 12/23/13

Revised:

Void:

TABULATIONS OF WETLAND QUANTITIES & TEMPORARY WETLAND VEGETATION PROTECTION DETAIL

Designer:	J. Klish	Structure	
Detailer:	J. Klish	Numbers	
Subset:	TAB	Subset Sheets: 4 of 4	

Project No./Code

C 131A-035

18861R

Sheet Number 14



klishj 2:46:37 PM c:\projectwise\pwz\_working\0233335\18861SURV\_Tab.dgn

TO ESTABLISH GEOMETRIC CONTROL FOR THE CONSTRUCTION OF THIS PROJECT, THE DEPARTMENT HAS PROVIDED THE FOLLOWING INFORMATION:

Format \*

Horizontal Control

Vertical Control

Roadway Alignment

Original Terrain Data

Other:

Plan Sheets: Electronic Data

Plan Sheets: Electronic Data

Plan Sheets: Electronic Data

Plan Sheets: Electronic Data

Specify the information format, ie., plan sheet, computer disk, computer printout, or other. The information marked is either contained on the plans or is available from the Engineer.

Landscaping

Signalization

Safety Improvement

Asphalt Overlay

Concrete Overlay

Minor Widening

Major Reconstruction

New Roadway Construction

Bridge Replacement

Bridge Widening

New Bridge

Other: Culvert Replacement

SURVEY WORK TO BE PERFORMED BY OTHERS: New Culvert Locations

Establish and Maintain Project Centerline or Engineer Approved Offset Line(s)

Verification and Maintenance of Horizontal and Vertical Control

Verify or Determine existing grades and alignments

Verify or Determine existing topography

Clearing and Grubbing Limits (Section 201)

Removal Limits (Section 202)

Reset Items (Section 210)

Excavation and Embankment (Section 203)

Excavation

Unclassified

Stripping

Muck

Rock

Borrow

Other: Structure

Potholing

Embankment

Site Grading

Erosion Control (Perm)

Other:

As Staked Earthwork Quantities (See General Notes)

Landscaping

Top Soil (Section 207)

Seeding (Section 212)

Mulching (Section 213)

Planting (Section 214)

Herbicide (Section 217)

Other:

Erosion Control (Section 208)

Seeding (Temp)

Silt Fence

Erosion Bales

Erosion Logs

Riprap (Temp)

Other:

Roadway Bases

Untreated Subgrade

Treated Subgrade

Aggregate Base Course (Section 304)

Reconditioning

PMBB - Plant Mix Bituminous Base

Other:

Pavements

HMA - Hot Mix Asphalt (Section 403)

Concrete (Section 412)

Heating & Scarifying Treatment

Prime Coat, Tack Coat & Rejuvenating Agent (Section 407)

Seal Coat or Chip Seal (Section 409)

Other:

Roadway Elements

Curb and Gutter (Section 609)

Drop inlets - alignment and grades (Section 604)

Retaining Walls

Guard Rail (Section 606)

Sidewalk (Section 608)

Overlay Stationing

Other:

Riprap (Perm) (Section 506)

Slope and Ditch Paving (Section 507)

Minor Structures

Structure Excavation limits (Section 206)

Culverts (Section 603)

Culverts w/ Headwalls and Wingwalls (Section 601)

Concrete Box Culverts w/ Headwalls and Wingwalls

Pipes (Section 603)

Sanitary Sewer

Storm Sewer

Water

Irrigation

Miscellaneous

Manholes (Section 604)

Inlets (Section 604)

Other:

Major Structures - Overhead Signs (Section 614), Concrete Box Culverts, Bridges - and all other structures assigned a structure number

Structure Excavation limits (Section 206)

Concrete Box Culverts (Section 603) w/ Headwalls and Wingwalls (Section 601)

Piling locations and cut off elevations (Section 502)

Caisson locations and elevations (Section 503)

Footing locations, alignment, and elevations

Abutment/Pier locations, alignment, and elevations

Wingwall skew angles/offsets

Structural concrete form locations

Substructure As-constructed survey required for Bridges (Subsection 601 .12) and Overhead signs (S-614-50)

Bridge expansion joint(s) alignment and grade (longitudinal and transverse)

Deck grades at Girder 10th or "n" th point locations and elevations

Slope and Ditch Paving (Section 507)

Other:

Fencing (Section 607)

Temporary

Permanent

Sound Barrier

Other:

Delineators (Section 612)

Temporary

Permanent

Lighting (Section 613) and Traffic Control Devices (Permanent) (Section 614)

Signal pole locations and elevations

Light pole locations and elevations

Sign locations

Field verify sign post locations, elevations, and lengths before fabrication.

Other:

Pavements

Grid (Y/N)

Special Interval

Special Offset

-

-

Curb & Gutter

Tangent Interval

Curve Interval

Special Offset

-

-

-

Stationing

Left Interval

Center Interval

Right Interval

-

-

-

Pavement Marking (Section 627)

Striping (Temp)

Striping (Perm)

Symbols

Other:

Temporary Lighting and Construction Traffic Control Devices (Section 630)

Signal pole locations and elevations (Temp)

Light pole locations and elevations (Temp)

Sign Locations (Temp)

Other:

Easements (Temp Staking by P.L.S. Only)

Right of Way (Temp Staking by P.L.S. Only)

Work Performed by the Contractor's Surveyor Under Section 629:

Monumentation (Section 629)

Control

Right of Way

Land corners, Aliquot corners

Easements

Reference the specified existing monuments: \*\*

Replace the specified existing monuments: \*\*

Locate monuments. It is estimated hours are required.

NOTE: All 629 items shall include adequate research, calculations, and evaluations of evidence for monuments to be set.

A Tabulation of Survey Monuments may be provided on the plans.

General Notes:

Unless indicated otherwise on this Survey Tabulation Sheet, all survey work and staking intervals shall be done in accordance with the latest edition of the CDDT Survey Manual.

Adequate information for establishing lines, grades, and locations for all work items have been specified on the plans. Any additional information required to stake the item or element shall be generated by the Contractor's surveyor.

The Contractor's surveyor shall provide an estimate of the man-hours necessary to complete the work items indicated on this sheet. A copy of this sheet, with the estimated man-hours written on the blank line to the left of the specified items, shall be submitted with the Survey Schedule to the Engineer 10 days prior to the Presurvey Conference - Construction Survey.

Stakes and Monuments which are damaged or destroyed by the progress of construction shall be replaced by the Contractor at no additional cost to the Department.

The Contractor shall furnish an As Staked earthwork quantity to the Engineer prior to completion of twenty percent (20%) of the planned earthwork in any phase as per the CDDT Survey Manual. A printed copy of the As Staked earthwork data and a computer disk in the specified format shall be submitted to the Engineer. The Contractor shall field verify original ground cross sections at a maximum 500 feet intervals.

Prior to beginning work on any subsequent operation, such as placing base course or paving, the Contractor shall certify in writing to the Engineer that the final grade is within specified tolerance.

The Contractor's surveyor shall perform all field surveying and calculations necessary to tie plan grades into field grades.

The Contractor shall coordinate construction staking on the project with any utility work.

Fieldbooks shall contain daily records of points set and or measurements observed. The information recorded shall contain: date, crew members' names, point no., description, staking information, and sketches. If the survey information is collected electronically, information recorded shall be provided to the Project Engineer in a hard copy format that is intuitive, clear and related to the supplemental information recorded in the field books. All linear surveys, such as slope stakes and blue tops, shall have the station and offset information related to the measured information. Non-linear surveys such as structures staking shall have sketches relating electronic information, such as point numbers, to the sketch.

The Contractor's surveyor shall submit the following fieldbooks to the Engineer:

Horizontal Control (Primary & Secondary)

Vertical Control (i.e. Benchmarks)

Property Pin Ties

Horizontal Alignment

Grading

Slope Staking

Minor Structures

Major Structures

One fieldbook for each work category shown on this sheet

Other Fieldbook(s):

Print Date: 3/1/2013

File Name: 18861SURV\_Tab.dgn

Horiz. Scale: N/A

Unit Information: GJ Design

Vert. Scale: N/A

JSL

Sheet Revisions

Date:

Comments

Init.

Colorado Department of Transportation

714 Grand Ave.  
Eagle, CO 81631  
Phone: (970) 328-9962 FAX: (970) 328-2368

Region 03

PJL

As Constructed

No Revisions: 12/23/13

Revised:

Void:

SURVEY TABULATION SHEET

Designer: J. Klish

Detailer: J. Klish

Subset: SURVTAB

Structure Numbers

Subset Sheets: 1 of 1

Project No./Code

C 131A-035

18861R

Sheet Number 15



Sheet Revisions

Date	Description	Initials
mm/dd/yy	XXXXXXXX	XXX

Sheet Revisions

Date	Description	Initials
mm/dd/yy	XXXXXXXX	XXX

Sheet Revisions

Date	Description	Initials
mm/dd/yy	XXXXXXXX	XXX

Project Control Diagram

Title Sheet

Project Number: C131A-035

Project Location: SH 131 Various Culverts MP 3 to MP 38

Eagle County

Project Code:	Last Mod. Date	Subset	Sheet No.	
18861R	01-24-2013	3.01 of 3.06	3.01	16

# DEPARTMENT OF TRANSPORTATION STATE OF COLORADO

## PROJECT CONTROL DIAGRAM

State Highway 131 MP 3.09 to 5.13

Section 3

Township 4 South, Range 83 West

Section 27

Township 3 South, Range 83 West

of the 6th Principal Meridian

County of Eagle

SHEET NO.

3.01, 3.04

3.02, 3.05

3.03, 3.06


INDEX OF SHEETS

(2) Title Sheet


(2) Coordinate Tables

(2) Plan Sheet

(6) Total Sheets

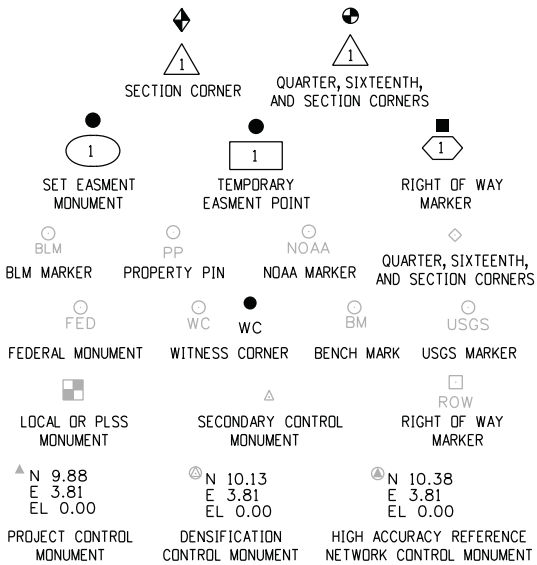

Note: For a complete listing of symbololgy used within this set of plans, please refer to the M-100-1 Standard Symbols of the Colorado Department of Transportation M&S Standards Publication dated July 2006. Existing features are shown as screened weight (gray scale). Proposed or new features are shown as full weight without screening.

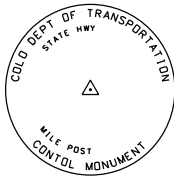


Typical Control Monument Cap  
Not to Scale

▲ CM-MP - Control Point Monuments set by CDOT. They are CDOT Type 2 monuments, a 3 1/4" dia. aluminum control monument cap (as shown) on a 3' x 3/4" dia. aluminum security rod on a 3' x 3/4" dia. smooth aluminum rod.

General Notes:

1. This Project Control Diagram is not a boundary survey of the adjoining property and is prepared for the Colorado Department of Transportation purposes only.
2. This plan set is subject to change and may not be the most current set. It is the user's responsibility to verify with CDOT that this set is the most current. The information contained on the attached drawing is not valid unless this copy bears an original signature of the Professional Land Surveyor hereon named.
3. Refer to the M-629-1 Survey Monuments of the Standard Plans dated July, 2006 found in The Colorado Department of Transportation, M & S Standards for typical survey monument descriptions.

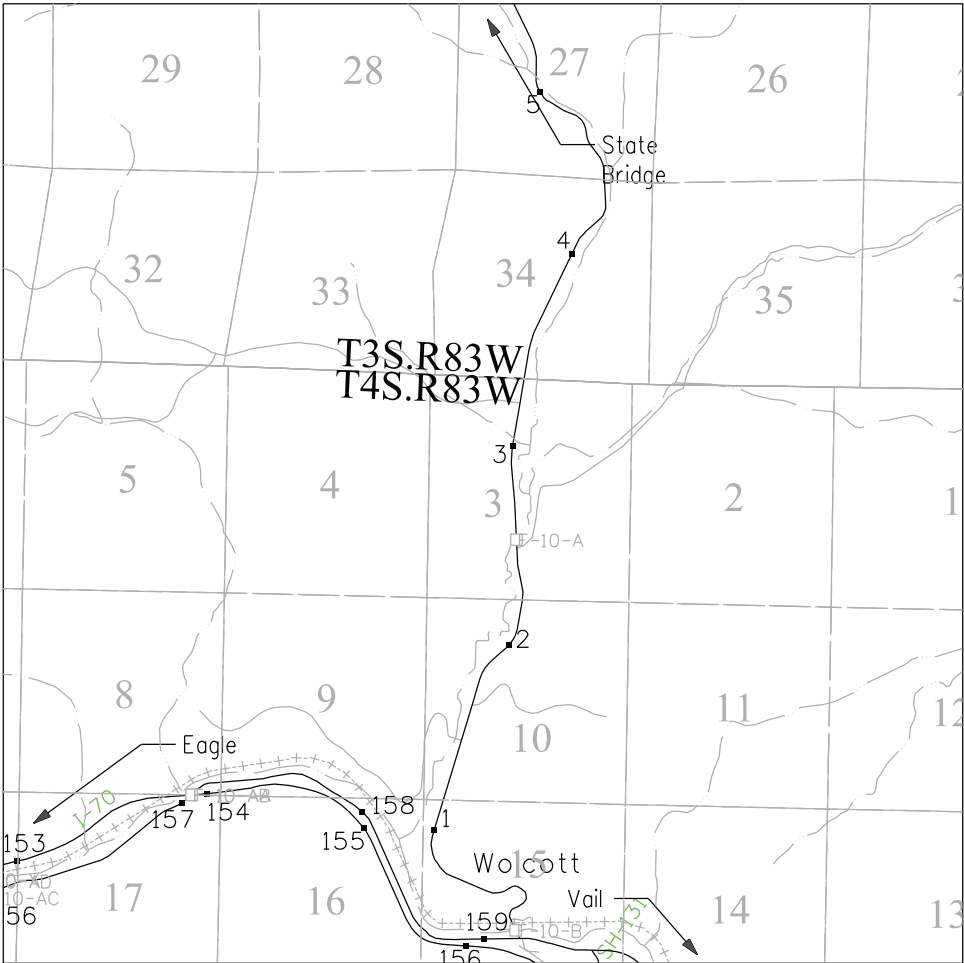

PROJECT LOCATION MAP

0' 2500' 5000' 10000'  
Lineal Units = U.S. Survey Feet



Basis of Bearings: Bearings used in the calculations of coordinates are based on a grid bearing of N3°38'47"E from CM-MP 2.98 to CM-MP 5.12. Both monuments are CDOT Type II, marked appropriately for their milepost location and control position. The survey data was obtained from a Global Positioning System (GPS) survey base on the Colorado High Accuracy Reference Network (CHARN).

Basis of Elevations: Project elevations are based on Bench Mark W 29 RESET, PID: KLO412, a standard bench mark disk set on top of a concrete monument, with a NAVD 88 elevation of 7442.4 ft. W 29 RESET is a Third order benchmark. Differential Levels for points MP 5.10 and MP 5.12 were run from this point. The elevation for MP 2.98 was established by GPS observation and differential levels were run from MP 2.98 to MP 3.05 and MP 3.10

COORDINATE DATUM: Project coordinates are modified Colorado State Plane Central Zone NAD '83/(2007) coordinates. The combined elevation/scale factor used to modify the coordinates from state plane to project coordinates is 1.0003434442. The resulting project coordinates are truncated by 500,000 m in the Northing and 800,000 m in the Easting after converting from state plane coordinates to project coordinates. The CHARN is based on the NAD '83(2007) datum.

Project Coordinates Northing US Survey Feet = (State Plane Coordinate Northing \* 1.0003434442 - 500,000) \* (3937/1200).

Project Coordinates Easting US Survey Feet = (State Plane Coordinate Easting \* 1.0003434442 - 800,000) \* (3937/1200).

NOTICE: According to Colorado law you must commence any legal action based upon any defect in this survey within three years after you first discover such defect. In no event may any action based upon any defect in this survey be commenced more than ten years from the date of the certification shown hereon.

SURVEYOR STATEMENT (PROJECT CONTROL DIAGRAM)

I, \_\_\_\_\_, a professional land surveyor licensed in the State of Colorado, do hereby state to the Colorado Department of Transportation this Project Control Diagram was prepared and the field survey it represents was performed under my responsible charge and, based upon my knowledge, information and belief is in accordance with applicable standards of practice defined by Colorado Department of Transportation publications. This statement is not a guaranty or warranty, either expressed or implied.

PLS No. xxxxx

Colorado Department of Transportation



222 South 6th Street  
Room 317  
Grand Junction, CO 81501  
Phone: 970-683-6234 FAX: 970-683-6249

Region 3

LED

Sheet Revisions

Date	Description	Initials
mm/dd/yy	XXXXXXXX	XXX

Sheet Revisions

Date	Description	Initials
mm/dd/yy	XXXXXXXX	XXX

Sheet Revisions

Date	Description	Initials
mm/dd/yy	XXXXXXXX	XXX

Project Control Diagram

Coordinate Tables SITE A

Project Number: C131A-035				
Project Locotion: SH 131 Various Culverts				
Eagle County, North of Walcott				
Project Code:	Last Mod. Date	Subset	Sheet No.	17
18861R	01-24-2013	3.02 of 3.06	3.02	

SITE A



CHARN GEODETIC COORDINATE SUMMARY TABLE

Point No.	Geodetic Coordinates NAD-83(2007) (CHARN)		Elip Height (NAVD88) (m)	Ortho Height (m)	Mapping Angle	Grid Scale Factor	NAD 83(2007) Zone CO Centra1		Description
	Latitude(N)	Longitude(W)					SP Northing(m)	SP Easting(m)	
W 29 RESET	39°45'42.71912" N	106°40'39.88794" W	2255.216		-0°44'34"	1.0003434442	519543.697	813483.599	CGS Type 5 Monument
Y 29	39°42'25.22614" N	106°41'10.35654" W	2183.053		-0°44'53"	1.0003434442	513462.683	812678.894	CGS Type 5 Monument (Not Shown)

GEODETIC COORDINATE TABLE

Point No.	Geodetic Coordinates NAD-83(XX) (CHARN)		Elip Height (NAVD88) (m)	Ortho Height (m)	Mapping Angle	Grid Scale Factor	NAD 83(XX) Zone XXXX		Description
	Latitude(N)	Longitude(W)					SP Northing(m)	SP Easting(m)	
298	39°44'09.34506" N	106°40'46.19640" W	2176.091	2188.992	-0°44'38"	1.0003434442	516666.082	813296.064	CDOT Type II Monument
305	39°44'12.88408" N	106°40'44.42305" W	2176.151	2189.049	-0°44'37"	1.0003434442	516774.673	813339.703	CDOT Type II Monument
310	39°44'15.25794" N	106°40'45.12339" W	2178.306	2191.206	-0°44'37"	1.0003434442	516848.097	813323.979	CDOT Type II Monument
510	39°45'45.08234" N	106°40'40.93215" W	2257.392	2270.606	-0°44'35"	1.0003434442	519616.899	813459.691	CDOT Type II Monument
511	39°45'47.72996" N	106°40'39.73263" W	2259.598	2272.810	-0°44'34"	1.0003434442	519698.179	813489.299	CDOT Type II Monument

PROJECT COORDINATE TABLE

Point No.	Project Coordinates		Elev(ft) (NAVD88)	Description
	Northing(ft)	Easting(ft)		
298	55260.81	44538.58	7181.72	CDOT Type II Monument
305	55617.20	44681.80	7181.90	CDOT Type II Monument
310	55858.17	44630.19	7188.98	CDOT Type II Monument
510	64945.27	45075.60	7449.48	CDOT Type II Monument
511	65212.03	45172.77	7456.71	CDOT Type II Monument
W 29 RESET	64705.03	45154.06	7442.37	CGS Type 5 Monument
y 29	44747.38	42513.05	7205.78	CGS Type 5 Monument

Coordinate System

Coordinate System	US State Plane 1983
ZONE	COLORADO CENTRAL
DATUM	NAD 1983(2007)
VERTICAL DATUM	NAVD 1988
ELLIPSOID NAME	Geodetic Reference System 7980
GEOID MODEL	GEOID09 (Conus)
AVERAGE COMBINED FACTOR	1.0003434442
NORTHING OFFSET	500000
EASTING OFFSET	800000
PROJECT ELEVATION	7300.00

Basis of Bearings: Bearings used in the calculations of coordinates are based on a grid bearing of N3° 38'47"E from CM-MP 2.98 to CM-MP 5.12. Both monuments are CDDT Type II, marked appropriately for their milepost location and control position. The survey data was obtained from a Global Positioning System (GPS) survey base on the Colorado High Accuracy Reference Network (CHARN).

Basis of Elevations: Project elevations are based on Bench Mark W 29 RESET, PID: KL0412, a standard bench mark disk set on top of a concrete monument, with a NAVD 88 elevation of 7442.4 ft. W 29 RESET is a Third order benchmark. Differential Levels for points MP 5.10 and MP 5.12 were run from this point. The elevation for MP 2.98 was established by GPS observation and differential levels were run from MP 2.98 to MP 3.05 and MP 3.10

COORDINATE DATUM: Project coordinates are modified Colorado State Plane Central Zone NAD '83/(2007) coordinates. The combined elevation/scale factor used to modify the coordinates from state plane to project coordinates is 1.0003434442. The resulting project coordinates are truncated by 500,000 m in the Northing and 800,000 m in the Easting after converting from state plane coordinates to project coordinates. The CHARN is based on the NAD '83(2007) datum.

Project Coordinates Northing US Survey Feet = (State Plane Coordinate Northing \* 1.0003434442 - 500,000) \* (3937/1200).

Project Coordinates Easting US Survey Feet = (State Plane Coordinate Easting \* 1.0003434442 - 800,000) \* (3937/1200).



Sheet Revisions			Sheet Revisions			Sheet Revisions		
Date	Description	Initials	Date	Description	Initials	Date	Description	Initials
mm/dd/yy	XXXXXXXX	XXX	mm/dd/yy	XXXXXXXX	XXX	mm/dd/yy	XXXXXXXX	XXX


Project Control Diagram				
Plan Sheet SITE A				
Project Number: C131A-035				
Project Location: SH 131 Various Culverts				
Eagle County, North of Wocott				
Project Code:	Last Mod. Date	Subset	Sheet No.	18
18861R	01-24-2013	3.03 of 3.06	3.03	



DEPARTMENT OF TRANSPORTATION

STATE OF COLORADO

PROJECT CONTROL DIAGRAM

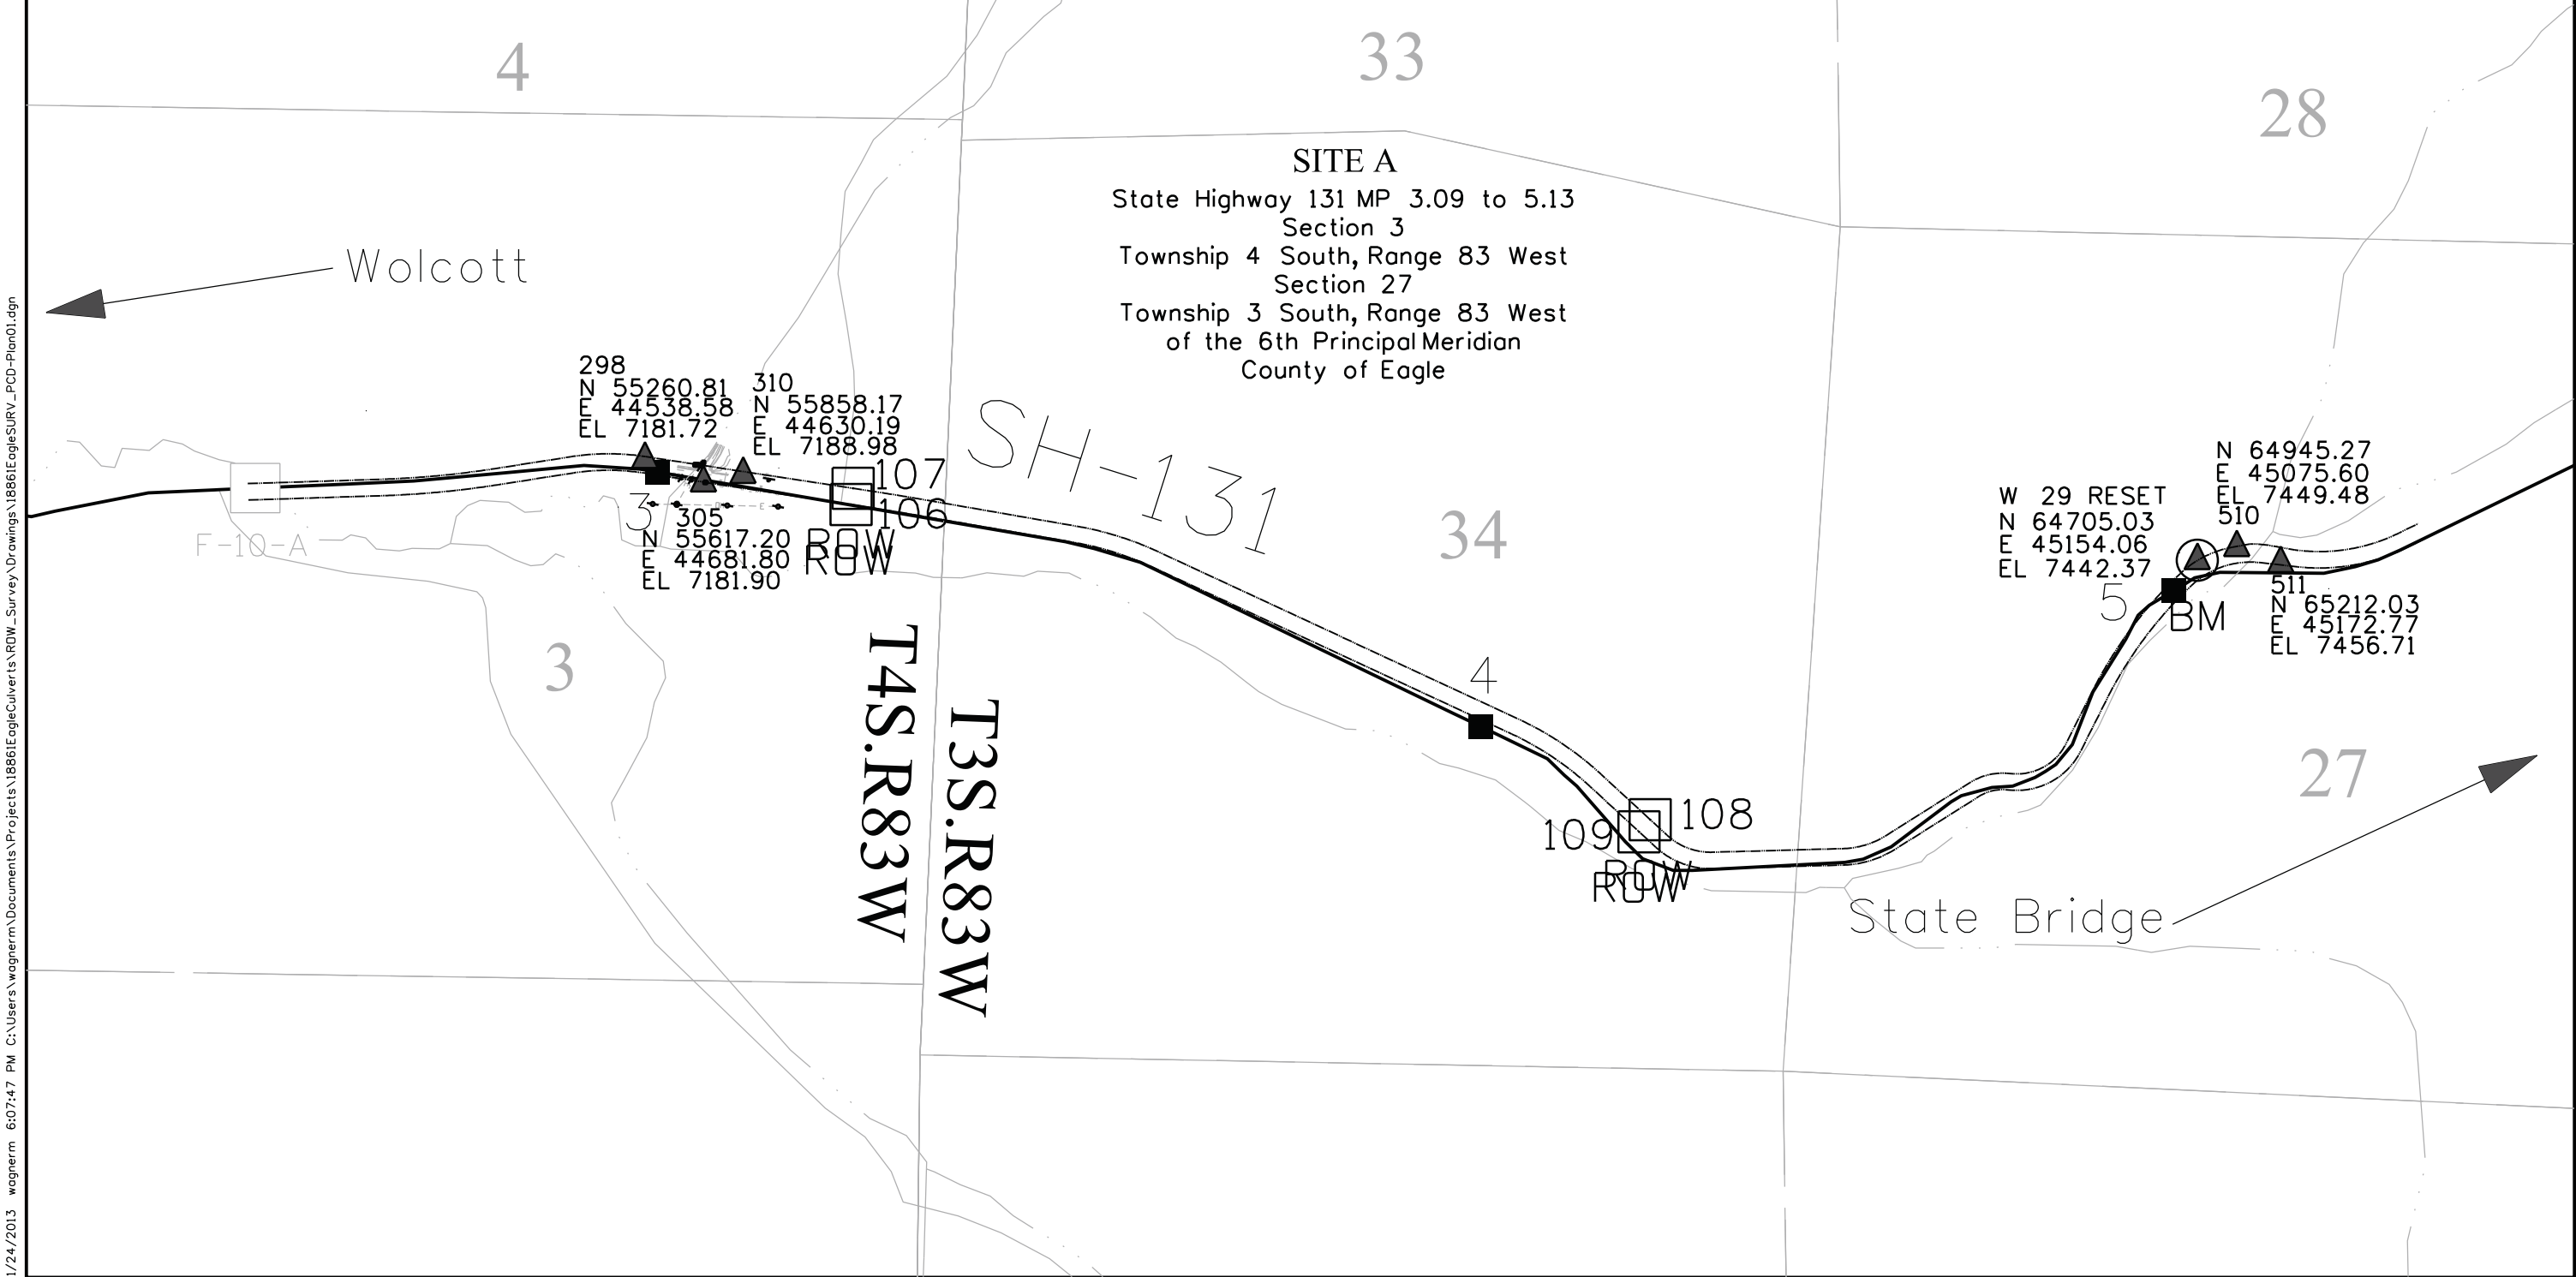

1/24/2013 5:53:58 PM C:\Users\wagnerm\Documents\Projects\18861Rout\Culverts\RDW\_Survey\Drawings\18861Rout\Culverts\_PCD-Title.dgn

Sheet Revisions			Sheet Revisions			Sheet Revisions		
Date	Description	Initials	Date	Description	Initials	Date	Description	Initials
mm/dd/yy	XXXXXXXX	XXX	mm/dd/yy	XXXXXXXX	XXX	mm/dd/yy	XXXXXXXX	XXX

Project Control Diagram				
Title Sheet				
Project Number: C131A-035				
Project Location: SH 131 Various Culverts				
Routt County between Yampa and Toponas				
Project Code:	Last Mod. Date	Subset	Sheet No.	19
18861R	01-24-2013	3.04 of 3.06	3.04	

# DEPARTMENT OF TRANSPORTATION STATE OF COLORADO

## PROJECT CONTROL DIAGRAM

State Highway 131 MP 36.3 to 37.8

Section 6

Township 1 North, Range 84 West

Section 1

Township 1 North, Range 85 West

Section 36

Township 2 North, Range 85 West

of the 6th Principal Meridian

County of Routt

### SHEET NO.

3.04

3.05

3.06


### INDEX OF SHEETS

(3.01, 3.04) Title Sheet


(3.02, 3.05) Coordinate Tables

(3.03, 3.06) Plan Sheet

(6) Total Sheets

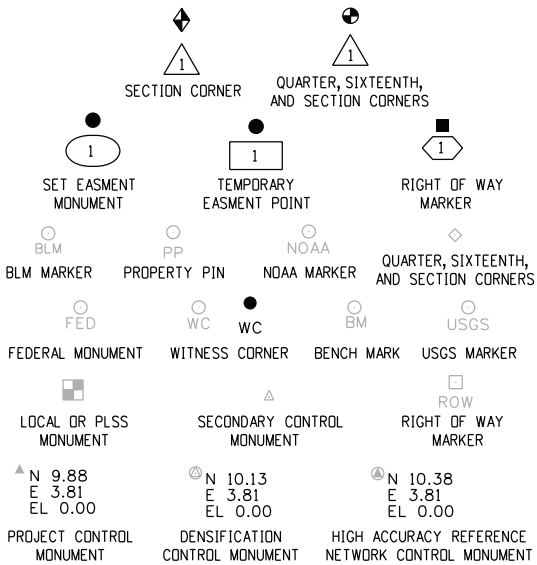

Note: For a complete listing of symbololgy used within this set of plans, please refer to the M-100-1 Standard Symbols of the Colorado Department of Transportation M&S Standards Publication dated July 2006. Existing features are shown as screened weight (gray scale). Proposed or new features are shown as full weight without screening.

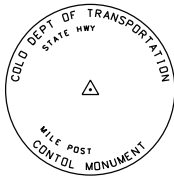


Typical Control Monument Cap  
Not to Scale

▲ CM-MP - ControlPoint Monuments set by CDOT. They are CDOT Type 2 monuments, a 3 1/4" dia. aluminum control monument cap (as shown) on a 3' x 3 1/4" dia. aluminum security rod on a 3' x 3 1/4" dia. smooth aluminum rod.

#### General Notes:

1. This Project ControlDiagram is not a boundary survey of the adjoining property and is prepared for the Colorado Department of Transportation purposes only.
2. This plan set is subject to change and may not be the most current set. It is the user's responsibility to verify with CDOT that this set is the most current. The information contained on the attached drawing is not valid unless this copy bears an original signature of the ProfessionalLand Surveyor hereon named.
3. Refer to the M-629-1 Survey Monuments of the Standard Plans dated July, 2006 found in The Colorado Department of Transportation, M & S Standards for typical survey monument descriptions.

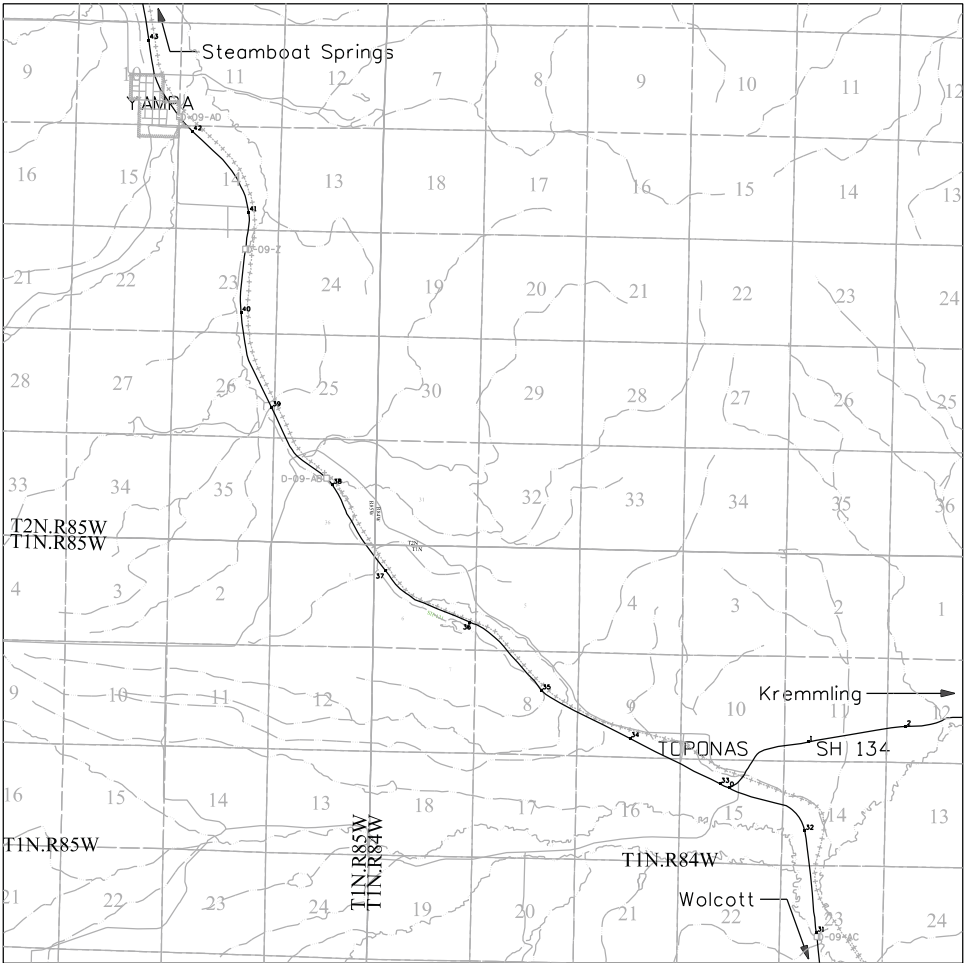

PROJECT LOCATION MAP

0' 5000' 10000' 20000'  
Lineal Units = U.S. Survey Feet

Basis of Bearings: Bearings used in the calculations of coordinates are based on a grid bearing of N42°02'58"W from CM-MP 36.4 to CM-MP 37.8. Both monuments are CDOT Type II, marked appropriately for their milepost location and controlposition. The survey data was obtained from a Global Positioning System (GPS) survey base on the Colorado High Accuracy Reference Network (CHARN).

Basis of Elevations: Project elevations are based on a GPS observation of CDOT Type 2 Monument MP 364, with an elevation of 8089.60ft. Differential Levels were run from this point through the other controlpoints to MP 378 and back.

COORDINATE DATUM: Project coordinates are modified Colorado State Plane North Zone NAD '83/(2007) coordinates. The combined elevation/scale factor used to modify the coordinates from state plane to project coordinates is 1.0003434442. The resulting project coordinates are truncated by 500,000 in the Northing and 800,000m in the Easting after converting from state plane coordinates to project coordinates. The CHARN is based on the NAD '83(2007) datum.

Project Coordinates Northing US Survey Feet = (State Plane Coordinate Northing \* 1.0003434442 - 200,000) \* (3937/1200).

Project Coordinates Easting US Survey Feet = (State Plane Coordinate Easting \* 1.0003434442 - 400,000) \* (3937/1200).

NOTICE: According to Colorado law you must commence any legalaction based upon any defect in this survey within three years after you first discover such defect. In no event may any action based upon any defect in this survey be commenced more than ten years from the date of the certification shown hereon.

#### SURVEYOR STATEMENT (PROJECT CONTROL DIAGRAM)

I, \_\_\_\_\_, a professional land surveyor licensed in the State of Colorado, do hereby state to the Colorado Department of Transportation this Project Control Diagram was prepared and the field survey it represents was performed under my responsible charge and, based upon my knowledge, information and belief is in accordance with applicable standards of practice defined by Colorado Department of Transportation publications. This statement is not a guaranty or warranty, either expressed or implied.

PLS No. xxxxx

Colorado Department of Transportation



222 South 6th Street  
Room 317  
Grand Junction, CO 81501  
Phone: 970-683-6234 FAX: 970-683-6249

Region 3

LED

Sheet Revisions

Date	Description	Initials
mm/dd/yy	XXXXXXXX	XXX

Sheet Revisions

Date	Description	Initials
mm/dd/yy	XXXXXXXX	XXX

Sheet Revisions

Date	Description	Initials
mm/dd/yy	XXXXXXXX	XXX

Project Control Diagram

Coordinate Tables SITE B

Project Number: C131A-035				
Project Location: SH 131 Various Culverts				
RDUTT County Between Yampa and Toponas				
Project Code:	Last Mod. Date	Subset	Sheet No.	20
18861R	01-24-2013	3.05 of 3.06	3.05	

SITE B

CHARN GEODETIC COORDINATE SUMMARY TABLE

Point No.	Geodetic Coordinates NAD-83(07) (CHARN)		Elip Height (NAVD88) (m)	Ortho Height (m)	Mapping Angle	Grid Scale Factor	NAD 83(2007) Zone C0 N.		Description
	Latitude(N)	Longitude(W)					SP Northing(m)	SP Easting(m)	
C131 MP37.9	40°05'53.50380" N	106°52'21.60061" W	2435.210	2447.870	-0°53'12.9"	1.0004218452	390629.157	797361.903	NGS GPS Control, CDOH Type 5 ROW Monument
F 29	40°03'53.99474" N	106°48'54.33621" W	2513.781	2526.444	-0°50'59.8"	1.0004218452	386869.245	802215.851	US CGS BM in Concrete Monument (not shown)

GEODETIC COORDINATE TABLE

Point No.	Geodetic Coordinates NAD-83(07) (CHARN)		Elip Height (NAVD88) (m)	Ortho Height (m)	Mapping Angle	Grid Scale Factor	NAD 83(2007) Zone C0 N.		Description
	Latitude(N)	Longitude(W)					SP Northing(m)	SP Easting(m)	
359	40°04'47.33541" N	106°50'47.07152" W	2470.765	2483.429	-0°52'12"	1.0004218452	388554.28700	799569.62900	CDOH Type 5 ROW Monument in Concrete
364	40°04'57.71154" N	106°51'21.62961" W	2453.051	2465.715	-0°52'34"	1.0004218452	388886.74700	798755.86900	CDOT Type 2 Control Monument
371	40°05'16.22034" N	106°51'50.42118" W	2444.282	2456.943	-0°52'53"	1.0004218452	389467.99300	798082.63200	CDOT Type 2 Control Monument
372	40°05'27.13131" N	106°51'56.62102" W	2439.683	2452.344	-0°52'57"	1.0004218452	389806.73200	797940.96100	Type 4 Township Corner
373	40°05'27.03437" N	106°52'03.94923" W	2440.810	2453.470	-0°53'02"	1.0004218452	389806.41800	797767.34400	CDOH Type 5 ROW Monument in Concrete
378	40°05'42.57125" N	106°52'15.96176" W	2438.440	2451.101	-0°53'09"	1.0004218452	390289.94700	797490.23300	CDOT Type 2 Control Monument
C131 MP37.9	40°05'53.50380" N	106°52'21.60061" W	2435.210	2447.870	-0°53'13"	1.0004218452	390629.15700	797361.90300	NGS GPS Control, CDOH Type 5 ROW Monument
F 29	40°03'53.99474" N	106°48'54.33621" W	2513.781	2526.444	-0°50'59"	1.0004218452	386869.24500	802215.85100	US CGS BM in Concrete Monument (not shown)

PROJECT COORDINATE TABLE

Point No.	Project Coordinates		Elev(ft) (NAVD88)	Description
	Northing(ft)	Easting(ft)		
359	291069.62	327777.96	8147.72	CDOH Type 5 ROW Monument in Concrete
364	292160.82	325107.03	8089.60	CDOT Type 2 Control Monument
371	294068.60	322897.32	8060.82	CDOT Type 2 Control Monument
372	295180.41	322432.32	8045.73	Type 4 Township Corner
373	295179.38	321862.47	8049.43	CDOH Type 5 ROW Monument in Concrete
378	296766.43	320952.94	8041.65	CDOT Type 2 Control Monument
C131 MP37.9	297879.79	320531.73	8031.05	NGS GPS Control, CDOH Type 5 ROW Monument
F 29	285538.94	336463.44	8288.84	US CGS BM in Concrete Monument (not shown)

Coordinate System

Coordinate System	US State Plane 1983
ZONE	COLORADO NORTH
DATUM	NAD 1983(2007)
VERTICAL DATUM	NAVD 1988
ELLIPSOID NAME	Geodetic Reference System 7980
GEOID MODEL	GEOID09 (Conus)
AVERAGE COMBINED FACTOR	1.0004218452
NORTHING OFFSET	300000 M
EASTING OFFSET	700000 N
PROJECT ELEVATION	8060 USSF

Basis of Bearings: Bearings used in the calculations of coordinates are based on a grid bearing of N42°02'58"W from CM-MP 36.4 to CM-MP 37.8. Both monuments are CDOT Type II, marked appropriately for their milepost location and control position. The survey data was obtained from a Global Positioning System (GPS) survey base on the Colorado High Accuracy Reference Network (CHARN).

Basis of Elevations: Project elevations are based on a GPS observation of CDOT Type 2 Monument MP 364, with an elevation of 8089.60ft. Differential Levels were run from this point through the other control points to MP 378 and back.

COORDINATE DATUM: Project coordinates are modified Colorado State Plane North Zone NAD '83/(2007) coordinates. The combined elevation/scale factor used to modify the coordinates from state plane to project coordinates is 1.0003434442. The resulting project coordinates are truncated by 500,000 in the Northing and 800,000m in the Easting after converting from state plane coordinates to project coordinates. The CHARN is based on the NAD '83(2007) datum.

Project Coordinates Northing US Survey Feet = (State Plane Coordinate Northing \* 1.0004218452 - 200,000) \* (3937/1200).

Project Coordinates Easting US Survey Feet = (State Plane Coordinate Easting \* 1.0004218452 - 400,000) \* (3937/1200).



Colorado Department of Transportation



222 South 6th Street  
Room 317  
Grand Junction, CO 81501  
Phone: 970-683-6234 FAX: 970-683-6249

Region 3

LED

Sheet Revisions


Date	Description	Initials
mm/dd/yy	XXXXXXXX	XXX

Sheet Revisions

Date	Description	Initials
mm/dd/yy	XXXXXXXX	XXX

Sheet Revisions

Date	Description	Initials
mm/dd/yy	XXXXXXXX	XXX

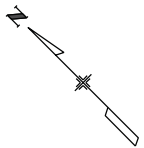

Project Control Diagram

Plan Sheet


Project Number: C131A-035				
Project Location: SH 131 Various Culverts				
SITE B, Routt County between Toponas and Yampa				
Project Code:	Last Mod. Date	Subset	Sheet No.	21
18861R	01-24-2013	3.06 of 3.06	3.06	

DEPARTMENT OF TRANSPORTATION  
STATE OF COLORADO

PROJECT CONTROL DIAGRAM



SITE B

State Highway 131 MP 36.3 to 37.70  
Section 6  
Township 1 North, Range 84 West  
Section 1  
Township 1 North, Range 85 West  
Section 36  
Township 2 North, Range 85 West  
of the 6th Principal Meridian  
County of Routt

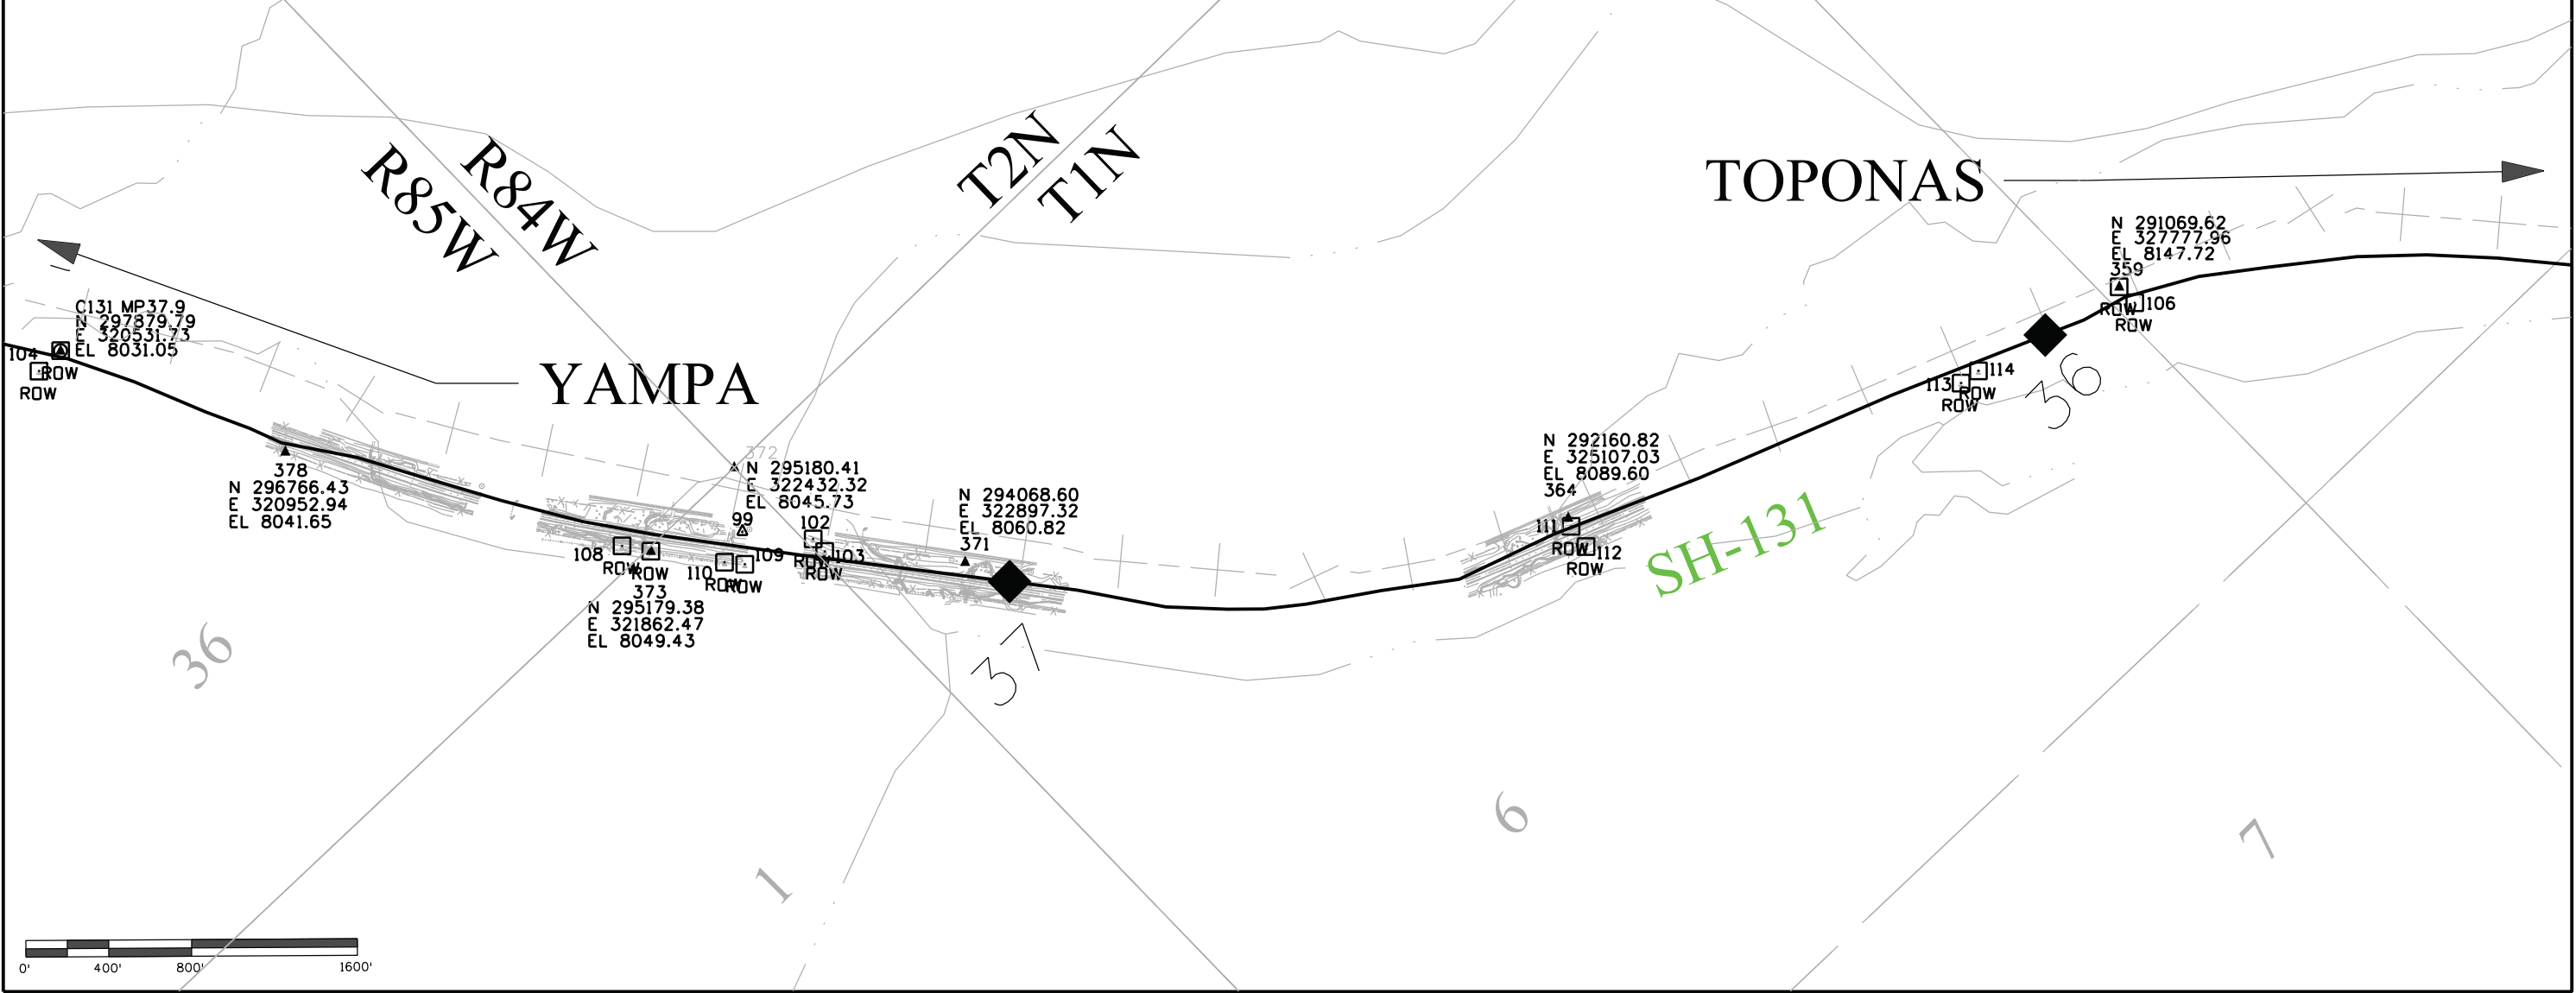

1/24/2013 5:35:11 PM C:\Users\wagnerm\Documents\Projects\18861RouttCulverts\ROW\_Survey\Drawings\18861RouttCulverts\_PCD-Plan01.dgn

klishj 2:46:42 PM c:\projectwise\pwz\_working\0233335\1886IDES\_Geometry001.dgn

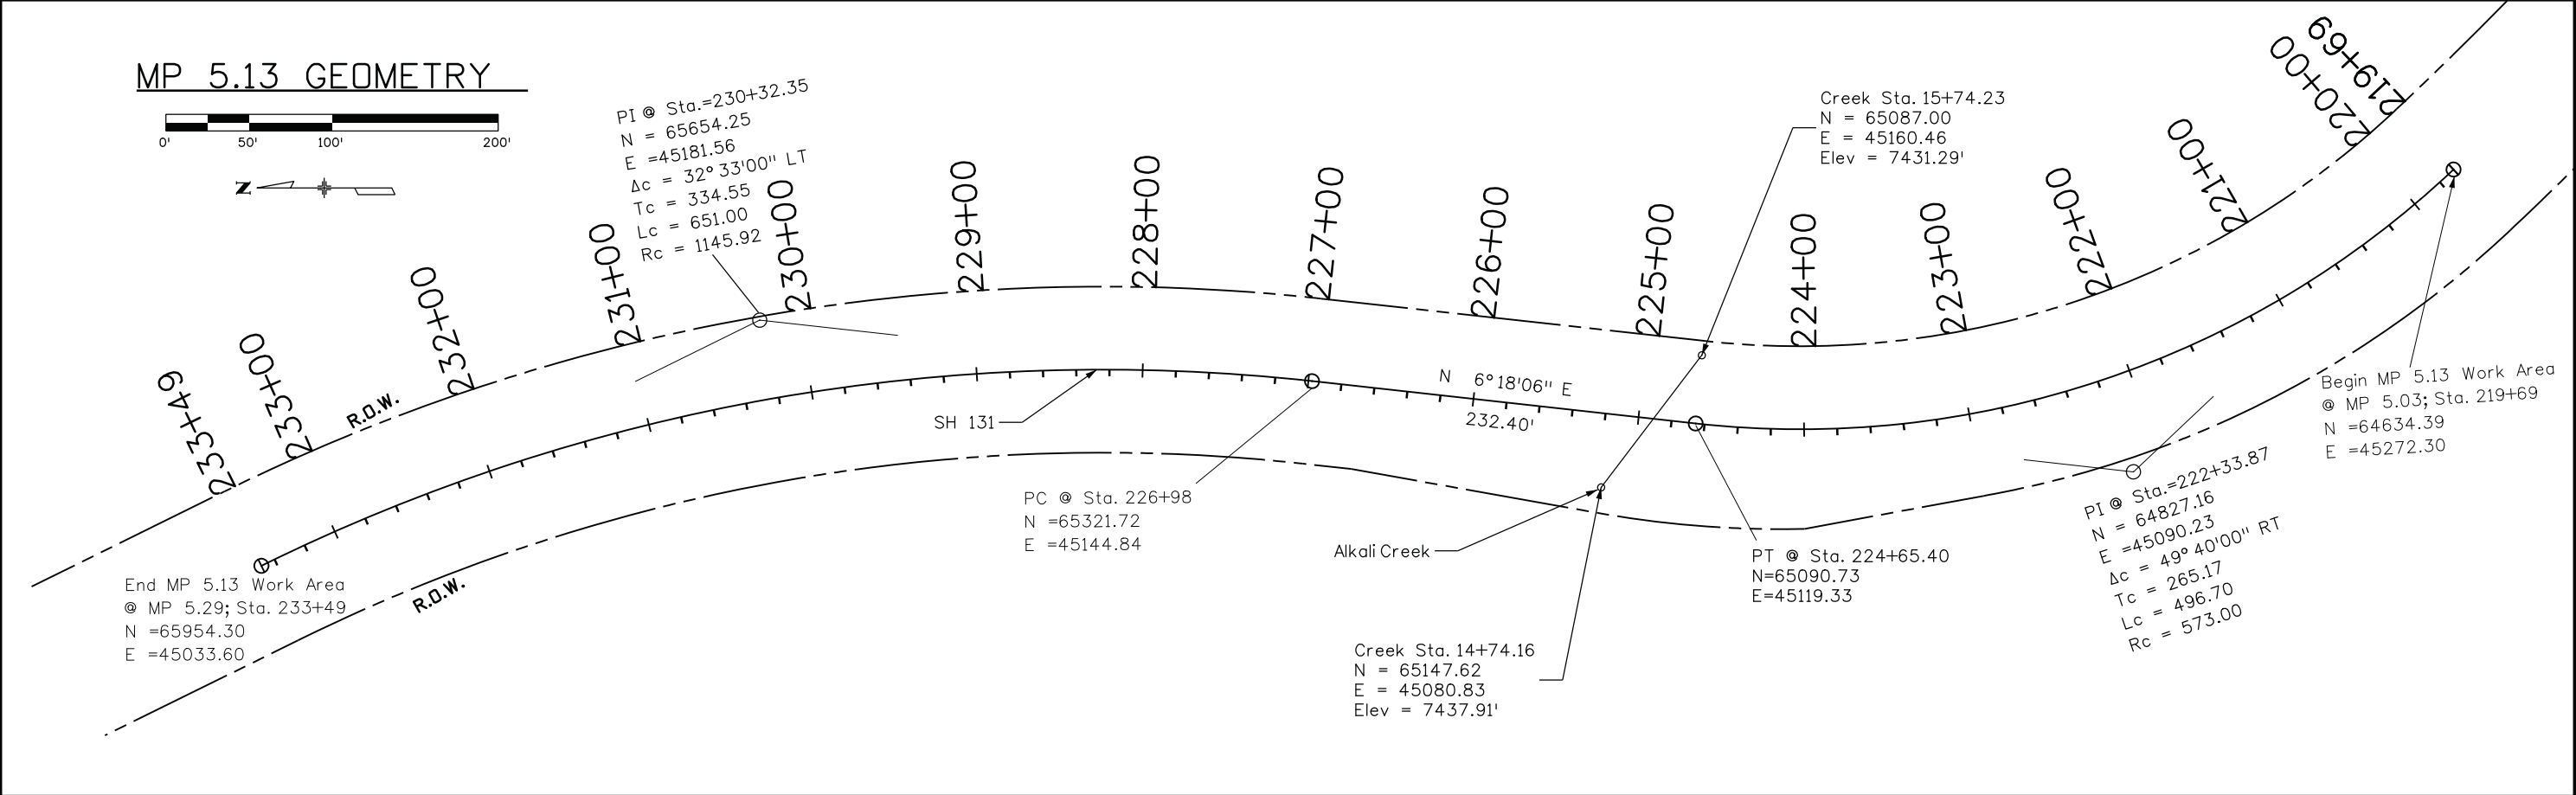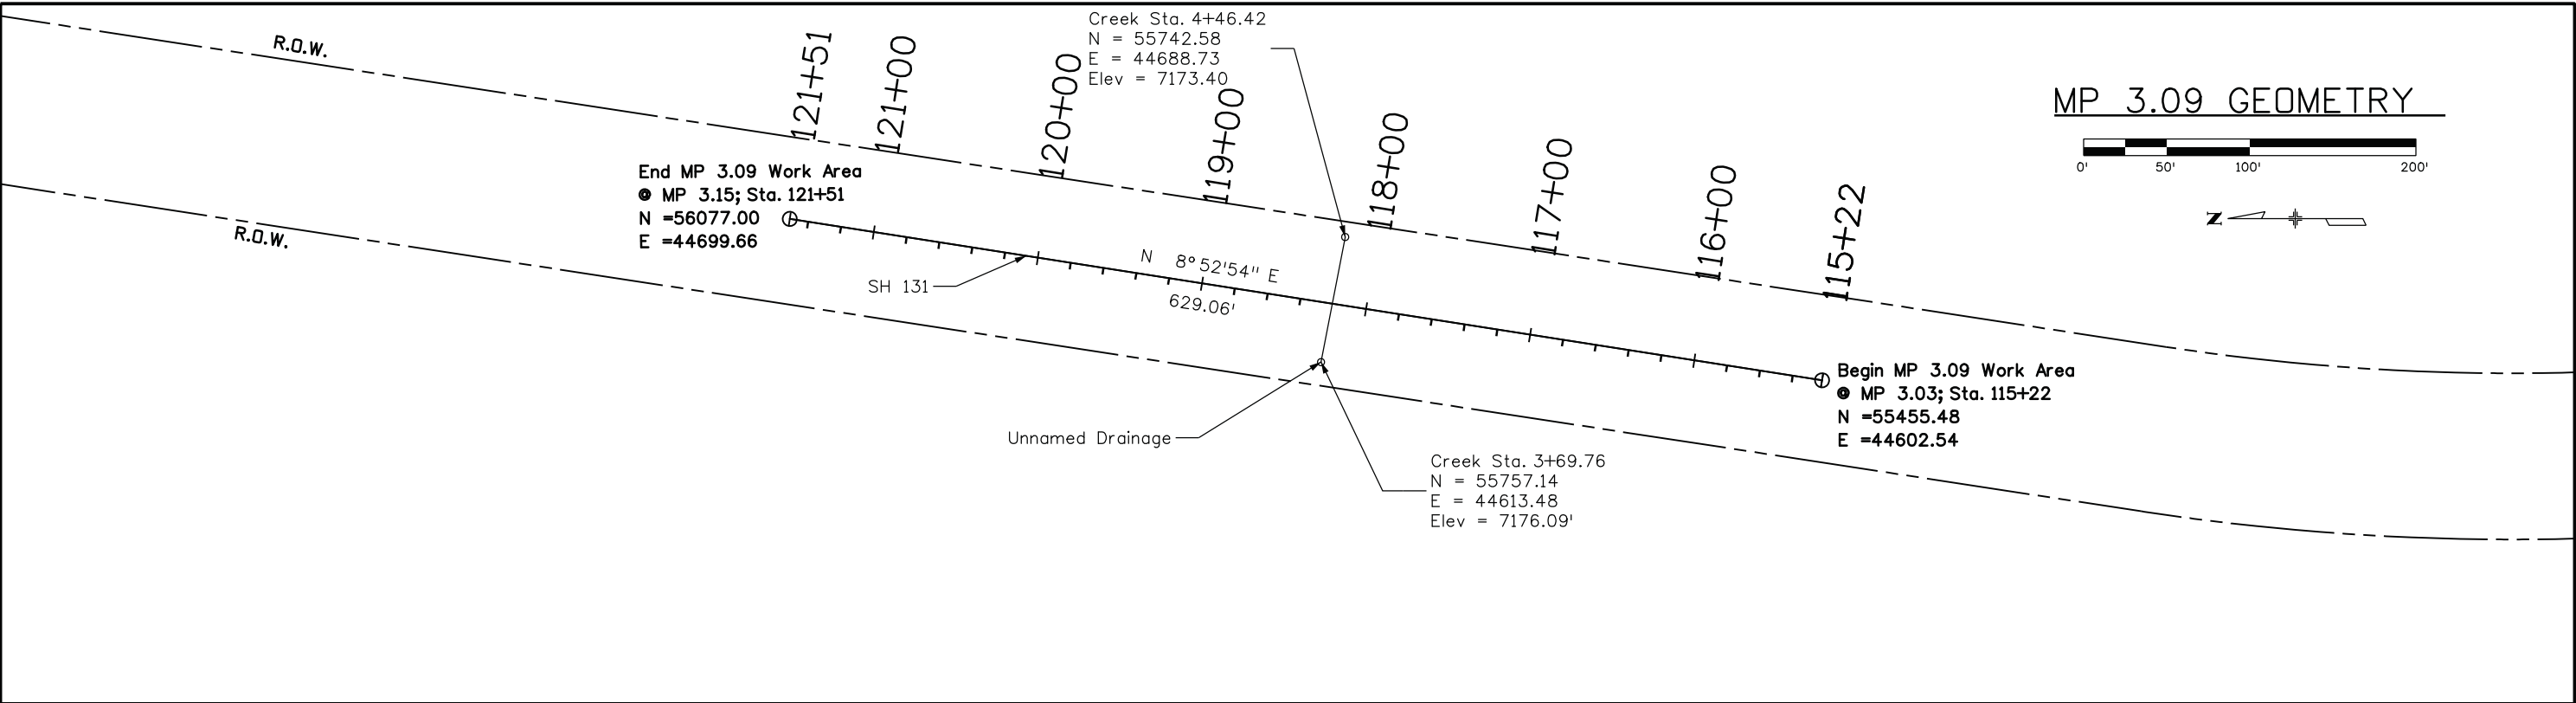


Print Date: 3/1/2013		<div>0000</div>	Sheet Revisions			<div><div><div>Colorado Department of Transportation</div><div>714 Grand Ave Eagle, CO 81631 Phone: (970) 328-9962 FAX: (970) 328-2368</div><div>Region 03</div><div>PJL</div></div></div>		As Constructed		GEOMETRY SHEETS			Project No./Code	
File Name: 18861DES_Geometry001.dgn			Date:	Comments	Init.			No Revisions: 12/23/13					C 131A-035	
Horiz. Scale: 1:100			Vert. Scale:	N/A						Revised:	Designer: J. Klish	Structure		18861R
Unit Information: GJ Design			JSL							Void:	Detailer: J. Klish	Numbers		Sheet Number 22
											Subset: GEOM	Subset Sheets: 1	of 3	



MP 36.42 GEOMETRY



M.P. 36.42 Creek				
Curve	Station	Northing	Easting	Elevation
PI 1	20+59.70	292159.53	325017.04	8082.80
PI 2	20+72.90	292151.68	325006.43	8082.86
PI 3	20+82.03	292146.96	324998.63	8082.48
PI 4	20+90.92	292139.99	324993.10	8083.03
PI 5	21+00.75	292130.82	324989.56	8089.34
PI 6	21+39.76	292094.43	324975.51	8083.37
PI 7	21+50.12	292084.77	324971.78	8082.40
PI 8	21+54.94	292080.20	324970.10	8082.21

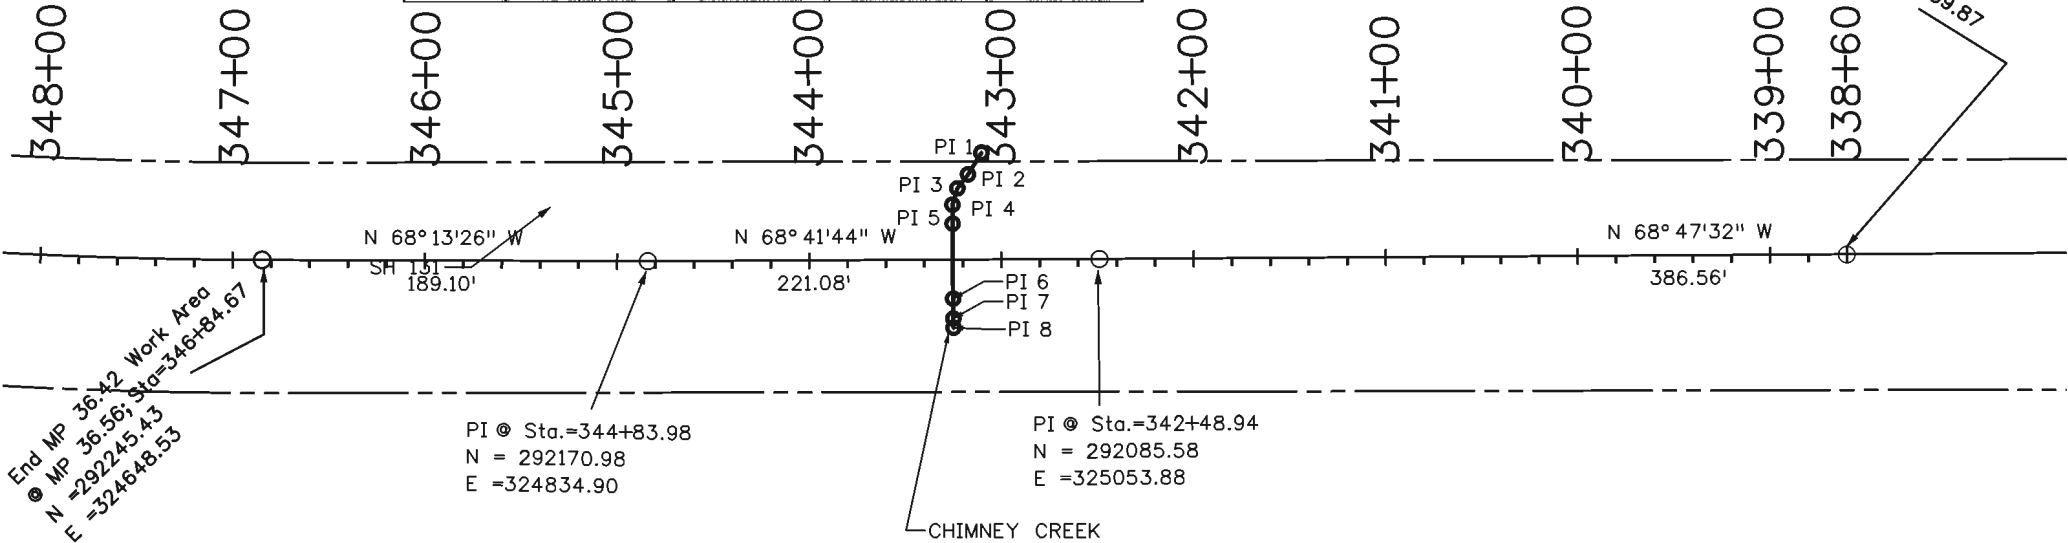

MP 37.08 & MP 37.11 GEOMETRY

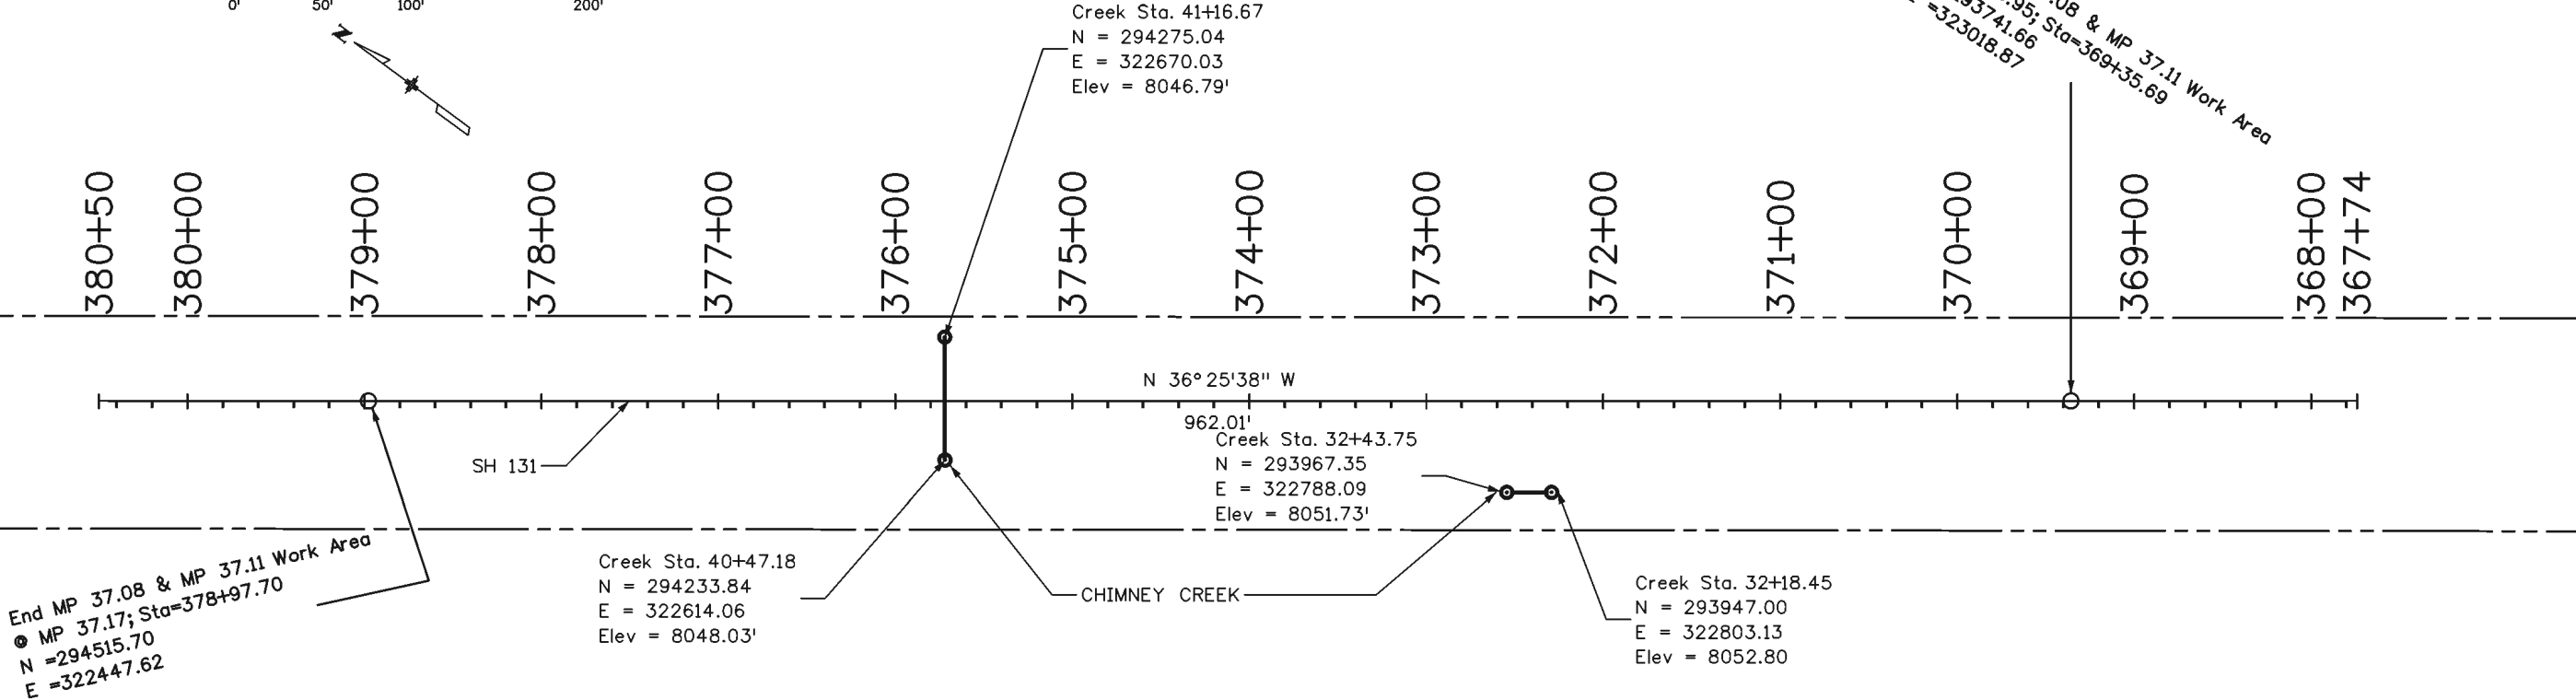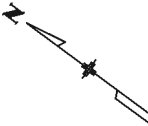


Print Date: 3/1/2013		<div>0000</div>	Sheet Revisions			Colorado Department of Transportation		As Constructed		GEOMETRY SHEETS			Project No./Code	
File Name: 18861DES_Geometry002.dgn			Date:	Comments	Init.	<div> 714 Grand Ave. Eagle, CO 81631 Phone: (970) 328-9962 FAX: (970) 328-2368 Region 03</div>	No Revisions: 12/23/13		C 131A-035					
Horiz. Scale: 1:100			Vert. Scale:	N/A					Revised:	Designer: J. Klish	Structure		18861R	
Unit Information: GJ Design			JSL							Detailer: J. Klish	Numbers			
									Void:	Subset: ConstTrafTab	Subset Sheets: 2	of 3	Sheet Number 23	

kishj 2:46:47 PM c:\projectwise\pwz\_working\vd02333335\18861DES\_Geometry002.dgn



MP 37.34 GEOMETRY

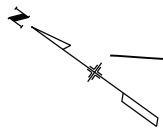

End MP 37.34 Work Area  
PDC @ MP 37.41  
Sta=392+00  
N=295648.36  
E=321621.06

392+00

391+00

390+00

389+00

388+00

387+00

386+00

385+00

384+00

383+17

$\Delta c = 10^\circ 27' 00''$   
 $Tc = 523.95'$   
 $L = 179.70'$   
 $Rc = 5729.58'$

N  $36^\circ 24' 18''$  W  
671.90'

CHIMNEY CREEK


Creek Sta. 52+27.06  
N = 295238.17  
E = 321871.71  
Elev = 8038.45'

Begin MP 37.34 Work Area  
@ MP 37.25; Sta=383+16.96  
N=294852.05  
E=322197.32

PC @ Sta=389+88.85  
N =295393.89  
E =321800.05

Creek Sta. 51+57.87  
N = 295279.60  
E = 321927.10  
Elev = 8039.20'

MP 37.70 GEOMETRY

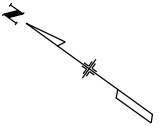

End MP 37.70 Work Area  
PDT @ MP 37.71  
Sta=405+00.00  
N=296867.36  
E=320976.35

406+80

406+00

405+00

404+00

403+00

402+00

401+00

400+00

399+00

398+00

397+00

396+40

N  $25^\circ 58' 13''$  W  
466.17'

CHIMNEY CREEK

Creek Sta. 63+24.86  
N = 296394.94  
E = 321177.57  
Elev = 8031.40'

Creek Sta. 63+90.24  
N = 296448.37  
E = 321215.21  
Elev = 8030.78'

PT @ Sta=400+33.84  
N = 296286.55  
E = 321259.53

Begin MP 37.70 Work Area  
PDC @ MP 37.55  
Sta=396+40.00  
N=295938.69  
E=321444.02

$\Delta c = 10^\circ 27' 00''$   
 $Tc = 523.95'$   
 $L = 393.84'$   
 $Rc = 5729.58'$

Print Date: 3/1/2013

File Name: 18861DES\_Geometry003.dgn

Horiz. Scale: 1:100      Vert. Scale:      N/A

Unit Information: GJ Design      JSL

0000

Sheet Revisions

Date:	Comments	Init.



Colorado Department of Transportation  
714 Grand Ave.  
Eagle, CO 81631  
Phone: (970) 328-9962 FAX: (970) 328-2368  
Region 03

PJL

As Constructed

No Revisions: 12/23/13

Revised:

Void:


GEOMETRY SHEETS

Designer:	J. Klish	Structure Numbers	
Detailer:	J. Klish		
Subset:	GEOM	Subset Sheets: 3 of 3	

Project No./Code

C 131A-035
18861R
Sheet Number 24

klishj 2:46:52 PM c:\projectwise\pwz\_working\00233335\18861DES\_Geometry003.dgn

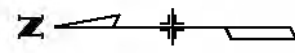

**PROJECT UTILITY CONTACTS:**

CENTURYLINK FIBER AND TELE MP 36-38 ANNA KENNER

970-679-3661  
CELL: 970-819-0776

CENTURYLINK FIBER AND TELE MP 3-5 BARB DAVIS

970-328-8288


VARIOUS MEMBER UTILITIES (UTILITIES NOTIFICATION CENTER OF COLORADO)

1-888-922-1967



STA 120+50  
END REMOVAL OF ASPHALT MAT (PLANING)  
REMOVAL OF ASPHALT MAT, AND WIDENING  
UP TO 6' SHOULDERS WITH NEW ASPHALT

SHORING IS ANTICIPATED TO BE USED IN THIS AREA &  
THIS WORK SHALL BE PAID FOR AS SHORING (AREA 1)

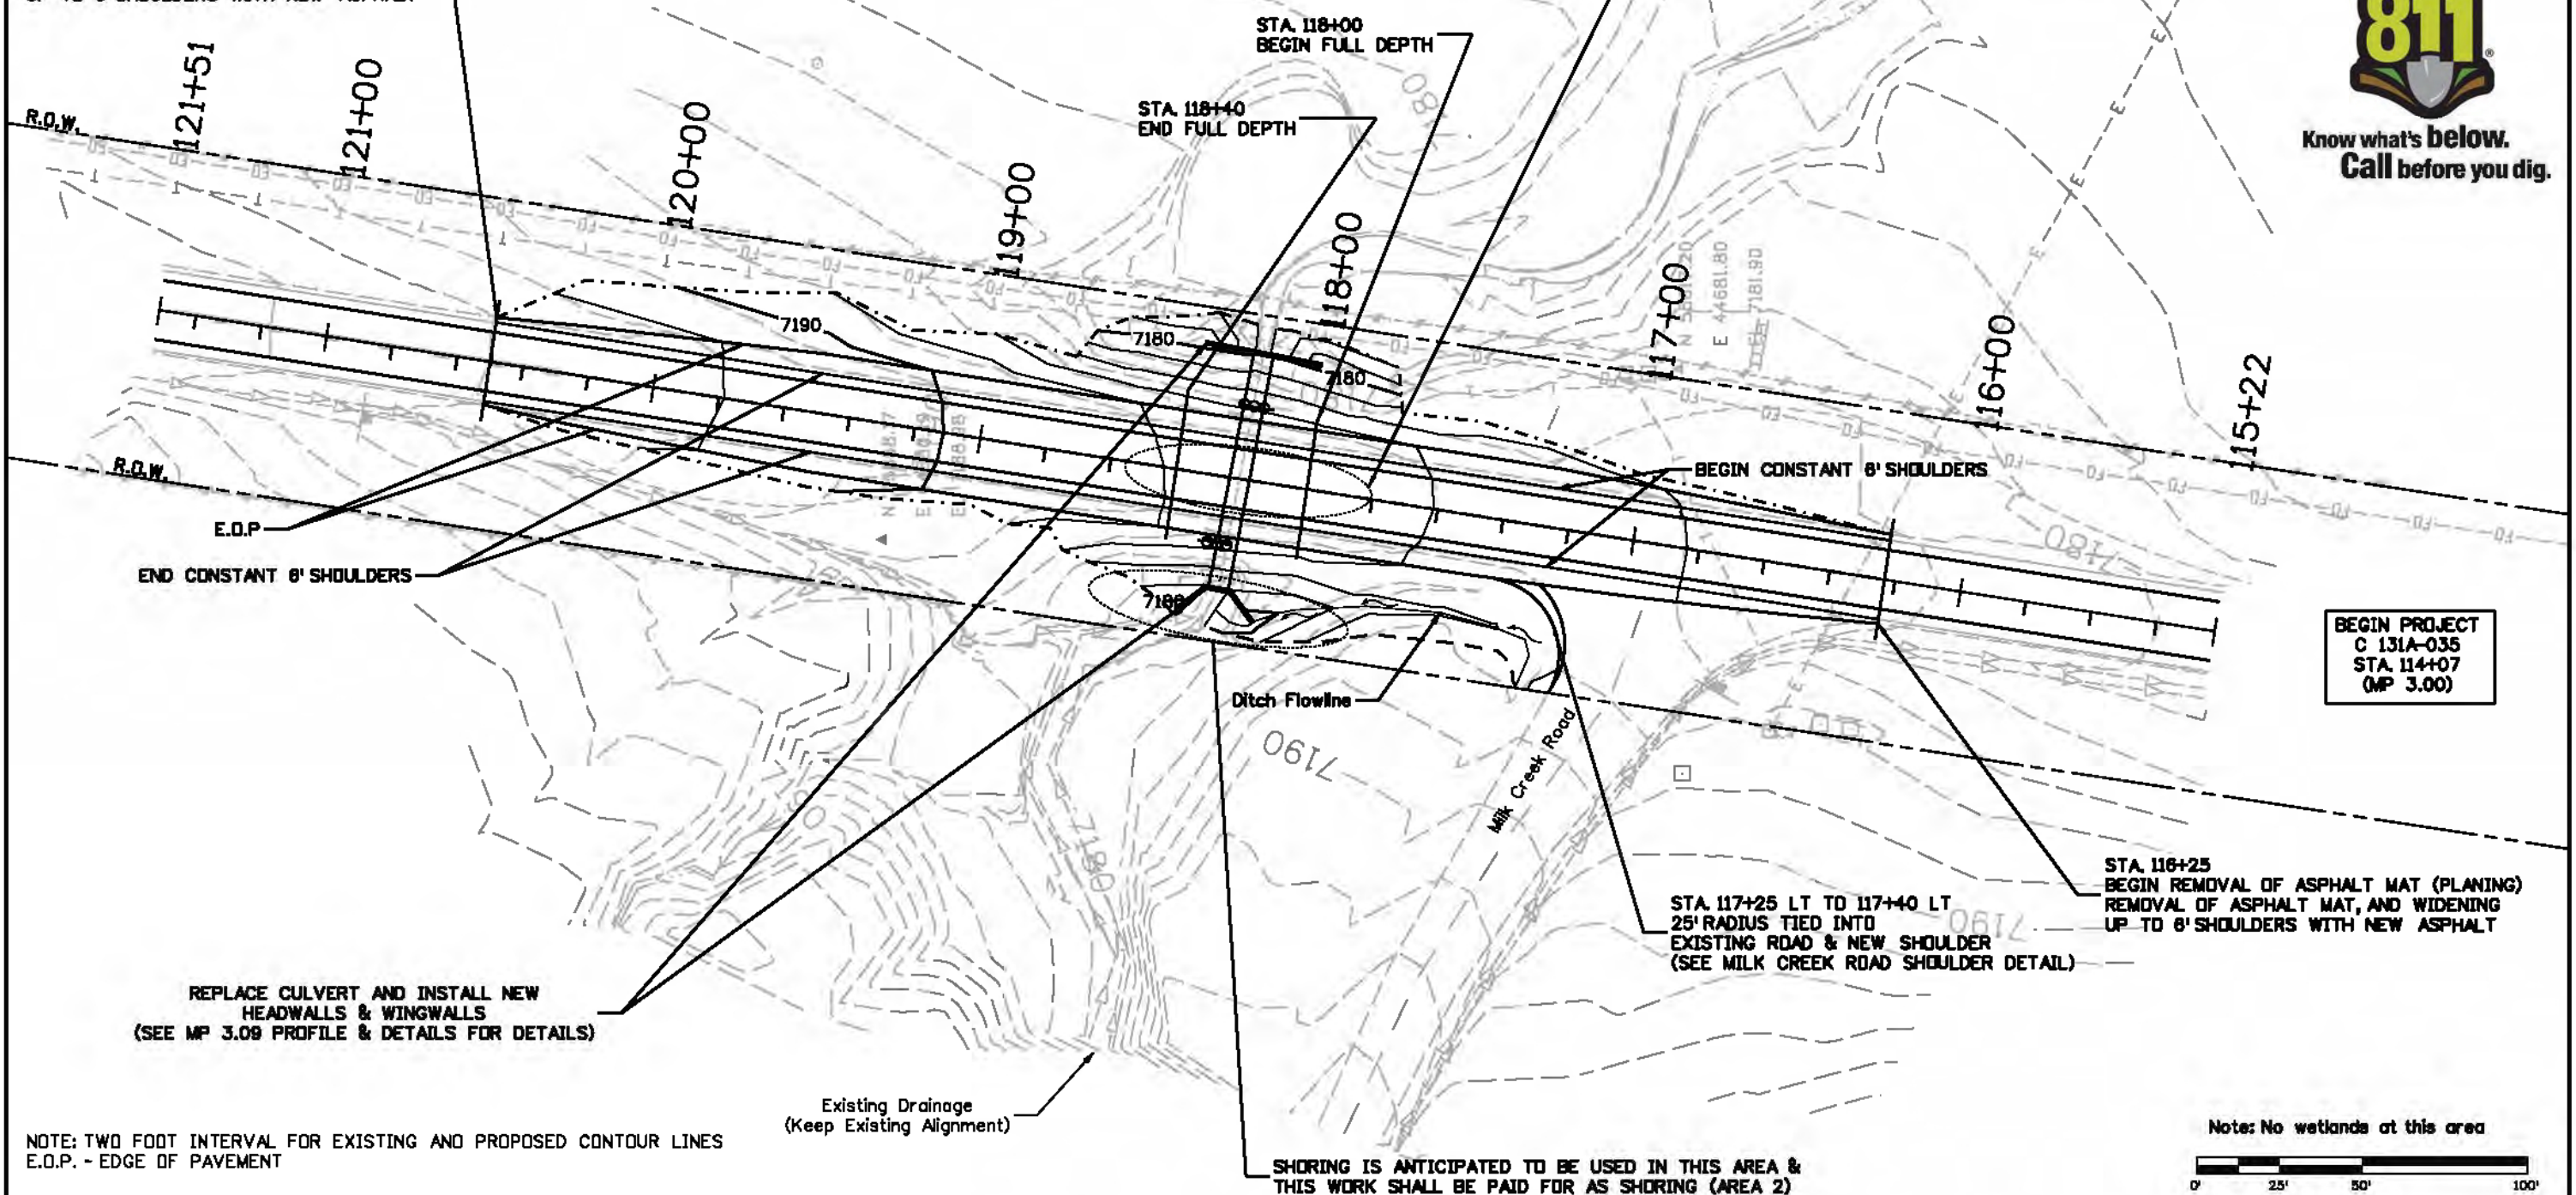

BEGIN PROJECT  
C 131A-035  
STA 114+07  
(MP 3.00)

REPLACE CULVERT AND INSTALL NEW  
HEADWALLS & WINGWALLS  
(SEE MP 3.09 PROFILE & DETAILS FOR DETAILS)

STA 117+25 LT TO 117+40 LT  
25' RADIUS TIED INTO  
EXISTING ROAD & NEW SHOULDER  
(SEE MILK CREEK ROAD SHOULDER DETAIL)

STA 118+25  
BEGIN REMOVAL OF ASPHALT MAT (PLANING)  
REMOVAL OF ASPHALT MAT, AND WIDENING  
UP TO 6' SHOULDERS WITH NEW ASPHALT

NOTE: TWO FOOT INTERVAL FOR EXISTING AND PROPOSED CONTOUR LINES  
E.O.P. - EDGE OF PAVEMENT

Existing Drainage  
(Keep Existing Alignment)



SHORING IS ANTICIPATED TO BE USED IN THIS AREA &  
THIS WORK SHALL BE PAID FOR AS SHORING (AREA 2)

Note: No wetlands at this area

0' 25' 50' 100'

Print Date: 3/1/2013		<div></div> <div></div> <div></div> <div></div> <div></div>	Sheet Revisions			Colorado Department of Transportation <div>714 Grand Ave. Eagle, CO 81631 Phone: (970) 328-9962 FAX: (970) 328-2368 Region 03</div>		As Constructed		MP 3.09 PLAN			Project No./Code		
File Name: 1886IDES_Plan001_NDGR.dgn			Date:	Comments	Init.			No Revisions: 12/23/13					C 131A-D35		
Horiz. Scale: 1:50			Vert. Scale: N/A					Revised:		Designer: J. Klish	Structure	MP 3.09		1886f <sup>R</sup>	
Unit Information: GJ Design			JSL					Void:		Detailer: J. Klish	Numbers	131B003090		Sheet Number 25	
										Subset: MP 3.09	Subset Sheets: 1 of 2				



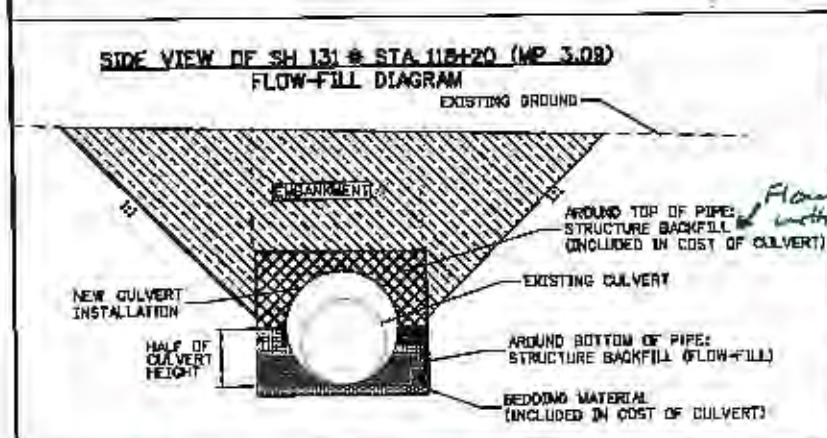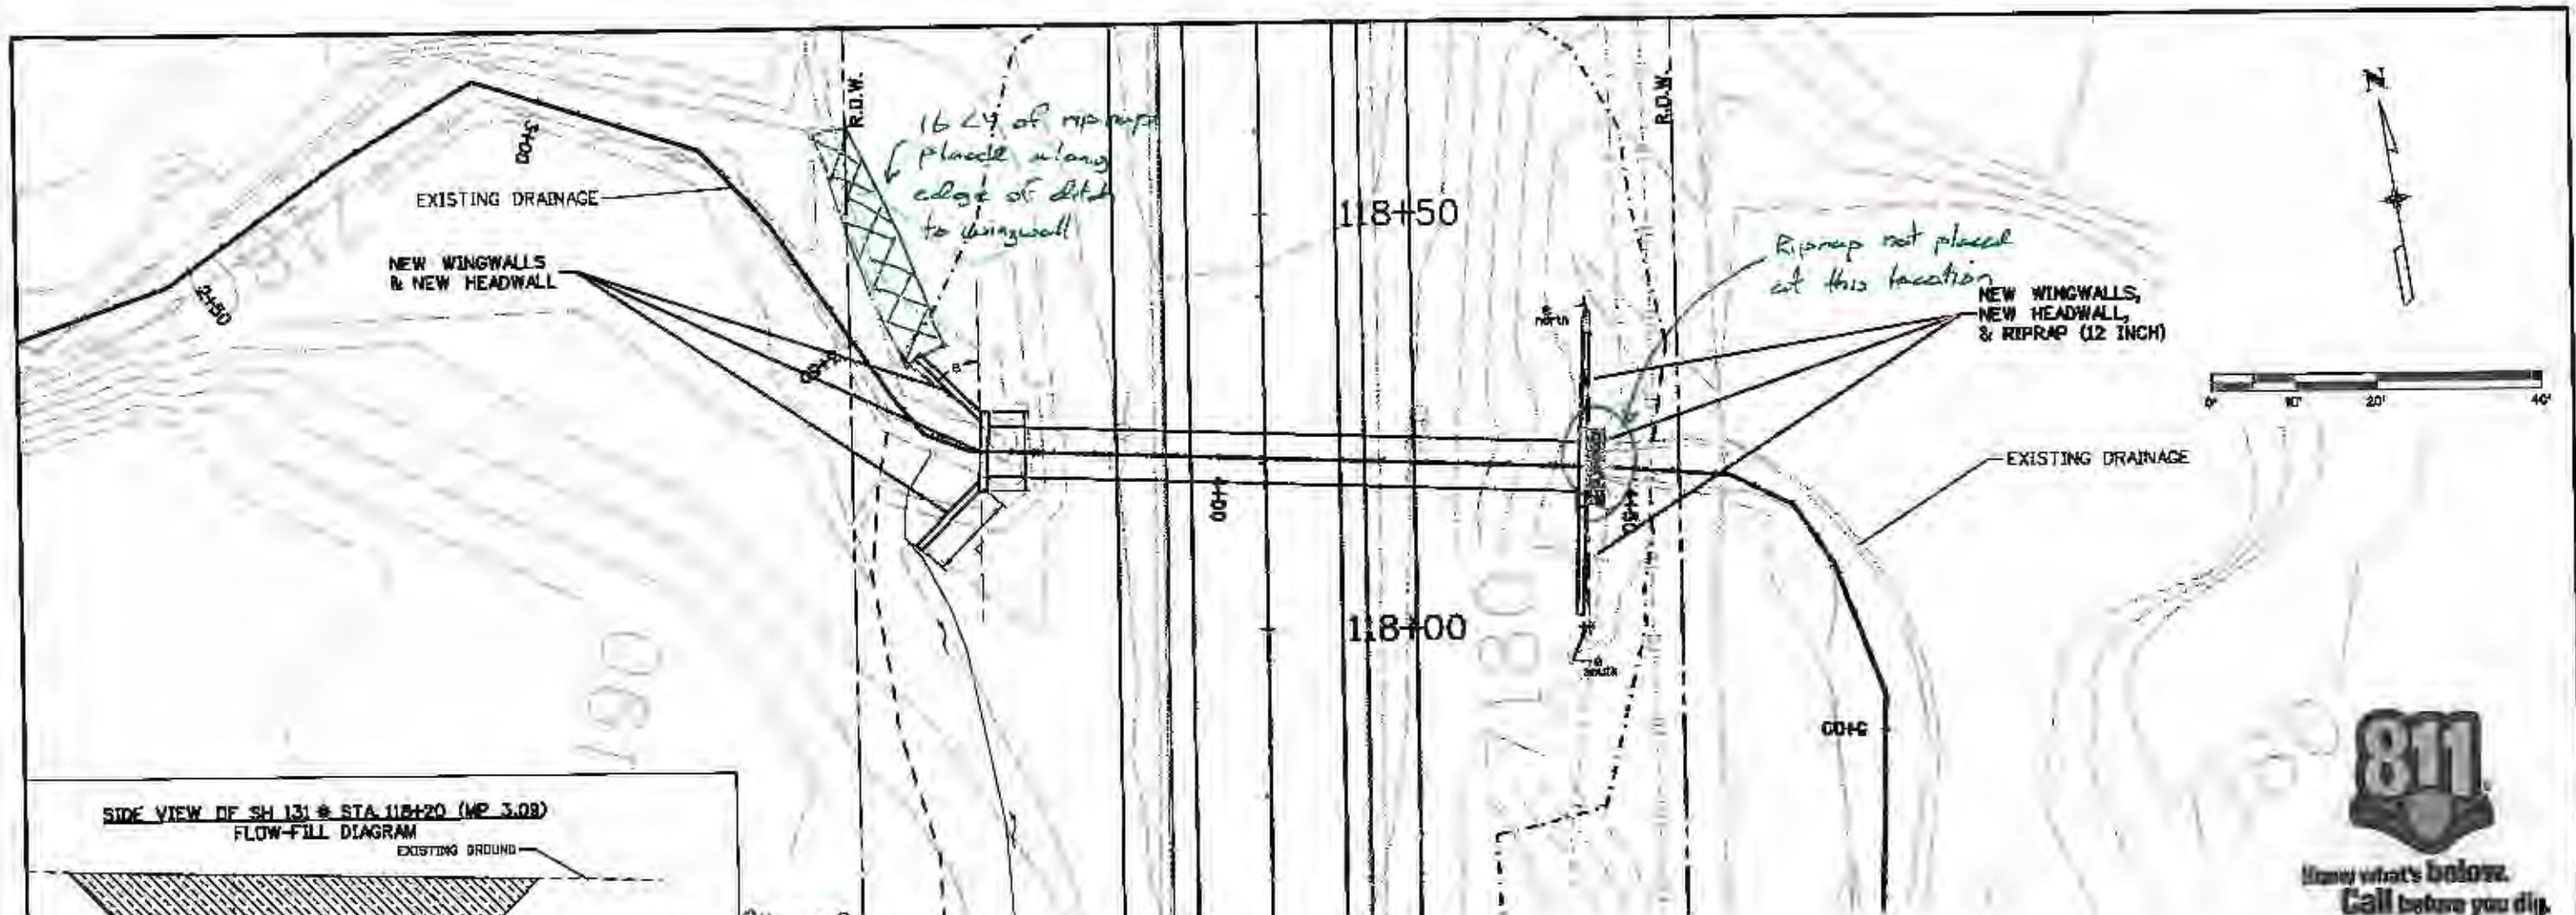

# Fillings used as embankment from top of flowfill to bottom of class 6 ABC

#### Left Wingwall (West side)

Code	Value	Units
Ba	60 inches	
m	80 inches	
k	4 feet	
L	10 feet	
e	45 degrees	
X	9.5 feet	


Hydraulic Data  
 O.A. = 1.25 sq. mi.  
 Q25 = 50 cfs  
 AHW = 7181.0'  
 DHW = 7178.2'  
 HW = 7179.7'

SH 131 @ STA 118+20 (MP 3.09)  
 REMOVAL OF PIPE 72 LF (EXISTING 84" CLP)  
 REQ'D 74 LF 80 INCH DRAINAGE PIPE  
 (CLASS 9) (COMPLETE IN PLACE) max n value = 0.013  
 REQ'D 48 CY STRUCTURE BACKFILL (FLOW-FILL)  
 REQ'D 17.7 CY CONCRETE CLASS B (WALL)  
 REQ'D 1152 LBS REINFORCING STEEL  
 REQ'D 30 CY STRUCTURE BACKFILL (CLASS 1)  
 AT HEADWALLS AND WINGWALLS  
 REQ'D 2 CY RIPRAP (12 INCH)  
 INV=7178.00 @ UN-NAMED DRAINAGE STA 3+70.98  
 INV=7173.50 @ UN-NAMED DRAINAGE STA 4+44.50

#### Right Wingwall (East side)

Code	Value	Units
Ba	60 inches	
m	80 inches	
k	7.5 feet	
L	13 feet	
e	2 degrees	
X	9.5 feet	

NOTES:  
 1) REFER TO M&S STANDARDS  
 M-601-20 FOR THE CODING OF  
 THE WINGWALL DIMENSIONS.

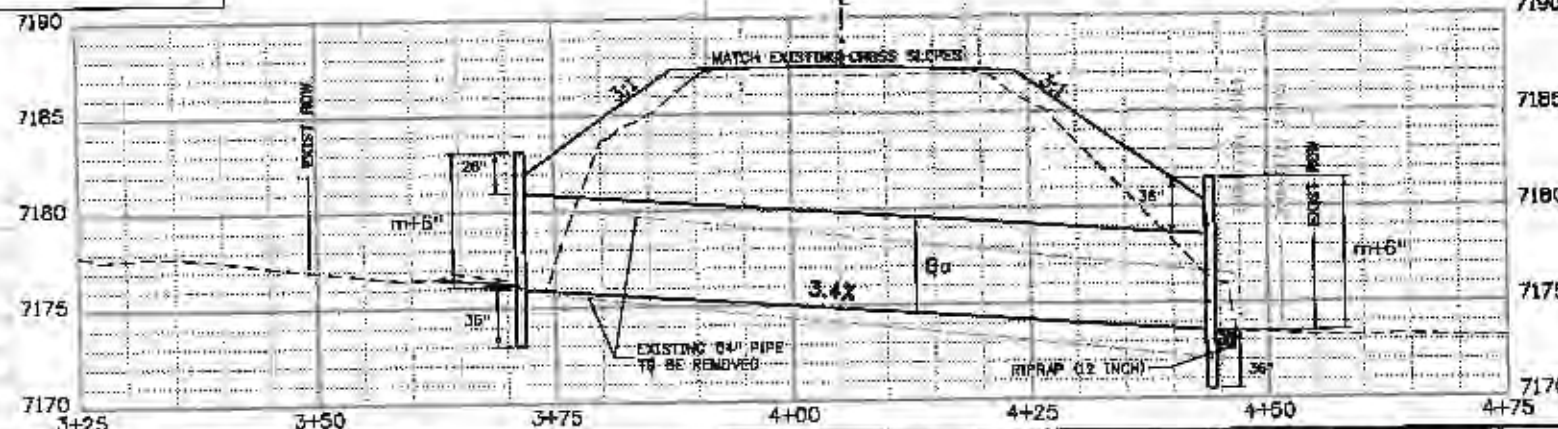

Print Date: 4/24/2013

File Name: 18661DES\_StructureDETAIL001.dgn

Horiz. Scale: 1:20

Vert. Scale: As Noted

Unit Information: GJ Design

JSL

#### Sheet Revisions

Date:	Comments	Init.

Colorado Department of Transportation



714 Grand Ave.  
 Eagle, CO 81631  
 Phone: (970) 328-9962 FAX: (970) 328-2368

Region 03

PJL

#### As Constructed

No Revisions:

Revised: 12/23/13

Void:

#### MP 3.09 PROFILE & DETAILS

Designers:	J. Kish	Structure	MP 3.09
Detailer:	J. Kish	Numbers	1318003090
Subset:	MP 3.09	Subset Sheets:	2 of 2

#### Project No./Code

C 131A-035

18661R

Sheet Number 26




NOTE: TWO FOOT INTERVAL FOR EXISTING CONTOUR LINES

CULVERT LINING AND INSTALL NEW HEADWALL  
(SEE MP 5.13 PROFILE & DETAILS FOR DETAILS)

EXISTING WETLANDS



Know what's below.  
Call before you dig.

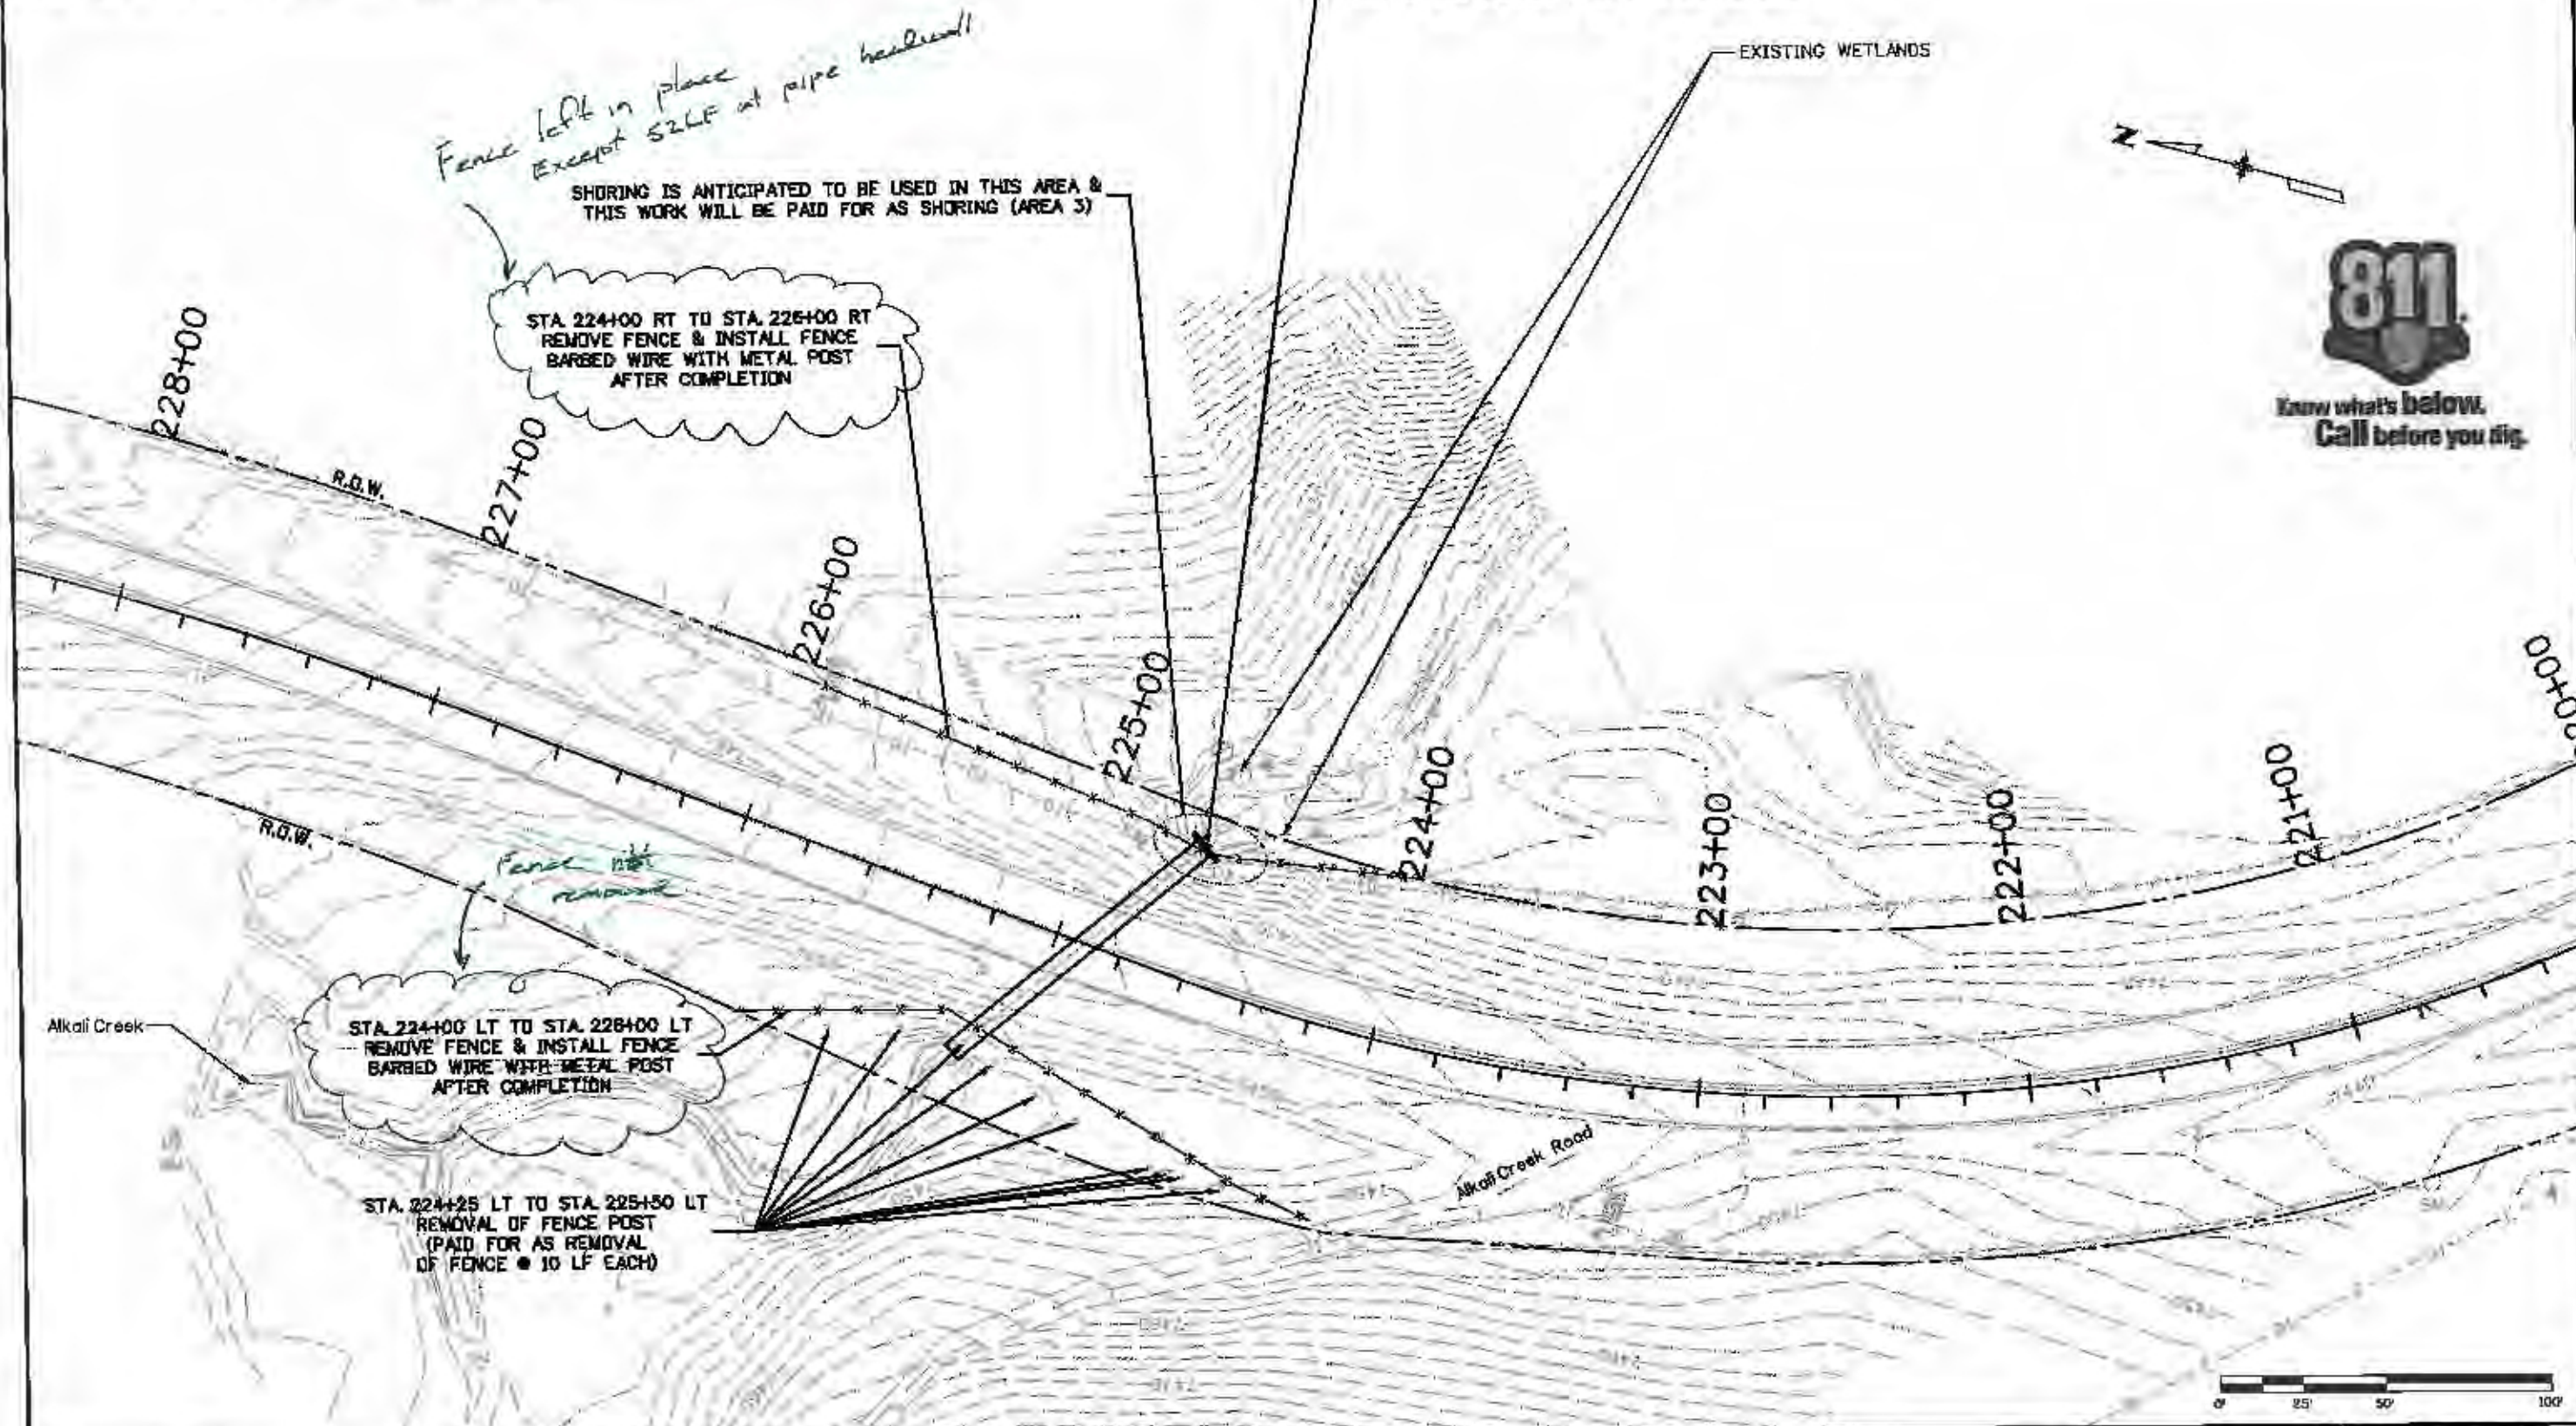

Print Date: 3/1/2013

File Name: 18861DES\_Plan002\_NDGR.dgn

Horiz. Scale: 1:50

Vert. Scale: N/A

Unit Information: GJ Design

JSL

# Sheet Revisions

Date:	Comments	Init.

## Colorado Department of Transportation



714 Grand Ave.  
Eagle, CO 81631  
Phone: (970) 328-9962 FAX: (970) 328-2388

Region 03

PJL

## As Constructed

No Revisions:

Revised: 12/23/13

Void:

## MP 5.13 PLAN

Designer:	J. Klish	Structure	MP 5.13
Detaller:	J. Klish	Numbers	1318005130
Subset:	MP 5.13	Subset Sheets:	1 of 3


## Project No./Code

C 131A-Q35


18861R

Sheet Number 27



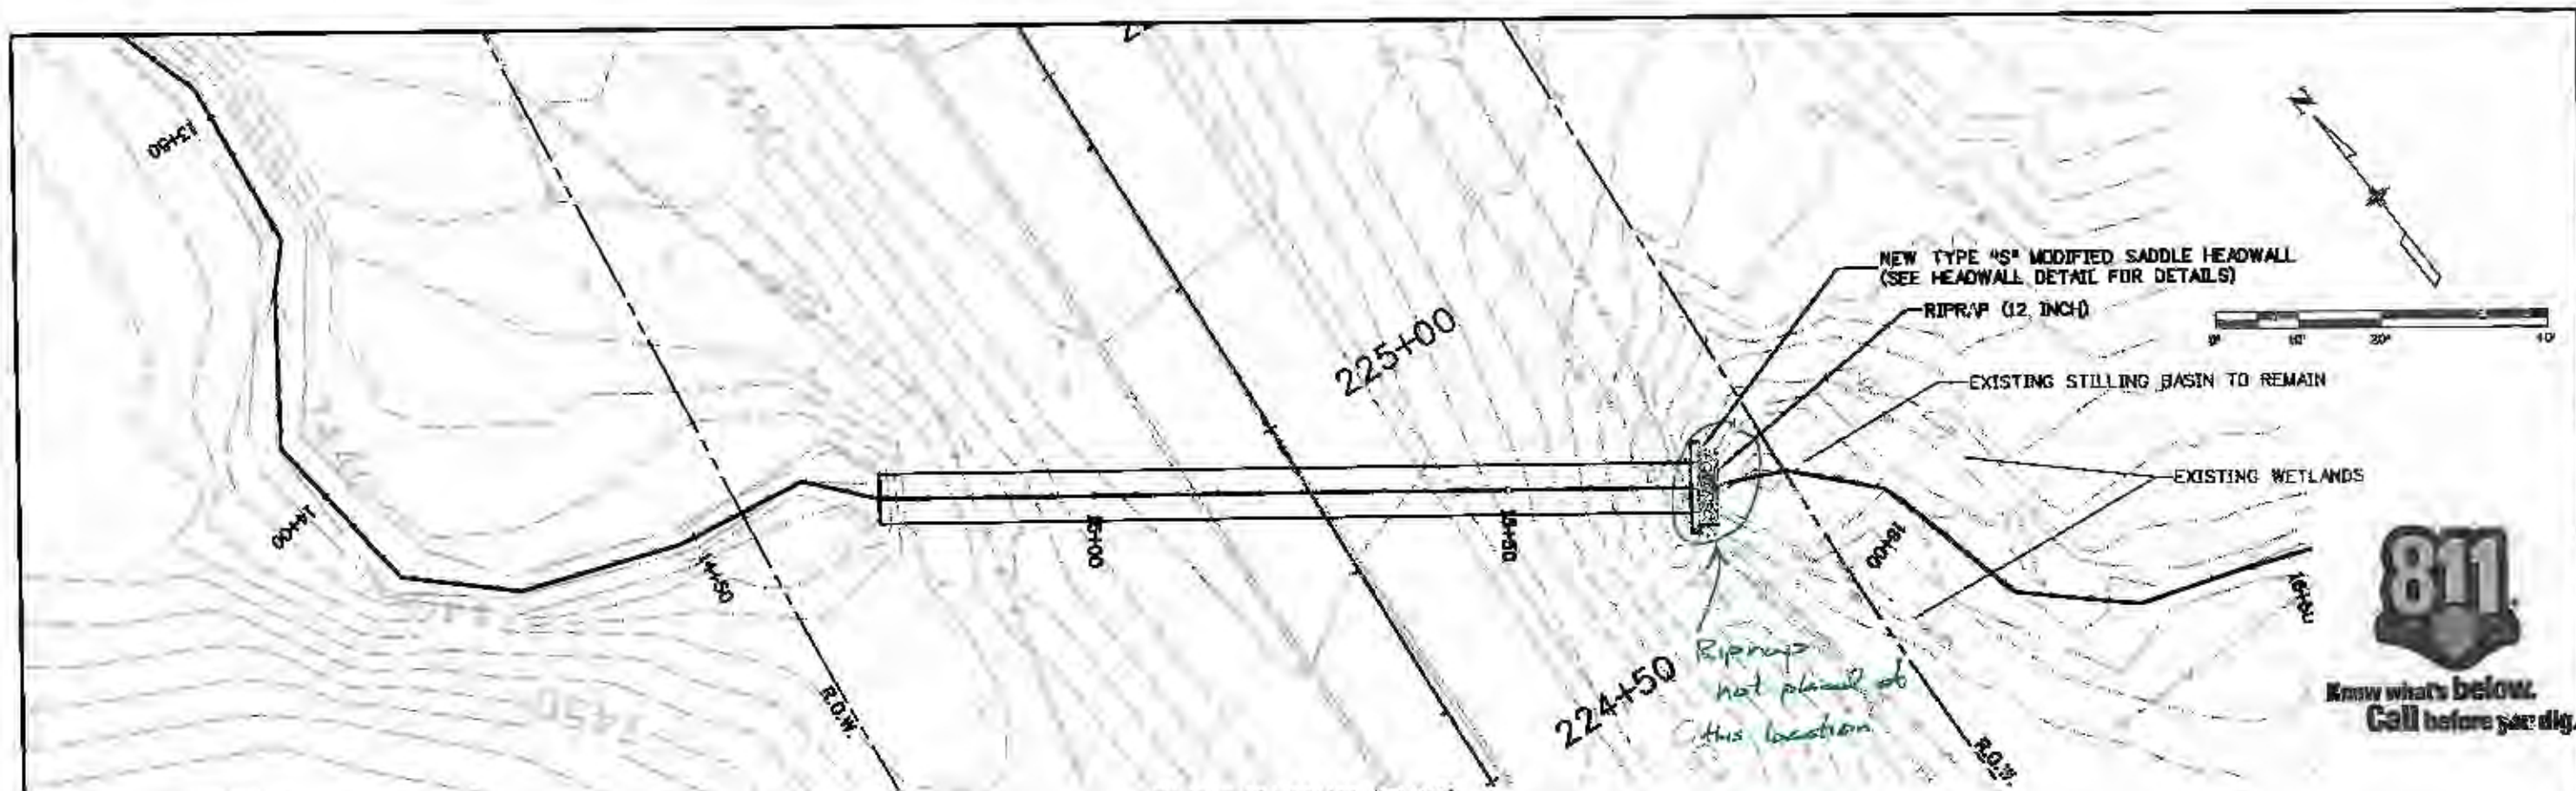

SH 131 @ STA 224+80 (27.513)  
 REQ'D 50 CF CEMENT CREUT  
 REQ'D 100 LF CULVERT LINING (72 INCH) (SPECIAL)  
 REQ'D 4.4 CY CONCRETE CLASS B (W/LL)  
 REQ'D 293 LBS REINFORCING STEEL  
 REQ'D 10 CY STRUCTURE BACKFILL (CLASS 1)  
 AT HEADWALLS AND WINGWALLS  
 REQ'D 2 CY RIPRAP (12 INCH)  
 INVIn=7435.8' @ ALKALI CREEK STA 14+74.01  
 INVout=7432.4' @ ALKALI CREEK STA 15+73.31

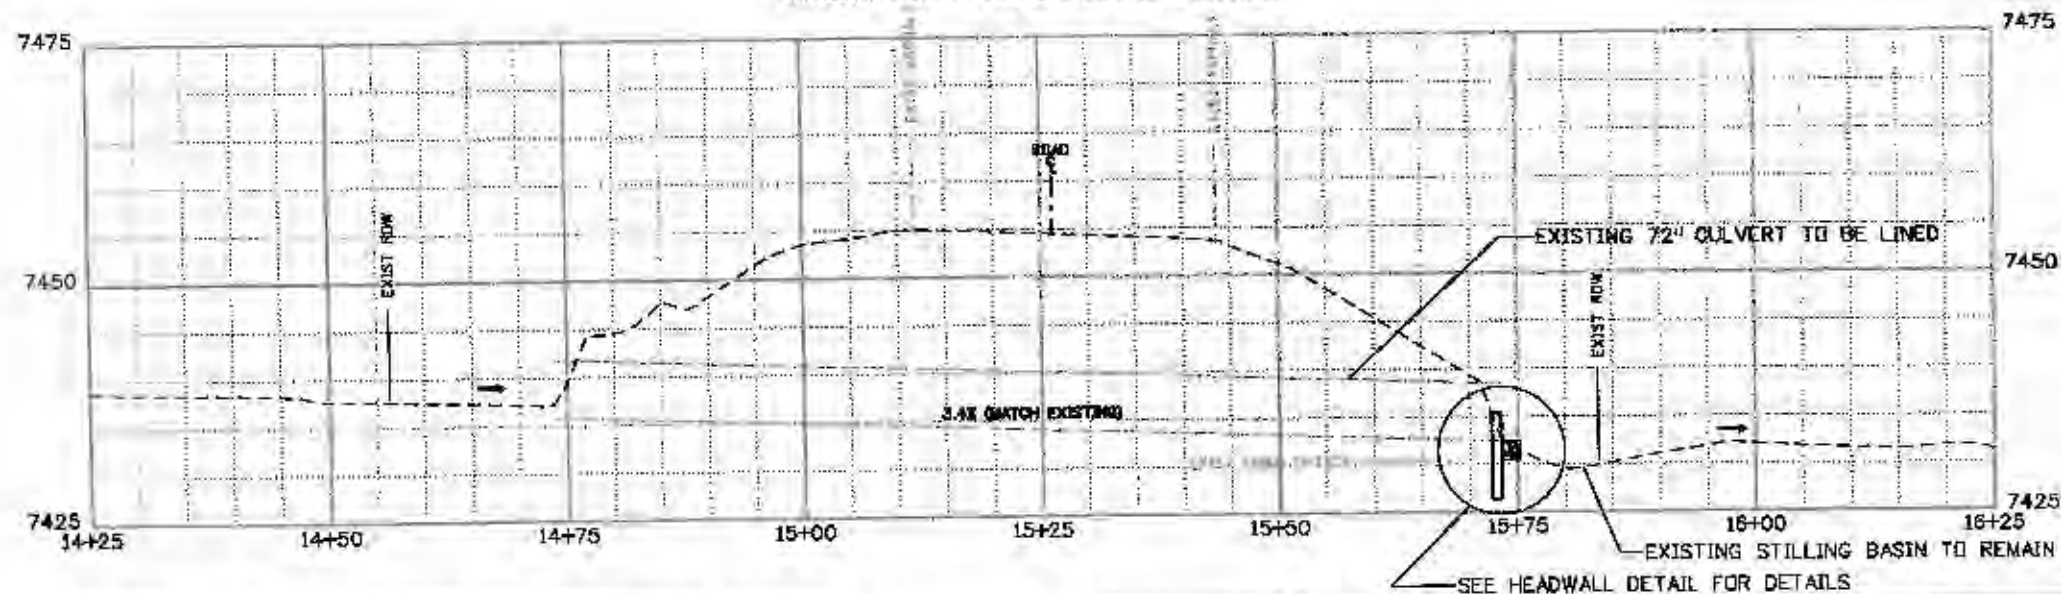

Hydraulic Data:  
 D.A = 23.1 sq. mi.  
 Q25 = 540 cfs  
 AHW = 7442.0'  
 OHW = 7451.6'  
 HW = Overtopping

Print Date: 4/22/2013  
 File Name: 18861DES-StructureDETAIL002.dgn  
 Horiz. Scale: 1:20 Vert. Scale: As Noted  
 Unit Information: GJ Design JSL

Sheet Revisions		
Date:	Comments	Init.

Colorado Department of Transportation  
  
 714 Grand Ave.  
 Eagle, CO 81631  
 Phone: (970) 328-8962 FAX: (970) 328-2368  
 Region 03 PJL

As Constructed  
 No Revisions:  
 Revised: 12/23/13  
 Void:



### MP 5.13 PROFILE & DETAILS

Designer: J. Klish  
 Detailer: J. Klish  
 Subset: MP 5.13  
 Structure Numbers: MP 5.13  
 131B005130  
 Subset Sheets: 2 of 3

Project No./Code  
 C 131A-035  
 18861R  
 Sheet Number 28



File Name: C:\Program Files\Internet Explorer\Internet Explorer.exe

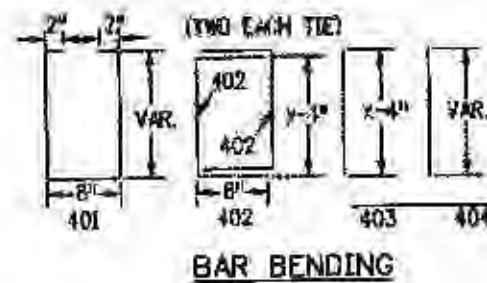
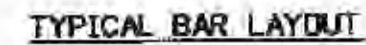
0000

Colorado Department of Transportation  
 714 Grand Ave.  
 Eagle, CO 81631  
 Phone: (970) 328-9962 FAX: (970) 328-2366  
 Region 03 P.J.L.

MP 5.13 DETAILS			
Designer:	J. Klish	Structure	MP 5.13
Detailer:	J. Klish	Numbers	131B005130
Subject:	MP 5.13	Sheet	3 of 3

Project No./Code	
C 131A-03S	
18861R	
Sheet Number	29



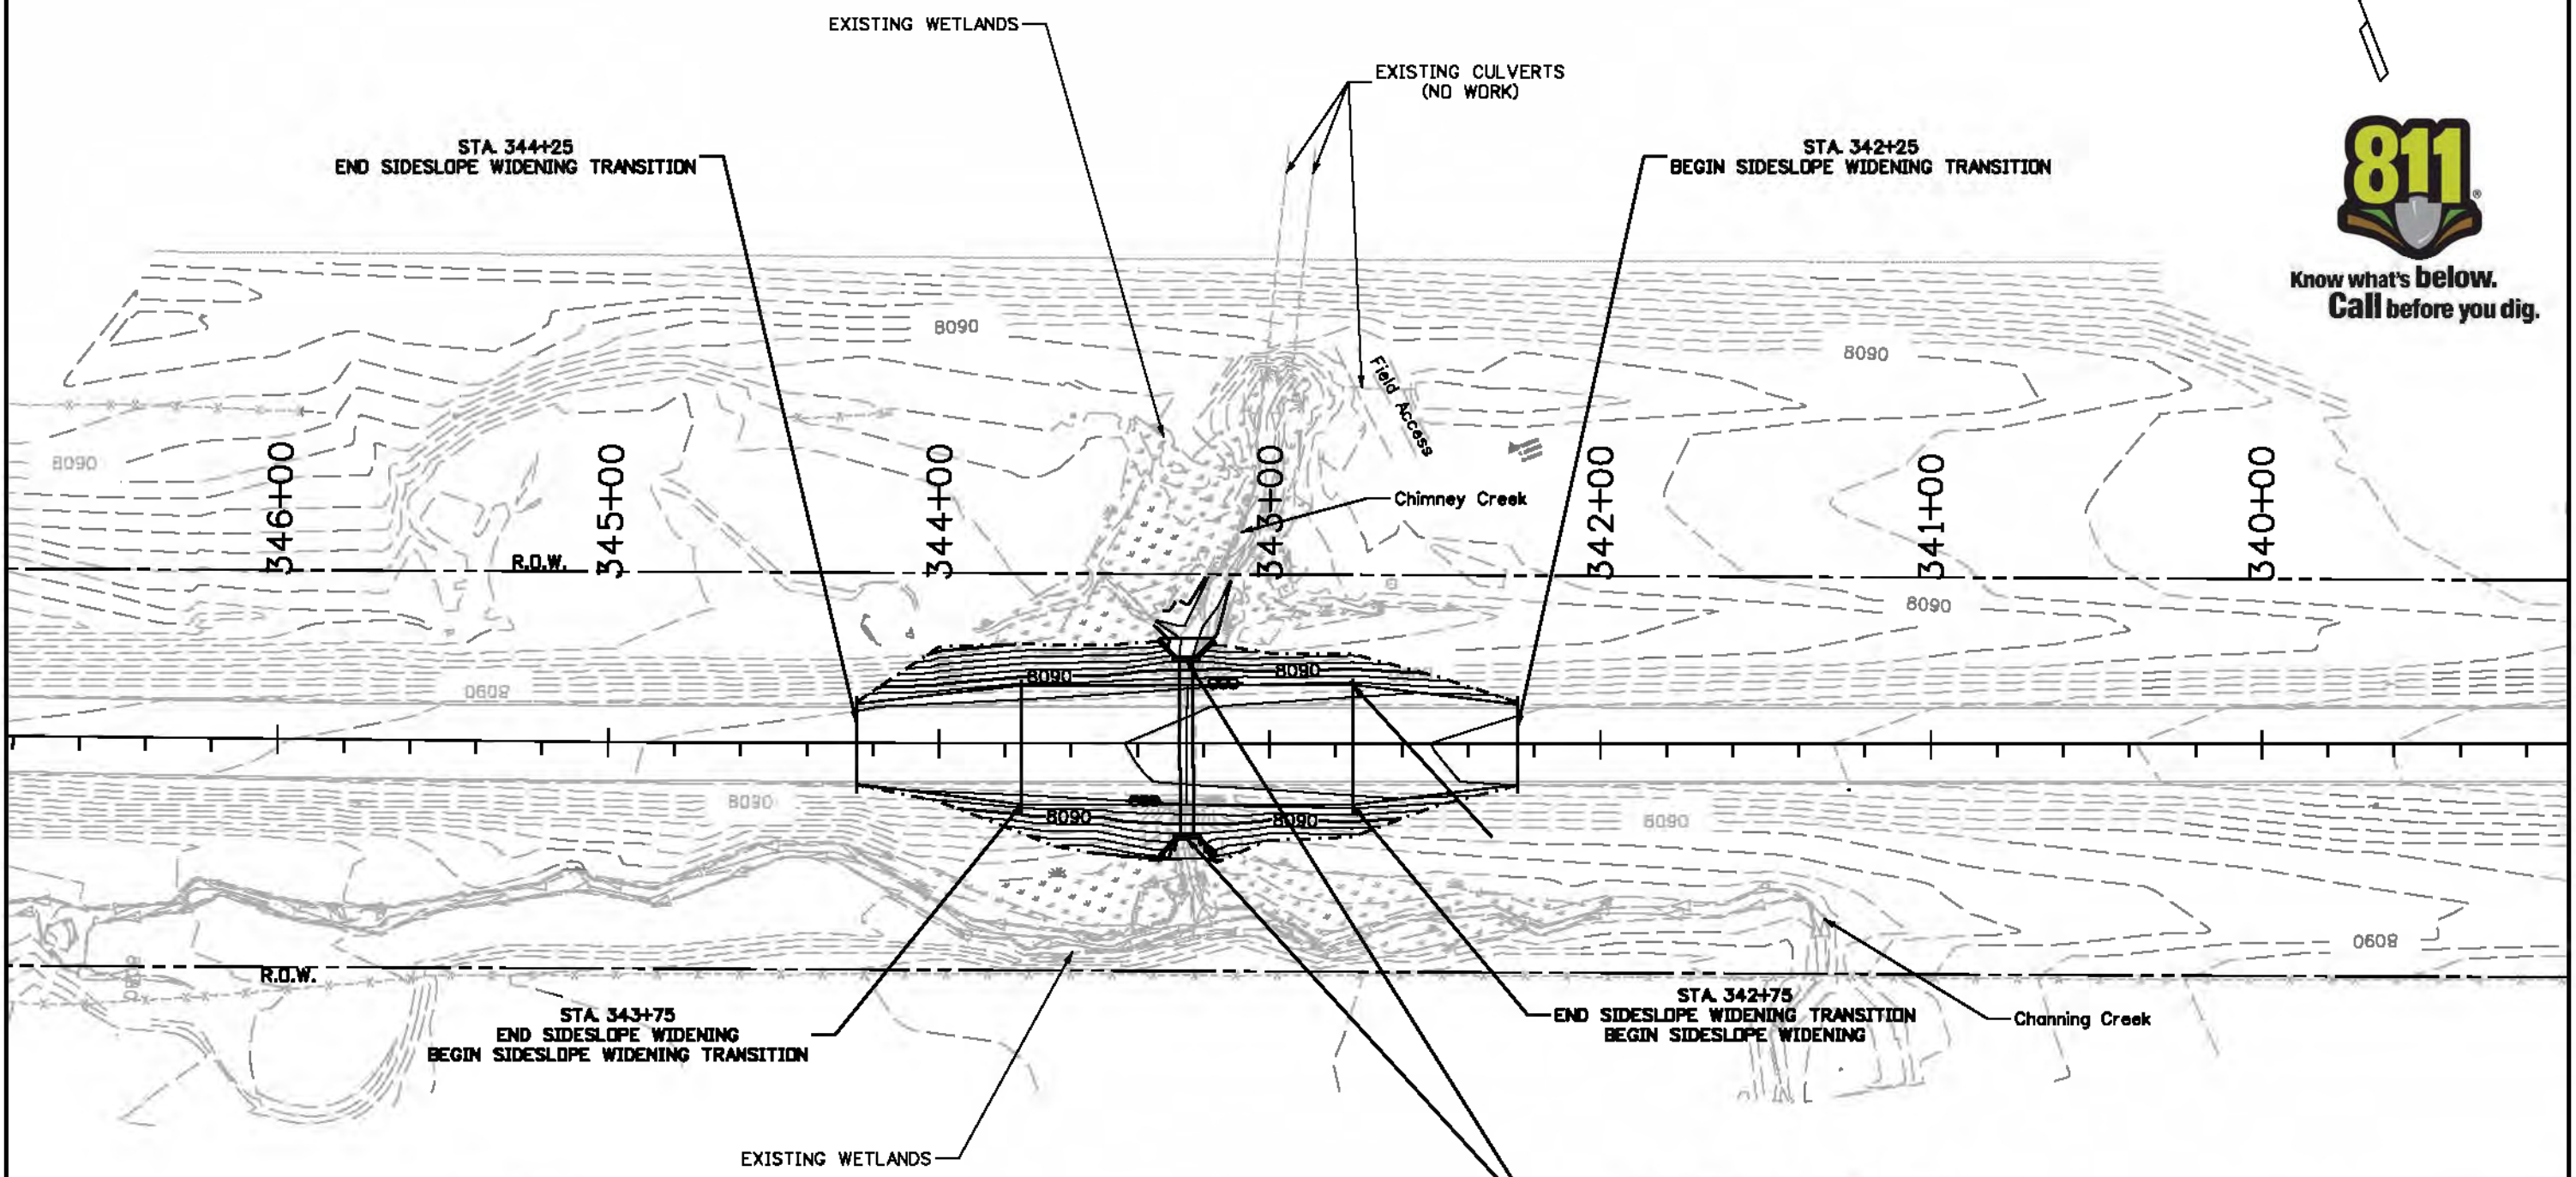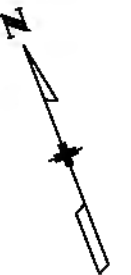

NOTE: ONE FOOT INTERVAL FOR EXISTING AND PROPOSED CONTOUR LINES  
P.O.S.S. - POINT OF SLOPE SELECTION  
E.O.P. - EDGE OF PAVEMENT

CULVERT LINING, ANNULAR GROUTING,  
NEW HEADWALLS & WINGWALLS  
(SEE MP 36.42 PROFILE & DETAILS FOR DETAILS)



Print Date: 3/1/2013	
File Name: 18861DES_Plan003_NDGR.dgn	
Horiz. Scale: 1:50	Vert. Scale: N/A
Unit Information: GJ Design JSL	

Sheet Revisions		
Date:	Comments	Init.



**Colorado Department of Transportation**  
714 Grand Ave.  
Eagle, CO 81631  
Phone: (970) 328-9962 FAX: (970) 328-2368  
**Region 03**

**PJL**



As Constructed	
No Revisions:	12/23/13
Revised:	
Void:	

MP 36.42 PLAN			
Designer:	J. Klish	Structure Numbers	MP 36.42
Detailer:	J. Klish		131B036420
Subaet:	MP 36.42	Subset Sheets: 1 of 2	

Project No./Code	
C 131A-D35	
1886R	
Sheet Number	30

k:\proj\18861DES\_Plan003\_NDGR.dgn 2:47:28 PM c:\project\18861DES\_Plan003\_NDGR.dgn



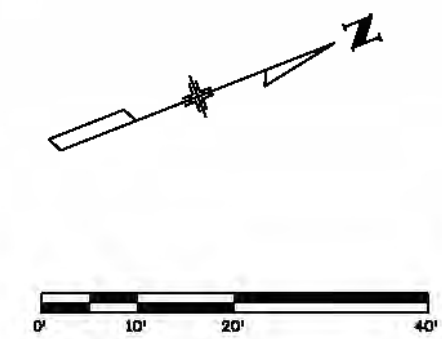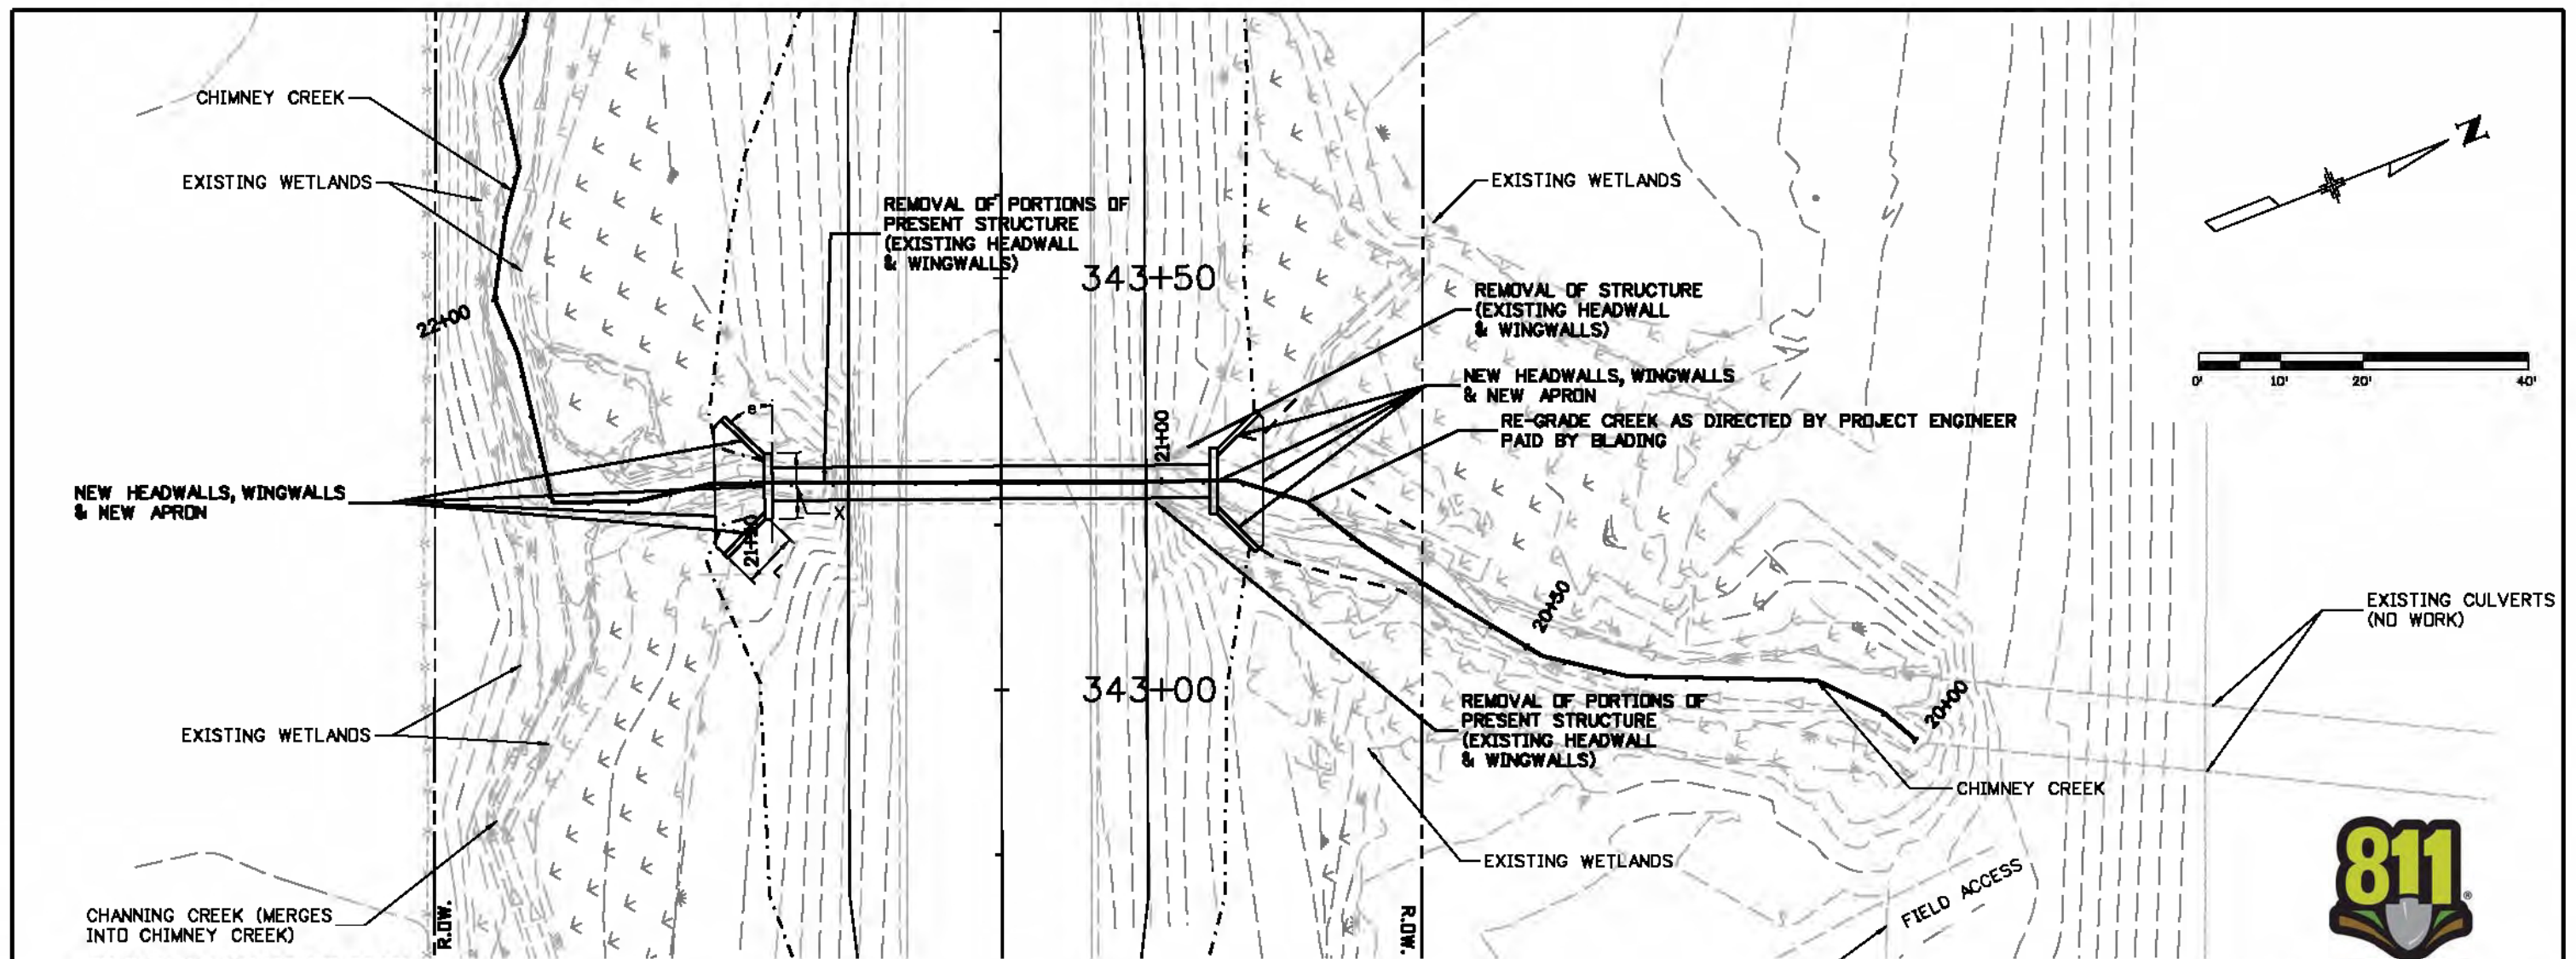


SH 131 @ STA 343+25 (MP 36.42)  
REMOVAL OF PORTIONS OF PRESENT  
STRUCTURE - 2 EACH  
REQ'D 50 CF CEMENT GROUT  
REQ'D 56 LF CULVERT LINING (42 INCH)  
NOMINAL OUTER DIAMETER = 42";  
NOMINAL (MAXIMUM) WALL THICKNESS = 1.30"  
REQ'D 10 CY ANNULAR SPACE GROUTING  
REQ'D 11.7 CY CONCRETE CLASS B (WALL)  
REQ'D 921 LBS REINFORCING STEEL  
REQ'D 15 CY STRUCTURE BACKFILL (CLASS 1)  
AT HEADWALLS AND WINGWALLS  
INVin=8083.5 @ CHIMNEY CREEK STA 20+93.25  
INVout=8083.1 @ CHIMNEY CREEK STA 21+48.40

Hydraulic Data:  
D.A. = 5.7 sq. mi.  
Q25 = 90 cfs  
AHW = 8089.0'  
DHW = 8088.6'  
HW = 8091.0'

Left Wingwall (West side)

Code	Value	Units
Ba	42	inches
m	74.5	inches
k	4	feet
L	6.5	feet
e	45	degrees
X	7.5	feet

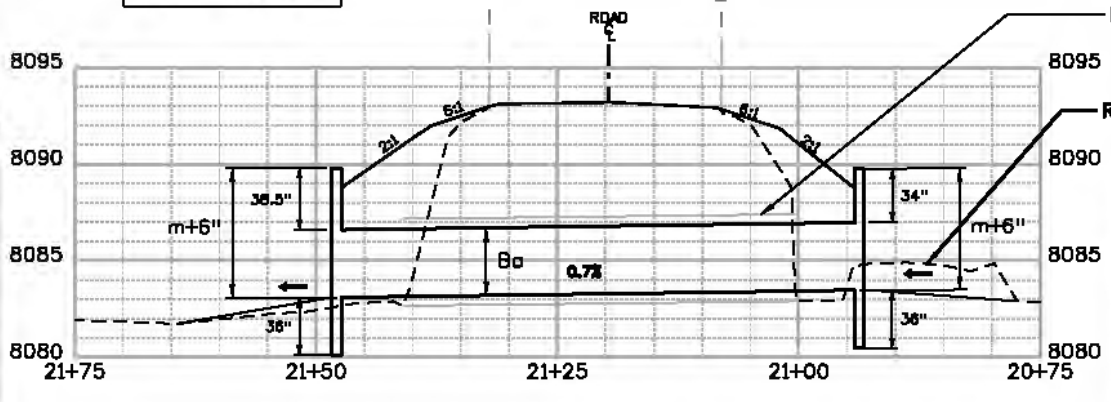

Right Wingwall (East side)


Code	Value	Units
Ba	42	inches
m	70	inches
k	4	feet
L	6.5	feet
e	45	degrees
X	7.5	feet

- NOTES:
- 1) ROW LIMITS ARE OUTSIDE THE PROFILE, REFER TO ABOVE DRAWING FOR ROW LIMIT LOCATIONS.
  - 2) NO UTILITIES WERE FOUND ON THIS SHEET.
  - 3) IMPACTS TO WATER FLOW HERE MAY AFFECT OTHER DOWNSTREAM WORK AREAS. PROCEED WITH CAUTION.
  - 4) REFER TO M&S STANDARDS M-601-20 FOR THE CODING OF THE WINGWALL DIMENSIONS.
  - 5) A PREFABRICATED CONCENTRIC HYDRAULIC REDUCER SHALL BE INSTALLED AT THE INLET END OF THE LINER, FROM THE SAME MANUFACTURER AS THE REMAINDER OF THE PIPE LINER MATERIAL. THE COST OF THE REDUCER WILL BE INCLUDED IN THE COST OF CULVERT LINING.




Print Date: 4/22/2013	Sheet Revisions			Colorado Department of Transportation		As Constructed		MP 36.42 PROFILE & DETAILS		Project No./Code	
File Name: 1886IDES_StructureDETAIL003.dgn	Date:	Comments	Init.	714 Grand Ave. Eagle, CO 81631 Phone: (970) 328-9962 FAX: (970) 328-2368		No Revisions: 12/23/13		Designer: J. Klish		C 131A-035	
Horiz. Scale: 1:20 Vert. Scale: As Noted				Region 03		Revised:		Detailer: J. Klish		1886R	
Unit Information: GJ Design JSL				PJT		Void:		Subset: MP 36.42		Sheet Number 31	
								Structure Numbers 131B036420			
								Subsets: 2 of 2			



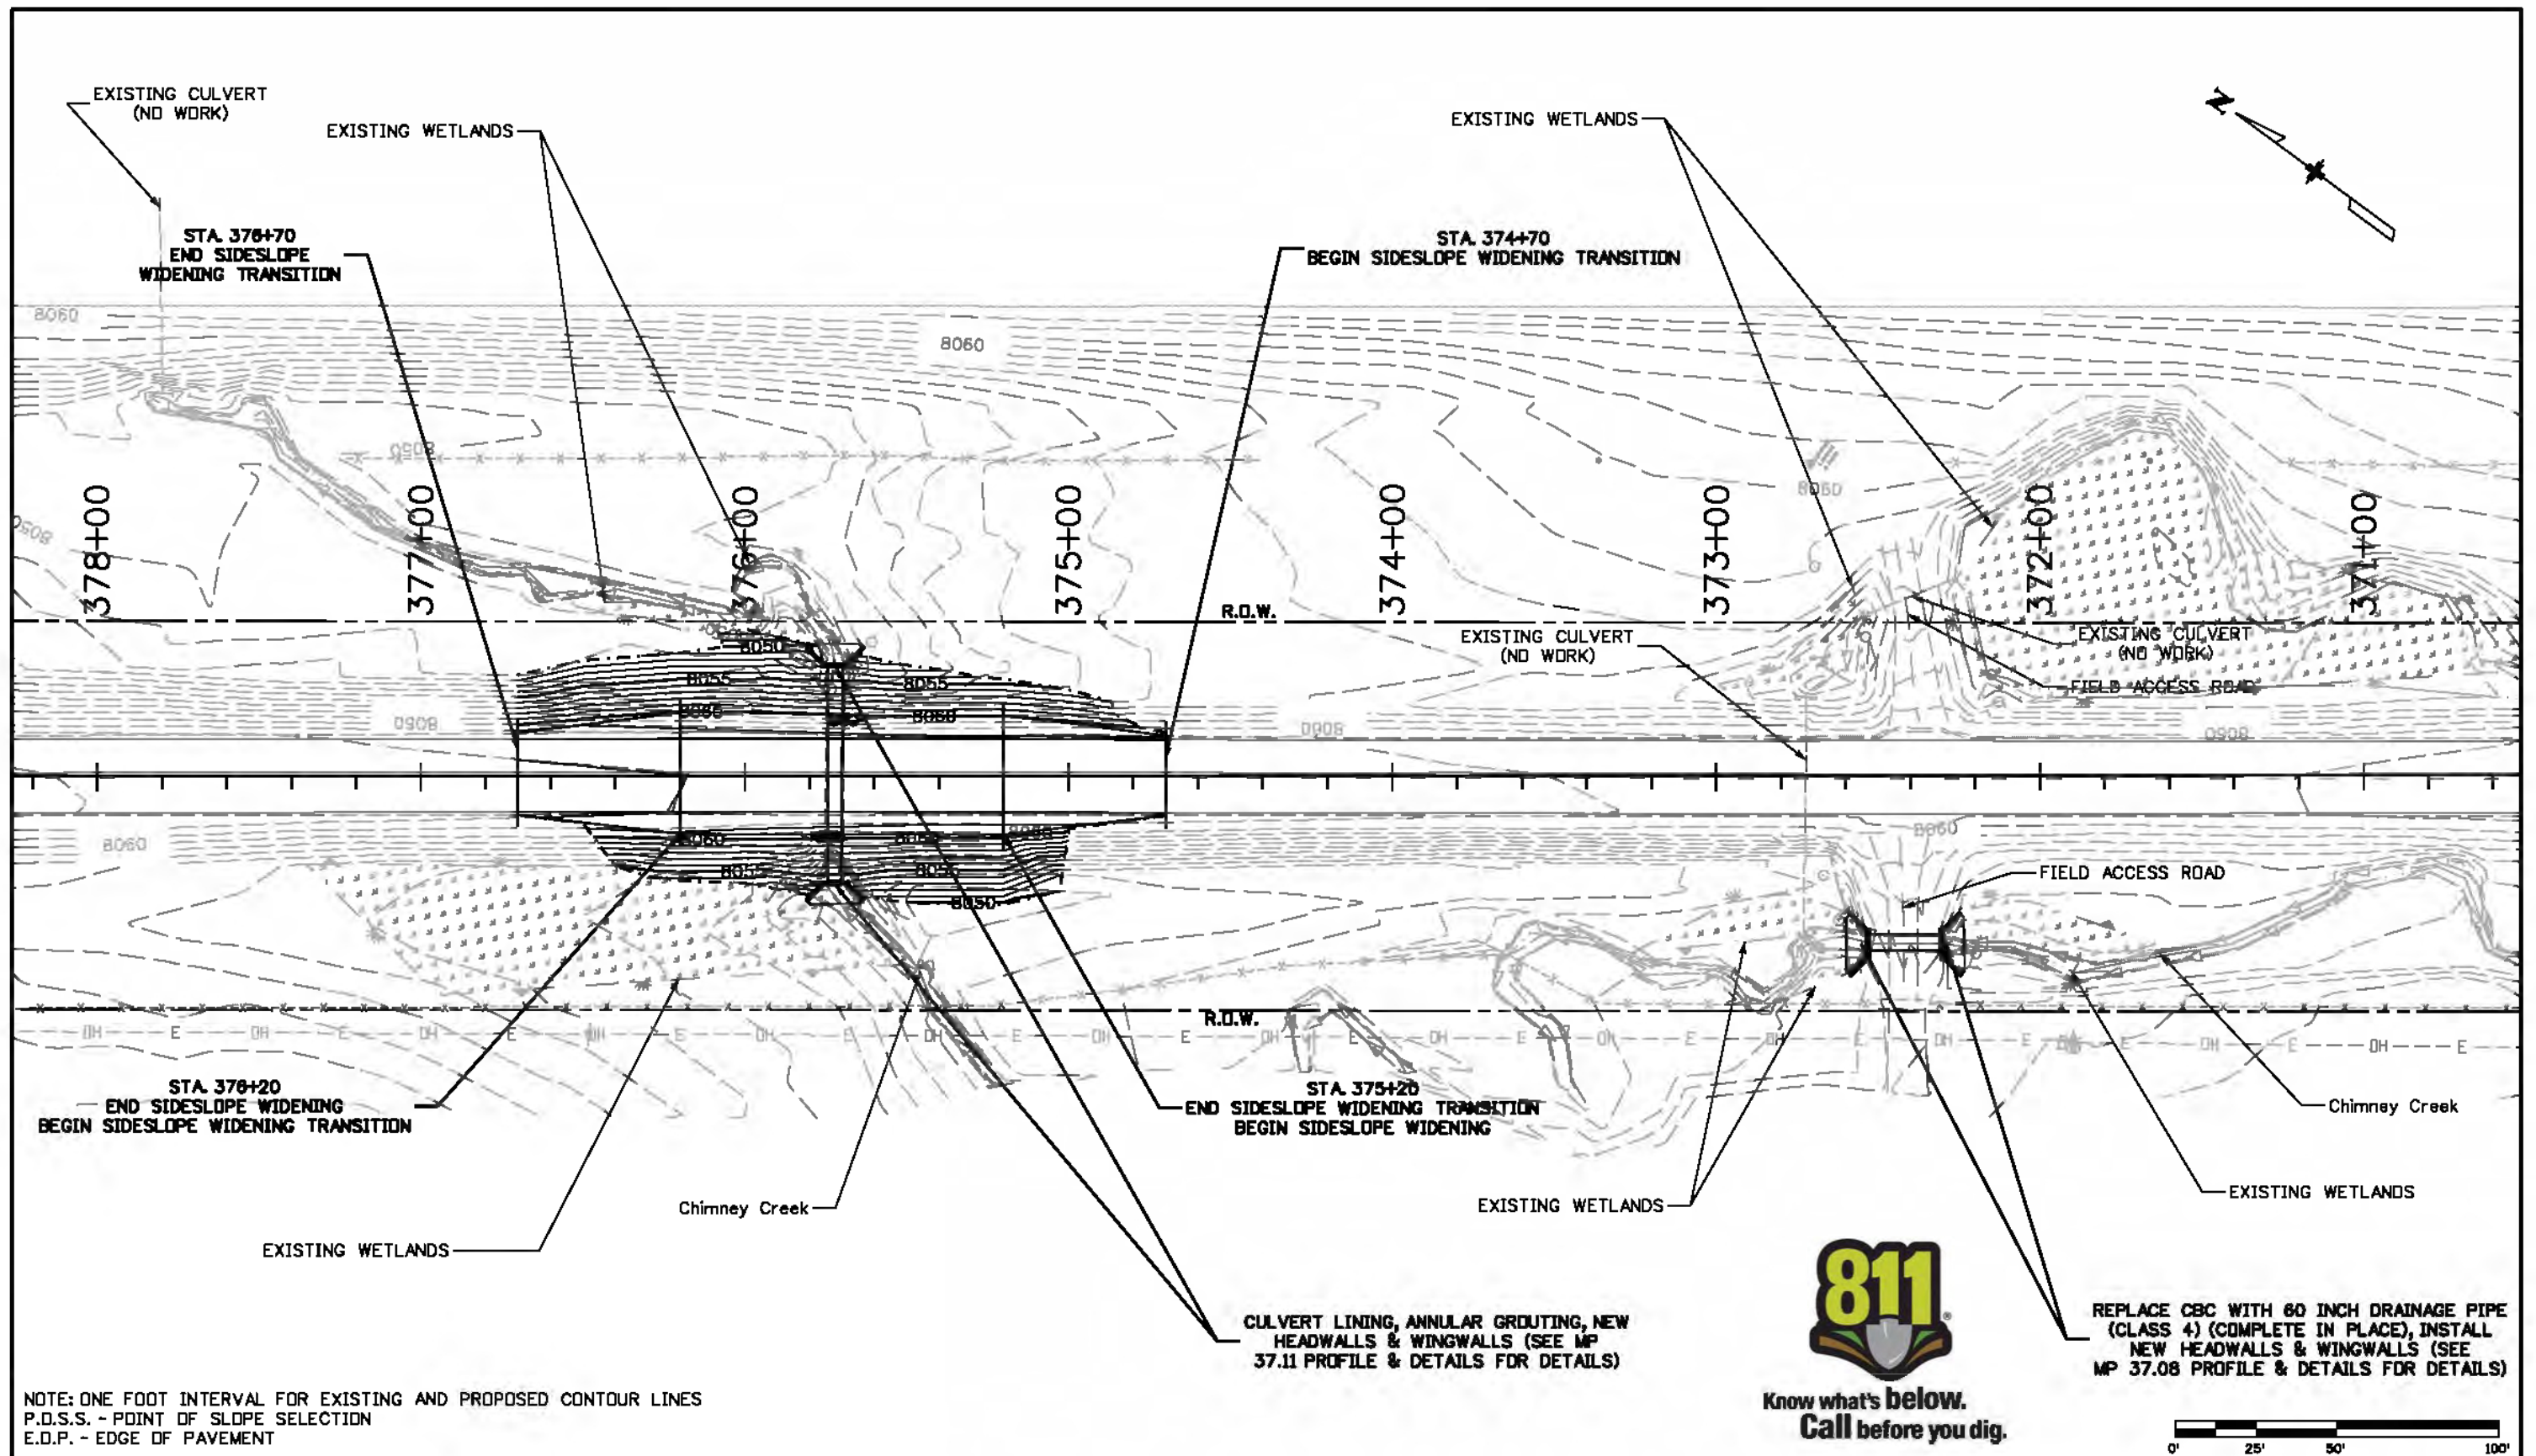

Print Date: 3/1/2013		<div>0000</div>	Sheet Revisions			Colorado Department of Transportation		As Constructed		MP 37.08 & MP 37.11 PLAN			Project No./Code	
File Name: 1886IDES_Plan004&5_NQGR.dgn			Date:	Comments	Init.	<div><div>714 Grand Ave. Eagle, CO 81631 Phone: (970) 328-9962 FAX: (970) 328-2368</div></div> <div>Region 03</div> <div>PJL</div>	No Revisions: 12/23/13		C 131A-035					
Horiz. Scale: 1:50      Vert. Scale: N/A							Revised:		Designer: J. Klish	Structure Numbers	MP 37.11	18861R		
Unit Information: GJ Design      JSL							Void:		Detailer: J. Klish		131B037110			
									Subset: 37.08 & 37.11	Subset Sheets: 1	of 3	Sheet Number 32		



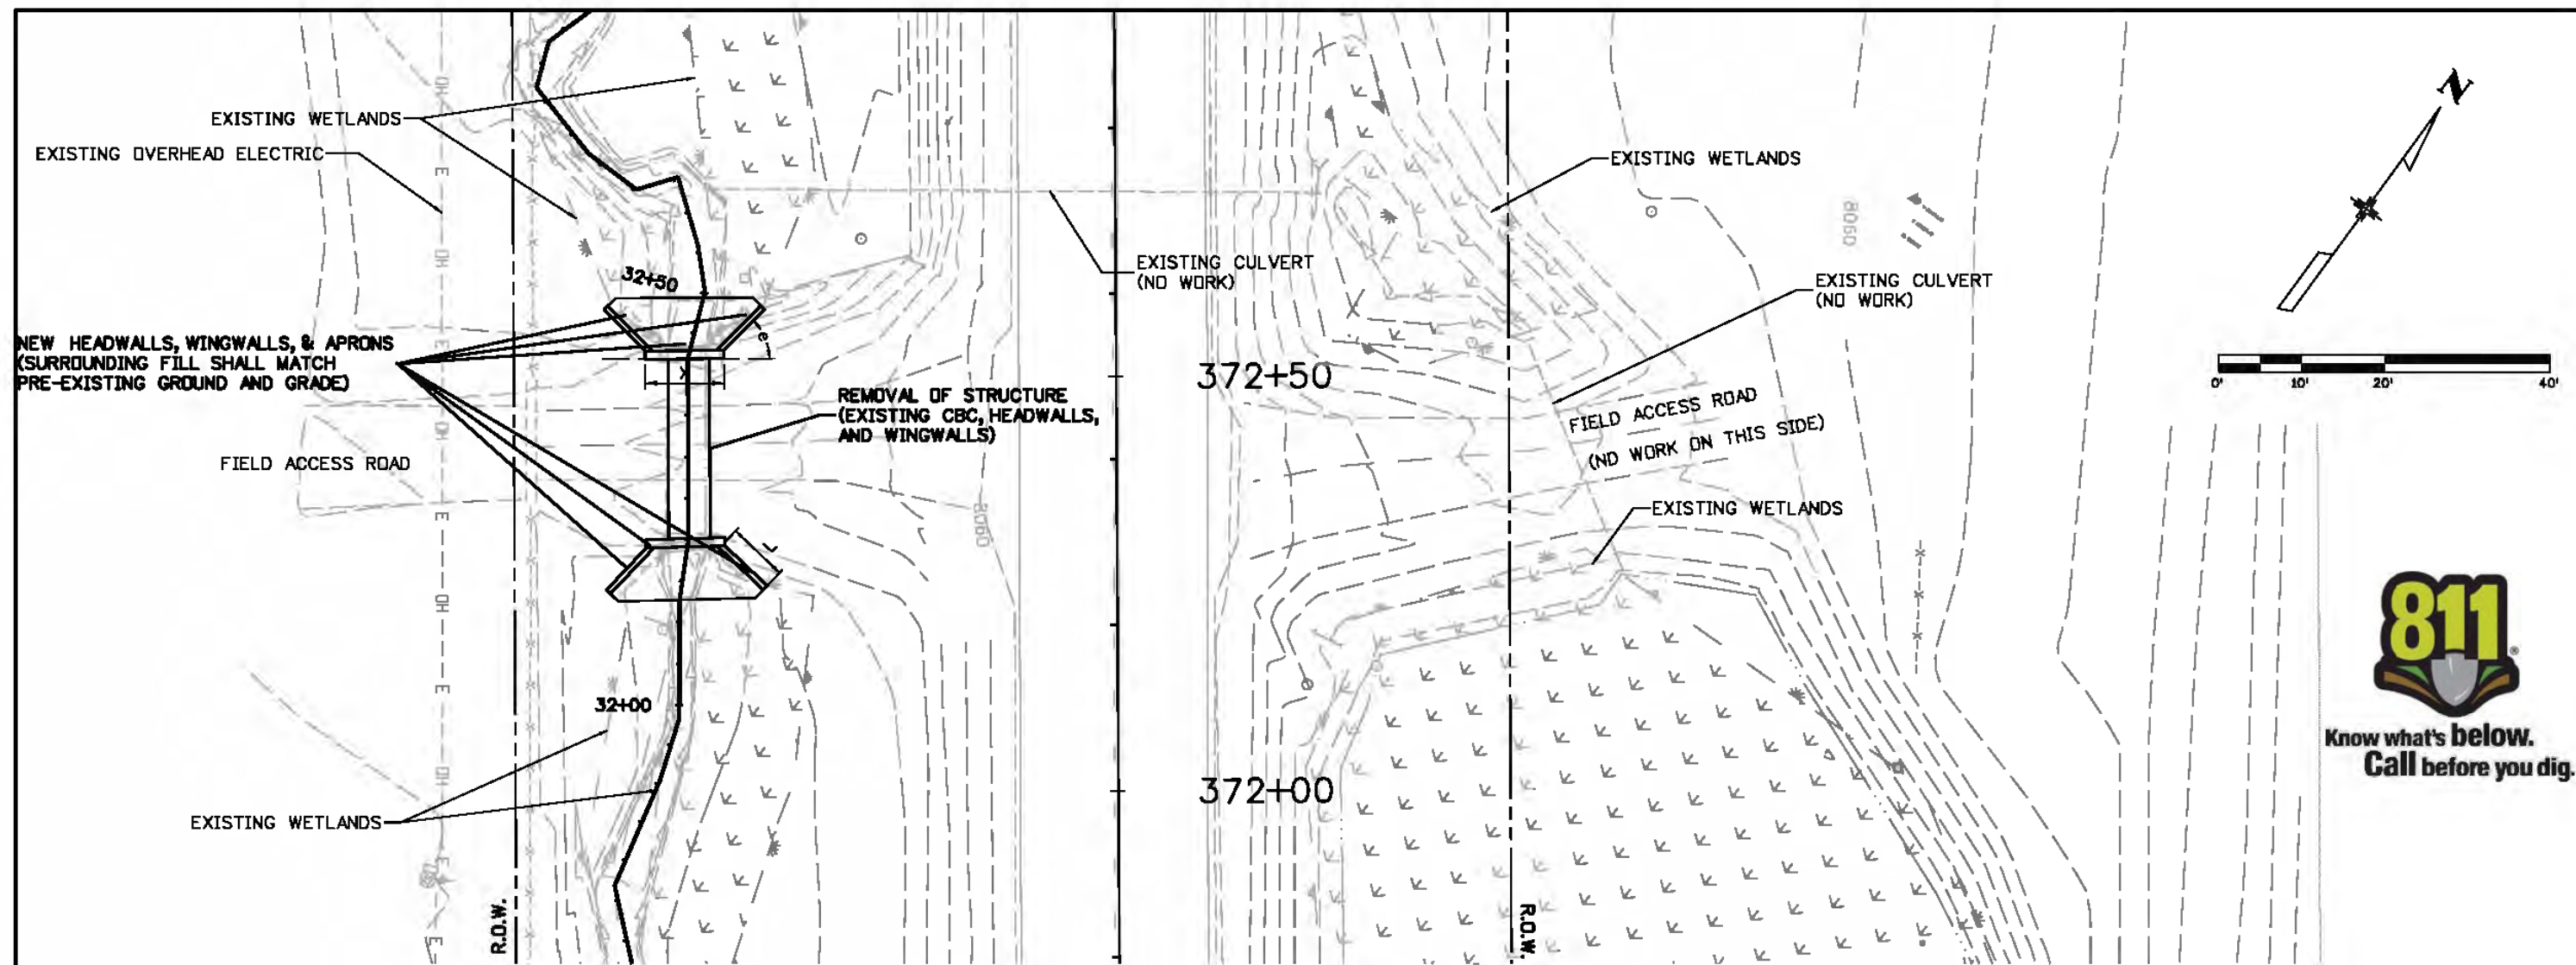

**SH 131 • STA 372+42 LT FIELD ACCESS ROAD (MP 37.08)**


REMOVAL OF STRUCTURE - 1 EACH  
REQ'D 25 LF 60 INCH DRAINAGE PIPE  
(CLASS 4) (COMPLETE IN PLACE) max n value = 0.013  
REQ'D 13.2 CY CONCRETE CLASS B (WALL)  
REQ'D 1002 LBS REINFORCING STEEL  
REQ'D 17 CY BACKFILL STRUCTURE (CLASS 1)  
AT HEADWALLS AND WINGWALLS  
INVIn=8051.74 • CHIMNEY CREEK STA. 32+19.35  
INVout=8051.68 • CHIMNEY CREEK STA. 32+43.93

12' MINIMUM FILL OVER NEW DRAINAGE PIPE

**Hydraulic Data:**  
D.A. = 7.5 sq. mi.  
Q25 = 110 cfs  
AHW = 8056.0'  
DHW = 8054.3'  
HW = 8055.2'

**South Wingwall**

Code	Value	Units
Ba	60	inches
m	83.5	inches
k	4	feet
L	7	feet
e	45	degrees
X	9.5	feet

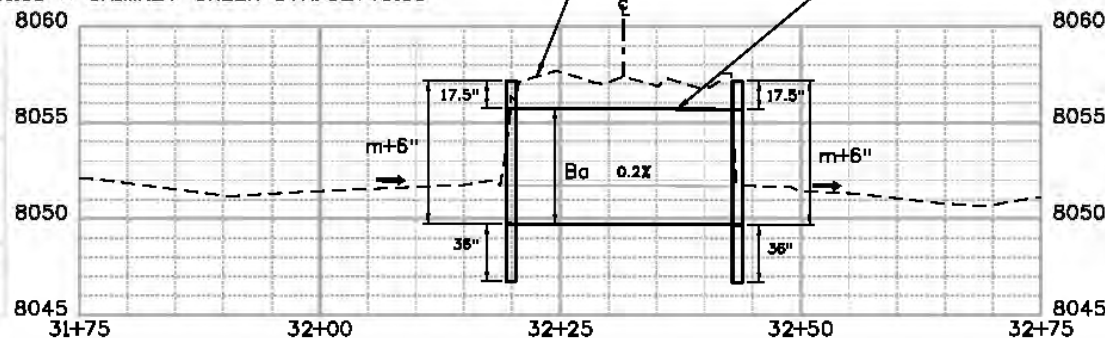


**North Wingwall**

Code	Value	Units
Ba	60	inches
m	83.5	inches
k	4	feet
L	7	feet
e	45	degrees
X	9.5	feet

- NOTES:**
- 1) ROW LIMITS DO NOT CROSS THE PROFILE, REFER TO ABOVE DRAWING FOR ROW LIMIT LOCATIONS.
  - 2) NO UTILITIES CROSS THE PROFILE, REFER TO THE ABOVE DRAWING FOR LOCATES.
  - 3) IMPACTS TO WATER FLOW HERE MAY AFFECT OTHER DOWNSTREAM WORK AREAS. PROCEED WITH CAUTION.
  - 4) REFER TO M&S STANDARDS M-601-20 FOR THE CODING OF THE WINGWALL DIMENSIONS.
  - 5) THE CONTRACTOR SHALL COORDINATE WITH THE LANDOWNER BEFORE MODIFYING THE ACCESS.

Print Date: 4/22/2013  
File Name: 18861DES\_StructureDETAIL004.dgn  
Horiz. Scale: 1:20 Vert. Scale: As Noted  
Unit Information: GJ Design JSL

Sheet Revisions		
Date:	Comments	Init.

Colorado Department of Transportation  
 714 Grand Ave.  
Eagle, CO 81631  
Phone: (970) 328-9962 FAX: (970) 328-2368  
Region 03 P.J.L.

As Constructed		MP 37.08 PROFILE & DETAILS		Project No./Code
No Revisions: 12/23/13		Designer: J. Klish	Structure MP 37.08	C 131A-035
Revised:		Detailer: J. Klish	Numbers (none)	18861R
Void:		Subset: 37.08 & 37.11	Subset Sheets: 2 of 3	Sheet Number 33











CHIMNEY CREEK  
(REMAIN AS EXISTING)

EXISTING OVERHEAD  
ELECTRIC

EXISTING WETLANDS

NEW HEADWALL, WINGWALLS,  
& APRON

REMOVAL OF PORTIONS OF  
PRESENT STRUCTURE  
(EXISTING HEADWALL  
& WINGWALLS)

388+50

388+00

NEW HEADWALL, WINGWALLS,  
& APRON

EXISTING WETLANDS

REMOVAL OF PORTIONS OF  
PRESENT STRUCTURE  
(EXISTING HEADWALL  
& WINGWALLS)

CHIMNEY CREEK  
(REMAIN AS EXISTING)

0' 10' 20' 40'




Know what's below.  
Call before you dig.

SH 131 @ STA 388+21 (MP 37.34)  
REMOVAL OF PORTIONS OF PRESENT  
STRUCTURE - 2 EACH  
REQ'D 50 CF CEMENT GROUT  
REQ'D 61 LF CULVERT LINING (54 INCH)  
NOMINAL OUTER DIAMETER = 54"  
NOMINAL (MAXIMUM) WALL THICKNESS = 1.70"  
REQ'D 17.0 CY ANNULAR SPACE GROUTING  
REQ'D 13.6 CY CONCRETE CLASS B (WALL)  
REQ'D 960 LBS REINFORCING STEEL  
REQ'D 14 CY STRUCTURE BACKFILL (CLASS 1)  
AT HEADWALLS AND WINGWALLS  
INVIn=8039.52' @ CHIMNEY CREEK STA 51+64.00  
INVOut=8038.87' @ CHIMNEY CREEK STA 52+24.97

Left Wingwall (West side)

Code	Value	Units
Ba =	54 inches	
m =	69.5 inches	
k =	4 feet	
L =	6.5 feet	
e =	45 degrees	
X =	8.5 feet	

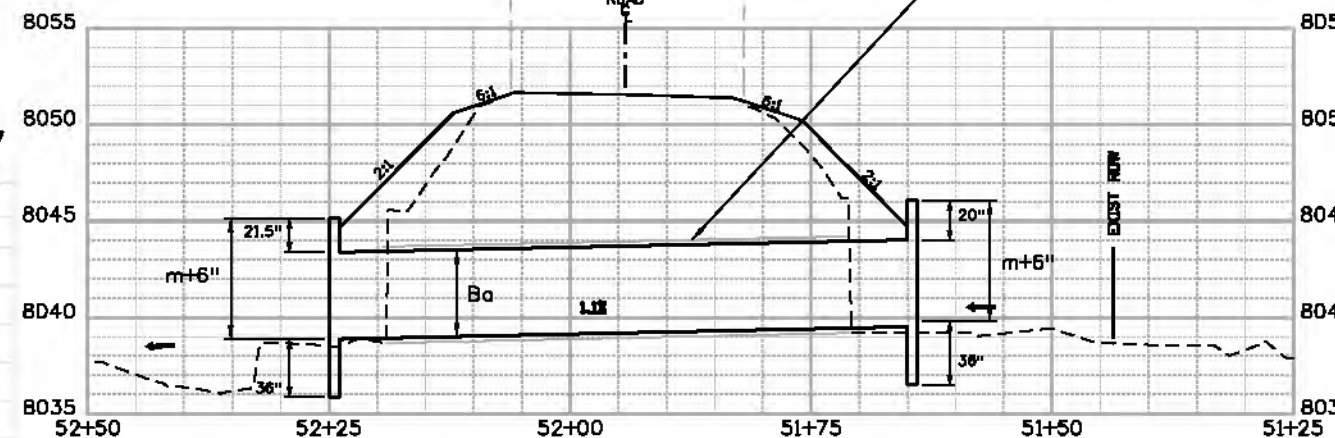

Hydraulic Data:  
D.A. = 9.1 sq. mi.  
Q25 = 125 cfs  
AHW = 8046.0'  
DHW = 8045.2'  
HW = 8048.1'

Right Wingwall (East side)

Code	Value	Units
Ba =	54 inches	
m =	68.0 inches	
k =	4 feet	
L =	6.5 feet	
e =	45 degrees	
X =	8.5 feet	

- NOTES:
- 1) ROW LIMITS CROSS THE PROFILE AT CREEK LOCATIONS, REFER TO ABOVE DRAWING FOR ROW LOCATIONS.
  - 2) NO UTILITIES CROSS THE PROFILE, REFER TO THE ABOVE DRAWING FOR LOCATES.
  - 3) IMPACTS TO WATER FLOW HERE MAY AFFECT OTHER DOWNSTREAM WORK AREAS. PROCEED WITH CAUTION.
  - 4) REFER TO M&S STANDARDS M-601-20 FOR THE CODING OF THE WINGWALL DIMENSIONS.
  - 5) A PREFABRICATED CONCENTRIC HYDRAULIC REDUCER SHALL BE INSTALLED AT THE INLET END OF THE LINER, FROM THE SAME MANUFACTURER AS THE REMAINDER OF THE PIPE LINER MATERIAL. THE COST OF THE REDUCER WILL BE INCLUDED IN THE COST OF CULVERT LINING.

Print Date: 4/22/2013

File Name: 18861DES\_StructureDETAIL006.dgn

Horiz. Scale: 1:20 Vert. Scale: As Noted

Unit Information: GJ Design JSL

### Sheet Revisions

Date:	Comments	Init.

Colorado Department of Transportation



714 Grand Ave.  
Eagle, CO 81631  
Phone: (970) 328-9962 FAX: (970) 328-2368

Region 03

PJL

As Constructed

No Revisions: 12/23/13

Revised:

Void:

### MP 37.34 PROFILE & DETAILS

Designer:	J. Klish	Structure	MP 37.34
Detailer:	J. Klish	Numbers	131B03740B
Subset:	MP 37.34	Subset Sheets:	2 of 2

Project No./Code

C 131A-035

18861R

Sheet Number 36





END PROJECT  
C 131A-035  
STA. 422+89  
(MP 38.00)

STA. 402+80  
END SIDESLOPE WIDENING TRANSITION

STA. 400+80  
BEGIN SIDESLOPE WIDENING TRANSITION

405+00

404+00

403+00

402+00

401+00

400+00

399+00

398+00

R.O.W.

R.O.W.

STA. 402+30  
END SIDESLOPE WIDENING  
BEGIN SIDESLOPE WIDENING TRANSITION

CULVERT LINING, ANNULAR GROUTING, AND  
NEW HEADWALLS & WINGWALLS (SEE MP  
37.70 PROFILE & DETAILS FOR DETAILS)


STA. 400+30  
END SIDESLOPE WIDENING TRANSITION  
BEGIN SIDESLOPE WIDENING

Chimney Creek

EXISTING WETLANDS

Headwall configuration  
changed. See sheet  
# 36.


NOTE: ONE FOOT INTERVAL FOR EXISTING AND PROPOSED CONTOUR LINES  
P.O.S.S. - POINT OF SLOPE SELECTION  
E.O.P. - EDGE OF PAVEMENT

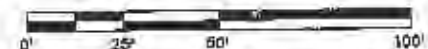

Print Date: 3/1/2013		0000	Sheet Revisions			Colorado Department of Transportation		As Constructed		MP 37.70 PLAN				Project No./Code	
File Name: 18861DES_Plan007_NOCR.dgn			Date:	Comments	Init.	 714 Grand Ave. Eagle, CO 81631 Phone: (970) 328-9982 FAX: (970) 328-2388 Region 03	No Revision:		Designer: J. Klish Detailer: J. Klish Subset: MP 37.70		Structure Numbers		C 131A-035		
Horiz. Scale: 1:50      Vert. Scale: N/A							Revised: 12/23/13				MP 37.70		18861R		
Unit Information: GJ Design      JSL							Void:		Subset Sheets: 1 of 2		Sheet Number: 37				



\\cd01\proj\131\131A\131A035\131A035.dgn 4/22/2013 4:23:18 PM PJL

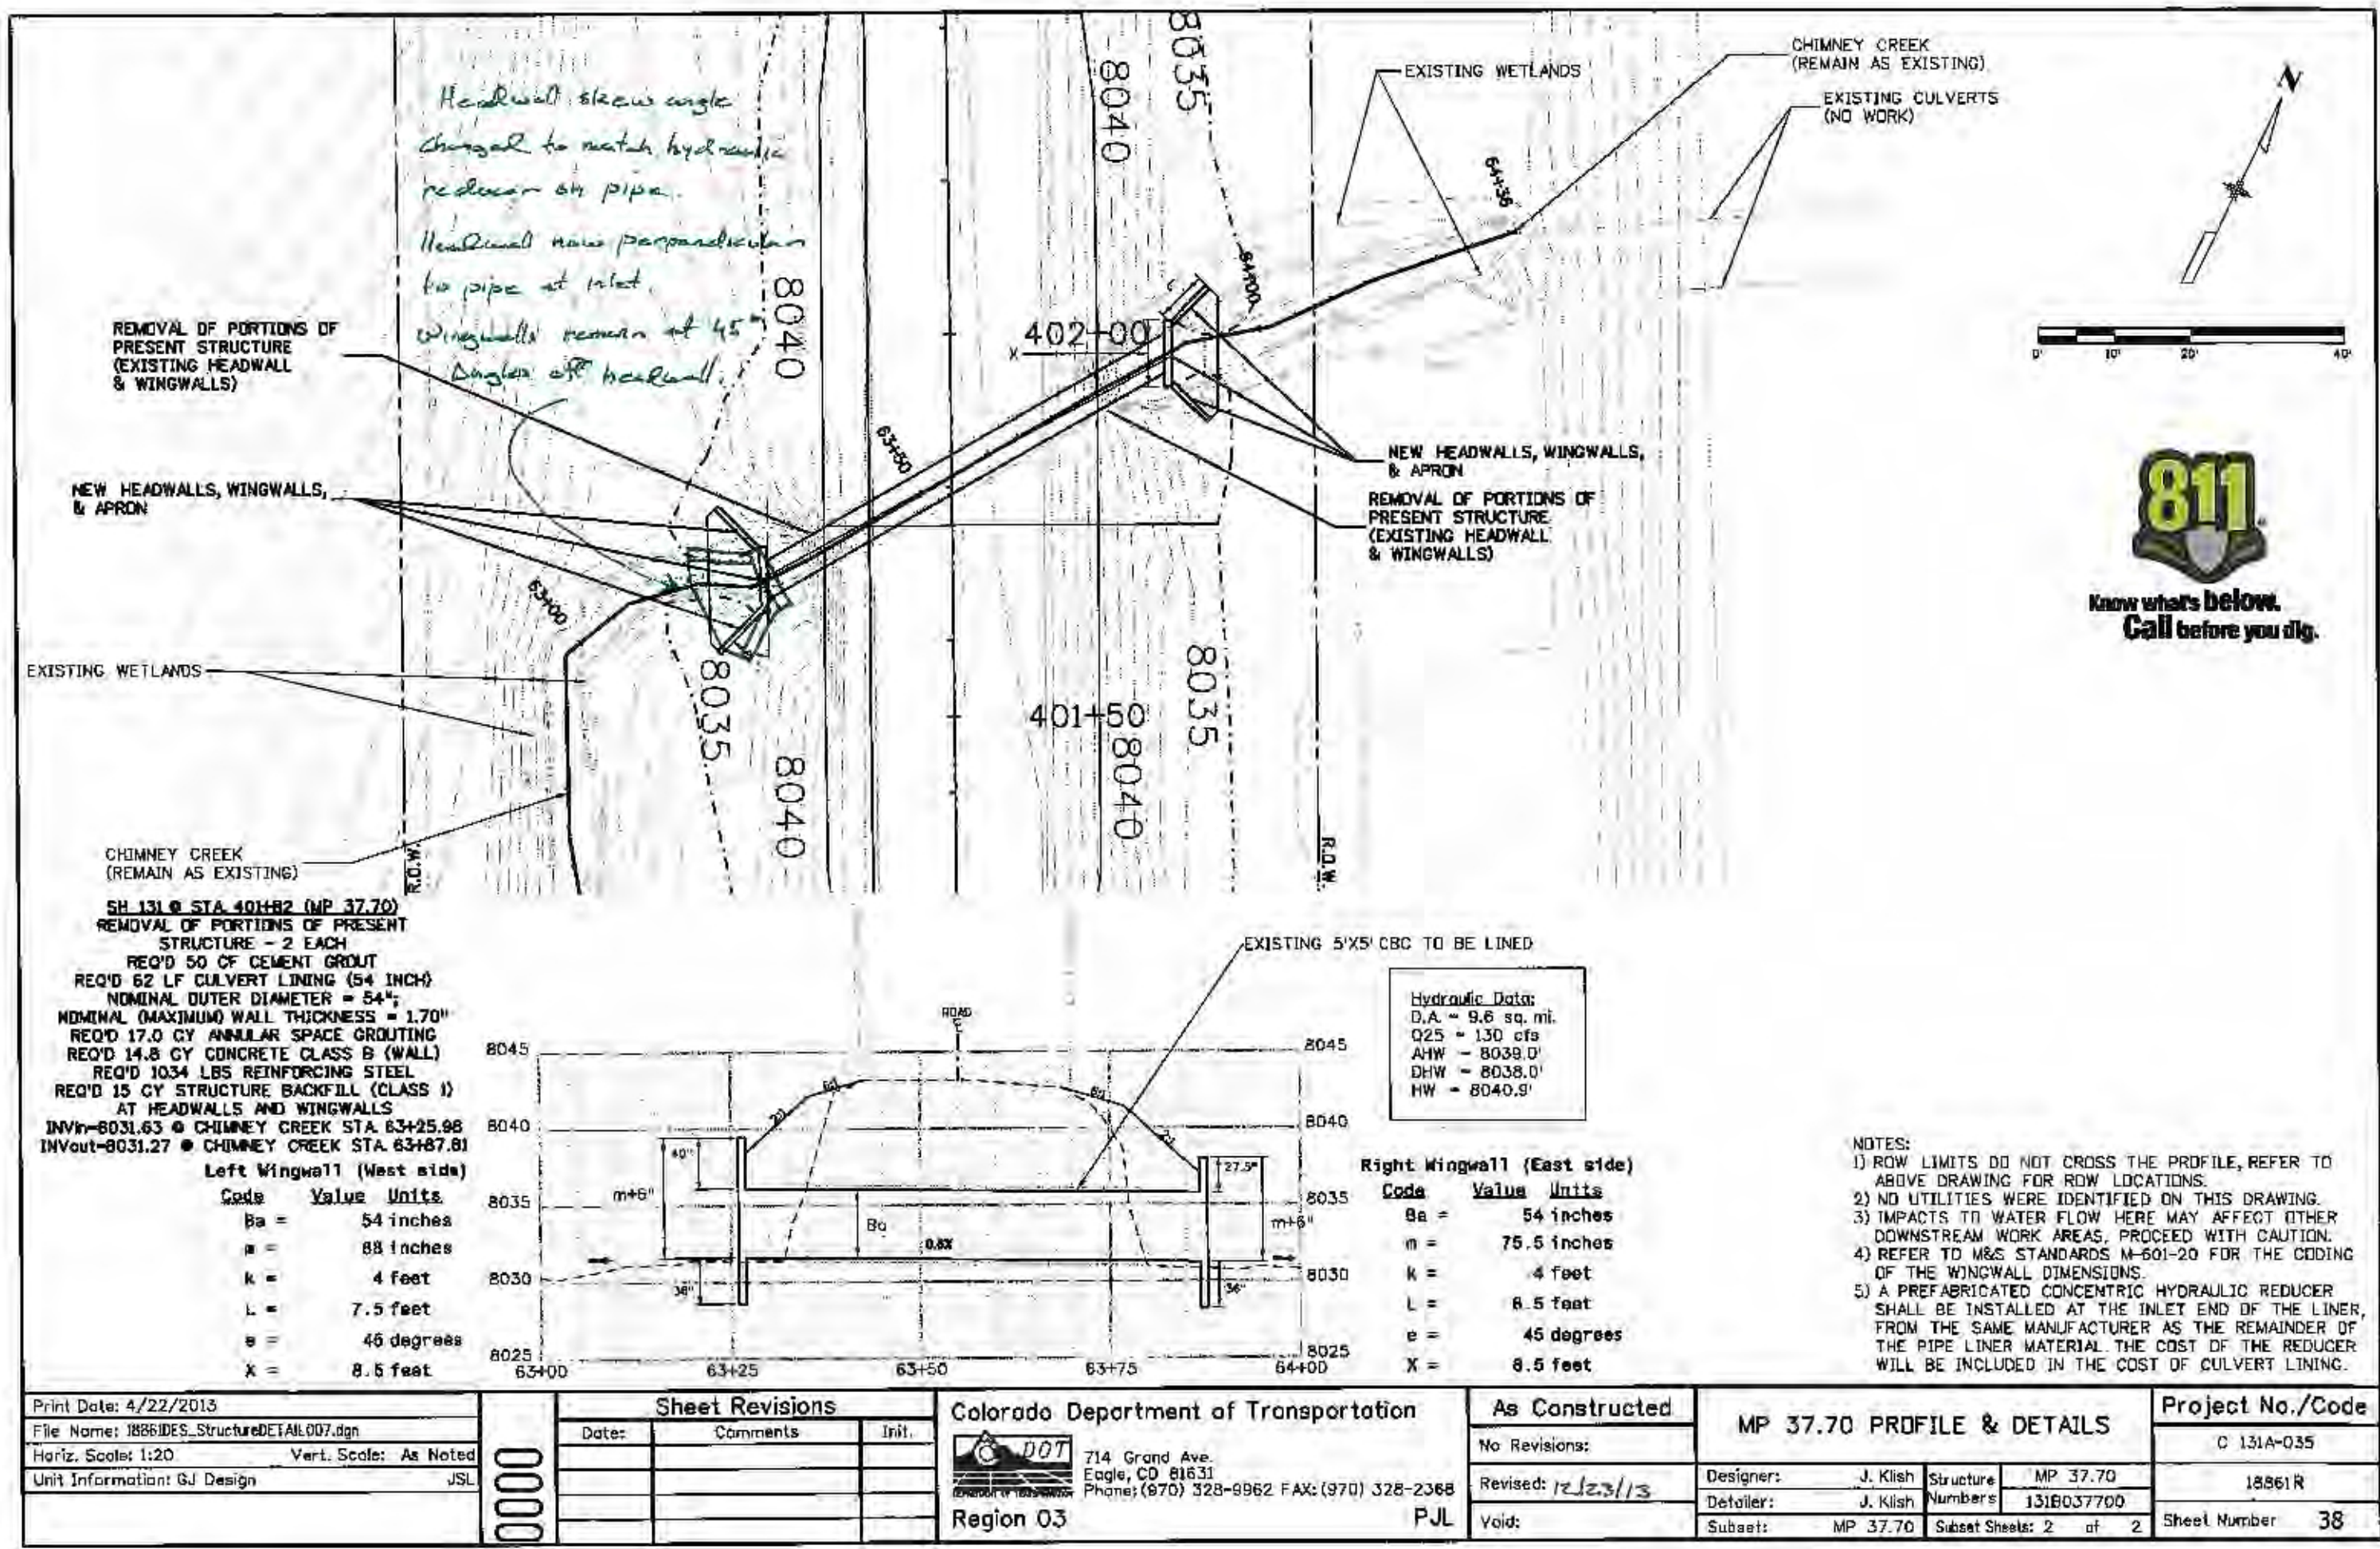

Know what's below.  
Call before you dig.

SH 131 @ STA 401+82 (MP 37.70)  
REMOVAL OF PORTIONS OF PRESENT  
STRUCTURE - 2 EACH  
REQ'D 50 CY CEMENT GROUT  
REQ'D 62 LF CULVERT LINING (54 INCH)  
NOMINAL OUTER DIAMETER = 54";  
NOMINAL (MAXIMUM) WALL THICKNESS = 1.70"  
REQ'D 17.0 CY ANNULAR SPACE GROUTING  
REQ'D 14.8 CY CONCRETE CLASS B (WALL)  
REQ'D 1034 LBS REINFORCING STEEL  
REQ'D 15 CY STRUCTURE BACKFILL (CLASS I)  
AT HEADWALLS AND WINGWALLS  
INVIn-8031.63 @ CHIMNEY CREEK STA 63+25.98  
INVOut-8031.27 @ CHIMNEY CREEK STA 63+87.81  
Left Wingwall (West side)

Code	Value	Units
Ba	54	inches
m	88	inches
k	4	feet
L	7.5	feet
θ	45	degrees
X	8.5	feet

Hydraulic Data:  
D.A. = 9.6 sq. mi.  
Q25 = 130 cfs  
AHW = 8039.0'  
DHW = 8038.0'  
HW = 8040.9'


Right Wingwall (East side)

Code	Value	Units
Ba	54	inches
m	75.5	inches
k	4	feet
L	8.5	feet
θ	45	degrees
X	8.5	feet


- NOTES:
- 1) ROW LIMITS DO NOT CROSS THE PROFILE, REFER TO ABOVE DRAWING FOR ROW LOCATIONS.
  - 2) NO UTILITIES WERE IDENTIFIED ON THIS DRAWING.
  - 3) IMPACTS TO WATER FLOW HERE MAY AFFECT OTHER DOWNSTREAM WORK AREAS, PROCEED WITH CAUTION.
  - 4) REFER TO M&S STANDARDS M-601-20 FOR THE CODING OF THE WINGWALL DIMENSIONS.
  - 5) A PREFABRICATED CONCENTRIC HYDRAULIC REDUCER SHALL BE INSTALLED AT THE INLET END OF THE LINER, FROM THE SAME MANUFACTURER AS THE REMAINDER OF THE PIPE LINER MATERIAL. THE COST OF THE REDUCER WILL BE INCLUDED IN THE COST OF CULVERT LINING.

Print Date: 4/22/2013	Sheet Revisions			Colorado Department of Transportation		As Constructed		MP 37.70 PROFILE & DETAILS		Project No./Code	
File Name: 18861DES_StructureDETAIL007.dgn	Date:	Comments:	Init.		714 Grand Ave. Eagle, CO 81631 Phone: (970) 328-9962 FAX: (970) 328-2368	No Revisions:				C 131A-035	
Horiz. Scale: 1:20 Vert. Scale: As Noted						Revised: 12/23/13		Designer: J. Klish	Structure Numbers: MP 37.70	18861R	
Unit Information: GJ Design JSL						Void:		Detailer: J. Klish	131B037700	Sheet Number 38	
				Region 03	PJL			Subest: MP 37.70	Subest Sheets: 2 of 2		



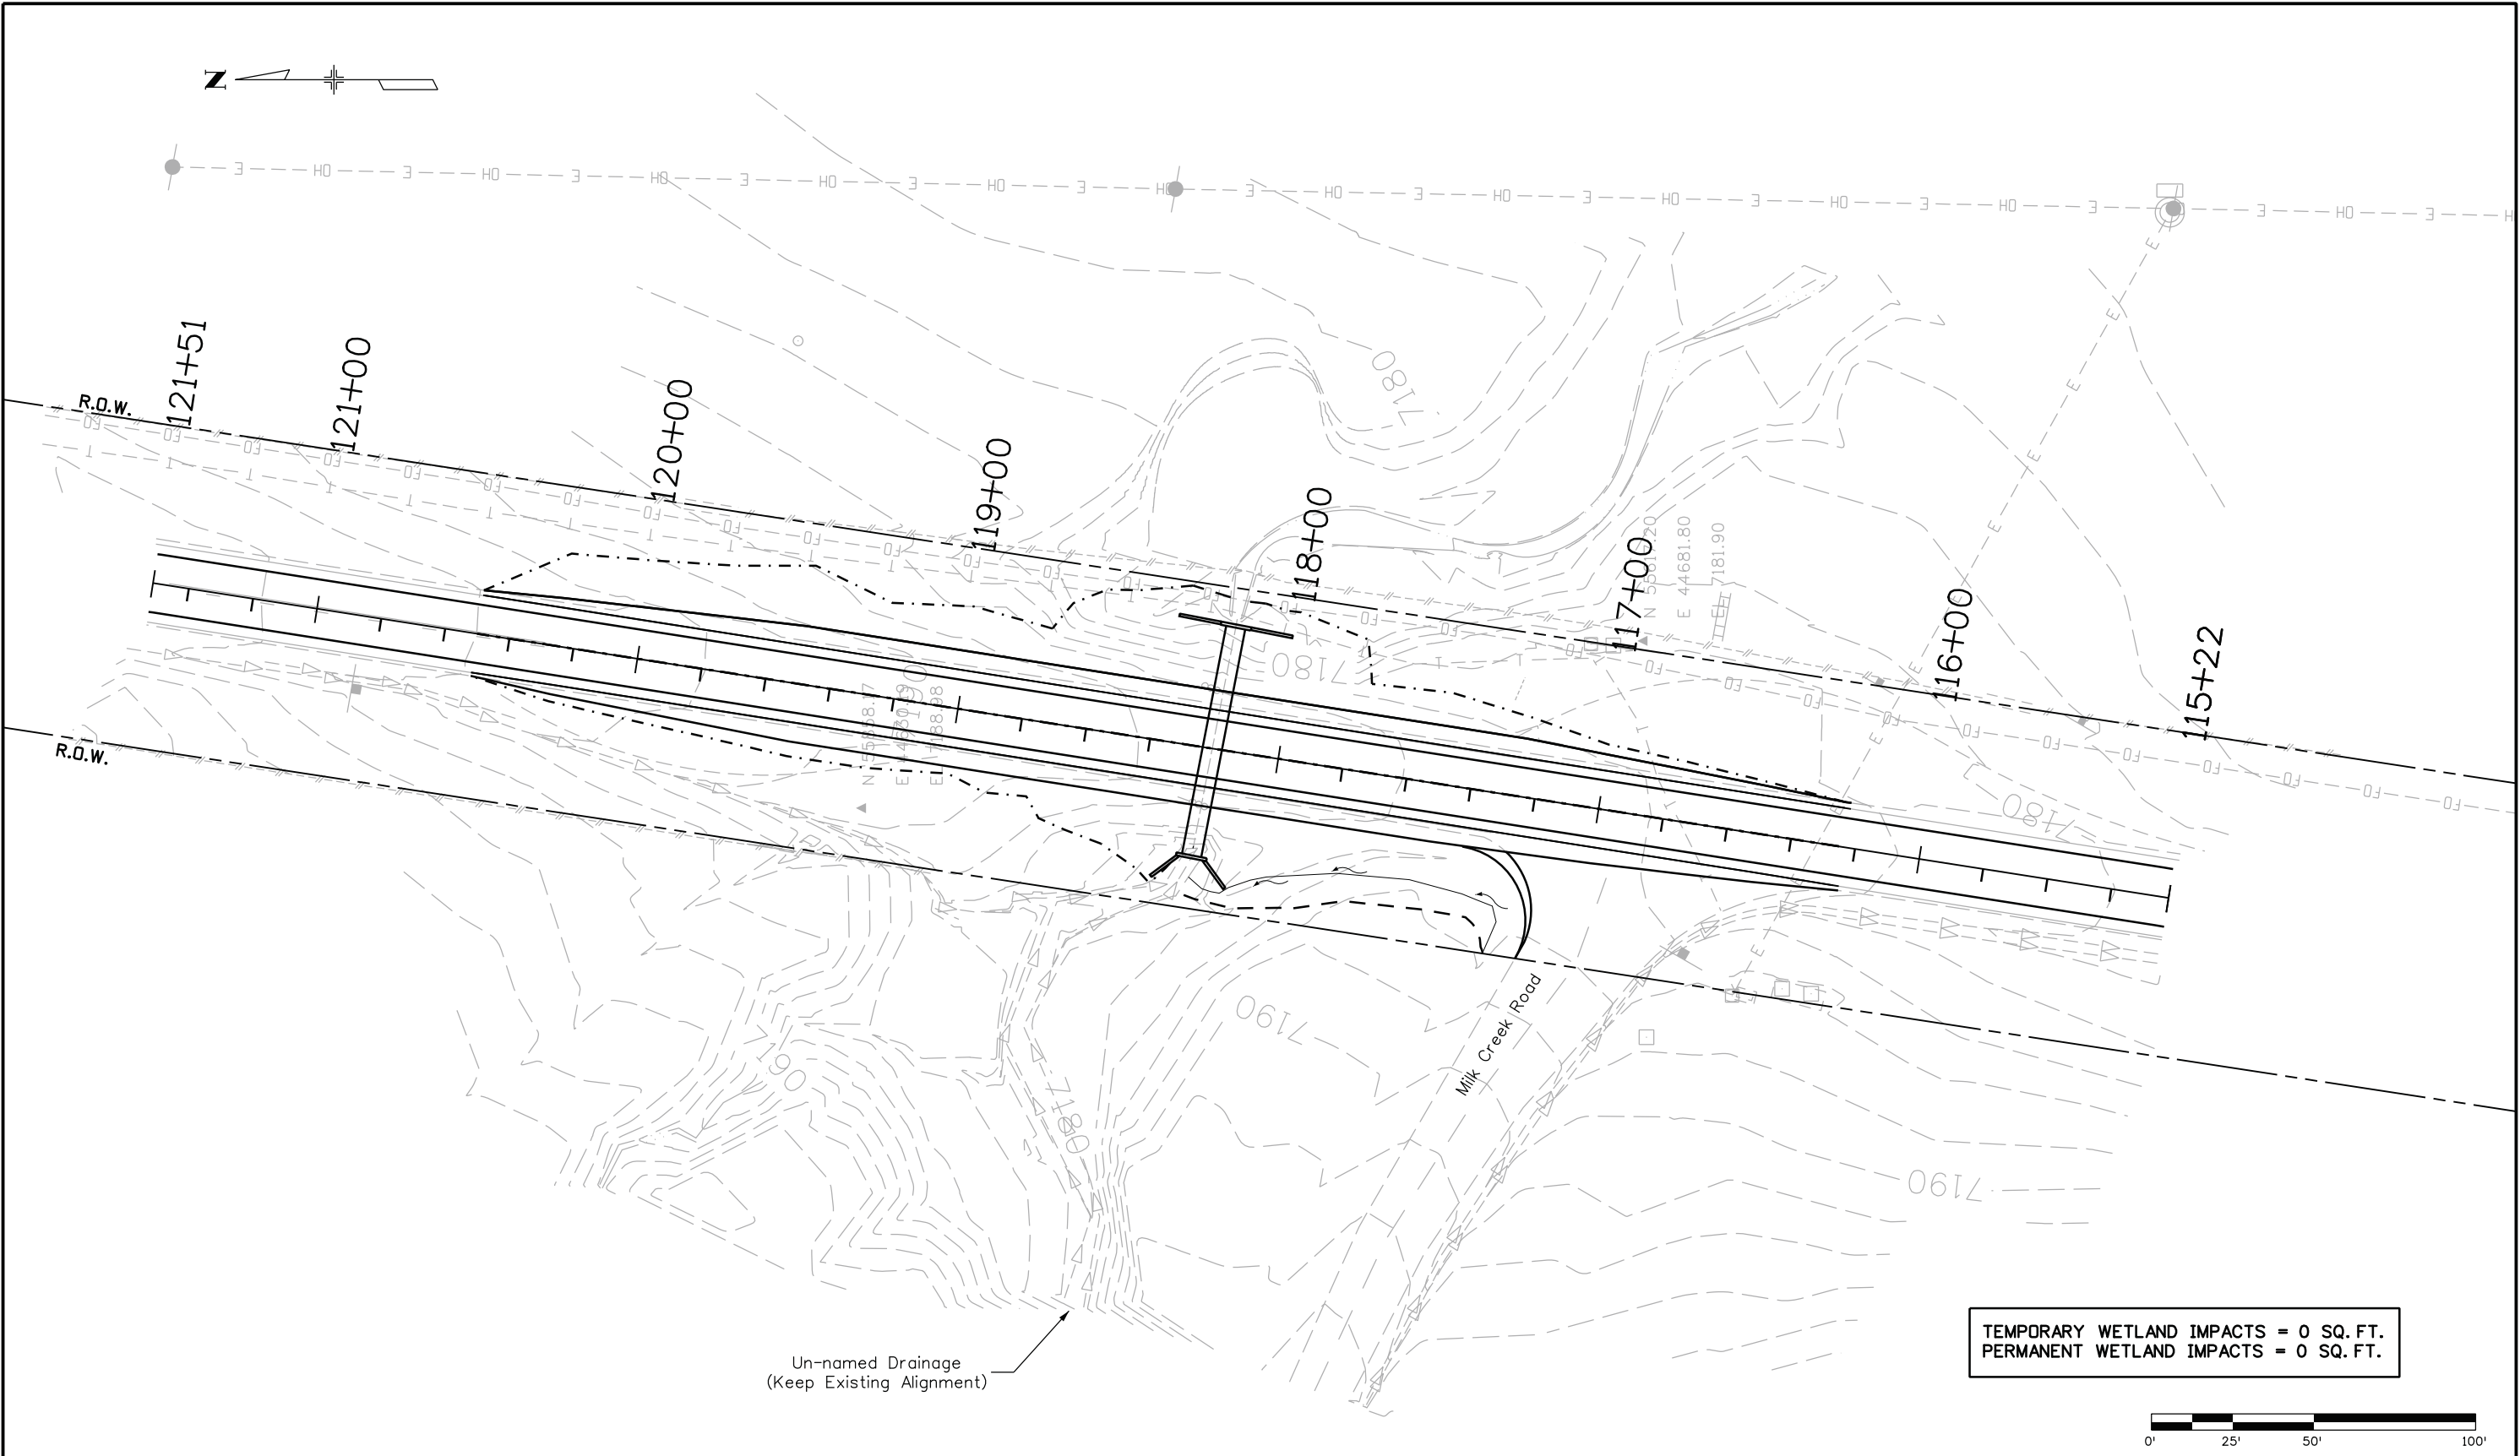


TEMPORARY WETLAND IMPACTS = 0 SQ. FT.  
PERMANENT WETLAND IMPACTS = 0 SQ. FT.

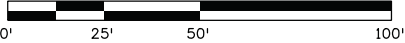

Print Date: 3/1/2013		<div>0000</div>	Sheet Revisions			Colorado Department of Transportation		As Constructed		PERMANENT & TEMPORARY WETLAND IMPACTS @ MP 3.09				Project No./Code	
File Name: 18861DES_Impacts001.dgn			Date:	Comments	Init.	 714 Grand Ave. Eagle, CO 81631 Phone: (970) 328-9962 FAX: (970) 328-2368 Region 03	No Revisions: 12/23/13		Designer: J. Klish Structure Numbers: 131B003090 MP 3.09				C 131A-035		
Horiz. Scale: 1:50      Vert. Scale:							Revised:						Detailer: J. Klish		
Unit Information: GJ Design      JSL							Void:		Subset: IMPACTS		Subset Sheets: 1 of 6		18861R		
													Sheet Number 39		


klishj 2:48:39 PM c:\projectwise\pwz\_working\0233335\1886IDES\_Impacts002.dgn

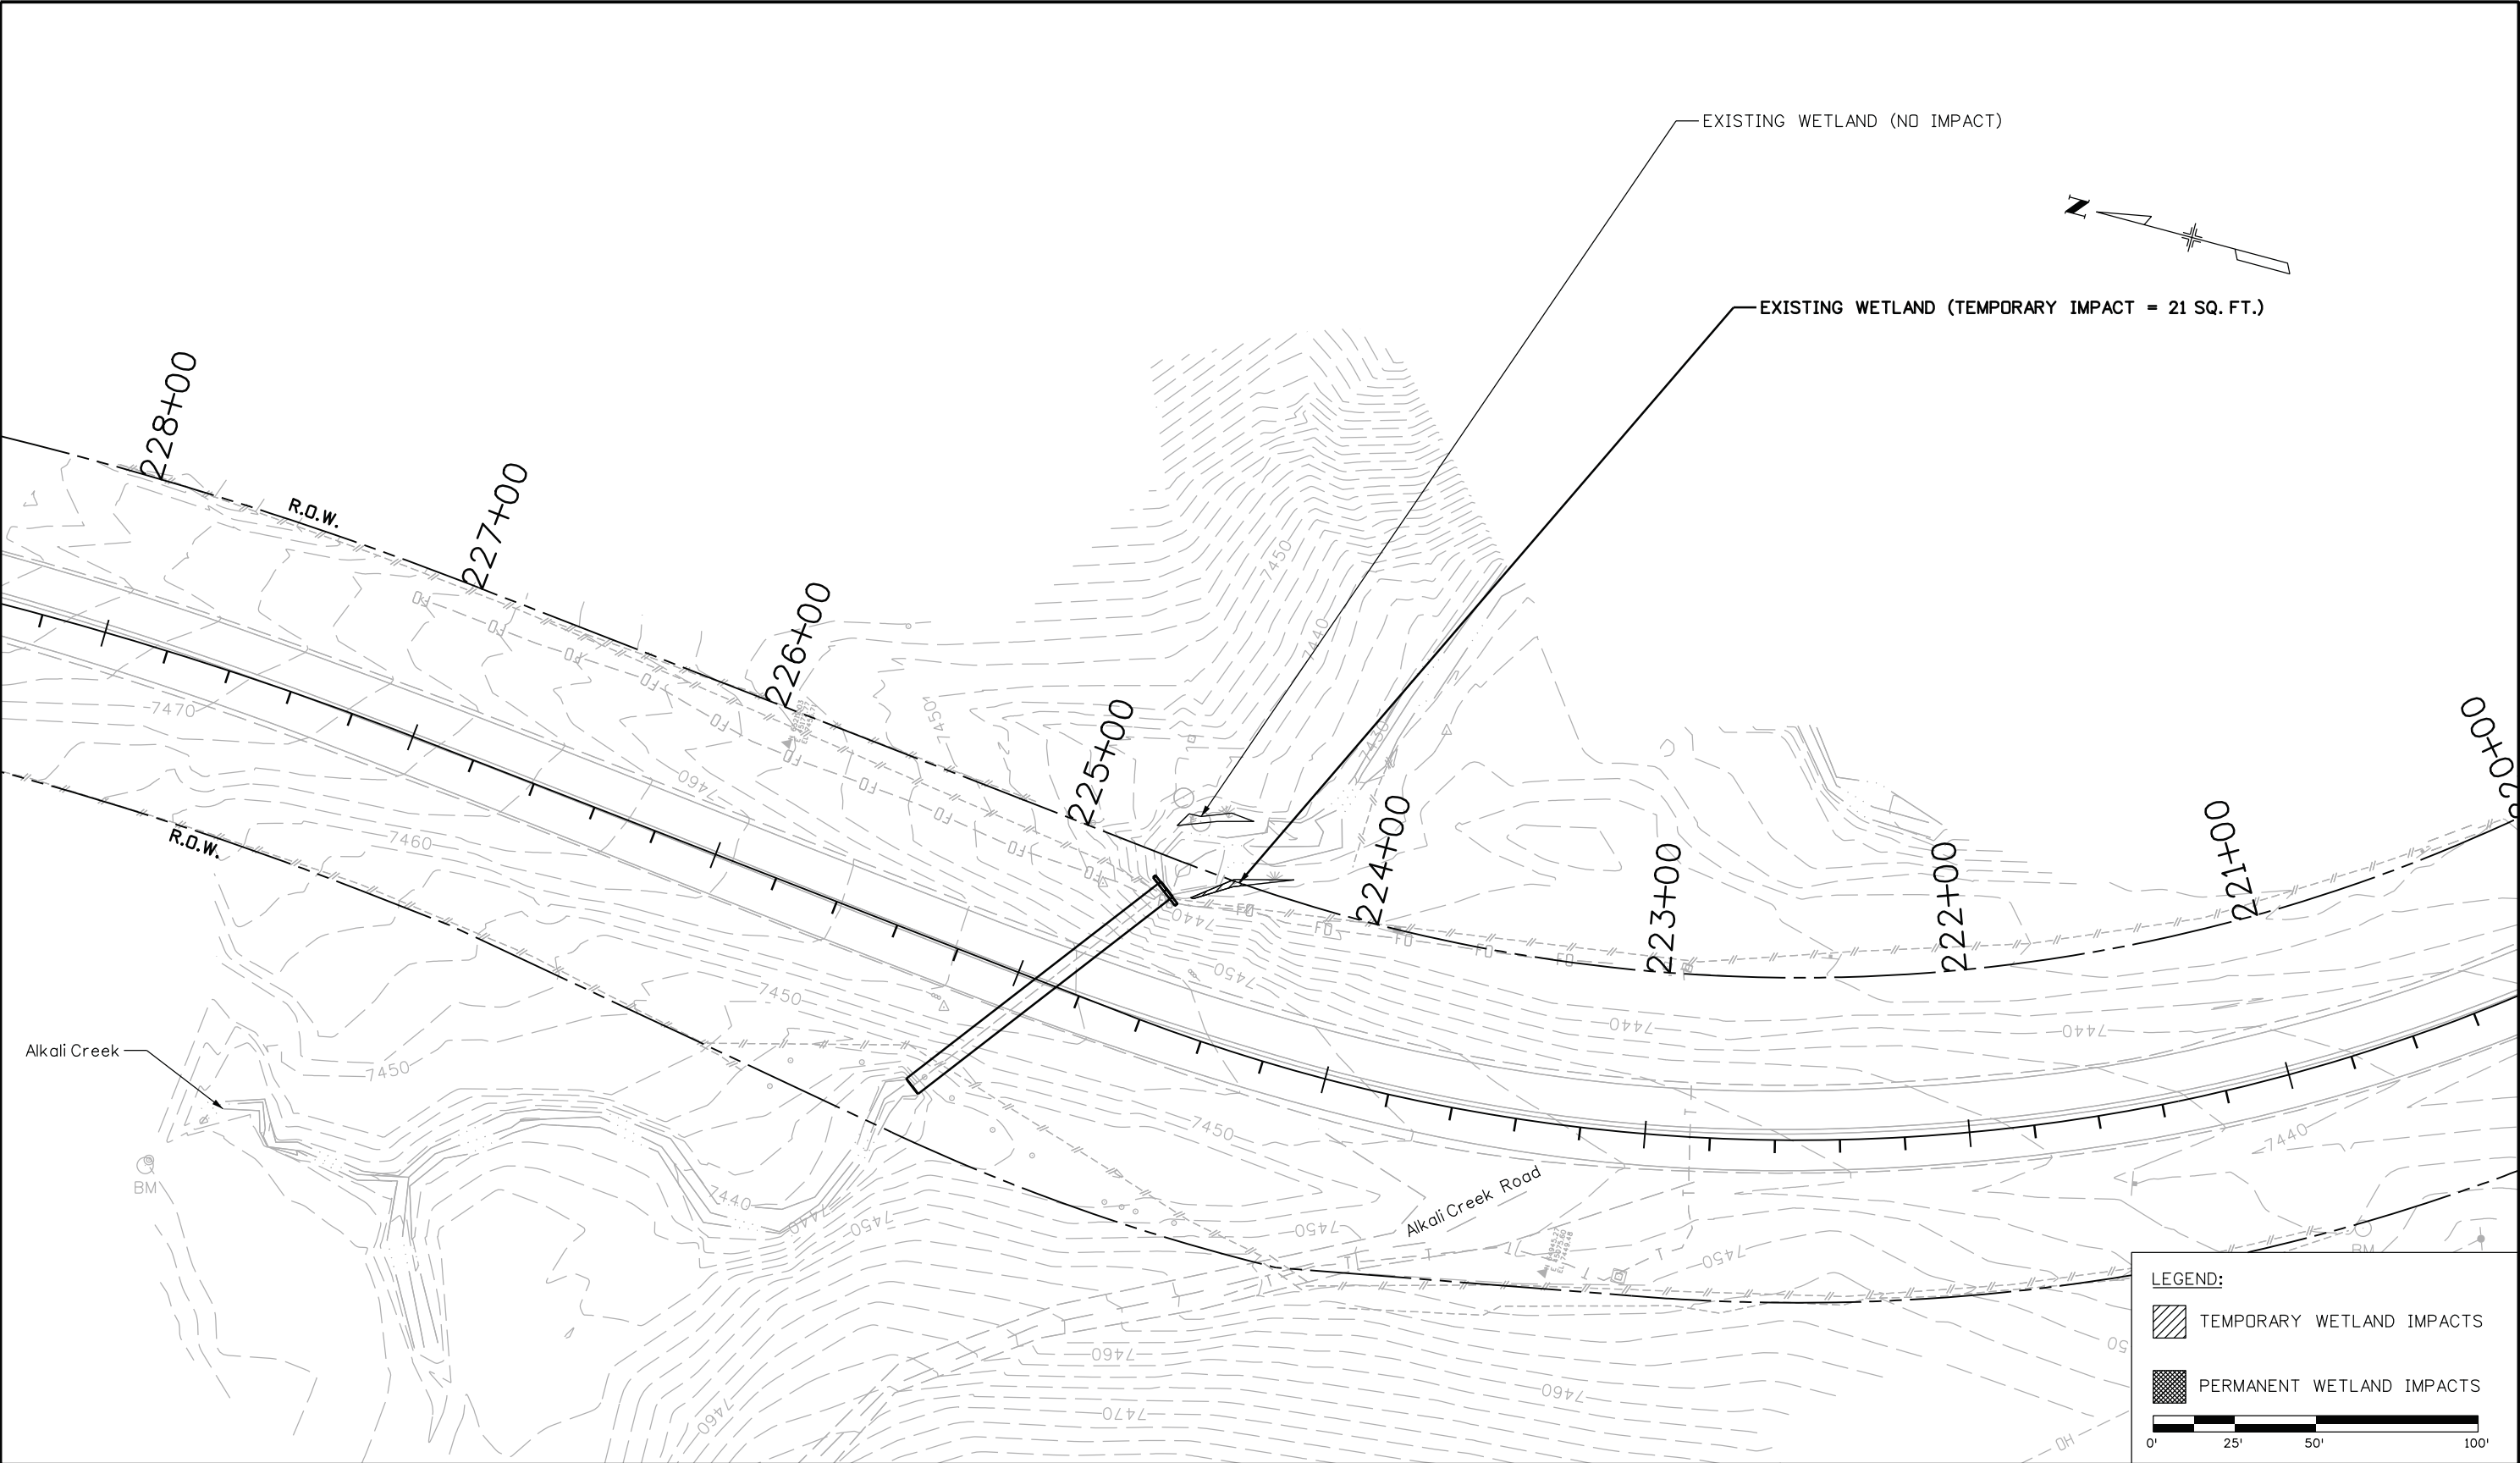


Print Date: 3/1/2013		<div>0000</div>	Sheet Revisions			<div><div><div>Colorado Department of Transportation</div><div>714 Grand Ave. Eagle, CO 81631 Phone: (970) 328-9962 FAX: (970) 328-2368</div><div>Region 03</div></div><div>PJL</div></div>		As Constructed		PERMANENT & TEMPORARY WETLAND IMPACTS MP 5.13				Project No./Code	
File Name: 18861DES_Impacts002.dgn			Date:	Comments	Init.			No Revisions: 12/23/13		C 131A-035					
Horiz. Scale: 1:50      Vert. Scale:								Revised:		Designer: J. Klish		Structure		MP 5.13	
Unit Information: GJ Design      JSL								Void:		Detailer: J. Klish		Numbers		131B005130	
										Subset: IMPACTS		Subset Sheets: 2 of 6		Sheet Number 40	





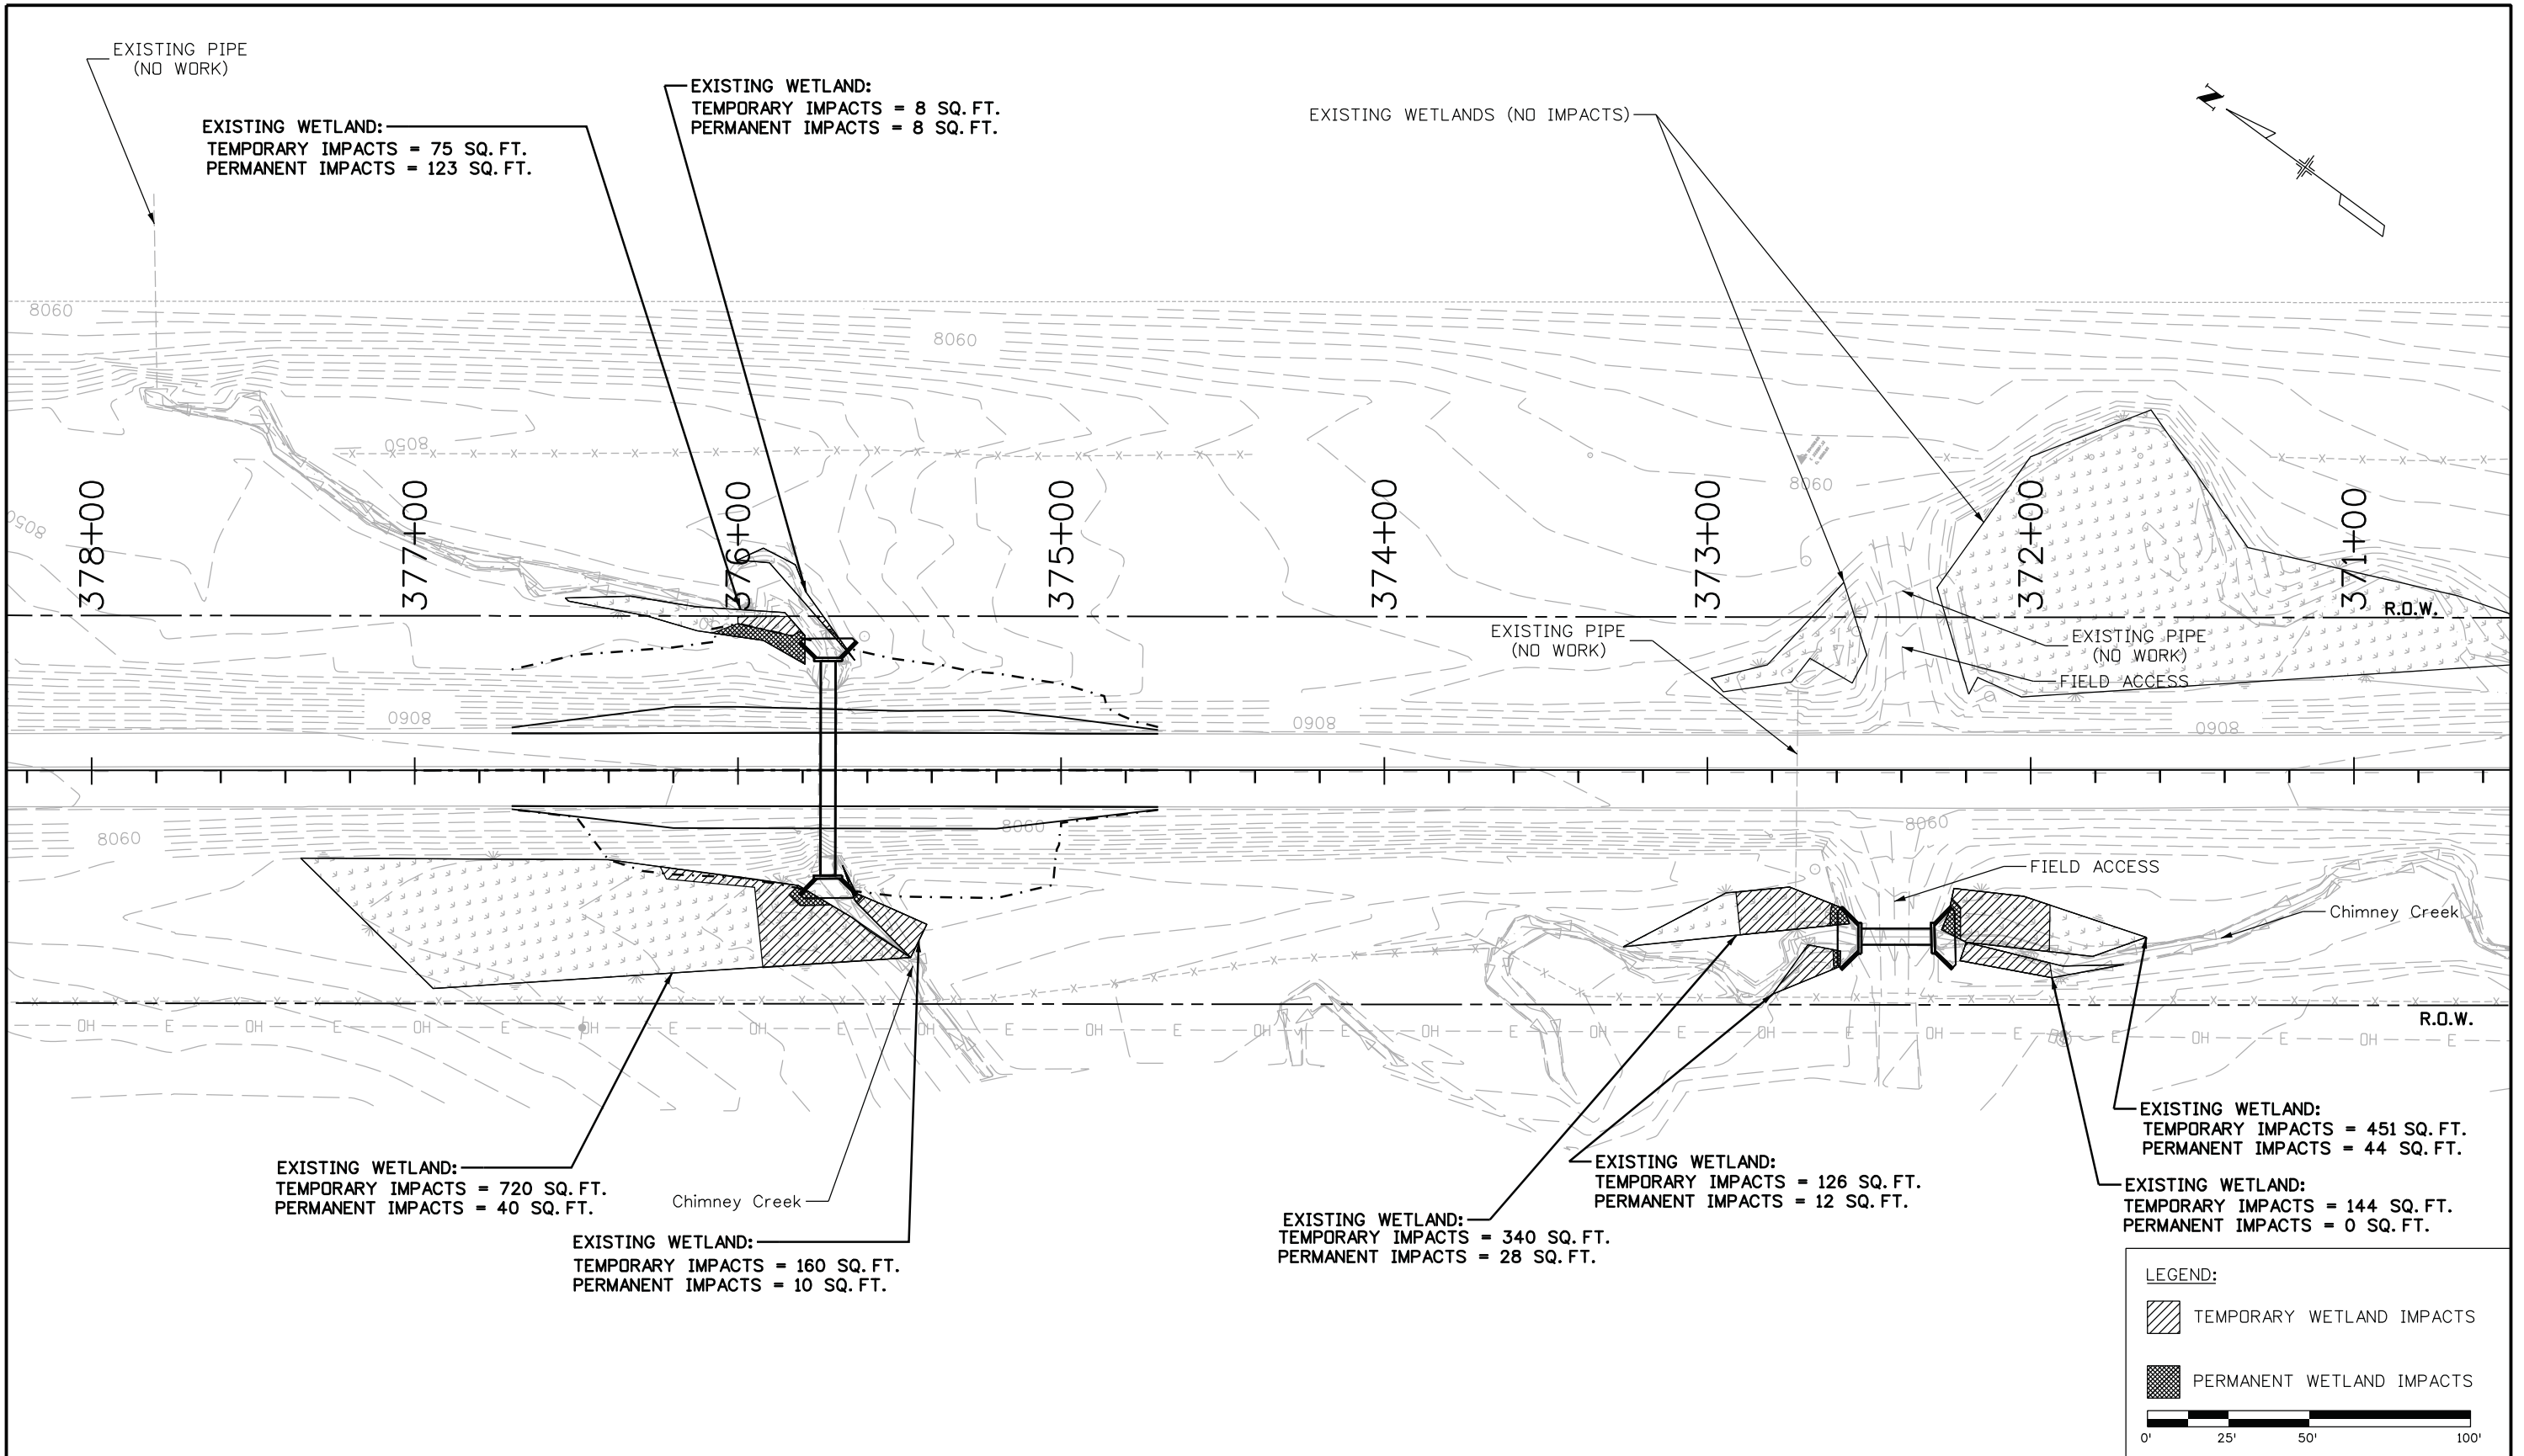


Print Date: 3/1/2013		<div></div> <div></div> <div></div> <div></div> <div></div>	Sheet Revisions			Colorado Department of Transportation		As Constructed		PERMANENT & TEMPORARY WETLAND IMPACTS @ MP 37.08 & MP 37.11			Project No./Code	
File Name: 18861DES_Impacts004&5.dgn			Date:	Comments	Init.	<div> 714 Grand Ave Eagle, CO 81631 Phone: (970) 328-9962 FAX: (970) 328-2368 Region 03</div> <div>PJL</div>	No Revisions: 12/23/13		Designer: J. Klish Structure MP 37.11 Detailer: J. Klish Numbers 131B037110			C 131A-035		
Horiz. Scale: 1:50      Vert. Scale: N/A							Revised:					Sheet Number 18861R		
Unit Information: GJ Design      JSL							Void:		Subset: IMPACTS      Subset Sheets: 4 of 6		42			





klishj 2:49:05 PM c:\projectwise\pwz\_working\40233335\18861DES\_Impacts007.dgn

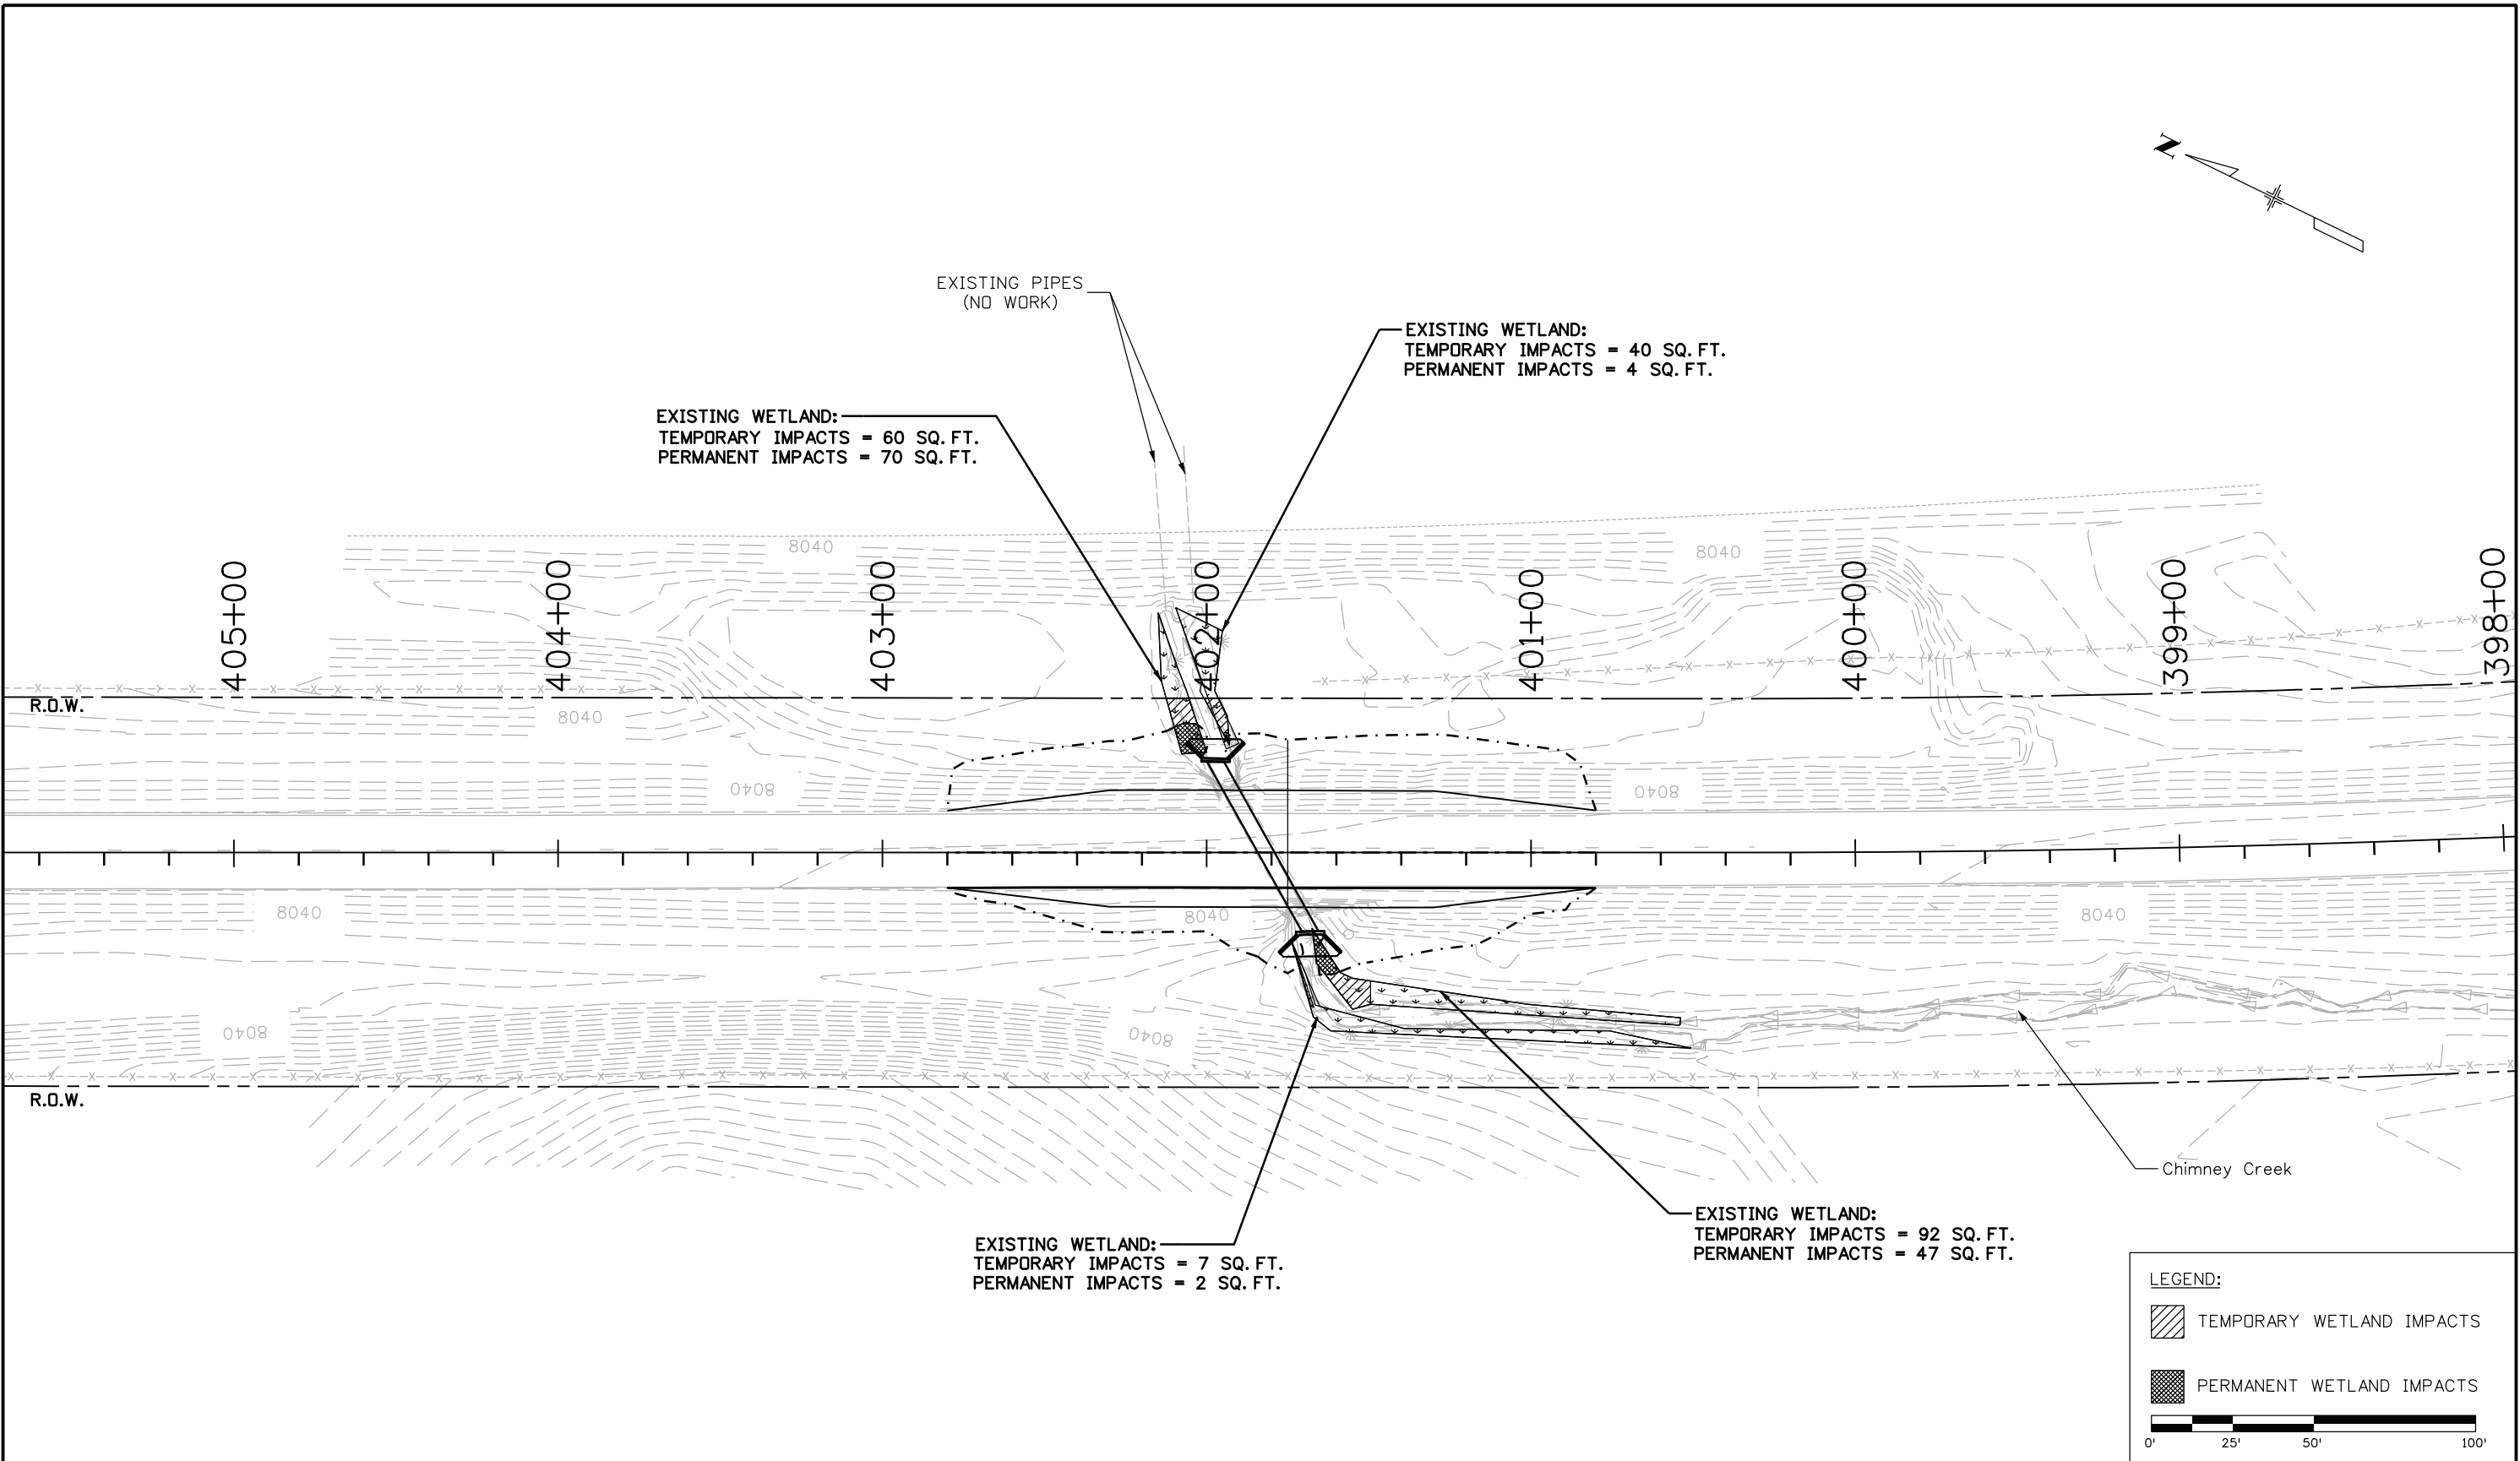

Print Date: 3/1/2013		<div>0000</div>	Sheet Revisions			<div>Colorado Department of Transportation</div> <div>714 Grand Ave Eagle, CO 81631 Phone: (970) 328-9962 FAX: (970) 328-2368 Region 03PJT</div>		As Constructed	PERMANENT & TEMPORARY WETLAND IMPACTS @ MP 37.70				Project No./Code	
File Name: 18861DES_Impacts007.dgn			Date:	Comments	Init.			No Revisions: 12/23/13					C 131A-035	
Horiz. Scale: 1:50      Vert. Scale: N/A								Revised:	Designer: J. Klisch		Structure	MP 37.70	18861R	
Unit Information: GJ Design      JSL								Void:	Detailer: J. Klisch		Numbers	131B037700	Sheet Number 44	
									Subset: IMPACTS		Subset Sheets: 6 of 6			



klishj 2:49:09 PM c:\projectwise\pwz\_working\40233335\18861DES-SWMP\_Plan001.dgn

1. STORMWATER MANAGEMENT CONTROLS FIRST CONSTRUCTION ACTIVITIES

THE CONTRACTOR SHALL PERFORM THE FOLLOWING:

A. POTENTIAL POLLUTANT SOURCES

1. Evaluate, identify and describe all potential sources of pollutants at the site in accordance with subsection 107.25 and place any BMPs required to contain potential pollutants.

B. BEST MANAGEMENT PRACTICES (BMPs) FOR STORMWATER POLLUTION PREVENTION

STRUCTURAL and NONSTRUCTURAL BMPs that may be potentially used on the project for erosion and sediment control; practices may include, but are not limited to:

Structural BMPs and Application	Narrative	BMP as Designed	In use on site	FIRST CONSTRUCTION ACTIVITIES	DURING CONSTRUCTION	INTERIM/FINAL STABILIZATION
Earth Berm/Stockpile	Placed around toe to contain sediment around stockpile	X			x	
Earth Berm/Toe of fill	Placed prior to earthwork within specified distance of toe to capture sediment and protect undisturbed areas	X		X	X	
Earth Berm/Diversion	Placed to divert drainage and subdivide runoff volume from less than 10 acre sub basins. Temp feature to be removed upon final stabilization	X		X	X	
*Rock Check Dams/Ditch	Velocity checks in ditches placed immediately after ditch grading					
Silt Fence/Sediment Control	Placed on contour to contain construction runoff					
Silt Fence/Protection of Vegetation	Placed to protect undisturbed area and delineate boundary of protected area					
Erosion Logs, Silt Berms or Silt Dikes/Ditch Checks	Erosion Control checks in ditches placed immediately after ditch grading to reduce flow velocity of runoff in ditch	X		X	X	X
Erosion Logs/ Existing Inlet	Placed prior to disturbance at existing inlets where disturbance maybe occurring to cause sediment laden water to enter pipe					
Erosion Logs/culvert inlet or outlet	Placed on culvert to filter or prevent sediment from entering pipe. If disturbance occurs above pipe then erosion logs are placed above pipe	X		X	X	X
Erosion Logs/Sediment Control	Placed to protect undisturbed area and delineate boundary of protected area	X		X	X	
Storm Drain Inlet Protection/Sediment Control	Placed to protect storm drain inlets to filter or prevent sediment from entering drainage system.					
Temporary Sediment Trap/Basin	Contain and filter sediment laden water from < 5 acre sub basins within construction disturbance					
Permanent Sediment Trap/Basin	Utilized during construction to act as temporary sediment containment. Outlet structure shall be modified for construction runoff	X	X	X	X	X
Embankment Protection or Temp Slope Drain	Placed as a conduit or chute to drain runoff down slope and prevent erosion of slope					
Outlet Protection	Material placed as energy dissipation device to prevent erosion at outlet structure					
Concrete Washouts/Construction Control	Construction waste management of concrete washout material	X			X	
Vehicle tracking Pad/ Construction Control	Placed to prevent tracking of sediment from disturbance to offsite surface	X		X	X	
Sweeping/Construction or Source Control	Utilized to remove sediment on pavement surface and to prevent sediment from entering drainage system	X			X	X
Dewatering/ Construction Control	Sediment control to remove or filter sediment from construction dewatering	X			X	X
Temporary Stream Crossing/ Construction Control	Constructed over stream or drainage to prevent discharge of pollutants from construction equipment into stream.					
Clean water diversion	Placed to divert clean surface or ground water from mixing with construction runoff or activity	X			X	
Other						

Non Structural BMPs and Application	Narrative	BMP As Designed	In Use On Site	FIRST CONSTRUCTION ACTIVITIES	DURING CONSTRUCTION	INTERIM/FINAL STABILIZATION
Surface Roughening/Grading Techniques	Interim and temp stabilization of disturbance and to minimize wind and erosion	X			X	X
Seeding Permanent/Final Stabilization	Reduce runoff and control erosion on disturbed areas	X			X	X
Seeding Temporary	Over wintering of disturbance or used to control erosion for areas scheduled for future construction					
Mulch/Mulch Tackifier/ Temp or Final Stabilization	Placed as a surface cover for erosion control and or seeding establishment	X			X	X
Soil Retention Blanket /Temp or Final Stabilization	Placed as surface cover for erosion control and seeding establishment					
Turf Reinforcement Mat/ Final Stabilization	Placed in channels or on slopes for erosion control, channel liner and seeding establishment					
Soil Binder/Temp Stabilization	Placed as surface treatment to provide temp erosion control					
Spray on mulch blanket/ Temp or Final Stabilization	Placed cover on slopes to control erosion and seeding establishment	X			X	X
Vegetative Buffer Strips	Filter sediment laden runoff from disturbance area	X		X	X	X
Protection Of Trees/Protected Resources -Fence Plastic	Placed prior to construction to protect existing vegetation to remain and to protect areas behind ROW without existing fence.	X		X	X	
Preservation Of Mature Vegetation/Work access and grading plans	Used to protect existing stable cover and minimize impact to vegetation	X		X	X	X

\*Check dams may be rock, erosion logs, silt dike, silt berm, etc. as indicated in the narratives and SWMP site map.

Erosion control devices are used to limit the amount of soil loss on site. Sediment control devices are designed to capture sediment on the project site. Construction control are BMPs related to construction access and staging. BMP locations are indicated on the SWMP site map for your information only.

C. OFFSITE DRAINAGE (RUN ON WATER)

1. Place BMPs to address run-on water in accordance with subsection 208.03.

D. CONSTRUCTION DEWATERING:

1. Obtain a dewatering permit from CDPHE if conditions of their low risk guidance for Discharges of Uncontaminated Groundwater to Land are not met; see subsection 107.25(b) 8.

E. VEHICLE TRACKING PAD

1. BMPs shall be implemented in accordance with subsection 208.04.

F. PERIMETER CONTROL

1. Perimeter control shall be established as the first item on the SWMP to prevent the potential for pollutants leaving the construction site boundaries, entering the stormwater drainage system, or discharging to state waters.  
2. Perimeter control may consist of vegetation buffers, berms, silt fence, erosion logs, existing landforms, or other BMPs as approved.  
3. Perimeter control shall be in accordance with subsection 208.04.

Print Date: 3/1/2013  
File Name: 18861DES\_SWMP\_Plan001.dgn  
Horiz. Scale: N/A Vert. Scale: N/A  
Unit Information: GJ Design JSL



Sheet Revisions

Date:	Comments	Init.

Colorado Department of Transportation



714 Grand Ave  
Eagle, CO 81631  
Phone: (970) 328-9962 FAX: (970) 328-2368

Region 03

PJL

As Constructed

No Revisions: 12/23/13

Revised:

Void:

STORMWATER MANAGEMENT  
PLAN NOTES & TABULATIONS

Designer: J. Klish  
Detailer: J. Klish  
Subset: SWMP Notes

Structure  
Numbers

Subset Sheets: 1 of 3

Project No./Code

C 131A-035

18861R

Sheet Number 45

2. DURING CONSTRUCTION

- A. MATERIALS HANDLING AND SPILL PREVENTION - prior to construction commencing the Contractor shall submit a Spill Prevention, Control and Countermeasure Plan, see subsection 208.06. Materials handling shall be in accordance with subsection 208.06.
- B. STOCKPILE MANAGEMENT - shall be done in accordance with subsection 107.25 and 208.07
- C. CONCRETE WASHOUT - Concrete wash out water or waste from field laboratories and paving equipment shall be contained in accordance with subsection 208.05.
- D. SAW CUTTING - shall be done in accordance with subsection 107.25, 208.04, 208.05
- E. STREET CLEANING - shall be done in accordance with subsection 208.04

3. INTERIM AND FINAL STABILIZATION

- A. SEEDING PLAN  
Soil preparation, soil conditioning or topsoil, seeding (native), mulching (weed free) and mulch tackifier will be required for an estimated 2.0 acres of disturbed area within the right-of-way limits which are not surfaced. The following types and rates shall be used:

The following types and rates shall be used at MP 3.09 & MP 5.13 areas:

COMMON NAME	SCIENTIFIC NAME	RATE LBS PLS/AC
'Garnet' Mountain Brome	Bromus marginatus	3
'Joseph' Idaho Fescue	Festuca idahoensis	2
'VNS' Needle and Thread	Hesperostipa comata	3
'VNS' Prairie Junegrass	Koeleria macrantha	1
'Arriba' Western Wheatgrass	Pascopyrum smithii	4
'High Plains' Sandberg Bluegrass	Poa secunda ssp. sandbergii	2
'P-7' Bluebunch Wheatgrass	Pseudoroegneria spicata ssp. spicata	4
TOTAL		19

The following types and rates shall be used at MP 36.42 through MP 37.70 areas:

COMMON NAME	SCIENTIFIC NAME	RATE LBS PLS/AC
'Sourdough' Bluejoint reedgrass	Calamagrostis canadensis	2
'Nortran' Tufted Hairgrass	Deschampsia caespitosa	1
VNS, American mannagrass	Glyceria grandis	1
VNS, Nebraska sedge	Carex nebrascensis	2.5
'Sodar' Streambank wheatgrass	Elymus lanceolatus spp. psammophilus	6
'Arriba' Western wheatgrass	Pascopyrum smithii	8
TOTAL		20.5

NOTE: VNS=Variety not stated

- B. SEEDING APPLICATION: Drill seed 0.25 inch to 0.5 inch into the soil. In small areas not accessible to a drill, hand broadcast at double the rate and rake 0.25 inch to 0.5 inch into the soil.
- C. MULCHING APPLICATION: Apply a minimum of 1 ½ tons of certified weed free hay per acre and in accordance with Section 212, and mechanically crimp it into the soil in combination with an organic mulch tackifier.
- D. SPECIAL REQUIREMENTS: Due to high failure rates, hydromulching and/or hydroseeding will not be allowed.
- E. SOIL CONDITIONING AND FERTILIZER REQUIREMENTS:

Soil conditioner paid for as Item 212- Soil Conditioning (Acre)		
Biological nutrient organic based fertilizer (lbs/acre)*	Humate (lbs/acre)	Compost (cy/acre) (1/2 inch depth)
600	200	65

\*Biological nutrient shall not exceed 8-8-8 (N-P-K). Humate based material shall be in accordance to Section 212 and compost shall be in accordance to Special Provision 212. Place compost when required to amend embankment and soil conditioner may be combined as a single application.

- F. BLANKET APPLICATION: On slopes and ditches requiring a blanket, the blanket shall be placed in lieu of mulch and mulch tackifier.

4. TABULATION OF STORMWATER QUANTITIES

ITEM NO.	ITEM DESCRIPTION	UNIT	QUANTITY	AS CONST.
208-00002	EROSION LOG (12 INCH)	LF	2360	
208-00045	CONCRETE WASHOUT STRUCTURE	EACH	6	
208-00070	VEHICLE TRACKING PAD	EACH	6	
208-00103	REMOVAL AND DISPOSAL OF SEDIMENT (LABOR)	HOURL	30	
208-00105	REMOVAL AND DISPOSAL OF SEDIMENT (EQUIPMENT)	HOURL	30	
212-00006	SEEDING (NATIVE)	ACRE	2	
212-00032	SOIL CONDITIONING	ACRE	2	
213-00003	MULCHING (WEED FREE)	ACRE	0.6	
213-00061	MULCH TACKIFIER	LB	120	
216-00015	SOIL RETENTION BLANKET (EXCELSIOR)	SY	6776	
240-00000	WILDLIFE BIOLOGIST	HOURL	40	
607-11525	FENCE (PLASTIC)	LF	3020	

It is anticipated that additional BMPs and BMP quantities not shown on the SWMP Site Maps shall be required on the project for unforeseen conditions and replacement of items that are beyond their useful service life, see subsection 208.03 and 208.04 (e). Quantities for all BMPs shown above are estimated, and have been increased for unforeseen Project conditions.

- A. BMP sediment removal and disposal shall be paid for as: 208 Removal and Disposal of Sediment (Equipment) and 208 Removal and Disposal of Sediment (Labor). All other BMP maintenance shall be included in the cost of the BMP Device.
- B. Maintenance of seeded areas shall be paid for as: Included in the price of the work.
- C. Each Concrete Washout Structure will be paid for once.

klishj 2:49:24 PM c:\projectwise\pwz\_working\402333335\18861DES\_SWMP\_Plan002.dgn

Print Date: 3/1/2013

File Name: 18861DES\_SWMP\_Plan002.dgn

Horiz. Scale: N/A      Vert. Scale: N/A

Unit Information: GJ Design      JSL

0000

Sheet Revisions

Date:	Comments	Init.

714 Grand Ave  
Eagle, CO 81631  
Phone: (970) 328-9962 FAX: (970) 328-2368

Region 03

PJL

As Constructed

No Revisions: 12/23/13

Revised:

Void:

STORMWATER MANAGEMENT PLAN NOTES & TABULATIONS

Designer: J. Klish	Structure Numbers
Detailer: J. Klish	
Subset: SWMP Notes	Subset Sheets: 2 of 2



Project No./Code

C 131A-035

18861R

Sheet Number 46



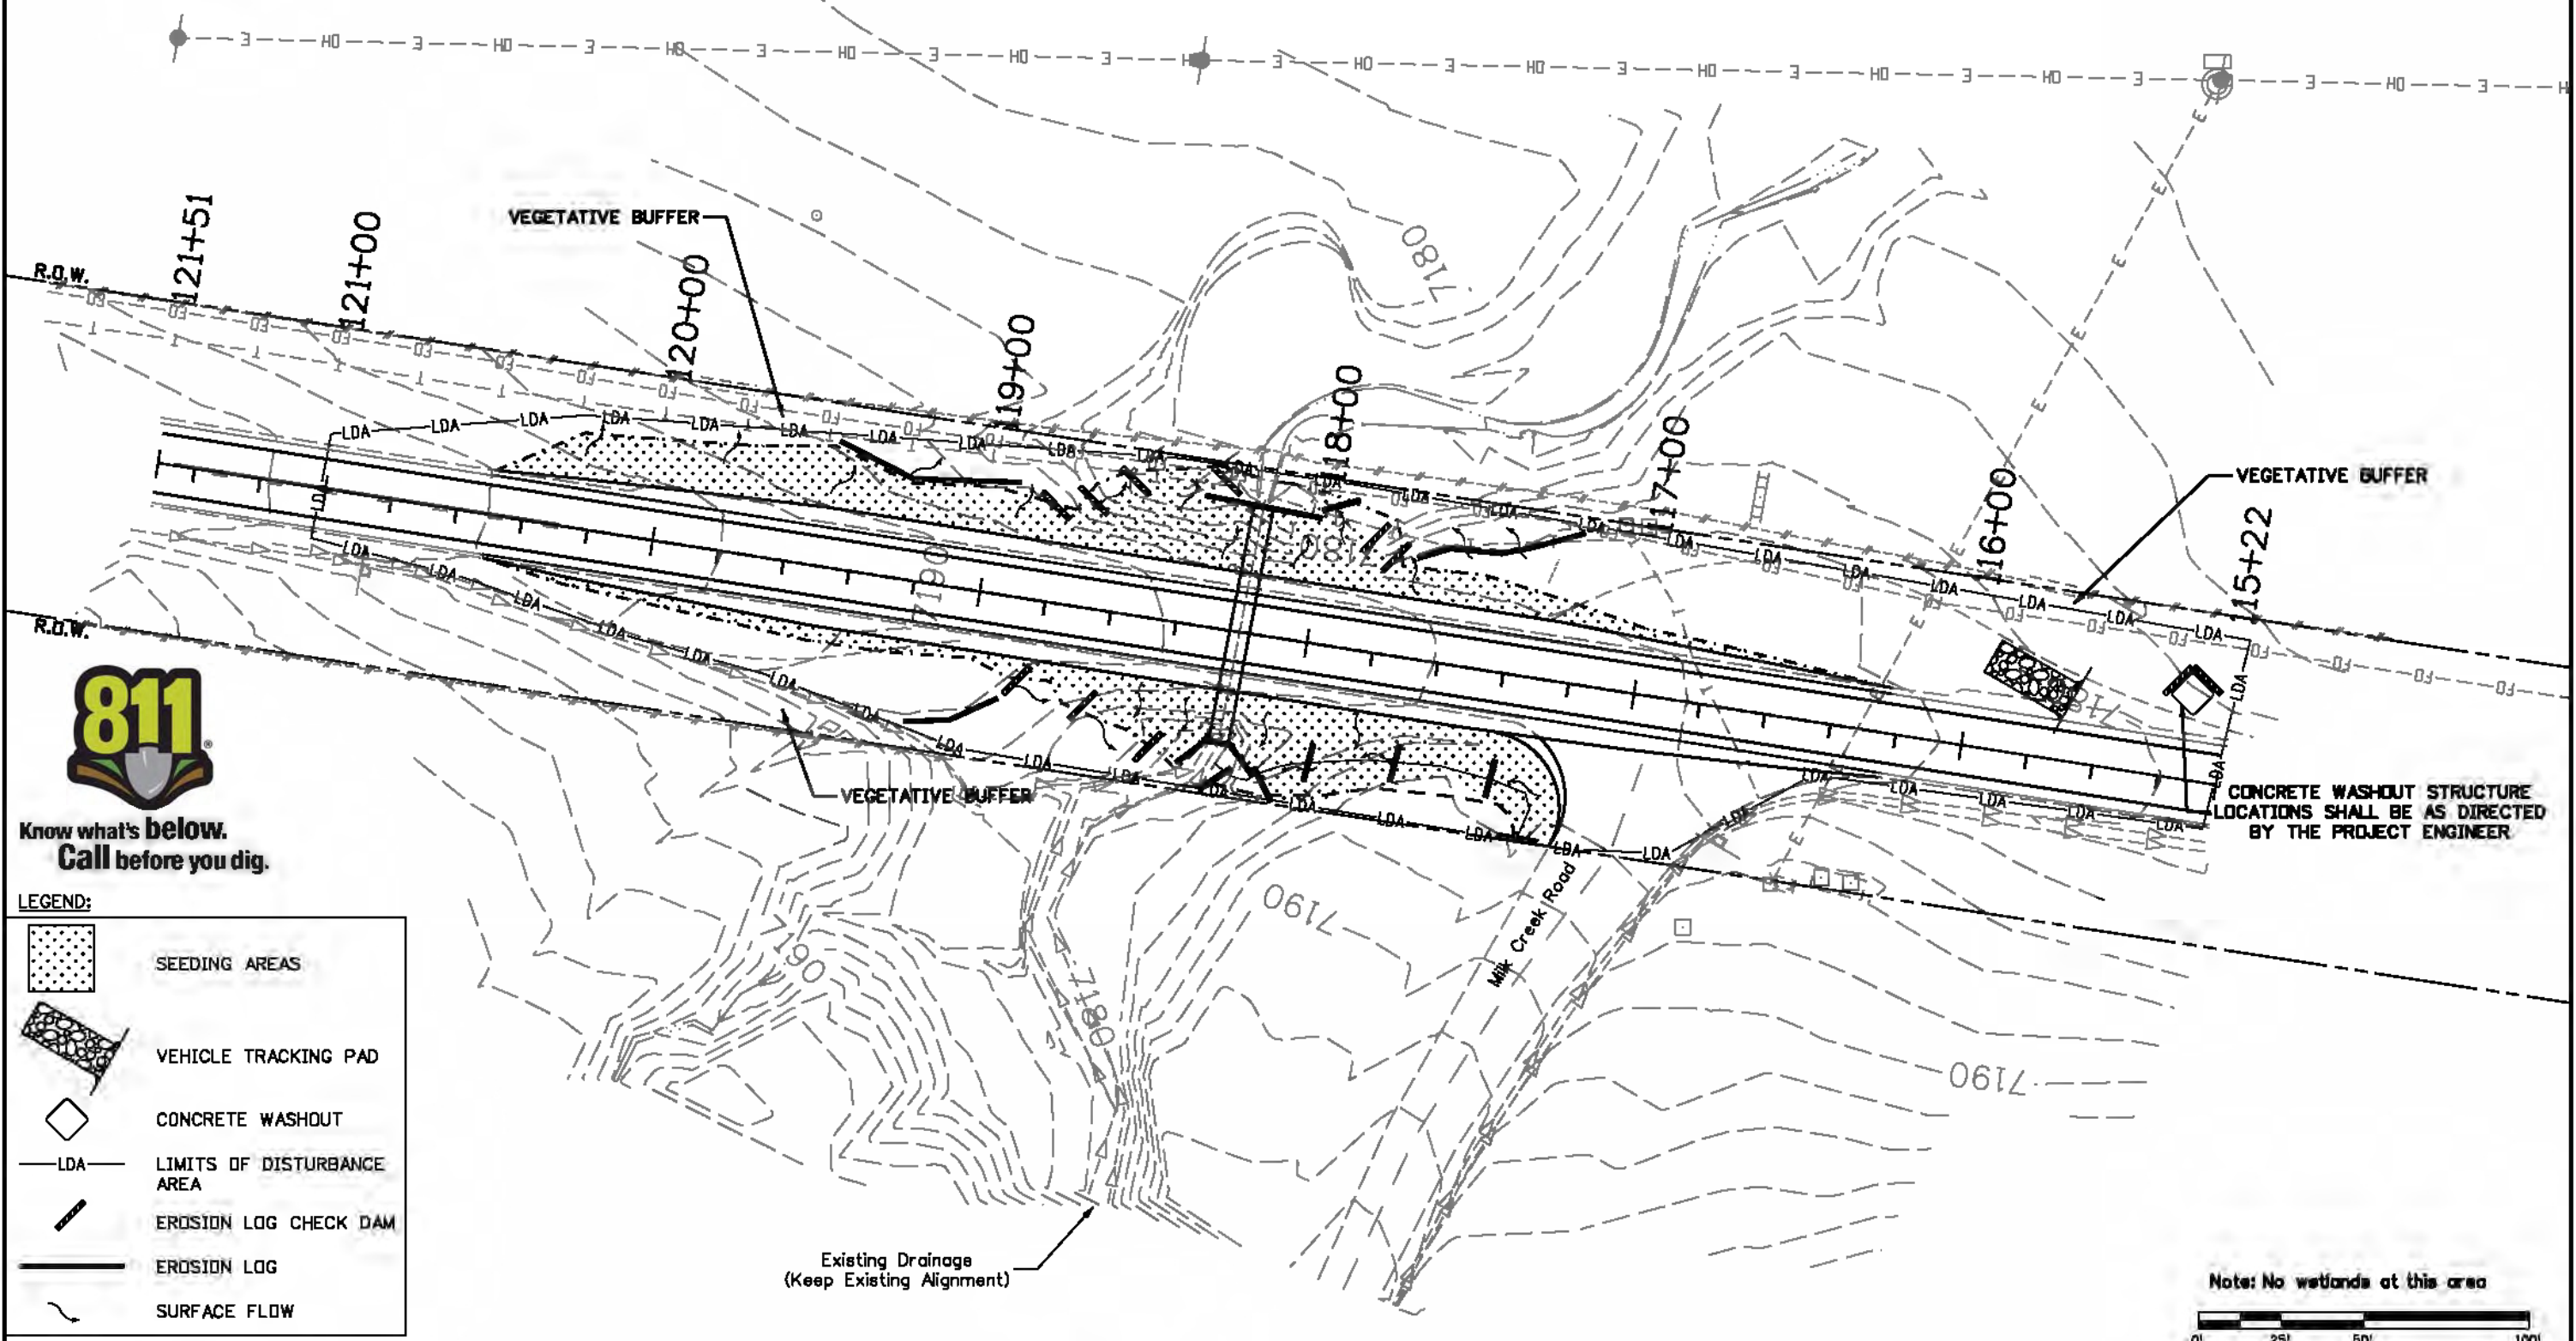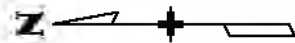

**LEGEND:**

	SEEDING AREAS
	VEHICLE TRACKING PAD
	CONCRETE WASHOUT
	LDA LIMITS OF DISTURBANCE AREA
	EROSION LOG CHECK DAM
	EROSION LOG
	SURFACE FLOW

Print Date: 3/1/2013
File Name: 1886IDES_SWMP_Map001.dgn
Horiz. Scale: 1:50      Vert. Scale: N/A
Unit Information: GJ Design      JSL

Sheet Revisions		
Date:	Comments	Init.

Colorado Department of Transportation

714 Grand Ave.  
Eagle, CO 81631  
Phone: (970) 328-9962 FAX: (970) 328-2368

Region 03      P.J.L.

As Constructed
No Revisions: 12/23/13
Revised:
Void:




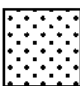
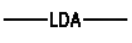



STORMWATER MANAGEMENT PLAN SITE MAP MP 3.09			
Designer:	J. Klish	Structure	MP 3.09
Detailer:	J. Klish	Numbers	131B003090
Subset:	SWMP MAP	Subset Sheets:	1 of 6

Project No./Code
C 131A-035
1886R
Sheet Number 47

klshj 2:48:38 PM c:\projects\swmp\working\1886IDES\_SWMP\_Map001.dgn




LEGEND:

	VEHICLE TRACKING PAD		SURFACE FLOW ARROW
	CONCRETE WASHOUT		SEEDING AREAS
	LDA LIMITS OF DISTURBANCE AREA		EROSION LOG CHECK DAM
	PF PLASTIC FENCE		EROSION LOG




Know what's below.  
Call before you dig.

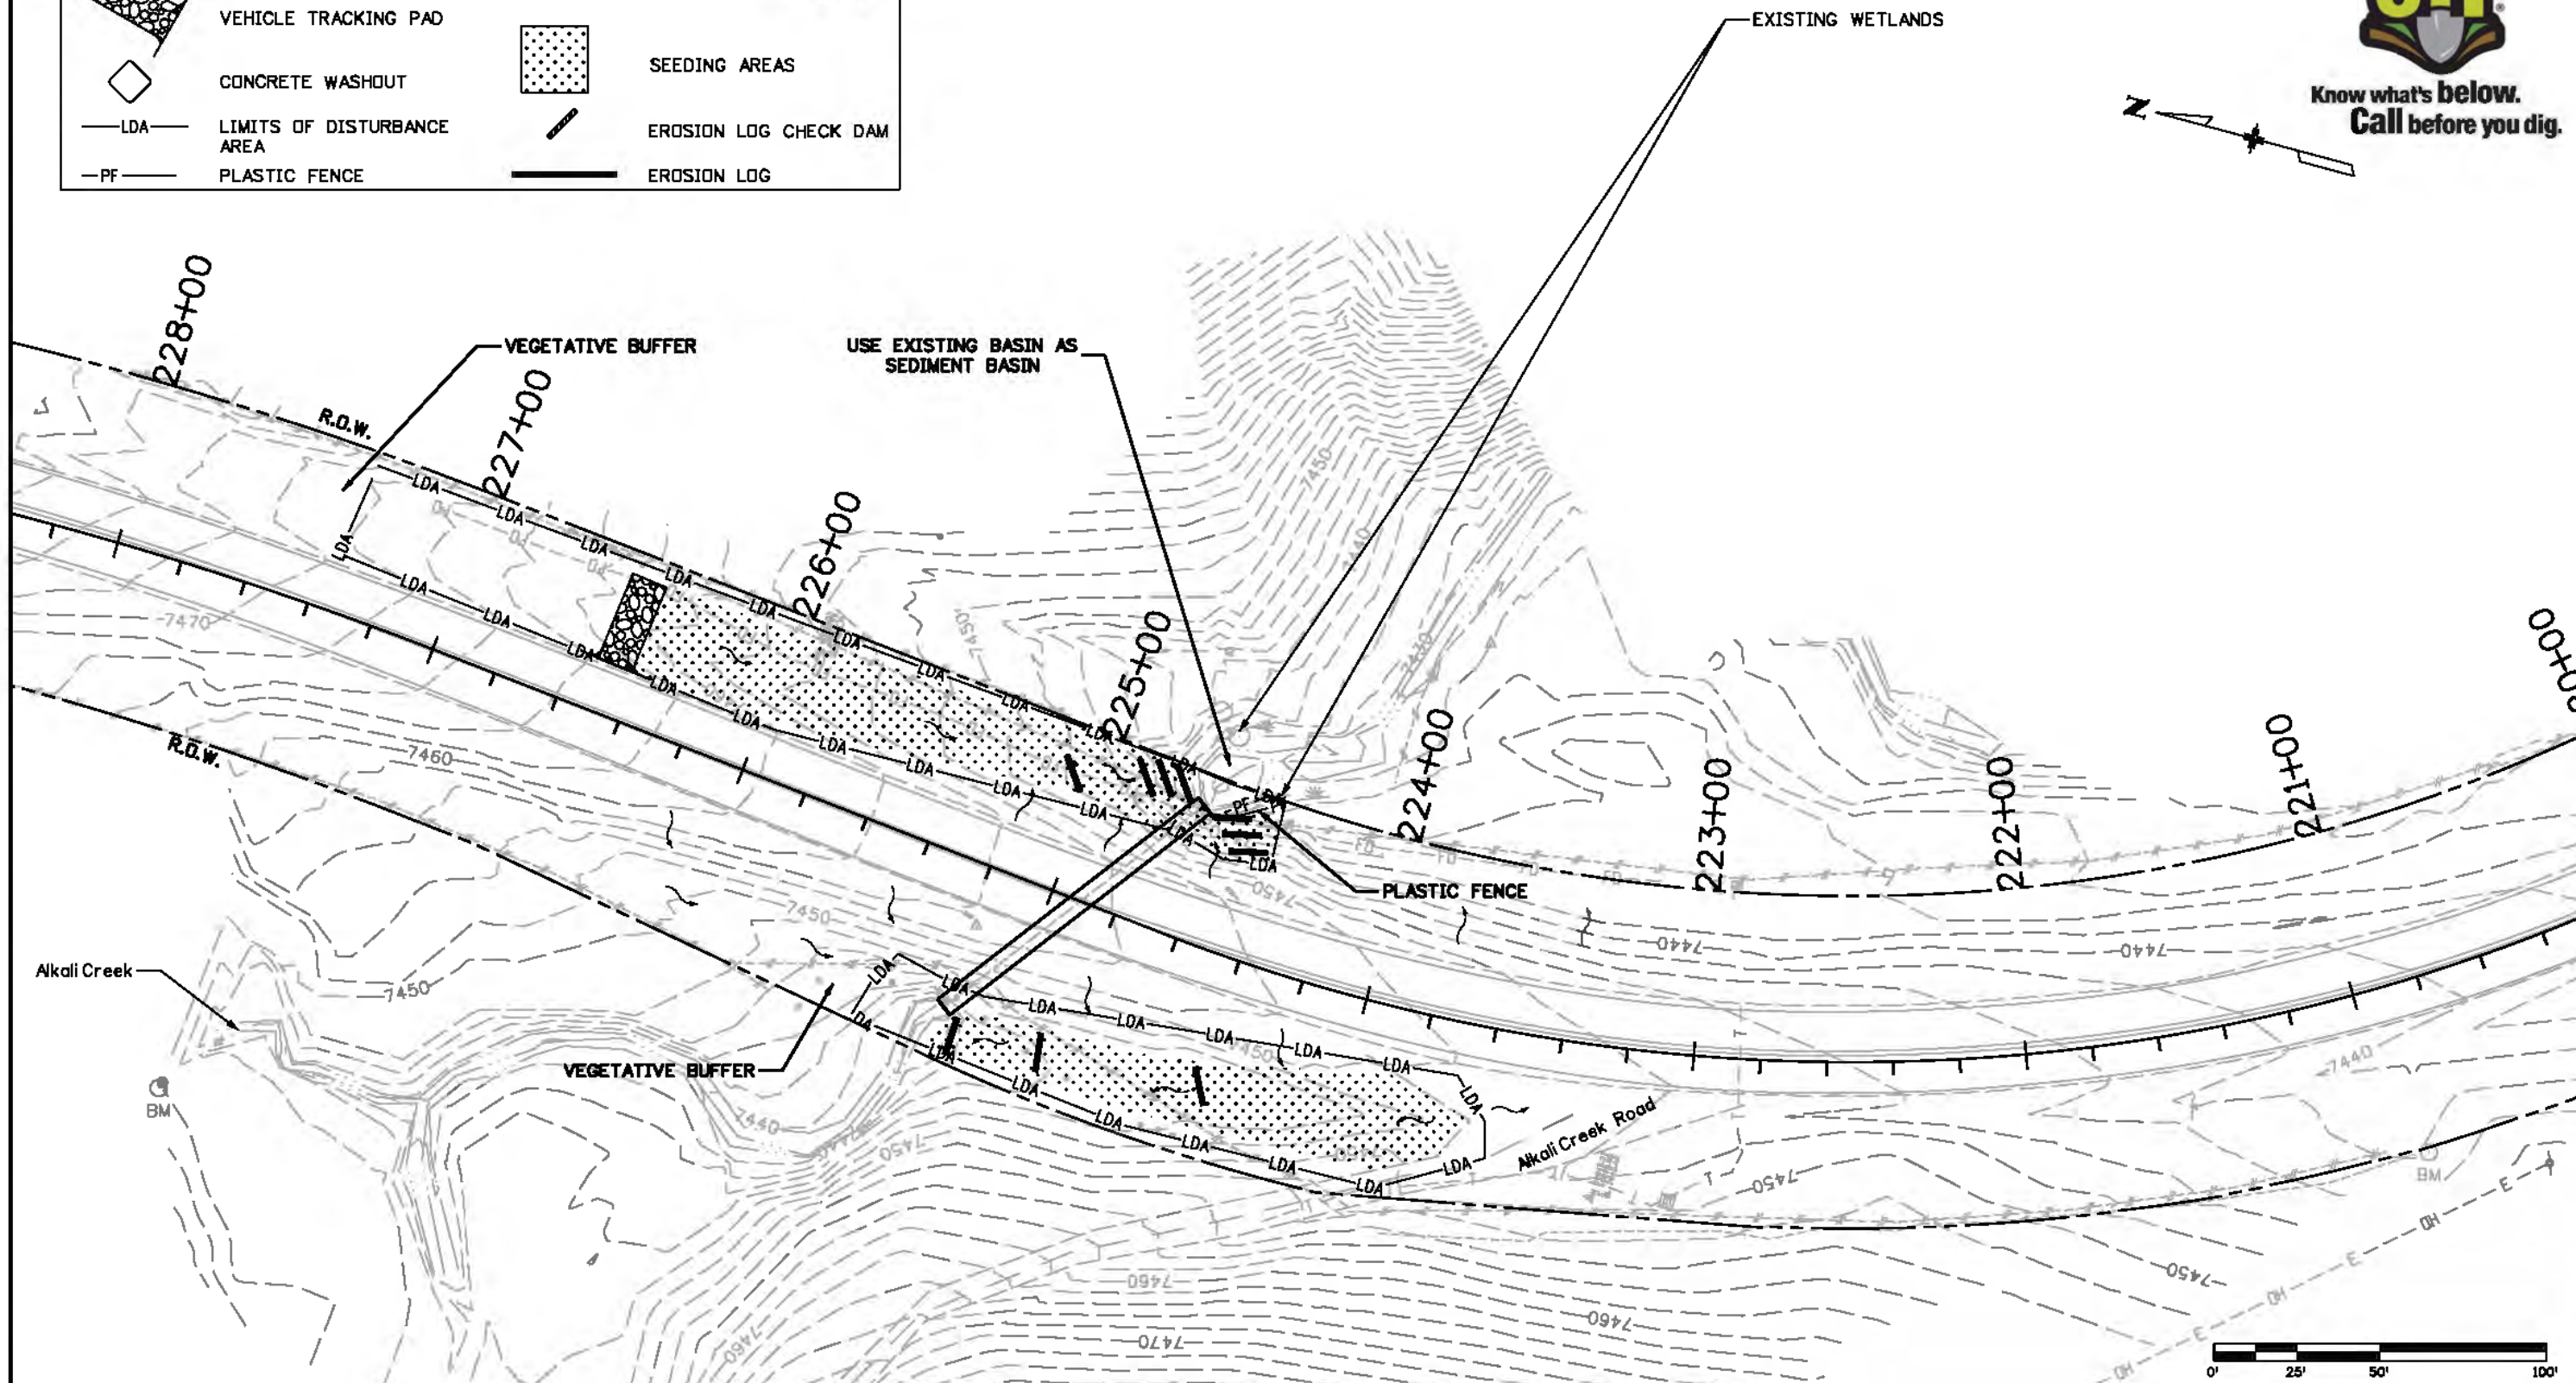

Print Date: 3/1/2013		0000	Sheet Revisions			Colorado Department of Transportation		As Constructed		STORMWATER MANAGEMENT PLAN SITE MAP MP 5.13				Project No./Code	
File Name: 18861DES_SWMP_Map002.dgn			Date:	Comments	Init.	 714 Grand Ave Eagle, CO 81631 Phone: (970) 328-9962 FAX: (970) 328-2368 Region 03	No Revisions: 12/23/13		Designer: J. Klish Detailer: J. Klish		Structure Numbers MP 5.13 131B005130		C 131A-D35		
Horiz. Scale: 1:50      Vert. Scale: N/A													18861R		
Unit Information: GJ Design      JSL											Sheet Number 48				

Colorado Department of Transportation



714 Grand Ave  
Eagle, CO 81631  
Phone: (970) 328-9962 FAX: (970) 328-2368







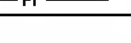

Region 03



PJL

\\c:\projects\18861DES\_SWMP\_Map002.dgn



LEGEND:

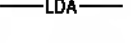
	VEHICLE TRACKING PAD		SURFACE FLOW ARROW
	CONCRETE WASHOUT		SEEDING AREAS
	LDA LIMITS OF DISTURBANCE AREA		EROSION LOG CHECK DAM
	PF PLASTIC FENCE		EROSION LOG

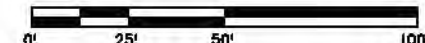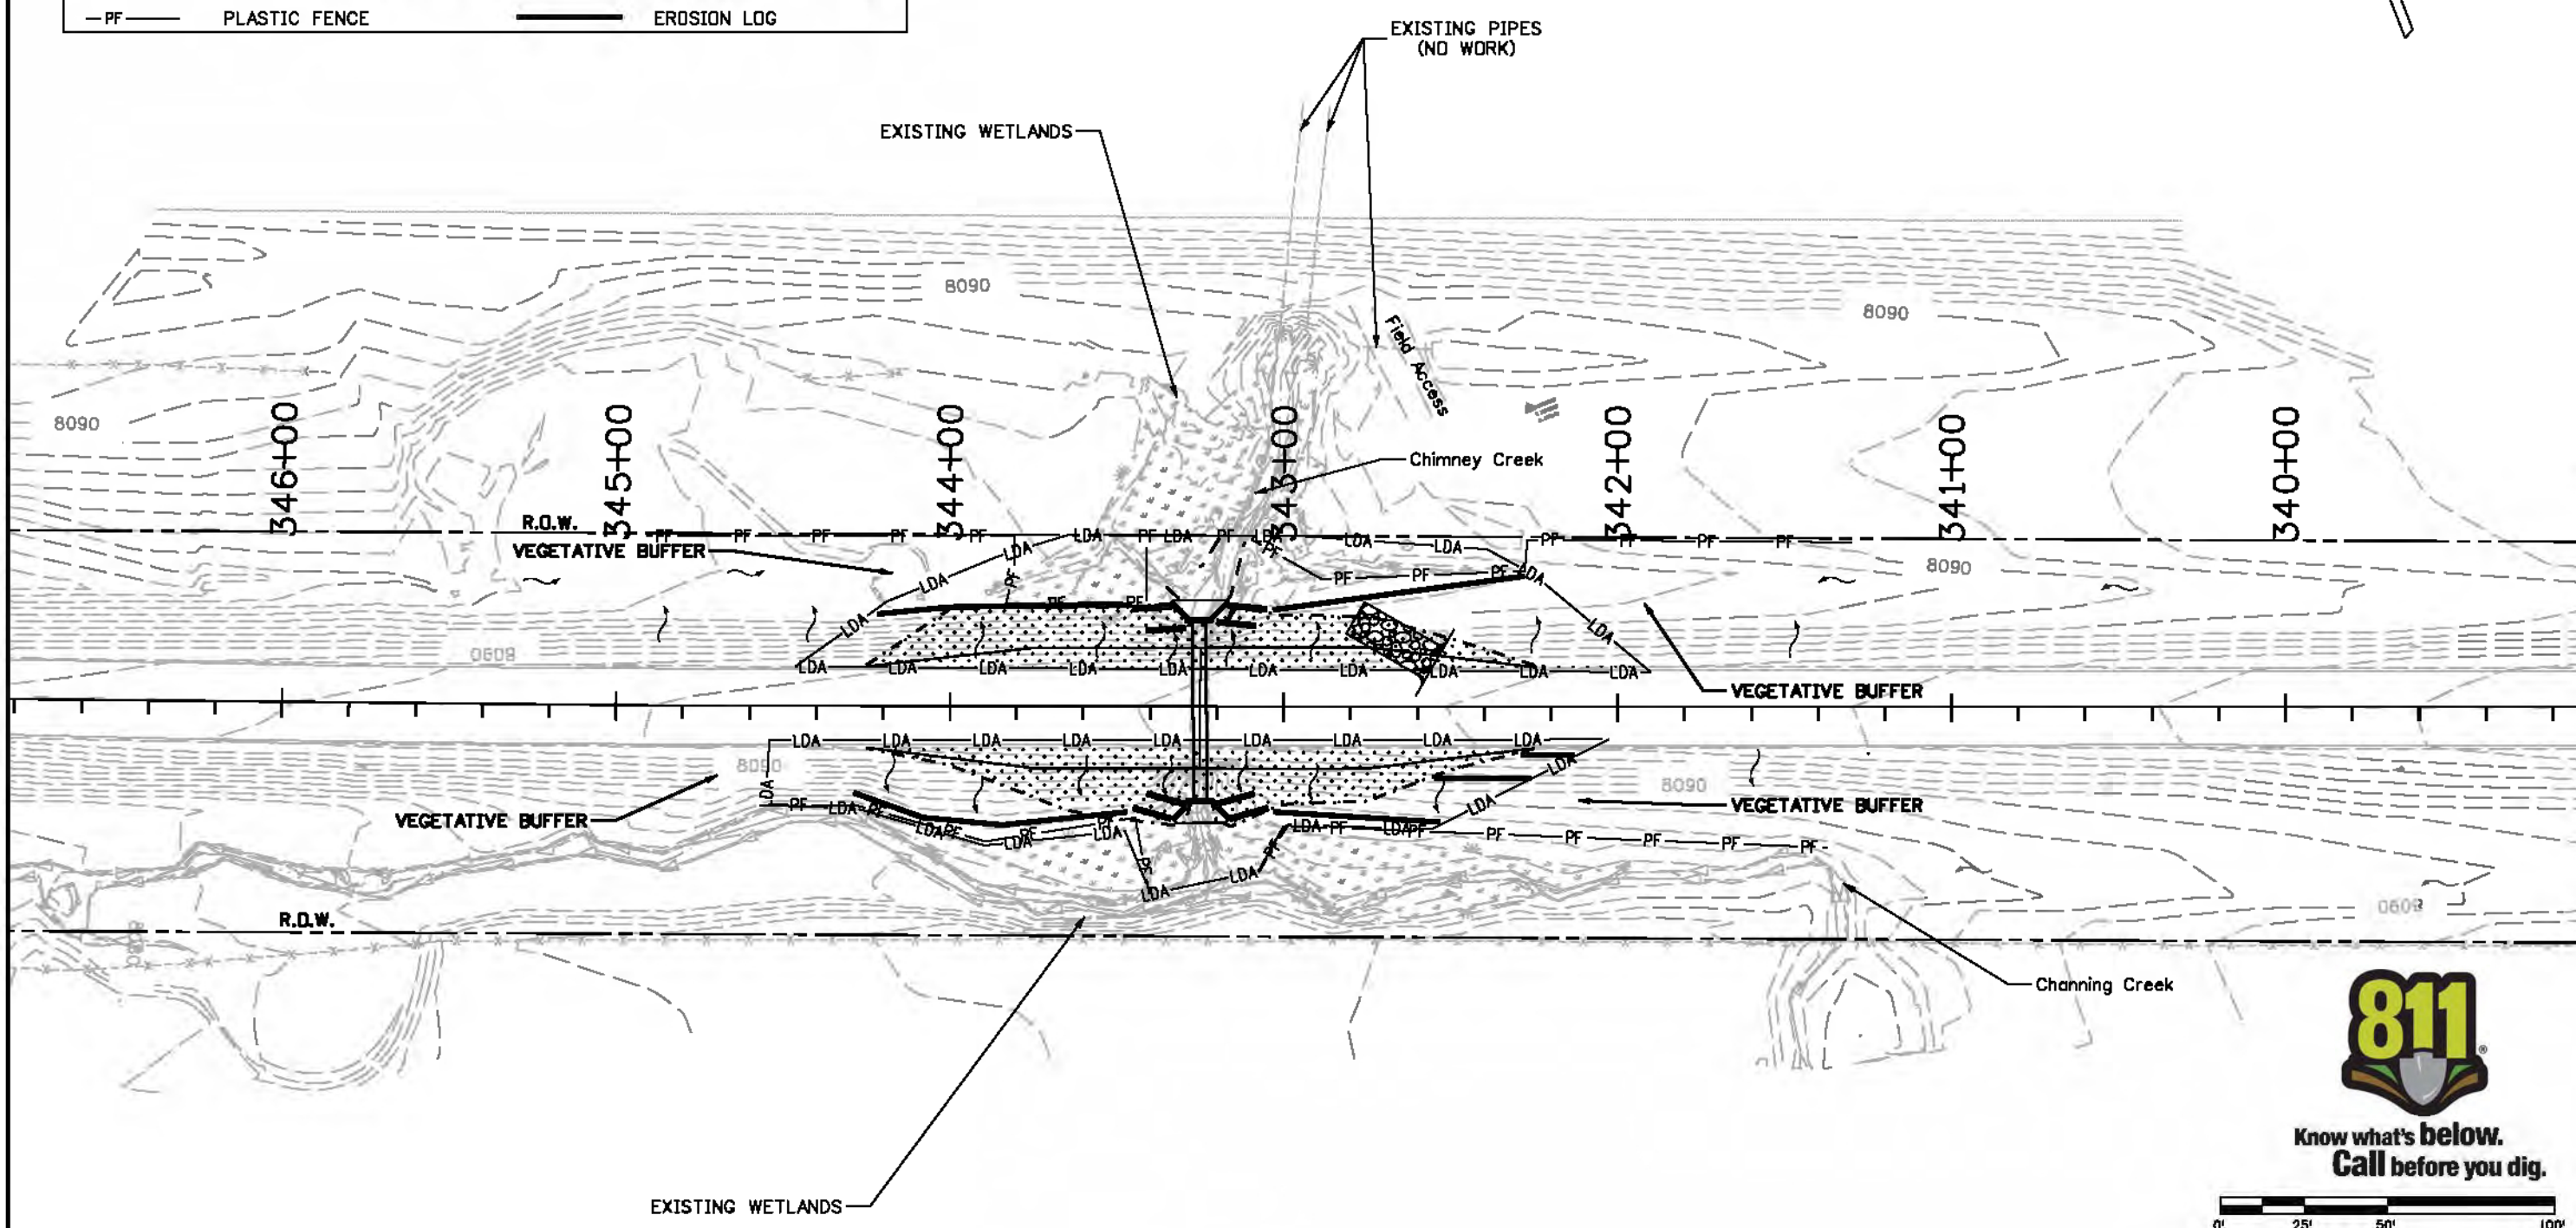

Print Date: 3/1/2013		0000	Sheet Revisions			Colorado Department of Transportation		As Constructed		STORMWATER MANAGEMENT PLAN SITE MAP MP 36.42			Project No./Code	
File Name: 18861DES_SWMP_Map003.dgn			Date:	Comments	Init.	 714 Grand Ave Eagle, CO 81631 Phone: (970) 328-9962 FAX: (970) 328-2368 Region 03	No Revisions: 12/23/13		Designer: J. Klish Structure Numbers: MP 36.42 Detailer: J. Klish 131B036420			C 131A-035		
Horiz. Scale: 1:50      Vert. Scale: N/A							Revised:					Sheet Number 49		
Unit Information: GJ Design      JSL							Void:		Subset: SWMP MAP      Subset Sheets: 3 of 6					

k:\proj\18861\18861DES\_SWMP\_Map003.dgn 2:49:51 PM 3/1/2013



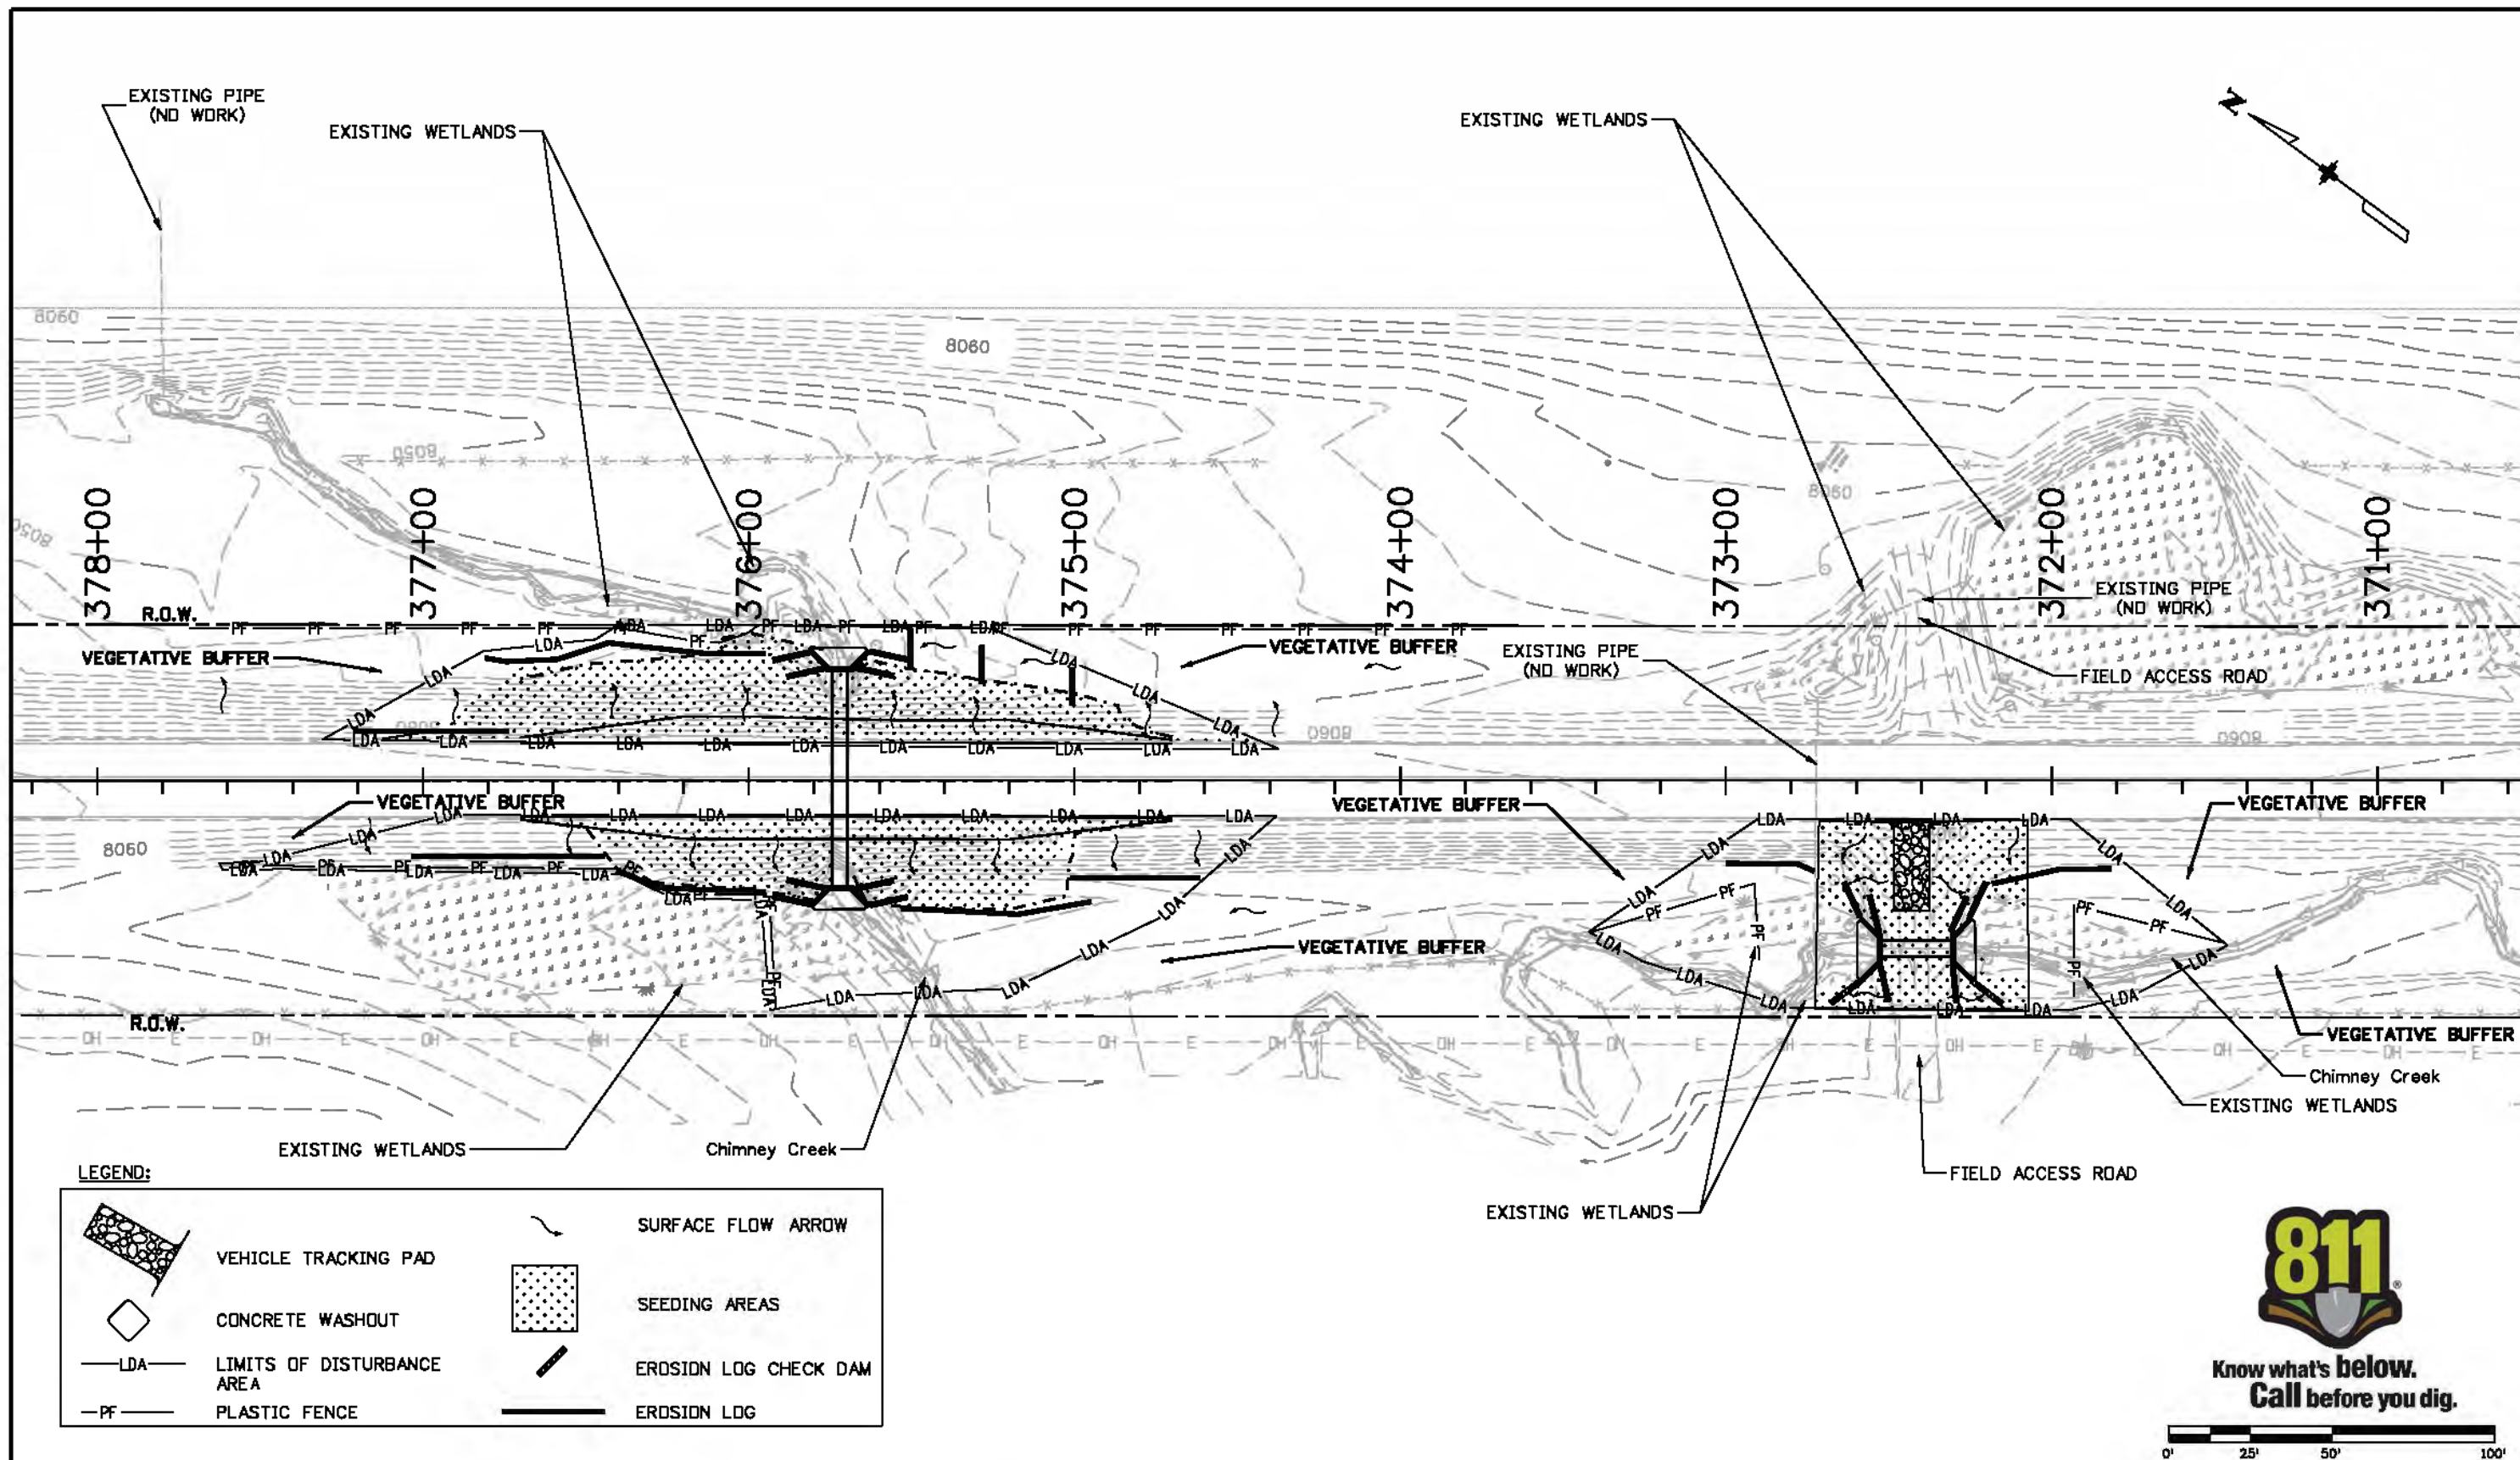


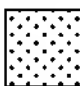
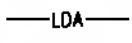





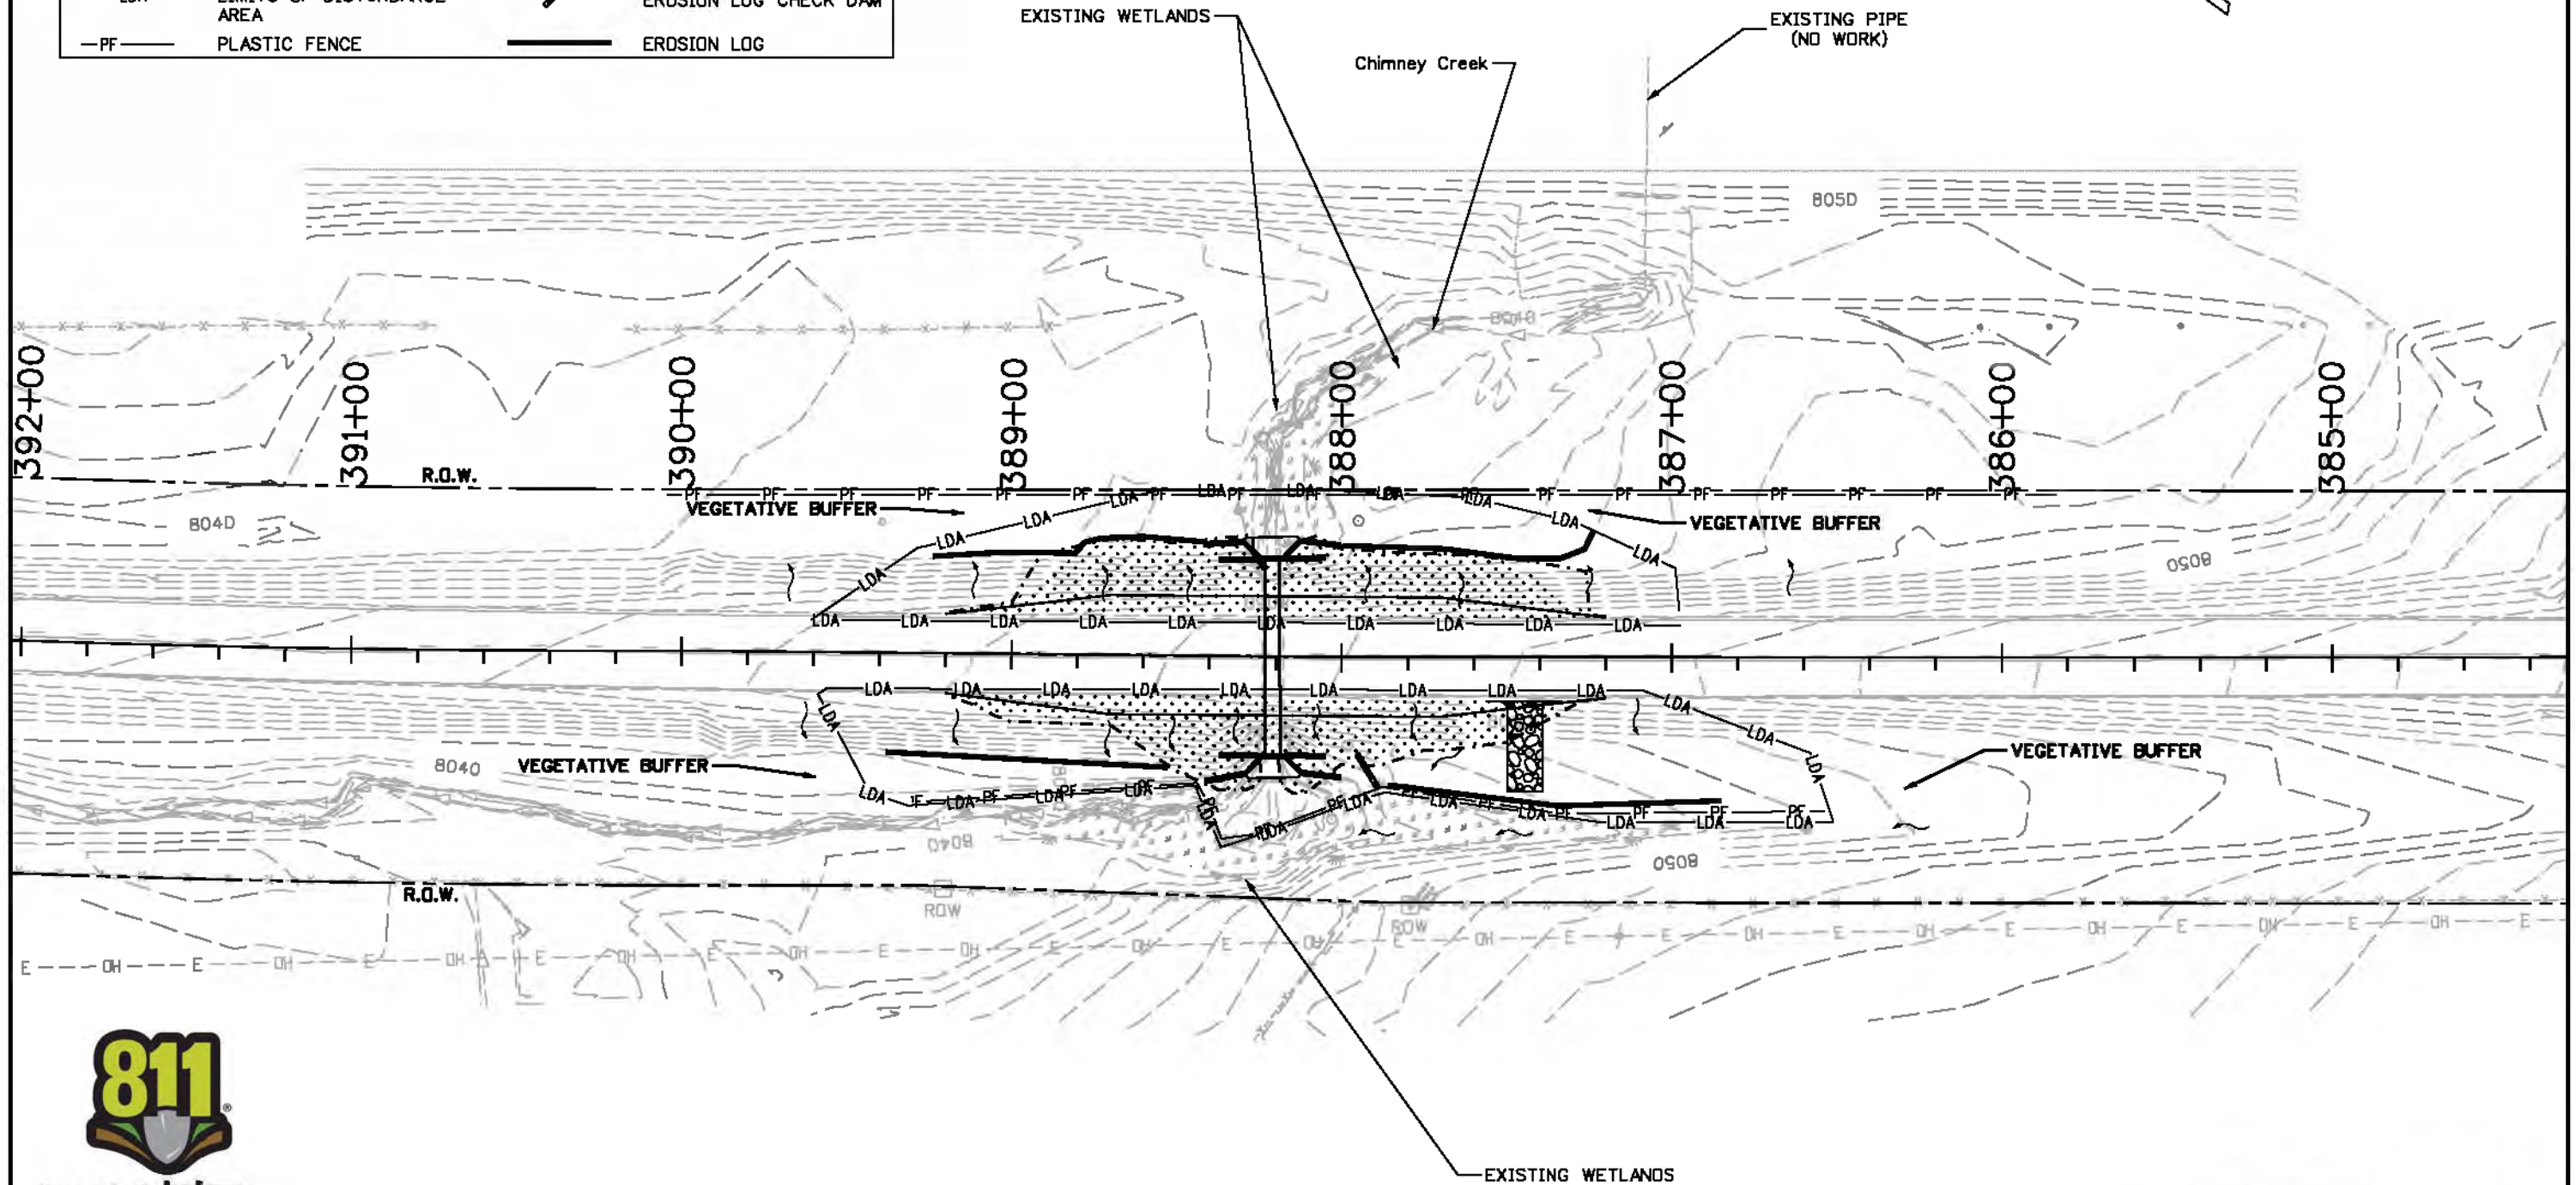
Print Date: 3/1/2013		0000	Sheet Revisions			Colorado Department of Transportation		As Constructed		STORMWATER MANAGEMENT PLAN SITE MAP MP 37.08 & MP 37.11			Project No./Code	
File Name: 18861DES_SWMP_Map004&5.dgn			Date:	Comments	Init.	 714 Grand Ave Eagle, CO 81631 Phone: (970) 328-9962 FAX: (970) 328-2368 Region 03	No Revisions: 12/23/13		Designer: J. Klish Structure Numbers: MP 37.11 Detailer: J. Klish 131B037110			C 131A-035		
Horiz. Scale: 1:50      Vert. Scale: N/A							Revised:					18861R		
Unit Information: GJ Design      JSL							Void:		Subset: SWMP MAP      Subset Sheets: 4 of 6		Sheet Number 50			
						PJL								

kshj 2:48:58 PM c:\projects\18861\18861DES\_SWMP\_Map004&5.dgn



LEGEND:

	VEHICLE TRACKING PAD		SURFACE FLOW ARROW
	CONCRETE WASHOUT		SEEDING AREAS
	LIMITS OF DISTURBANCE AREA		EROSION LOG CHECK DAM
	PLASTIC FENCE		EROSION LOG




Know what's below.  
Call before you dig.

Print Date: 3/1/2013
File Name: 18861DES_SWMP_Map006.dgn
Horiz. Scale: 1:50 Vert. Scale: N/A
Unit Information: GJ Design JSL

0000

Sheet Revisions

Date:	Comments	Init.

Colorado Department of Transportation  
  
 714 Grand Ave  
 Eagle, CO 81631  
 Phone: (970) 328-9962 FAX: (970) 328-2368  
 Region 03 P.J.L.

As Constructed

No Revisions: 12/23/13
Revised:
Void:




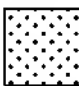
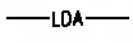



STORMWATER MANAGEMENT  
PLAN SITE MAP  
MP 37.34


Designer: J. Klish	Structure Numbers: MP37.34
Detailer: J. Klish	131B037340
Subset: SWMP MAP	Subset Sheets: 5 of 6

Project No./Code

C 131A-035
18861R
Sheet Number 51

LEGEND:

	VEHICLE TRACKING PAD		SURFACE FLOW ARROW
	CONCRETE WASHOUT		SEEDING AREAS
	LDA LIMITS OF DISTURBANCE AREA		EROSION LOG CHECK DAM
	PF PLASTIC FENCE		EROSION LOG

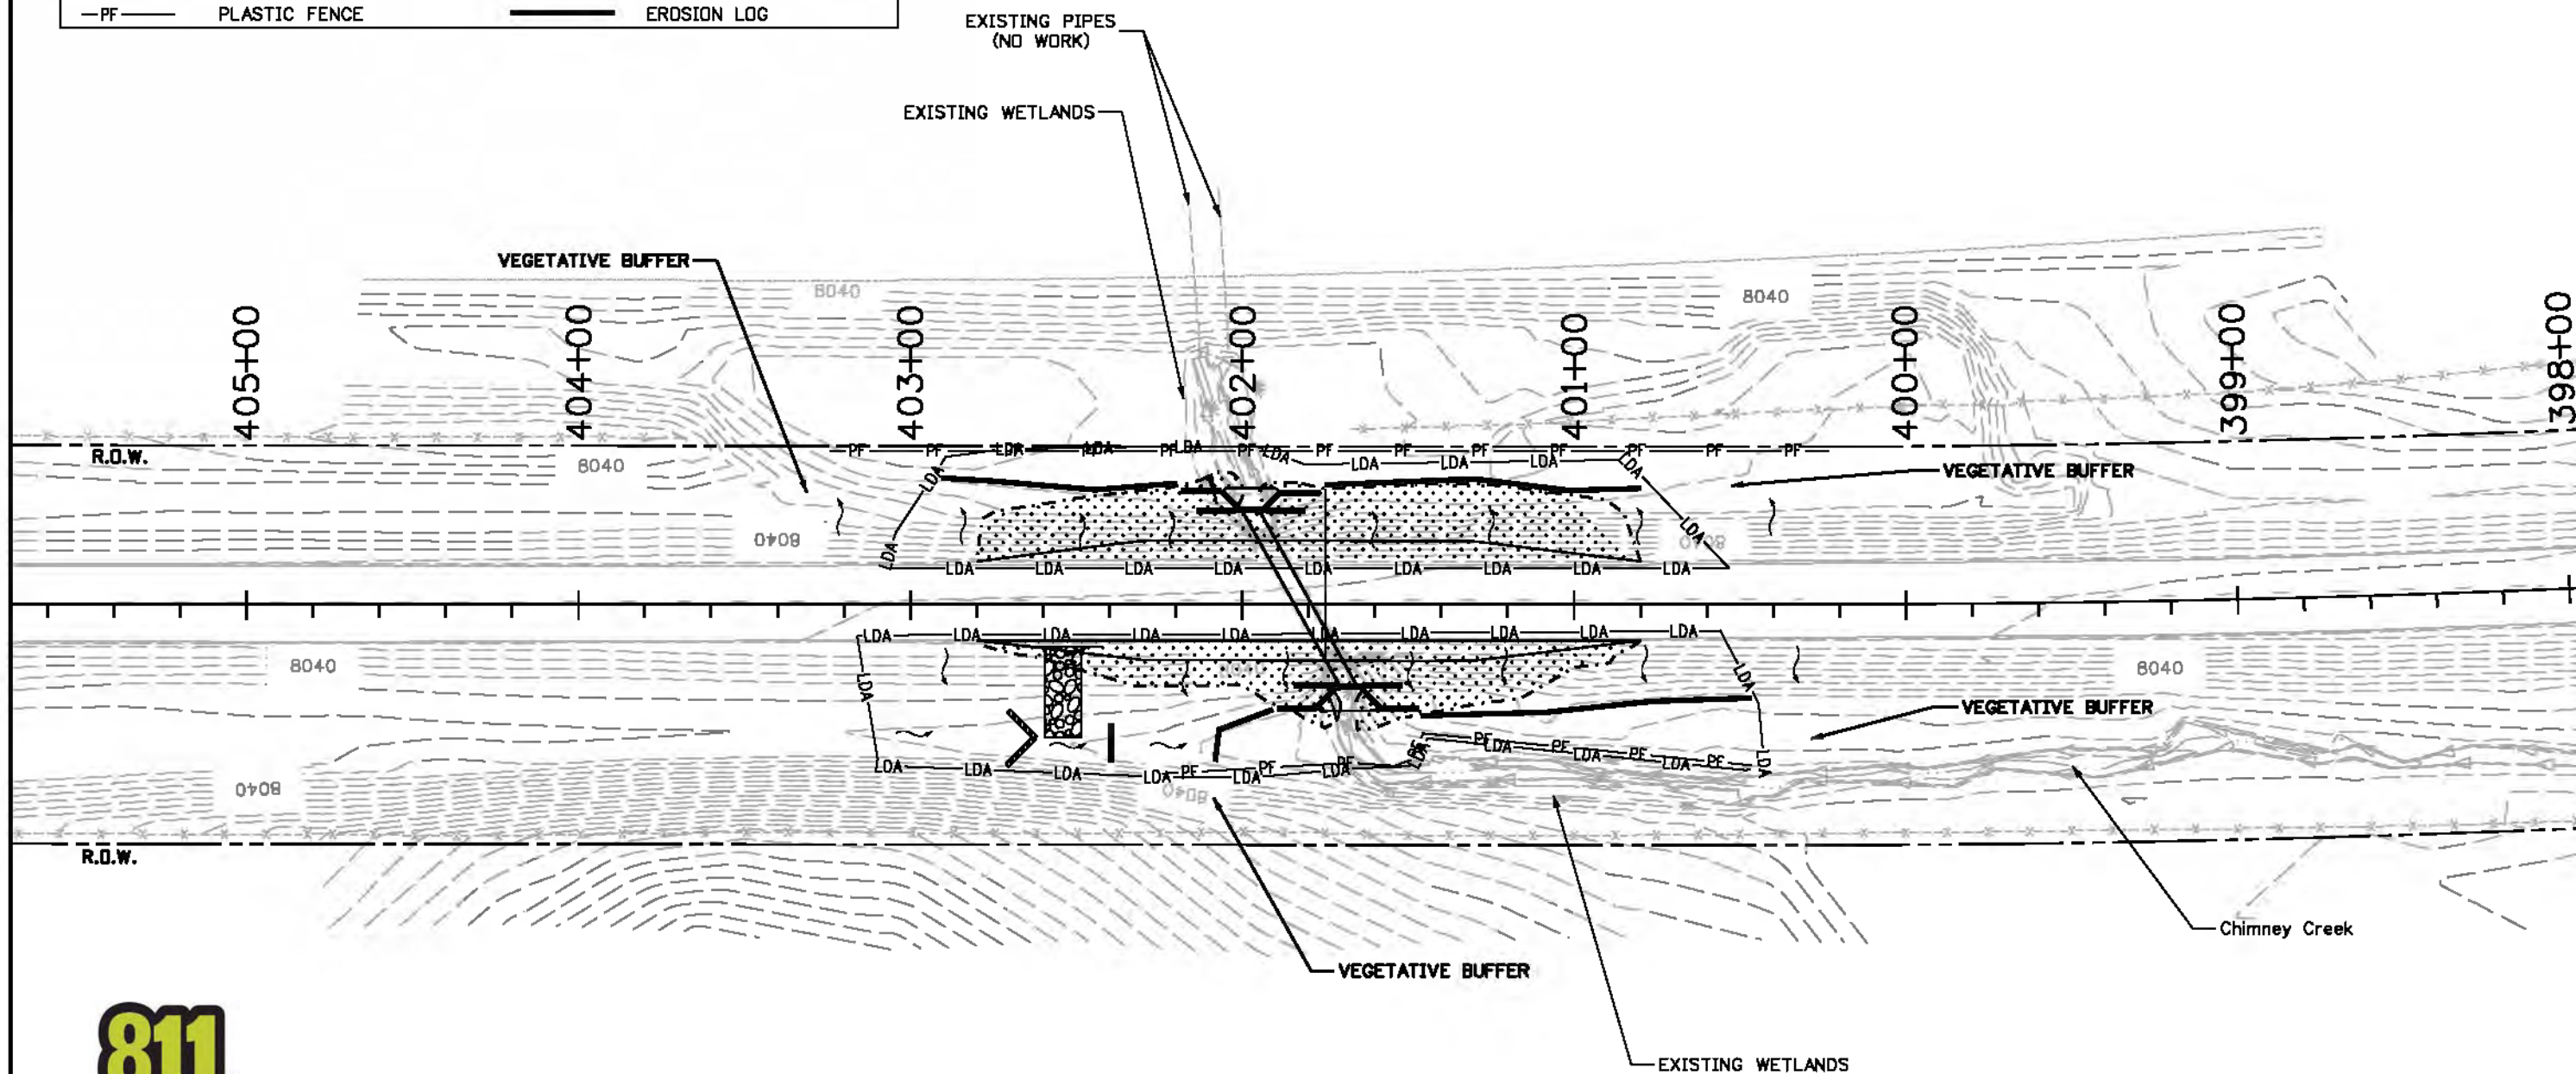

Know what's below.  
Call before you dig.



Print Date: 3/1/2013		<div>0000</div>	Sheet Revisions			Colorado Department of Transportation		As Constructed		STORMWATER MANAGEMENT PLAN SITE MAP MP 37.70				Project No./Code	
File Name: 18861DES_SWMP_Map007.dgn			Date:	Comments	Init.	 714 Grand Ave Eagle, CO 81631 Phone: (970) 328-9982 FAX: (970) 328-2388 Region 03	No Revisions: 12/23/13		Designer: J. Klish Detailer: J. Klish Subset: SWMP MAP				C 131A-035		
Horiz. Scale: 1:50      Vert. Scale: N/A							Revised:						Structure      MP 37.70		
Unit Information: GJ Design      JSL							Void:		Numbers      131B037700		18861R				
									Subset Sheets: 6 of 6		Sheet Number 52				
						PJL									



klishj 2:50:17 PM c:\projectwise\pwr\_working\00233335\1886IDES\_Tab\_TCD.dgn

TABULATION OF CONSTRUCTION TRAFFIC CONTROL DEVICES

SIGN CODE	LEGEND	DIMENSION	PAY ITEMS					
			EACH				SF	
			(630-80341) CONSTRUCTION TRAFFIC SIGN (PANEL SIZE A)		(630-80342) CONSTRUCTION TRAFFIC SIGN (PANEL SIZE B)		(630-80344) CONSTRUCTION TRAFFIC SIGN (SPECIAL)	
			Plan	As Const	Plan	As Const	Plan	As Const
W20-1	ROAD / WORK / AHEAD	48 x 48			5			
W20-4	ONE LANE / ROAD / XX FT	48 x 48			3			
R52-6a	BEGIN / FINES / DOUBLED / IN WORK / ZONE	36 x 48			6			
R2-6aP	FINES / DOUBLE	36 x 24	4					
R2-6a	SPEED/LIMIT/35	36 x 48			6			
G20-5	WORK/ZONE	36 x 12	12					
W20-5	RIGHT/LEFT LANE/CLOSED/AHEAD	48 x 48			4			
R4-1	DO/NOT/PASS	24 x 30	4					
R11-2	ROAD/CLOSED	48 x 30			2			
W1-6L	LARGE ARROW (ONE DIRECTION)(LEFT)	48 x 24	2					
W1-6R	LARGE ARROW (ONE DIRECTION)(RIGHT)	48 x 24	2					
R52-6b	END/FINES/DOUBLE/IN WORK/ZONE	36 x 48			4			
G20-10	XYZ/CONSTRUCTION/THANKS YOU/555-555-5555	48 x 48			2			
R2-6b	SPEED/LIMIT/50	36 x 48			4			
W20-7	FLAGGER/AHEAD	48 x 48			5			
W20-7a	FLAGGER SYMBOL	48 x 48			5			
W3-4	BE/PREPARED/TO STOP	48 x 48			4			
W21-5	SHOULDER/WORK	48 x 48			4			
W21-5aR	RIGHT/SHOULDER/CLOSED	48 x 48			4			
W21-5bR	RIGHT/SHOULDER/CLOSED/AHEAD	48 x 48			2			
R10-6	STOP HERE ON RED	24 x 36	2					
SPECIAL	* TEMPORARY SIGNAL INSTRUCTIONS	60 x 60					25	
SIGN TOTALS			26	3	60	46	25	0




\* TEMPORARY SIGNAL INSTRUCTIONS SHOULD BE USED AT MILK CREEK ROAD INTERSECTION TO AID THE TEMPORARY TRAFFIC SIGNAL OPERATIONS.

CODE	ITEM	UNIT	PLAN	AS CONST
630-00000	FLAGGING	HOURL	1560	1527
630-00007	TRAFFIC CONTROL INSPECTION	DAYS	40	33
630-00012	TRAFFIC CONTROL MANAGEMENT	DAYS	65	87
630-80336	BARRICADE (TYPE 3 M-B)(TEMPORARY)	EACH	4	1
630-80355	PORTABLE MESSAGE SIGN PANEL	EACH	2	2
630-80360	DRUM CHANNELIZING DEVICE	EACH	50	28
630-80363	DRUM CHANNELIZING DEVICE (WITH LIGHT) (FLASHING)	EACH	20	4
630-80364	DRUM CHANNELIZING DEVICE (WITH LIGHT) (STEADY BURN)	EACH	20	2
630-80367	PORTABLE TRAFFIC SPEED MONITOR	EACH	1	1
630-80370	CONCRETE BARRIER (TEMPORARY)	LF	300	300
630-80380	TRAFFIC CONE	EACH	300	63
630-85010	IMPACT ATTENUATOR (TEMPORARY)	EACH	2	2
630-86800	**TRAFFIC SIGNAL (TEMPORARY)	LS	1	1

\*\* TRAFFIC SIGNAL (TEMPORARY) SHALL BE USED AT MP 3.09 WORK AREA.

Print Date: 3/1/2013	0000	Sheet Revisions			Colorado Department of Transportation		As Constructed		TABULATION OF CONSTRUCTION TRAFFIC CONTROL DEVICES			Project No./Code
File Name: 1886IDES_Tab_TCD.dgn		Date:	Comments	Init.	 714 Grand Ave. Eagle, CO 81631 Phone: (970) 328-9962 FAX: (970) 328-2368 Region 03	P.J.L	No Revisions: 12/23/13		Designer: J. Klish	Structure		C 131A-035
Horiz. Scale: N/A Vert. Scale: N/A							Revised:		Detailer: J. Klish	Numbers		18861R
Unit Information: GJ Design JSL							Void:		Subset: ConstTrafTab	Subset Sheets: 1 of 1		Sheet Number 53




klishj 2:50:27 PM c:\projectwise\pwz\_working\p0233336\18861DES\_MP0309\_CrossSections.dgn

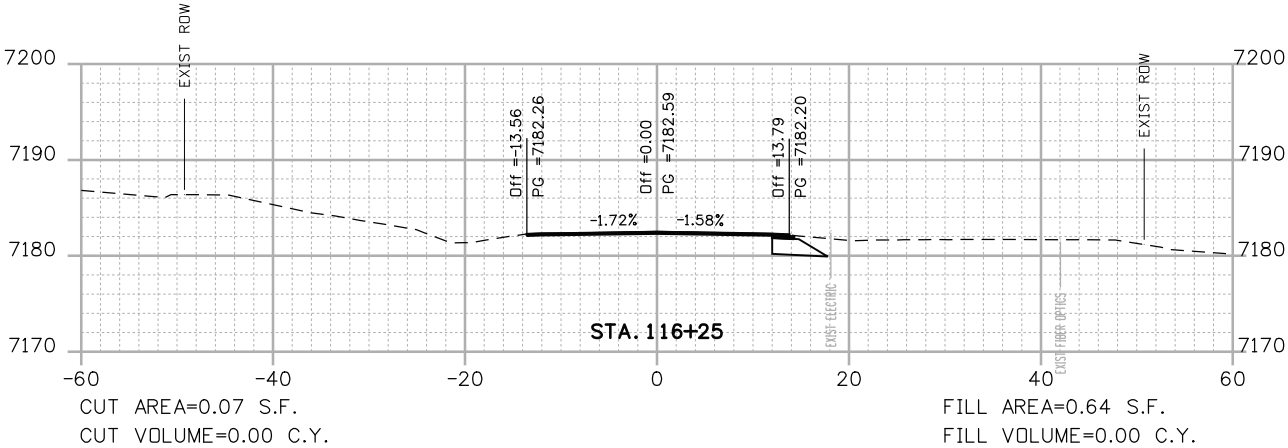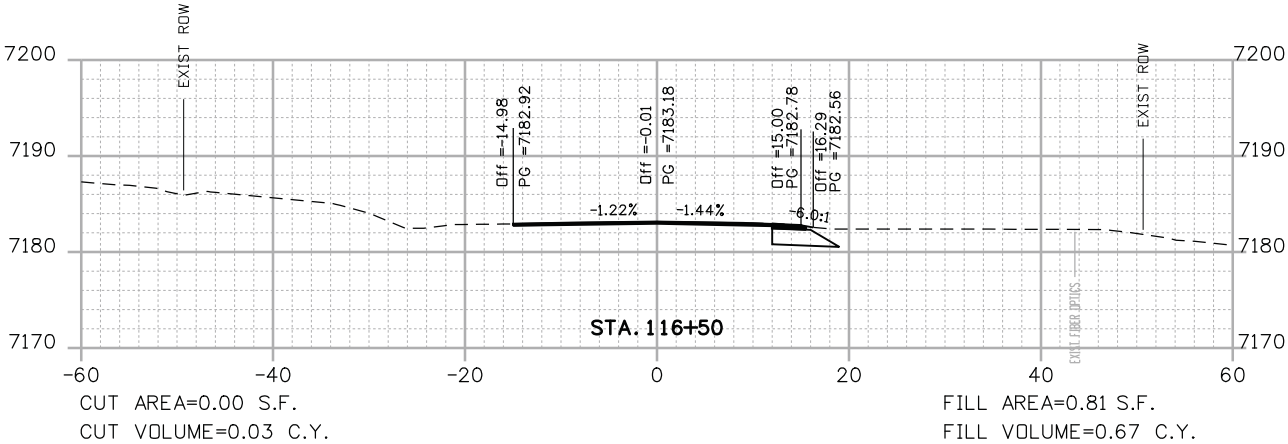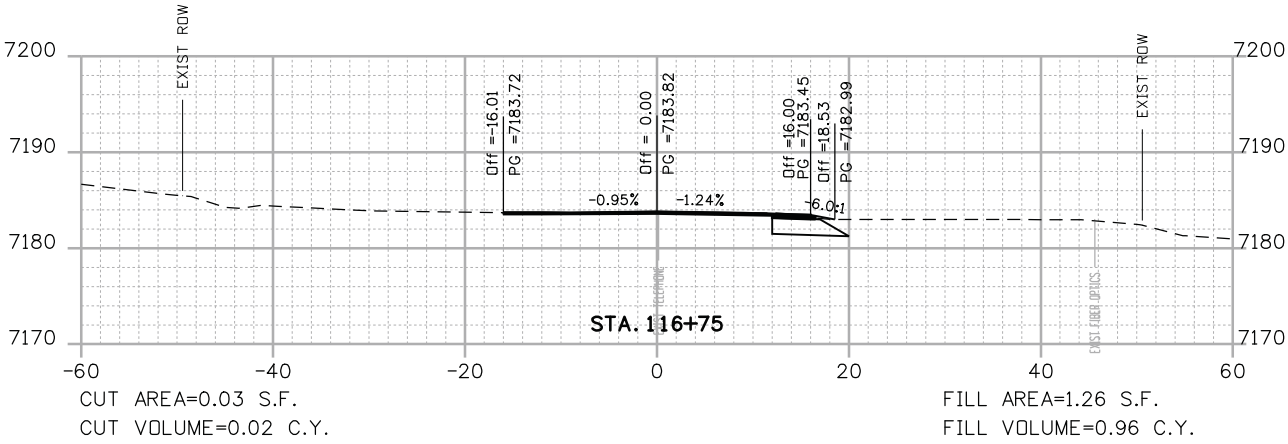

Print Date: 3/1/2013	<div>0000</div>	Sheet Revisions			Colorado Department of Transportation		As Constructed		CROSS SECTIONS			Project No./Code	
File Name: 18861DES_MP0309_CrossSections.dgn		Date:	Comments	Init.	<div> 714 Grand Ave. Eagle, CO 81631 Phone: (970) 328-6692 FAX: (970) 328-2368 Region 03</div>	PJL	No Revisions: 12/23/13		MP 3.09		C 131A-035		
Horiz. Scale: AS NOTED      Vert. Scale: AS NOTED							Revised:	Designer: J. Klish	Structure Numbers	18861R			
Unit Information: GJ Design      JSL							Void:	Detailer: J. Klish		Sheet Number 54			
								Subset: MP 3.09 X-SEC	Subset Sheets: 1 of 6				



klishj 2:50:30 PM c:\projectwise\pwz\_working\0233336\18861DES\_MPO309\_CrossSections.dgn

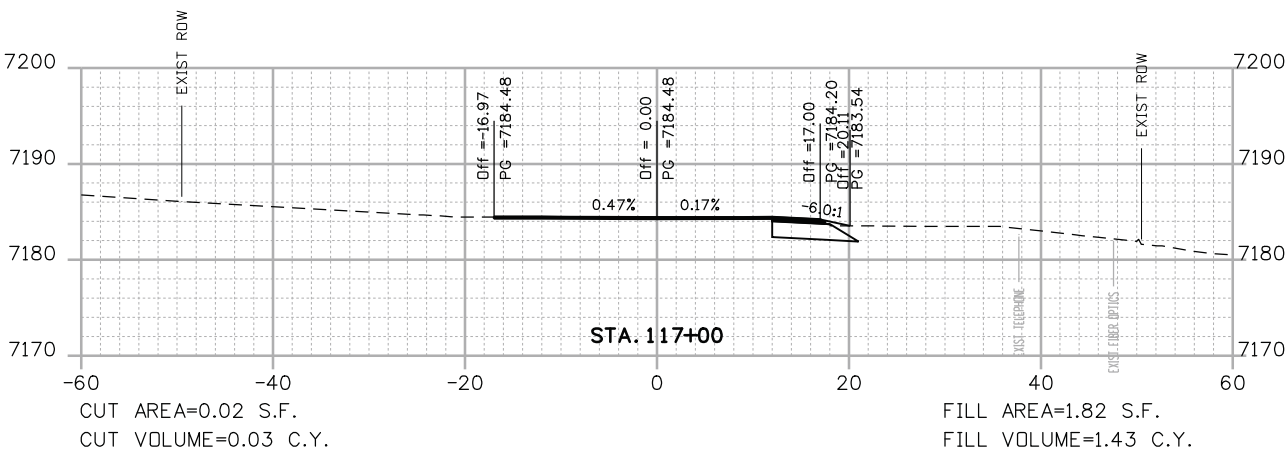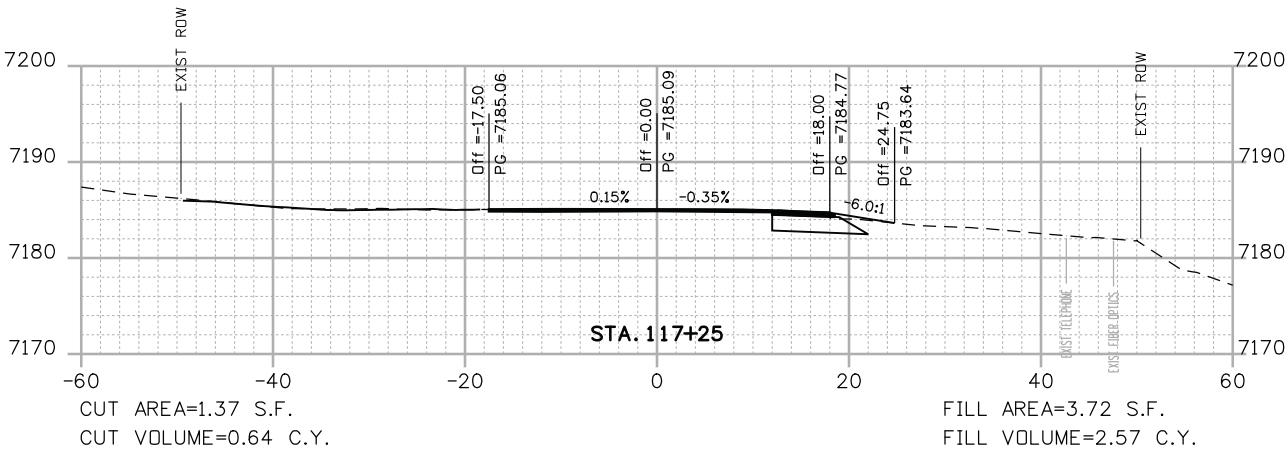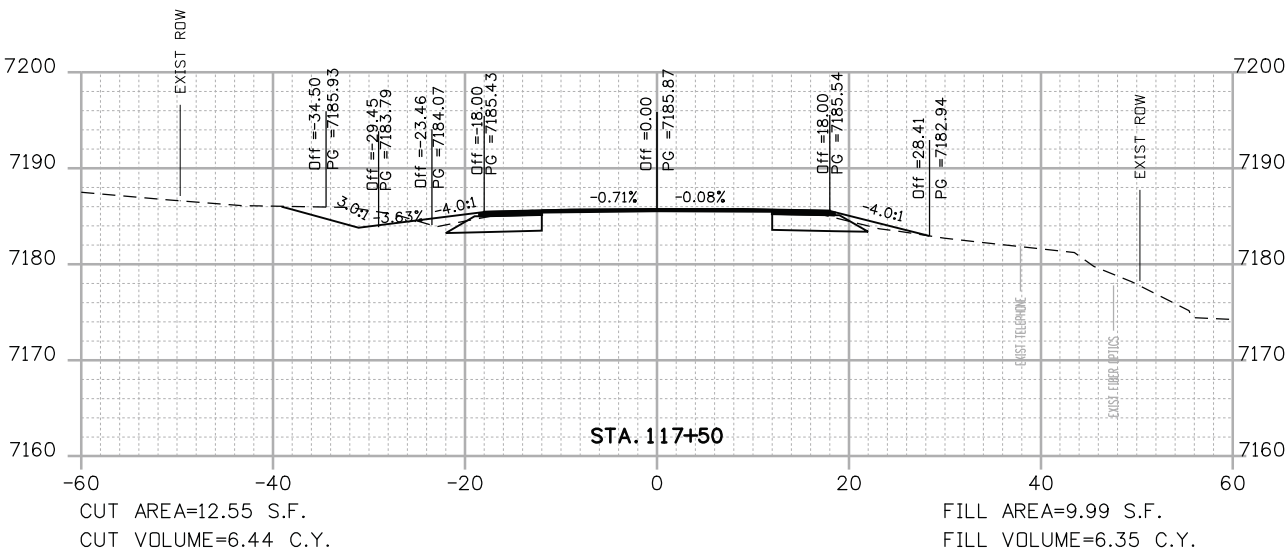

Print Date: 3/1/2013  
File Name: 18861DES\_MPO309\_CrossSections.dgn  
Horiz. Scale: AS NOTED Vert. Scale: AS NOTED  
Unit Information: GJ Design JSL

0000

Sheet Revisions		
Date:	Comments	Init.



Colorado Department of Transportation  
714 Grand Ave.  
Eagle, CO 81631  
Phone: (970) 328-6692 FAX: (970) 328-2368  
Region 03 PJJ

As Constructed

No Revisions: 12/23/13

Revised:

Void:

CROSS SECTIONS  
MP 3.09

Designer: J. Klish

Detailer: J. Klish

Subset: MP 3.09 X-SEC

Structure

Numbers

Subset Sheets: 2 of 6




Project No./Code

C 131A-035

18861R

Sheet Number 55

klishj 2:50:33 PM c:\projectwise\pwz\_working\0233336\18861DES\_MPO309\_CrossSections.dgn

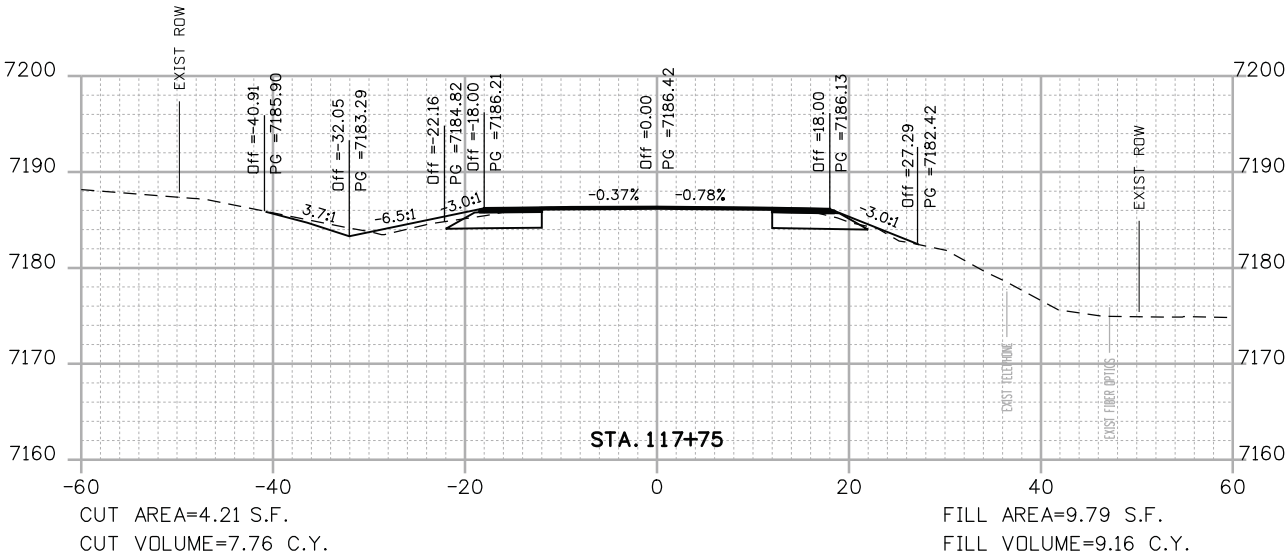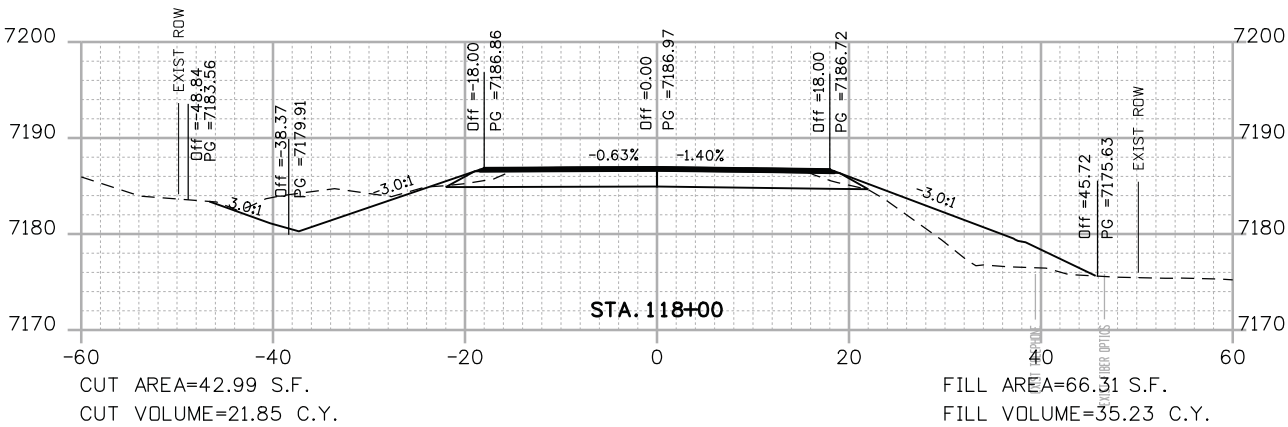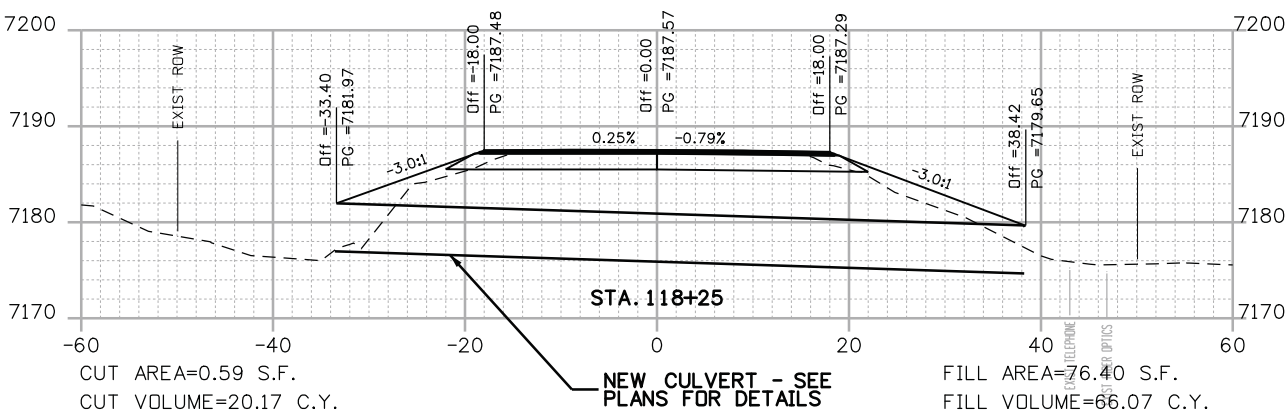

Print Date: 3/1/2013  
File Name: 18861DES\_MPO309\_CrossSections.dgn  
Horiz. Scale: AS NOTED Vert. Scale: AS NOTED  
Unit Information: GJ Design JSL

0000

### Sheet Revisions

Date:	Comments	Init.



Colorado Department of Transportation  
714 Grand Ave.  
Eagle, CO 81631  
Phone: (970) 328-6692 FAX: (970) 328-2368  
Region 03 PJJ

### As Constructed

No Revisions: 12/23/13

Revised:

Void:

### CROSS SECTIONS MP 3.09

Designer:	J. Klish	Structure Numbers	
Detailer:	J. Klish		
Subset:	MP 3.09 X-SEC	Subset Sheets: 3 of 6	

### Project No./Code




C 131A-035

18861R

Sheet Number 56






klishj 2:50:36 PM c:\projectwise\pwz\_working\dd0233336\18861DES\_MP0309\_CrossSections.dgn

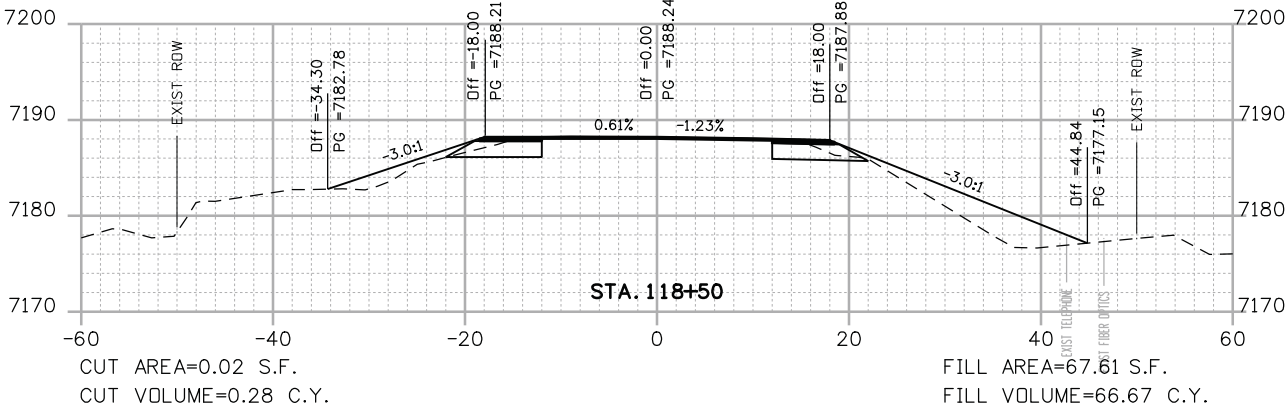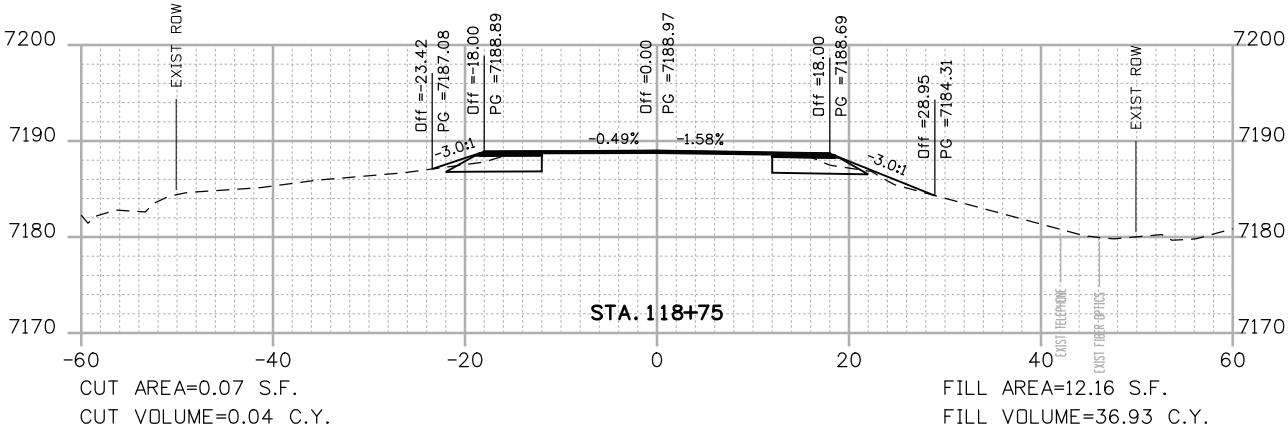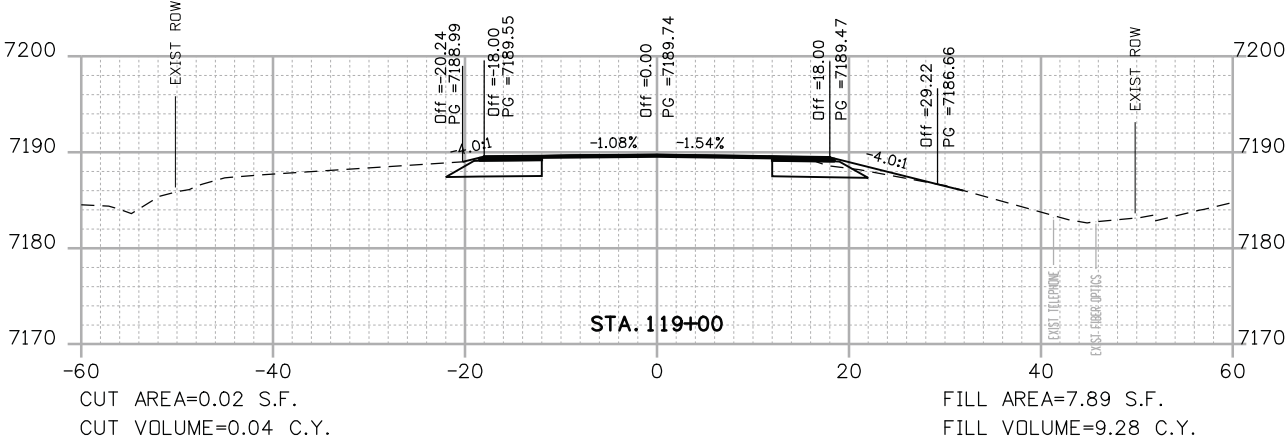

Print Date: 3/1/2013	0000	Sheet Revisions			Colorado Department of Transportation		As Constructed		CROSS SECTIONS		Project No./Code	
File Name: 18861DES_MP0309_CrossSections.dgn		Date:	Comments	Init.	 714 Grand Ave. Eagle, CO 81631 Phone: (970) 328-6692 FAX: (970) 328-2368 Region 03		No Revisions: 12/23/13		MP 3.09		C 131A-035	
Horiz. Scale: AS NOTED Vert. Scale: AS NOTED							Revised:		Designer: J. Klish	Structure Numbers	18861R	
Unit Information: GJ Design JSL							Void:		Detailer: J. Klish		Sheet Number 57	
					PJL				Subset: MP 3.09 X-SEC	Subset Sheets: 4 of 6		




klishj 2:50:39 PM c:\projectwise\pwz\_working\0233336\18861DES\_MP0309\_CrossSections.dgn

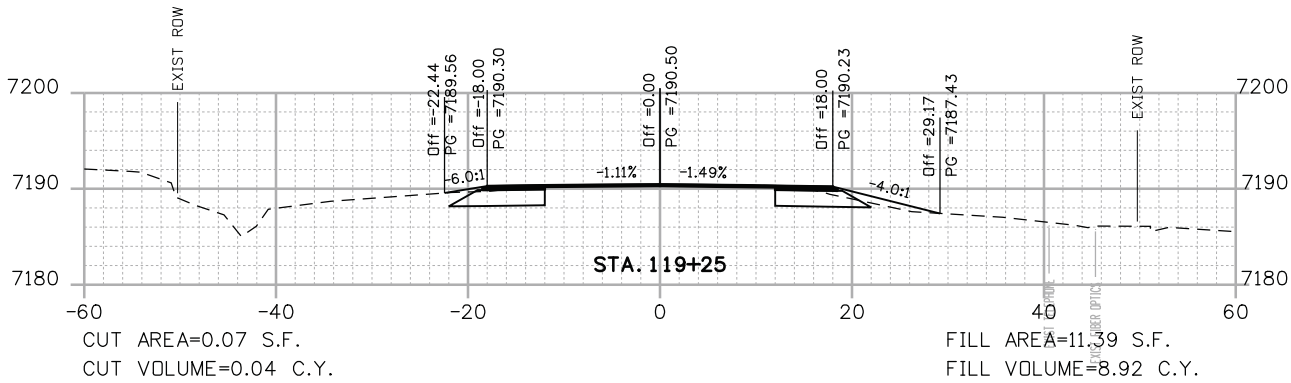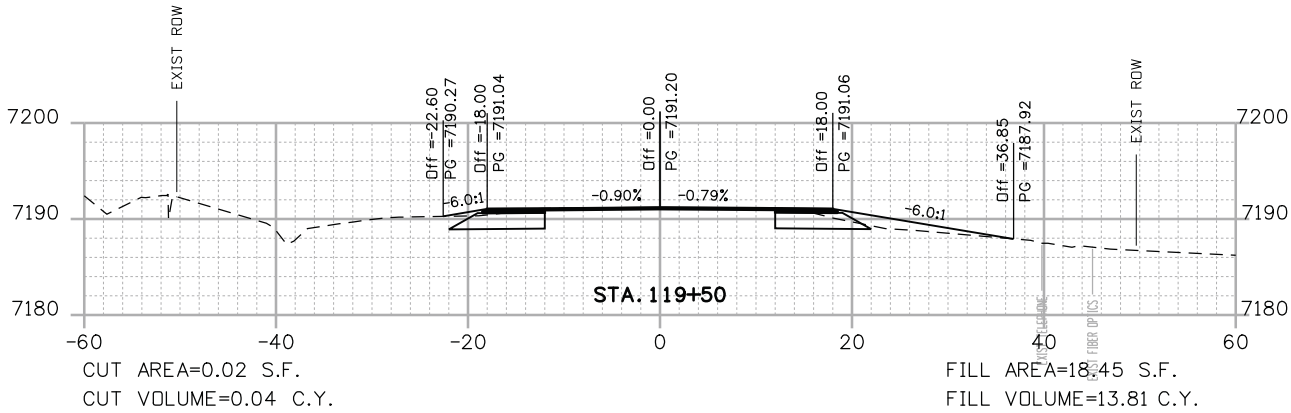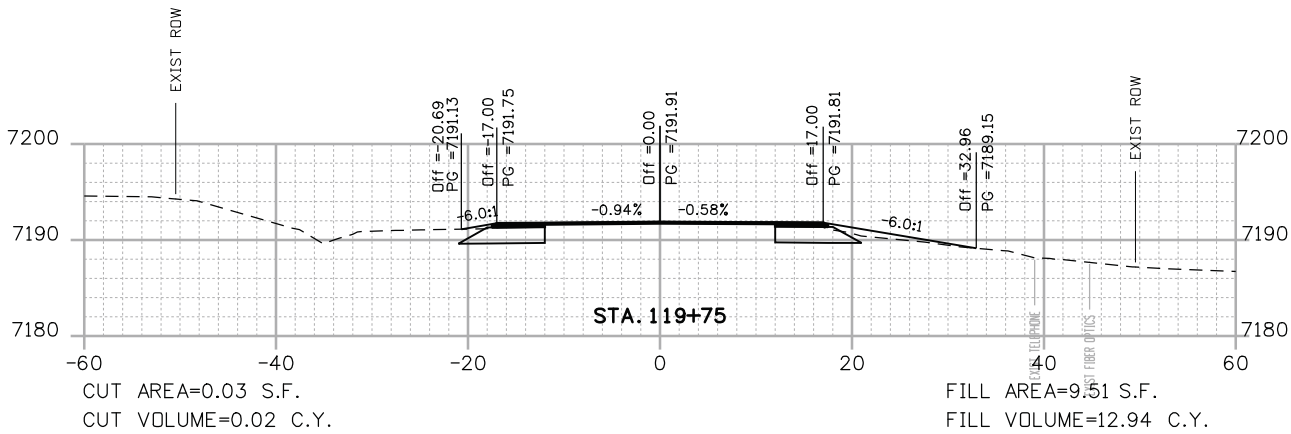

Print Date: 3/1/2013	<div>0000</div>	Sheet Revisions			Colorado Department of Transportation		As Constructed		CROSS SECTIONS MP 3.09			Project No./Code	
File Name: 18861DES_MP0309_CrossSections.dgn		Date:	Comments	Init.	<div> 714 Grand Ave. Eagle, CO 81631 Phone: (970) 328-6692 FAX: (970) 328-2368 Region 03</div> <div>PJL</div>	No Revisions: 12/23/13	C 131A-035						
Horiz. Scale: AS NOTED      Vert. Scale: AS NOTED						Revised:	Designer: J. Klish	Structure Numbers	18861R				
Unit Information: GJ Design      JSL						Void:	Detailer: J. Klish		Sheet Number 58				
							Subset: MP 3.09 X-SEC	Subset Sheets: 5 of 6					



klishj 2:50:42 PM c:\projectwise\pwz\_working\0233336\18861DES\_MP0309\_CrossSections.dgn

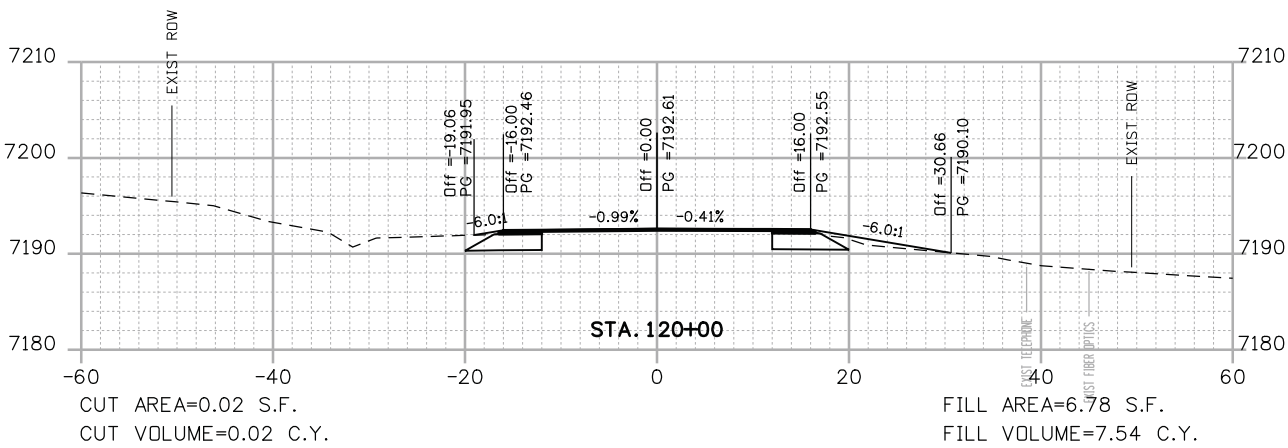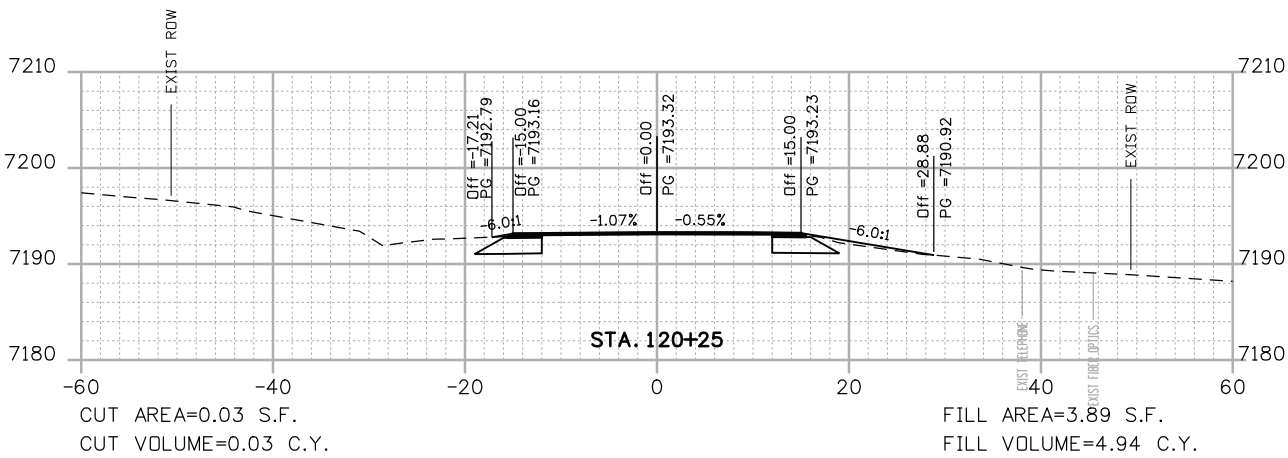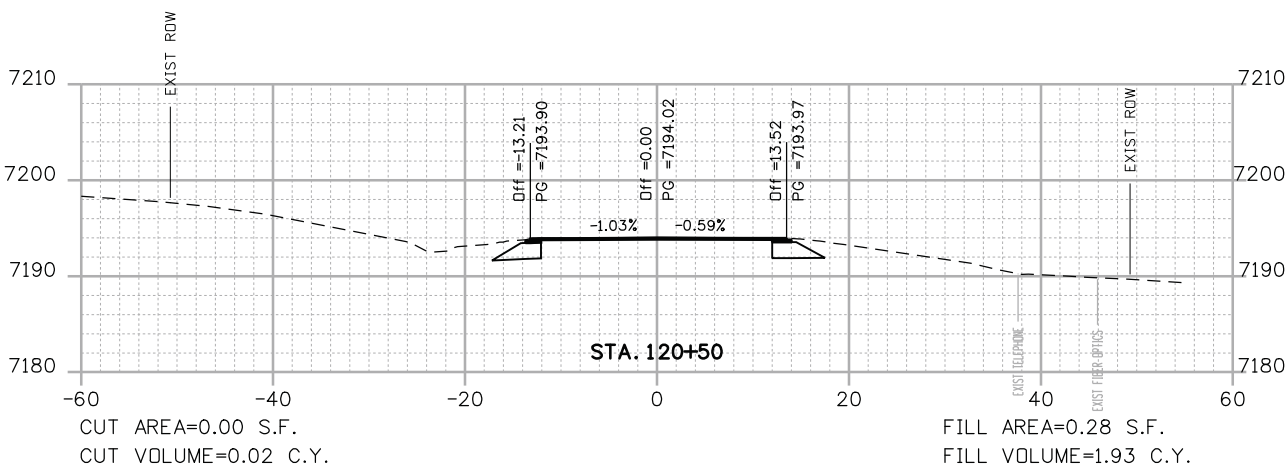

Print Date: 3/1/2013  
File Name: 18861DES\_MP0309\_CrossSections.dgn  
Horiz. Scale: AS NOTED Vert. Scale: AS NOTED  
Unit Information: GJ Design JSL

0000

Sheet Revisions

Date:	Comments	Init.



Colorado Department of Transportation  
714 Grand Ave.  
Eagle, CO 81631  
Phone: (970) 328-6692 FAX: (970) 328-2368  
Region 03 PJJ

As Constructed

No Revisions: 12/23/13

Revised:

Void:

CROSS SECTIONS  
MP 3.09

Designer:	J. Klish	Structure	
Detailer:	J. Klish	Numbers	
Subset:	MP 3.09 X-SEC	Subset Sheets:	6 of 6




Project No./Code

C 131A-035

18861R

Sheet Number 59




klishj 2:50:47 PM c:\projectwise\pwz\_working\0233336\1886IDES\_MP3642\_CrossSections.dgn

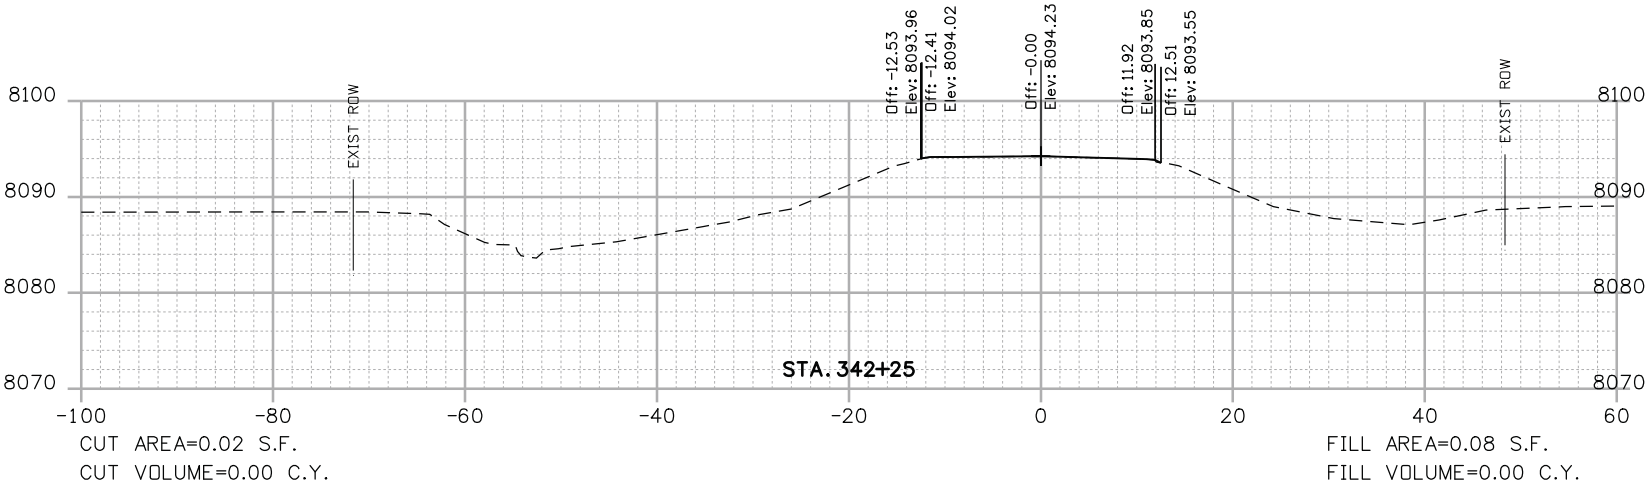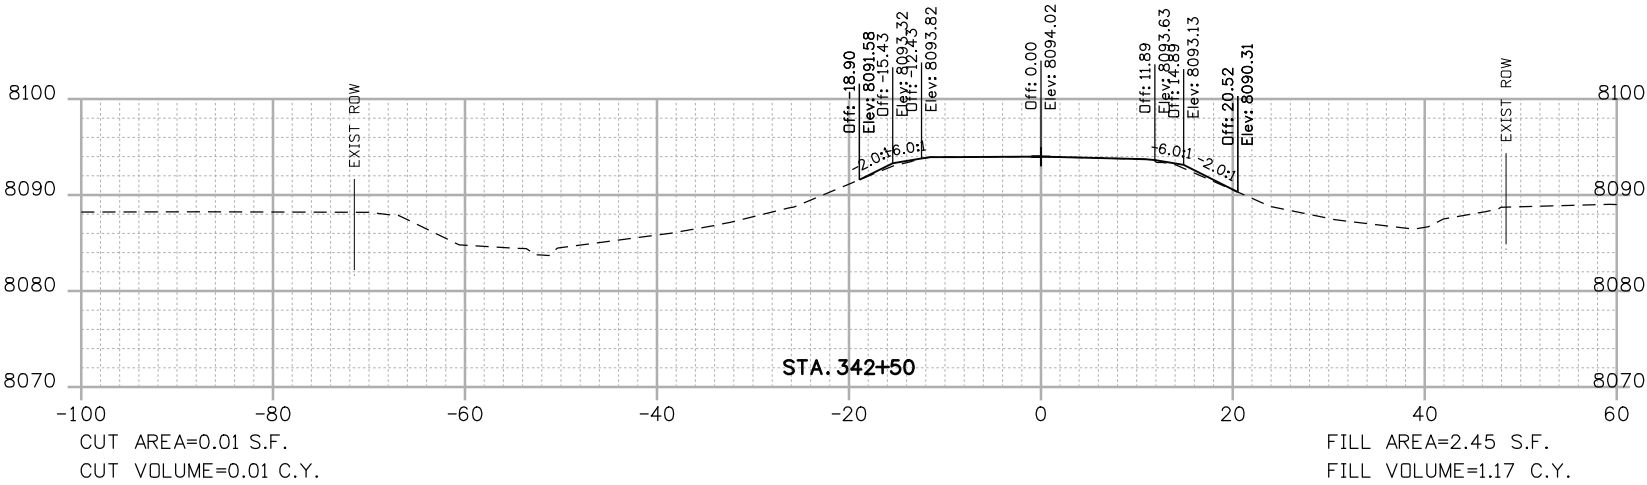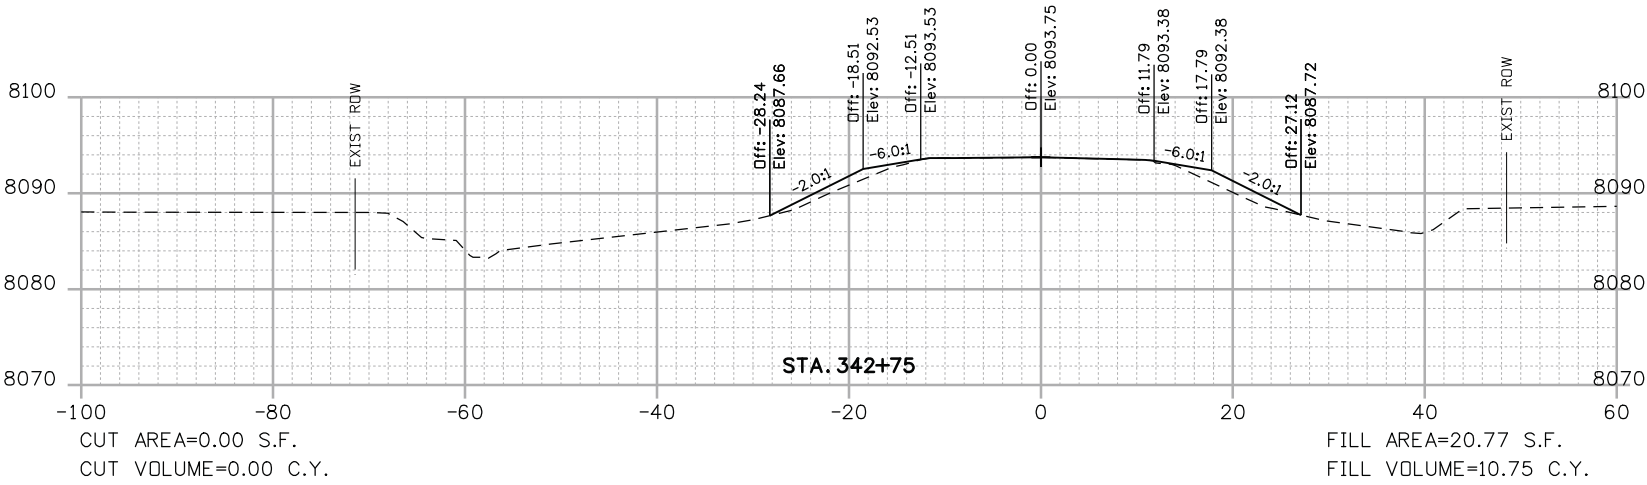

Print Date: 3/1/2013	<div>0000</div>	Sheet Revisions			Colorado Department of Transportation		As Constructed		CROSS SECTIONS			Project No./Code	
File Name: 18861DES_MP3642_CrossSections.dgn		Date:	Comments	Init.	<div> 714 Grand Ave. Eagle, CO 81631 Phone: (970) 328-9962 FAX: (970) 328-2368 Region 03</div>	PJL	No Revisions: 12/23/13		MP 36.42		C 131A-035		
Horiz. Scale: AS NOTED      Vert. Scale: AS NOTED							Revised:	Designer: J. Klish	Structure Numbers	18861R			
Unit Information: GJ Design      JSL							Void:	Detailer: J. Klish		Sheet Number 60			
								Subset: MP 36.42 X-SEC	Subset Sheets: 1 of 3				



klishj 2:50:50 PM c:\projectwise\pwz\_working\0233336\18861DES\_MP3642\_CrossSections.dgn

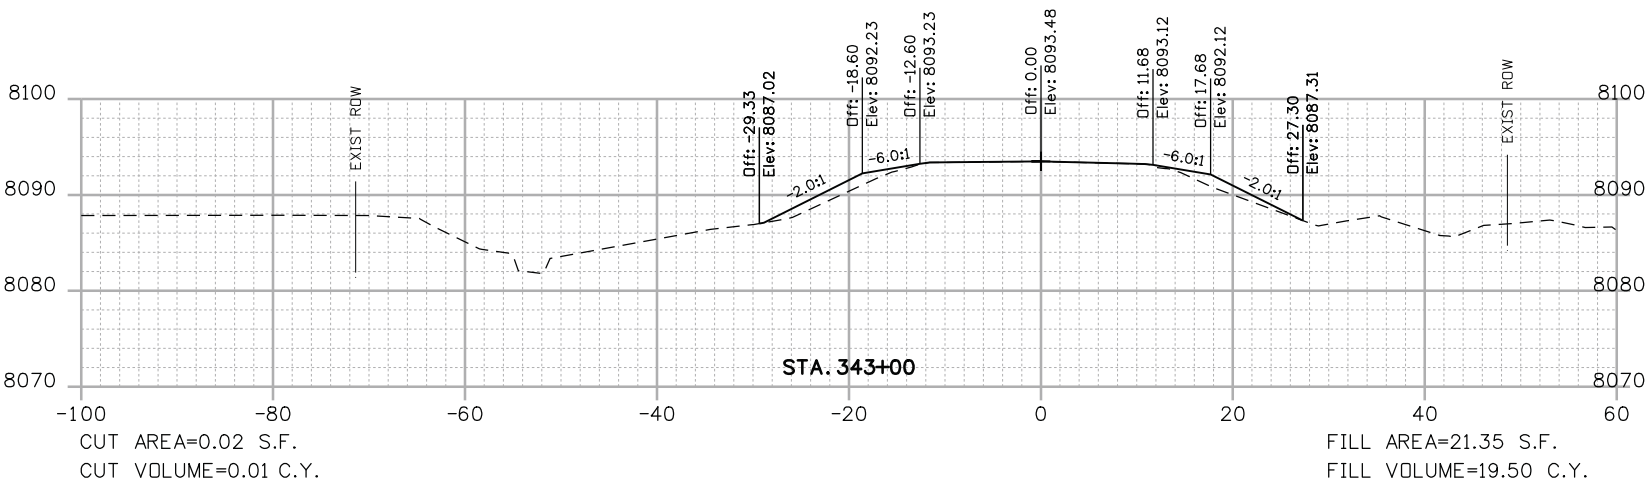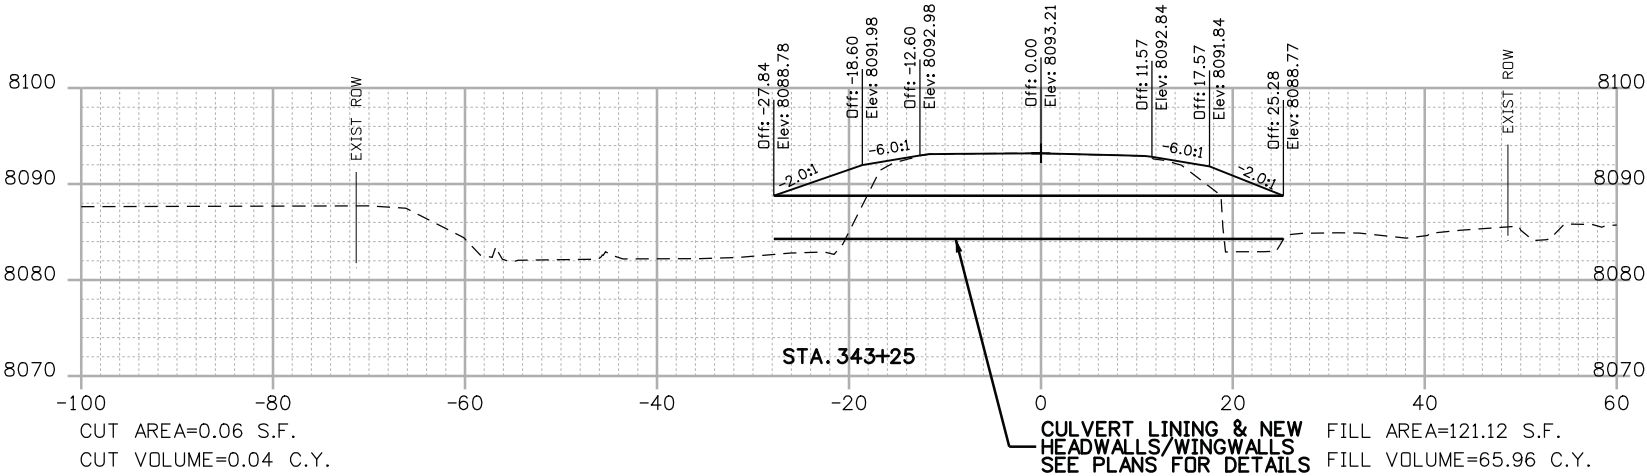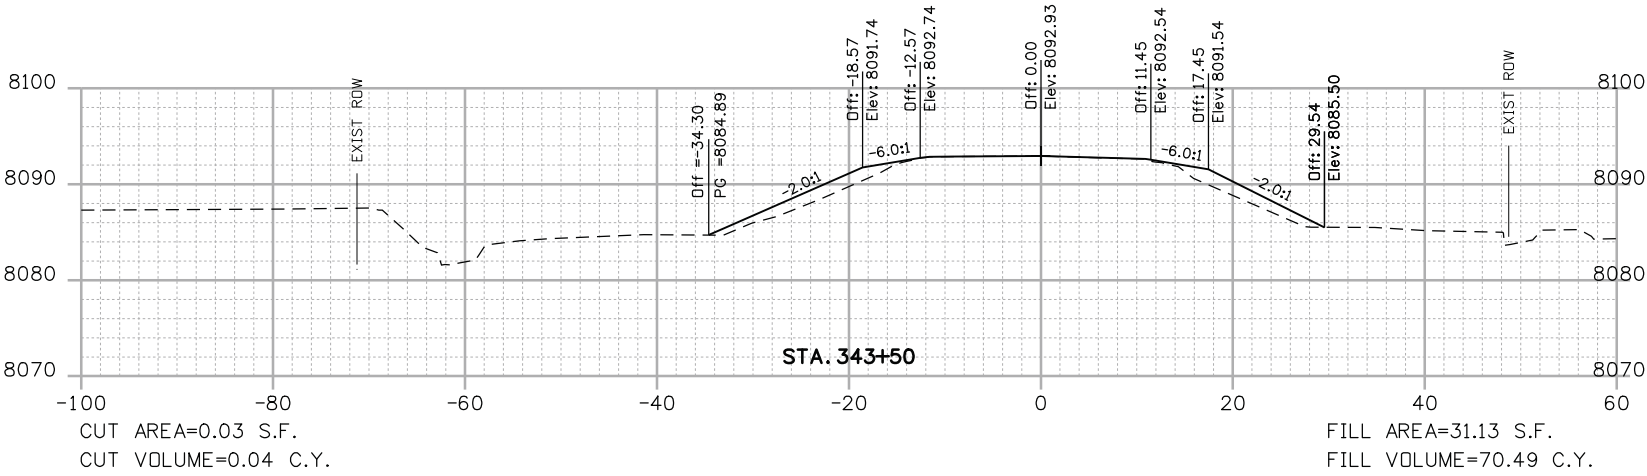

Print Date: 3/1/2013

File Name: 18861DES\_MP3642\_CrossSections.dgn

Horiz. Scale: AS NOTED Vert. Scale: AS NOTED

Unit Information: GJ Design JSL

0000

Sheet Revisions

Date:	Comments	Init.

Colorado Department of Transportation



714 Grand Ave.  
Eagle, CO 81631  
Phone: (970) 328-9962 FAX: (970) 328-2368

Region 03

PJL

As Constructed

No Revisions: 12/23/13

Revised:

Void:

CROSS SECTIONS  
MP 36.42

Designer:	J. Klish	Structure	
Detailer:	J. Klish	Numbers	
Subset: MP 36.42 X-SEC	Subset Sheets: 2	of	3




Project No./Code

C 131A-035

18861R

Sheet Number 61




klishj 2:50:53 PM c:\projectwise\pwz\_working\0233336\18861DES\_MP3642\_CrossSections.dgn

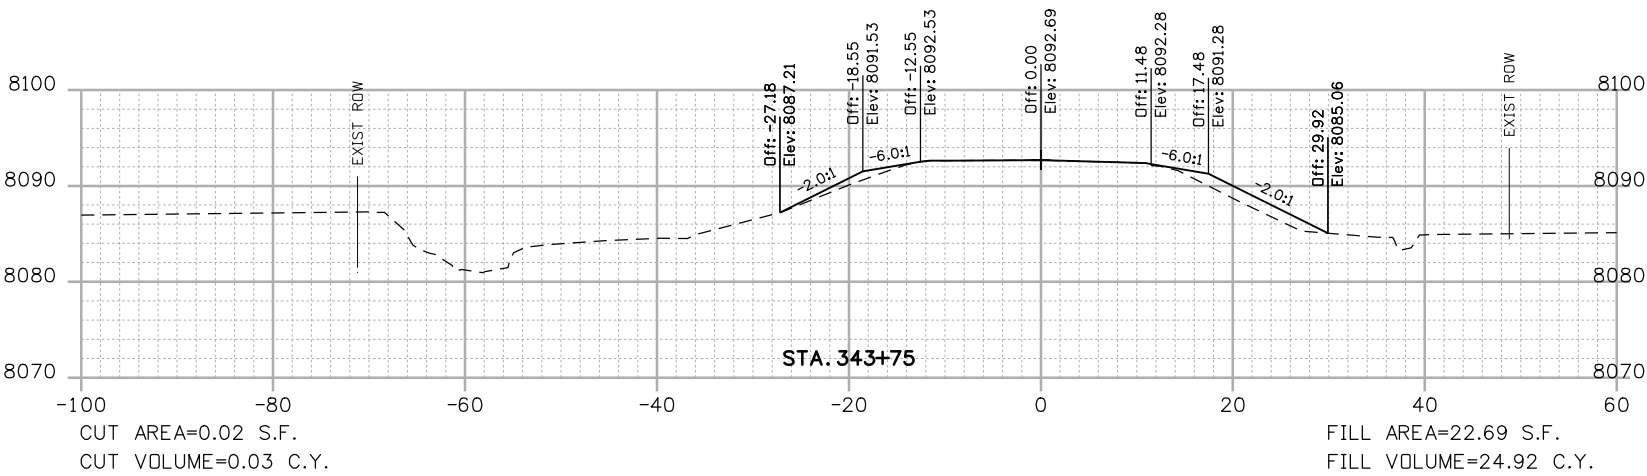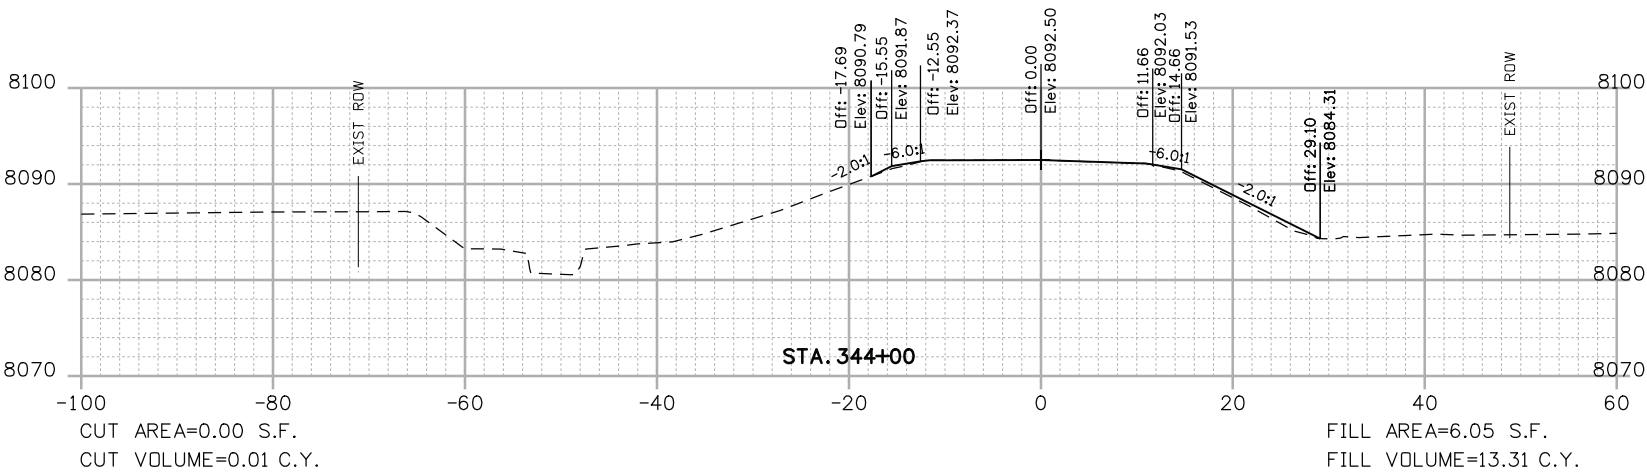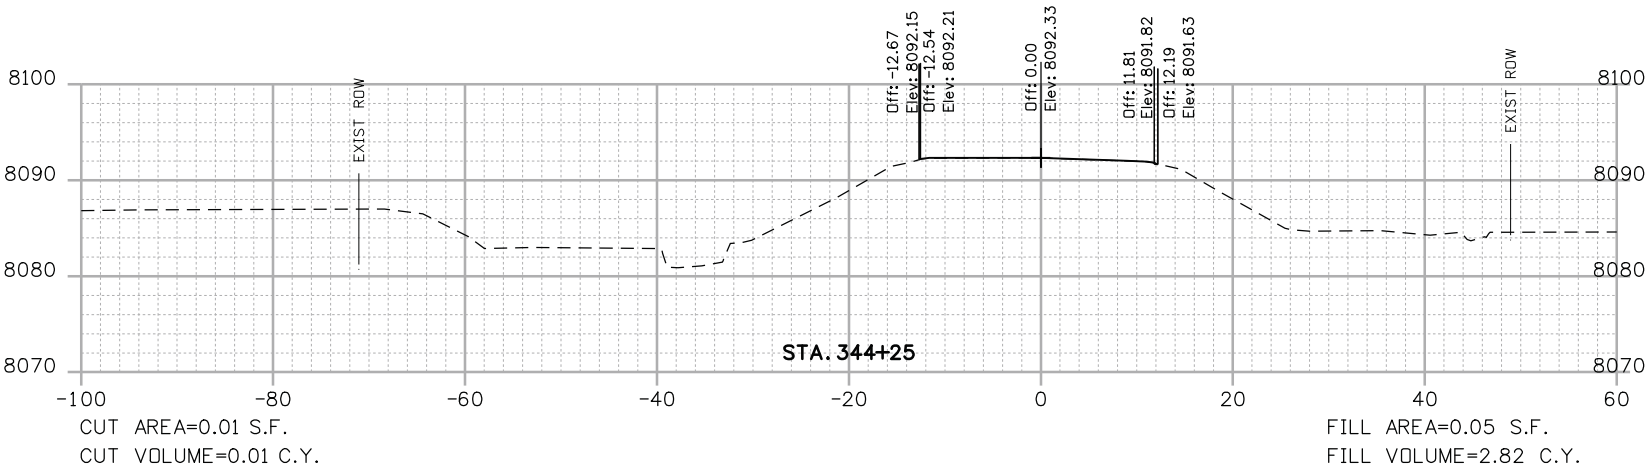

Print Date: 3/1/2013	<div>0000</div>	Sheet Revisions			Colorado Department of Transportation		As Constructed		CROSS SECTIONS				Project No./Code	
File Name: 18861DES_MP3642_CrossSections.dgn		Date:	Comments	Init.	<div> 714 Grand Ave. Eagle, CO 81631 Phone: (970) 328-9962 FAX: (970) 328-2368 Region 03</div>	No Revisions: 12/23/13		MP 36.42				C 131A-035		
Horiz. Scale: AS NOTED      Vert. Scale: AS NOTED						Revised:	Designer: J. Klish	Structure Numbers		18861R				
Unit Information: GJ Design      JSL						Void:	Detailer: J. Klish			Sheet Number 62				
							Subset: MP 36.42 X-SEC	Subset Sheets: 3 of 3						



klishj 2:50:57 PM c:\projectwise\pwz\_working\p0233336\1886IDES\_MP3711\_CrossSections.dgn

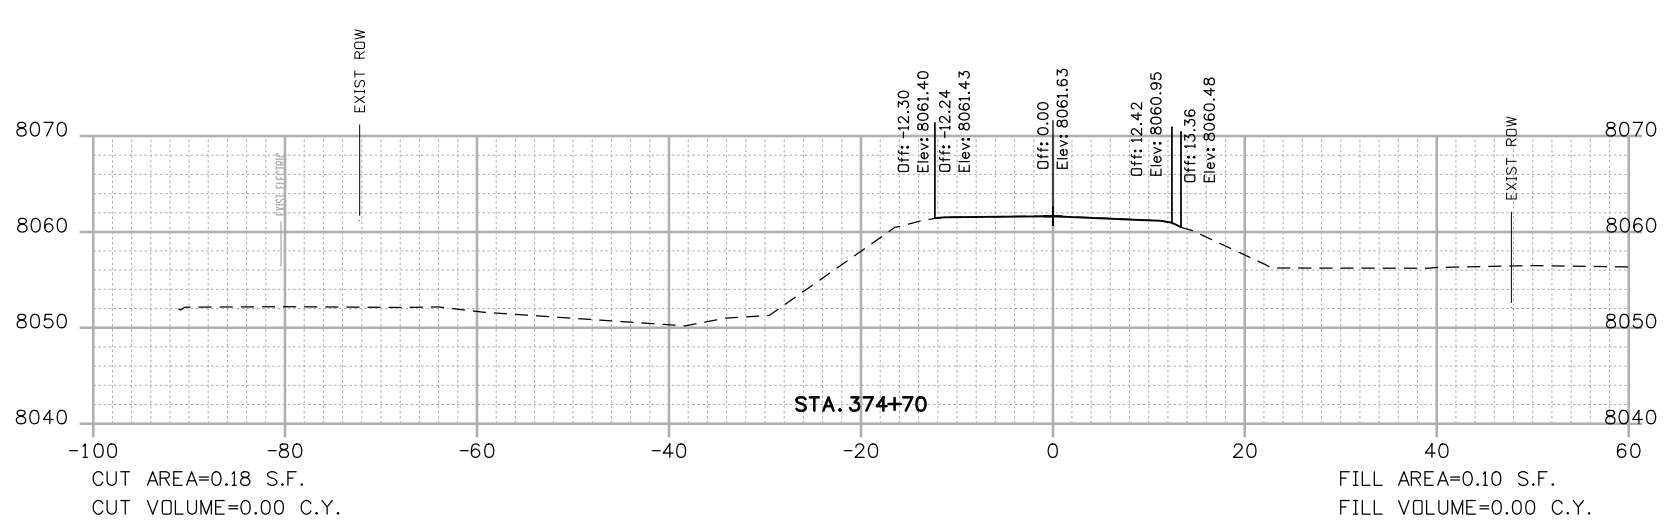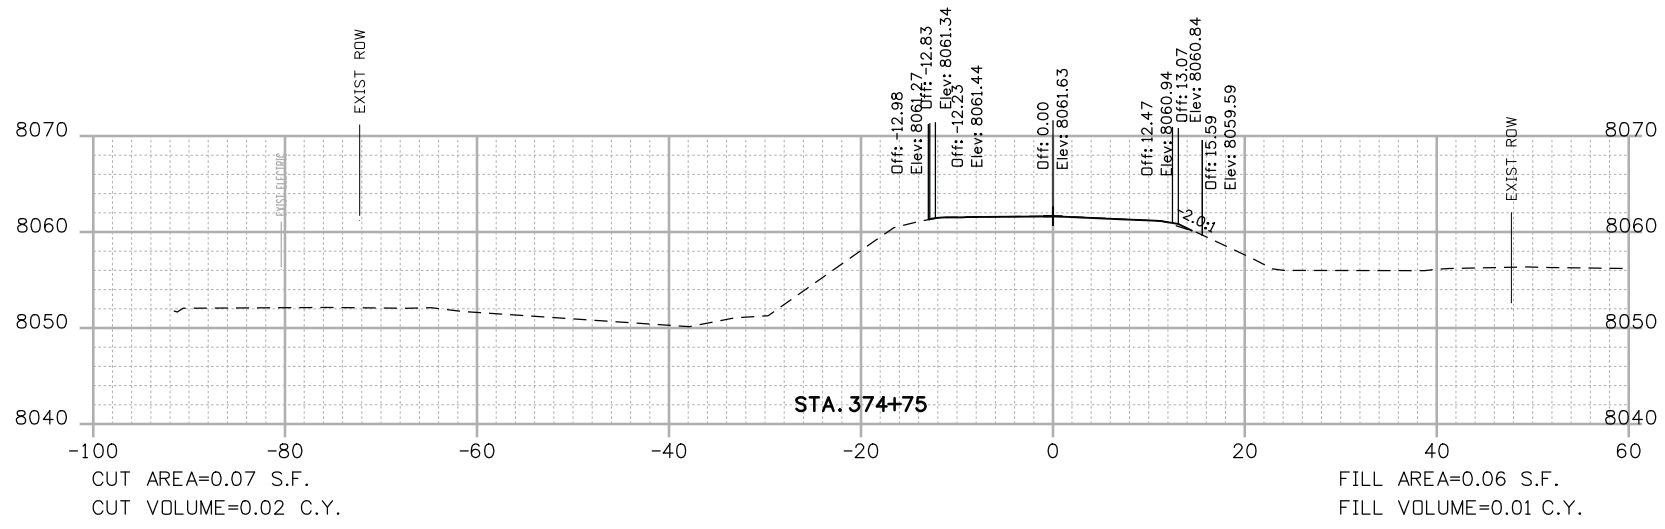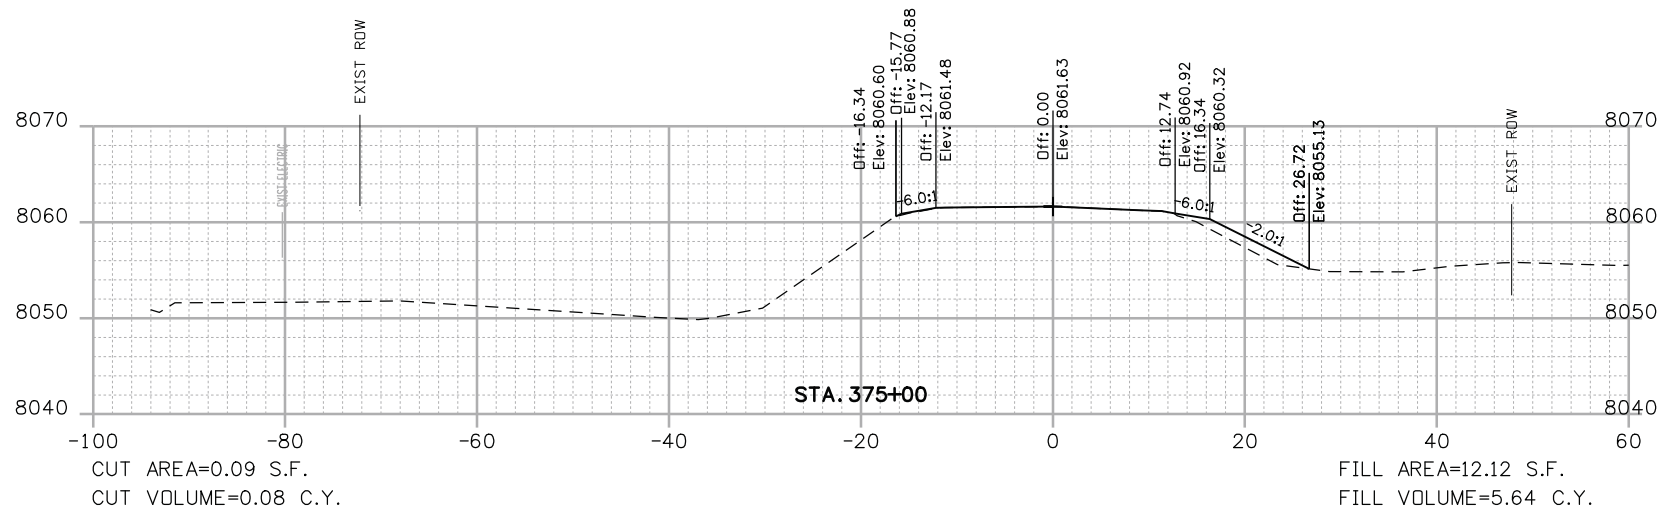

Print Date: 3/1/2013  
File Name: 1886IDES\_MP3711\_CrossSections.dgn  
Horiz. Scale: AS NOTED Vert. Scale: AS NOTED  
Unit Information: GJ Design JSL

0000

Sheet Revisions		
Date:	Comments	Init.






Colorado Department of Transportation  
714 Grand Ave.  
Eagle, CO 81631  
Phone: (970) 328-9962 FAX: (970) 328-2368  
Region 03

PJL

As Constructed		CROSS SECTIONS MP 37.11			Project No./Code
No Revisions: 12/23/13					C 131A-035
Revised:		Designer: J. Klish	Structure Numbers		18861R
Void:		Detailer: J. Klish	Subset Sheets: 1 of 4		Sheet Number 63
		Subset: MP 37.11 X-SEC			




klishj 2:51:00 PM c:\projectwise\pwz\_working\0233336\1886IDES\_MP3711\_CrossSections.dgn

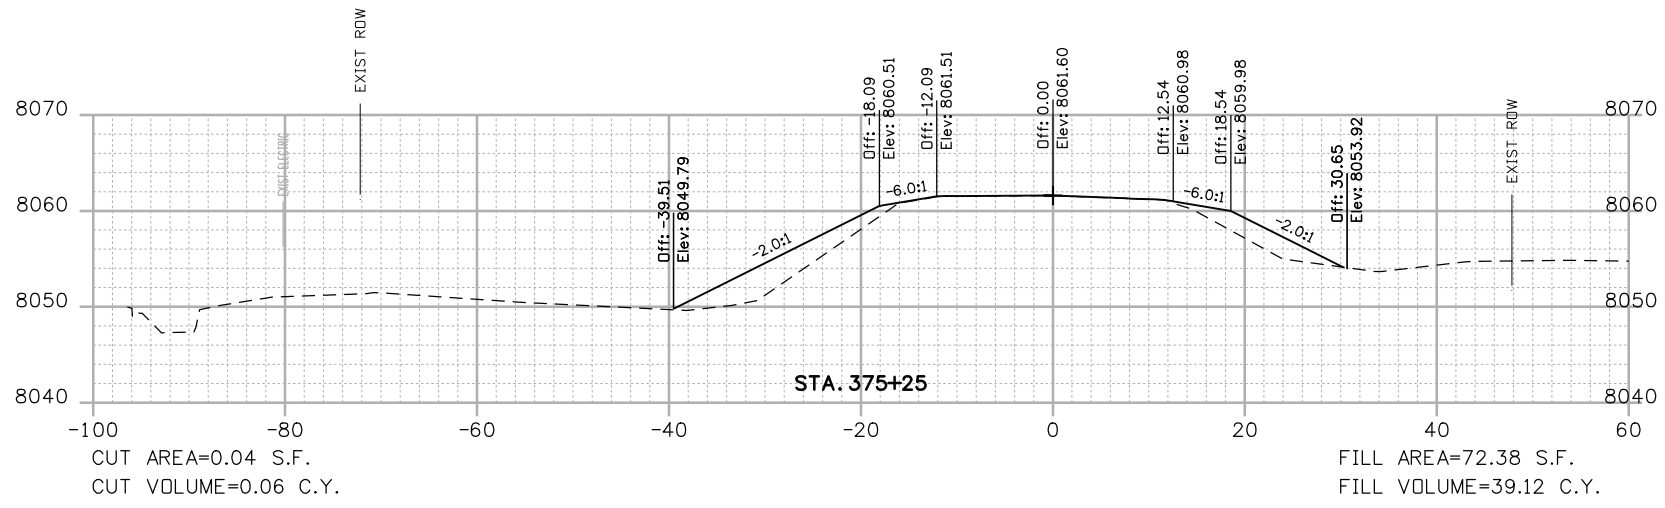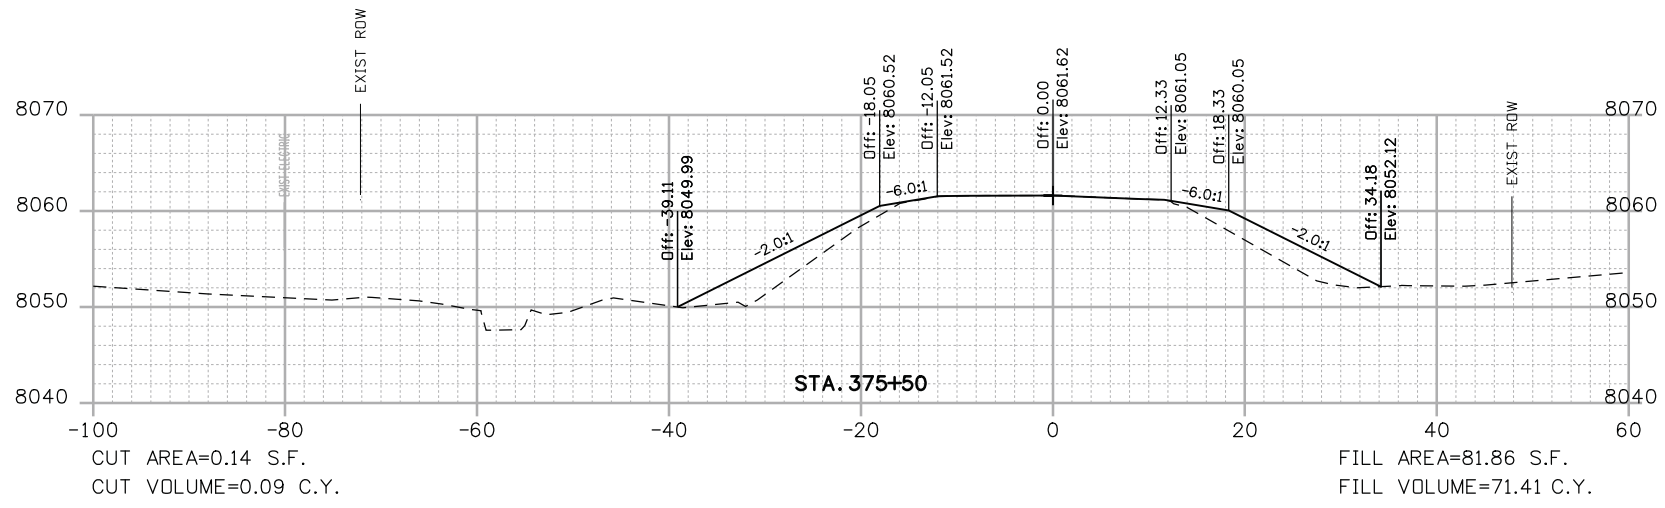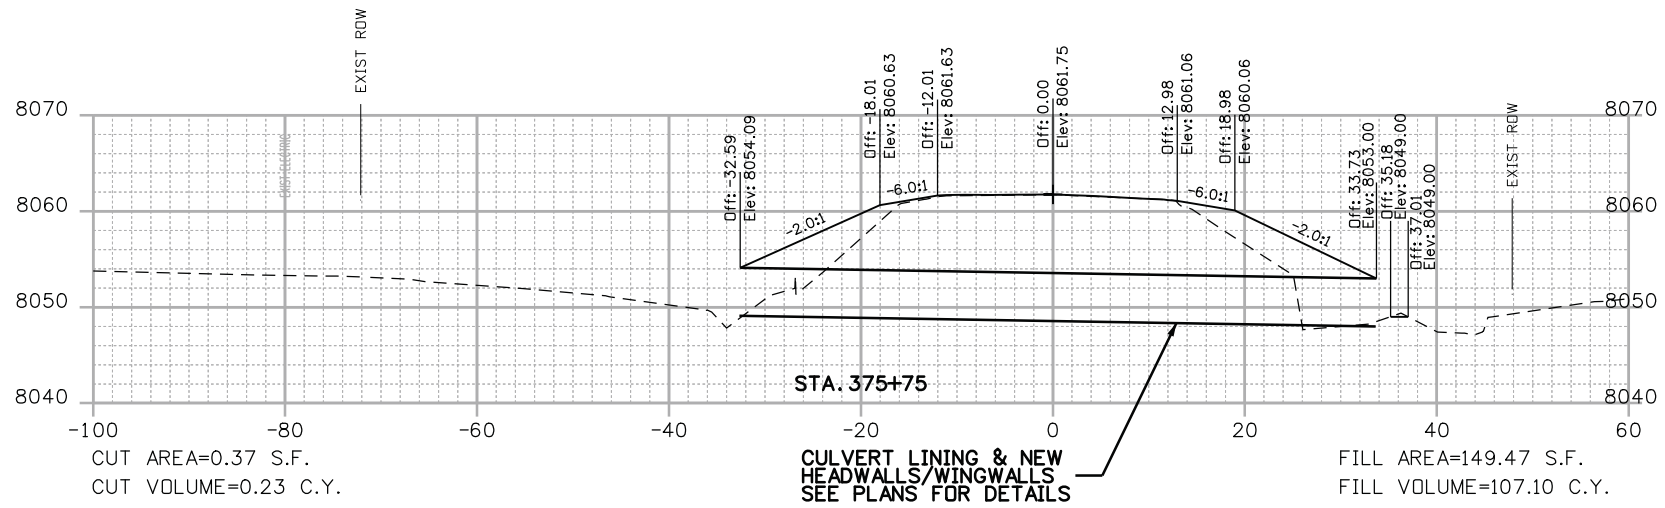

Print Date: 3/1/2013	<div>0000</div>	Sheet Revisions			Colorado Department of Transportation		As Constructed		CROSS SECTIONS				Project No./Code	
File Name: 1886IDES_MP3711_CrossSections.dgn		Date:	Comments	Init.	<div> 714 Grand Ave. Eagle, CO 81631 Phone: (970) 328-9962 FAX: (970) 328-2368 Region 03</div>	No Revisions: 12/23/13	MP 37.11				C 131A-035			
Horiz. Scale: AS NOTED      Vert. Scale: AS NOTED							Revised:	Designer: J. Klish	Structure Numbers	18861R				
Unit Information: GJ Design      JSL							Void:	Detailer: J. Klish		Sheet Number 64				
								Subset: MP 37.11 X-SEC	Subset Sheets: 2 of 4					




klishj 2:51:03 PM c:\projectwise\pwz\_working\0233336\18861DES\_MP3711\_CrossSections.dgn

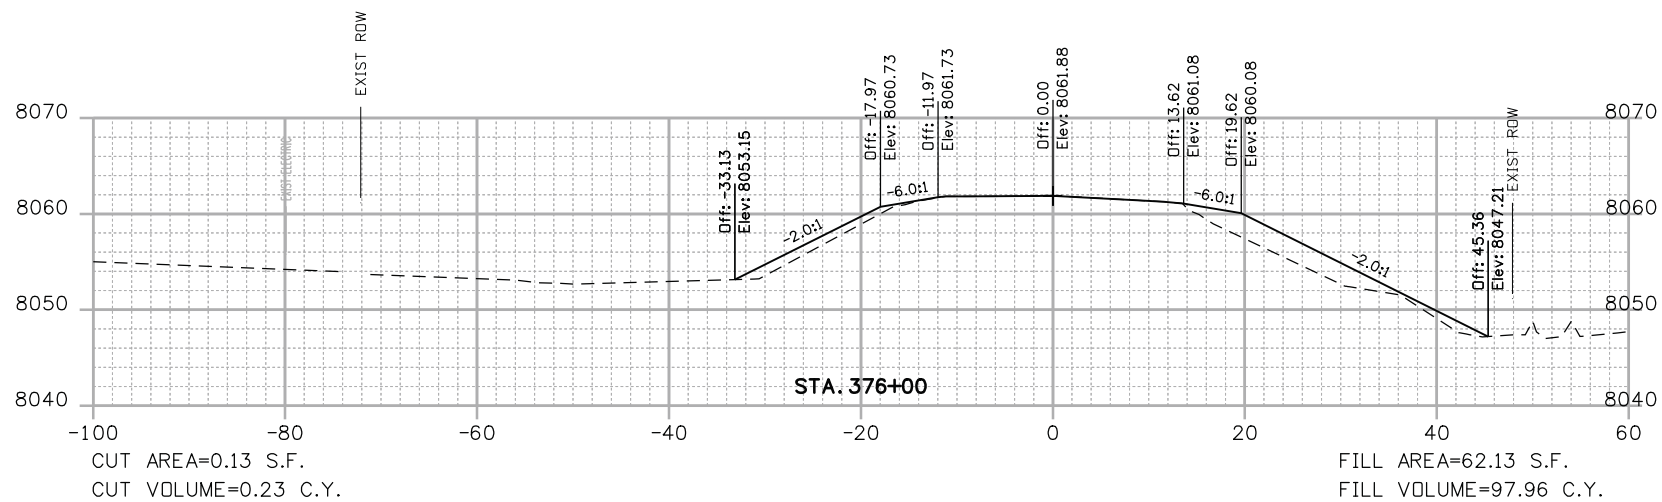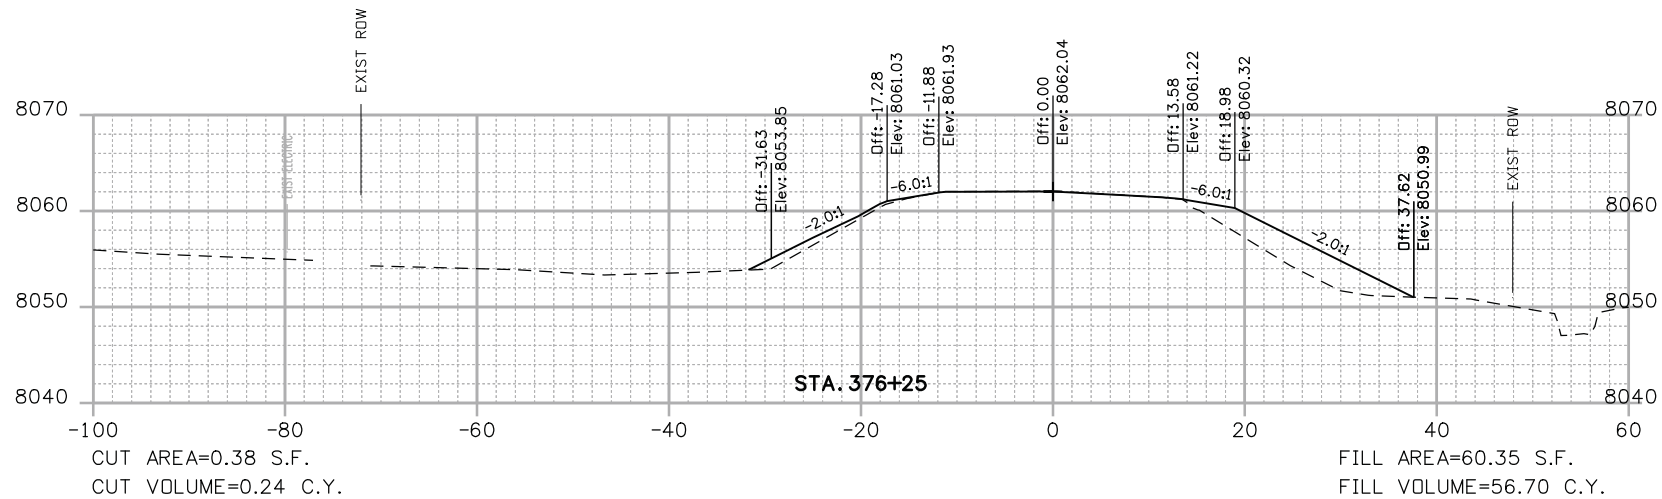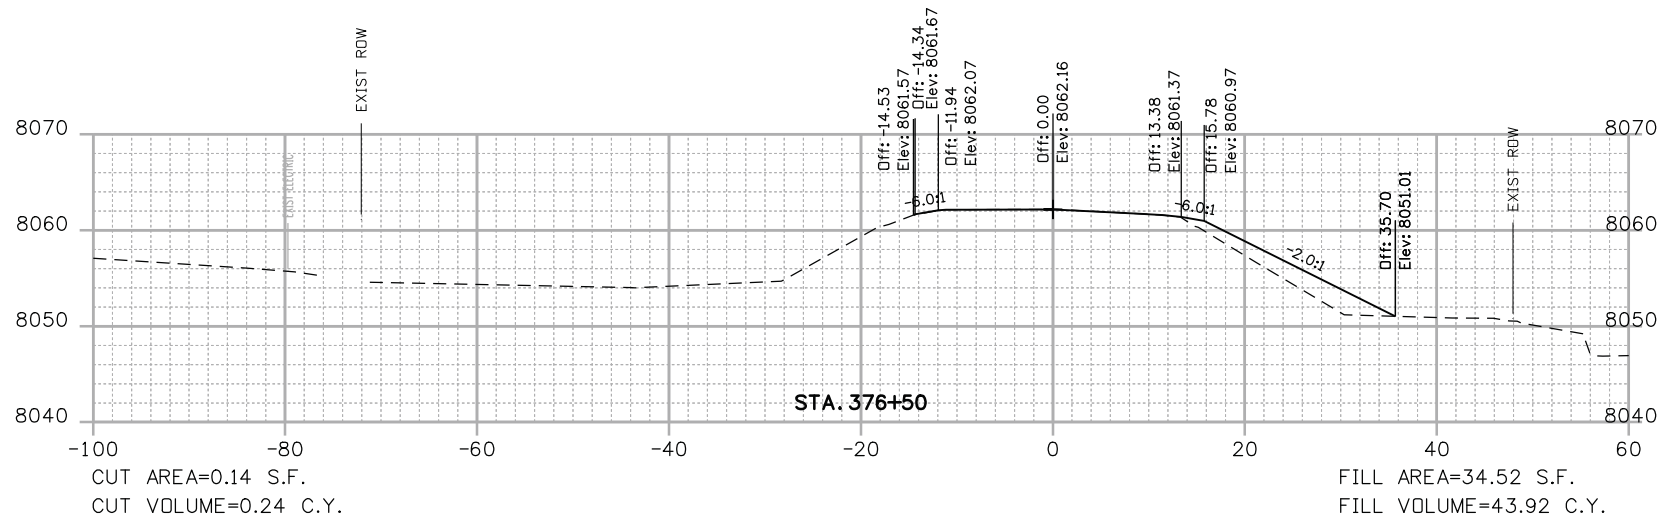

Print Date: 3/1/2013	0000	Sheet Revisions			Colorado Department of Transportation		As Constructed		CROSS SECTIONS		Project No./Code	
File Name: 18861DES_MP3711_CrossSections.dgn		Date:	Comments	Init.	 714 Grand Ave. Eagle, CO 81631 Phone: (970) 328-9962 FAX: (970) 328-2368 Region 03	PJL	No Revisions: 12/23/13		MP 37.11		C 131A-035	
Horiz. Scale: AS NOTED Vert. Scale: AS NOTED							Revised:	Designer: J. Klish	Structure		18861R	
Unit Information: GJ Design JSL									Numbers		Sheet Number 65	
							Void:	Subset: MP 37.11 X-SEC	Subset Sheets: 3 of 4			




klishj 2:51:06 PM c:\projectwise\pwworking\0233336\18861DES\_MP3711\_CrossSections.dgn

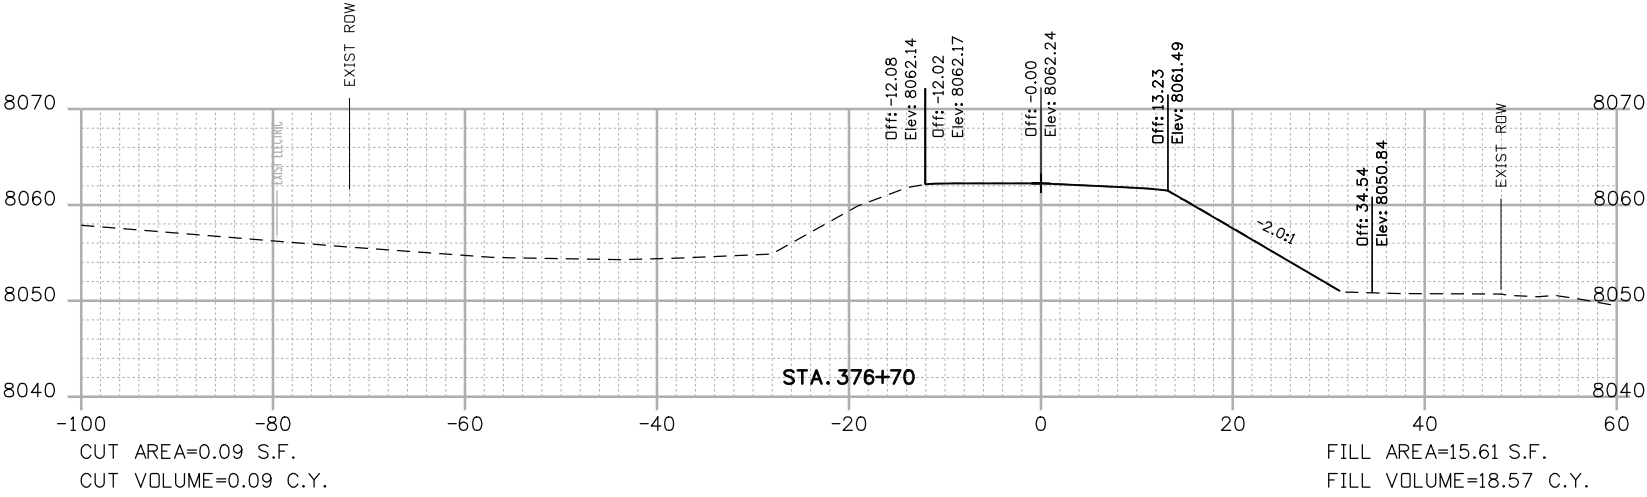


Print Date: 3/1/2013		<div>0000</div>	Sheet Revisions			Colorado Department of Transportation		As Constructed		CROSS SECTIONS MP 37.11		Project No./Code	
File Name: 18861DES_MP3711_CrossSections.dgn			Date:	Comments	Init.	<div> 714 Grand Ave. Eagle, CO 81631 Phone: (970) 328-9962 FAX: (970) 328-2368 Region 03</div>	No Revisions: 12/23/13		C 131A-035				
Horiz. Scale: AS NOTED      Vert. Scale: AS NOTED							Revised:	J. Klish	Structure	18861R			
Unit Information: GJ Design      JSL							Detailer:	J. Klish	Numbers				
						Void:	Subset: MP 37.11 X-SEC	Subset Sheets: 4 of 4	Sheet Number 66		PJL		






klishj 2:51:10 PM c:\projectwise\pwworking\02333336\18861DES\_MP3734\_CrossSections.dgn

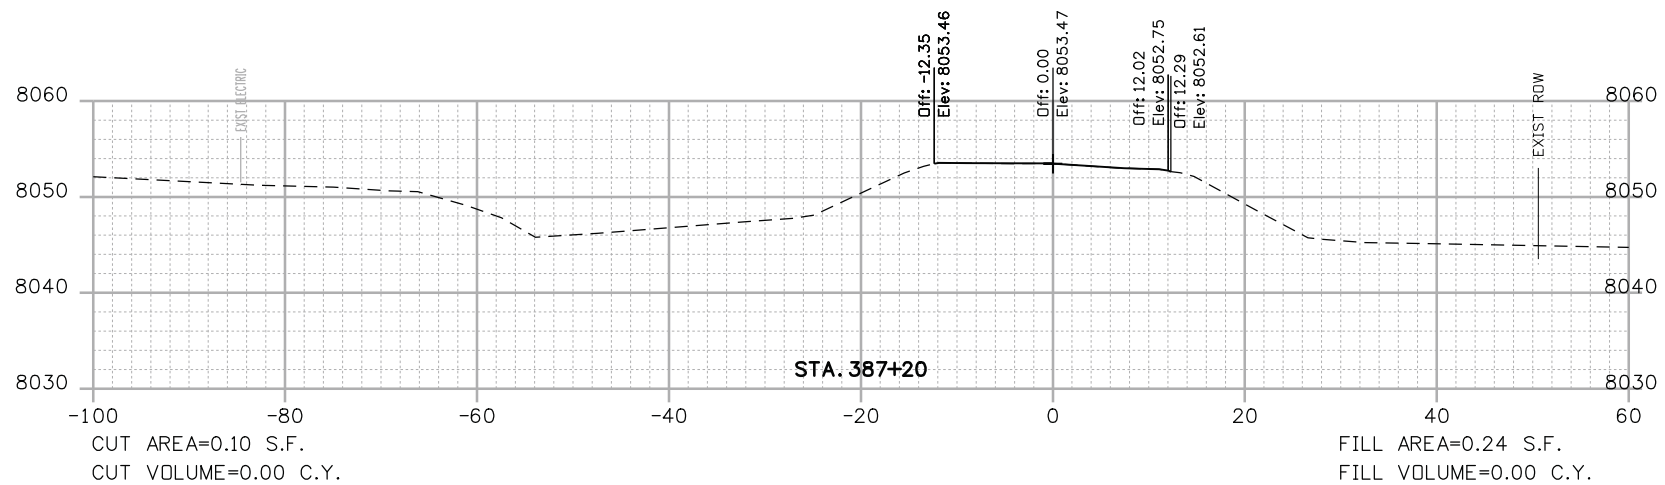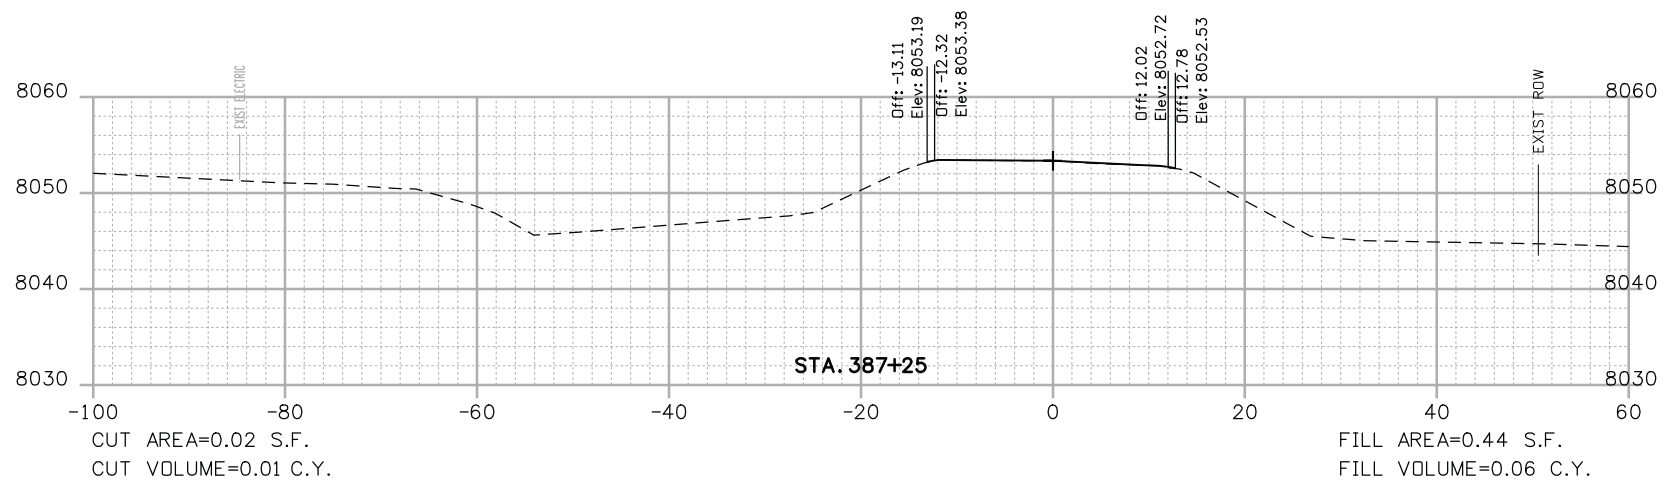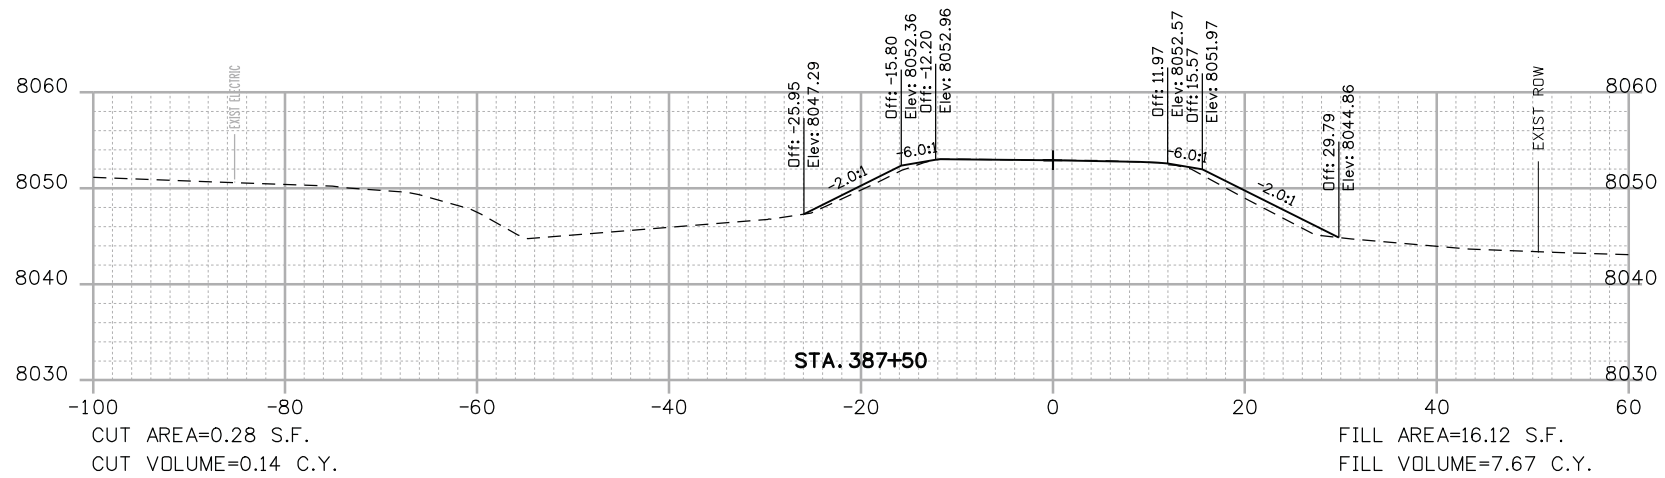

Print Date: 3/1/2013		<div>0000</div>	Sheet Revisions			Colorado Department of Transportation		As Constructed		CROSS SECTIONS				Project No./Code	
File Name: 18861DES_MP3734_CrossSections.dgn			Date:	Comments	Init.	<div> 606 S 9th St Grand Jct, CO 81501 Phone: (970) 683-6351 FAX:  Region 03</div>	No Revisions: 12/23/13		MP 37.34				C 131A-035		
Horiz. Scale: AS NOTED      Vert. Scale: AS NOTED							Revised:	Designer: J. Klish	Structure Numbers	18861R					
Unit Information: GJ Design      JSL							Void:	Detailer: J. Klish		Sheet Number 67					
								Subset: ConstTraTab	Subset Sheets: 1 of 4						

klishj 2:51:13 PM c:\projectwise\pwz\_working\02333336\18861DES\_MP3734\_CrossSections.dgn

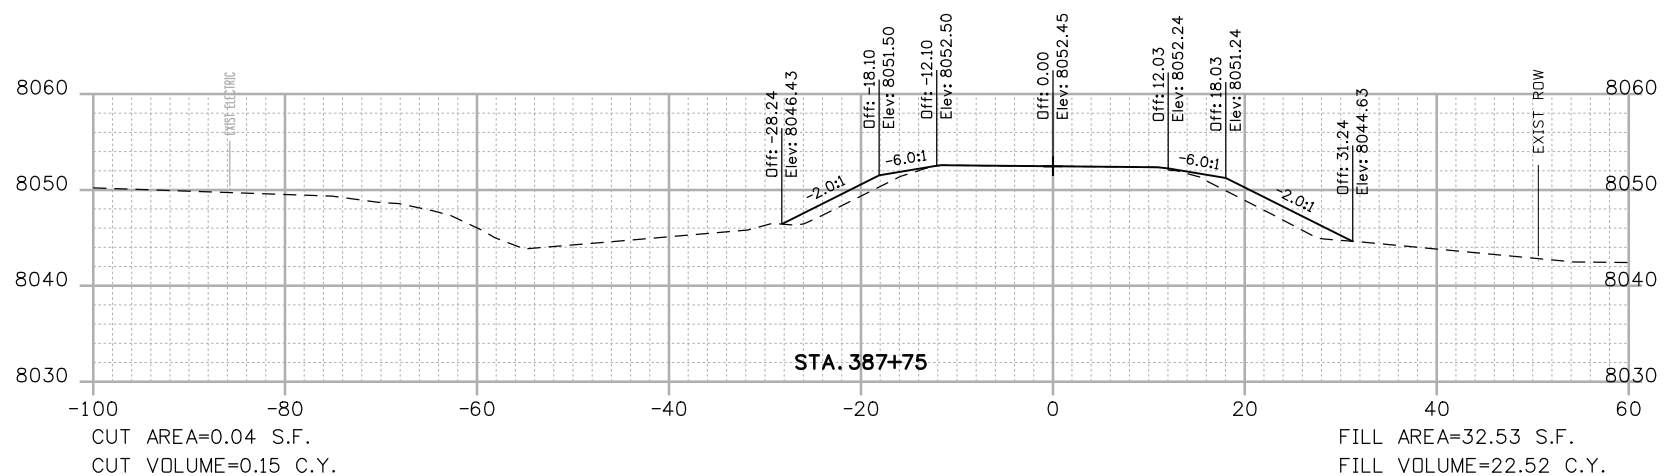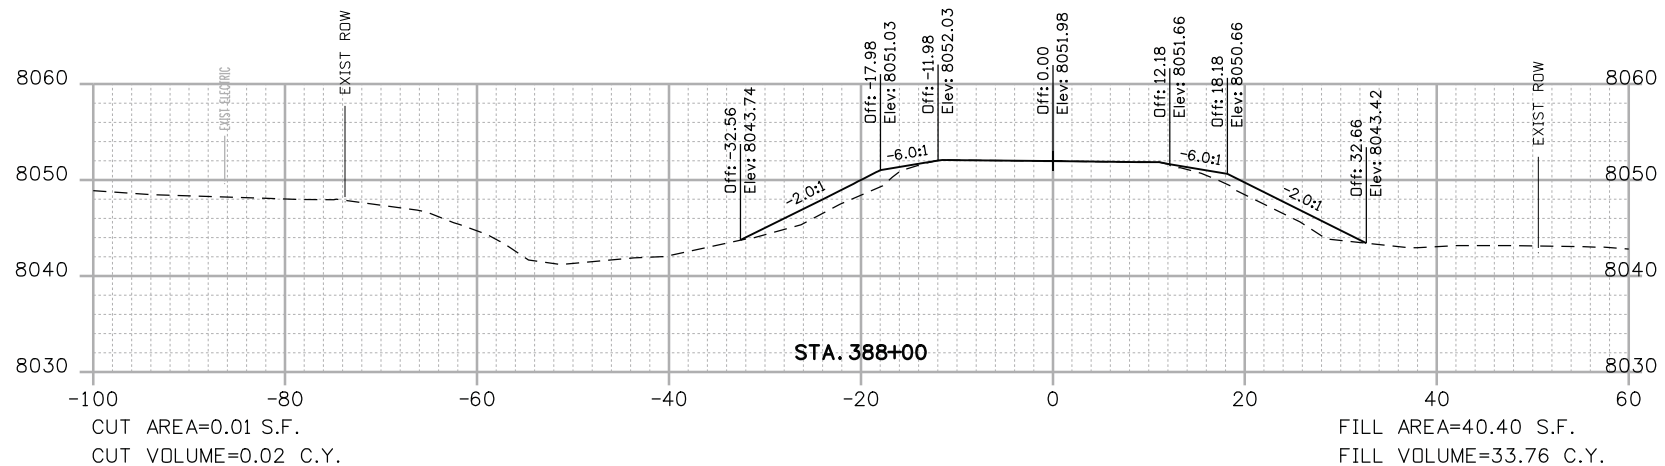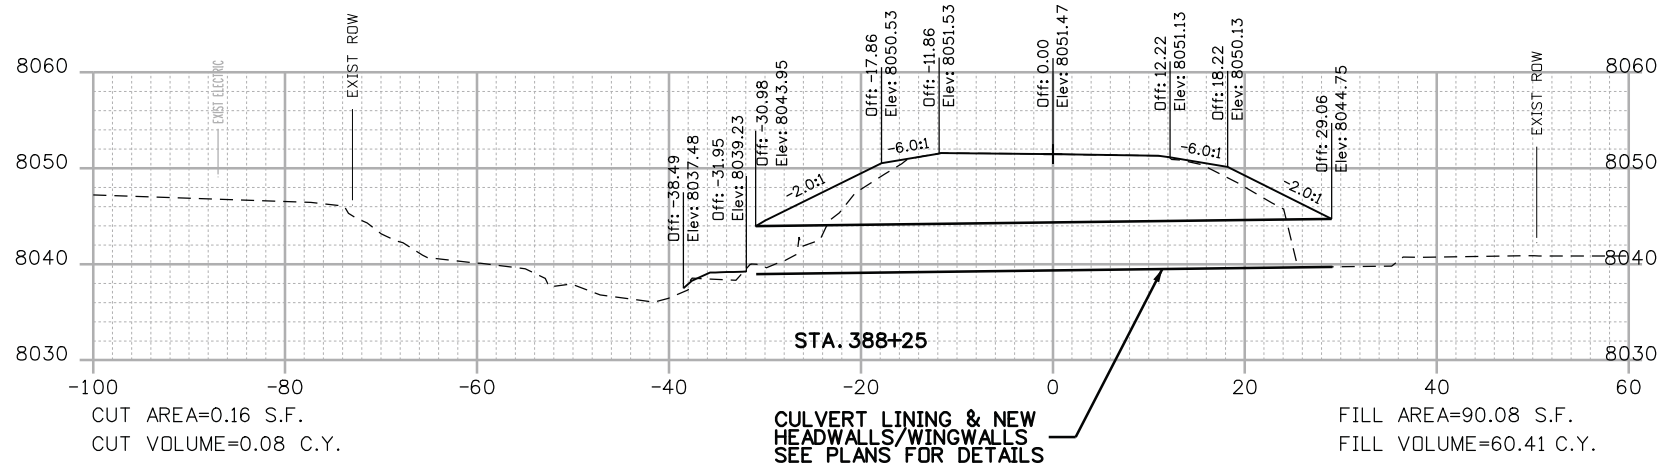


Print Date: 3/1/2013  
File Name: 18861DES\_MP3734\_CrossSections.dgn  
Horiz. Scale: AS NOTED Vert. Scale: AS NOTED  
Unit Information: GJ Design JSL

0000

Sheet Revisions		
Date:	Comments	Init.

Colorado Department of Transportation




 606 S 9th St  
Grand Jct, CO 81501  
Phone: (970) 683-6351 FAX:  


Region 03 JCS

As Constructed		CROSS SECTIONS MP 37.34			Project No./Code
No Revisions: 12/23/13					C 131A-035
Revised:		Designer: J. Klish	Structure Numbers		18861R
Void:		Detailer: J. Klish	Subset: ConstTraTab	Subset Sheets: 2 of 4	Sheet Number 68




klishj 2:51:16 PM c:\projectwise\pwz\_working\0233336\1886IDES\_MP3734\_CrossSections.dgn

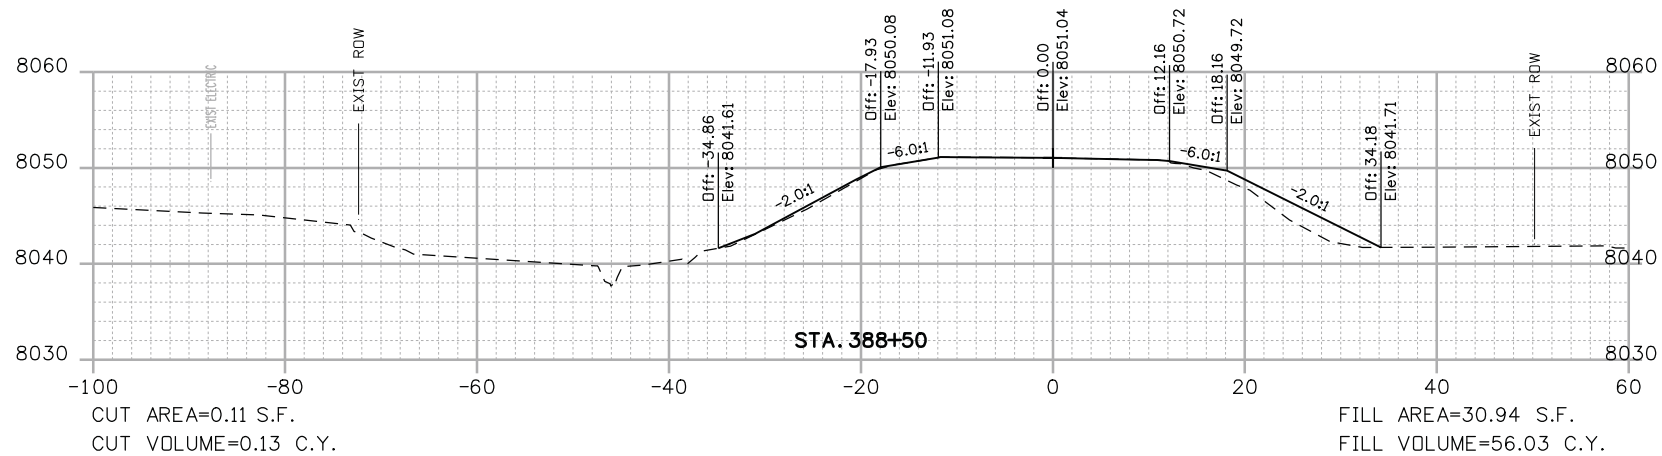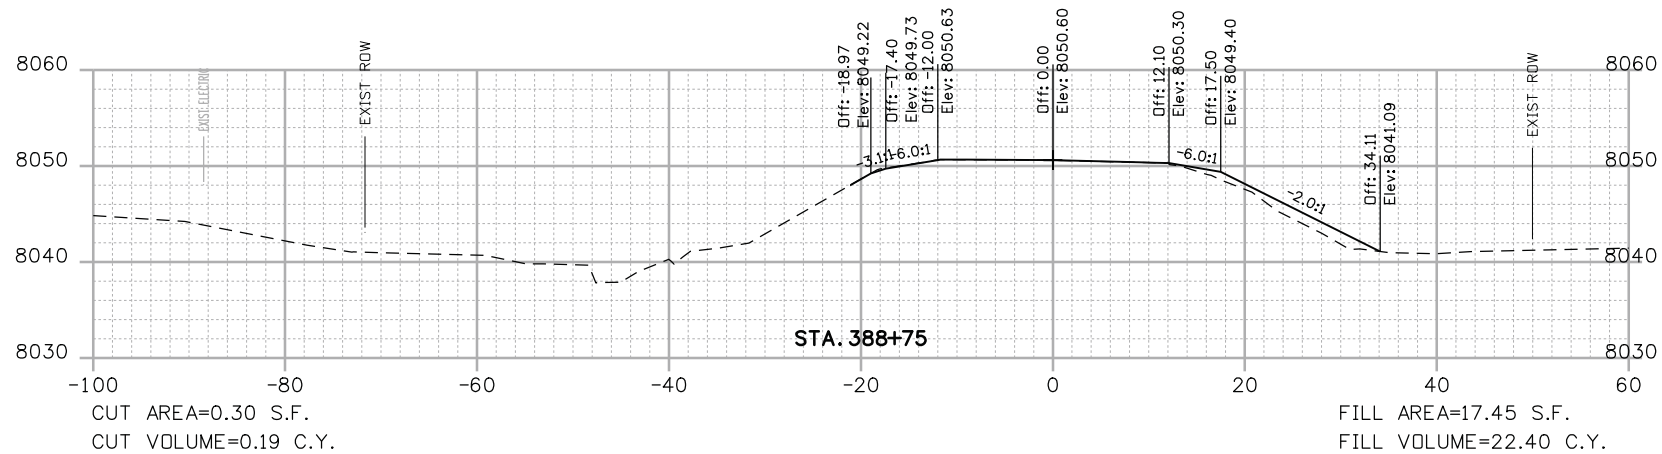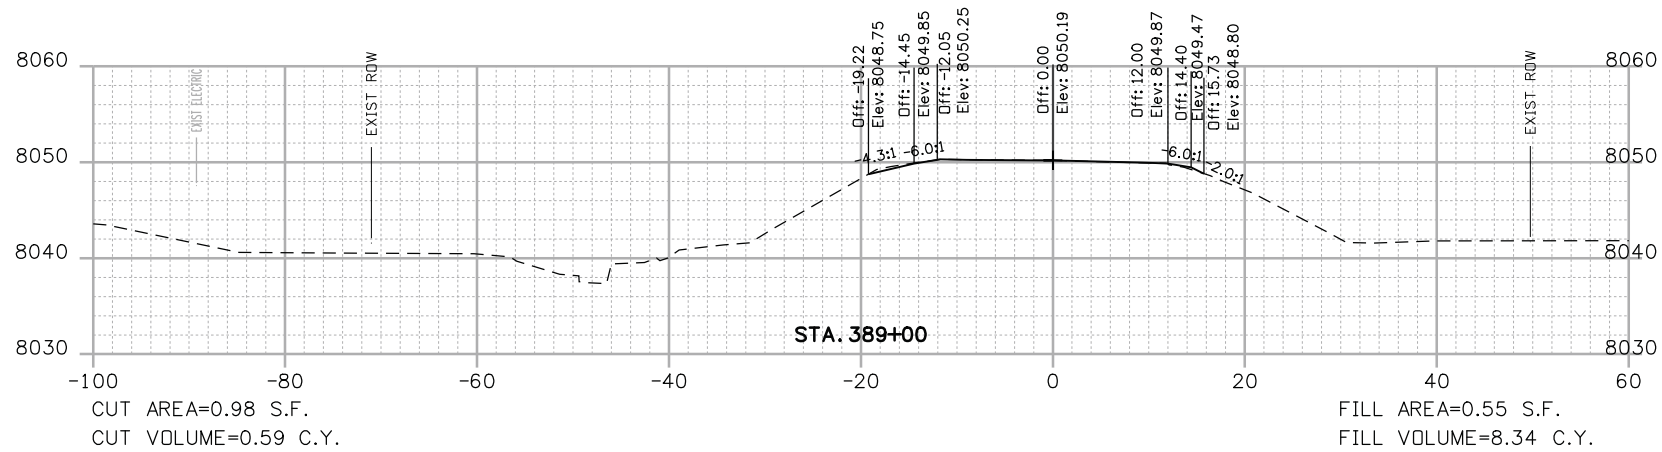

Print Date: 3/1/2013		<div>0000</div>	Sheet Revisions			Colorado Department of Transportation		As Constructed		CROSS SECTIONS				Project No./Code	
File Name: 1886IDES_MP3734_CrossSections.dgn			Date:	Comments	Init.	<div><div>606 S 9th St Grand Jct, CO 81501 Phone: (970) 683-6351 FAX:</div></div>	No Revisions: 12/23/13	MP 37.34			C 131A-035				
Horiz. Scale: AS NOTED      Vert. Scale: AS NOTED							Revised:	Designer: J. Klish	Structure Numbers	18861R					
Unit Information: GJ Design      JSL							Void:	Detailer: J. Klish		Sheet Number 69					
								Subset: ConstTraTab	Subset Sheets: 3 of 4						
						Region 03	JCS								




klishj 2:51:19 PM c:\projectwise\pwz\_working\0233336\18861DES\_MP3734\_CrossSections.dgn

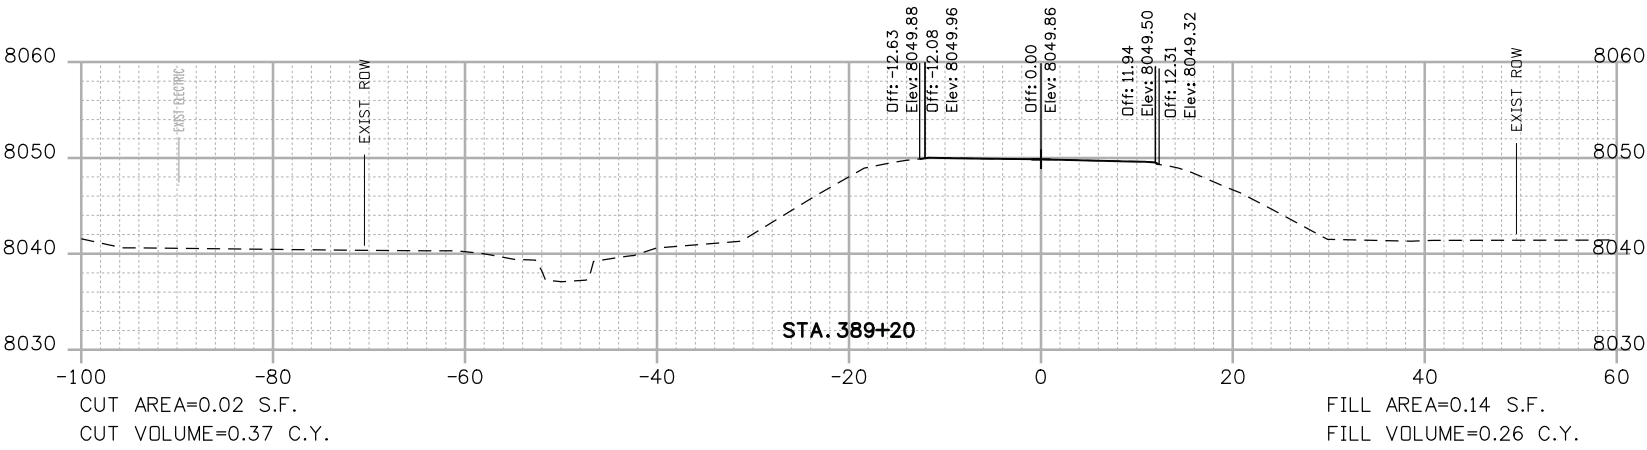

Print Date: 3/1/2013		<div>0000</div>	Sheet Revisions			Colorado Department of Transportation		As Constructed		CROSS SECTIONS MP 37.34				Project No./Code	
File Name: 18861DES_MP3734_CrossSections.dgn			Date:	Comments	Init.			No Revisions: 12/23/13						C 131A-035	
Horiz. Scale: AS NOTED      Vert. Scale: AS NOTED						Revised:		Designer: J. Klish	Structure Numbers	18861R					
Unit Information: GJ Design      JSL						Void:		Detailer: J. Klish		Sheet Number 70					
						Region 03      JCS		Subst: ConstTrafTab	Subst Sheets: 4 of 4						





klishj 2:51:24 PM c:\projectwise\pwz\_working\40233336\1886IDES\_MP3770\_CrossSections.dgn

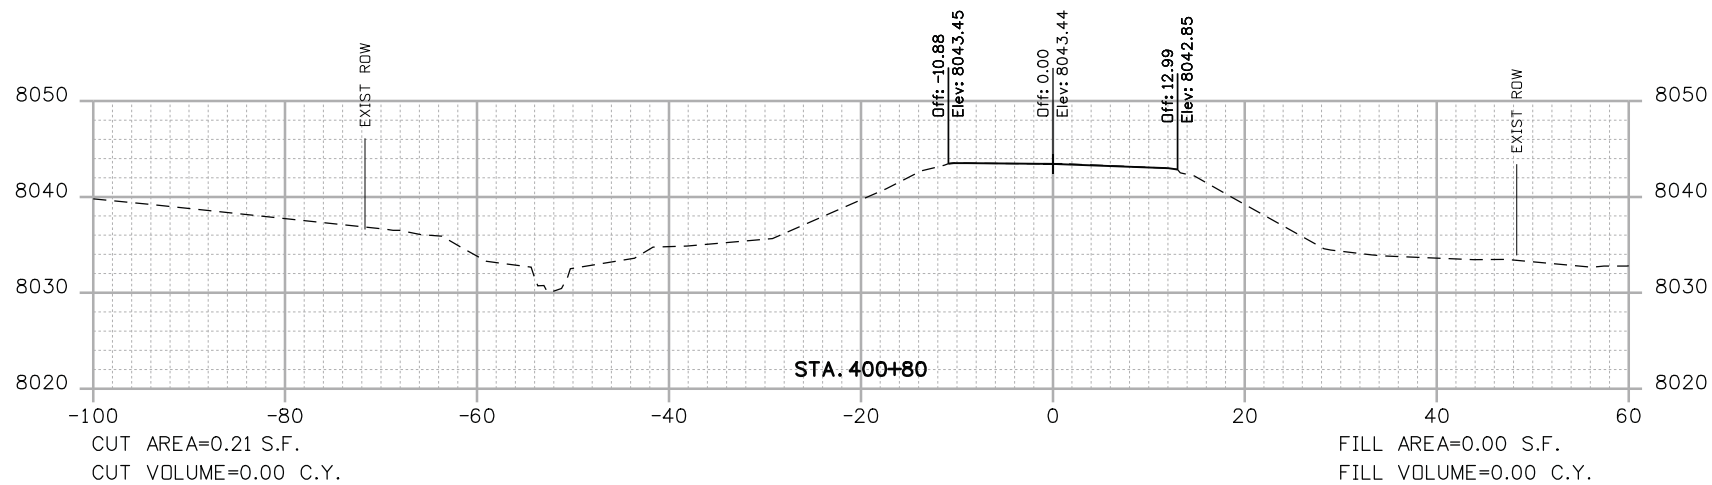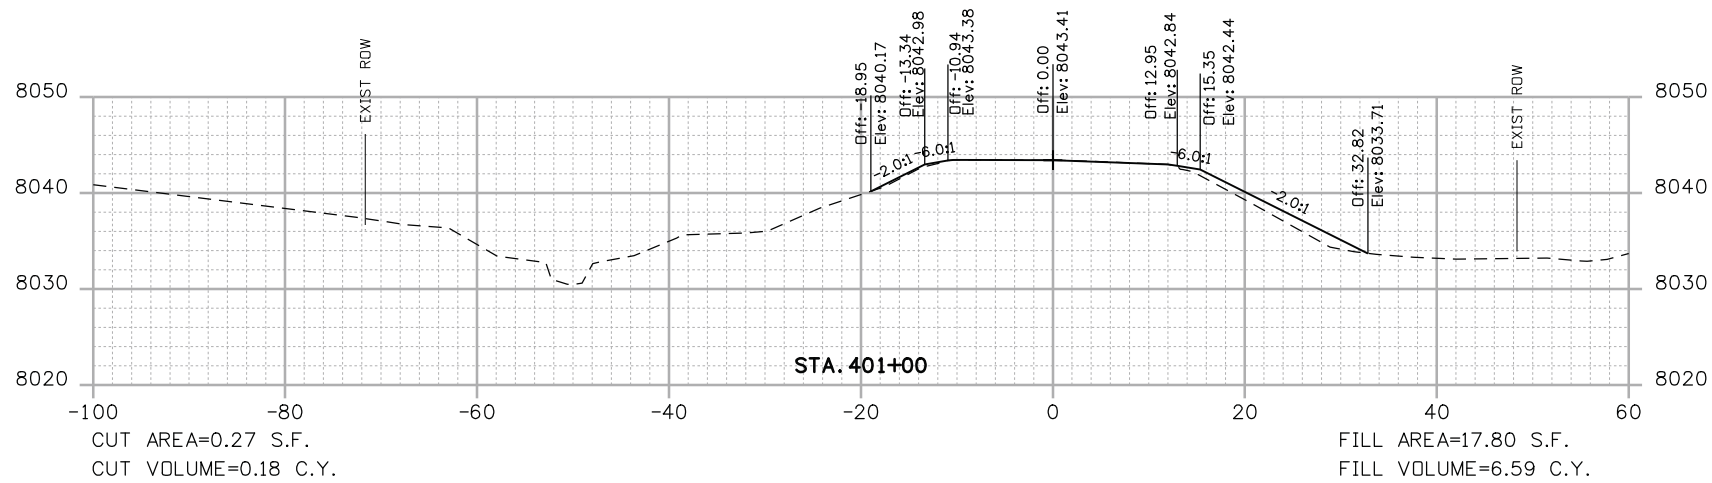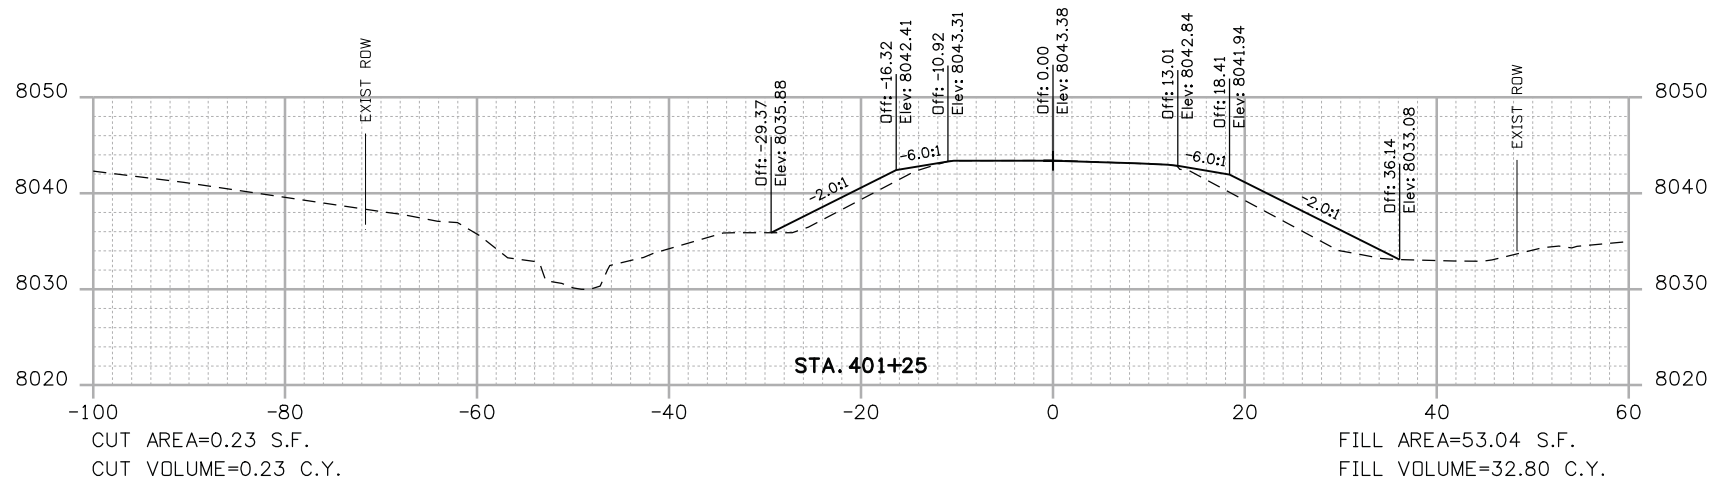

Print Date: 3/1/2013		<div>0000</div>	Sheet Revisions			Colorado Department of Transportation		As Constructed		CROSS SECTIONS				Project No./Code	
File Name: 18861DES_MP3770_CrossSections.dgn			Date:	Comments	Init.	<div> 714 Grand Ave. Eagle, CO 81631 Phone: (970) 328-9962 FAX: (970) 328-2368 REGION 03</div>	No Revisions: 12/23/13	MP 37.70				C 131A-035			
Horiz. Scale: AS NOTED      Vert. Scale: AS NOTED								Revised:	Designer: J. Klish	Structure Numbers	18861R				
Unit Information: GJ Design      JSL								Void:	Detailer: J. Klish		Sheet Number 71				
									Subset: MP 37.70 X-SEC	Subset Sheets: 1 of 5					



klishj 2:51:27 PM c:\projectwise\pwz\_working\40233336\18861DES\_MP3770\_CrossSections.dgn

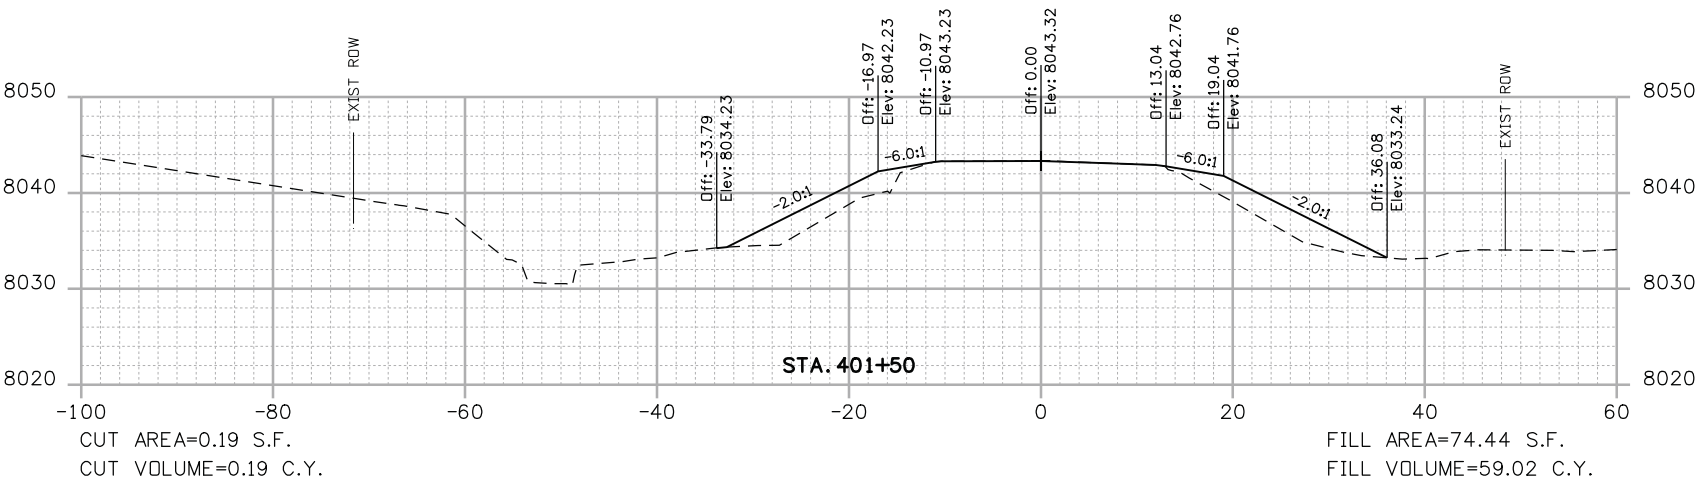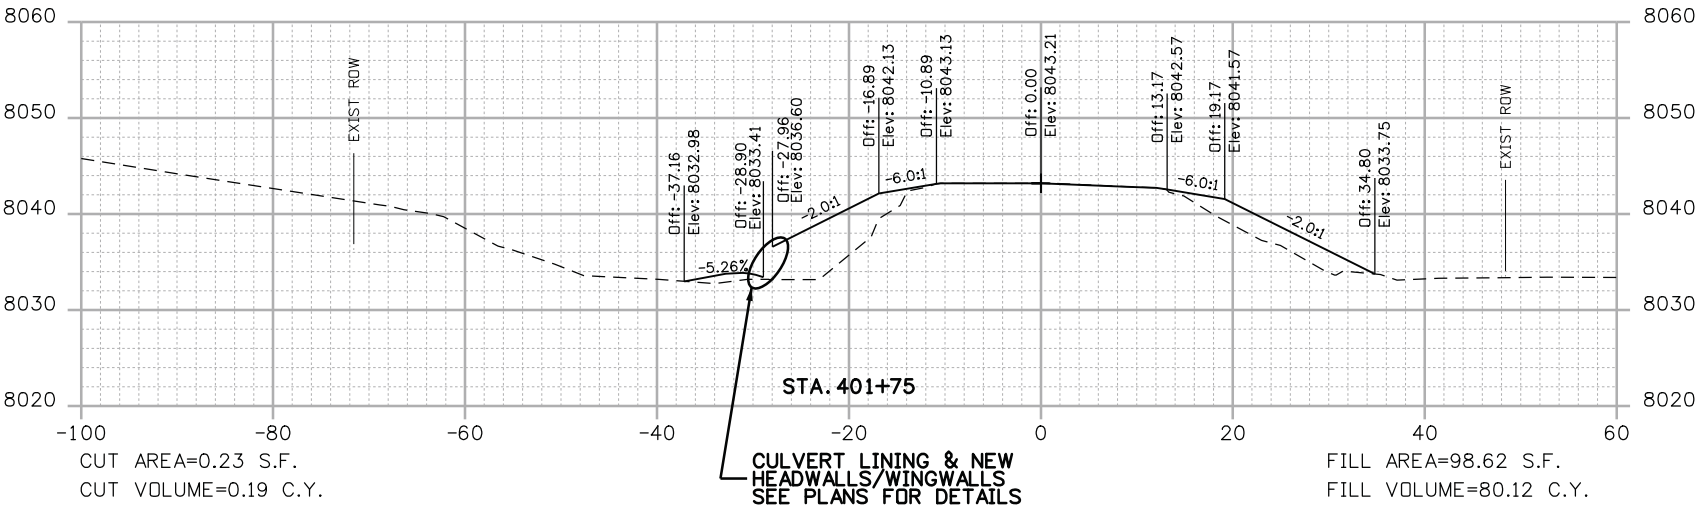

Print Date: 3/1/2013	0000	Sheet Revisions			Colorado Department of Transportation		As Constructed		CROSS SECTIONS		Project No./Code	
File Name: 18861DES_MP3770_CrossSections.dgn		Date:	Comments	Init.	 714 Grand Ave. Eagle, CO 81631 Phone: (970) 328-9962 FAX: (970) 328-2368 REGION 03	PJL	No Revisions: 12/23/13		MP 37.70		C 131A-035	
Horiz. Scale: AS NOTED Vert. Scale: AS NOTED							Revised:	Designer: J. Klish	Structure Numbers	18861R	Sheet Number	72
Unit Information: GJ Design JSL												
							Void:	Subset: MP 37.70 X-SEC	Subset Sheets: 2 of 5			



klishj 2:51:30 PM c:\projectwise\pwz\_working\0233336\18861DES\_MP3770\_CrossSections.dgn

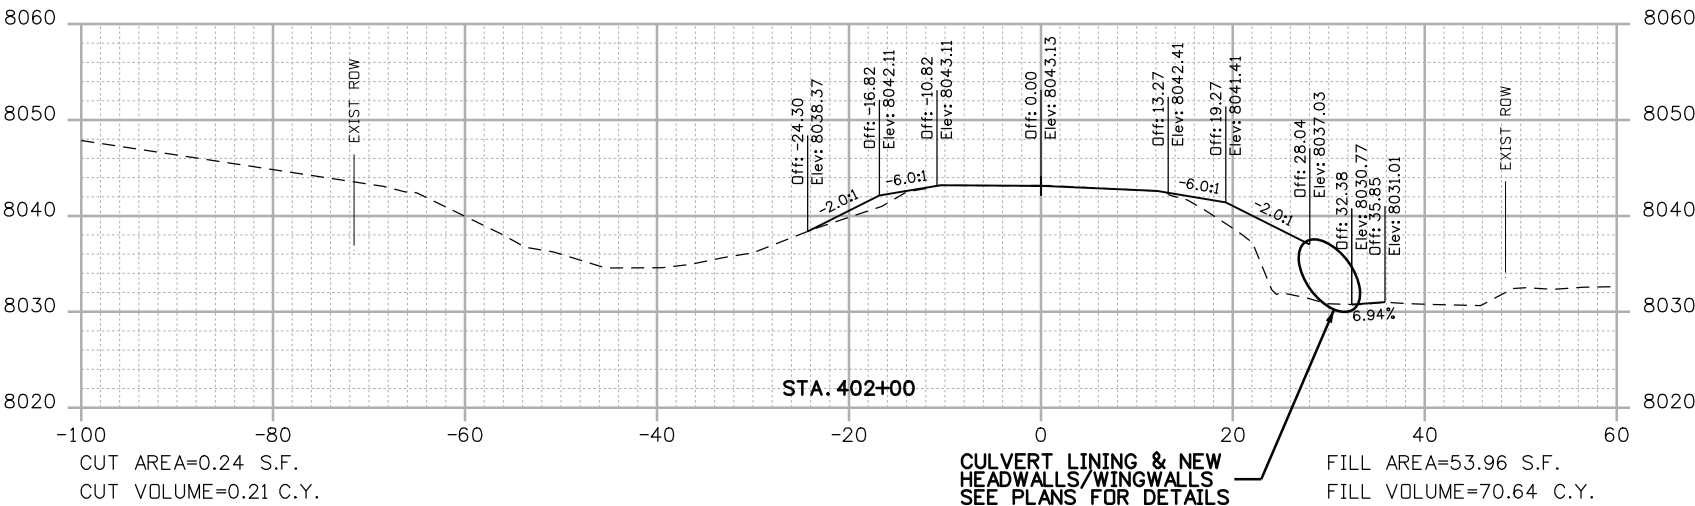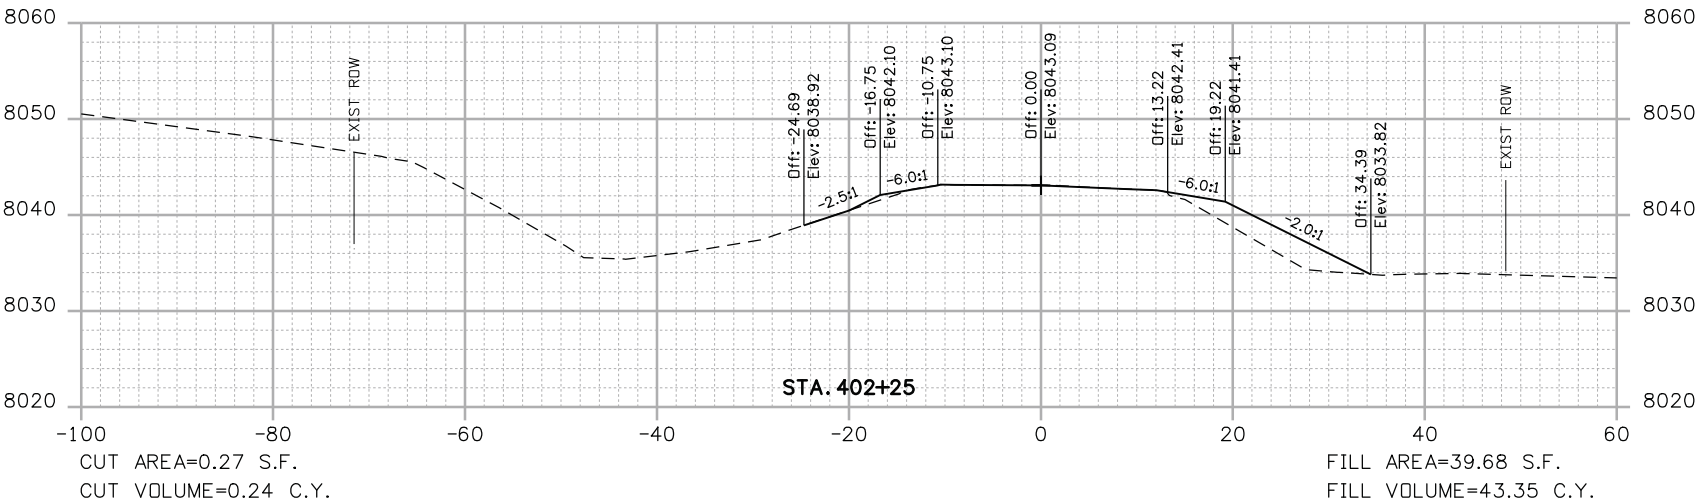

Print Date: 3/1/2013  
File Name: 18861DES\_MP3770\_CrossSections.dgn  
Horiz. Scale: AS NOTED Vert. Scale: AS NOTED  
Unit Information: GJ Design JSL

0000

Sheet Revisions

Date:	Comments	Init.



Colorado Department of Transportation  
714 Grand Ave.  
Eagle, CO 81631  
Phone: (970) 328-9962 FAX: (970) 328-2368  
REGION 03  
PJL

As Constructed

No Revisions: 12/23/13

Revised:

Void:

CROSS SECTIONS  
MP 37.70

Designer:	J. Klish	Structure Numbers	
Detailer:	J. Klish		
Subset: MP 37.70 X-SEC	Subset Sheets: 3 of 5		



Project No./Code

C 131A-035

18861R

Sheet Number 73


klishj 2:51:33 PM c:\projectwise\pwworking\40233336\18861DES\_MP3770\_CrossSections.dgn

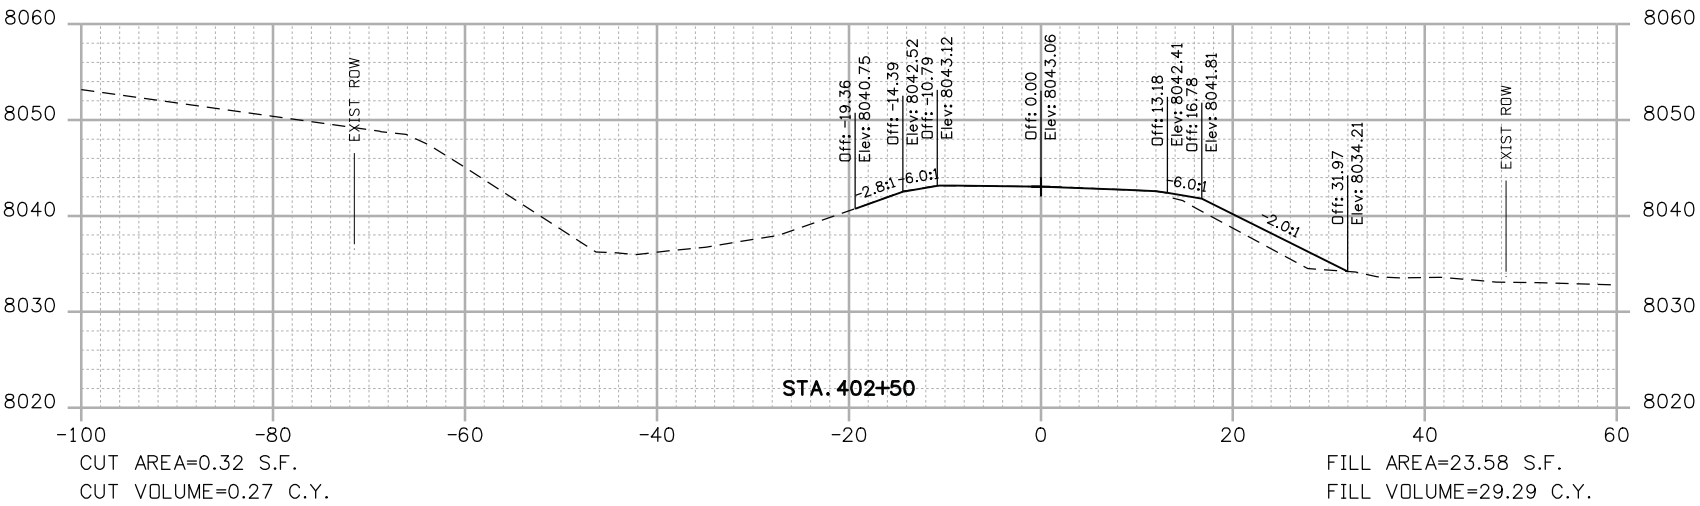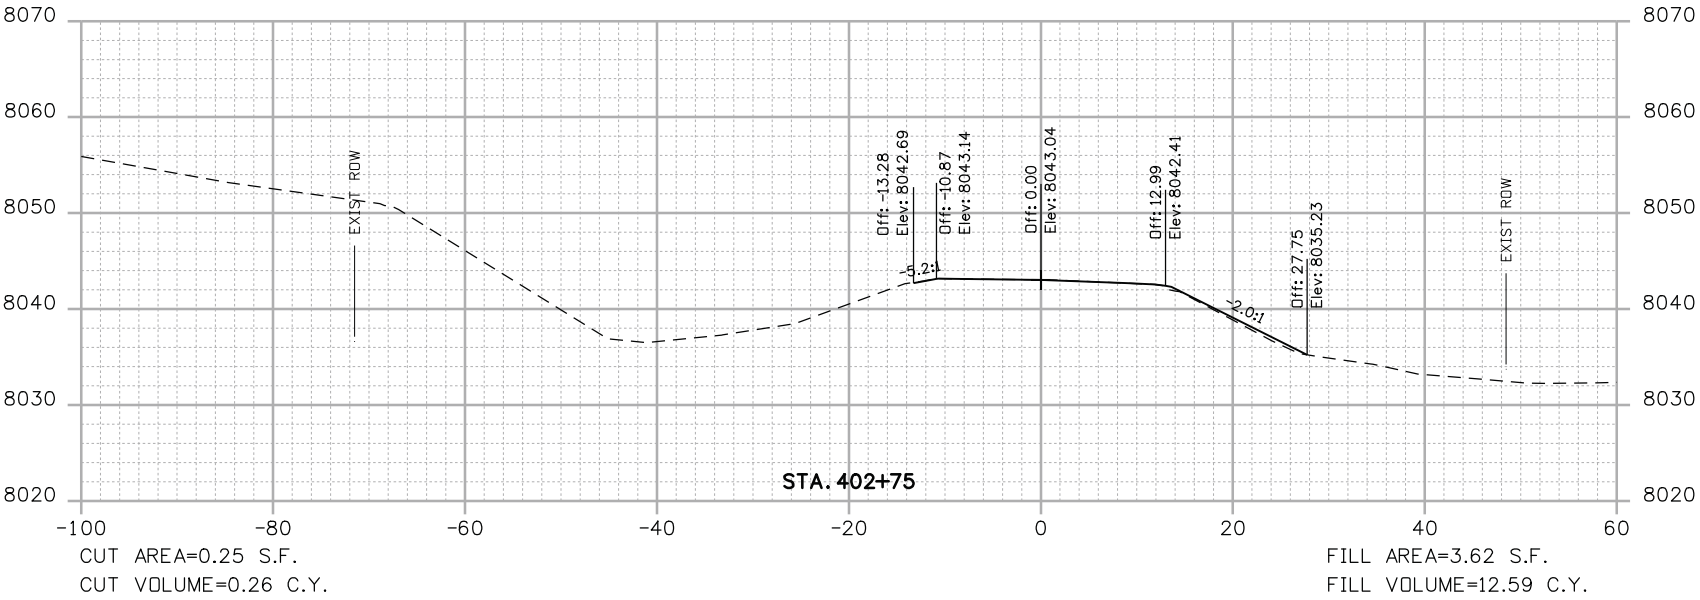


Print Date: 3/1/2013	<div>0000</div>	Sheet Revisions			<div>Colorado Department of Transportation</div> <div><div></div><div>714 Grand Ave. Eagle, CO 81631 Phone: (970) 328-9962 FAX: (970) 328-2368</div><div>REGION 03</div><div>PJL</div></div>		As Constructed	<div>CROSS SECTIONS</div> <div>MP 37.70</div>				Project No./Code	
File Name: 18861DES_MP3770_CrossSections.dgn		Date:	Comments	Init.			No Revisions: 12/23/13					C 131A-035	
Horiz. Scale: AS NOTED      Vert. Scale: AS NOTED							Revised:	Designer: J. Klish	Structure		18861R		
Unit Information: GJ Design      JSL							Void:	Detailer: J. Klish	Numbers		Sheet Number 74		
								Subset: MP 37.70 X-SEC	Subset Sheets: 4	of 5			



klishj 2:51:36 PM c:\projectwise\pwworking\0233336\18861DES\_MP3770\_CrossSections.dgn

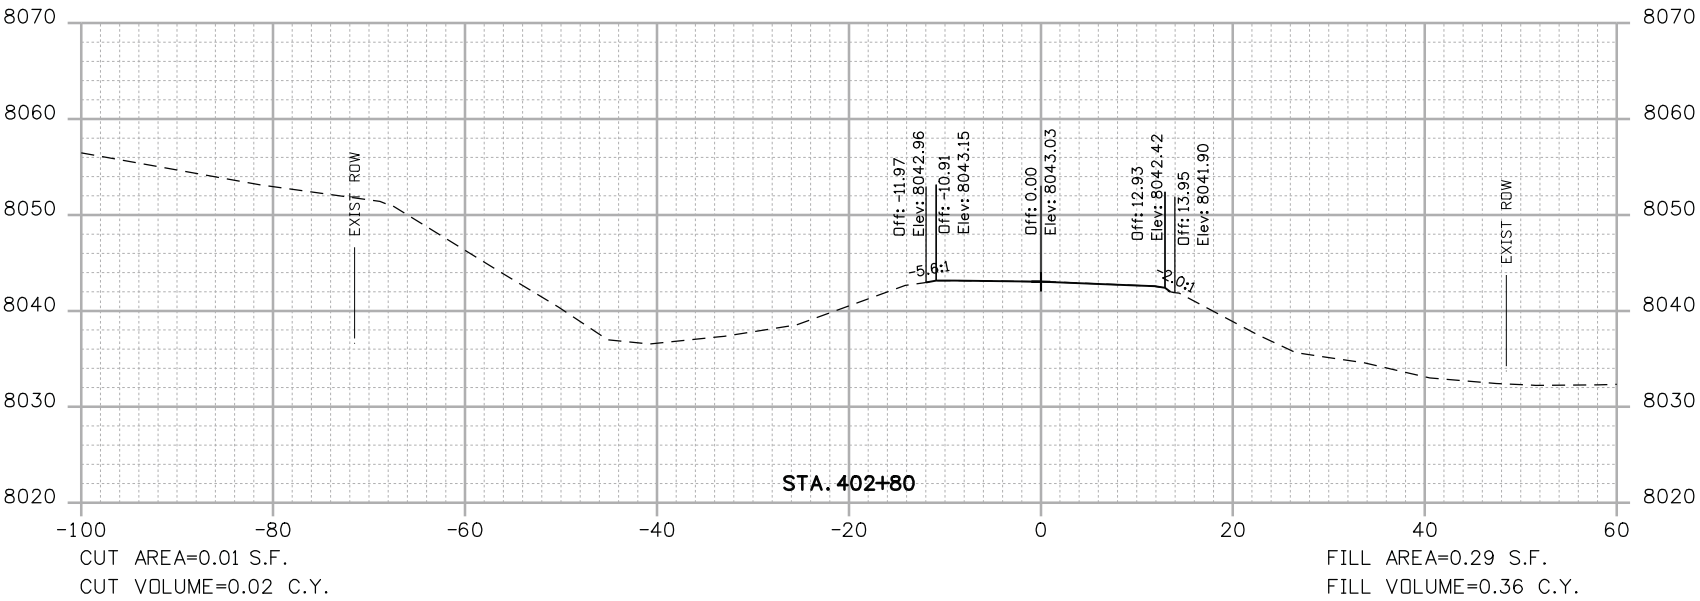

Print Date: 3/1/2013	0000	Sheet Revisions			Colorado Department of Transportation		As Constructed		CROSS SECTIONS		Project No./Code	
File Name: 18861DES_MP3770_CrossSections.dgn		Date:	Comments	Init.	 714 Grand Ave. Eagle, CO 81631 Phone: (970) 328-9962 FAX: (970) 328-2368 REGION 03	PJL	No Revisions: 12/23/13	MP 37.70	MP 37.70		C 131A-035	
Horiz. Scale: AS NOTED Vert. Scale: AS NOTED							Revised:		Designer: J. Klish	Structure Numbers	18861R	
Unit Information: GJ Design JSL							Void:		Detailer: J. Klish		Sheet Number 75	
									Subset: MP 37.70 X-SEC	Subset Sheets: 5 of 5		

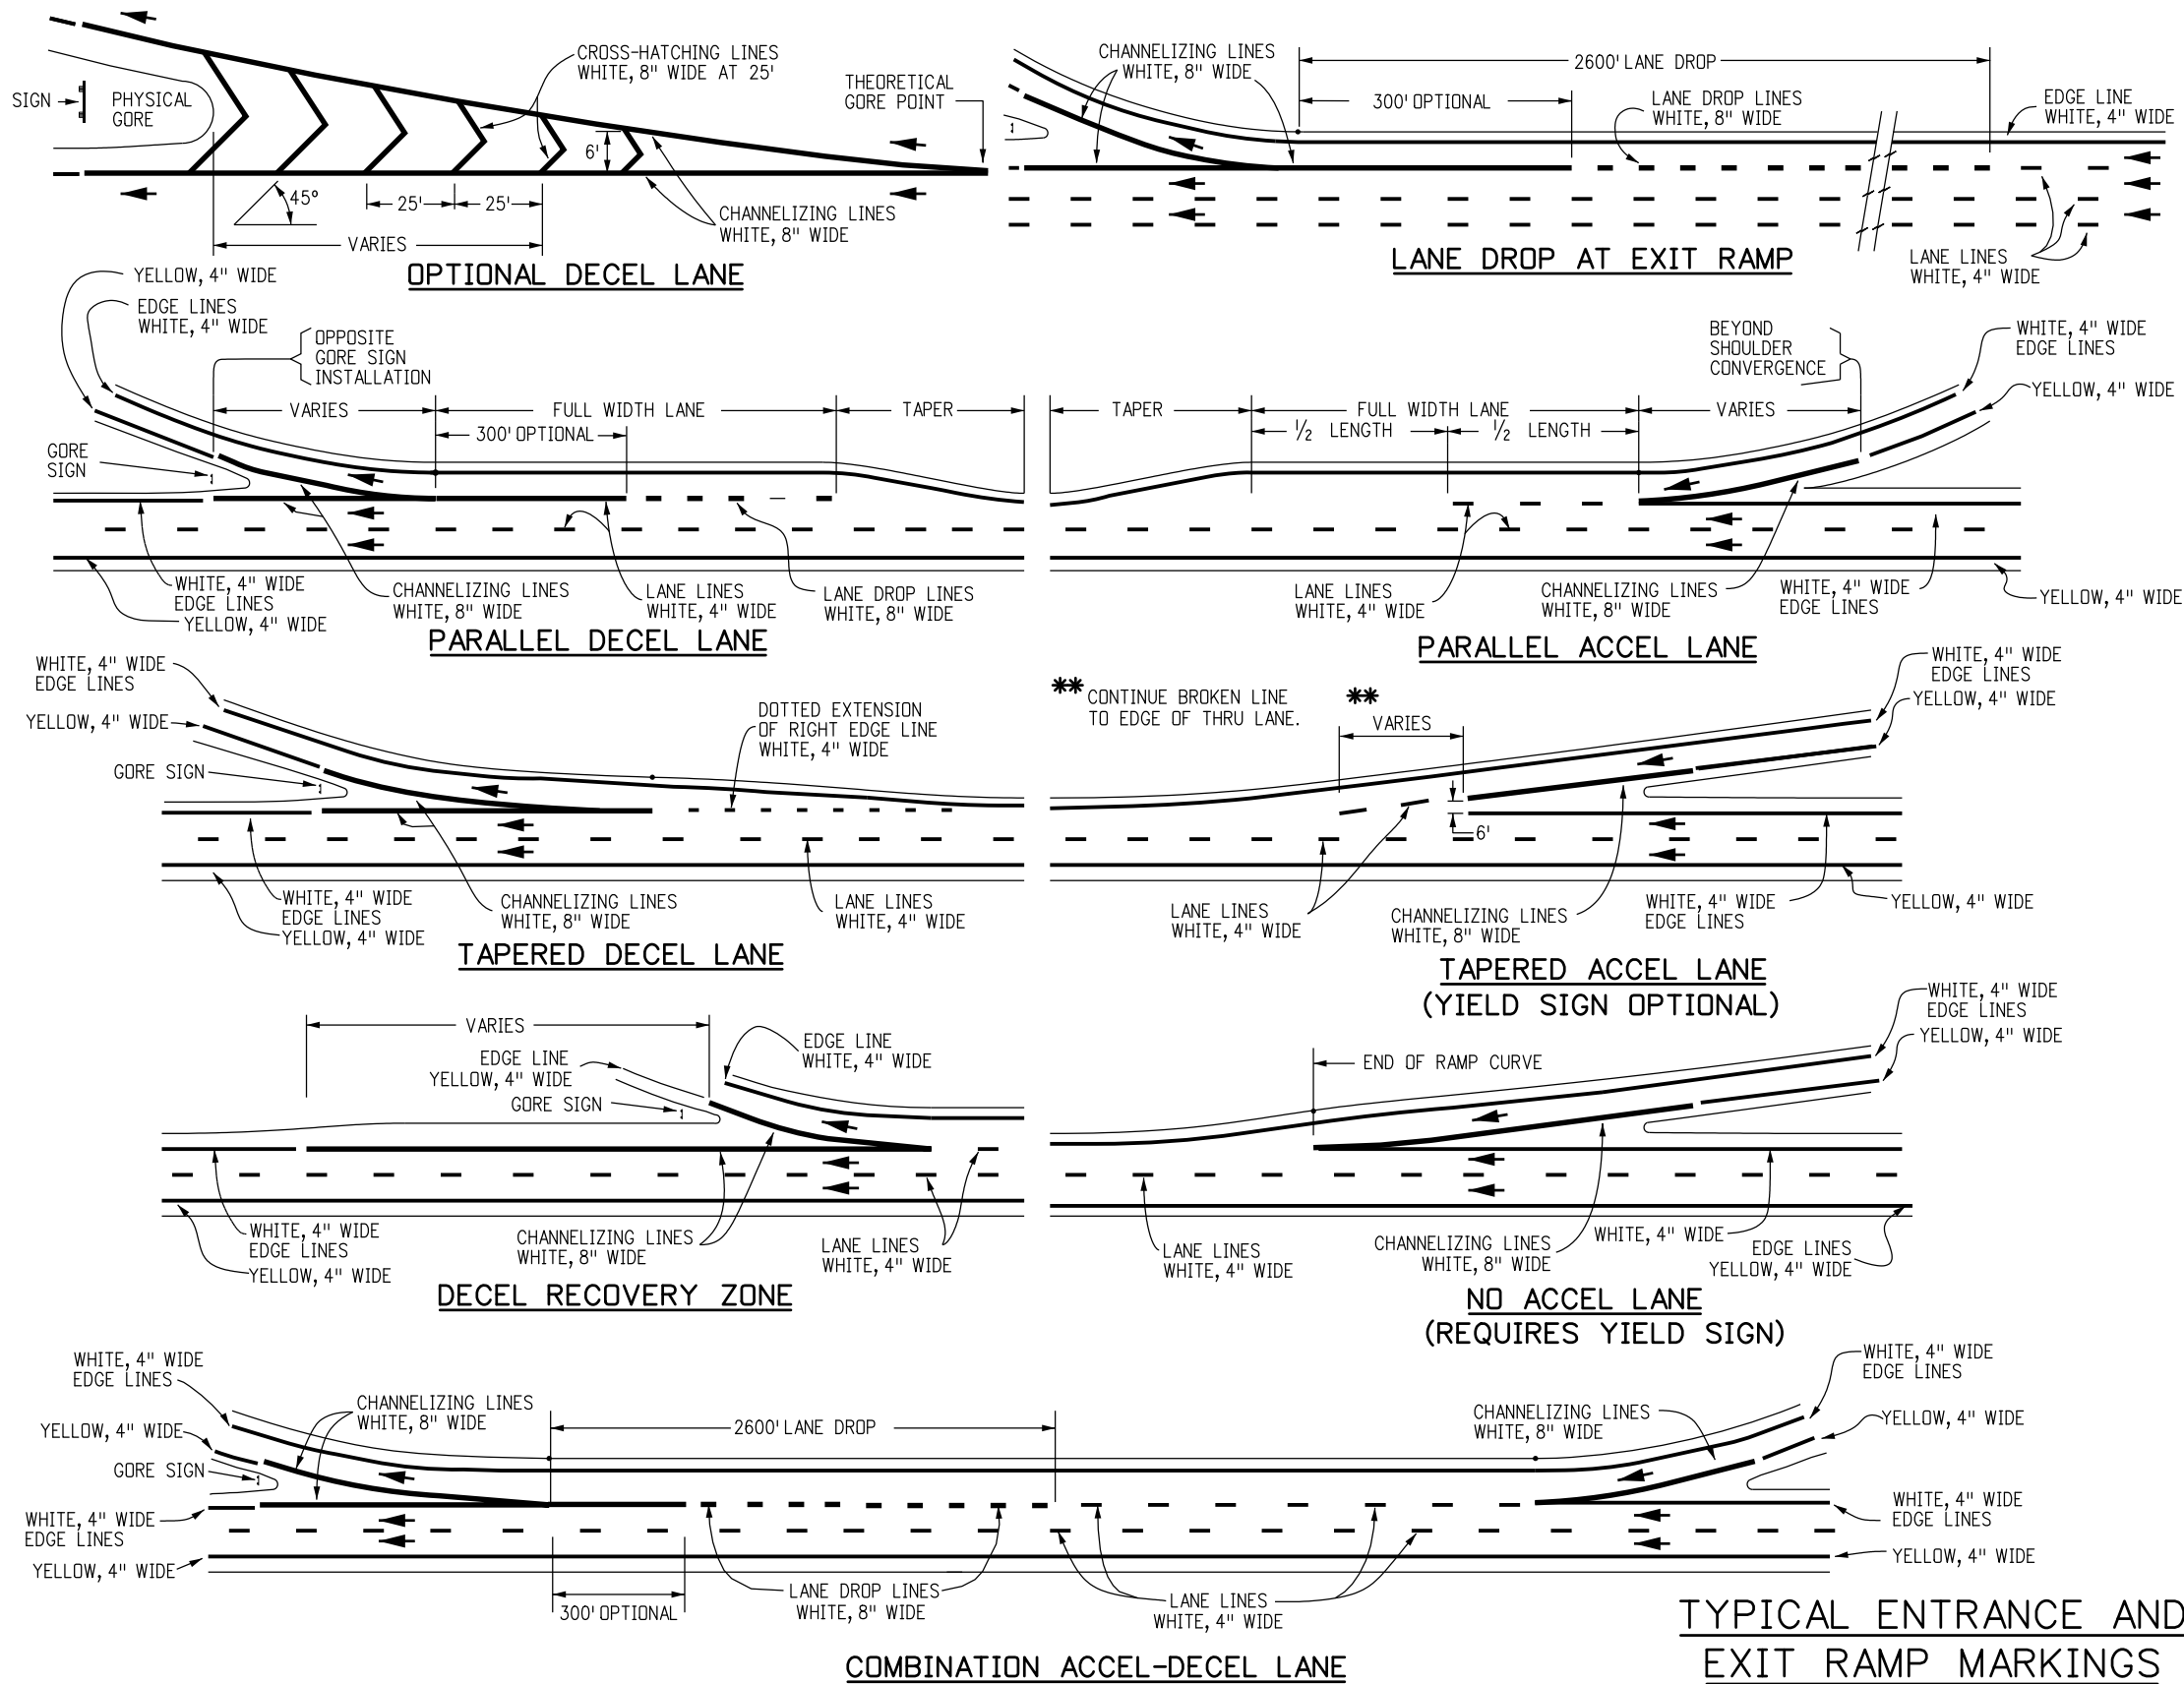


GENERAL NOTES

- CENTER LINES**  
BROKEN YELLOW, 4 IN. WIDE - 10 FT. SEGMENTS WITH 30 FT. GAPS.  
  
SOLID YELLOW, 4 IN. WIDE.  
THESE LINES SEPARATE ADJACENT-OPPOSITE DIRECTION TRAFFIC LANES. DOUBLE LINES SHALL BE SPACED 4 IN. APART.
- LANE LINES**  
BROKEN WHITE, 4 IN. WIDE - 10 FT. SEGMENTS WITH 30' GAPS.  
  
SOLID WHITE, 4 IN. WIDE.  
THESE LINES SEPARATE ADJACENT-SAME DIRECTION TRAFFIC LANES. A SOLID LINE MAY BE USED TO DISCOURAGE LANE CHANGING, WHILE TWO PARALLEL SOLID WHITE LINES ARE REQUIRED TO PROHIBIT LANE CHANGING.
- EDGE LINES**  
SOLID WHITE OR YELLOW EDGE LINES SHALL BE 4 IN. WIDE. YELLOW EDGE LINES SHALL BE USED ONLY FOR LEFT EDGE, IN THE DIRECTION OF TRAVEL OF DIVIDED STREETS AND HIGHWAYS (SEPARATED BY OTHER THAN A PAINTED MEDIAN) AND ONE-WAY ROADWAYS (INCLUDING RAMPs).  
  
EDGE LINES ARE NOT CONTINUED THROUGH INTERSECTIONS AND ARE NOT BROKEN FOR DRIVEWAYS. CARE MUST BE TAKEN TO AVOID EDGE LINE APPEARING AS LANE LINE ALONG ROADWAYS WITH WIDE SHOULDERS AND/OR CLOSELY SPACED DRIVEWAYS.
- DOTTED LINES**  
BROKEN WHITE, WIDTH MATCHING THE LINE BEING EXTENDED-2 FT. SEGMENTS WITH 4 FT. GAPS. THESE LINES ARE USED TO DELINEATE THE EXTENSION OF A LINE THROUGH AN INTERSECTION OR INTERCHANGE AREA.
- CHANNELIZING LINES**  
SOLID WHITE, 8 IN. WIDE. THESE LINES ARE USED WITH ACCELERATION-DECELERATION LANES, PAVEMENT WIDTH TRANSITIONS, AND LEFT-RIGHT TURN SLOTS OR ISLANDS.
- CROSS-HATCHING LINES**  
SOLID WHITE OR YELLOW, 8 IN. WIDE-45 DEGREE DIAGONAL, SPACED AT 25 FT. INTERVALS. THESE LINES ARE OPTIONAL, AND MAY BE PLACED AT LOCATIONS INDICATED ON THE PLANS OR DETERMINED BY THE ENGINEER. YELLOW SHALL BE USED FOR PAINTED MEDIANS OR PAVEMENT WIDTH TRANSITIONS ONLY.  
  
OPTIONAL DIAGONAL SHOULDER MARKINGS SHALL BE SOLID WHITE, 8 IN. WIDE, SPACED AT INTERVALS OF 20 FT. MINIMUM TO 100 FT. MAXIMUM.
- PARKING LINES**  
SOLID WHITE, 3 IN. WIDE-DIAGONAL OR PARALLEL AS SHOWN ON THE PLANS OR DIRECTED BY THE ENGINEER.
- STOP LINES**  
SOLID WHITE, 24 IN. WIDE-EXTEND PARALLEL TO INTERSECTED ROADWAY ACROSS ALL APPROACH LANES OR AS INDICATED AT LOCATIONS ON THE PLANS. LOCATE AT THE DESIRED STOPPING POINT, NOT MORE THAN 30 FT. NOR LESS THAN 4 FT. FROM THE NEAREST EDGE OF THE INTERSECTED TRAFFIC LANE.
- LANE DROP MARKINGS**  
BROKEN WHITE, 8 IN. WIDE - 3 FT. SEGMENTS WITH 12 FT. GAPS. THESE LINES SHOULD BEGIN 2600 FT. IN ADVANCE OF THE THEORETICAL GORE POINT TO DISTINGUISH THE LANE DROP FROM A CONTINUOUS LANE. THE CHANNELIZING LINE MAY BE EXTENDED APPROXIMATELY 300 FT. UPSTREAM.


(CONTINUED ON SHEET NO. 2)

Computer File Information		Sheet Revisions		<div>Colorado Department of Transportation</div> <div>4201 East Arkansas Avenue Denver, Colorado 80222 Phone: (303) 757-9543 Fax: (303) 757-9219</div> <div>Safety &amp; Traffic Engineering Branch      KCM/SCL</div>	PAVEMENT MARKINGS	STANDARD PLAN NO.
Creation Date: 07/04/12	Initials: SCL	Date:	Comments			S-627-1
Last Modification Date: 10/18/12	Initials: SCL	10/18/12	SHEET 2 - ADDED "D" NOTE			Sheet No. 1 of 5
Full Path: www.coloradodot.info/library/traffic/traffic-s-standard-plans					Issued By: Safety & Traffic Engineering Branch July 4, 2012	
Drawing File Name: S-627-01_1of5.dgn						
CAD Ver.: MicroStation V8	Scale: Not to Scale	Units: English				




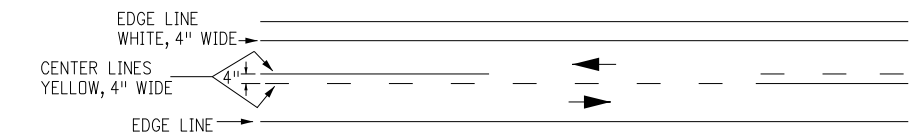


TWO LANE HIGHWAY

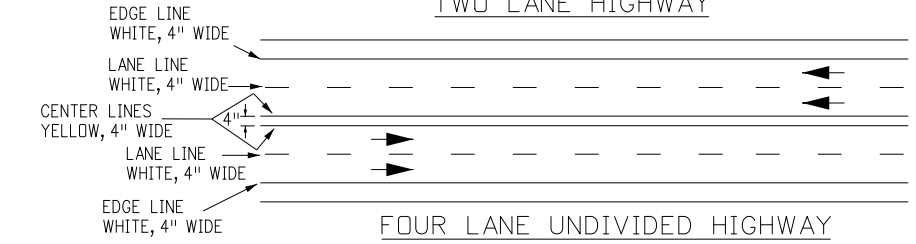


FOUR LANE UNDIVIDED HIGHWAY

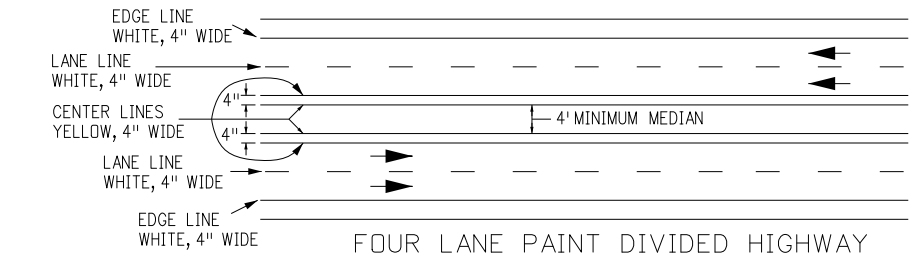


FOUR LANE PAINT DIVIDED HIGHWAY

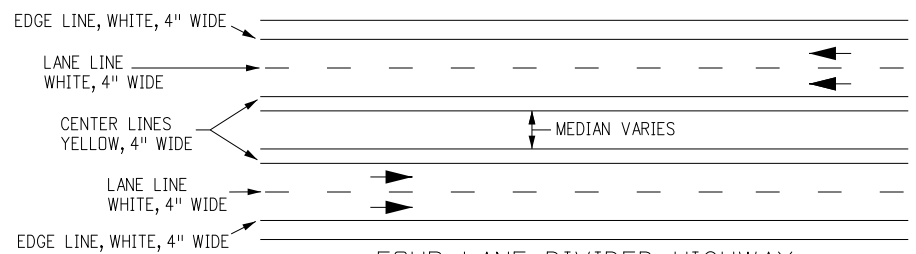


FOUR LANE DIVIDED HIGHWAY

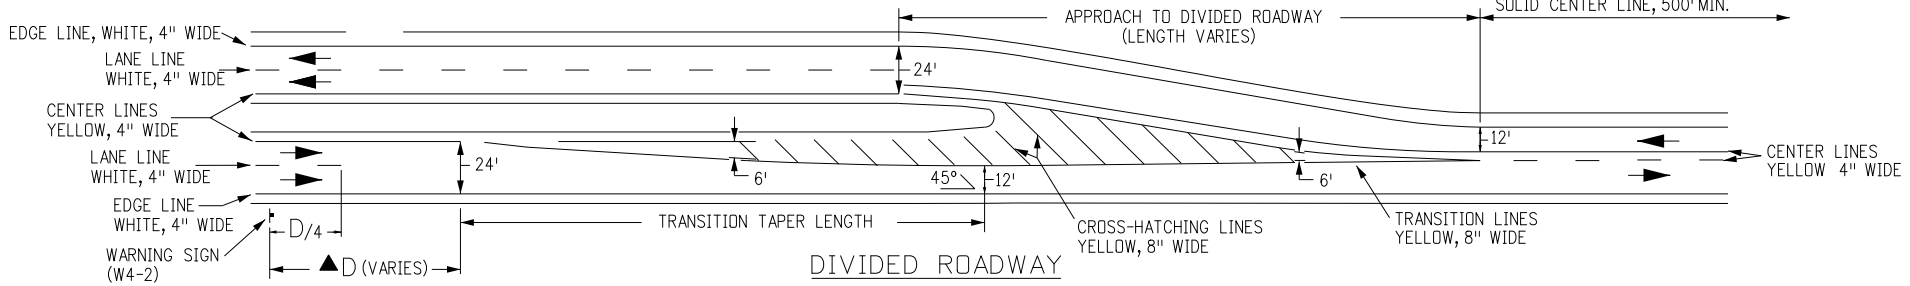


DIVIDED ROADWAY

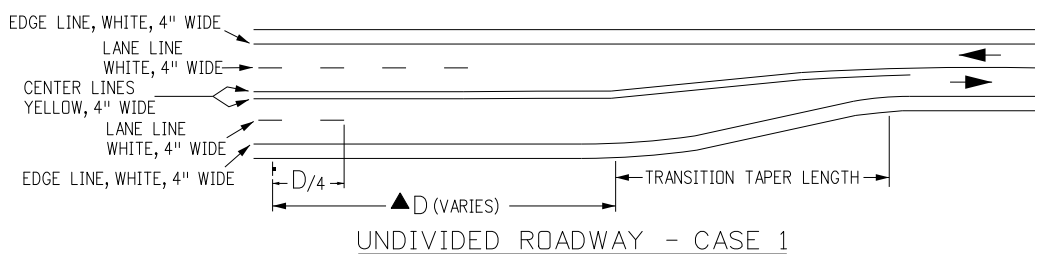


UNDIVIDED ROADWAY - CASE 1

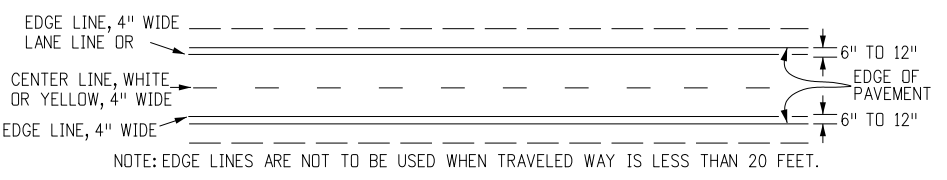


NO SHOULDER OR UNSURFACED SHOULDER

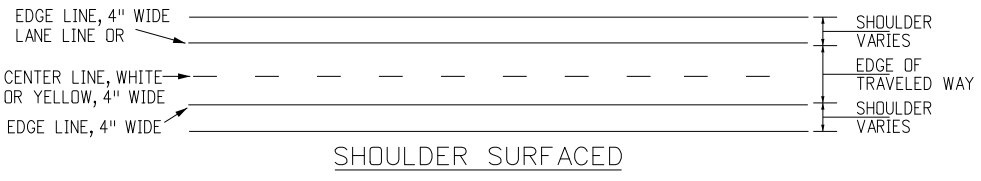


SHOULDER SURFACED

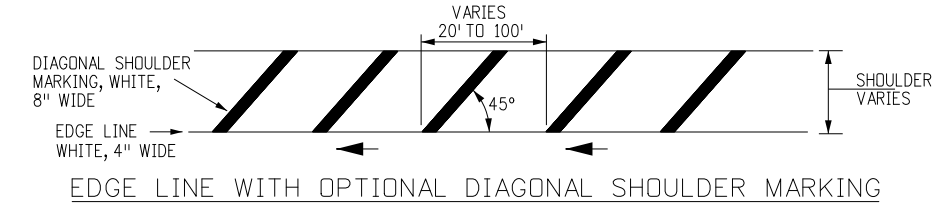

EDGE LINE WITH OPTIONAL DIAGONAL SHOULDER MARKING

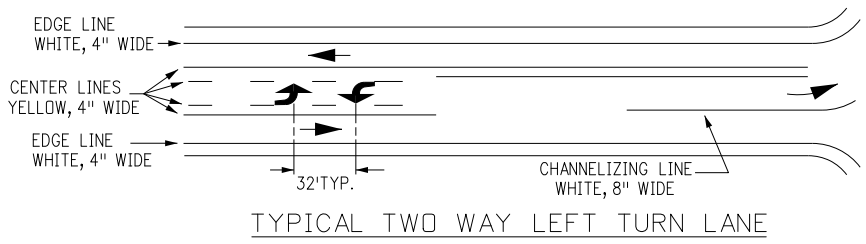

TYPICAL TWO WAY LEFT TURN LANE

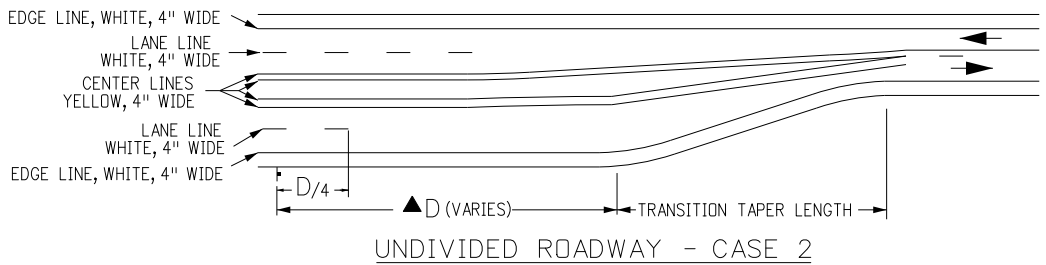

UNDIVIDED ROADWAY - CASE 2

TYPICAL PAVEMENT WIDTH TRANSITION MARKINGS

GENERAL NOTES

(CONTINUED FROM SHEET NO. 1)


10. CROSSWALK LINES  
SOLID WHITE, 12 IN. WIDE FOR TRANSVERSE LINE TYPE - EXTEND ACROSS ENTIRE WIDTH OF PAVEMENT. IF NO ADVANCE STOP LINE IS PROVIDED, INCREASE THE WIDTH OF THE CROSSWALK LINES TO 24 IN. THE DISTANCE BETWEEN THE LINES IS USUALLY DETERMINED BY THE WIDTH OF THE SIDEWALKS SO CONNECTED, HOWEVER, IN NO CASE SHALL THIS BE LESS THAN 6 FT.
11. WORD, ARROW AND SYMBOL MARKINGS  
ALL LETTERS, ARROWS AND SYMBOLS SHALL BE IN CONFORMANCE WITH "THE STANDARD ALPHABETS FOR HIGHWAY SIGNS AND PAVEMENT MARKINGS" ADOPTED BY THE FEDERAL HIGHWAY ADMINISTRATION.
12. TRANSITION TAPER LENGTH  
L = MINIMUM LENGTH OF TAPER.  
S = DESIGN SPEED FOR NEW CONSTRUCTION OR NUMERICAL VALUE OF THE POSTED SPEED LIMIT OF THE 85TH PERCENTILE SPEED OF EXISTING TRAFFIC.  
W = WIDTH TRANSITIONED  
FORMULA: FOR SPEED 45 MPH OR MORE,  $L = S \times W$   
FOR SPEED 40 MPH OR LESS,  $L = \frac{WS^2}{60}$
13. TRANSITION LINES  
SOLID YELLOW, 8 IN. WIDE. THESE LINES ARE USED WHERE ADDITIONAL EMPHASIS OR VISIBILITY IS DESIRABLE AT PAVEMENT WIDTH TRANSITIONS. PLACE AT LOCATIONS INDICATED ON THE PLANS OR AS DIRECTED BY THE ENGINEER.
14. SPEED MEASURING MARKING  
SOLID WHITE, 24 IN. - EXTEND 4 FT. FROM OUTSIDE OF EDGE LINES ON SHOULDERS.

▲ NOTE:  
D = THE DISTANCE FROM THE PAVEMENT WIDTH TRANSITION SIGN (W4-2) TO THE BEGINNING OF THE TRANSITION TAPER. FOR MORE INFORMATION ON THE "D" VALUE REGARDING SIGN AND PAVEMENT MARKING PLACEMENT, SEE THE "MANUAL ON UNIFORM TRAFFIC CONTROL DEVICES", TABLE 2C-4, CONDITION A: SPEED REDUCTION AND LANE CHANGING IN HEAVY TRAFFIC AND FOOTNOTE 2 REGARDING TYPICAL CONDITIONS.


Computer File Information		<div><div></div><div>(R-1)</div><div>(R-X)</div><div>(R-X)</div><div>(R-X)</div></div>	Sheet Revisions		<div>Colorado Department of Transportation</div> <div><div></div><div>4201 East Arkansas Avenue Denver, Colorado 80222 Phone: (303) 757-9543 Fax: (303) 757-9219</div></div>	PAVEMENT MARKINGS		STANDARD PLAN NO.
Creation Date: 07/04/12	Initials: KEN		Date:	Comments				S-627-1
Last Modification Date: 10/18/12	Initials: SCL		10/18/12	ADDED MORE NOTES ON "D" VALUE				Sheet No. 2 of 5
Full Path: www.coloradodot.info/library/traffic/traffic-s-standard-plans								
Drawing File Name: S-627-01_2of5.dgn								
CAD Ver.: MicroStation V8	Scale: Not to Scale	Units: English			Safety & Traffic Engineering Branch	KCM/SCL	Issued By: Safety & Traffic Engineering Branch July 4, 2012	






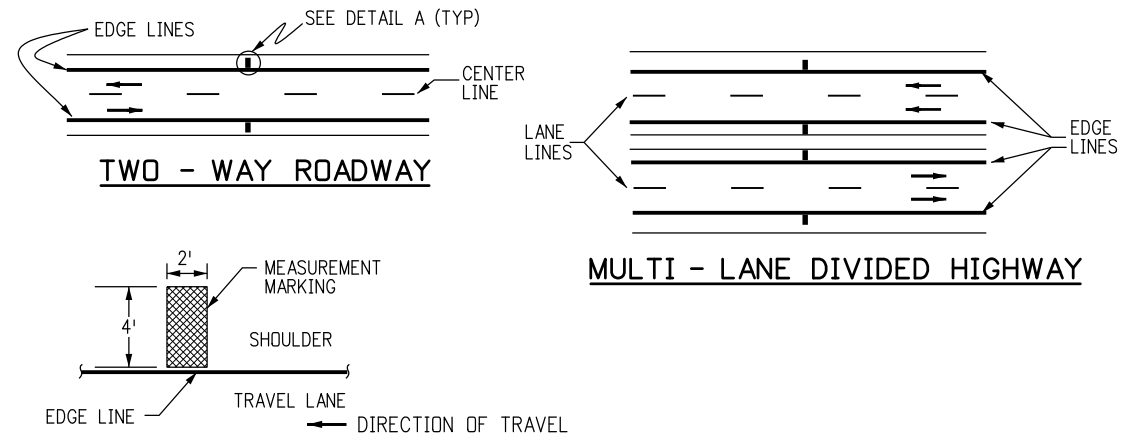

**DETAIL A**  
**TYPICAL SPEED MEASUREMENT MARKING**



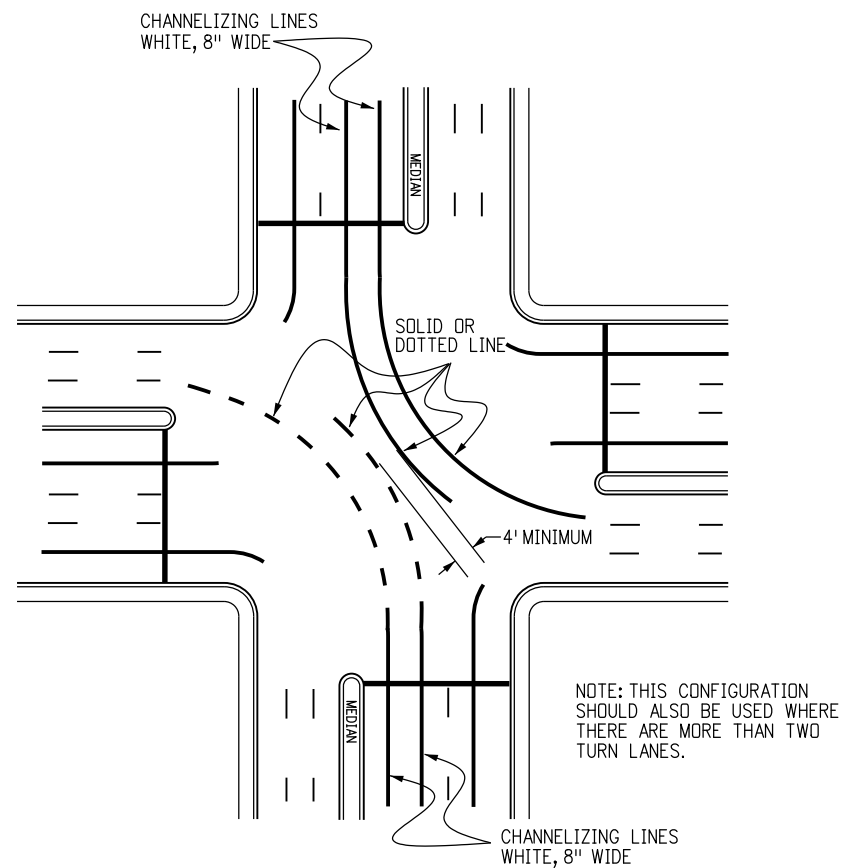


**TYPICAL DOUBLE LEFT TURN MARKINGS**

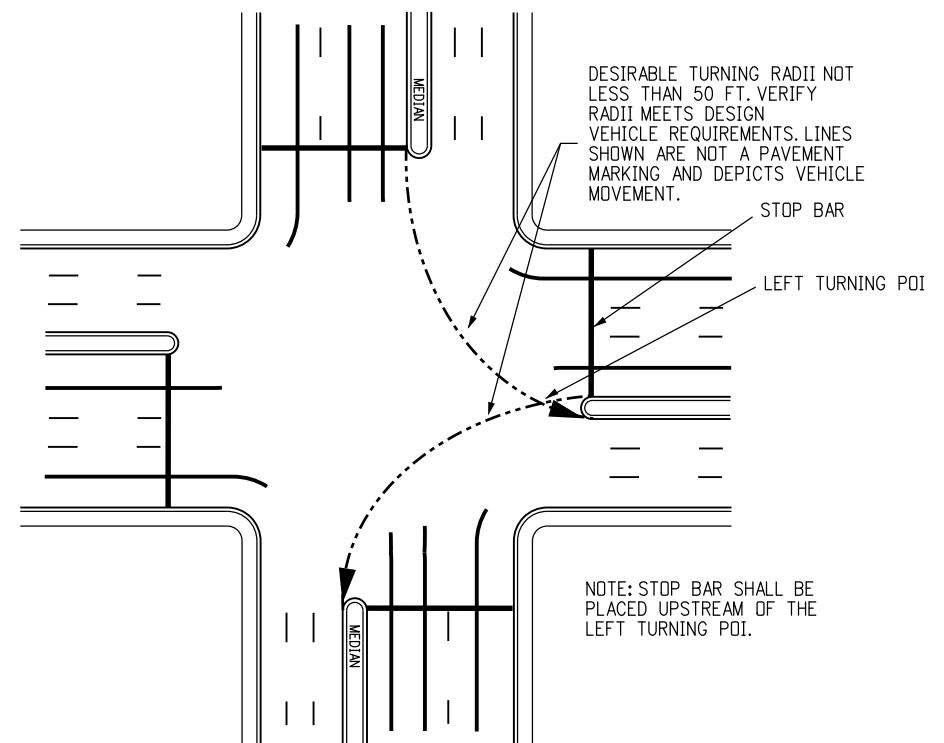

**TYPICAL STOP BAR PLACEMENT**

Computer File Information		Sheet Revisions		<div> <div>Colorado Department of Transportation</div> <div>  <div> 4201 East Arkansas Avenue  Denver, Colorado 80222  Phone: (303) 757-9543  Fax: (303) 757-9219 </div> </div> <div> Safety &amp; Traffic Engineering Branch KCM/SCL </div> </div>	PAVEMENT MARKINGS		STANDARD PLAN NO.
Creation Date: 07/04/12	Initials: SCL	Date:	Comments				S-627-1
Last Modification Date:	Initials:	(R-X)					
Full Path: www.coloradodot.info/library/traffic/traffic-s-standard-plans		(R-X)					
Drawing File Name: S-627-01_4of5.dgn		(R-X)					
CAD Ver.: MicroStation V8	Scale: Not to Scale	Units: English	(R-X)		Issued By: Safety & Traffic Engineering Branch July 4, 2012		Sheet No. 4 of 5

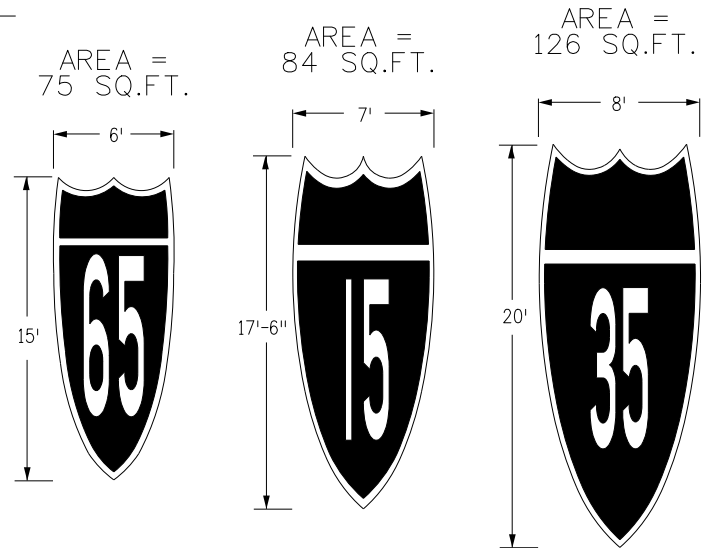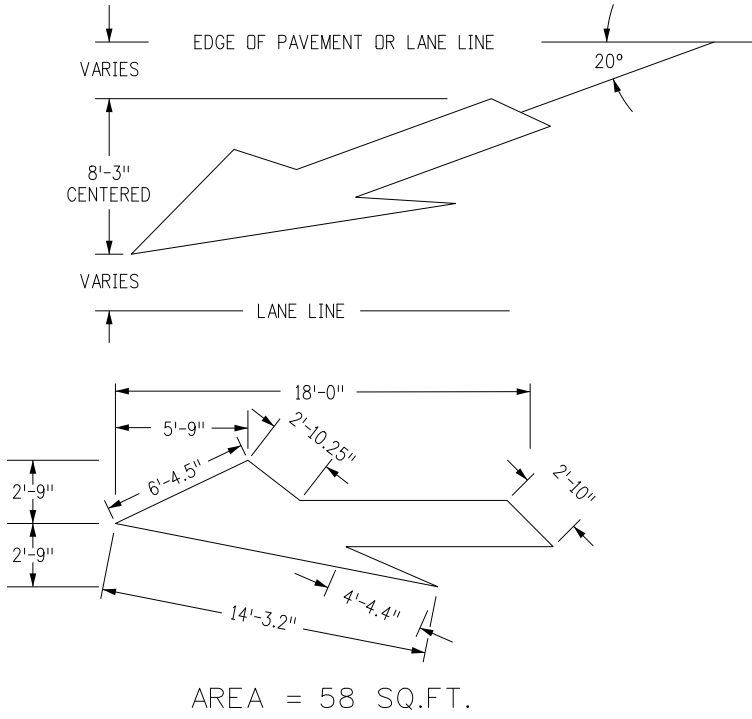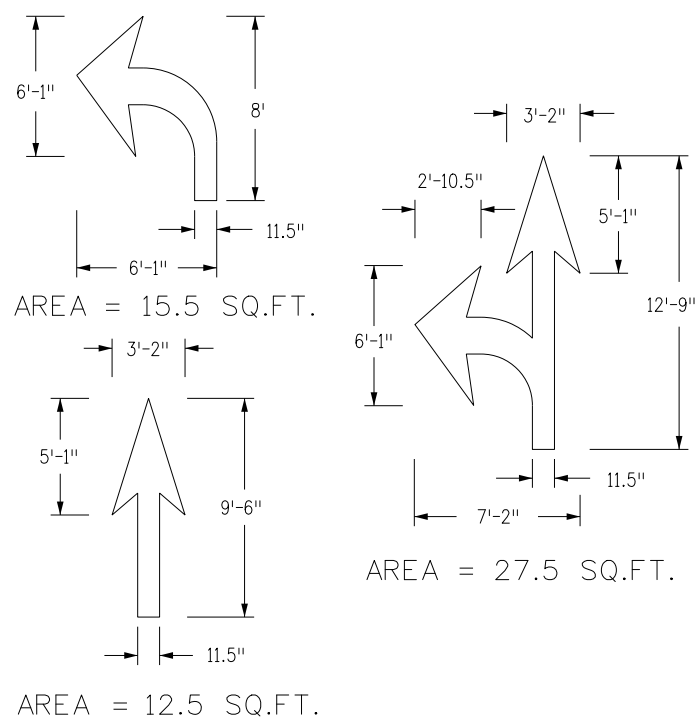

ELONGATED ROUTE SHIELDS

ELONGATED ROUTE SHIELD NOTES


ELONGATED ROUTE SHIELDS SHALL BE AT LEAST 8'x20' WHEN USED ON HIGH SPEED ROADWAYS (45 MPH OR MORE).

PER FIGURE 3B-25 OF THE 2009 MUTCD ELONGATED ROUTE SHIELD COLORS SHALL CONFORM WITH THE STANDARD HIGHWAY SIGNS AND MARKINGS BOOK.

DESIGNATED PAYMENT AREAS


FOR THE FOLLOWING H, W, AND S DIMENSIONS PAY:

H = 4' WORDS	
BIKE - 5.5 SQ.FT.	LANE - 6.0 SQ.FT.
ONLY - 6.0 SQ.FT.	XING - 5.0 SQ.FT.
H = 8' WORDS	
STOP - 23.0 SQ.FT.	XING - 20.0 SQ.FT.
ONLY - 22.5 SQ.FT.	LANE - 22.5 SQ.FT.
AHEAD - 29.0 SQ.FT.	BIKE - 21.0 SQ.FT.
BUS - 18.5 SQ.FT.	HWY - 16.5 SQ.FT.
THRU - 22.0 SQ.FT.	SCHOOL(1L) - 33.0 SQ.FT.
PED - 17.5 SQ.FT.	SCHOOL(2L) - 85.0 SQ.FT.

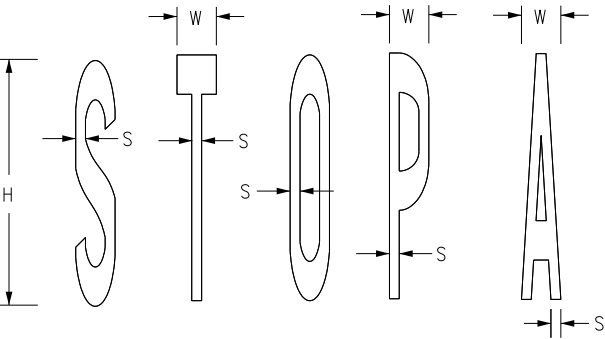


H = HEIGHT	H = 8'	H = 4'
W = WIDTH	W = 1'-3.4" TO 1'-4"	W = 7.7" TO 8"
S = STROKE	S = 3.8" TO 4"	S = 1.9" TO 2"


TYPICAL LETTER MEASUREMENTS

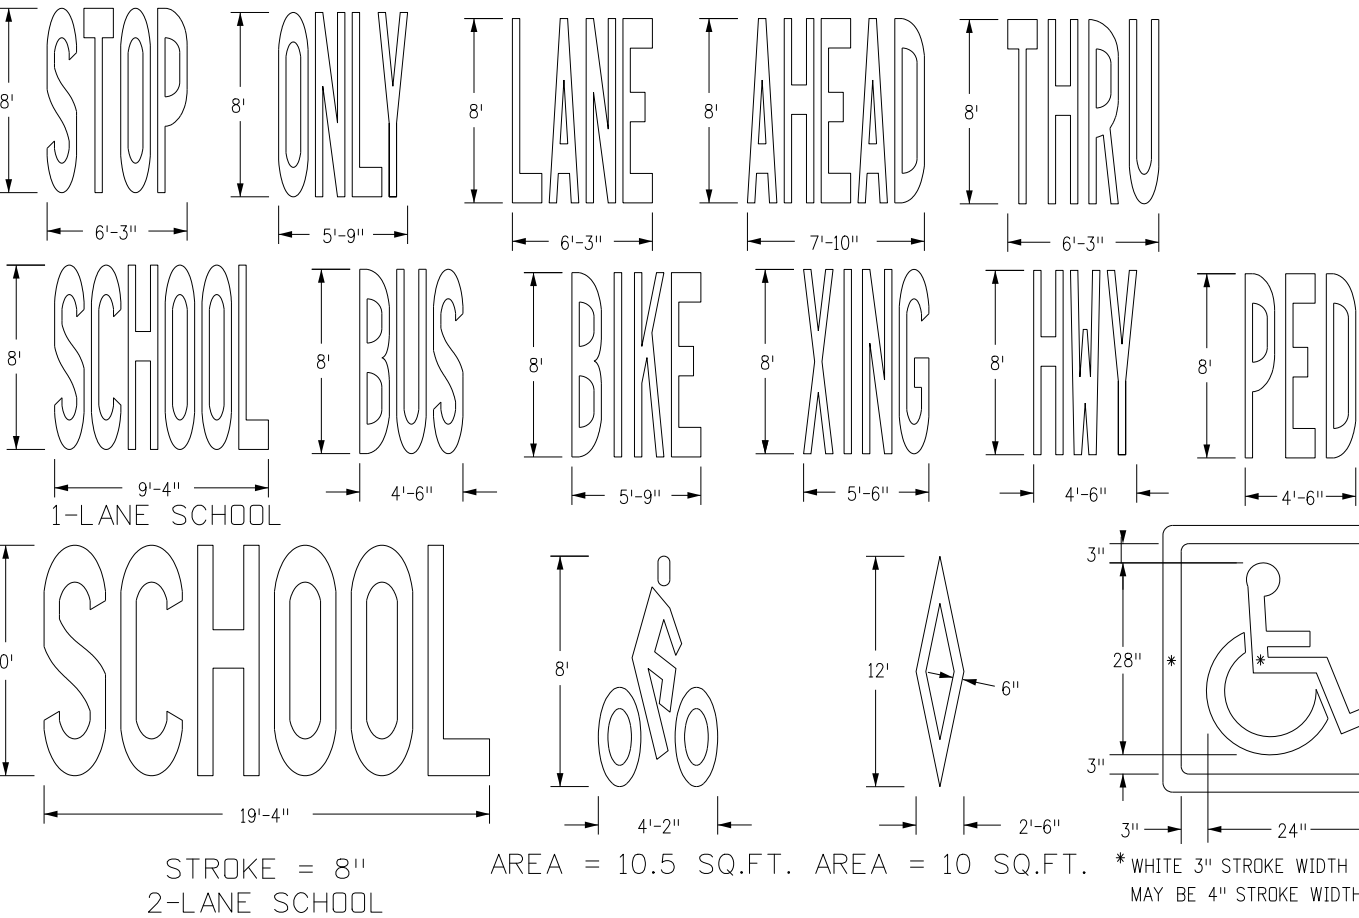

PAVEMENT MARKING WORDS AND SYMBOLS

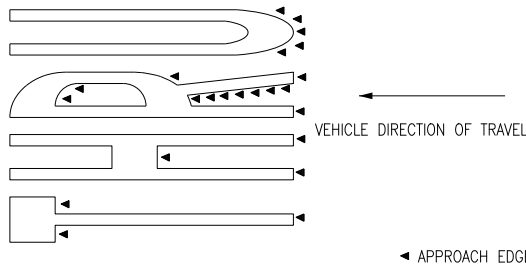

TYPICAL APPROACH EDGE TAPERING VIEW

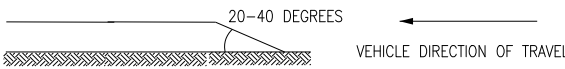

TYPICAL APPROACH EDGE TAPERING PROFILE VIEW

WORD AND SYMBOL NOTES

IF HEIGHT IS INCREASED OR DECREASED THEN ALL MEASUREMENTS CHANGE PROPORTIONATELY. EXAMPLE: "H" MEASUREMENT FOR STOP IS REDUCED TO 4' FROM 8' THEN SQUARE FEET = 5.75 (1/4 OF 23.0 SQ. FT.).

PAVEMENT WORD AND SYMBOL MARKINGS, TRANSVERSE AND LONGITUDINAL (CONTINENTAL) CROSSWALK LINES, AND STOP LINES WILL BE PAID FOR IN SQUARE FEET USING THEIR SPECIFIC BID ITEMS.

TAPERING NOTES

ALL PAVEMENT MARKING APPROACH EDGES FROM THE VEHICLE DIRECTION OF TRAVEL SHALL BE TAPERED USING A PUTTY KNIFE OR SIMILAR TOOL.

Computer File Information		Sheet Revisions		Colorado Department of Transportation  4201 East Arkansas Avenue Denver, Colorado 80222 Phone: (303) 757-9543 Fax: (303) 757-9219 Safety & Traffic Engineering Branch KCM/SCL	PAVEMENT MARKINGS	STANDARD PLAN NO.
Creation Date: 07/04/12	Initials: SCL	Date:	Comments			S-627-1
Last Modification Date:	Initials:	(R-X)				Sheet No. 5 of 5
Full Path: www.coloradodot.info/library/traffic/traffic-s-standard-plans		(R-X)				
Drawing File Name: S-627-01_5of5.dgn		(R-X)				
CAD Ver.: MicroStation V8	Scale: Not to Scale	Units: English			Issued By: Safety & Traffic Engineering Branch July 4, 2012	

GENERAL NOTES									
<div>1. ALL CONSTRUCTION ZONE TRAFFIC CONTROL DEVICES, INCLUDING BUT NOT LIMITED TO BARRICADES, SIGNS, ARROW PANELS, FLASHING BEACON (PORTABLE), AND CHANNELIZING DEVICES, SHALL BE FURNISHED, INSTALLED, MAINTAINED (INCLUDING WASHING), REPLACED IF DAMAGED, REMOVED WHEN TEMPORARILY NOT IN USE AND RETURNED WHEN REQUIRED, RESET AS NECESSARY DURING THE PROGRESS OF CONSTRUCTION, AND REMOVED ENTIRELY WHEN THE PROJECT IS COMPLETED. ALL DEVICES SHALL MEET THE REQUIREMENTS OF THE LATEST EDITION OF THE ATSSA "QUALITY GUIDELINES FOR TEMPORARY TRAFFIC CONTROL DEVICES &amp; FEATURES".</div> <div>2. WORK ON THE PROJECT SHALL NOT BE STARTED UNTIL ALL REQUIRED TRAFFIC CONTROL DEVICES ARE IN PLACE, AND APPROVED BY THE ENGINEER.</div> <div>3. WHEN SPEED LIMIT REDUCTION IS REQUIRED, SUCH REDUCTION SHALL BE IN ACCORDANCE WITH CDOT FORM 568, "AUTHORIZATION AND DECLARATION OF TEMPORARY SPEED LIMITS."</div> <div>WHEN A CHANGE IN AN EXISTING SPEED LIMIT IS REQUIRED, THE R2-1 SIGNS, SHOWN ON THE SCHEDULE OF CONSTRUCTION TRAFFIC CONTROL DEVICES, SHOULD BE INSTALLED AT THE LOCATIONS SHOWN ON THE TYPICAL CASES BY R2-1 (OPTIONAL) SIGNS.</div> <div>AN ADVISORY SPEED PLATE (W13-1P) MAY BE USED WITH A WARNING SIGN WHEN THE MAXIMUM RECOMMENDED SPEED FOR CONDITION NAMED IS LOWER THAN THE POSTED SPEED LIMIT.</div> <div>THE REGULATORY OR ADVISORY SPEED REDUCTION DISPLAYED SHALL NOT EXCEED 15 MPH PER SIGN INSTALLATION.</div> <div>4. ANY TRAFFIC CONTROL DEVICE THAT IS DAMAGED, WEATHERED, WORN, OR OTHERWISE DEEMED UNACCEPTABLE BY THE ENGINEER, SHALL BE REPLACED.</div> <div>5. CONTRACTOR AND PERSONAL VEHICLE PARKING IS PROHIBITED WITHIN THE RIGHT-OF-WAY UNLESS DESIGNATED ON THE PLANS, OR APPROVED BY THE ENGINEER.</div> <div>6. CONSTRUCTION TRAFFIC SIGNS SHALL BE MEASURED BY THE FOLLOWING SIZES AND DESCRIPTIONS:</div> <div>PANEL SIZE A0.01 TO 9.00 SQ. FT. (INCLUDING TYPE 1 AND TYPE 2 BARRICADES).</div> <div>PANEL SIZE B9.01 TO 16.00 SQ. FT.</div> <div>PANEL SIZE CGREATER THAN 16 SQ. FT.</div> <div>CONSTRUCTION TRAFFIC SIGN (SPECIAL), SQ. FT., MAY BE USED FOR SOME PROJECT SPECIFIC INFORMATION SIGNS.</div> <div>FOR DETAILED DIMENSIONS OF SIGNS WITH SIGN CODE NUMBERS, SEE "STANDARD HIGHWAY SIGNS" AND THE "COLORADO SUPPLEMENT" THERETO. SIGN LAYOUTS FOR OTHER SIGNS WILL BE FURNISHED IN THE PLANS, TRANSMITTED TO THE ENGINEER AFTER AWARD, OR MAY BE AVAILABLE UPON REQUEST.</div> <div>W20-5 WARNING SIGNS SHALL BE FURNISHED WITH EXCHANGEABLE PLAQUES READING "RIGHT", "LEFT", "CENTER", "RIGHT 2", ETC. AT NO ADDITIONAL COST.</div>	<div>7. ALL WARNING AND REGULATORY SIGNS SHALL BE POSTED ON BOTH SIDES OF THE ROADWAY ON DIVIDED HIGHWAYS, MULTI-LANE RAMPS, ONE-WAY STREETS, AND AS DIRECTED BY THE ENGINEER, EXCEPT WHERE ONLY ONE SHOULDER IS CLOSED (EX: CASE 11 ON SHEET 7).</div> <div>8. ADDITIONAL TRAFFIC CONTROL DEVICES ADDRESSING FLAGGING, SPEED REDUCTION, ETC. WILL BE NECESSARY FOR SET-UP AND TAKE-DOWN OF MOST CASE APPLICATIONS; DAILY WORK SITE ACCESS; AND PAVEMENT MARKING REMOVAL AND INSTALLATION OPERATIONS.</div>	<div>9. BASED ON SIGHT DISTANCE AND OTHER CONSIDERATIONS, THE FINAL LOCATIONS OF SIGNS ARE SUBJECT TO APPROVAL OF THE ENGINEER.</div> <div>10. IF CONSTRUCTION RELATED TRAFFIC CONGESTION BACKS UP BEYOND THE INSTALLED ADVANCE SIGN SEQUENCE, ADDITIONAL ADVANCE SIGNING SHALL BE PLACED BEYOND THE CONGESTION.</div> <div>11. ALL SIGN MATERIAL SHALL BE SOUND AND DURABLE TO THE DEGREE NECESSARY FOR MAINTAINING EFFECTIVE AND NEAT APPEARING TRAFFIC CONTROLS, AND:</div> <div>a. SIGN PANELS MAY BE FABRICATED FROM PLYWOOD, STEEL, ALUMINUM, OR OTHER SUITABLE MATERIAL.</div> <div>b. REFLECTIVE SHEETING SHALL CONFORM TO ASTM D4956. THE TYPE SHALL BE AS DESCRIBED IN THE STANDARD SPECIFICATIONS AND/OR AS SHOWN ON THE PLANS.</div> <div>c. SYMBOLS AND LEGEND SHALL BE OF GOOD WORKMANSHIP (UNEVEN OR HAND LETTERING WILL NOT BE ACCEPTED).</div> <div>d. PORTABLE OR TEMPORARY MOUNTING SHALL NOT BE CONSTRUCTED OR WEIGHTED BY ANY METHOD OR MATERIAL THAT MAKES THEM HAZARDOUS TO TRAFFIC.</div> <div>e. CERTAIN POST SIZES AND SHAPES REQUIRE A "BREAK-AWAY" DEVICE. SEE THE APPLICABLE STANDARD PLAN. OTHER POST DESIGNS OR SYSTEMS REQUIRE THE SUBMITTAL OF AN FHWA LETTER OF ACCEPTANCE TO THE ENGINEER, AND MUST BE APPROVED BY THE ENGINEER PRIOR TO THEIR USE.</div> <div>12. ALL CONSTRUCTION SIGN PLACEMENT SHALL BE IN ACCORDANCE WITH STANDARD PLAN "TYPICAL GROUND SIGN PLACEMENT" UNLESS OTHERWISE APPROVED.</div> <div>SIGNS APPROVED TO BE MOUNTED ON PORTABLE SUPPORTS, OR APPROPRIATE SIGNS MOUNTED ON BARRICADES, MAY BE AT LOWER HEIGHTS, BUT THE BOTTOM OF THE SIGNS SHALL NOT BE LESS THAN ONE FOOT ABOVE THE PAVEMENT ELEVATION.</div> <div>13. SIGNS MOUNTED ON THE MEDIAN OF DIVIDED HIGHWAYS WHERE MEDIAN BARRIER IS IN PLACE MAY BE MOUNTED ON THE BARRIER WITH A SADDLE TYPE BRACKET. IF THE BRACKET ALLOWS THE SIGN PANEL TO BE TURNED PARALLEL TO THE ROADWAY, THE SIGN MAY REMAIN IN PLACE WHEN NOT APPLICABLE, BUT LAYING THE SIGN PANEL DOWN IN A HORIZONTAL POSITION IS NOT PERMITTED.</div> <div>14. TRAFFIC CONES SHALL BE AT LEAST 28 INCHES IN HEIGHT. HOWEVER, THE MINIMUM SIZE SHALL BE 36 INCHES WHEN THEY ARE USED ON FREEWAYS AND EXPRESSWAYS, OR DURING NIGHT TIME WORKING HOURS. THEY SHOULD ALSO BE 36 INCHES WHEN USED ON OTHER HIGH SPEED ROADWAYS (45 MPH OR MORE) WITH AN ADT OF 6,000 OR MORE.</div> <div>15. TYPE 1 BARRICADES SHALL NOT BE USED ON FREEWAYS, EXPRESSWAYS, OR OTHER HIGH SPEED ROADWAYS (55 MPH OR MORE).</div> <div>16. WHEN TWO-WAY TRAFFIC IS PLACED ON ONE ROADWAY OF A NORMALLY DIVIDED HIGHWAY, OPPOSING TRAFFIC SHALL BE SEPARATED EITHER WITH CONCRETE BARRIER (TEMPORARY), OR WITH CHANNELIZING DEVICES APPROVED FOR THIS APPLICATION, THROUGHOUT THE LENGTH OF TWO-WAY OPERATION. THE TRANSITION ZONES SHALL HAVE CONCRETE BARRIER (TEMPORARY). THE BARRIER SHALL BE TIED TO AN EXISTING STRUCTURE OR GUARD RAIL, FLARED OR EXTENDED, TO MEET CLEAR ZONE REQUIREMENTS, OR FITTED WITH AN IMPACT ATTENUATION DEVICE.</div> <div>17. CHANNELIZING DEVICE SPACING, IN FEET, SHALL BE AS FOLLOWS:</div> <div>a. FOR TAPERS AND TRANSITIONS, SPACING EQUALS THE NUMERICAL VALUE OF THE SPEED LIMIT. (e.g. 45 MPH = 45 FEET)</div> <div>b. FOR TANGENTS ALONG THE BUFFER SPACE OR WORK AREA, SPACING MAY NOT BE GREATER THAN TWO TIMES THE SPEED LIMIT. (e.g. 50 MPH = 50 FEET TO 100 FEET MAXIMUM)</div>	<div>18. FOR DETAILS ON BARRICADES, CONCRETE BARRIER (TEMPORARY), VERTICAL PANELS, AND FLASHING BEACON (PORTABLE), SEE THE APPLICABLE STANDARD PLANS.</div> <div>19. FLOOD LIGHTS SHALL BE USED TO ILLUMINATE FLAGGER STATIONS DURING THE HOURS OF DARKNESS UNLESS OTHERWISE APPROVED. A TYPICAL LIGHT SHOULD PROVIDE THE FOLLOWING: A FULLY DIRECTIONAL SWIVEL MOUNT QUARTZ LIGHT SOURCE (500 WATT MINIMUM), SELF-SUPPORTING STAND WITH VARIABLE LIGHT HEIGHT FROM A MINIMUM OF EIGHT FEET ABOVE THE ROADWAY, AND A POWER SOURCE. IT SHALL ILLUMINATE THE STATION AREA AND A FLAGGER ESCAPE PATH, BUT SHALL NOT PRESENT ANY GLARE TO TRAFFIC.</div> <div>20. IF WORK ON THE ROADWAY IS FOR A LONG-TERM STATIONARY PERIOD, AS DEFINED IN SECTION 6G.02 OF THE MUTCD, INAPPLICABLE PAVEMENT MARKINGS ARE TO BE REMOVED, AND FULL COMPLIANCE PAVEMENT MARKINGS ARE TO BE INSTALLED IN ACCORDANCE WITH THE APPLICABLE SPECIFICATIONS, (PAVEMENT MARKING - GENERAL), AND/OR AS DETAILED ON THE PLANS.</div> <div>FOR ADDITIONAL PAVEMENT MARKING DETAILS, SEE STANDARD PLAN "TYPICAL PAVEMENT MARKINGS".</div> <div>21. BUFFER SPACE IS OPTIONAL. NEED MUST BE DETERMINED ON A PROJECT OR SITE SPECIFIC BASIS AS DIRECTED BY THE ENGINEER. WHEN A BUFFER SPACE IS USED, DIMENSIONS AND/OR DEVICES USED ARE TO BE INCORPORATED IN THE TRAFFIC CONTROL PLAN (TCP) OR THE CONTRACTOR'S METHOD OF HANDLING TRAFFIC (MHT).</div> <div>22. ADDITIONAL VMS SIGNAGE SHOULD BE CONSIDERED AT LEAST A MILE IN ADVANCE OF THE SIGNING SHOWN IN THE DETAIL FOR ANY LANE CLOSURES ON INTERSTATE AND OTHER HIGH SPEED FACILITIES ESPECIALLY WHEN THE LEVEL OF SERVICE IS SIGNIFICANTLY REDUCED AS A RESULT OF CONSTRUCTION. THE LEGENDS SHOULD BE CHANGED TO ADVISE MOTORISTS OF UPCOMING TRAFFIC CONDITIONS AND TO ALERT THEM OF UPCOMING LANE USAGE.</div> <div>ADDITIONAL ADVANCE WARNING SIGNAGE IS ENCOURAGED IN ALL CASES WHERE TRAFFIC VOLUMES AND SPEEDS ARE HIGH AND/OR WHERE THERE ARE INFREQUENT EXITS. ADDITIONAL SIGNAGE IS ALSO ENCOURAGED IN LOCATIONS WHERE DRIVERS' LINE OF SIGHT TO ADVANCE WARNING SIGNS IS OBSTRUCTED.</div> <div>23. WHEN ARROW BOARDS ARE USED TO CLOSE MULTIPLE LANES, A SEPARATE ARROW BOARD SHALL BE USED FOR EACH CLOSED LANE.</div> <div>IF ARROW BOARDS ARE USED FOR SHOULDER WORK, BLOCKING THE SHOULDER, FOR ROADSIDE WORK NEAR THE SHOULDER, OR FOR TEMPORARILY CLOSING ONE LANE ON A TWO-LANE, TWO-WAY ROADWAY, USE THE ARROW BOARDS ONLY IN THE CAUTION MODE.</div> <div>24. RAISED PAVEMENT MARKERS MAY BE USED TO SUPPLEMENT TEMPORARY STRIPING DURING NON-SNOW PERIODS. THEIR USE IS ENCOURAGED ON HIGHER SPEED FACILITIES WHEN TRAFFIC IS BEING DIVERTED FROM ITS USUAL COURSE.</div> <div>25. THE TYPICAL CASES DEPICTED IN THIS STANDARD REFLECT THE MINIMUM REQUIREMENTS, UNLESS AS OTHERWISE DIRECTED BY THE PROJECT PLANS AND SPECIFICATIONS, AND/OR THE PROJECT ENGINEER.</div> <div>26. A SIGNIFICANT PROJECT IS DEFINED AS ONE THAT, ALONE OR IN COMBINATION WITH OTHER CONCURRENT PROJECTS NEARBY, IS ANTICIPATED TO CAUSE SUSTAINED WORK ZONE IMPACTS AT A LOCATION FOR THREE OR MORE CONSECUTIVE DAYS WITH EITHER INTERMITTENT OR CONTINUOUS LANE CLOSURES.</div>	<div>Computer File Information</div> <div>Creation Date: 07/04/12Initials: KEN</div> <div>Last Modification Date: 02/26/13Initials: KEN</div> <div>Full Path: www.coloradodot.info/library/traffic/traffic-s-standard-plans</div> <div>Drawing File Name: S-630-01_1of20.dgn</div> <div>CAD Ver.: MicroStation V8Scale: Not to ScaleUnits: English</div>	<div><div><div><div></div><div></div></div><div><div></div><div></div></div></div><div>DOT</div><div>DEPARTMENT OF TRANSPORTATION</div></div> <div>Safety &amp; Traffic Engineering BranchKCM/KEN</div>	<div>TRAFFIC CONTROLS FOR HIGHWAY CONSTRUCTION</div> <div>Issued By: Safety &amp; Traffic Engineering Branch July 4, 2012</div>	STANDARD PLAN NO.		
							S-630-1		
							Sheet No. 1 of 20		




INDEX TO TYPICAL WORK ZONE CASES

TYPICAL CASE DESCRIPTION	CASE NO.	SHEET NO.
CLOSURE OF ONE ROADWAY, 4-LANE HIGHWAY	1	3
CLOSURE OF HALF OF 4-LANE UNDIVIDED HIGHWAY	2	4
ROAD CLOSURE, USE OF ADJACENT SHOULDERS	3	
ROAD CLOSURE, BYPASS DETOUR PROVIDED	4	5
LANE #1 CLOSURE, MULTI-LANE FREEWAY	5	
LANE #2 CLOSURE, MULTI-LANE FREEWAY	6	6
LANE #3 CLOSURE, MULTI-LANE FREEWAY	7	
LANE #4 CLOSURE, MULTI-LANE FREEWAY	8	
CENTER LANE CLOSURE - MULTI-LANE FREEWAY	9	7
ONE LANE CLOSE - 4-LANE DIVIDED HIGHWAY	10	
SHOULDER WORK - FREEWAY/EXPRESSWAY	11	
TRAFFIC CONTROL ON FREEWAY NEAR AN OFF-RAMP	12	8
TRAFFIC CONTROL ON FREEWAY BEFORE AN ON-RAMP	13	
TRAFFIC CONTROL ON FREEWAY ALLOWING ACCESS FROM ON-RAMP	14	
BLASTING ZONE	15	9
RAMP CONSTRUCTION WHERE PARTIAL RAMP IS CLOSED	16	
LANE CLOSURE, 2-LANE HIGHWAY, AT CURVE	17	
TRAFFIC CONTROL AROUND A WORK AREA NEAR AN INTERSECTION, ONE LANE CLOSED	18	10
TRAFFIC CONTROL AROUND A WORK AREA NEAR AN INTERSECTION	19	
TYPICAL SIGNING FOR ROAD CLOSURE	20	
FULL CLOSURE, MULTI-LANE FREEWAY	21	11
CONTINUOUS LANE RAMP CLOSURE, MULTI-LANE FREEWAY	22	
SIMPLE RAMP CLOSURE, MULTI-LANE FREEWAY	23	
"FINES DOUBLE IN WORK ZONE" SIGNING (WITH SPEED REDUCTION)	24	12
SHIFTING OF ONE ROADWAY ON 4-LANE DIVIDED HIGHWAY	25	13
SHOULDER WORK - FREEWAY/EXPRESSWAY w/ 65 MPH SPEED LIMIT	26	14
SHOULDER WORK - FREEWAY/EXPRESSWAY w/ 75 MPH SPEED LIMIT	27	
ROCK SCALING - ROAD CLOSURE, 4-LANE DIVIDED HIGHWAY	28	15

TYPICAL CASE DESCRIPTION	CASE NO.	SHEET NO.
LATE MERGING - ONE LANE CLOSED, 4-LANE DIVIDED HIGHWAY	29	16
MOBILE PAVEMENT MARKING ZONE, MOBILE SHOULDER CLOSURE ON 2-LANE UNDIVIDED HIGHWAY	30	17
MOBILE PAVEMENT MARKING ZONE, CENTERLINE STRIPING ON 2-LANE UNDIVIDED HIGHWAY	31	
MOBILE PAVEMENT MARKING ZONE, LANE LINE STRIPING - CENTER LANE OPERATIONS ON MULTI-LANE DIVIDED HIGHWAY	32	18
MOBILE PAVEMENT MARKING ZONE, MOBILE RAMP CLOSURE - EXPRESSWAY/FREEWAY	33	
MOBILE OPERATION OF LANE CLOSURE OF MULTI-LANE HIGHWAY (NOT FOR USE ON FREEWAYS)	34	19
MOBILE OPERATION OF LANE CLOSURE OF MULTI-LANE HIGHWAY	35	

Computer File Information		Sheet Revisions		<div>Colorado Department of Transportation</div> <div>4201 East Arkansas Avenue Denver, Colorado 80222 Phone: (303) 757-9543 Fax: (303) 757-9219</div> <div>Safety &amp; Traffic Engineering Branch      KCM/KEN</div>	TRAFFIC CONTROLS FOR HIGHWAY CONSTRUCTION	STANDARD PLAN NO.
Creation Date: 07/04/12	Initials: KEN					S-630-1
Last Modification Date:	Initials:					Sheet No. 2 of 20
Full Path: www.coloradodot.info/library/traffic/traffic-s-standard-plans						
Drawing File Name: S-630-01_2of20.dgn					Issued By: Safety & Traffic Engineering Branch July 4, 2012	
CAD Ver.: MicroStation V8    Scale: Not to Scale    Units: English						

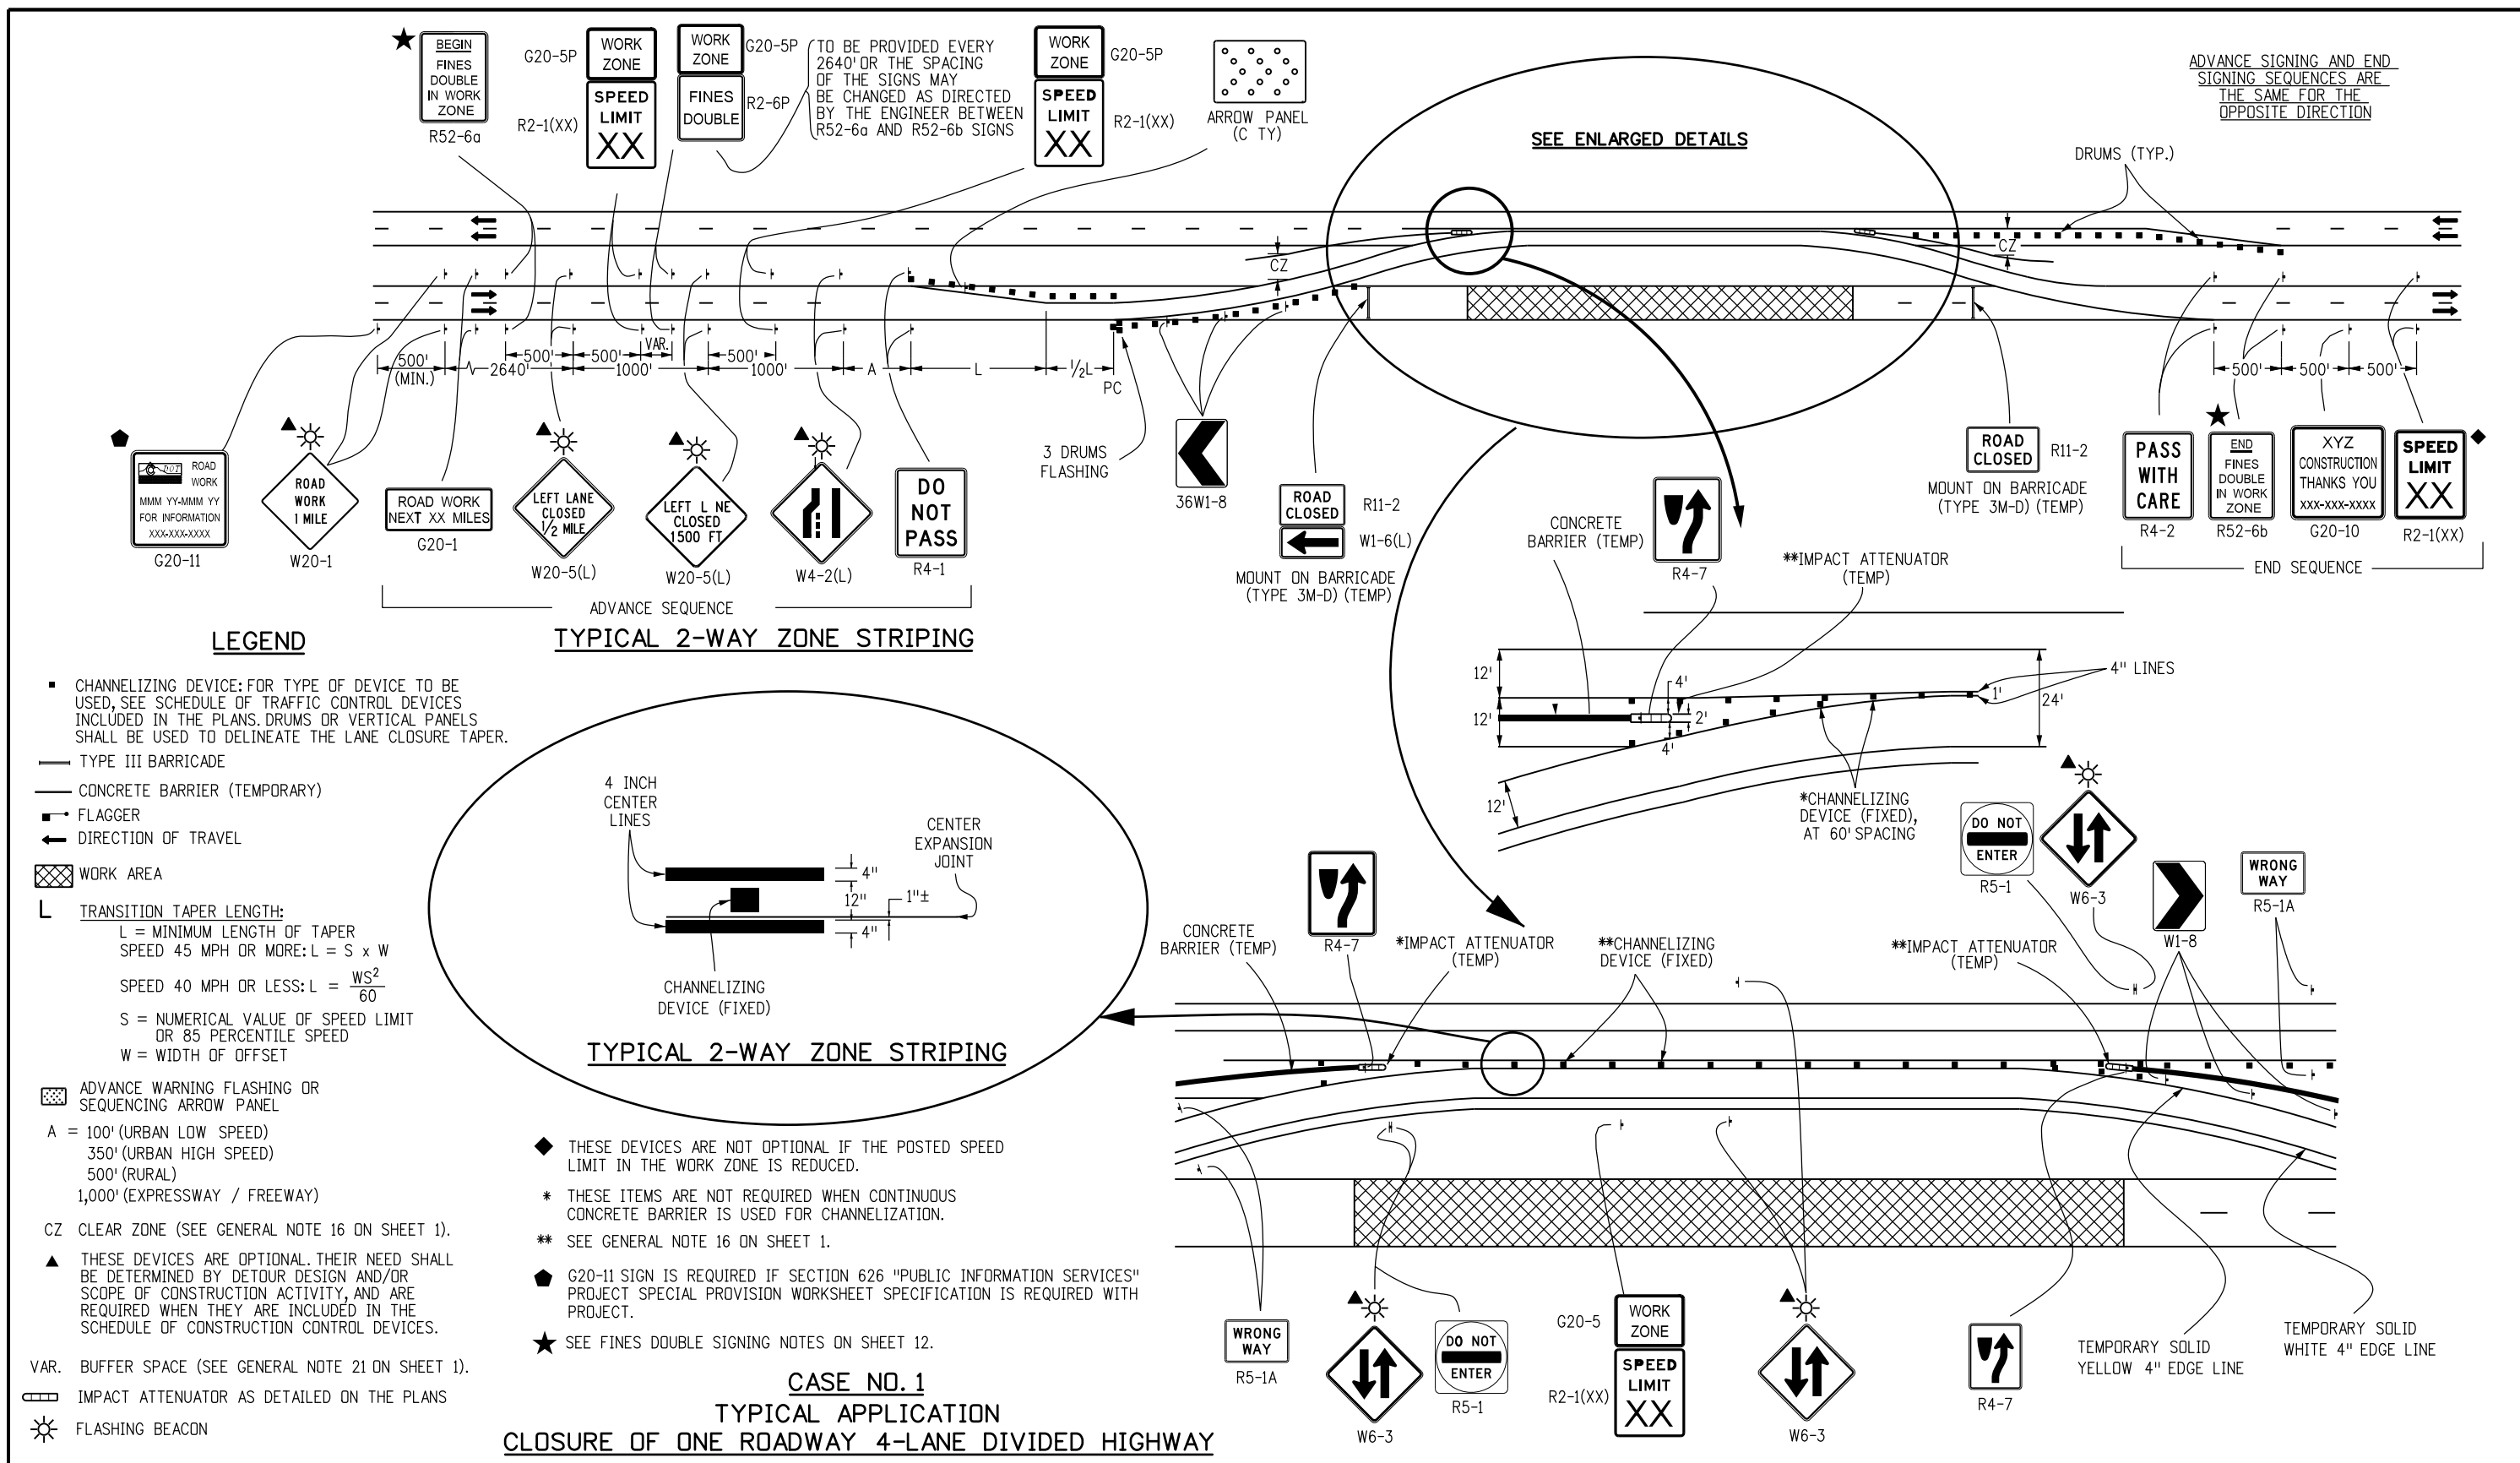


Computer File Information		Sheet Revisions		<div> <div> </div> <div> <b>Colorado Department of Transportation</b>  4201 East Arkansas Avenue  Denver, Colorado 80222  Phone: (303) 757-9543  Fax: (303) 757-9219  <b>Safety &amp; Traffic Engineering Branch</b> </div> <div> <b>KCM/RRR</b> </div> </div>	<b>TRAFFIC CONTROLS FOR HIGHWAY CONSTRUCTION</b>  Issued By: Safety & Traffic Engineering Branch July 4, 2012	STANDARD PLAN NO.
Creation Date: 07/04/12	Initials: RRR	Date:	Comments:			S-630-1
Last Modification Date:	Initials:	(R-X)				
Full Path: www.coloradodot.info/library/traffic/traffic-s-standard-plans		(R-X)				
Drawing File Name: S-630-01_3of20.dgn		(R-X)				
CAD Ver.: MicroStation V8	Scale: Not to Scale	Units: English				Sheet No. 3 of 20












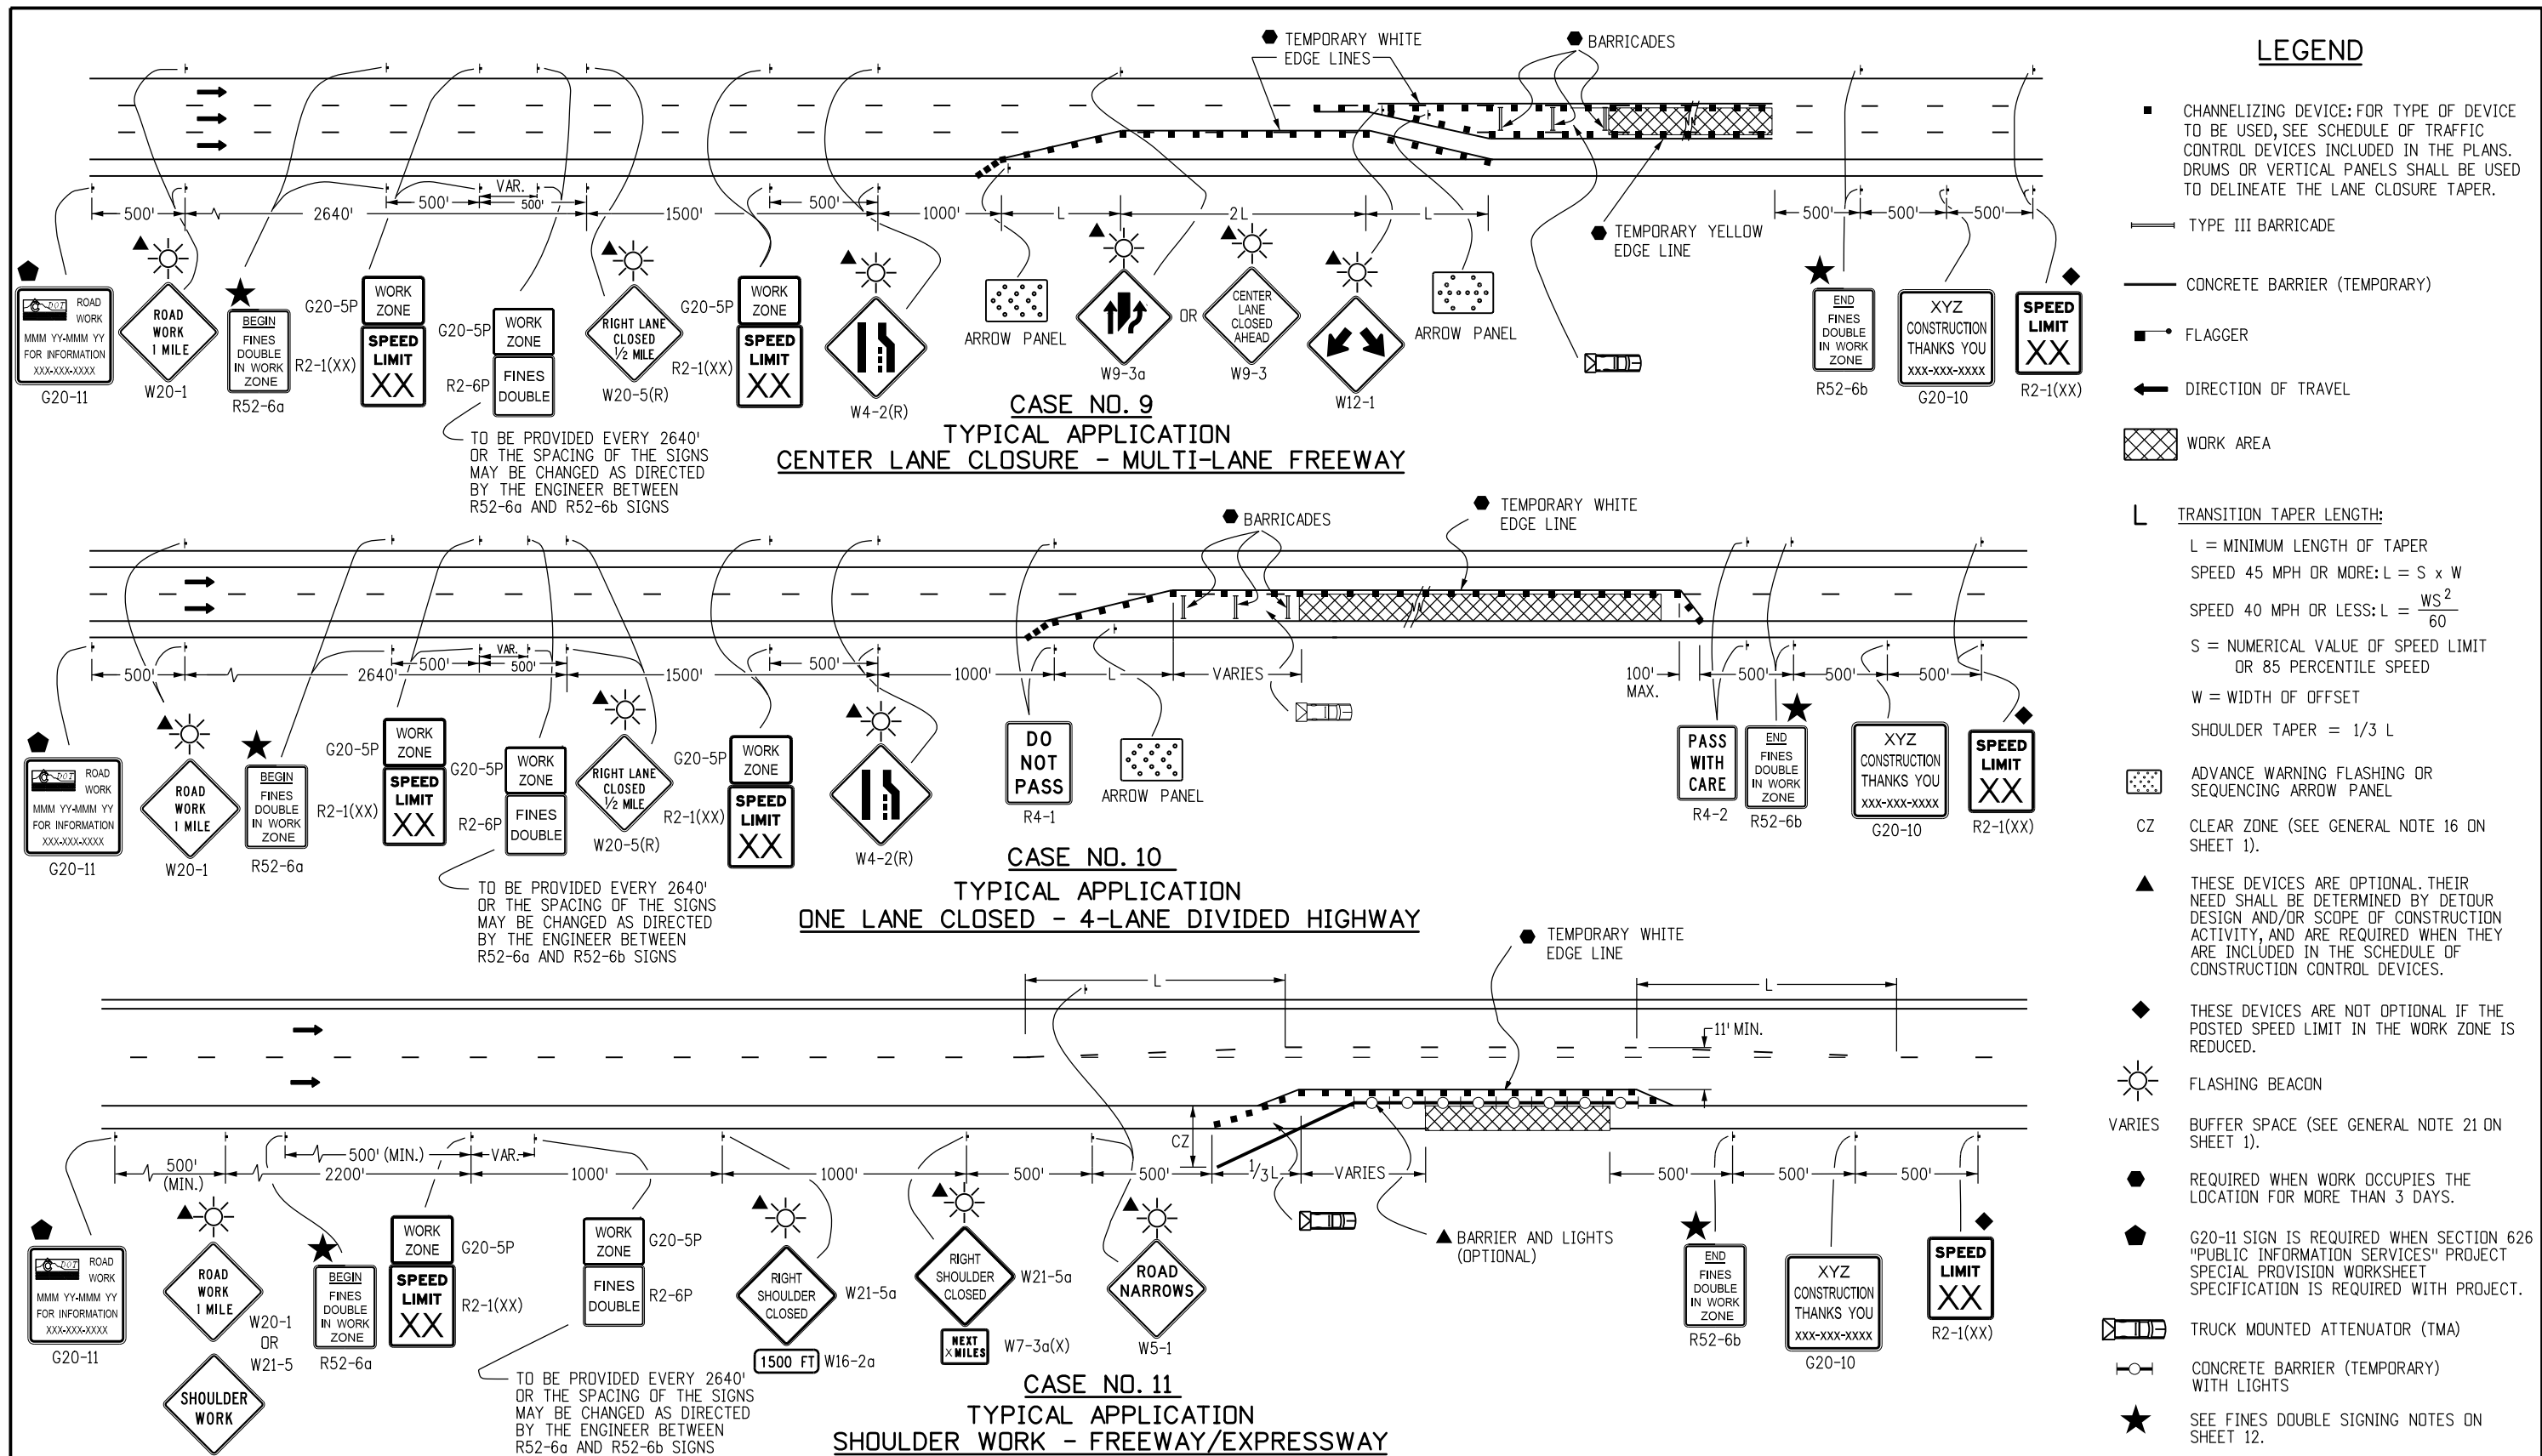


Computer File Information			Sheet Revisions		Colorado Department of Transportation  4201 East Arkansas Avenue Denver, Colorado 80222 Phone: (303) 757-9543 Fax: (303) 757-9219 Safety & Traffic Engineering Branch KCM/RRR	TRAFFIC CONTROLS FOR HIGHWAY CONSTRUCTION Issued By: Safety & Traffic Engineering Branch July 4, 2012	STANDARD PLAN NO.
Creation Date: 07/04/12	Initials: RRR		Date:	Comments			S-630-1
Last Modification Date:	Initials:	<div>R-X</div>					
Full Path: www.coloradodot.info/library/traffic/traffic-s-standard-plans		<div>R-X</div>					
Drawing File Name: S-630-01_7of20.dgn		<div>R-X</div>					
CAD Ver.: MicroStation V8	Scale: Not to Scale	Units: English	<div>R-X</div>				Sheet No. 7 of 20



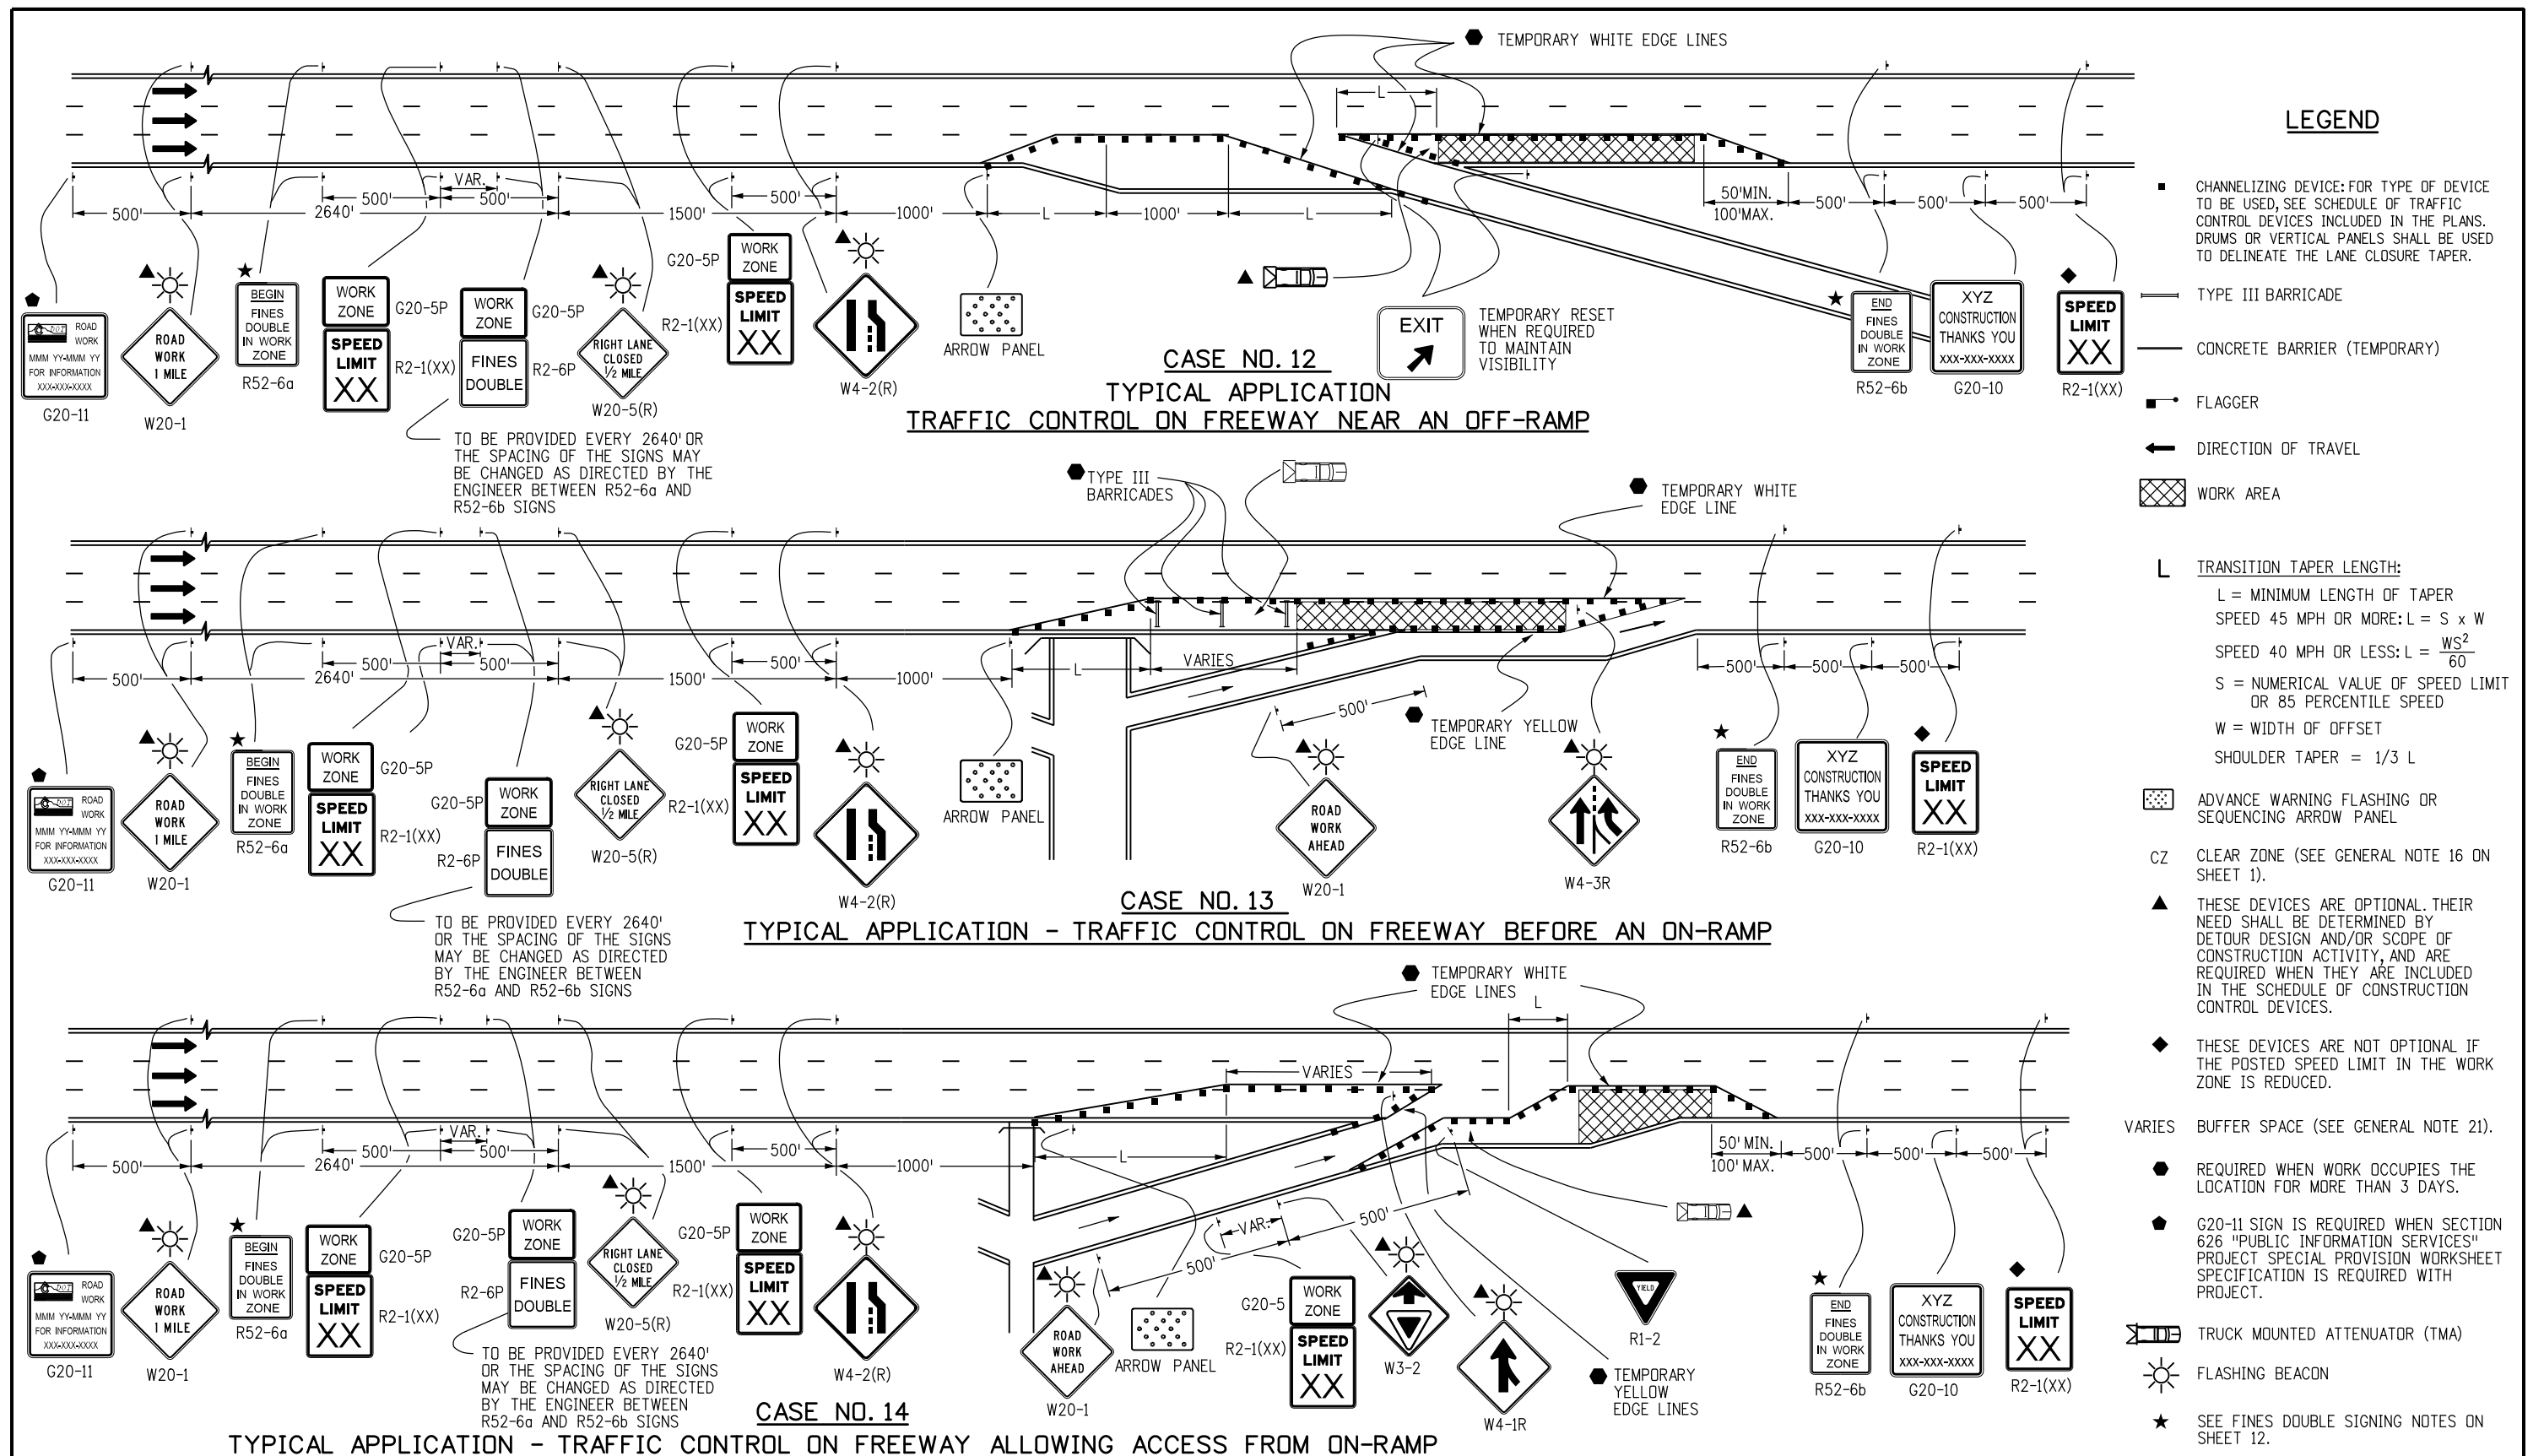

Computer File Information		Sheet Revisions		Colorado Department of Transportation  4201 East Arkansas Avenue Denver, Colorado 80222 Phone: (303) 757-9543 Fax: (303) 757-9219 Safety & Traffic Engineering Branch KCM/RRR	TRAFFIC CONTROLS FOR HIGHWAY CONSTRUCTION Issued By: Safety & Traffic Engineering Branch July 4, 2012	STANDARD PLAN NO.
Creation Date: 07/04/12	Initials: RRR	Date:	Comments:			S-630-1
Last Modification Date:	Initials:					
Full Path: www.coloradodot.info/library/traffic/traffic-s-standard-plans						
Drawing File Name: S-630-01_8of20.dgn						
CAD Ver.: MicroStation V8	Scale: Not to Scale	Units: English				Sheet No. 8 of 20

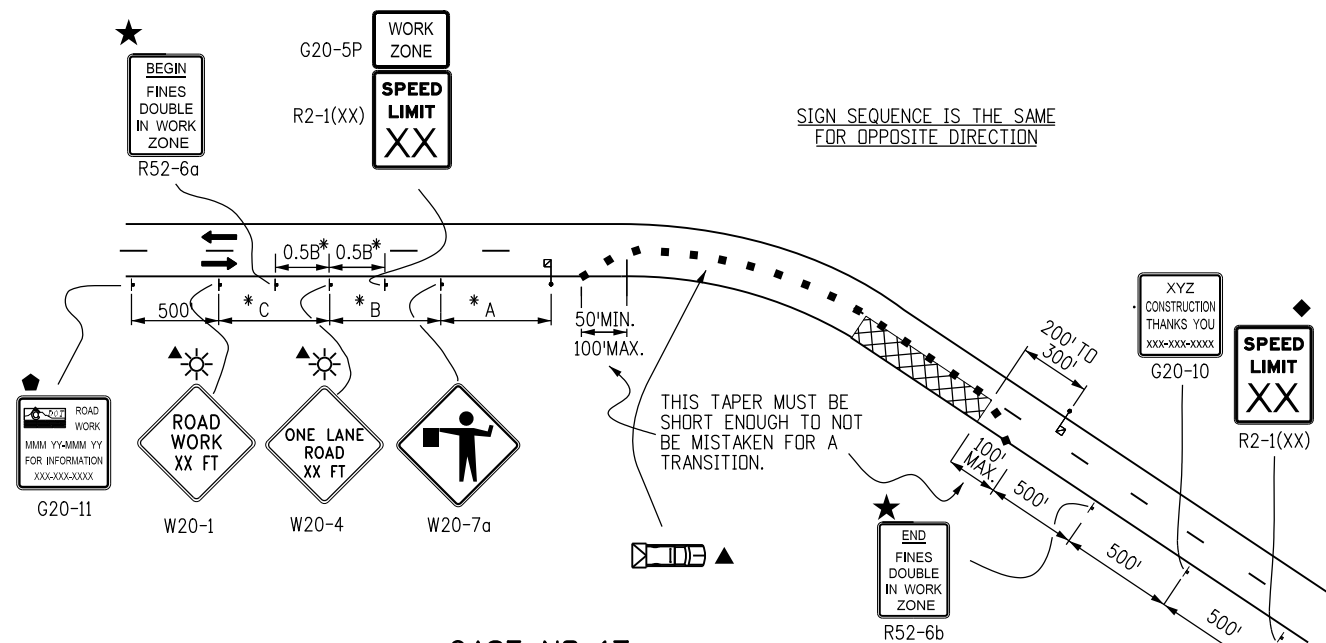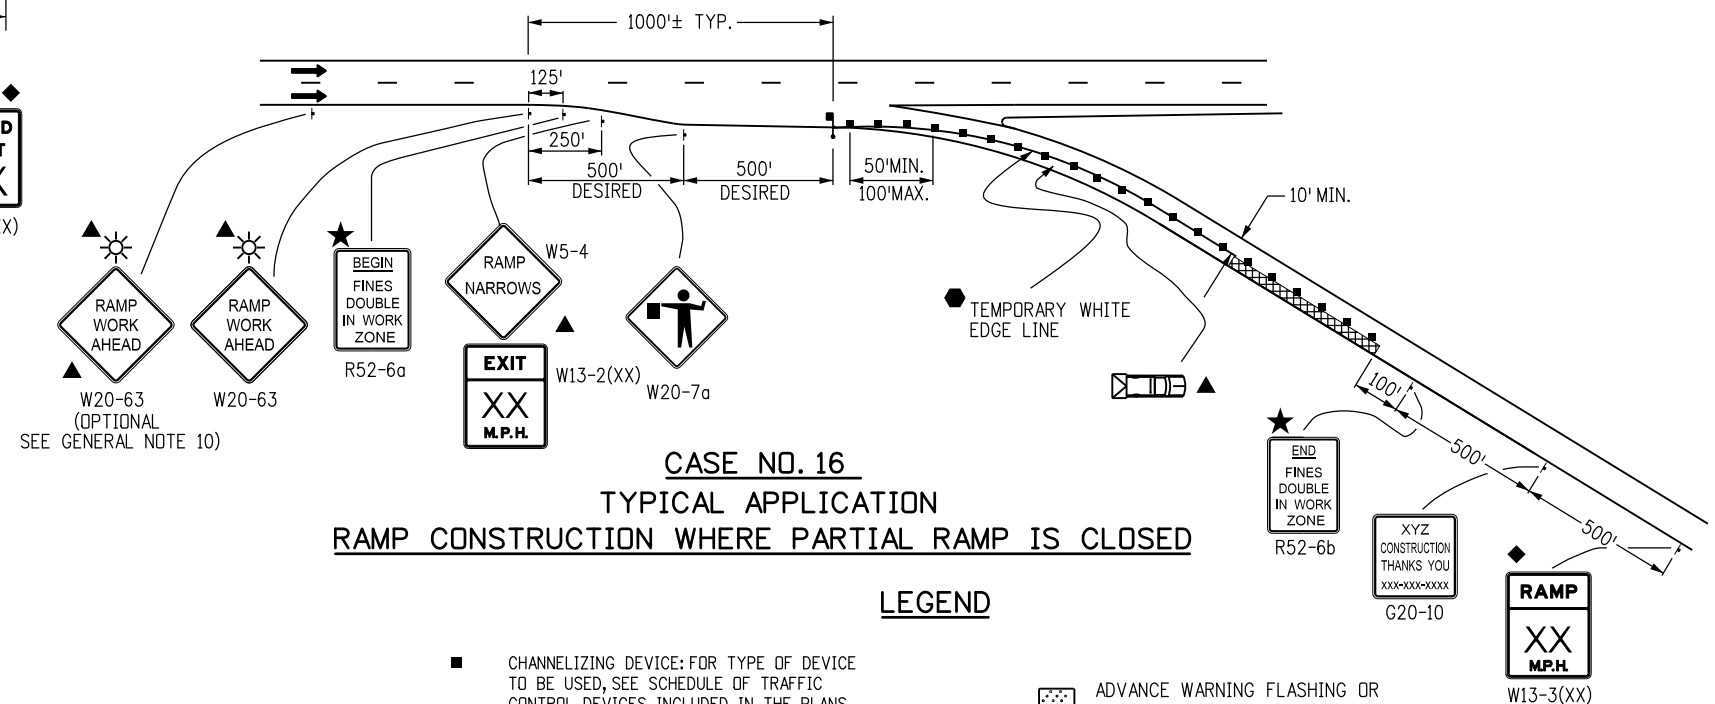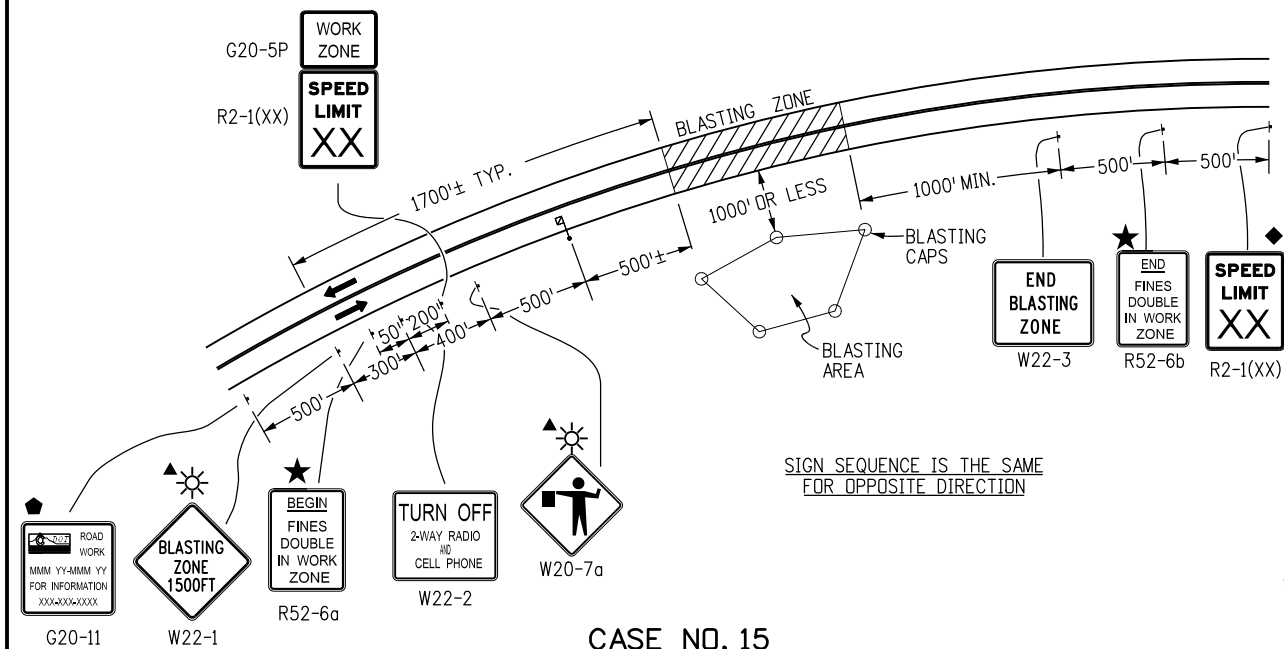

- CHANNELIZING DEVICE: FOR TYPE OF DEVICE TO BE USED, SEE SCHEDULE OF TRAFFIC CONTROL DEVICES INCLUDED IN THE PLANS. DRUMS OR VERTICAL PANELS SHALL BE USED TO DELINEATE THE LANE CLOSURE TAPER.
  - ══ TYPE III BARRICADE
  - CONCRETE BARRIER (TEMPORARY)
  - FLAGGER
  - ← DIRECTION OF TRAVEL
  - ▨ WORK AREA
  - L TRANSITION TAPER LENGTH:
    - L = MINIMUM LENGTH OF TAPER
    - SPEED 45 MPH OR MORE:  $L = S \times W$
    - SPEED 40 MPH OR LESS:  $L = \frac{WS^2}{60}$
    - S = NUMERICAL VALUE OF SPEED LIMIT OR 85 PERCENTILE SPEED
    - W = WIDTH OF OFFSET
    - SHOULDER TAPER =  $1/3 L$
  - ▩ TRUCK MOUNTED ATTENUATOR (TMA)
  - ★ SEE FINES DOUBLE SIGNING NOTES ON SHEET 12
  - ▩ ADVANCE WARNING FLASHING OR SEQUENCING ARROW PANEL
  - CZ CLEAR ZONE (SEE GENERAL NOTE 16 ON SHEET 1).
  - ▲ THESE DEVICES ARE OPTIONAL. THEIR NEED SHALL BE DETERMINED BY DETOUR DESIGN AND/OR SCOPE OF CONSTRUCTION ACTIVITY, AND ARE REQUIRED WHEN THEY ARE INCLUDED IN THE SCHEDULE OF CONSTRUCTION CONTROL DEVICES.
  - ◆ THESE DEVICES ARE NOT OPTIONAL IF THE POSTED SPEED LIMIT IN THE WORK ZONE IS REDUCED.
  - ☀ FLASHING BEACON
  - REQUIRED WHEN WORK OCCUPIES THE LOCATION FOR MORE THAN 3 DAYS.
  - ◆ G20-11 SIGN IS REQUIRED WHEN SECTION 626 "PUBLIC INFORMATION SERVICES" PROJECT SPECIAL PROVISION WORKSHEET SPECIFICATION IS REQUIRED WITH PROJECT.

\*KEY TO ADVANCE SIGNING DISTANCES

ROAD TYPE	DISTANCE BETWEEN SIGNS		
	A	B	C
URBAN ( $\leq 40$ MPH)	100	100	100
URBAN ( $> 45$ MPH)	350	350	350
RURAL	500	500	500
EXPRESSWAY/FREEWAY	1000	1500	2640

Computer File Information		
Creation Date: 07/04/12	Initials: RRR	
Last Modification Date:	Initials:	
Full Path: <a href="http://www.coloradodot.info/library/traffic/traffic-s-standard-plans">www.coloradodot.info/library/traffic/traffic-s-standard-plans</a>		
Drawing File Name: S-630-01_9of20.dgn		
CAD Ver.: MicroStation V8	Scale: Not to Scale	Units: English


Sheet Revisions	
Date:	Comments
R-X	
R-X	
R-X	
R-X	

**Colorado Department of Transportation**  
 4201 East Arkansas Avenue  
 Denver, Colorado 80222  
 Phone: (303) 757-9543  
 Fax: (303) 757-9219  
**Safety & Traffic Engineering Branch** **KCM/RRR**

# TRAFFIC CONTROLS FOR HIGHWAY CONSTRUCTION

Issued By: Safety & Traffic Engineering Branch July 4, 2012


STANDARD PLAN NO.
S-630-1
Sheet No. 9 of 20

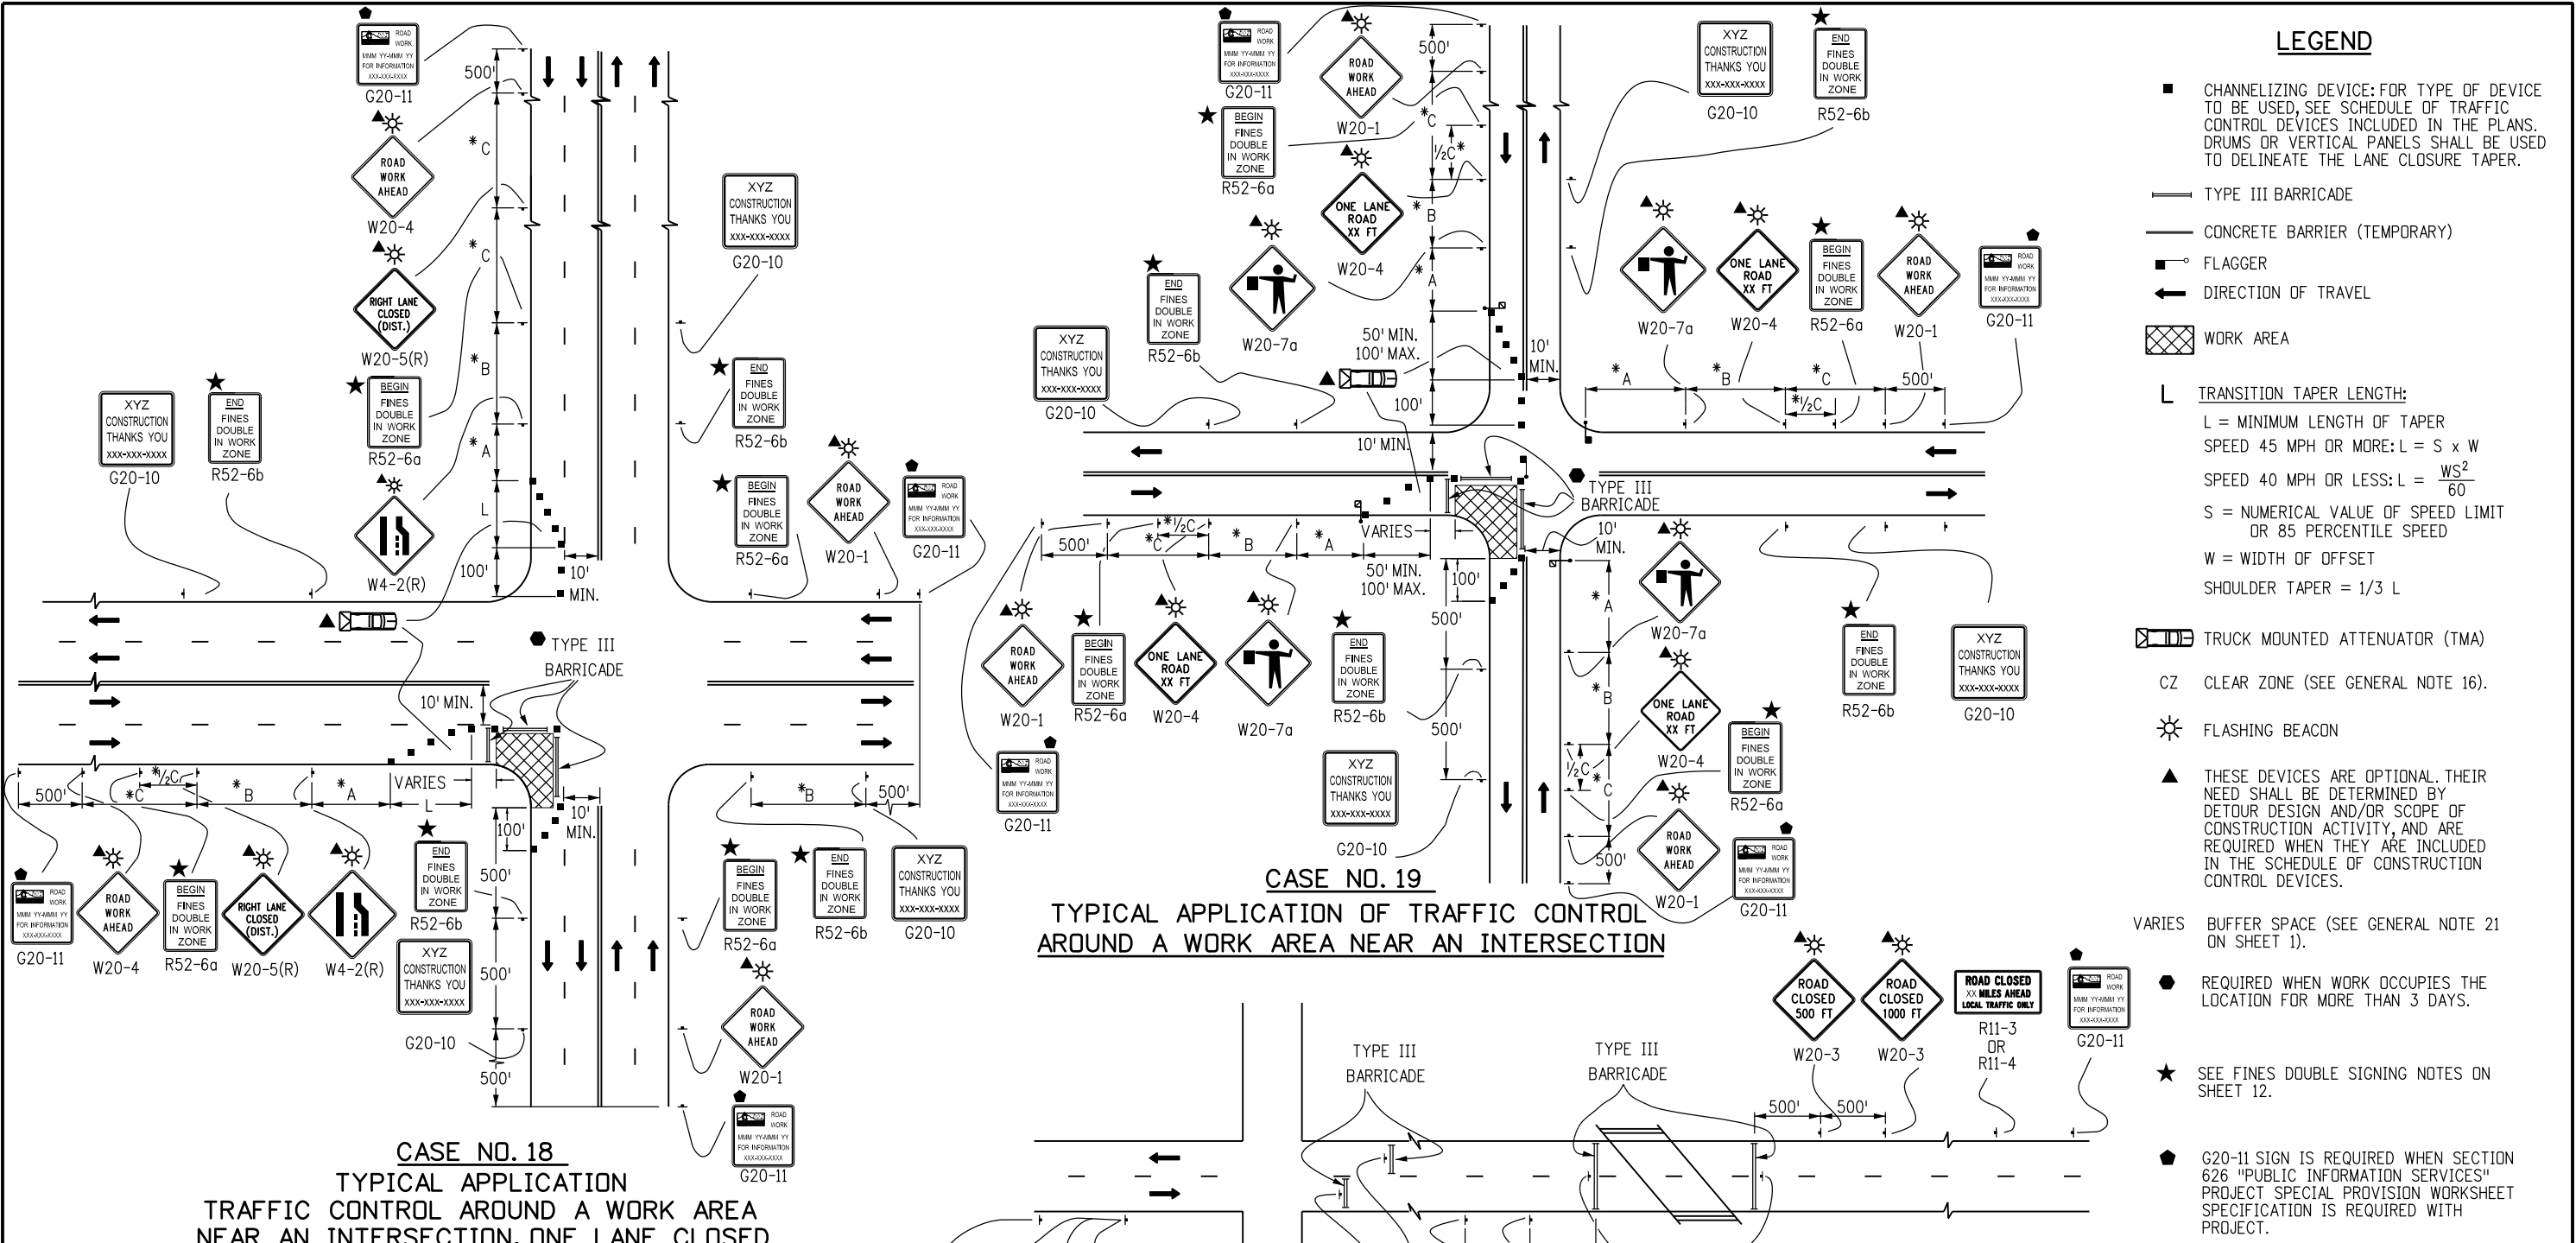

Computer File Information	
Creation Date: 07/04/12	Initials: RRR
Last Modification Date:	Initials:
Full Path: www.coloradodot.info/library/traffic/traffic-s-standard-plans	
Drawing File Name: S-630-01.10of20.dgn	
CAD Ver.: MicroStation V8 Scale: Not to Scale Units: English	

Sheet Revisions	
Date:	Comments
(R-X)	
(R-X)	
(R-X)	
(R-X)	

Colorado Department of Transportation



4201 East Arkansas Avenue  
Denver, Colorado 80222  
Phone: (303) 757-9543  
Fax: (303) 757-9219

Safety & Traffic Engineering Branch

KCM/RRR

TRAFFIC CONTROLS  
FOR HIGHWAY  
CONSTRUCTION

Issued By: Safety & Traffic Engineering Branch July 4, 2012


STANDARD PLAN NO.

S-630-1

Sheet No. 10 of 20





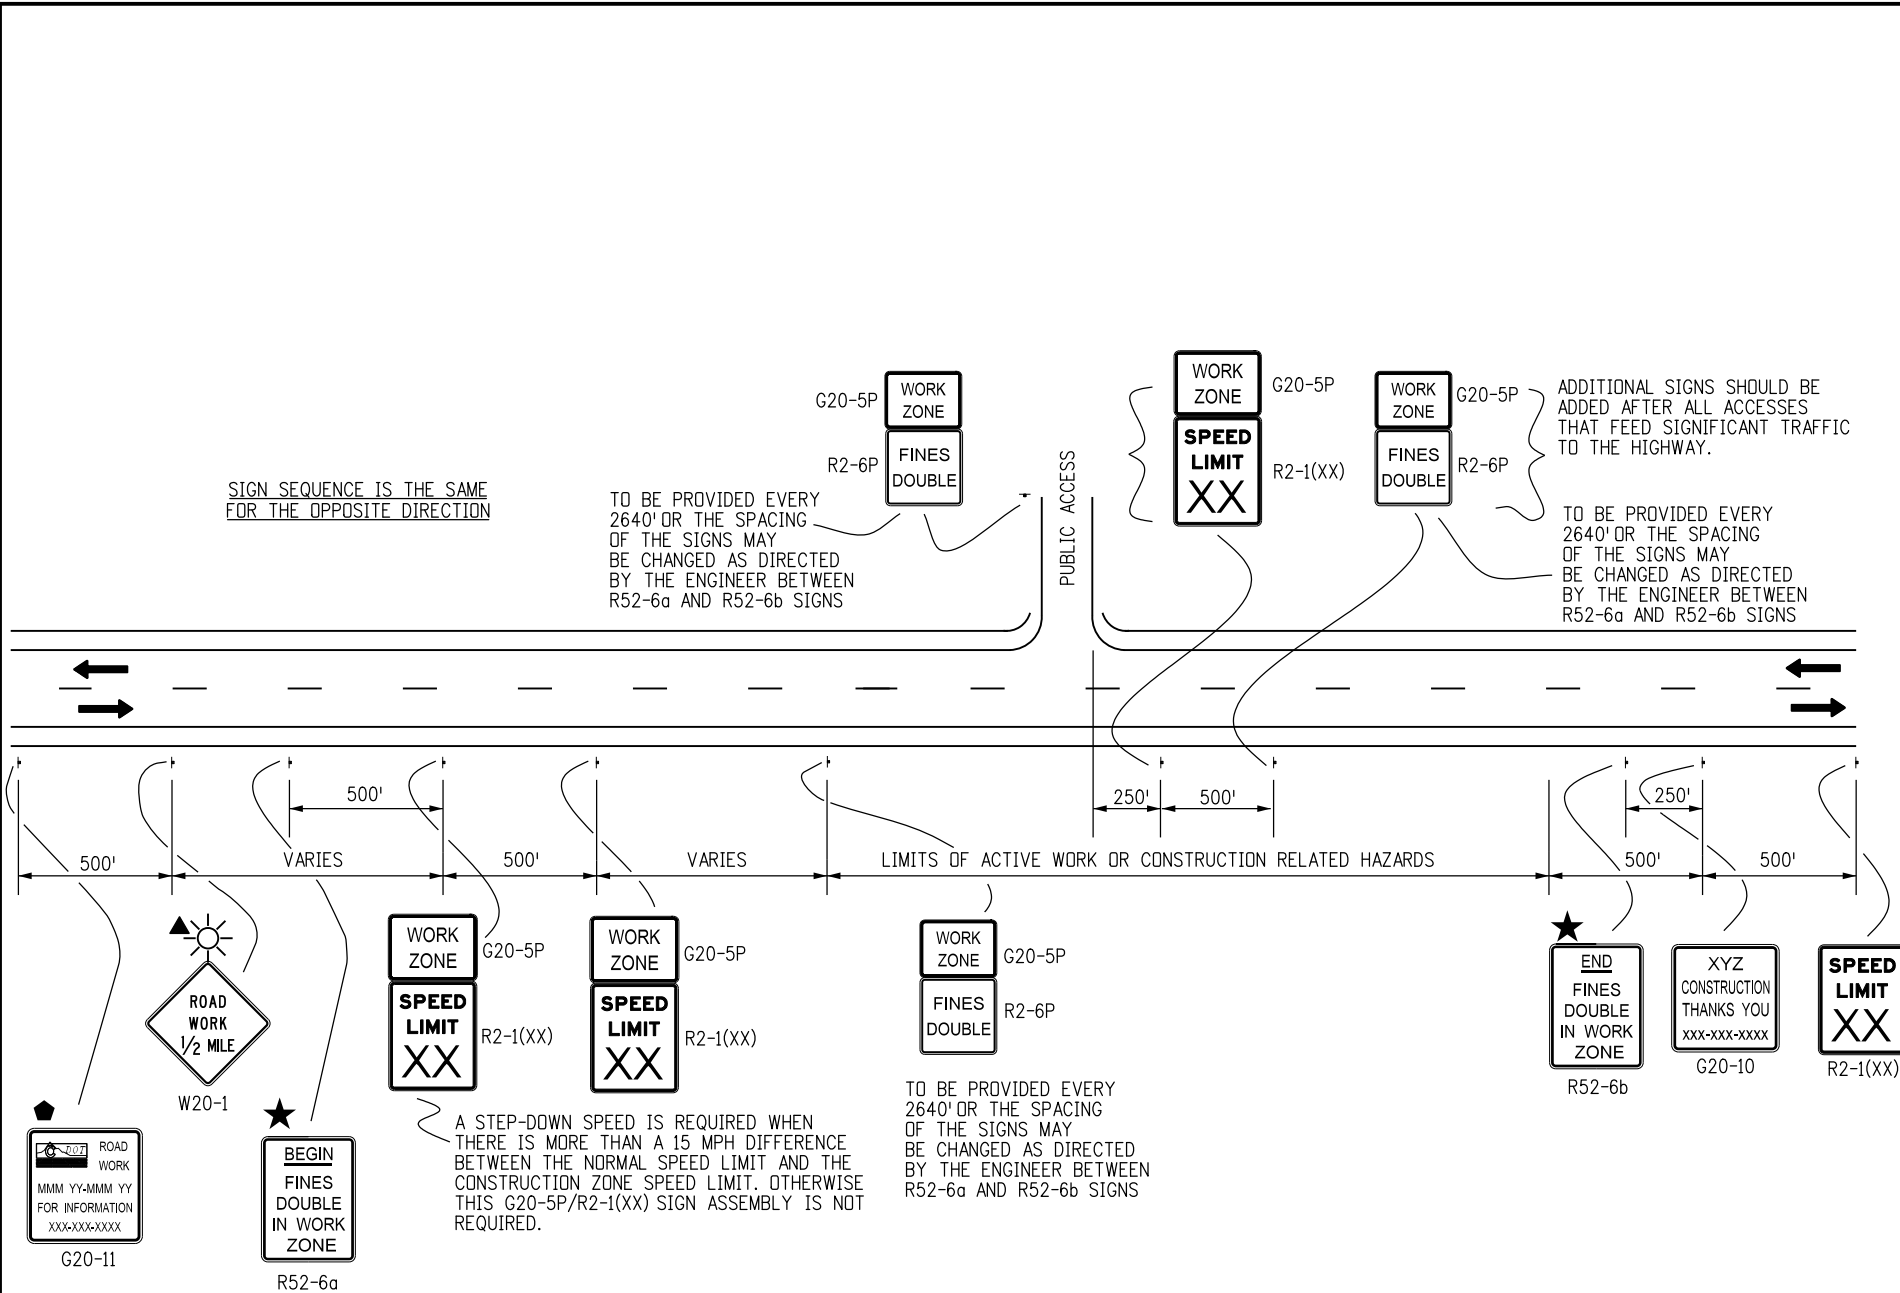

LEGEND

- ← DIRECTION OF TRAVEL
- ▲ THESE DEVICES ARE OPTIONAL. THEIR NEED WILL BE DETERMINED BY THE DESIGNER BASED ON DETOUR DESIGN AND/OR SCOPE OF THE CONSTRUCTION ACTIVITY, AND ARE REQUIRED WHEN THEY ARE INCLUDED IN THE PLANS.
- ◆ G20-11 SIGN IS REQUIRED WHEN SECTION 626 "PUBLIC INFORMATION SERVICES" PROJECT SPECIAL PROVISION WORKSHEET SPECIFICATION IS REQUIRED WITH PROJECT.
- ☀ FLASHING BEACON
- ★ FINES DOUBLE SIGNING NOTES, SEE BELOW

FINES DOUBLE SIGNING NOTES:

- SIGNS SHALL NOT BE PLACED SOONER THAN FOUR HOURS BEFORE WORK IS TO BEGIN AND SHALL BE REMOVED AS SOON AS WORK ACTIVITIES ARE CONCLUDED, UNLESS POTENTIAL HAZARDS INTRODUCED AS A RESULT OF THE WORK ARE STILL PRESENT AT THE END OF THE WORK DAY. IF SIGNS ARE LEFT IN PLACE AFTER WORK ACTIVITIES, THE TRAFFIC CONTROL SUPERVISOR SHALL MAKE AN ENTRY IN THEIR DAILY DIARY THAT JUSTIFIES THEIR USE.
- "HAZARDS" INCLUDE BUT ARE NOT LIMITED TO:
  - EDGE DROP OFFS
  - EQUIPMENT, WORKERS OR NON-SHIELDED OBJECTS IN THE CLEAR ZONE
  - ROUGH PAVEMENT
  - MAJOR CHANGE IN ALIGNMENT
  - REDUCED SHOULDER WIDTH
  - TEMPORARY GUARD RAIL OR BARRIER
  - LANE CLOSURE
- SIGNS SHALL ONLY BE PLACED WHERE WORKERS ARE PRESENT IN THE ROADWAY OR CLEAR ZONE OR ARE AT RISK, OR WHERE THERE ARE HAZARDS IN THE TRAVELWAY, SHOULDERS OR CLEAR ZONE.
- SIGNS SHOULD BE PLACED SO THAT MOTORISTS IMMEDIATELY ASSOCIATE THE SIGNS WITH PRESENT WORK ACTIVITIES. IF THE ZONE OF WORK ACTIVITY MOVES, THE SIGNS SHOULD BE MOVED ACCORDINGLY.
- SIGNING SHOWN IS REQUIRED TO ENFORCE DOUBLE FINES IN A WORK ZONE. ADDITIONAL SIGNING SHALL BE IN ACCORDANCE WITH THAT NORMALLY REQUIRED FOR THE PARTICULAR WORK ZONE. PLACEMENT OF "FINES DOUBLE" SIGNING MAY BE ADJUSTED AS NEEDED TO PROVIDE A MINIMUM 250' SPACING BETWEEN OTHER SIGNING REQUIRED FOR THE SPECIFIC WORK ZONE SETUP.

CASE NO. 24  
TYPICAL APPLICATION  
"FINES DOUBLE IN WORK ZONE" SIGNING  
(WITH SPEED REDUCTION)

Computer File Information		Sheet Revisions		Colorado Department of Transportation 4201 East Arkansas Avenue Denver, Colorado 80222 Phone: (303) 757-9543 Fax: (303) 757-9219 Safety & Traffic Engineering Branch KCM/RRR	TRAFFIC CONTROLS FOR HIGHWAY CONSTRUCTION	STANDARD PLAN NO.
Creation Date: 07/04/12	Initials: RRR	Date:	Comments			S-630-1
Last Modification Date:	Initials:	(R-X)				Sheet No. 12 of 20
Full Path: www.coloradodot.info/library/traffic/traffic-s-standard-plans		(R-X)			Issued By: Safety & Traffic Engineering Branch July 4, 2012	
Drawing File Name: S-630-01_12of20.dgn		(R-X)				
CAD Ver.: MicroStation V8	Scale: Not to Scale	Units: English				





LEGEND

CHANNELIZING DEVICE: FOR TYPE OF DEVICE TO BE USED, SEE SCHEDULE OF TRAFFIC CONTROL DEVICES INCLUDED IN THE PLANS. DRUMS OR VERTICAL PANELS SHALL BE USED TO DELINEATE THE LANE CLOSURE TAPER.

TYPE III BARRICADE

CONCRETE BARRIER (TEMPORARY)

FLAGGER

DIRECTION OF TRAVEL

WORK AREA

TRANSITION TAPER LENGTH:

L = MINIMUM LENGTH OF TAPER

SPEED 45 MPH OR MORE:  $L = S \times W$

S = NUMERICAL VALUE OF SPEED LIMIT OR 85 PERCENTILE SPEED

W = WIDTH OF OFFSET

SHOULDER TAPER =  $1/3 L$

ADVANCE WARNING FLASHING OR SEQUENCING ARROW PANEL

CZ CLEAR ZONE (SEE GENERAL NOTE 16 ON SHEET 1).

THESE DEVICES ARE OPTIONAL. THEIR NEED SHALL BE DETERMINED BY TRAFFIC VOLUMES AND/OR SCOPE OF CONSTRUCTION ACTIVITY, AND ARE REQUIRED WHEN THEY ARE INCLUDED IN THE SCHEDULE OF CONSTRUCTION CONTROL DEVICES.


G20-11 SIGN IS REQUIRED WHEN SECTION 626 "PUBLIC INFORMATION SERVICES" PROJECT SPECIAL PROVISION WORKSHEET SPECIFICATION IS REQUIRED WITH PROJECT.

REQUIRED WHEN WORK OCCUPIES THE LOCATION FOR MORE THAN 3 DAYS.


TRUCK MOUNTED ATTENUATOR

FLASHING BEACON

SEE FINES DOUBLE SIGNING NOTES ON SHEET 12.

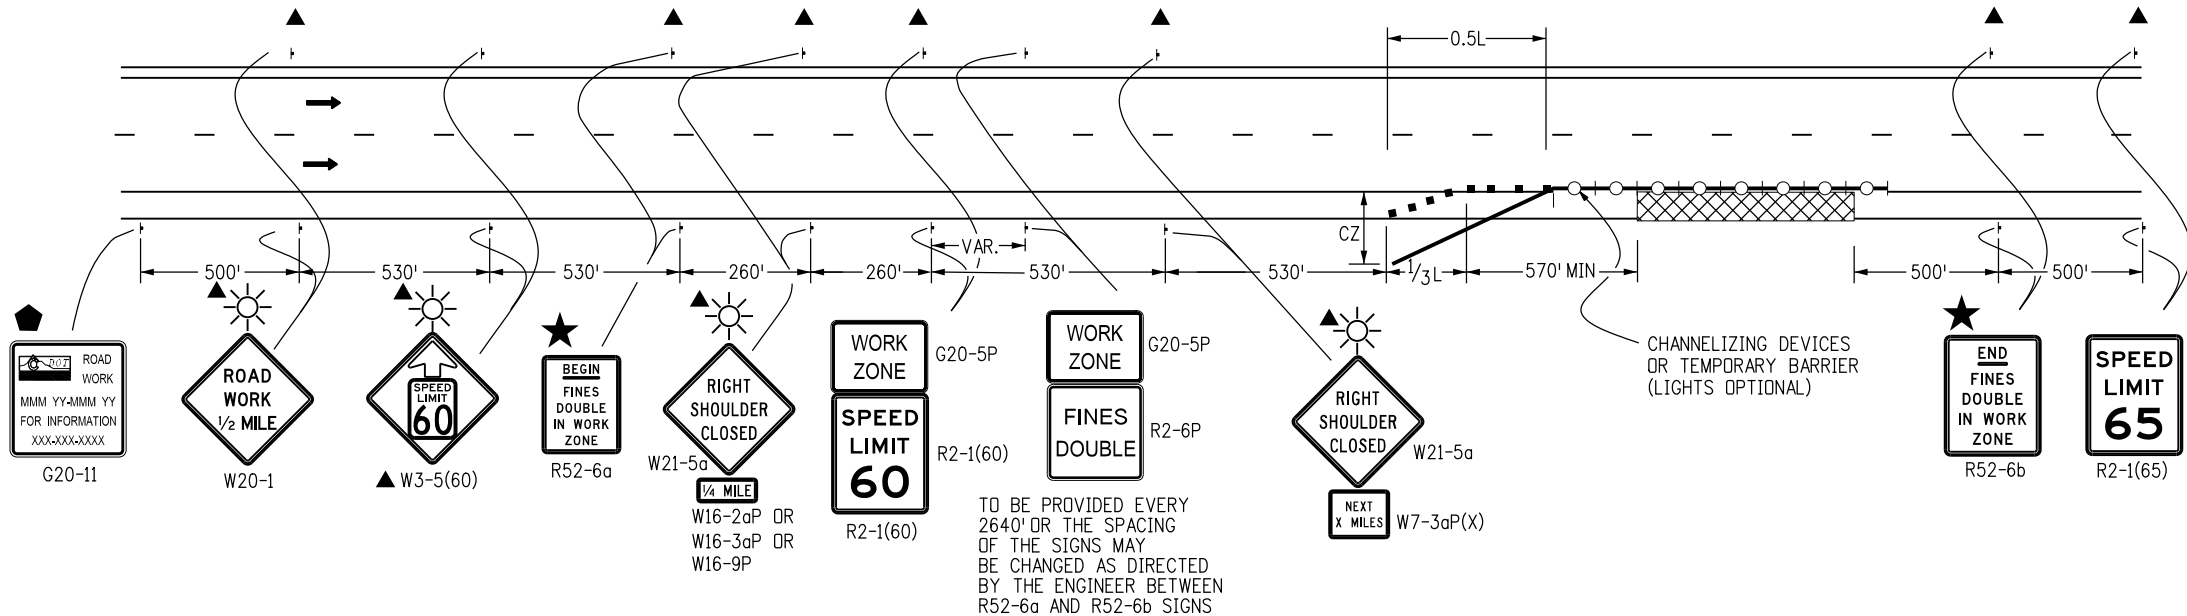


CASE NO. 26  
TYPICAL APPLICATION  
SHOULDER WORK - FREEWAY/EXPRESSWAY w/ 65 MPH SPEED LIMIT  
WHEN HAZARDS (WORKERS, EQUIPMENT, OR TEMPORARY BARRIER) ARE WITHIN 8 FT OF TRAVEL WAY

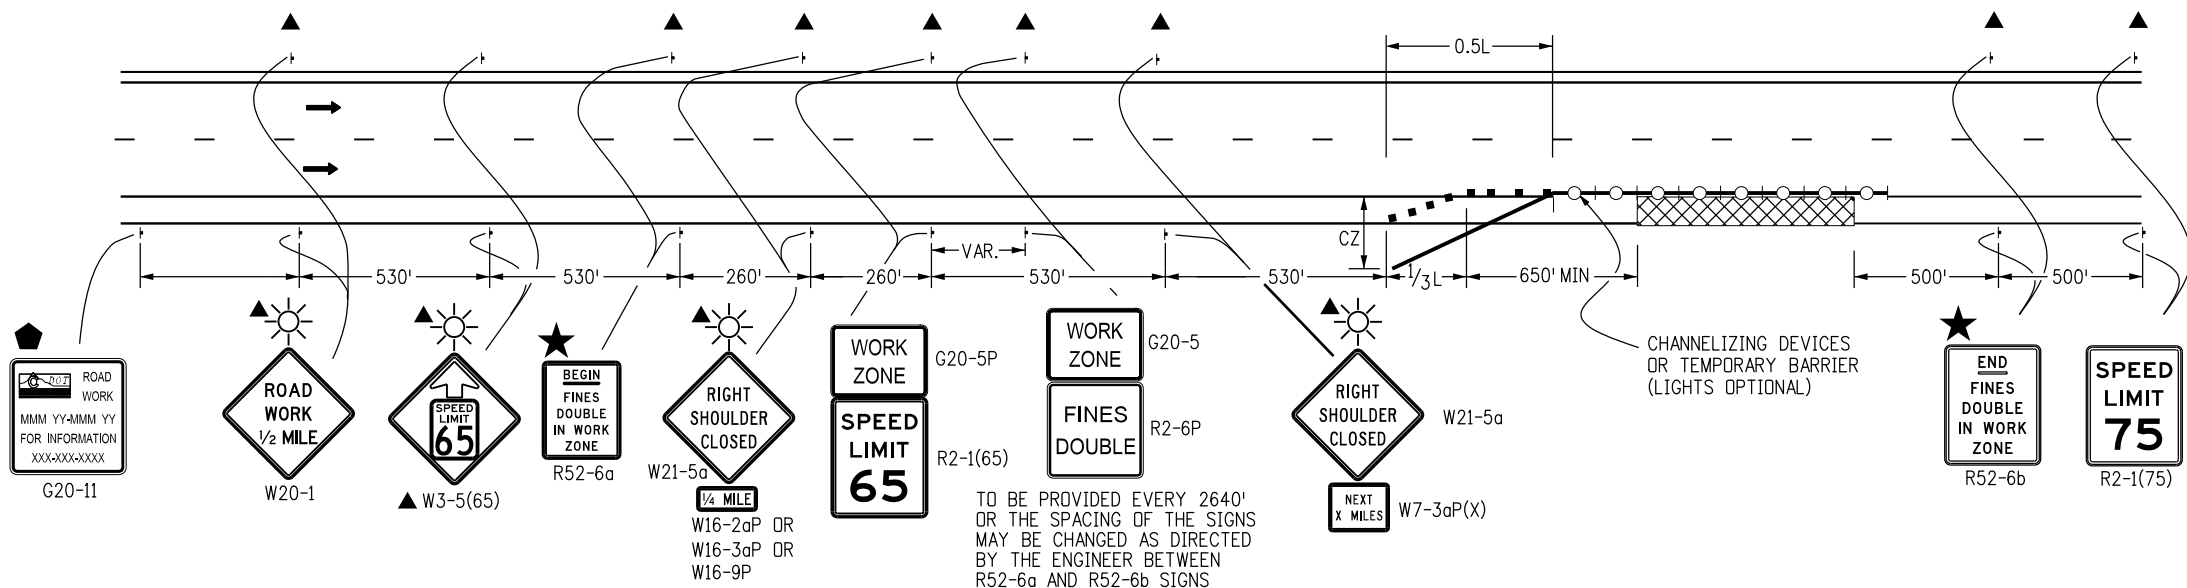

CASE NO. 27  
TYPICAL APPLICATION  
SHOULDER WORK - FREEWAY/EXPRESSWAY w/ 75 MPH SPEED LIMIT  
WHEN HAZARDS (WORKERS, EQUIPMENT, OR TEMPORARY BARRIER) ARE WITHIN 10 FT OF TRAVEL WAY

Computer File Information		Sheet Revisions		Colorado Department of Transportation 4201 East Arkansas Avenue Denver, Colorado 80222 Phone: (303) 757-9543 Fax: (303) 757-9219 Safety & Traffic Engineering Branch KCM/RRR	TRAFFIC CONTROLS FOR HIGHWAY CONSTRUCTION	STANDARD PLAN NO.
Creation Date: 07/04/12	Initials: RRR	Date:	Comments			S-630-1
Last Modification Date:	Initials:					Sheet No. 14 of 20
Full Path: www.coloradodot.info/library/traffic/traffic-s-standard-plans						
Drawing File Name: S-630-01_14of20.dgn						
CAD Ver.: MicroStation V8	Scale: Not to Scale	Units: English			Issued By: Safety & Traffic Engineering Branch July 4, 2012	



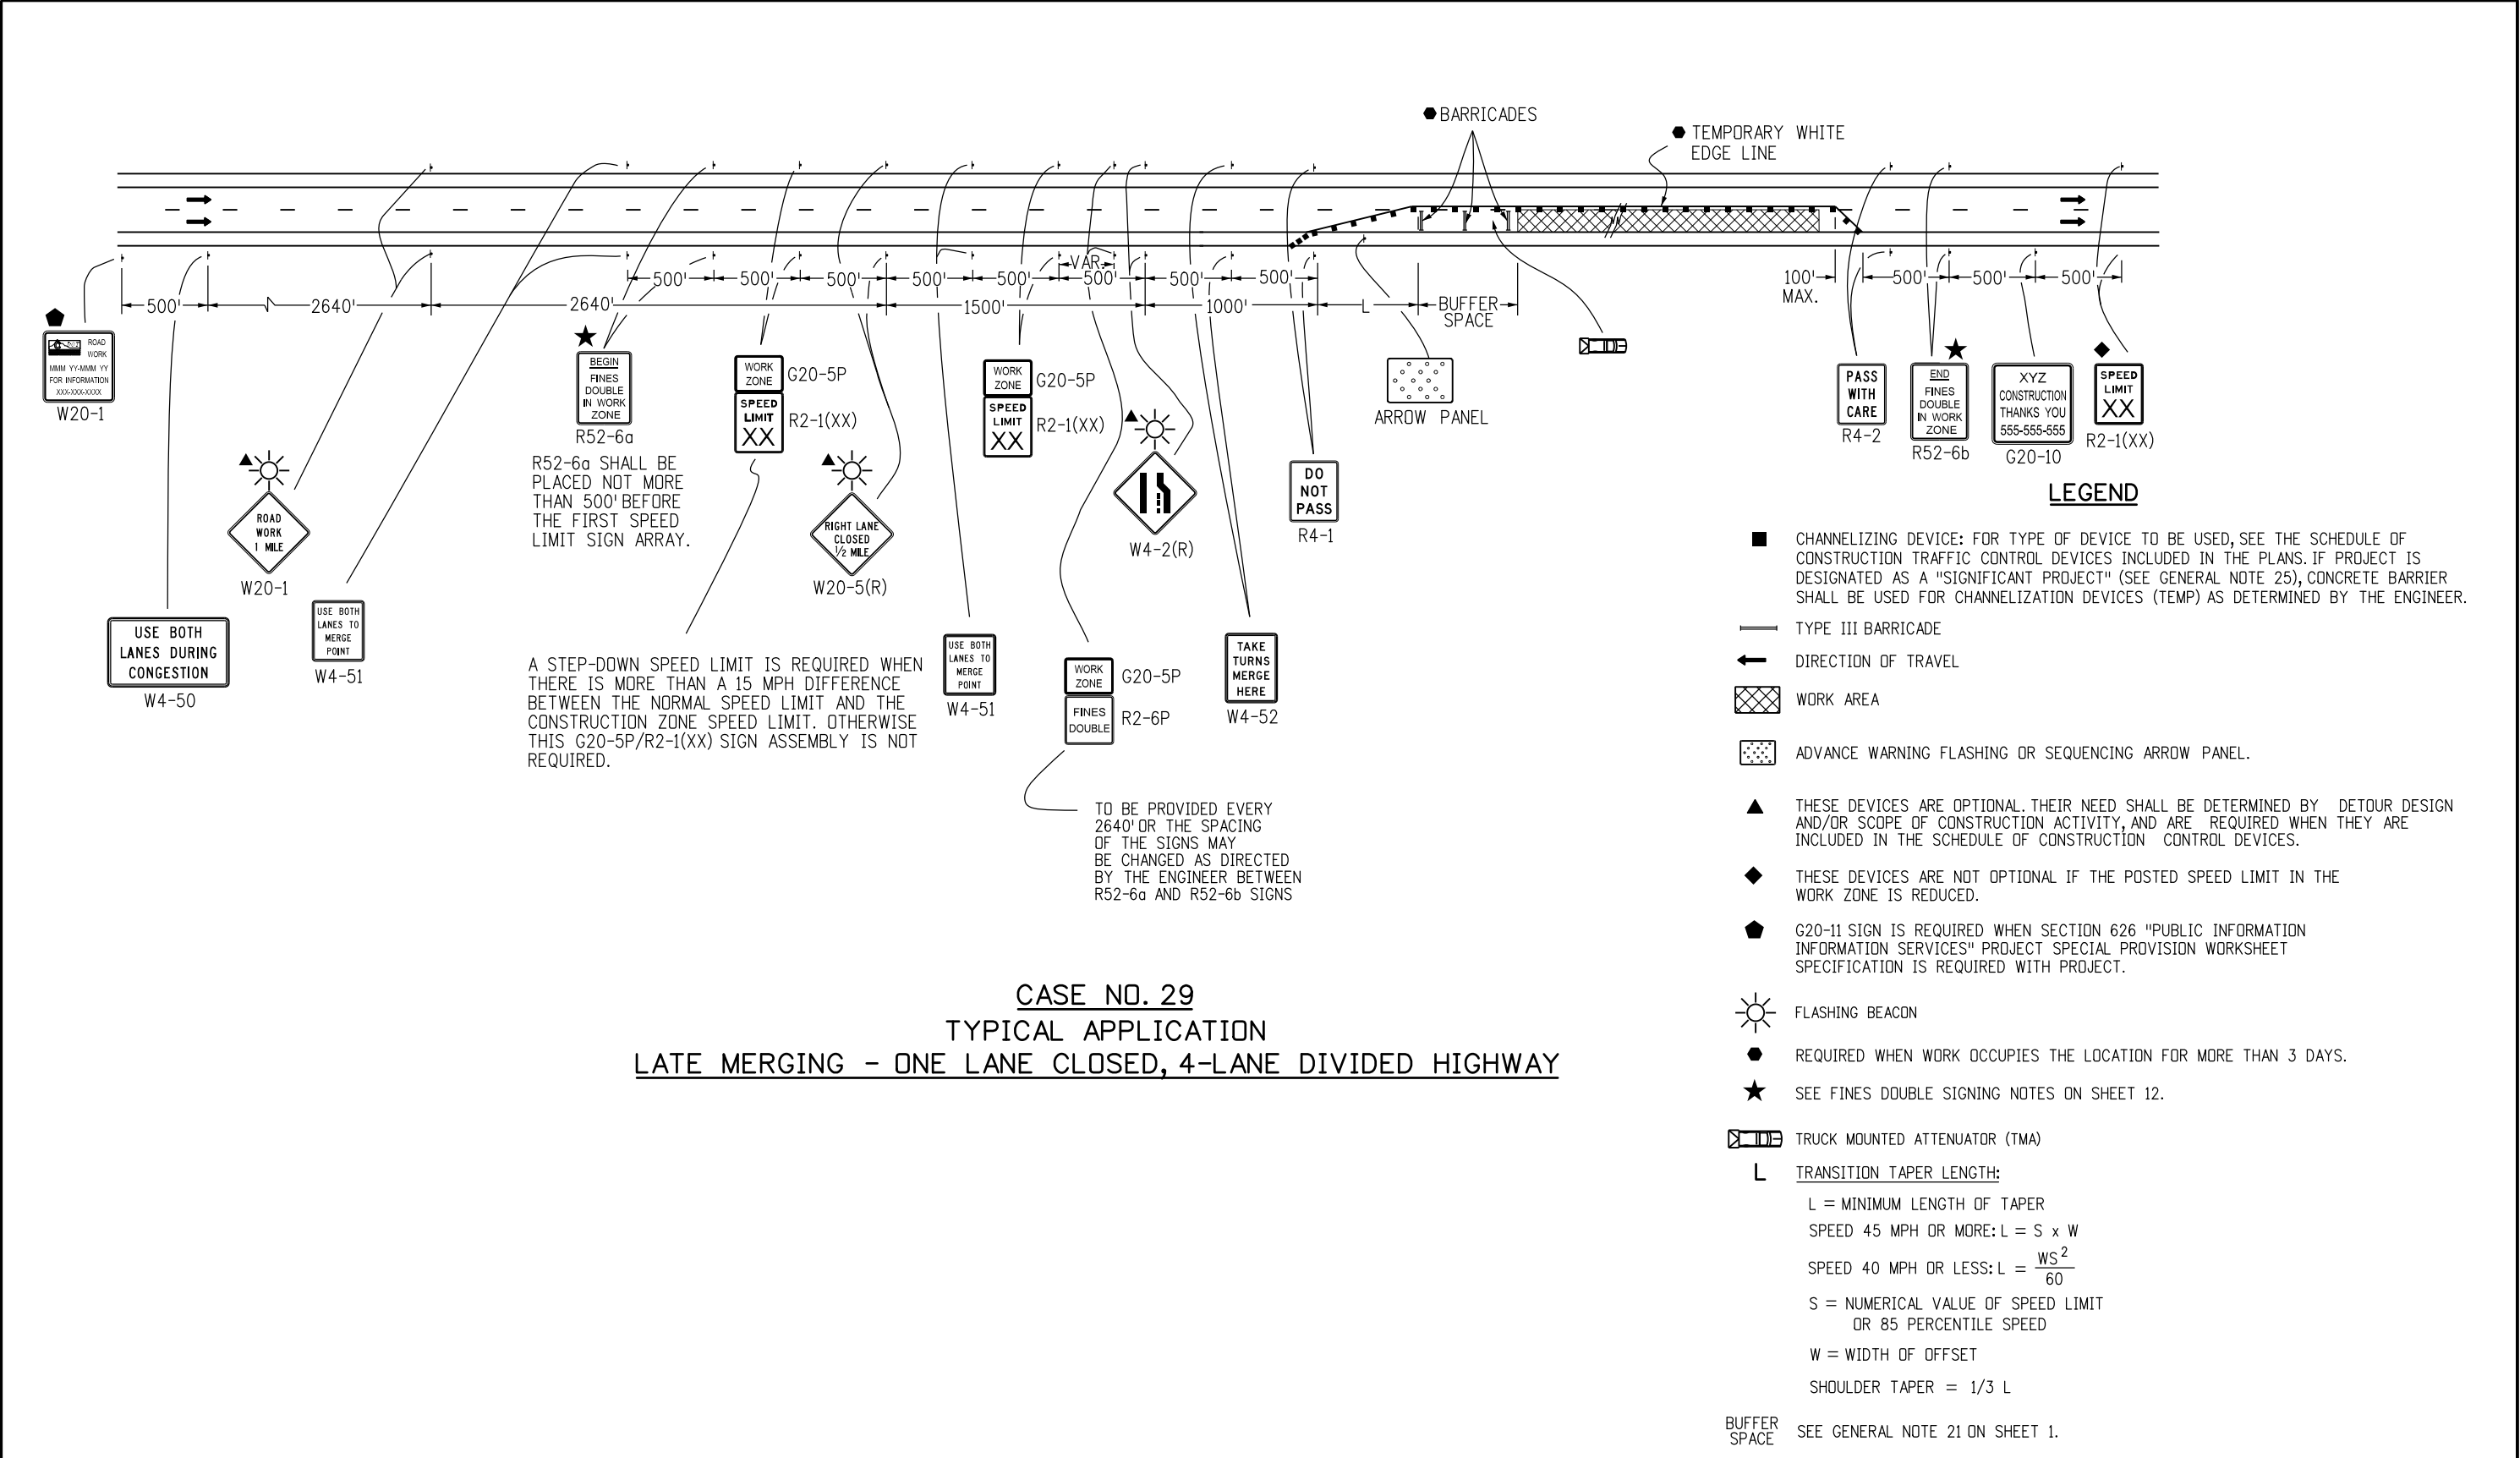

CASE NO. 29  
TYPICAL APPLICATION  
LATE MERGING - ONE LANE CLOSED, 4-LANE DIVIDED HIGHWAY

Computer File Information		Sheet Revisions		<div>Colorado Department of Transportation</div> <div>4201 East Arkansas Avenue Denver, Colorado 80222 Phone: (303) 757-9543 Fax: (303) 757-9219</div> <div>Safety &amp; Traffic Engineering Branch</div> <div>KCM/RRR</div>	TRAFFIC CONTROLS FOR HIGHWAY CONSTRUCTION	STANDARD PLAN NO.
Creation Date: 07/04/12	Initials: RRR	Date:	Comments			S-630-1
Last Modification Date:	Initials:	<div>(R-X)</div>				
Full Path: www.coloradodot.info/library/traffic/traffic-s-standard-plans		<div>(R-X)</div>				
Drawing File Name: S-630-01_16of20.dgn		<div>(R-X)</div>				Sheet No. 16 of 20
CAD Ver.: MicroStation V8	Scale: Not to Scale	Units: English			Issued By: Safety & Traffic Engineering Branch July 4, 2012	





LEGEND

- 
- VEHICLE WITH TRUCK-MOUNTED ATTENUATORS (TMA), TWO 360-DEGREE YELLOW FLASHING BEACONS, AND YELLOW FLASHING VEHICLE LIGHTS OR STROBES.
- 
- ADVANCE WARNING FLASHING OR SEQUENCING ARROW PANEL.
- 
- VARIABLE MESSAGE SIGN (VMS).
- 
- WHEN VMS IS USED, THE "SHOULDER CLOSED" SIGN BECOMES OPTIONAL.
- 
- THE "PICK-UP VEHICLES" OR "WARNING VEHICLE" MAY ENCRDACH INTO THE TRAFFIC LANE WHEN THE SHOULDER IS TOO NARROW TO DRIVE ON.
- 
- IF TRACKING OF THE WET PAINT IS ANTICIPATED, THE USE OF CONES OR STATIONARY "WET PAINT" SIGNS SHALL BE POSTED.
- 
- THE VARIABLE SEPARATION DISTANCE BETWEEN THE "CONE PLACEMENT VEHICLE" AND "CONE PICKUP VEHICLE" SHALL BE DETERMINED BY THE TRACK DRYING TIME OF THE PAVEMENT MARKING MATERIAL.


FOLLOWING DISTANCE CHART FOR WARNING AND SIGNING VEHICLES


POSTED WZ SPEED LIMIT (MPH)	FOLLOWING DISTANCE (FEET)
0 - 30	250 - 550
35 - 40	325 - 700
45 - 50	600 - 900
55	750 - 1200
60 - 65	1000 - 1400
70 - 75	1200 - 1600

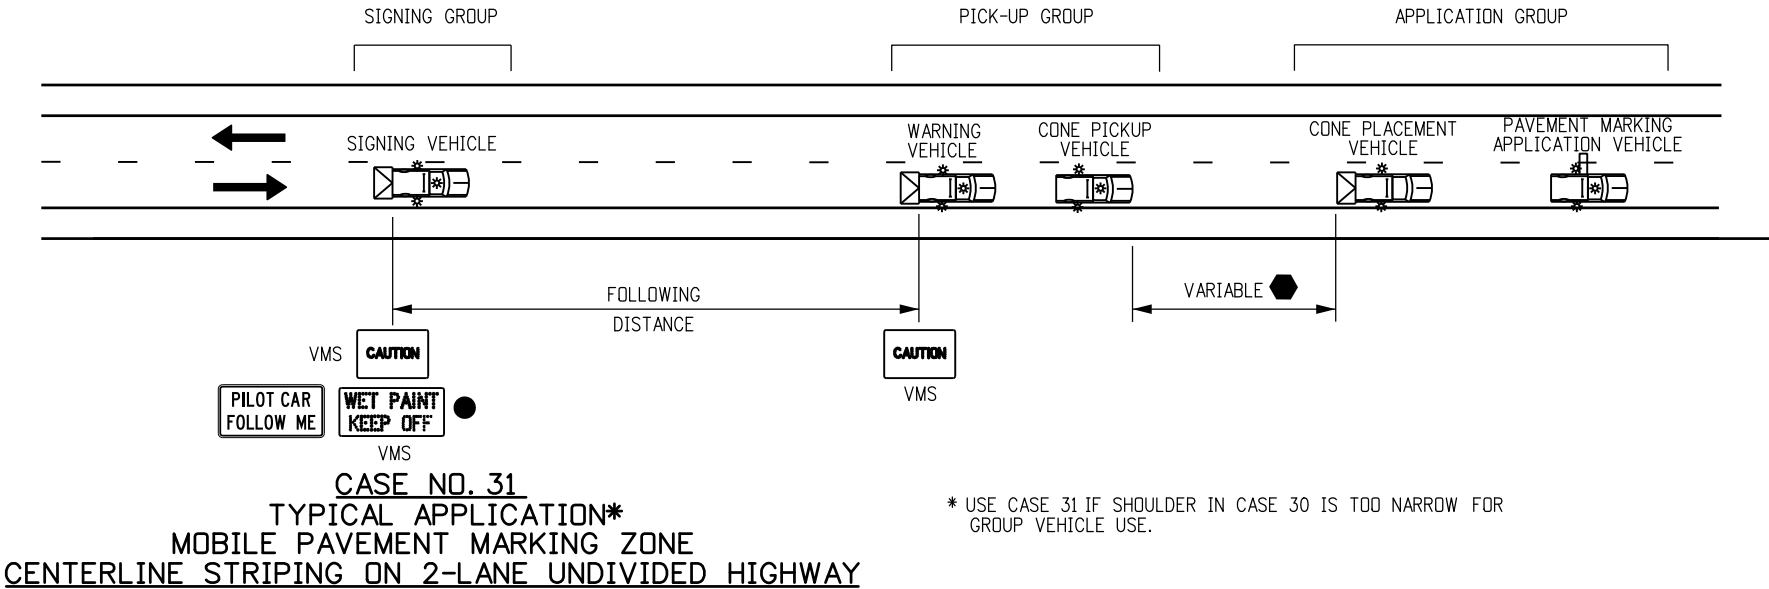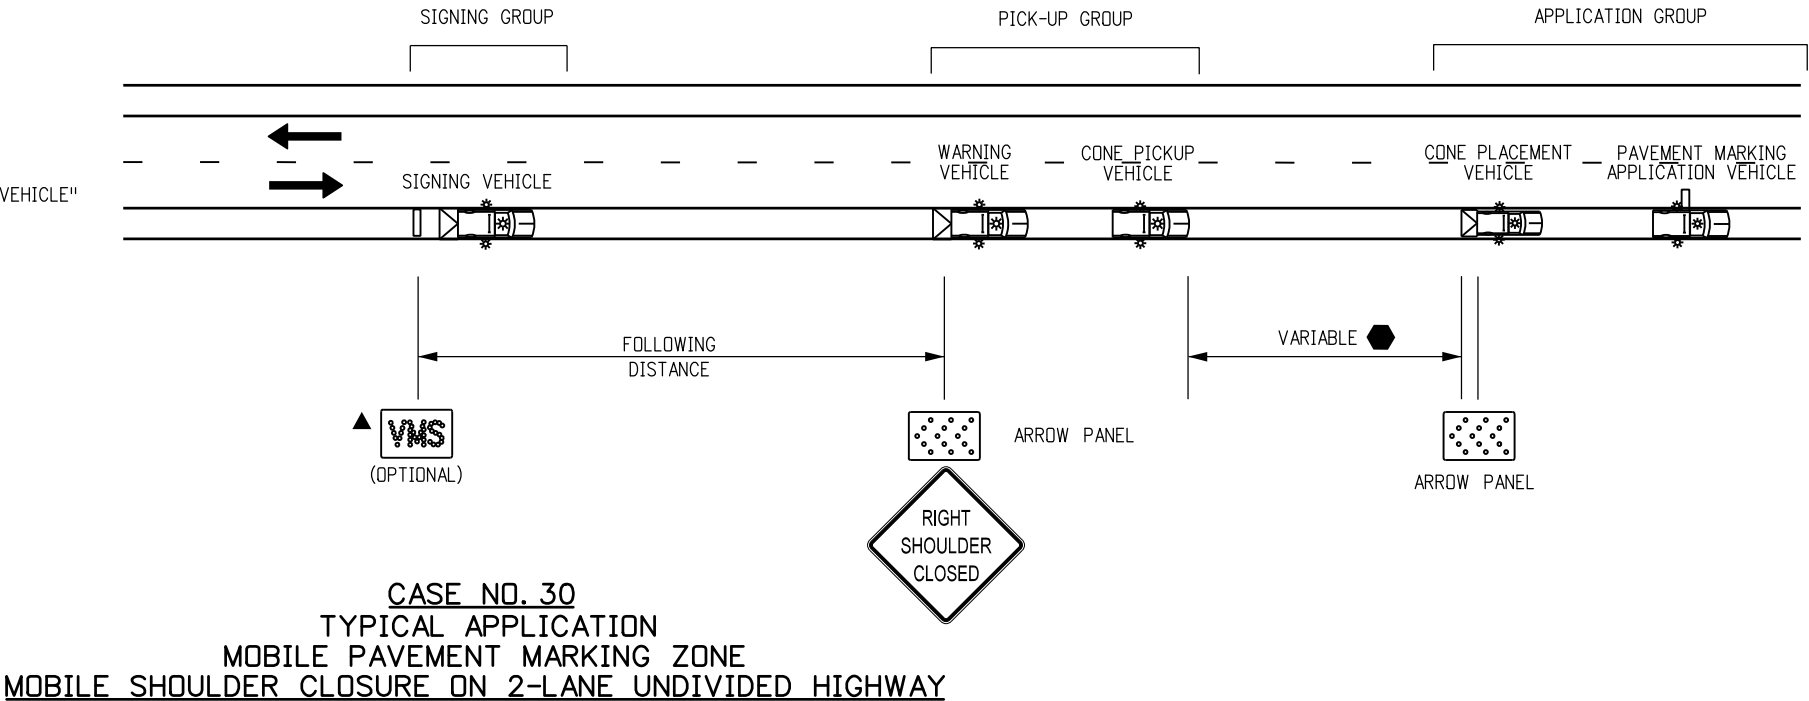


Computer File Information		Sheet Revisions		Colorado Department of Transportation  4201 East Arkansas Avenue Denver, Colorado 80222 Phone: (303) 757-9543 Fax: (303) 757-9219 Safety & Traffic Engineering Branch KCM/KEN	TRAFFIC CONTROLS FOR HIGHWAY CONSTRUCTION	STANDARD PLAN NO.
Creation Date: 07/04/12	Initials: KEN	Date:	Comments			S-630-1
Last Modification Date:	Initials:					Sheet No. 17 of 20
Full Path: www.coloradodot.info/library/traffic/traffic-s-standard-plans						
Drawing File Name: S-630-1_17of20.dgn						
CAD Ver.: MicroStation V8	Scale: Not to Scale	Units: English			Issued By: Safety & Traffic Engineering Branch July 4, 2012	


LEGEND

- 

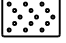
VEHICLE WITH TRUCK-MOUNTED ATTENUATORS (TMA), TWO 360-DEGREE YELLOW FLASHING BEACONS, AND YELLOW FLASHING VEHICLE LIGHTS OR STROBES.
- 


ADVANCE WARNING FLASHING OR SEQUENCING ARROW PANEL.
- 


AHEAD




LANE CLOSED

PORTABLE VARIABLE MESSAGE SIGN (VMS).
- 

WHEN THE VMS IS USED, THE "SHOULDER CLOSED" (W21-5aX) OR W21-5bX), AND "RAMP CLOSED AHEAD" SIGNS BECOME OPTIONAL.
- 

IF TRACKING OF THE WET PAINT IS ANTICIPATED, THE USE OF CONES OR STATIONARY "WET PAINT" SIGNS SHALL BE POSTED.
- 

THE VARIABLE SEPARATION DISTANCE BETWEEN THE "WARNING VEHICLE" AND "SIGNING VEHICLE" SHALL BE DETERMINED BY THE TRACK DRYING TIME OF THE PAVEMENT MARKING MATERIAL.

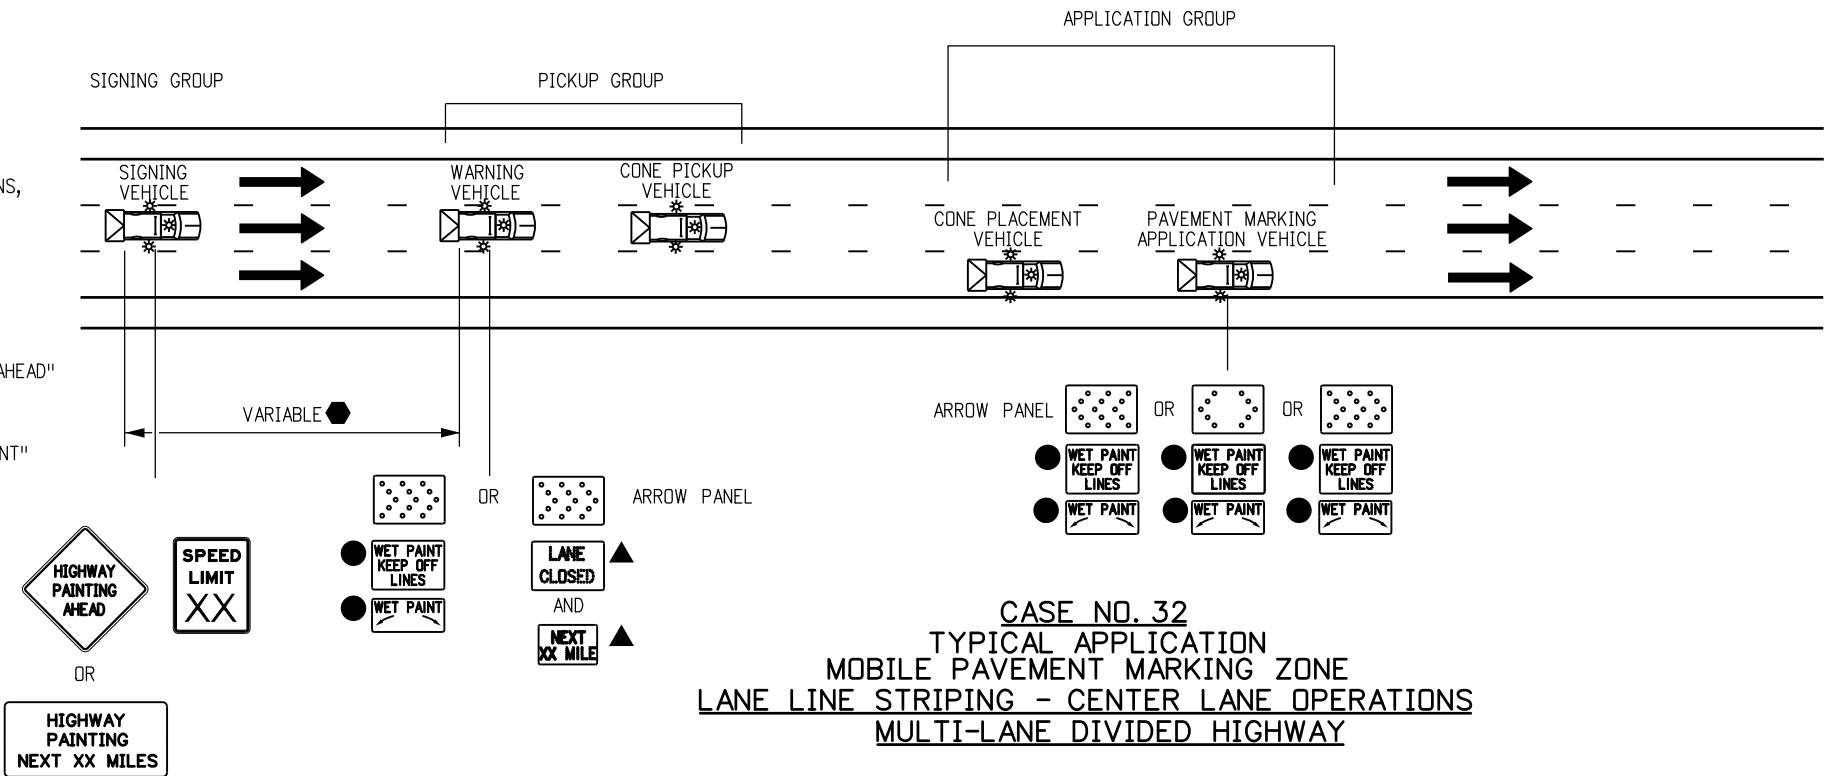


FOLLOWING DISTANCE CHART FOR WARNING VEHICLE AND SIGNING VEHICLES

POSTED WZ SPEED LIMIT (MPH)	FOLLOWING DISTANCE (FEET)
0 - 30	250 - 550
35 - 40	325 - 700
45 - 50	600 - 900
55	750 - 1200
60 - 65	1000 - 1400
70 - 75	1200 - 1600


NOTES


1. THE SIGNING VEHICLES MAY ENCRDACH INTO THE TRAFFIC LANE WHEN THE SHOULDER IS TOO NARROW TO DRIVE ON.
2. IF THE RAMP CANNOT BE REOPENED WITHIN 15 MINUTES, USE CASE NO. 22 OF THE S-630-1 STANDARD PLAN.

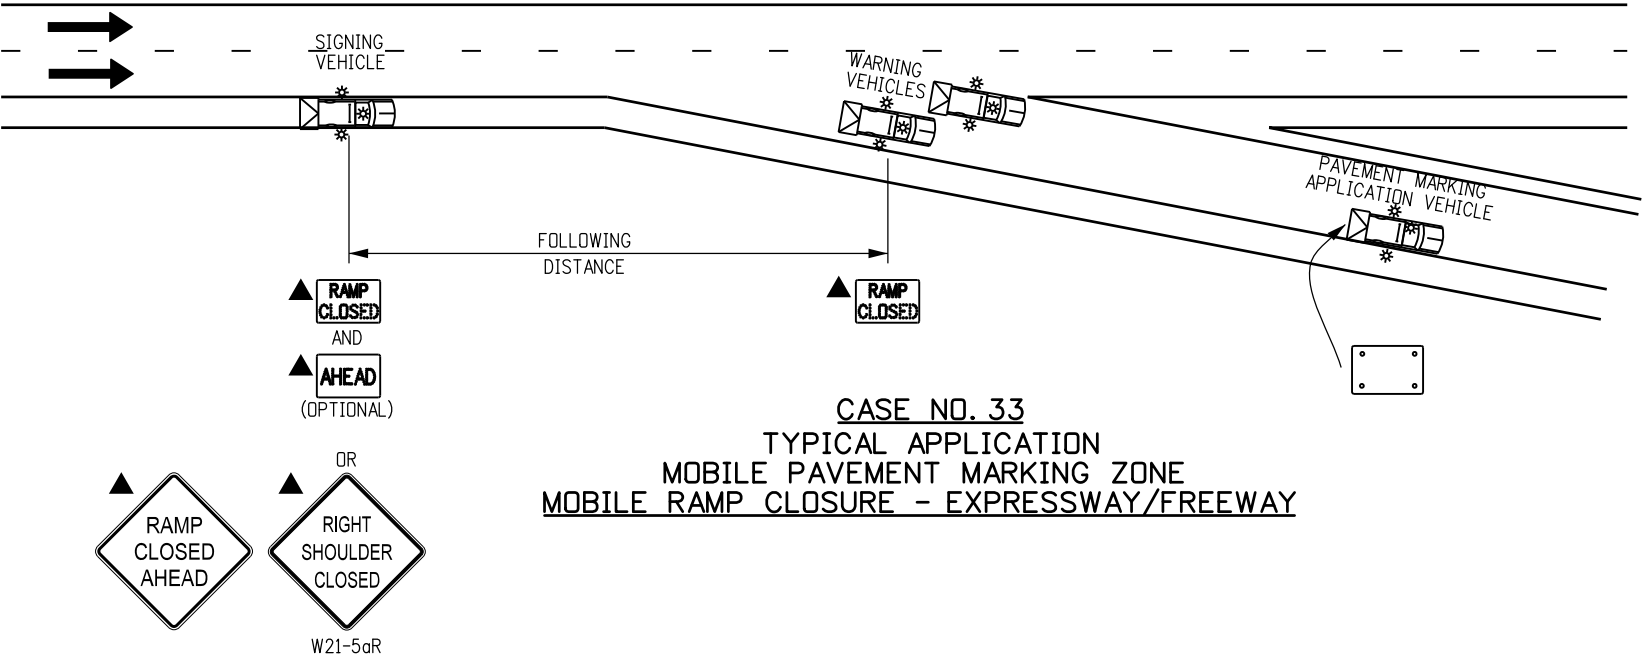



Computer File Information		Sheet Revisions		 <p>Colorado Department of Transportation 4201 East Arkansas Avenue Denver, Colorado 80222 Phone: (303) 757-9543 Fax: (303) 757-9219 Safety &amp; Traffic Engineering Branch KCM/KEN</p>	TRAFFIC CONTROLS FOR HIGHWAY CONSTRUCTION		STANDARD PLAN NO.
Creation Date: 07/04/12	Initials: KEN	Date:	Comments				S-630-1
Last Modification Date:	Initials:						
Full Path: www.coloradodot.info/library/traffic/traffic-s-standard-plans							
Drawing File Name: S-630-1_18of20.dgn							
CAD Ver.: MicroStation V8	Scale: Not to Scale	Units: English			Issued By: Safety & Traffic Engineering Branch July 4, 2012		Sheet No. 18 of 20

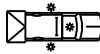
LEGEND

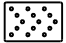- 

VEHICLE WITH TRUCK-MOUNTED ATTENUATORS (TMA), TWO 360-DEGREE YELLOW FLASHING BEACONS, AND YELLOW FLASHING VEHICLE LIGHTS OR STROBES.
- 

ADVANCE WARNING FLASHING OR SEQUENCING ARROW PANEL.
- 

PORTABLE VARIABLE MESSAGE SIGN (VMS).
- 

WHEN THE VMS IS USED, THE "RIGHT LANE CLSED AHEAD" (W9-3X) SIGN BECOMES OPTIONAL.
- 


THE "CONE PICK-UP VEHICLE" OR "WARNING VEHICLE" MAY ENCRDOACH INTO THE TRAFFIC LANE WHEN THE SHOULDER IS TOO NARROW TO DRIVE ON.

NOTES


1. IN ROADWAY WHERE THE AADT IS 2,000 OR LESS, A SINGLE WORK VEHICLE WITH APPROPRIATE WARNING DEVICES ON THE VEHICLE MAY BE USED.
2. RADIO COMMUNICATIONS BETWEEN THE WORKCREW AND THE MOVING BLOCKADE ARE REQUIRED TO ADJUST THE BLOCKADE TO INCREASE OR DECREASE THE CLOSURE TIME. RELEASE TRAFFIC ONLY AFTER CONFIRMATION THAT ALL WORKERS AND THEIR VEHICLES ARE CLEAR OF THE ROADWAY.
3. IF APPLICABLE, ALL RAMPS AND ACCESS BETWEEN THE MOVING BLOCKADE AND WORK OPERATION AREA SHALL BE TEMPORARILY CLOSED USING TRAFFIC CONTROL EQUIPMENT AND PERSONNEL. EACH RAMP MUST REMAIN CLOSED UNTIL THE CREW DOING THE WORK GIVES THE "ALL CLEAR" SIGNAL OR UNTIL THE FRONT OF THE MOVING BLOCKADE PASSES THE CLOSED RAMP(S).

FOLLOWING DISTANCE CHART FOR WARNING VEHICLE AND SIGNING VEHICLES

POSTED WZ SPEED LIMIT (MPH)	FOLLOWING DISTANCE (FEET)
0 - 30	250 - 550
35 - 40	325 - 700
45 - 50	600 - 900
55	750 - 1200
60 - 65	1000 - 1400
70 - 75	1200 - 1600

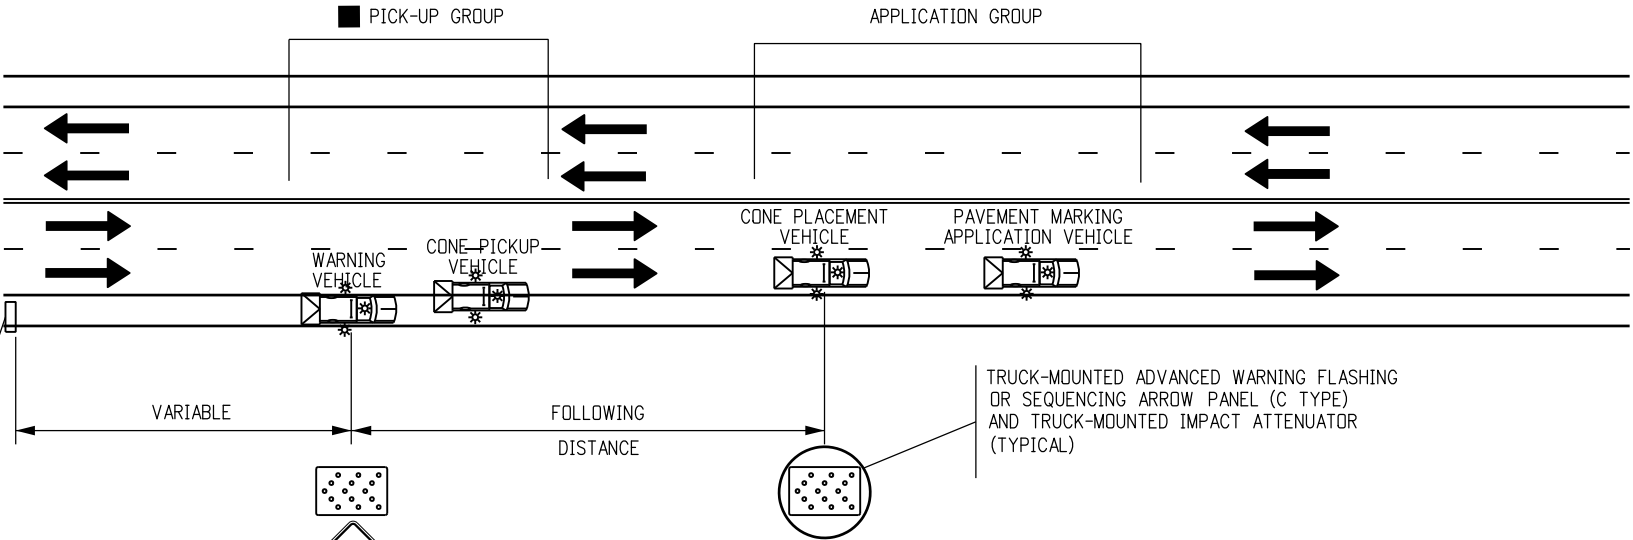

CASE NO. 34  
TYPICAL APPLICATION  
MOBILE OPERATION OF LANE CLOSURE OF MULTI-LANE HIGHWAY  
(NOT FOR USE ON FREEWAYS)

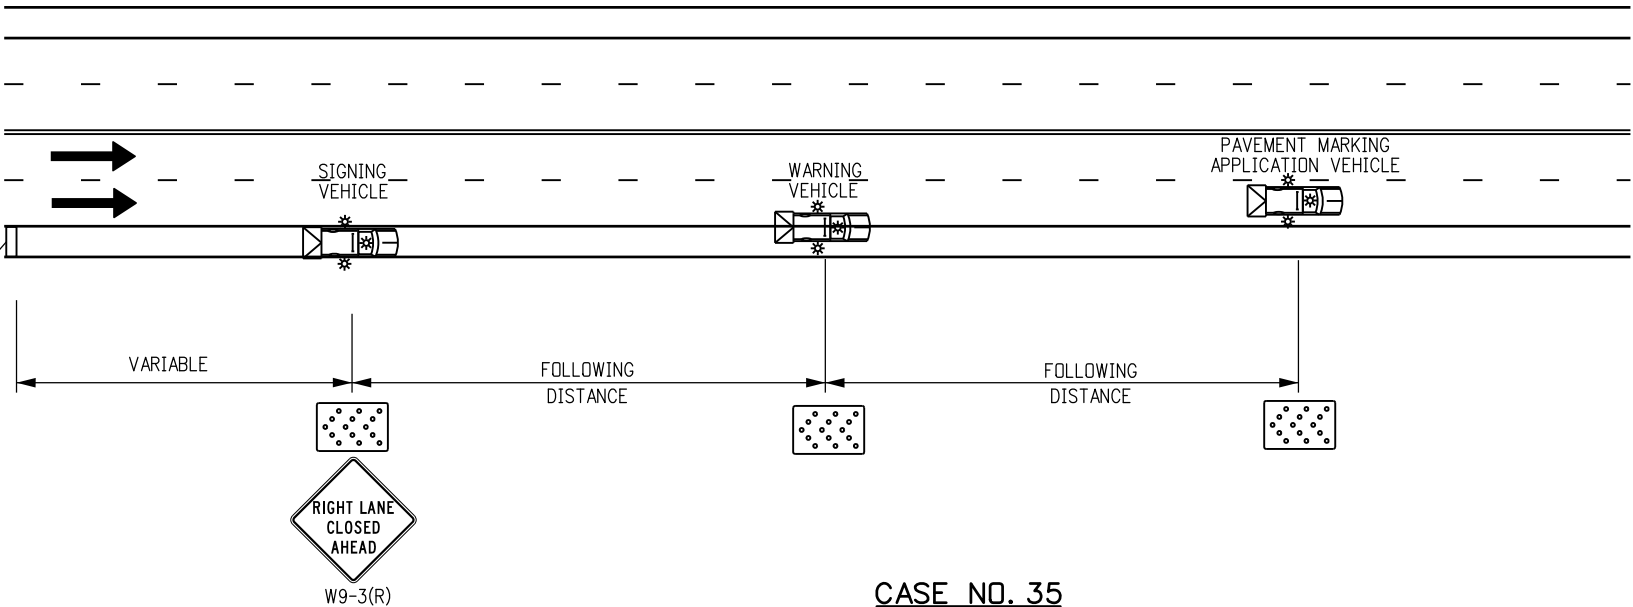

CASE NO. 35  
TYPICAL APPLICATION  
MOBILE OPERATION OF LANE CLOSURE OF MULTI-LANE HIGHWAY



Computer File Information		Sheet Revisions		 Colorado Department of Transportation 4201 East Arkansas Avenue Denver, Colorado 80222 Phone: (303) 757-9543 Fax: (303) 757-9219 Safety & Traffic Engineering Branch KCM/KEN	TRAFFIC CONTROLS FOR HIGHWAY CONSTRUCTION	STANDARD PLAN NO.
Creation Date: 07/04/12	Initials: KEN	Date:	Comments			S-630-1
Last Modification Date:	Initials:					
Full Path: www.coloradodot.info/library/traffic/traffic-s-standard-plans						
Drawing File Name: S-630-1_19of20.dgn						
CAD Ver.: MicroStation V8	Scale: Not to Scale	Units: English			Issued By: Safety & Traffic Engineering Branch July 4, 2012	Sheet No. 19 of 20



THESE SIGNING NOTES ARE INTENDED AS A QUICK REFERENCE  
FOR TYPICAL SIGN USE AND PLACEMENT IN CONSTRUCTION ZONES.

### ADVANCE PLACEMENT OF WARNING SIGNS

+ CONDITION A: SPEED REDUCTION AND LANE CHANGING IN HEAVY TRAFFIC. TYPICAL SIGNS ARE "MERGE" AND "RIGHT LANE ENDS".

++ CONDITION B: TYPICAL CONDITIONS ARE THE WARNING OF A POTENTIAL STOP SITUATION AND LOCATIONS WHERE THE ROAD USER MUST DECREASE SPEED TO MANEUVER THROUGH THE WARNING CONDITION. TYPICAL SIGNS ARE "STOP AHEAD", "SIGNAL AHEAD", "YIELD AHEAD", "CURVE", "REVERSE CURVE", "TURN".

● NO SUGGESTED DISTANCES ARE PROVIDED AT THESE SPEEDS, AS THE PLACEMENT IS DEPENDENT ON SITE CONDITIONS AND OTHER SIGNING.

A SUPPLEMENTAL PLAQUE MAY BE USED WITH WARNING SIGNS SPECIFYING THE DISTANCE TO THE CONDITION IF THERE IS AN IN-BETWEEN INTERSECTION THAT MIGHT CONFUSE THE MOTORIST.

\* PLACEMENT SHOULD BE IN ACCORDANCE WITH WARNING SIGN PLACEMENT TABLE.

Colorado Department of Transportation

4201 East Arkansas Avenue  
Denver, Colorado 80222  
Phone: (303) 757-9543  
Fax: (303) 757-9219

## Safety & Traffic Engineering Branch

KCM/KEN

# TRAFFIC CONTROLS FOR HIGHWAY CONSTRUCTION

Issued By: Safety & Traffic Engineering Branch July 4, 2012

## STANDARD PLAN NO.

S-630-1

Sheet No. 20 of 20