

STATE DEPARTMENT OF HIGHWAYS DIVISION OF HIGHWAYS—STATE OF COLORADO

FEDERAL ROAD REGION NO.	DIVISION	PROJECT NO.	SHEET NO.
VIII	COLORADO	C16-0012-01	1

AS CONSTRUCTED
NO REVISIONS DATE 10/24/73

INDEX OF SHEETS


SHEET NO

PLAN AND PROFILE OF PROPOSED COLORADO PROJECT NO. C16-0012-01 STATE HIGHWAY NO. 12 HUERFANO COUNTY

- 1 TITLE PAGE, SKETCH MAP AND TABULATION OF LENGTH
- 2 TYPICAL SECTION, GENERAL NOTES AND STRUCTURE REQUIREMENTS
- 3 SUMMARY OF APPROXIMATE QUANTITIES
- 4 SURFACING PLAN, TABULATIONS OF ROAD APPROACHES, GUARD RAIL TYPE 3 AND DETAILS OF HEADWALL REMOVAL
- 5 PIT SKETCH
- 6 GUARD RAIL (TYPE 3) CONNECTION TO EXISTING STRUCTURE
- 7 STRUCTURE CROSS SECTION
EX Pit sketching

TABULATION OF LENGTH

STATION	ROADWAY LIN. FT.
20+10-BEGIN C16-0012-01	36,490.0
385+00 Bk. = 402+62.0 Ah. = BEGIN S0079(2) EQ.	988.3
412+50.3 Bk. = 412+52.3 Ah. EQ.	1,533.2
427+85.5 Bk. = 427+77.1 Ah. EQ.	1,240.1
440+17.2 Bk. = 440+11.0 Ah. EQ.	985.4
449+96.4 Bk. = 449+96.2 Ah. EQ.	533.0
455+29.2 - END C16-0012-01 = 455+29.2 ON S0079(2)	
TOTAL	41,770.0
SUMMARY	
ROADWAY	41,770.0 7.911
TOTAL NET & GROSS LENGTH	41,770.0 7.911

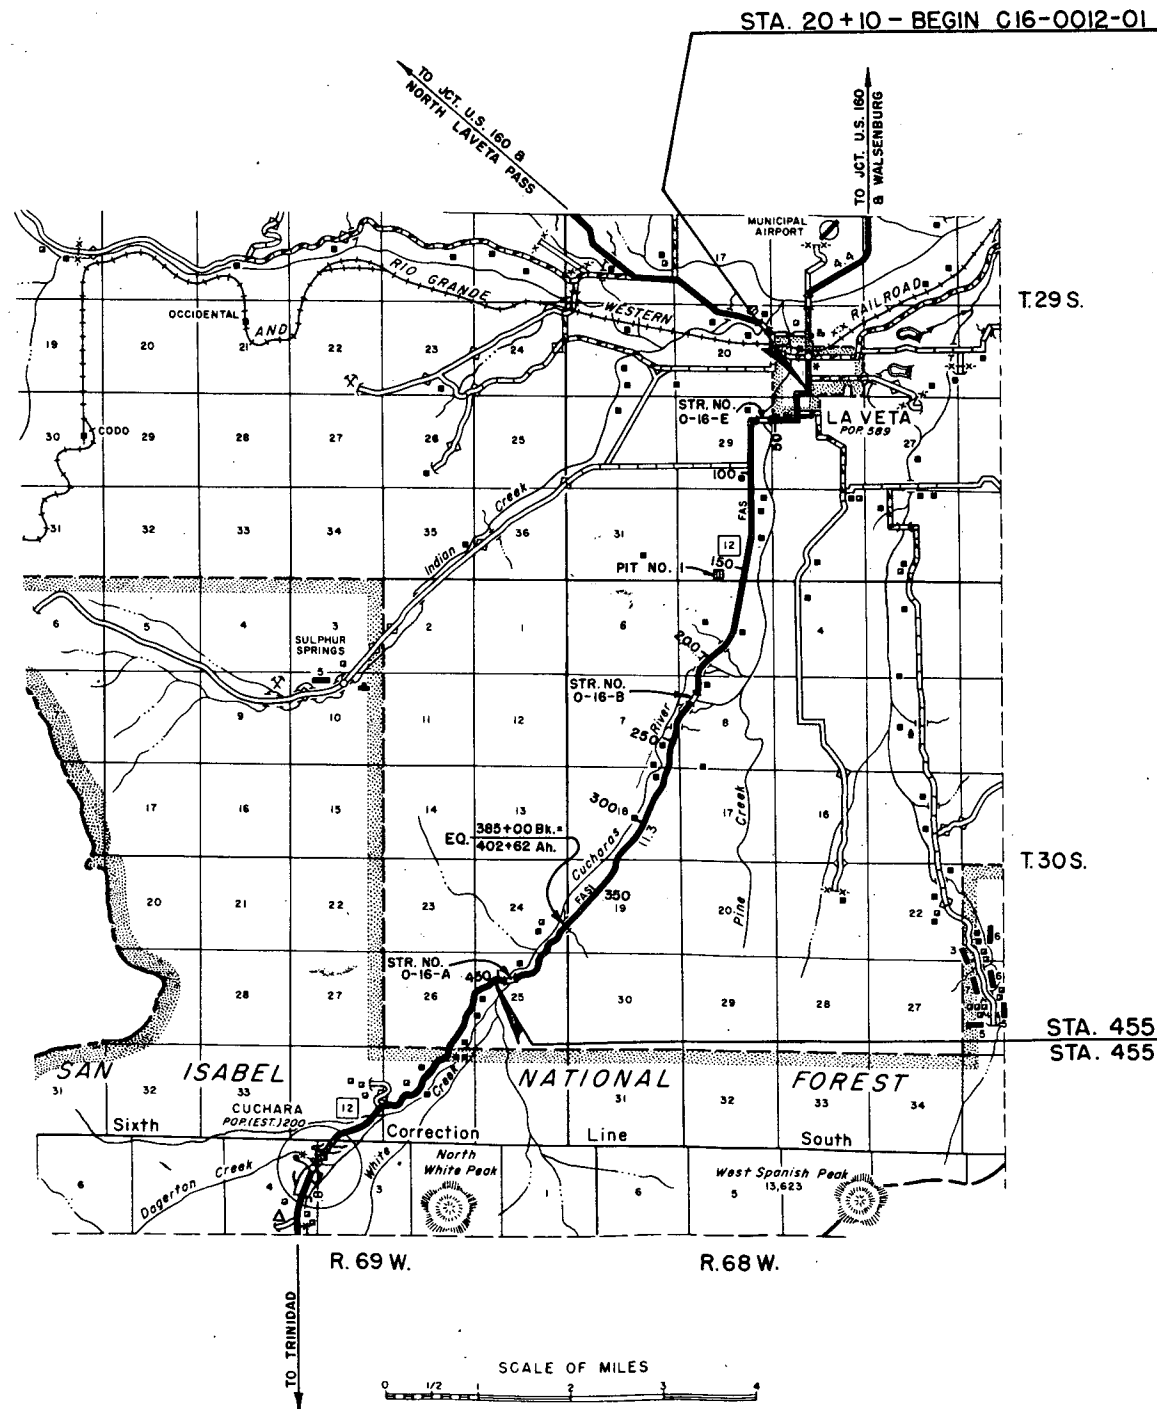

M-206-AA	EXCAVATION AND BACKFILL FOR STRUCTURES	(2 SHEETS)	2-16-72
M-500-A	LETTERS AND FIGURES FOR STRUCTURE NUMBERS		7-1-65
M-601-A	SINGLE AND DOUBLE CONCRETE BOX CULVERTS		5-10-71
M-601-C	WINGWALLS FOR CONCRETE BOX CULVERTS - 4:1 SIDE SLOPES	(2 SHEETS)	10-25-68
M-606-AB	GUARD RAIL, TYPE 3	(3 SHEETS)	12-20-71
M-614-TB	TRAFFIC SIGNING FOR HIGHWAY CONSTRUCTION	(3 SHEETS)	11-22-71
S-612-51A	TYPICAL DELINEATOR INSTALLATIONS	(2 SHEETS)	10-26-72
S-614-52A	BARRICADES AND VERTICAL PANEL CHANNELIZING DEVICES		6-26-73

DIVISION OF HIGHWAYS

APPROVED *[Signature]* 7/18/73
CHIEF ENGINEER DATE

AS CONSTRUCTED INFORMATION

CONTRACTOR I.W. Avery Const. Co.
Resident ENGINEER Bill B. Warren
(Project or Resident)

PROJECT STARTED August 13, 1973
PROJECT COMPLETED October 24, 1973


AS CONSTRUCTED PLANS APPROVED [Signature]
Dist. Const. Eng. 1-7-74
TITLE DATE

turn to rawer # 26
C16-0012-01

IS CONSTRUCTED
 REVISED DATE 10/24/73

FEDERAL ROAD REGION NO.	DIVISION	PROJ. NO.	SHEET NO.	TOTAL SHEETS
VIII	COLORADO	C16-0012-01	2	

TYPICAL SECTION

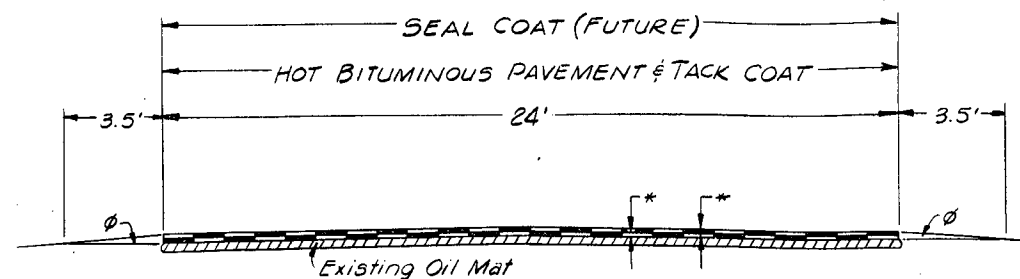

* Material shall be placed in separate courses at the following rates per 100 lin. ft. of roadway:

STATION	REQUIREMENTS	TONS/STA. EA. LAYER
20+10 to 80+00	2 Layers @ 1 1/2" thick	22
80+00 to 165+00	3 Layers @ 1 1/2" thick	22
165+00 to 385+00	2 Layers @ 1 1/2" thick	22
385+00 to 455+29.2	1 Layer @ 2" thick	29

φ Shoulder Material 6 Tons (A.B.C. Cl. G)

STRUCTURE REQUIREMENTS

225+40 - Remove Headwalls,
 Req'd. Extend 6' x 7' C.B.C.
 5' Lt. & 3' Rt. with Wingwalls
 (4:1) Provide 9" Floor Slab
 in Existing C.B.C. as directed

~~Struct. Exc. = 42 Cu. Yd.
 Struct. BxL = 112 Cu. Yd.
 Conc. Cl. A (Box Cul.) = 34.4 Cu. Yd.
 Rein. Steel = 2,512 Lbs.
 Removal of Headwall - 2~~

Deleted by W.D. # 03333
 Does not Delete Remove Headwalls

Req'd Delineators throughout
 Project as directed.

Delineator Type I - 94
 Delineator Type III - 6

GENERAL NOTES

For Preliminary Plan quantities of Bituminous Materials the following rates of application were used:

Tack Coat (CSS-1H) ^{0.02} 0.10 Gal. per Sq. Yd.

Diluted Emulsified Asphalt for Tack Coat shall consist of 1 part Emulsified Asphalt and 1 part water.

Rates of application shall be as determined by the Engineer at the time of application.

Any layer of bituminous pavement that is to have a succeeding layer placed thereon shall be completed full width before succeeding layer is placed.

A Ski-type device at least 30 feet in length and short ski or short shoe shall be furnished with each bituminous paver.

Road Approaches which require bituminous pavement shall be tack coated and a 2" thickness of pavement placed as follows:

Public approaches and entrances to buildings or residences shall be paved 50 ft. out from edge of shoulder or to the Right-of-Way line whichever is less. Field entrances shall be paved 4 ft. out from edge of shoulder.

It is estimated that 600 Hours of Flagging for controlling traffic will be required for this project.

Delineators will be removed by State Forces.

It is estimated that 20 Hours of Blading will be required for this Project as directed by the Engineer.

SUMMARY OF APPROXIMATE QUANTITIES

AS CONSTRUCTED
REVISED DATE 10/24/73

FEDERAL ROAD REGION NO.	DIVISION	PROJ. NO.	SHEET NO.	TOTAL SHEETS
VIII	COLORADO	C16-0012-01	3	

INDEX			CONTRACT ITEM NO.	CONTRACT ITEM	UNIT										W. O. Numbers		PROJECT TOTALS Plan	PROJECT TOTALS FINAL	diff.	%
BOOK	PAGE	SHEET																		
DOH 305	1		202	Removal of Headwall	Each												2	2	0	
Cross Sect.		8 EX	203	Stripping	Cu. Yd.												3,200	2516	-684	-21
DOH 305	3		203	Blading	Hour												20	20	0	
		4	204	Haul	Ton Mi.												54,600	53,527	-1073	-2
			206	Structure Excavation	Cu. Yd.									03333			50	0	-50	-100
			206	Structure Backfill (Cl. 2)	Cu. Yd.									03333			120	0	-120	-100
		4	210	Reset Guard Rail Type 3	Lin. Ft.												63	50	-13	-21
		4	304	Aggregate Base Course (Cl. G)	Ton												2,700	2861.55	+161.55	+6
		4	403	Hot Bituminous Pavement (Grading E) (Hydrated Lime)	Ton												22,500	21,645.70	-854.30	-4
DOH 305	10		411	Asphalt Cement (AC-5)	Ton												1,420	1449.28	+29.28	+2
DOH 305	11		411	Emulsified Asphalt (CSS-1H)	Gal.												11,600	1950	-9650	-83
			601	Concrete Class A (Box Culvert)	Cu. Yd.									03333			35	0	-35	-100
			602	Reinforcing Steel	Lb.									03333			2,514	0	-2514	-100
		4	606	Guard Rail Type 3 (6'-3" Spacing)	Lin. Ft.												1,475	1513	+38	+3
		4	606	End Anchor Type 3 A	Each												12	18	+6	+50
DOH 305	16		612	Delineator Type I	Each												94	94	0	
DOH 305	17		612	Delineator Type III	Each												6	6	0	
DOH 305	18		614	Flagging	Hour												600	544	-56	-9
DOH 305	19		620	Field Laboratory	Each												1	1	0	
DOH 305	20		620	Sanitary Facility	Each												1	1	0	
			626	Mobilization	L.S.												•	•		
				<u>FORCE ACCOUNT</u>																
				Excavate Base Failures	L.S.									03332			•	•		
				Channel Change, Plug C.B.C., Install 60'x20' CSP	L.S.									03333			•	•		
				<u>STATE FORCES</u>																
				Striping	L.S.												•	•		

FINAL SURFACING PLAN *Ref. Envelopes with white scale tickets*

3 CONSTRUCTED
REVISED DATE 10/24/73

FEDERAL ROAD REGION NO.	DIVISION	PROJ. NO.	SHEET NO.	TOTAL SHEETS
III	COLORADO	CIG-0012-01	4	

STATION	SOURCE	TONS								HAUL-TON MILE							
		AGGREGATE BASE COURSE CLASS G		HOT BITUMINOUS PAVEMENT-GRADING E				AGGREGATE BASE COURSE CLASS G		HOT BITUMINOUS PAVEMENT-GRADING E							
		Plan	Final	BOTTOM LAYER		MIDDLE LAYER		TOP LAYER		Plan	Final	BOTTOM LAYER		MIDDLE LAYER		TOP LAYER	
20+10 to 80+00	Geomer Pit	360	426.10	1318	1358.85	1699	1535.20	1699	1639.25	803	950	2,939	3030	1,582	1,429	1,582	4708
80+00 to 157+20		464	611.15	1,699	2,037.70	1,699	1,535.20	1,699	1,639.25	432	569	1,582	1,897	1,582	1,429	1,582	1526
157+20 to 165+00		47	81.65	172	232.50	172	189.70	172	178.20	13	22	48	64	48	52	48	49
165+00 to 385+00		1,320	1,742.65	4,840	4,833.00				4,840	3,209	4,237	11,767	11,749	11,767	11,767	12,598	
402+62 to 455+29.2		317	*						1,532	1,590	*				7,682	8,946	
Appr. to Proj.		50	*	527	562.95					102	*	1,072	1,701				
From Tab. of Rd. Appr.		122	*	473	*					248	*	962	*				
Leveling Course				903	*	187	*	945	*			1,837	*	381	*	1,923	*
Project Totals		2,680	2,861.55	9,932	3,025.00	2,058	1,724.90	10,506	10,825.80	6,397	5,778	20,207	18,441	2,011	1,481	25,941	27,827


* Quantities included with Roadway Tabulation

FINAL GUARD RAIL TYPE 3 *Ref. Book 1 Pg. 10 & 11*

STATION	SIDE	GUARD RAIL TYPE 3		RESET GUARD RAIL TYPE 3		END ANCHORAGE TYPE 3-A	
		Plan	Final	Plan	Final	Plan	Final
53+26 to 54+76 ^φ	Rt.	150	150			+	1
54+01 to 54+76 ^φ	Lt.	75	75			+	1
55+05.5 ^φ to 55+80.5	Rt.	75	50			+	1
55+05.5 ^φ to 56+55.5	Lt.	150	100			+	1
222+85.3 to 224+60.3 ^φ	Lt.	175	88			+	1
223+10.3 to 224+60.3 ^φ	Rt.	150	137			+	1
224+96.5 ^φ to 226+21.5	Rt.	125	125			+	3
224+96.5 ^φ to 226+21.5	Lt.	125	125			+	1
445+14.9 to 446+64.9*	Rt.	150	150			+	1
445+89.9 to 446+64.9*	Lt.	75	75			+	1
*446+64.9 to *446+96.3	Rt.			31.4	25		
*446+64.9 to *446+96.3	Lt.			31.4	25		
446+96.3* to 447+71.3	Rt.	75	63			+	1
446+96.3* to 448+46.3	Lt.	150	150			+	1
212+26 to 213+50	Rt.						2
212+50 to 213+50	Lt.						2
Project Total		1475	1513	62.8	50	12	18

^φ Connect to Existing Bridge Rail (Detail on Sheet No. 6).

* Existing Bridge: Structure No. 0-16-A.
Guard Rail on Existing Bridge shall be blocked out with 6"x8"x14" Timber Blocks (Estimated 10 Blocks Required) bolted to the Existing Posts (See Standard M-606-AB). Terminal Sections on Ends of Existing Bridge Rail shall be removed and new approach Guard Rail shall be connected to the Existing Bridge Rail.
Blocks, Bolts and all work necessary to accomplish the above shall be Included in the Bid Price for Item 210 "Reset Guard Rail, Type 3."
See Typical Guard Rail Flares and Table on Sheet No. 6.
Post Spacing for Guard Rail shall be 6' 3".

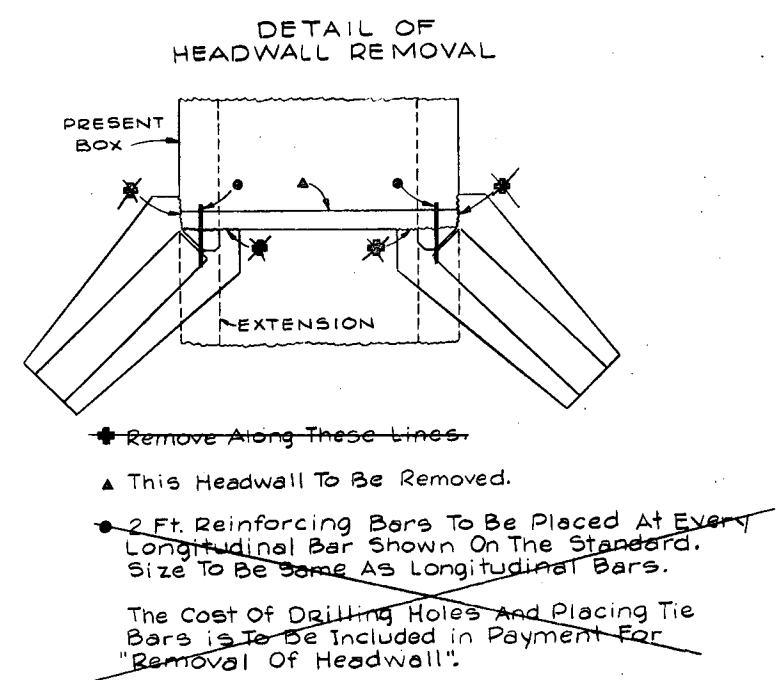

TABULATION OF ROAD APPROACHES

STATION	SIDE	AGGREGATE BASE COURSE CLASS G	TONS	
			HOT BITUMINOUS PAVMT. GRADING E	Final
92+30	Rt.		40	
93+10	Lt.		2	
100+43	Rt.		10	
105+74	Lt.		10	
115+50	Rt.		10	
115+95	Lt.		15	
118+90	Lt.		2	
103+60	Lt.		20	
132+05	Rt.		2	
133+60	Lt. & Rt.		6	
158+10	Rt.		4	
160+25	Lt.		2	
169+00	Lt.		2	
173+00	Lt.		5	
179+00	Rt.		20	
186+20	Rt.		2	
190+30	Lt.	25	25	
192+95	Rt.		2	
194+05	Lt.		4	
203+30	Lt.		2	
210+50	Rt.		4	
218+05	Lt.		2	
220+00	Lt.		30	
220+50	Lt.		2	
223+70	Lt.		20	
225+70	Lt.		2	
227+50	Rt.		2	
229+60	Lt.		2	
236+00	Lt.		2	
246+20	Rt.		2	
252+75	Lt.		2	
257+10	Rt.	40	40	
260+10	Rt.		4	
261+10	Lt.		40	
269+50	Rt.		40	
289+50	Lt.		2	
302+60	Lt.		10	
303+85	Rt.		5	
318+00	Lt.		2	
336+	Lt.	40	40	
348+10	Rt.		2	
351+80	Lt.		2	
368+60	Rt.		5	
369+95	Lt.		2	
370+95	Rt.		7	
378+00	Rt.		2	
385+	Lt. & Rt.		7	
431+15	Rt.	17	8	
Project Totals^φ		122	473	

^φ Quantities taken to Surfacing Plan.
Also includes Approaches between Sta. 20+10 ~ 92+30 and Sta. 431+15 ~ 455+29.2

PIT SKETCH

AS CONSTRUCTED
 REVISED DATE 10/24/73

FEDERAL ROAD REGION NO.	DIVISION	PROJ. NO.	SHEET NO.	TOTAL SHEETS
XIII	COLORADO	C16-0012-01	5	

PIT NO. 1

Owner: J. Curtis and L. Otto Goemmer
 Box 212, La Veta, Colo. 81055



LOCATION: SW 1/4 SE 1/4 & SE 1/4 SW 1/4, Sec. 32, T. 29 S. R. 68 W.

USE: Base Course and Bituminous Pavement

QUANTITY AVAILABLE: Ample


HAUL DISTANCE: 0.2 Mi. to Sta. 157+20 1250

STRIPPING: Removing Overburden = 1,600 Cu. Yds.
 Replacing Overburden = 1,250

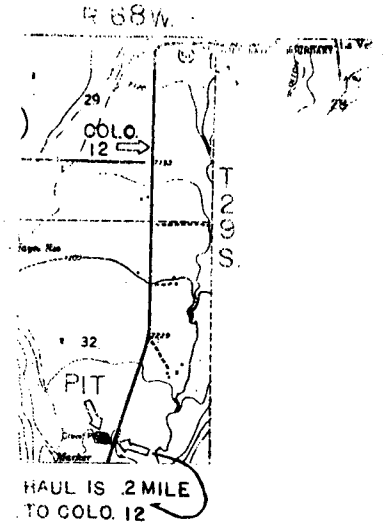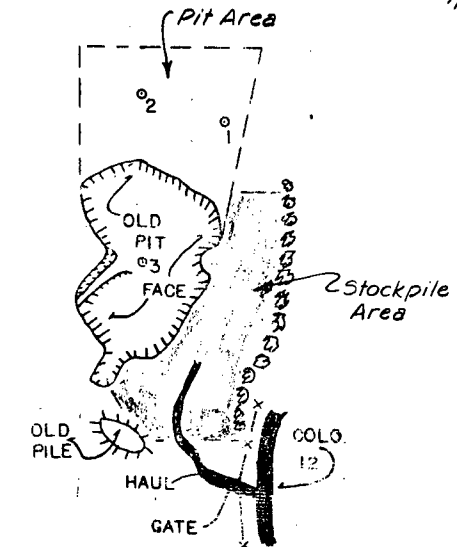

LOG OF PIT

Sample No. 1763 (Proj. No. M02-0004-73)


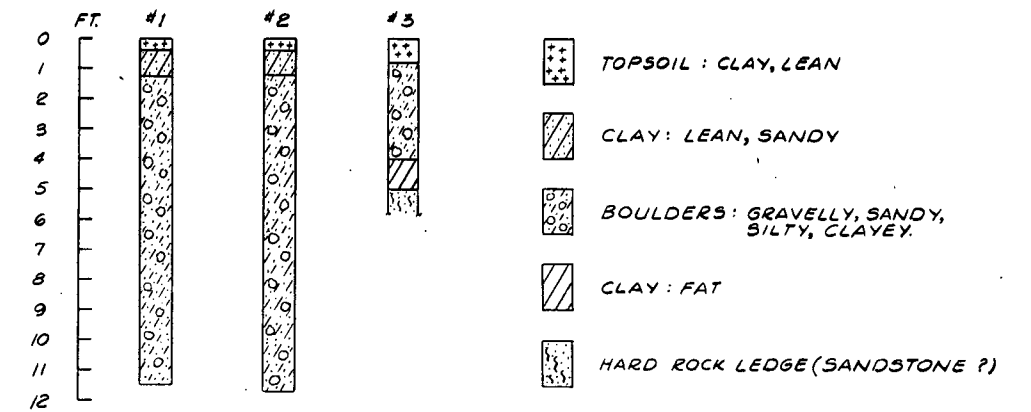


Depth of Water Table: 11.5'
 Date of Test: May 8, 1973

AS CONSTRUCTED
 NO REVISIONS DATE 10/24/73

FEDERAL ROAD REGION NO.	DISTRICT	PROJ. NO.	SHEET NO.	TOTAL SHEETS
8111	COLORADO	C16-0012-01	6	

REVISIONS	

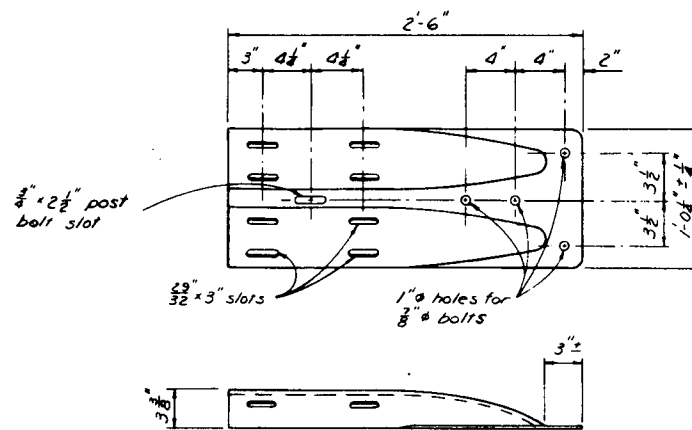
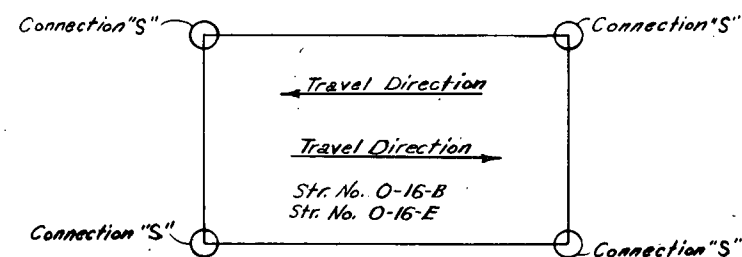


SPECIAL END SHOE
 8-REQ'D


TABLE OF OFFSETS
 FOR 75' & 150' PARABOLIC
 FLARES

X	Y For W=8'	
	L=75'	L=150'
12'-0"	0.22'	0.06'
25'-0"	0.89'	0.22'
37'-6"	2.00'	0.50'
50'-0"	3.56'	0.89'
62'-6"	5.56'	1.39'
75'-0"	8.00'	2.00'
87'-6"		2.72'
100'-0"		3.56'
112'-6"		4.50'
125'-0"		5.56'
137'-6"		6.73'
150'-0"		8.00'

TYPICAL GUARD RAIL FLARES

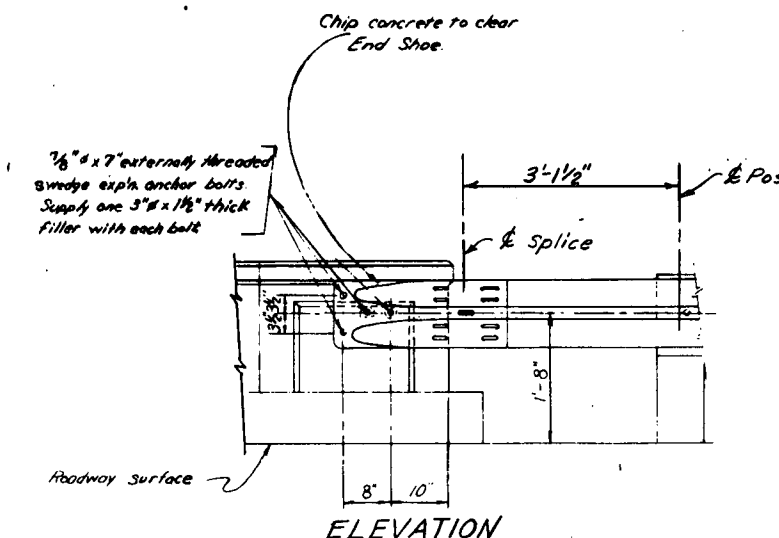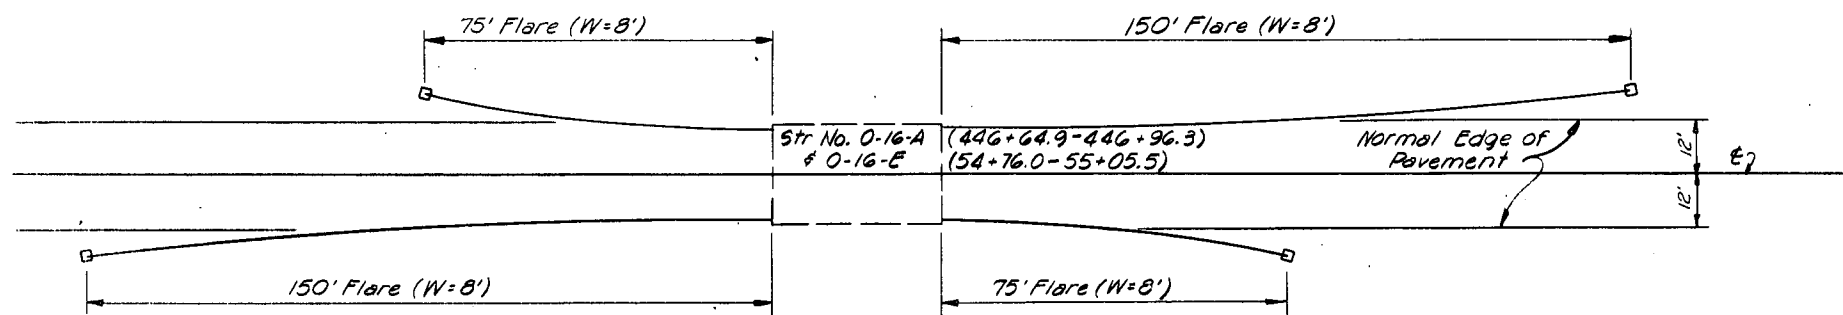

GUARD RAIL CONNECTION "S"
 Req'd. B

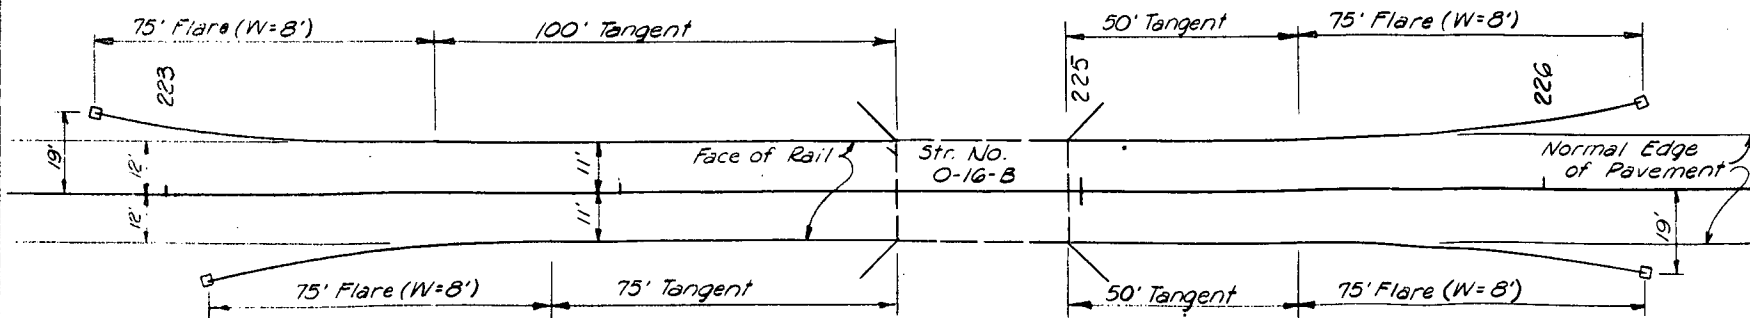

Gen. Notes
 For additional details of guard rail and its installation not shown on these sheets see Std. M-606-AB.
 All work necessary to accomplish the above shall be included in the bid price for Item No. 606, Guard Rail Type 3.
 The special end shoe shall be 10 ga. steel and galvanized in accordance with ASTM Designation: A93 or A123 with coating class 2.50.

DIVISION OF HIGHWAYS

GUARD RAIL (TYPE 3)
 CONNECTION TO
 EXISTING STRUCTURE

Approved: _____ Designer: D. Shosky
 Bridge Engineer: _____ Structures: O-16-B, O-16-E
 Date: _____ DWG. No. 8 / OF 1


STANDARD M-206-AA

(MARCH 1, 1971)
(SHEET 1 OF 2)

FED. ROAD REGION NO.	DIVISION	PROJECT NO.	SHEET NO.
VIII	COLO.		


REVISION			
(R-1)	2-16-72	CBC, Abut., Walls.	MRH

CONCRETE BOX CULVERTS & WINGWALLS

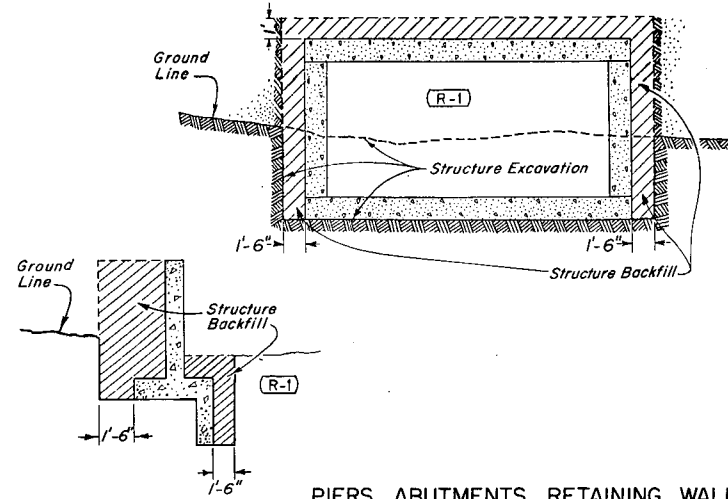


PIERS, ABUTMENTS, RETAINING WALLS ETC.


CAST IN PLACE CONDUIT

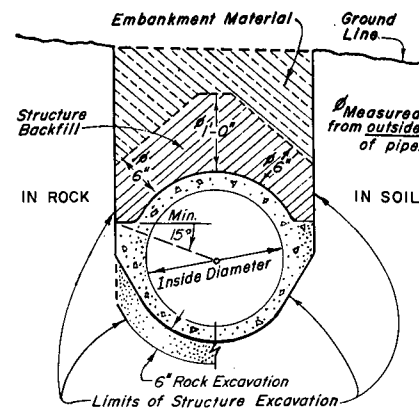


CIRCULAR CONDUIT

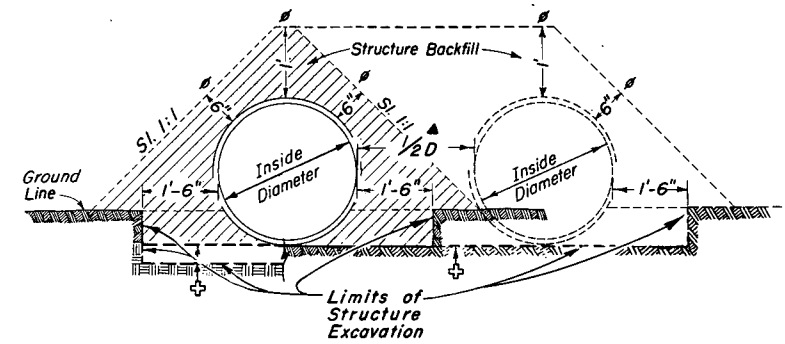

ELLIPTICAL OR ARCH CONDUIT

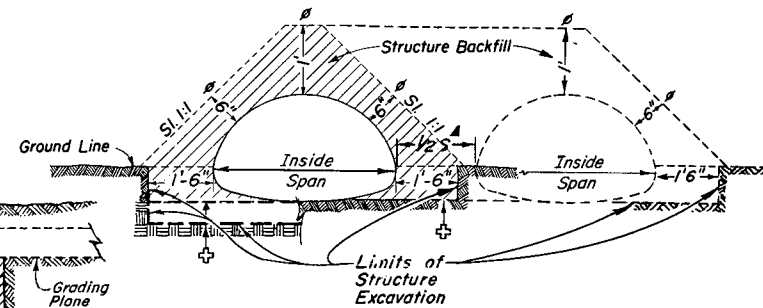

SIPHONS OR CONDUIT IN TRENCH

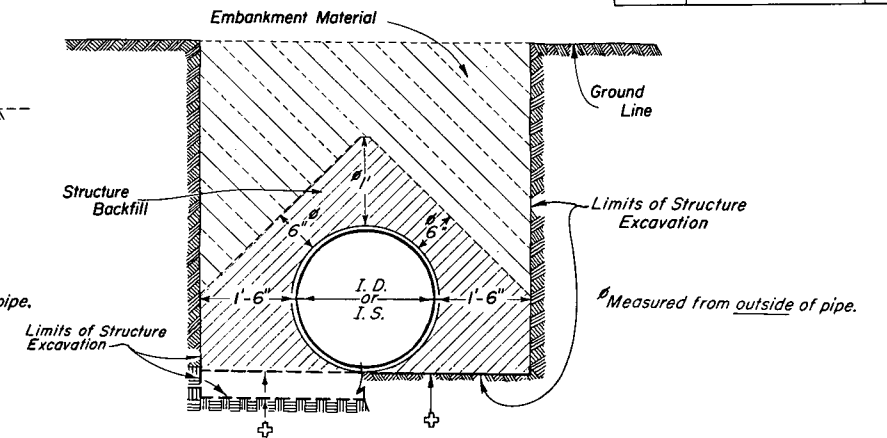

NOTES:

▲ When two or more conduits are laid side by side they shall be spaced so that the adjacent pipes will be $\frac{1}{2}$ I.D., $\frac{1}{2}$ I.S. or 3 feet apart (including wall thickness), whichever is less. Minimum spacing shall be not less than 1 foot between outside walls of pipe.
For additional conduit installation details see M Standards for metal, concrete, or structural plate pipe culverts.

✦ Bottom of trench as excavated. For applicable limits of Structure Excavation, see bedding details on standards for culverts.

GENERAL NOTES

All work shall be done according to the Standard Specifications applicable to the Project.


Where the roadway cross section is in fill, excavation for concrete footings (except those in rock or those on piles) and for box culverts shall be done according to the following:

Embankment shall be built up and compacted to a point one foot above the bottom of the box or one foot above the bottom of the footing. The trench shall then be excavated to accommodate construction of the box or footing.


Excavation and backfill patterns different from those indicated on these sheets will be shown elsewhere on the plans.

Excavation for structure installation shall be classified as "Structure Excavation" unless otherwise shown on plans.


All material that is to be compacted shall be placed in horizontal layers not more than 6" inches in depth and compacted before the next layer is placed. For Arches, Rigid Frames and Box Culverts the fill shall be brought up uniformly on both sides of the center of structure to avoid stresses in the structure caused by unsymmetrical loading.

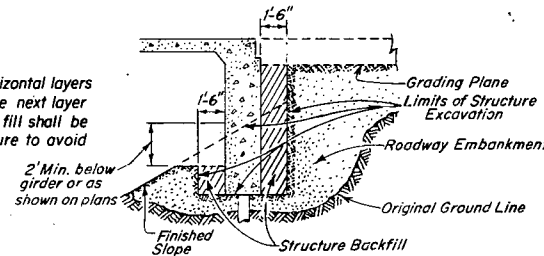

ABUTMENT IN EMBANKMENT

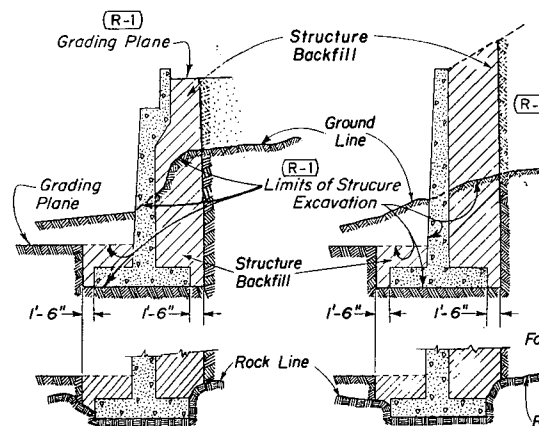


ABUTMENT IN ORIGINAL GROUND

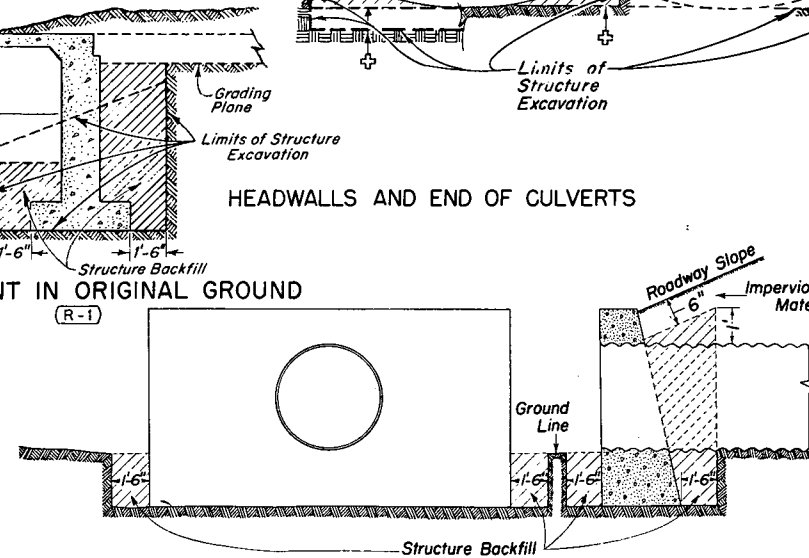


HEADWALLS AND END OF CULVERTS

DROP INLETS, DIVISION BOXES, INTERCEPTING HEADWALLS, ETC.

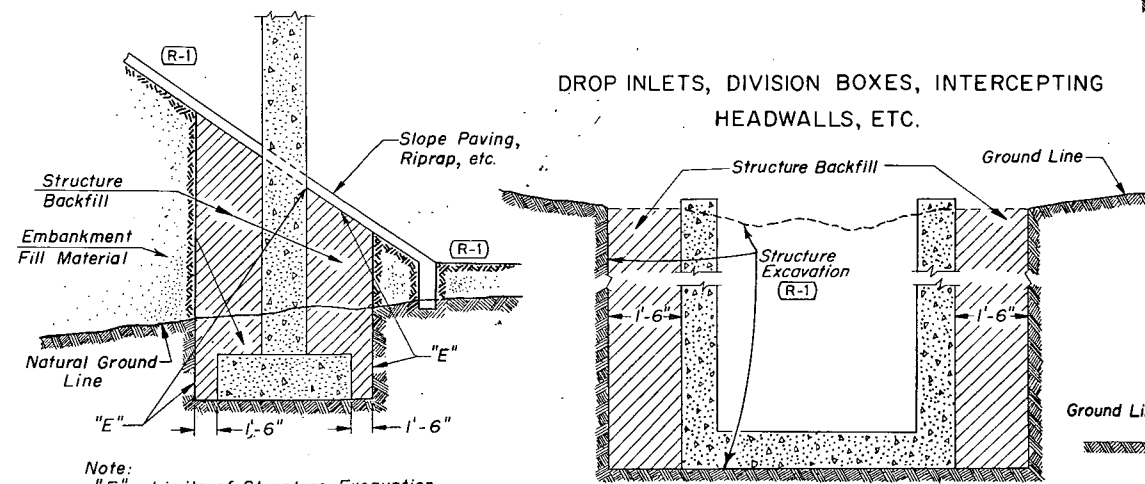

Note: "E" = Limits of Structure Excavation

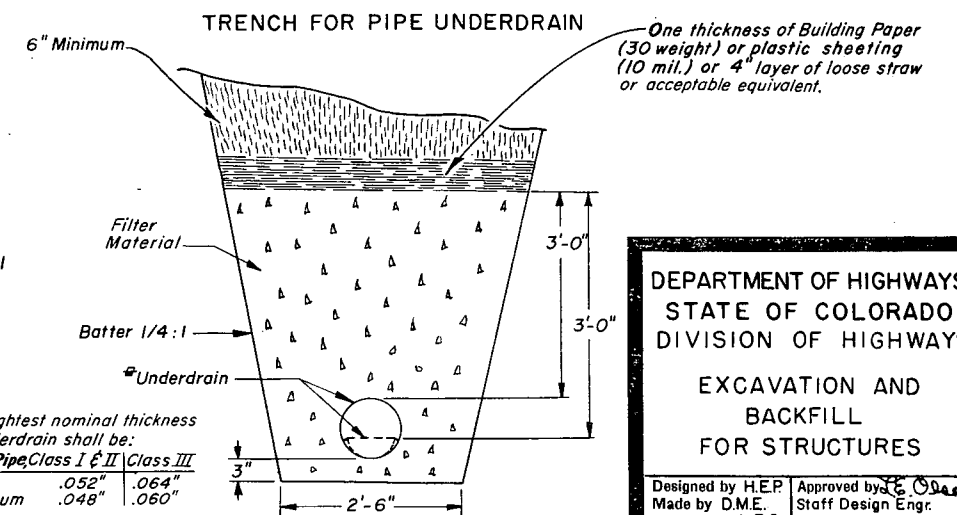

The lightest nominal thickness for underdrain shall be:
Type III Pipe, Class I & II Class III
Steel .052" .064"
Aluminum .048" .060"

DEPARTMENT OF HIGHWAYS
STATE OF COLORADO
DIVISION OF HIGHWAYS
EXCAVATION AND
BACKFILL
FOR STRUCTURES

Designed by H.E.P. Approved by E. Olson
Made by D.M.E. Staff Design Engr.
Checked by L.E.O. Date: March 1, 1971


STANDARD M-206-AA

(MARCH 1, 1971)
(SHEET 2)


FEDERAL ROAD REGION NO.	DIVISION	PROJ. NO.	SHEET NO.	TOTAL SHEETS
VIII	COLORADO			

REVISIONS:			
(R-1)	2-16-72	Revision date only.	M.R.H.



STRUCTURE EXCAVATION MEASUREMENT FOR PIPE CULVERTS

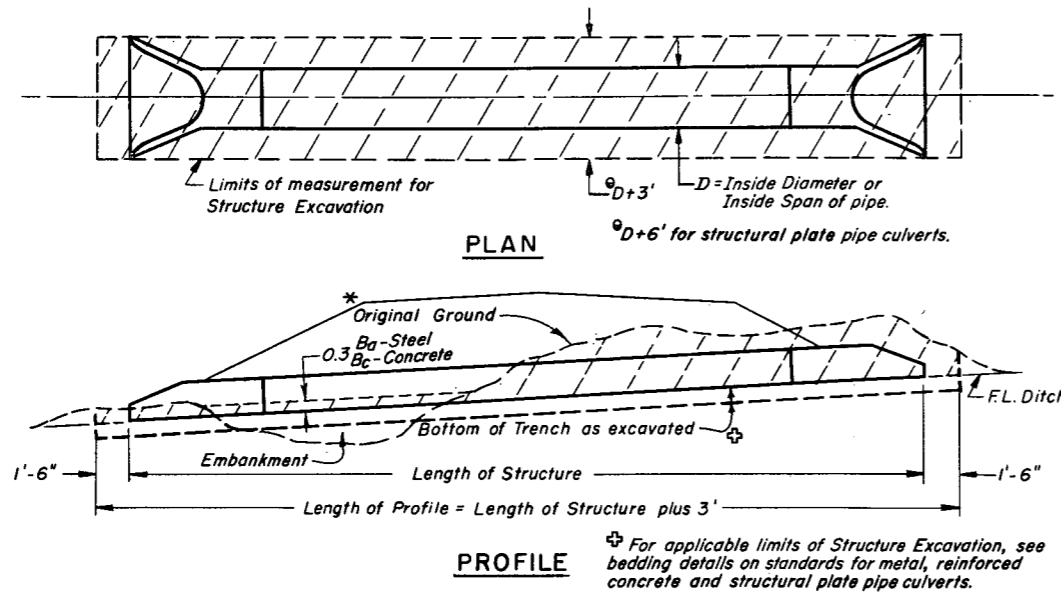

STRUCTURE EXCAVATION MEASUREMENT FOR CONCRETE BOX CULVERTS

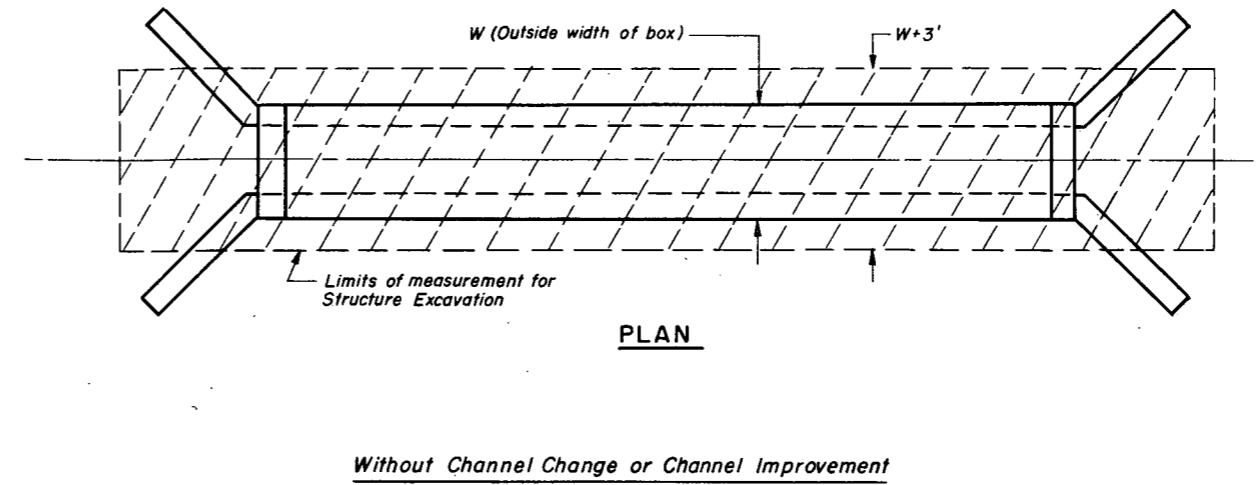

STRUCTURE EXCAVATION MEASUREMENT FOR DIVERSION OR DIVISION BOXES

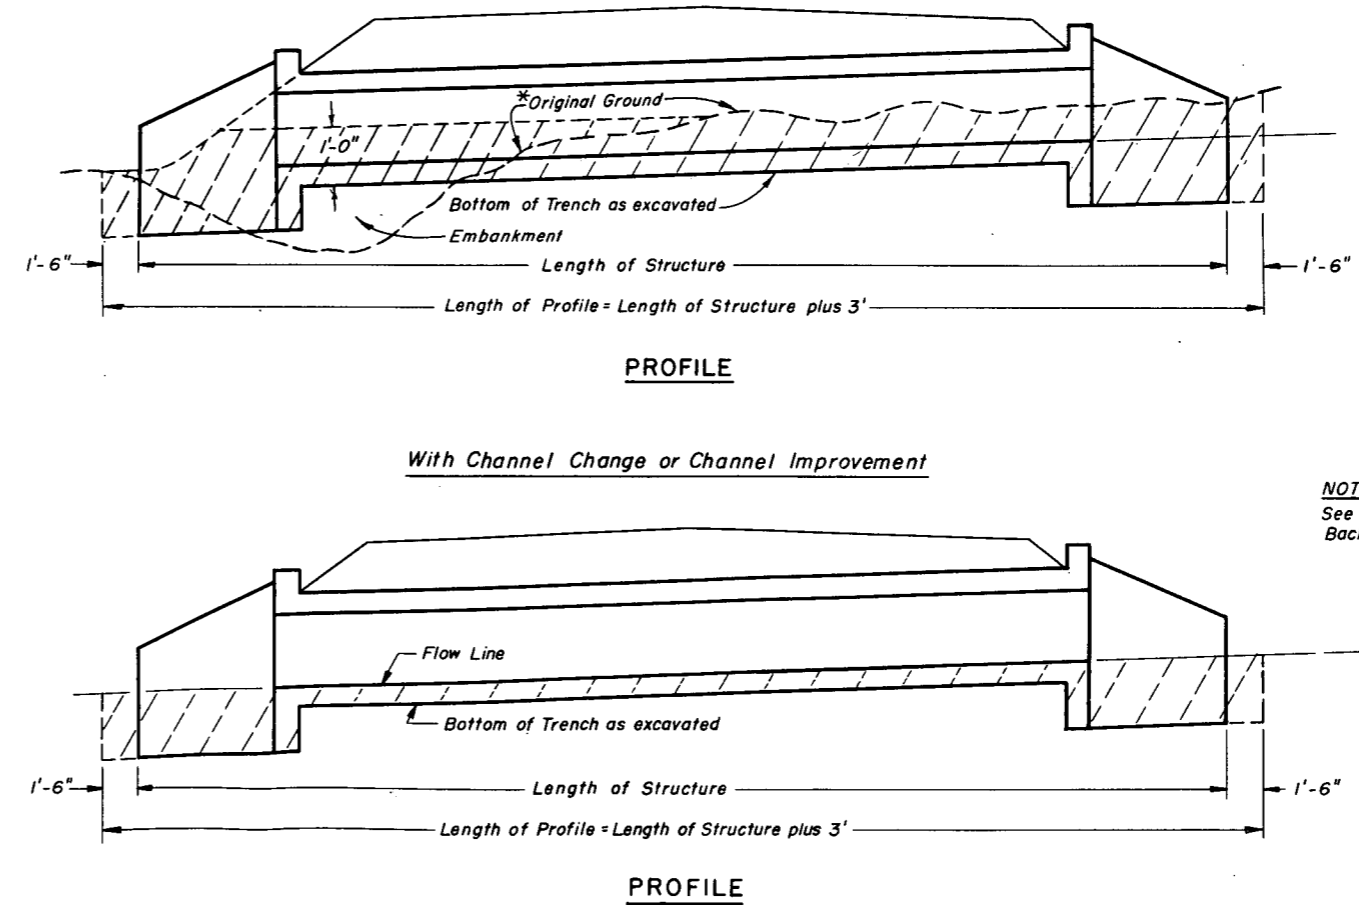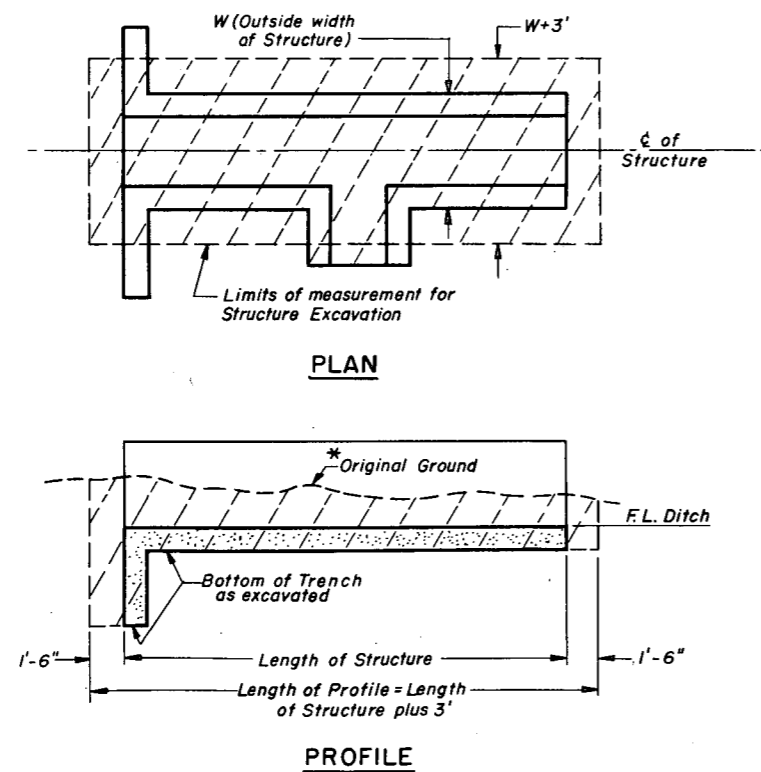

NOTE:
See Sheet 1 for General Notes and Backfilling Details.

* Along C of Structure

Areas to be used for Structure Excavation computations.

DEPARTMENT OF HIGHWAYS
STATE OF COLORADO
DIVISION OF HIGHWAYS

EXCAVATION AND BACKFILL FOR STRUCTURES

Designed by: M.R.H. Approved by: *[Signature]*
Made by: H.P.B. Staff Design Engr.
Checked by: Date: March 1, 1971

STANDARD M-500-A

(JULY 1, 1965)

FED. ROAD REG. NO.	DIVISION	PROJECT NO.	SHEET NO.
9	COLO.		

1 2 3 4 5 6 7 8 9 0.


A B C D E F G H I J K L

M N O P Q R S T U V W


a f g l J 14 K 1 9 5 0

Scale in inches
0 1 2 3


abcdefghijklmnopqrstuvwxyz

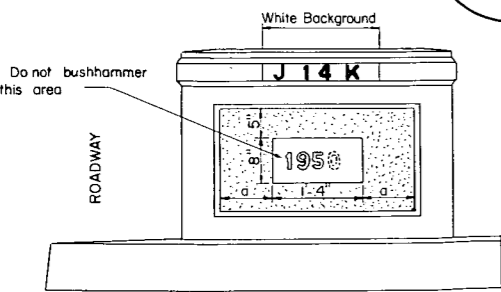


TYPICAL FOR CONCRETE END POST

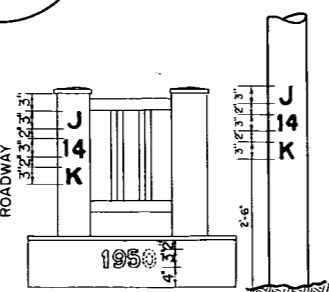

TYPICAL FOR STEEL HANDRAIL END POST

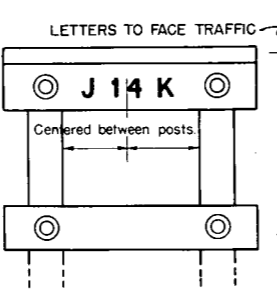

TYPICAL FOR TIMBER WING HANDRAIL

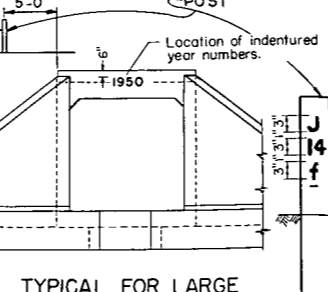

TYPICAL FOR LARGE BOX CULVERTS & STRUCTURES WITHOUT END POSTS

SAMPLE BRIDGE NUMBER

GENERAL NOTES

SAMPLE YEAR NUMBER

ALL WORK SHALL BE DONE IN ACCORDANCE WITH THE STANDARD SPECIFICATIONS APPLICABLE TO THE PROJECT. THE SIZE, SHAPE AND SPACING OF THE LETTERS AND FIGURES SHALL BE IN ACCORDANCE WITH THE FULL SIZE SHOWN ON THIS SHEET. ADDITIONAL COPIES OF THIS FULL SIZE SHEET CAN BE OBTAINED FROM THE DEPARTMENT WITHOUT CHARGE.

THE YEAR NUMBERS ARE RECESSED IN CONCRETE 3/8" MINIMUM AS SHOWN INTO THE PANEL OF THE ENDPOST ON THE RIGHT HAND SIDE OF EACH BRIDGE END AND INTO THE FACE OF THE DOWNSTREAM HEADWALL OF CULVERTS AS SHOWN ON PLAN DETAILS. NUMBERS TO BE MADE OF WOOD, METAL OR OTHER SUITABLE MATERIAL AND ATTACHED TO THE FORMS BEFORE CONCRETE IS POURED. THE YEAR NUMBER OF EACH STRUCTURE SHALL CORRESPOND WITH THE YEAR IN WHICH THE CONCRETE IS POURED.

THE STRUCTURE NUMBER SHALL BE STENCILED ON THE RIGHT HAND SIDE OF EACH BRIDGE END AS SHOWN ON THIS STANDARD AND AS SPECIFIED, WHERE THE STRUCTURE HAS NO END POSTS THE NUMBER SHALL BE PLACED ON A POST ON THE RIGHT HAND SIDE OF THE ROAD AS SHOWN. FOR SIGNS THE NUMBER SHALL BE PLACED ON SIGN POSTS ON THE RIGHT HAND SIDE OF THE ROADWAY.

THE CORRECT NUMBER FOR EACH BRIDGE OR SIGN IS SHOWN ON THE PLANS.

THE NUMBERS FOR MAJOR STRUCTURES OF OVER 20 FEET CLEAR SPAN SHALL BE UPPER CASE LETTERS. THE NUMBERS FOR MINOR STRUCTURES OF 12 TO 20 FEET CLEAR SPAN SHALL BE LOWER CASE LETTERS. SIGN BRIDGES SHALL BE CONSIDERED AS MAJOR STRUCTURES.

A PROPER WHITE BACKGROUND RECTANGULAR IN SHAPE AND EXTENDING THREE INCHES BEYOND THE LIMITS OF THE NUMBER SHALL BE PAINTED WITH TWO COATS OF ACCEPTABLE WHITE PAINT UNLESS AN APPROVED WHITE CONCRETE PAINT IS USED. BEFORE PAINTING THE SURFACE MUST BE THOROUGHLY DRIED, CLEANED AND PROPERLY SIZED ON TIMBER HANDRAILS. THE WHITE PAINT USED ON THE BRIDGE WILL BE SATISFACTORY.

AFTER THE WHITE BACKGROUND HAS DRIED SUFFICIENTLY, THE CORRECT STRUCTURE NUMBER SHALL BE CAREFULLY STENCILED WITH "EXTERIOR BLACK PAINT" AS SPECIFIED IN SECTION 708 - PAINTS, OR AN ACCEPTABLE EQUIVALENT. THE BRACES OF THE STENCILED LETTERS AND FIGURES SHALL BE CAREFULLY FILLED IN BY HAND TO MAKE SOLID FIGURES.

SUFFICIENT TIME BETWEEN SUCCESSIVE COATS SHALL BE ALLOWED TO PERMIT THORO DRYING.

THE COST OF PAINTING OF STRUCTURE NUMBERS AND FURNISHING AND PLACING POSTS FOR STRUCTURE NUMBERS SHALL BE CONSIDERED SUBSIDIARY WORK AND SHALL BE INCLUDED IN THE ORIGINAL CONTRACT ITEMS AND WILL NOT PAID FOR AS SEPARATE ITEMS.

THE LENGTH OF SPAN OF STRUCTURE SHALL BE MEASURED ALONG CENTER LINE OF ROADWAY. IN CASE OF DOUBLE OR MULTIPLE BOX CULVERTS THE CENTER WALL OR WALLS SHALL BE DISREGARDED AND CLEAR SPAN MEASURED FROM INSIDE OF END WALLS.

IN ADDITION TO THE REQUIREMENTS STATED ABOVE, STRUCTURE NUMBERS FOR HIGHWAYS, PASSING UNDER CROSSROADS ARE TO BE PLACED AT THE FOLLOWING POINTS:

(A) FOR STRUCTURES OF 3 OR MORE SPANS, THE STRUCTURE NUMBER SHALL BE STENCILED, FACING TRAFFIC, ON THE OUTSIDE FACE OF THE END COLUMN OF THE RIGHT-HAND PIER.

(B) FOR 2-SPAN STRUCTURES, THE STRUCTURE NUMBER SHALL BE STENCILED, FACING TRAFFIC, ON THE OUTSIDE FACE OF EACH END COLUMN IN THE CENTER PIER.

REVISIONS	

DEPARTMENT OF HIGHWAYS
STATE OF COLORADO

LETTERS AND FIGURES
FOR
STRUCTURE NUMBERS

Designed by _____
Made by _____
Checked by _____

Approved by *L. H. Marshall*
Bridge Engineer
Date: July 1, 1965

STRUCTURE NO. _____

STANDARD M-60I-A

(JULY 1, 1965)


FED. ROAD REG. NO.	DIVISION	PROJECT NO.	SHEET NO.
9	COLORADO		

Dimensions & Quantities (see Wingwall Standard for Wings)

Height of Fill Allowed	Type	Span S	Height H	Slab T	Wall W	Bar size & spacing		No. required	Quantities for One Lin. Ft. of Box		Quantities for Two Headwalls	
						V ₁ Size Spacing	V ₂ Size Spacing		Concrete Cu Yds.	Steel Lbs.	Concrete Cu Yds.	Steel Lbs.
35'-0"	2A	2'-0"	2'-0"	6"	8"	3/4"	12"	8	0.232	7.5	1.3	81
30'-0"	3A	3'-0"	3'-0"	7"	8"	3/4"	12"	10	0.299	9.6	1.6	112
20'-0"	4A	4'-0"	4'-0"	8"	8"	3/4"	12"	12	0.362	12.1	1.7	120
16'-0"	5A	5'-0"	5'-0"	8"	8"	3/4"	12"	16	0.461	15.7	2.1	158
20'-0"	5B	5'-0"	5'-0"	8 1/2"	8"	3/4"	12"	16	0.500	16.5	2.2	153
14'-0"	6A	6'-0"	6'-0"	8 1/2"	8"	3/4"	12"	24	0.764	24.1	3.0	188
20'-0"	6B	6'-0"	6'-0"	10"	8"	3/4"	12"	24	0.854	26.1	3.2	184
12'-0"	7A	7'-0"	7'-0"	9"	9"	3/4"	12"	24	0.776	23.5	2.8	212
15'-0"	7B	7'-0"	7'-0"	9"	9"	3/4"	12"	24	0.827	25.3	2.9	202
20'-0"	7C	7'-0"	7'-0"	11"	9"	3/4"	12"	24	0.881	26.0	3.0	203
10'-0"	8A	8'-0"	8'-0"	9 1/2"	10"	3/4"	12"	28	0.966	28.2	3.0	243
16'-0"	8B	8'-0"	8'-0"	11 1/2"	10"	3/4"	12"	28	1.086	32.0	3.0	268
20'-0"	8C	8'-0"	8'-0"	12 1/2"	10"	3/4"	12"	28	1.208	35.5	3.0	282
7'-0"	9A	9'-0"	9'-0"	10"	11"	3/4"	12"	32	1.176	35.0	3.3	331
14'-0"	9B	9'-0"	9'-0"	12"	11"	3/4"	12"	32	1.370	40.7	3.3	338
20'-0"	9C	9'-0"	9'-0"	14"	11"	3/4"	12"	32	1.444	43.0	3.3	344
5'-0"	10A	10'-0"	10'-0"	12"	12"	3/4"	12"	36	1.334	40.0	3.5	388
10'-0"	10B	10'-0"	10'-0"	12"	12"	3/4"	12"	36	1.408	42.0	3.5	378
16'-0"	10C	10'-0"	10'-0"	14"	12"	3/4"	12"	36	1.593	46.0	3.5	426
5'-0"	11A	11'-0"	11'-0"	11"	12"	3/4"	12"	36	1.441	42.5	3.5	387
9'-0"	11B	11'-0"	11'-0"	12 1/2"	12"	3/4"	12"	36	1.564	45.0	3.5	412
13'-0"	11C	11'-0"	11'-0"	14"	12"	3/4"	12"	36	1.725	50.0	3.5	461
5'-0"	12A	12'-0"	12'-0"	12"	12"	3/4"	12"	36	1.525	45.0	3.5	411
10'-0"	12B	12'-0"	12'-0"	14"	12"	3/4"	12"	36	1.772	51.0	3.5	467
4'-0"	13A	13'-0"	13'-0"	12 1/2"	12"	3/4"	12"	40	1.740	50.0	3.5	456
8'-0"	13B	13'-0"	13'-0"	14"	12"	3/4"	12"	40	1.868	53.0	3.5	484
4'-0"	14A	14'-0"	14'-0"	13 1/2"	12"	3/4"	12"	40	1.925	55.0	3.5	502
8'-0"	14B	14'-0"	14'-0"	15"	12"	3/4"	12"	40	2.033	58.0	3.5	529

Quantities for one culvert shall be (quantity for one lin. ft. of box times L) plus (quantity for two head walls) plus (quantities for four wings).
 Note: This design not to be used when height of fill exceeds the allowed amount tabulated.

SINGLE CONCRETE BOX CULVERT

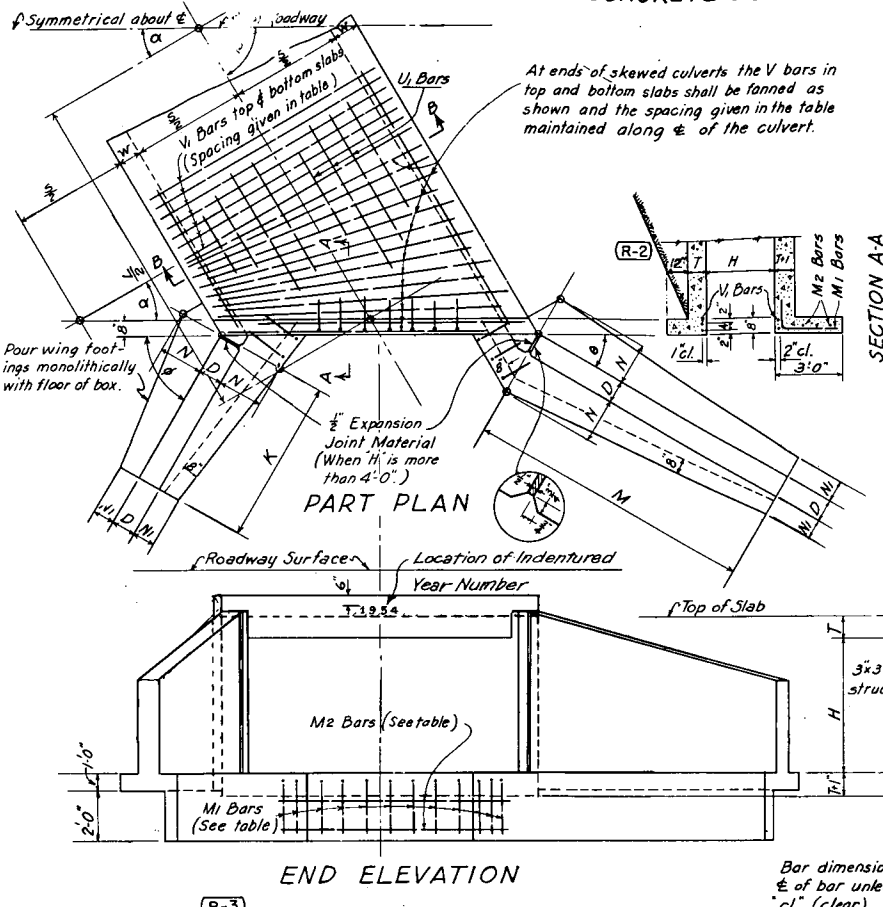

Bar List for Culvert & Headwalls (See Wingwall Standard for Wings)

Mark	Size	No. Req'd	Type	Length
V ₁	See table	10 x 24 L Spacing	I	S+2W+6
V ₂	See table	6 x 24 L Spacing	I	H+2T+5
U ₁	3/4"	See table	I	L+1'0"
M ₁	3/4"	See table	II	3'-6"
M ₂	3/4"	4	I	S+2W+6 Cos α


(Bar dimensions are out to out of bar)

Possible Combinations (Span & Height)

2' x 2'	5' x 5'	9' x 5'	10' x 7'	11' x 8'	11' x 10'
3' x 2'	7' x 4'	8' x 6'	9' x 8'	10' x 9'	14' x 8'
4' x 2'	6' x 5'	7' x 7'	12' x 6'	13' x 7'	13' x 9'
3' x 3'	8' x 4'	9' x 6'	11' x 7'	12' x 8'	12' x 10'
4' x 3'	7' x 5'	8' x 7'	13' x 6'	14' x 7'	14' x 9'
5' x 3'	6' x 6'	10' x 6'	10' x 8'	11' x 9'	13' x 10'
4' x 4'	8' x 5'	9' x 7'	9' x 9'	10' x 10'	10' x 10'
5' x 4'	6' x 7'	8' x 8'	12' x 7'	13' x 8'	14' x 10'
6' x 4'	7' x 6'	11' x 6'	14' x 6'	12' x 9'	

STANDARD M-60I-A

(JULY 1, 1965)

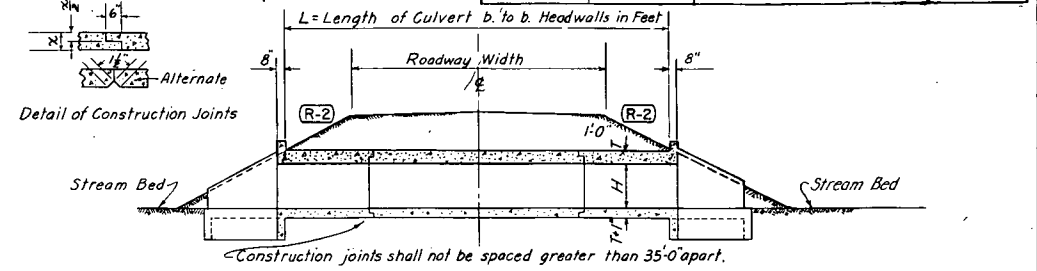

REVISIONS

REVISION	DATE	DEPT. NAME	MR. H.
R-1	7-23-68	Dept. Name	M.R.H.
R-2	10-25-68	Delete Slope	M.R.H.
R-3	5-10-71	Add General Notes	M.R.H.

GENERAL NOTES


All work shall be done in accordance with the Standard Specifications applicable to the project.
 All wing surfaces to receive Class I finish.
 All construction joints shall be thoroughly cleaned before fresh concrete is poured. Secondary bars when spliced shall be given a lap of 24 bar diameters.
 All reinforcing bars shall be tagged with the station number and bar designation.
 All dimensions not shown as clear are to the centerline of the bar.
 All exposed corners on concrete shall be chamfered 3/4".
 All concrete shall be Class A.
 Footings in rock shall be poured out to rock and not formed.
 Note: K, M, N, N₁ and D are dimensioned on Wingwall Standard for the various heights of culverts.

Dimensions & Quantities (see Wingwall Standard for Wings)

Height of Fill Allowed	Type	Span S	Height H	Slab T	Wall W	Bar size & spacing		No. required	Quantities for One Lin. Ft. of Box		Quantities for Two Headwalls	
						V ₁ Size Spacing	V ₂ Size Spacing		Concrete Cu Yds.	Steel Lbs.	Concrete Cu Yds.	Steel Lbs.
10'-0"	6'-6"-A	6'-0"	6'-0"	8"	8"	3/4"	12"	12	1.000	32.0	3.85	327
15'-0"	6'-6"-B	6'-0"	6'-0"	9 1/2"	8"	3/4"	12"	12	1.161	35.0	4.05	337
20'-0"	6'-6"-C	6'-0"	6'-0"	10 1/2"	8"	3/4"	12"	12	1.321	38.0	4.25	347
10'-0"	8'-8"-A	8'-0"	8'-0"	10"	10"	3/4"	12"	12	1.569	44.0	4.50	406
15'-0"	8'-8"-B	8'-0"	8'-0"	11"	10"	3/4"	12"	12	1.729	47.0	4.70	416
20'-0"	8'-8"-C	8'-0"	8'-0"	12 1/2"	10"	3/4"	12"	12	1.889	50.0	4.90	426
5'-0"	10'-10"-A	10'-0"	10'-0"	10"	12"	3/4"	12"	12	1.935	52.0	5.10	436
10'-0"	10'-10"-B	10'-0"	10'-0"	12"	12"	3/4"	12"	12	2.095	55.0	5.30	446
15'-0"	10'-10"-C	10'-0"	10'-0"	14"	12"	3/4"	12"	12	2.255	58.0	5.50	456
5'-0"	12'-12"-A	12'-0"	12'-0"	12"	12"	3/4"	12"	12	2.315	60.0	5.70	466
10'-0"	12'-12"-B	12'-0"	12'-0"	14"	12"	3/4"	12"	12	2.475	63.0	5.90	476
15'-0"	12'-12"-C	12'-0"	12'-0"	16"	12"	3/4"	12"	12	2.635	66.0	6.10	486
5'-0"	14'-14"-A	14'-0"	14'-0"	12"	15"	3/4"	12"	12	2.695	68.0	6.30	496
10'-0"	14'-14"-B	14'-0"	14'-0"	14"	15"	3/4"	12"	12	2.855	71.0	6.50	506


Quantities for one culvert shall be (quantity for one lin. ft. of box times L) plus (quantity for two head walls) plus (quantities for four wings).

DOUBLE CONCRETE BOX CULVERT

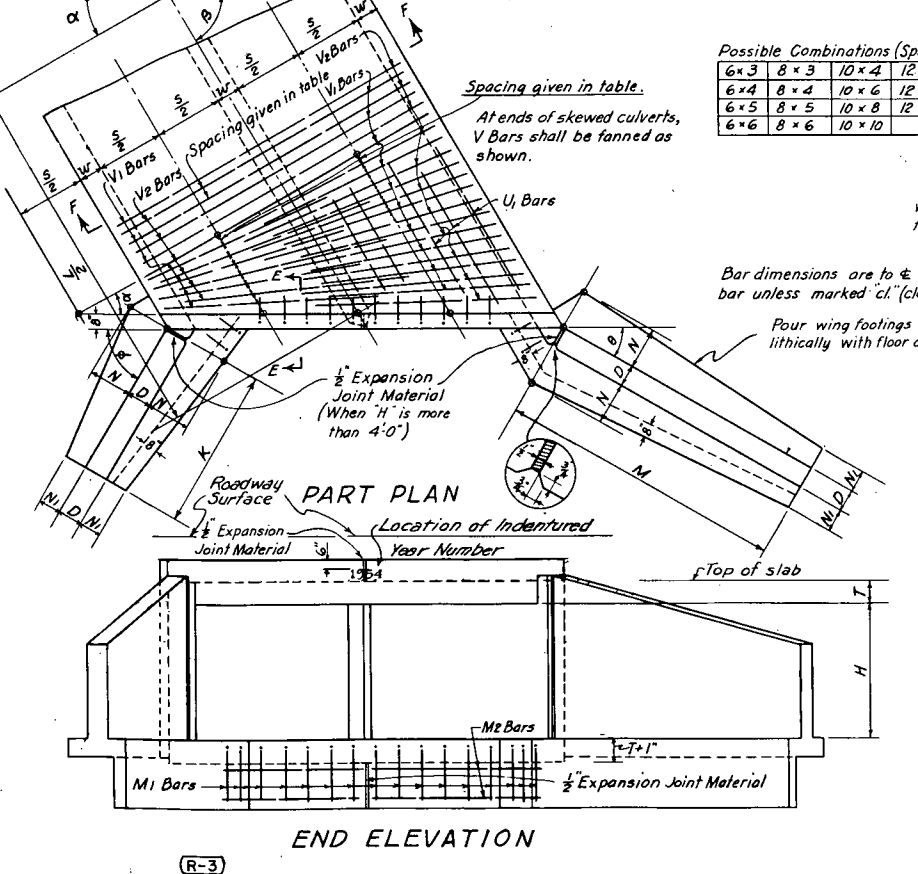

Possible Combinations (Span & Height)

6' x 3'	8' x 3'	10' x 4'	12' x 6'	14' x 6'
6' x 4'	8' x 4'	10' x 6'	12' x 8'	14' x 8'
6' x 5'	8' x 5'	10' x 8'	12' x 10'	14' x 10'
6' x 6'	8' x 6'	10' x 10'	12' x 10'	14' x 10'

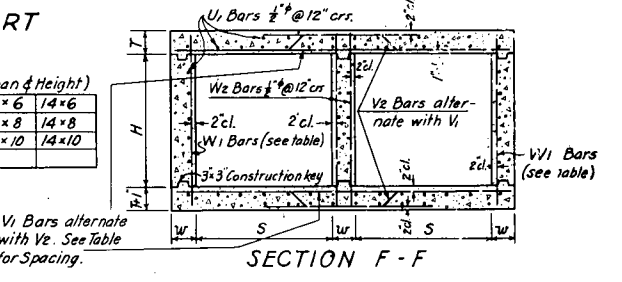

Bar List for Culvert and Two Headwalls (See Wingwall Std. for Wings)

Mark	Size	Number Required	Type	L	Total Length
V ₁	See Table	24(L+2)	I	S+15W+4'	2L+m
V ₂	See Table	12(L+2)	II	H+2T+4'	l
U ₁	3/4"	See Table	I	H+2T+4'	l
M ₁	3/4"	See Table	I	L+12"	l
M ₂	3/4"	8	I	S+15W+4'	l

(Bar dimensions are out to out of bar.)
 For General Notes, Loading and Design Data, see Wingwall Std.

DEPARTMENT OF HIGHWAYS
 STATE OF COLORADO
 DIVISION OF HIGHWAYS

SINGLE AND DOUBLE
 CONCRETE BOX CULVERTS


(FOR SIZES SEE TABLE OF
 POSSIBLE COMBINATIONS)

Designed by: W.W.D. Approved by: J.W. Kneib
 Made by: W.W.D. Bridge Engineer
 Checked by: T.J.M. Date: July 1, 1965

STANDARD M-601-C

(SHEET 1 OF 2 SHEETS)
(JULY 1, 1965)


FED. ROAD REG. NO.	DIVISION	PROJECT. NO.	SHEET NO.
9	COLO.		

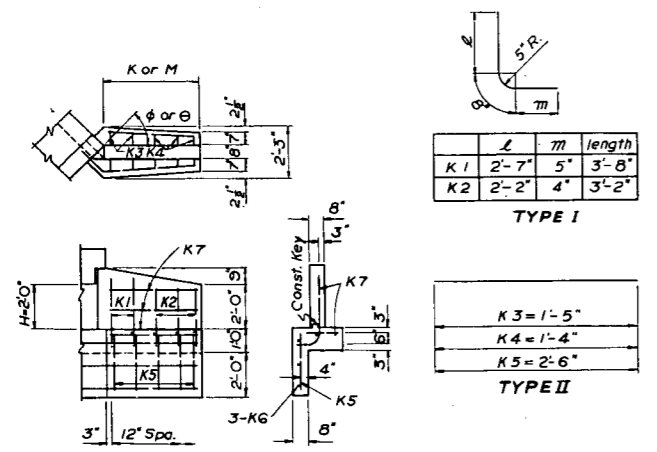

BAR LIST & QUANTITIES FOR ONE WING WHEN H=2'-0"

When φ or θ equals	Number of bars required								Length of bars		Quantities for One Wing	
	K1	K2	K3	K4	K5	3-K6	4-K7	3-K6	4-K7	Concrete Cu.Yd.	Steel Lb.	
22°30'	4	4	4	4	8	9'-10"	7'-8"	1.47	80			
30°	3	3	3	3	6	7'-4"	5'-8"	1.10	59			
37°30'	3	2	3	2	5	6'-1"	4'-8"	0.92	50			
45°	2	3	2	3	5	5'-2"	3'-11"	0.78	45			
52°30'	2	2	2	2	4	5'-1"	3'-5"	0.69	39			
60°	2	2	2	2	4	4'-6"	3'-2"	0.64	37			
67°30'	2	2	2	2	4	4'-0"	2'-11"	0.60	36			


WING DETAIL WHEN H=2'-0"

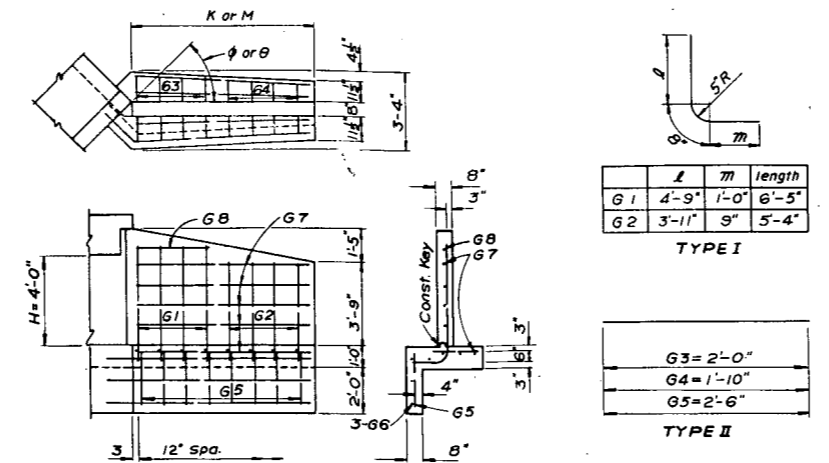

BAR LIST & QUANTITIES FOR ONE WING WHEN H=4'-0"

When φ or θ equals	Number of bars required								Length of bars		Quantities for One Wing	
	G1	G2	G3	G4	G5	3-G6	8-G7	1-G8	3-G6	8-G7	1-G8	Concrete Cu.Yd.
22°30'	6	9	6	9	15	17'-4"	14'-5"	5'-2"	3.97	219		
30°	5	7	5	7	12	13'-2"	10'-11"	4'-2"	3.03	170		
37°30'	4	6	4	6	10	10'-10"	8'-11"	3'-2"	2.49	141		
45°	4	4	4	4	8	9'-4"	7'-8"	3'-2"	2.15	118		
52°30'	3	5	3	5	8	9'-0"	6'-11"	2'-2"	1.95	112		
60°	3	4	3	4	7	7'-10"	6'-2"	2'-2"	1.75	99		
67°30'	3	3	3	3	6	7'-0"	5'-8"	2'-2"	1.61	88		


WING DETAIL WHEN H=4'-0"

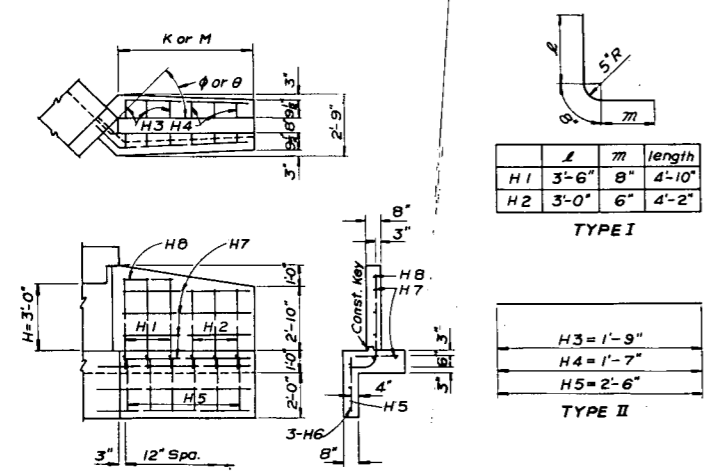

BAR LIST & QUANTITIES FOR ONE WING WHEN H=3'-0"

When φ or θ equals	Number of bars required					Length of bars			Quantities for One Wing	
	H1	H2	H3	H4	H5	3-H6	5-H7	1-H8	Concrete Cu.Yd.	Steel Lb.
22°30'	6	5	6	5	11	13'-2"	10'-8"	5'-2"	2.47	131
30°	5	4	5	4	9	10'-2"	8'-2"	4'-2"	1.91	104
37°30'	4	3	4	3	7	8'-4"	6'-8"	3'-2"	1.57	82
45°	3	3	3	3	6	7'-1"	5'-8"	2'-2"	1.35	70
52°30'	3	3	3	3	6	7'-0"	5'-2"	2'-2"	1.23	68
60°	3	2	3	2	5	6'-2"	4'-8"	2'-2"	1.12	59
67°30'	3	2	3	2	5	5'-4"	4'-2"	2'-2"	1.01	56

WING DETAIL WHEN H=3'-0"

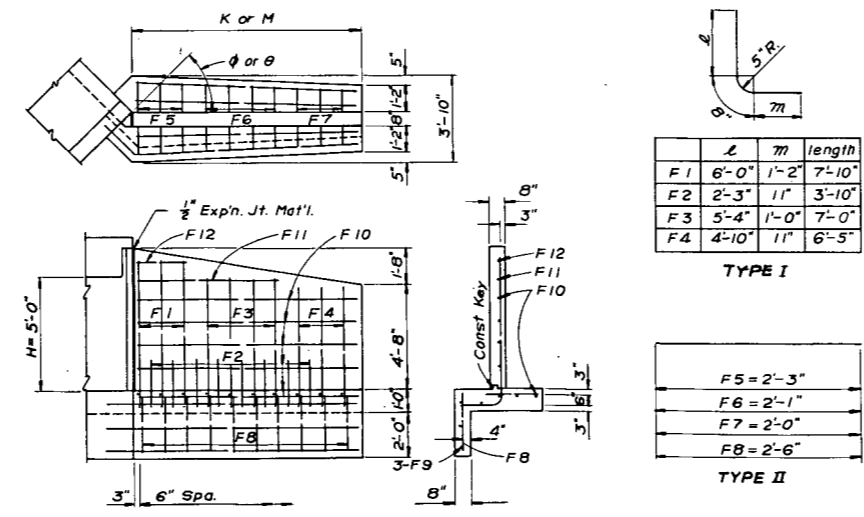

BAR LIST & QUANTITIES FOR ONE WING WHEN H=5'-0"

When φ or θ equals	Number of bars required								Length of bars				Quantities for One Wing	
	F1	F2	F3	F4	F5	F6	F7	F8	3-F9	8-F10	1-F11	1-F12	Concrete Cu.Yd.	Steel Lb.
22°30'	6	14	7	5	6	7	5	18	20'-11"	17'-8"	12'-2"	5'-2"	5.61	328
30°	5	11	5	4	5	5	4	14	16'-2"	13'-8"	9'-2"	4'-2"	4.36	254
37°30'	4	9	4	4	4	4	4	12	13'-3"	11'-2"	7'-2"	3'-2"	3.58	211
45°	3	8	4	3	3	4	3	10	11'-6"	9'-8"	6'-2"	2'-2"	3.11	180
52°30'	3	7	3	3	3	3	3	9	10'-8"	8'-5"	5'-2"	2'-2"	2.72	160
60°	3	6	2	3	3	2	3	8	9'-6"	7'-8"	4'-2"	2'-2"	2.49	143
67°30'	3	6	3	2	3	3	2	8	8'-7"	7'-2"	5'-2"	2'-2"	2.33	140


WING DETAIL WHEN H=5'-0"

TABLE SHOWING VALUES OF K & M WHEN β, φ & θ ARE GIVEN

β	α	φ	θ	H=2'-0"		H=3'-0"		H=4'-0"		H=5'-0"		H=6'-0"	
				K	M	K	M	K	M	K	M	K	M
45°	45°	67°30'	22°30'	3'-3"	8'-0"	4'-6"	11'-0"	6'-0"	14'-9"	7'-6"	18'-0"	8'-9"	21'-0"
60°	30°	60°	30°	3'-6"	6'-0"	5'-0"	8'-6"	8'-0"	11'-3"	8'-0"	14'-0"	9'-3"	16'-0"
75°	15°	52°30'	37°30'	3'-9"	5'-0"	5'-6"	7'-0"	7'-3"	9'-3"	8'-9"	11'-6"	10'-0"	13'-3"
90°	0°	45°	45°	4'-3"	4'-3"	6'-0"	6'-0"	8'-0"	8'-0"	10'-0"	10'-0"	11'-6"	11'-6"
105°	15°	37°30'	52°30'	5'-0"	3'-9"	7'-0"	5'-6"	9'-3"	7'-3"	11'-6"	8'-9"	13'-3"	10'-0"
120°	30°	30°	60°	6'-0"	3'-6"	8'-6"	5'-0"	11'-3"	6'-6"	14'-0"	8'-0"	16'-0"	9'-3"
135°	45°	22°30'	67°30'	8'-0"	3'-3"	11'-0"	4'-6"	14'-9"	6'-0"	18'-0"	7'-6"	21'-0"	8'-9"

β equals the angle between the centerline of culvert and centerline of roadway. α equals the angle between the centerline of culvert and a line normal to the centerline of roadway. φ and θ are angles between the wingwall and a line parallel with the centerline of roadway. (R-3)

EXAMPLE FOR USING THE ABOVE TABLE: Suppose a stream makes an angle of β=65° with the centerline of roadway, then from the table, select the nearest angle, β=60°, then α, φ, & θ equal 30°, 80° & 30° respectively. If the desired height "H" of culvert is 6'-0", then K & M will be 9'-3" and 16'-0". Locate the WING DETAIL WHEN H=6'-0" on this sheet.

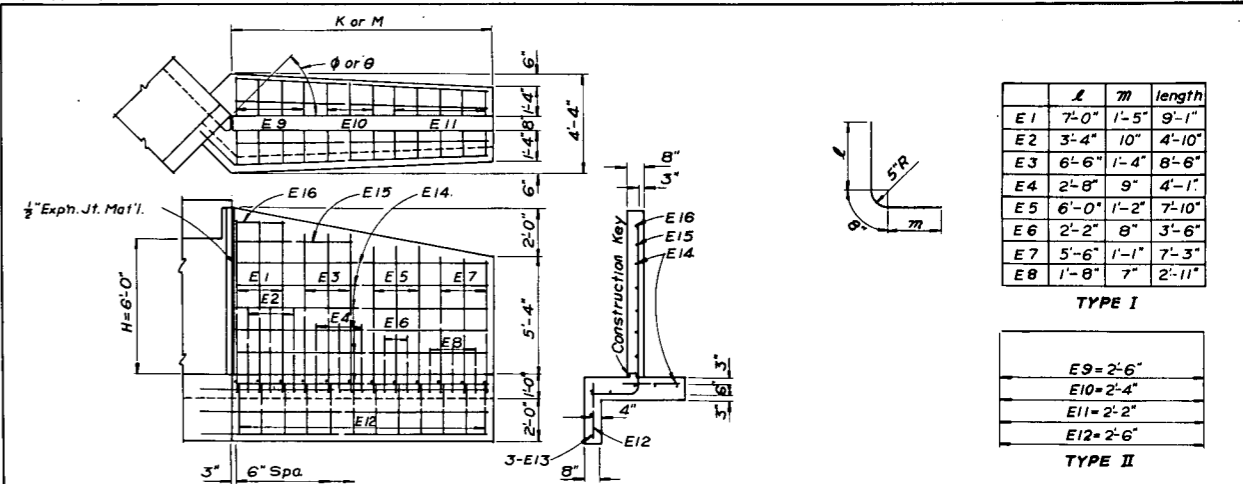

BAR LIST & QUANTITIES FOR ONE WING WHEN H=6'-0"

When φ or θ equals	Number of bars required												Length of bars				Quantities for One Wing	
	E1	E2	E3	E4	E5	E6	E7	E8	E9	E10	E11	E12	3-E13	9-E14	1-E15	1-E16	Concrete Cu.Yd.	Steel Lb.
22°30'	6	5	5	5	5	5	5	5	6	7	8	21	24'-3"	20'-8"	10'-2"	5'-2"	7.30	430
30°	4	4	4	4	4	4	4	3	5	5	6	16	18'-5"	15'-8"	7'-2"	3'-2"	5.56	326
37°30'	4	3	3	3	3	3	3	4	4	5	5	14	15'-3"	12'-11"	6'-2"	3'-2"	4.60	278
45°	3	3	3	3	3	2	3	3	4	3	5	12	13'-2"	11'-2"	5'-2"	2'-2"	3.99	240
52°30'	3	2	2	3	3	2	2	2	3	4	3	10	12'-1"	9'-8"	4'-2"	2'-2"	3.47	202
60°	3	2	2	2	2	2	3	3	3	3	4	10	10'-10"	8'-11"	4'-2"	2'-2"	3.21	194
67°30'	3	2	2	2	2	2	2	2	3	3	3	9	9'-11"	8'-5"	4'-2"	2'-2"	3.04	180

WING DETAIL WHEN H=6'-0"

LOADING DATA INTERSTATE ALTERNATE (R-2) DESIGNING DATA
LIVE LOAD: A.A.S.H.O. (HS 20-44) A.A.S.H.O. 1965 UNIT STRESS, EXCEPT AS NOTED
DEAD LOAD: CONCRETE 150 POUNDS PER CUBIC FOOT Reinforcing Steel fs 20000 lbs. per sq. in.
EARTH 84 POUNDS PER CUBIC FOOT Structural Steel fs 18000 lbs. per sq. in.
fc 1200 lbs. per sq. in.
n 10

GENERAL NOTES

ALL WORK SHALL BE DONE ACCORDING TO THE STANDARD SPECIFICATIONS APPLICABLE TO THE PROJECT.

ALL CONCRETE SHALL BE CLASS "A".
ALL WING SURFACES TO RECEIVE CLASS I FINISH.
WING FOOTINGS & FLOOR OF BOX SHALL BE POURED MONOLITHICALLY.
FOOTINGS IN ROCK SHALL BE POURED OUT TO ROCK AND NOT FORMED.
SOUNDING AND DEPTH OF FOOTING SHOWN ARE IN ACCORDANCE WITH THE BEST AVAILABLE DATA AND WHEN DIFFERENT CONDITIONS ARE ENCOUNTERED THE BRIDGE ENGINEER WILL INSPECT AND DETERMINE IF RE-DESIGN IS NECESSARY.

(R-3) EACH REINFORCING STEEL BAR SHALL BE TAGGED WITH THE NUMBER DESIGNATION AND THE STATION NUMBER OF THE PROJECT. SECONDARY BARS WHEN SPICED SHALL LAP 24 DIAMETERS OF THE BAR. DIMENSIONS FOR REINFORCING STEEL NOT SHOWN AS CLEAR SHALL BE TO THE CENTER LINE OF THE BAR. OUT TO OUT DIMENSIONS SHALL BE USED ON BAR BENDING DETAILS.

SUPPORTING SOILS FOR ALL CULVERTS MUST BE COMPOSED OF FIRM AND UNIFORM MATERIAL THROUGHOUT. HORIZONTAL CONSTRUCTION KEYS ARE NOT REQUIRED WHEN FOOTING AND WALL ARE POURED MONOLITHICALLY. ALL CONSTRUCTION KEYS SHOWN BETWEEN FOOTINGS AND WALLS ARE 3" X 3".

STEEL WEIGHTS INCLUDE 1% ± FOR OVERRUN.
EXPANSION JOINT MATERIAL IS TO BE INCLUDED IN THE PRICE OF CLASS "A" CONCRETE. AND SHALL CONFORM TO A.A.S.H.O. DESIGNATION M-213.
FOR CULVERTS REQUIRED AND GOVERNING DIMENSIONS SEE "LIST OF STRUCTURES".

(R-1) WHEN EXCAVATING FOR FOOTINGS THE FINAL SURFACE ELEVATION SHALL BE UNDISTURBED NATURAL OR COMPACTED SOIL.

REVISIONS		
(R-1)	7-17-67	General Note
(R-2)	7-15-68	General Note & Dept. Name
(R-3)	10-25-68	General Note & Table Note

DEPARTMENT OF HIGHWAYS
STATE OF COLORADO
DIVISION OF HIGHWAYS


WINGWALLS FOR
CONCRETE BOX CULVERTS
4:1 SIDE SLOPES

Designed by C.D.P. Approved by J.M.H.R.L.S. Bridge Engineer
Made by J.M.H.R.L.S. Checked by A.I.T.P.M. Date: July 1, 1965

STANDARD M-60I-C

(SHEET 2)
(JULY 1, 1965)

FED. ROAD REG. NO.	DIVISION	PROJECT NO.	SHEET NO.
9	COLO.		

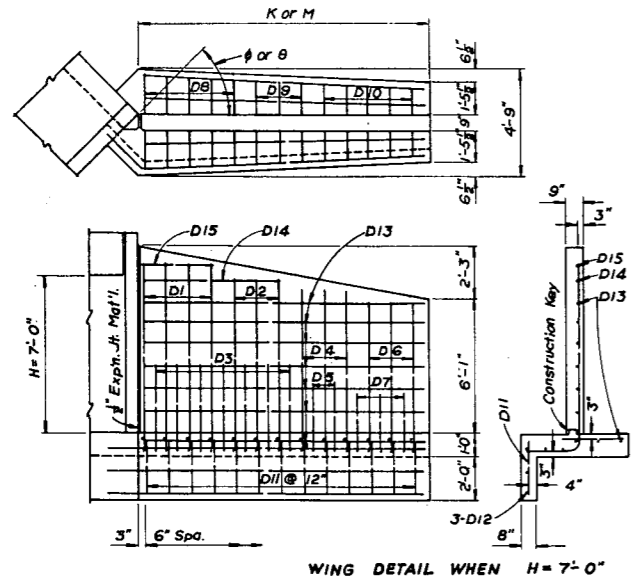

D	ℓ	m	length
D1	7'-11"	1'-8"	10'-3"
D2	7'-4"	1'-6"	9'-6"
D3	3'-4"	1'-0"	5'-0"
D4	6'-9"	1'-5"	8'-10"
D5	2'-8"	1'-0"	4'-2"
D6	6'-3"	1'-3"	8'-2"
D7	2'-2"	9"	3'-7"

TYPE I

D8 = 2'-8"
D9 = 2'-6"
D10 = 2'-4"
D11 = 2'-6"

TYPE II

When φ or θ equals	Number of bars required											Length of bars				Quantities for One Wing	
	D1	D2	D3	D4	D5	D6	D7	D8	D9	D10	D11	3-D12	1-D13	1-D14	1-D15	Concrete Cu.Yd.	Steel Lb.
22°30'	7	6	12	6	6	5	5	8	7	9	24	27'-4"	23'-5"	12'-2"	6'-2"	9.62	592
30°	5	5	9	5	5	4	4	6	6	7	19	20'-11"	17'-11"	9'-2"	4'-2"	7.39	457
37°30'	4	4	8	4	3	3	3	5	5	5	15	17'-2"	14'-8"	7'-2"	3'-2"	6.07	368
45°	4	3	7	3	2	3	3	5	3	5	13	14'-10"	12'-8"	6'-2"	3'-2"	5.26	321
52°30'	3	3	6	3	2	3	3	4	4	4	12	13'-10"	11'-2"	5'-2"	2'-2"	4.66	287
60°	3	3	5	3	2	2	2	4	3	4	11	12'-3"	10'-2"	5'-2"	2'-2"	4.25	262
67°30'	3	3	5	2	3	2	2	4	3	3	10	11'-4"	9'-8"	5'-2"	2'-2"	4.05	245


BAR LIST & QUANTITIES FOR ONE WING WHEN H=7'-0"

TABLE SHOWING VALUES OF K & M WHEN β & φ ARE GIVEN

β	α	φ	θ	H=7'-0"		H=8'-0"		H=9'-0"		H=10'-0"	
				K	M	K	M	K	M	K	M
45°	45°	67°30'	22°30'	10'-0"	23'-9"	11'-0"	26'-9"	12'-3"	29'-6"	13'-6"	32'-3"
60°	30°	60°	30°	10'-6"	18'-3"	11'-9"	20'-6"	13'-0"	23'-9"	14'-3"	24'-9"
75°	15°	52°30'	37°30'	11'-6"	15'-0"	13'-0"	16'-9"	14'-3"	18'-6"	15'-9"	20'-3"
90°	0°	45°	45°	13'-0"	13'-0"	14'-6"	14'-6"	16'-0"	16'-0"	17'-6"	17'-6"
105°	15°	37°30'	52°30'	15'-0"	11'-6"	13'-0"	13'-0"	18'-6"	14'-3"	20'-3"	15'-9"
120°	30°	30°	60°	18'-3"	10'-6"	20'-6"	11'-9"	23'-9"	13'-0"	24'-9"	14'-3"
135°	45°	22°30'	67°30'	23'-9"	10'-0"	26'-9"	11'-0"	29'-6"	12'-3"	32'-3"	13'-6"

β equals the angle between φ of culvert and φ of roadway. α equals the angle between φ of culvert and a line normal to φ of roadway. φ and θ are angles between the wingwall and a line parallel with the φ of roadway.

EXAMPLE FOR USING THE ABOVE TABLE. Suppose a stream makes an angle of β=65° with φ of roadway, then, from the table, select the nearest angle β=60°, then α, φ, θ equal 30°, 60°, 30° respectively. If the desired height "H" of culvert is 8'-0", then "K" & "M" will be 11'-9" & 20'-6". Locate the WING DETAIL WHEN H=8'-0" on this sheet.

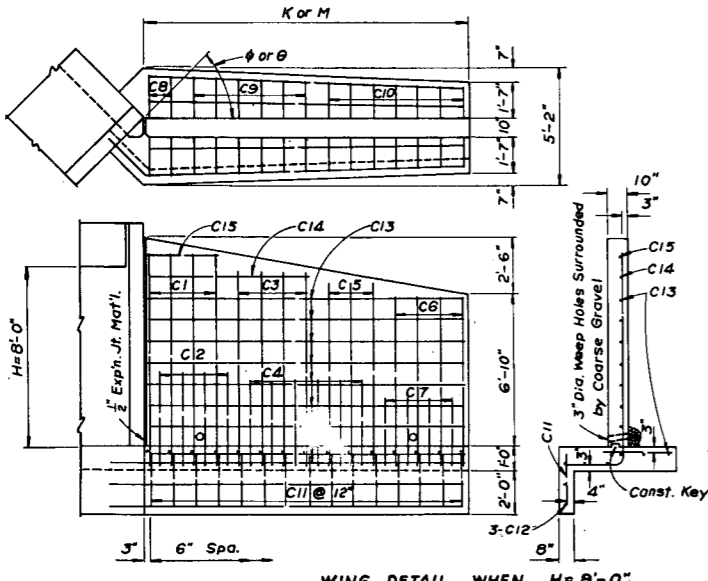

C	ℓ	m	length
C1	8'-10"	1'-11"	11'-5"
C2	3'-8"	1'-2"	5'-6"
C3	8'-3"	1'-9"	10'-8"
C4	3'-4"	1'-1"	5'-1"
C5	7'-8"	1'-8"	10'-0"
C6	7'-0"	1'-6"	9'-2"
C7	2'-7"	11"	4'-2"



TYPE I

C8 = 3'-0"
C9 = 2'-9"
C10 = 2'-6"
C11 = 2'-6"

TYPE II

When φ or θ equals	Number of bars required										Length of bars				Quantities for One Wing	
	A1	A2	A3	A4	A5	A6	A7	A8	A9	A10	3-A11	1-A12	1-A13	1-A14	Concrete Cu.Yd.	Steel Lb.
22°30'	9	16	8	8	16	8	10	12	11	33	36'-10"	31'-11"	16'-2"	8'-2"	19.74	1224
30°	7	12	6	6	12	6	7	10	8	25	28'-2"	24'-5"	12'-2"	6'-2"	15.14	930
37°30'	6	10	5	5	10	5	6	8	7	21	23'-11"	19'-11"	10'-2"	5'-2"	12.39	775
45°	5	9	4	5	8	4	5	7	6	18	19'-9"	17'-2"	8'-2"	4'-2"	10.71	665
52°30'	5	8	3	4	7	4	5	6	5	16	18'-9"	15'-5"	7'-2"	4'-2"	9.63	597
60°	4	7	4	3	7	4	4	6	5	15	16'-6"	13'-11"	7'-2"	3'-2"	8.72	543
67°30'	4	7	3	4	6	3	4	5	5	14	15'-2"	13'-2"	6'-2"	3'-2"	8.26	515

BAR LIST & QUANTITIES FOR ONE WING WHEN H=10'-0"

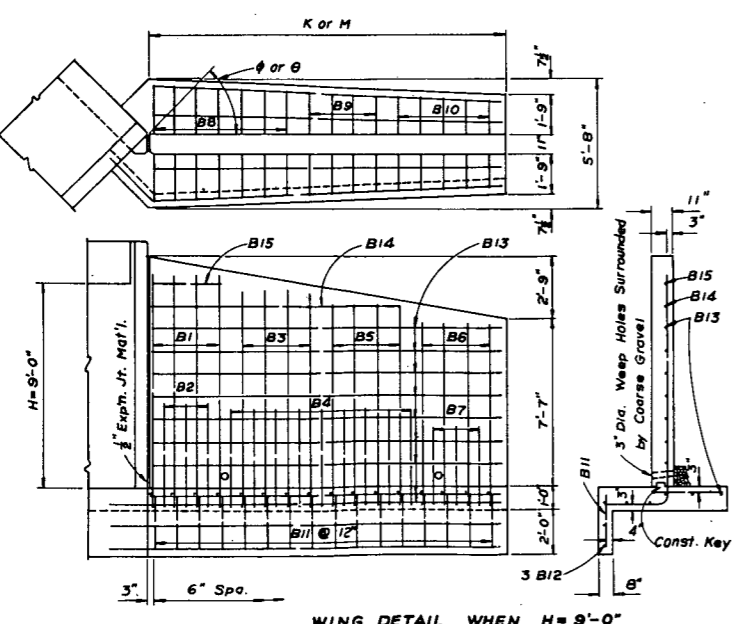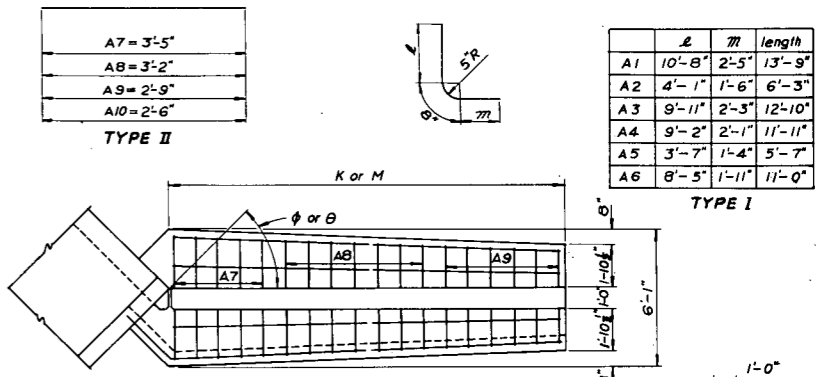

B	ℓ	m	length
B1	9'-11"	2'-3"	12'-10"
B2	4'-2"	1'-4"	6'-2"
B3	9'-2"	2'-11"	11'-11"
B4	3'-11"	1'-3"	5'-10"
B5	8'-5"	1'-10"	10'-11"
B6	7'-9"	1'-9"	10'-2"
B7	3'-1"	1'-1"	4'-10"

TYPE I

B8 = 3'-3"
B9 = 2'-9"
B10 = 2'-7"
B11 = 2'-6"

TYPE II

When φ or θ equals	Number of bars required											Length of bars				Quantities for One Wing	
	C1	C2	C3	C4	C5	C6	C7	C8	C9	C10	C11	3-C12	1-C13	1-C14	1-C15	Concrete Cu.Yd.	Steel Lb.
22°30'	8	7	6	12	6	7	7	5	10	12	27	30'-8"	26'-5"	13'-2"	7'-2"	12.53	779
30°	6	5	5	10	4	6	5	4	7	10	21	23'-5"	20'-2"	10'-2"	5'-2"	9.60	601
37°30'	5	4	4	8	4	4	4	3	6	8	17	19'-1"	16'-5"	8'-2"	4'-2"	7.84	487
45°	4	4	4	6	3	4	4	2	6	7	15	16'-6"	14'-2"	7'-2"	3'-2"	6.79	424
52°30'	4	3	3	6	3	3	3	2	5	6	13	15'-6"	12'-8"	6'-2"	3'-2"	6.08	374
60°	4	3	2	6	3	3	2	2	4	6	12	13'-8"	11'-5"	5'-2"	3'-2"	5.50	341
67°30'	3	3	3	5	2	3	2	2	4	5	11	12'-5"	10'-8"	5'-2"	2'-2"	5.15	315

BAR LIST & QUANTITIES FOR ONE WING WHEN H=8'-0"

When φ or θ equals	Number of bars required											Length of bars				Quantities for One Wing	
	B1	B2	B3	B4	B5	B6	B7	B8	B9	B10	B11	3-B12	1-B13	1-B14	1-B15	Concrete Cu.Yd.	Steel Lb.
22°30'	7	6	8	16	8	7	7	13	8	9	30	33'-9"	29'-2"	22'-2"	6'-2"	15.93	930
30°	5	5	7	13	6	6	5	10	7	7	24	27'-0"	23'-5"	17'-2"	4'-2"	12.82	742
37°30'	4	4	5	10	5	5	4	8	5	6	19	21'-1"	18'-2"	13'-2"	3'-2"	9.98	580
45°	4	3	4	9	4	4	3	7	4	5	16	18'-2"	15'-8"	11'-2"	3'-2"	8.63	495
52°30'	3	3	4	8	4	4	3	6	4	5	15	17'-0"	13'-11"	10'-2"	2'-2"	7.69	453
60°	3	3	4	7	3	3	2	6	3	4	13	15'-1"	12'-8"	9'-2"	2'-2"	7.01	406
67°30'	3	2	3	7	4	3	3	5	3	5	13	13'-9"	11'-11"	9'-2"	2'-2"	6.61	385

BAR LIST & QUANTITIES FOR ONE WING WHEN H=9'-0"

REVISIONS

R-2	7-15-68	Dept. Name	M.R.H.
R-3	10-25-68	Table Note	M.R.H.

DEPARTMENT OF HIGHWAYS
STATE OF COLORADO
DIVISION OF HIGHWAYS

WINGWALLS FOR CONCRETE BOX CULVERT
4:1 SIDE SLOPES


Designed by L.D.P. Approved by [Signature]
Made by J.W.M.R.L.S. Bridge Engineer
Checked by A.T.R.A.M. Date: July 1, 1965

STANDARD M-606-AB

(MARCH 1, 1968)
(SHEET 1 OF 3)

FEDERAL ROAD REGION NO.	DIVISION	PROJ. NO.	SHEET NO.	TOTAL SHEETS
9	COLORADO			

REVISIONS				
(R-7)	10-21-71	Replace post spacing Gen. Note with table.	M.R.H.	
(R-8)	12-20-71	Shoulder treatment with and without curb.	M.R.H.	

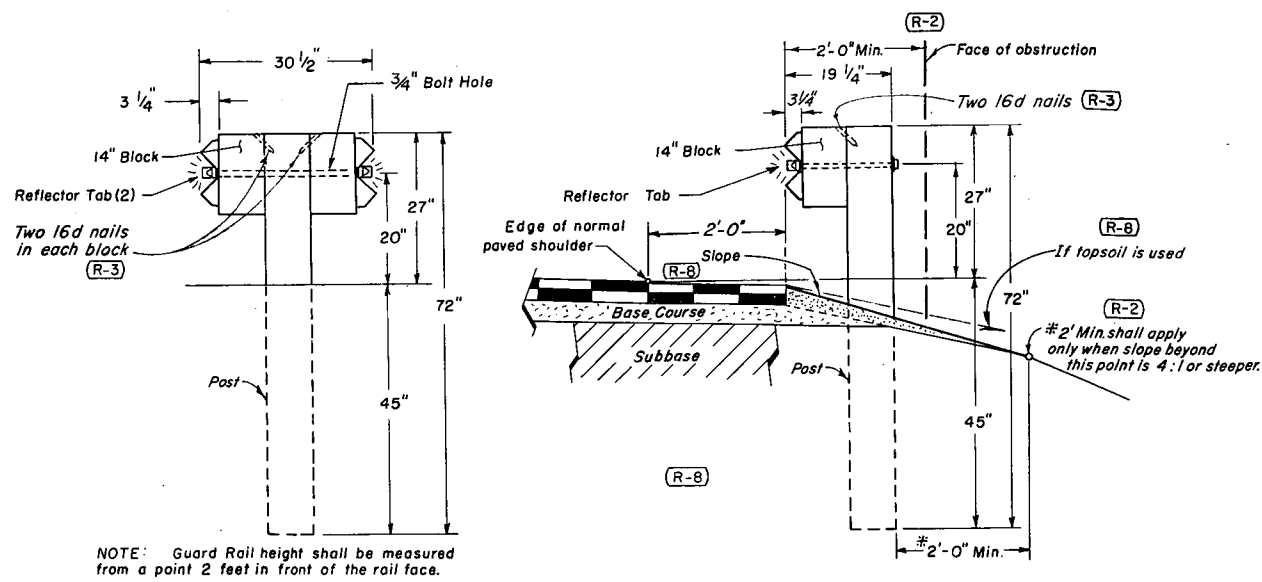

TYPICAL POST INSTALLATIONS & SHOULDER TREATMENT WITHOUT CURB
(See Table for Post & Block Cross Section)


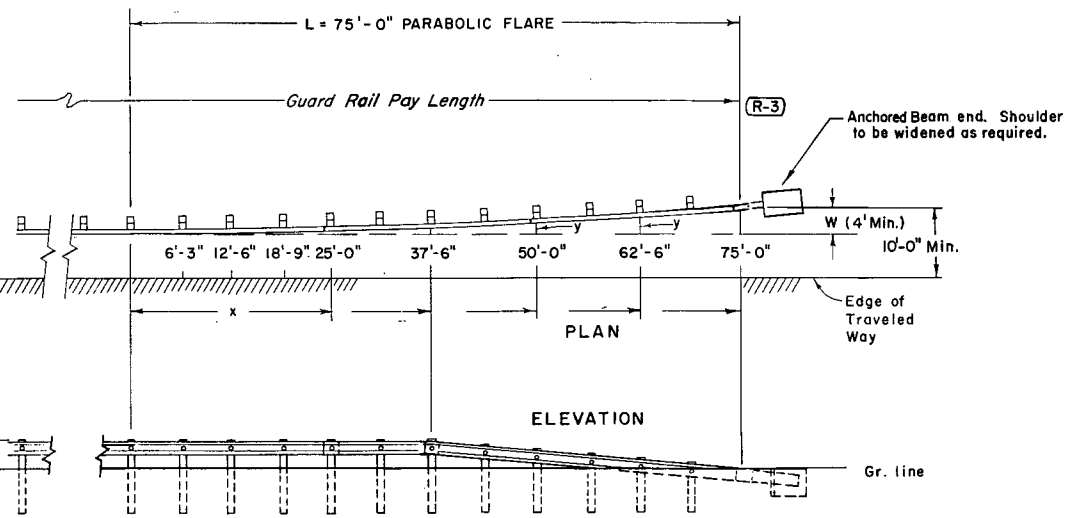



TABLE OF OFFSETS FOR 75' PARABOLIC FLARES

x	y					
	W=4'	W=5'	W=10'	W=12'	W=14'	W=16'
12'-6"	0.11	0.14	0.28	0.33	0.39	0.44
25'-0"	0.44	0.55	1.11	1.33	1.56	1.78
37'-6"	1.00	1.25	2.50	3.00	3.50	4.00
50'-0"	1.78	2.22	4.44	5.33	6.23	7.11
62'-6"	2.78	3.48	6.95	8.34	9.73	11.11
75'-0"	4.00	5.00	10.00	12.00	14.00	16.00

LEGEND
W = Full parabolic offset.
L = Length of parabolic transition.
x = Longitudinal dist. from beginning of flare.
y = Offset = $W \cdot x^2 / L^2$

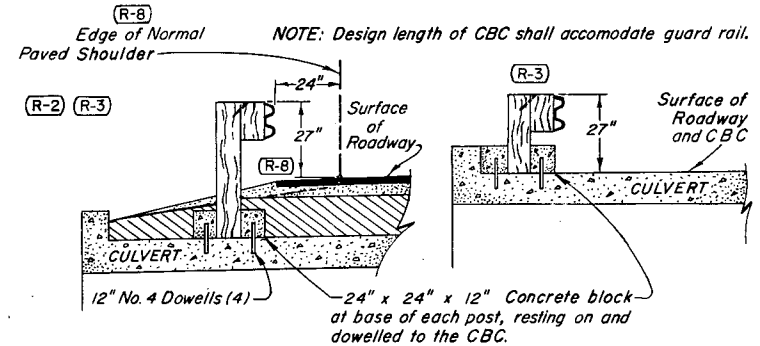


GUARD RAIL ACROSS CONCRETE BOX CULVERT

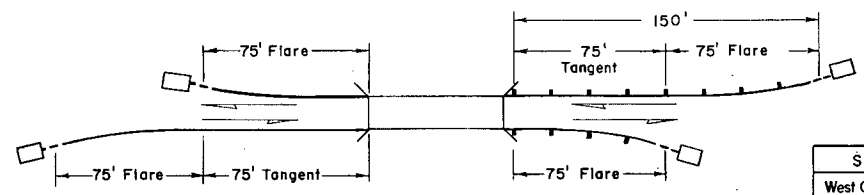


2-LANE HIGHWAY BRIDGE APPROACH GUARD RAIL

NOTE: For divided highways see Sheet No. 2.

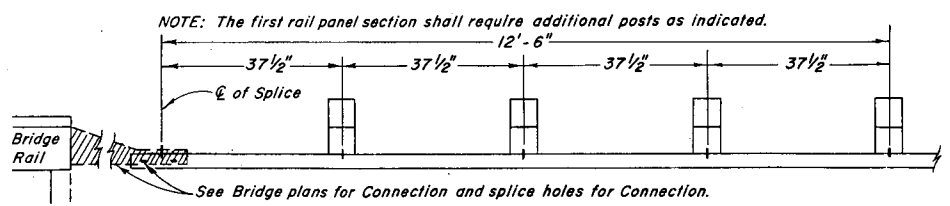


GUARD RAIL AT BRIDGES

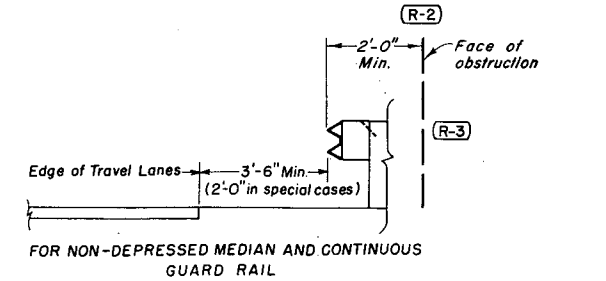

GUARD RAIL FOR OBSTRUCTIONS IN MEDIAN

(See Sheet No. 3)

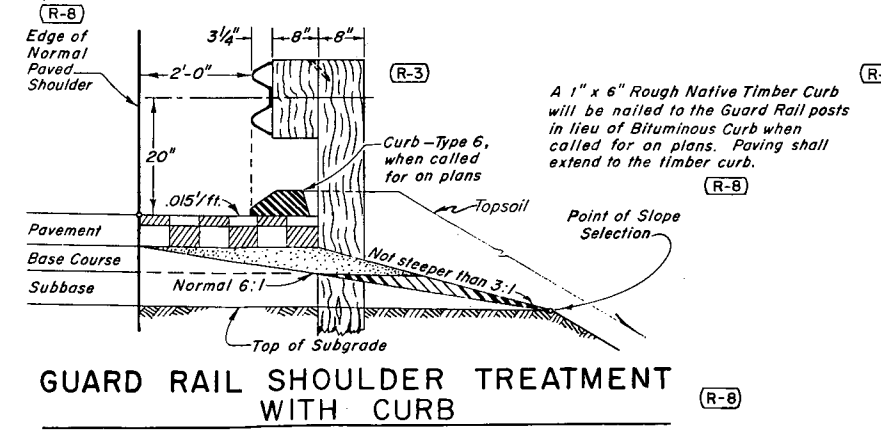

GUARD RAIL SHOULDER TREATMENT WITH CURB

GENERAL NOTES

All work shall be done in accordance with the Standard Specifications applicable to the project.

All timber shall be close grained Douglas Fir of the Coast Region, Dense Longleaf or Shortleaf Southern Pine, Lodgepole Pine, Ponderosa Pine, Western Hemlock, or Larch, and shall conform to the following grading specifications and requirements:

SPECIES	SIZE	FOHC	GRADING RULES
West Coast Douglas Fir	6"x8"	Yes	WCLB #16 Par. 131 b
West Coast Hemlock	6"x8"	Yes	WCLB #16 Par. 131 a
Larch	6"x8"	Yes	WWP 1970 Par. 80.11
Southern Pine	6"x8"	No	SPIB 1970 Par. 285
Lodgepole Pine	8"x8"	No	WWP 1970 Par. 80.10
Ponderosa Pine	8"x8"	No	WWP 1970 Par. 80.10
West Coast Hemlock	8"x8"	Yes	WCLB #16 Par. 131 b

WCLB #16 — "Standard Grading Rules #16 for West Coast Lumber" Published by the West Coast Lumber Inspection Bureau. Effective Sept. 1, 1970.

WWP 1970 — "1970 Standard Grading Rules for Southern Pine Lumber" Published by the Western Wood Products Association. Effective Sept. 1, 1970.

SPIB 1970 — "1970 Standard Grading Rules for Southern Pine Lumber" Published by the Southern Pine Inspection Bureau. Effective Sept. 1, 1970.

FOHC — Free of Heart Centers. See paragraph 714 c of WCLB.

NOTE — 6" x 8" Posts and Blocks shall be installed with the 6" dimension parallel to the roadway.

Post & block cross section — All timber shall be rough, free of wane, square cut and full sawn.

At the time the post or block is installed, any seasoning check which extends the full length of the piece shall not exceed one-quarter inch in width at its maximum width.

Blocks shall be cut from timber of the same cross section, species and grade as the posts and receive the same treatment.

Timber shall be incised and pressure treated in accordance with AASHTO Designation M133, except that blocks need not be incised. Post bolt holes are to be drilled before treatment is applied.

The preservative shall be either (a) Creosote or (b) Pentachlorophenol in a petroleum carrier (liquid or L.P. gas). Unless otherwise permitted by the Engineer, only one preservative shall be used on the project.

Where pedestrian hazard exists and sidewalk is constructed on the roadway shoulder, guard rail shall be placed between the sidewalk and the edge of traffic lane.

Guard rail plate shall not be lighter than No. 12 U.S. Standard Gage. 25' length of rail panels will be permitted.

Metal plate guard rail shall be painted in accordance with standard specifications or shall be galvanized in accordance with Designation M-111 or with ASTM Designation A 525, Coating Class 2.50.

Posts used for vertical transition shall be adjusted in length so that a minimum of 45" will be buried.

Standard galvanized wrought steel washers shall be used under all bolt heads or nuts coming in contact with wood posts.

Concrete shall be Class A, B or D.

Blocks shall be toenailed to posts with two 16 penny galvanized nails in the top of each block.

If posts are cut in the field, cut ends shall receive 2 coats of hot creosote.

NORMAL CENTER-TO-CENTER POST SPACING

LOCATION	DESIGN SPEED	
	Less Than 50mph and ADT < 750	50mph and Over
Tangents	12'-6"	6'-3"
Curves with Radius Over 200'	12'-6"	6'-3"
Curves with Radius of 200' or Less	6'-3"	6'-3"
Flares and Obstructions	6'-3"	6'-3"

**DEPARTMENT OF HIGHWAYS
STATE OF COLORADO
DIVISION OF HIGHWAYS
GUARD RAIL
TYPE 3**


Designed by M.R.H. Approved by J.C.B.
Made by R.B.B. Staff Design Engineer
Checked by R.S.M. Date: March 1, 1968

STANDARD M-606-AB

(MARCH 1, 1968)
(SHEET 2)


FEDERAL ROAD REGION NO.	DIVISION	PROJ. NO.	SHEET NO.	TOTAL SHEETS
9	COLORADO			

REVISIONS		
(R-7)	10-21-71	Revision date only.
(R-8)	12-20-71	End anchorage type numbers.

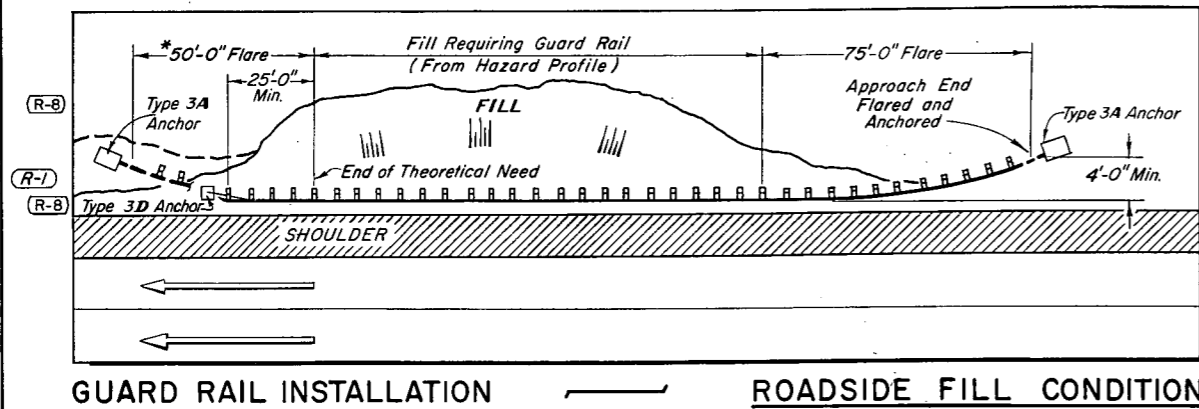


GUARD RAIL INSTALLATION ——— ROADSIDE FILL CONDITION


NOTES:
* 2-Lane Highways — The exit end of Guard Rail shall extend 50 feet past the end of theoretical need and shall be flared and anchored.

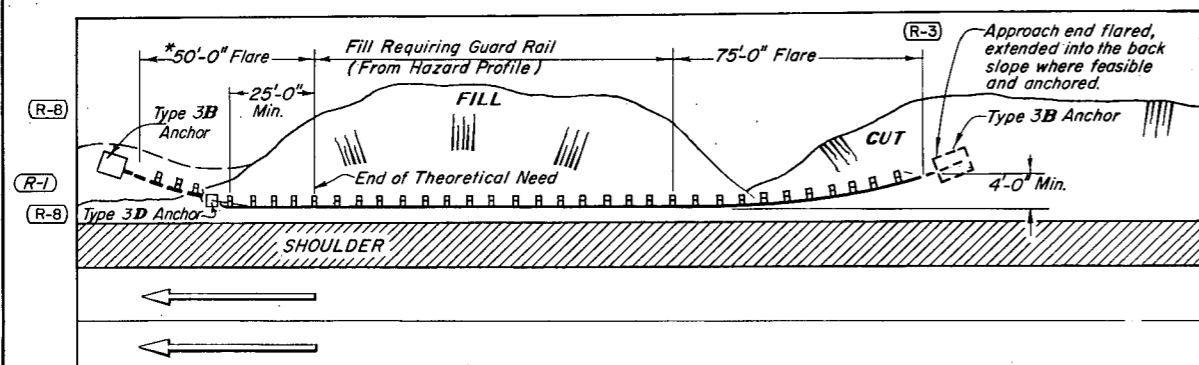

GUARD RAIL INSTALLATION ——— ROADSIDE CUT TO FILL CONDITION

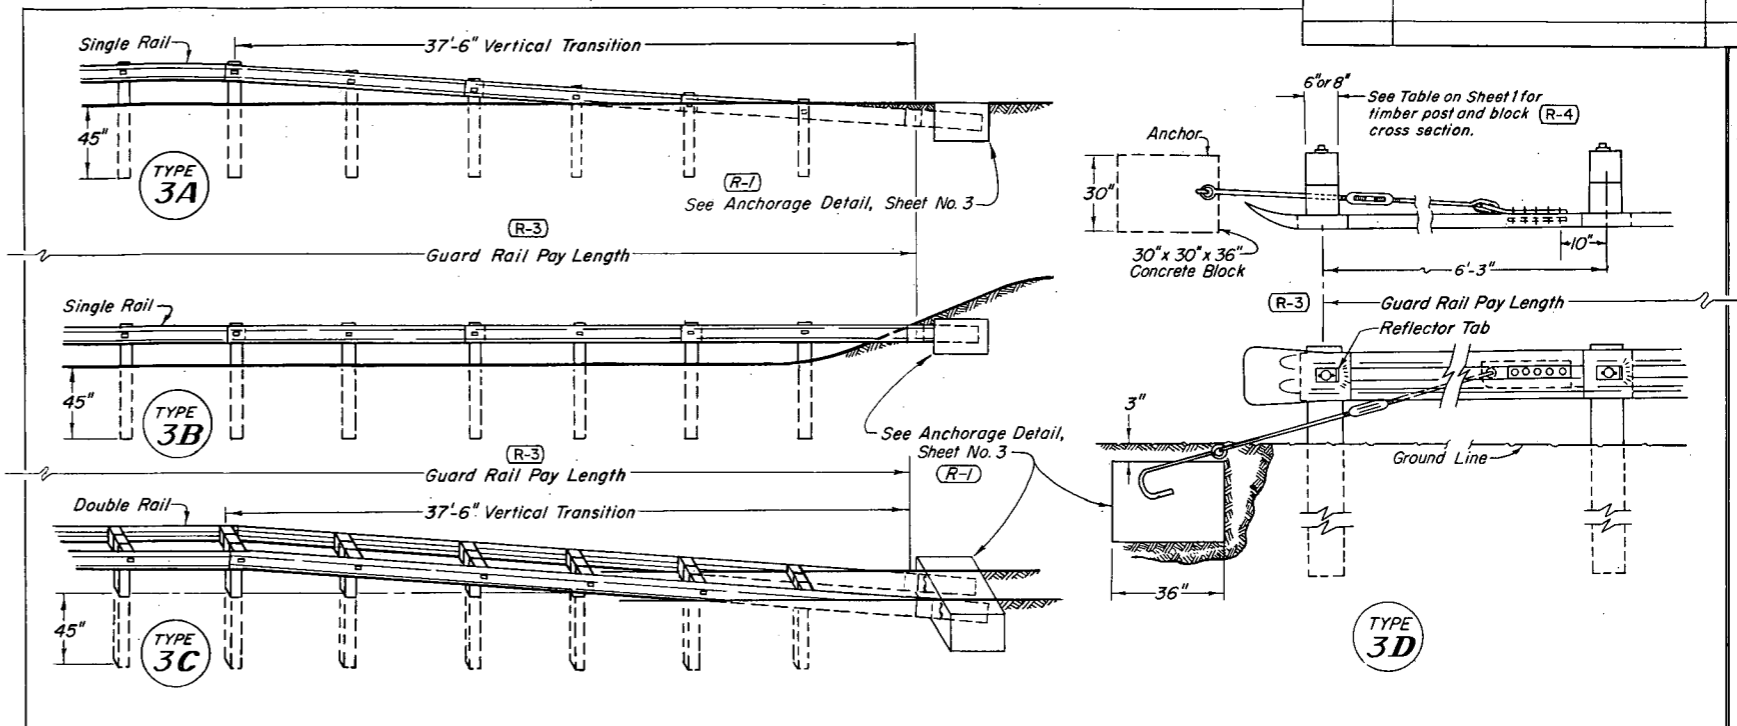

TYPICAL END ANCHORAGE

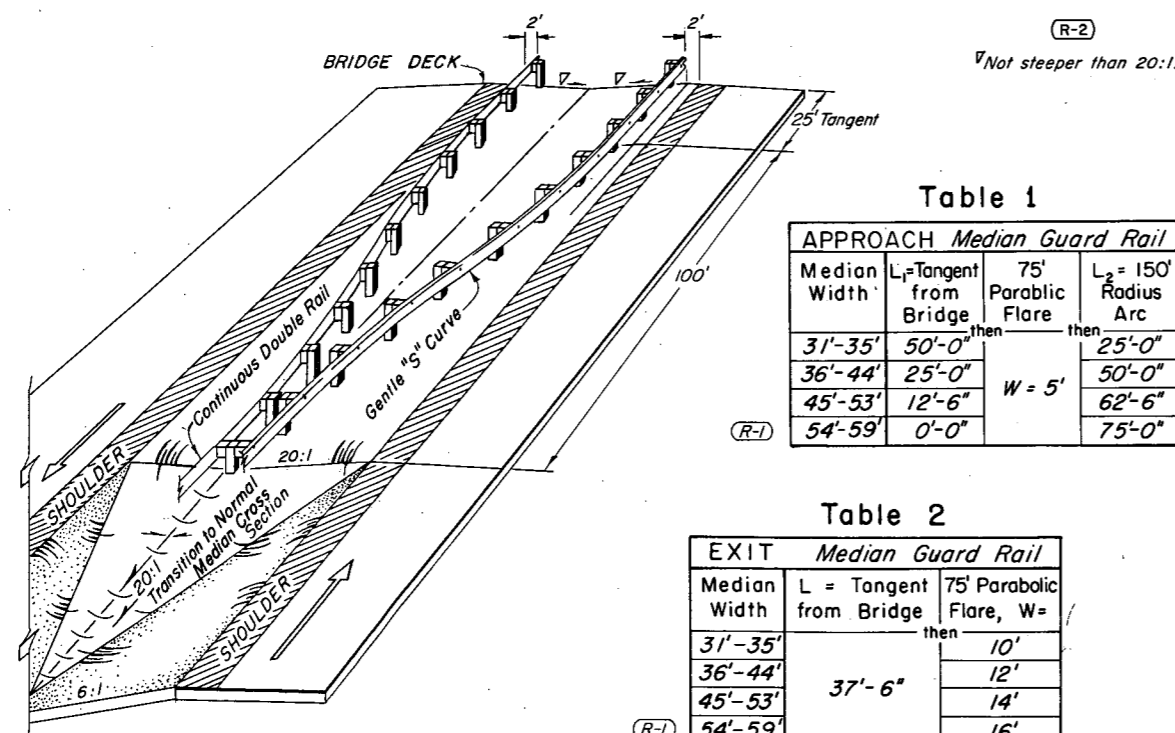

21' to 30' MEDIAN


Table 1

APPROACH Median Guard Rail				
Median Width	L_1 = Tangent from Bridge	75' Parabolic Flare	L_2 = 150' Radius Arc	
31'-35'	50'-0"	then	then	25'-0"
36'-44'	25'-0"			50'-0"
45'-53'	12'-6"	$W = 5'$		62'-6"
54'-59'	0'-0"			75'-0"


Table 2

EXIT Median Guard Rail		
Median Width	L = Tangent from Bridge	75' Parabolic Flare, $W =$
31'-35'		10'
36'-44'		12'
45'-53'	37'-6"	14'
54'-59'		16'

GUARD RAIL AT BRIDGE APPROACH

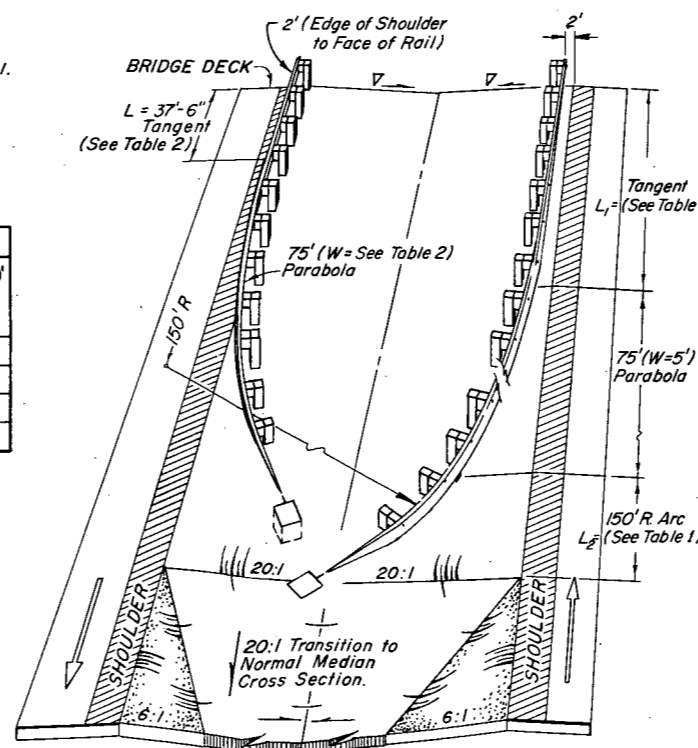

31' to 59' MEDIAN

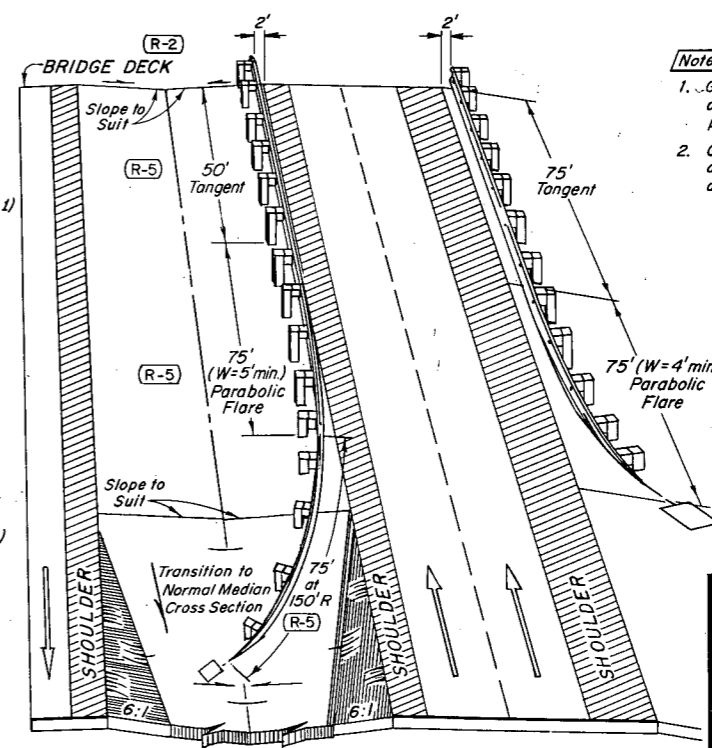

MEDIAN 60' AND OVER

Notes: EXIT FROM BRIDGES:

- Guard rail for OUTSIDE shoulders at exit end of bridges on divided highways to be determined from hazard profile.
- Guard rail for INSIDE shoulders at exit end of bridges on divided highways with medians 60' and over to be determined from hazard profile.

DEPARTMENT OF HIGHWAYS
STATE OF COLORADO
DIVISION OF HIGHWAYS

GUARD RAIL TYPE 3


Designed by M. R. H. Approved by J. R. B.
Made by J. R. B. Staff Design Engineer
Checked by R. S. M. Date: March 1, 1968

STANDARD M-606-AB



(MARCH 1, 1968)
(SHEET 3)

FEDERAL ROAD REGION NO.	DIVISION	PROJ. NO.	SHEET NO.	TOTAL SHEETS
9	COLORADO			



REVISIONS				
(R-7)	10-21-71	Revision date only.		M.R.H.
(R-8)	12-20-71	Anchorage type numbers & reflector tab.		M.R.H.

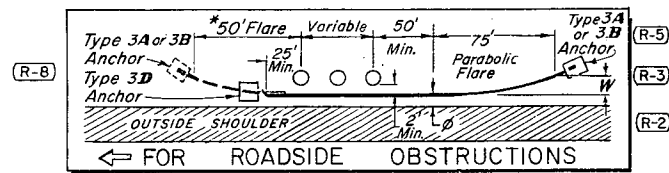

*2-Lane Highways — The exit end of Guard Rail shall extend 50 ft past the end of theoretical need and shall be flared and anchored.

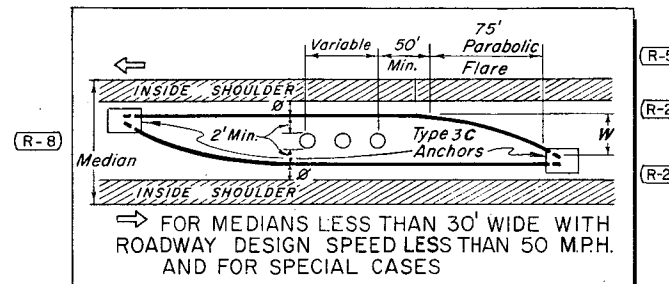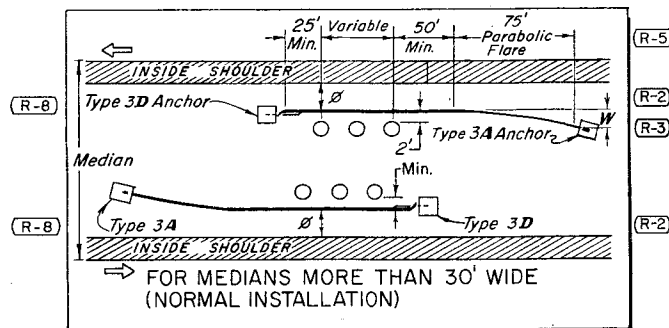


NON-CONTINUOUS RAIL

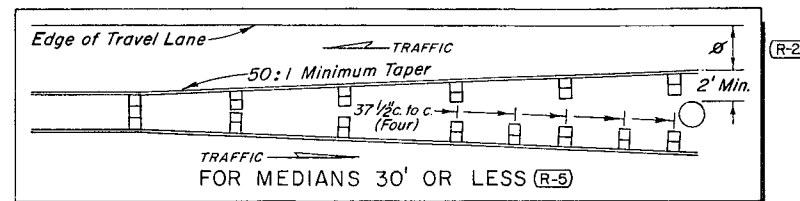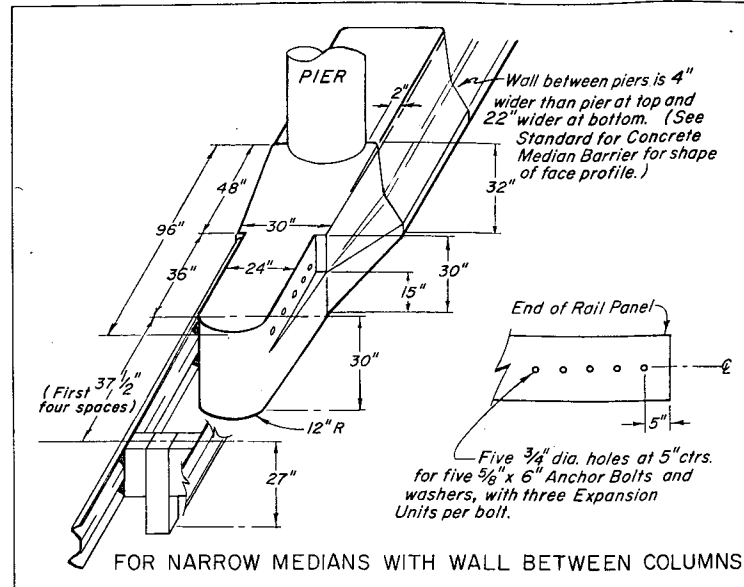






CONTINUOUS RAIL

When slope is 6:1 or flatter and an obstruction is present, increase where possible, to allow more area for vehicle recovery.


TYPICAL GUARD RAIL FOR OBSTRUCTIONS

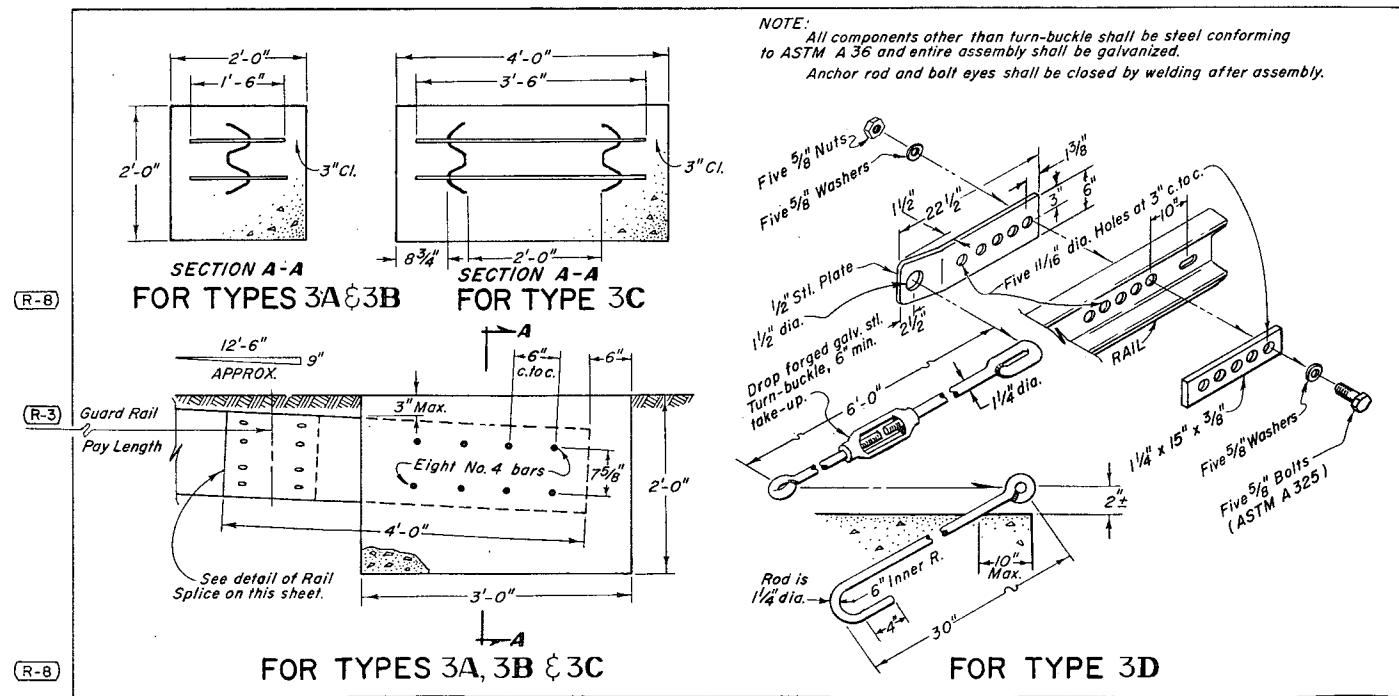




DETAILS FOR TYPICAL END ANCHORAGE

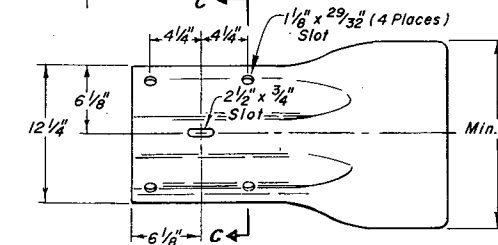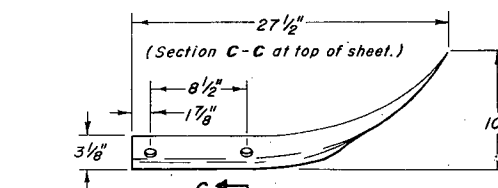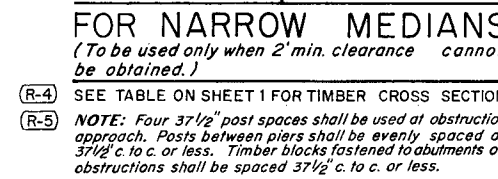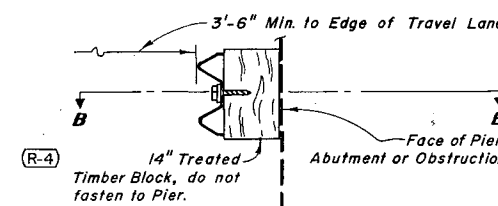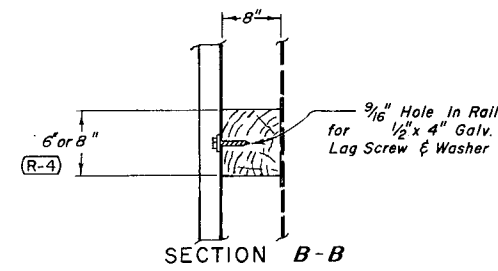

DETAIL OF RAIL AND SPLICE

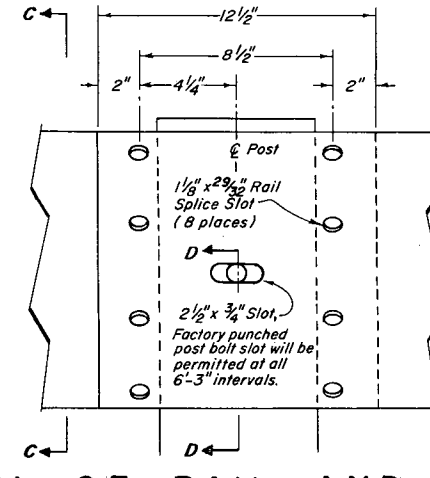

DETAIL OF RAIL AND SPLICE

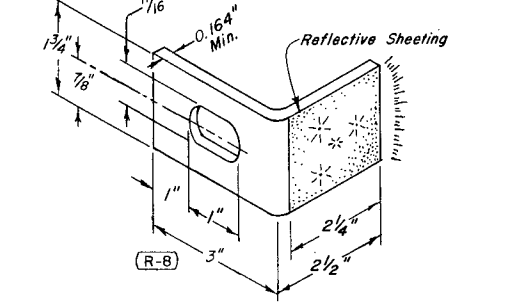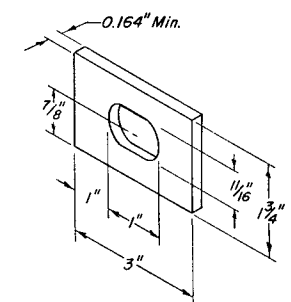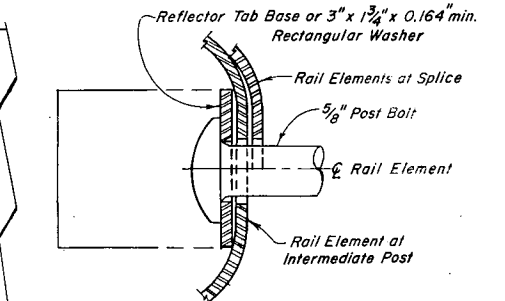

RECTANGULAR WASHER DETAIL

REFLECTOR TAB DETAIL

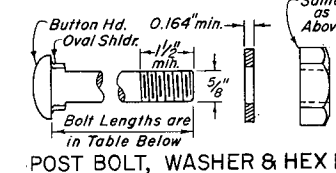
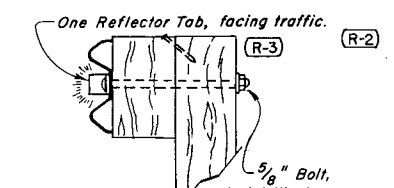
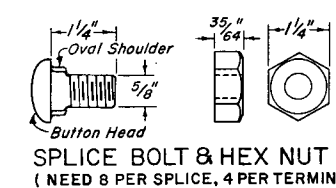


TABLE OF POST BOLT SIZES

Block	Post	RAIL	BOLT SIZE
8" x 6"	Double	5/8" x 25 3/4"	
8" x 6"	Single	5/8" x 17 1/2"	

NOTE: When 6" x 6" timber is used, the 8" dimension shall be perpendicular to the roadway.

DEPARTMENT OF HIGHWAYS
STATE OF COLORADO
DIVISION OF HIGHWAYS

GUARD RAIL
TYPE 3

Designed by M.R.H. Approved by J.R.B.
Made by J.R.B. Staff Design Engineer
Checked by R.S.M. Date: March 1, 1968

STANDARD M-614-TB


(SHEET 1 OF 3 SHEETS)

(JULY 1, 1965)

FEDERAL ROAD REGION NO.	DIVISION	PROJECT NO.	SHEET NO.
9	COLORADO		



REVISIONS			
(R-1)	7-12-67	Note 23	G.W.F.
(R-2)	7-8-68	Rev. Break-away, Placement, Code Nos, & Dept. Name	G.W.F.
(R-3)	12-24-68	Rev. U.S. Shields	J.L.S.
(R-4)	11-22-71	Rev. Signs & Code Nos	J.J.S.

Typical Signing Where Traffic Is Prohibited Along Construction

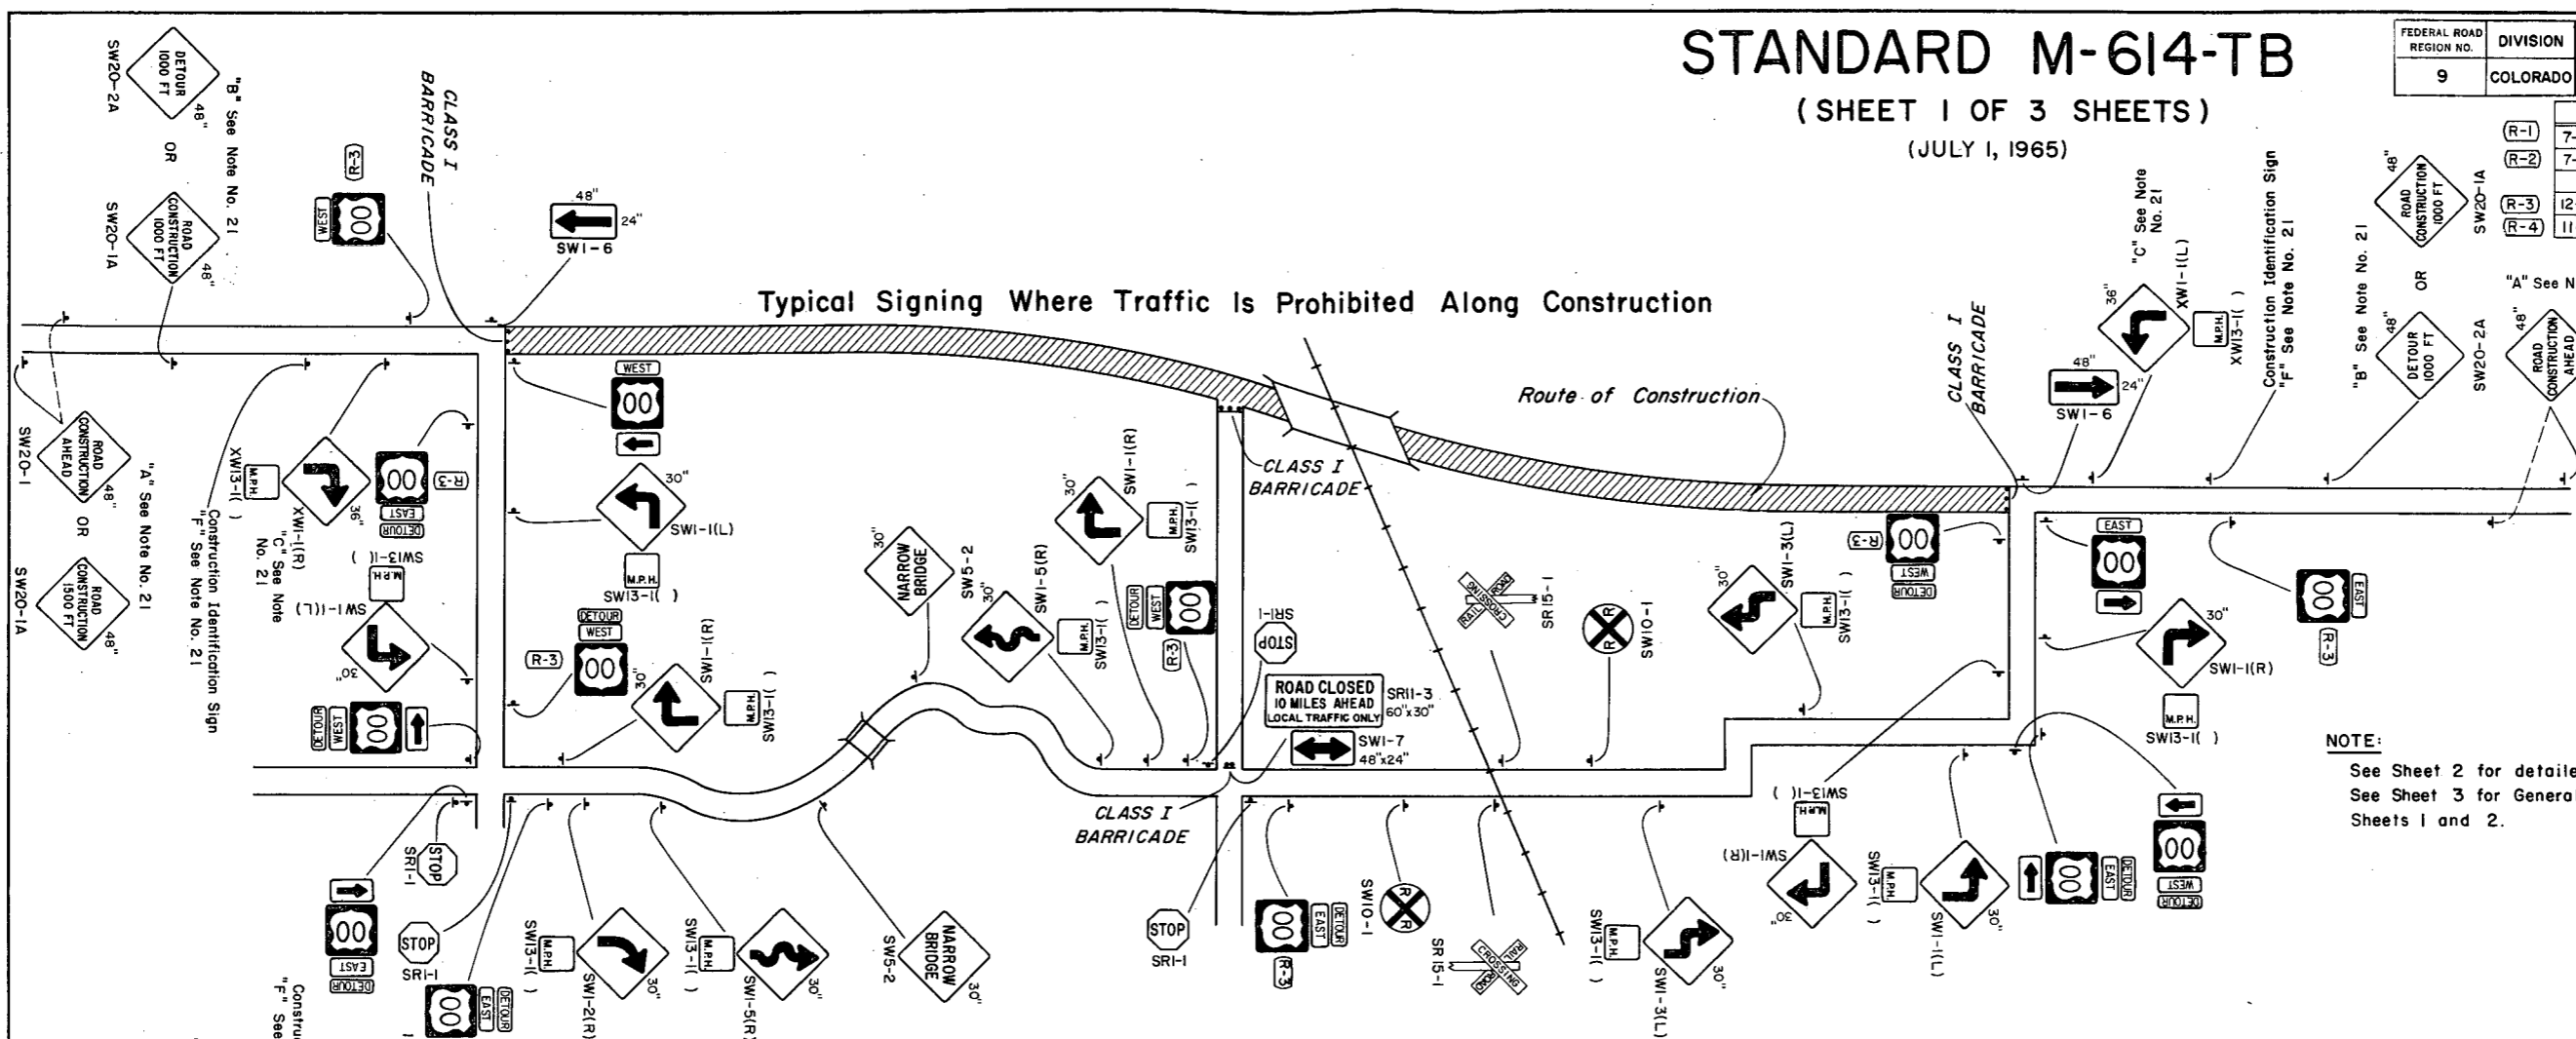

NOTE:
See Sheet 2 for detailed drawings of signs.
See Sheet 3 for General Notes applicable to Sheets 1 and 2.

Typical Signing Where Traffic Is Permitted Along Construction

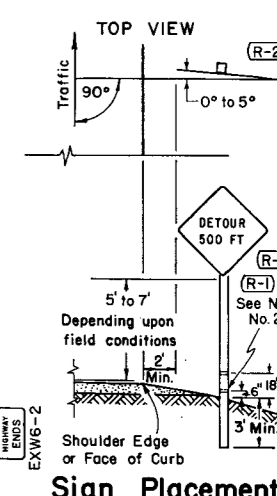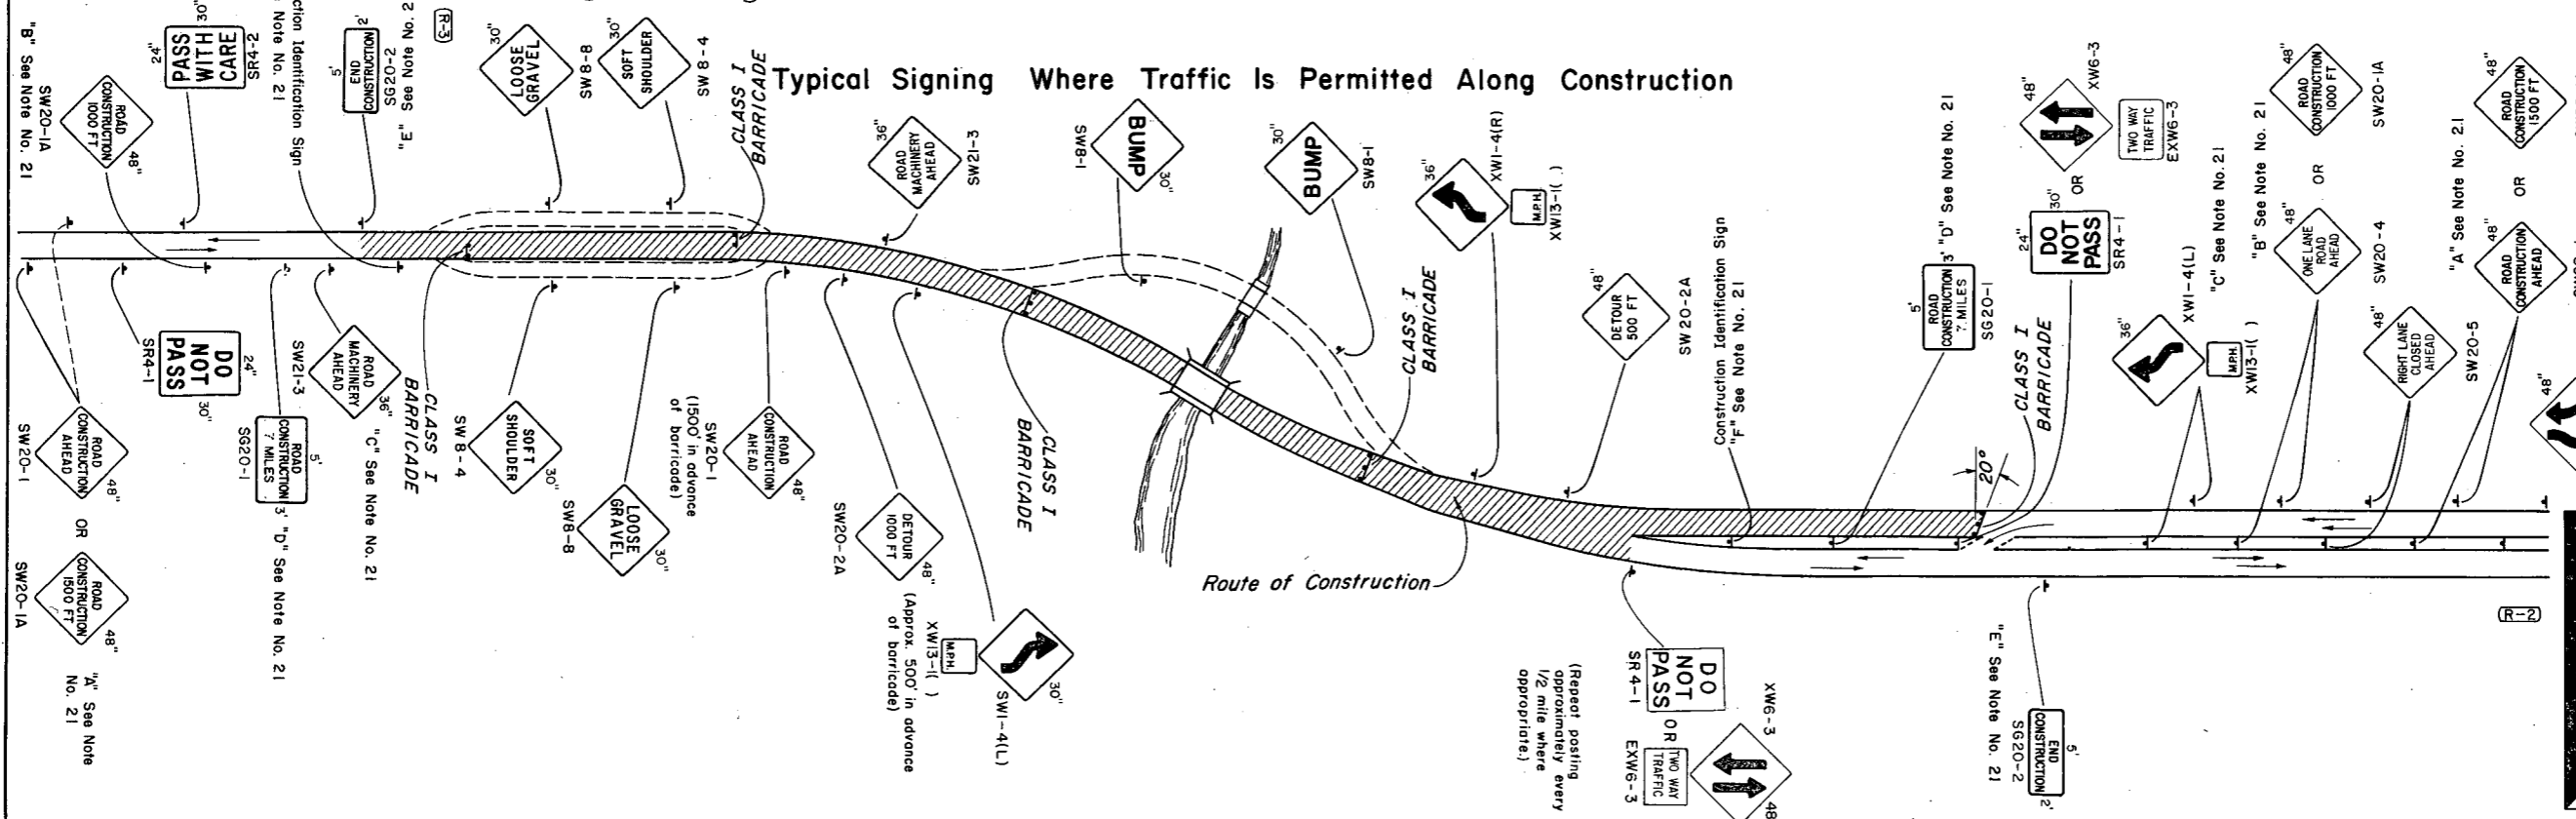

DEPARTMENT OF HIGHWAYS
STATE OF COLORADO
DIVISION OF HIGHWAYS
TRAFFIC SIGNING FOR HIGHWAY CONSTRUCTION

Designed By: D.R.W. Approved By: *[Signature]*
Made By: JLS Traffic Engineer
Checked By: J.B. Date: AUGUST 9, 1965

STANDARD M-614-TB

(SHEET 2 OF 3 SHEETS)



(JULY 1, 1965)

FEDERAL ROAD REGION NO.	DIVISION	PROJECT NO.	SHEET NO.
9	COLORADO		

REVISIONS			
(R-1)	7-12-67		M.R.H.
(R-2)	7-8-68	Rev. Code No. & Dept. Name	G.W.F.
(R-3)	12-24-68	Added Notes	J.L.S.
(R-4)	11-22-71	Rev. Signs & Code Nos.	J.J.S.


WARNING SIGNS

See Note No. 10

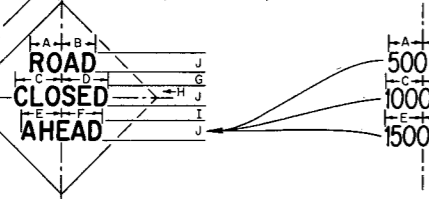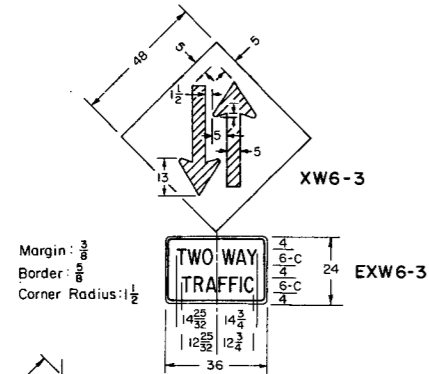




REGULATORY SIGNS

See Note No. 9

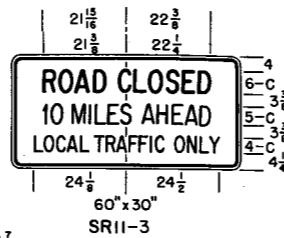

WARNING SIGNS

See Note No. 10

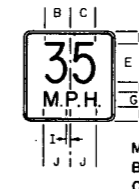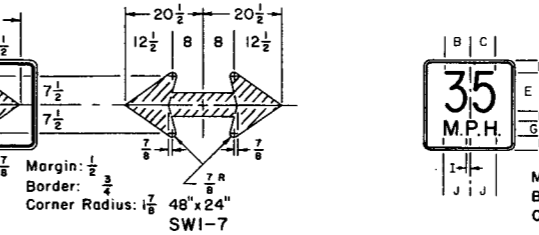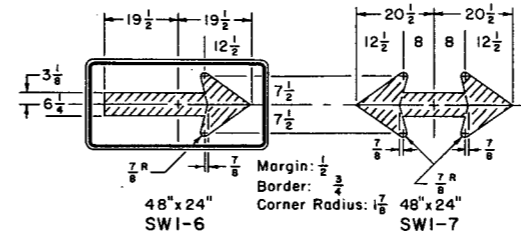

Panel	A	B	C	D	E	F	G	H	I	J
SW13-1	18" x 18"	$5\frac{1}{8}$	$5\frac{3}{8}$	$2\frac{1}{4}$	8-C	2	3-E	$2\frac{3}{4}$	$3\frac{3}{8}$	$5\frac{3}{8}$
XW13-1	24" x 24"	$6\frac{3}{8}$	$6\frac{3}{8}$	$3\frac{3}{4}$	10-C	$2\frac{3}{4}$	4-E	4	$1\frac{1}{8}$	$6\frac{3}{8}$

WARNING SIGNS

See Note No. 10





















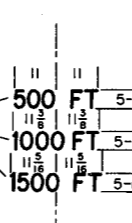


PLATE DETAILS

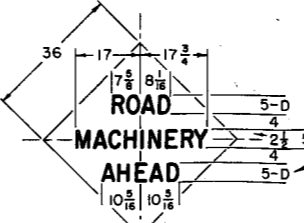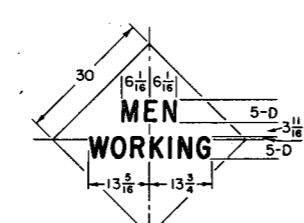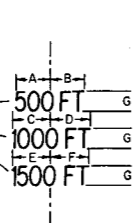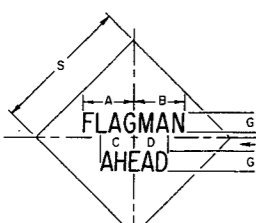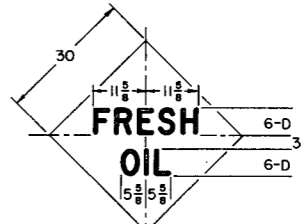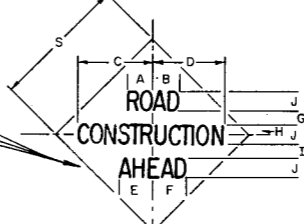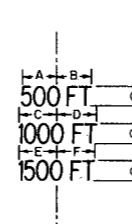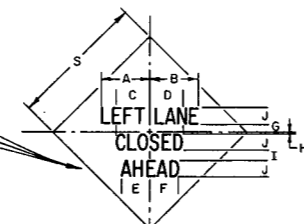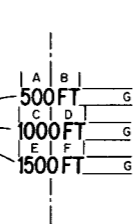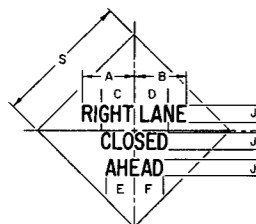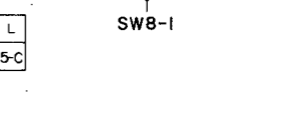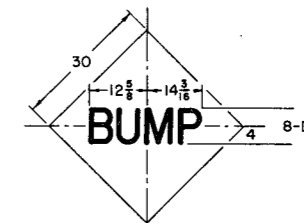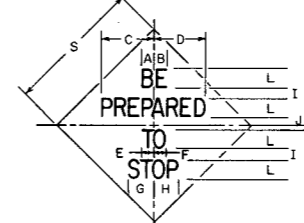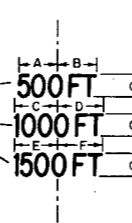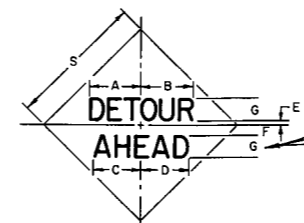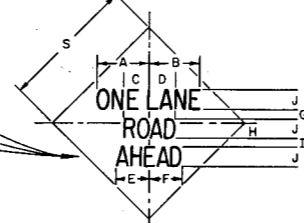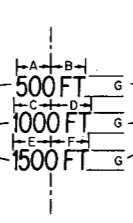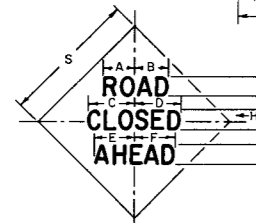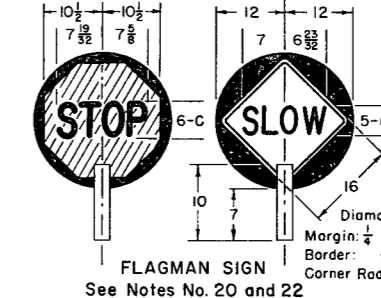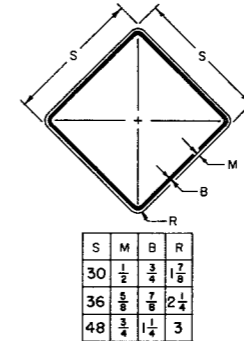

FLAGMAN SIGN
See Notes No. 20 and 22








NOTES:

SEE SHEET 1 FOR TYPICAL SIGNING AND SIGN PLACEMENT.
SEE SHEET 3 FOR GENERAL NOTES APPLICABLE TO SHEETS 1 AND 2.

ALL DIMENSIONS THAT ARE NOT LABELED ARE IN INCHES.

GUIDE SIGNS

See Note No. 11

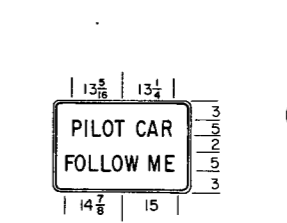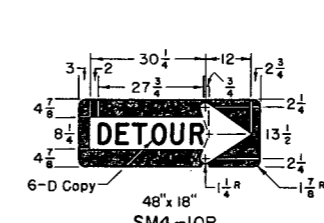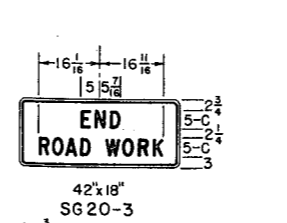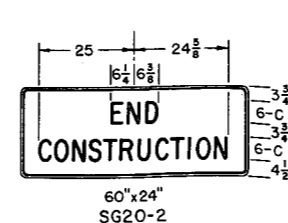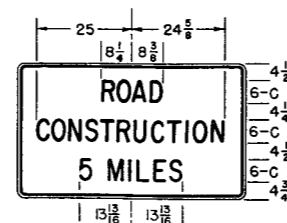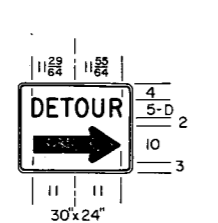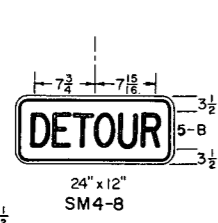

DEPARTMENT OF HIGHWAYS
STATE OF COLORADO
DIVISION OF HIGHWAYS
TRAFFIC SIGNING
FOR HIGHWAY
CONSTRUCTION

Designed By: D.R.W.
Made By: H.B.D.
Checked By: J.B.

Approved By: *[Signature]*
Traffic Engineer
Date: AUGUST 9, 1965

STANDARD M-614-TB

(SHEET 3 OF 3 SHEETS)

(JULY 1, 1965)

FEDERAL ROAD REGION NO.	DIVISION	PROJECT NO.	SHEET NO.
9	COLORADO		

REVISIONS			
(R-1)	7-12-67	Added Note 23	G.W.F.
(R-2)	7-8-68	Rev. Note 23 & Dept. Name -	
		Deleted Note	G.W.F.
(R-3)	12-24-68	Rev. Note No. 18	J.L.S.
(R-4)	11-22-71	Rev. Notes	J.J.S.

GENERAL NOTES

- (R-4) 1. All work shall be done in accordance with: (a) the Standard Specifications applicable to the Project, and (b) the "Manual on Uniform Traffic Control Devices for all Classes of Streets and Highways" published by the U.S. Department of Transportation, Federal Highway Administration, and the related Colorado Supplement.
2. Where traffic is maintained through or over any part of the Project the Contractor will be required to mark all hazards within the limits of the Project (including connecting roads) with well-maintained Barricades, Warning, and Guide Signs. All Barricades and Signs shall be moved, added to, changed or removed as required during the progress of construction and removed entirely when the Project is completed.
- (R-4) 3. Where traffic is prohibited from the Project the Detour will be marked by the Division except that the Contractor shall provide, erect and maintain Barricades, complete, (when required) at the ends of the Project, ends of the Detour and connecting roads. All U.S. or State Route Markers required for the Project will be furnished and installed by the Division. The location and positioning of Warning Signs, Barricades, and Regulatory Signs shall be as recommended by the appropriate District Engineering Forces of the Division.
4. Work on the Project shall not be started until all required signs are in place and approved by the Engineer. Where speed control appears necessary such speed control shall be requested from the Engineer by the Contractor. Control of speed through a construction zone may be achieved by Advisory Speed plates in conjunction with Warning Signs (SW13-1 for use with 30" Warning Signs and XW13-1 for use with 36" and 48" Warning Signs). The Advisory Speed plate is to be posted only at those locations where the safe speed is lower than the imposed Regulatory speed limit.
5. All Signs and Barricades shall be placed for best visibility and legibility, maintained in good condition and kept clean and free of dirt at all times. Contractor's and Engineer's vehicles and equipment must be parked so that signs and barricades are visible to approaching traffic at all times.
6. Where two identical signs are used for dual posting they are to be staggered on the two sides of the roadway for a minimum distance of 75' to avoid a tunneling effect.
7. Examples for marking Projects, as shown on Sheet 1, are typical of signs required and are subject to alteration to fit actual conditions encountered in the field. Locations for control devices are to be staked by the Engineer. In all cases Warning signs are to be placed well in advance of the hazard, the distance depending on topography and existing approach speeds. Additional markings and any special signs required for the guidance and protection of traffic will be placed as required on the Project at the Contractor's expense.
- (R-4) 8. Desirable sizes for signs are shown on Sheet 1 of this Standard. Larger or smaller signs shall be used where warranted. Detailed dimensions for signs normally used in connection with construction are shown on Sheet 2 of this Standard. For information on standard roadway signs not detailed on this Standard see the "Manual on Uniform Traffic Control Devices for all Classes of Streets and Highways" published by the U.S. Department of Transportation, Federal Highway Administration, and the related Colorado Supplement.
9. Signs with the prefix "R" in the sign code are Regulatory signs and as such impose legal compulsions or restrictions on drivers and should only be used as authorized by the Engineer.
10. Signs with the prefix "W" in the sign code are Warning signs and are used to alert traffic to existing or potentially hazardous conditions.
11. Signs with the prefix "D" or "M" in the sign code are Guide signs. Those with the prefix "D" convey general information and those with the prefix "M" are used for marking the traffic route.
- (R-4) 12. All signs shall be reflectorized unless otherwise specified on plans. Regulatory signs (unless otherwise specified) shall have a screen processed black legend and border on a white flexible reflective sheeting, non-exposed lens background. The back side of Regulatory and Guide signs shall be painted with two coats of "Exterior Sign White Paint." Warning signs shall have a screen processed black legend and border on an orange flexible reflective sheeting, non-exposed lens background. The back side of Warning signs shall be painted with two coats of exterior sign white. Guide signs shall have a black message on an orange background.
13. Painting for wood surfaces shall conform with Section 508 of the Standard Specifications.
14. Posts for regulatory, warning, and guide signs will normally be 4"x 4" or 6"x 6" and shall conform to the Standard Specifications for Untreated Timber-S4S. Timber shall conform to Construction grade Paragraph 123B or 125B of Standard No. 15 Grading & Dressing Rules for West Coast Douglas Fir (1956) or Dense Structural 58 and LL Structural 58 Paragraph 284 or 285 of 1956 Grading Rules for Southern Pine. Posts shall be painted with one coat of "White Wood Primer" and one coat of "Outside White Paint."
15. Sign panels furnished by the Contractor for use only during construction may be fabricated from plywood, aluminum, steel or other suitable material but shall be stable and durable enough to meet other requirements of this Standard.
16. All material shall be sound and durable. Barricades, signs, symbols, and lettering shall be of good workmanship. Uneven lettering will not be accepted.
- (R-4) 17. Alternate methods of processing signs or the substitution of symbols or other reflecting elements for painted symbols will be permitted only after approval by the Division.
- (R-3) 18. Lanterns and Torches - Lanterns, shall be used only in low speed urban areas. Open-flame torches shall not be used under any circumstances.
- (R-4) 19. Barricades, Flashing Beacons and Flashers - Refer to appropriate Division Standard Drawings (Timber Barricades) for details.
20. Flagman Sign - This sign shall have a black painted background on both sides to form a contrast for the octagonal Stop sign and the diamond Warning sign. The "STOP" sign shall be fabricated by reverse screen process using transparent red paint on smooth surface silver reflective sheeting. The "SLOW" side of the Flagman Sign shall be black process paint on smooth surface orange reflective sheeting. Handle to be grooved on one side to indicate reading of sign to Flagman.
- (R-4) 21. Sign "A": This is the first advance warning sign and shall be placed 1,500 feet ahead of Barricade or project terminal. Postings are required on both sides of the roadway on divided highways. Dual posting is required where warranted on two-lane, two-way highways.
Sign "B": This is the second advance warning sign and shall be placed 1,000 feet ahead of barricade or project terminal. Postings are required on both sides of the roadway on divided highways and singly on two-lane, two-way highways.
Sign "C": This is the third advance warning sign in cases where barricades are used and shall be placed 500 to 750 feet ahead of barricade or potentially hazardous condition. Postings are required on both sides of the roadway on divided highways and singly on two-lane, two-way highways.
Sign "D": SG20-1 This sign shall be placed to mark the beginning of a Project of more than 2 miles in extent, where traffic is maintained through the project. It shall be placed singly and near the beginning of construction.
Sign "E": SG20-2 This sign shall be placed to mark the end of the Project. It shall be placed singly and may be placed opposite barricade if desirable.
Sign "F": Construction identification signs shall be furnished and installed by the Division on all Federal-Aid and Forest Highway Projects where actual construction is in progress and visible to highway users. These signs should be located so as not to obscure or detract from the effectiveness of other official signs. Where two or more projects are contiguous the appropriate data may be included in one set of signs. Refer to appropriate Division Standard Drawings (Identification Signs) for sign details. Signs A through F shall be furnished, installed and maintained by the Division.
22. When Flags are used in lieu of the Flagman Sign, they shall be a minimum of 18"x18", made of a good grade of bright red material, and fastened securely to a staff of approximately 3 foot length. The free edge should be weighted to insure that the flag will hang vertically, even in heavy winds.
- (R-1) 23. Each 6"x6" timber sign post shall be provided with two 2" diameter holes through the neutral axis normal to the roadway, one hole at 6" and one hole at 18" above the ground level. The 4"x4" timber posts shall not be provided with any type of break-away device. The inside portion of each 2" diameter hole shall be painted white. The underground portion of each timber post shall be treated with creosote.

(R-2)

(R-2)

DEPARTMENT OF HIGHWAYS STATE OF COLORADO DIVISION OF HIGHWAYS TRAFFIC SIGNING FOR HIGHWAY CONSTRUCTION	
Designed By: D.R.W.	Approved By: <i>[Signature]</i>
Made By: J.L.S.	Traffic Engineer
Checked By: J.B.	Date: AUGUST 9, 1965


STANDARD S-612-51A

(SHEET 1 OF 2 SHEETS)
SEPTEMBER 29, 1972


FEDERAL ROAD REGION NO.	DIVISION	PROJ. NO.	SHEET NO.	TOTAL SHEETS
VIII	COLORADO			

REVISIONS			
NO.	DATE	REVISED BY	REVISION
(R-1)	10-26-72	Rev. Std. No., Notes & Red Usage	J.D.S.

TYPICAL INSTALLATION FOR DIAMOND INTERCHANGE

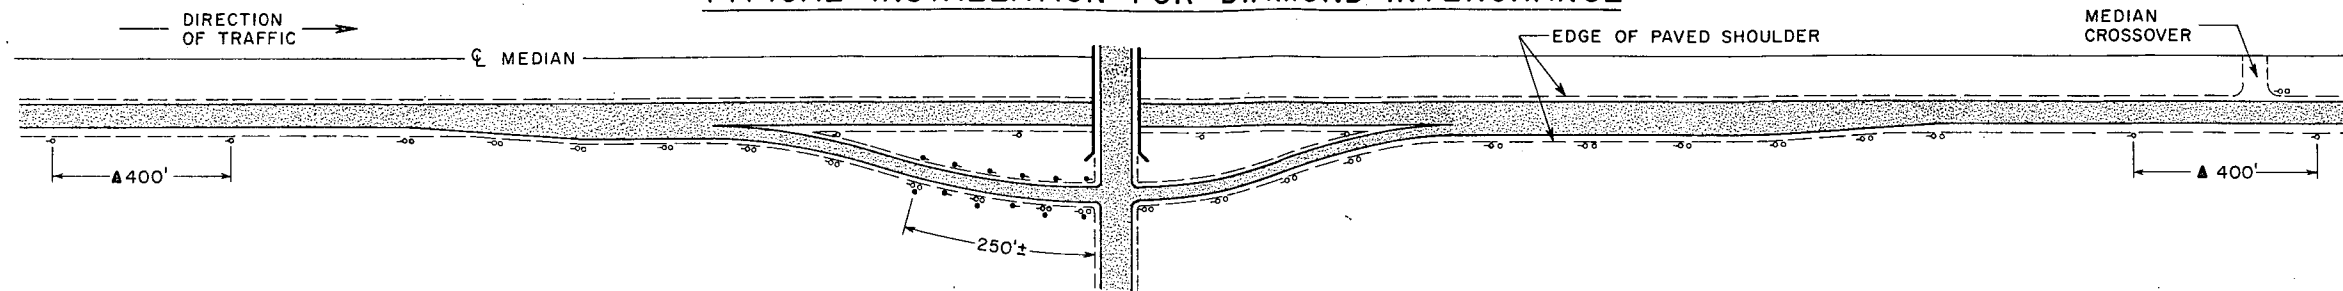

TYPICAL INSTALLATION FOR CLOVERLEAF INTERCHANGE

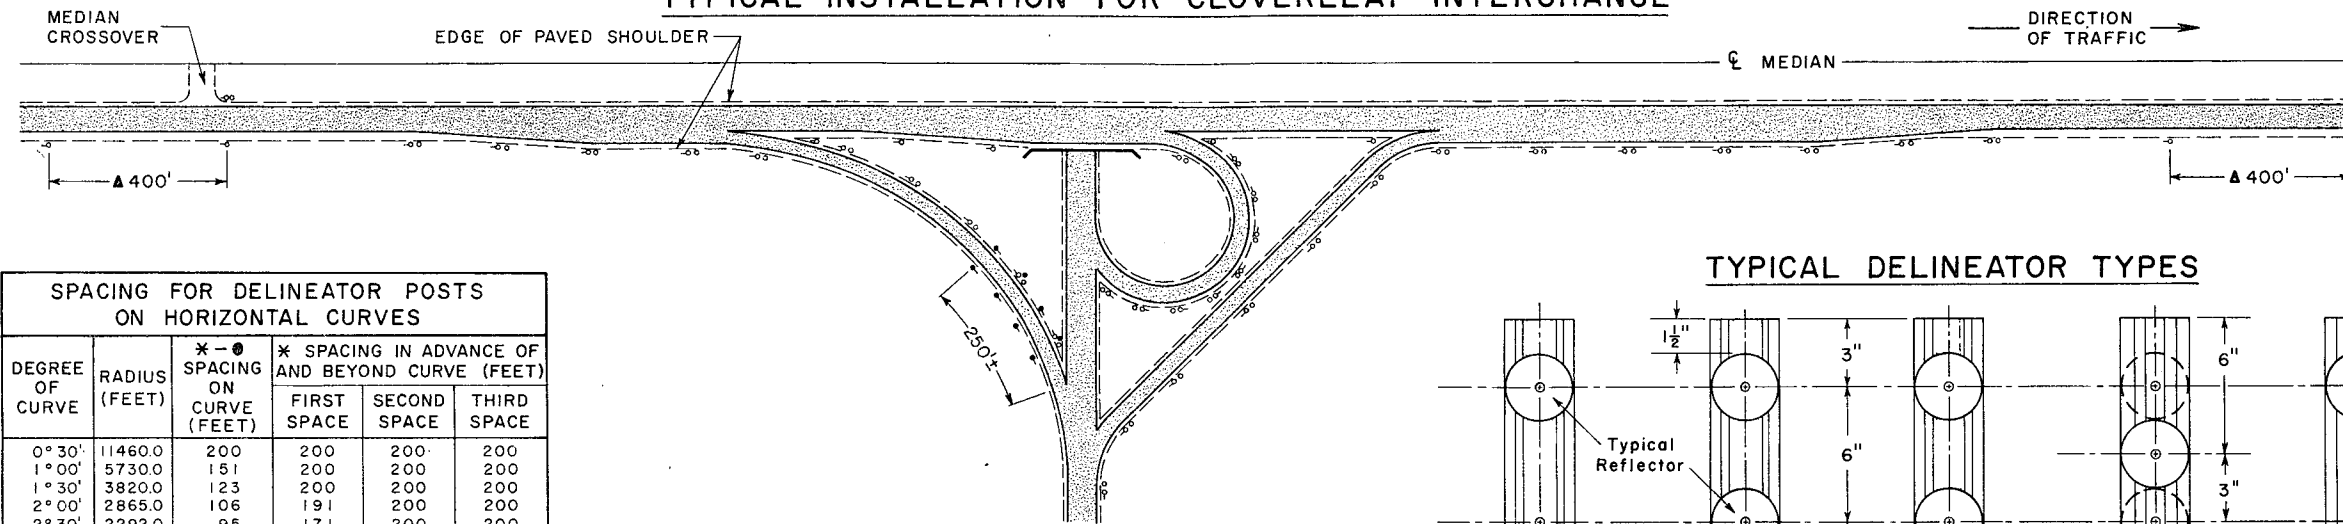

PLAN LEGEND

- ⊕ TYPE I DELINEATORS
- ⊙ TYPE II DELINEATORS
- ⊘ TYPE III DELINEATORS
- ⊗ TYPE IV DELINEATORS
- ⊙ TYPE V DELINEATORS
- (R-1) ▲ EXPRESSWAY SPACING (Delineators will not be required on tangents of Conventional and Frontage roadways.)

SPACING FOR DELINEATOR POSTS ON HORIZONTAL CURVES					
DEGREE OF CURVE	RADIUS (FEET)	*-⊙ SPACING ON CURVE (FEET)	* SPACING IN ADVANCE OF AND BEYOND CURVE (FEET)		
			FIRST SPACE	SECOND SPACE	THIRD SPACE
0° 30'	11460.0	200	200	200	200
1° 00'	5730.0	151	200	200	200
1° 30'	3820.0	123	200	200	200
2° 00'	2865.0	106	191	200	200
2° 30'	2292.0	95	171	200	200
3° 00'	1910.0	86	155	200	200
3° 30'	1637.1	80	144	200	200
4° 00'	1432.5	74	133	200	200
4° 30'	1273.3	70	126	200	200
5° 00'	1146.0	66	119	198	200
5° 30'	1041.8	63	113	189	200
6° 00'	955.0	60	108	180	200
6° 30'	881.5	58	104	174	200
7° 00'	818.6	55	99	165	200
7° 30'	764.0	53	95	159	200
8° 00'	716.3	52	94	156	200
8° 30'	674.1	50	90	150	200
9° 00'	636.7	48	86	144	200
9° 30'	603.2	47	85	141	200
10° 00'	573.0	46	83	138	200
10° 30'	545.7	45	81	135	200
11° 00'	520.9	43	77	129	200
11° 30'	498.3	42	76	126	200
12° 00'	477.5	41	74	123	200
15° 00'	382.0	36	65	108	200
18° 00'	318.3	33	59	99	198
21° 00'	272.9	30	54	90	180
25° 00'	229.2	27	49	81	162
30° 00'	191.0	24	43	72	144

(R-1) * OMIT THIRD SPACE ON PRIMARY AND SECONDARY ROUTES AND DOUBLE THE DISTANCE ON THE CURVE AND IN ADVANCE OF AND BEYOND THE CURVE. FOR CURVES LESS THAN 2 DEGREES ON EXPRESSWAY THROUGH ROADWAYS USE EXPRESSWAY TANGENT SPACING.

● $S = 2 \sqrt{R-50}$ (NO SPACES TO EXCEED 200 FEET)


FIRST SPACE = 1.8 S
SECOND SPACE = 3 S
THIRD SPACE = 6 S

GENERAL NOTES


- All work shall be done in accordance with the Standard Specifications applicable to the Project.
- See the Tabulation in the Plans for delineator requirements.
- Spacing between posts on acceleration and deceleration lanes and on relatively straight portions of interchange ramps shall be 100' on Interstate and 200' on Primary and Secondary projects. Spacing between posts on the outside of interchange ramp curves shall be as indicated in the table with a 24' minimum. Post spacing in advance of and beyond the curve shall not apply to ramp curves.
- When guard rail is present, place delineators outside and at a height that permits an unobstructed view of all reflectors.
- Delineators are not to be placed beyond tangent points of reversing curves for median transitions. (See Sheet 2)
- Delineators may be placed on the median side of a roadway when the Engineer determines that a location is hazardous and/or that each side can be treated as an independent roadway due to horizontal or vertical separation.
- When normal delineator spacing falls on an intersecting roadway it may be moved either direction a distance not to exceed 1/4 of the normal space.
- Type, location and spacing of delineators for tunnels and snow sheds shall be as directed by the Engineer.
- Frontage road delineators are not to be installed where they might be misleading to mainline traffic.
- Install face of delineator at 90 degrees to centerline of the roadway.
- The color of delineator posts shall be Interstate Green.

(R-1) General Notes continued on Sheet 2.

TYPICAL DELINEATOR TYPES

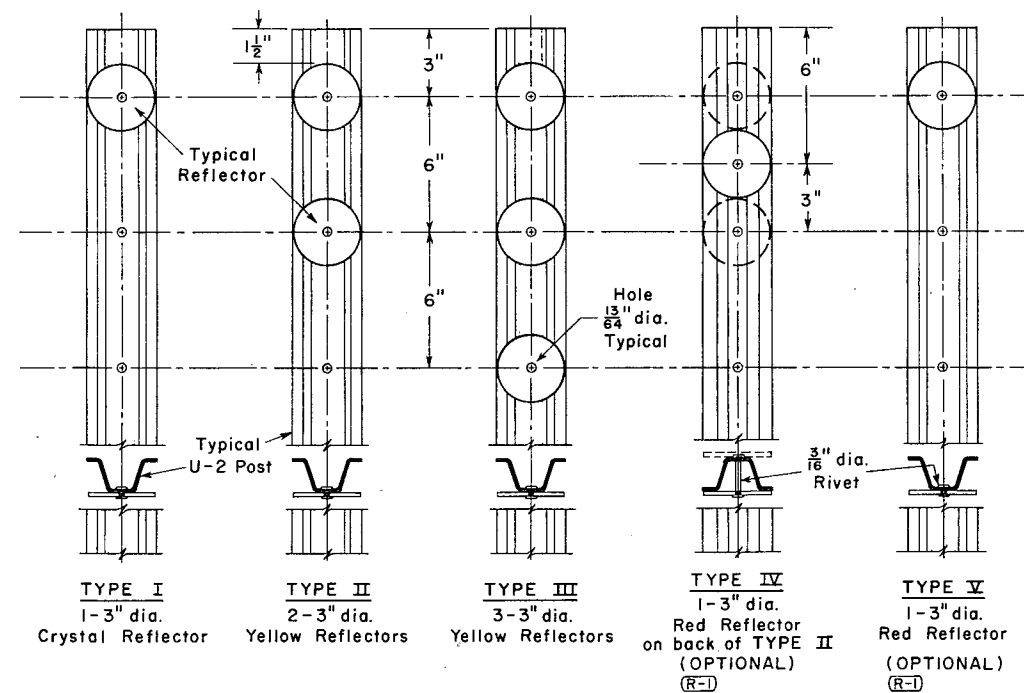


TYPICAL U-2 POST SECTION AND NOTES

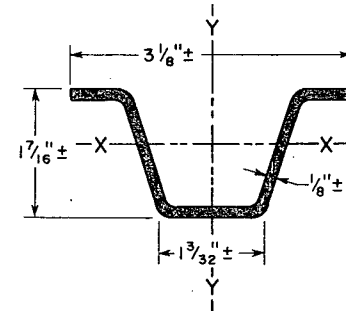

Steel posts shall meet requirements of Paragraph 4.5 U.S. Dept. of Commerce Commercial Standard 184-51. Re-rolled rails are acceptable material. Posts are to weigh 2 lbs./ft. with a mill tolerance of minus 3 1/2% of the weight of any one post being allowed. Alternate post is acceptable if section modulus is at least 0.200 in.³ about the X-X axis and at least 0.250 in.³ about the Y-Y axis. Posts shall be set in drilled or excavated holes, placed plumb and firmly tamped in place; or may be driven plumb. A minimum of 3 holes for Types I, II, III and V and a minimum of 4 holes for Type IV delineator posts with 1 3/64 inch diameter, are required (spacing as shown above).

TYPICAL DELINEATOR PLACEMENT

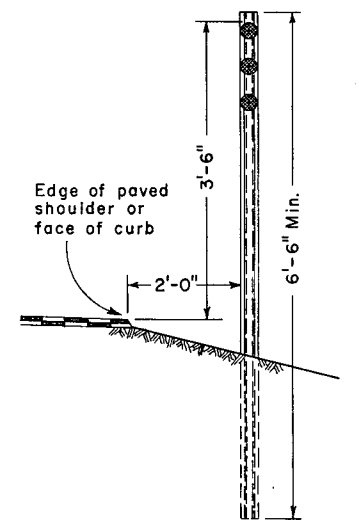

DEPARTMENT OF HIGHWAYS
STATE OF COLORADO
DIVISION OF HIGHWAYS
TYPICAL
DELINEATOR
INSTALLATIONS

Designed By: G.W.F. Approved By: *[Signature]*
Made By: F.J.B. Traffic Engineer
Checked By: J.D.S. Date: Sept. 22, 1972


STANDARD S-612-51A

(SHEET 2 OF 2 SHEETS)
SEPTEMBER 29, 1972


FEDERAL ROAD REGION NO.	DIVISION	PROJ. NO.	SHEET NO.	TOTAL SHEETS
VIII	COLORADO			

REVISIONS		
NO.	Rev. Std. No., Notes & Red Usage.	J.D.S.
(R-1)	10-26-72	


TYPICAL INSTALLATION FOR CHANNELIZED INTERSECTION

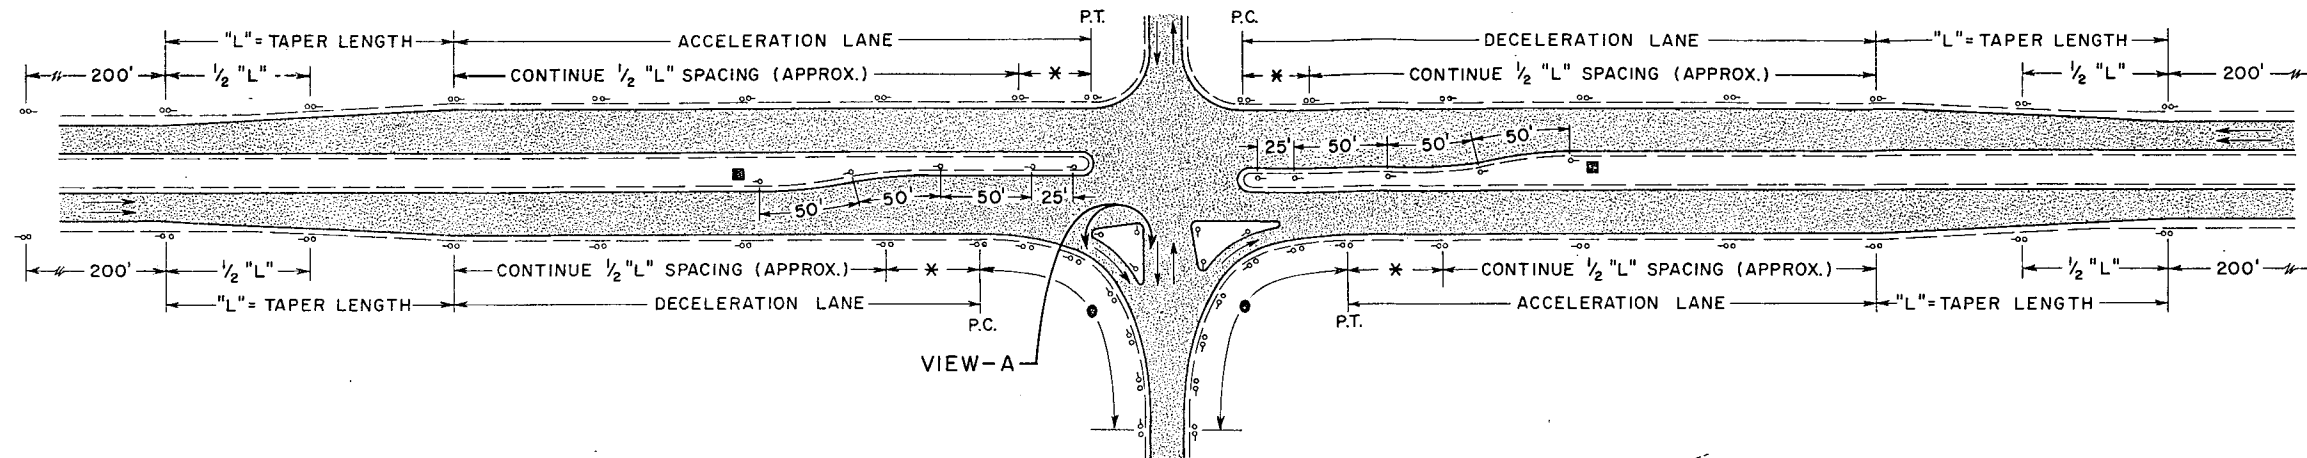


VIEW-A, TYPICAL ISLAND

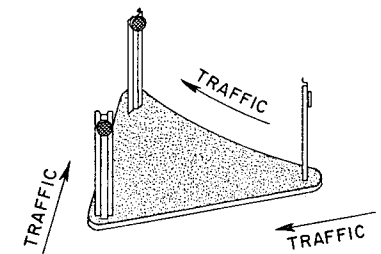

TYPICAL INSTALLATION FOR 4-LANE DIVIDED HIGHWAY

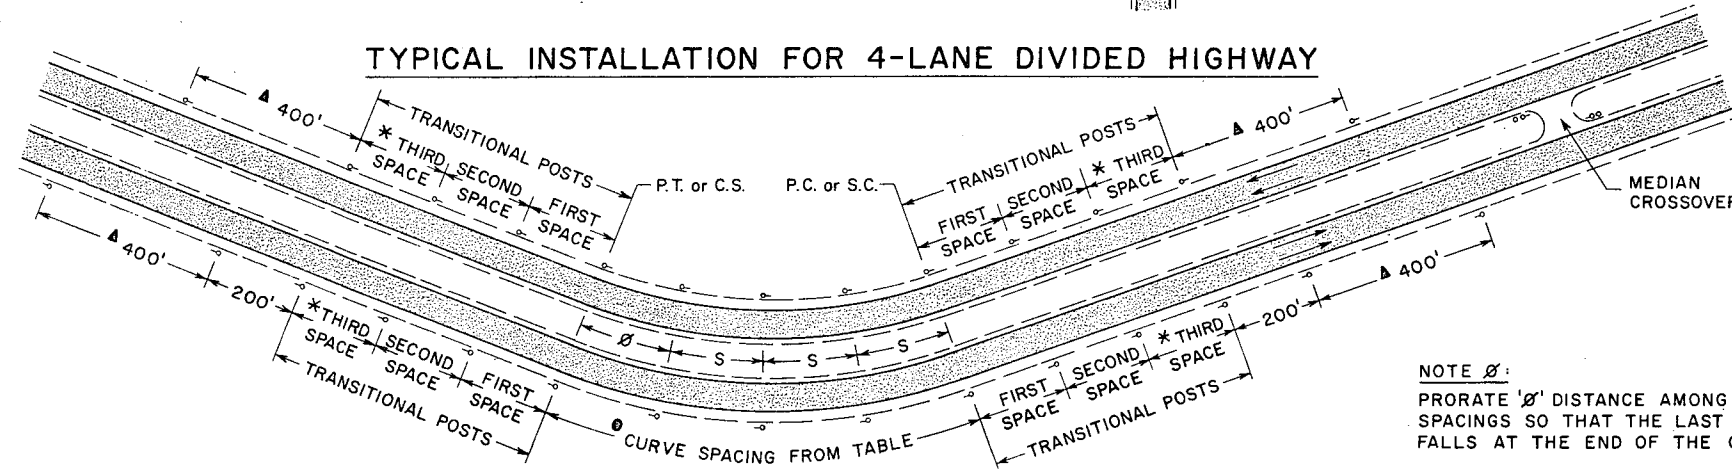


TYPICAL INSTALLATION FOR 2-LANE, 2-WAY HIGHWAY

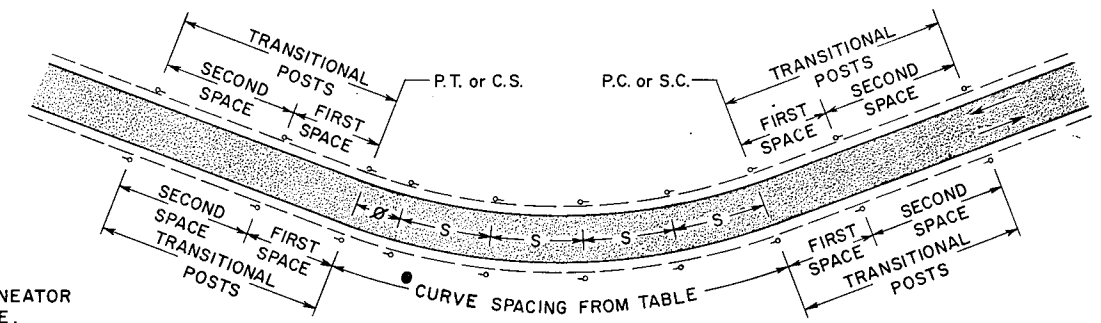

NOTE Ø:
PRORATE 'Ø' DISTANCE AMONG ALL SPACINGS SO THAT THE LAST DELINEATOR FALLS AT THE END OF THE CURVE.

TYPICAL INSTALLATION FOR BRIDGE APPROACHES

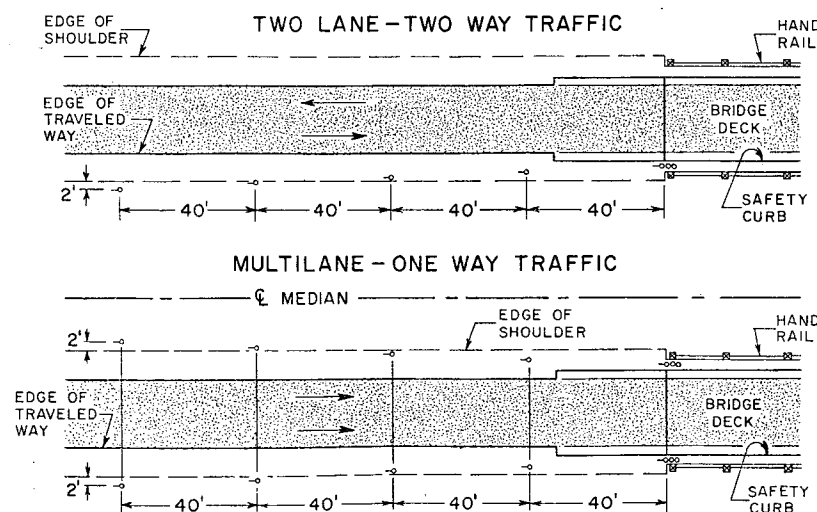


BRIDGE NOTES
WHERE CURB TO CURB WIDTH OF BRIDGE IS EQUAL TO OR GREATER THAN ROADWAY WIDTH PLUS USABLE SHOULDER WIDTH, USE THE TYPE III DELINEATORS ONLY AND OMIT ALL THE TYPE I DELINEATORS.
WHEN APPROACH SLAB HAS CURB, PLACE THE TYPE III DELINEATOR IMMEDIATELY BEHIND THE CURB.

GENERAL NOTES CONT'D.


12. Red delineators may be installed on existing roadways where investigation shows a need to guard against wrong-way movements.

TYPICAL DELINEATOR FABRICATION DETAILS


TYPES I, II, III & V

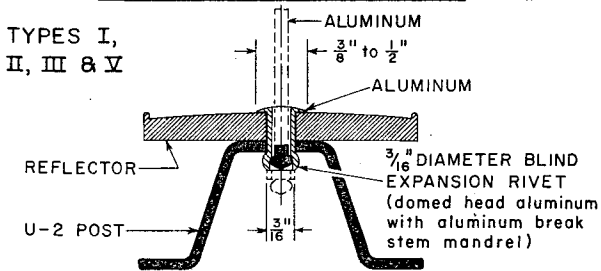

TYPE IV (Red Reflector)

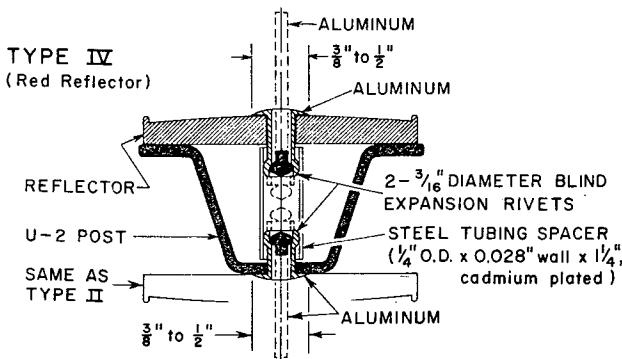

TYPICAL INSTALLATION FOR CLIMBING LANE TRANSITION

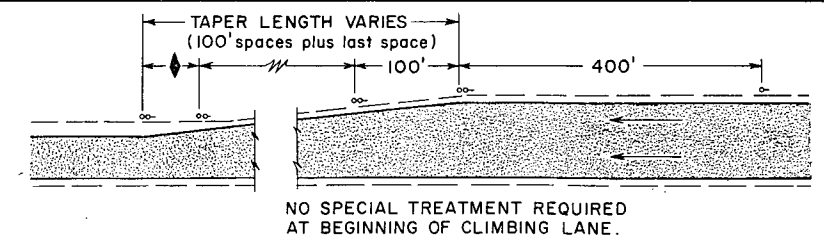

PLAN LEGEND

- TYPE I DELINEATORS
- TYPE II DELINEATORS
- TYPE III DELINEATORS
- (R-1) ▲ EXPRESSWAY SPACING
- SEE GENERAL NOTE 5
- * SEE SPACING TABLE
- SEE SPACING TABLE
- ◆ LAST SPACE (Space is variable - not to exceed 100')

DEPARTMENT OF HIGHWAYS
STATE OF COLORADO
DIVISION OF HIGHWAYS
TYPICAL DELINEATOR INSTALLATIONS

Designed By: G.W.F. Approved By: *[Signature]*
Made By: F.J.B. Traffic Engineer
Checked By: J.D.S. Date: Sept 29, 1972


STANDARD S-614-52A

(MARCH 1, 1972)

FEDERAL ROAD REGION NO.	DIVISION	PROJ. NO.	SHEET NO.	TOTAL SHEETS
VIII	COLORADO			


REVISIONS		
(R-1)	6-26-73	Notes

TYPE 1 BARRICADE

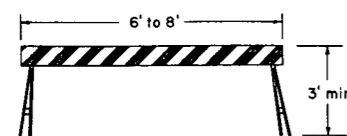


May be fabricated of lumber, aluminum or other suitable light weight materials of structural soundness. Stands may be detachable for mobility.

TYPE 2 BARRICADE

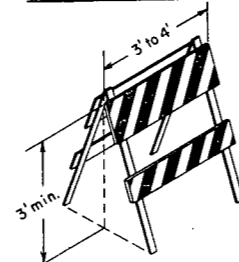

May be fabricated of lumber, aluminum or other suitable light weight materials of structural soundness.

TYPICAL TYPE 3 BARRICADES (Timber)

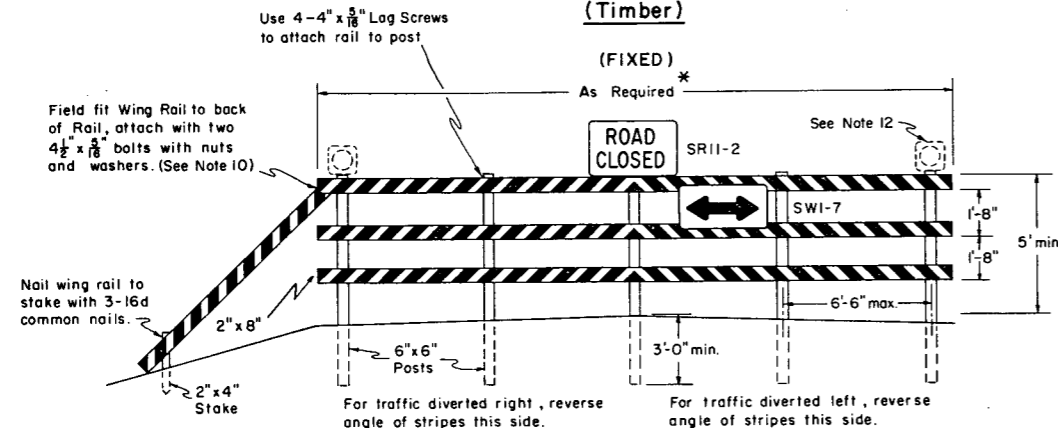

Nail wing rail to stake with 3-16d common nails.

Field fit Wing Rail to back of Rail, attach with two 4 1/2 x 3/8 bolts with nuts and washers. (See Note 10)

Use 4-4" x 1/8" Lag Screws to attach rail to post

For traffic diverted right, reverse angle of stripes this side.

For traffic diverted left, reverse angle of stripes this side.

See Note 12

As Required

5' min.

6" x 6" Posts

3'-0" min.

6'-6" max.

2" x 8" Stake

2" x 4" Stake

2" x 8"

4" x 6" Posts and Braces

1'-8"

1'-8"

5' min.

6'-6" max.

4" x 6" Skids

Sandbags for added stability

RIGID


DEMOUNTABLE

HINGED


	BARRICADE DESIGNATIONS		
	TYPE 1	TYPE 2	TYPE 3
Rail Width	8" min. - 12" max.	Top-8" min. - 12" max. Mid-4" min. - 8" max.	8" min. - 12" max.
Rail Length	6' to 8'	3' to 4'	As Required, see Table *
Height	3' min.	3' min.	5' min.
Stripes	See Detail of Barricade Striping		See Notes 4 & 7
Frame	Demountable or Heavy Duty "A" Frame	Light "A" Frame	Posts, Skids or "A" Frame
Flexibility	Movable	Portable	Fixed or movable
Use	Temporary	Temporary	Temporary or Permanent

RAIL LENGTH TABLE *		
TYPE 3 BARRICADE		LENGTH
FIXED	MOVABLE	
F-A	M-A	8' - 14'
F-B	M-B	15' - 24'
F-C	M-C	25' - 35'
F-D	M-D	> 35'

DETAIL OF BARRICADE RAIL STRIPING

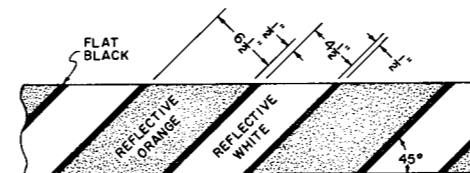


Temporary Barricades (For construction and maintenance operations only)

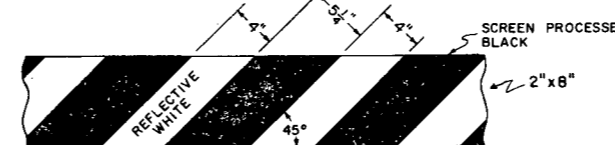

Permanent Barricades

TYPICAL VERTICAL PANEL CHANNELIZING DEVICE

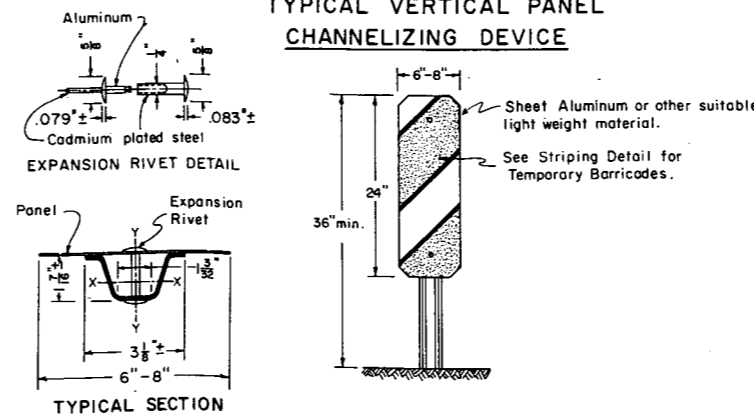

TYPICAL SECTION

GENERAL NOTES

- All work shall be done in accordance with the Standard Specifications applicable to the project.
- All signs, sign materials, beacons, and barricade warning lights shall conform to the standards set forth in the "Manual on Uniform Traffic Control Devices for Streets and Highways" published by the Federal Highway Administration, of current issue, and the Colorado Supplement thereto, and this standard.
- The various types and combinations of approved signs and beacons for barricades required for each project shall be governed by field conditions and subject to approval by the Engineer. Typical barricade applications are shown in Part 6 of the Manual on Uniform Traffic Control Devices for Streets and Highways.
- Painting shall conform with Subsections 508.08 and 614.07 of the Standard Specifications. All skids, braces and posts shall be painted with 2 coats of "Exterior White Paint". Horizontal and wing rails on all temporary barricades shall have orange and white stripes with a narrow flat black stripe separating the orange and white stripes as shown in striping detail. The entire area of orange and white stripes shall be reflectorized. For striping of permanent barricades see Note 7.
- Each barricade rail shall be striped on the face side only with stripes slanting downward at a 45° angle toward the side to which traffic is to turn or pass. The backsides of rails shall be painted with "Exterior White Paint".
- When fixed barricades are designated on plans, the portion of the posts below ground line shall be dipped in hot creosote oil. The portion of the post above ground line shall be painted with 2 coats of "Exterior White Paint".
- A Fixed Type 3 Barricade which is required as a permanent installation shall have rails striped with black and white in lieu of orange and white. The white stripes shall be 4" in width, the black stripes shall be 5/4" wide as shown in striping detail. The white stripes shall be reflectorized. The posts of a permanent installation shall be painted with 2 coats of "Exterior White Paint".
- All skids, braces, rails and posts shall be nailed together with No. 20d nails. All screws, bolts, nuts and washers shall be galvanized or cadmium plated. Skids (bases) of movable barricades shall be weighted where necessary to provide stability.
- All timber shall be Grade No. 2 or better, S 4 S, Douglas fir or Larch, as described in the current Standard Grading Rules published by the Western Wood Products Association, and shall conform to applicable paragraphs for the rails and posts.
- Detachable extension wing rails for bypassing of construction equipment are permitted when necessary. The length is variable and shall be adequate to provide closing of borrow pit and/or shoulder as required. May be used on Fixed or Movable Type 3 Barricades.
- Alternate materials or other reflective elements on traffic signs or barricades will be permitted only after approval of such material by the Division in writing.
- Flashing Beacons or Barricade Warning Lights shall be used in connection with barricades when called for by the Engineer. When used, they shall be positioned above the top rail of the barricades to produce the most effective results. When used, Barricade Warning Lights shall be of the type specified by the Engineer.
- All reflective surfaces shall be reflective sheeting of the smooth surface type.
- Barricades used as "Traffic Controls for Highway Construction" are not to be paid for separately.
- Barricades will be paid for separately when designated on plans as bid items.

DEPARTMENT OF HIGHWAYS
STATE OF COLORADO
DIVISION OF HIGHWAYS

BARRICADES AND VERTICAL PANEL CHANNELIZING DEVICES

Designed By: GWF
Made By: JVN
Checked By: GWF

Approved By: *[Signature]*
Traffic Engineer
Date: March 1, 1972