

COLORADO DEPARTMENT OF HIGHWAYS


PLAN AND PROFILE OF PROPOSED COMB. FEDERAL AID PROJECT NO. DF013-1(5) & COLORADO PROJECT NO. ~~C19-0102-11~~ STATE HIGHWAY NO. 102 YUMA COUNTY

INDEX OF SHEETS		
SHEET NO.	1	TITLE SHEET
	2-28	TABULATION SHEETS
	3-20	PLAN & PROFILE SHEETS
	21-24	OWNERSHIP MAPS

FEDERAL ROAD REGION NO.	DIVISION	PROJ. NO.	SHEET NO.	TOTAL SHEETS
9	COLORADO	DF 013-1(5) C19-0102-11	1	


RIGHT OF WAY

CONVENTIONAL SIGNS

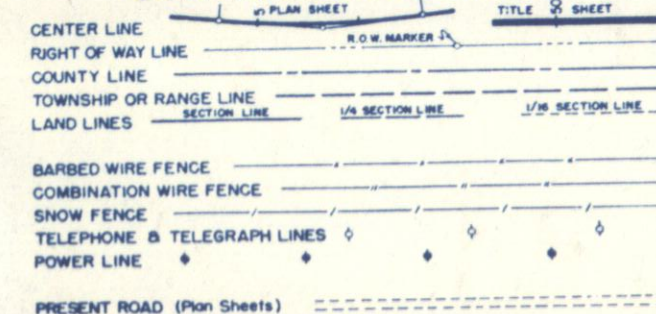

SCALES OF ORIGINAL DRAWINGS

ON PLAN, 1 IN. = 100 FT.
ON PROFILE, 1 IN. = 100 FT. HORIZONTAL
1 IN. = 10 FT. VERTICAL
GRADE LINE ON PROFILE IS SHOWN AS GRADE OF FINISHED ROAD
GROSS LENGTH OF PROJECT
NET LENGTH OF PROJECT

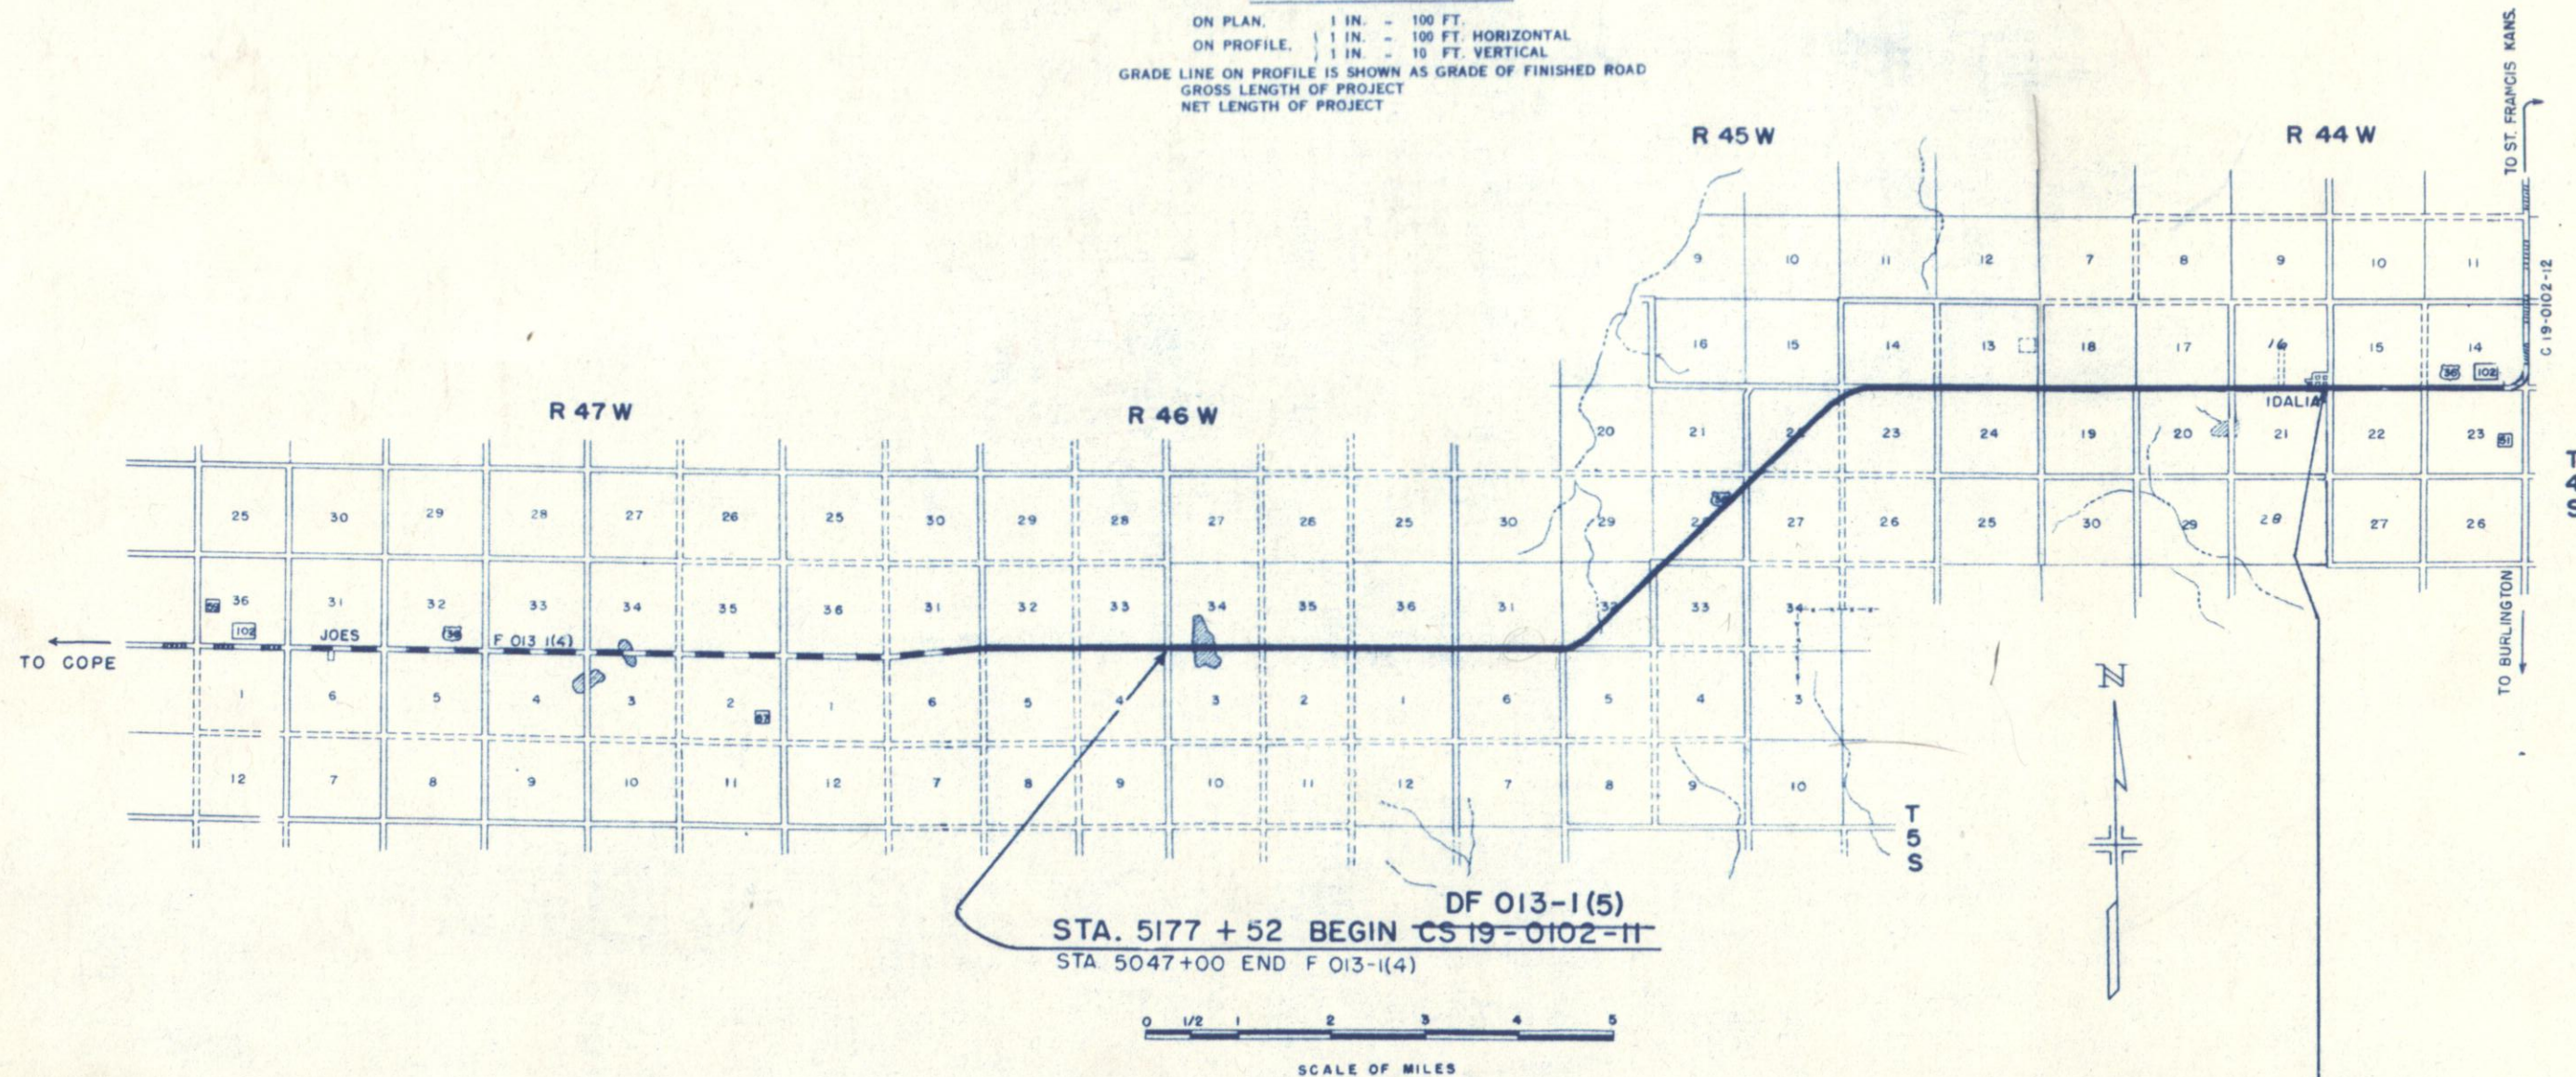

DF 013-1(5)
STA. 5177 + 52 BEGIN ~~C19-0102-11~~
STA. 5047+00 END F 013-1(4)

DF 013-1(5)
STA. 5885 + 00 END ~~C19-0102-11~~
STA. 5885 + 00 BEGIN C19-0102-

R.O.W. TABULATION OF PROPERTIES IN

YUMA

COUNTY S.H.No. 102

PROJ.

DF 013-1(5)
CS 19-0102-H

FEDERAL ROAD DISTRICT	PROJ. NO.	SHEET NO.	TOTAL SHEETS
0	DF 013-1(5) CS 19-0102-H	2A	7

RIGHT OF WAY Rev. 7-2-58 21Rev.F.C.M.

PARCEL NO.	OWNER	ADDRESS	LOCATION	AREA IN		DATE	LAND	IMPROV'M'TS	DAMAGE	MISC.	TOTAL	REMARKS	NO
				PARCEL	TO BE ACQUIRED								
			T. 4 S., R. 45 W.										
20	LOUIS FLEER JR.	IDALIA, COLO.	NE 1/4 Sec. 28	11.330	11.125								
21Rev.	BARBARA A. LAWRENCE	WRAY, COLO.	NW 1/4 NW 1/4 Sec. 27	2.190	1.653								
22	ARTHUR LOHMAN	WRAY, COLO.	SW 1/4 Sec. 22	12.228	12.058								
23	HENRY RICHERS & CHRISTINA RICHERS, J.T.	ST. FRANCIS, KANSAS	SE 1/4 NW 1/4 Sec. 22	0.582	0.582								
24	LUCILLE SARA McALLISTER	BOX 234A Rt. 2 VANCOUVER, WASHINGTON	NE 1/4 Sec. 22	12.634	12.432								
25	GEORGE W. WINGFIELD, Contract for sale to: FRANK G. KEJR & HARRY KEJR	IDALIA, COLO.	S 1/2 SW 1/4 Sec. 14	4.094	1.600								
26	WILLIAM F. GERBER	IDALIA, COLO.	S 1/2 SE 1/4 Sec. 14	4.658	2.152								
27	HAROLD W. LANGENDOERFER	IDALIA, COLO.	S 1/2 S 1/2 Sec. 13	9.192	4.245								
28	RICHARD A. MILLER Et al	505 TENTH ST. FT. MADISON, IOWA	N 1/2 NW 1/4 Sec. 23	5.623	3.064								
29	CORINNE O. PETERSON, TRUSTEE	WRAY, COLO.	N 1/2 NE 1/4 Sec. 23	4.657	2.150								
30	STATE OF COLORADO		N 1/2 NW 1/4 Sec. 24	4.693	2.168								
31	HERMAN H. BRINKHOFF & ANNA H. BRINKHOFF, J.T.	IDALIA, COLO.	N 1/2 NE 1/4 Sec. 24	4.498	2.077								
			T. 4 S., R. 44 W.										
32	VETA STALCUP Et al	JULESBURG, COLO.	S 1/2 SW 1/4 Sec. 18	4.726	2.798								
33	CORINNE O. PETERSON, TRUSTEE	WRAY, COLO.	S 1/2 SE 1/4 Sec. 18	4.756	2.853								
34	CORINNE O. PETERSON, TRUSTEE	WRAY, COLO.	S 1/2 SW 1/4 Sec. 17	4.524	2.706								
35	HARRY P. WUDTKE	IDALIA, COLO.	S 1/2 SE 1/4 Sec. 17	4.625	2.111								
36	FRED H. EBELER	IDALIA, COLO.	N 1/2 N 1/2 Sec. 19	9.544	5.648								
37	H. W. MOELLENBERG	ARMEL, COLO.	N 1/2 NW 1/4 Sec. 20	4.620	2.745								
38	MARGARET JANE PYLE (CLARKE) % GENE P. WARNER	WRAY, COLO.	N 1/2 NE 1/4 Sec. 20	4.709	2.194								
39	MARGARET JANE PYLE (CLARKE) % GENE P. WARNER	WRAY, COLO.	N 1/2 NW 1/4 Sec. 21	4.776	2.256								
40	EDWARD RAMSEIER	IDALIA, COLO.	N 1/2 NE 1/4 Sec. 21	3.472	1.650								

R.O.W. TABULATION OF PROPERTIES IN YUMA

YUMA

COUNTY S.H. No. 102 PROJ.

DF 013-1(5)

~~CS 19-0102-11~~




FEDERAL ROAD DIVISION NO.	DISTRICT	PROJ. NO.	SHEET NO.	TOTAL SHEETS
9	COLORADO	DF 013-1(15) C-19-0102-11	28	

RIGHT OF WAY Rev. 7-2-58 48 Rev. F.C.M.

NO.	OWNER	ADDRESS	LOCATION	AREA IN ACRES		DATE	LAND	IMPROV'M'TS	DAMAGE	MISC.	TOTAL	REMARKS	NO.
				PARCEL	TO BE ACQUIRED								
41	J KENNETH CONRAD & MARGUERITE CONRAD, J T.	WRAY, COLO.	T. 4 S., R. 44 W. SW 1/4 SW 1/4 Sec 16	2.322	1.338								
42	GEORGE W. WINGFIELD	IDALIA, COLO.	S 1/2 S 1/2 Sec 16	3.308	1.495								
43	W.F. WILCOXEN & ELLA V. WILCOXEN, J. T.	IDALIA, COLO.	SW 1/4 SE 1/4 Sec 16	0.718	0.322								
44	MARTIN E. STUTHEIT	IDALIA, COLO.	SE 1/4 SE 1/4 Sec 16	0.021	0.021								
45	MRS. MARTIN E. STUTHEIT	IDALIA, COLO.	SE 1/4 SE 1/4 Sec 16	0.050	0.050								
46	CORINNE PETERSON(1/2),CARL O. PETERSON(1/2)	WRAY, COLO.	SE 1/4 SE 1/4 Sec 16	0.005	0.005								
47	BOARD OF TRUSTEES FOR THE ST. PAUL EVANGELICAL ASSOCIATION	IDALIA, COLO.	SE 1/4 SE 1/4 Sec 16	0.032	0.032								
48	MINNIE L. HUGHEY		SE 1/4 SE 1/4 Sec 16	0.034	0.034								
49	CORINNE PETERSON(1/2),CARL O. PETERSON(1/2)	WRAY, COLO.	SE 1/4 SE 1/4 Sec 16	0.005	0.005								
50	ROSE BEECHLEY	IDALIA, COLO.	SE 1/4 SE 1/4 Sec 16	0.032	0.032								
51	CORINNE PETERSON(1/2),CARL O. PETERSON(1/2)	WRAY, COLO.	SE 1/4 SE 1/4 Sec 16	0.012	0.012								
52	METROPOLITAN LIFE INSURANCE CO.		SE 1/4 SE 1/4 Sec 16	0.046	0.046								
53	CORINNE PETERSON(1/2),CARL O. PETERSON(1/2)	WRAY, COLO.	SE 1/4 SE 1/4 Sec 16	0.005	0.005								
54	WILLIAM J. BRENNER & ELSIE V. BRENNER, J. T.	IDALIA, COLO.	SE 1/4 SE 1/4 Sec 16	0.030	0.030								

Rev. 7-18-58 1 Rev. R.E.C. Rev. 7-8-58 4 Deleted R.E.C.			
FED. ROAD DIST. NO.	STATE	PROJ. NO.	SHEET NO.
3	COLO.	DF 013-1(5) CS-19-0102-11	4
RIGHT OF WAY			

S.S. Sec. 34, T.4S, R.46W.
ORA, L. STREET & EVA I. STREET, J.T.
REV. KIRK, COLO.

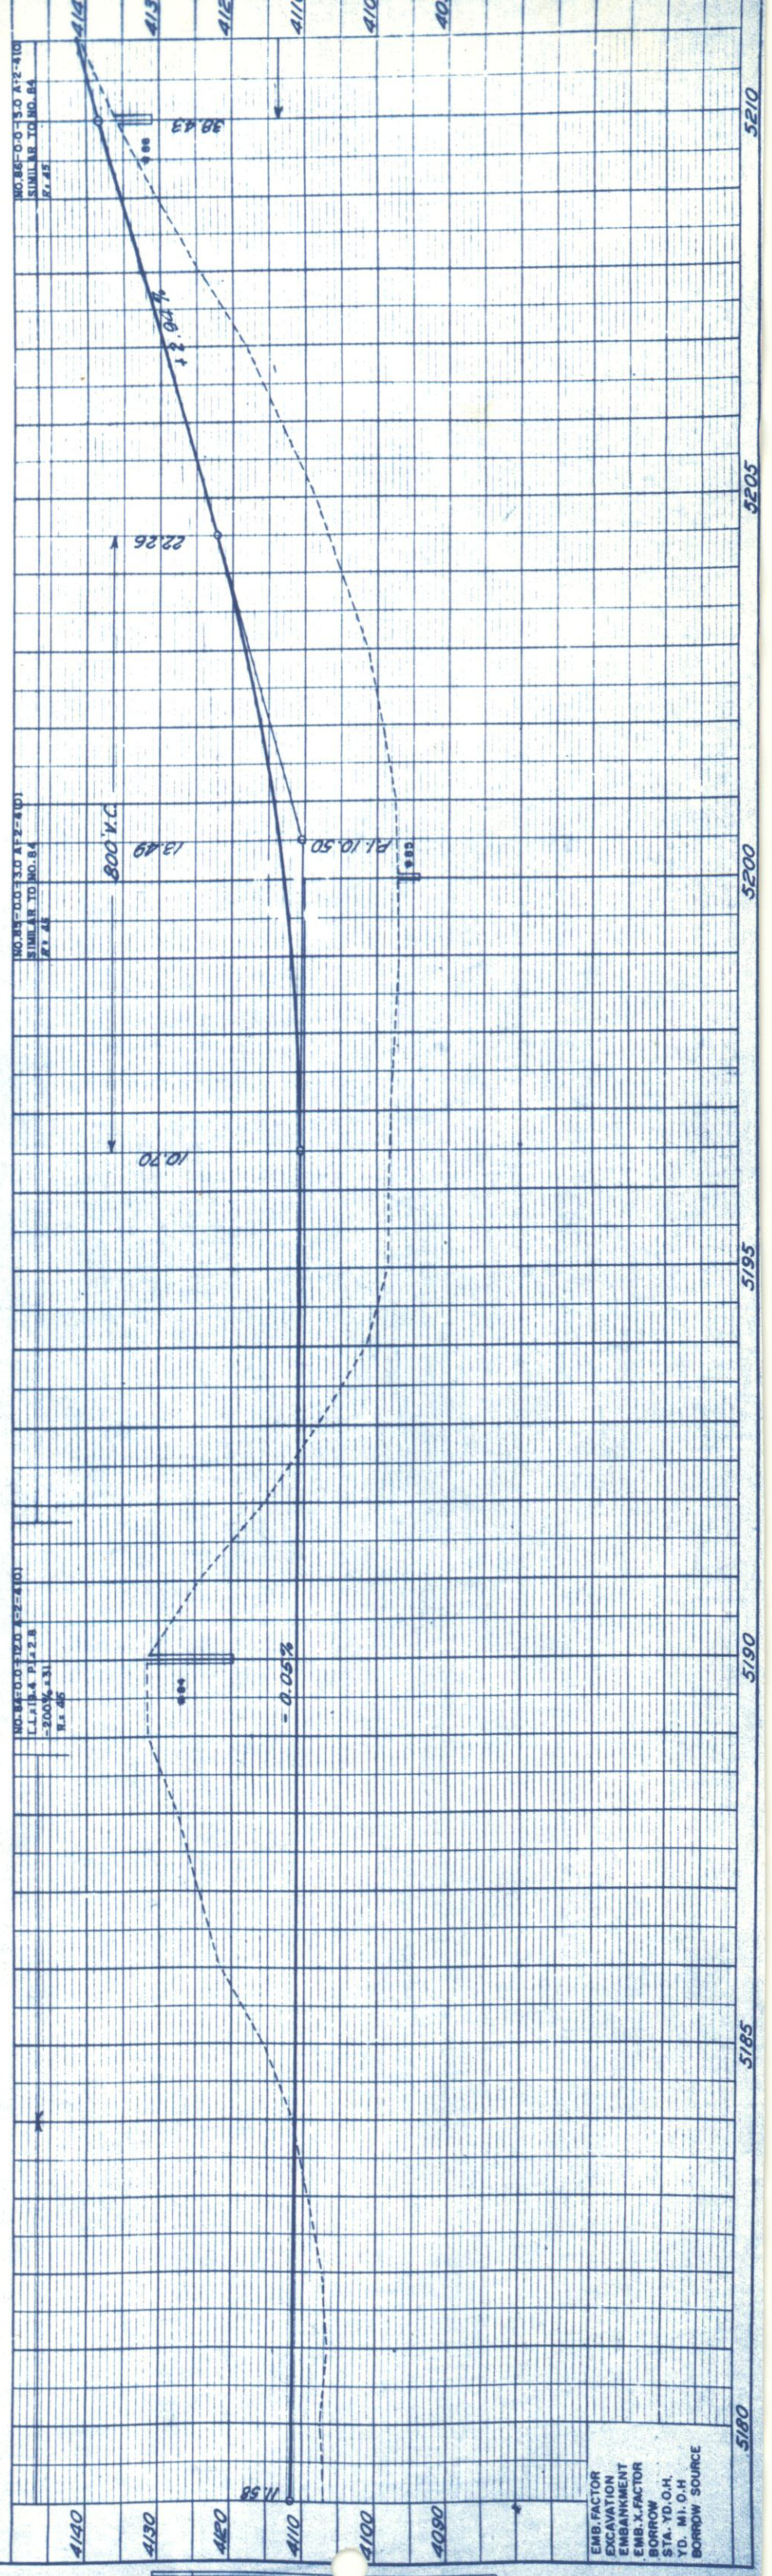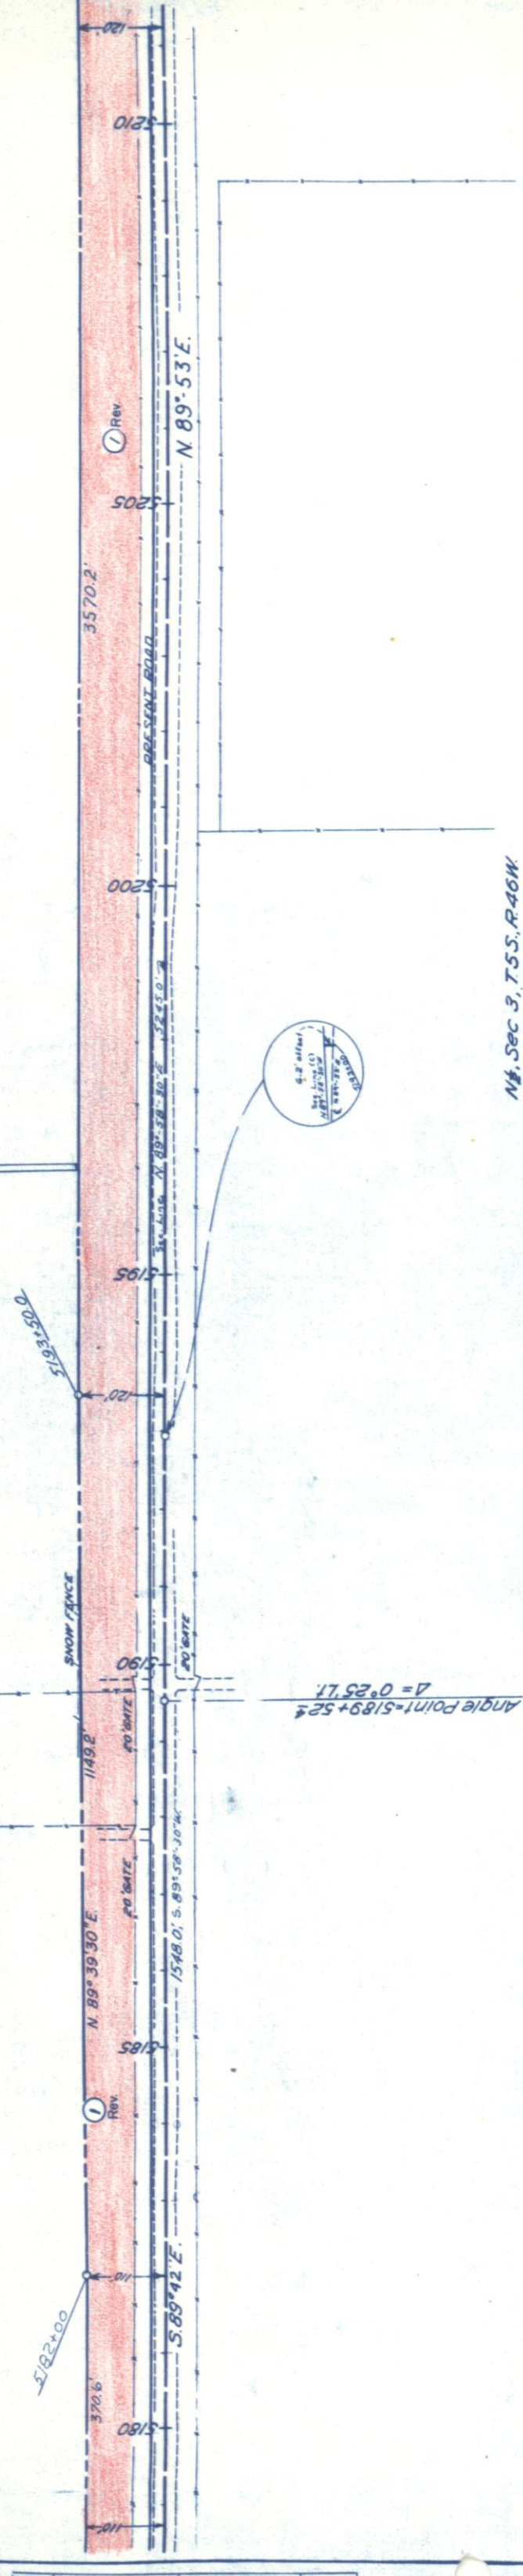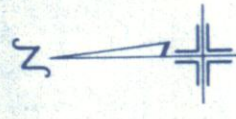

EMB. FACTOR
EXCAVATION
EMBANKMENT
EMB. X. FACTOR
BORROW
STA. YD. O.H.
YD. M. O.H.
BORROW SOURCE

S. 1/2 Sec. 34, T. 4 S., R. 46 W.


Rev. 7-18-58 | Rev. R.E.C.

1 ORA L. STREET & EVA I. STREET, J.T.
KIRK, COLO.

RIGHT OF WAY S. 1/2 Sec. 35, T. 4 S., R. 46 W.


2 WILLIAM J. BRENNER &
ELSIE V. BRENNER, J.T.
IDALIA, COLO.

FED. ROAD DIST. NO.	STATE	PROJ. NO.	SHEET NO.	TOTAL SHEETS
3	COLO.	DF 013-11(5) 69-19-002-H	5	

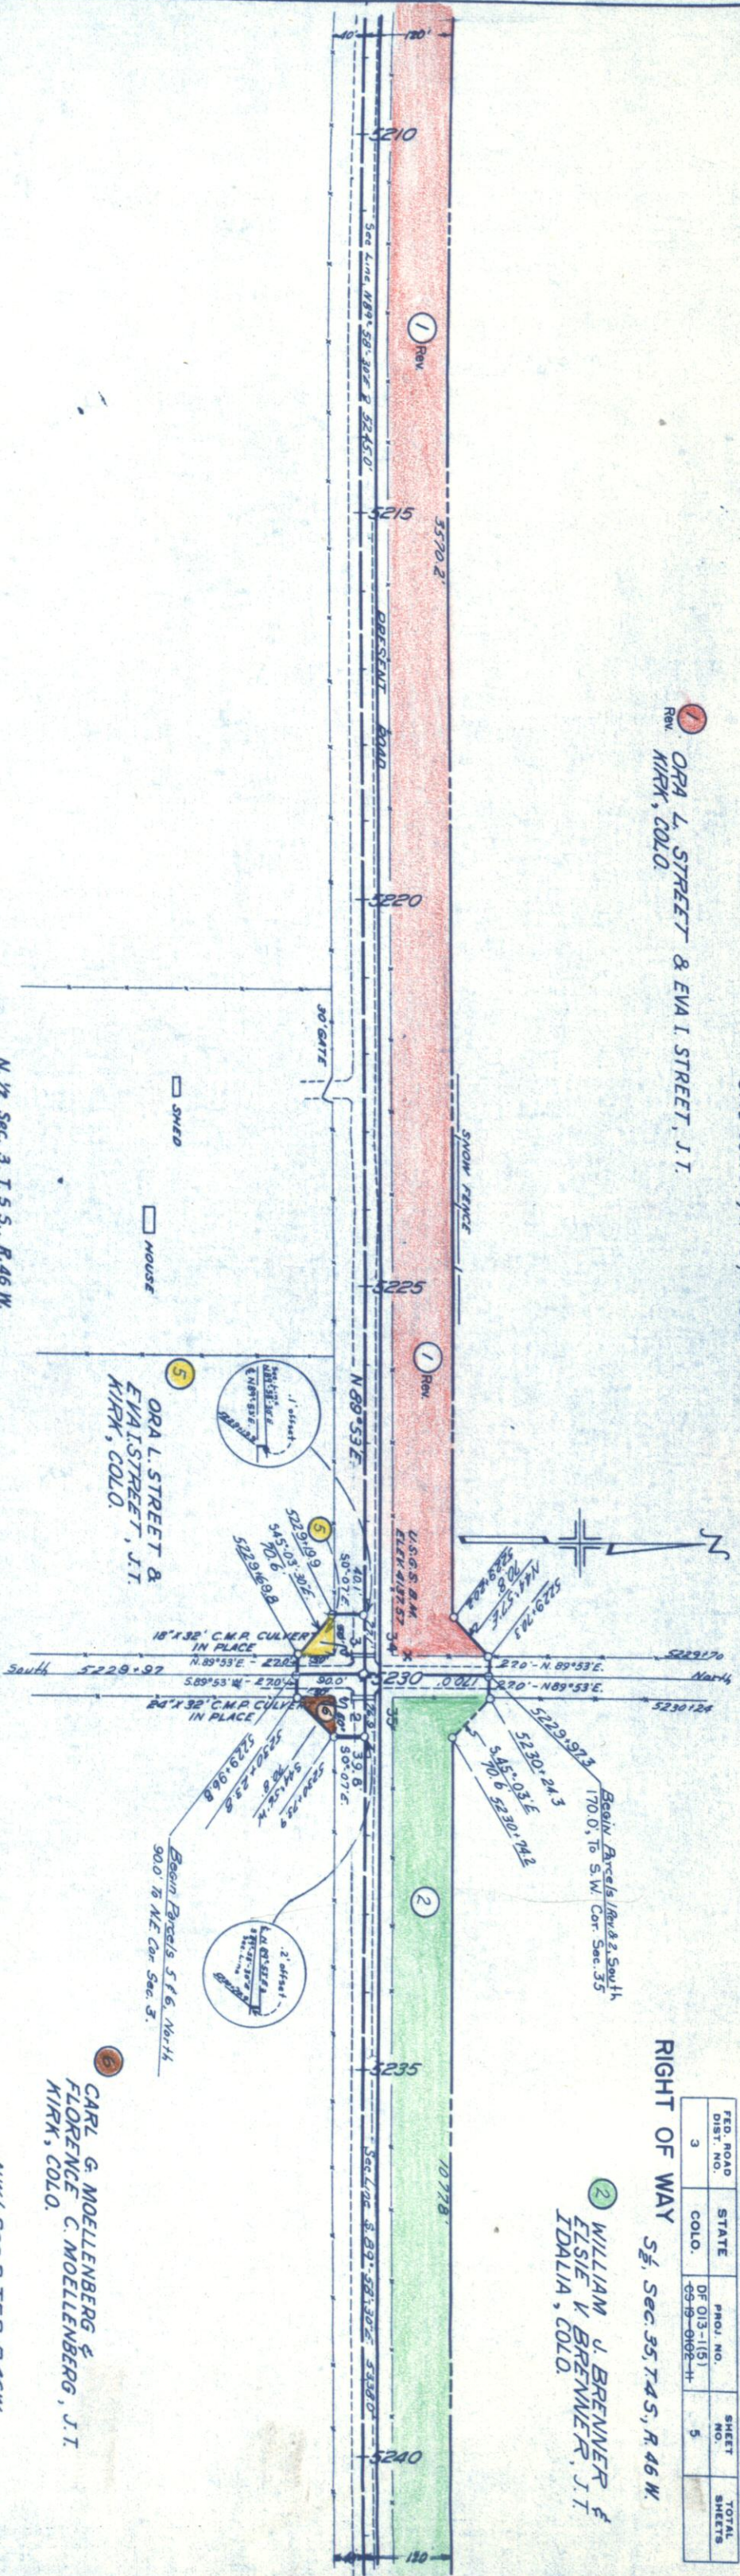

N. 1/2 Sec. 3, T. 5 S., R. 46 W.

NW 1/4 Sec. 2, T. 5 S., R. 46 W.

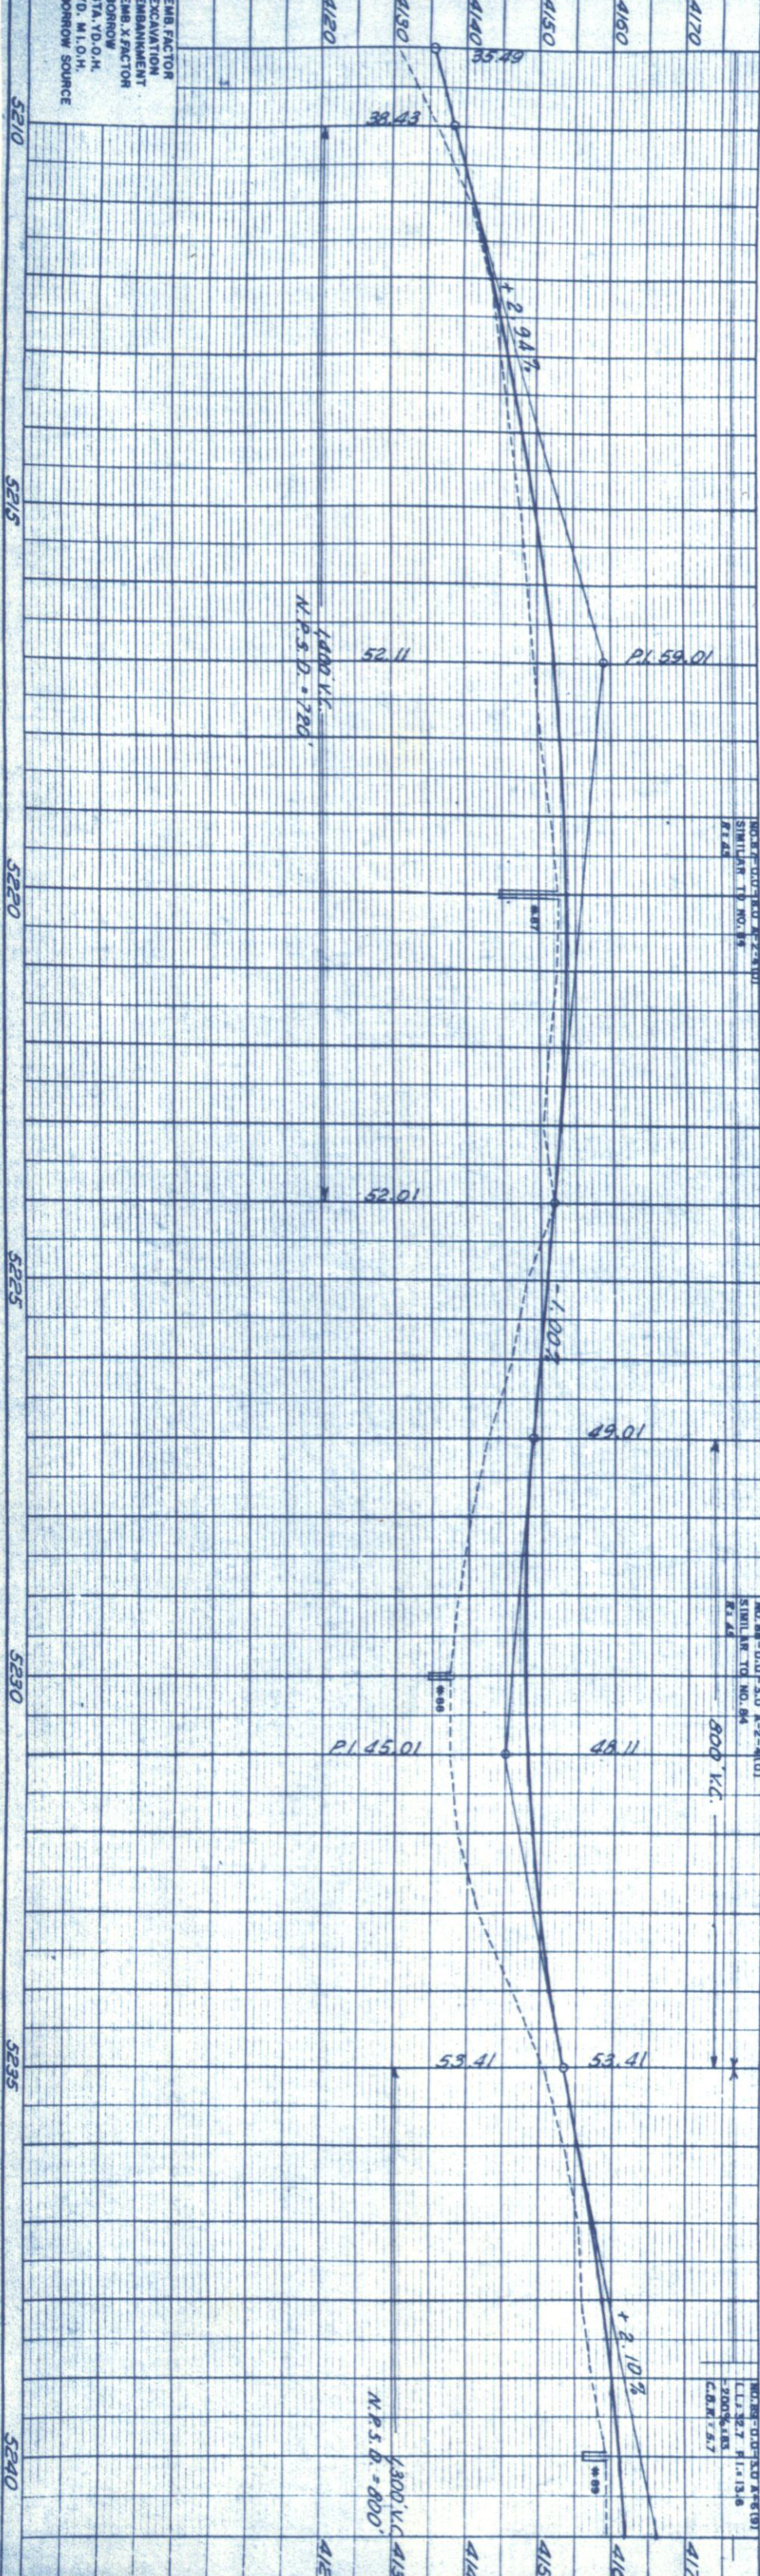


③ SCHOOL LAND
STATE OF COLO.

Sec. 36, T.4 S., R. 46 W.

FED. ROAD DIST. NO.	STATE	PROJ. NO.	SHEET NO.	TOTAL SHEETS
3	COLO.	DF 013-1(5) CS 19-0102-11	7	

RIGHT OF WAY

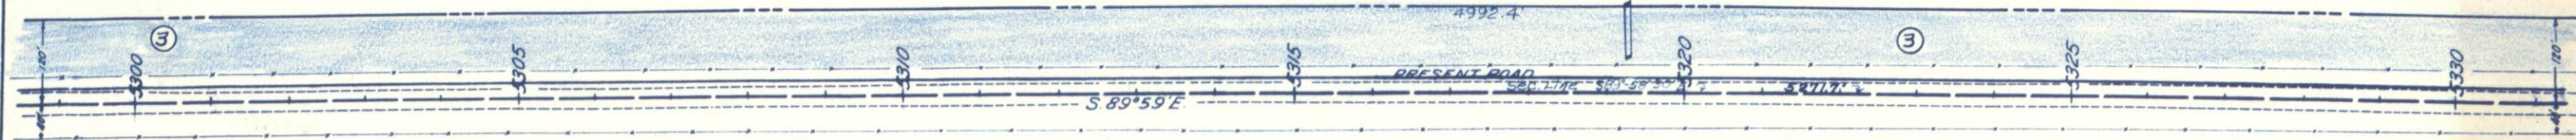


N. 1/2 Sec. 1, T. 5 S., R. 46 W.

NO. 96-0.0-3.0 A-6(9)
SIMILAR TO NO. 89
C.B.R. 5.7

NO. 97-0.0-3.0 A-6(9)
SIMILAR TO NO. 89
C.B.R. 5.7

NO. 98-0.0-3.0 A-6(9)
SIMILAR TO NO. 89
C.B.R. 5.7

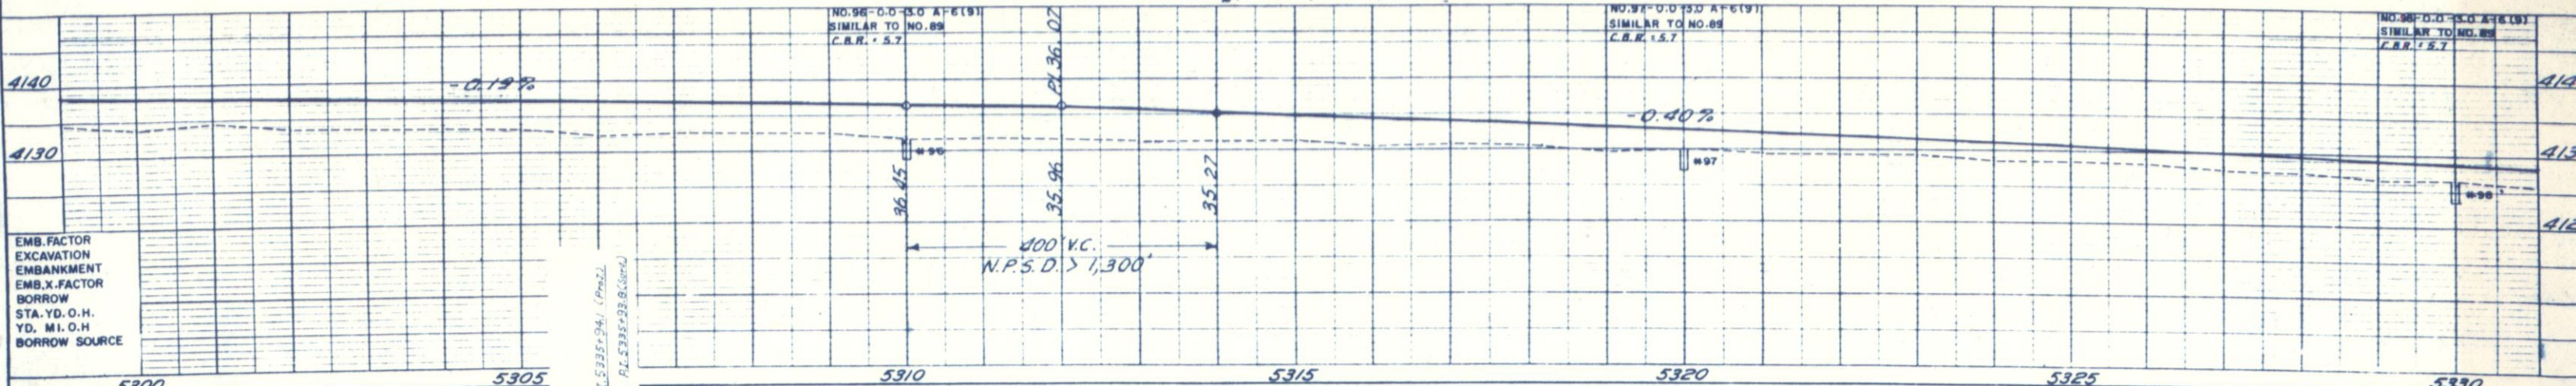

EMB. FACTOR
EXCAVATION
EMBANKMENT
EMB. X. FACTOR
BORROW
STA. YD. O.H.
YD. MI. O.H.
BORROW SOURCE

Sec. 36, T. 4 S., R. 46 W.
③ SCHOOL LAND
STATE OF COLORADO


SW 1/4 Sec. 31, T. 4 S., R. 45 W.

⑩ DOROTHY A. DUTTON
Rt. 4
McCOOK, NEBR.



⑨ MILDRED M. DUTTON, Et al
Rt. 4
McCOOK, NEBR.
NE 1/4 Sec. 1, T. 5 S., R. 46 W.

⑫ CARL O. PETERSON &
JOHN C. PETERSON
WRAY, COLO.

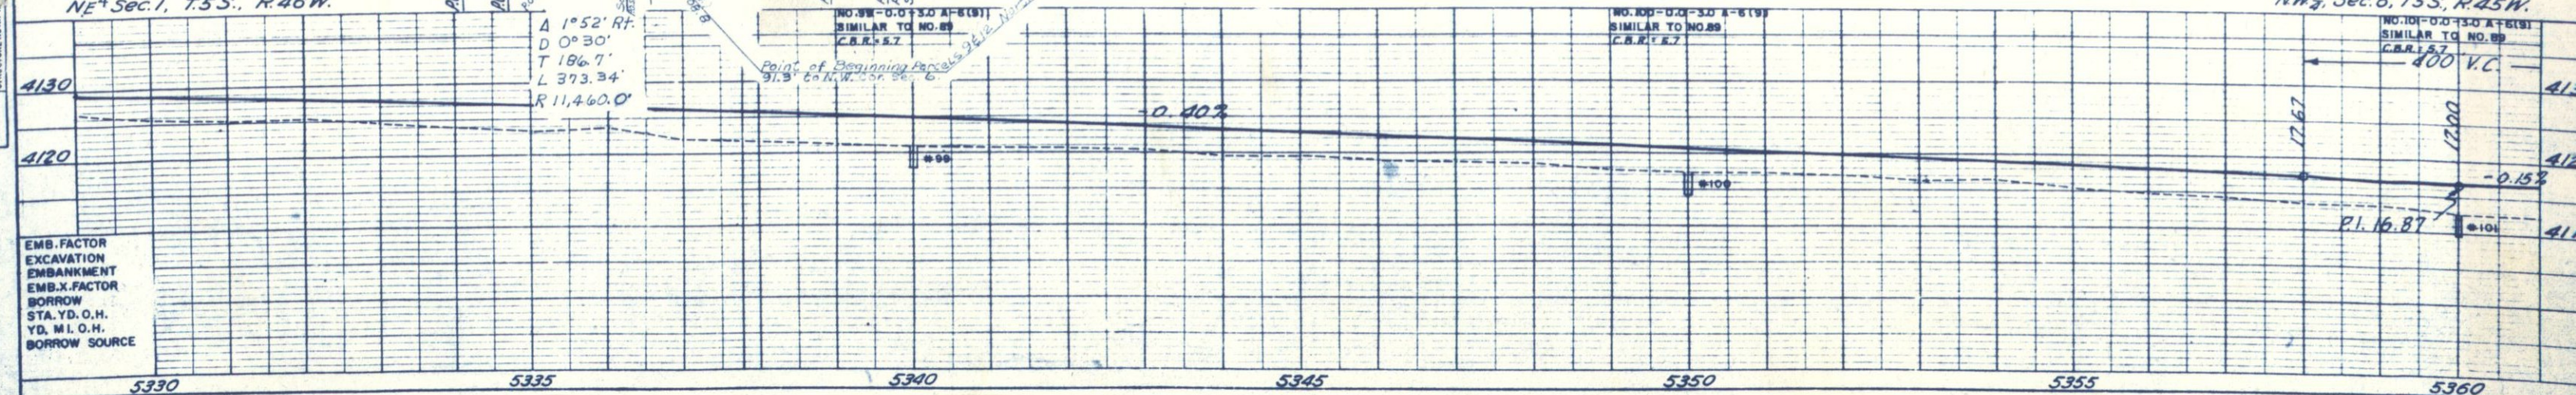

EMB. FACTOR
EXCAVATION
EMBANKMENT
EMB. X. FACTOR
BORROW
STA. YD. O.H.
YD. MI. O.H.
BORROW SOURCE

SW 1/4 SEC. 31
T. 4 S., R. 45 W.


SE 1/4, SEC. 31, T. 4 S., R. 45 W.

FED. ROAD DIST. NO.	STATE	PROJ. NO.	SHEET NO.	TOTAL SHEETS
3	COLO.	DF 013-1(15) CS 19-0102-11	8	


RIGHT OF WAY

⑩ DOROTHY A. DUTTON
RT. 4
McCOOK, NEBR.

⑪ MILDRED M. DUTTON Etal.
RT. 4
McCOOK, NEBR.

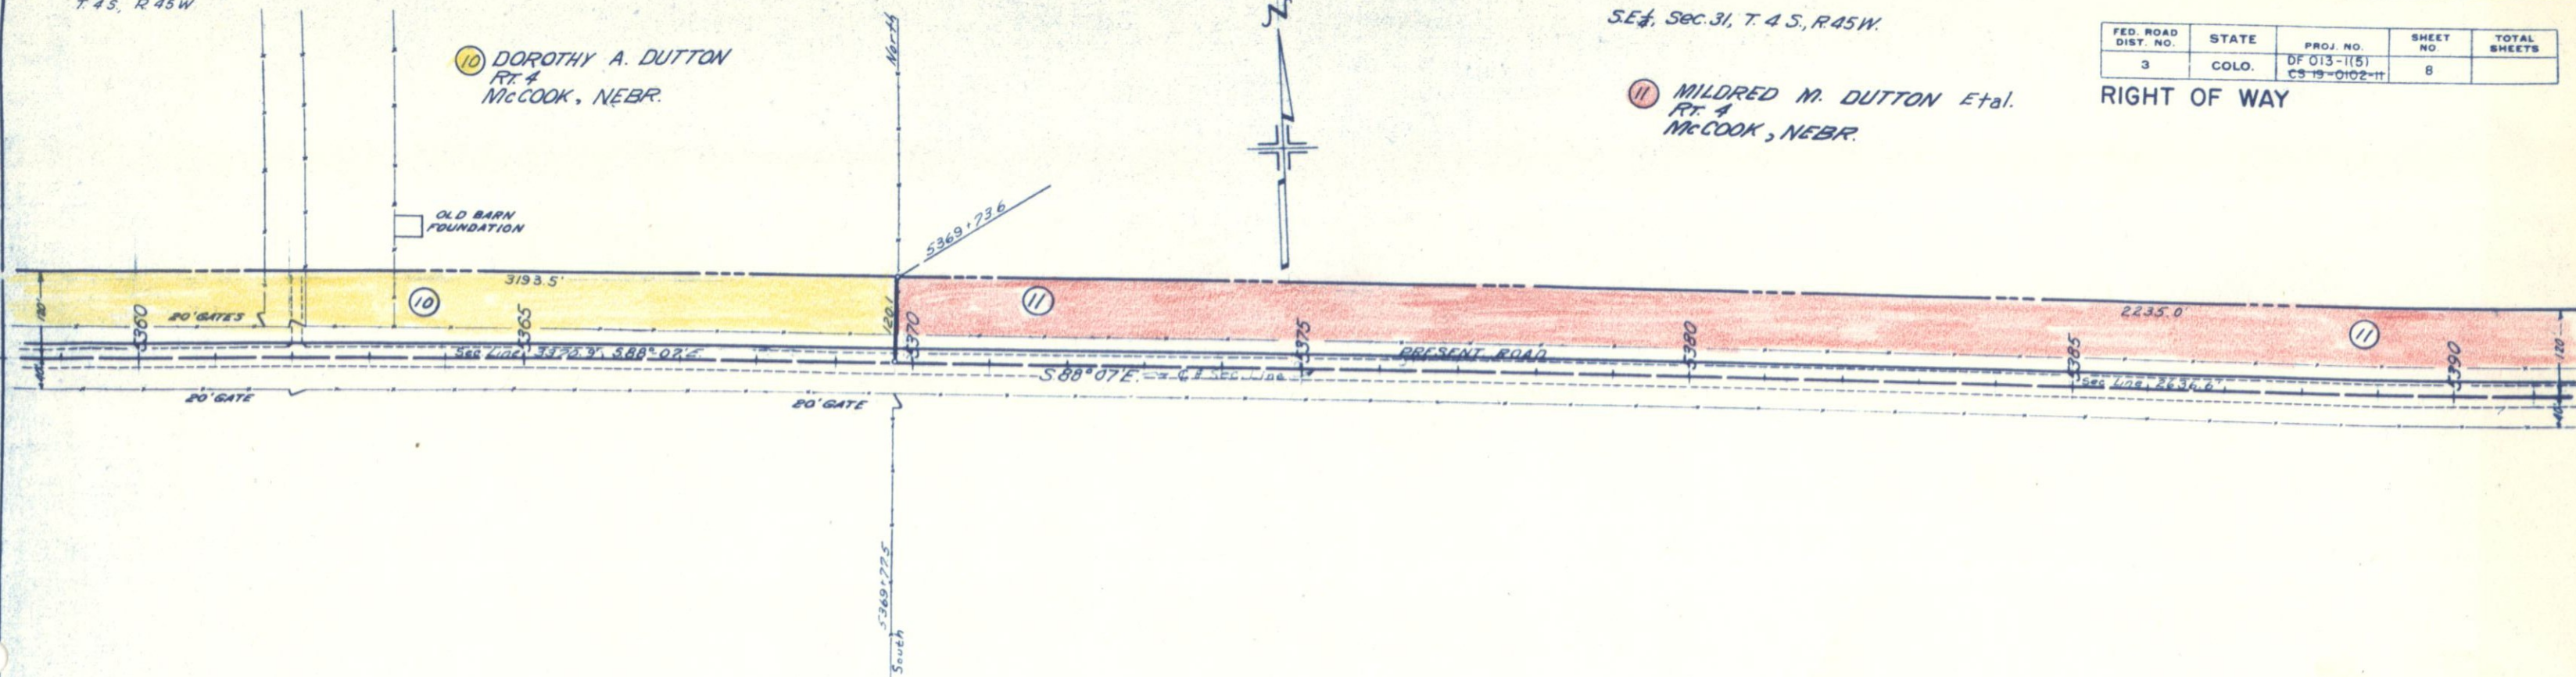

NE 1/4, Sec. 6, T. 5 S., R. 45 W.

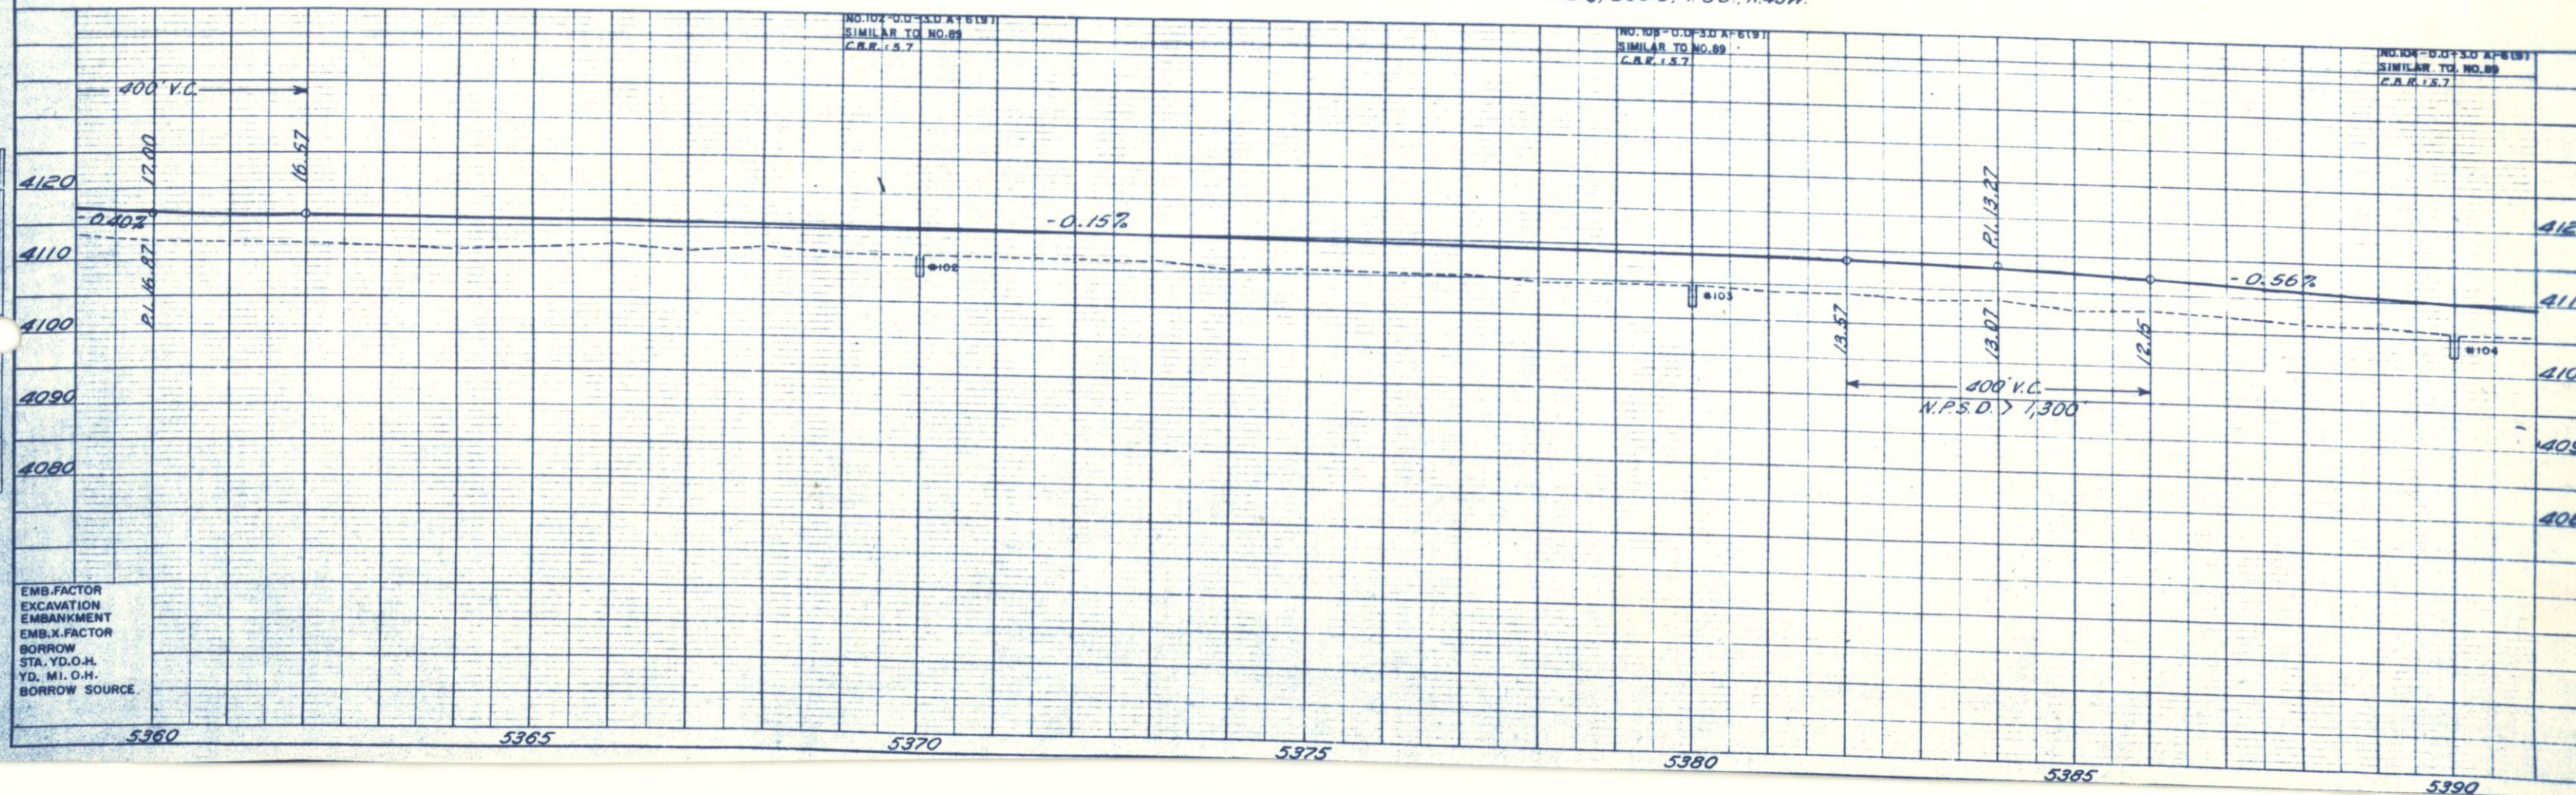


SE 1/4 SEC. 31
T. 4 S., R. 45 W.

11 MILDRED M. DUTTON, Etal.
RT. 4
McCOOK, NEBR.

SW 1/4 SEC. 32
T. 4 S., R. 45 W.

FED. ROAD DIV. NO.	DIST.	PROJ. NO.	SHEET NO.	TOTAL SHEETS
9	COLO.	DF 013-1(5) CS 19-0102-11	9	

RIGHT OF WAY

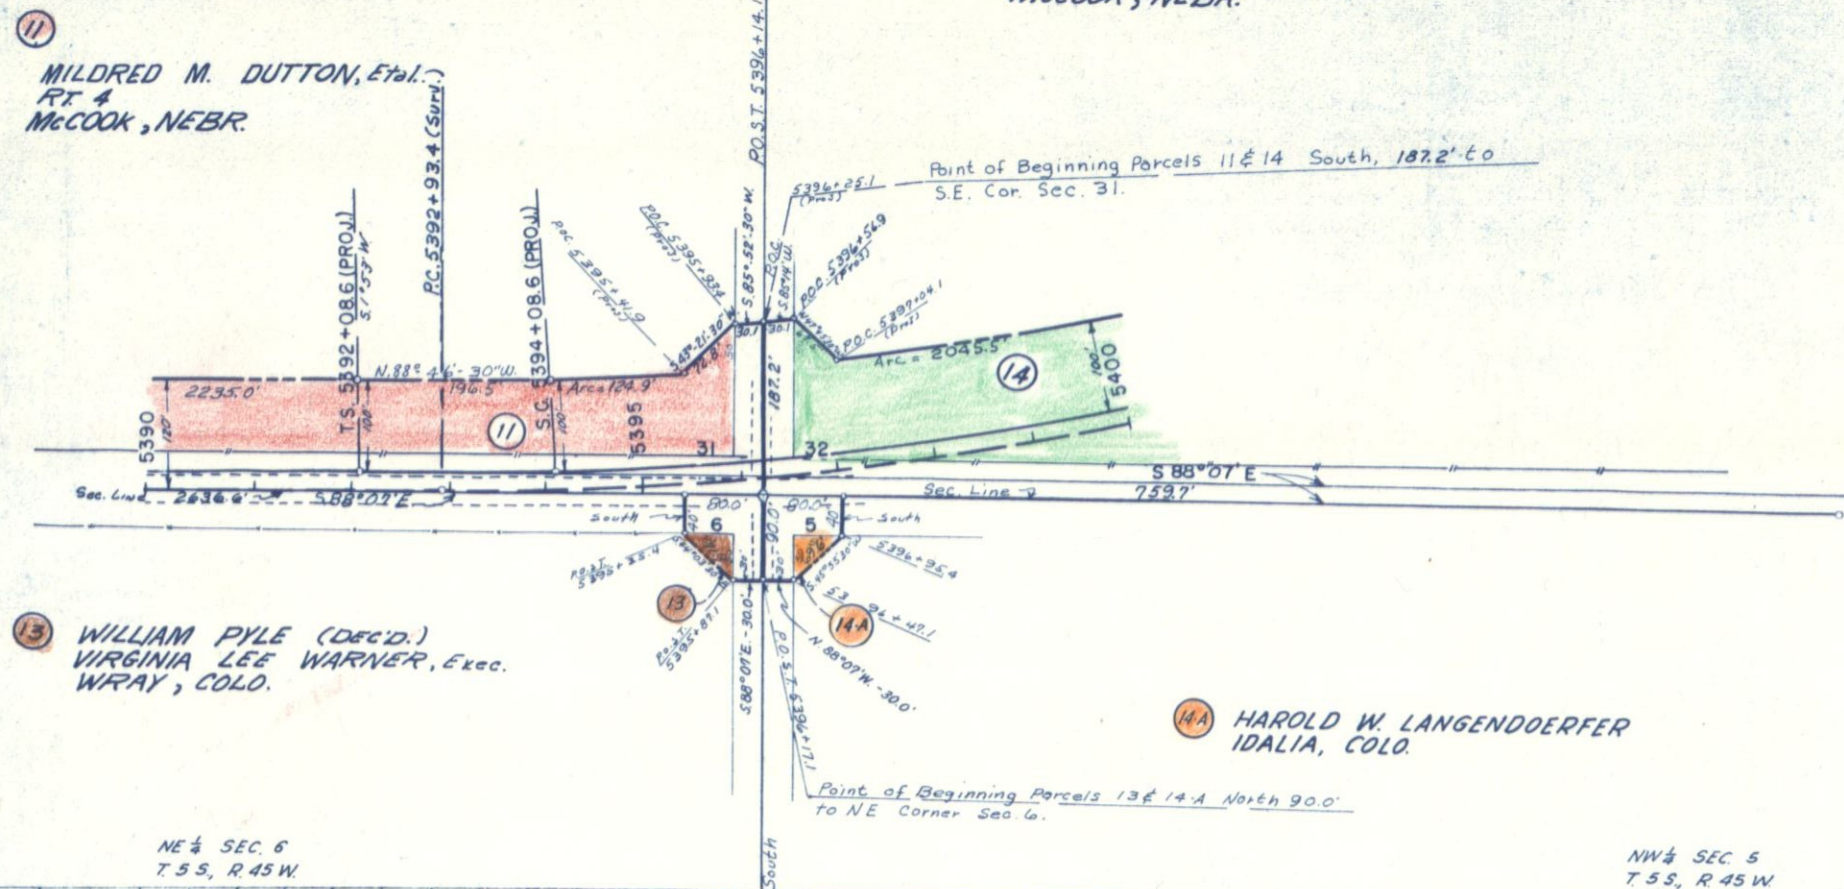


NE 1/4 SEC. 6
T. 5 S., R. 45 W.

NO. 104 C-3.0 A-6(9)
SIMILAR TO NO. 89
C.B.R. = 5.7

NO. 105 C-3.0 A-6(9)
SIMILAR TO NO. 89
C.B.R. = 5.7

NW 1/4 SEC. 5
T. 5 S., R. 45 W.

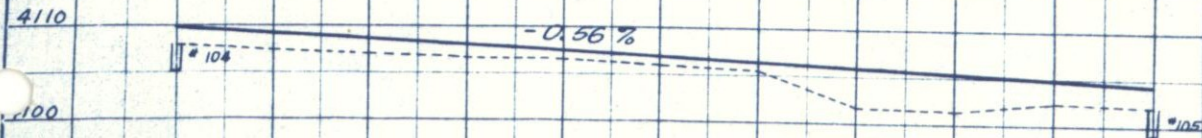



14 MILDRED M. DUTTON, Et al
Rt. 4
McCook, NEBR.

FED. ROAD DIST. NO.	STATE	PROJ. NO.	SHEET NO.	TOTAL SHEETS
3	COLO.	DF 013-1(5) CS 19-0102-11	10	

RIGHT OF WAY
5429+24.0

(PROJ.)
Δ = 52°18' LT.
Ts = 1506.9
Δc = 48°18'
Dc = 2°00'
Tc = 1284.6'
Lc = 2415.0'
Rc = 2865'
E = 327.3'
θs = 2°00'
Ls = 200'
LT = 133.34'
ST = 66.67'

(SURV.)
Δ = 52°10' LT.
D = 2°
T = 1406.6'
L = 2615'
R = 2865'
E = 326.7'

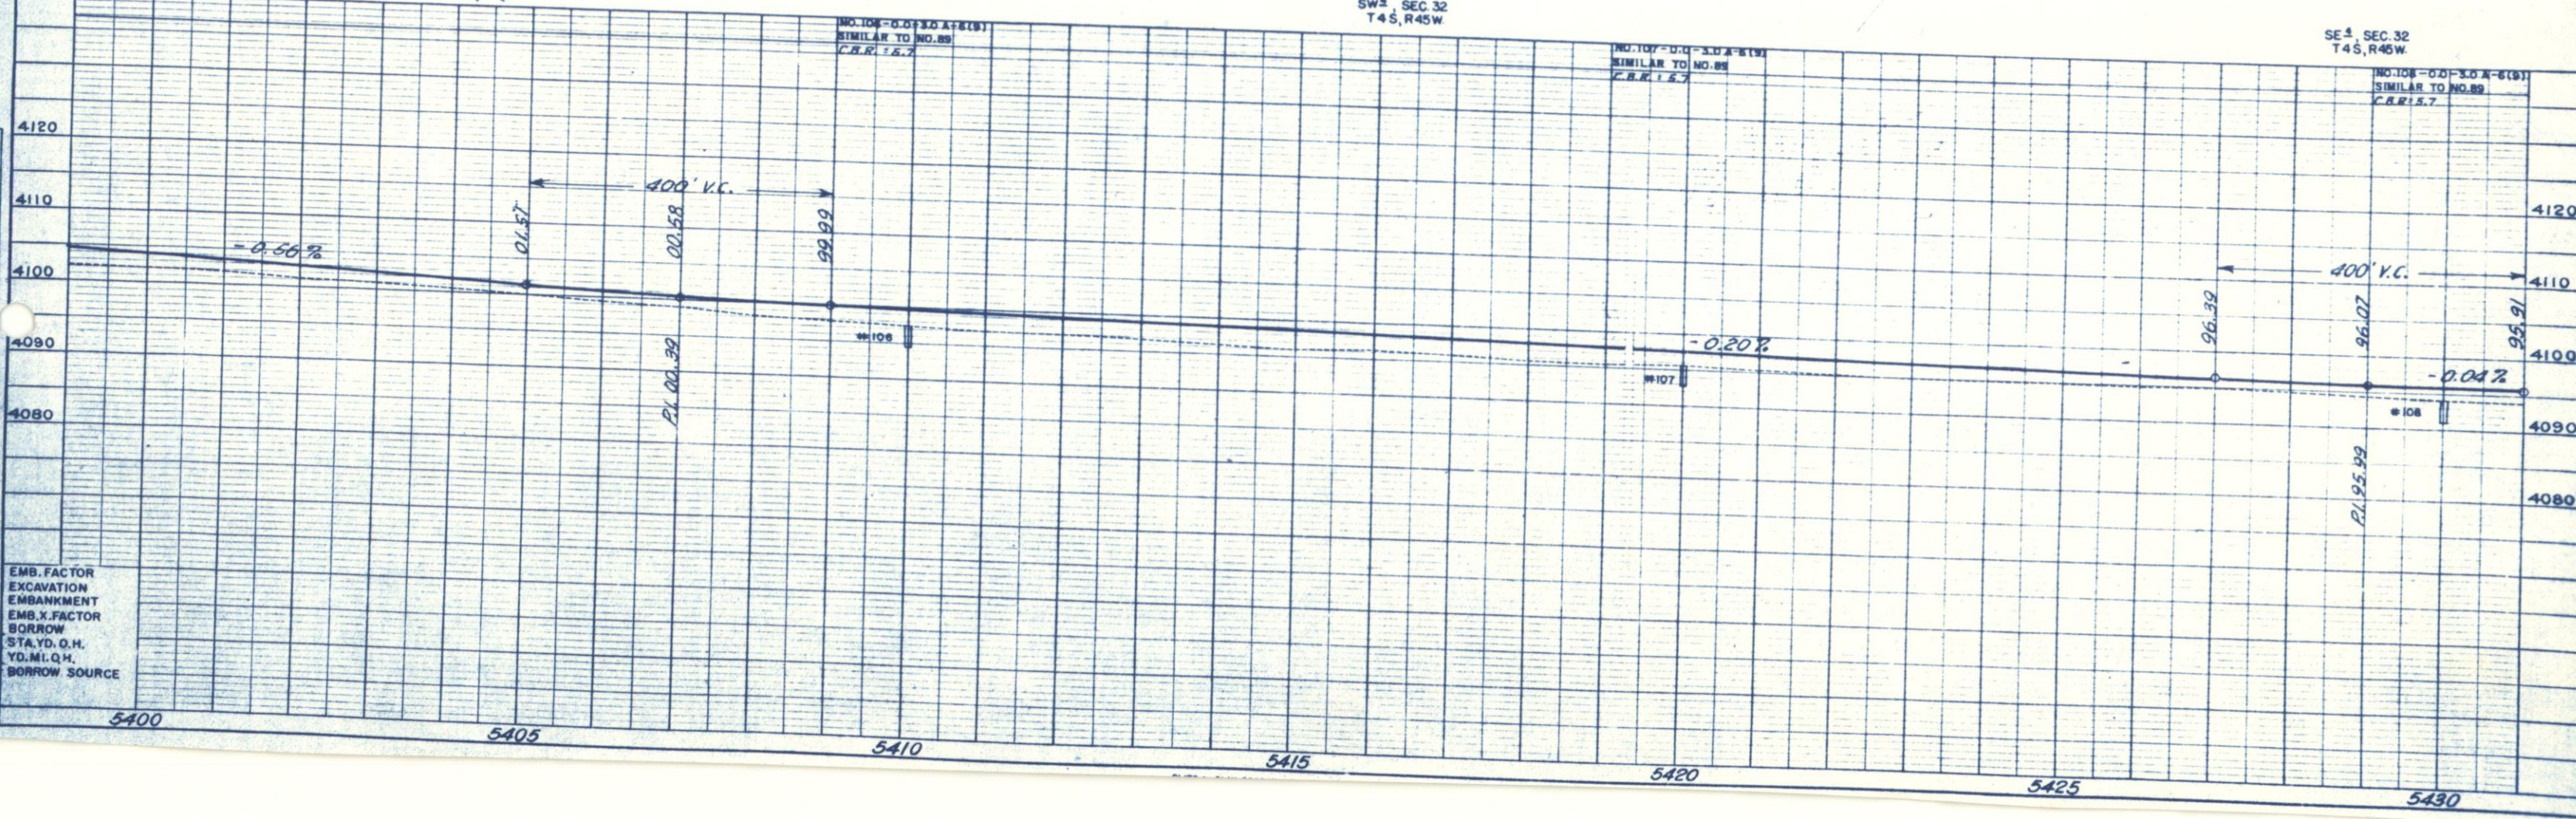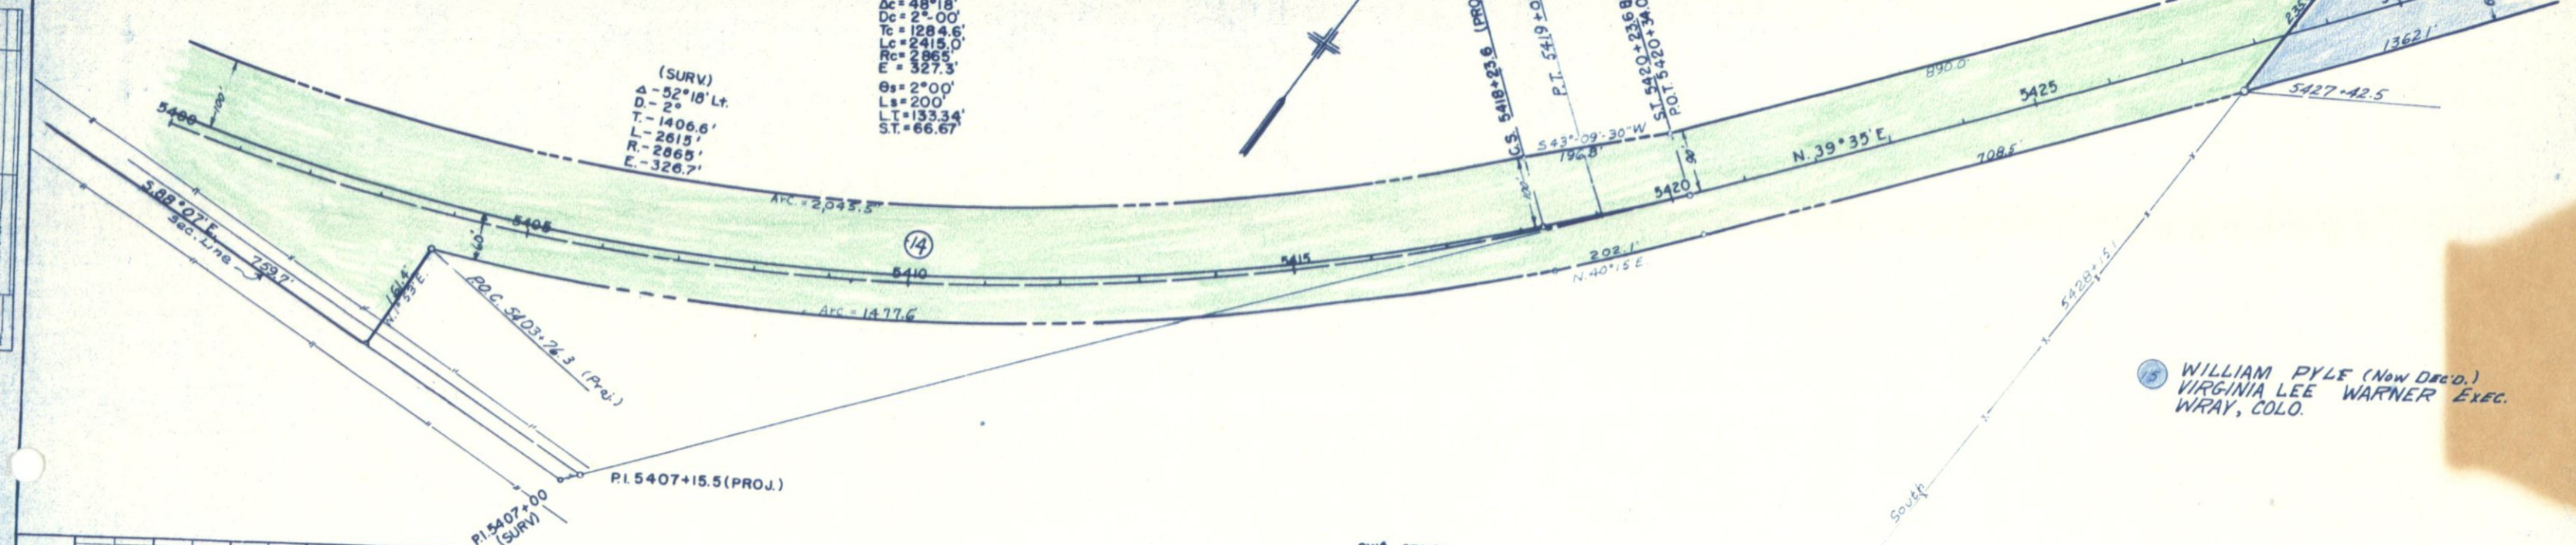






EMB. FACTOR
EXCAVATION
EMBANKMENT
EMB. X. FACTOR
BORROW
STA. YD. Q.H.
YD. MI. Q.H.
BORROW SOURCE

22 ARTHUR LOHMAN
WRAY, COLO.

SW 1/4 SEC. 22
T4S, R45W

FED. ROAD DIST. NO.	STATE	PROJ. NO.	SHEET NO.	TOTAL SHEETS
3	COLO.	DF013-1(5) CS-19-0102-11	13	

RIGHT OF WAY

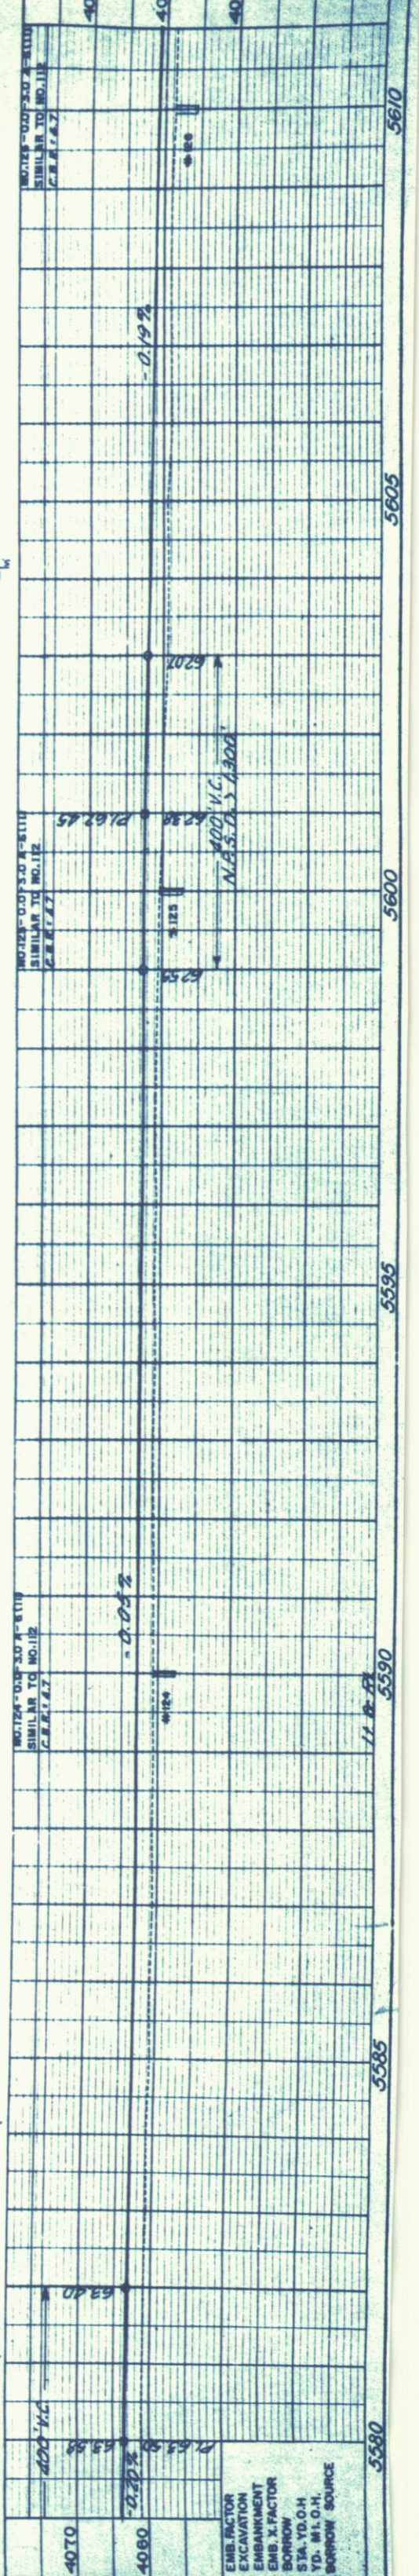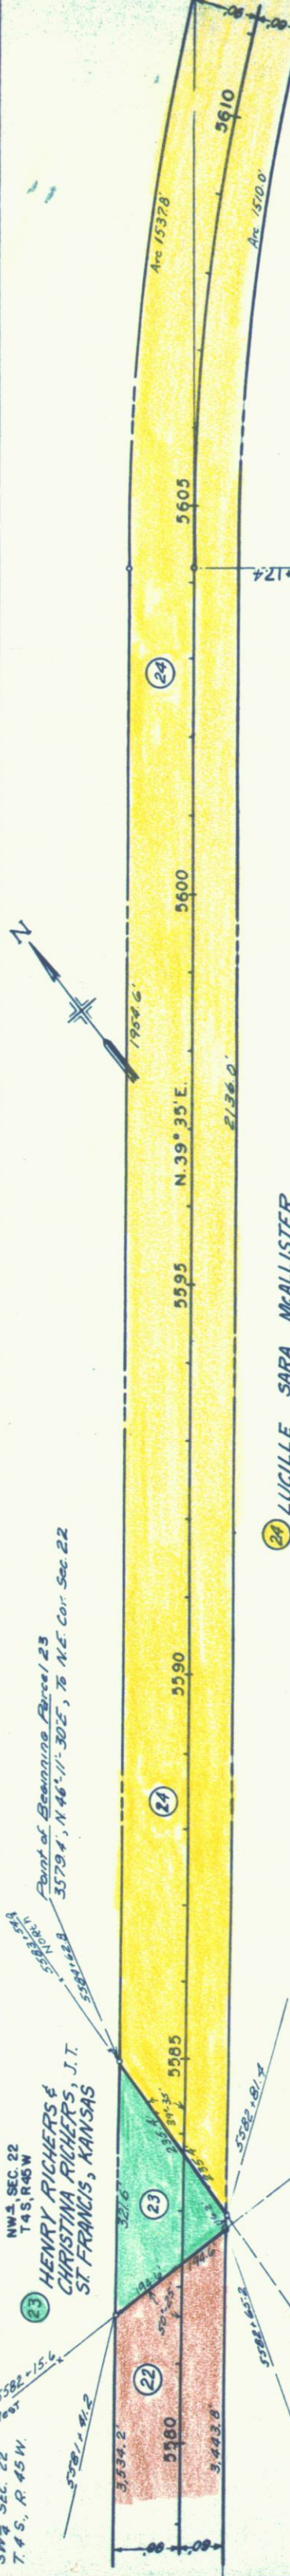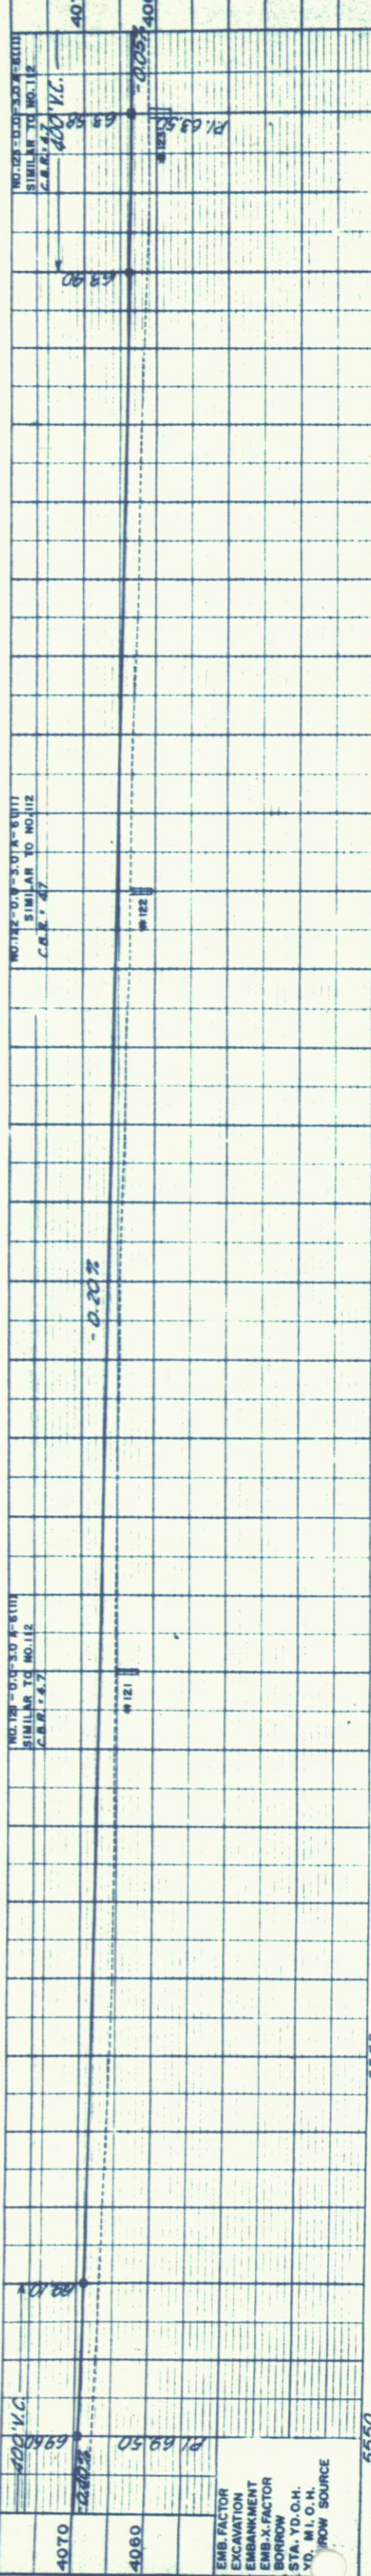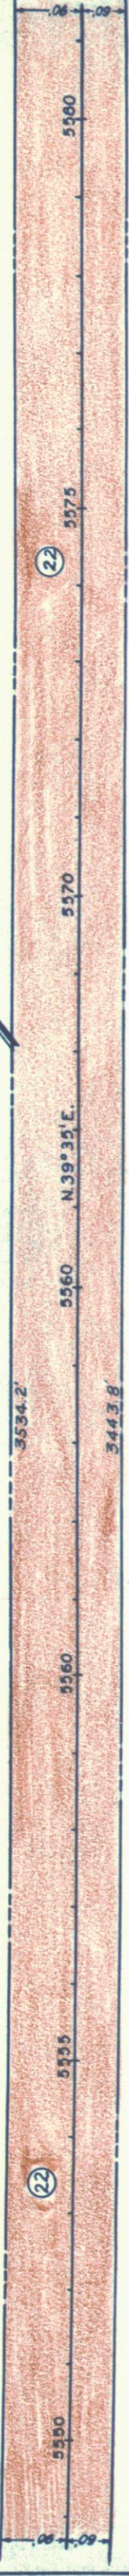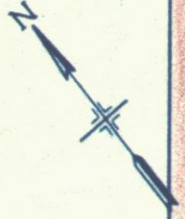

NE 1/4 Sec. 22
T. 4S., R. 45 W.

24 LUCILLE SARA McALLISTER
RT. 2, BOX 234-A
VANCOUVER, WASH.


N 39° 33' E.

Δ - 49° 45' Rt
D - 2°
T - 1328.4'
L - 2487.5'
R - 2865.0'
C - 293.0'

FED. ROAD DIST. NO.	STATE	PROJ. NO.	SHEET NO.	TOTAL SHEETS
3	COLO.	DF 013-1(5) CS-19-0102-11	14	

RIGHT OF WAY

SW 1/4, SEC. 14
T. 4S., R. 45 W

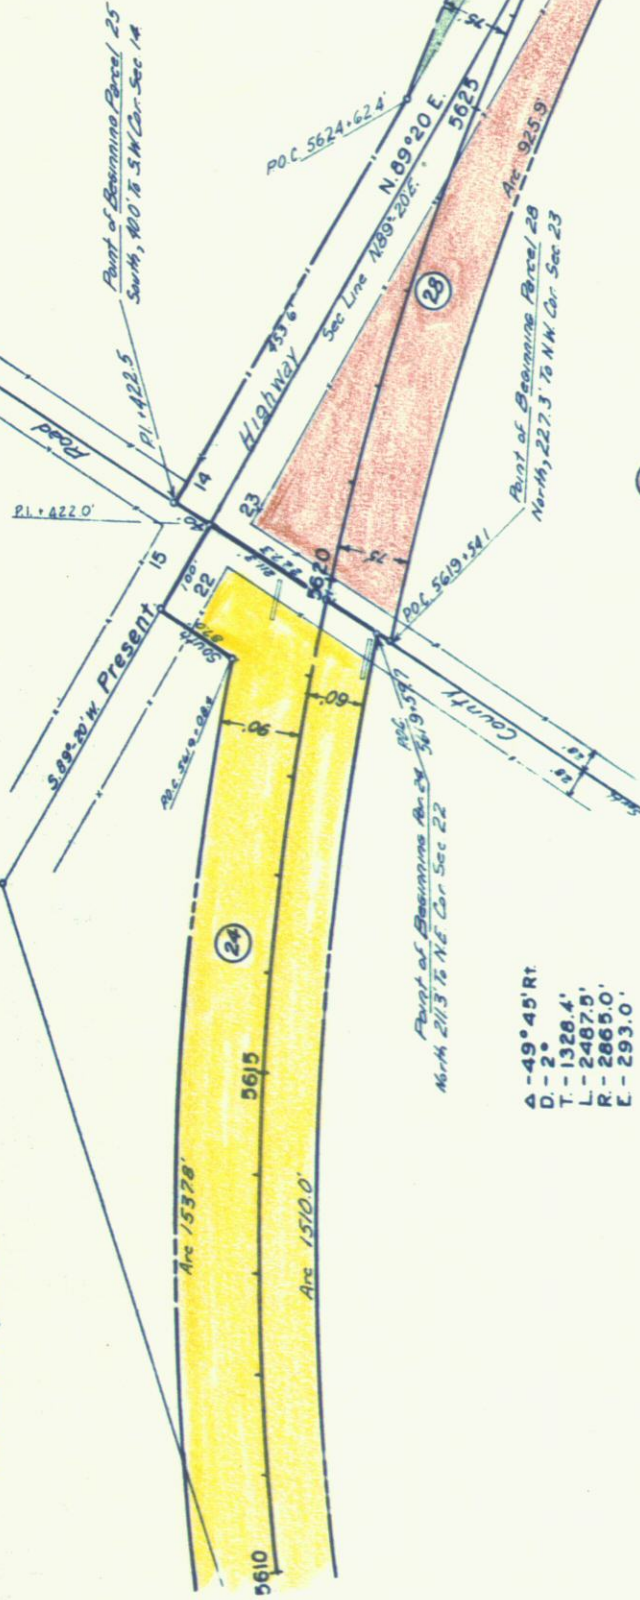

GEORGE W. WINGFIELD
CONTRACT FOR SALE TO:
FRANK G. KEJR &
HARRY KEJR
ITALIA, COLO.

26 RICHARD A. MILLER, ETAL.
505 10th ST
FT MADISON, IOWA

NW 1/4, SEC 23, T4S, R45W


NOTE - GUTTER AT 5'11"
SIMILAR TO NO. 112
C.B.E. 4.7

NOTE - GUTTER AT 6'11"
SIMILAR TO NO. 112
C.B.E. 4.7

NOTE - GUTTER AT 6'11"
SIMILAR TO NO. 112
C.B.E. 4.7

- 0.19 %

EMB. FACTOR
EXCAVATION
EMBANKMENT
EMB. X. FACTOR
BORROW
STA. YD. O. H.
YD. MI. O. H.
BORROW SOURCE

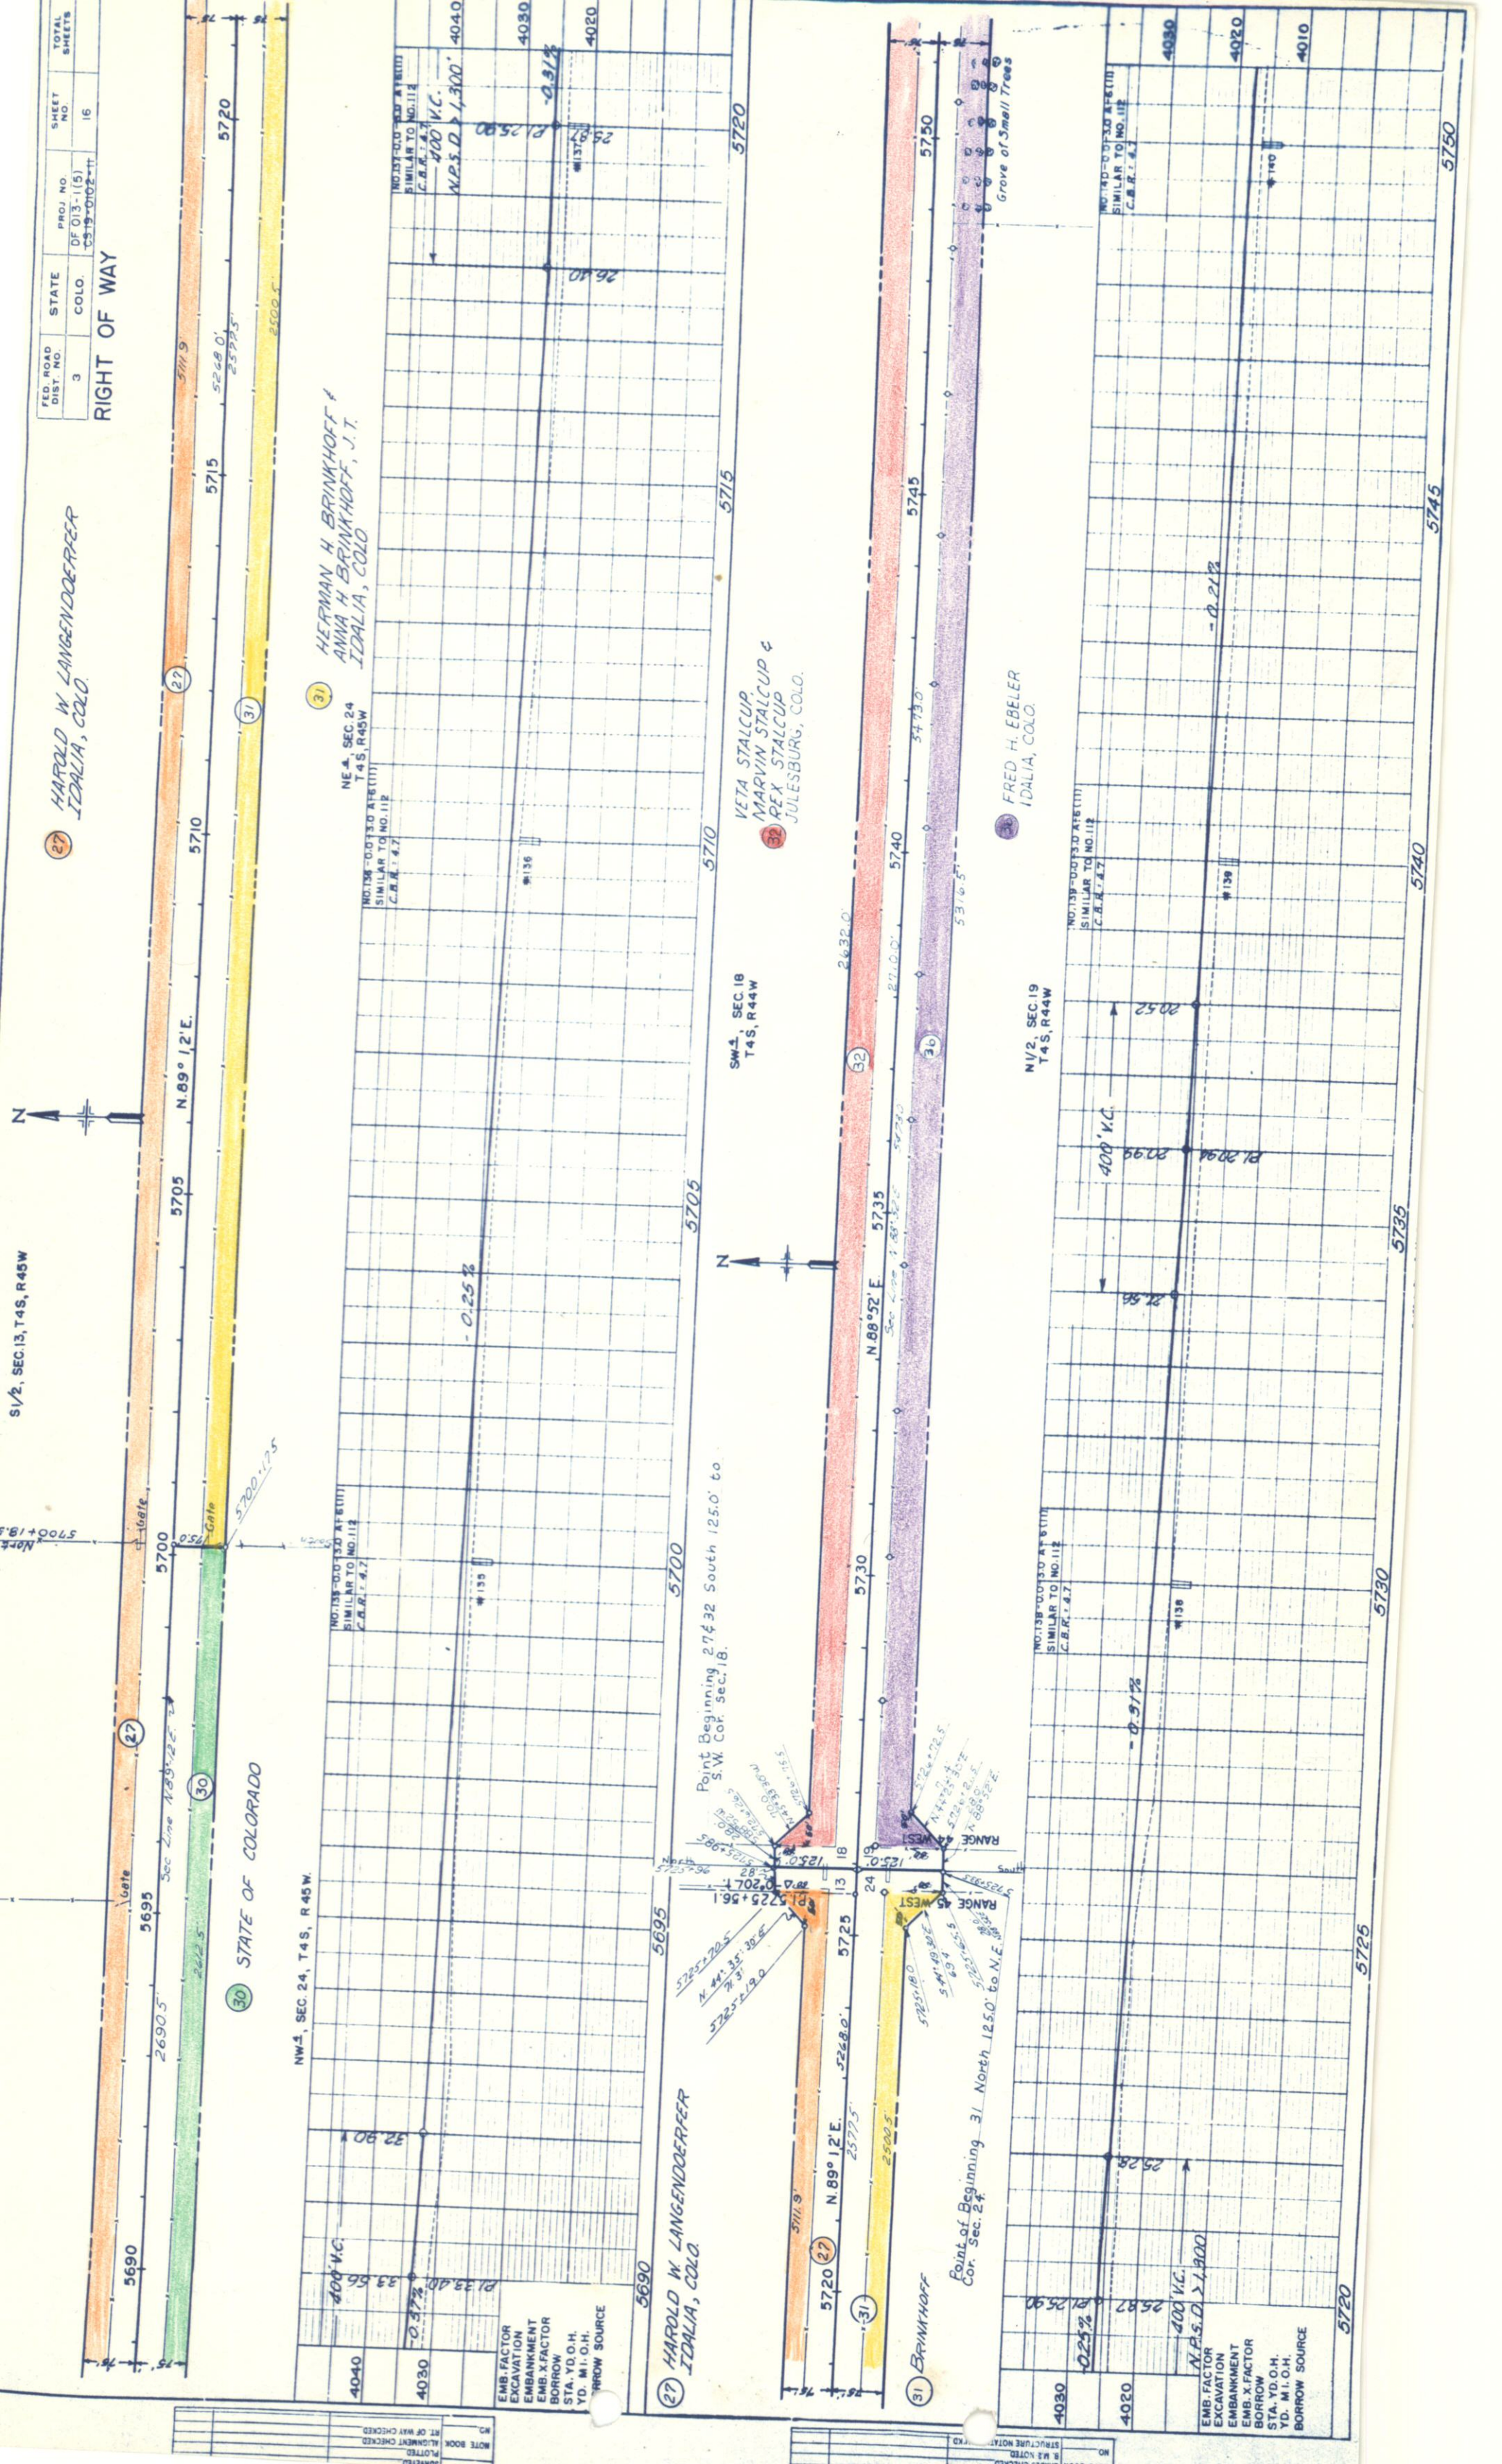

S.E. 1/4 Sec. 16
T.4S., R.44W.

42 GEORGE W. WINFIELD
IDALIA, COLO.

43 W.F. WILCOXEN & ELLA K. WILCOXEN, J.T.
IDALIA, COLO.

44 MARTIN E. STUTHEIT
IDALIA, COLO.

45 CORINNE PETERSON &
CARL O. PETERSON
WIRAY, COLO.

RIGHT OF WAY Rev. 8-5-57 A.A.H. Rev. 7-2-58 48REV. F.C.M.

FILE NO.	DIST.	PROJ. NO.	SHEET NO.	TOTAL SHEETS
9	COLD.	DF 013-1(5) CS 19-0102-1	20	


Point of Beginning Parcels 42 & 43
2016.2', S88°36'E. to SE Cor. Sec. 16

Point of Beginning Parcels 44 & 45
12282', S88°48'30"E. to SE Cor. Sec. 16

Point of Beginning Parcel No. 48 & 49
600.9', S. 86°51'30"E. to S.E. Cor. Sec. 16

Point of Beginning Parcel No. 52 & 53
5.78° 45' 30"E., 193.7' to SE Cor. Sec. 16

Point of Beginning Parcel
54 3.45' 20"E., 56.2' to SE Cor. Sec. 16

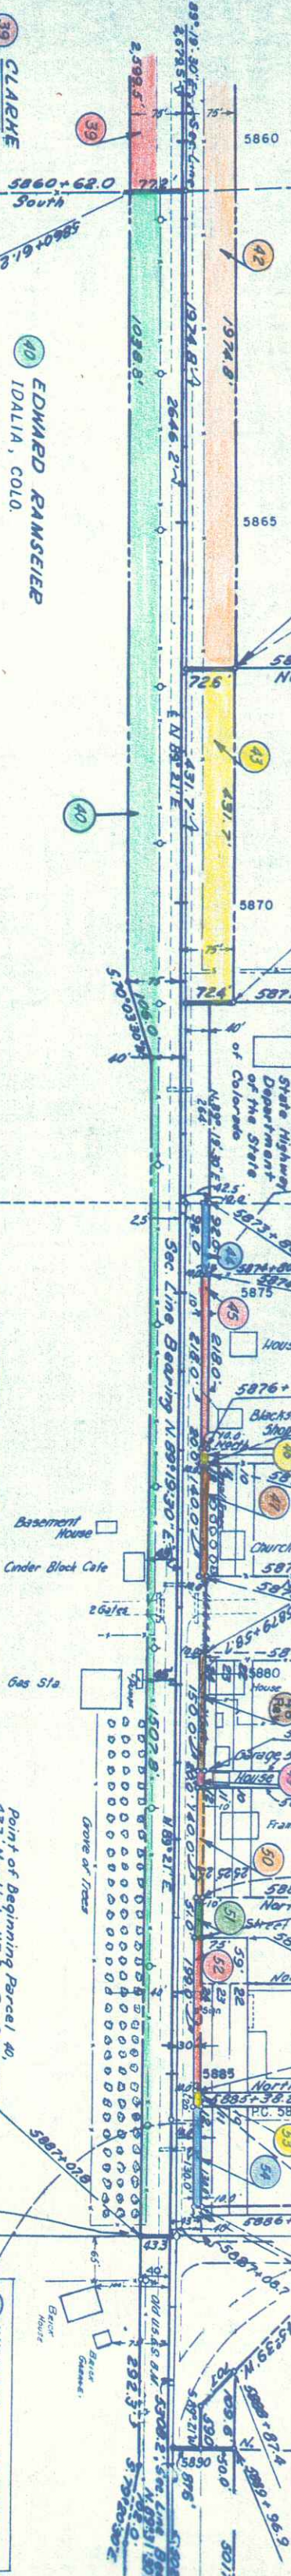

39 CLARKE

40 EDWARD RAMSEIER
IDALIA, COLO.

47 BOARD OF TRUSTEES FOR
THE ST. PAUL CHURCH
EVANGELICAL ASSOCIATION
IDALIA, COLO.

48 MINNIE L. HUGHEY

50 ROSE BEECHLEY
IDALIA, COLO.

52 METROPOLITAN LIFE
INSURANCE CO.


54 WILLIAM J. BRENNER &
ELSIE V. BRENNER, J.T.

NW 1/4 SEC. 21

NE 1/4, SEC. 21
T.4S., R.44W

Point of Beginning Parcel 40,
43.3' North to NE Cor. Sec. 21

END PROJ. DF 013-1(5)
STA. 5887 + 082
T.4S., R.44W
SEC. 22

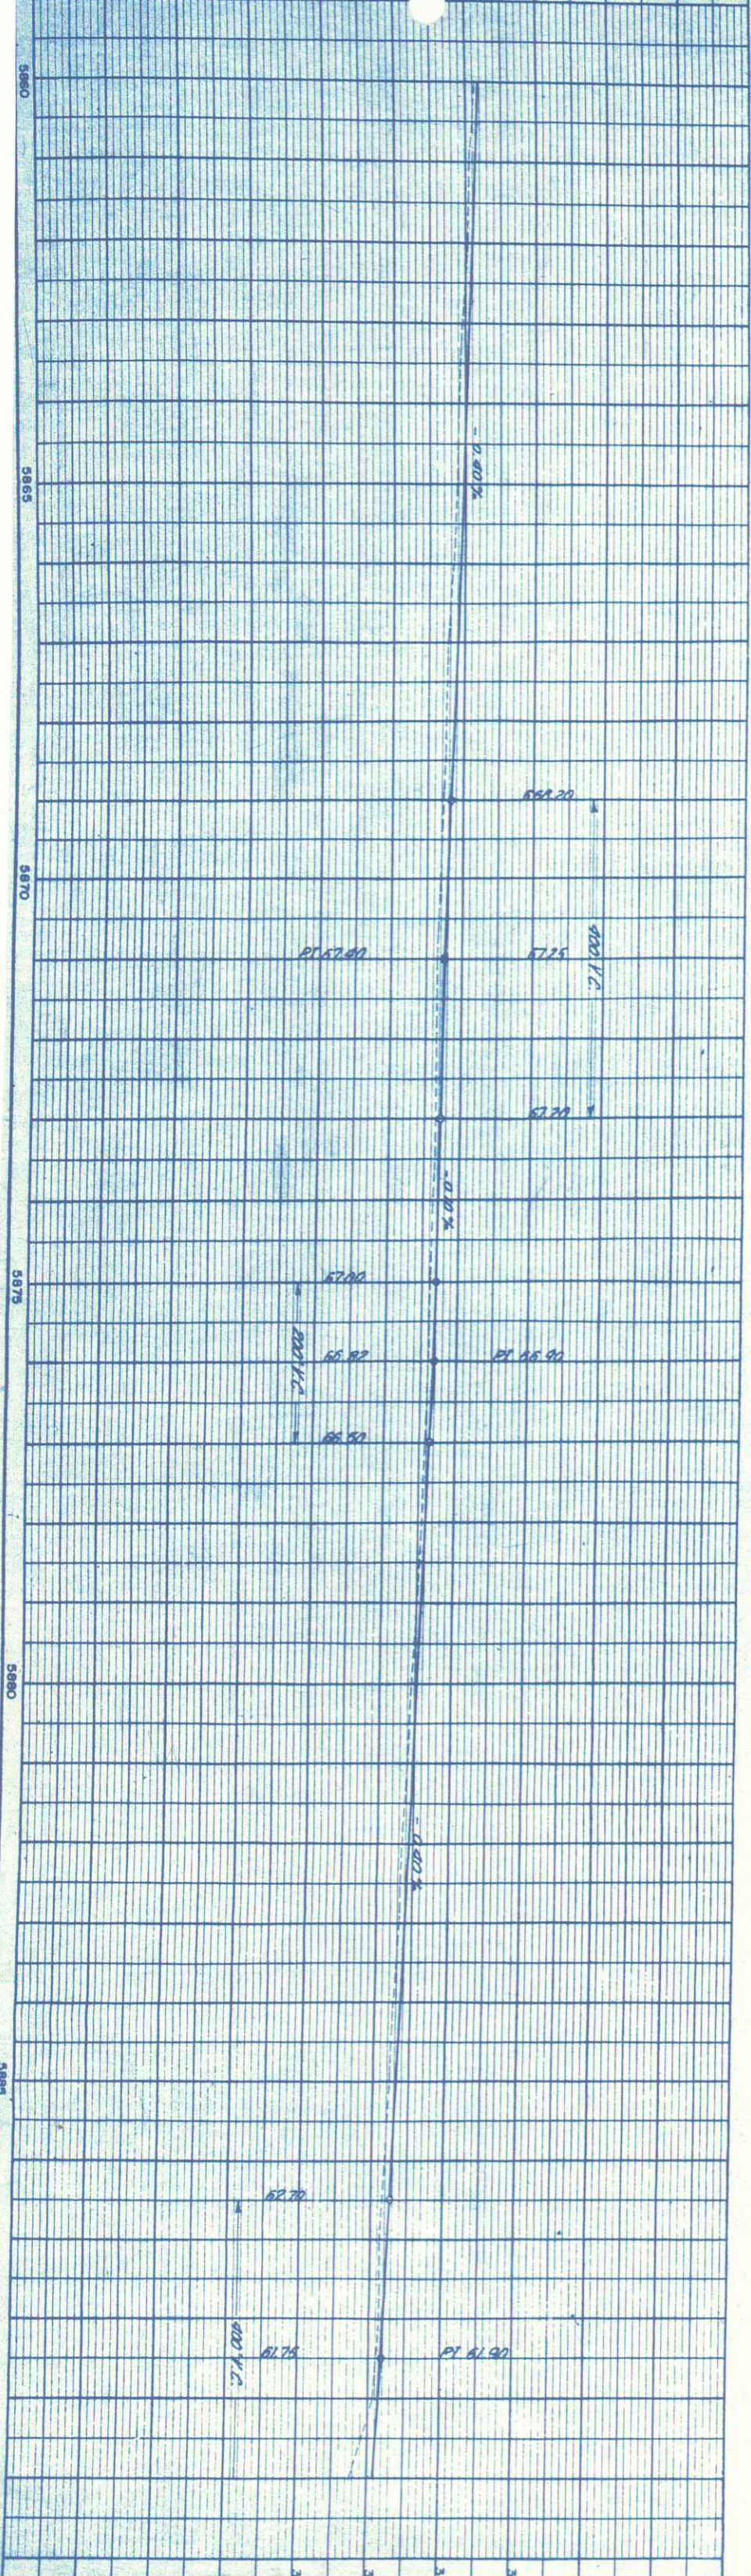



SE 1/4 SEC. 34
T.4S., R.46W.

SW 1/4 SEC. 35
T.4S., R.46W.

SE 1/4 SEC. 35
T.4S., R.46W.

SW 1/4 SEC. 36
T.4S., R.46W.

1 ORA L. STREET & EVA I. STREET, J.T.
REV. KIRK, COLO.
5 1/2 SEC. 34

2 WILLIAM J. BRENNER &
ELSIE V. BRENNER, J.T.
IDALIA, COLO.
5 1/2 SEC. 35

3 SCHOOL LAND
STATE OF COLO.
5 1/2 SEC. 36

RIGHT OF WAY
SE 1/4 SEC. 36
T.4S., R.46W.

FED. ROAD DIST. NO.	STATE	PROJ. NO.	SHEET NO.
9	COLO.	DF 013-1(15)	22

OWNERSHIP-MAP
JOES-IDALIA
SCALE 1" = 400'

Rev. 7-8-58 R.E.C.
Rev. 7-18-58 R.E.C.

5 ORA L. STREET &
EVA I. STREET, J.T.
KIRK, COLO.
N 1/2 SEC. 3
N. 40' HWY ROW

6 CARL G. MOELLENBERG &
FLORENCE C. MOELLENBERG, J.T.
KIRK, COLO.
NW 1/4 SEC. 2
N. 40' HWY ROW

7 LUCILLE SARA McALLISTER
Box 234A Rt. 2
VANCOUVER, WASHINGTON
NE 1/4 SEC. 2
N. 40' HWY ROW

8 MILDRED M. DUTTON,
DOROTHY ANNE DUTTON,
LEONARD LEROY DUTTON &
JAMES EDWARD DUTTON
Rt. 4 McCook, NEBR.
N 1/2 SEC. 1

SE 1/4 SEC. 36
T.4S., R.46W.

NE 1/4 SEC. 3
T.5S., R.46W.
SW 1/4 SEC. 31
T.4S., R.45W.

NW 1/4 SEC. 2
T.5S., R.46W.

NE 1/4 SEC. 2
T.5S., R.46W.

NW 1/4 SEC. 1
T.5S., R.46W.

SE 1/4 SEC. 32
T.4S., R.45W.

NE 1/4 SEC. 1
T.5S., R.46W.

10 DOROTHY A. DUTTON
Rt. 4 McCook, NEBR.
SW 1/4 SEC. 31
S. 40' HWY ROW

11 MILDRED M. DUTTON,
DOROTHY ANNE DUTTON,
LEONARD LEROY DUTTON &
JAMES EDWARD DUTTON
Rt. 4 McCook, NEBR.
SE 1/4 SEC. 31

15 WILLIAM PYLE (Now Decd)
VIRGINIA LEE WARNER, EXEC.
WRAY, COLO.
SE 1/4 SEC. 32
S. 40' HWY ROW, 4
ROW IN SE. CORNER SEC. 32.

12 CARL O. PETERSON &
JOHN C. PETERSON
WRAY, COLO.
Lots 3, 4, 5 (APPROX. NE NW 1/4 SEC. 6)
N. 40' HWY ROW

13 WILLIAM PYLE (Decd)
VIRGINIA LEE WARNER, EXEC.
WRAY, COLO.
Lots 1, 2 (APPROX. NE NE 1/4 SEC. 6)

14 HAROLD W. LANGENDERFER
IDALIA, COLO.
NW 1/4 SEC. 5

NE 1/4 SEC. 1
T.5S., R.46W.

NW 1/4 SEC. 6
T.5S., R.45W.

NE 1/4 SEC. 6
T.5S., R.45W.

NW 1/4 SEC. 5
T.5S., R.45W.

NE 1/4 SEC. 5
T.5S., R.45W.

NE 1/4 SEC. 32
T.4S., R.45W.

MILDRED M. DUTTON,
DOROTHY ANNE DUTTON,
LEONARD LEROY DUTTON &
JAMES EDWARD DUTTON
Rt 4 McCook NEBR.
N 1/2 & SW 1/4 SEC. 32

WILLIAM PYLE (now Decd)
VIRGINIA LEE WARNER, Exec.
SE 1/4 Sec. 32
S. 40', Hwy ROW &
ROW in SE Corer SEC. 32.

SE 1/4 SEC. 32
T.4S., R.45W.

ROBERT D. ROMKEE
KATHRYN ROMKEE, J.T.
KIRK, COLO.
NW 1/4 SEC. 33
N. 40', Hwy ROW &
W. 40' Hwy ROW &
ROW in NW Corer

NW 1/4 SEC. 33
T.4S., R.45W.

SW 1/4 SEC. 22
T.4S., R.45W.
ARTHUR LOHMAN
WRAY, COLO.
SW 1/4 Sec. 22

NW 1/4 SEC. 22
T.4S., R.45W.
HENRY RICHERS &
CHRISTINA RICHERS, J.T.
ST. FRANCIS, KANSAS
N. 40', Hwy ROW
W. 40', Hwy ROW
ROW in NW Corer SEC. 22

LUCILLE SARA MCALLISTER
BOX 234A
VANCOUVER, WASH.
NE 1/4 Sec. 22
NW 1/4 SEC. 22

SE 1/4 SEC. 15
T.4S., R.45W.

SW 1/4 SEC. 14
T.4S., R.45W.

GEORGE W. WINGFIELD -
CONTRACT FOR SALE TO:
FRANK G. KEUR &
HARRY KEUR
IDALIA, COLO.
SW 1/4 SEC. 14
S. 40', Hwy ROW
E. 65', ROW

RICHARD A. MILLER &
BEULAH MILLER, ETAL.
505 Tenth St.
FT. MADISON, IOWA
NW 1/4 Sec. 23
N. 40', Hwy ROW

NW 1/4 SEC. 23
T.4S., R.45W.

ARTHUR C. EBELER
IDALIA, COLO.

NW 1/4 SEC. 28
T.4S., R.45W.

NE 1/4 SEC. 28
T.4S., R.45W.
LOUIS FLEER, JR.
IDALIA, COLO.
NE 1/4 Sec. 28

BERTHA W. INGALLS
315 E. Williamette Ave
COLO. SPRINGS, COLO.
SE 1/4 SEC. 28
S. 40', Hwy ROW
E. 40', Hwy ROW &
ROW in SE Corner

CLARENCE E. INGALLS &
BERTHA E. INGALLS, J.T.
802 Cimarron St.
Colo. Springs, Colo.
SW 1/4 Sec. 28
S. 40', Hwy ROW

BARBARA A. LAWRENCE
WRAY, COLO.
NW 1/4 Sec. 27

ARTHUR LOHMAN
WRAY, COLO.
SW 1/4 Sec. 22

REV. 7-2-58 F.C.M.

FED. ROAD DIST. NO.	STATE	PROJ. NO.	SHEET NO.
9	COLO.	DF 013-115	23

OWNERSHIP MAP
JOES - IDALIA

SCALE 1" = 400'

RIGHT OF WAY

SE 1/4 SEC. 14
T.4S, R.45W.

SW 1/4 SEC. 13
T.4S, R.45W.

SE 1/4 SEC. 13
T.4S, R.45W.

SW 1/4 SEC. 18
T.4S, R.44W.

Rev. 7-2-58 F.C.M.

26 WILLIAM F. GERBER
IDALIA, COLO.
SE 1/4 Sec. 14
S. 40' Hwy. R.O.W.

28 HAROLD W. LANGENDOERFER
IDALIA, COLO.
SW 1/4 Sec. 13
S. 40' Hwy. R.O.W.

32 VETA STALCUP,
MARVIN STALCUP &
JULESBURG, COLO.
SW 1/4 Sec. 18

33 CORINNE O. PETERSON, TRUSTEE
WRAY, COLO.
SE 1/4 Sec. 18

29 CORINNE O. PETERSON
WRAY, COLO.
NE 1/4 Sec. 23
N. 40' Hwy. R.O.W.

30 STATE OF COLO.
NW 1/4 Sec. 24
N. 40' Hwy. R.O.W.

31 HERMAN H. BRINKHOFF &
ANNA H. BRINKHOFF, J.T.
IDALIA, COLO.
NE 1/4 Sec. 24
N. 40' Hwy. R.O.W.

34 FRED H. EBELER
IDALIA, COLO.
N 1/2 Sec. 19

NE 1/4 SEC. 23
T.4S, R.45W.
SW 1/4 SEC. 17
T.4S, R.44W.

NW 1/4 SEC. 24
T.4S, R.45W.
SE 1/4 SEC. 17
T.4S, R.44W.

NE 1/4 SEC. 24
T.4S, R.45W.
SW 1/4 SEC. 16
T.4S, R.44W.

NW 1/4 SEC. 19
T.4S, R.44W.
SE 1/4 SEC. 16
T.4S, R.44W.

NE 1/4 SEC. 19
T.4S, R.44W.

37 CORINNE O. PETERSON, TRUSTEE
WRAY, COLO.
SW 1/4 Sec. 17

35 HARRY P. WUDTKE
IDALIA, COLO.
SE 1/4 Sec. 17
S. 40' Hwy. R.O.W.

41 J. KENNETH CONRAD &
MARGUERITE CONRAD, J.T.
WRAY, COLO.
W 1/2 SW 1/4 Sec. 16

42 GEORGE W. WINGFIELD
IDALIA, COLO.
E 1/2 SW 1/4 & W 1/2 SE 1/4
Except: Wilcoxen Tract
S. 40' Hwy. R.O.W.

43 W.F. WILCOXEN &
ELLA V. WILCOXEN, J.T.
IDALIA, COLO.
Tract N. SW 1/4 Sec. 16
Except 40' R.O.W.

44 MARTIN E. STUTHEIT
IDALIA, COLO.
SE 1/4 SE 1/4 Sec. 16

45 MRS. MARTIN E. STUTHEIT
IDALIA, COLO.
SE 1/4 SE 1/4 Sec. 16

46 CORINNE PETERSON &
CARL O. PETERSON
WRAY, COLO.

47 THE ST. PAUL CHURCH
EVANGELICAL ASSOC.
IDALIA, COLO.
Lots 8-12, Blk. 11

48 MINNIE L. HUGHEY
IDALIA, COLO.
Lots 23-24, Blk. 10

49 ROSE BEECHLEY
IDALIA, COLO.
Lots 9-12, Blk. 10

50 METROPOLITAN LIFE INSURANCE CO.
IDALIA, COLO.

51 WILLIAM J. BRENNER &
ELSIE V. BRENNER, J.T.
IDALIA, COLO.
Lots 3 thru 12, Blk. 9 - Except 40' R.O.W. E

37 H.W. NOELLENBERG
ARMEL, COLO.
NW 1/4 Sec. 20

38 MARGARET JANE PYLE (CLARKE)
WRAY, COLO.
NE 1/4 Sec. 20
N. 40' Hwy. R.O.W.

39 MARGARET JANE PYLE (CLARKE)
WRAY, COLO.
NW 1/4 Sec. 21
N. 40' Hwy. R.O.W.

40 EDWARD RAMSEIER
IDALIA, COLO.
NE 1/4 Sec. 21

End Proj. 5885+00
Sta. 5885+00

NW 1/4 SEC. 20
T.4S, R.44W.

NE 1/4 SEC. 20
T.4S, R.44W.

NW 1/4 SEC. 21
T.4S, R.44W.

NE 1/4 SEC. 21
T.4S, R.44W.

Sec. Cor. 3' Lt. P.O.T. 5887+08.2

Sec. line 5780+69

PI 5780+46.9
Δ=0°03' Lt.

5646+58

5650

5660

5670

5680

5690

5700

5710

5720

5725

5730

5740

5750

5753+06

5760

5770

Sec. Line 5673+28

PI 5725+56.1
Δ=0°20' Lt.

5725+96

5700+18.5

PI 5833+57.8
Δ=0°08' Lt.

Sta. 5833+82.5

Sec. Cor. 1.1' Lt.

50° 24' E BLK

SOUTH AND

N 0° 26' W BLK

NORTH AND

5840

5850

5860

5865

5870

6980