

COLORADO


STATE HIGHWAY DEPARTMENT

PLAN AND PROFILE OF PROPOSED FEDERAL AID PROJECT N^oE-248-E STATE HIGHWAY NO. 4 LAKE COUNTY


INDEX OF SHEETS

- 1. TITLE PAGE
- 2. TYPICAL SECTION & SUMMARY
- 3. DETAILS OF BRIDGE, STA. 326+
- 4. STANDARD GUARD FENCE M-20-F
- 5. " MARKER POSTS & FENCES M-24-F
- 6. " SUPERELEVATION SHEET M-1-A
- 7-13. PLAN & PROFILE
- 14-48. CROSS SECTIONS

CONVENTIONAL SIGNS

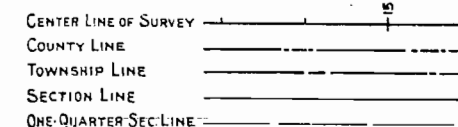

SCALES
 ON PLAN, 1 IN. = 100 FT.
 ON PROFILE (1 IN. = 100 FT. HORIZONTAL
 (1 IN. = 10 FT. VERTICAL)
 GRADE LINE ON PROFILE IS SHOWN AS GRADE OF FINISHED ROAD
 GROSS LENGTH OF PROJECT } 19,314.3 FT. = 3.658 MI.
 NET LENGTH OF PROJECT }

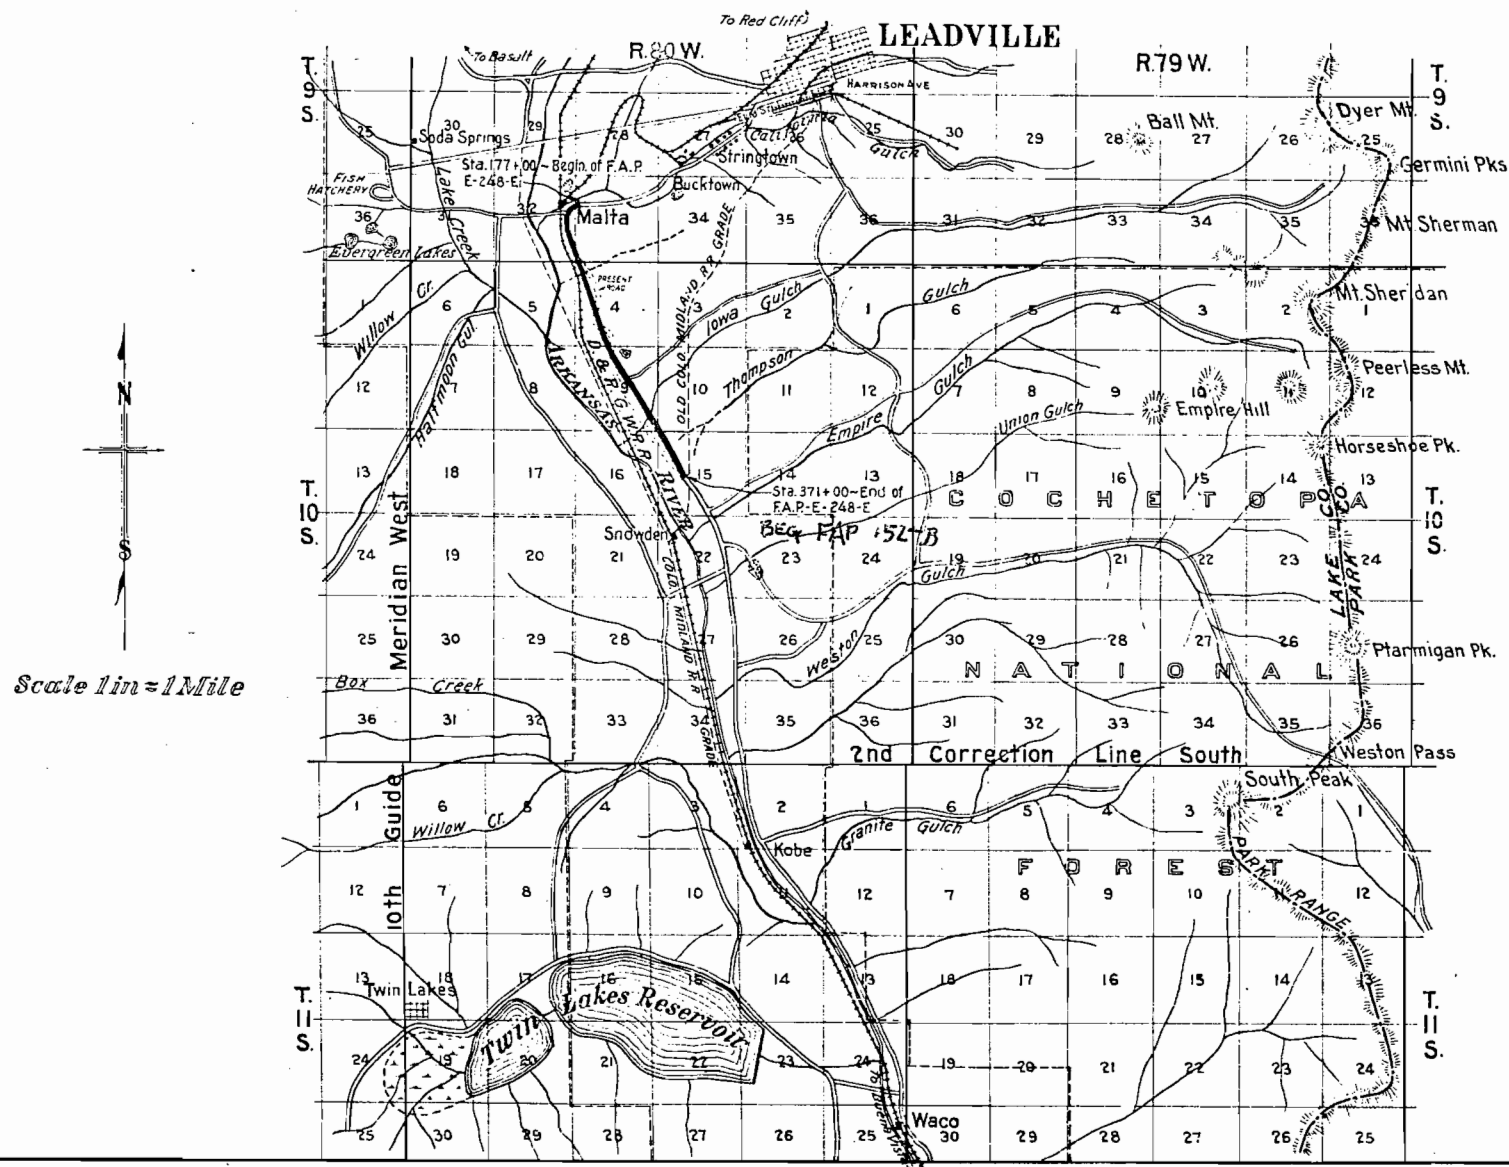

RECOMMENDED FOR APPROVAL 9/9/32

J. H. Malone
ASSISTANT ENGINEER

APPROVED
Clas Otis
STATE HIGHWAY ENGINEER

RECOMMENDED FOR APPROVAL

DIST. ENG. BUREAU PUBLIC ROADS


RECOMMENDED FOR APPROVAL

CHIEF ENG. BUREAU PUBLIC ROADS

APPROVED

DIRECTOR BUREAU PUBLIC ROADS

TYPICAL CROSS SECTION OF IMPROVEMENT AND SUMMARY OF QUANTITIES

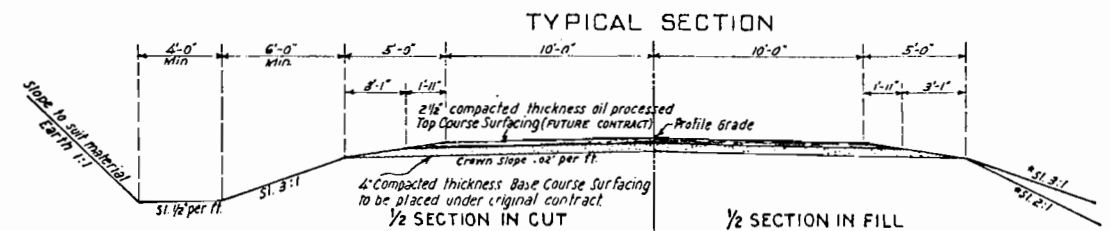

NOTE: The thickness of top and base courses of surfacing is to be considered approximate only. Surfacing material is to be placed at the rate of 32 tons per 100 ft. for the Top Course and at the rate of 61 tons per 100 ft. for the Base Course.

*NOTE: 3:1 slope to be used on fills of 3 ft. or less. 2:1 slope to be used on fills of over 3 ft.

GENERAL NOTES

This project is to be constructed in conformity with the Standard Specifications of the Colorado State Highway Department adopted on January 1, 1930.

All quantities on preliminary plans are to be considered as approximate only.

All roadway excavation required to construct the project is to be obtained as indicated on the plans. Quantities involved beyond the limits of the ditch as shown on Typical Section, either noted on profile as "Borrow" or in the List of Structures as "Embankment" are to be classified and paid for as "Unclassified Excavation". These quantities are to be staked as part of the original excavation at locations indicated on the plans. Slope stakes beyond the limits of the Typical Section as shown, are subject to change by the Engineer to fit embankment requirements actually encountered during construction.

Unless otherwise noted on the plan sheets, the inlet ends of all pipe cross culverts are to be protected by Dry Rubble Slope Paving 1 ft. thick placed about the end of the pipe. The approximate quantity of slope paving required is shown in the List of Structures.

All curves are to be super-elevated in accordance with methods shown on the Standard Super-elevation sheet included in the plans.

The entire project is to be cleared for the full width of the right of way, and the cost thereof is to be included in the Lump Sum bid for "Clearing and Grubbing the Entire Project". Approximate location and character of clearing and grubbing required is indicated in notes on plans.

The upper 6" of the subgrade between Sta. 177+00 and Sta. 210+00 of the project is to be covered with selected material, which is to be classified and paid for as "Unclassified Excavation". This material is to be used to fill the interstices in the rocky subgrade, and to prepare the subgrade for the gravel surface course.

It is estimated that this material will be obtained approximately 300 ft. left of Sta. 209 and will be placed at the rate of approximately 60 cu. yds. per 100 linear feet of roadway. It is estimated that this operation involves the following quantities:

Item #9 13c Unclassified Excavation 2,000 Cu. Yds.
 " #10a Station Yard Overhaul 19,300 Sta. Yds.
 " #10b Yard Mile Overhaul 190 Yd. Mi.

The detour for this project lies along the present travelled roadway, and where the new work and the present travelled roadway coincide, the contractor shall, at his own expense, so prosecute construction that traffic can readily pass over the road. Also he shall maintain in safe condition and at his own expense, all temporary approaches to and crossings of intersecting highways.

Except as limited by the special provisions, power equipment may be used on this project.

FENCING				GATES			ROW MARKERS		
LOCATION	SIDE	BUILD	REMOVE	LOCATION	SIDE	NO.	LOCATION	SIDE	NO.
193+00-211+20	R	1740	1750	270+00	R	1	177+00	R&L	2
211+20-233+40	R&L	16440		275+00	"	1	181+51	"	2
240+00-247+00	X		850	288+20	R&L	2	188+35	"	2
250+30-269+50	R&L		1950	309+00	"	2	212+11	"	2
274+00-291+00	R		1800	321+25	"	2	216+27	"	2
348+00-367+00	L		2050	341+00	L	1	244+20	"	2
367+00-371+00	R&L		900	368+30	R&L	2	273+11	"	2
293+40-293+00	R	50		369+30	R	1	289+00	"	2
296+00-296+40	R	40					305+00	"	2
296+40-369+00	R&L	14520					336+25	"	2
369+00-370+20	R	120					337+25	"	2
370+20-371+00	R&L	160					367+05	"	2
							371+00	"	2
TOTALS		33070	9300	TOTAL		12	TOTAL		26

LIST OF STRUCTURES

LOCATION	DESCRIPTION	REMOVE STRUCT.		EXCAVATION CU. YD.		STRUCTURAL EXCAVATION-CU.YD.		CORRUGATED METAL CULV. PIPE - Lin. Ft.				DR. RIB SL. PAV. 18" TH. SQ. YD.	MISCELLANEOUS.
		NO.	UNCL.	DRY	WET	18"	24"	30"	36"				
177+00	Project marker and approach												1 Proj. Marker
179+40	Side Drain and approach												
187+50	Cross Culvert and ditches					13.5							5.9
192+00	Side Drain and approach												
205+30	Remove structure, Cross Culvert	1	27	5									5.8
222+00	"	1		4.6									6.3
236+50-243+00	Diversion channel												
243+00	Cross Culvert and ditches			19.6									7
245+50	Remove structure	1											
250+00	" Cross Culv. ditches	1		18.8									5
254+00	Cross Culvert			22									6.0
264+00-269+10	Ditch change												
264+80	Remove structure, Cross Culvert	1		4.5									3.1
269+10	"	1		23.2									3.1
270+00	Side Drain and approach												
270+50-271+30	Ditch change												
275+00	Cross Culvert			3.2									6.0
284+35-284+95	Stone Underdrain			31.1	46.6								140. Lin. Ft.
285+15	Remove structure, Cross Culvert, Ditches	1	57	1.7									5.1
295+28	"	1		31.7	37								6.0
297+20	Approaches												
300+00	Cross Culvert			7.8									9.7
302+91-303+50	" Side Drain, Approach			21.3									3.1
309+00	Approaches												
321+25	" side drain												
326+38-326+68	Bridge (See Summary for Quant)			180.5									
332+33	Cross Culvert, Ditches			32.5									7.8
338+50	"			3.7									11.9
341+00	Approaches			3.8									
347+00	Remove structure, Cross Culv. ditches	1	592	19.7									6.9
349+00	"	1		3.7									6.3
217+75	"	1		31.9									6.0
361+15	Cross Culvert, ditches			7.2									4.5
361+15-365+50	Ditch change												
362+06	Remove structure	1	111										
368+30	Approaches												
367+40-369+00	Remove Buildings (STATE FORCES)												
369+57	Remove structure, Cross Culvert	1		3.5									4.5
370+00	Move Pond												
371+00	Project Marker and approach												1 Proj. Marker
223+40	"					24.3							6.0
294+50-297+40	Riprap												200 Cu. Yds.
284+00-285+00	Ditch Change			44.4									
TOTALS		12	155.6	470.5	50.3			362	324	52	50	120.8	

SUMMARY OF APPROXIMATE QUANTITIES

NO.	ITEM	UNIT	ROADWAY	BRIDGE-326'	TOTAL
10a	Clear and Grub the Entire Proj	L.S. Sum			
11	Removing 12 Structures	"			
12a	" Fence	Lin. Ft.	9300		9300
13c	Unclassified Excavation	Cu. Yd.	57202.0	416.0	57618.0
14b	Com.	"	290.0	180.5	470.5
14d	Com.	"			
18a	Station Yard Overhaul	Sta. Yds.	225725.6		225725.6
18b	Yard Mile	Yd. Mi.	2120.1		2120.1
30x	Gravel or Crushed Rock Surfacing	Tons.	12516.0		12516.0
32b	Treated Bridge Timber	M.F.B.M.		0.35	0.35
46a	Class "A" Concrete	Cu. Yd.		42	42
46b	" " "	"		13444	13444
47	Reinforcing Steel	Lb.		4800	4800
48	Structural	"		14600	14600
53b	18" Corr. Metal Culv. Pipe	Lin. Ft.	962		962
53c	24" " " "	"	324		324
53d	30" " " "	"	52		52
53e	36" " " "	"	50		50
65	Dry Rubble Slope Paving (12" Thick)	Sq. Yd.	120.8		120.8
72	Wire Cable Guard Fence	Lin. Ft.		200	200
75a	Galvan. Barb. Wire	"	33070		33070
75b	Gates in " " "	Each	12		12
78	Project Markers	"	2		2
79	Right of Way Markers	"	26		26
63	Riprap	cu. yd.	200		200
68	Stone underdrain	lin. ft.	140		140
	MATERIALS TO BE FURNISHED & WORK TO BE DONE BY STATE FORCES				
	Moving Buildings, Sta 367+	L.S. Sum	2000		2000
	Selected Material	Cu. Yd.			

Structural Excavation is estimated to be 80% Common and 20% Rock each of which is estimated to be 50% Dry and 50% Wet.

FINAL SUMMARY OF QUANTITIES

FED. ROAD DIST. NO.	STATE	FED. AID PROJ. NO.	SURVEY NO.	SECTION
0	COLO.	1-148	2.4	

FINAL CONSTRUCTION SHEET

SUMMARY OF CRUSHED ROCK BOOKS

GRAVEL BOOK NO.	TICKET NOS.		STATIONS		BOOK TOTAL TONS
	FROM	TO	FROM	TO	
1	E85231	H85283	246+00	243+00	
"	E85284	H85300	232+	241+00	1599.9
2	E85301	H85340	210+	232+	
"	E85341	H85350	201+	207+00	1692.4
3	E85351	E85399	177+00	201+	
"	F85399	H85400	296+00	300+	1692.4
4	E85401	H85402	293+	296+00	
"	E85406	H85423	300+	310+	
"	F85424	E85430	313+	326+	
"	F85430	H85430	243+	246+	1593.2
5	E85451	H85457	310+	313+	
"	E85458	F85465	241+00	246+	
"	H85465	E85472	207+00	210+	
"	F85472	H85473	326+	327+	
"	E8547	H85475	267+00	268+00	
"	F85474	F85483	263+00	267+00	
"	H85483	H85500	268+00	277+	1537.5
6	E8551	F85370	277+	287+00	
"	H85370	H85370	291+00	293+	
"	H85373	H85377	Road App.	303+50	
"	E85378	H85381	327+	332+	
"	E85387	H85394	287+00	291+00	
"	H85394	H85400	332+	336+	1596.3
7	E85401	F85412	336+	343+00	
"	H85412	H85413	346+00	347+00	
"	E85414	E85419	343+00	346+00	
"	F85419	H85430	347+00	366+	1811.2
8	E85431	H85435	366+	568+00	
"	F85435	F85435	366+	371+00	
"	All other tickets in this book to No. G85483 were used in road approaches and low spots				
11-6	E85231	H85483	177+00	377+00	12516.0

SUMMARY OF FINAL QUANTITIES

No.	ITEM	UNIT	ROADWAY	BRIDGE	TOTAL	REFERENCE
10a	Clearing & Grubbing	Lp Sm				SPEC.
11	Remove 12 structures					AND PLANS Book 3, Page 24
12a	Remove fence	Lin ft	9300		9300	PLANS B3, P. 22
13c	Unclassified excavation	Cu Yd	3720.2	416.0	5761.8	CROSS SECTIONS 101-102
14b	Dry common excavation struct		2909	180.0	470.5	CROSS SECTIONS
14d	Wet "		50.3		50.3	do BOOK 3 PAGE 18
18a	Sta Yds. overhaul	Sta Yd	225,725.6		225,725.6	MASS DIAGRAM
18b	Yd. Mile	Yd. Mi.	2,120.1		2,120.1	do
30c	Gravel or crushed rock surf.	Tons	12516.0		12516.0	SCALE BOOKS
42b	Treated bridge timber	M ft BM		0.35	0.35	PLANS
46a	Class 'A' concrete	Cu Yd		42.0	42.0	
46b	" 'B' "			134.44	134.44	PLANS FIELD BK. NO. 3 P. 2
47	Reinforcing steel	Lbs.		1800	1800	" Book 3, Page 23
48	Structural "			14600	14600	" Book 3, Page 23
53b	18" corrugated metal culvert pipe	Lin. ft	962		962	" W.O. NOS. 313, 314, 315, 316 3764 0.3 P. 25
53c	24" "		324		324	" do b-end p.
53d	30" "		32		32	" "
53e	36" "		30		30	" "
65	Dry rubble slope paving (12" thick)	Sq. Yd	120.0		120.0	BOOK 3, PAGE 17
72	Wire cable guard fence	Lin. ft		200	200	PLANS Book 3, Page 19
75a	Galvan barb wire		3307.0		3307.0	" Book 3 p. 22
75b	Gates in "	Each	12		12	" "
78	Project markers		2		2	" BOOK 3, P. 7-10.
79	Right of way "		26		26	" "
	Moving buildings Sta 367	Lp Sm				" W.O. NO. 323
68	Stone underdrain	Lin. ft	140		140	" 3438 B3 PIR
63	Rip rap	Cu yds	200		200	" 3013 B3 PIR

FENCING

LOCATION	SIDE	BUILD	REMOVE
193+00 - 211+20	R	1740	1750
211+20 - 299+40	R & L	16440	
240+30 - 247+00	X		830
250+30 - 249+30	R & L		1530
274+00 - 231+00	R		1800
348+00 - 367+00	L		2030
367+00 - 371+00	R & L		900
293+40 - 293+90	R	90	
296+20 - 296+40	R	40	
296+40 - 309+00	R & L	14520	
369+00 - 370+20	R	120	
370+20 - 371+00	R & L	140	
TOTALS		33070	9300

GATES

LOCATION	SIDE	No.
270+00	R	1
275+00	R	1
298+20	R & L	2
309+00	R & L	2
321+75	R & L	2
341+00	L	1
361+30	R & L	2
369+00	R	1
TOTAL		12

R.O.W. MARKERS

LOCATION	SIDE	No.
177+00	R & L	2
181+51	"	2
189+35 E	"	2
212+18	"	2
216+67 E	"	2
244+20	"	1
273+11	"	2
289+60	"	2
305+80	"	2
336+95	"	2
337+85	"	1
367+05	"	1
371+00	"	2
TOTAL		26

LIST OF STRUCTURES

LOCATION	DESCRIPTION	REMOVE STRUCT. No.	EXCAVATION Cu Yd		STRUCTURAL EXCAVATION Cu Yd		CONCRETE TO METAL CURV. FIN. - Lin ft				Misc. Sq. Yd.	REFERENCE
			Uncl.	Emb.	Dry	Wet	18"	24"	30"	36"		
177+00	Project marker and approach				2.4							Book 3 Page 10 & X-Sections
179+60	Side drain and approach			15.4								Book 3 Page 46 & X-Sections
187+50	Cross culvert and ditches				13							Book 3 Pages 21 & 25, X-Sections
192+00	Side drain and approach				82.4							Book 3 Page 25
205+30	Remove structure; cross culvert ditch	1	2		5.0							Book 3 Pages 24, 24.17
222+00	" " " "	1			4.6				50			" " " "
236+50 - 243+00	Diversion channel											" " " "
243+00	Cross culvert and ditches				19.6					50		" " " "
245+30	Remove structure	1										" " " "
250+00	" " " " " " " "	1			10.8				50			" " " "
254+30	Cross culvert				2.2				30			" " " "
264+00 - 269+10	Ditch change											" " " "
264+36	Remove structure; cross culvert	1			4.5				54			3.1
269+10	" " " " " " " "	1			23.2				70			3.1
270+00	Side drain and approach				14.8							
270+50 - 271+30	Ditch change											
275+00	Cross culvert				3.2				30			6.0
284+55 - 284+95	Stone Underdrain				21.7	46.6						40 lin ft Work order No. 3238, Book 3, Page 18
284+00	Remove structure; cross culvert	1	33		1.7				40			6.1
295+28	" " " " " " " "	1			31.2	3.1			68			Book 3 Page 17
284+95 - 285+15	Ditches			24								" " " " 21.2
300+00	Cross culvert				7.8				70			3.7
302+91	" " " " " " " "				21.3				60			3.1 Work order No. 3234
303+50	Side drain and approach				7.99				80			" " " " 3760
309+00	Approaches				6.53							Cross Sections
321+75	Side drain and approaches				32.4				32			" " " "
326+38 - 326+60.1	Bridge (See summary for quantities)					180.5						Cross section sheet
332+33	Cross culvert ditches			325		5.7			50			7.8
338+30	" " " " " " " "					5.8			54			11.9
341+00	Approaches				28.0							Cross Sections
347+04	Remove structure; cross culvert, ditches	1	592		19.7				36			6.9
349+00	" " " " " " " "	1			8.7				32			6.3
361+15	" " " " " " " "				7.2				48			4.8
361+15 - 365+30	Ditch change			117								
362+06	Remove structure	1										
368+30	Approaches				35.1							Cross Sections
367+40 - 369+00	Remove buildings											W.O. No. 3235
369+51	Remove structure; cross culvert	1			3.5				46			4.9
370+00	Move pond & Approach				5.9							Cross Sections
371+00	Project marker and approach				6.3							" " " "
217+75	Cross Culvert					31.9			64			6.0 Work Order No. 3764
223+40	" " " " " " " "					24.3			71			6.0
294+50 - 297+40	Riprap											200 Cu Yd 3013
284+00 - 286+00	Ditch change				44.1							Book 3, Page 21
TOTALS		12	1654		470.5	50.3	962	324	52	50	1208	

Note: For culvert excavation refer to cross section sheets. To the yardage there shown add excavation for rubble paving, page 17, Book 3. Ditch change page 21, Book 3. Dry rubble slope paving, page 17, Book 3. Building removal Work order No. 3235. Culvert list Book 3, page 25. Approaches: see cross sections.

N.W. 1/4, SEC. 33
T. 9S. R. 80W.

S.W. 1/4, SEC. 33
T. 9S. R. 80W.

S.E. 1/4, SEC. 32
T. 9S. R. 80W.



N.E. 1/4, SEC. 32
T. 9S. R. 80W.

FED. ROAD DIST. NO.	STATE	FED. AID PROJ. NO.	SHEET NO.	TOTAL SHEETS
2	COLO.	248E	7	

NOTE: Fencing, Gates and Right of Way Markers required are tabulated on Sheet No. 2.
Pole lines encroaching on the right of way are to be moved by owners.

PLAN	DATE
NO.	

PROFILE	DATE
NO.	

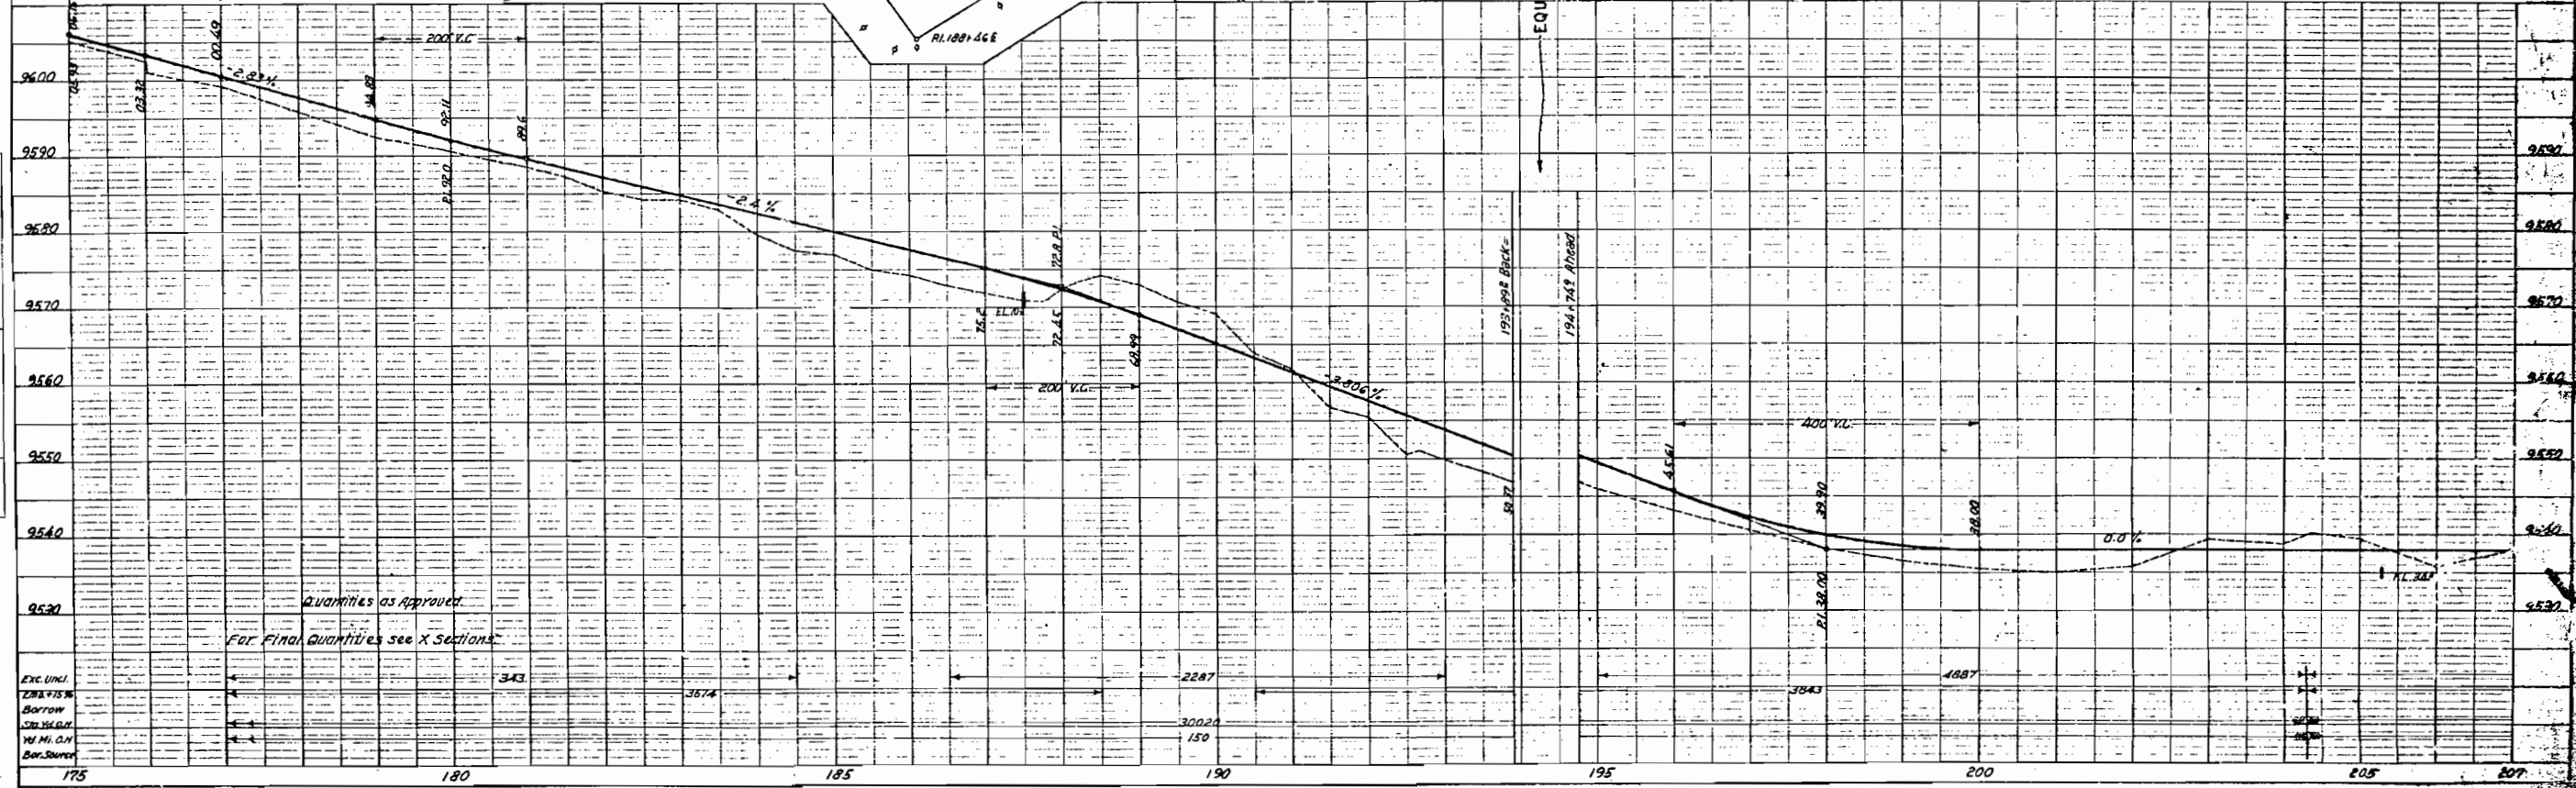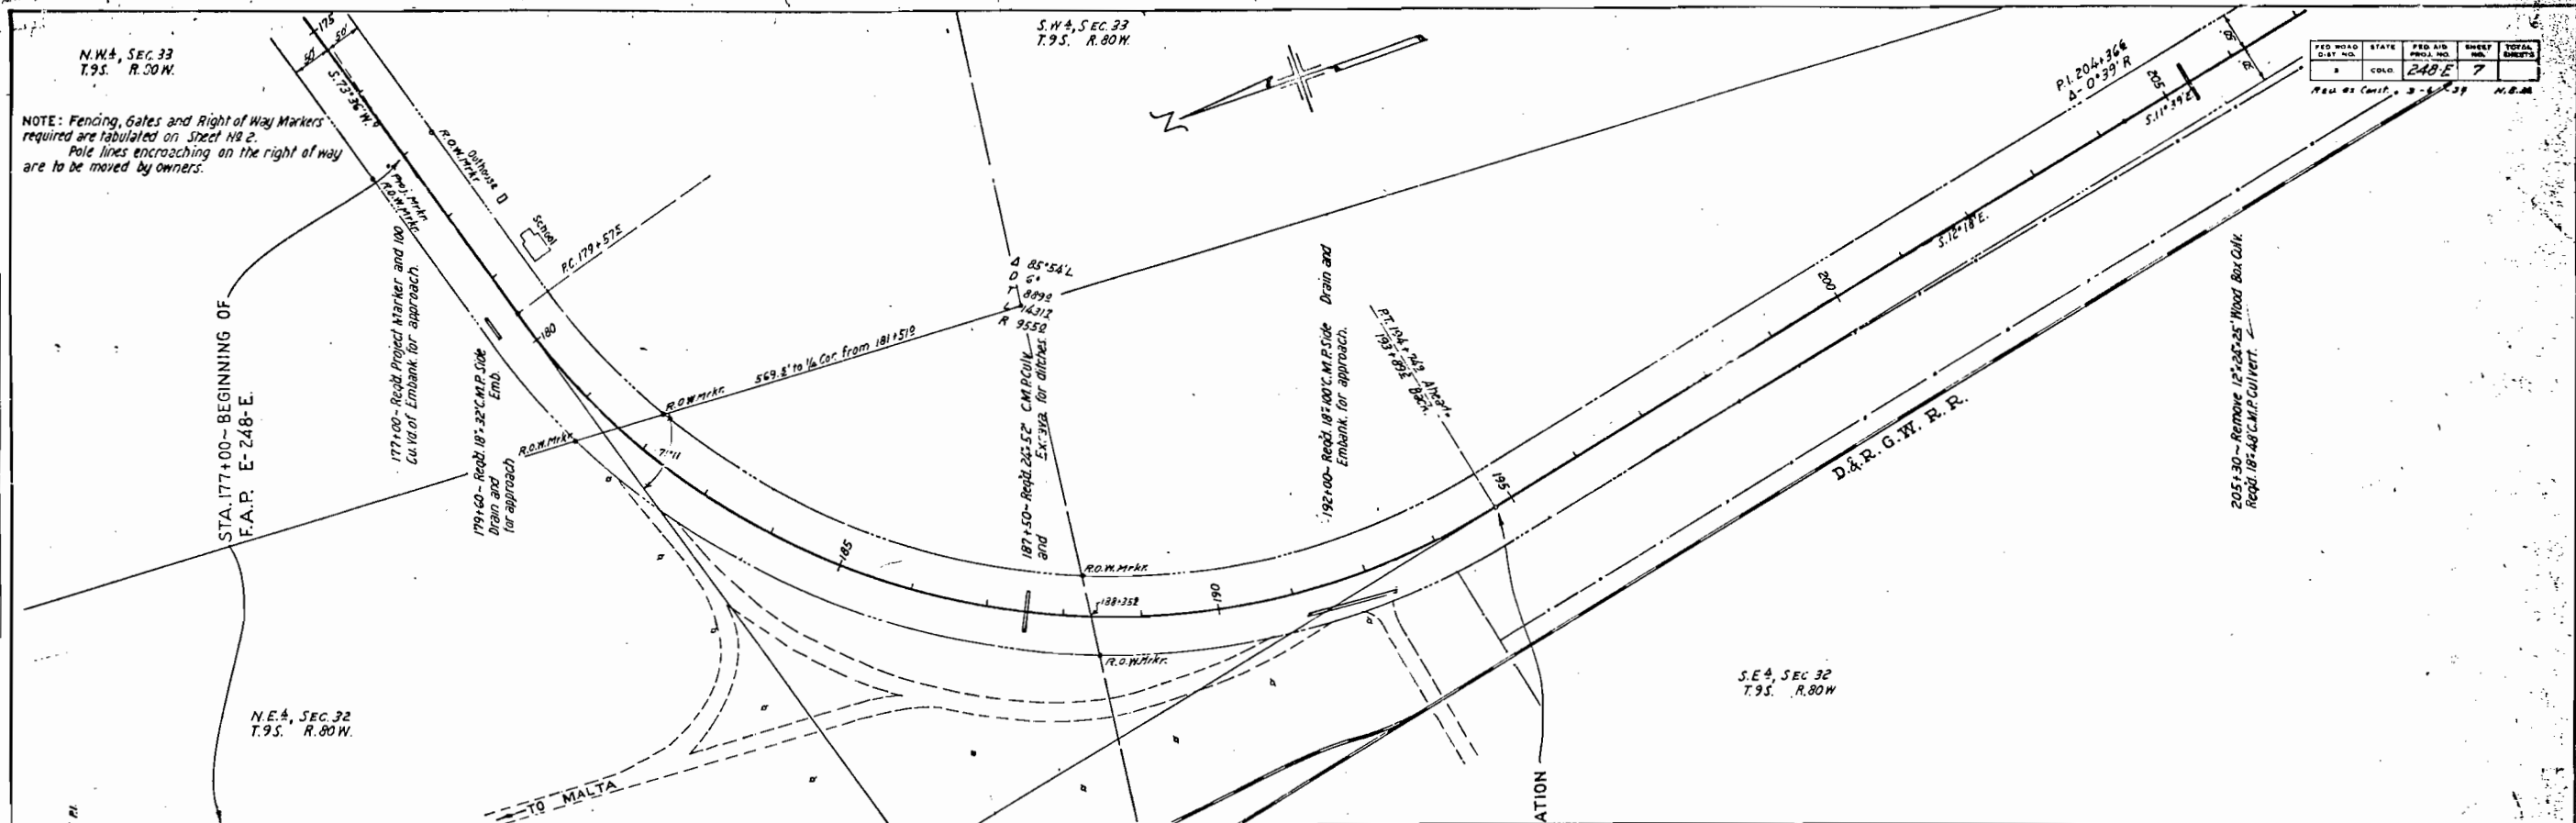


S.W. 1/4 SEC. 33
T. 9 S. R. 80 W.

N.W. 1/4 SEC. 4
T. 10 S. R. 80 W.


FED. ROAD DIST. NO.	STATE	FED. AID PROJ. NO.	SHEET NO.	TOTAL SHEETS
1	COLO.	248-E	8	

Rev. of Const. 3-6-38 H.E.M.


PLAN
DATE: _____ BY: _____
CHECKED: _____
NOTE BOOK NO. _____
BT OF WAY CHECKED: _____
NO. _____

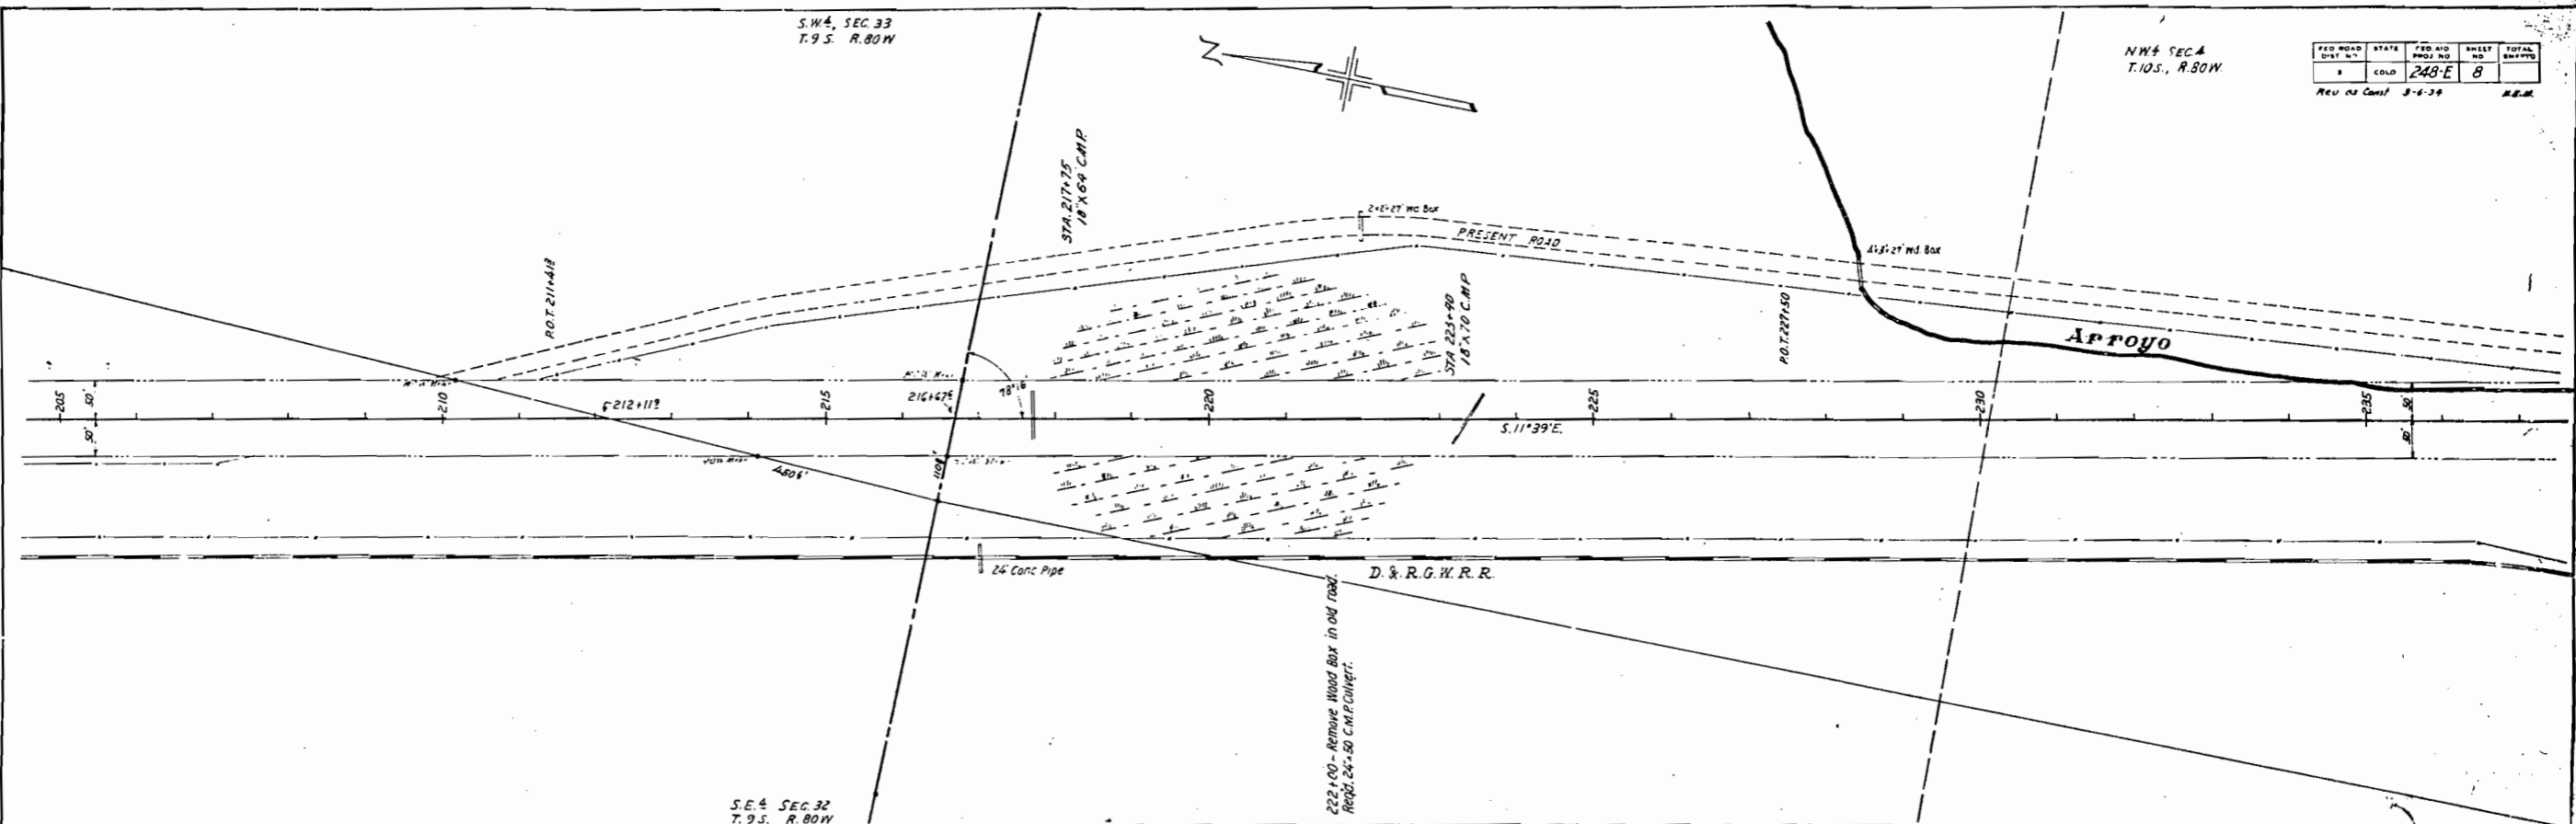

PROFILE
DATE: _____ BY: _____
CHECKED: _____
NOTE BOOK NO. _____
STRUCTURE MOISTURE CHECKED: _____
NO. _____

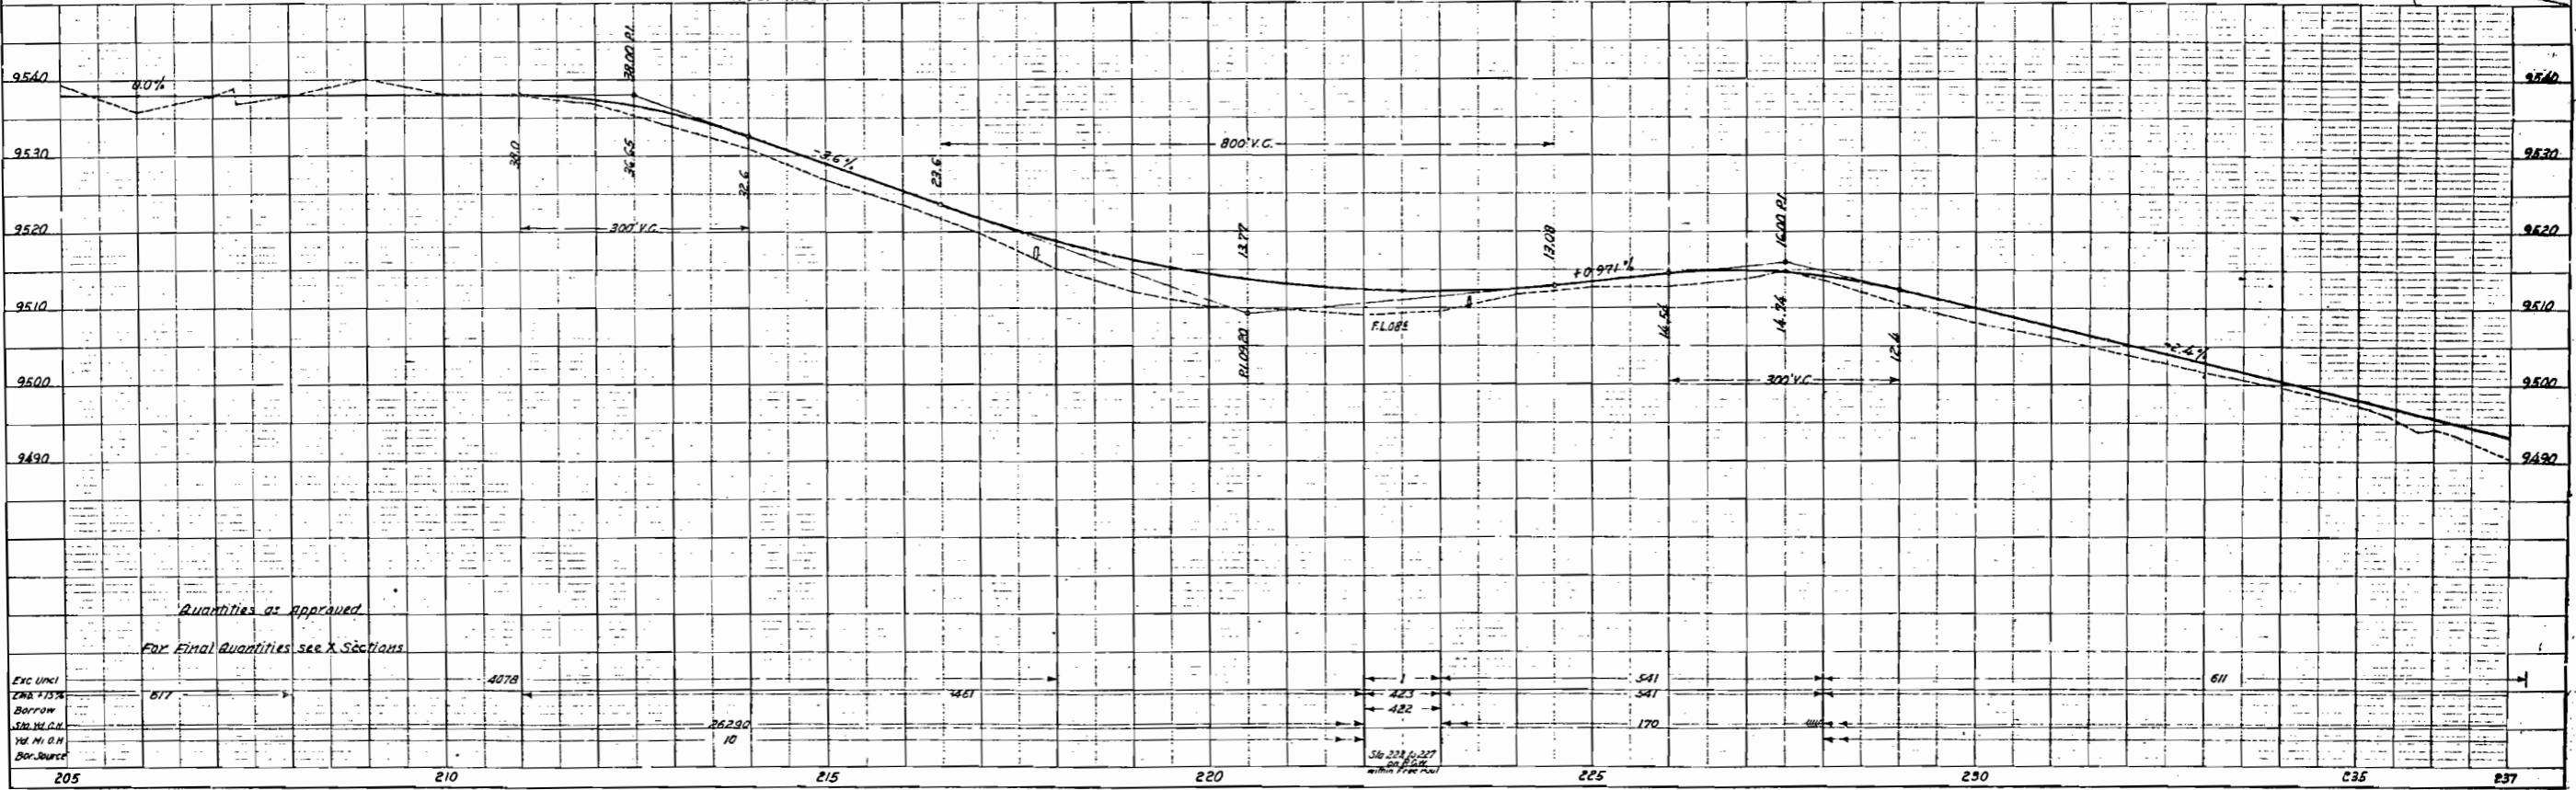


Quantities as Approved
For Final Quantities see X Sections

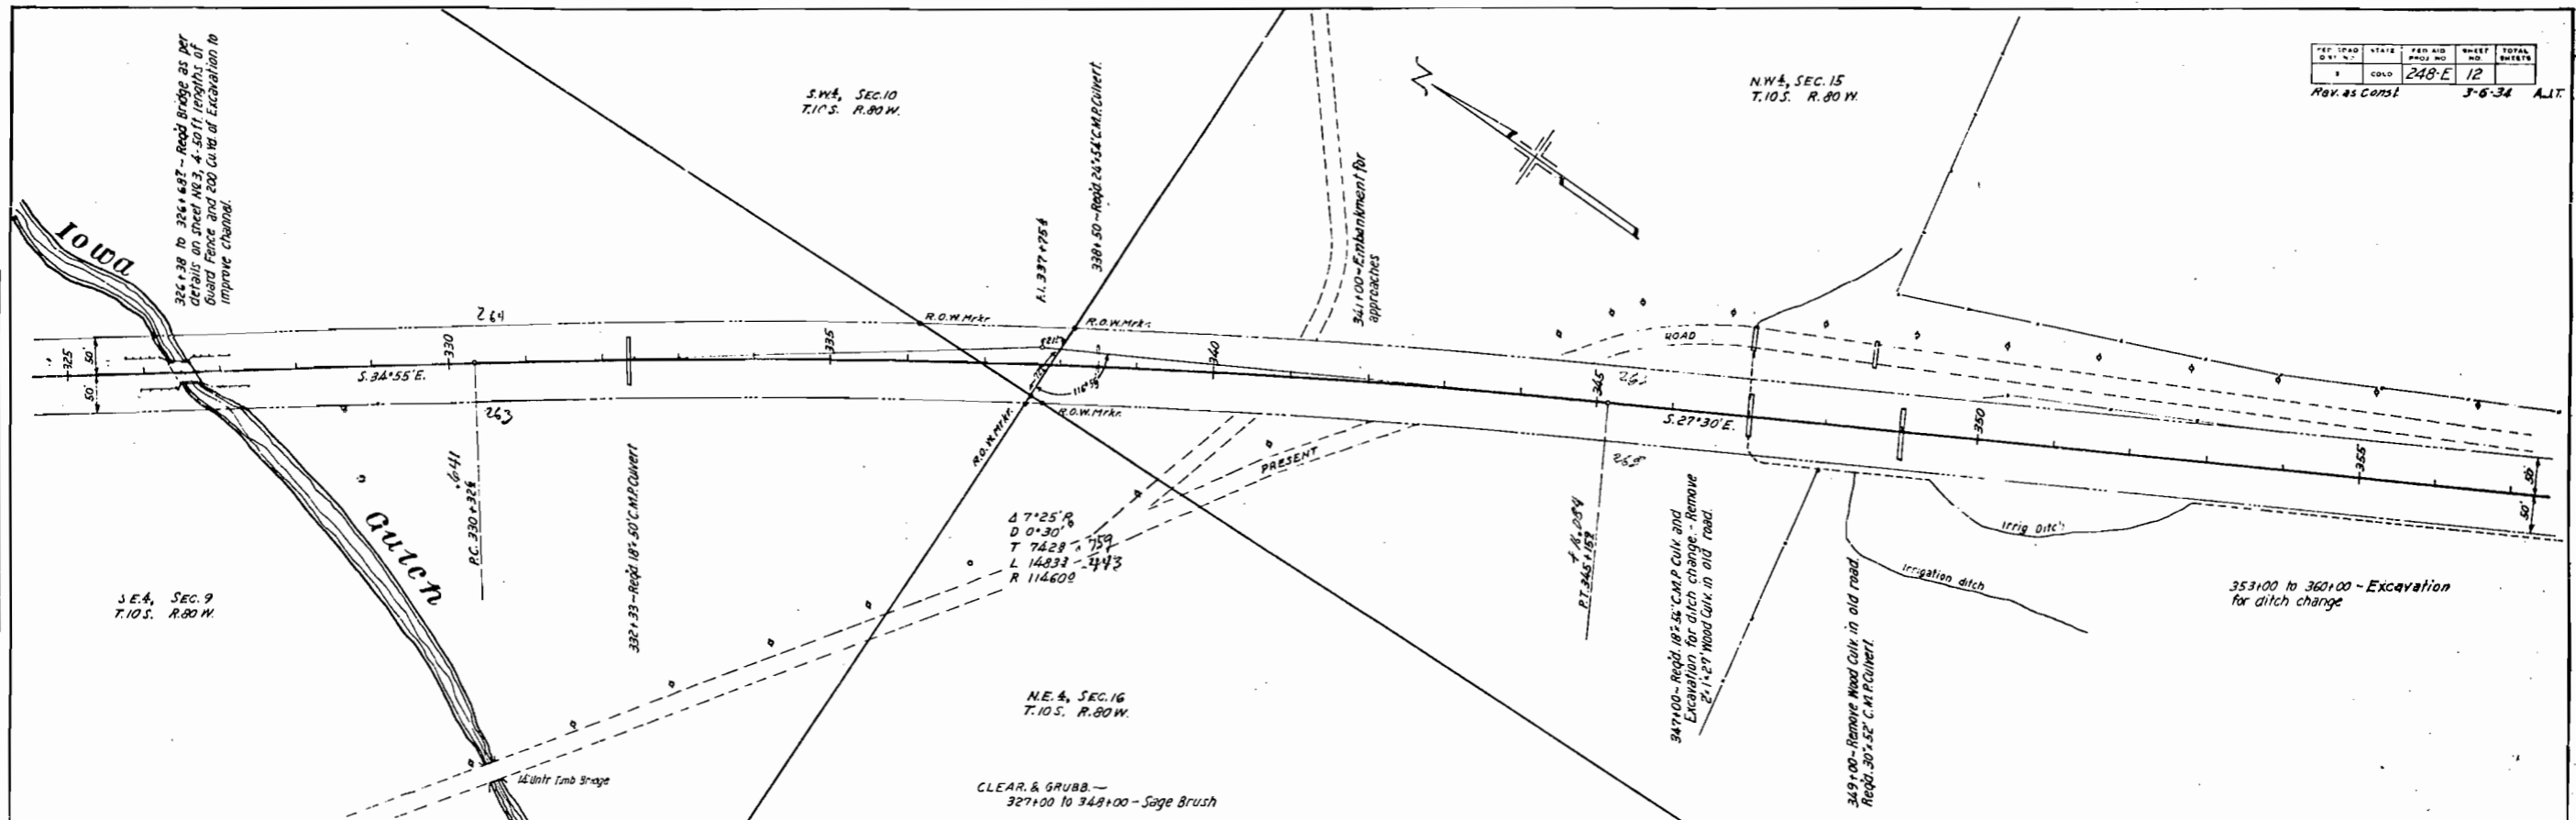

PLAN	DATE
BY	
CHECKED	
APPROVED	
NOTE BOOK	
NO.	

PROFILE	DATE
BY	
CHECKED	
APPROVED	
NOTE BOOK	
NO.	

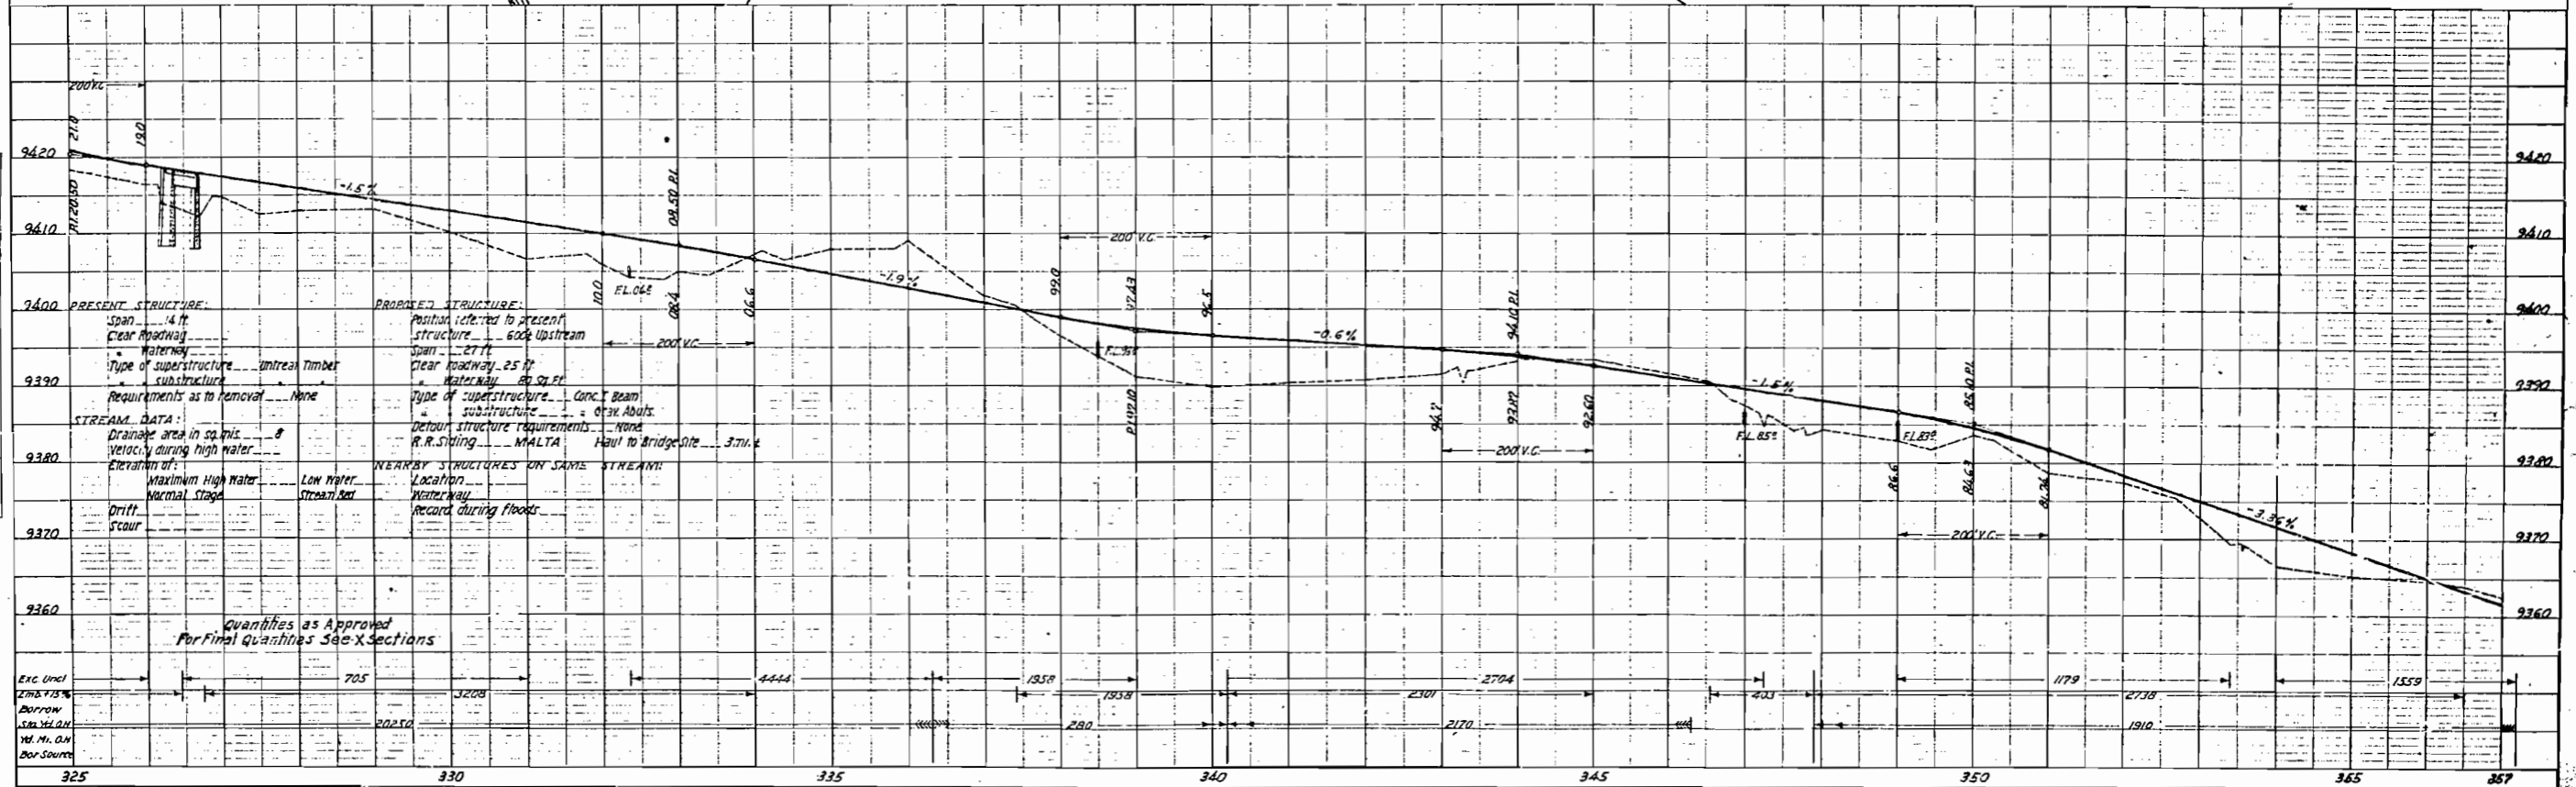

N.W. 1/4, SEC. 15
T. 105. R. 80 W.

S.W. 1/4, SEC. 15
T. 105. R. 80 W.

FIELD NO.	STATE	FED. AID PROJ. NO.	SHEET NO.	TOTAL SHEETS
2	COLO.	248-E	13	

Revised as Constructed 3-5-74 A. J. T.

PLAN	DATE	BY
REVISIONS		
NO.		

NOTE: BOON GRADINGS CHECKED BY []

PROFILE	DATE	BY
REVISIONS		
NO.		

NOTE: BOON GRADINGS CHECKED BY []

