



COLORADO
Department of
Transportation

DOCUMENT SEPARATOR SHEET

REGION 5 – JUNE 2017 CONVERSION

To be placed at the beginning of each separator sheet.



r500001673

Description:

ROW Plans 11X17

Route # and Mile Points:

SH 141

Originating Office:

ROW/Survey

File Name:

EHS-S 0141(15)_ROW(.PDF)

Box Location:

27 of 38


STATE DEPARTMENT OF HIGHWAYS

DIVISION OF HIGHWAYS—STATE OF COLORADO

R.O.W. PURCHASED
UNDER S 0141(2)

FEDERAL ROAD REGION NO.	DIVISION	PROJECT NO.	SHEET NO.
VIII	COLORADO	EHS-S 0141(15)	/

CONVENTIONAL SIGNS

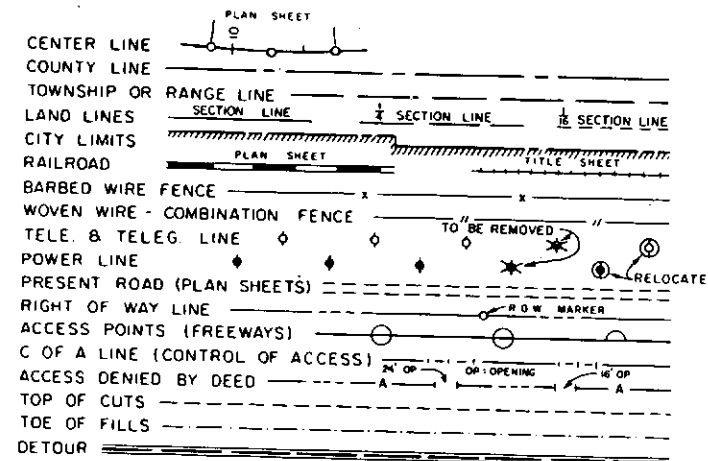

PLAN AND PROFILE OF ~~PROPOSED~~ COMPLETED FEDERAL AID PROJECT NO. EHS-S 0141(15) STATE HIGHWAY NO. 141 MONTROSE COUNTY

SCALES OF ORIGINAL DRAWINGS


ON PLAN, 1 IN. = 100 FT.
ON PROFILE { 1 IN. = 100 FT. HORIZONTAL
1 IN. = 10 FT. VERTICAL
GRADE LINE ON PROFILE IS SHOWN AS GRADE OF FINISHED ROAD

Contractor: Nilsen, Inc.
Insp. Engr.: R. E. Marschall
Plan Engr.: F. A. G. Sales
Proj. Initialed: May 22, 1972
Proj. Completed: October 17, 1972

TABULATION OF LENGTH & DESIGN DATA

STATION	ROADWAY	MAJOR STRUCTURE
	LIN. FT.	LIN. FT.
98+61.7 BEGIN EHS-S 0141(15) APPROX. STA. 98+61.7 ON S 0141(2)	605.1	
104+66.8 STRUCTURE NO. L-2-F 105+89.2	432.5	122.4
110+21.7 END EHS-S 0141(15)		
	1037.6	122.4
SUMMARY		
	LIN. FT.	MILES
ROADWAY	1037.6	0.197
MAJOR STRUCTURE	122.4	0.023
TOTAL-NET AND GROSS LENGTH	1160.0	0.220
DESIGN DATA		
MAXIMUM DEGREE OF CURVE	8°00'	
MAXIMUM GRADE	4.90%	
MINIMUM S.S.D.—HORIZONTAL	500'	
MINIMUM S.S.D.—VERTICAL	NONE	
MAXIMUM DESIGN SPEED	30 M.P.H.	

1991 DESIGN TRAFFIC VOLUME — 1500 A.D.T.
240 D.H.V.

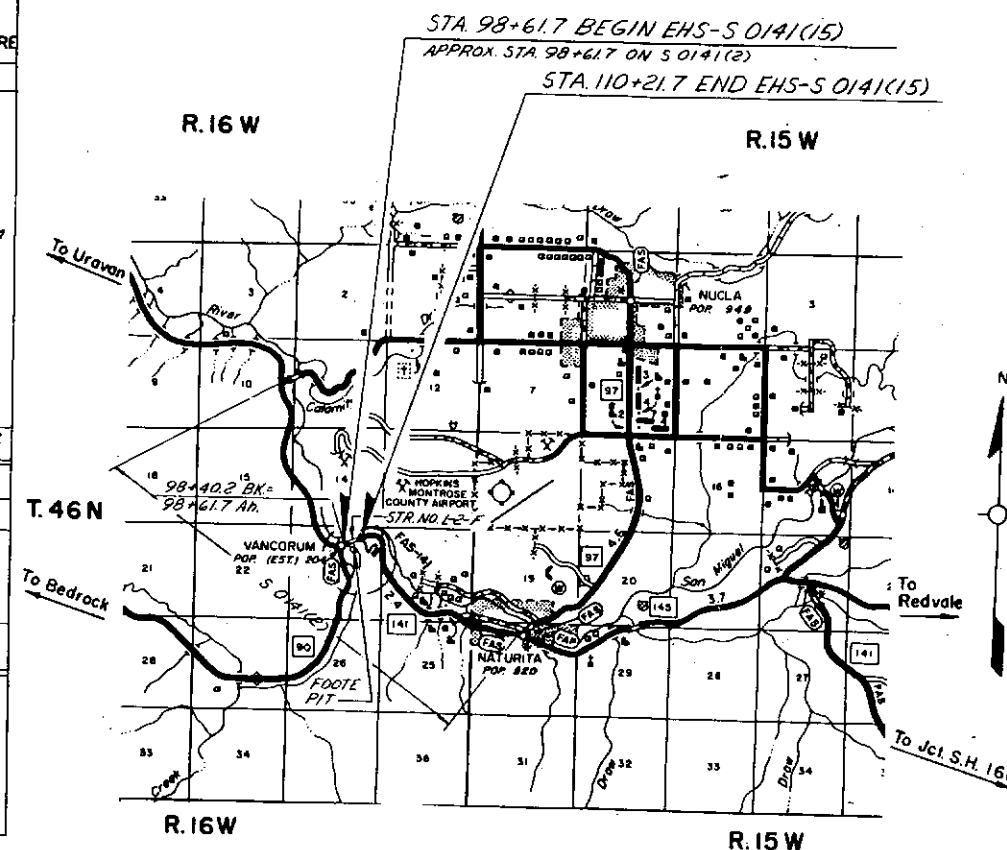

SHEET NO.	INDEX OF SHEETS	
1	TITLE PAGE, SKETCH MAP AND TABULATION OF LENGTH AND DESIGN	
2	TYPICAL SECTIONS, GENERAL NOTES AND DETAIL OF GUARD RAIL INSTALLATION	
3 - 4	(PRESENT CONSTRUCTION)	
5	SUMMARY OF APPROXIMATE QUANTITIES	
6	STRUCTURE QUANTITIES	
7	SUMMARY OF EARTHWORK QUANTITIES, TABULATION OF GUARD RAIL AND	
8 - 25	TABULATION OF DELINEATORS	
26	PIT SKETCH	
27 - 29	DETAILS OF BRIDGE	
30 - 36	PLAN AND PROFILE	
	STRUCTURE CROSS SECTIONS	
	CROSS SECTIONS	
M-203-SC	SUPERELEVATION & WIDENING OF CURVES-CROWNED HIGHWAYS	10-22-71
M-203-B	APPROACH ROADS, FLARING, CUT SLOPE TREATMENT,	
	BRIDGE & CREST WIDENING	
M-203-C	DITCH TYPES	4-27-70
M-206-AA	EXCAVATION AND BACKFILL FOR STRUCTURES	7-23-68
M-500-A	LETTERS AND FIGURES FOR STRUCTURE NUMBERS	2-16-72
M-603-M	METAL CULVERT PIPE - 18-20 LADING	7-1-65
M-603-RC	REINFORCED CONCRETE PIPE	2-11-71
M-604-BA	INLET, TYPE C	3-1-71
M-606-AB	GUARD RAIL, TYPE 3	5-24-71
M-612-A	MARKER POSTS AND BENCH MARKS	12-20-71
M-612-C	DELINEATORS	6-30-71
M-614-A	TIMBER BARRICADES	7-11-68
M-614-IC	STANDARD CONSTRUCTION IDENTIFICATION SIGNS	4-23-69
M-614-TB	TRAFFIC SIGNING FOR HIGHWAY CONSTRUCTION	9-25-70
		11-22-71

"As Constructed No Revisions"
Sheets 7, 9-13, 18-25

INACTIVE

SEE SPECIAL PROVISIONS FOR
NOTICE TO BIDDERS

DIVISION OF HIGHWAYS	
APPROVED	DATE
<i>L. B. Bowen</i>	3-28-72
CHIEF ENGINEER	


Department of Highways State of Colorado	
Final Approval as Constructed Plans	DATE
<i>L. B. Bowen</i>	1-5-73
DIST. COL. TRNG. ENGINEER	

DEPARTMENT OF TRANSPORTATION FEDERAL HIGHWAY ADMINISTRATION	
APPROVED	DATE
DIVISION ENGINEER	

FEDERAL ROAD REGION NO.	DIVISION	PROJ. NO.	SHEET NO.	TOTAL SHEET
VIII	CO: OREGON	EHS-S 0141 (15)	26	

AS CONSTRUCTED
REVISED DATE 10-17-72

Note: Adjustments of alignment ~~may be~~ required to fit Approaches to Project.

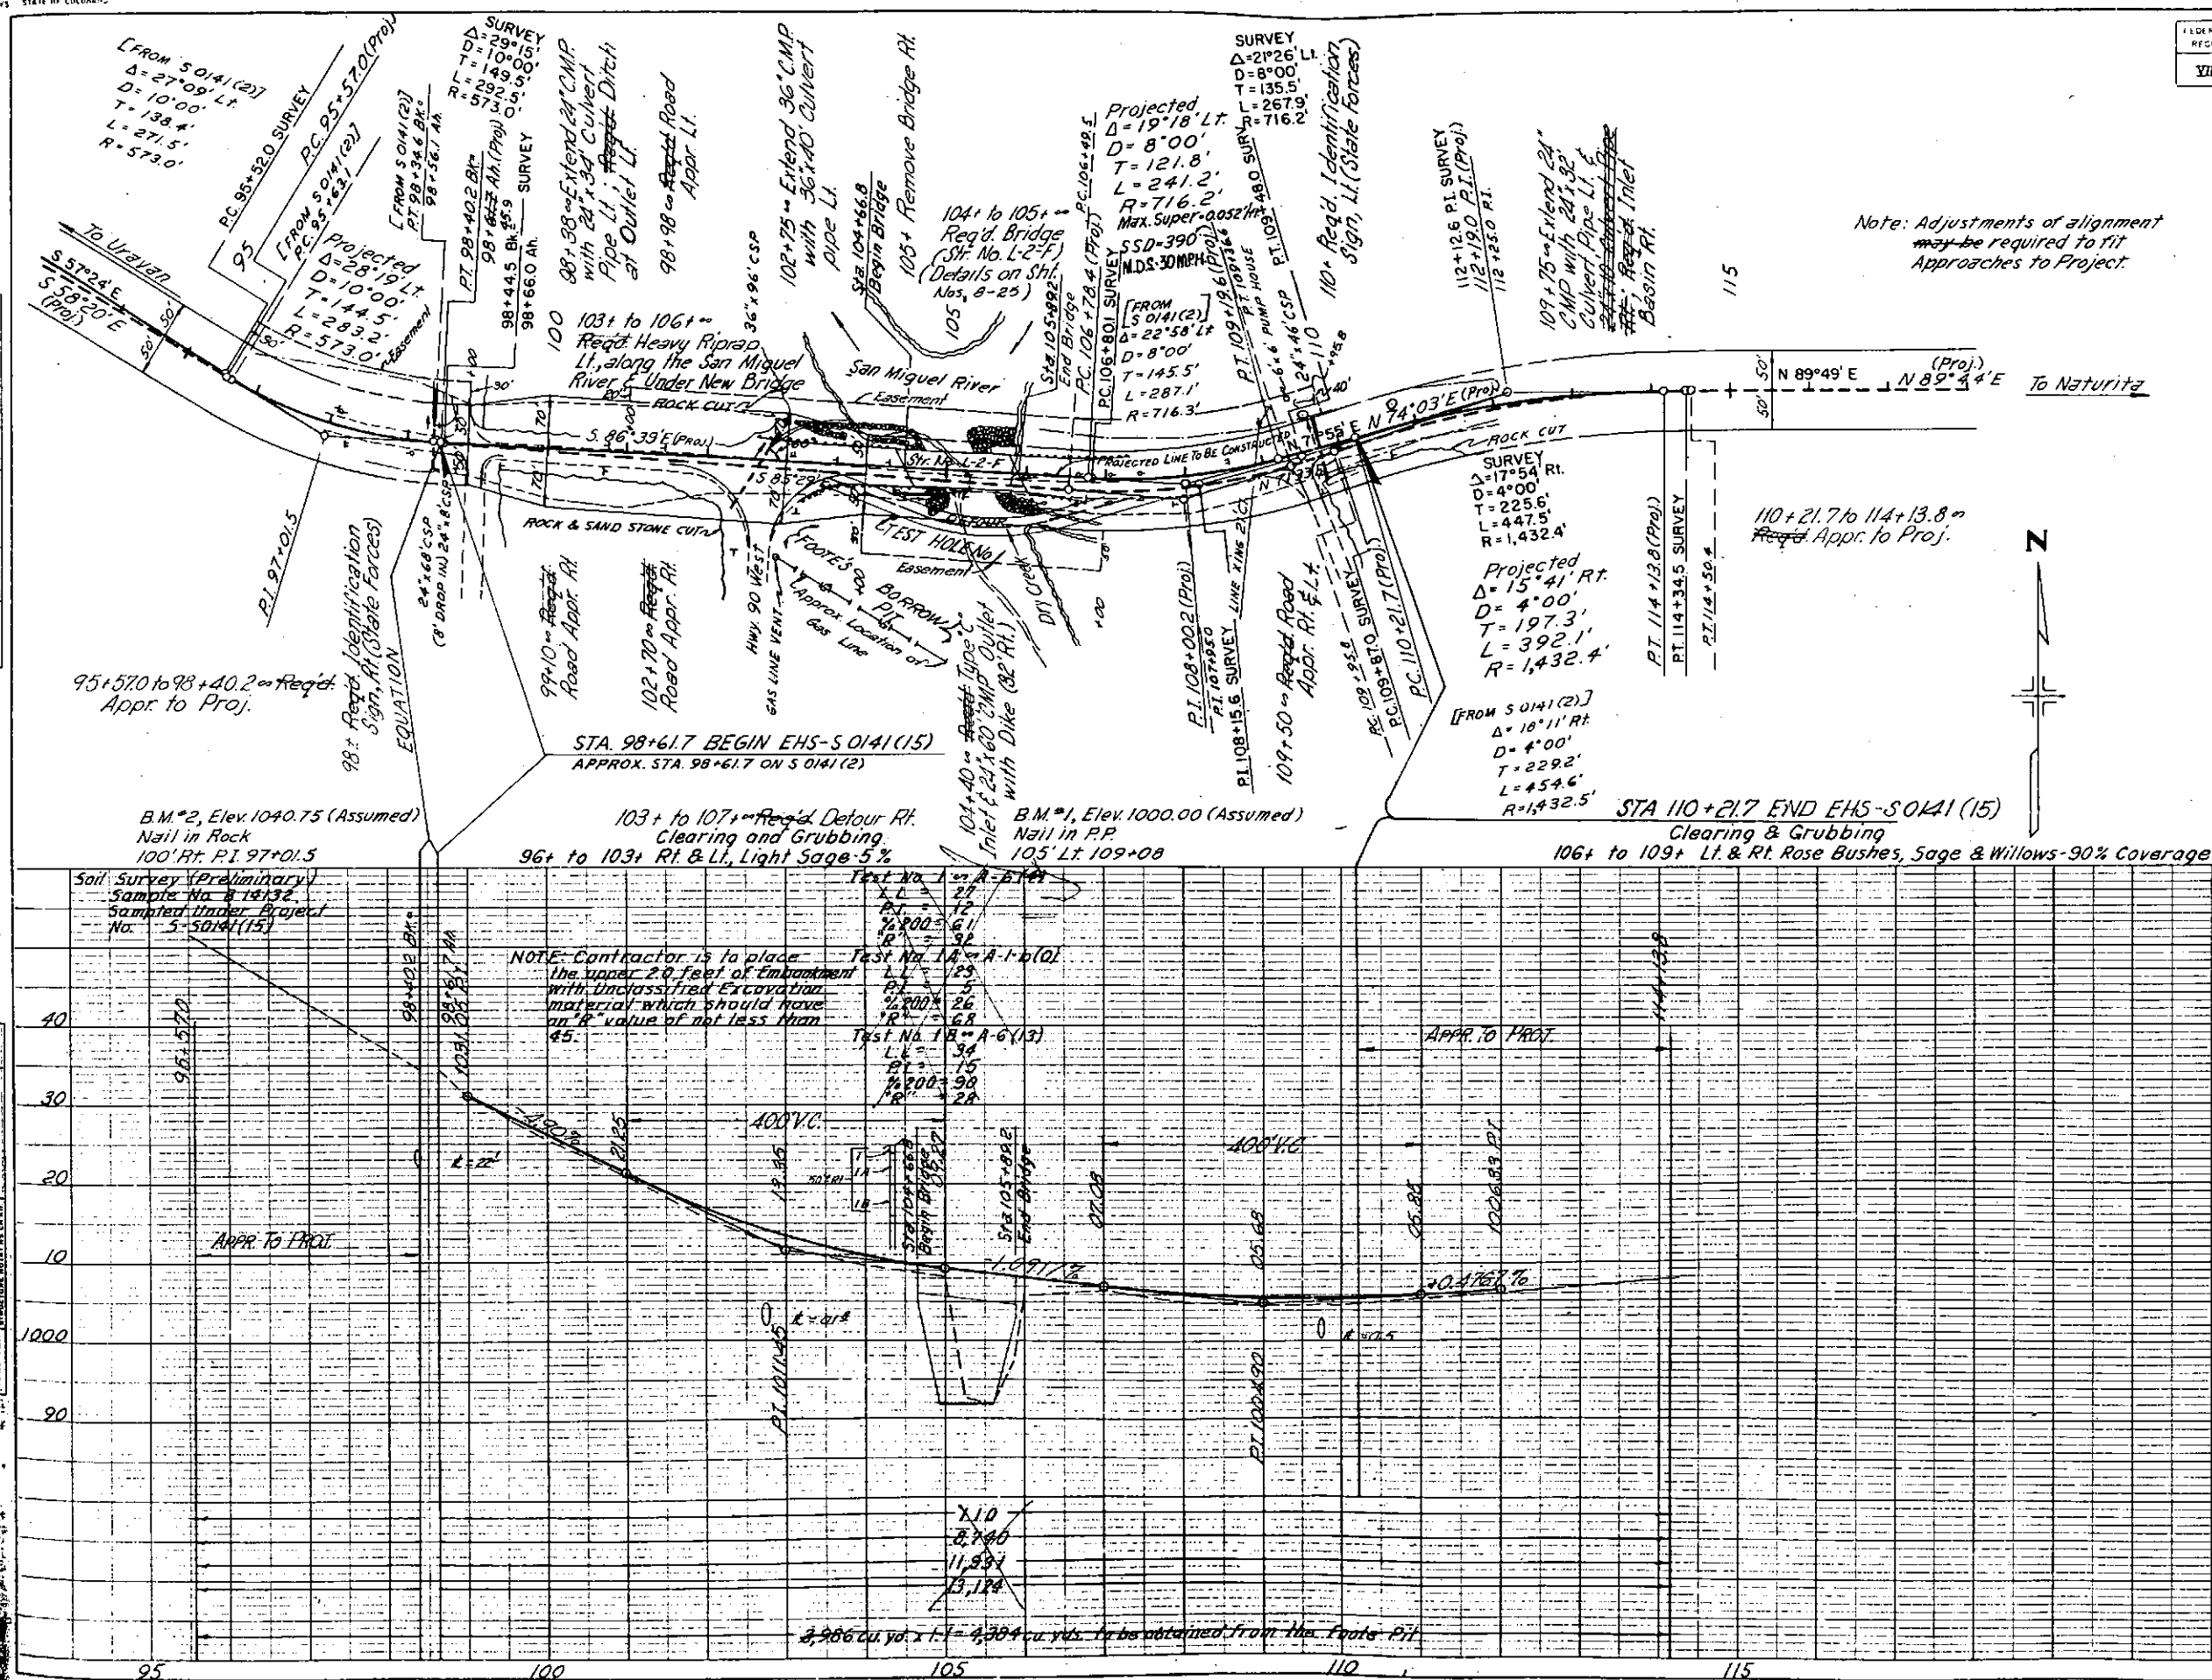

Emb. Factor
Excavation
Embankment
Emb. x Factor
Yd. Mi. Haul
Borrow