
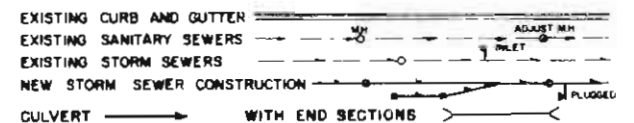


CONVENTIONAL SIGNS

TITLE SHEET

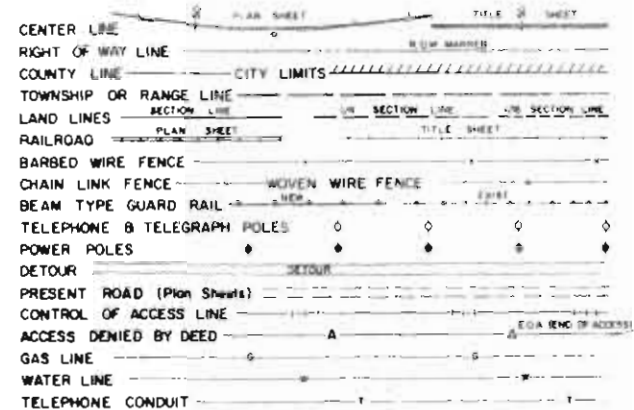

STATE DEPARTMENT OF HIGHWAYS DIVISION OF HIGHWAYS—STATE OF COLORADO

PLAN AND PROFILE OF PROPOSED FEDERAL AID PROJECT NO. EHS-F 121-1(7) STATE HIGHWAY NO. 121 BOULDER COUNTY

10-21-71 POL
CHG PROJ. NO.

FEDERAL ROAD REGION NO.	DIVISION	PROJECT NO.	SHEET NO.
9	COLORADO	EHS-F 121-1(7)	1


P.E. & R.O.W. OBLIGATED UNDER F 121-1(1)

INDEX OF SHEETS: SEE SHEET No. 2

SCALES OF ORIGINAL DRAWINGS
ON PLAN 1" = 100 FT
ON PROFILE 1" = 100 FT HORIZONTAL
1" = 10 FT VERTICAL
GRADE LINE ON PROFILE IS SHOWN AS GRADE OF FINISHED ROAD
GROSS LENGTH OF PROJECT = 0.605 MILES
NET LENGTH OF PROJECT = 0.375 MILES

STA. 647 + 87.0 END PROJECT
EHS-F 121-1(7)

STA. 509 + 74.7 BEGIN PROJECT
EHS-F 121-1(7)

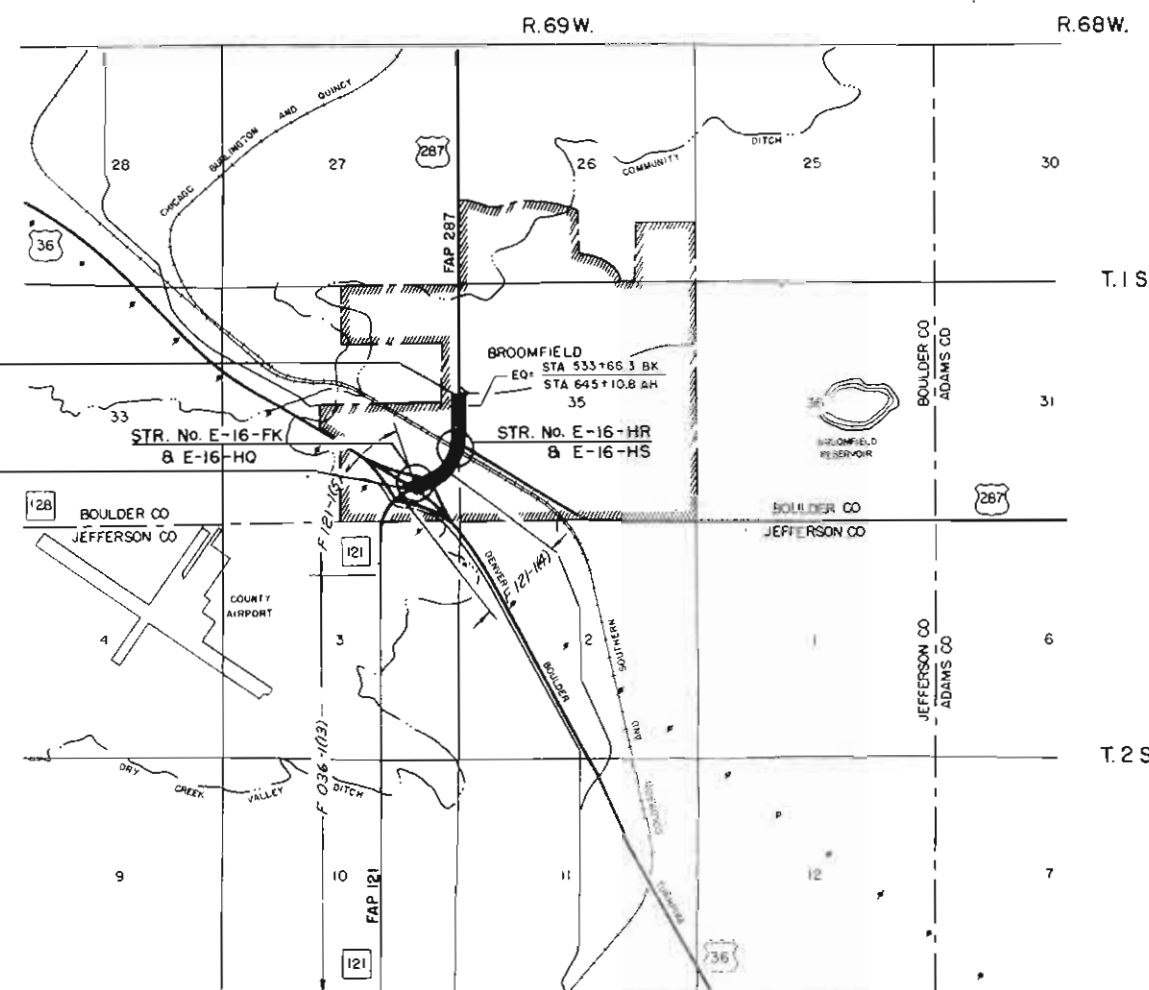

SCALE OF MILES
0 1/2 1 2

INACTIVE

SEP 10 1975

CONTRACTOR Siegrist Construction Company
RESIDENT ENGINEER R.D. SHERMAN
PROJECT ENGINEER R.L. RIDGELL
DATE COMPLETED August 24 1973
APPROVED BY *[Signature]* District Construction Engineer

DIVISION OF HIGHWAYS	
APPROVED	DATE
<i>[Signature]</i>	10-71
CHIEF ENGINEER	DATE

PLANS PREPARED UNDER
CONTRACT
F121-1(1)
BY
BARTON • STODDARD • MILHOLLIN • HIGGINS
A DIVISION OF INTERNATIONAL ENGINEERING COMPANY, INC.
DENVER, COLORADO

DEPARTMENT OF TRANSPORTATION FEDERAL HIGHWAY ADMINISTRATION	
APPROVED	DATE
DIVISION ENGINEER	

10-21-71 PDL
CHG PROJ. NO.
GEN. NOTE
REV. STD. DATES

FEDERAL ROAD REGION NO.	DIVISION	PROJ. No.	SHEET NO.	TOTAL SHEETS
9	COLORADO	ENS-F 121-1(7)	2	

10-21-71

TABULATION OF LENGTH

STATION	ROADWAY	MAJOR STRUCTURE
	BOULDER COUNTY LIN. FT.	BOULDER COUNTY LIN. FT.
509 + 74.7 Begin Project STR. NO. E-16-FK	1,000.1	231.0
512 + 05.7		
522 + 05.8		
526 + 61.3 STR. NO. E-16-HR E-16-HS	705.0	455.5
533 + 66.3 Back =	276.2	
645 + 10.8 Ahead		
647 + 87.0 End Project		
TOTAL FEET	1,981.3	686.5
TOTAL MILES	0.375	0.130

SUMMARY

	LIN. FT.	MILES
Roadway - Net Length	1,981.3	0.375
Major Structures - Boulder County	686.5	0.130
Gross Length	2,667.8	0.505

DESIGN DATA

	MAINLINE
Maximum Design Speed	60 M.P.H.
Maximum Degree of Curve	5° 00'
Maximum Grade	5.96%
Minimum Stopping Sight Distance - Horiz.	> 600'
Minimum Stopping Sight Distance - Vert.	515'
Design Loading of Major Structures	HS-20-44

GENERAL NOTES

For preliminary plan quantities of bituminous materials the following rates of application were used:

Prime Coat MC 70 0.40 Gal./Sq. Yd.
Emulsified Asphalt Tack Coat SS1H 0.10 Gal./Sq. Yd.

Rates of application shall be as determined by the Engineer at the time of application.

It is estimated that 2,000 hrs of flagging for traffic will be required for the project.

All utilities encroaching on construction are to be moved by the owners.

Wetting applications shall be at the following approximate rates:

Embankment 40 Gal./C.Y.
Subbase and Surfacing 15 Gal./Ton

Any layer of Bituminous Pavement that is to have a succeeding layer placed thereon shall be completed full width before succeeding layer is placed.

Road approaches which require Bituminous Pavement shall be primed and a 2" thickness of pavement placed.

Public approaches and entrances to buildings or residences shall be paved to the R/W line.

It is estimated that the old road is to be obliterated in the location shown on the grading plans.

Full depth of all embankments and bases of cuts and fills to a depth of 6" shall be constructed with moisture and density control (T 99). Excavation required for compaction of base of cuts and fills will be considered subsidiary to that operation and will not be paid for separately.

The type of compaction for structural backfill shall be AASHTO T 99.

The minimum thickness of topsoil shall be 4" (6.75 C.Y. required).

Seeding will be required within R/W limits on all areas not surfaced (See Table for types).

A ski type device of at least 30' shall be furnished with each bituminous paver equipped with an automatic control system.

It is required that the top 2.0' of fills shall have a minimum R value of 25.

INDEX OF SHEETS

SHEET No.

DESCRIPTION

1	Title Sheet
2	Index of Sheets, Tabulation of Length and Design Data, General Notes
3-4	Typical Sections
5-7	Summary of Approximate Quantities
8	List of Structures
9	Surface Materials Plan
10	Summary of Earthwork, Tabulation of Delineators, Seeding, Guard Rail and Fencing Quantities
11	Galvanized Steel Bridge Rail Detail - Str. No. E-16-FK
12	Existing Structure Modifications - Str. No. E-16-FK
13-29	Structure Plans - Str. Nos. E-16-HR and E-16-HS
30	Energy Dissipator Detail
31-31A	Miscellaneous Details - Guard Rail Connection and Stair Detail, Special Fence Detail
32-33	Interchange Details
34	Intersection Detail - Ramp 'C' and 'D' with Bus Ramp
35-36	Ramp Profiles
37-38	Plan - Profile Sheets
39-40	Delineators, Guard Rail and Regrading Details, Detail A
41-42	Lighting Details
43-47	Drainage Cross Sections
48-74	Cross Sections

STANDARD DRAWINGS

STD. No.

TITLE



DATE

M-203-A	Superelevation and Widening of Curves - Crowned Highways	7-30-68
M-203-A-1	Superelevation of Curves - Divided Highways	7-30-68
M-203-B	Approach Roads, Flaring, Cut Slope Treatment, Bridge and Crest Widening	4-27-70
M-206-AA	Excavation and Backfill for Structures (2 Sheets)	3-1-71
M-500-A	Letters and Figures for Structure Numbers	7-1-65
M-603-CA	Concrete and Metal End Sections	6-25-71
M-603-M	Metal Culvert Pipe H-20 Loading	2-11-71
M-604-AA	Concrete Inlets Types 3 and 3 Double	12-2-68
M-604-AB	Concrete Inlet Type 13	4-15-71
M-604-BA	Inlet, Type C	5-24-71
M-604-D	Steps for Manholes and Inlets	7-23-68
M-606-AB	Guard Rail Type 3 (3 Sheets)	10-21-71
M-607-A	Wire Fences and Gates (2 Sheets)	8-19-71
M-609-A	Curbs and Gutters	5-7-71
M-612-A	Marker Posts and Bench Marks	6-30-71
M-612-C	Delineators (2 Sheets)	7-11-68
M-614-1C	Standard Construction Identification Signs (2 Sheets)	9-25-70
M-614-TB	Traffic Signing for Highway Construction (3 Sheets)	12-24-68
M-614-RB	Standard Railroad Warning Signs	8-22-68
M-607-B	Chain Link Fence (2 Sheets)	4-20-71
M-614-A	Timber Barricades	4-23-69


TYPICAL SECTIONS

10-21-71 PDL
CHG PROJ. NO

PROJECT NO.	SHEET NO.	TOTAL SHEETS
EHS-F 121-1(7)	3	

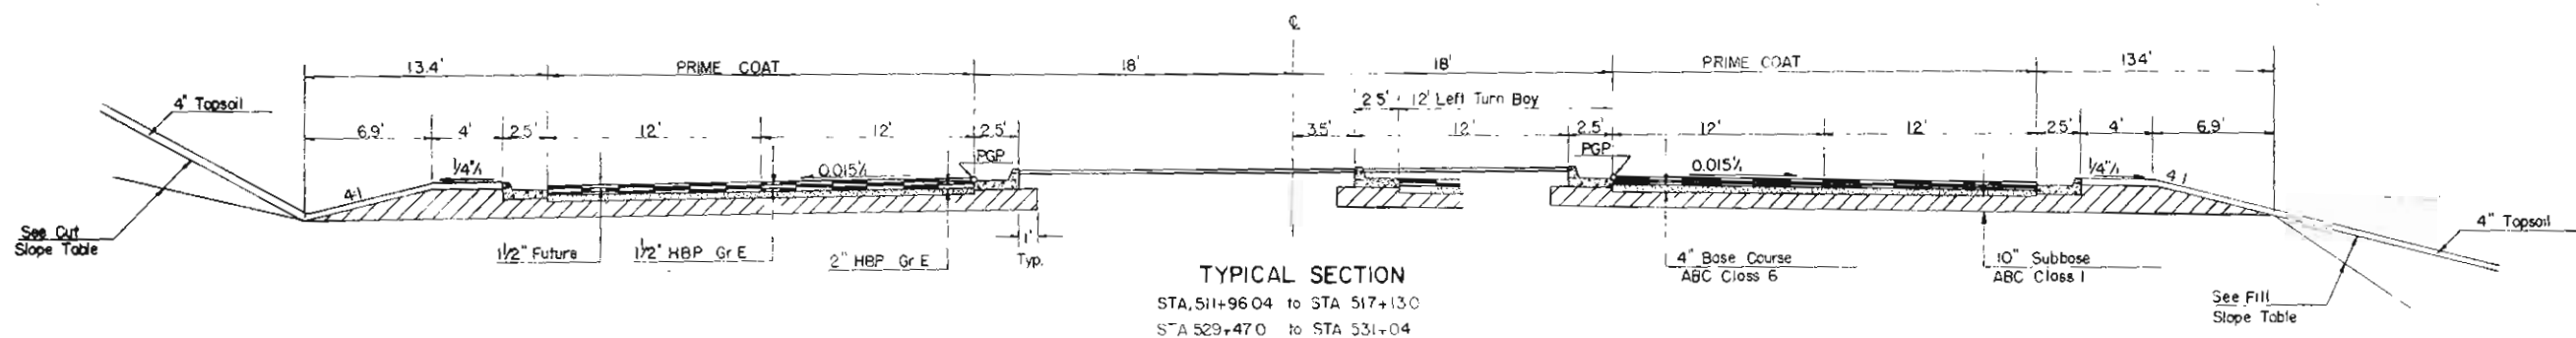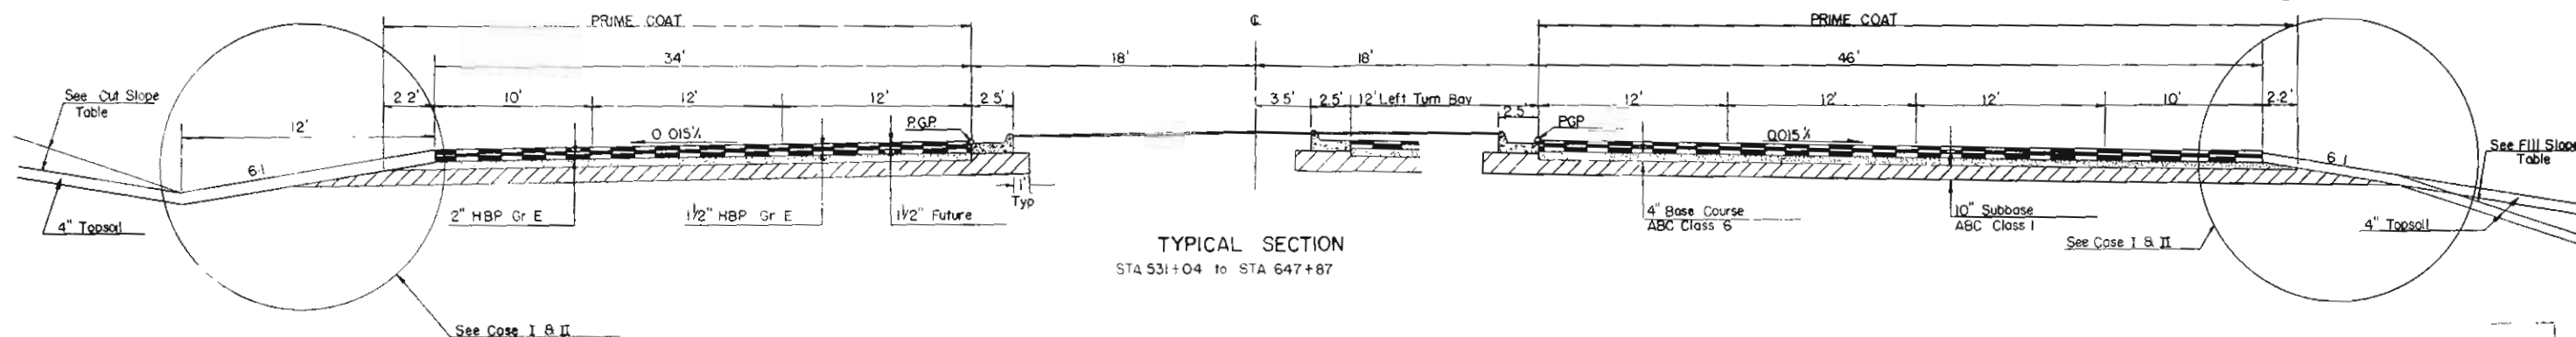


CASE I
Bottom of subbase above superlevation control line elevation

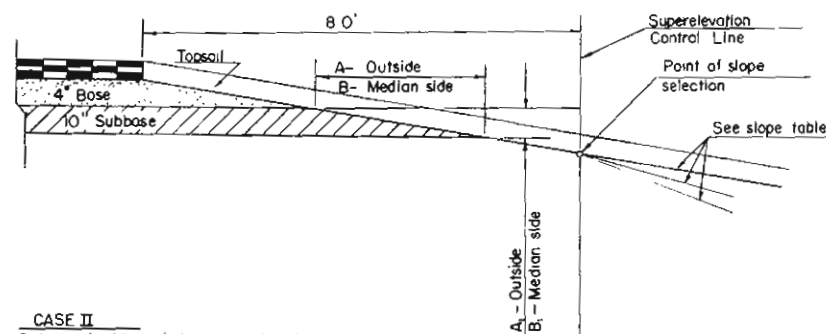


SLOPE TABLE			
CUT		FILL	
H	Slope *	H	Slope *
0-10'	6:1	0-10'	6:1
10'-30'	4:1	10'-25'	4:1
30'-	3:1	25'-	3:1

* Some special slopes required, see cross sections

CASE II
Bottom of subbase below superlevation control line elevation

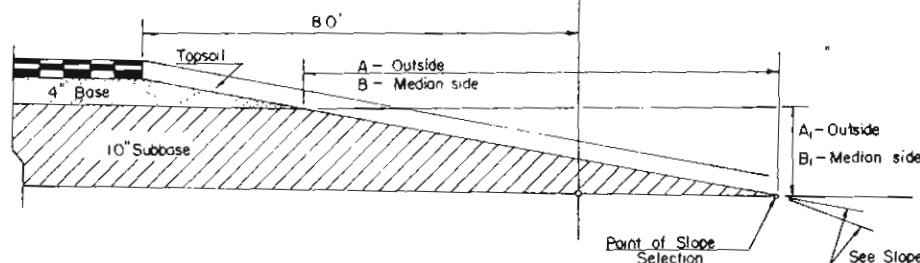


SLOPE DIMENSIONS				
T	A	A ₁	B	B ₁
10'	5.5'	0.92'	4.6'	0.76'

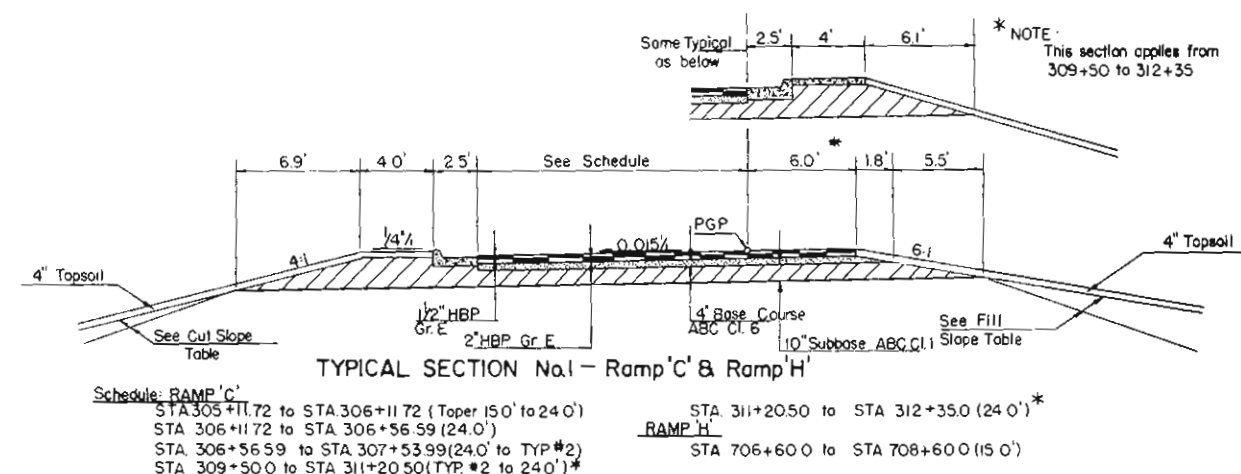

Schedule: RAMP 'C'
STA 305+11.72 to STA 306+11.72 (Taper 150' to 240')
STA 306+11.72 to STA 306+56.59 (240')
STA 306+56.59 to STA 307+53.99 (240' to TYP #2)
STA 309+50.0 to STA 311+20.50 (TYP #2 to 240')*

RAMP 'H'
STA 311+20.50 to STA 312+35.0 (240')*
STA 706+60.0 to STA 708+60.0 (150')

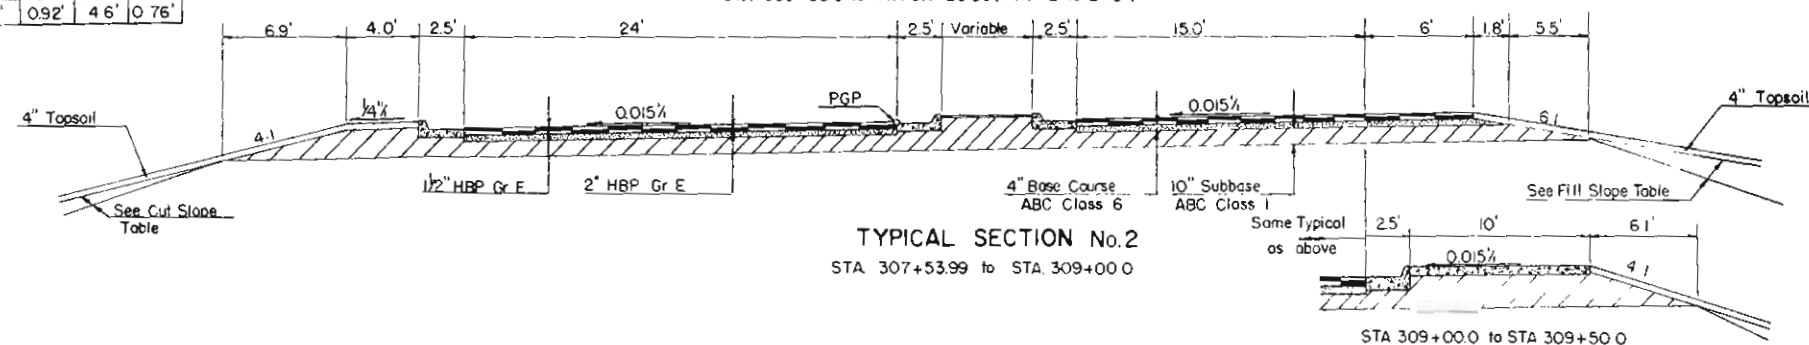









TYPICAL SECTIONS

R-1 10-21-71 PDL
CHG PROG NO

PROJECT NO.	SHEET NO.	PROJ. NAME	SHEET NO.	TOTAL SHEETS
10-21-71	121-1(7)	EHS-F 121-1(7)	4	

R-1

10-21-71
18-1-1964

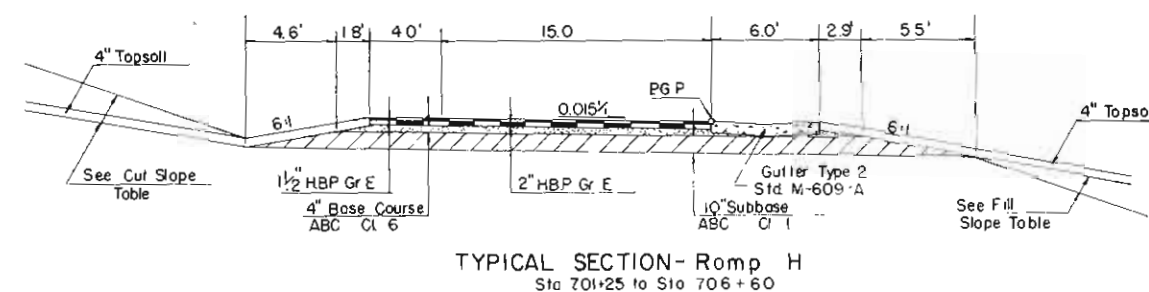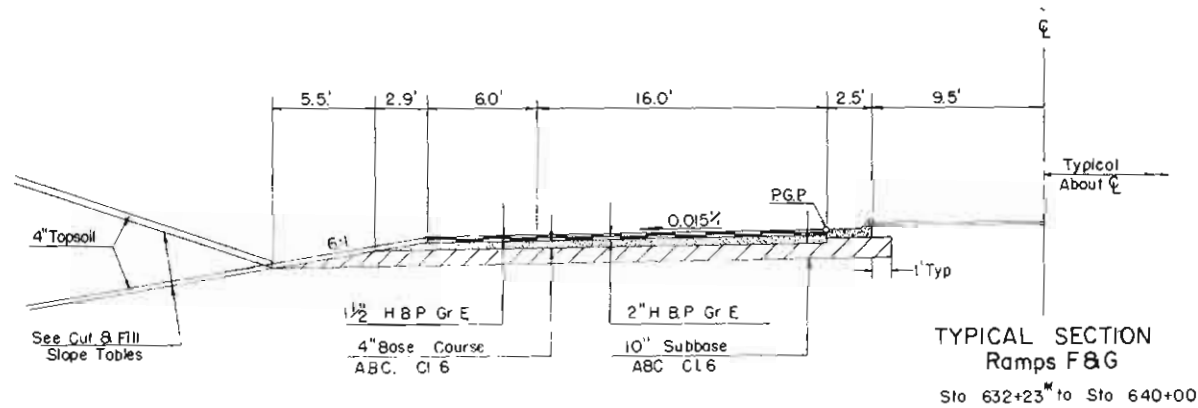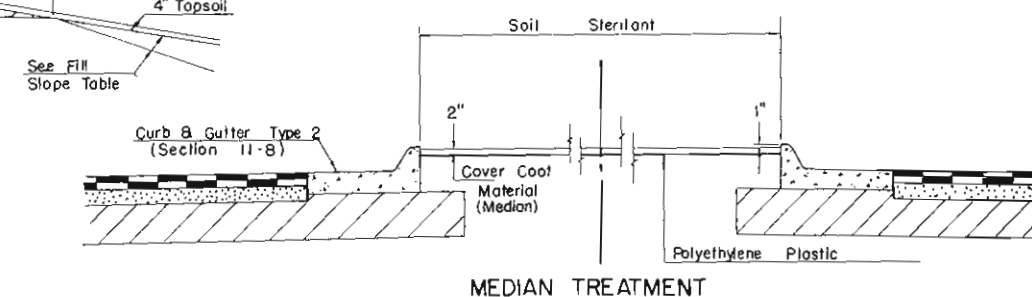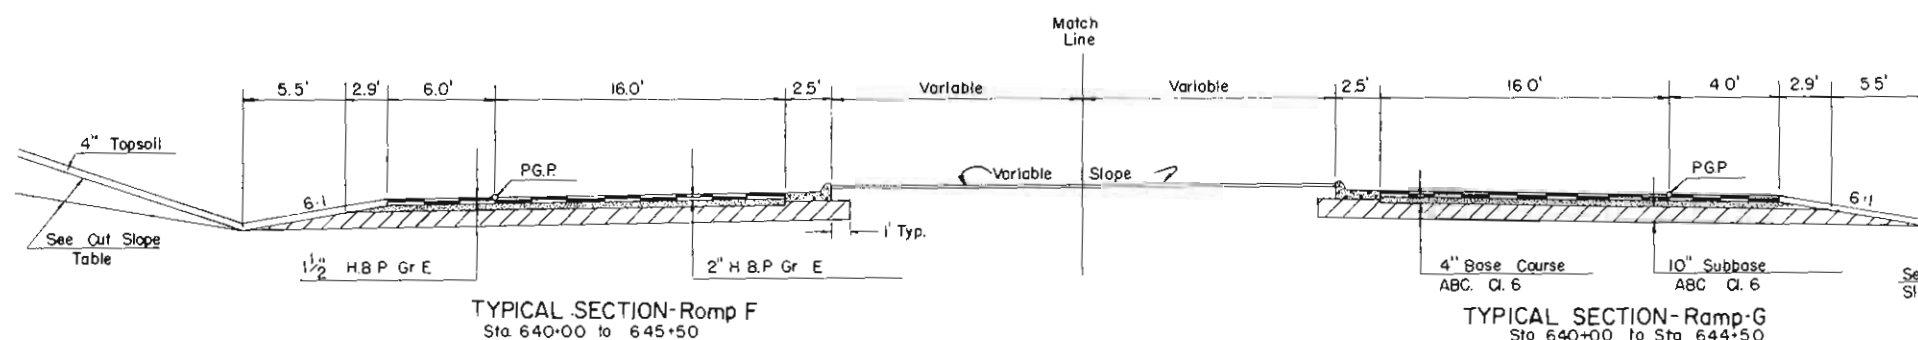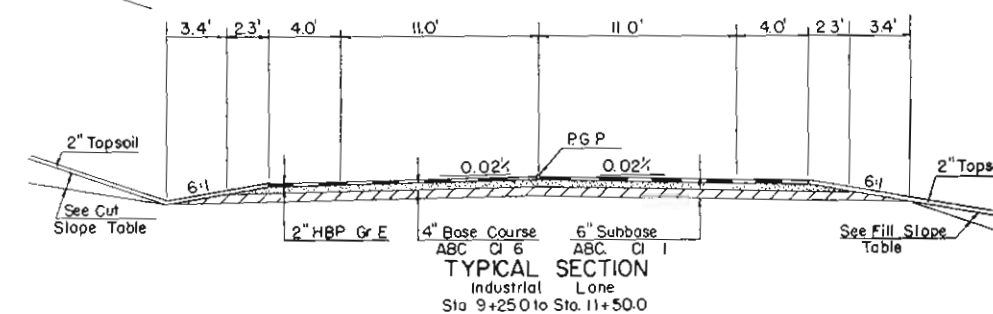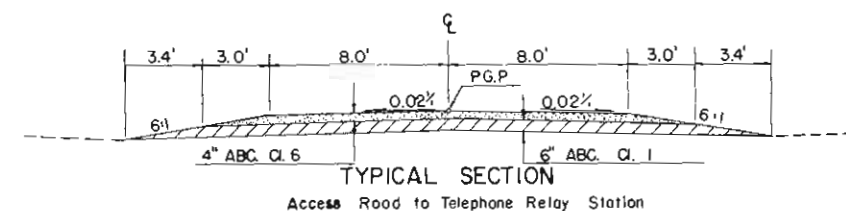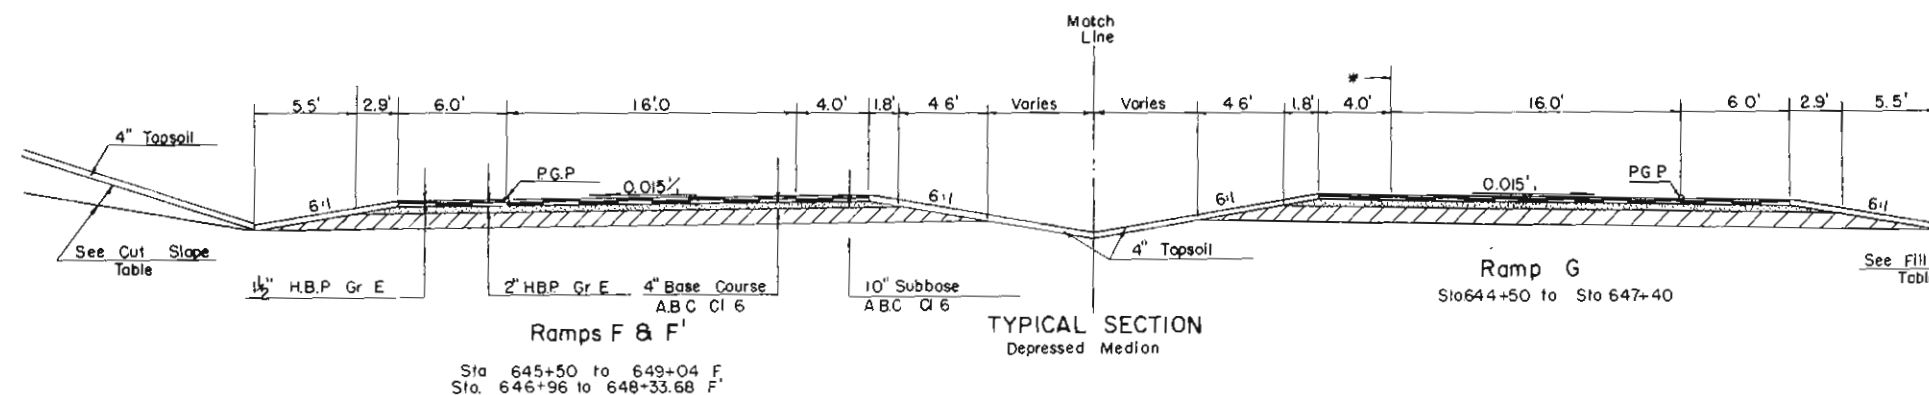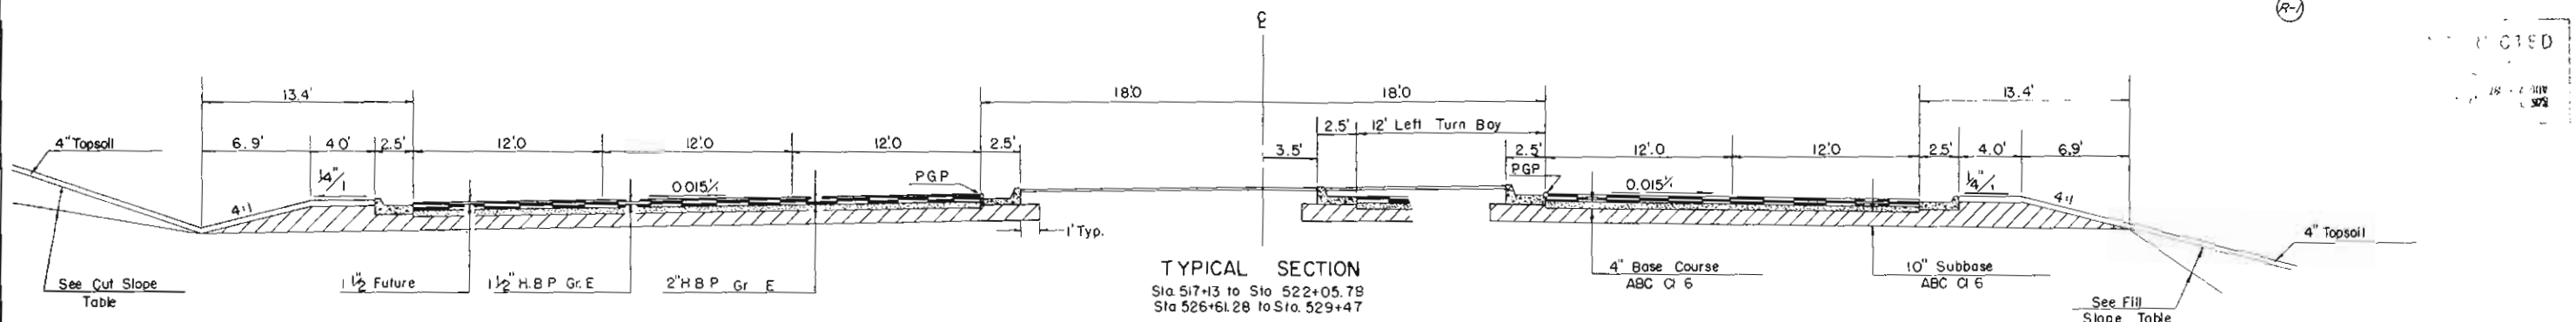

* From 632+23 to 634+23
Width Tapers from Var. to 16.0'

SUMMARY OF APPROXIMATE QUANTITIES

FINAL

AS CONSTRUCTED

(R-1) 10-21-71 PDL
CHG. PROJ. NO., QUANTITIES
(R-2) 11-10-71 PDL
QUANTS

PROJECT NO.	DIVISION	PROJ. NO.	SHEET NO.	TOTAL SHEETS
		EHS-F 121-1(7)	5	

ITEM No.	ITEM	UNIT	BOULDER COUNTY - Sta. 509+74.7 - 647+87.0										PROJECT TOTALS	INDEX		
			ROADWAY (FINAL)	ROADWAY	Str. No. E-16-FK	E-16-FK (FINAL)	Str. No. E-16-HR	E-16-HR (FINAL)	Str. No. E-16-HS	FINAL E-16-HS	Difference + or -	FINAL PROJECT TOTALS		BOOK	PAGE	SHEET
201	Clearing and Grubbing	Lump Sum		•							-1	•	•	1	7	
202	Removal of Structure	Each		32								3	3	1	8	
202	Removal of Curb and Gutter	Lin. Ft.		+800 1871							+71	1871	+800	1	9	
202	Removal of Concrete Pavement	Sq. Yd.		3070							+34	3104	3070	1	10	
202	Removal of Mat from Bridge	Sq. Yd.		3104	720 766						+46	766	720	1	11	
202	Removal of Bridge Railing	Lin. Ft.			229						0	229	229	1	12	
202	Removal of Fence	Lin. Ft.		640 1,639							+999	1,639	640	1	13	
203	Embankment Material (Haul and Compaction)	Cu. Yd.		253,911 253,811							15811 +15,811	253,811	253,811	1	14	
206	Structure Excavation	Cu. Yd.		759 888			355		326		+123	1,563	1,440	1	15	
206	Structure Backfill (Class 2)	Cu. Yd.		312 284			151		145		27 +27	608	580	1	16	
207	Topsoil (Haul)	Cu. Yd.		6,100 9199							+3067 3099	9162	6,100	1	17	
209	Wetting	M. Gal.		10,380 7080							-3300 -3,290	7080	10,380	1	18	
212	Seeding	Acre		12 18.21							+716.21	18.21	12	1	19	
213	Mulching	Acre		12 18.21							+716.21	18.21	12	1	20	
217	Soil Sterilization	Sq. Yd.		7650 7,750							+100	7,750	7,650	1	21	
304	Aggregate Base Course (Class 1) (Haul)	Ton		22,800 28,851.90							+16,051.90	28,851.90	22,800	1	22	
304	Aggregate Base Course (Class 6) (Haul)	Ton		6,200 7,850.0							+1,650 1860.7	7,850.0	6,200	1	23	
403	Hot Bituminous Pavement (Grading DX) (Haul and Asphalt)	Ton			60 131.80		114		163		+102.80	439.80	337	1	24	
403	Hot Bituminous Pavement (Grading E) (Haul and Asphalt)	Ton		5,863 6,986.05					208		+1123.15	6,986.05	5,863	1	25	
411	Emulsified Asphalt (SS-1H)	Gal.		400 4072							+3,672	4072	400	1	27	
411	Liquid Asphaltic Material (MC-70)	Gal.		12,000 5213							-6,805	5,195	12,000	1	28	
502	Reinforcing Tip (12 BP 53)	Each					52		66		-18	0	118	1	29	
502	Steel Piling (12 BP 53)	Lin. Ft.					1,228		1,574		+414	3,216	2,802	1	30	
502	Steel Piling Cut off - 30%	Lin. Ft.					142		142		+43	43.0	0	1	30	
507	Concrete Slope and Ditch Paving (Reinforced)	Cu. Yd.					245		235		-10	428.36	480	1	31	
508	Untreated Timber	L.S.					216		216		0	0	0	1	32	
509	Structural Steel	Lb					468,400		588,600		0	1,057,000	1,057,000	1	33	

SUMMARY OF APPROXIMATE QUANTITIES

FINAL

(R-1) 10-21-71 PDL
CHS PROJ NO., QUANTITIES
(R-2) 11-10-71 PDL
QUANTITIES

PROJECT No.	141-1 (12)	SHEET No.	6	TOTAL SHEETS	12
PROJECT No.	CHS-F 121-1 (7)	SHEET No.	6	TOTAL SHEETS	12

ITEM No	ITEM	UNIT	BOULDER COUNTY - Sta. 509 +74.7 - 647 +87.0										PROJECT TOTALS		INDEX		
			ROADWAY	Str. No. E-16-FK	Str. No. E-16-HR	Str. No. E-16-HS	Final E-16-HS	DIFFERENCE + DE-	Final Project Totals						BOOK	PAGE	SHEET
(R-2) (R-1) 509	Structural Steel (Galvanized)	Lb		7,800	35,900	36,000		0	79,700				79,700	/	34		
515	Waterproofing (Membrane) (WO ⁺ Q1582)	Sq. Yd.		-775	2,000	2,000		-2,775	2,000				4,775	/	35		
518	Bridge Expansion Device (Type 4)	Lin. Ft.			56	80		0	136				136	/	36		
519	Epoxy (New Tension Rod)	Gal.						-2	2					/	37		
601	Concrete Class A	Cu Yd.			352	406		-0.60	762.40				763	/	39		
601	Concrete Class D	Cu Yd.			386	524		0	910				910	/	40		
602	Reinforcing Steel	Lb			153,245	218,959		+22	372,322				372,300	/	41		
						218,981			372,234								
603	18Inch Corrugated Steel Pipe	Lin. Ft.						-72	237				309	/	42		
603	24Inch Corrugated Steel Pipe	Lin. Ft.						+140	940				800	/	43		
603	29 x 18Inch Corrugated Steel Pipe Arch	Lin. Ft.						+2	103				101	/	44		
603	18Inch Steel End Section	Each						0	2				2	/	45		
603	24Inch Steel End Section	Each						+3	5				2	/	46		
603	29 x 18Inch Steel End Section	Each						0	4				4	/	47		
604	Inlet Type C (5 Foot)	Each						0	2				2	/	48		
604	Inlet Type C (10Foot)	Each						+2	3				+	/	49		
604	Inlet Type 3 (5Foot)	Each						0	6				6	/	50		
604	Inlet Type 3 (10Foot)	Each						0	3				3	/	51		
604	Inlet Type 3 (15Foot)	Each						0	1				+	/	52		
604	Inlet Type 13 (10Foot)	Each						0	1				+	/	53		
606	End Anchorage Type 1	Each						-1	6				7	/	54		
606	End Anchorage Type 3	Each						0	3				3	/	55		
606	End Anchorage Type 4	Each						-3	7				10	/	56		
606	Guard Rail Type 3	Lin. Ft.						-245	5,130				5,375	/	57		
606	Guard Rail Type 3 (Double)	Lin. Ft.						-105	920				1,025	/	58		
607	End Post	Each						+6	7				+	/	59		
607	Corner and Line Brace Post	Each						+3	4				+	/	60		
607	Fence Combination Wire with Metal Posts	Lin. Ft.						2,253	2,753				500	2	7		
607	Fence Chain Link Special	Lin. Ft.						+4	688				684	2	8		
607	16Foot Gate Driveway (Double R.C. 1167978)	Each						-1	0				+	2	9		
608	Concrete Sidewalk	Sq. Yd.						136.68	393.32				530	2	10		
609	Curb and Gutter Type 2 (Section II-B)	Lin. Ft.						-110	10,921				10,811	2	11		

SUMMARY OF APPROXIMATE QUANTITIES

FINAL

(R-1) 10-21-71 PDL
CHG PROJ NO., QUANTITIES
(R-2) 11-10-71 PDL
QUANTITIES

PROJECT NO.	200	SHEET NO.	7	TOTAL SHEETS	10
PROJECT NAME	EHS-F 121-1 (T)				

BOULDER COUNTY - Sta. 509+74.7 - 647+87.0

ITEM No.	ITEM	UNIT	BOULDER COUNTY - Sta. 509+74.7 - 647+87.0										PROJECT TOTALS	INDEX		
				ROADWAY	Str.No. E-16-FK		Str.No. E-16-HR		Str.No. E-16-HS	FINAL EIGHTS	DIFFERENCE	FINAL PROJECT TOTALS		BOOK	PAGE	SHEET
609	Gutter Type 2 (6Foot)	Lin Ft.		1,570-2.036							1.466	2.036	1,570	2	12	
610	Medion Cover Material	Ton		760 968.75							1208.75	968.75	760	2	13	
612	Delineator (Type I)	Each		18							0	18	18	2	14	
612	Delineator (Type II)	Each		72							0	72	72	2	15	
612	Delineator (Type III)	Each		4							0	4	4	2	16	
613	1 1/2 Inch Electrical Conduit	Lin. Ft.					501.5 557.5		23		+56	580.5	524.5	2	17	
614	Flagging	Hour		5647 1,800	200						+3847	5,847	2,000	2	18	
620	Field Office Deleted W.D.#01485	Each		+ 0							-	0	1	2	19	
620	Field Laboratory	Each		+ 0 1							0	1	1	2	20	
620	Sanitary Facility	Each		1							0	1	1	2	21	
626	Mobilization	Lump Sum		•								•	•	2	22	
515	Waterproofing (Membrane) (W.D.#01482)	SYD			766							766		2	23	
515	Waterproofing (Membrane) (W.D.#01482)	SYD					1,400					1,400		2	24	
403	HSP (Gr.E) (H ASPH) (W.D.#05413)	TON									Pd. Field Quantity	3,191.35		1	25	
FORCE ACCOUNT																
Lighting (Work by Public Service Co. of Colo.) (W.D.#01481)			Lump Sum		•							•	•			
Railroad Flogging (Work by C. and S. R.R. Co. Forces) (W.D.#01485)			Lump Sum		•							•	•			
Install Railroad Crossing (Work by C. and S. R.R. Co. Forces)			Lump Sum		•							•	•			
Obliterating Old Road (W.D.#01484)			Lump Sum		•							•	•			
On-The-Job-Training (W.D.#01483)			Each		1							1	1			
STATE FORCES																
Furnishing and Installing Identification Sign			Each		2							2	2			
Furnishing and Installing R.R. Advance Warning Sign			Each		2							2	2			
NON-FEDERAL AID																
Signing (State Forces)			Lump Sum									•	•			
410	Slurry Seal Coat (Delete W.D.#01578)	Gal.									-300	0	800	1	26	
519	Mortar	Bbl.									-2	2	4	1	37	
519	Epoxy	Gal.									•	3	8	1	38	

LIST OF STRUCTURES

AS - 11-11-71 (R-1) 10-21-71 PDL
CHG. PROJ. NO.

FIGURE NO.	DIVISION	PROJECT NO.	SHEET NO.	TOTAL SHEETS
6	ROAD AND	ENS-F 121-1 (7)	8	

[illegible]

* EDES - ENERGY DISSIPATOR END SECTION

SURFACING MATERIALS PLAN

AS CONSTRUCTED
WITH REVISIONS
Date Completed 11-1-87

10-21-71 PDL
CHG. PROJ. NO.

FED. ROAD REGION NO.	STATE	PROJECT NO.	SHEET NO.	TOTAL SHEETS
9	COLO.	ENS-7 121-1 (7)	9	

COUNTY	STATION TO STATION	LENGTH	'T'	AGGREGATE BASE COURSE				HOT BITUMINOUS PAVEMENT (GRADING E)				LIQUID ASPHALTIC MATERIAL		MEDIAN COVER MATERIAL	SOIL STERIL- IZATION	CURB & GUTTER TYPE 2 (SECTION IIB)	GUTTER TYPE 2	CONCRETE SIDEWALK
				CLASS 1		CLASS 6		BOTTOM LAYER 2"		TOP LAYER 1 1/2"		(MC-70)	EMUL. ASPH. (SS-1H)					
				STATIONS	INCHES	TONS / STA	TONS	TONS / STA	TONS	TONS / STA	TONS	GALLON	GALLON	TONS	SQ YD	LIN. FT.	LIN. FT.	SQ. YD.
BOULDER	511+96.04 - 517+13	5.1696	10			500	2,585	106	548	58.7	304	44.0	228	1,103		117.52	1,178	
	Intersections, Returns, Turn Bay, Etc.						341		137		76		57	277		4.9	40	
	517+13 - 522+06	4.93	10			566	2,791	132	651	73.4	362	55.0	271	1,315		168.217	1,698	
	526+61 - 529+47	2.86	10			566	1,619	132	578	73.4	210	55.0	158	763		71.81	720	
	529+47 - 531+04	1.57	10			500	785	106	167	58.7	92	44.0	69	335		33.35	332	
	Intersections, Returns, Turn Bay, Etc.						337		135		75		57	273				
	531+04 - 533+61.33 = 645+10.80	2.5733	10			594	1,529	181	466	97.8	252	73.4	189	965		54.57	542	123.93
	645+10.80 - 647+63	2.522	10			594	1,498	181	457	97.8	247	73.4	185	946	145	53.56	532	180
	Turn Bay		10				225		90		50		38	182				
	'C' Ramp																	
	305+12 - 306+12	1.00	10			261	261	58	58	31.2	32	23.4	24	121				
	306+12 - 306+57	0.45	10			286	29	68	31	36.7	17	27.5	13	64				
	306+57 - 307+54	0.97	10				362		82		45		34	166		1.2	8	
	307+54 - 309+00	1.46	10			459	671	101	148	55.0	81	41.3	61	304		8.9	81	122.11
	309+00 - 309+50	0.50	10			557	279	86	43	47.7	24	35.8	18	87		3	28	135
	309+50 - 311+20	1.70	10				745		119		66		50	240		2	16	22.88
	311+20 - 312+39	1.19	10			319	380	53	63	29.3	35	22.0	27	127		1.43	1,383	215
	'D' Ramp																	
	400+45 - 401+04	0.59	10				466		142		79		60	287				
	'F' & 'G' Ramps																	
	632+00 - 634+04 (Incl. Turn Bay)	2.04	10								156		117		21.27	215		
	634+04 - 640+00	5.96	10			348	2,075	104	620	53.8	321	40.4	241	1,320		125.202	1,258	1590
	'F' Ramp																	
	640+00 - 645+50	5.50	10			174	957	52	286	26.9	148	20.2	112	610		54.64	550	
	645+50 - 648+70	3.20	10			197	631	63	202	31.8	102	23.8	77	355				
	646+96 - 648+24 'F'	1.28	10			197	253	63	81	31.8	41	23.8	31	142				
	Taper		10				91		37		21		16	75				
	'G' Ramp																	
	640+00 - 644+50	4.50	10			174	783	52	234	26.9	121	20.2	91	498		45.53	450	
	644+50 - 647+00	2.50	10			197	493	63	158	31.8	80	23.8	60	277				
	Taper		10				62		26		14		11	53				
	'H' Ramp																	
	701+25 - 706+60	5.35	10			197	1,054	44	236	23.2	125	17.4	93	495				
	706+60 - 708+60	2.00	10			236	472	48	96	25.7	52	19.3	39	203		102	186	706.1166
	Taper		10				86		35		19		15	70				
	Industrial Lane																	
	9+25 - 11+50	2.25	6			126	284	71	160	36.7	83			346				
	From List of Structures						480		240									
	18+95 Industrial Lane - 0+00 Alter St								40				30					
	PROJECT TOTAL					22,724		6,166		3,330		2,472		11,999	317	759	7,648	530
						28,851.90		7,850		6,986.15		5,195	3,959	968.75	7,750	10,921	2,036	393.11

NOTE: The estimated quantities are based on the following materials and rates of application.
Actual materials and rates of application shall be as directed by the Engineer.
Aggregate Base Course (Cl. 1B 6) - 132 lbs./ft.³
Hot Bituminous Pavement Grade E - 146 lbs./ft.³
Liquid Asphaltic Material Prime - 0.40 gal./S.Y. 0.25
Tack - 0.10 gal./S.Y.

NOTE: Asphaltic Surface Design Bases
Asphaltic Cement Content 5.8%
Hot Bituminous Pavement R₁ = 95
Aggregate Base Course R₁ = 78-83
S₁ = 2.5 RF = 1.0
R = 22 18" EDLA = 122
Embankments - Upper 2.0' R = 25+
Below 2.0' R = 13+

SEEDING

COMMON NAME	BOTANICAL NAME	Percent Purity	Percent Germ	Rate PLS. Acre
Total Acres <u>12.191</u>				
Blue Gamma	Bouteloua Curtpendula	35	60	2 lbs
Western Wheatgrass	Agropy Smithii	85	75	5 lbs
Perennial Ryegrass	Lolium Perenne	90	85	3 lbs
Yellow Sweet Clover	Melilotus Officinalis	98	85	2 lbs

TABULATION OF DELINEATORS

STATION TO STATION	SIDE	SPACING	DELINEATORS		
			Type I Each	Type II Each	Type III Each
516+00 to 522+00	Rt - Lt				2*
527+60 to 647+87	Rt - Lt			6	2
Ramp 'C'	Rt - Lt			8	
Ramp 'D'	Rt	3			
Ramp 'F'		1		33	
Ramp 'G'				8	
Ramp 'F-G'		12		6	
Ramp 'H'		1		11	
Ramp 'F'		1			
PROJECT TOTALS			18	72	4

* Type III Delineators are to be placed on both sides of roadway approaching bridge abutments. For spacing and approx location see Sheets 39 & 40

TABULATION OF FENCING QUANTITIES

STATION TO STATION	SIDE	REMOVE FENCE		BUILD COMB	FENCE WIRE	LINE BRACE & CORNER POST	LINE POST
		Lin. Ft		Lin. Ft		Each	Each
518+00 - 518+50 (Service Road)	Lt	230	1,543	595	2	1	
518+50 - 521+50	Rt	410	1,543	595			
518+00 - 522+00	Lt			415		+	30
400 and Ramp D	Lt			881	1	1	
500 + 522	Lt			584	2	1	
Ramp C 501-507	Lt			658	End Post	1	
PROJECT TOTAL		640	1,639	415	+	+	*30

2,753

7

* For Information Only

TABULATION OF PAVEMENT MARKING		
PAINT QUANTITIES		
LOCATION	GAL. of Paint	LBS. of BEADS
Mainline & Ramps	46	184

TABULATIONS

TABULATION OF CURB & GUTTER REMOVALS

STATION TO STATION	SIDE & DISTANCE	QUANTITY (LIN. FT.)
633 75 RAMP 'F' & 'G'	Q	
636 04 "	57' RT.	500'
635 90 'F' & 'G'	10' RT.	
636 20 "	10' LT.	120'
524 87 SH 121	50' RT.	
526 40 "	33' RT.	450'
525 97 SH 121	100' RT.	80'
529 30 "	20' RT.	730'
PROJECT TOTALS		1,800' / 1,871'

TABULATION OF GUARD RAIL

STATION TO STATION	SIDE	Type 3		Type 3 (Double)		End Anchors		
		Lin. Ft	Feet	Lin. Ft	Feet	TYPE		
Mainline						I	II	III
511+68 - 516+05	Lt	437.5	452.5					
511+87 - 513+00	Med	412.5						I
512+00 - 513+00	Med	400.0	280.0	226.0				
513+00 - 515+63	Med			262.5	226.0			I
512+20 - 516+07	Rt	387.5	388.0					
518+07 - 522+07	Lt	400.0	559.0	362.0				
516+65 - 521+03	Med			437.5	369.0			I
521+03 - 522+03	Med	400.0	287.0					
521+03 - 522+15	Med	412.5						
518+13 - 522+00	Rt	387.5	525.0					
526+80 - 529+44 (647+40 'G')	Lt	262.5	263.0					I
526+42 - 529+55	Rt	312.5	312.5					I
526+35 - 527+85	Med	450.0						
526+72 - 527+85	Med	412.5	236.0					
527+85 - 531+10	Med			325.0	325.0			I
Ramps								
307+00 - 312+40 Ramp 'C'	Rt	550.0	312.5					2
309+70 - 312+20 Ramp 'C'	Lt	250.0						+
399+38 - 401+00 Ramp 'D'	Rt	462.5						+
400+60 - 401+60 Ramp 'D'	Lt	62.5						I
636+07.5 - 638+45 Ramp 'F-G'	Med	237.5	237.5					I
636+25 - 638+62.5 Ramp 'F-G'	Med	237.5	237.5					I
640+00 - 645+00 Ramp 'G'	Lt	550.0	552.0					I
704+50 - 709+00 Ramp 'H'	Rt	450.0	450.0					I
403+25 - 403+60 Ramp 'H'	Rt		37.0					
PROJECT TOTALS		5,375.0	5,130.0	1,025.0	920.0	7	3	10

5,130.0


920.0

6


7

SUMMARY OF EARTHWORK


DESCRIPTION	BOULDER COUNTY
EMBANKMENT MATERIAL (Haul & Compaction):	
From Cross Sections	237,511
From List of Structures as Embankment	237,511
TOTAL	253,971 253,811
SOURCES FOR EMBANKMENT (Info. only):	
From Cross Sections as Excavations	21,131
From List of Structures as Ditch Excavation	18
From List of Structures as Unclassified Excavation	10,600
From Re-grading	247,676
From Borrow (Undesignated)	279,425
TOTAL	
COMPACTION (for Info. only)	
Embankment (From cross sections)	237,511
Bases of Cuts & Fills	11,034
From List of Structures as Embankment	
TOTAL	248,545
	253,971 253,811

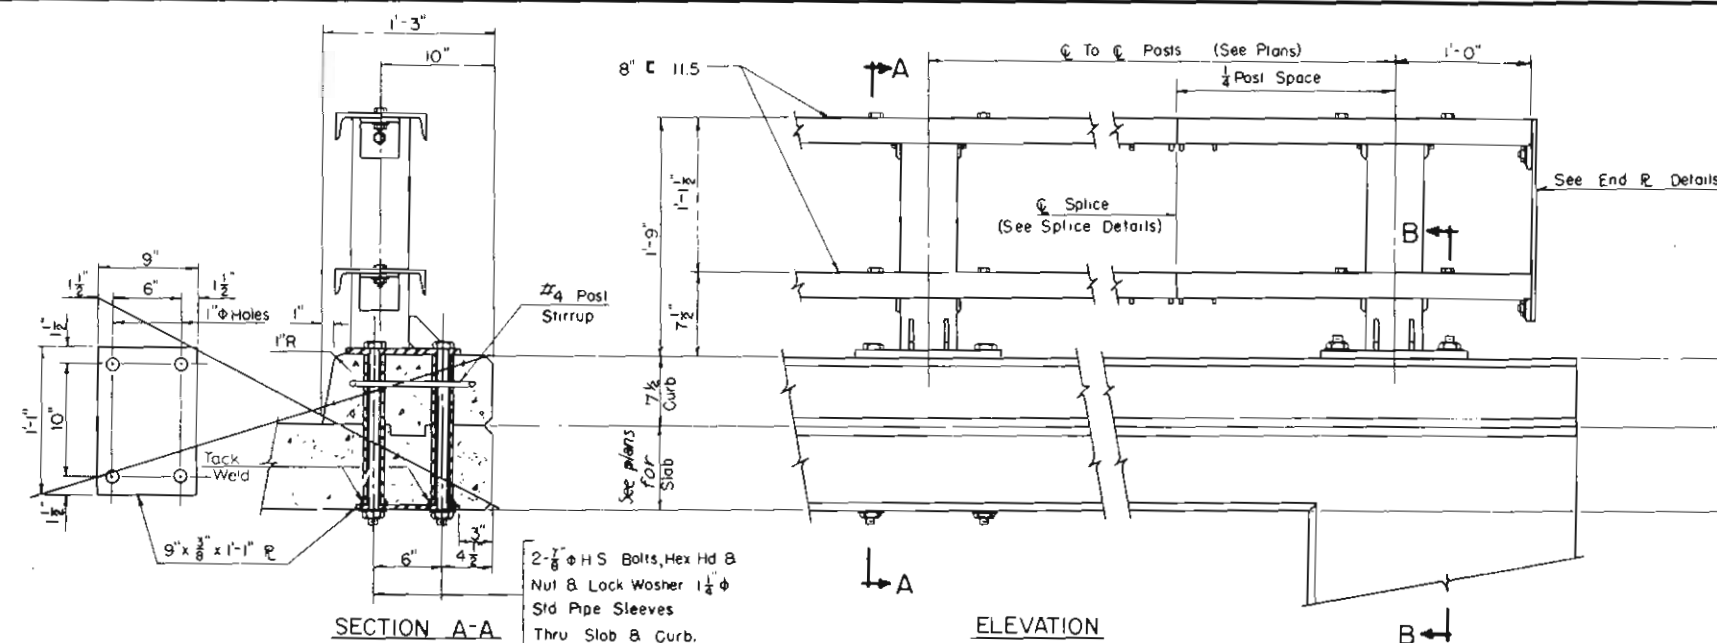

THRU SLAB MOUNTED POST
No. Rec'd. Q

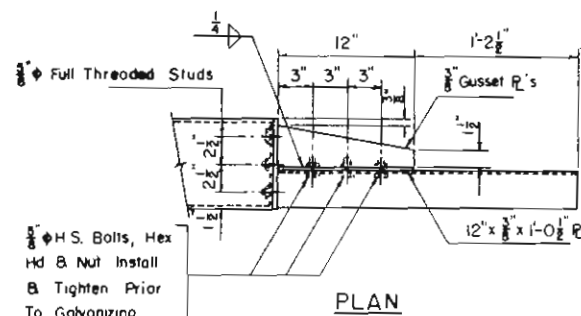

PLAN

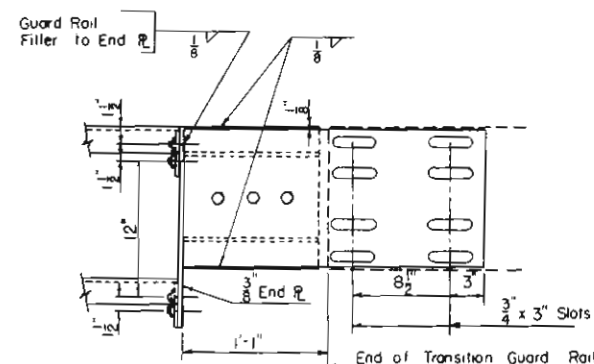

ELEVATION END VIEW
DETAIL OF END CONNECTION FOR FASTENING BRIDGE RAIL
TO TRANSITION GUARD RAIL

Complete Unit Shall Be Galvanized After Fabrication


Detail Shown is For Right Hand Rail.

Opposite Hand For Left Hand Rail


No. Req'd 1

No Req'd 1


{ North side only

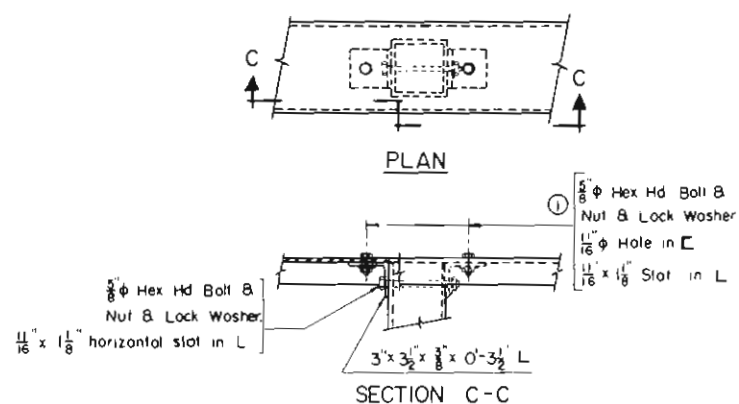

DETAIL AT TOP RAIL

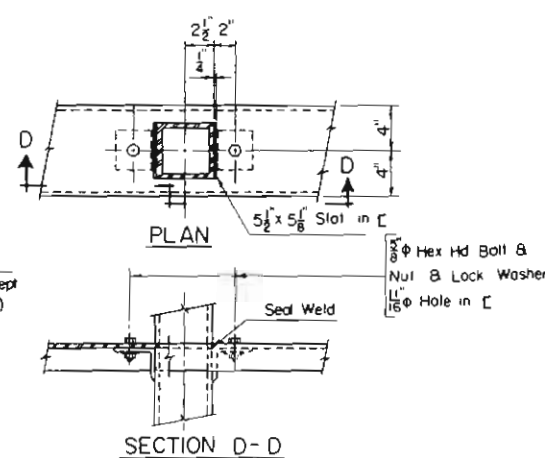


DETAIL AT BOTTOM RAIL

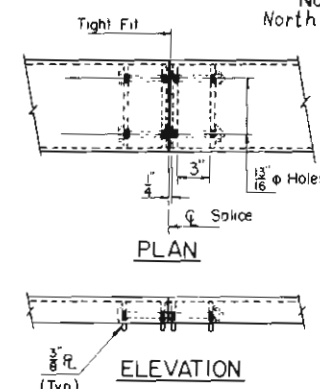

END VIEW

SPLICE DETAIL

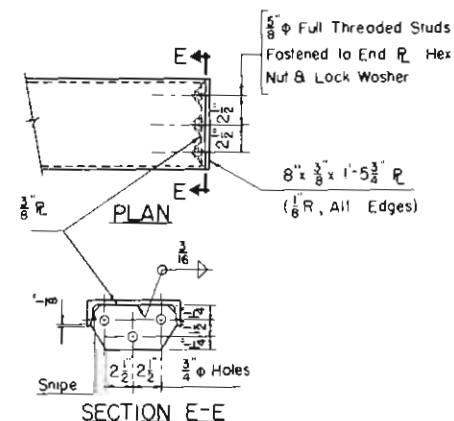


END PLATE DETAIL
No. Req'd 0


See sheet no. 12 for details of
mount.
See section A-A for detail of
post.

END ANCHORED POST

No. Req'd. 3
North side only.

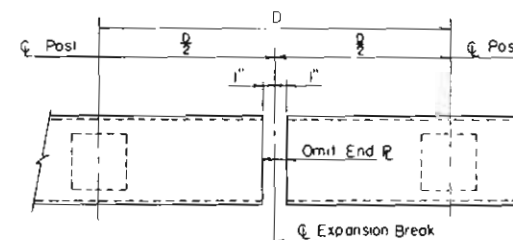

DETAIL AT EXPANSION BREAK

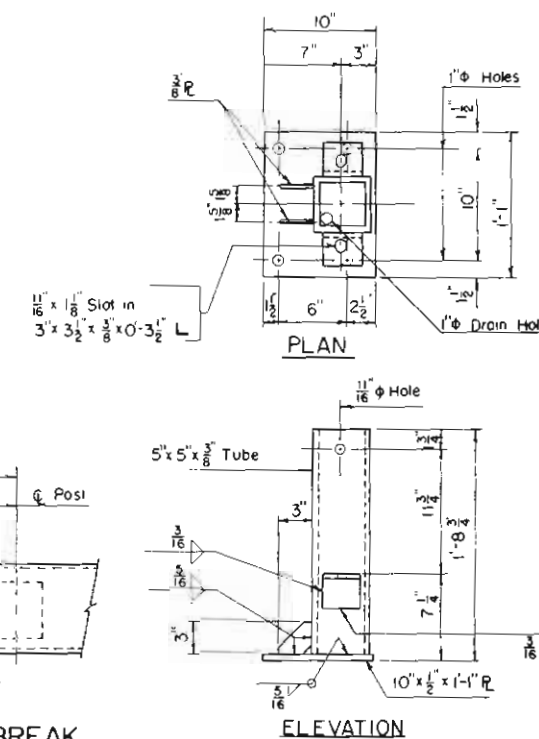

POST DETAIL

NOTES:
POSTS SHALL BE PERPENDICULAR TO GRADE AND SLOPE OF THE
DECK

ALL RAIL ELEMENTS, ANCHOR ASSEMBLIES, ANCHOR BOLTS, NUTS AND WASHERS SHALL BE GALVANIZED AFTER FABRICATION IN ACCORDANCE WITH THE SPECIFICATIONS.

A 1 S 1 114 STEEL RODS MAY BE USED IN LIEU OF 4 S.
BOLTS SHOWN 10° WEDGE TEST NOT REQ FOR EITHER BOLTS
OR RODS USED IN RAIL ASSEMBLY.

① 5/16" Ø STANDARD FULL THREADED STUDS WELDED TO THE CHANNEL MAY BE USED. INCREASE SIZE OF SLOT IN THE ANGLE TO $\frac{13}{16}$ " X $1\frac{1}{2}$ "
CHANNELS SHALL BE CONTINUOUS OVER 3 OR 4 POSTS BEFORE SPLICING

WHEN THRU SLAB MOUNTED POSTS ARE USED, PRIOR TO
SETTING THE POSTS AND TIGHTENING THE NUTS A PERIMETER
BEAD OF CAULKING GRADE, POLYURETHANE JOINT SEALER, SHAL
BE PLACED ON THE CONCRETE 1" INSIDE THE EDGES OF THE
POST BASE PLATE

DIVISION OF HIGHWAYS

DETAILS OF GALVANIZED STEEL BRIDGE RAIL

Accepted

Designer B S M H

Detailed: M. McMurle

Bridge Engineer


Numbers	
---------	--

DWG No. B OF

FEDERAL ROAD REGION No.	DIVISION	PROJECT No.	SHEET No.
9	COLORADO	EHS-F 121-1(7)	12

AS CONSTRUCTED
WITH REVISIONS
Date Completed 11-10-71


All details above this point as per Std Rail Sheet No 11
32 Posts req'd North curb only.

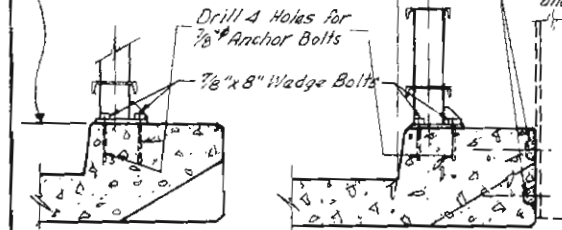

SECTION BB


SECTION AA

Remove exist Railing
Chip back conc around existing anchor bolts below surface of conc. and grout over

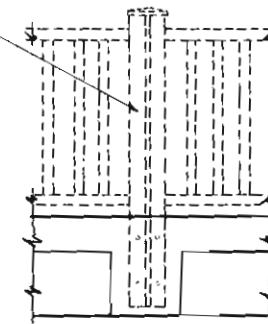

EXISTING RAIL

SECTIONS AT RAIL

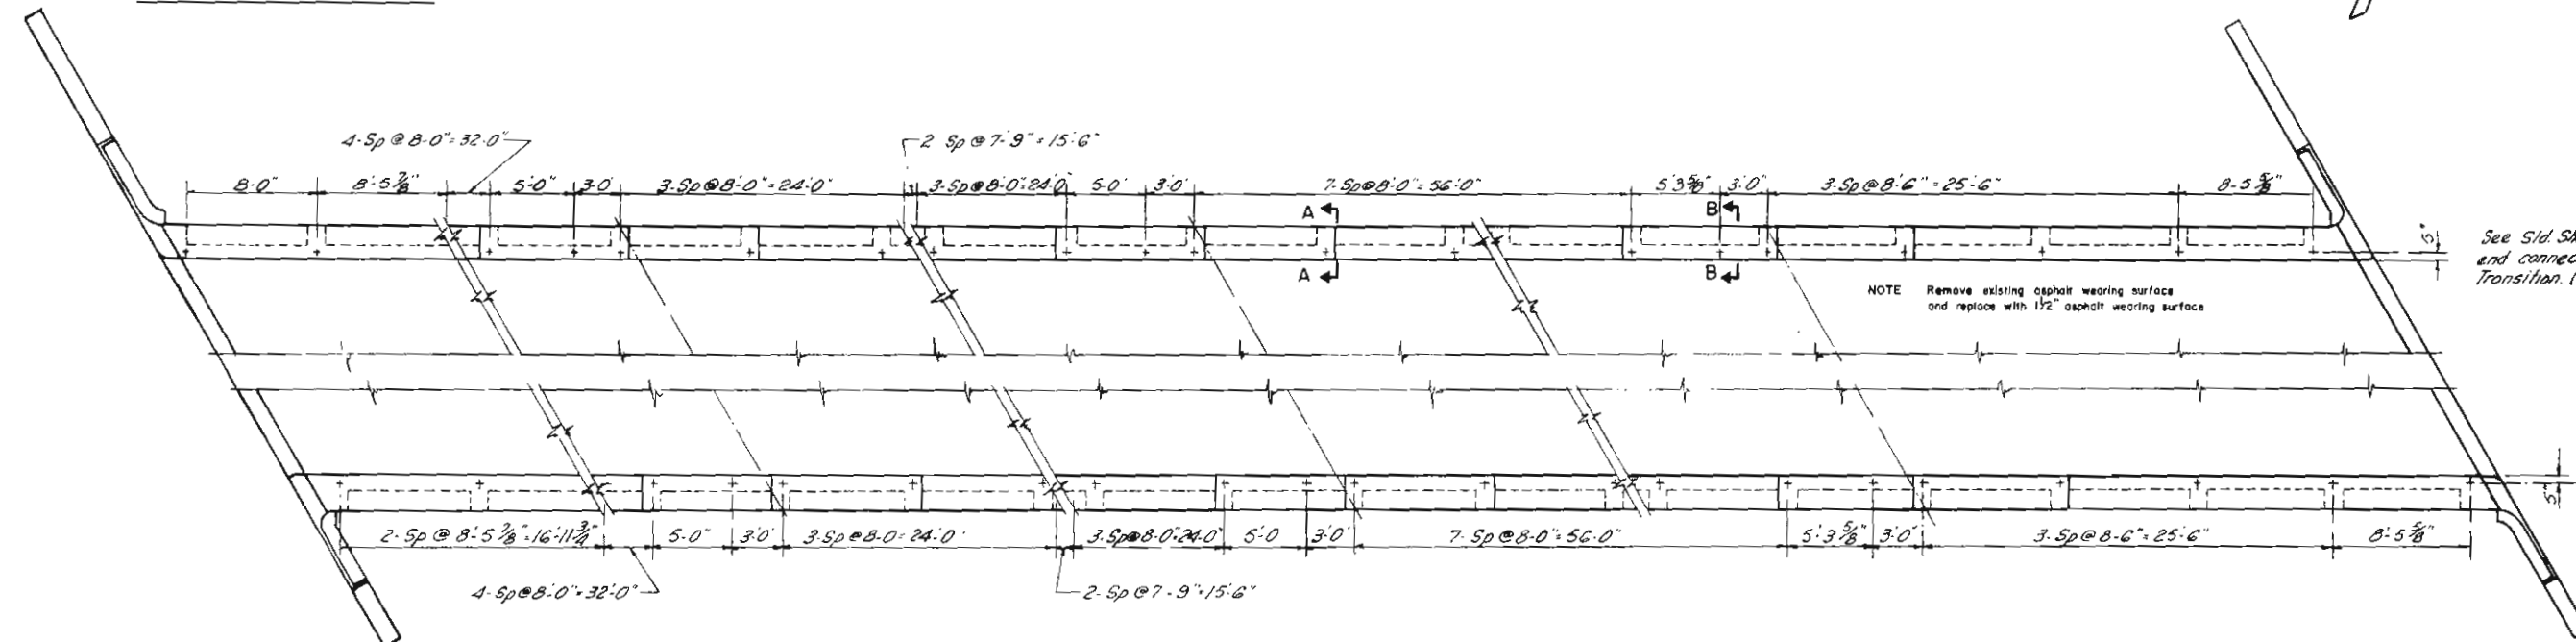

RAIL POST SPACING FOR EXISTING STRUCTURE

NOTE Remove existing asphalt wearing surface and replace with 1 1/2" asphalt wearing surface

See Std Sheet 11 for Detail of end connection to Guard Rail Transition. (Both ends of bridge.)

Notes: Drilling and grouting holes for bridge rail bolts to be included in the bid price for Item 509 Structural Steel (Galvanized)
Externally threaded wedge expansion bolts to be installed in accordance with the manufacturer's recommendations. Drill hole tolerance -0% -10% of nominal bolt diameter.

Str. No. E-16-FK			
APPROXIMATE QUANTITIES			
ITEM	DESCRIPTION	UNIT	QUANTITY
(R-2) 515	Waterproofing (Membrane)	Sq. Yd.	775.0
202	Removal of Bridge Railing	Lin. Ft.	228.25
202	Removal of Mat from Bridge	Sq. Yd.	720
(R-1) 403	Hot Bituminous Pavement (Gr DX) (H & A)	Ton	60
509	Structural Steel (Galvanized)	Lbs	7800
(R-1) 10	Slurry Seal Coat	Gal.	800
(R-2) 519	Mortar	Bbl.	4
(R-1) 519	Epoxy	Gal.	8

(R-1) NON-FEDERAL AID

(R-2)

COLORADO
DEPARTMENT OF HIGHWAYS
EXISTING STRUCTURE MODIFICATIONS

Across U.S. 36
Sta. 509+74.67 to 512+06.25
Near Broomfield Sec 34 T. 15 R. 69W

Designed by BSMH
Made by P.S.
Checked by A.L.

Approved by Bridge Engineer
Date 11-10-71

STRUCTURE NO E-16-FK

Added clearance note GLB
Additional Quantities GLB
10-21-71 P.D.L.
CHG PROJ. NO. ADDED NOTE

FEDERAL ROAD DISTRICT NO.	DIVISION	PROJECT NO.	SHEET NO.
9	COLORADO	EHS-F 121-1(7)	13
11-10-71	Revised quantities		M.L.M.

GENERAL NOTES

ALL WORK SHALL BE DONE ACCORDING TO THE STANDARD SPECIFICATIONS OF THE COLORADO DEPARTMENT OF HIGHWAYS APPLICABLE TO THE PROJECT.
EXPANSION JOINT MATERIAL SHALL CONFORM TO AASHTO M-213, UNLESS OTHERWISE NOTED.
ALL REINFORCING STEEL SHALL BE DEFORMED BILLET STEEL, GRADE 40 (ASTM A615). EACH BAR SHALL BE TAGGED WITH THE BAR DESIGNATION, STRUCTURE NUMBER, AND STATION NUMBER OF THE PROJECT.
IF, BY PERMISSION OF THE ENGINEER, PRIMARY BARS ARE SPICED, THEY SHALL LAP A MINIMUM OF 40 DIAMETERS FOR BARS NEAR TOPS OF BEAMS HAVING MORE THAN 12 INCHES OF CONCRETE UNDER THE BARS, AND 24 DIAMETERS FOR BARS NEAR BOTTOM MEMBERS. SECONDARY BARS WHEN SPICED SHALL LAP 24 DIAMETERS OF THE BAR.
DIMENSIONS FOR REINFORCING STEEL NOT SHOWN AS CLEAR SHALL BE TO THE CENTERLINE OF THE BAR.
SOUNDINGS AND DEPTH OF FOOTINGS ARE IN ACCORDANCE WITH THE BEST AVAILABLE DATA AND WHEN DIFFERENT CONDITIONS ARE ENCOUNTERED THE BRIDGE ENGINEER WILL INSPECT AND DETERMINE IF REDESIGN IS NECESSARY.
WHEN EXCAVATING FOR FOOTINGS THE FINAL 6 INCHES IN DEPTH SHALL BE DONE BY HAND LABOR METHODS. FOR DETAILS OF STRUCTURAL EXCAVATION AND STRUCTURE BACKFILL, SEE STANDARD M-206-A.
CONCRETE SURFACES MARKED WITH THE SYMBOL ∇ AS SHOWN SHALL RECEIVE CLASS 2 SURFACE FINISH.

ALL STRUCTURAL STEEL SHALL BE PAINTED IN ACCORDANCE WITH ITEM 509 FOR GREEN PAINT
ALL BOLTS SHALL BE 7/8" H.S. UNLESS OTHERWISE NOTED.
ALL CONCRETE CHAMFERS TO BE 3/4" UNLESS OTHERWISE NOTED.
BOLTS SHALL BE FURNISHED IN THE AMOUNT OF TWO PERCENT IN EXCESS OF THE NOMINAL NUMBER REQUIRED FOR EACH SIZE AND LENGTH.
WELDING SHALL CONFORM TO THE LATEST EDITION OF THE A.W.S. STANDARD SPECIFICATIONS FOR WELDING HIGHWAY BRIDGES, AS AMENDED.

FOR WELDED GIRDERS, ALL SHOP BUTT WELDS IN FLANGES AND WEBS SHALL BE MADE BEFORE WELDING INTO GIRDERS.
SHOP BOLTS SHALL BE INSPECTED RADIOGRAPHICALLY OR BY THE PENETRANT DYE METHOD.
ALL STRUCTURAL STEEL NOT OTHERWISE NOTED SHALL BE A 58 KSI H.S.
NO WELDING OF ANY KIND SHALL BE PERMITTED ON THE FLANGES OF STEEL GIRDERS UNLESS SPECIFICALLY CALLED FOR ON THE PLANS.

LOADING DATA

LIVE LOAD A 4 S.H.O. HS 20-44 OR INTER. ALT.
DEAD LOAD ASSUMES 20 LBS. PER SQ. FT. AND NO PROVISION HAS BEEN MADE FOR ADDITIONAL OVERLAYS.

DESIGNING DATA

A.A.S.H.O. 1969 UNIT STRESSES.
F_c = 1,200 LBS. PER SQ. IN. (10)
F_s = 20,000 LBS. PER SQ. IN. (A36)

SUMMARY OF QUANTITIES

ITEM	DESCRIPTION	UNIT	SOUTH BOUND STRUCTURE					TOTAL	NORTH BOUND STRUCTURE					TOTAL
			SUPER STR.	ABUT. 1	PIER 2	PIER 3	PIER 4		SUPER STR.	ABUT. 1	PIER 2	PIER 3	PIER 4	
206	STRUCTURE EXCAVATION	CU. YD.		72	64	59	64	326		65	85	55	85	355
207	STRUCTURE BACKFILL (CLASS 2)	CU. YD.		23	33	33	33	145		16	43	33	43	151
403	HOT BITUMINOUS PAVEMENT (GRAD. DX) (H.B.A.)	TON	163	218.3	358.0	398.0	470.0	2,793	163	218.3	358.0	398.0	470.0	2,793
502	STEEL PILING (H-20PS31) (10' x 10' x 1/2" PLATE)	LIN. FT.		255	340	340	480	1,775		255	340	340	480	1,775
502	Reinforcing Tip (D.C. 10' x 10' x 1/2" PLATE)	EA.		5	20	16	20	5		5	20	16	20	5
507	CONC. SLOPE / DITCH PAVING (REINF.)	CU. YD.		100.8	128			228.8		100.8	128			228.8
509	STRUCTURAL STEEL	LBS.	588608					588608	458400					458400
509	STRUCTURAL STEEL (ALUMINUM)	LBS.	36000					36000	35900					35900
515	Waterproofing (Membrane)	SQ. YD.	2000					2000	2000					2000
515	BRIDGE EXPANSION DEVICE (TYPE 4)	LIN. FT.	80					80	56					56
515	CONCRETE CLASS "A"	CU. YD.		33	113	112	115	406		25	106	89	107	352
515	CONCRETE CLASS "B"	CU. YD.		524				524		386				386
502	REINFORCING STEEL	LBS.	161453	2248	18621	15998	18391	1,13947	1792	14211	7344	14159	1792	153245
502	Pile Cut off (10' HSP57)	LIN. FT.		0	3.1	8.8	2.3	14.2		21	16.4	7.2	2.6	47.2
613	1 1/2" Ø ELECTRICAL CONDUIT	LIN. FT.			23			23			23			46

NOTES
CONSTRUCTION SEQUENCE OF NEW BRIDGES (E-16-HS, E-16-HR) FOR SURFACING:

1. PLACE WATERPROOFING MEMBRANE OVER PREPARED BRIDGE DECK.
2. CONSTRUCT TWO 3/4 INCH. COURSES OF HOT BITUMINOUS PAVEMENT (GR. DX) OVER THE PREPARED DECK SURFACE.

4 SPAN CONTINUOUS
(111'-0", 114'-0", 114'-0", 111'-0")
COMPOSITE, CONCRETE SLAB AND WELDED STEEL CURVED GIRDER BRIDGE OVER U.S. 287 AND THE COLORADO SOUTHERN RAILROAD.

E-16-HS DECIM STA. 522+10.52
E-16-HR DECIM STA. 526+76.36
E-16-HR DECIM STA. 526+44.18



COLORADO
DEPARTMENT OF HIGHWAYS

GENERAL LAYOUT

Across US 287, Colo. & Southern R.R.
Sta. See Sheet No. 12
Near Broomfield, Sec. 34, T.1S, R.6W

Designed by BSMH
Made by DL-PS
Checked by AL
Approved by Bridge Engineer
Date: 19

STRUCTURE NO.

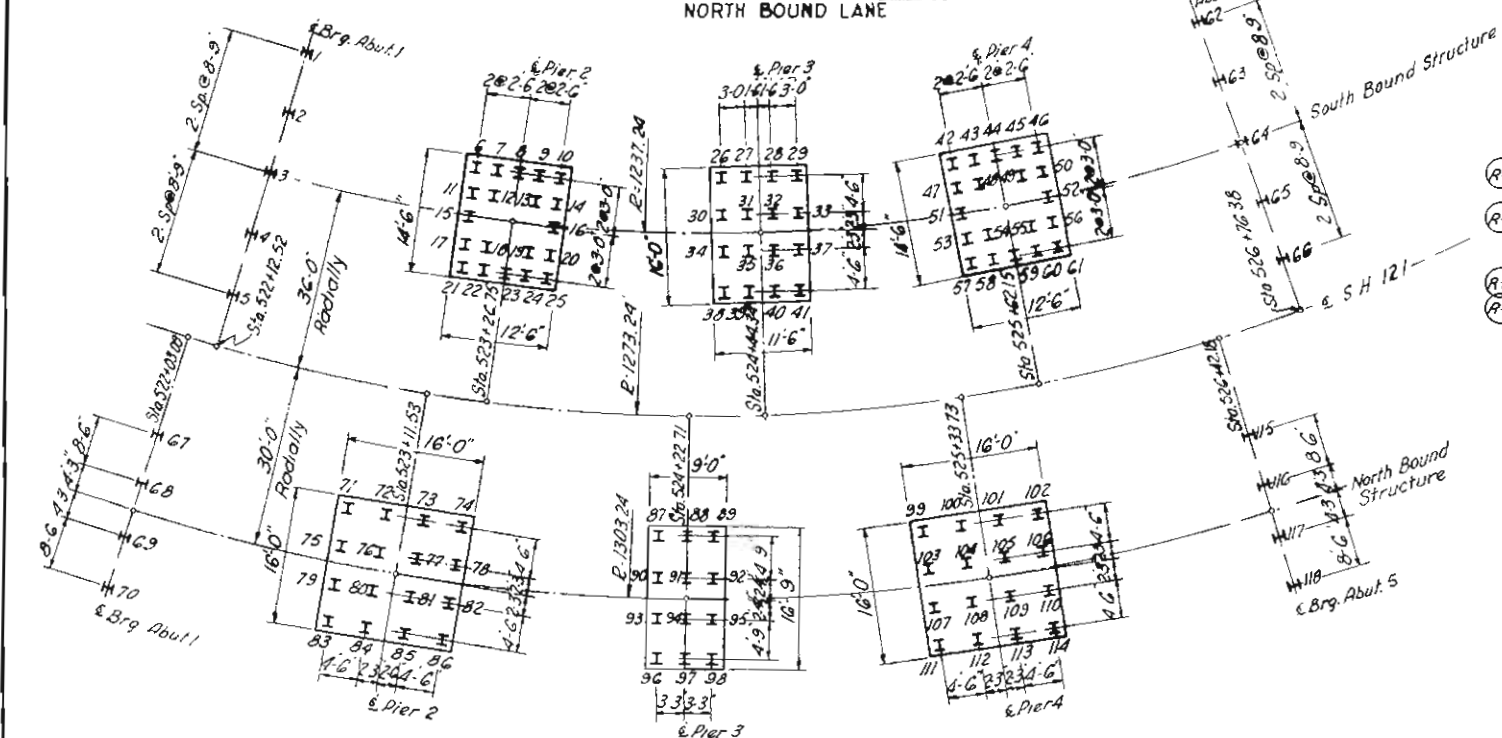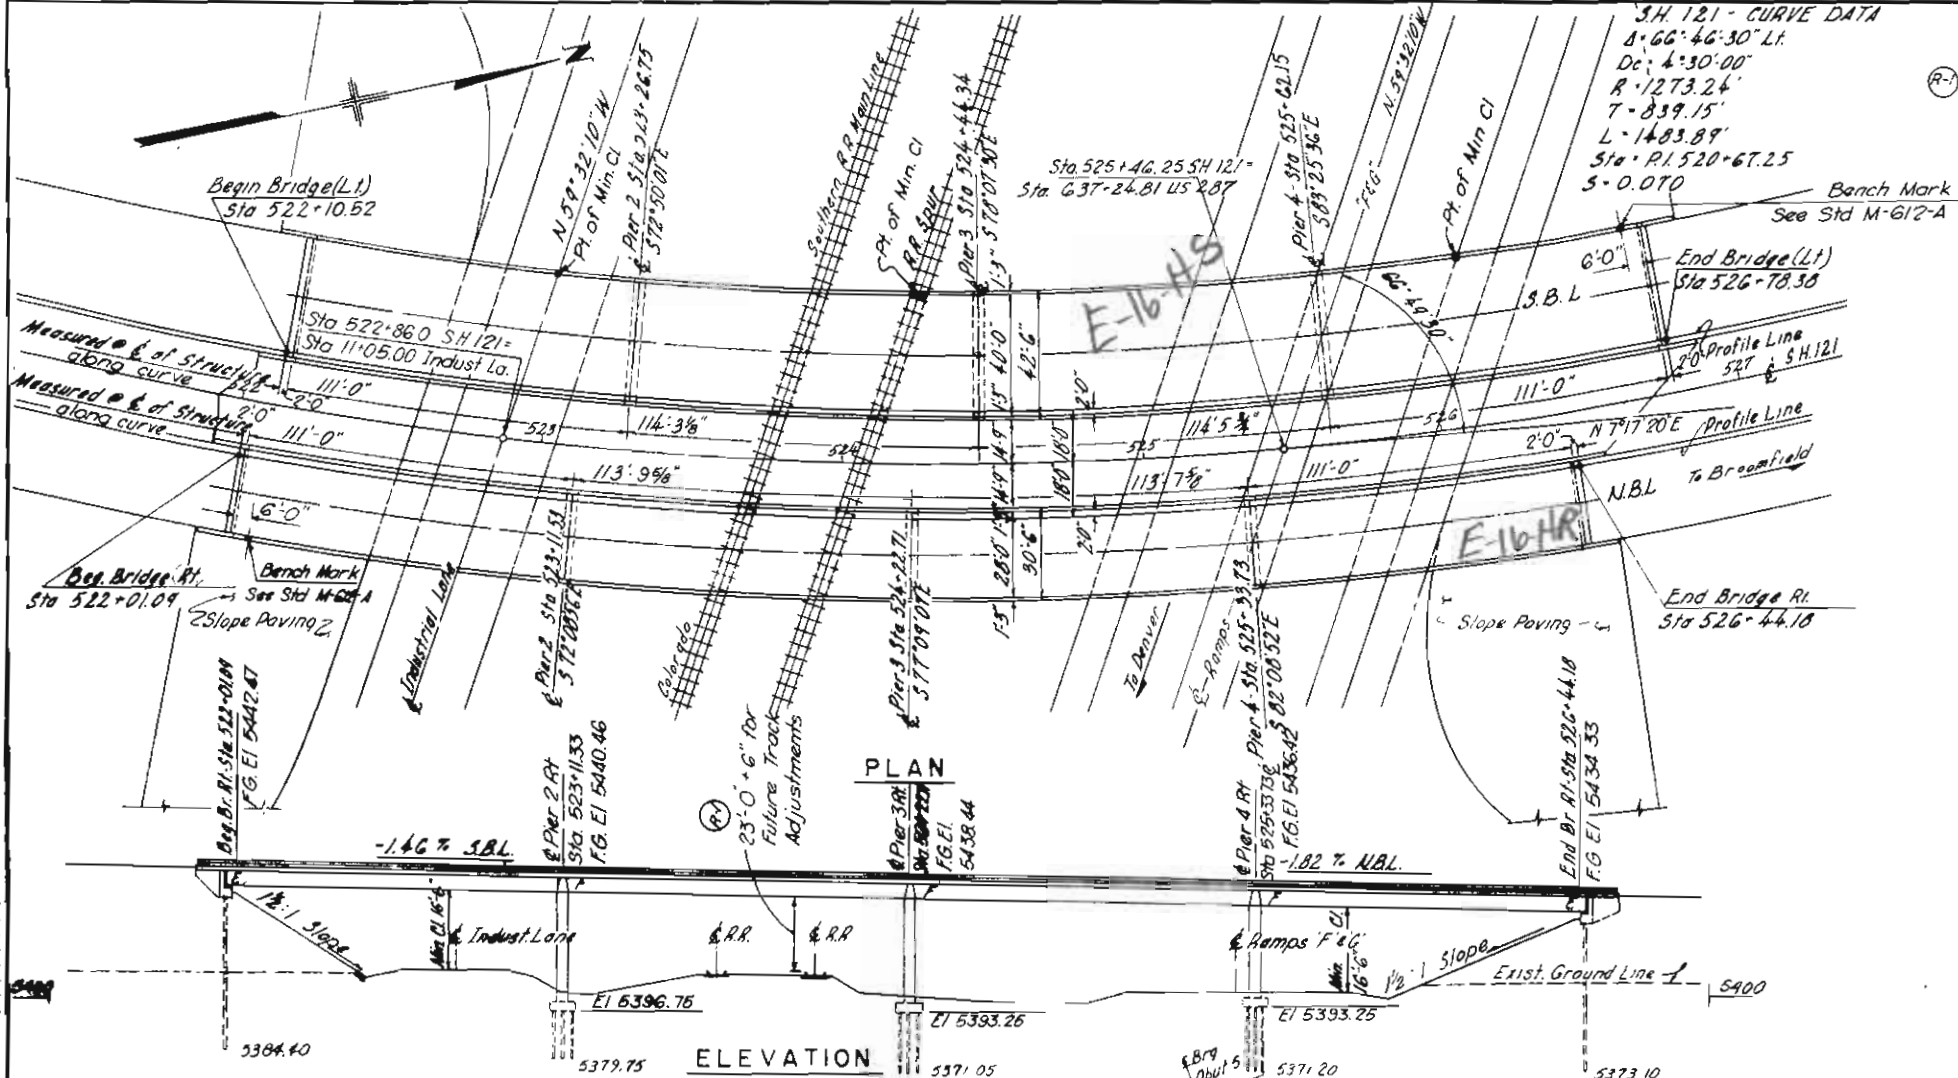


PILE & FOOTING STAKING DIAGRAM
Dimensions are at bottom of concrete

(R-1) 10-21-71 P.D.L.
CHG PROJ NO

FED ROAD REG NO	DIVISION	PROJECT NO	SHEET NO	TOTAL SHEETS
9	COLO	EMS-F121-1(17)	14	

AS CONSTRUCTED
NO REVISIONS
Date Completed 4/24/73

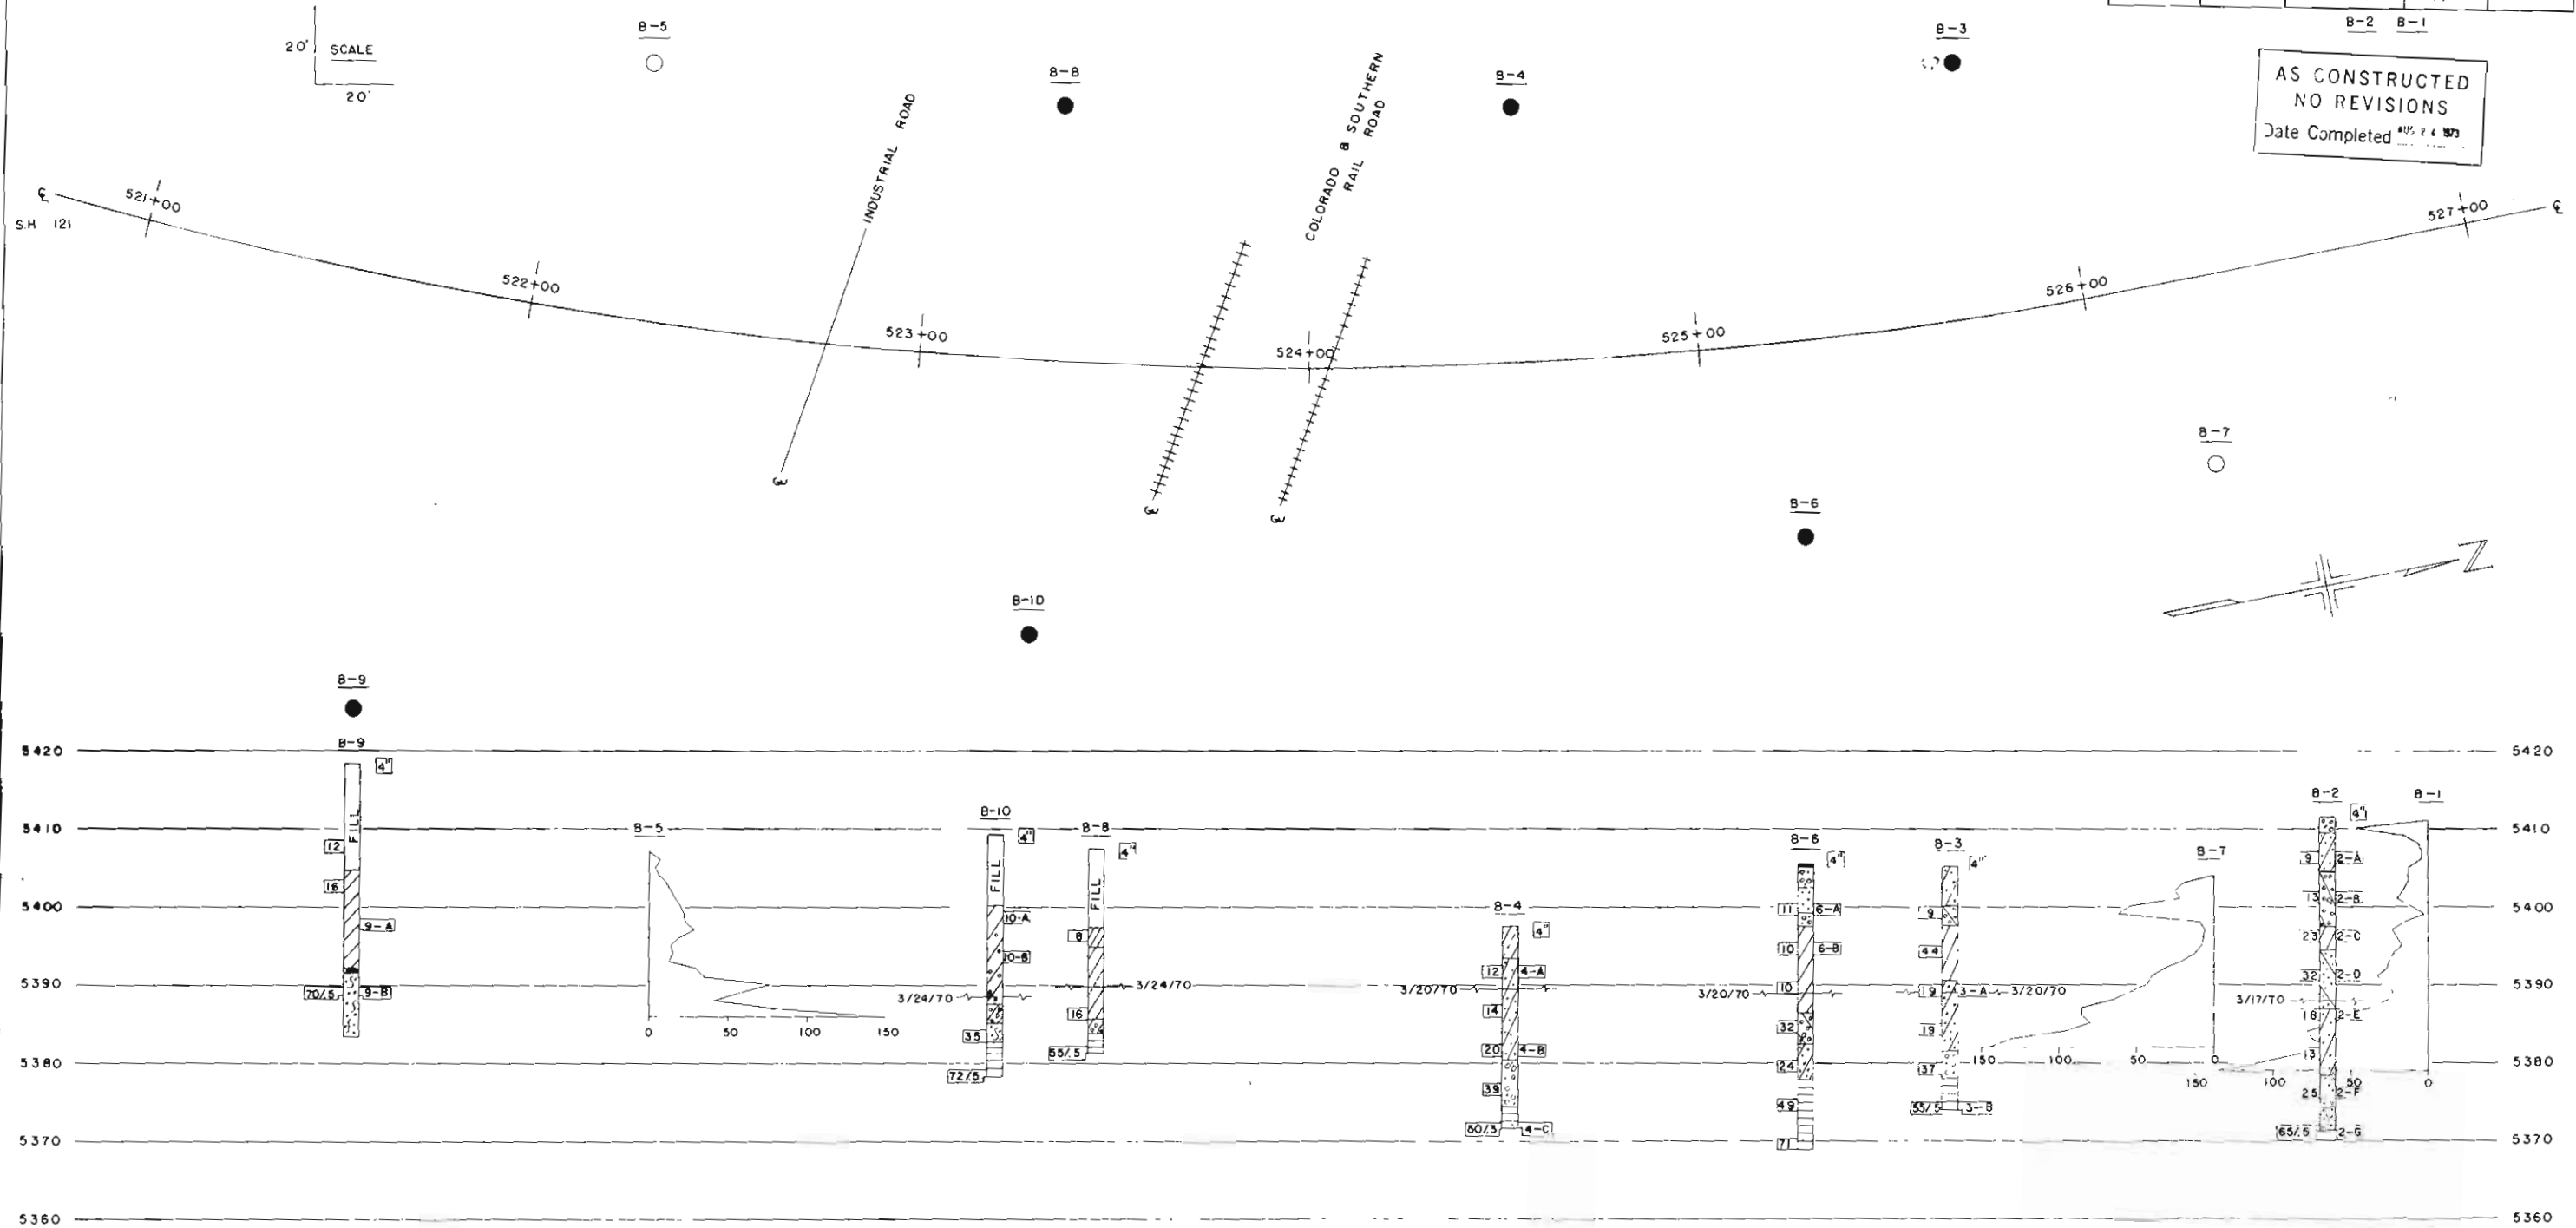


SUMMARY OF TEST RESULTS

Sample No	Depth	Classification	Grading Analysis	AASHTO	Gravel	Coarse Sand	Fine Sand	Silt and Clay	Liquid Limit	Plastic Limit	Plastic Index	Water Content	Shrinkage	Unconfined Strength	Triaxial Shear Strength	D ₅₀ Sample
2-D	20.0-20.4	Sandy clay	A-6(19)	1	2	18	79	40	14	26	14.3	129.7	6.2			1.4
2-E	25.0-25.4	Sandy clay	A-7-6(22)	1	4	23	72	49	16	33	18.3	132.6	3.2			1.4
3-A	15.8-16.3	Sandy clay	A-7-6(23)	0	1	21	78	47	16	31	16.8	137.2	6.2			1.4
4-B	15.3-15.8	Sandy clay	A-6(13)	0	2	26	72	35	14	21	16.7	134.6	2.4			1.4
4-C	25.1-25.6	Shale	A-6(21)	0	0	11	89	40	16	24	12.4	135.5	6.6			1.4
6-B	10.5-11.0	Clay	A-7-6(36)	0	1	12	87	57	18	39	23.2	125.7	1.9			1.4
9-A	19.8-21.3	Clay	A-7-6(28)	0	1	15	84	49	16	33	16.7	118.4		36.3	0.37	2.5
9-B	28.5-29.5	Sandstone	A-6(11)	2	3	16	79	34	19	15	13.0					2.5
10-A	9.8-11.3	Sandy clay	A-7-6(19)	1	3	22	74	45	17	28	23.3	123.7				2.5
10-B	14.8-16.3	Sandy clay	A-7-6(26)	2	2	20	76	51	16	35	19.5	129.0				2.5

TYPE OF MATERIAL

CLAY	SANDSTONE
SAND	SAND & GRAVEL
SHALE	SANDY CLAY
CLAYEY GRAVEL	SILTY CLAY
CLAYEY SAND	SANDY SHALE
GRAVELLY CLAY	

LEGEND

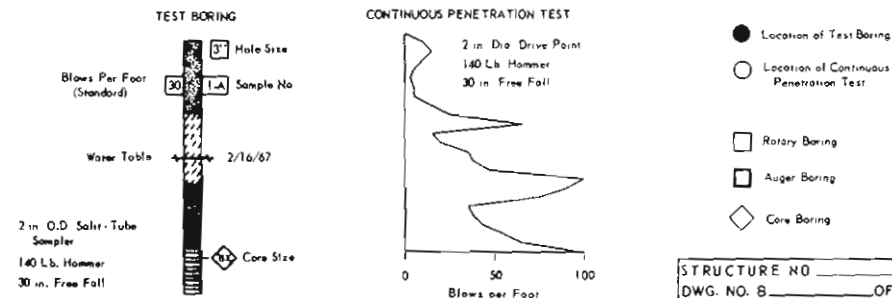

DEPARTMENT OF HIGHWAYS STATE OF COLORADO

ENGINEERING GEOLOGY


Across: COLO. & SOUTHERN R.R. INDUS. LANE
Site: See SM
Near: BROOMFIELD Sec. T R
Geologist: K W B Approved by
Made by: D K O Bridge Engineer
Checked by: G C P Date: 19

STRUCTURE NO. _____
DWG. NO. B. _____ OF _____

FEDERAL ROAD DISTRICT No.	DIVISION	PROJECT No.	SHEET No.
9	COLORADO	EHS-F 121-17	18

Revised note GLB 10-21-71 CHG. PROJ NO - PDL.

Notes:
Heat curving of girders will be permitted in accordance with the AASHTO Interim Specifications, Interim II, 1970.

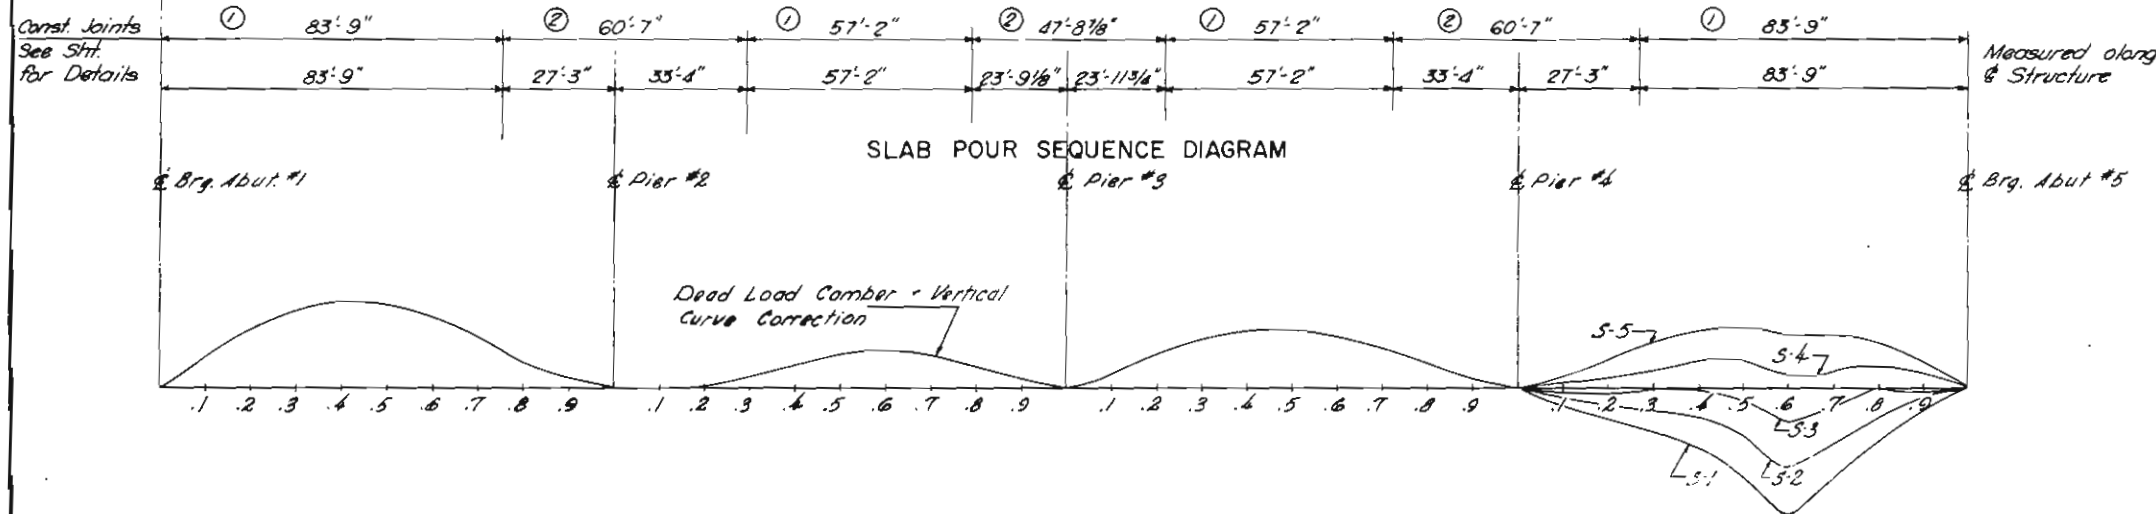

GIRDER WEBS TO REMAIN CONSTANT DEPTH.
SLAB POUR SEQUENCE SHALL BE AS SHOWN. AREAS MARKED ① SHALL BE POURED BEFORE AREAS MARKED ②, BUT AREAS OF THE SAME NUMBER NEED NOT BE POURED SIMULTANEOUSLY.

AS INSTRUCTED
NO REVISIONS
Date Completed 6-6-73

$1/2$ $3/8$ $1/4$ $1/8$ $1/16$ $1/32$ $1/64$ $1/128$ $1/256$ $1/512$	$1/16$ 0 $1/16$ $1/8$ $3/16$ $1/4$ $5/16$ $3/8$ $1/2$ $5/8$ $3/4$ $7/8$ 1	$1/16$ $1/8$ $3/16$ $1/4$ $5/16$ $3/8$ $1/2$ $5/8$ $3/4$ $7/8$ 1 $1 1/8$ $1 1/4$ $1 1/2$ $1 3/4$ 2 $2 1/4$ $2 1/2$ $2 3/4$ 3 $3 1/4$ $3 1/2$ $3 3/4$ 4	$1/16$ $1/8$ $3/16$ $1/4$ $5/16$ $3/8$ $1/2$ $5/8$ $3/4$ $7/8$ 1 $1 1/8$ $1 1/4$ $1 1/2$ $1 3/4$ 2 $2 1/4$ $2 1/2$ $2 3/4$ 3 $3 1/4$ $3 1/2$ $3 3/4$ 4
--	---	--	--

Deflection Due to Slab Pour
Total D.L. Deflection


DEAD LOAD DEFLECTION & CAMBER DIAGRAM - SOUTH BOUND LANE

NOTE: MINUS(-) DEFLECTIONS AND CAMBER ARE DOWN
PLUS (+) DEFLECTIONS AND CAMBER ARE UP.

FINISHED GRADE ELEVATION - SOUTH BOUND LANE (TOP OF ASPHALT)

S-1			S-2			S-3			S-4			S-5		
STA.	FIN. GRADE ELEVATION	Br. Face Abut. #1	STA.	FIN. GRADE ELEVATION	Br. Face Abut. #1	STA.	FIN. GRADE ELEVATION	Br. Face Abut. #1	STA.	FIN. GRADE ELEVATION	Br. Face Abut. #1	STA.	FIN. GRADE ELEVATION	Br. Face Abut. #1
10	52210.522	5441.476	10	52210.522	5441.476	10	52210.522	5441.476	10	52210.522	5441.476	10	52210.522	5441.476
11	52212.522	5441.476	11	52212.522	5441.476	11	52212.522	5441.476	11	52212.522	5441.476	11	52212.522	5441.476
12	52213.522	5441.476	12	52213.522	5441.476	12	52213.522	5441.476	12	52213.522	5441.476	12	52213.522	5441.476
13	52214.522	5441.476	13	52214.522	5441.476	13	52214.522	5441.476	13	52214.522	5441.476	13	52214.522	5441.476
77	52278.522	5441.476	77	52278.522	5441.476	77	52278.522	5441.476	77	52278.522	5441.476	77	52278.522	5441.476
78	52279.522	5441.476	78	52279.522	5441.476	78	52279.522	5441.476	78	52279.522	5441.476			

NOTE:
Notes on Finished Grade Elevations and Camber
Diagram S.B.L. Sheet are applicable to North Bound Lanes.

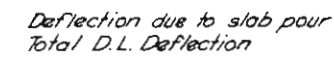

FINISHED GRADE ELEVATION - NORTH BOUND LANE (TOP OF ASPHALT)

COLORADO
DEPARTMENT OF HIGHWAYS



Finished Grade Elevations
&
Camber Diagram N.B.L.
Across U.S. 287; Colo. & Southern R.R.
Sta. See Sheet
Near BROOMFIELD Sec. 34 T. 1 S. R. 69 W

Designed by BSMH
Made by P.S.
Checked by A.L.

Approved by
Bridge Engineer
Date: 19

REVISIONS

FEDERAL ROAD DISTRICT No.	DIVISION	PROJECT No.	SHEET No.
9	COLORADO	EHS - F 121 - 1 (7)	17

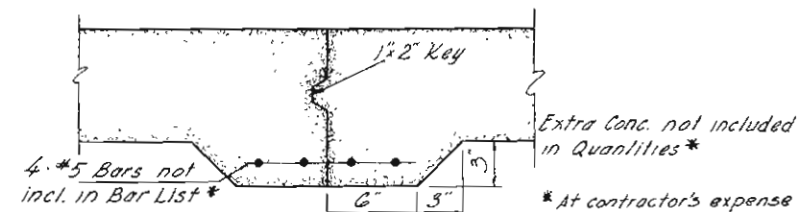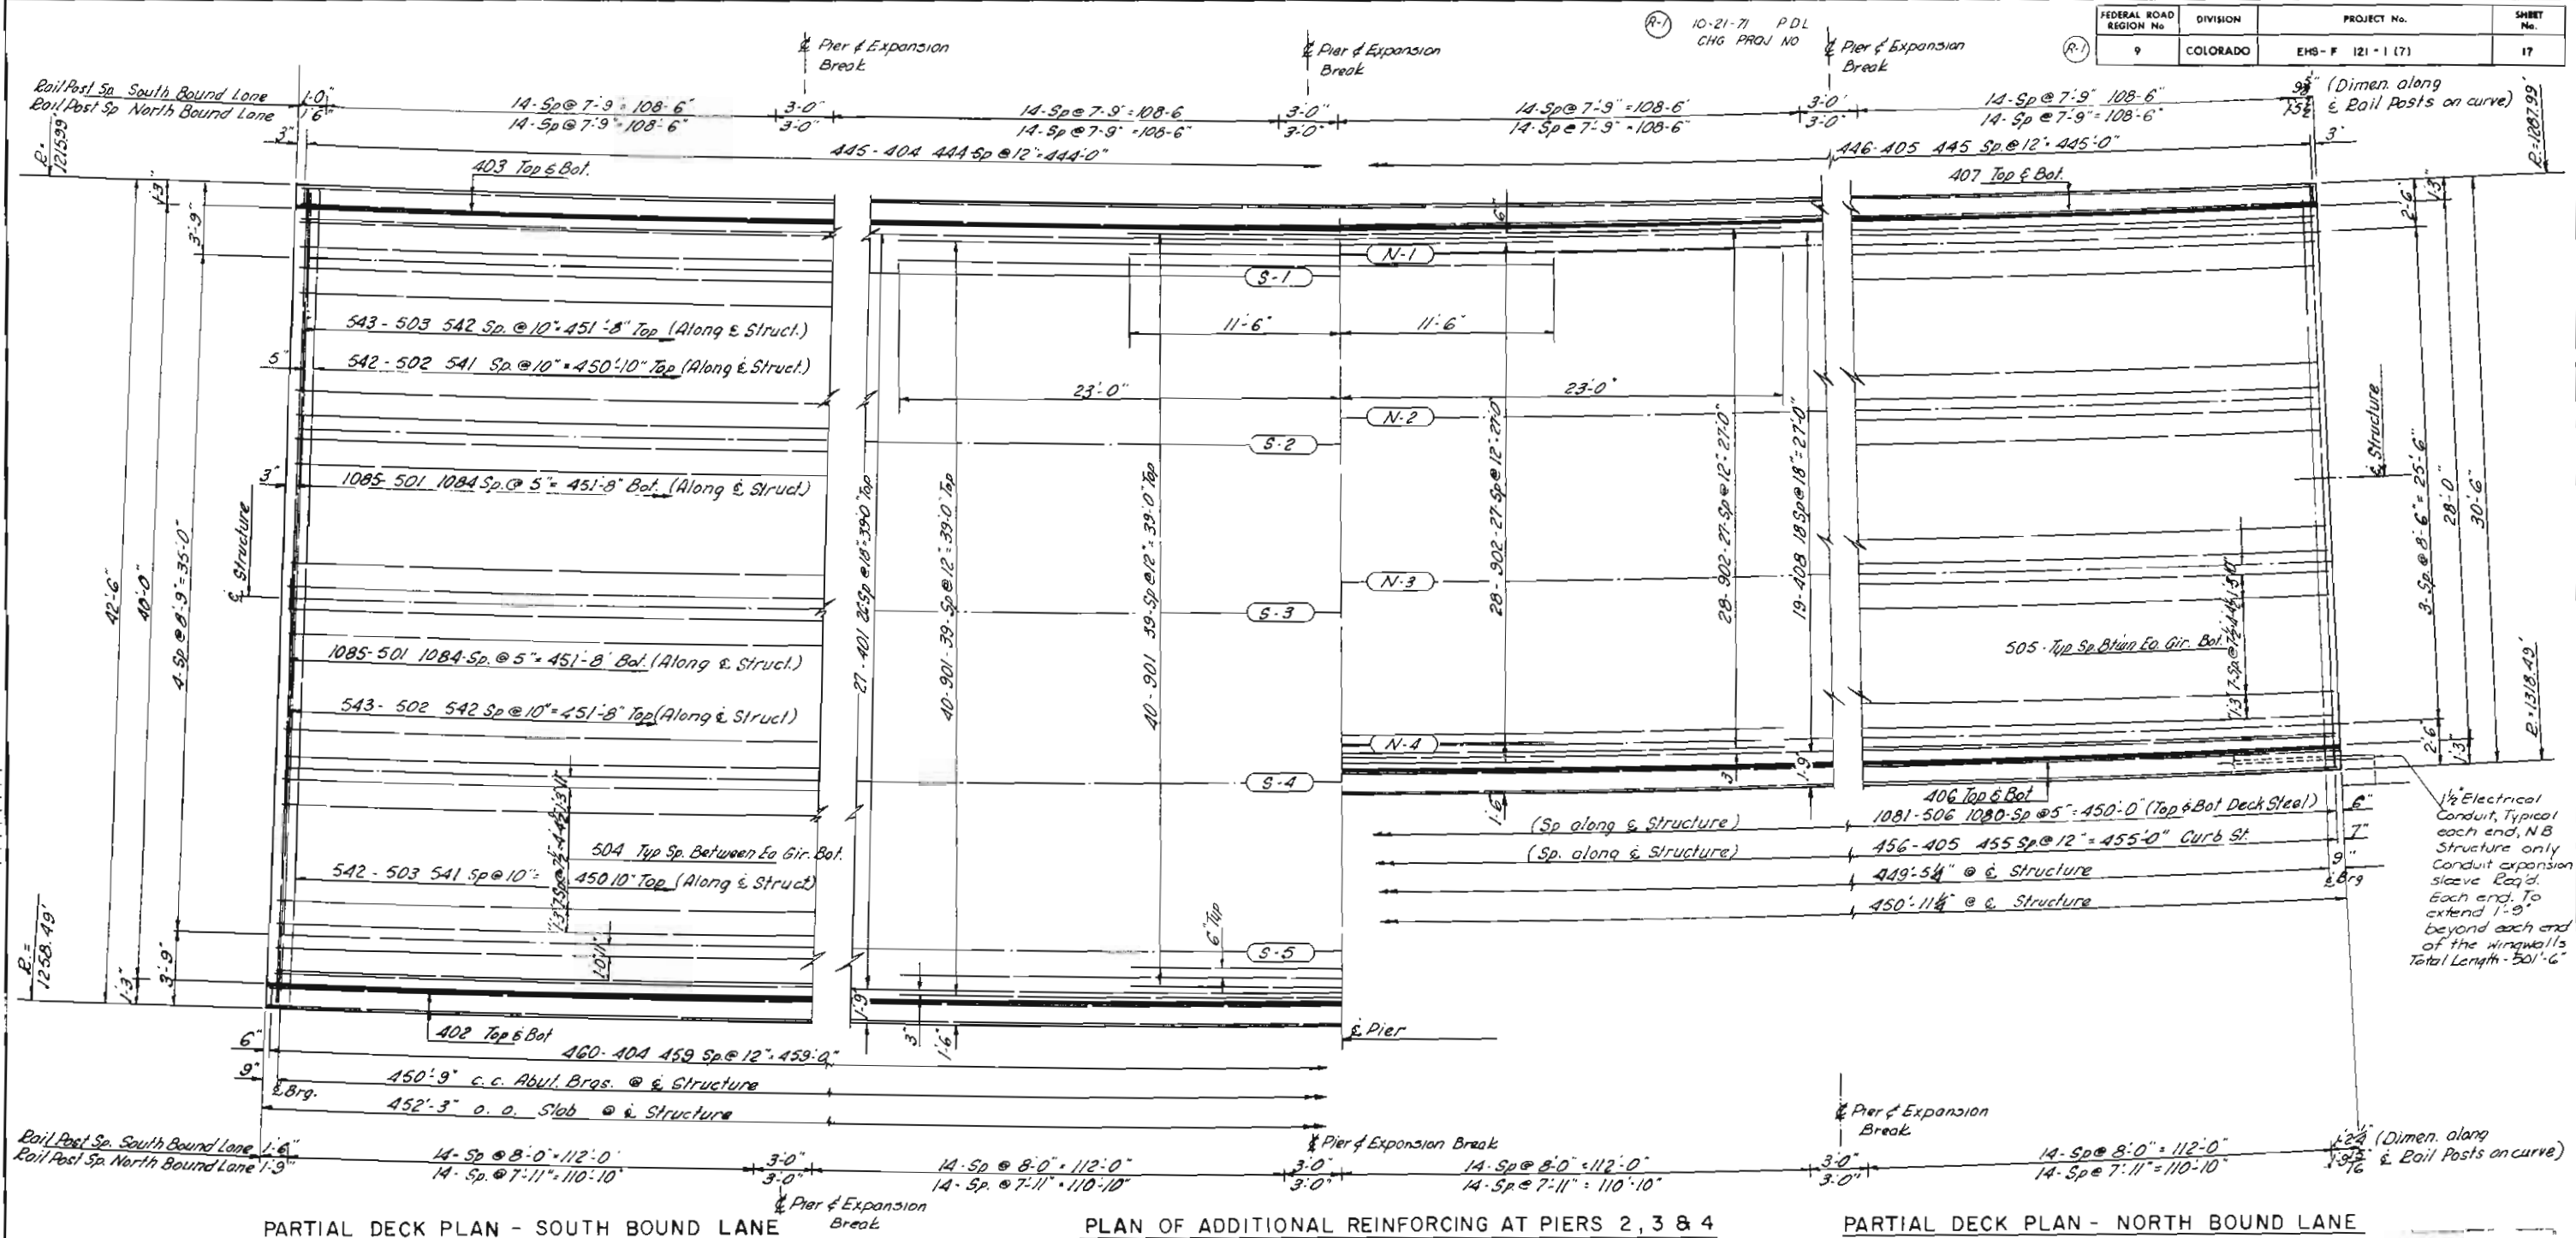

COLORADO
DEPARTMENT OF HIGHWAYS

DECK PLAN

Across US 297, Colo. & Southern R.R.
Sta. See SH
Near BROOMFIELD Sec. 34 T.15 R.69W

Designed by BSMH
Made by P.S.
Checked by A.L.

Approved by
Bridge Engineer
Date: 19


STRUCTURE NO. 17

REVISIONS




(R-1) 10-21-71 P.D.L.
CHG PROJ NO

FEDERAL ROAD REGION No.	DIVISION	PROJECT No.	SHEET No.
9	COLORADO	EHS - F (21-1 (7))	19

INSTRUCTED REVISIONS
Completed 10-24-71

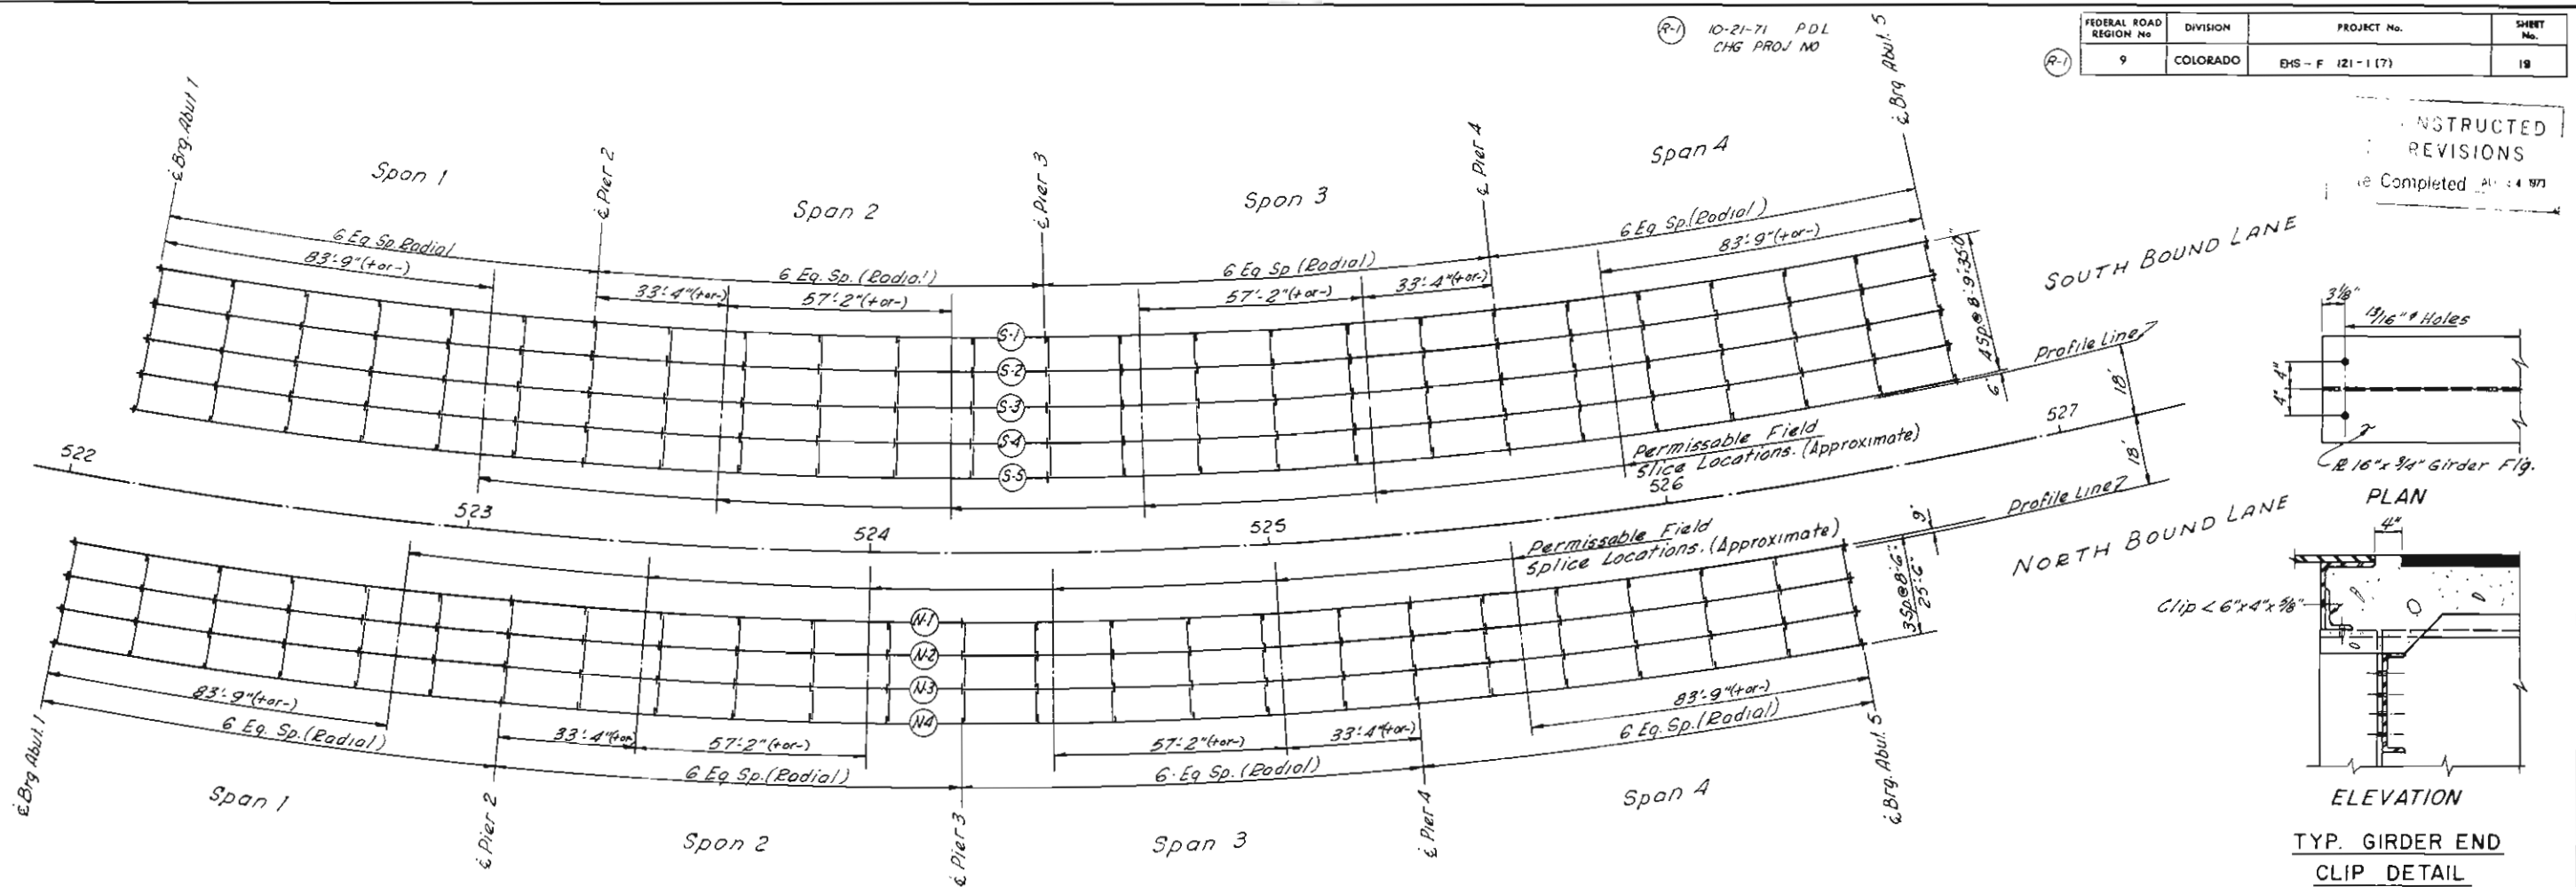

ERECTION DIAGRAM

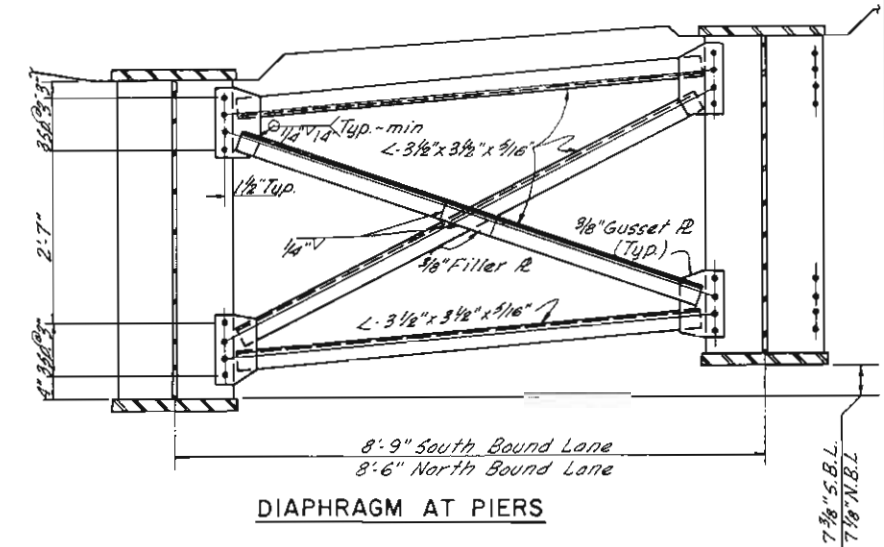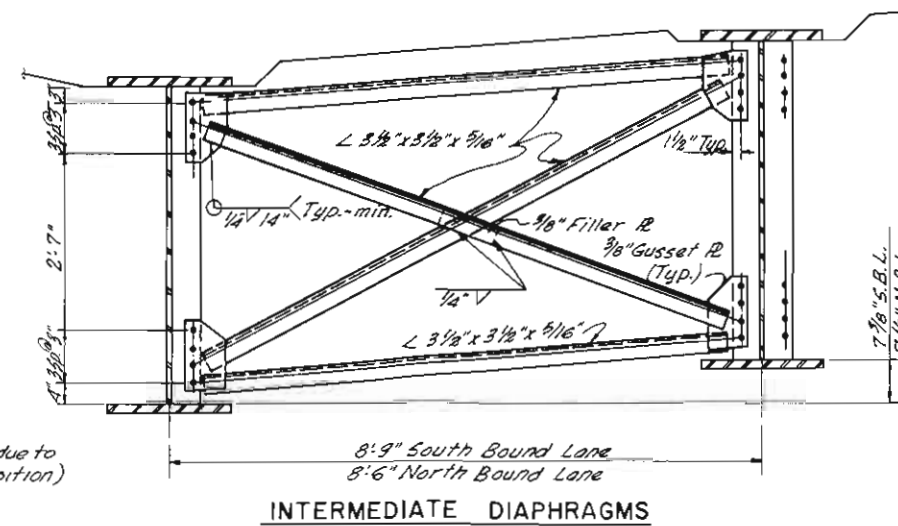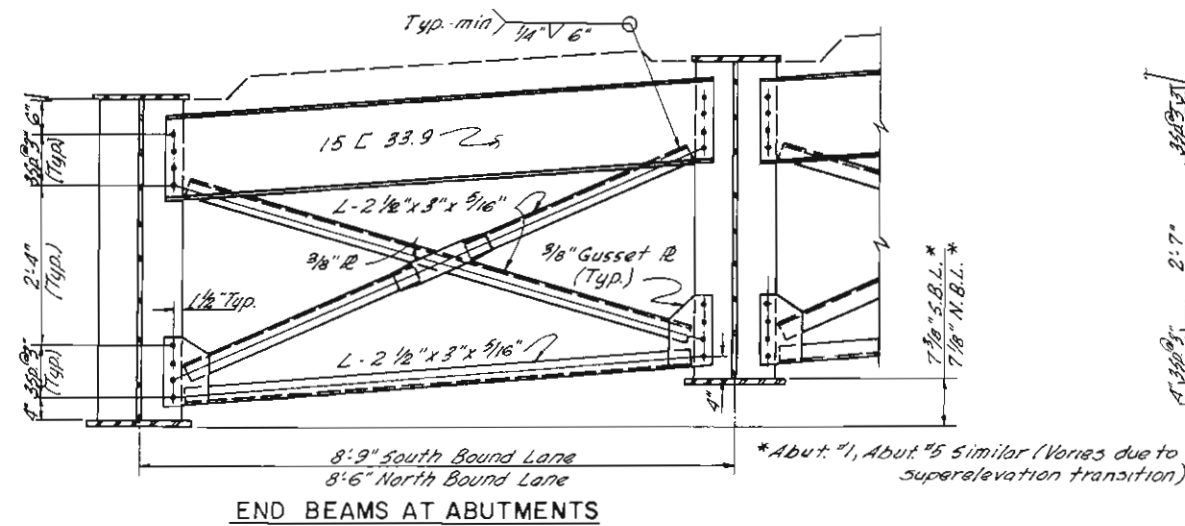

COLORADO
DEPARTMENT OF HIGHWAYS

FRAMING PLAN







Across U.S. 287, Colo. 8 Southern R.R.
Sta. See Sht
Near BROOMFIELD Sec 34 T. 1S. R. 69W

Designed by BSMH
Made by P.S.
Checked by A.L.

Approved by
Bridge Engineer
Date: 19

STRUCTURE NO

Date Completed _____

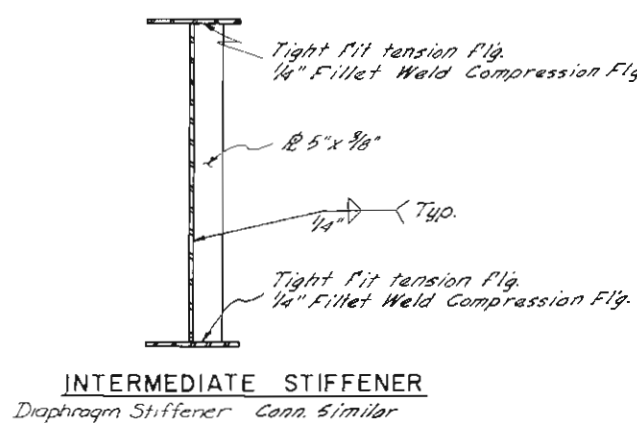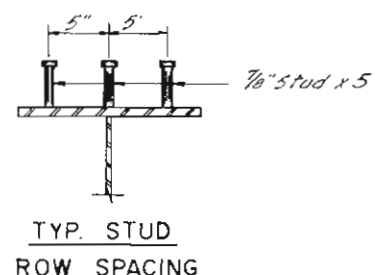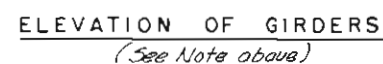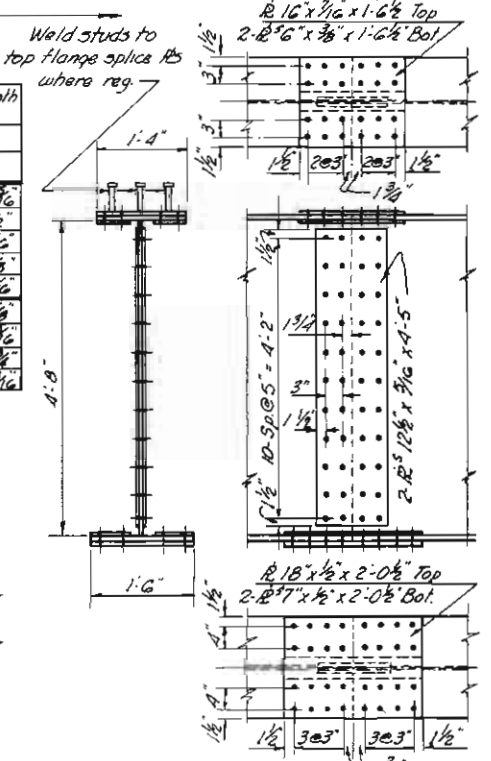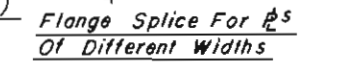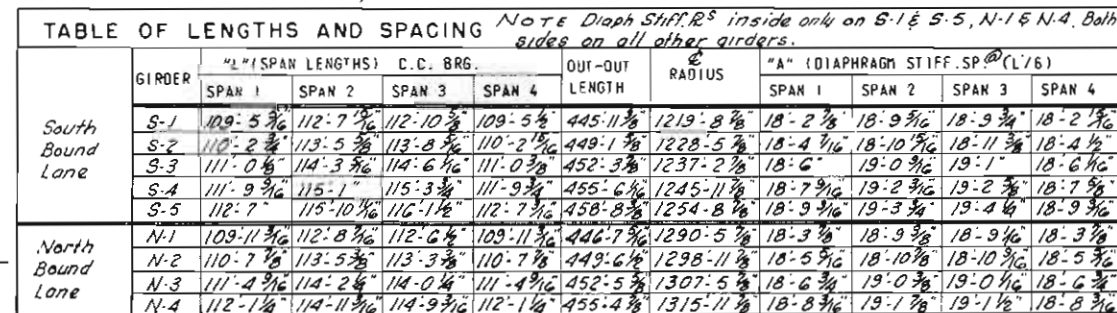

Note: For compression flange welding, the compression area is defined as the area of shear connectors.

TYPICAL FIELD SPLICE
(See Erection Diagram for Locations of Field Splice Pts.)

COLORADO
DEPARTMENT OF HIGHWAYS

GIRDER DETAILS

Across U.S. 287; Colo. & Southern R.R.
Sta See Shl


Near BROOMFIELD Sec. 34 T. 1 S. R. 69 W

Downloaded by [BSMU] - Approved by

Designed by SSMR. Approved by
Made by P. S. Bridge Engineer


Checked by A.L. Date: 19

STRUCTURE NO

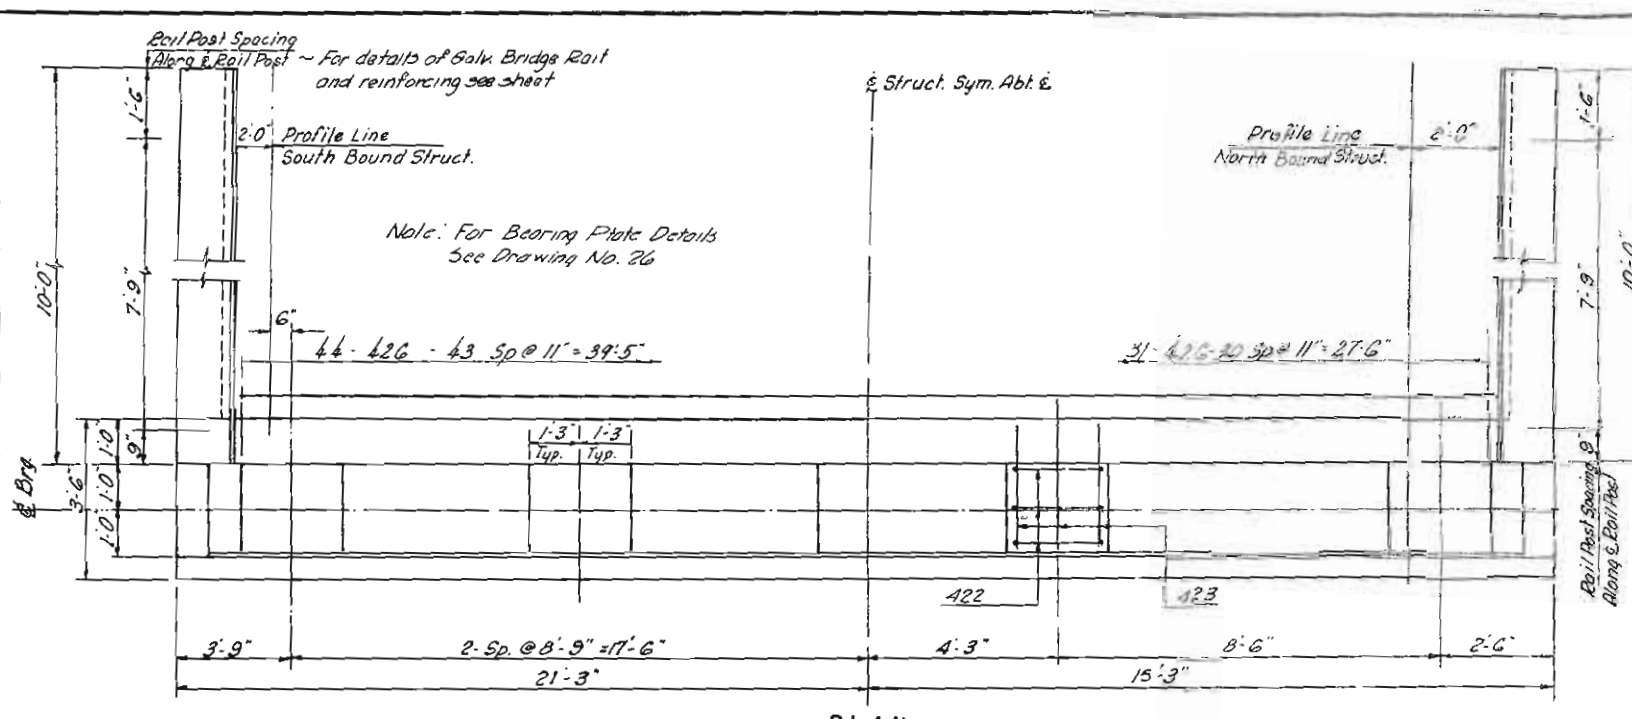


SOUTH BOUND STRUCT. ABUT. No. 5
(ABUT. No. 1 SIMILAR)

NORTH BOUND STRUCT. ABUT. No. 1
(ABUT. No. 5 SIMILAR)

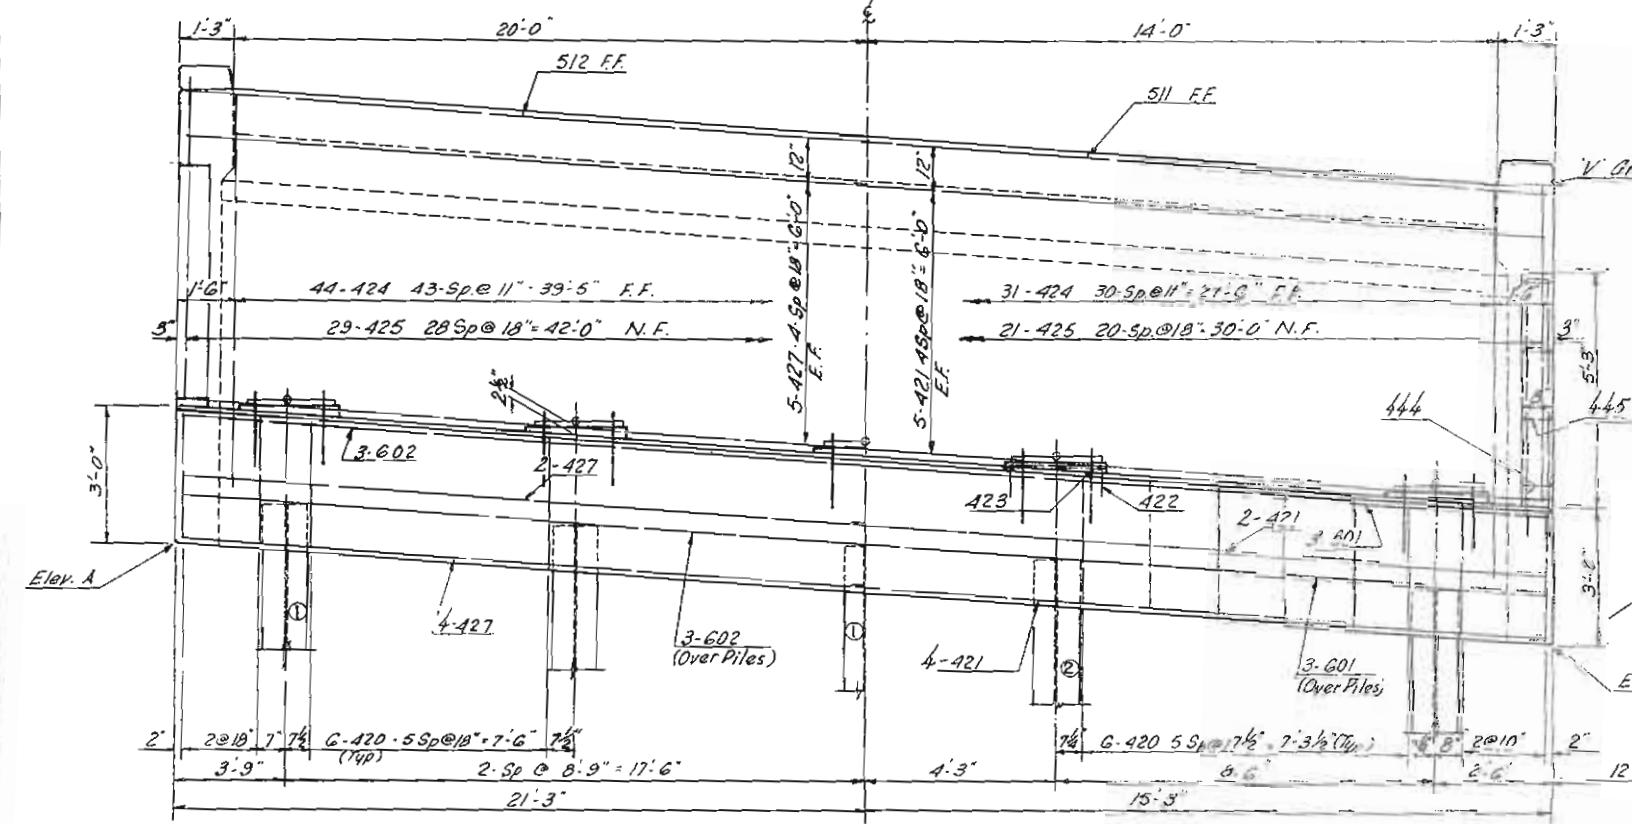


SOUTH BOUND STRUCT. ABUT. No. 5
(ABUT. No. 1 SIMILAR)


NORTH BOUND STRUCT. ABUT. No. 1
(ABUT. No. 5 SIMILAR)

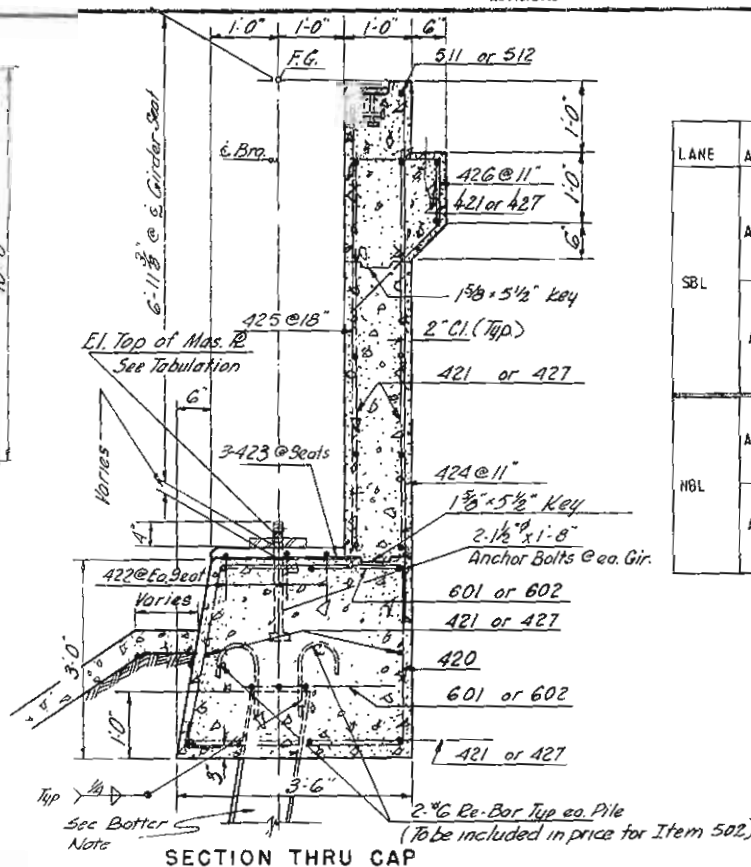

SECTION THRU CAP

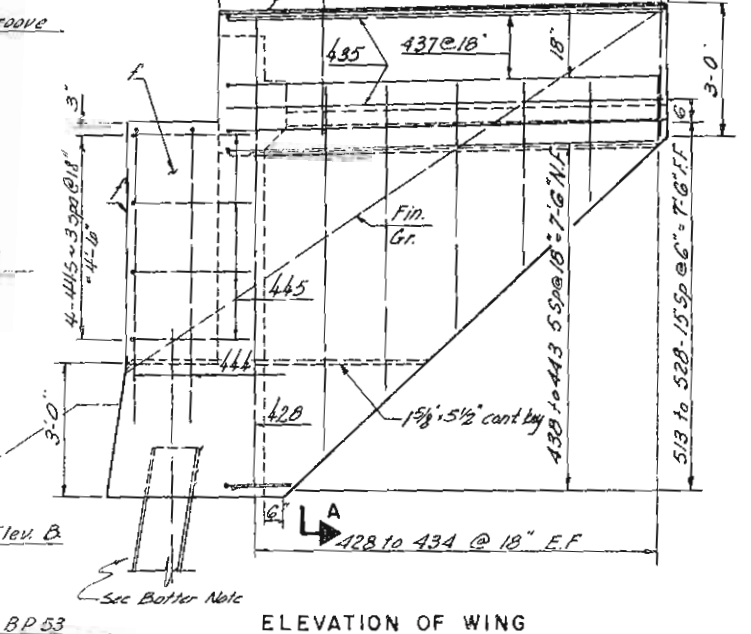

ELEVATION OF WING

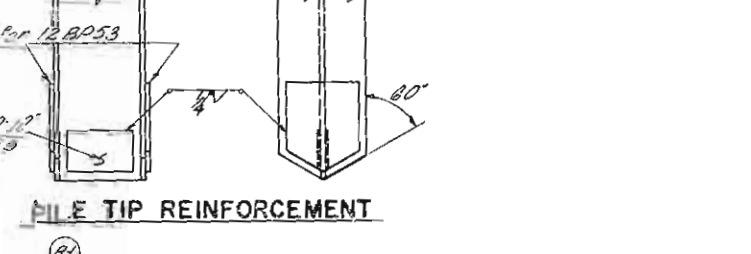


PILE TIP REINFORCEMENT

FEDERAL ROAD DISTRICT NO.	DIVISION	PROJECT No.	SHEET No.
9	COLORADO	ENS-F 121-1 (7)	81

LANE	ABUT	GIR. NO.	ELEV. @ TOP OF MASONRY R.	ELEV. A	ELEV. B
SBL	ABUT 1	S-1	5434.80	5434.18	5431.20
		S-2	5435.41		
		S-3	5436.02		
		S-4	5436.64		
		S-5	5437.25		
SBL	ABUT 5	S-1	5427.36	5423.82	5426.15
		S-2	5427.85		
		S-3	5428.33		
		S-4	5428.81		
		S-5	5429.28		
NBL	ABUT 1	N-1	5435.56	5434.18	5432.05
		N-2	5436.15		
		N-3	5436.75		
		N-4	5437.34		
		N-5	5437.93		
NBL	ABUT 5	N-1	5427.51	5424.01	5426.03
		N-2	5428.07		
		N-3	5428.64		
		N-4	5429.20		
		N-5	5429.77		

Note: Abutment cap, parapet and wing walls shall be poured monolithically to each const. jt.

STRUCTURED REVISIONS
Date Completed: 4/1/72

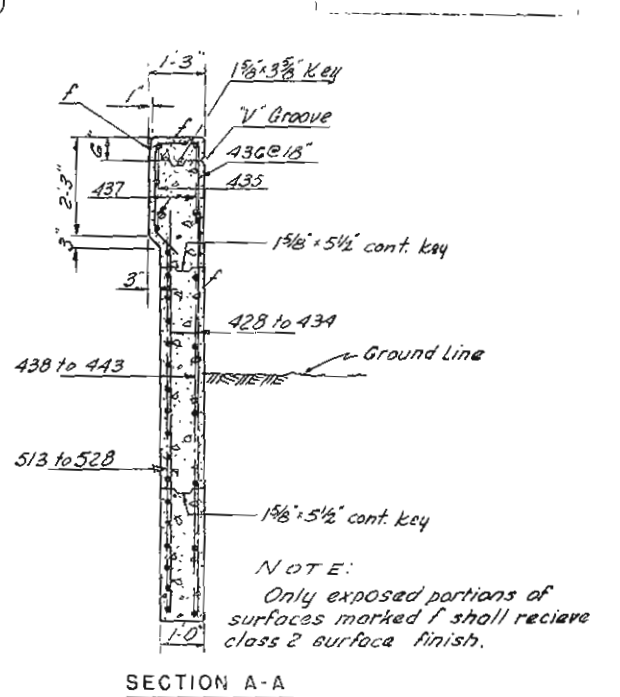

SECTION A-A

Notes:
All piles to be end bearing piles
Estimated pile length is 51 ft at all Abuts.
N.F. = Near Face. F.F. = Far Face. E.F. = Each Face

NOTE: ① S.B. Lanes, both Abuts N. & S. Batter Center and Outer 2 piles @ 4:12
② N.B. Lanes, both Abuts N. & S. Batter Center and Outer 2 piles @ 4:12


COLORADO
DEPARTMENT OF HIGHWAYS

ABUTMENT DETAILS
S.B.L. & N.B.L.

cross. U.S. 287, Colo. & Southern R.R.
Sta. See Shl.
3 ROOMFIELD Sec. 34, T. 1 S., R. 69 W.

Designed by BSMH
Made by P.S.
Checked by A.L.


Approved by
Bridge Engineer
Date: 19

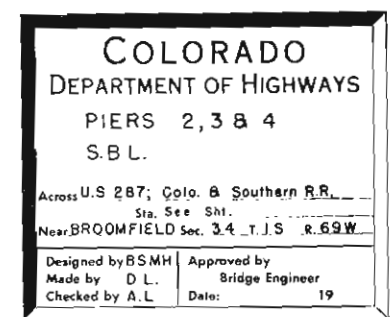


STRUCTURE NO.

REVISIONS


FEDERAL ROAD REGION No.	DIVISION	PROJECT No.	SHEET No.
9	COLORADO	EHS - F (21-1 (7))	23

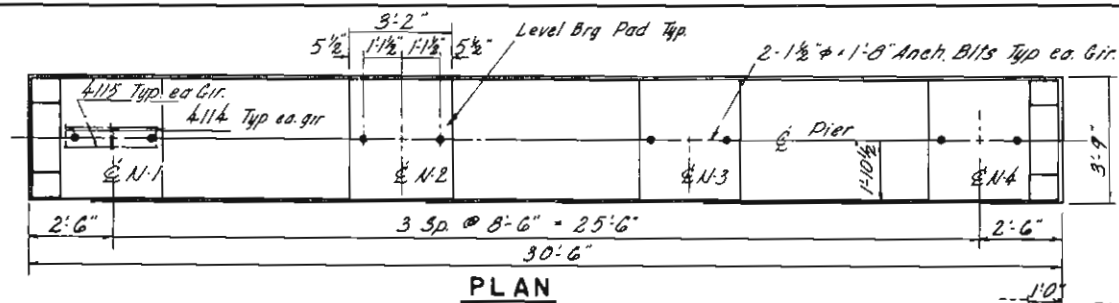

PLAN

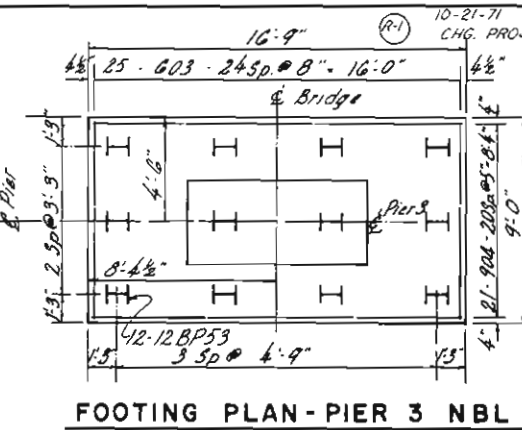


FOOTING PLAN - PIER 3 NBL

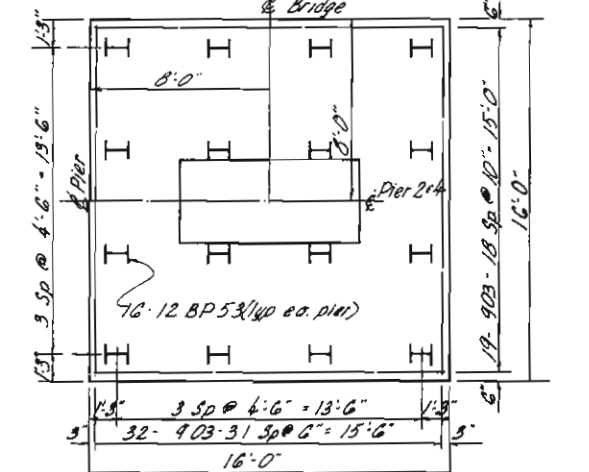


FOOTING PLAN - PIER 2 & 4 NBL

UNSTRUCTURED
NO REVISIONS
Date Completed: 11/5/73

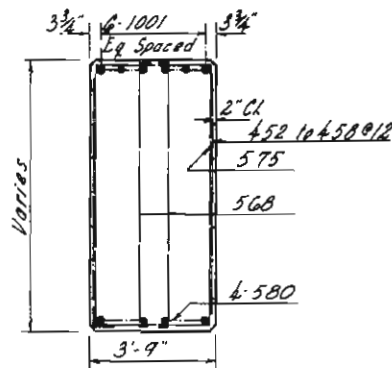

SECTION B-B

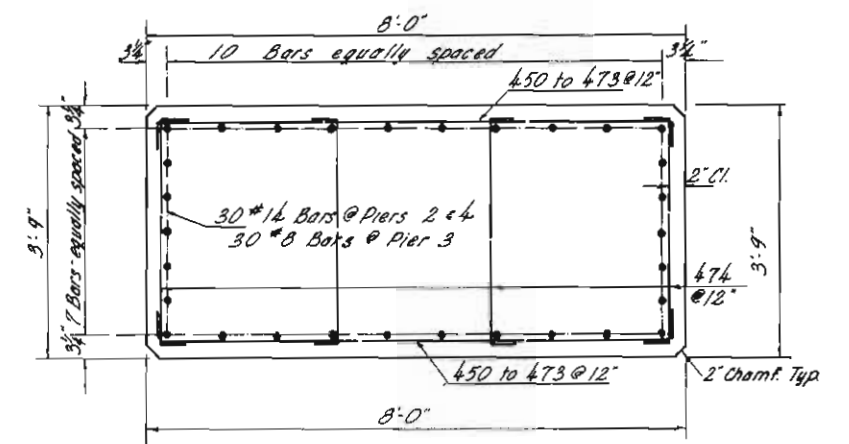

SECTION A-A

Notes: All Pile- to be end bearing piles
Estimated av. length: 18 ft. - Pier 2
19 ft. - Pier 3
19 ft. - Pier 4

DESCRIPTION	PIER 2	PIER 3	PIER 4
ELEV. "A"	5433.98	5432.02	5429.94
ELEV. "B"	5434.45	5432.49	5430.41
ELEV. "C"	5435.04	5433.08	5431.00
ELEV. "D"	5435.64	5433.68	5431.59
ELEV. "E"	5436.23	5434.27	5432.19
ELEV. "F"	5436.12	5434.16	5432.07
ELEV. "G"	5409.85	5407.89	5405.81
ELEV. "H"	5407.71	5405.75	5403.67
ELEV. "J"	5396.75	5393.25	5393.25
ELEV. "K"	5439.52	5437.50	5435.46
ELEV. "L"	5441.48	5439.46	5437.44

TOP OF MASONRY
ELEVATION

Col. Stl. Typ. @ Pier 3
Sym abt. &

801 & 802

803 Dowels

See Ftg. Plans
for Details

10-1406 @ Pier 2
10-1406 @ Pier 4
5-1408 @ Pier 2 & 4

Col. Stl. Typ. @ Pier 2 & 4
Sym abt. &
1402

1401

PIER END

Note:
Notes on sheet are also
applicable to North Bound Piers.

Jct Box EACH FACE
PIER #2 - ELEV 5420

Col. Stl. Typ. @ Pier 3
Sym abt. &

Tangent Pt.
Elev "G"

20-801

10-802

30-803 Dowels
Space w/ 801 & 802

1401

1402

1403

1404

ELEVATION - PIERS 2, 3, & 4 NBL

Col. Stl. Typ. @ Piers 2 & 4
Sym abt. &

10-1405 @ Pier 2
10-1407 @ Pier 4
Butt weld - stagger
on adj. Bars

Tangent Pt.
Elev "H"

15-1402

1403

15-1401

903 @ Pier 2 & 4

603 @ Pier 3

903 @ Pier 2 & 4

904 @ Pier 3

12 BP 53

Elev. "J"

1401

1402



1403

1404

10-21-71 P.D.L.
CHA PROJ NO

FEDERAL ROAD DISTRICT	PROJ NO	SHEET NO	TOTAL SHEETS
9	COLORADO	24	24

REVISIONS	BY	DATE
R-2 1-26-72 Revised dimension	HHH	

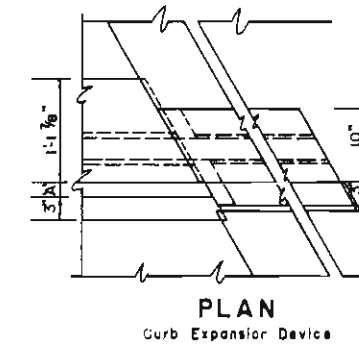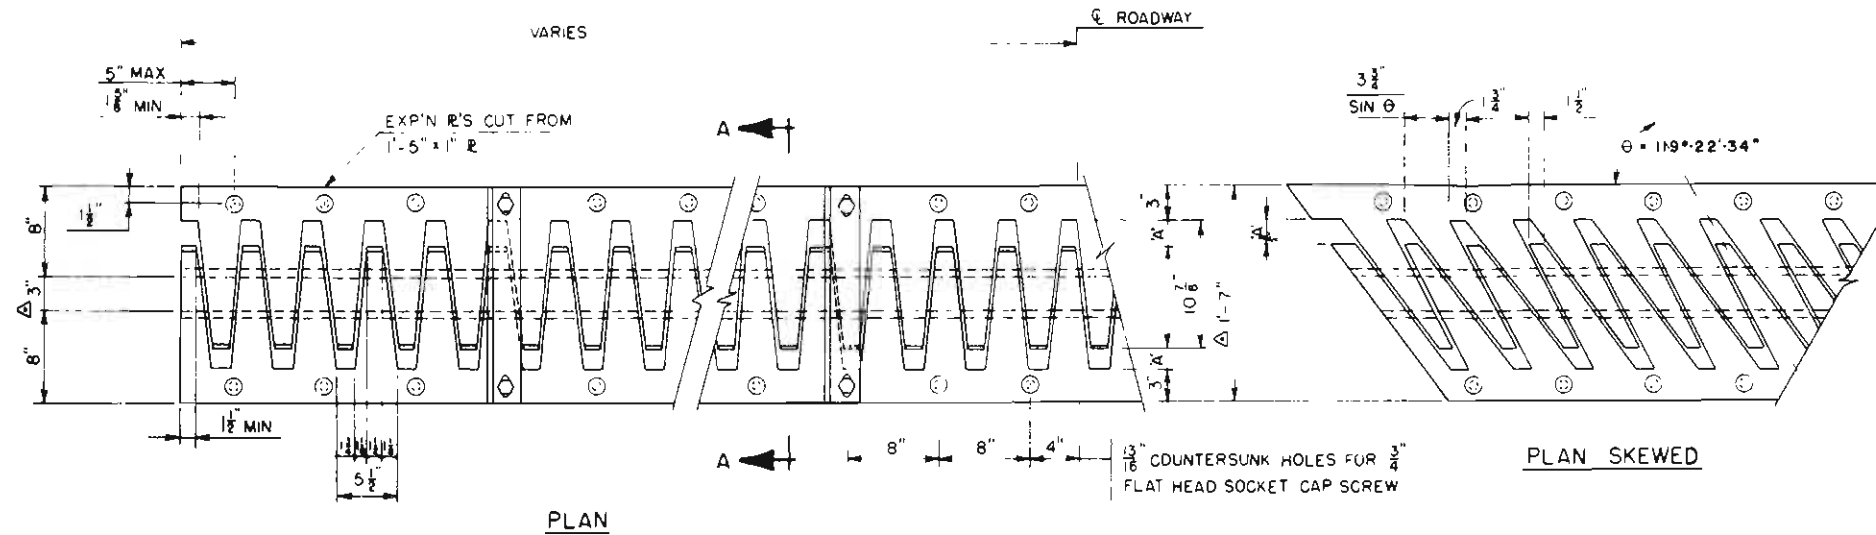





NOTES

FORM THE CURB FACES TO THE PROPER DIMENSION TO RECEIVE JOINT SEALER. (Δ 3" @ 70°)




THE 3/4" Φ FLATHEAD SOCKET CAP SCREWS AND THE 3/4" Φ CONSTRUCTION BOLTS THREAD ENDS SHALL BE COATED WITH TALLOW AND WHITE LEAD.

AFTER THE CONCRETE HAS ATTAINED INITIAL SET, REMOVE CONSTRUCTION BOLTS, ANGLES, AND INSTALL SOCKET HEAD CAP SCREWS

DO NOT PAINT STEEL SURFACES IN CONTACT WITH CONCRETE AND COMPRESSION JOINT SEALER.

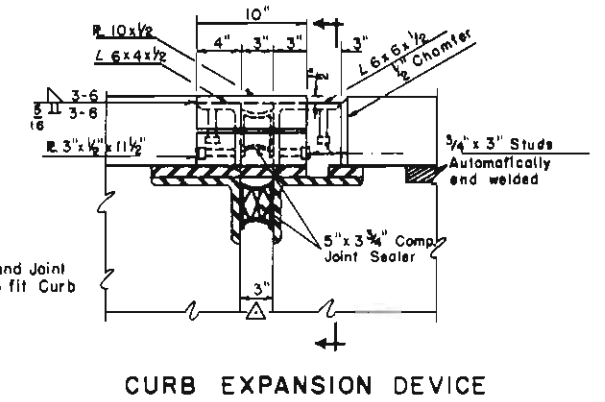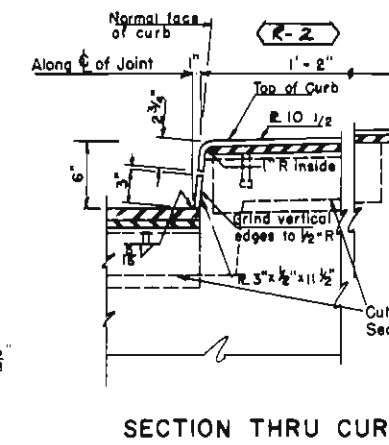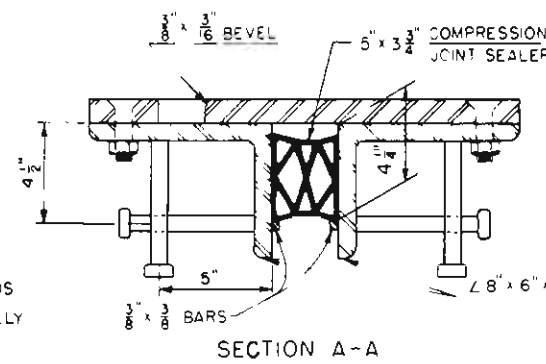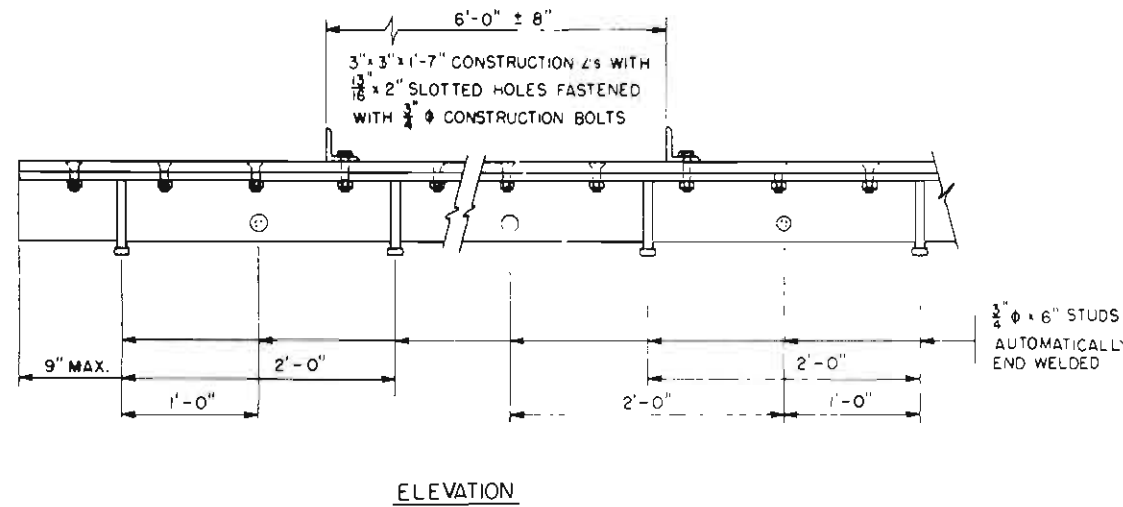

DETAILS of EXPANSION DEVICE - Concrete Slab & Steel Girders

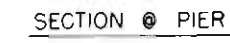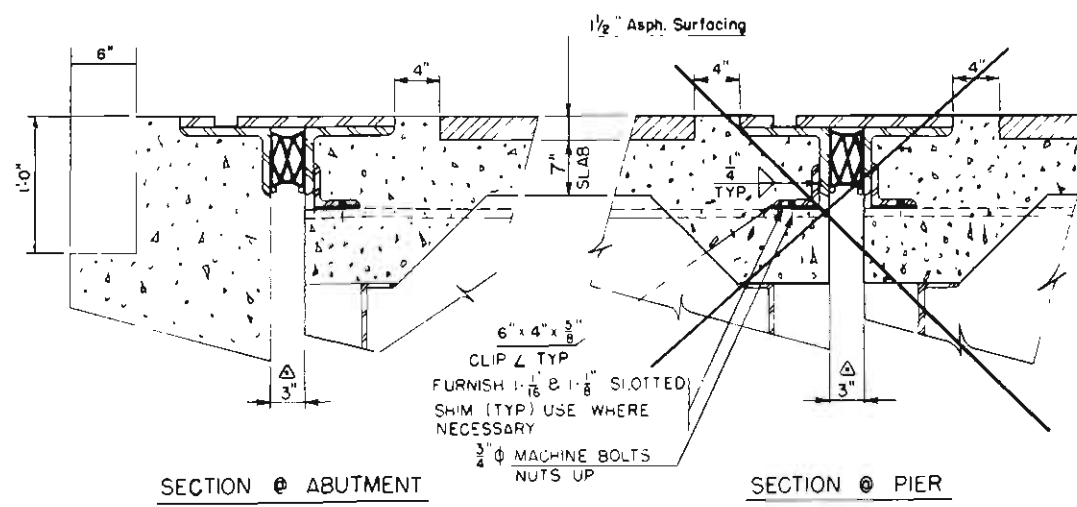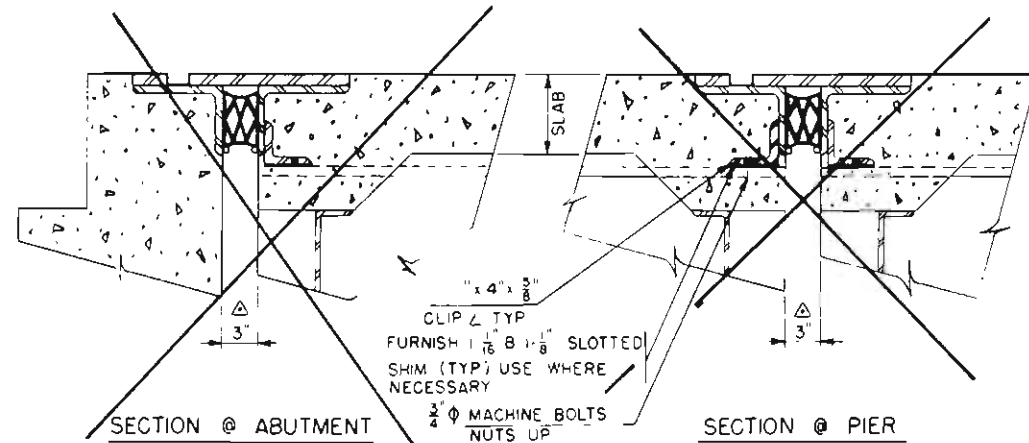


OUTSIDE TEMP	ABUT #1 DIM 'A'	ABUT #5 DIM 'A'	DIM 'A'
40°	2 1/8"	2 1/8"	
50°	2 1/8"	2 1/8"	
60°	2 1/8"	2 1/8"	
70°	2 1/8"	2 1/8"	2 1/8"
80°	1 1/8"	1 1/8"	
90°	1 1/8"	1 1/8"	
100°	1 1/8"	1 1/8"	

DIVISION OF HIGHWAYS


BRIDGE EXPANSION DEVICE FABRICATED (TYPE IV)

Approved:	Designer BSMH	Detailer:
Structure Engineer	E-16-HR	
Date:	E-16-HS	
	DWG. No. B	OF

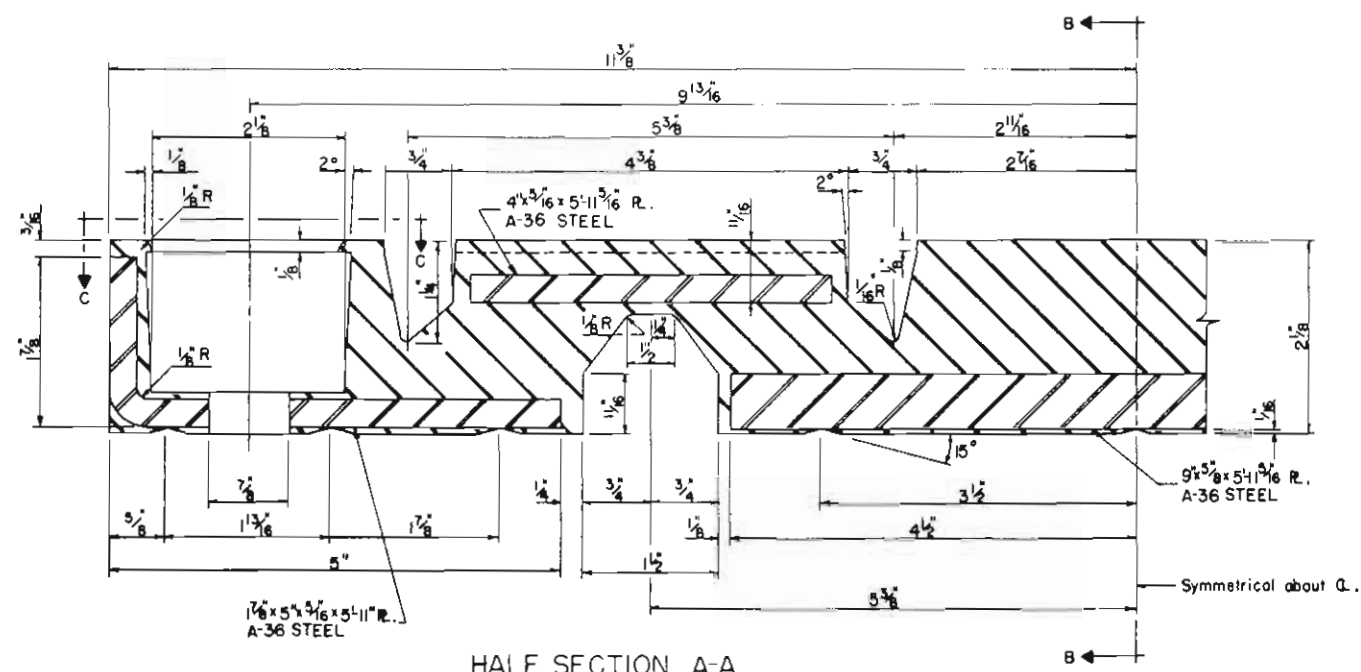

HALF SECTION A-A


Note: Contractor to make all necessary adjustments in slab and abutment details if this expansion device is selected. Slab and abutment details as shown are for the Bridge Expansion Device ~ Fabricated (Type IV).

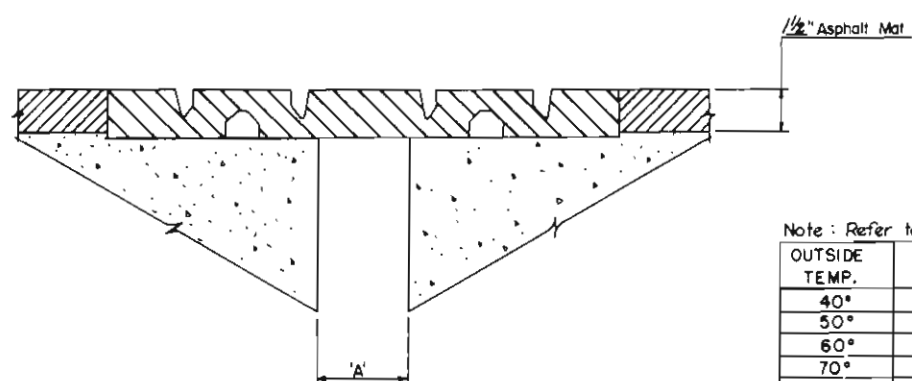


SECTION @ PIER OR ABUTMENT

Note: Refer to Sht. No. 38 for dimension A.


OUTSIDE TEMP.	DIM 'A' (MIN.)	DIM 'A' (MIN.)	DIM 'A' (MIN.)
40°	3 $\frac{1}{16}$ "		
50°	3 $\frac{1}{16}$ "		
60°	3 $\frac{1}{16}$ "		
70°	3 $\frac{1}{16}$ "		
80°	2 $\frac{13}{16}$ "		
90°	2 $\frac{3}{4}$ "		
100°	2 $\frac{1}{2}$ "		

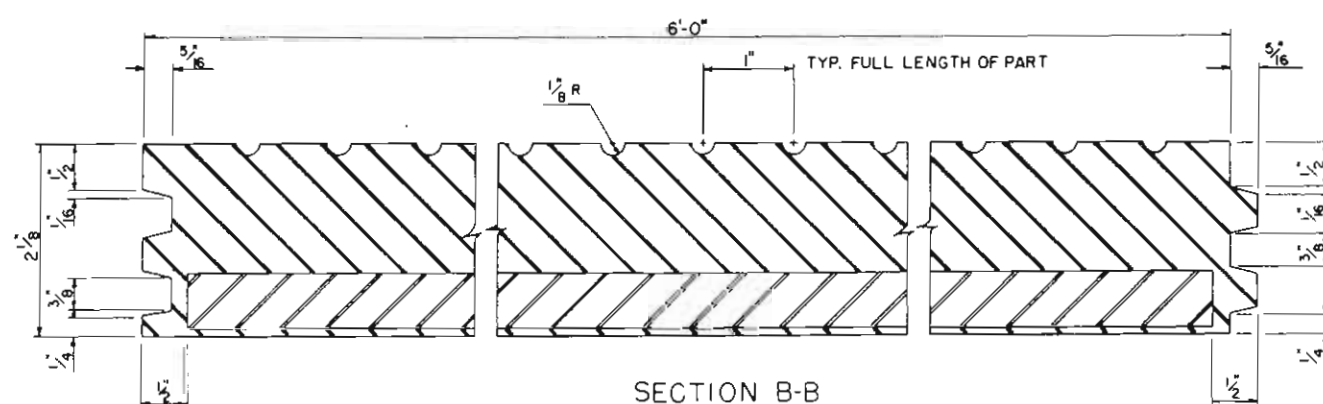

SECTION B-B

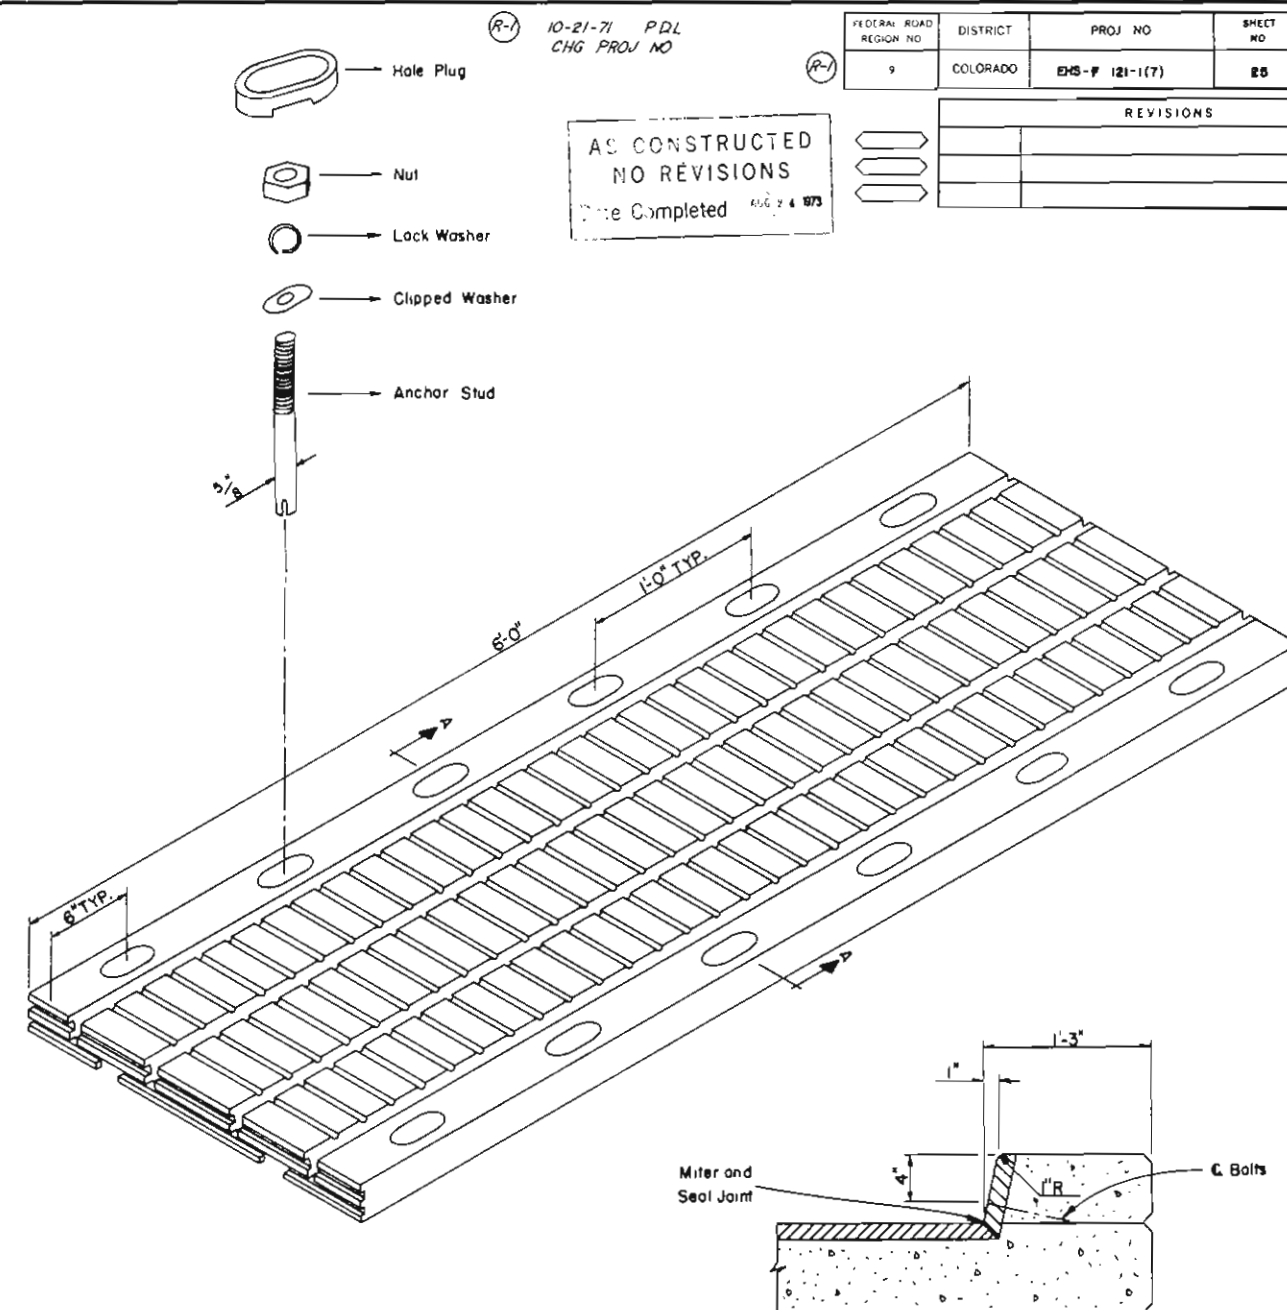

TYPICAL SECTION @ CURB

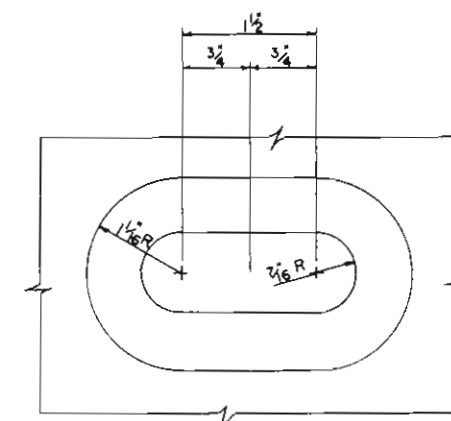

SECTION C-C

FEDERAL ROAD REGION NO	DISTRICT	PROJ NO	SHEET NO	TOTAL SHEETS
9	COLORADO	EHS-F 121-1(7)	25	

AS CONSTRUCTED
NO REVISIONS
Date Completed AUG 24 1973


REVISIONS	

DIVISION OF HIGHWAYS		
BRIDGE EXPANSION DEVICE		
PREMOLDED (TYPE IV)		
Approved	Designer <i>BSMH</i>	Detailer
Bridge Engineer	Structure Numbers	<i>E-16-HR</i>
		<i>E-16-HS</i>
Date	DWG. No. <i>B</i> of <i>OF</i>	


FEDERAL ROAD DISTRICT	PROJ. NO.	SHEET NO.	TOTAL SHEETS
9	COLORADO	121-117	28

AS CONSTRUCTED
NO REVISIONS
Date Completed DEC 24 1973


REVISIONS	
10-21-71	Added Bearing Plate Det GLB
	CHG PROJ NO PDL

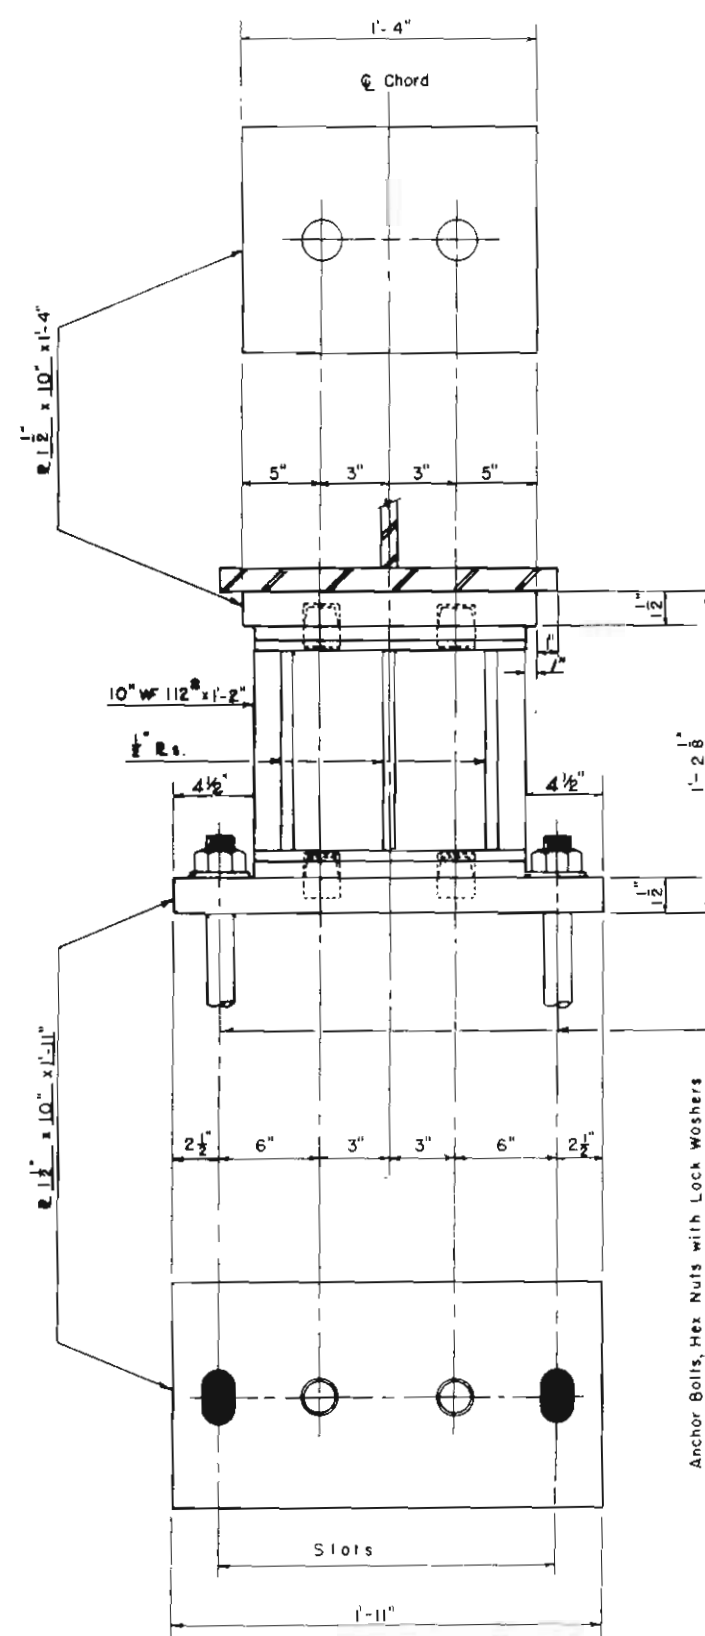


EXPANSION BEARING
18 Req'd

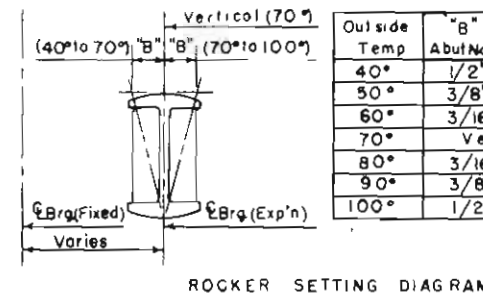

ROCKER SETTING DIAGRAM

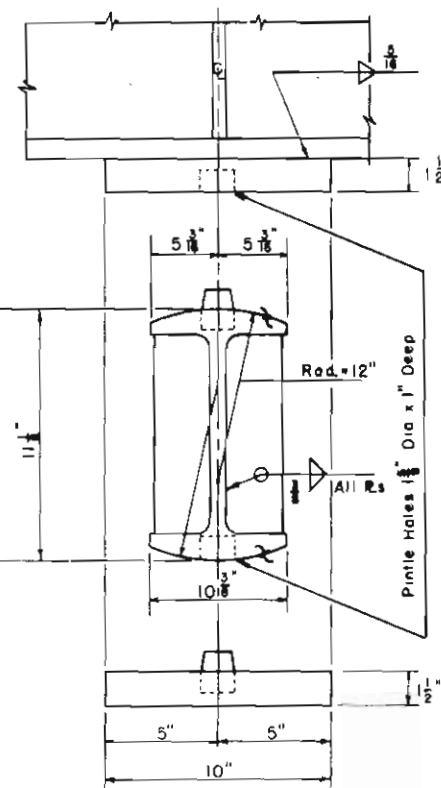


TYPICAL ELEVATIONS

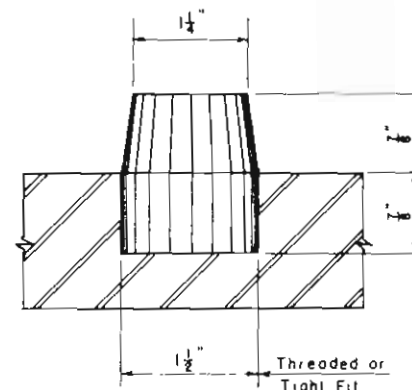


PINTLE DETAIL

DETAILS OF BEARINGS

Rocker may be built from plates equal in thickness to designated WF Section or may be made from Cast Steel

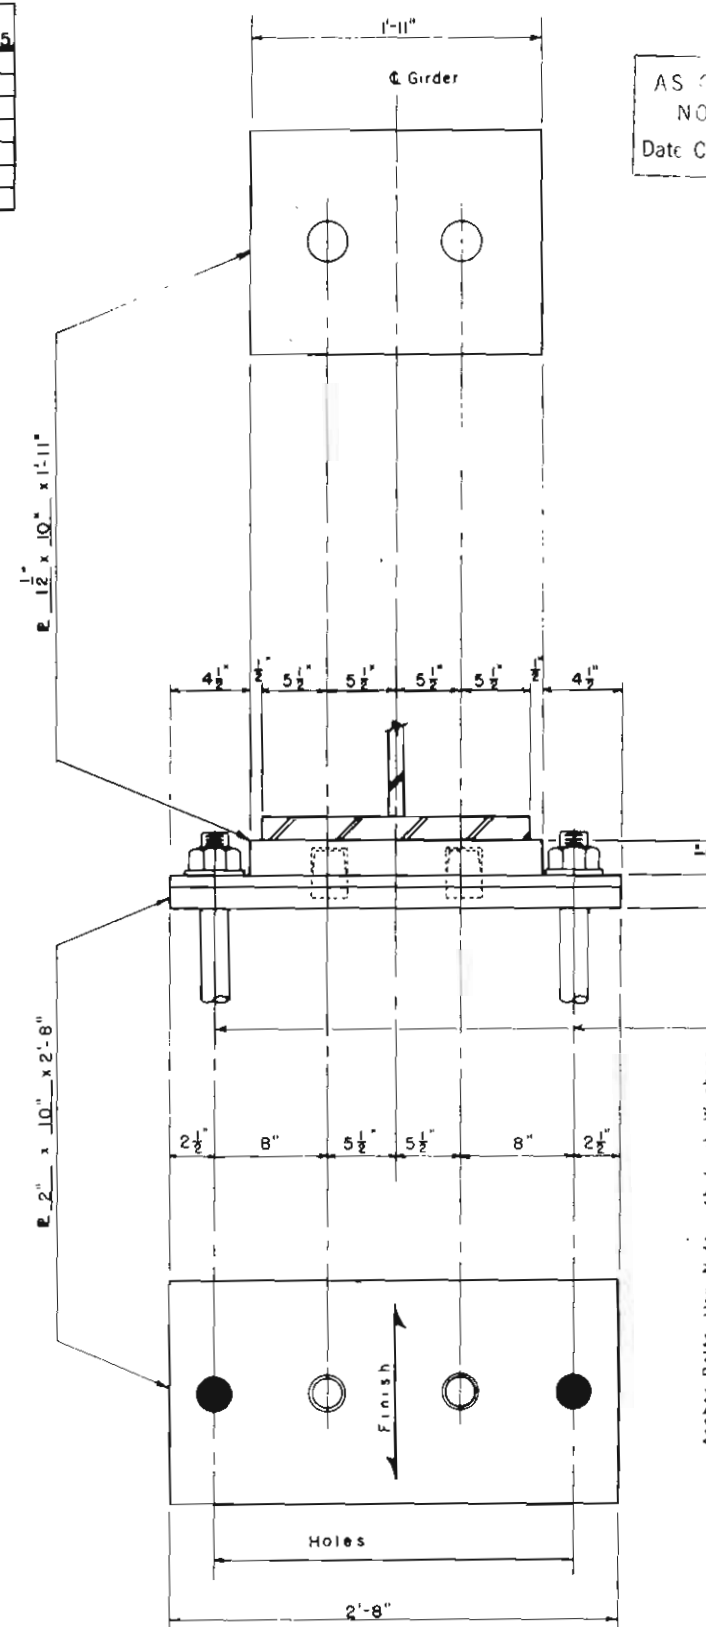


FIXED BEARING
27 Req'd

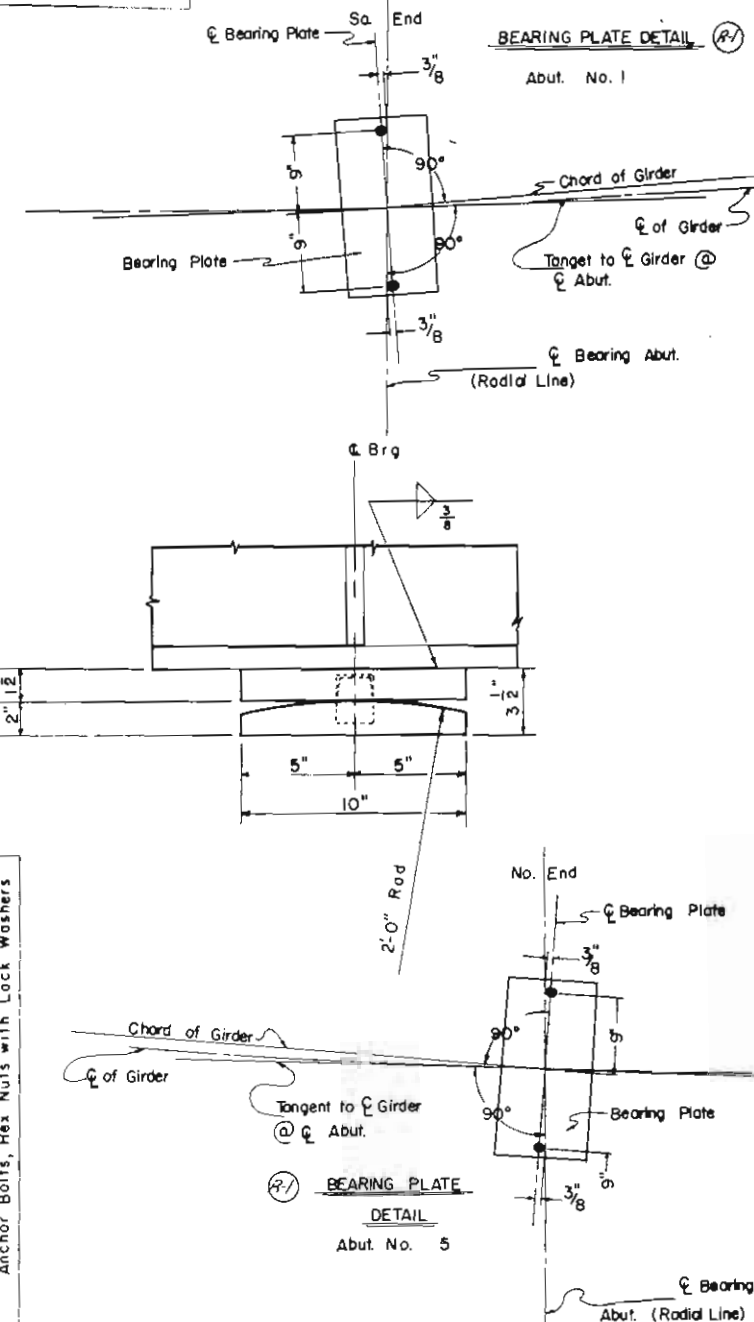


DIVISION OF HIGHWAYS

BEARING DETAIL


Approved	Designer	B.S.M.H.	Detailer
Bridge Engineer	Structure	E-10-HS	S.B.L.
	Numbers	E-10-HR	N.B.L.
Date	DWG. No.	B	OF

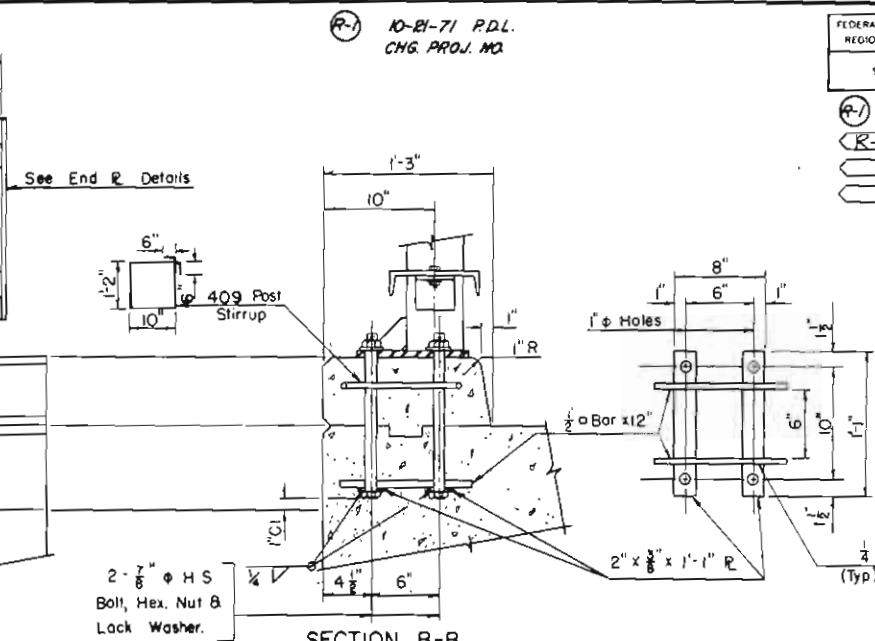


END ANCHORED POST
No. Req'd. 8 S.B. Struct.
No. Req'd. 8 N.B. Struct.

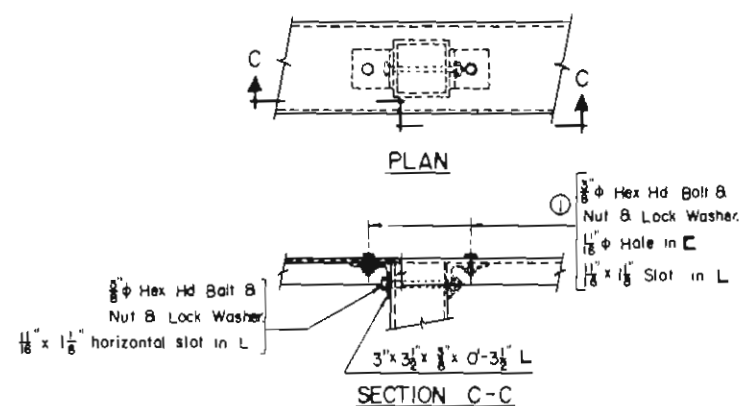


DETAIL AT TOP RAIL

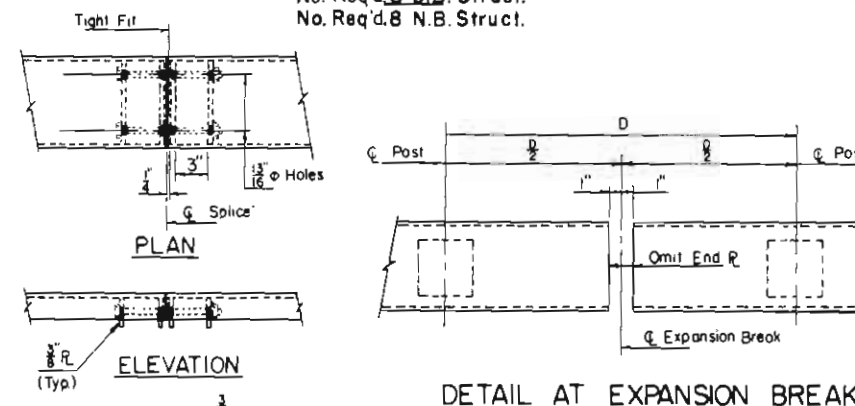


DETAIL AT EXPANSION BREAK

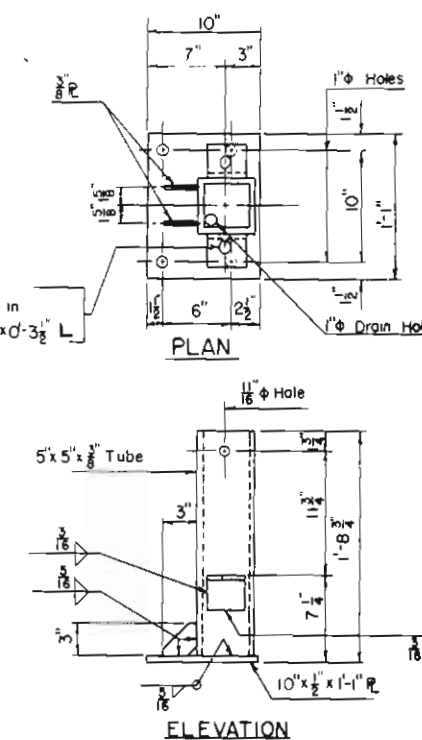

POST DETAIL

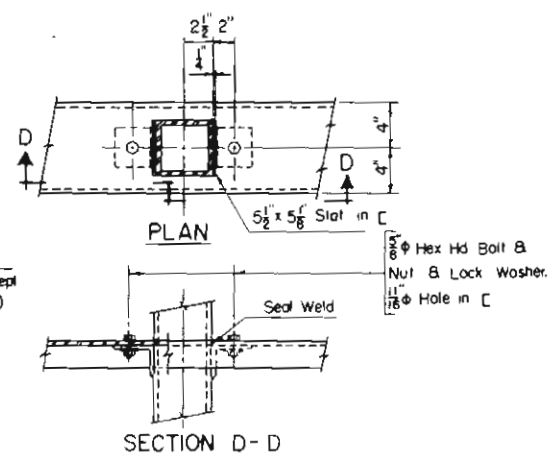

DETAIL AT BOTTOM RAIL

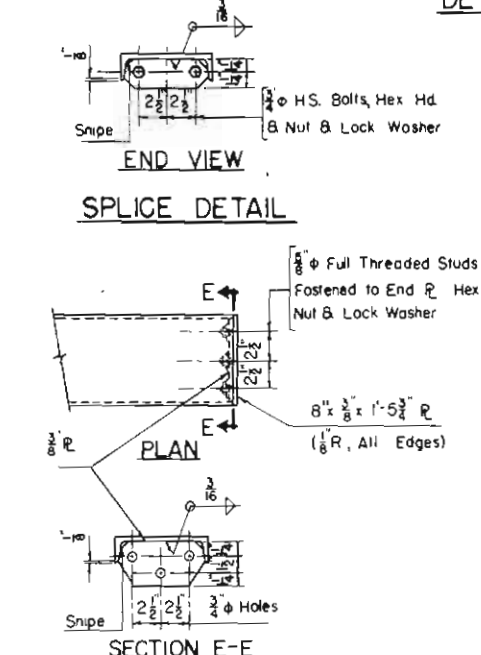

END PLATE DETAIL
No. Req'd 8 S.B. Struct.
No. Req'd 8 N.B. Struct.

R-2 Posts shall be perpendicular to grade and slope of the top of curb.

All rail elements, anchor assemblies, anchor bolts, nuts and washers shall be galvanized after fabrication in accordance with the specifications.

AISI 1144 Steel Rods May Be Used In Lieu Of H.S Bolts Shown.

10° Wedge Test Not Req For Either Bolts Or Rods Used In Rail Assembly.

① $\frac{1}{8}$ " Standard Full Threaded Studs Welded To The Channel May Be Used To Increase Size Of Slot In The Angle To $\frac{13}{16}$ " x $\frac{1}{4}$ "

Channels Shall Be Continuous Over 3 Or 4 Posts Before Splicing

When thru slab mounted posts are used, prior to setting the posts and tightening the bolts a perimeter band of caulking, grade polyurethane joint sealer, shall be placed on the concrete just inside the edges of the post base plate.

DETAILS OF GALVANIZED STEEL
BRIDGE RAIL

Complete Unit Shall Be Galvanized After Fabrication

Detail Shown is For Right Hand Rail.	No. Req'd <u>2 S.B.</u> Struct. & <u>2 N.B.</u> Struct.
Opposite Hand For Left Hand Rail	No. Req'd <u>2 S.B.</u> Struct. & <u>2 N.B.</u> Struct.


Approved	Designer	B.S.M.H.	Detailer
	Structure	E-1G-HS	
Bridge Engineer	Numbers	E-1G-HR	N.B.
	Date	DWG. No. B Of	

10-21-71 PDL
CHG. PROJ. NO

FEDERAL ROAD REGION NO.	DISTRICT	PROJ. NO.	SHEET NO.	TOTAL SHEETS
9	COLORADO	EHS-F 121-1(7)	28	

UNSTRUCTURED
NO REVISIONS
Date Completed 4/4/73

REVISIONS	

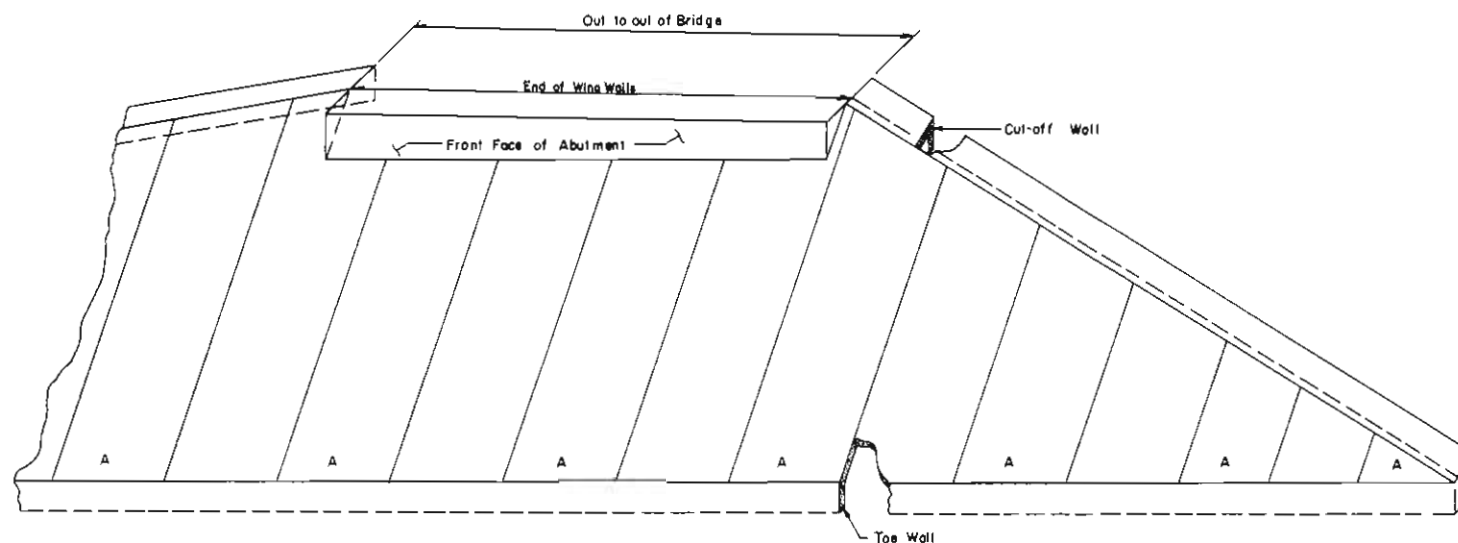

ELEVATION

NOTES

SLOPE PAVING SHALL BE POURED IN 10-FT. TRANSVERSE SECTIONS WITH A TOOLED CONSTRUCTION JOINT AT EACH SECTION.

WIRE FABRIC SHALL BE 2" FROM THE END OF JOINTS AND SHALL LAP 4" AT SPICES.

WHERE SLOPE OR BERM PAVING BUTTS AGAINST STRUCTURAL CONCRETE, SEPARATE WITH 1/2" EXPANSION JOINT MATERIAL. (INCLUDE IN BID PRICE FOR ITEM 507.)

TRANSITION ENDS OF SLOPE PAVING MAY BE MODIFIED BY THE ENGINEER TO FIT CONDITIONS ENCOUNTERED IN THE FIELD.

CONCRETE SHALL CONFORM TO THE REQUIREMENTS OF SECTION 601. (CONCRETE SHALL BE CLASS "B".)

ALL WORK NECESSARY BY THESE REQUIREMENTS SHALL BE INCLUDED IN THE BID PRICE FOR ITEM NUMBER 507.

PANELS MARKED THUS, "A", ARE TO RECEIVE AN EXPOSED AGGREGATE FINISH. AFTER THE CONCRETE IS STRUCK TO GRADE, THE SURFACE SHALL BE SPRAYED WITH AN APPROVED RETARDER. THE AMOUNT OF RETARDER SPRAYED ON THE SURFACE SHALL BE AS RECOMMENDED BY THE MANUFACTURER.


IN ALL CASES, THE EXPOSED AGGREGATE FINISH SHALL BE STARTED ON THE FIRST PANEL FACING ON-COMING TRAFFIC.

THE CONCRETE SHALL THEN BE ALLOWED TO SET, SETTING TIME SHALL BE DETERMINED BY THE ENGINEER. AFTER SETTING THE PRESCRIBED TIME, THE SURFACE SHALL BE BROOMED AND WASHED WITH WATER TO EXPOSE THE AGGREGATE.

THE EXPOSED AGGREGATE FINISH SHALL THEN BE SPRAYED WITH A CLEAR CURING COMPOUND.

COARSE AGGREGATE USED IN EXPOSED AGGREGATE PANELS SHALL BE COMPOSED PREDOMINANTLY OF STONE CONTRASTING IN COLOR TO THAT OF NORMAL CONCRETE IN ADJACENT PANELS.

COARSE AGGREGATE SHALL MEET THE REQUIREMENTS OF AASHTO DESIGNATION M 43 SIZE NUMBER 6.

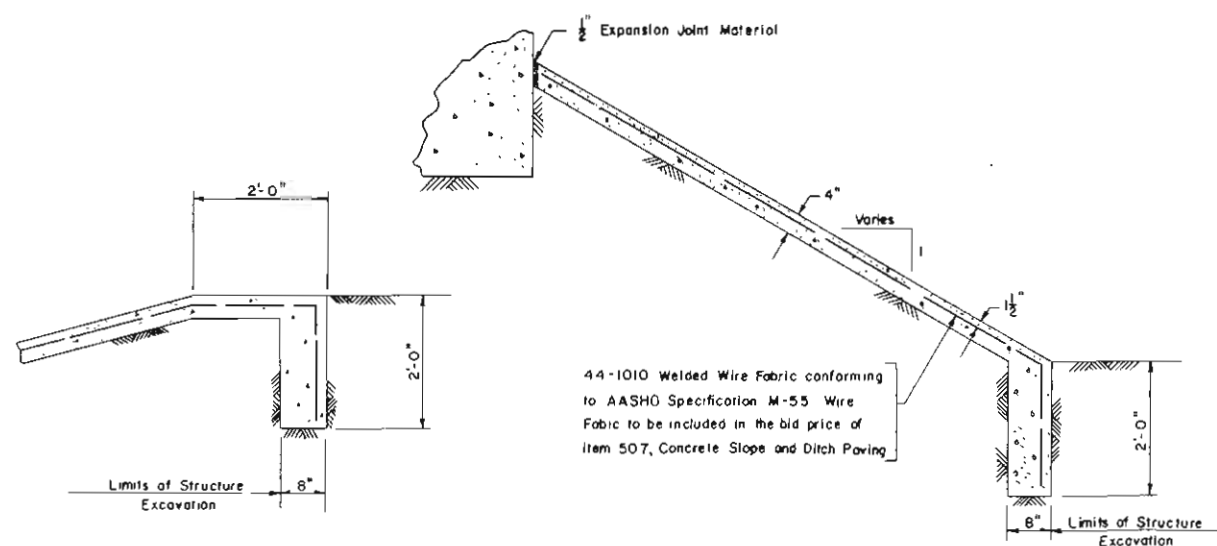

SECTION THRU CUT-OFF WALL

SECTION THRU SLOPE PAVING

DIVISION OF HIGHWAYS

SLOPE PAVING DETAILS

Approved	Designer: BSMH	Detailer:
Bridge Engineer	Structure Numbers	
Date:	DWG. No. B	OF

Note: Bars 5100 to 5106, 5117 to 5123, 5132 to 5138 and 5149 to 5155 have been set in incremental groups by which to approximate the curved pier sides.

BAR LIST - SUPERSTRUCTURE

MARK	NO. REQ'D.		LENGTH	TYPE	DIMENSIONS	
	S.B. STR. E-16-HS	N.B. STR. E-16-HR			ℓ	m
401	432		29'-8"	STR.		
402	64		29'-8"	STR.		
403	64		28'-8"	STR.		
404	905		2'-8"	I		
405		902	2'-8"	I		
406		64	29'-8"	STR.		
407		64	28'-8"	STR.		
408		304	29'-8"	STR.		
409	120	120	3'-0"	II	10"	1'-2"
501	2170		21'-9"	STR.		
502	1085		17'-5"	STR.		
503	1085		25'-1"	STR.		
504	572		36'-6"	STR.		
505		416	36'-3"	STR.		
506		2152	30'-2"	STR.		
512	2			STR.		
901	249		34'-8"	STR.		
902		169	34'-8"	STR.		

BAR LIST - ABUT. No.1 (ABUT. No.5 Similar)

MARK	NO. REQ'D.		LENGTH	TYPE	DIMENSIONS	
	S.B. STR. E-16-HS	N.B. STR. E-16-HR			ℓ	m
420	30	24	11'-9"	II		
421		18	30'-2"	STR.		
422	15	12	9'-2"	IV	5"	2'-2"
423	15	12	2'-8"	STR.		
424	44	31	8'-2"	STR.		
425	29	21	8'-10"	STR.		
426	44	31	4'-0"	X		
427	38		21'-7"	STR.		
428	4	4	9'-10"	STR.		
429			7'-10"			
TO	4 EA.	4 EA.	8 E.I.	STR.		
431			1'-6"			
435	4	4	9'-2"	STR.		
436	12	12	8'-2"	IV		
437	6	6	10'-8"	II	9'-8"	1'-0"
438			10'-6"		9'-6"	1'-0"
TO	2 EA.	2 EA.	8 E.I.	STR.		
443			1'-7"		7"	1'-0"
444	4	4	12'-5"	IV	6'-1"	4"
445	8	8	5'-8"	IV	2'-8"	4"
511		1	30'-2"	STR.		
512	1		21'-7"	STR.		
513	2	2	10'-8"	II	9'-8"	1'-0"
514			10'-6"		9'-6"	1'-0"
TO	2 EA.	2 EA.	8 E.I.	STR.		
528			1'-7"		7"	1'-0"
601		6	30'-2"	STR.		
602	6		42'-2"	STR.		

BAR LIST - PIERS

MARK	NUMBER REQUIRED						LENGTH	TYPE	DIMENSIONS	
	S.B. STR. E-16-HS	N.B. STR. E-16-HR	PIER 2	PIER 3	PIER 4	PIER 2			ℓ	m
450			2	2	2		14'-6"	II	14'-0"	8"
451			2	2	2		29'-6"	I	28'-6"	
452							28'-2"		27'-2"	
TO			2 EA.	2 EA.	2 EA.		8 E.I.		8 E.I.	
458							18'-8"		17'-8"	
459							17'-8"		16'-8"	
TO			2 EA.	2 EA.	2 EA.		8 E.I.		8 E.I.	
465							12'-2"		11'-2"	
466							11'-6"		10'-6"	
TO			2 EA.	2 EA.	2 EA.		8 E.I.		8 E.I.	
472							9'-0"		8'-0"	
473	16	22	16	22	28	24	8'-8"	I	7'-8"	
474	190	200	190	176	188	180	4'-5"	I	3'-5"	
480	2	2	2				17'-0"	II	17'-0"	6"
481	2	2	2				39'-8"	I	38'-8"	
482							37'-11"		36'-11"	
TO	2 EA.	2 EA.	2 EA.				8 E.I.		8 E.I.	
487							26'-4"		25'-4"	
488							24'-7"		23'-7"	
TO	2 EA.	2 EA.	2 EA.				8 E.I.		8 E.I.	
493							17'-8"		16'-8"	
494							16'-4"		15'-4"	
TO	2 EA.	2 EA.	2 EA.				8 E.I.		8 E.I.	
499							12'-2"		11'-2"	
4100							11'-8"		10'-8"	
TO	2 EA.	2 EA.	2 EA.				8 E.I.		8 E.I.	1'-10"
4105							9'-4"	I	8'-4"	
4108							11'-8"		11'-8"	
TO	2 EA.	2 EA.	2 EA.				8 E.I.		8 E.I.	8"
4113							8'-0"		7'-8"	
4114	15	15	15	12	12	12	2'-0"	I	1'-0"	
4115	10	10	10	8	8	8	2'-10"	STR.		
4116							8'-2"		3'-5"	
TO			2 EA.	2 EA.	2 EA.		8 E.I.		8 E.I.	
4121							5'-8"		1'-8"	
512										
549			2	2	2		2'-8"	I	1'-8"	
550							4'-4"		3'-4"	
TO			2 EA.	2 EA.	2 EA.		8 E.I.		8 E.I.	
554							11'-4"		10'-4"	
555			2	2	2		14'-8"	I	13'-8"	
556							10'-10"	II	1'-6"	3'-5"
557							14'-8"		3'-4"	
TO			1 EA.	1 EA.	1 EA.		8 E.I.		8 E.I.	3'-5"
561							28'-8"		10'-4"	
562							35'-2"	II	13'-8"	3'-5"
563							44'-8"	II	18'-4"	
564							2'-4"		1'-4"	
TO			2 EA.	2 EA.	2 EA.		8 E.I.		8 E.I.	
566							7'-11"		6'-11"	
568			2	2	2		10'-4"	I	9'-4"	
570			2	2	2		13'-4"	I	12'-4"	
571							10'-6"		1'-4"	
TO			1 EA.	1 EA.	1 EA.		8 E.I.		8 E.I.	3'-5"
575							21'-8"		6'-11"	
576							26'-6"	II	9'-4"	3'-5"
577							32'-6"	II	12'-4"	
578							41'-2"	II	16'-8"	
579	16	16	16	12	12	12	8'-2"	II	6'-2"	2'-0"
580							28'-7"	II	28'-7"	
591	6	6	6				36'-0"	II	36'-0"	
592							3'-8"		2'-8"	
TO	2 EA.	2 EA.	2 EA.				8 E.I.		8 E.I.	
596							5'-0"		4'-0"	
597	2	2	2				5'-8"	I	4'-8"	
598	2	2	2				6'-2"	I	5'-2"	
599	7	2	2				6'-8"	I	5'-8"	
5100							7'-7"		6'-7"	
TO	2 EA.	2 EA.	2 EA.				8 E.I.		8 E.I.	
5103							13'-2"		12'-2"	
TO	2 EA.	2 EA.	2 EA.				8 E.I.		8 E.I.	
5106							23'-5"		22'-5"	
5107							9'-10"	II	1'-0"	3'-5"


BAR LIST - PIERS (CONT'D.)

MARK	NUMBER REQUIRED						LENGTH	TYPE	DIMENSIONS	
	S.B. STR. E-16-HS			N.B. STR. E-16-HR					ℓ	m
	PIER 2	PIER 3	PIER 4	PIER 2	PIER 3	PIER 4				
5108	1	1	1				11'-8"	II	1'-11"	3'-5"
5109							13'-8"		2'-11"	
TO	1 EA.	1 EA.	1 EA.				8 E.I.	II	8 E.I.	3'-5"
5113							15'-10"		4'-0"	
5114	1	1	1				17'-2"	II	4'-8"	3'-5"
5115	1	1	1				18'-2"	II	5'-2"	"
5116	1	1	1				19'-2"	II	5'-8"	"
5117							21'-0"		6'-7"	
TO	1 EA.	1 EA.	1 EA.				8 E.I.	II	8 E.I.	3'-5"
5120							32'-2"		12'-2"	
TO	1 EA.	1 EA.	1 EA.				8 E.I.	II	8 E.I.	3'-5"
5123							52'-8"		22'-5"	
5124							3'-5"		2'-5"	
TO	2 EA.	2 EA.	2 EA.				8 E.I.	X	8 E.I.	
5128							4'-5"		3'-5"	
5129	2	2	2				4'-11"	X	3'-11"	
5130	2	2	2				5'-2"	X	4'-2"	
5131	2	2	2				5'-11"	X	4'-11"	
5132							6'-5"		5'-5"	
TO	2 EA.	2 EA.	2 EA.				8 E.I.	X	8 E.I.	
5135							11'-8"		10'-8"	
TO	2 EA.	2 EA.	2 EA.				8 E.I.	X	8 E.I.	
5138							21'-2"		20'-2"	
5139	1	1	1				9'-10"	II	1'-0"	3'-5"
5140	1	1	1				11'-2"	II	1'-8"	"
5141							12'-6"		2'-4"	
TO	1 EA.	1 EA.	1 EA.				8 E.I.	II	8 E.I.	3'-5"
5145							14'-6"		3'-6"	
5146	1	1	1				15'-8"	II	3'-11"	"
5147	1	1	1				16'-4"	IV	4'-3"	"
5148	1	1	1				17'-8"	IV	4'-11"	"
5149							19'-0"		5'-7"	"
TO	1 EA.	1 EA.	1 EA.				8 E.I.	II	8 E.I.	3'-5"
5152							20'-2"		10'-8"	
TO	1 EA.	1 EA.	1 EA.				8 E.I.	II	8 E.I.	
5155							48'-2"		20'-2"	"
803					25		8'-8"	STR.		
801					20		35'-0"	STR.		
802					10		18'-0"	STR.		
803					30		6'-3"	STR.	4'-11"	1'-4"
903					51	51	15'-8"	STR.		
904					21		16'-5"	STR.		
910	29		29				12'-2"	STR.		
911	20		20				14'-2"	STR.		
912		19					11'-2"	STR.		
913		26					15'-8"	STR.		
1001					6	6	30'-2"	STR.		
1002	12	12	12				42'-2"	STR.		
1101		42					7'-10"	STR.	5'-10"	2'-0"
1102		12					18'-0"	STR.		
1103		30					35'-0"	STR.		
1401	21		21	15		15	7'-8"	STR.	5'-1"	2'-7"
1402	21		21	15		15	13'-8"	STR.	11'-1"	"
1403	6		6	15		15	16'-0"	STR.		
1404				10			31'-0"	STR.		
1405				10			25'-0"	STR.		
1406						10	30'-6"	STR.		
1407						10	24'-6"	STR.		
1408	6		6				10'-0"	STR.		
1410	15						31'-3"	STR.		
1411	15						25'-3"	STR.		
1412			15				30'-3"	STR.		
1413			15				24'-3"	STR.		


10-21-71 P.D.L.
CHG. PROJ. NO.

FEDERAL ROAD REGION NO	DISTRICT	PROJ NO	SHEET NO	TOTAL SHEETS
9	COLORADO	EMS - F 121-1(7)	30	

AS CONSTRUCTED
NO REVISIONS
Date Completed. Aug 8 1973

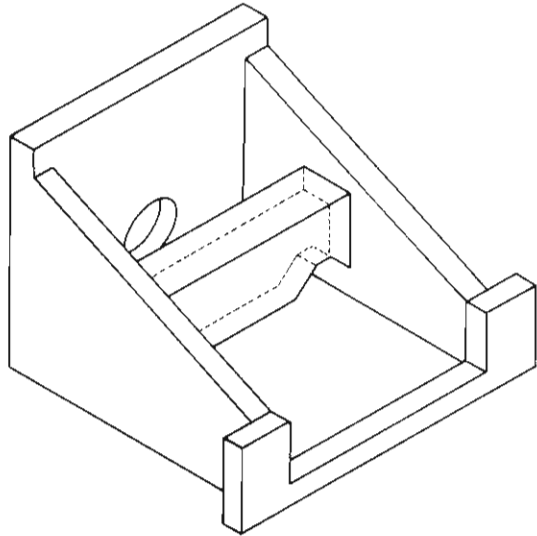


ISOMETRIC VIEW

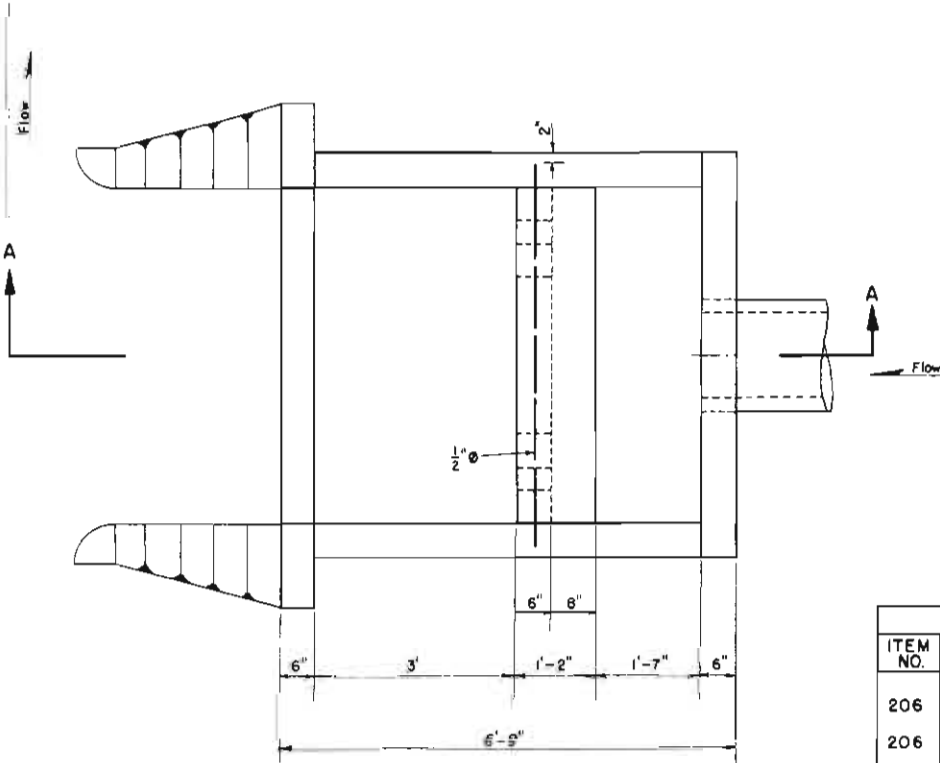


PLAN

SUMMARY OF APPROXIMATE QUANTITIES			
ITEM NO.	ITEM	UNIT	QUANTITY (Ea.)
206	Str. Excav.	Cu Yds.	10.0
206	Str. Backfill (Class 3)	Cu Yds.	3.7
601	Class "A" Concrete	Cu Yds.	2.2
602	Reinforcing Steel	lbs.	4.1

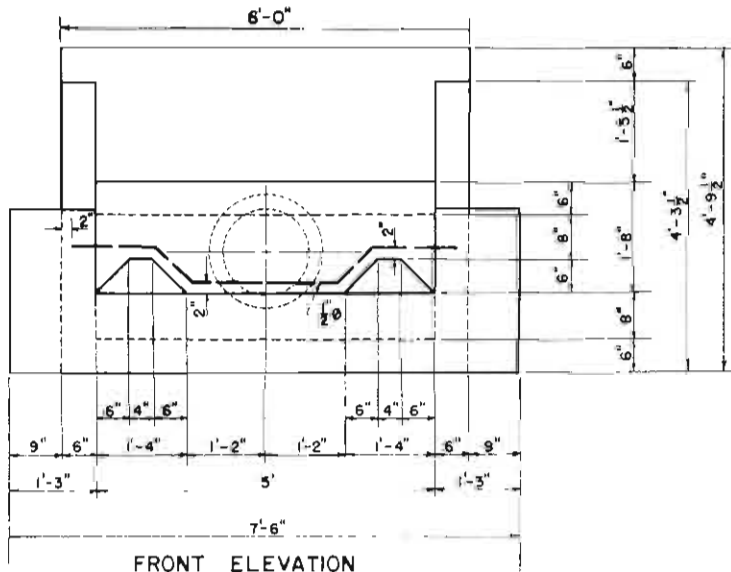

FRONT ELEVATION

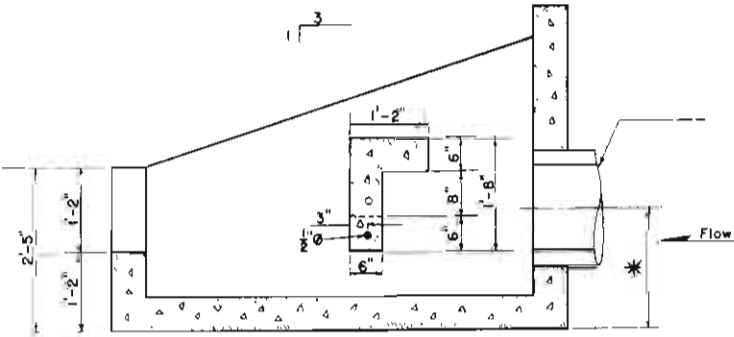

SECTION A-A

* 18" Pipe - 1'-11"
24" Pipe - 2'-2"

ENERGY DISSIPATOR DETAIL
ORIG SCALE 3/4" = 1'-0"





ENERGY DISSIPATOR END SECTIONS		
STATION	SIDE	QUANTITY
Mainline:		
521 + 60	L1	1
528 + 35	R1	1

10-21-71 P.D.L.
CHG. PROJ. NO.

FEDERAL ROAD REGION NO.	DIVISION	PROJ. NO.	SHEET NO.	TOTAL SHEETS
9	COLORADO	EHS-F 121-1 (7)	31A	

(R-1)

CONSTRUCTED
WITH REVISIONS
Completed 11/14/73

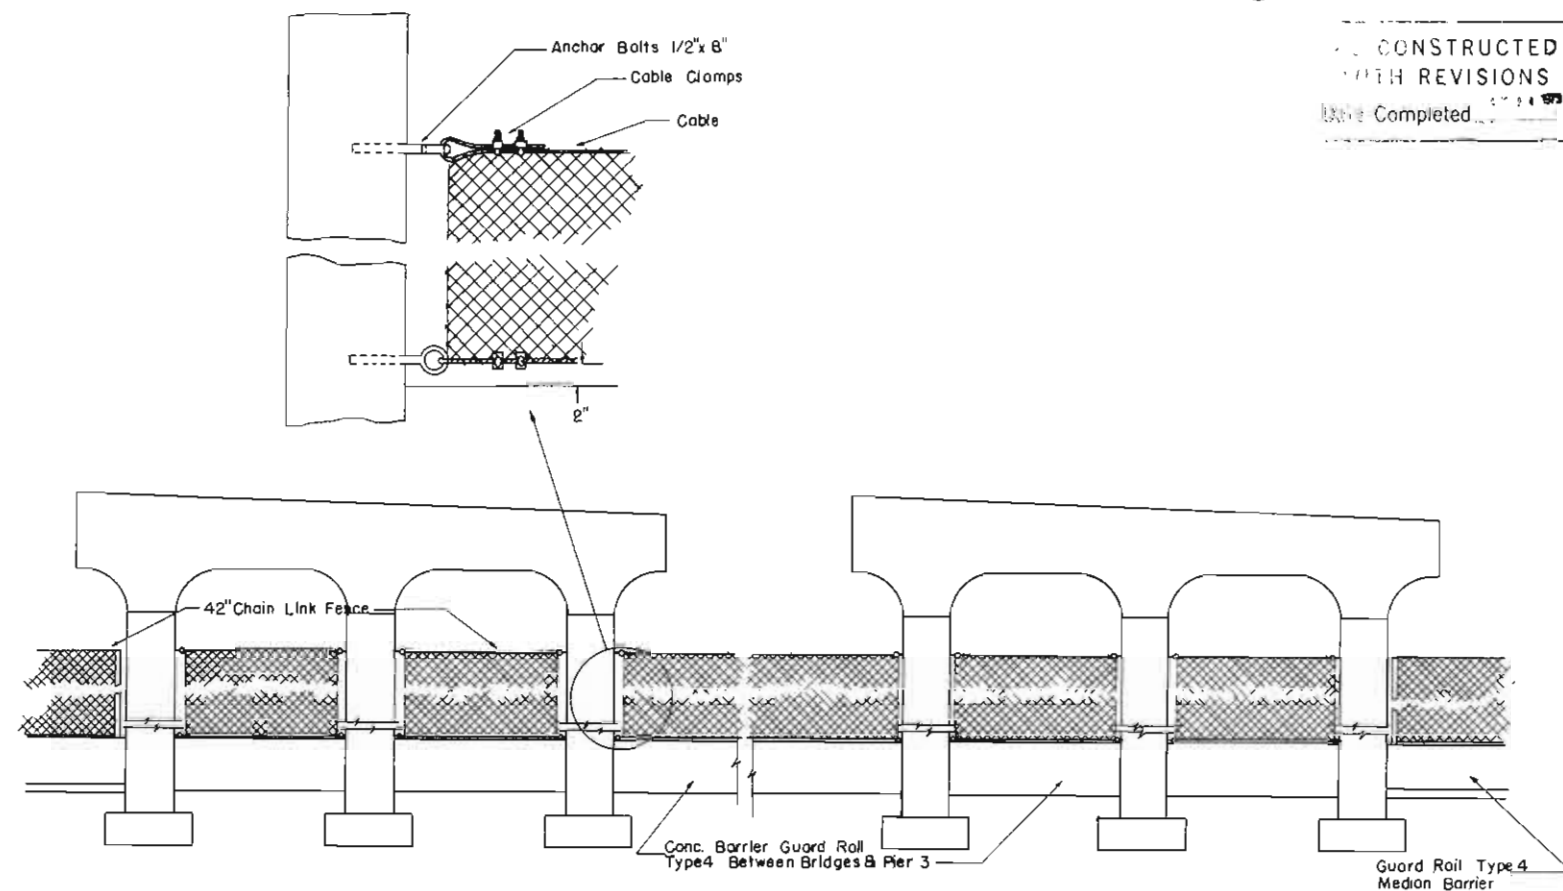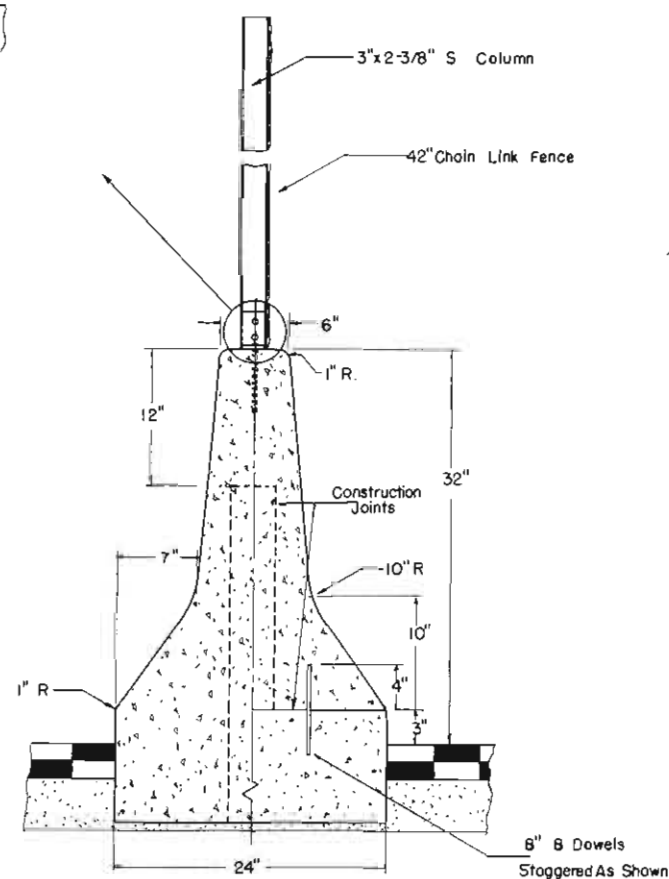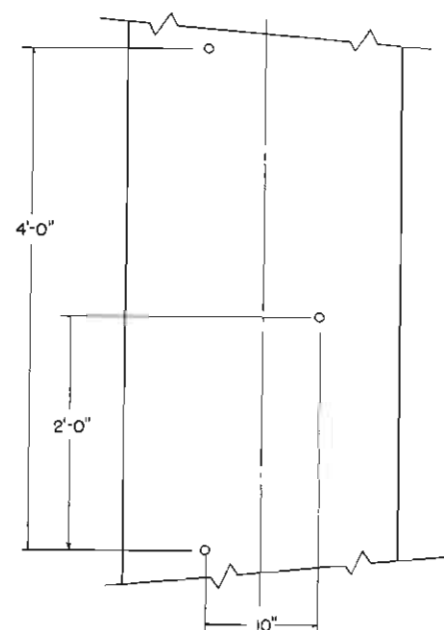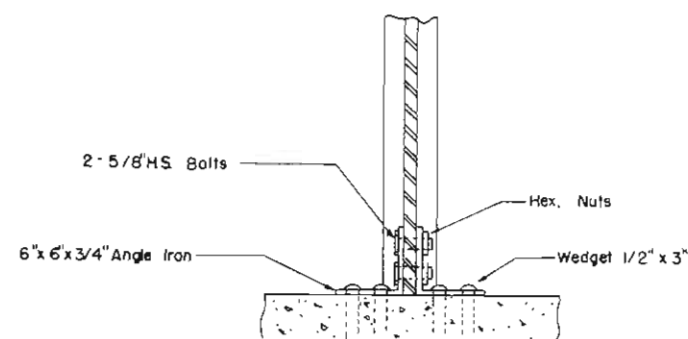


POST	60 ea.
IRON	120 ea.
BOLTS 5/8"	120 ea.
WEDGET	240 ea.
LINK FENCE	684 ft 688
EYE BOLTS	20 ea.
CABLE	168 ft


CHAIN LINK FENCE DETAIL
STA 653+00 TO STA 660+00 on U.S. 36

(R-1) 10-21-71 P.D.L.
CHG. PROJ. NO.


FED. ROAD REGION NO.	STATE	PROJECT NO.	SHEET NO.	TOTAL SHEETS
9	COLO.	EHS-F 121-1 (7)	24	

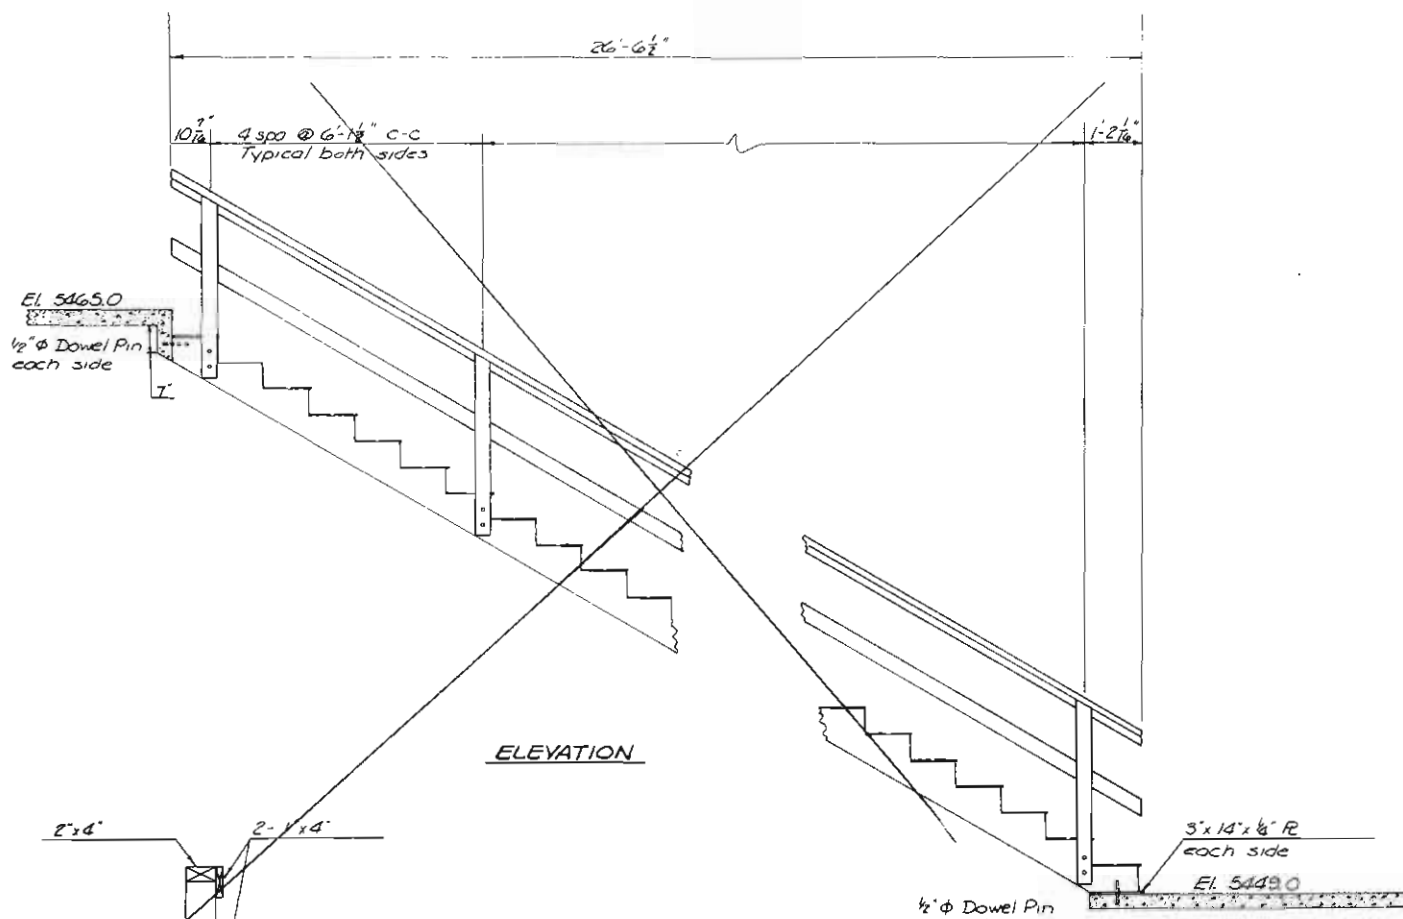

ELEVATION

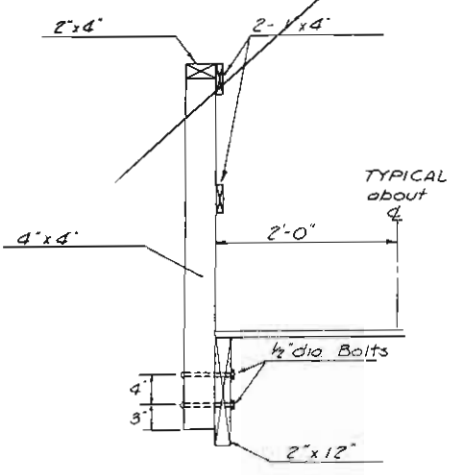

POST DETAIL

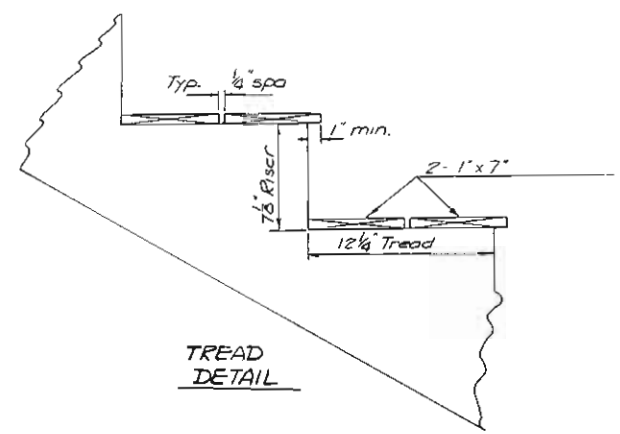


TREAD DETAIL

Note:
All size dimensions shown
for wood are nominal


Deleted LO 09478

BILL OF MATERIALS		
ITEM	UNIT	QUANTITY
1/2" φ x 4" Dowel Pins	Each	4
1/2" φ x 6" Bolts	Each	20
3" x 14" x 1/8" R	Each	2
2" x 4" x 30'-3" Hand Rail	Each	2
1" x 4" x 30'-3" Facing Strip	Each	4
4" x 4" x 8'-1" Post	Each	10
2" x 12" x 30'-3"	Each	2
1" x 7" x 4'-0" Treads	Each	52


STAIR DETAIL
Ramp 'C'

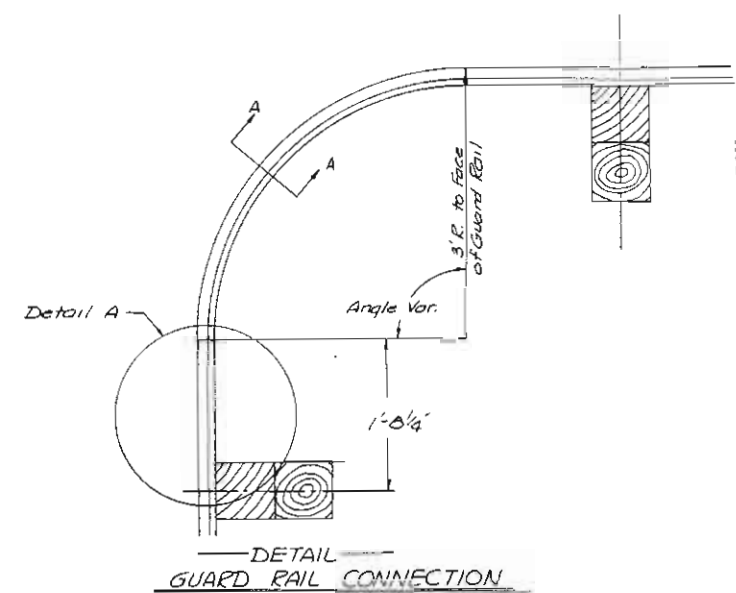

DETAIL
GUARD RAIL CONNECTION

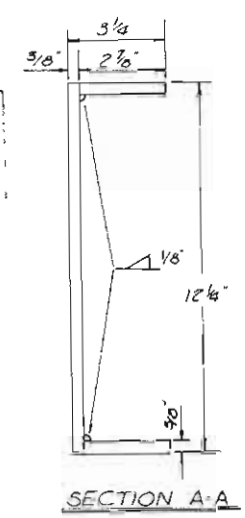


AS CONSTRUCTED
1 REVISIONS
Date Completed 5-1-72

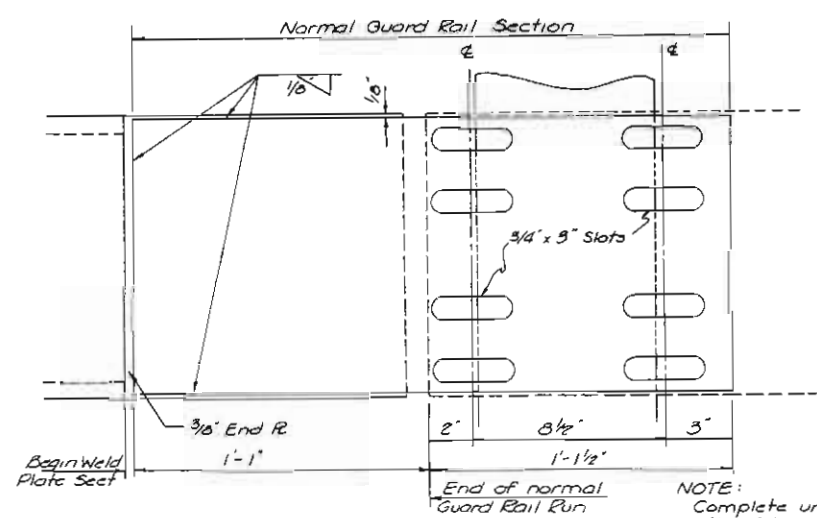

ELEVATION
DETAIL A

NOTE:
Complete unit shall be galvanized
after fabrication. Shall be paid
for as Lin Ft of guard rail, Type S.

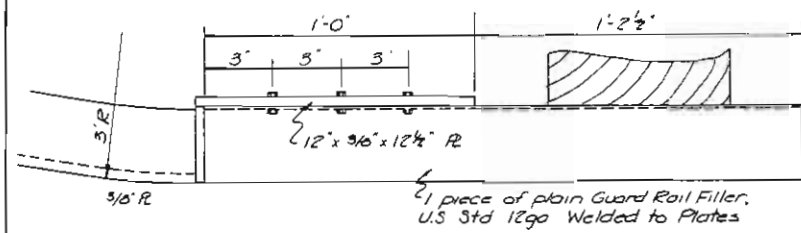

PLAN
DETAIL A

1 piece of plain Guard Rail Filler,
U.S. Std 12ga Welded to Plates

MISCELLANEOUS DETAILS


STATE FORCES
1. (After St.) Reg'd B-Reflectorized
R.R. Advance Warning Signs
(Work by State Forces)

FORCE ACCOUNT
1. (After St.) Reg'd R.R. Grade Crossing
(48 Ft in length), B-Flashing Light Signals
and Rearrange Railroad Facilities
(Work by Colo & Southern R.R. Co Forces)

10-21-71 P.D.L.
CHG. PROJ. NO.

FED. ROAD REGION NO.	STATE	PROJECT NO.	SHEET NO.	TOTAL SHEETS
9	COLO.	EHS-F 121-1 (7)	32	

AS CONSTRUCTED
WITH REVISIONS
Date Completed AUG 24 1973

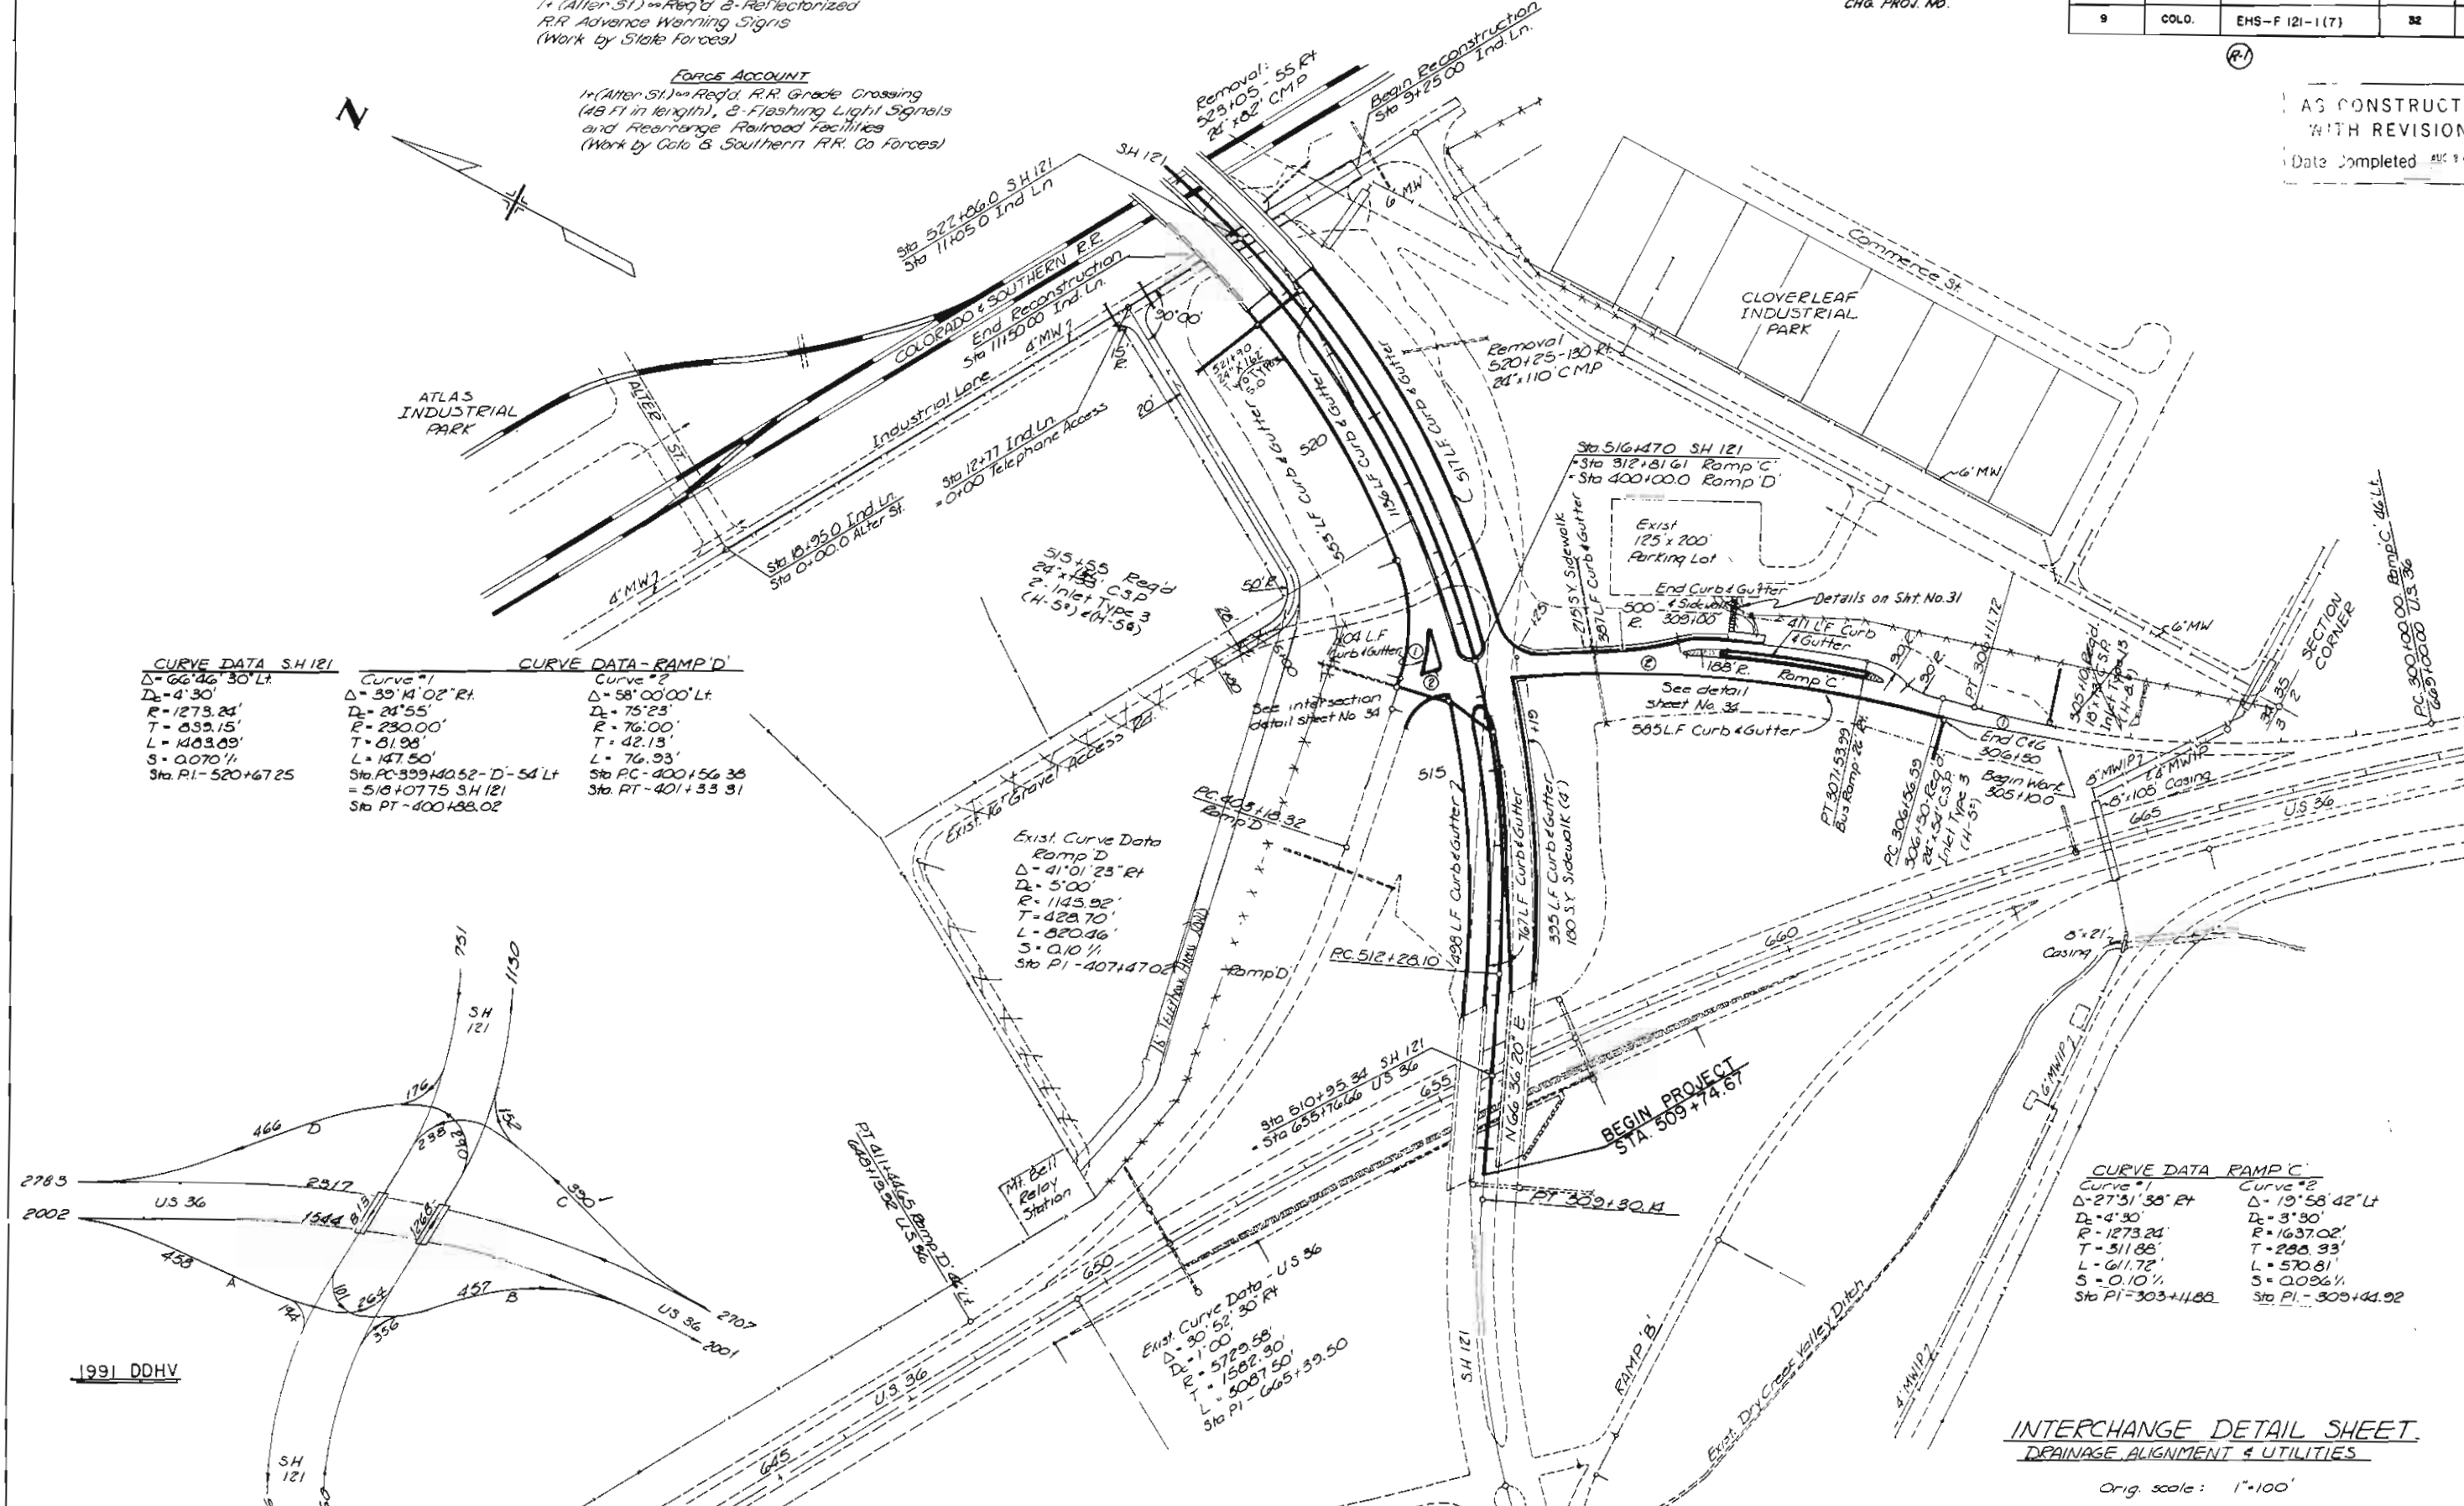

CURVE DATA SH 121
Δ = 66°46'30" Lt
D = 4°30'
R = 1273.24'
T = 833.15'
L = 1483.69'
S = 0.070 1/4
Sta. PI = 520+67.25

CURVE DATA - RAMP D
Curve #1
Δ = 39°14'02" Rt
D = 24°55'
R = 230.00'
T = 81.98'
L = 147.50'
Sta. PC = 399+40.52 - D' - 54 Lt
= 518+07.75 SH 121
Sta. PT = 400+68.02

CURVE DATA - RAMP D
Curve #2
Δ = 58°00'00" Lt
D = 75°23'
R = 76.00'
T = 42.13'
L = 76.93'
Sta. PC = 400+56.38
Sta. PT = 401+33.31

**Exist. Curve Data
Ramp D**
Δ = 41°01'25" Rt
D = 5°00'
R = 1143.92'
T = 428.70'
L = 820.46'
S = 0.10 1/4
Sta. PI = 407+47.02

CURVE DATA RAMP C
Curve #1
Δ = 27°51'38" Rt
D = 4°30'
R = 1273.24'
T = 511.88'
L = 611.72'
S = 0.10 1/4
Sta. PI = 303+44.88

CURVE DATA RAMP C
Curve #2
Δ = 19°58'42" Lt
D = 3°30'
R = 1637.02'
T = 288.33'
L = 570.81'
S = 0.036 1/4
Sta. PI = 309+44.92

INTERCHANGE DETAIL SHEET
DRAINAGE ALIGNMENT & UTILITIES

Orig. scale: 1" = 100'

1991 DQHV

FEDERAL ROAD REGION NO	DIVISION	PROJ NO	SHEET NO	TOTAL SHEETS
9	COLORADO	EHS-F 121-1(7)	33	

(R-1) 10-21-71 P.D.L.
CHG PROJ NO.

REVISION
Completed



ALTER ST

ENCLOSURE

END PROJECT
STA. 647+87.00
Sta. 647+87.0 SH 12
= E Midway Blvd.

INTERCHANGE DETAIL SHEET

ALIGNMENT & DRAINAGE & UTILITIES

CURVE DATA

CURVE #1 'F'	CURVE #2 'F'	CURVE #3 'F'	CURVE #4 'G'	CURVE #5 'G'	CURVE #6 'G'
Δ = 41°00'00" RT	Δ = 89°53'30" RT	Δ = 78°20'01" LT	Δ = 69°45'00" RT	Δ = 138°03'30" RT	Δ = 31°33'30" RT
D = 17°34'31"	D = 23°17'27"	D = 28°28'57"	D = 28°11'50"	D = 38°11'50"	D = 24°54'40"
T = 121.89'	T = 243.54'	T = 222.49'	T = 160.30'	T = 391.36'	T = 64.99'
R = 323.00'	R = 246.00'	R = 310.00'	R = 230.00'	R = 230.00'	R = 230.00'
L = 239.28'	L = 385.97'	L = 385.95'	L = 279.93'	L = 361.44'	L = 126.66'
STA PC ₁ = 640+02.81	STA PCC ₂ = 642+36.09	STA PCC ₃ = 646+22.06	STA PC ₄ = 640+22.30	STA PCC ₅ = 643+02.29	STA PCC ₆ = 646+63.73
STA PC ₁ = 642+36.09	STA PCC ₂ = 646+22.06	STA PC ₃ = 650+08.01	STA PCC ₄ = 643+02.29	STA PCC ₅ = 646+63.73	STA PC ₆ = 647+20.91

NOTE: AT STA 640+00.0, CONTROL LINE (E) shifts 28' LT for RAMP "F" & 28' RT for RAMP "G".

ORIG SCALE 1" = 50'

FED. ROAD REGION NO.	STATE	PROJECT NO.	SHEET NO.	TOTAL SHEETS
9	COLO.	ENS-F 121-1(7)	34	

(A-1) 10-21-71 R.D.L.
CHG. PROJ. NO.

AS CONSTRUCTED
WITH REVISIONS
Date Completed

(P1)


N

INTERSECTION DETAIL SHEET
RAMPS 'C' & 'D'

LEGEND:

- Point Stripe or Contrasting Pavement
- Shoulder

Orig Scale: 1"=20'

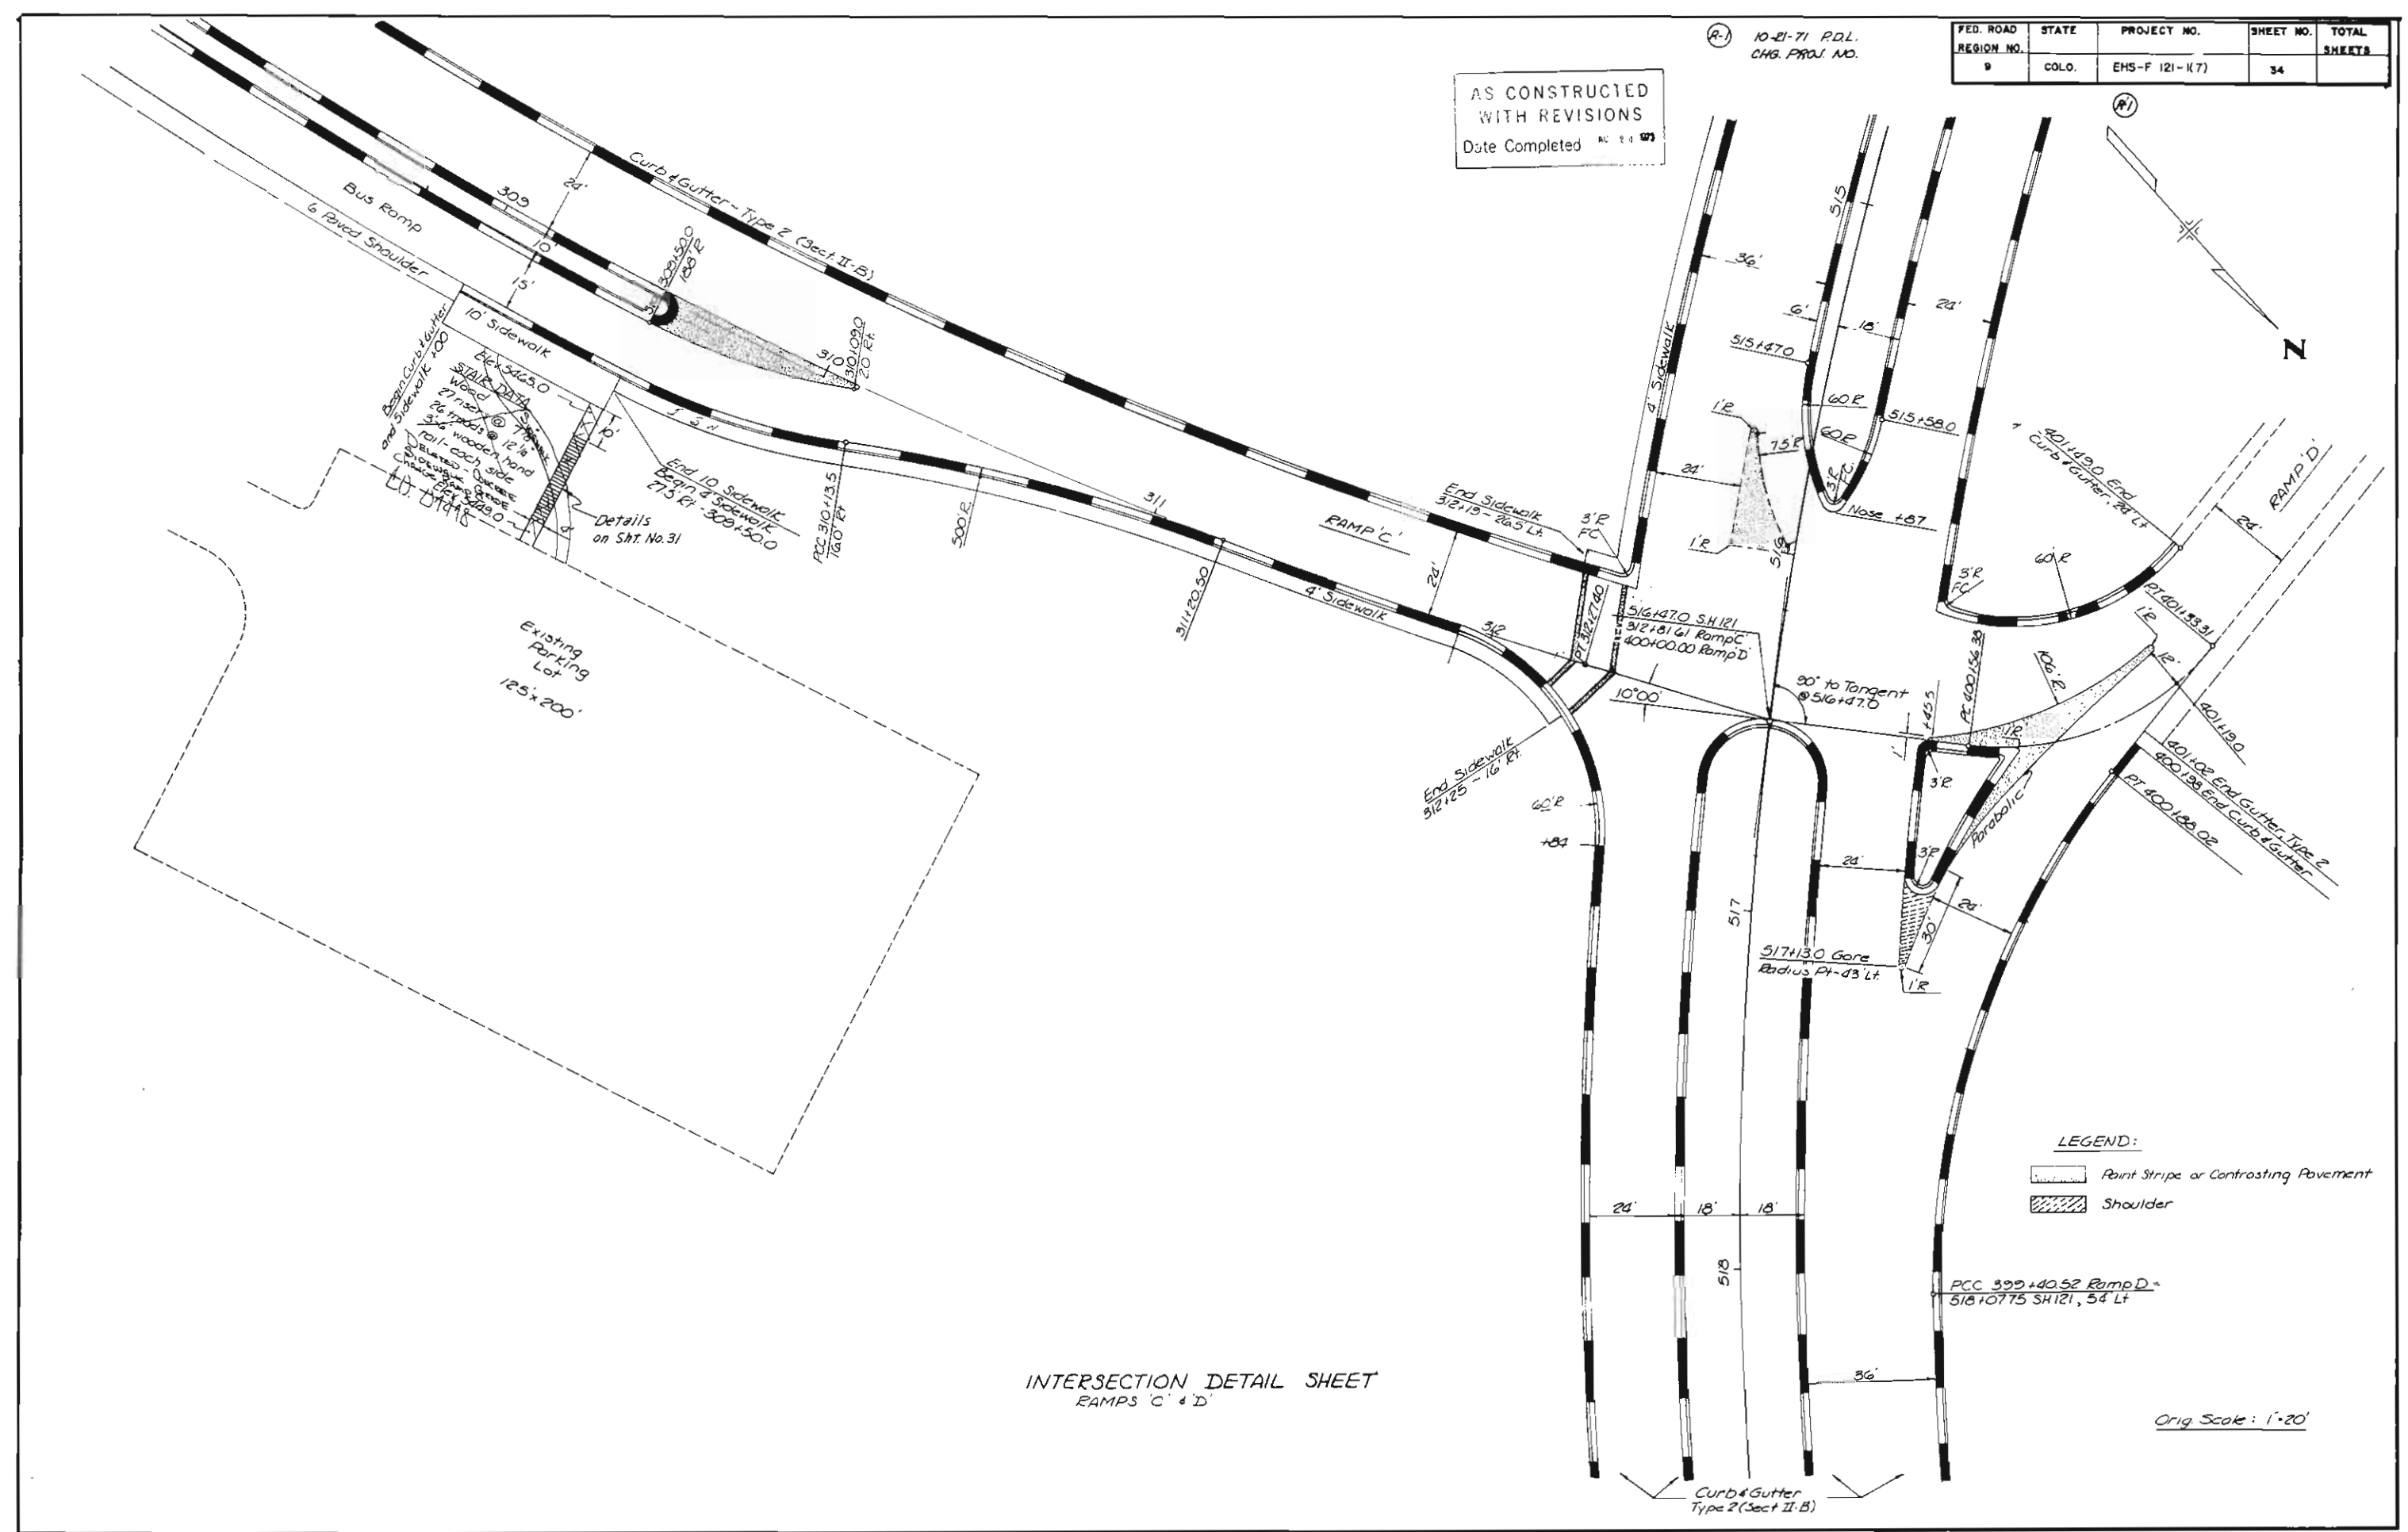


BROOMFIELD AND US 36 INTERCHANGE RAMP PROFILES

10-2171 R.D.L.
CND PROJ. NO.

FEDERAL ROAD REGION NO.	DIVISION	PROJ. NO.	SHEET NO.	TOTAL SHEETS
9	COLORADO	EHS-F (21-117)	36	

DATE	BY
REVIEWED	
DESIGNED	
CHECKED	
APPROVED	



DATE	BY
REVIEWED	
DESIGNED	
CHECKED	
APPROVED	

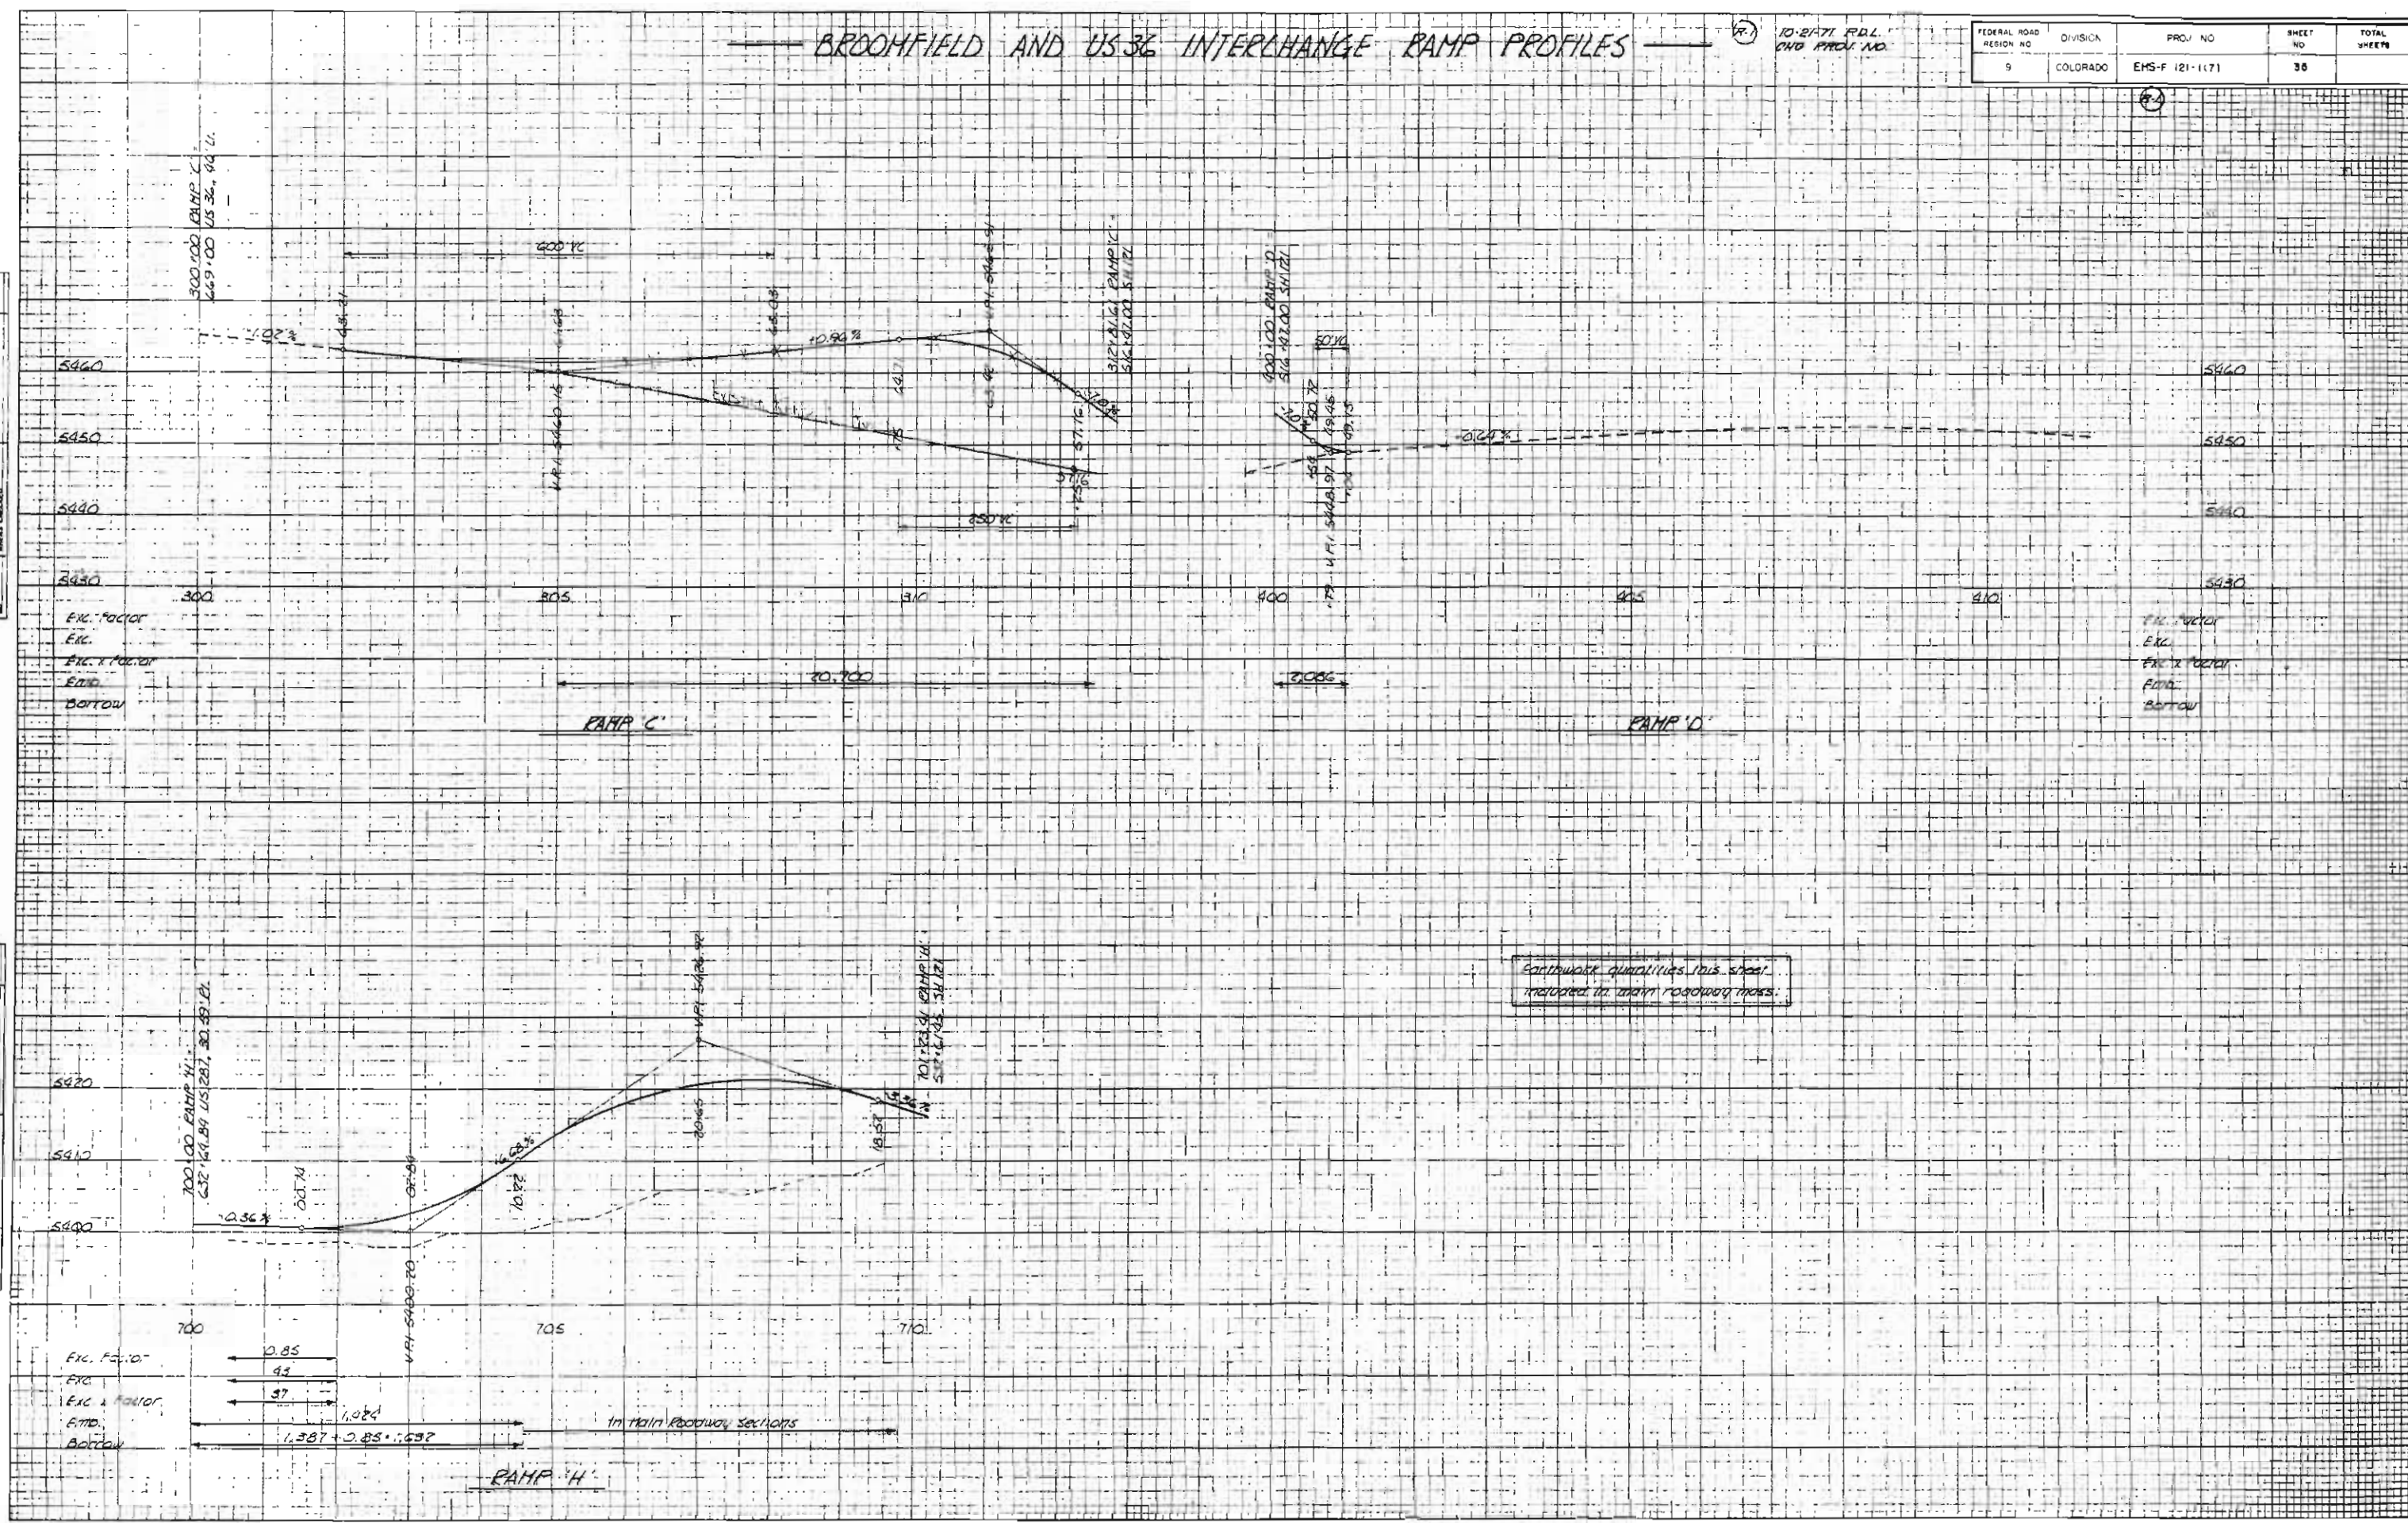

Earthwork quantities this sheet
included in main roadway mass.

(R-1) 10-21-71 P.D.L.
CHG PROJ. NO




FEDERAL ROAD REGION NO	DIVISION	PROJ NO	SHEET NO	TOTAL SHEETS
9	COLORADO	EHS - F 121-1 (7)	36	

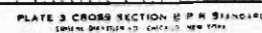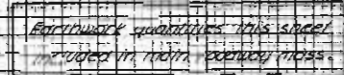

FED. ROAD REGION NO.	STATE	PROJ. NO.	SHEET NO.	TOTAL SHEETS
9	COLO.	ENS-F 121-1(7)	37	


ALIGNMENT & DRAINAGE

(B-1)

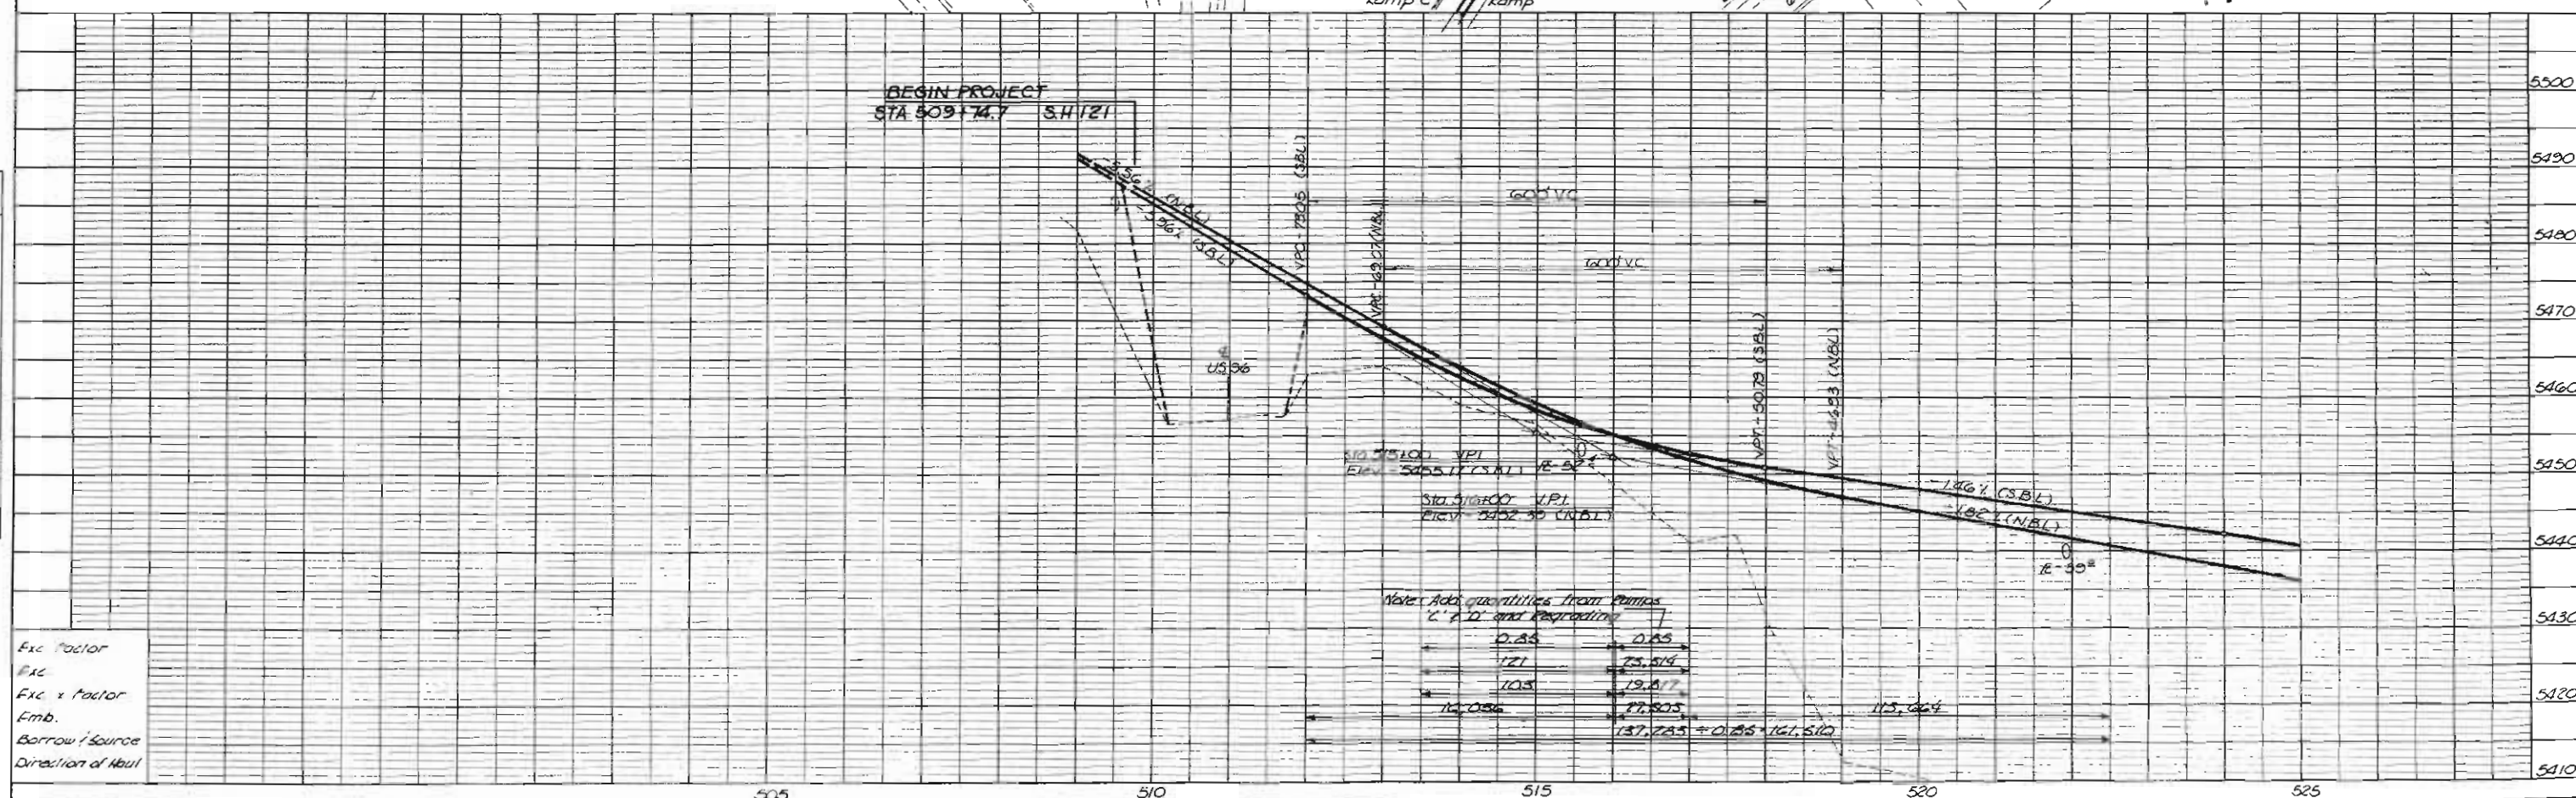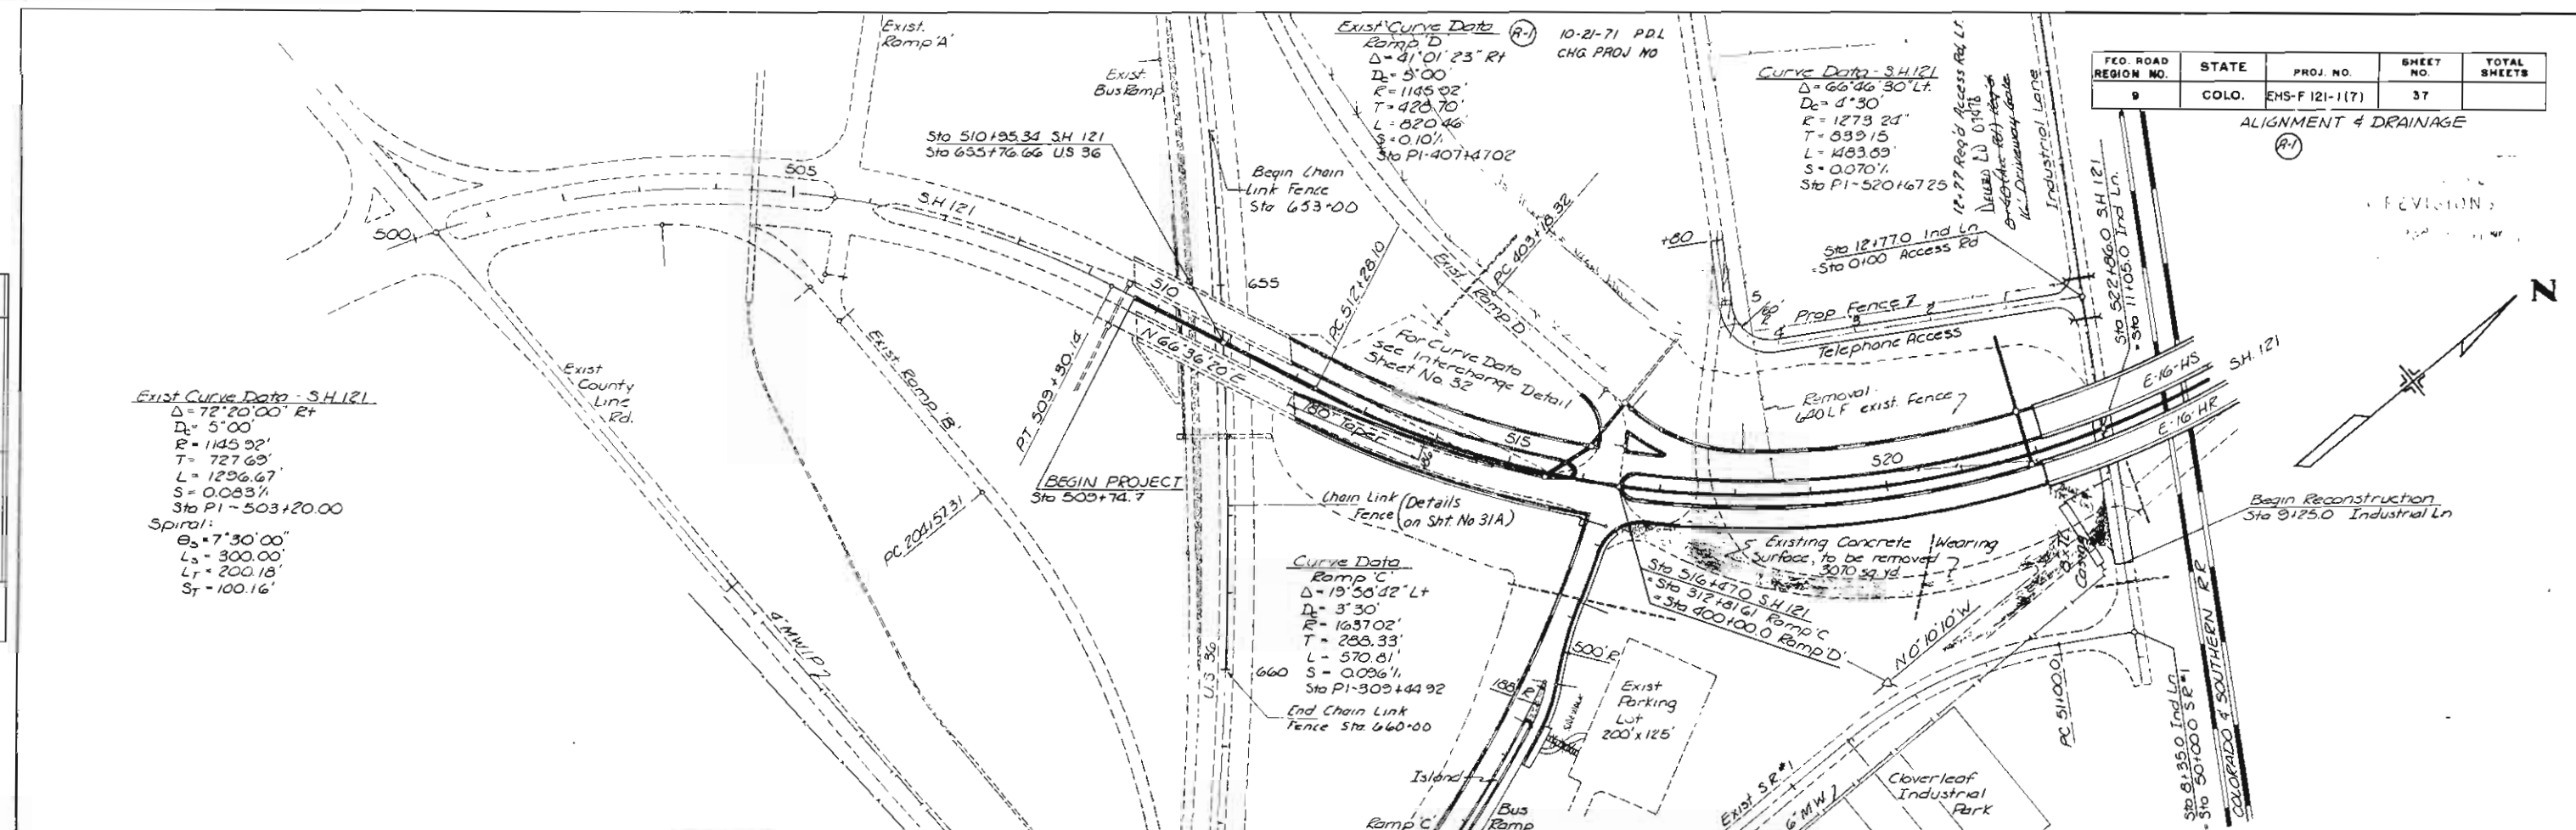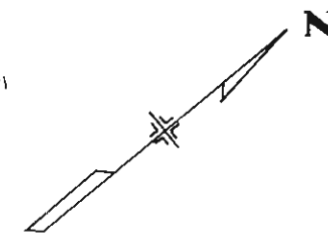

Y_P PLATE 1 - PLAN-PROFILE OF P.A.N. & STANDARD
CONCRETE & STEEL JOINT, NEW YORK.

ALIGNMENT & DRAINAGE
(R-1)

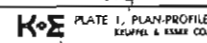

(R-1) 10-21-71 P.D.L.
CHG PROJ NO

FED. ROAD REGION NO.	STATE	PROJECT NO.	SHEET NO.	TOTAL SHEETS
9	COLO.	ENS-F 121-1 (7)	39	

(R-1)

DELINEATOR & GUARD RAIL DETAIL

For delineator spacing and guard
fence quantities see Sheet No. 10.

UNSTRUCTURED
WITH REVISIONS
Date Completed 10-21-71



CURVE DATA SH 121
Δ = 66° 48' 30" Lt.
D = 4' 30"
R = 1273.24'
T = 635.15'
L = 1403.09'
S = 0.070%
Sta PI = 520+67.25

CURVE DATA - RAMP 'D'
Curve #1
Δ = 55° 14' 02" Rt.
D = 24' 55"
R = 230.00'
T = 61.93'
L = 147.50'
Sta PC = 399+40.52 - D = 54' Lt
Sta PT = 400+138.02
Curve #2
Δ = 58° 00' 00" Lt.
D = 75' 25"
R = 76.00'
T = 42.13'
L = 76.93'
Sta PC = 400+56.38
Sta PT = 401+53.31

**Exist. Curve Data
Ramp 'D'**
Δ = 41° 01' 23" Rt.
D = 5' 00"
R = 1145.92'
T = 422.70'
L = 820.46'
S = 0.10%
Sta PI = 407+147.00

CURVE DATA RAMP 'C'
Curve #1
Δ = 27° 31' 35" Rt.
D = 4' 30"
R = 1273.24'
T = 311.88'
L = 611.72'
S = 0.10%
Sta PI = 303+11.68
Curve #2
Δ = 19° 58' 42" Lt.
D = 3' 30"
R = 1637.02'
T = 288.33'
L = 570.81'
S = 0.09%
Sta PI = 303+141.92

Exist. Curve Data - US 36
Δ = 30° 52' 30" Rt.
D = 1' 00"
R = 5729.58'
T = 1582.50'
L = 5087.50'
Sta PI = 665+52.50

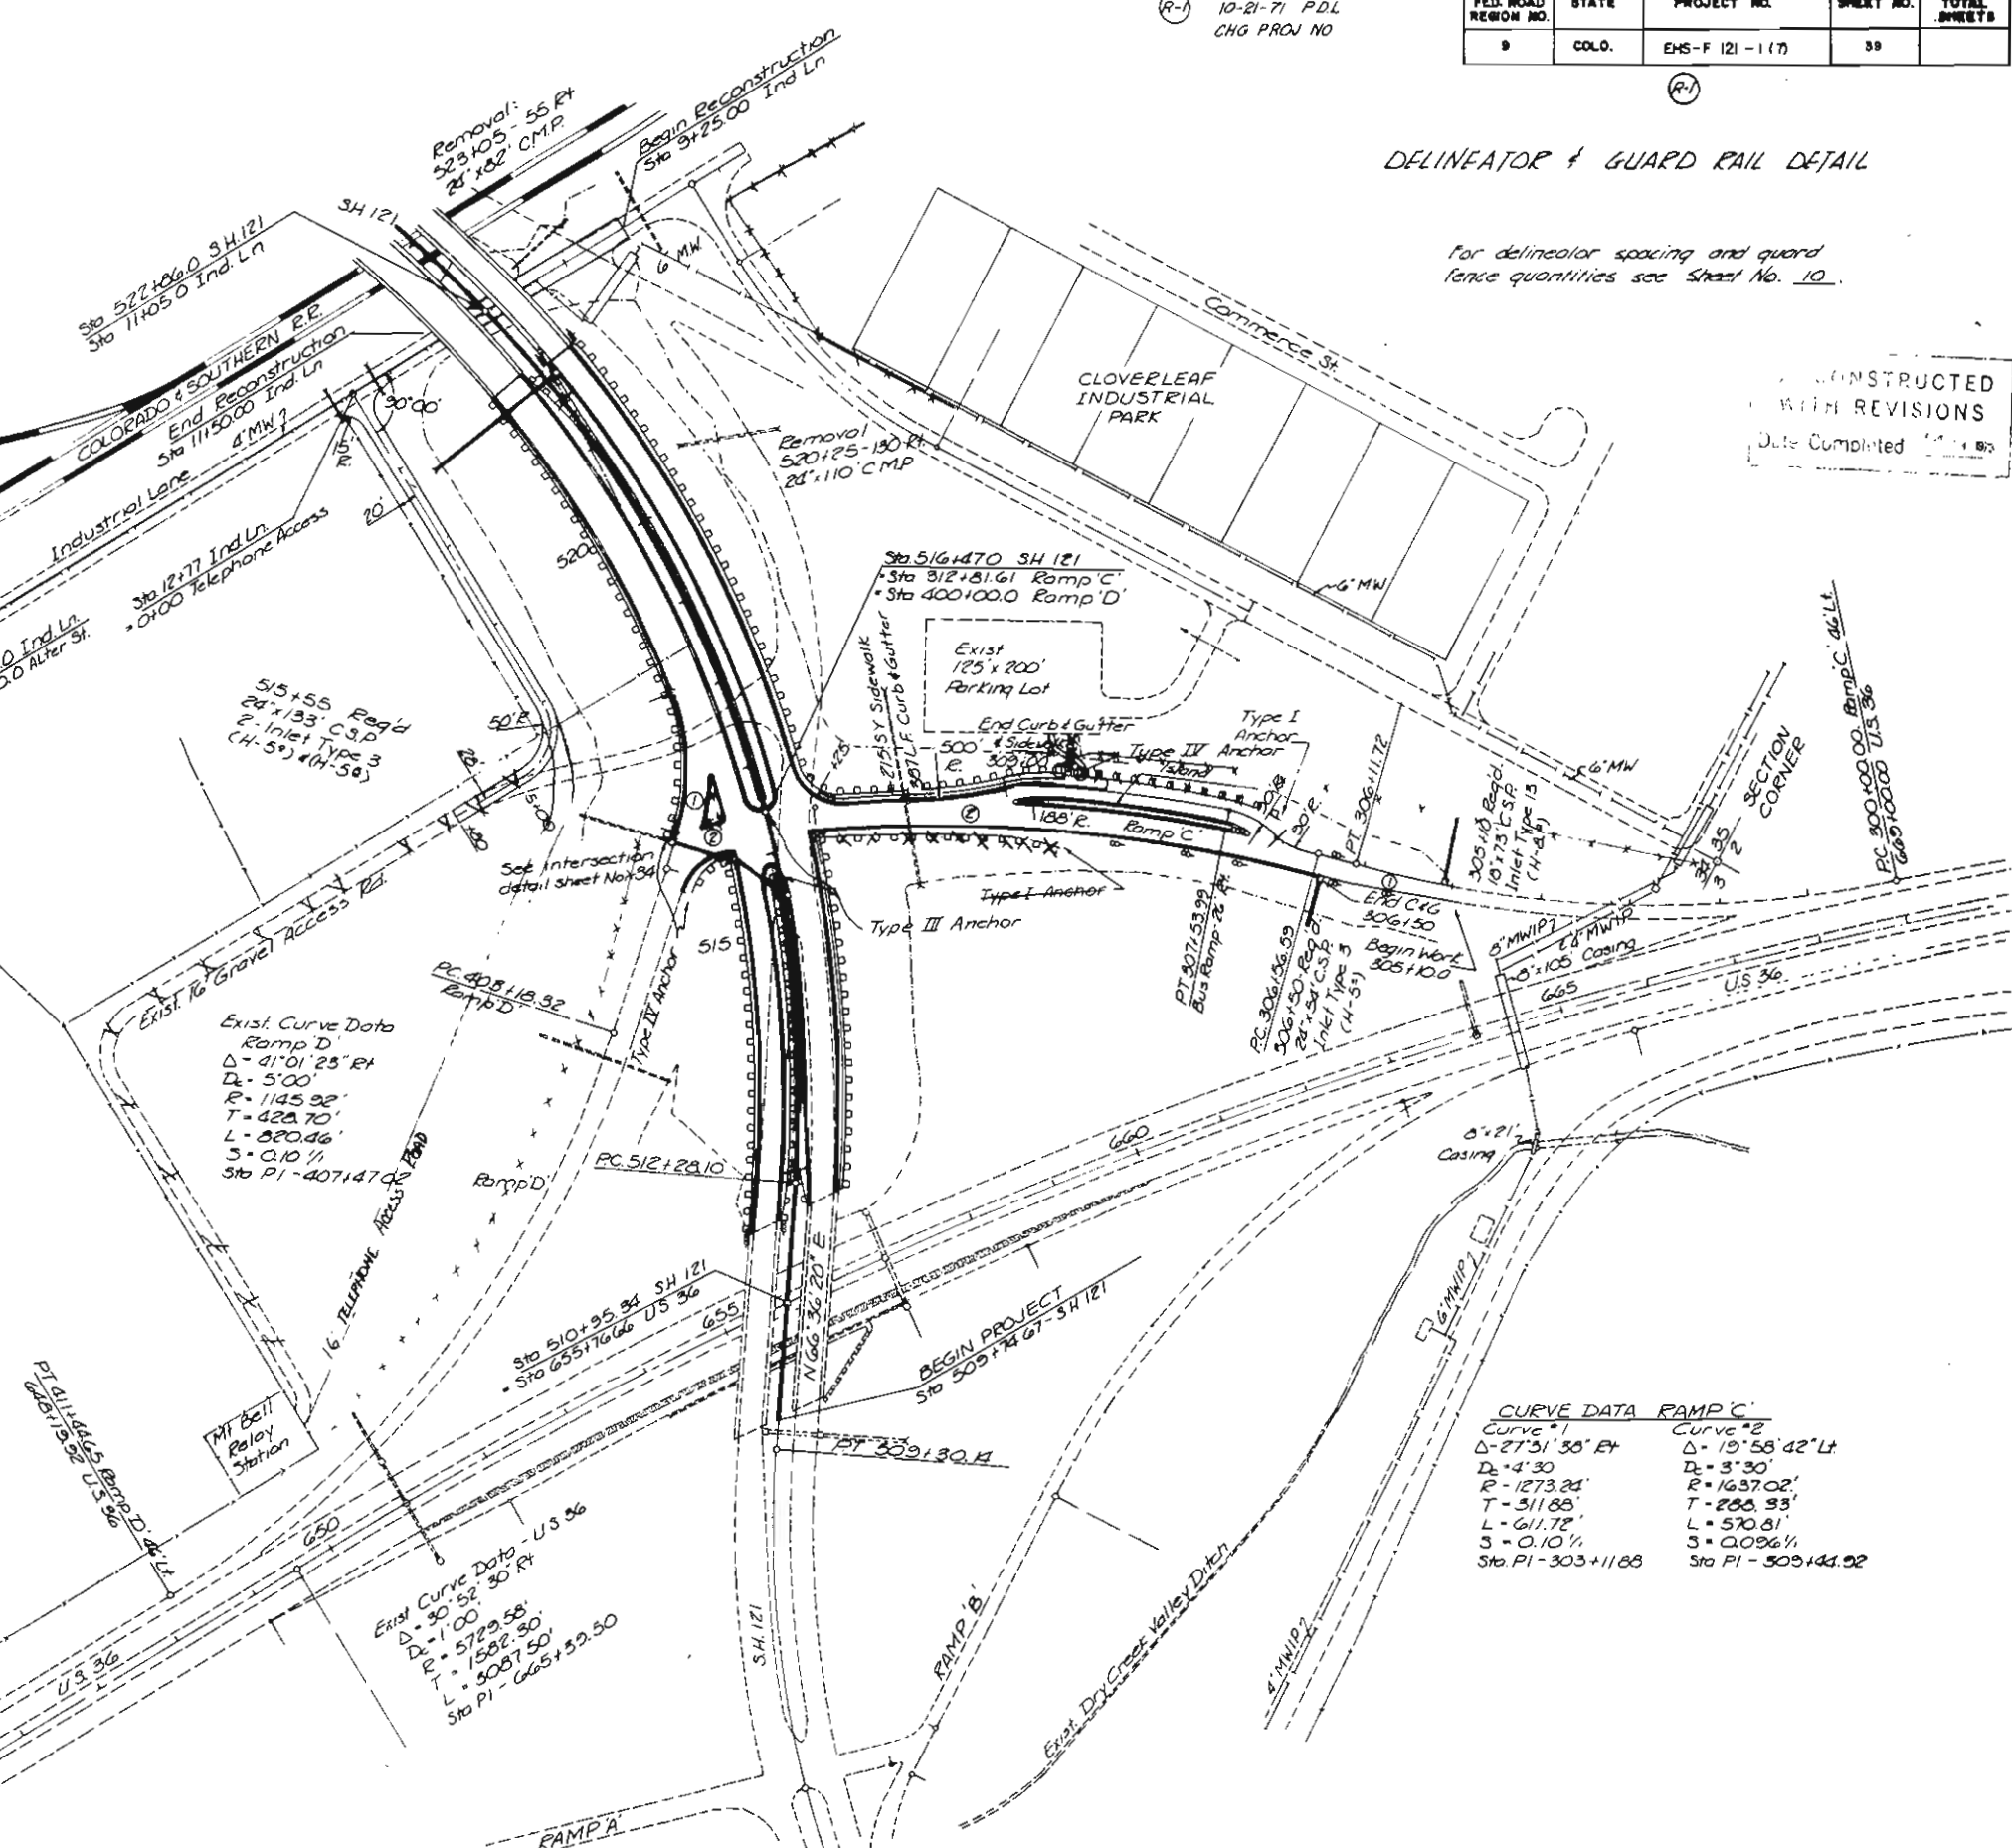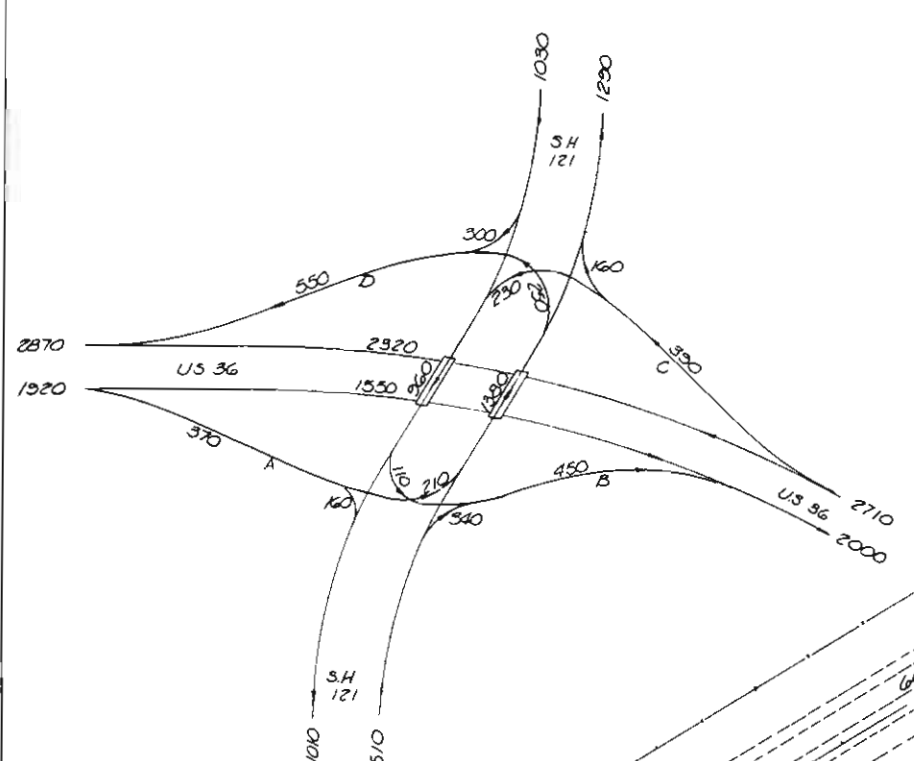


10-21-71 P.D.L.
CHG PROJ. NO.

FEDERAL ROAD REGION NO.	DIVISION	PROJ. NO.	SHEET NO.	TOTAL SHEETS
9	COLORADO	E-5-F 121-1(7)	40	


DELINEATOR, GUARD RAIL, & REGRADING DETAILS


For delineator spacing & guard fence
quantities see Sheet No. 10.

CONSTRUCTED
WITH REVISIONS
Date Completed: 10-21-71

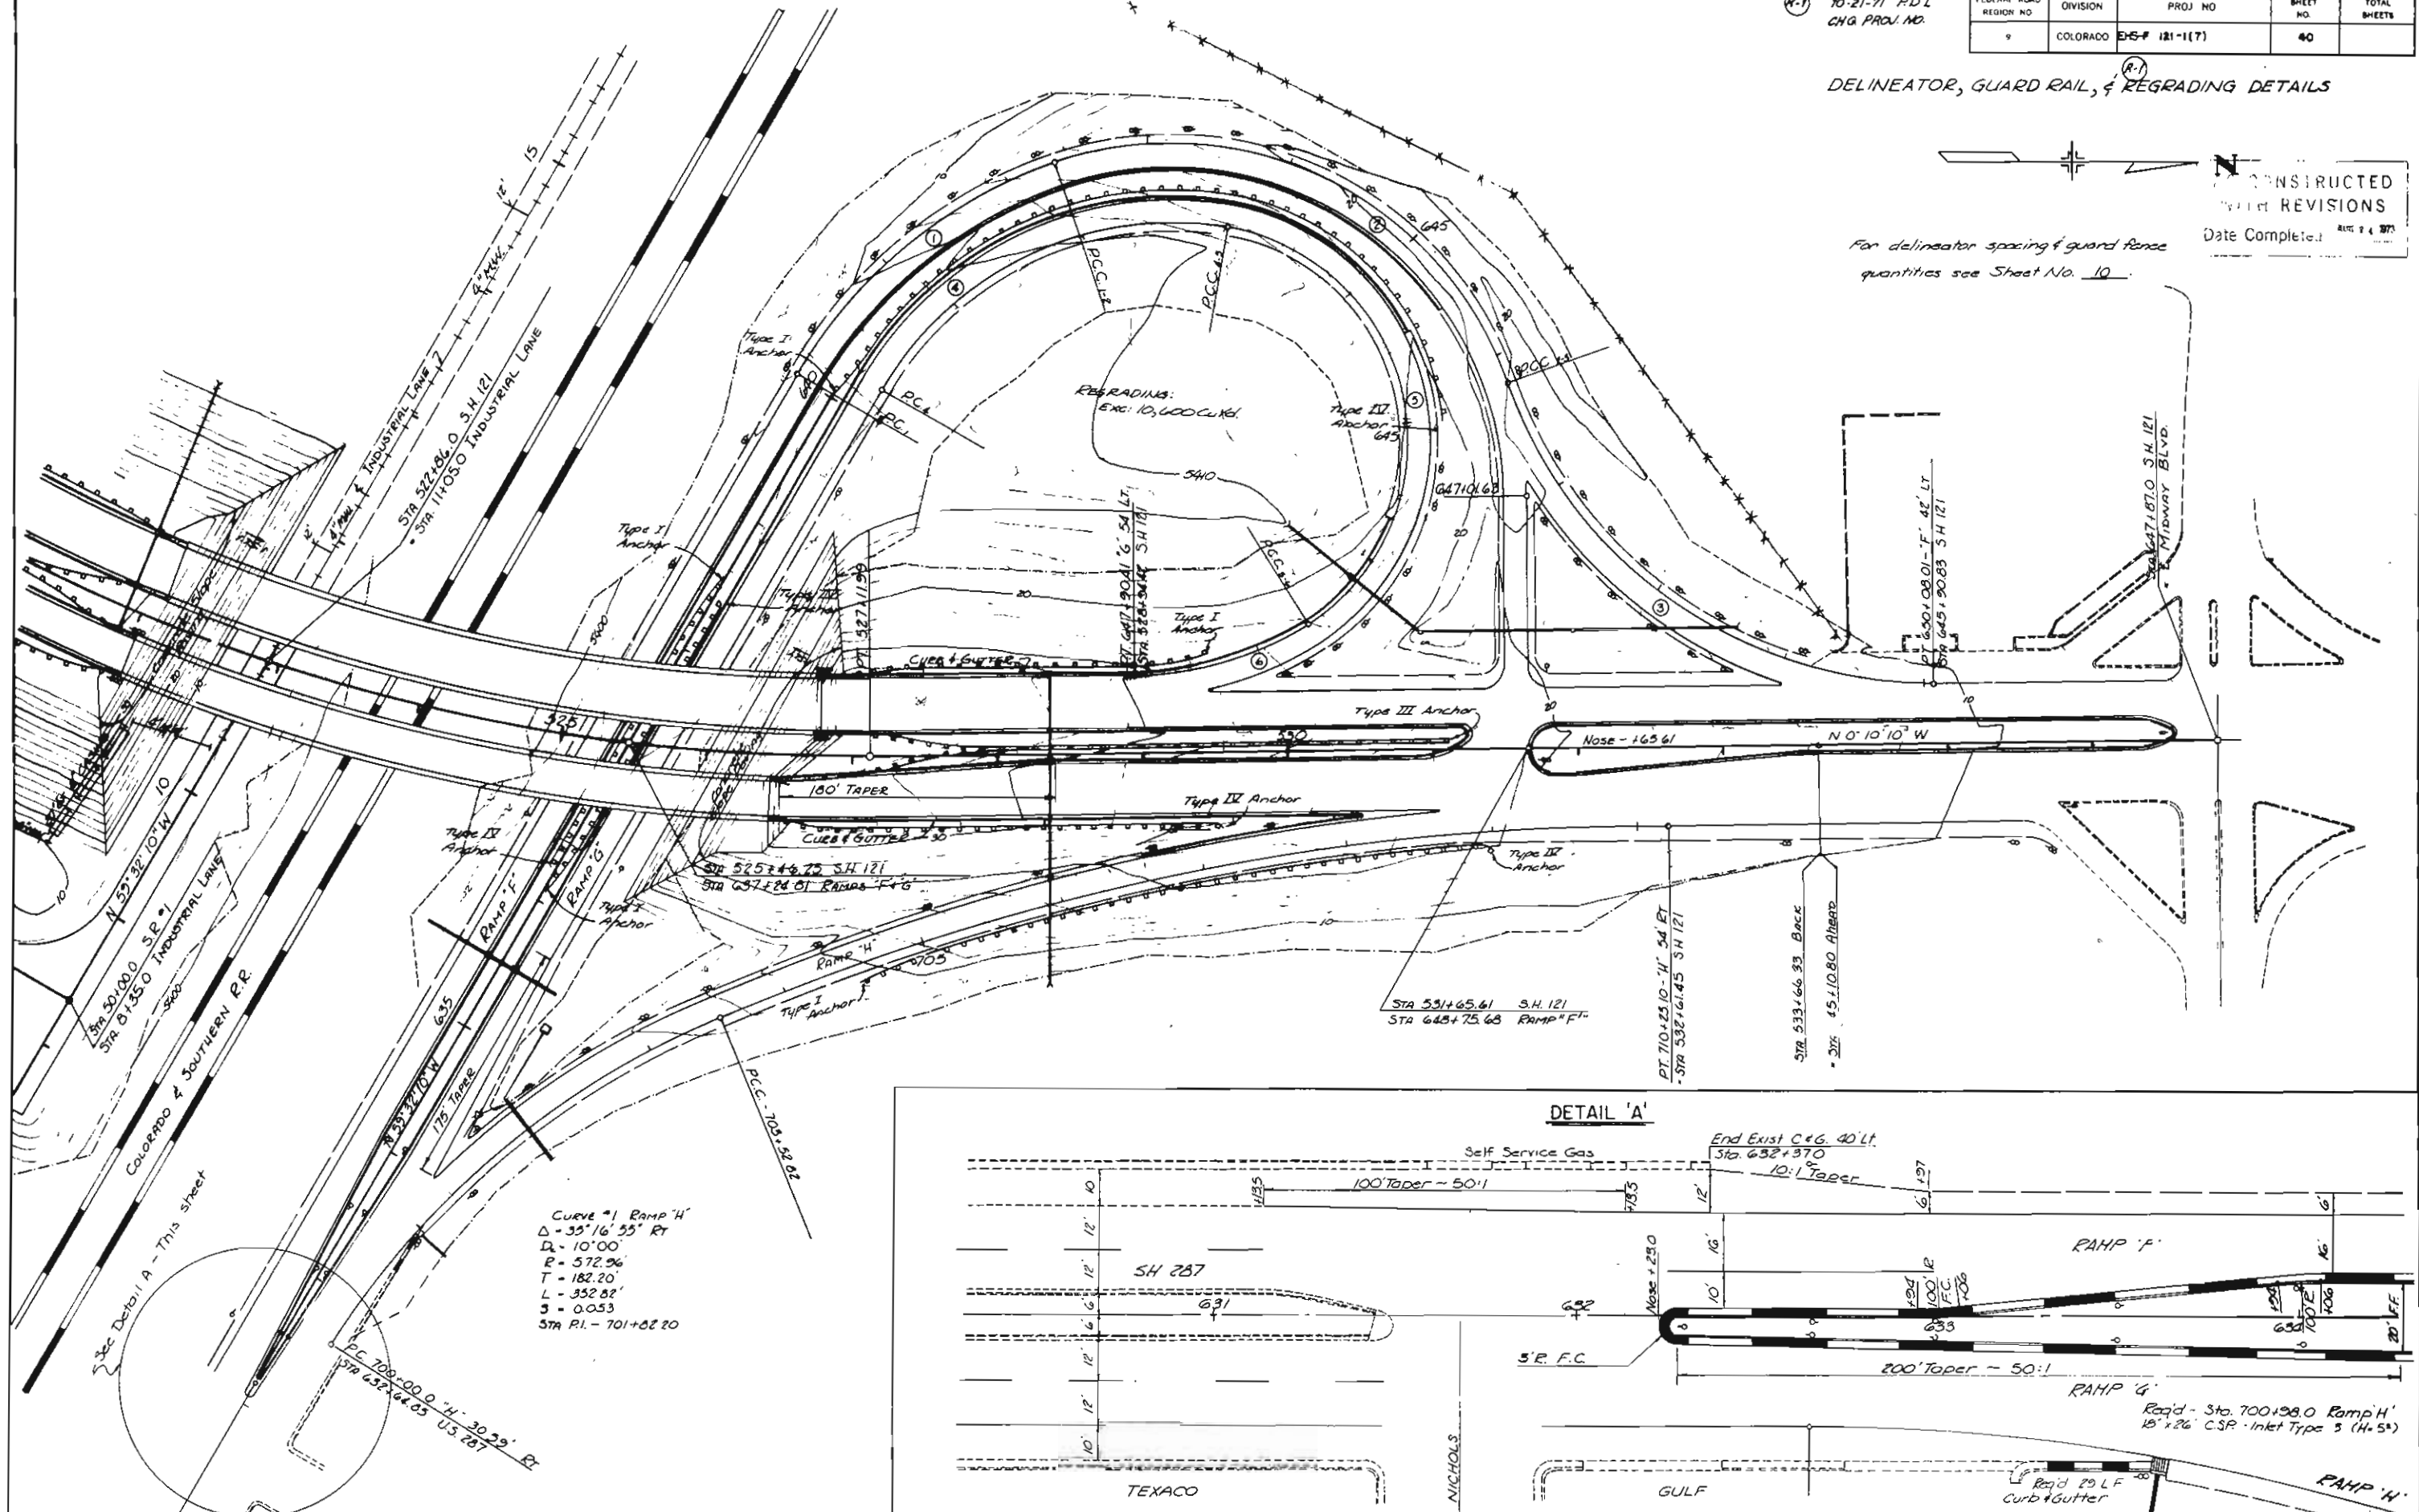

DETAIL 'A'

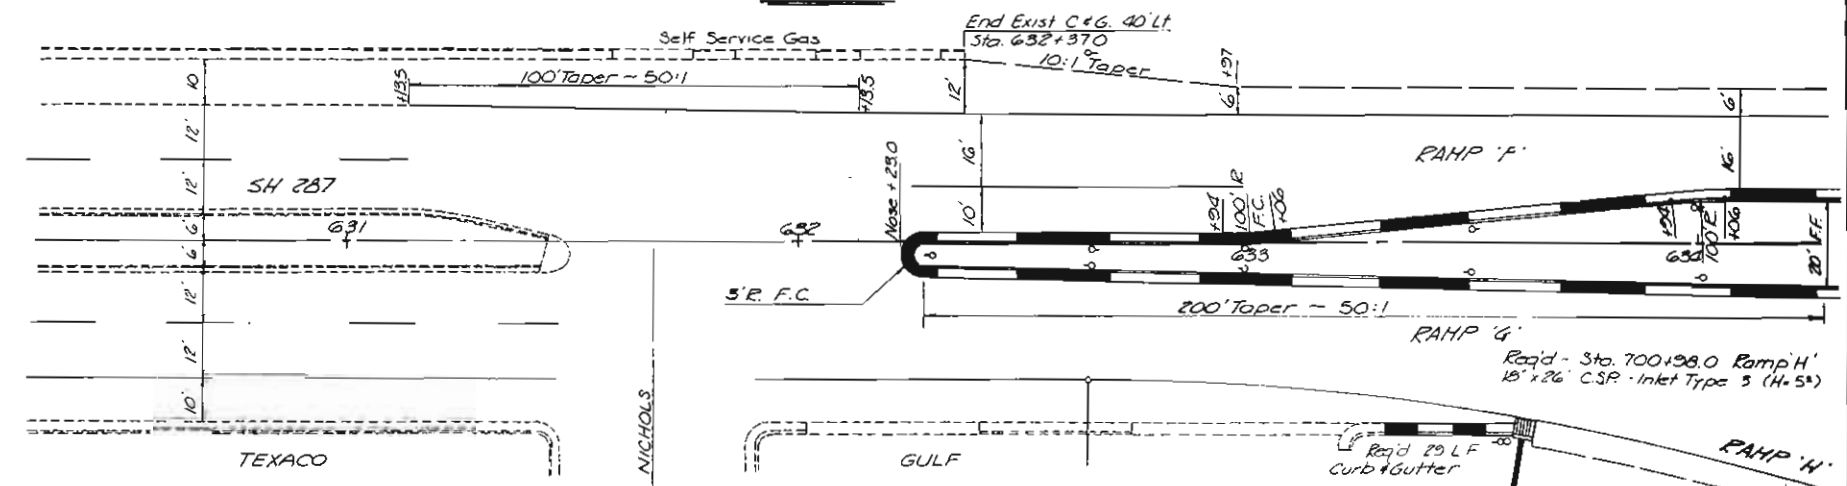

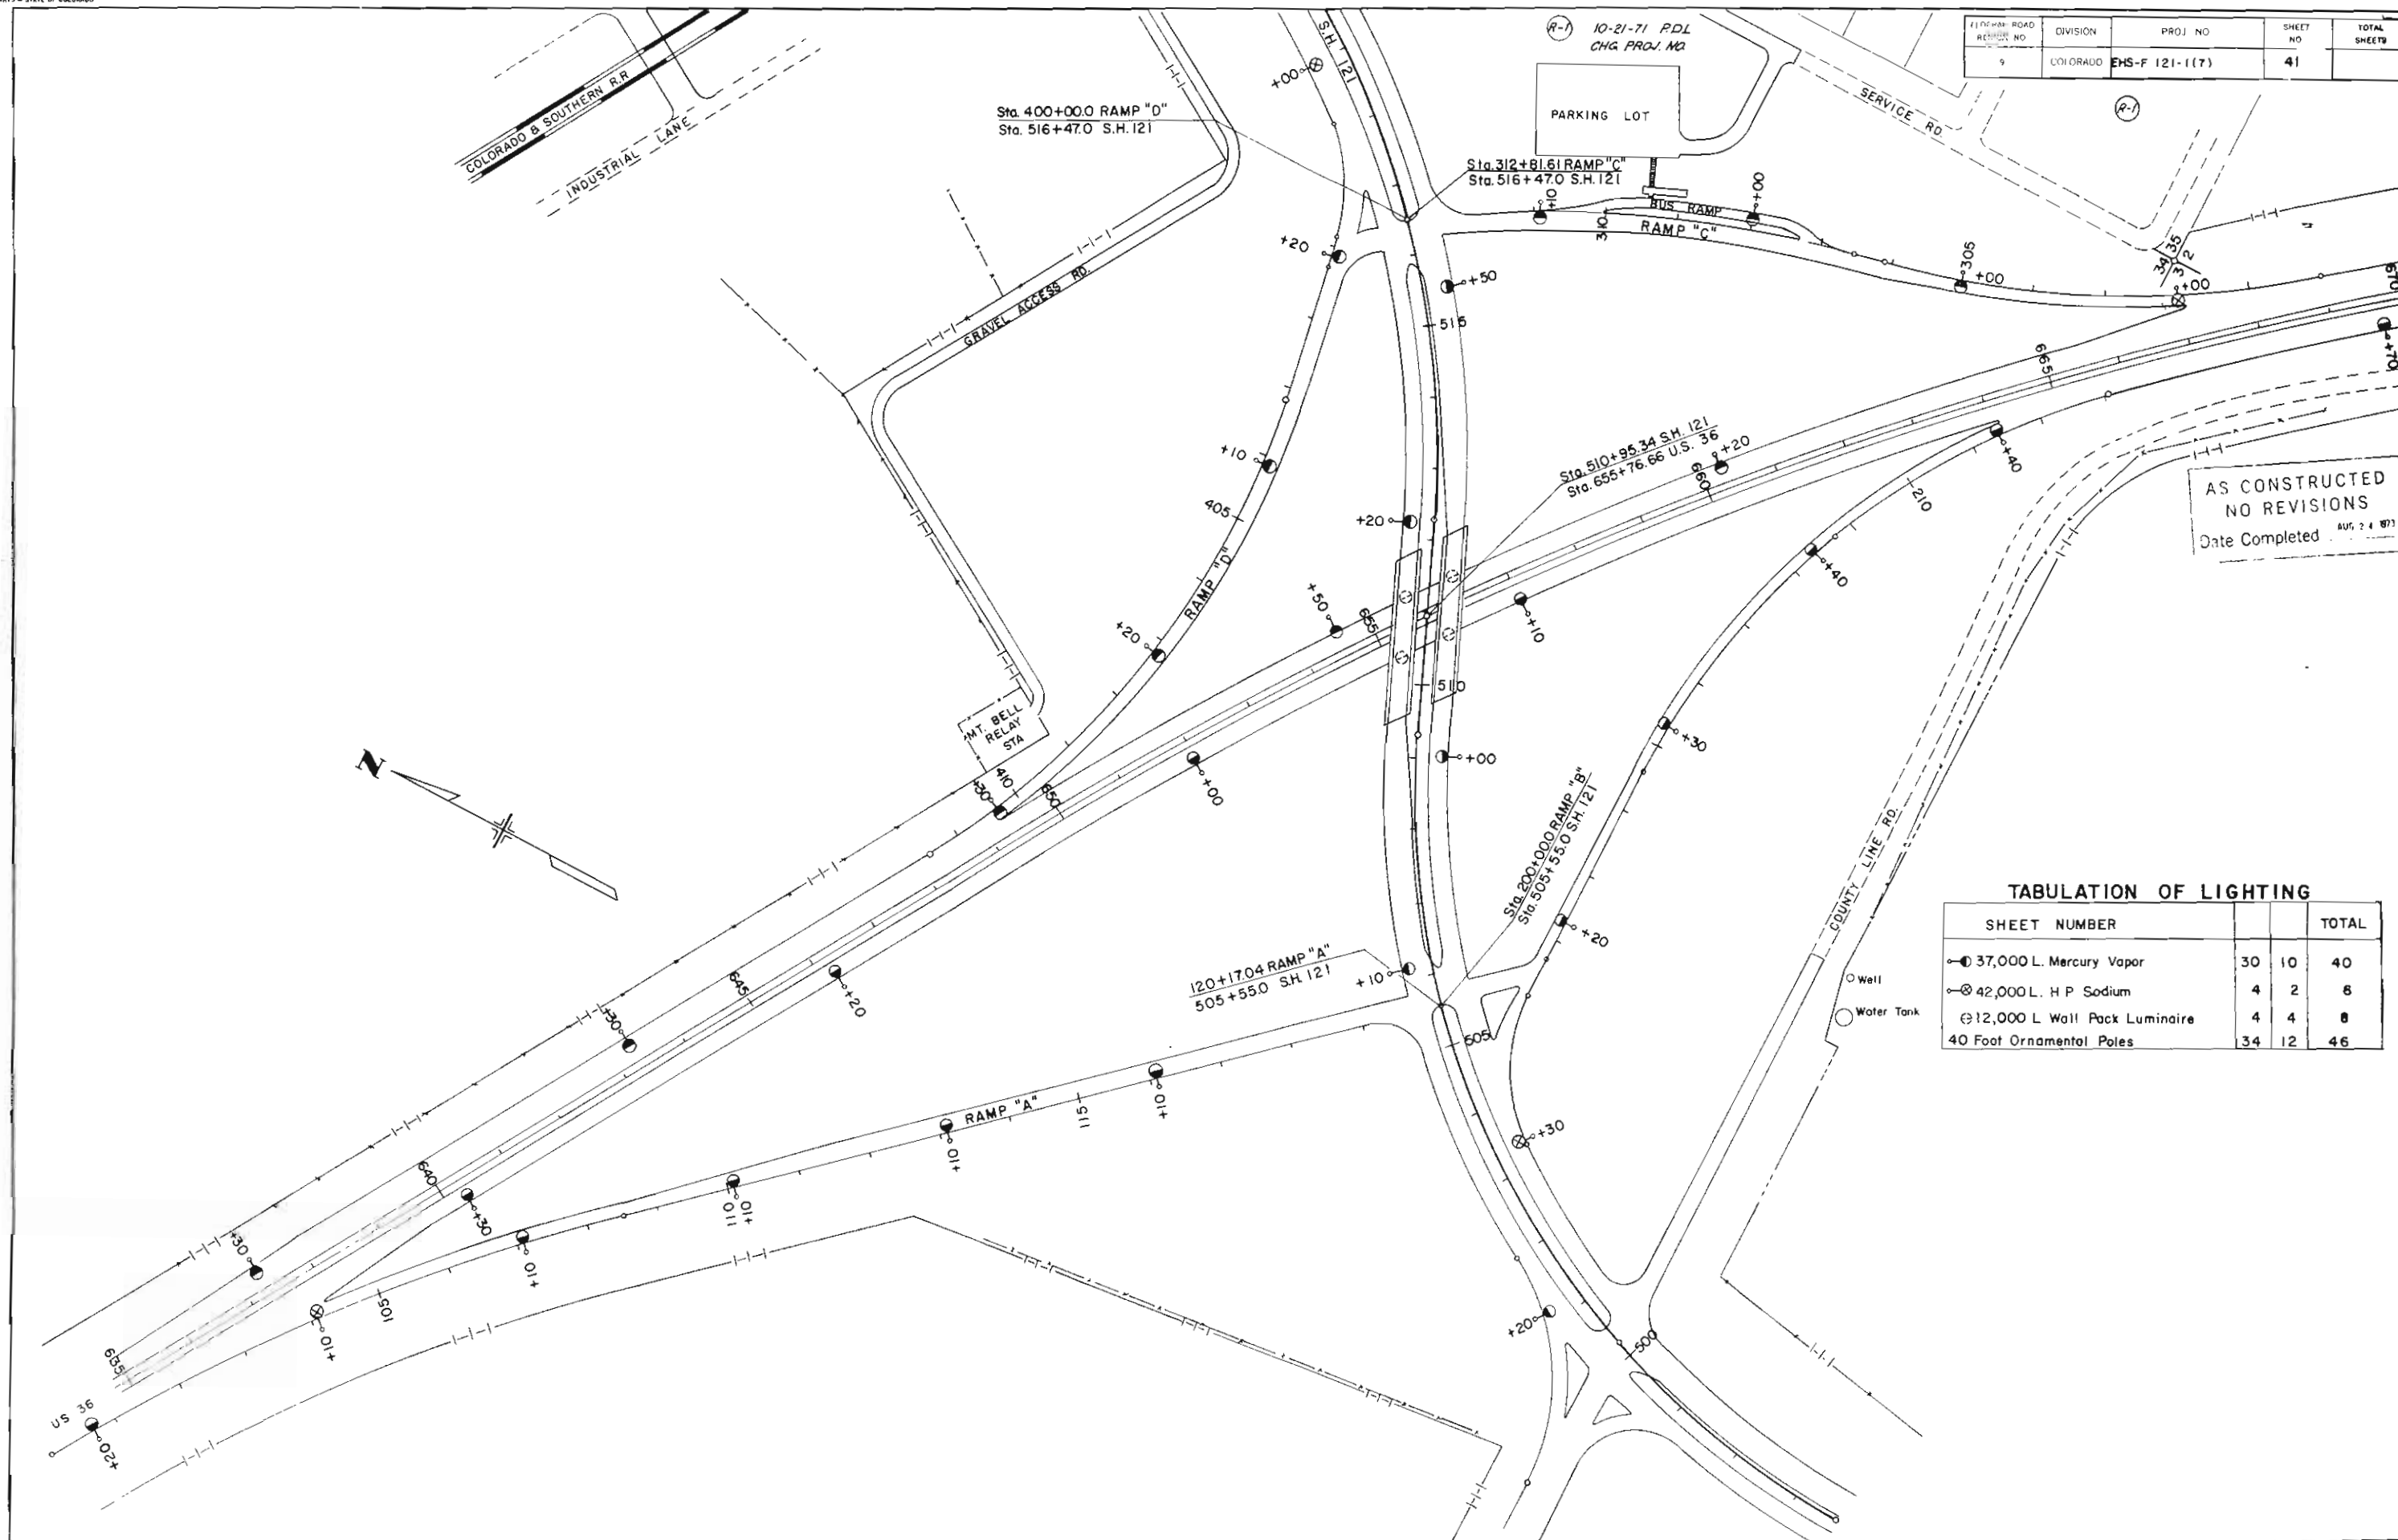

FILE NO. ROAD REVISION NO.	DIVISION	PROJ. NO.	SHEET NO.	TOTAL SHEETS
9	COLORADO	EHS-F 121-1(7)	41	

AS CONSTRUCTED
NO REVISIONS
Date Completed AUG. 24, 1973

TABULATION OF LIGHTING


SHEET NUMBER			TOTAL
37,000 L. Mercury Vapor	30	10	40
42,000 L. H.P. Sodium	4	2	6
12,000 L. Wall Pack Luminaire	4	4	8
40 Foot Ornamental Poles	34	12	46

(R-1) 10-21-71 P.D.L.
CHG. PROJ. NO

FEDERAL ROAD REGION NO.	DIVISION	PROJ. NO.	SHEET NO.	TOTAL SHEETS
9	COLORADO	ENS-F 121-1171	42	

(R-1)




AS CONSTRUCTED
NO REVISIONS
Date Completed AUG 21 1973

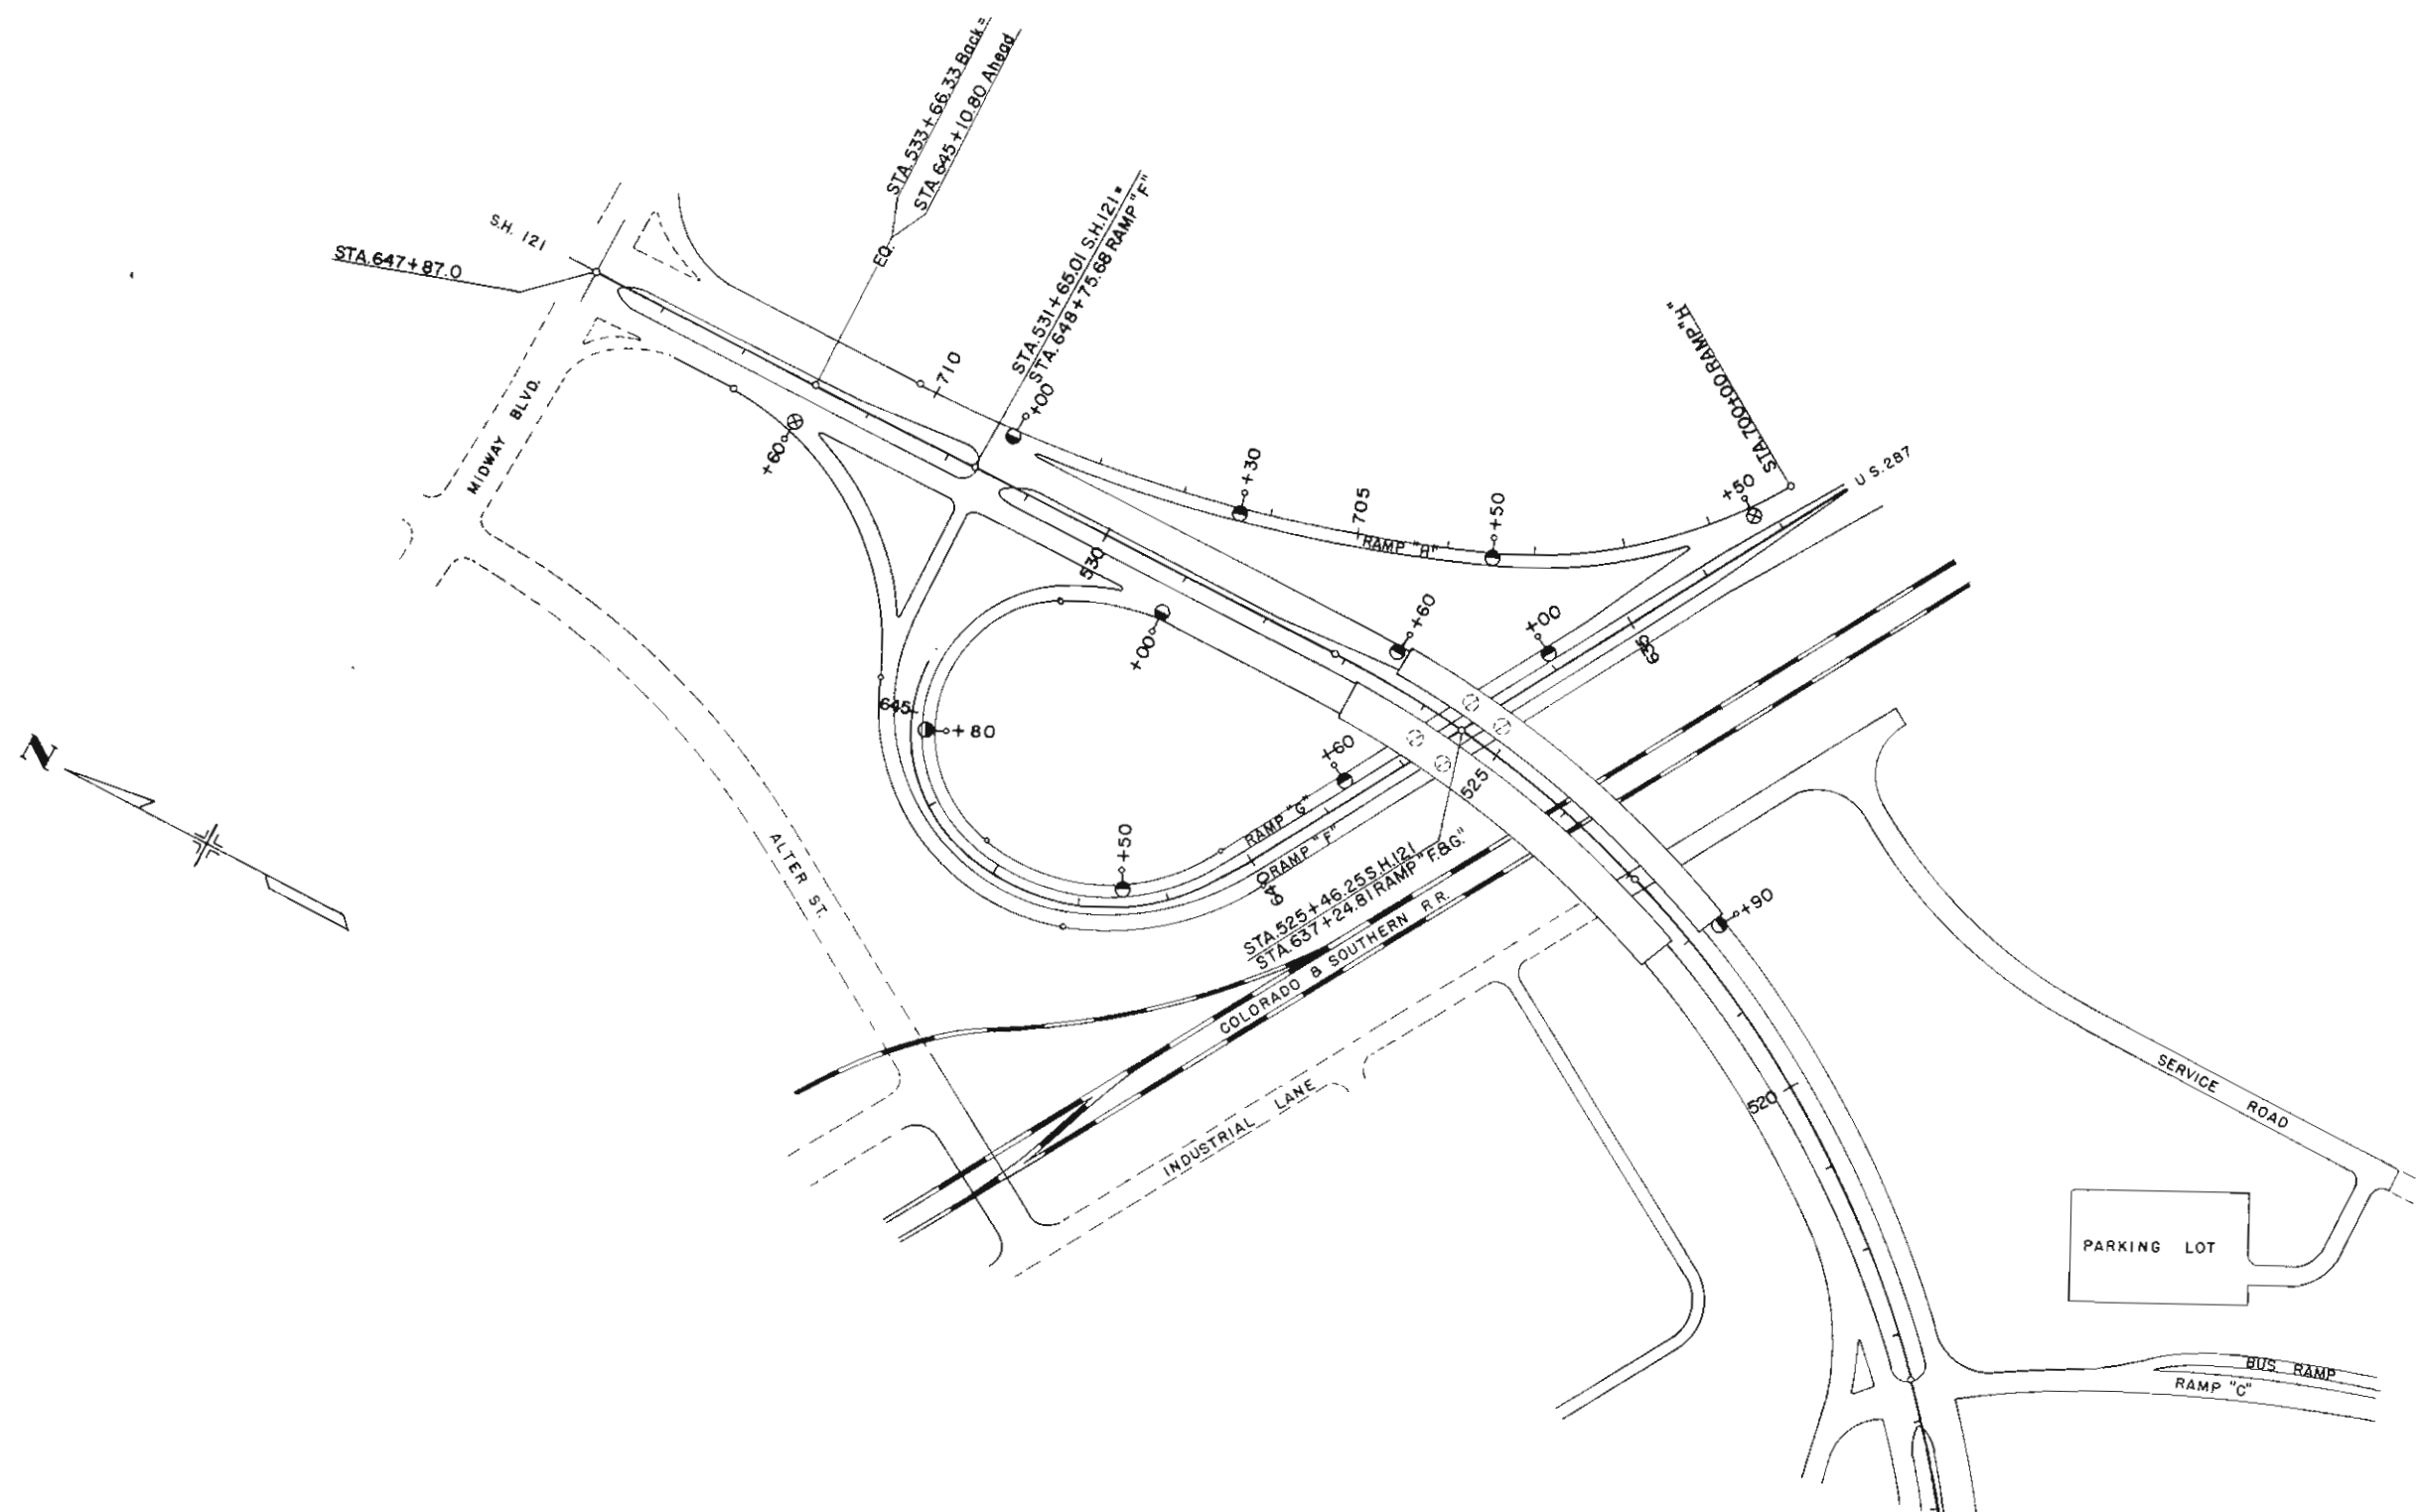

STANDARD M-203-A

(JULY 1, 1965)

FEDERAL ROAD REGION NO.	DIVISION	PROJECT NO.	SHEET NO.
9	COLORADO		

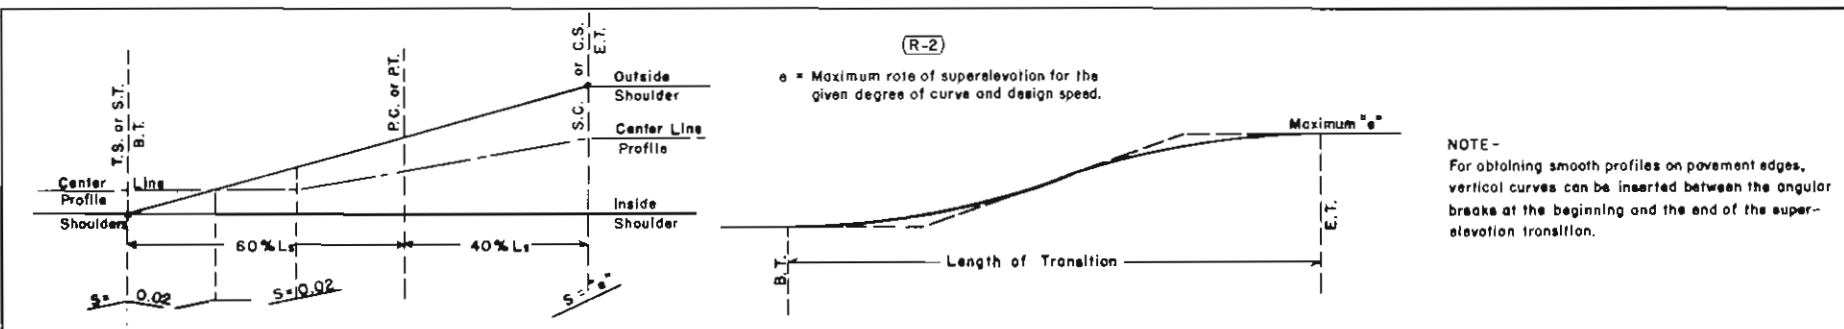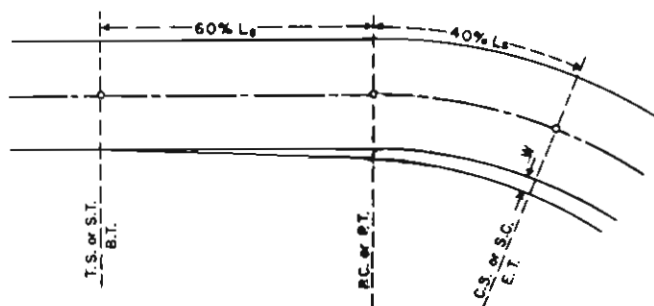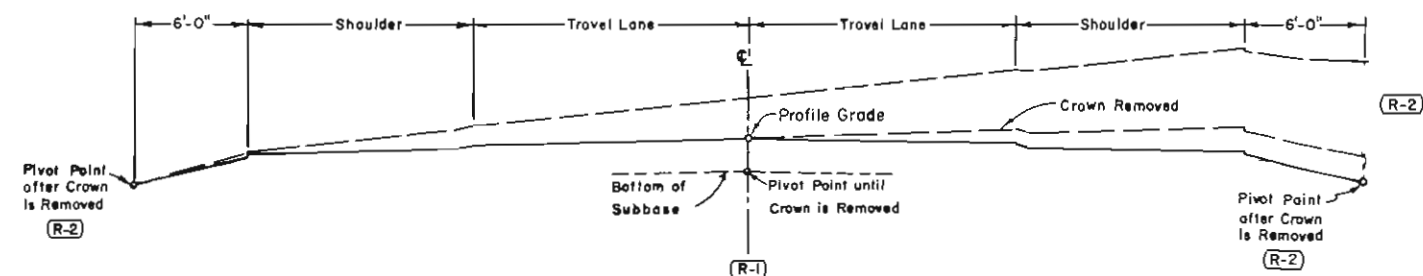

PAVEMENT WIDENING

Pavement Width	20 Ft.	22 Ft.	24 Ft.
Degree of Curve			
0° - 3°	0 Ft.	0 Ft.	0 Ft.
4° - 6°	2.0 Ft.	0 Ft.	0 Ft.
7° - 10°	2.5 Ft.	0 Ft.	0 Ft.
11° - 17°	3.0 Ft.	2.0 Ft.	0 Ft.
18° - 21°	3.5 Ft.	2.5 Ft.	0 Ft.
22° - Up	4.0 Ft.	3.0 Ft.	2.0 Ft.

Widening is to be on the inside edge of the pavement and the transition is to extend over the same transition length as the superelevation.

REVISIONS

REVISIONS		
(R-1)	5-26-67 Superelev Template	M.R.H.
(R-2)	7-30-68 Template, Rate Tables and Dept. Name	M.R.H.

TABLE 1
SUPERELEVATION RATES FOR TWO LANE CROWNED HIGHWAYS

Degree of Curve	Maximum Superelevation = 0.08			Maximum Superelevation = 0.10		
	Super. Rate Ft./Ft.	Maximum Design Speed M.P.H.	Minimum Transition or Spiral Length	Super. Rate Ft./Ft.	Maximum Design Speed M.P.H.	Minimum Transition or Spiral Length
0°15'	.020	70	200'	.020	70	200'
0°30'	.020	70	200'	.020	70	200'
0°45'	.021	70	200'	.021	70	200'
1°00'	.028	70	200'	.028	70	200'
1°30'	.042	70	200'	.042	70	200'
2°00'	.056	70	200'	.055	70	200'
2°30'	.069	70	200'	.069	70	200'
3°00'	.078	70	250'	.083	70	260'
3°30'	.080	70	250'	.096	70	300'
4°	.080	65	250'	.100	65	300'
5°	.080	60	250'	.100	60	300'
6°	.080	55	200'	.100	55	250'
7°	.080	50	200'	.100	50	250'
8°	.080	45	200'	.100	50	250'
9°	.080	45	200'	.100	45	250'
10°	.080	40	200'	.100	45	250'
11°	.080	40	200'	.100	40	200'
12°	.080	40	200'	.100	40	200'
13°	.080	35	150'	.100	40	200'
14°	.080	35	150'	.100	35	200'
15°	.080	35	150'	.100	35	200'
16°	.080	35	150'	.100	35	200'
17°	.080	30	150'	.100	35	200'
18°	.080	30	150'	.100	30	200'
19°	.080	30	150'	.100	30	200'
20°	.080	30	150'	.100	30	200'
21°	.080	30	150'	.100	30	200'
22°	.080	30	150'	.100	30	200'
23°	.080	30	150'	.100	30	200'
24°				.100	30	200'
25°				.100	30	200'

NOTES—Plains Areas use 0.10 Maximum Superelevation Rate.
Mountainous Areas & areas where icing conditions frequently exist, use 0.08 Maximum Superelevation Rate.

TABLE 2
SUPERELEVATION RATES FOR SPECIAL CASES

Degree of Curve	30 M.P.H.			35 M.P.H.			40 M.P.H.			45 M.P.H.			50 M.P.H.			55 M.P.H.			60 M.P.H.			Degree of Curve
	Required Superelevation Rate Ft./Ft.	Minimum Length of Transition or Spiral	Minimum Length of Transition or Spiral	Required Superelevation Rate Ft./Ft.	Minimum Length of Transition or Spiral	Minimum Length of Transition or Spiral	Required Superelevation Rate Ft./Ft.	Minimum Length of Transition or Spiral	Minimum Length of Transition or Spiral	Required Superelevation Rate Ft./Ft.	Minimum Length of Transition or Spiral	Minimum Length of Transition or Spiral	Required Superelevation Rate Ft./Ft.	Minimum Length of Transition or Spiral	Minimum Length of Transition or Spiral	Required Superelevation Rate Ft./Ft.	Minimum Length of Transition or Spiral	Minimum Length of Transition or Spiral	Required Superelevation Rate Ft./Ft.	Minimum Length of Transition or Spiral	Minimum Length of Transition or Spiral	
0°15'	NC	NC	0	NC	NC	0	NC	NC	0	NC	NC	0	NC	NC	0	NC	NC	0	NC	NC	0	0°15'
0°30'	NC	NC	0	NC	NC	0	NC	NC	0	NC	NC	0	.020	.020	150'	.020	.020	200'	.020	.020	200'	0°30'
0°45'	NC	NC	0	NC	NC	0	.020	.020	150'	.020	.020	150'	.020	.020	150'	.020	.020	200'	.020	.020	200'	0°45'
1°00'	NC	NC	0	.020	.020	150'	.020	.020	150'	.020	.020	150'	.020	.020	150'	.021	.021	200'	.022	.022	200'	1°00'
1°30'	.020	.020	100'	.020	.020	150'	.020	.020	150'	.023	.024	150'	.027	.027	150'	.031	.031	200'	.035	.034	200'	1°30'
2°00'	.020	.020	100'	.020	.021	150'	.025	.027	150'	.030	.032	150'	.035	.036	150'	.041	.042	200'	.047	.046	200'	2°00'
2°30'	.020	.020	100'	.025	.026	150'	.030	.035	150'	.036	.039	150'	.043	.045	150'	.050	.052	200'	.058	.059	200'	2°30'
3°00'	.023	.024	100'	.029	.031	150'	.035	.038	150'	.042	.046	150'	.050	.054	150'	.057	.062	200'	.066	.070	200'	3°00'
3°30'	.026	.027	100'	.033	.036	150'	.040	.045	150'	.048	.053	150'	.056	.063	150'	.064	.072	200'	.072	.081	250'	3°30'
4°	.029	.030	100'	.037	.040	150'	.044	.050	150'	.053	.060	150'	.062	.070	200'	.069	.079	200'	.076	.090	250'	4°
5°	.035	.038	100'	.044	.048	150'	.053	.060	150'	.062	.071	200'	.070	.083	200'	.077	.091	250'	.080	.099	300'	5°
6°	.041	.044	100'	.050	.056	150'	.060	.068	150'	.069	.080	200'	.076	.093	250'	.080	.100	250'		.100	300'	6°
7°	.045	.050	100'	.056	.063	150'	.066	.076	150'	.074	.088	200'	.079	.097	250'		.100	250'				7°
8°	.050	.055	100'	.061	.069	150'	.071	.084	200'	.078	.094	200'	.080	.100	250'							8°
9°	.054	.061	100'	.065	.075	150'	.074	.089	200'	.080	.097	250'										9°
10°	.058	.065	150'	.069	.081	150'	.077	.093	200'	.080	.100	250'										10°
11°	.061	.070	150'	.072	.085	200'	.079	.096	200'													11°
12°	.065	.074	150'	.075	.089	200'	.080	.098	200'													12°
13°	.067	.078	150'	.077	.092	200'		.100	200'													13°
14°	.070	.082	150'	.078	.095	200'																
15°	.072	.085	150'	.079	.097	200'																
16°	.074	.087	150'		.099	200'																
17°	.076	.090	150'		.100	200'																
18°	.077	.093	200'		.100	200'																
19°	.078	.095	200'																			
20°	.079	.096	200'																			
21°	.080	.098	200'																			
22°	.080	.099	200'																			
23°	.080	.099	200'																			
24°	.100	200'																				
25°	.100	200'																				

NOTES—Transition or Spiral Lengths are shown in the tables for 2 Lane Crowned Highways.
For 3 Lane Crowned Highways use 1.2 times the lengths shown, rounded to the nearest 50 feet.
Width of Crowned Highway to be figured for Superelevation—left pivot point to right pivot point.

Table 2 data may be used for City Streets & Interchanges.
NC=Normal Crown section.

DEPARTMENT OF HIGHWAYS
STATE OF COLORADO
DIVISION OF HIGHWAYS



SUPERELEVATION &
WIDENING OF CURVES
CROWNED HIGHWAYS

Designed by S.B.L.
Made by S.B.L.
Checked by L.E.O.
Approved by [Signature]
Staff Design Engr.
Date July 1, 1965

STANDARD M-203-A-1

(JULY 1, 1965)

FEDERAL ROAD REGION NO.	DIVISION	PROJECT NO.	SHEET NO.
9	COLORADO		

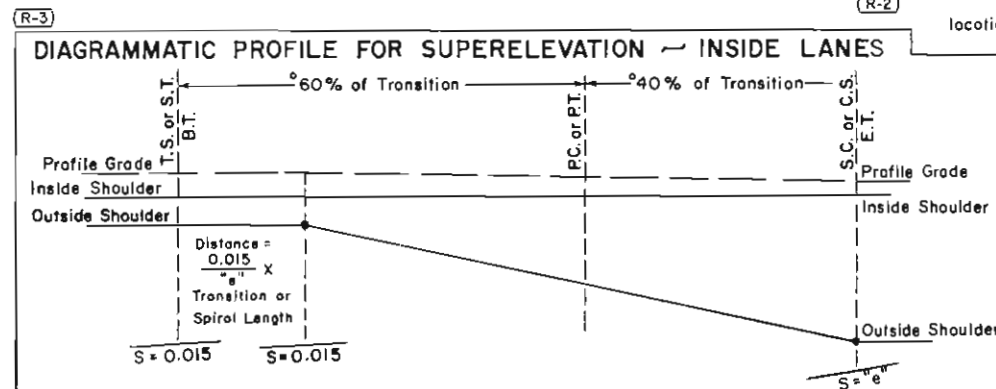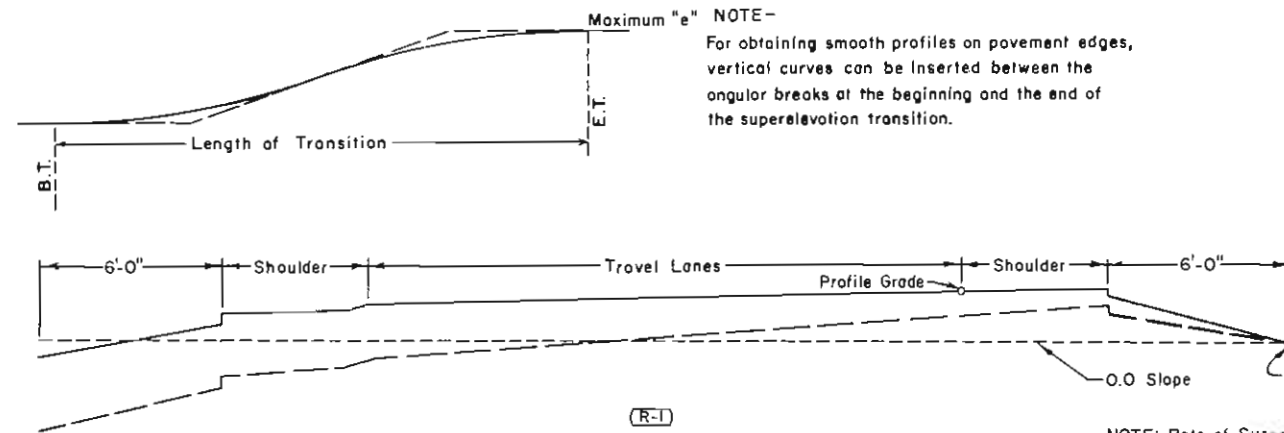


NOTE: Rate of Superlevation is applied from 0.0 slope line.
In case of narrow (non-depressed) median, the normal location of pivot point will be at the centerline of the median.

* When Curve is Not Spiralled

(R-3)
e = Maximum rate of superlevation for the given degree of curve and design speed.

DIAGRAMMATIC PROFILE FOR SUPERELEVATION ~ OUTSIDE LANES

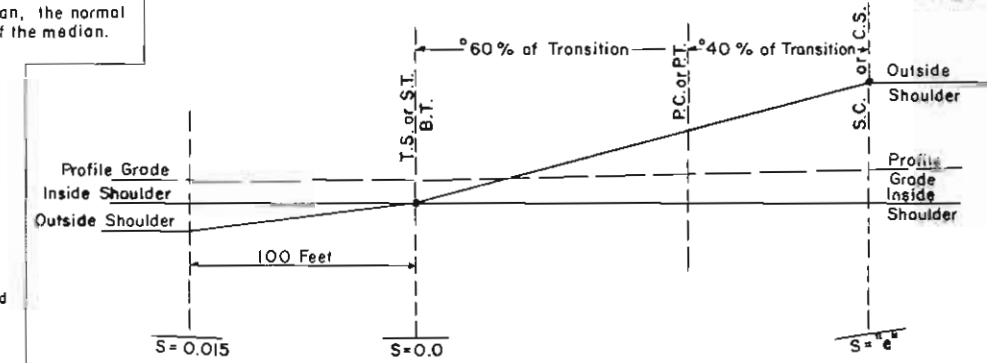

REVISIONS		
(R-1)	6-20-65	Superelev Template M.R.H.
(R-2)	7-26-67	Median note R.S.M.
(R-3)	7-30-68	Opt. Name, Tables, Note M.R.H.

(R-3)
TABLE 1
SUPERELEVATION RATES FOR FOUR LANE DIVIDED HIGHWAYS

Degree of Curve	Maximum Superelevation = 0.08			Maximum Superelevation = 0.10		
	Super. Rate Ft./Ft.	Maximum Design Speed M.P.H.	Minimum Transition or Spiral Length	Super. Rate Ft./Ft.	Maximum Design Speed M.P.H.	Minimum Transition or Spiral Length
0° 15'	.015	70	200'	.015	70	200'
0° 30'	.015	70	200'	.015	70	200'
0° 45'	.021	70	200'	.020	70	200'
1° 00'	.028	70	200'	.028	70	200'
1° 30'	.042	70	200'	.042	70	200'
2° 00'	.056	70	250'	.055	70	250'
2° 30'	.069	70	250'	.069	70	250'
3° 00'	.077	70	250'	.083	70	300'
3° 30'	.080	70	500'	.096	70	550'
4°	.080	65	300'	.100	70	350'
5°	.080	60	300'	.100	65	350'
6°	.080	55	250'	.100	55	300'
7°	.080	50	250'	.100	55	300'
8°	.080	50	250'	.100	50	300'
9°	.080	45	250'	.100	45	300'
10°	.080	45	250'	.100	45	300'
11°	.080	40	200'	.100	40	250'
12°	.080	40	200'	.100	40	250'
13°	.080	35	200'	.100	40	250'
14°	.080	35	200'	.100	35	200'
15°	.080	35	150'	.100	35	200'
16°	.080	35	150'	.100	35	200'
17°	.080	30	150'	.100	35	200'
18°	.080	30	150'	.100	35	200'
19°	.080	30	150'	.100	30	200'
20°	.080	30	150'	.100	30	200'
21°	.080	30	150'	.100	30	200'
22°	.080	30	150'	.100	30	200'
23°	.080	30	150'	.100	30	200'
24°	.080	30	150'	.100	30	200'
25°	.080	30	150'	.100	30	200'

NOTES—Plains Areas use 0.10 Maximum Superelevation Rate.
Mountainous Areas & areas where icing conditions frequently exist, use 0.08 Maximum Superelevation Rate.

(R-3)
TABLE 2 ~ SUPERELEVATION RATES FOR SPECIAL CASES

Degree of Curve	25 M.P.H.		30 M.P.H.		35 M.P.H.		40 M.P.H.		45 M.P.H.		50 M.P.H.		55 M.P.H.		60 M.P.H.		Degree of Curve
	Required Super. Rate Ft./Ft.	Minimum Length of Transition or Spiral	Required Super. Rate Ft./Ft.	Minimum Length of Transition or Spiral	Required Super. Rate Ft./Ft.	Minimum Length of Transition or Spiral	Required Super. Rate Ft./Ft.	Minimum Length of Transition or Spiral	Required Super. Rate Ft./Ft.	Minimum Length of Transition or Spiral	Required Super. Rate Ft./Ft.	Minimum Length of Transition or Spiral	Required Super. Rate Ft./Ft.	Minimum Length of Transition or Spiral	Required Super. Rate Ft./Ft.	Minimum Length of Transition or Spiral	
0° 15'	NS	NS	NS	NS	NS	NS	NS	NS	NS	NS	NS	NS	NS	NS	NS	NS	0° 15'
0° 30'	NS	NS	NS	NS	NS	NS	NS	NS	NS	NS	NS	NS	NS	NS	NS	NS	0° 30'
0° 45'	NS	NS	NS	NS	NS	NS	NS	NS	NS	NS	NS	NS	NS	NS	NS	NS	0° 45'
1° 00'	NS	NS	NS	NS	NS	NS	NS	NS	NS	NS	NS	NS	NS	NS	NS	NS	1° 00'
1° 30'	NS	NS	NS	NS	NS	NS	NS	NS	NS	NS	NS	NS	NS	NS	NS	NS	1° 30'
2° 00'	.015	100'	.016	100'	.020	150'	.025	150'	.030	150'	.035	150'	.041	200'	.047	200'	2° 00'
2° 30'	.015	100'	.020	100'	.025	150'	.030	150'	.036	150'	.043	150'	.050	200'	.057	200'	2° 30'
3° 00'	.016	100'	.023	100'	.029	150'	.035	150'	.042	150'	.050	150'	.057	200'	.066	200'	3° 00'
3° 30'	.019	100'	.026	100'	.033	150'	.040	150'	.048	150'	.056	150'	.064	200'	.072	250'	3° 30'
4°	.021	100'	.029	100'	.037	150'	.044	150'	.053	150'	.062	150'	.069	200'	.076	250'	4°
5°	.026	100'	.035	100'	.044	150'	.053	150'	.062	150'	.070	150'	.077	200'	.084	250'	5°
6°	.031	100'	.041	100'	.050	150'	.060	150'	.069	150'	.076	150'	.083	200'	.089	250'	6°
7°	.035	100'	.045	100'	.056	150'	.066	150'	.074	150'	.082	150'	.089	200'	.095	250'	7°
8°	.039	100'	.050	100'	.061	150'	.071	150'	.078	150'	.086	150'	.092	200'	.098	250'	8°
9°	.043	100'	.054	100'	.065	150'	.074	150'	.080	150'	.088	150'	.094	200'	.100	250'	9°
10°	.046	100'	.058	150'	.069	150'	.077	200'	.084	200'	.091	200'	.097	200'	.100	250'	10°
11°	.049	100'	.061	150'	.072	200'	.079	200'	.086	200'	.092	200'	.098	200'	.100	250'	11°
12°	.052	100'	.065	150'	.075	200'	.082	200'	.088	200'	.094	200'	.099	200'	.100	250'	12°
13°	.054	100'	.067	150'	.077	200'	.084	200'	.090	200'	.096	200'	.100	200'	.100	250'	13°
14°	.057	100'	.070	150'	.078	200'	.085	200'	.091	200'	.097	200'	.100	200'	.100	250'	14°
15°	.059	100'	.072	150'	.079	200'	.086	200'	.092	200'	.098	200'	.100	200'	.100	250'	15°
16°	.061	100'	.074	150'	.080	200'	.087	200'	.093	200'	.099	200'	.100	200'	.100	250'	16°
17°	.063	100'	.076	150'	.082	200'	.089	200'	.095	200'	.100	200'	.100	200'	.100	250'	17°
18°	.065	100'	.077	150'	.083	200'	.090	200'	.096	200'	.100	200'	.100	200'	.100	250'	18°
19°	.067	100'	.078	150'	.084	200'	.091	200'	.097	200'	.100	200'	.100	200'	.100	250'	19°
20°	.069	100'	.079	150'	.085	200'	.092	200'	.098	200'	.100	200'	.100	200'	.100	250'	20°
21°	.070	100'	.080	150'	.086	200'	.093	200'	.099	200'	.100	200'	.100	200'	.100	250'	21°
22°	.072	100'	.082	150'	.088	200'	.095	200'	.100	200'	.100	200'	.100	200'	.100	250'	22°
23°	.073	100'	.083	150'	.089	200'	.096	200'	.100	200'	.100	200'	.100	200'	.100	250'	23°
24°	.075	100'	.085	150'	.091	200'	.098	200'	.100	200'	.100	200'	.100	200'	.100	250'	24°
25°	.076	100'	.086	150'	.092	200'	.099	200'	.100	200'	.100	200'	.100	200'	.100	250'	25°
26°	.077	100'	.087	150'	.093	200'	.100	200'	.100	200'	.100	200'	.100	200'	.100	250'	26°
27°	.078	100'	.088	150'	.094	200'	.100	200'	.100	200'	.100	200'	.100	200'	.100	250'	27°
28°	.079	100'	.089	150'	.095	200'	.100	200'	.100	200'	.100	200'	.100	200'	.100	250'	28°
29°	.079	100'	.089	150'	.095	200'	.100	200'	.100	200'	.100	200'	.100	200'	.100	250'	29°
30°	.080	100'	.090	150'	.096	200'	.100	200'	.100	200'	.100	200'	.100	200'	.100	250'	30°
32°	.080	100'	.090	150'	.096	200'	.100	200'	.100	200'	.100	200'	.100	200'	.100	250'	32°
35°	.080	100'	.090	150'	.096	200'	.100	200'	.100	200'	.100	200'	.100	200'	.100	250'	35°

NOTES—
Transition or Spiral Lengths are shown in the tables for 4 Lane Divided Highways.
For 6 Lane Divided Highways use 1.2 times the lengths shown, rounded to the nearest 50 feet.

Table 2 data may be used for City Streets & Interchanges.
NS = Normal Slope section.

Do nothing to inside lanes. Superelev outside lanes at rate shown in tables.

DEPARTMENT OF HIGHWAYS
STATE OF COLORADO
DIVISION OF HIGHWAYS

SUPERELEVATION
OF CURVES
DIVIDED HIGHWAYS

Designed by S.B.L. Approved by S.B.L.
Made by S.B.L. Staff Design Engr.
Checked by L.E.O. Date July 1, 1965


STANDARD SIDE APPROACH ROADS, FLARING, CUT SLOPE TREATMENT & WIDENING AT BRIDGES AND AT CREST OF GRADES

STANDARD M-203-B

(JULY 1, 1965)

FILE NO.	DIVISION	PROJECT NO.	SHEET NO.
1	COLO		

GENERAL DETAILS FOR FLARING OF EARTH CUTS, CUT SLOPE TREATMENT & WIDENING AT BRIDGES

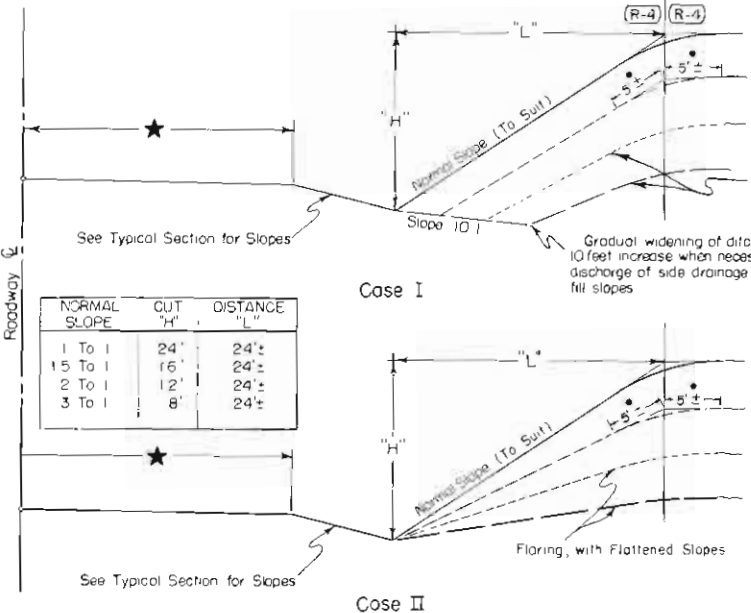


FLARING OF EARTH CUTS The backlopes at ends of all earth cuts shall be flattened & where necessary the ditch shall be widened gradually to discharge side ditch drainage away from the base of adjacent fill slopes in order to avoid erosion & to improve appearance. The transition of flattened backlopes & widened ditch shall be constructed in such a manner that a uniform appearance of slope & ditch results. Backlopes shall be flared to the approximate "L" distance shown on Slope Table included with this detail. Rock cuts shall not be flared.

CUT SLOPE TREATMENT IN EARTH CUTS The intersection of cut slopes with the existing ground shall be rounded in earth cuts, beginning outside the slope stake and extending down the cut slope. The exact dimension will be determined by the Engineer based on the type of material encountered.

Quantities shall be included in "Unclassified Excavation"

WIDENING AT BRIDGE APPROACHES: Roadway embankment at bridge approaches shall be so constructed that base of surfacing at shoulder point is a minimum of 2 ft. beyond the edge of bridge deck. Where widening is necessary to achieve this result it shall take place gradually over a distance of 300 ft.

PLAN OF FLARING IN EARTH CUTS

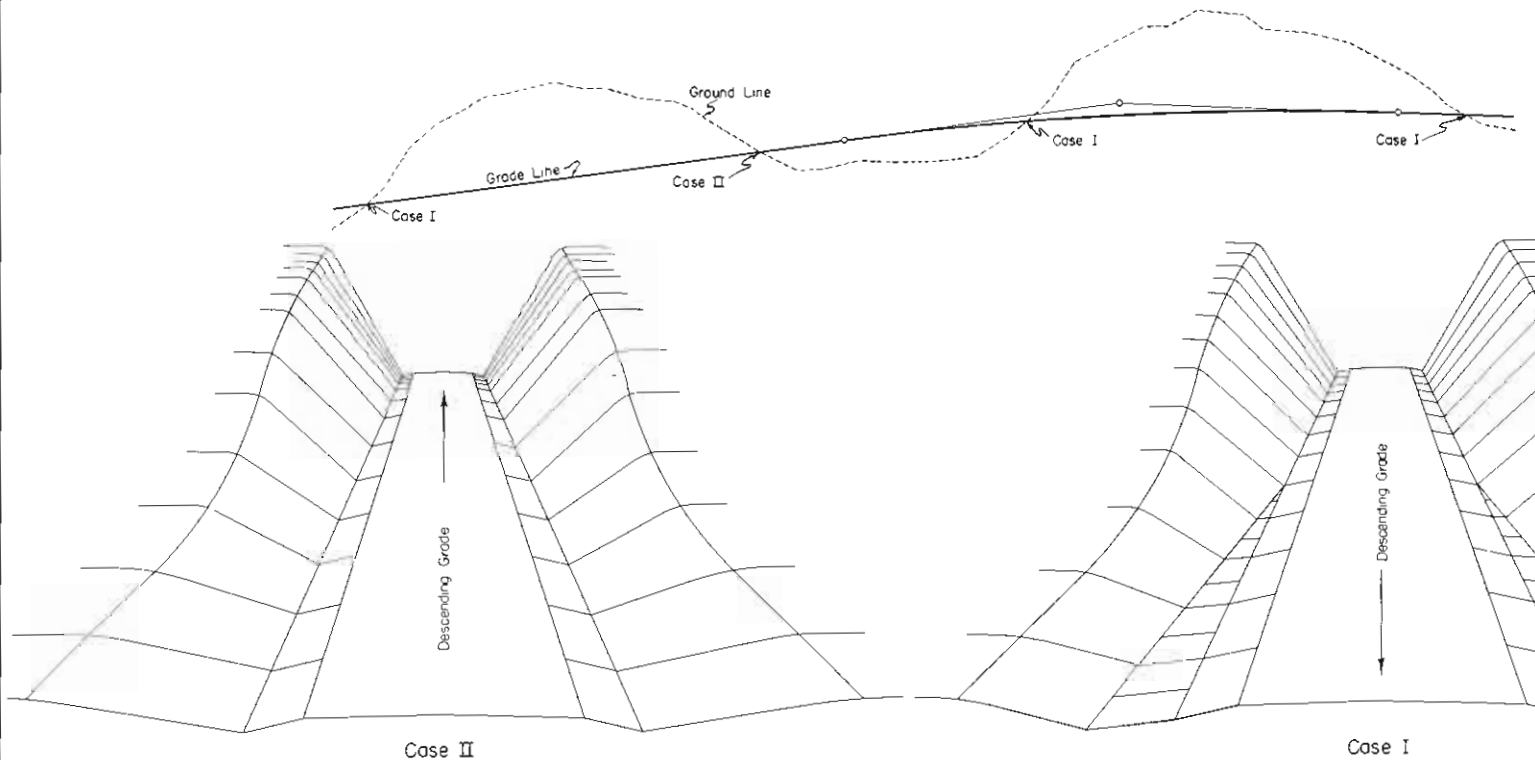


TYPICAL PLANS FOR SIDE APPROACH ROADS AND EMERGENCY MEDIAN CROSS OVERS

Where practical Side Drains are to be placed in line with the roadway ditches


50' Radii to be used on all intersecting roads except private approaches

Radii may be varied to suit field conditions

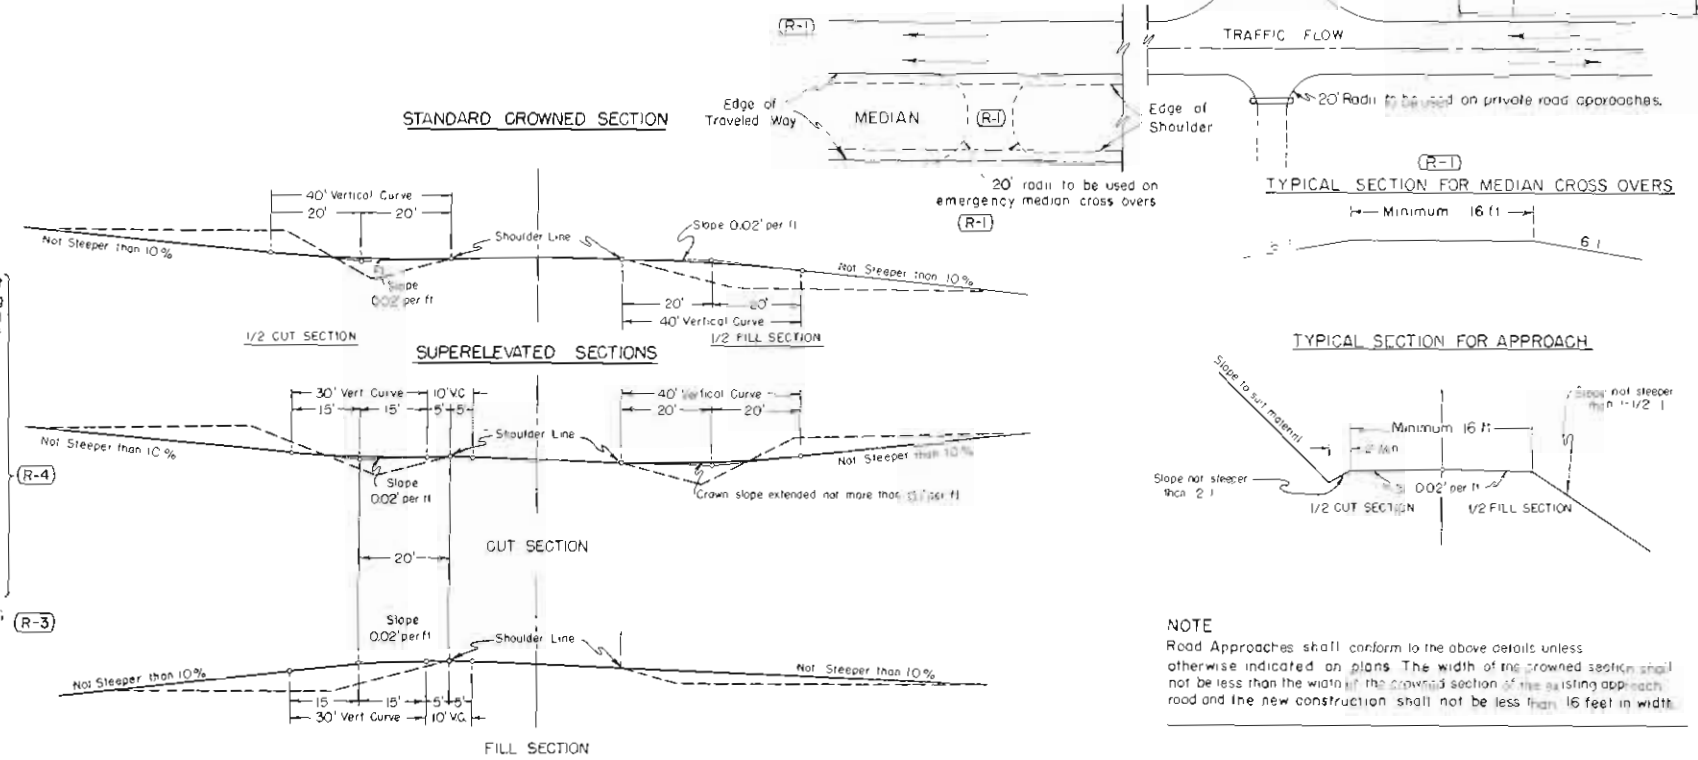

NOTE
Road Approaches shall conform to the above details unless otherwise indicated on plans. The width of the crowned section shall not be less than the width of the existing approach road and the new construction shall not be less than 16 feet in width.

DETAILS FOR DITCH & WIDENED SHOULDERS AT CREST OF GRADES (TO BE USED ONLY WHERE SIGHT DISTANCE AT CREST OF GRADE IS 600 FT OR LESS)

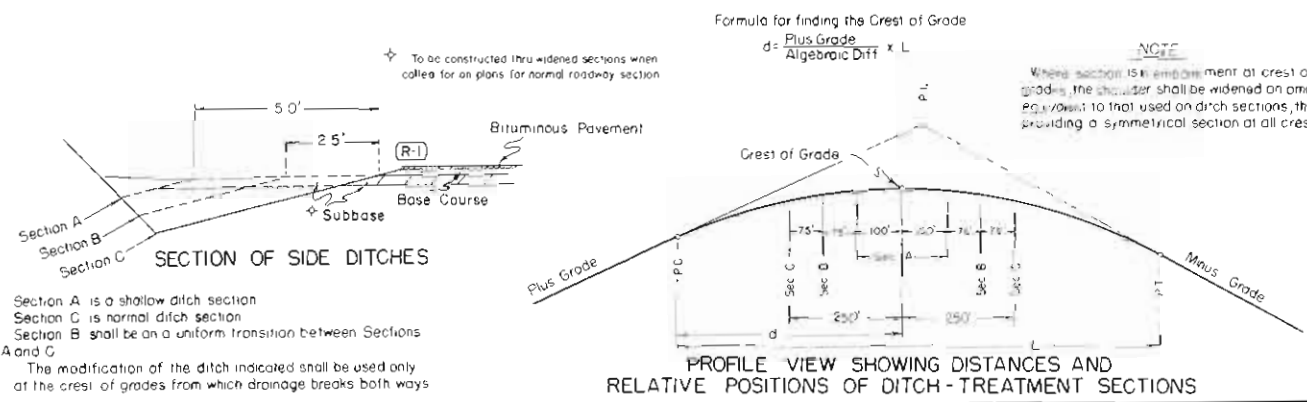

GENERAL NOTES

All work shall be done in accordance with the Standard Specifications applicable to the Project


All side approach roads to the Project shall be Gravel Surfaced with a 4 inch thickness of Aggregate Base Course extending approximately to the Right of Way Line. Estimated tonnage and class of material required for this operation are shown in the Aggregate Base Course Plan

The maximum grades shown are to be the limiting grades for all road approaches and no higher grades will be permitted where adherence to the grades as shown would cause drainage to imperil or create other unsatisfactory conditions. Grades flatter than limiting shown are to be used wherever feasible

DEPARTMENT OF HIGHWAYS
STATE OF COLORADO
DIVISION OF HIGHWAYS
APPROACH ROADS,
FLARING, CUT SLOPE TREATMENT,
BRIDGE & CREST WIDENING


Designed by J. Z. Approved by J. E. W. Staff Design Engr.
Made by J. M. B. Checked by C. R. S. Date: July 1, 1965

CONCRETE BOX CULVERTS & WINGWALLS

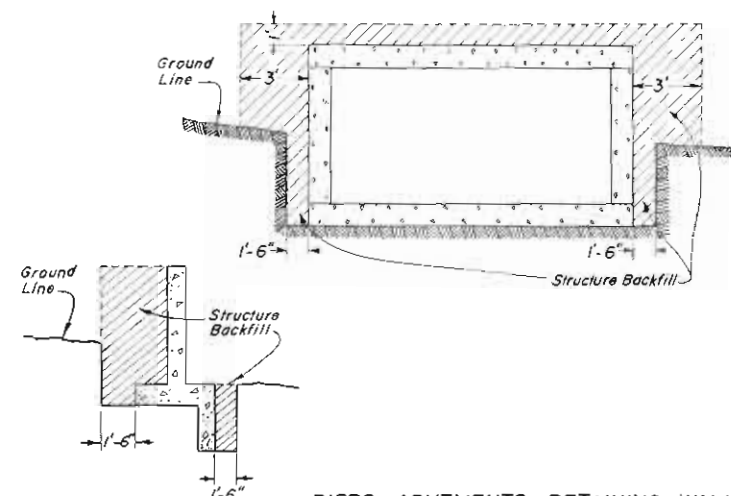


PIERS, ABUTMENTS, RETAINING WALLS ETC.

All material that is to be compacted shall be placed in horizontal layers not more than 6" inches in depth and compacted before the next layer is placed. For Arches, Rigid Frames and Box Culverts the fill shall be brought up uniformly on both sides of the center of structure to avoid stresses in the structure caused by unsymmetrical loading.

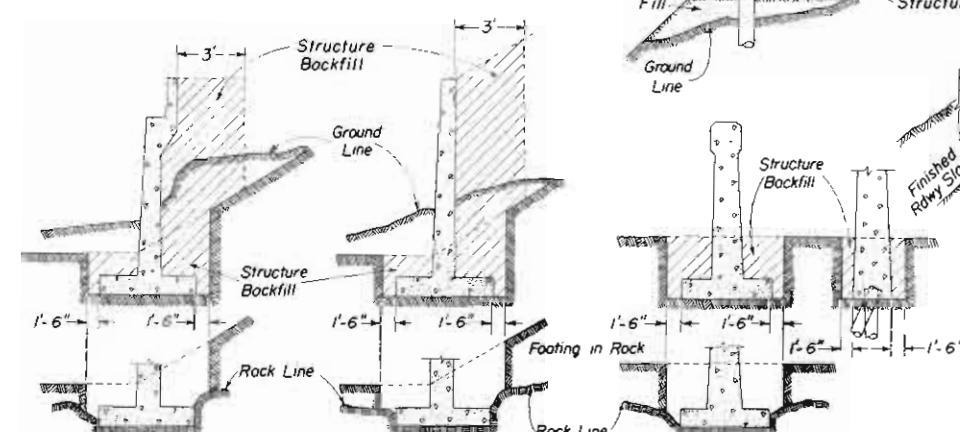


DROP INLETS, DIVISION BOXES, INTERCEPTING HEADWALLS, ETC.

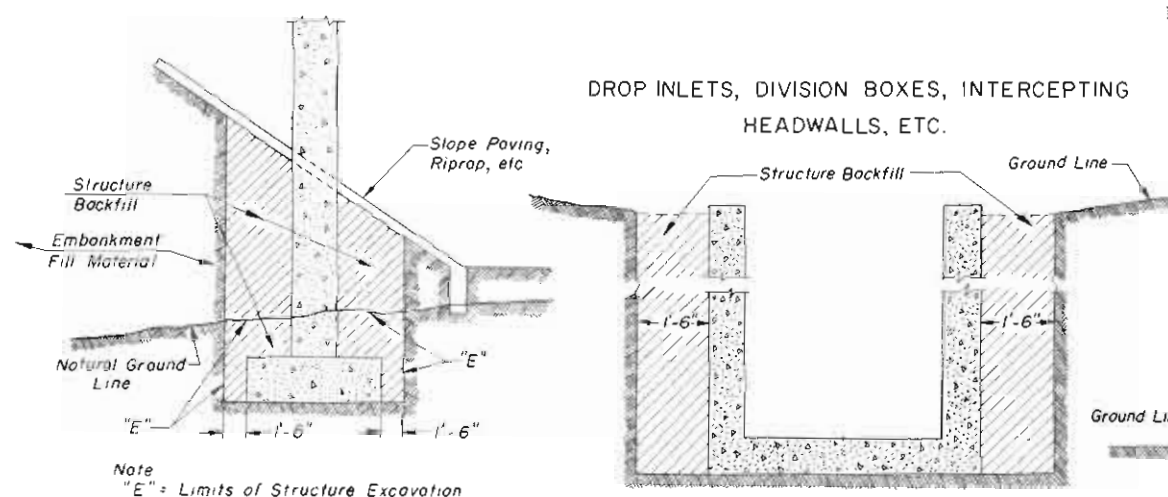

Note "E" = Limits of Structure Excavation


CAST IN PLACE CONDUIT

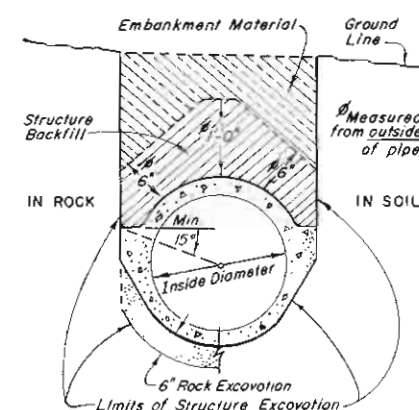


STANDARD M-206-AA

(MARCH 1, 1971)
(SHEET 1 OF 2)


CIRCULAR CONDUIT

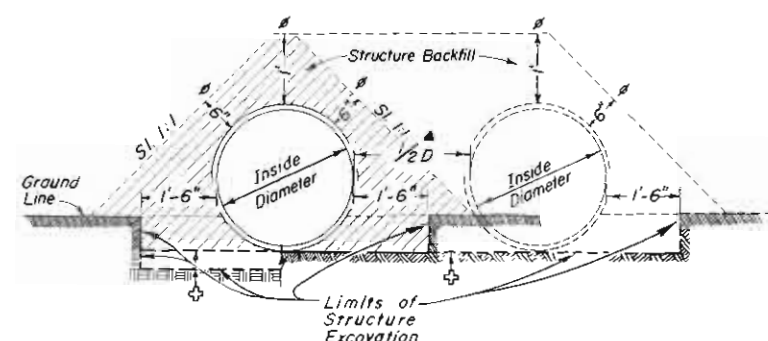


ELLIPTICAL OR ARCH CONDUIT

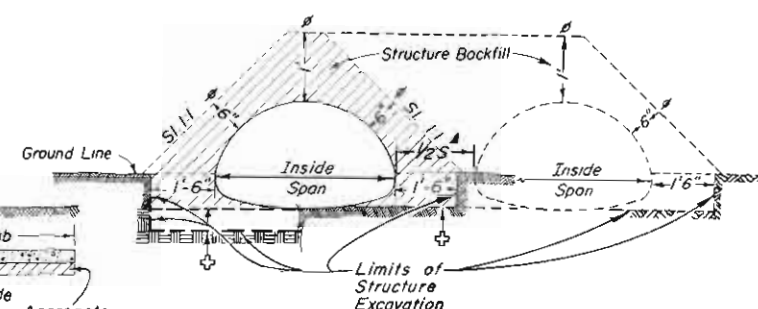

HEADWALLS AND END OF CULVERTS

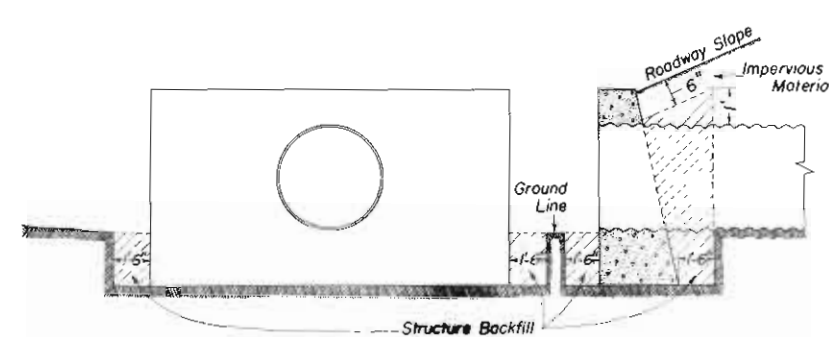

SIPHONS OR CONDUIT IN TRENCH

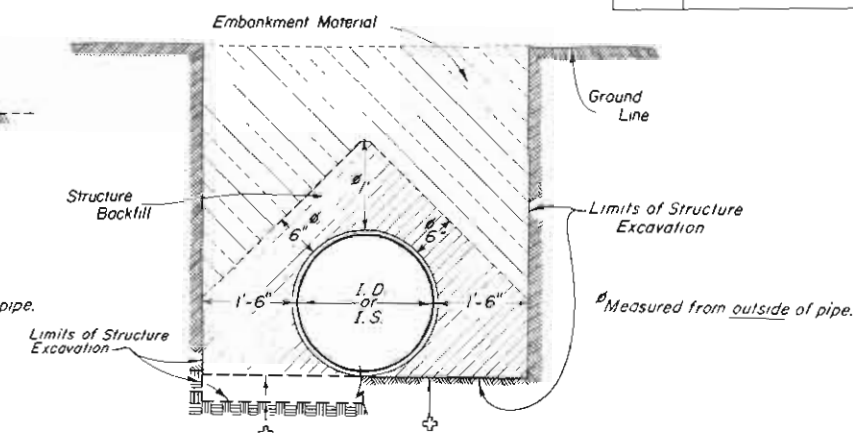

NOTES:

When two or more conduits are laid side by side they shall be spaced so that the adjacent pipes will be $\frac{1}{2}I.D.$, $\frac{1}{2}I.S.$ or 3 feet apart (including wall thickness), whichever is less. Minimum spacing shall be not less than 1 foot between outside walls of pipe.
For additional culvert installation details see M Standards for metal, concrete, or structural plate pipe culverts.

Bottom of trench as excavated. For applicable limits of Structure Excavation, see bedding details on standards for culverts.

GENERAL NOTES

All work shall be done according to the Standard Specifications applicable to the Project.


Where the roadway cross section is in fill, excavation for concrete footings (except those in rock or those on piles) and for box culverts shall be done according to the following.

Embankment shall be built up and compacted to a point one foot above the bottom of the box or one foot above the bottom of the footing. The trench shall then be excavated to accommodate construction of the box or footing.

Excavation and backfill patterns different from those indicated on these sheets will be shown elsewhere on the plans.

Excavation for structure installation shall be classified as "Structure Excavation" unless otherwise shown on plans.

TRENCH FOR PIPE UNDERDRAIN

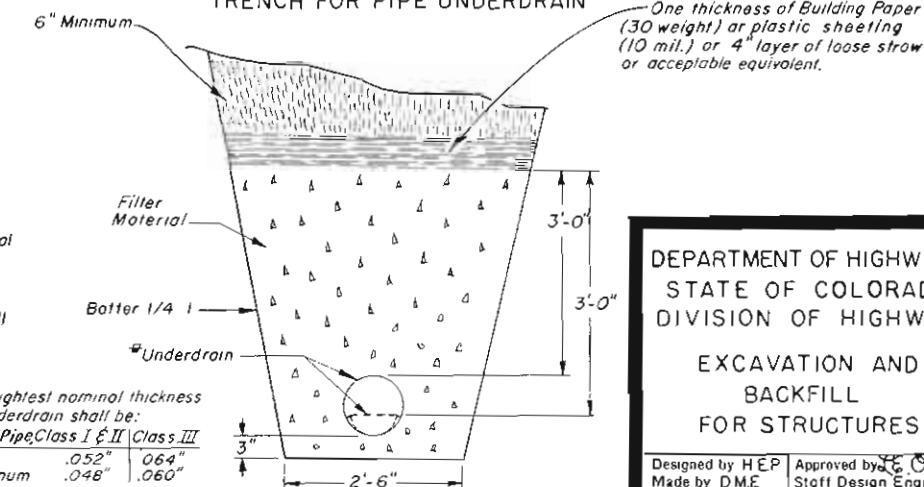

The lightest nominal thickness for underdrain shall be:
Type III Pipe Class I & II Class III
Steel .052" .064"
Aluminum .048" .060"

DEPARTMENT OF HIGHWAYS
STATE OF COLORADO
DIVISION OF HIGHWAYS

EXCAVATION AND
BACKFILL
FOR STRUCTURES

Designed by HEP
Made by DME
Checked by LEO
Approved by [Signature]
Staff Design Engr.
Date: March 1, 1971


STANDARD M-206-AA

(MARCH 1, 1971)
(SHEET 2)


FEDERAL ROAD REGION NO	DIVISION	PROJ NO	SHEET NO	TOTAL SHEETS
9	COLORADO			

REVISIONS	



STRUCTURE EXCAVATION MEASUREMENT FOR PIPE CULVERTS

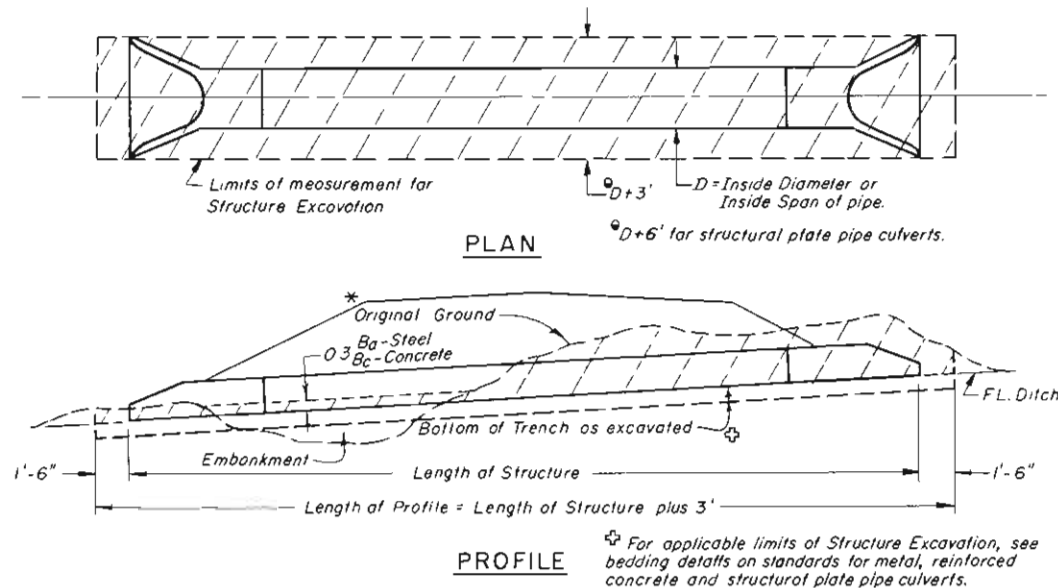

STRUCTURE EXCAVATION MEASUREMENT FOR CONCRETE BOX CULVERTS

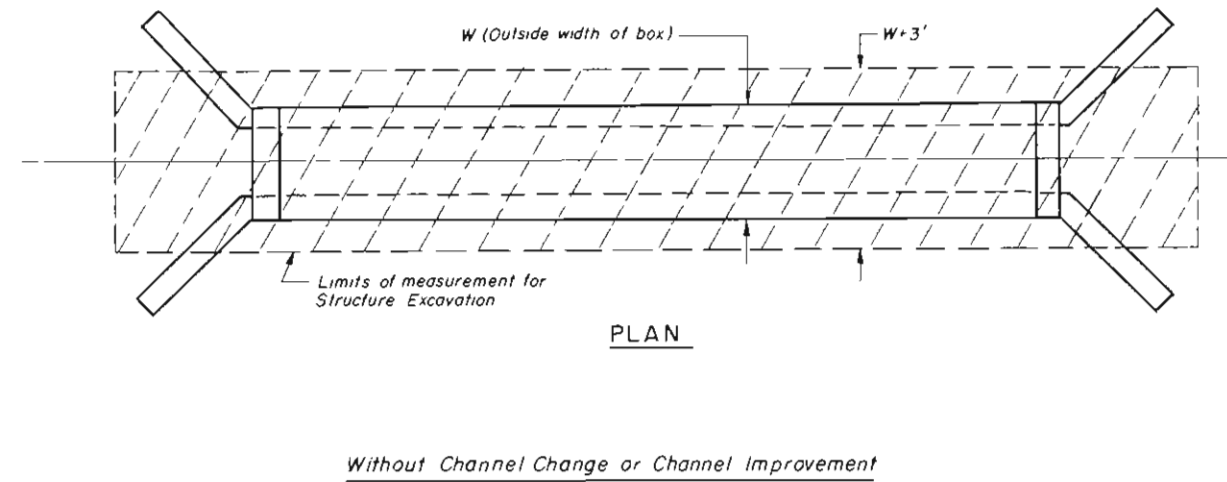

STRUCTURE EXCAVATION MEASUREMENT FOR DIVERSION OR DIVISION BOXES

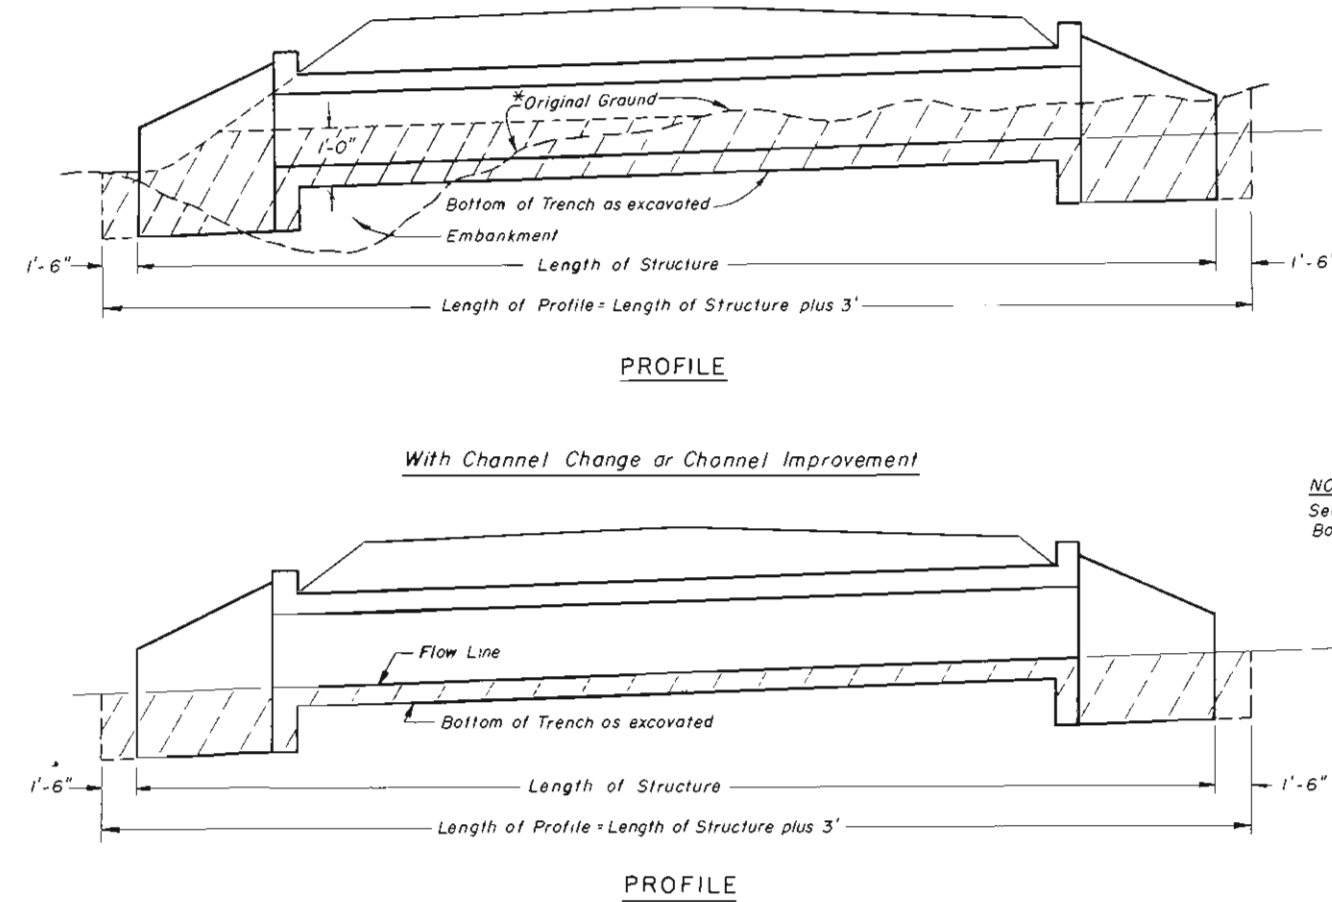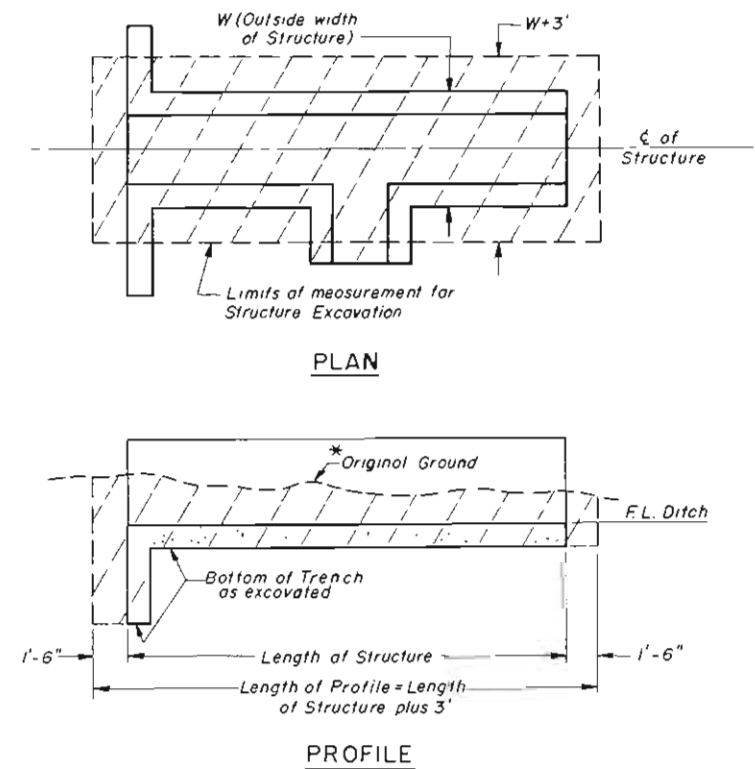

NOTE:
See Sheet 1 for General Notes and Backfilling Details

* Along ζ of Structure

Areas to be used for Structure Excavation computations

DEPARTMENT OF HIGHWAYS
STATE OF COLORADO
DIVISION OF HIGHWAYS

EXCAVATION AND BACKFILL FOR STRUCTURES

Designed by M R H
Made by H P B
Checked by





Approved by *[Signature]*
Staff Design Engr
Date March 1, 1971

STANDARD M-500-A
(JULY 1, 1965)

PER. HAND NO.	DIVISION	PROJECT NO.	SHEET NO.
9	SULO.		



abcdefghijklmnopqrstuvwxyz

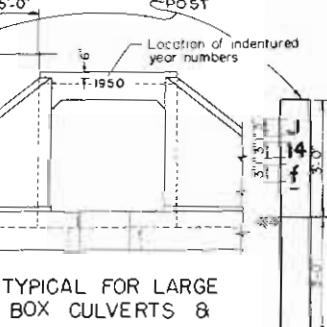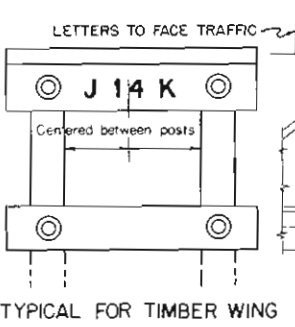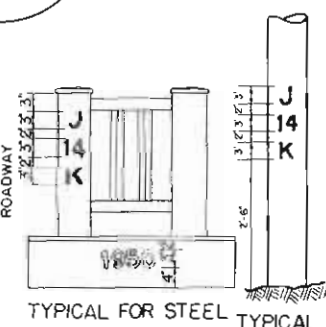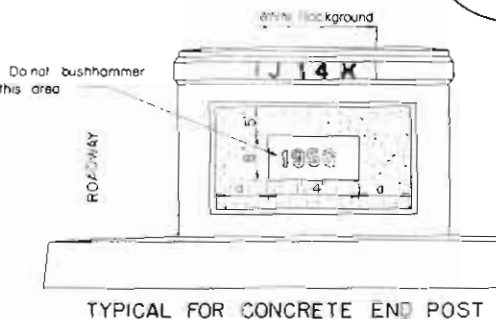

SAMPLE BRIDGE NUMBER

GENERAL NOTES

SAMPLE YEAR NUMBER

ALL WORK SHALL BE DONE IN ACCORDANCE WITH THE STANDARD SPECIFICATIONS APPLICABLE TO THE PROJECT. THE SIZE, SHAPE AND SPACING OF THE LETTERS AND FIGURES SHALL BE IN ACCORDANCE WITH THE FULL SIZE SHOWN ON THIS SHEET. ADDITIONAL COPIES OF THIS FULL SIZE SHEET CAN BE OBTAINED FROM THE DEPARTMENT WITHOUT CHARGE.

THE YEAR NUMBERS ARE RECESSED IN CONCRETE TO A MINIMUM AS SHOWN IN THE PANEL OF THE ENDPOST ON THE RIGHT HAND SIDE OF EACH BRIDGE END AND INTO THE FACE OF THE DOWNSTREAM HEADWALL OF CULVERTS AS SHOWN ON PLAN DETAILS. NUMBERS TO BE MADE OF WOOD, METAL OR OTHER SUITABLE MATERIAL AND ATTACHED TO THE FORMS BEFORE CONCRETE IS POURED. THE YEAR NUMBER OF EACH STRUCTURE SHALL CORRESPOND WITH THE YEAR IN WHICH THE CONCRETE IS POURED.

THE STRUCTURE NUMBER SHALL BE STENCILED ON THE RIGHT HAND SIDE OF EACH BRIDGE END AS SHOWN ON THIS STANDARD AND AS SPECIFIED WHERE THE STRUCTURE HAS NO END POSTS. THE NUMBER SHALL BE PLACED ON A POST ON THE RIGHT HAND SIDE OF THE ROAD AS SHOWN FOR SIGNS. THE NUMBER SHALL BE PLACED ON SIGN POSTS ON THE RIGHT HAND SIDE OF THE ROADWAY.

THE CORRECT NUMBER FOR EACH BRIDGE OR SIGN IS SHOWN ON THE PLANS.

THE NUMBERS FOR MAJOR STRUCTURES OF OVER 20 FEET CLEAR SPAN SHALL BE UPPER CASE LETTERS. THE NUMBERS FOR MINOR STRUCTURES OF 12 TO 20 FEET CLEAR SPAN SHALL BE LOWER CASE LETTERS. SIGN BRIDGES SHALL BE CONSIDERED AS MAJOR STRUCTURES.

A PERMANENT WHITE BACKGROUND RECTANGULAR IN SHAPE AND EXTENDING THREE INCHES BEYOND THE LIMITS OF THE NUMBER SHALL BE PAINTED WITH TWO COATS OF ACCEPTABLE WHITE PAINT. UNLESS AN APPROVED WHITE CONCRETE PAINT IS USED, BEFORE PAINTING THE SURFACE MUST BE THOROUGHLY DRIED, CLEANED AND PROPERLY OILED ON TIMBER HANDRAILS. THE WHITE PAINT USED ON THE BRIDGE WILL BE SATISFACTORY.

AFTER THE WHITE BACKGROUND HAS DRIED SUFFICIENTLY, THE CORRECT STRUCTURE NUMBER SHALL BE CAREFULLY STENCILED WITH "EXTERIOR BLACK PAINT" AS SPECIFIED IN SECTION 708 - PAINTS, OR AN ACCEPTABLE EQUIVALENT. THE BACKER OF THE STENCILED LETTERS AND FIGURES SHALL BE CAREFULLY FILLED IN BY HAND TO MAKE SOLID FIGURES.

SUFFICIENT TIME BETWEEN SUCCESSION COATS SHALL BE ALLOWED TO PERMIT THORO DRYING.

THE COST OF PAINTING OF STRUCTURE NUMBERS AND FURNISHING AND PLACING POSTS FOR STRUCTURE NUMBERS SHALL BE CONSIDERED SUBSIDIARY WORK AND SHALL BE INCLUDED IN THE ORIGINAL CONTRACT ITEMS AND WILL NOT BE PAID FOR AS SEPARATE ITEMS.

THE LENGTH OF SPAN OF STRUCTURE SHALL BE MEASURED ALONG CENTER LINE OF ROADWAY. IN CASE OF DOUBLE OR MULTIPLE BOX CULVERTS THE CENTER WALL OR WALLS SHALL BE DISREGARDED AND CLEAR SPAN MEASURED FROM INSIDE OF END WALLS.

IN ADDITION TO THE REQUIREMENTS STATED ABOVE, STRUCTURE NUMBERS FOR HIGHWAYS PASSING UNDER CROSSROADS ARE TO BE PLACED AT THE FOLLOWING POINTS:

(A) FOR STRUCTURES OF 3 OR MORE SPANS, THE STRUCTURE NUMBER SHALL BE STENCILED, FACING TRAFFIC, ON THE OUTSIDE FACE OF THE END COLUMNS OF THE RIGHT-HAND PIER.

(B) FOR 2-SPAN STRUCTURES, THE STRUCTURE NUMBER SHALL BE STENCILED, FACING TRAFFIC, ON THE OUTSIDE FACE OF EACH END COLUMN IN THE CENTER PIER.

REVISIONS

DEPARTMENT OF HIGHWAYS
STATE OF COLORADO

LETTERS AND FIGURES
FOR
STRUCTURE NUMBERS

Designed by _____
Made by _____
Checked by _____

Approved by *H. H. Marshall*
Bridge Engineer
Date: July 1, 1965

STANDARD M-603-CA (NOVEMBER 10, 1967)

FEDERAL ROAD DISTRICT NO.	DIVISION	PROJ. NO.	SHEET NO.	TOTAL SHEETS
1	COLORADO			

REVISIONS				
(R-1)	4-19-68	Welding—Conc. Arch, Ellipt.—Gen. Notes	M.R.H.	
(R-2)	7-23-68	Dep't. Name	M.R.H.	
(R-3)	3-10-71	Change all gage to thickness	M.R.H.	
(R-4)	6-25-71	General Note for Joint Fasteners	M.R.H.	

GENERAL NOTES

All work shall be done in accordance with the Standard Specifications applicable to the project.

Concrete End Sections are to be furnished with tongue or groove as req'd. Alternate equivalent designs for Concrete End Sections may be submitted to the Division for approval. Design length of culvert is based on length of End Section shown in table. Additional pipe required to provide the design length of the culvert shall be furnished by and at the expense of the Contractor.

Other sizes of concrete pipe and end sections may be available upon request, however, the designer should contact supplier prior to calling for sizes other than those shown on this standard.



Inside configuration and joint of concrete end section and pipe shall match.

Galvanized Toe Plate as shown will be required on End Sections for corrugated steel pipe and shall be same thickness as End Sections. Toe Plate shall be field bolted to End Section with 3/8" galvanized bolts, nuts and washers.

Designs for Aluminum End Sections for use on aluminum culverts shall be submitted to the Division for approval prior to use.




Concrete Pipe Joint Fasteners, where shown on plans, shall be installed so that a minimum of 15 linear feet of the outlet end of the pipe are mechanically locked together. End Section lengths, when used, will be included in the 15 l.f. requirement.

DIMENSIONS							
PIPE DIAM. (in.)	THICKNESS (in.)	A (1"±)	B (Max.)	H (1"±)	L (11/2"±)	W (2"±)	T (in.)
12	.064	6	6	6	21	24	34
15	.064	7	8	6	26	30	40
18	.064	8	10	6	31	36	46
24	.064	9	12	6	36	42	52
24	.064	10	13	6	41	48	58
30	.079	12	16	8	51	60	70
36	.079	14	19	9	60	72	84
42	.109	16	22	11	69	84	106
48	.109	18	27	12	78	90	112
54	.109	18	30	12	84	102	124
60	.109	18	33	12	87	114	136
66	.109	18	36	12	87	120	142
72	.109	18	39	12	87	126	148
78	.109	18	42	12	87	132	154
84	.109	18	45	12	87	138	160

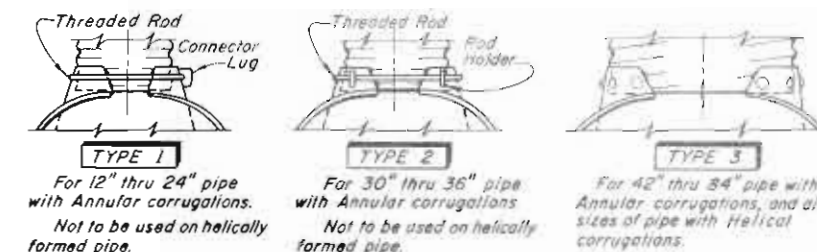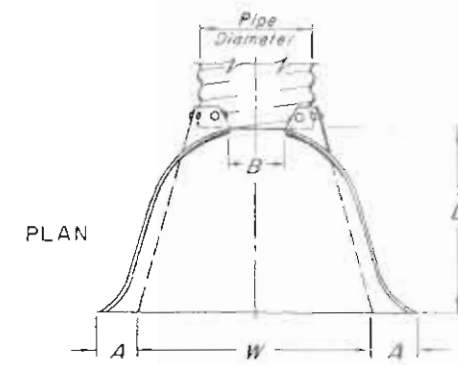

NOTE: Type 3 connections shall consist of an end section shop attached to a minimum 2 ft. of pipe with galvanized rivets or bolts, or by welding.


TYPICAL CONNECTIONS END SECTION AND CONNECTION DETAILS FOR ROUND CORRUGATED STEEL PIPE CULVERTS

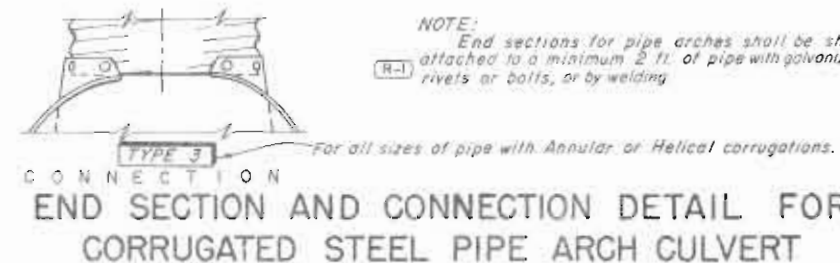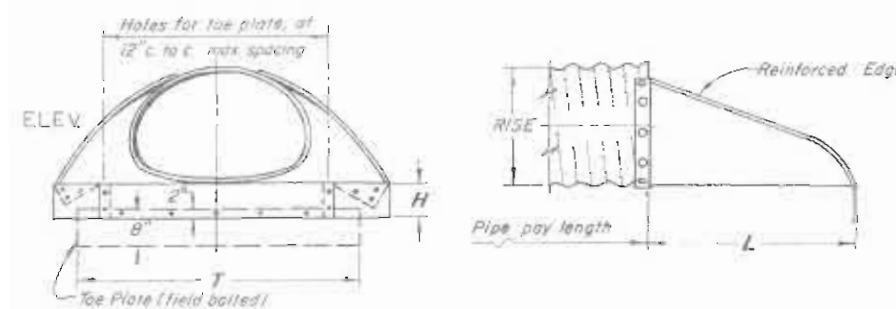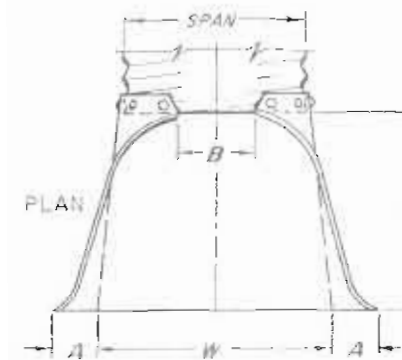


NOTE: End sections for pipe arches shall be shop attached to a minimum 2 ft. of pipe with galvanized rivets or bolts, or by welding.

For all sizes of pipe with Annular or Helical corrugations.


CONNECTION END SECTION AND CONNECTION DETAIL FOR CORRUGATED STEEL PIPE ARCH CULVERT

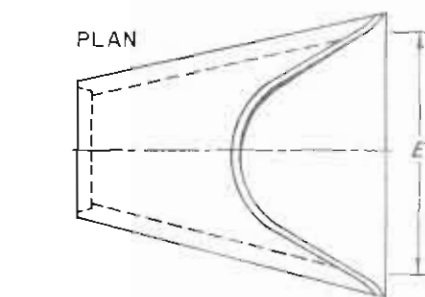


DIMENSIONS					
PIPE I.D. (in.)	A (in.)	B (in.)	C (in.)	D (in.)	E (in.)
12	3 1/2	23	49	72	24
15	7	26	47	73	29
18	11 1/2	26	48	74	36
24	12	43	54	97	48
30	17	53	63	96	60
36	18	60	67	97	71
42	24	61	66	97	78
48	28	70	78	98	84
54	27	65	73	100	90
60	36	78	90	98	96
72	34 1/2	75	81	96	108

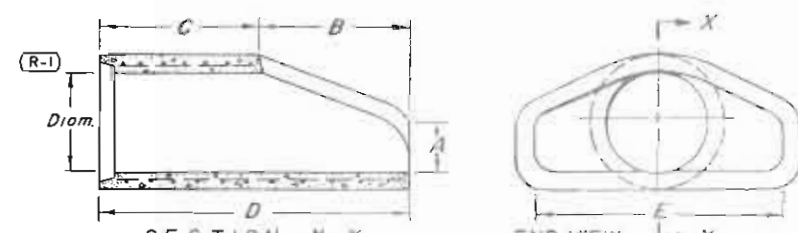

SECTION X-X END SECTION FOR REINFORCED CONCRETE CIRCULAR PIPE

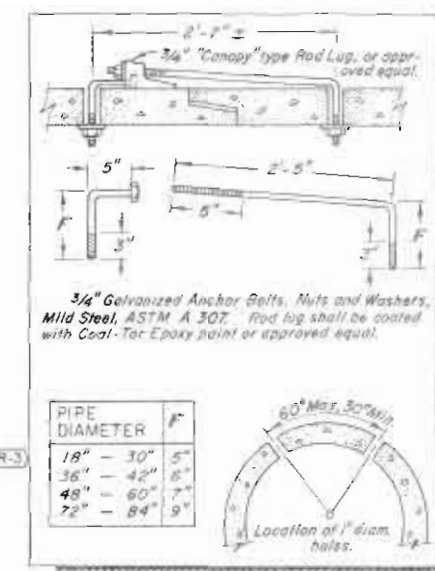


CONCRETE JOINT FASTENER

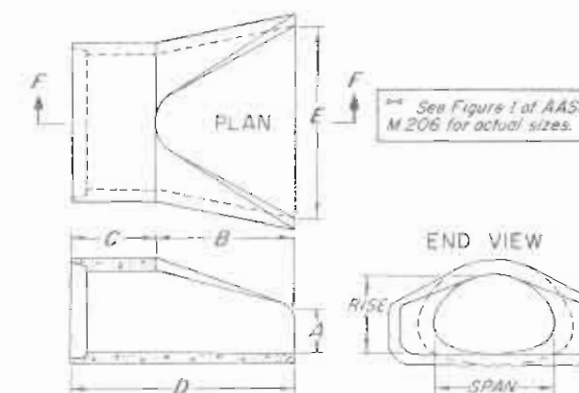

DIMENSIONS (inches)							
EQUIVALENT CIRCULAR DIAM. (inches)	NOMINAL (in.)	SPAN	RISE	A	B	C	D
24	29	18	8 1/2	39	33	72	48
30	36	22	9 1/2	50	46	96	60
36	43	27	11 1/2	60	56	96	72
42	50	31	13 1/2	60	56	96	78
48	58	36	21	60	56	96	84
54	65	40	25 1/2	60	56	96	90
60	72	44	31	60	56	96	96
72	88	54	31	60	56	99	120

END SECTION FOR REINFORCED CONCRETE ARCH PIPE

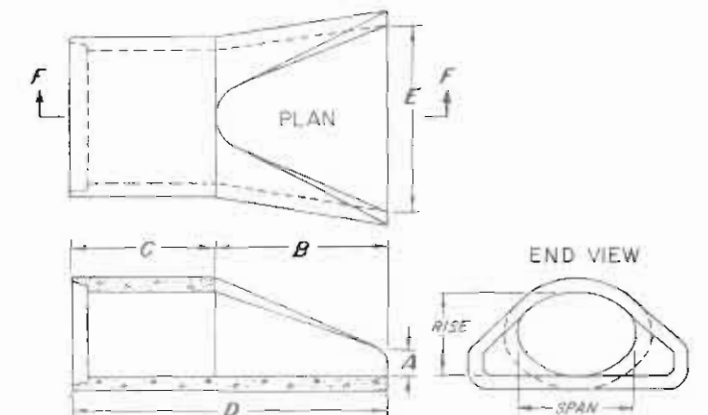

DIMENSIONS (inches)							
EQUIVALENT CIRCULAR DIAM. (inches)	NOMINAL (in.)	SPAN	RISE	A	B	C	D
24	30	19	8 1/2	39	33	72	48
30	36	24	9 1/2	54	46	96	60
36	45	29	11 1/2	60	56	96	72
42	53	34	15 1/2	60	56	96	78
48	60	38	21	60	56	96	84
54	68	43	25 1/2	60	56	96	90
60	76	48	30	60	56	96	96

END SECTION FOR REINFORCED CONCRETE ELLIPTICAL PIPE

DEPARTMENT OF HIGHWAYS
STATE OF COLORADO
DIVISION OF HIGHWAYS
CONCRETE AND METAL
END SECTIONS

Designed by: M.R.H. Approved by: J.R.B.
Made by: J.R.B. Staff Design Engineer
Checked by: A.S.M. Date: November 10, 1967

STANDARD M-603-M

(MARCH 20, 1967)

FEDERAL ROAD DISTRICT NO.	DIVISION	PROJ. NO.	SHEET NO.	TOTAL SHEETS
9	COLORADO			

REVISIONS			
R-1	4-5-68	Added notes.	M.R.H.
R-2	7-23-68	Dept. Name & Note	M.R.H.
R-3	2-11-71	Thickness Tables, General Notes	M.R.H.

FILL HEIGHT & THICKNESS TABLES FOR METAL CULVERT PIPE (RIVETED, WELDED OR HELICAL FABRICATION)

TABLE I
CORRUGATED STEEL PIPE

(2" x 1/2") OR (2-2/3" x 1/2") CORRUGATIONS

PIPE SIZE (B _g) Inches	AREA (Sq. Ft.)	HEIGHT OF FILL OVER TOP OF PIPE IN FEET															
		1 to 10	10+ to 15	15+ to 20	20+ to 25	25+ to 30	30+ to 35	35+ to 40	40+ to 45	45+ to 50	50+ to 55	55+ to 60	60+ to 70	70+ to 80	80+ to 90	90+ to 100	
THICKNESS IN INCHES																	
12	0.8	.064	.064	.064	.064	.064	.064	.064	.064	.064	.064	.064	.064	.064	.079	.109	
15	1.2	.064	.064	.064	.064	.064	.064	.064	.064	.064	.064	.064	.064	.079	.109	.138	
18	1.8	.064	.064	.064	.064	.064	.064	.064	.064	.079	.079	.109	.109	.138	.168		
24	3.1	.064	.064	.064	.064	.064	.079	.109	.138	.168							
30	4.9	.064	.064	.064	.064	.079	.079	.109	.109	.138	.168						
36	7.1	.064	.064	.064	.064	.079	.109	.138	.168								
42	9.6	.064	.064	.064	.064	.064	.079	.109									
48	12.6	.064	.064		.064	.079	.079	.109	.168								
54	15.9	.079	.079	.079	.079	.079	.109	.105									
60	19.6	.109	.109	.109	.109	.109	.109	.138									
66	23.8	.109	.109		.109	.109	.138	.168									
72	28.3	.138	.138	.138	.138	.168											
78	33.0	.168	.168	.168	.168												
84	38.0	.168	.168	.168													

----- See General Note.


--- See General Note.

TABLE II
CORRUGATED STEEL PIPE ARCH


(2" x 1/2") OR (2-2/3" x 1/2") CORRUGATIONS

PIPE SIZE Span- Rise (Inches)	AREA (Sq.Ft.)	CORNER RADIUS (Inches)	HEIGHT OF FILL OVER TOP OF PIPE IN FEET							
			1.5 to 7	7+ to 8	8+ to 9	9+ to 10	10+ to 12	12+ to 13		
			THICKNESS IN INCHES							
18 x 11	1.1	3 1/2	.064	.064	.064	.064	.064	.064	.064	
22 x 13	1.6	4	.064	.064	.064	.064	.064	.064	.064	
25 x 16	2.2	4	.064	.064	.064	.064	.064	.064	.064	
29 x 18	2.8	4 1/2	.064	.064	.064	.064	.064	.064	.064	
36 x 22	4.4	5	.064	.064	.064	.064	.064	.064	.064	
43 x 27	6.4	5 1/2	.064	.064	.064	.064	.064	.064	.064	
50 x 31	8.7	6	.079	.079	.079	.079	.079	.079	.079	
58 x 36	11.4	7	.109	.109	.109	.109	.109	.109	.109	
65 x 40	14.3	8	.109	.109	.109	.109	.109	.109	.109	
72 x 44	17.6	9	.138	.138	.138	.138	.138	.138	.138	

METAL CULVERT WITH END SECTIONS

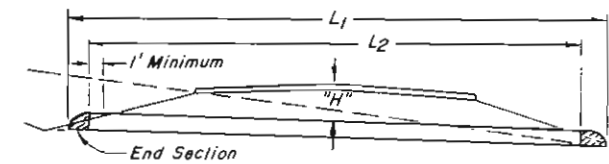

METAL CULVERT WITHOUT END SECTIONS

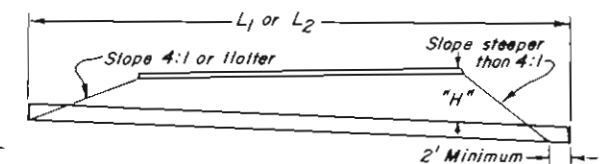

"H" = Maximum height of fill over top of Culvert, including pavement.

L1 = Length of Culvert to be measured when placed in accordance with Section 617.

L2 = Length of pipe to be measured when placed in accordance with Section 603.

(R-1) Length of extension, when placed in accordance with Section 617, shall be the actual number of feet of new culvert required.

TABLE III
CORRUGATED STEEL PIPE

3" x 1" CORRUGATIONS

PIPE SIZE (Bq) Inches	AREA (Sq. Ft.)	HEIGHT OF FILL OVER TOP OF PIPE IN FEET															
		1 to 10	10 to 15	15 to 20	20 to 25	25 to 30	30 to 35	35 to 40	40 to 45	45 to 50	50 to 55	55 to 60	60 to 70	70 to 80			
		THICKNESS IN INCHES															
36	7.1	.064	.064	.064	.064	.064	.079	.079	.109	.109	.109	.138	.168				
42	9.6	.064	.064	.064	.064	.079	.079	.079	.109	.109	.109	.109	.168				
48	12.6	.064	.064	.064	.079	.079	.079	.109	.109	.109	.138	.168					
54	15.9	.064	.064	.064	.079	.079	.109	.109	.138	.168							
60	19.6	.064	.064	.064	.079	.109	.109	.109	.138								
66	23.8	.064	.064	.079	.079	.109	.109	.138									
72	28.3	.064	.064	.079	.109	.109	.109	.138									
78	33.0	.064	.064	.079	.109	.138	.168										
84	38.0	.079	.079	.079	.109	.109											
90	44.0	.079	.079	.109	.109	.109											
96	50.3	.109	.109	.109	.109	.138											
102	57.0	.109	.109	.109	.109												
108	64.0	.109	.109	.109	.138												
114	70.9	.138	.138	.138	.168												
120	78.6	.138	.138	.138	.168												

----- See General Note.

--- See General Note.

TABLE IV
CORRUGATED STEEL PIPE

3" x 1" CORRUGATIONS

PIPE SIZE (Bq) Inches	AREA (Sq.Ft)	HEIGHT OF FILL OVER TOP OF PIPE IN FEET															
		1 to 10	10+ to 15	15+ to 20	20+ to 25	25+ to 30	30+ to 35	35+ to 40	40+ to 45	45+ to 50	50+ to 55	55+ to 60	60+ to 70	70+ to 80	80+ to 90	90+ to 100	
THICKNESS IN INCHES																	
36	7.1	.064	.064	.064	.064	.064	.064	.064	.079	.079	.109	.109	.109	.109	.109	.138	
42	9.6	.064	.064	.064	.064	.064	.064	.064	.079	.079	.109	.109	.109	.138	.168		
48	12.6	.064	.064	.064	.064	.064	.079	.079	.079	.109	.109	.109	.138	.168			
54	15.9	.064	.064	.064	.064	.064	.079	.079	.109	.109	.138	.138					
60	19.6	.064	.064	.064	.064	.079	.079	.109	.109	.138	.168						
66	23.8	.064	.064	.064	.079	.079	.109	.109	.138	.168							
72	28.3	.064	.064	.064	.079	.079	.109	.109	.138	.168							
78	33.0	.064	.064	.064	.079	.109	.109	.138	.168								
84	38.0	.079	.079	.079	.079	.109	.109	.138									
90	44.0	.079	.079	.079	.079	.109	.109	.138									
96	50.3	.109	.109	.109	.109	.109	.138	.168									
102	57.0	.109	.109	.109	.109	.109	.138	.168									
108	64.0	.109	.109	.109	.109	.109	.138										
114	70.9	.138	.138	.138	.138	.138	.168										
120	78.6	.138	.138	.138	.138	.138											
----- See General Note.																	


--- See General Note.

TABLE V
CORRUGATED STEEL PIPE ARCH

3" x 1" CORRUGATIONS

PIPE SIZE Span- Rise (Inches)	AREA (Sq.Ft.)	CORNER RADIUS (Inches)	HEIGHT DF FILL OVER TOP OF PIPE IN FEET							
			1.5 to 10	10+ to 11	11+ to 12	12+ to 14	14+ to 15			
			THICKNESS IN INCHES							
43 x 27	6.4	7 3/4	.064	.064	.064					
50 x 31	8.7	9	.064	.064	.064					
58 x 36	11.4	10 1/2	.064	.064	.064					
65 x 40	14.3	12	.064	.064	.064					
72 x 44	17.6	13 1/4	.064	.064	.064					
73 x 55	22.0	18	.064	.064	.064	.064	.064			
81 x 59	26.0	18	.079	.079	.079	.079	.079	.079		
87 x 63	31.0	18	.079	.079	.079	.079	.079	.079	.079	
95 x 67	35.0	18	.109	.109	.109					
103 x 71	41.0	18	.109	.109						
					</					

INSTALLATION OF METAL CULVERT PIPE

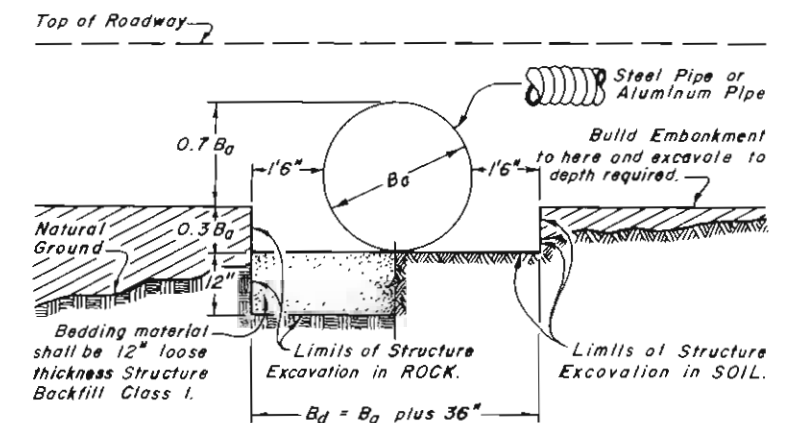

NOTE: Spacing for multiple pipe installations shall conform to the details shown on M Standard for Excavation and Backfill for Structures.

TABLE VI
CORRUGATED ALUMINUM PIPE


2-2/3" x 1/2" CORRUGATIONS

PIPE SIZE (8 _{in}) Inches	AREA (Sq. Ft.)	HEIGHT OF FILL OVER TOP OF PIPE IN FEET															
		1 to 10	10 ⁺ 15	15 ⁺ 20	20 ⁺ 25	25 ⁺ 30	30 ⁺ 35	35 ⁺ 40	40 ⁺ 45	45 ⁺ 50	50 ⁺ 55	55 ⁺ 60	60 ⁺ 70	70 ⁺ 80			
THICKNESS IN INCHES																	
12	0.8	.060	.060	.060	.060	.060	.060	.075	.105	.105	.105	.105	.105	.105			
18	1.8	.060	.060	.060	.060	.075	.105	.135	.164	.164							
24	3.1	.060	.060	.080	.075	.135											
30	4.9	.060	.060	.060	.075	.105	.164										
36	7.1	.060	.060	.075	.105	.164											
42	9.6	.075	.075	.105	.075	.105	.135	.164									
48	12.6	.105	.105	.105	.105	.135	.164	.164									
54	15.9	.105	.105	.135	.164	.164											
60	19.6	.135	.135	.164													
66	23.8	.135	.164														
72	28.3	.164															
----- See General Note.																	

STANDARD M-604-AA
(APRIL 21, 1967)

FEDERAL ROAD REGION NO.	DIVISION	PROJ. NO.	SHEET NO.	TOTAL SHEETS
9	COLORADO			

NO. 13 GRATING & FRAMES
Approx. Weight 680 lbs

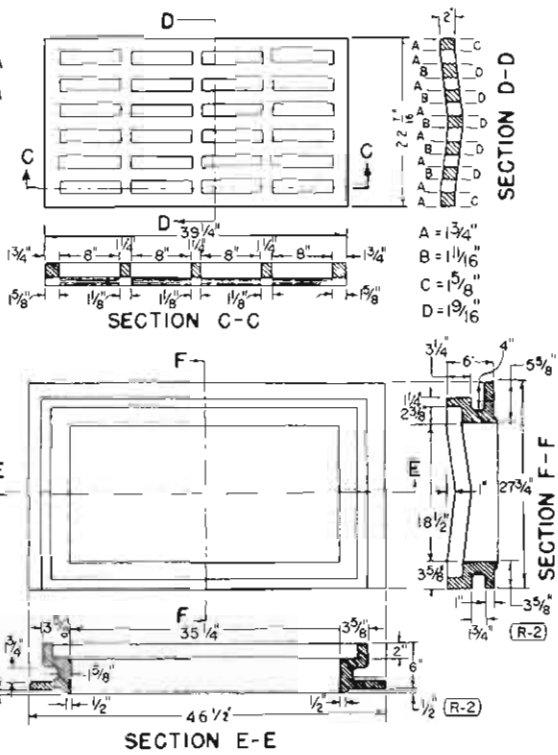

QUANTITIES

H	NO. OF 402 BARS REQ'D	TYPE 3 INLET		TYPE 3 DOUBLE INLET	
		CLASS A CONCRETE	REINFORCING STEEL	CLASS A CONCRETE	REINFORCING STEEL
3'-0"	3	1.30	64.29	2.20	110.77
3'-6"	4	1.47	78.35	2.51	132.47
4'-0"	4	1.64	82.40	2.82	139.22
4'-6"	5	1.81	96.46	3.13	160.92
5'-0"	6	1.98	110.51	3.44	182.63
5'-6"	6	2.15	114.56	3.75	189.38
6'-0"	7	2.32	128.62	4.06	211.08
6'-6"	8	2.49	142.68	4.37	232.78
7'-0"	8	2.66	146.73	4.68	239.53
7'-6"	9	2.83	160.79	4.99	261.24
8'-0"	10	3.00	174.85	5.30	282.94
8'-6"	10	3.17	178.90	5.61	289.69
9'-0"	11	3.34	192.96	5.92	311.39
9'-6"	12	3.51	207.02	6.23	333.10
10'-0"	12	3.68	211.07	6.54	339.84

Ø Includes 1% for overrun
(R-2) X Includes volume occupied by pipes


BAR LIST FOR H=3'-0"

MARK	TYPE	NO. REQ'D	TYPE 3 INLET DIMENSIONS		LENGTH	NO. REQ'D	TYPE 3 DOUBLE INLET DIMENSIONS		LENGTH
			x	y			x	y	
401	I	4	1'-0"	1'-0"	2'-0"	7	1'-0"	1'-0"	2'-0"
402	II	3	3'-7 1/4"	2'-10 1/2"	14'-11 1/2"	3	7'-2 1/2"	2'-10 1/2"	22'-2"
403	III	2	3'-5 3/4"	* 2'-0 1/2"	7'-6 3/4"	2	7'-1"	* 2'-0 1/2"	11'-2"
404	II	4	2'-9"	* 2'-1"	6'-11"	8	2'-9"	* 2'-1"	6'-11"
405	STR					2			3'-0"

* Add 6" to this dimension for each 6" increase in "H" above 3'-0".

BENDING DIAGRAM

All dimensions are out to out of bar

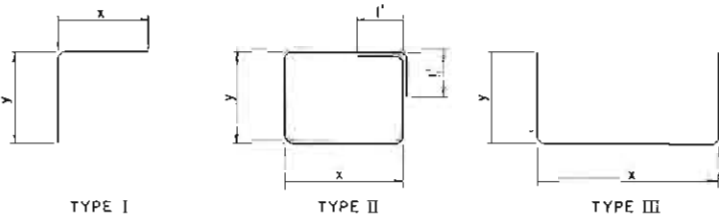

REVISIONS		
(R-1)	7-19-68	Depr. Name M.R.H.
(R-2)	12-2-68	Delete All. Frame, Note & Details M.R.H.


GENERAL NOTES

All work shall be done in accordance with the Standard Specifications applicable to the project.


All concrete shall be class "A".
All concrete walls shall be formed on both sides.
All exposed concrete corners shall be beveled to a 1" face.
All reinforcing bars shall be tagged with bar designation and station number.
All dimensions not shown as clear are to center of bar.
All gratings, rings and covers shall be cast iron.

NOTE: Use steps for all inlets with H=3'-6" or more Start 2'-0" below gutter line and space equally at Minimum of 18"


Details of Steps on Standard M-604-D

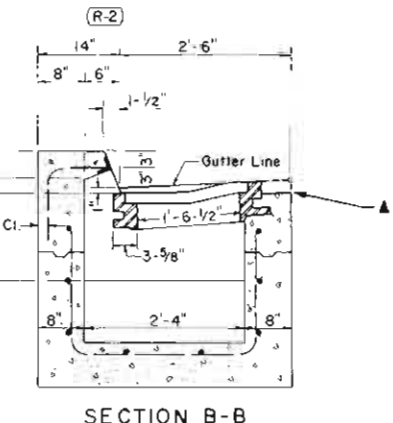

SECTION B-B

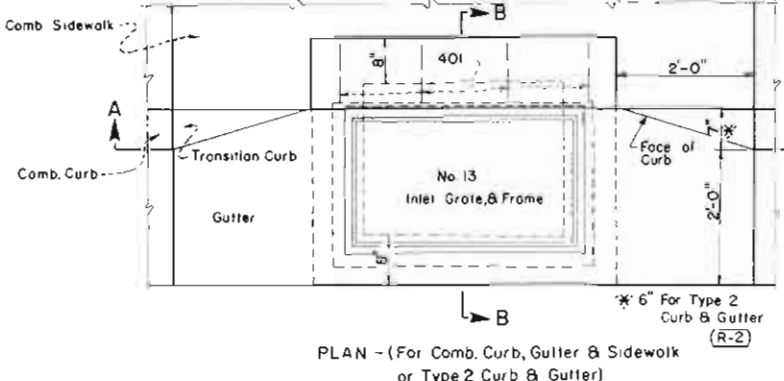


PLAN - (For Comb. Curb, Gutter & Sidewalk or Type 2 Curb & Gutter)

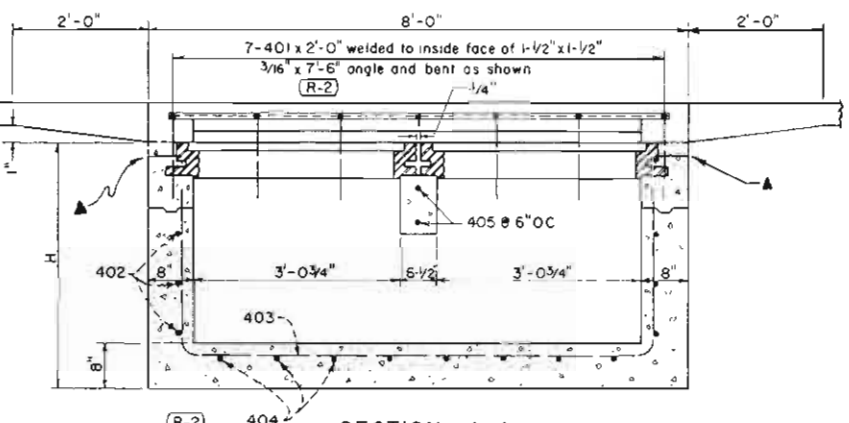


SECTION A-A


DOUBLE INLET TYPE 3

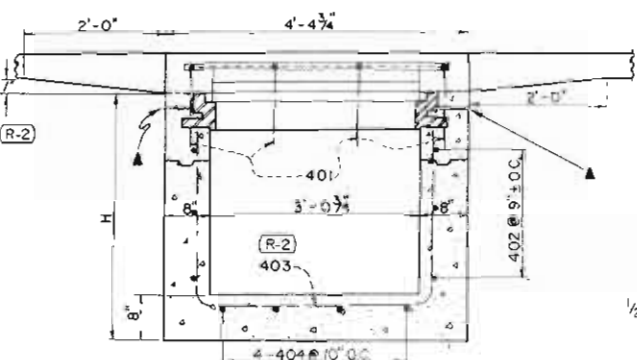

SECTION A-A (For Comb. Curb, Gutter, & Sidewalk or Type 2 Curb & Gutter)

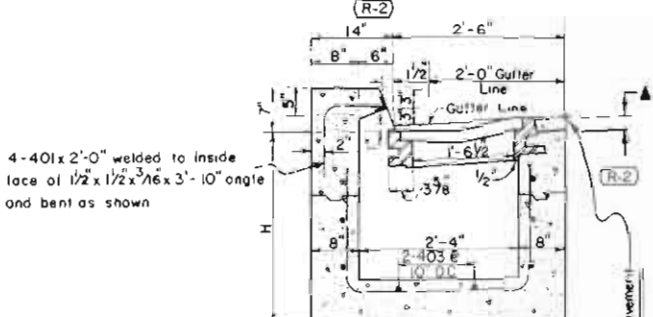

SECTION B-B
Use with Type 2 Curb & Gutter

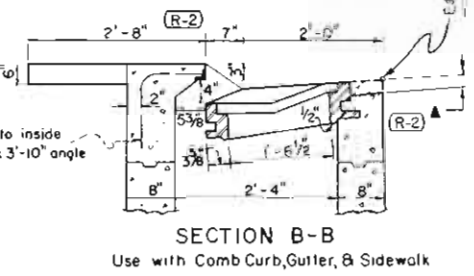


SECTION B-B

Use with Comb. Curb, Gutter, & Sidewalk

INLET TYPE 3

No 13 Grate and Frame to be used with Type 3 Inlet

DETAILS OF INLET ALTERATION
For Longer Size or Skewed Pipes

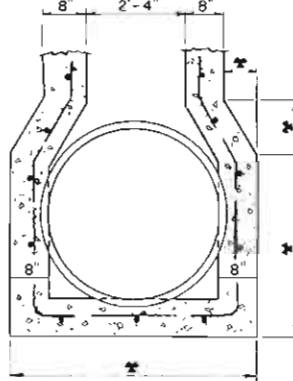

NOTE: Vary steel shape and quantity as required.

* Variable - to suit pipe size or skew angle

DEPARTMENT OF HIGHWAYS
STATE OF COLORADO
DIVISION OF HIGHWAYS
CONCRETE INLETS
TYPES 3 & 3 DOUBLE


Designed by H.E.P. Approved by J.G.C.
Made by J.R.B. Staff Design Engr.
Checked by M.R.H. Date APRIL 21, 1967

STANDARD M-604-AB


(APRIL 21, 1967)

FEDERAL ROAD DISTRICT NO.	DIVISION	PROJECT NO.	SHEET NO.	TOTAL SHEETS
4	COLO. DIST. 100			

REVISIONS				
NO.	DATE	BY	REVISION	APPROVED
(R-1)	7-19-58	Dept. Name		M. R. H.
(R-2)	4-15-71	Concrete	Gen. Note & Quant. table	M. R. H.

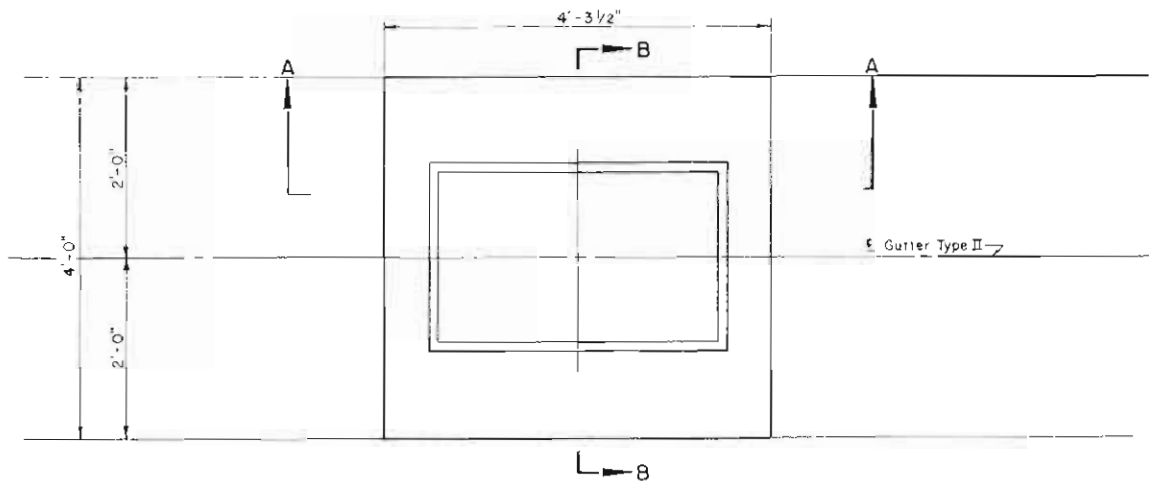


PLAN OF TYPE 13 INLET FOR GUTTER TYPE II

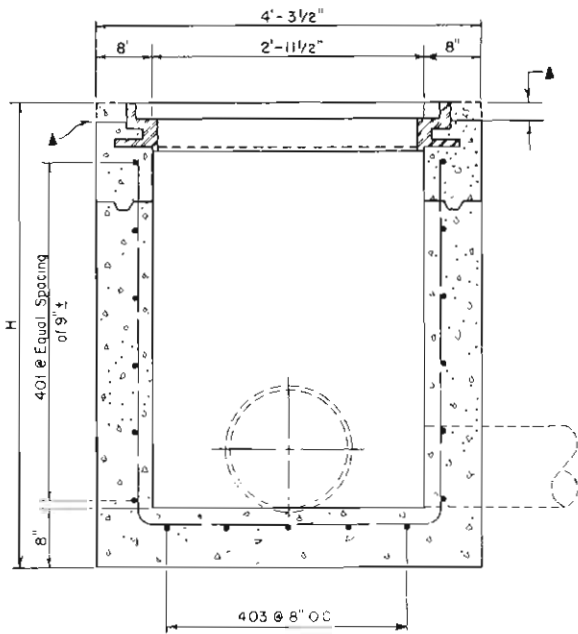


SECTION A-A

NOTE:
See plan details for location and size of pipe.
▲ — When bituminous material is to extend to the edge of the grating frame, concrete may be depressed.

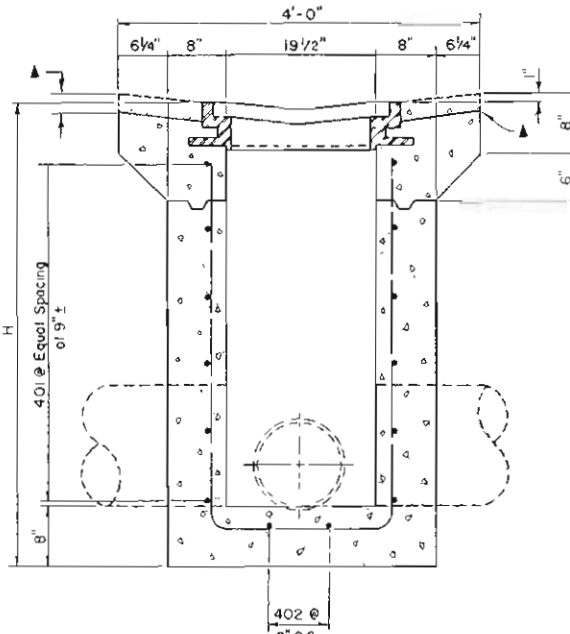


SECTION B-B

(R-2)
GENERAL NOTES
All work shall be done in accordance with the Standard Specifications applicable to the Project.
All concrete shall be class A, B or D.
All concrete walls shall be formed on both sides.
All exposed concrete corners shall be beveled to a 1\"/>

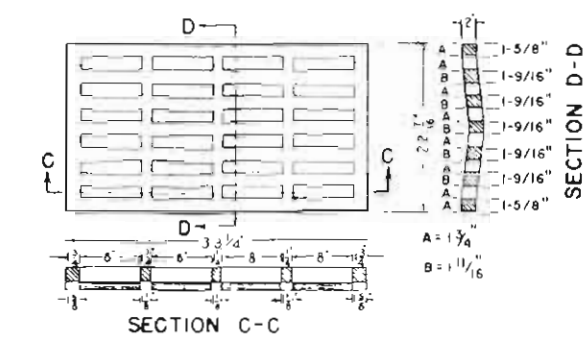


SECTION C-C

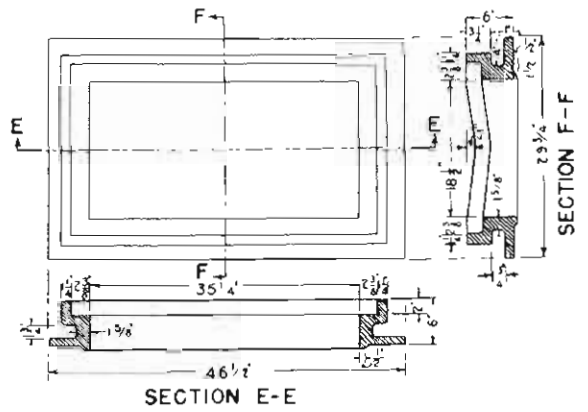

SECTION E-E

ALTERNATE NO. 13 FRAME

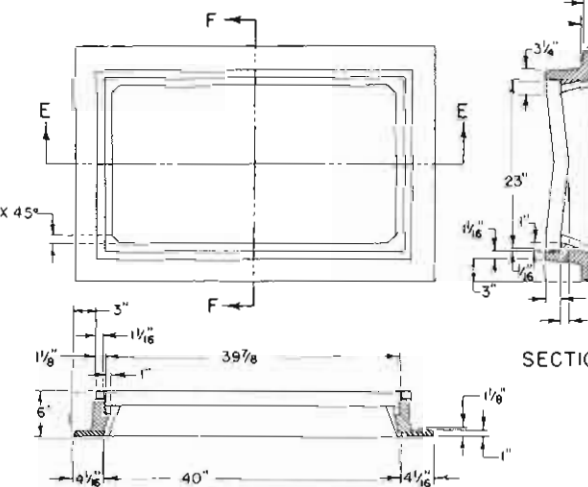

SECTION E-E

NO. 13 GRATING & FRAMES
Approx. Weight 680 lbs

(R-2)


H	CONCRETE	REINFORCING	NO. OF 401 BARS REQ'D.
	CU. YD.	STEEL Ø LB.	
3'-0"	1.13	56.42	3
3'-6"	1.28	70.14	4
4'-0"	1.42	74.87	4
4'-6"	1.57	88.60	5
5'-0"	1.72	102.31	6
5'-6"	1.86	107.04	6
6'-0"	2.01	120.77	7
6'-6"	2.15	134.49	8
7'-0"	2.30	139.22	8
7'-6"	2.45	152.93	9
8'-0"	2.59	166.66	10
8'-6"	2.74	171.39	10
9'-0"	2.88	185.11	11
9'-6"	3.03	198.83	12
10'-0"	3.18	203.56	12

Ø Includes 1% for overrun
(R-2) Note: Concrete quantities include volume occupied by pipe

BAR LIST FOR H=3'-0"

MARK	TYPE	NO. REQ'D.	DIMENSIONS		LENGTH
			x	y	
401	I	3	3'-6"	2'-2"	13'-4"
402	II	2	3'-4 1/2"	* 1'-10 1/2"	7'-1 1/2"
403	III	5	2'-0 1/2"	* 1'-11"	5'-10 1/2"

* Add 6" to this dimension for each 6" increase of "H" over 3'-0"

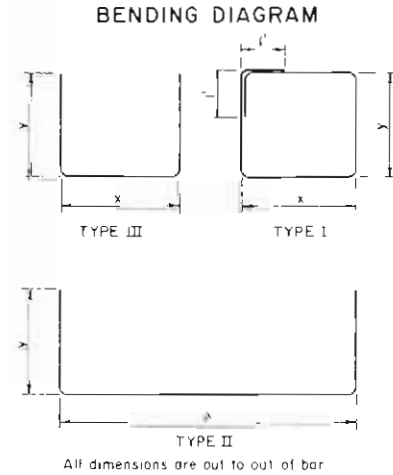

(R-1)

DEPARTMENT OF HIGHWAYS
STATE OF COLORADO
DIVISION OF HIGHWAYS


CONCRETE INLET
TYPE 13

Designed by H.E.P. Approved by J.R.B.
Made by J.R.B. Staff Design Engr
Checked by M.R.H. Date: APRIL 21, 1967


STANDARD M-604-BA
(JUNE 1, 1967)

FEDERAL ROAD DISTRICT NO.	DIVISION	PROJ. NO.	SHEET NO.	TOTAL SHEETS
9	COLORADO			

REVISIONS				
(R-1)	9-13-67	Grate Detail & Quant.	M.R.H.	
(R-2)	12-18-67	Connect to skewed culvert, General Note	M.R.H.	
(R-3)	7-19-68	Note B Dept. Name	M.R.H.	
(R-4)	4-15-71	Conc. in G Note and table. Re-do grate welds	M.R.H.	
(R-5)	5-24-71	Lower fastener bolt so top is flush w. conc.	M.R.H.	

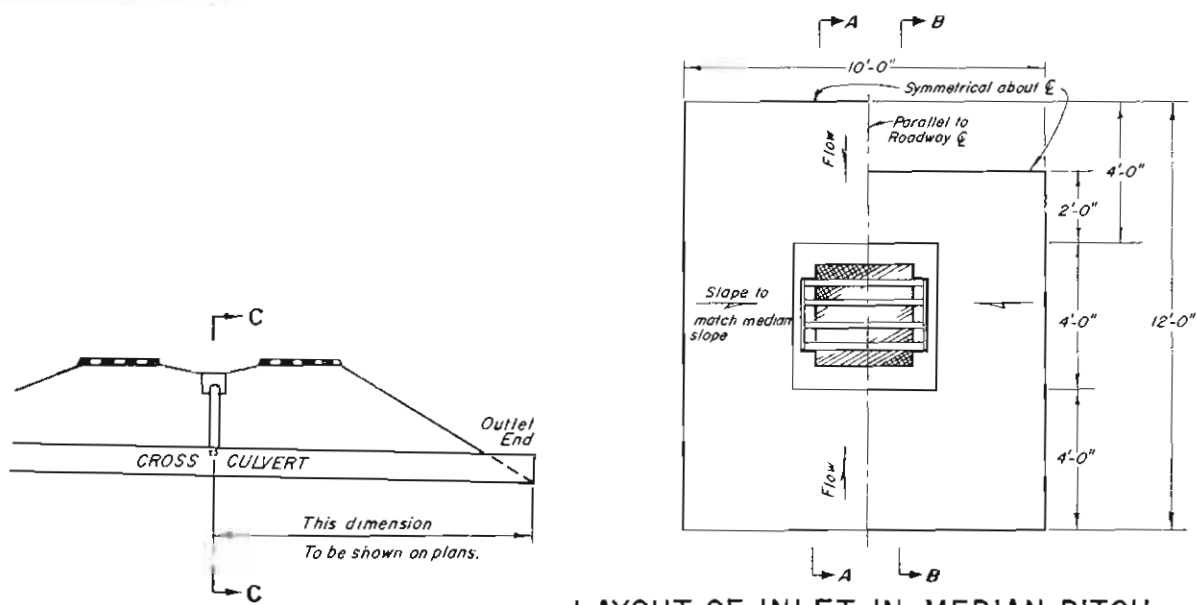


LAYOUT OF INLET IN MEDIAN DITCH

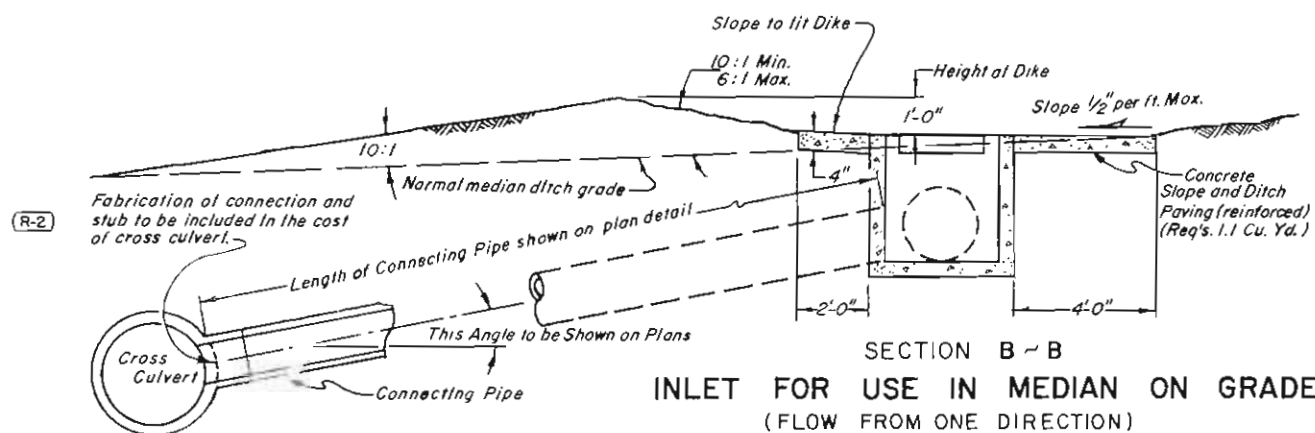


SECTION B-B
INLET FOR USE IN MEDIAN ON GRADE
(FLOW FROM ONE DIRECTION)

SECTION C-C
DETAIL SHOWING MEDIAN INLET
CONNECTED TO A CROSS CULVERT

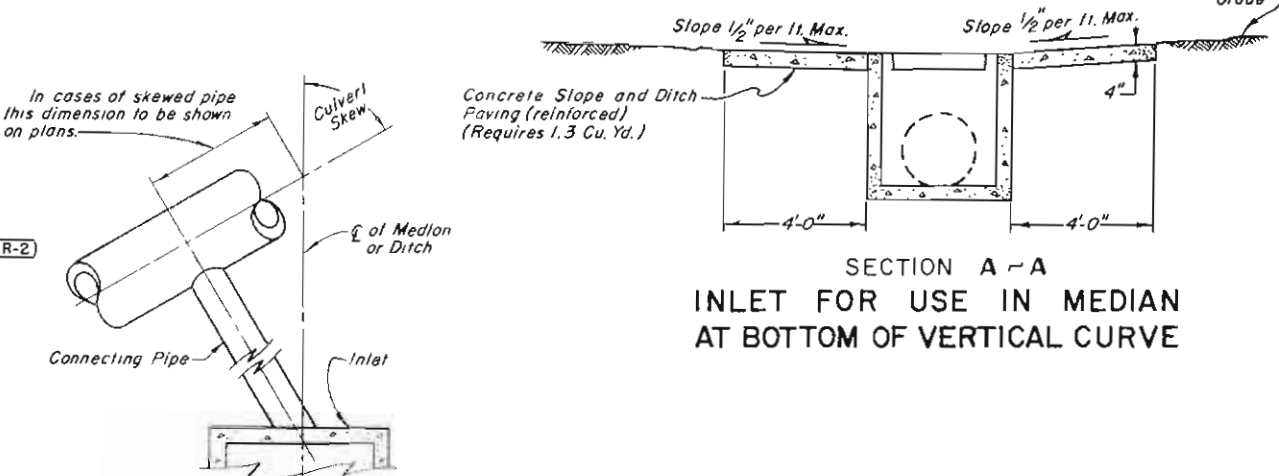


SECTION A-A
INLET FOR USE IN MEDIAN
AT BOTTOM OF VERTICAL CURVE

DETAIL SHOWING MEDIAN INLET
CONNECTED TO A SKEWED CROSS CULVERT

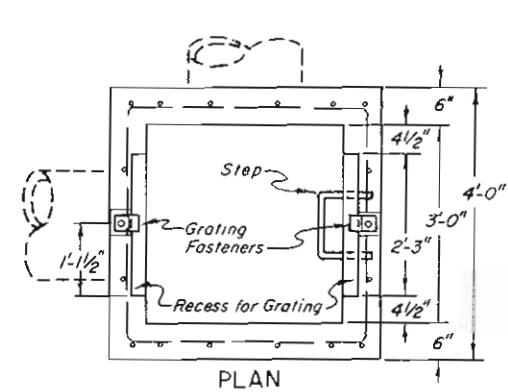

PLAN
CONCRETE INLET

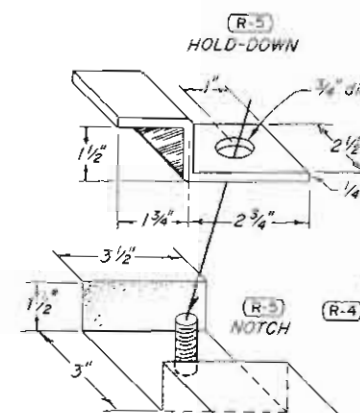

SECTION D-D
DETAIL OF RECESS AND
GRATING FASTENER
(2 REQUIRED)

QUANTITIES FOR ONE INLET

H	CONCRETE (CU. YDS.)	REIN. STEEL (LBS.)	NO. STEPS REQ'D
3'-0"	1.0	83	0
3'-6"	1.1	89	0
4'-0"	1.2	105	0
4'-6"	1.4	111	1
5'-0"	1.5	127	2
5'-6"	1.6	134	2
6'-0"	1.7	150	2
6'-6"	1.9	157	3
7'-0"	2.0	172	3
7'-6"	2.1	178	3
8'-0"	2.3	194	4
8'-6"	2.4	201	4
9'-0"	2.5	217	4
9'-6"	2.7	223	5
10'-0"	2.8	239	5
11'-0"	3.0	261	6
12'-0"	3.3	283	6

* Note: Includes volume occupied by pipes. (R-3)

BAR LIST FOR H=3' AND
BENDING DIAGRAM

MARK	NO. REQ'D	HGT. "U"	LENGTH
401	9	2'-7"	8'-8"
402	3		15'-4"

No. 401 U

Increase dimension "U"
6" for each 6" increase of
H above 3'-0".

No. 402

Add one bar for each foot
increase of H above 3'-0".

All bars to be 1/2" Dia. - Cut or bend around pipes as required.

GENERAL NOTES

- All work shall be done in accordance with the Standard Specifications applicable to the project.
- All concrete shall be Class A, B or D.
- For detail of Inlet Step, see M-Standard "Steps for Manholes and Inlets".
- All reinforcing bars shall be deformed, at intermediate grade, and shall be tagged with the station number and bar designation.
- All edge distances not marked "clear" are to center of bar.
- Concrete slope and ditch paving shall conform to Section 507. Reinforcement for concrete slope paving shall be 4 x 4, 10/10.
- Grating shall conform to Section 604.
- Inlet grating shall be galvanized as described for Frames, Grates, Covers and Steps in Section 712.
- Steps or ladder will be required when Inlet depth exceeds 3'-6".

MATERIAL LIST FOR GRATING, FASTENERS


PART	NO. REQ'D	SIZE	LBS. PER UNIT	WEIGHT ~ LBS.
Flat (R-4)	2	3/2 x 1/4 x 2'-2 3/8"	2.98/ft.	13
Flat	2	3 x 1/4 x 2'-2 3/8"	2.6/ft.	12
Beam	4	41 7/8 x 3'-4"	7.7/ft.	103
Fastener	2	6 x 1/4 x 2 1/2"	1.0 ea.	
Bolt	2	5/8 x 8"	0.8 ea.	
Washer	2		0.1 ea.	
TOTAL WEIGHT				132

DEPARTMENT OF HIGHWAYS
STATE OF COLORADO
DIVISION OF HIGHWAYS
INLET, TYPE C

Designed by D. B. R. Approved by J. R. B. Staff Design Engineer
Made by J. R. B. Checked by R. S. M. Date: JUNE 1, 1967


FEDERAL ROAD REGION NO.	DIVISION	PROJ. NO.	SHEET NO.	TOTAL SHEETS
9	COLORADO			

REVISIONS		
(R-1)	7-23-68	Dept. Name. _____ M.R.H. _____

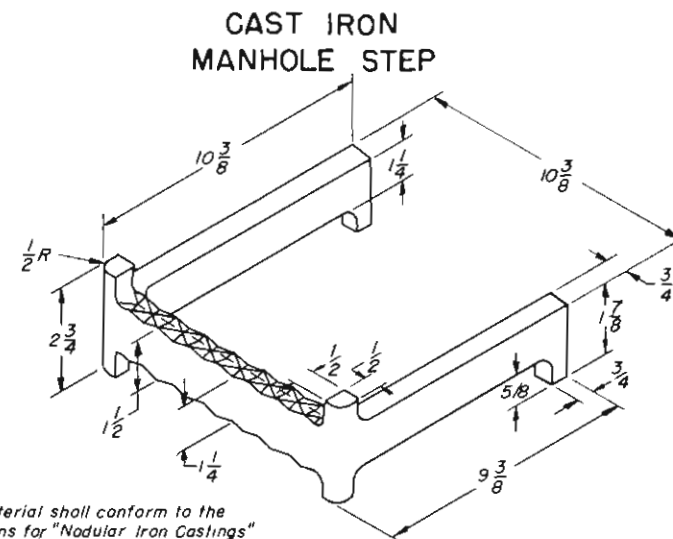


*This material shall conform to the
Specifications for "Nodular Iron Castings"
ASTM Designation A 339 Grade 60-45-10*

MILD STEEL
MANHOLE OR INLET STEP

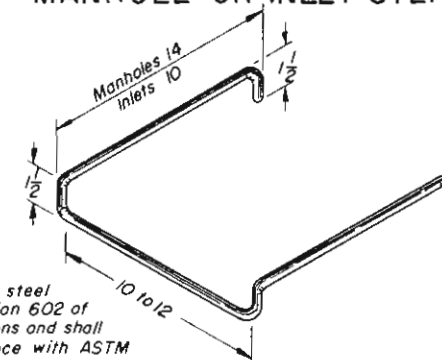

Step shall be 3/4 Dia steel bars conforming to Section 602 of the Standard Specifications and shall be galvanized in accordance with ASTM Designation A 123.

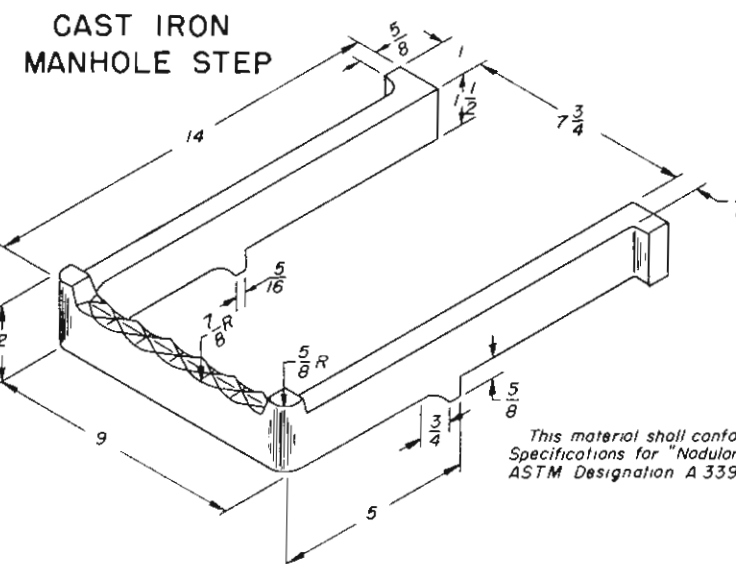

*This material shall conform to the
Specifications for "Nodular Iron Castings"
ASTM Designation A 339 Grade 60-45-10*

GENERAL NOTES

All work shall be done according to the Standard Specifications applicable to the project.

Steps shall be included in the cost of "Monholes" or "Inlets".

All dimensions shown in inches

DEPARTMENT OF HIGHWAYS
STATE OF COLORADO
DIVISION OF HIGHWAYS

STEPS FOR MANHOLES AND INLETS

Designed by: M.R.H.	Approved by: <i>PE Owen</i>
Made by: H.P.B.	Staff Design Engr.
Checked by:	Date: July 1, 1965

STANDARD M-606-AB

(MARCH 1, 1968)
(SHEET 1 OF 3)


FEDERAL ROAD REGION NO.	DIVISION	PROJ NO	SHEET NO	TOTAL SHEETS
9	COLORADO			

REVISIONS			
(R-7)	10-21-71	Replace post spacing Gen. Note with table	M.R.H.


TABLE OF OFFSETS
FOR 75' PARABOLIC FLARES

x	W=4'	W=5'	W=10'	W=12'	W=14'	W=16'
12'-6"	0.11	0.14	0.28	0.33	0.39	0.44
25'-0"	0.44	0.55	1.11	1.33	1.56	1.78
37'-6"	1.00	1.25	2.50	3.00	3.50	4.00
50'-0"	1.78	2.22	4.44	5.33	6.23	7.11
62'-6"	2.78	3.48	6.95	8.34	9.73	11.11
75'-0"	4.00	5.00	10.00	12.00	14.00	16.00


LEGEND
W = Full parabolic offset.
L = Length of parabolic transition.
X = Longitudinal dist from beginning of flare.
Y = Offset = $W \cdot \frac{x^2}{L^2}$

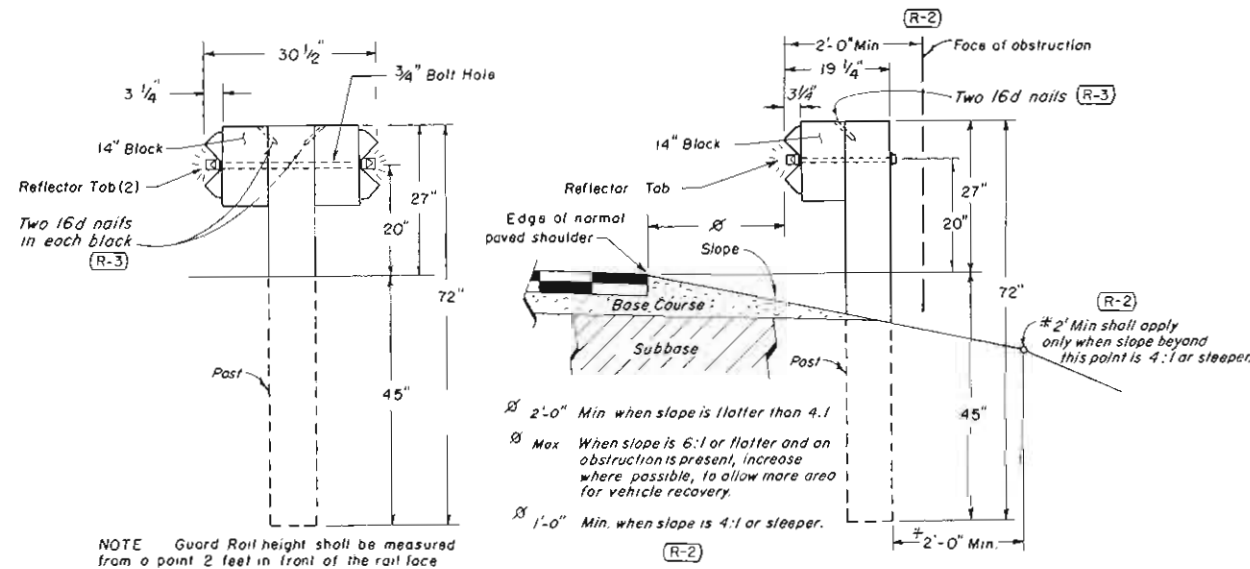


TYPICAL POST INSTALLATIONS
(See Table for Post & Block Cross Section)

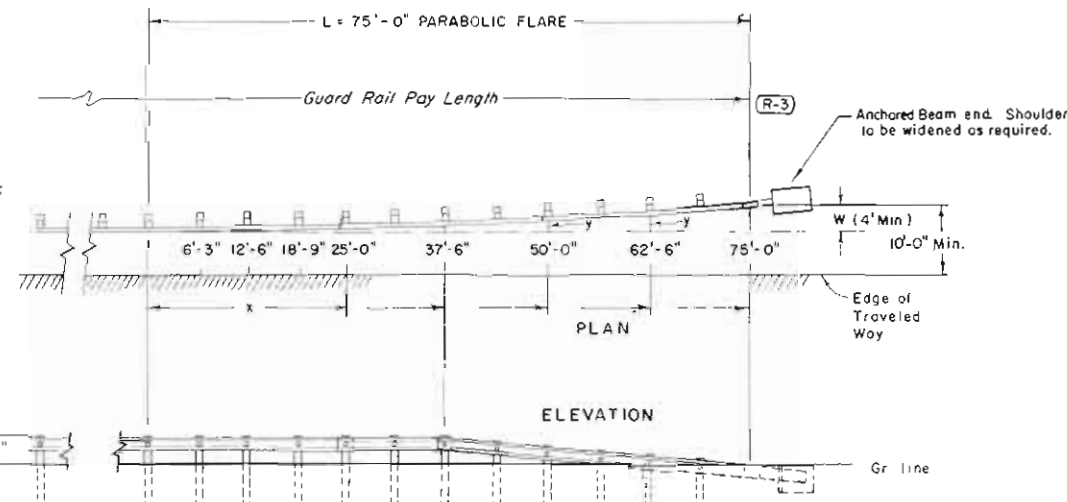

PARABOLIC TRANSITION & END TREATMENT

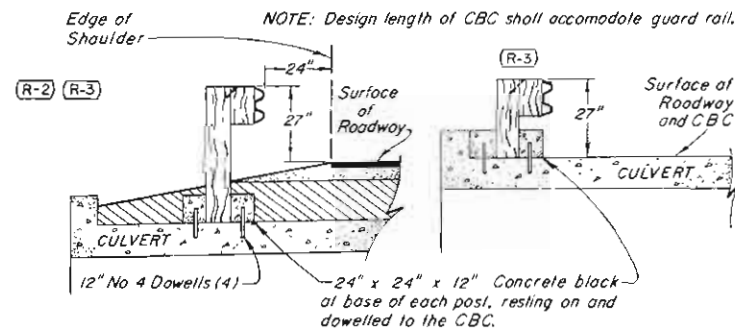

GUARD RAIL ACROSS CONCRETE BOX CULVERT

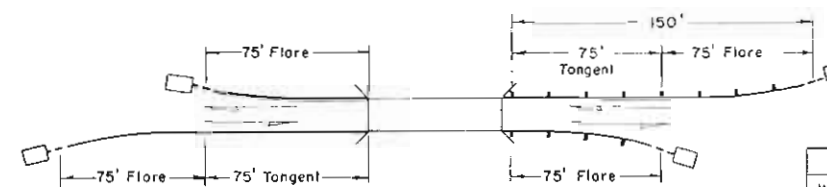

2-LANE HIGHWAY
BRIDGE APPROACH GUARD RAIL

NOTE: For divided highways see Sheet No. 2

GENERAL NOTES

All work shall be done in accordance with the Standard Specifications applicable to the project.

All timber shall be close grained Douglas Fir of the Coast Region, Dense Leaflet or Shortleaf Southern Pine, Lodgepole Pine, Ponderosa Pine, Western Hemlock, or Larch, and shall conform to the following grading specifications and requirements:

SPECIES	SIZE	FOHC	GRADING RULES
West Coast Douglas Fir	6"x8"	Yes	WCLB #16 Par 131 b
West Coast Hemlock	6"x8"	Yes	WCLB #16 Par 131 a
Larch	6"x8"	Yes	WWP 1970 Par 80.11
Southern Pine	6"x8"	No	SPIB 1970 Par 285
Lodgepole Pine	6"x8"	No	WWP 1970 Par 80.10
Ponderosa Pine	6"x8"	No	WWP 1970 Par 80.10
West Coast Hemlock	6"x8"	Yes	WCLB #16 Par 131 b

WCLB #16 — "Standard Grading Rules #16 for West Coast Lumber" Published by the West Coast Lumber Inspection Bureau. Effective Sept. 1, 1970.

WWP 1970 — "1970 Standard Grading Rules for Southern Pine Lumber" Published by the Western Wood Products Association. Effective Sept. 1, 1970.

SPIB 1970 — "1970 Standard Grading Rules for Southern Pine Lumber" Published by the Southern Pine Inspection Bureau. Effective Sept. 1, 1970.

FOHC — Free of Heart Centers. See paragraph 714 c of WCLB.

NOTE — 6"x8" Posts and Blocks shall be installed with the 6" dimension parallel to the roadway.

Post & block cross section — All timber shall be rough, free of wane, square cut and full sawn.

At the time the post or block is installed, any seasoning check which extends the full length of the piece shall not exceed one-quarter inch in width at its maximum width.

Blocks shall be cut from timber of the same cross section, species and grade as the posts and receive the same treatment.

Timber shall be incised and pressure treated in accordance with AASHTO Designation M133, except that blocks need not be incised. Post bolt holes are to be drilled before treatment is applied.

The preservative shall be either (a) Creosote or (b) Pentachlorophenol in a petroleum carrier (liquid or L.P. gas). Unless otherwise permitted by the Engineer, only one preservative shall be used on the project.

Where pedestrian hazard exists and sidewalk is constructed on the roadway shoulder, guard rail shall be placed between the sidewalk and the edge of traffic lane.

Guard rail plate shall not be lighter than No. 12 U.S. Standard Gage. 25' length of rail panels will be permitted.

Metal plate guard rail shall be painted in accordance with standard specifications or shall be galvanized in accordance with AASHTO Designation M-111 or with ASTM Designation A 525, Coating Class 2.50.

Posts used for vertical transition shall be adjusted in length so that a minimum of 45" will be buried.

Standard galvanized wrought steel washers shall be used under all bolt heads or nuts coming in contact with wood posts.

Concrete shall be Class A, B or D.

Blocks shall be toenailed to posts with two 16 penny galvanized nails in the top of each block.


If posts are cut in the field, cut ends shall receive 2 coats of hot creosote.

NORMAL CENTER-TO-CENTER POST SPACING


LOCATION	DESIGN SPEED Less Than 50mph and ADT < 750	DESIGN SPEED 50mph and Over
Tangents	12'-6"	6'-3"
Curves with Radius Over 200'	12'-6"	6'-3"
Curves with Radius of 200' or Less	6'-3"	6'-3"
Flares and Obstructions	6'-3"	6'-3"

DEPARTMENT OF HIGHWAYS
STATE OF COLORADO
DIVISION OF HIGHWAYS
GUARD RAIL
TYPE 3


Designed by M.R.H. Approved by J.B.
Made by J.R.B. by Staff Design Engineer
Checked by R.S.M. Date March 4, 1968

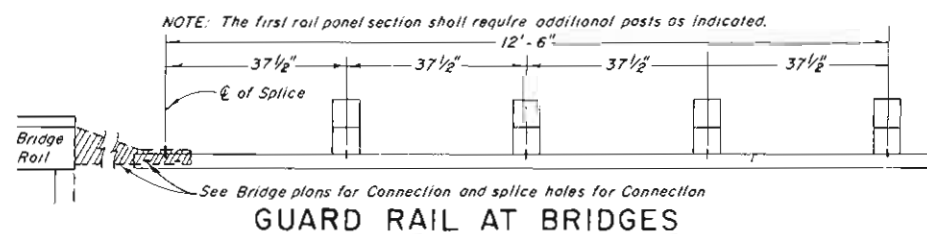

GUARD RAIL AT BRIDGES

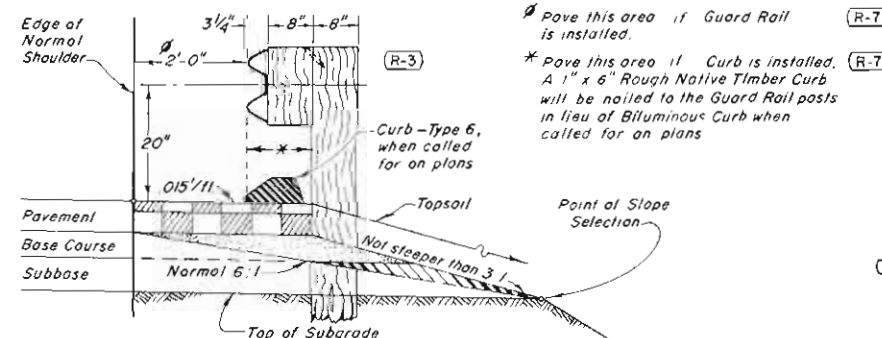

GUARD RAIL SHOULDER TREATMENT
(Showing Typical Shoulder Widening)

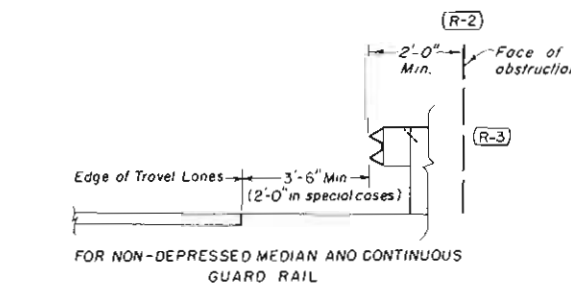


GUARD RAIL FOR OBSTRUCTIONS IN MEDIAN
(See Sheet No. 3)

STANDARD M-606-AB

(MARCH 1, 1968)


(SHEET 2)

FEDERAL ROAD DISTRICT	DIVISION	PROJECT NO.	SHEET NO.	TOTAL SHEETS
1	1			
REVISIONS				
(R-7)	10-21-71	Revision date only		M.R.H.

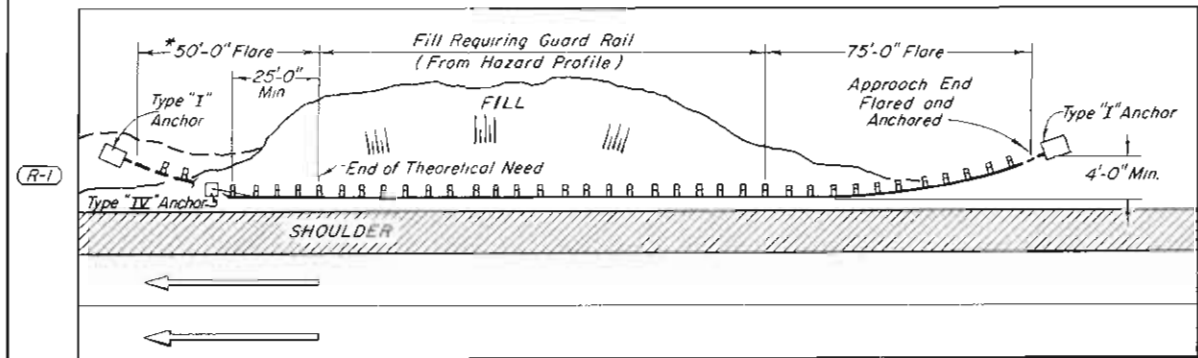


GUARD RAIL INSTALLATION ——— ROADSIDE FILL CONDITION


NOTES:
* 2-Lane Highways — The exit end of Guard Rail shall extend 50 feet past the end of theoretical need and shall be flared and anchored.

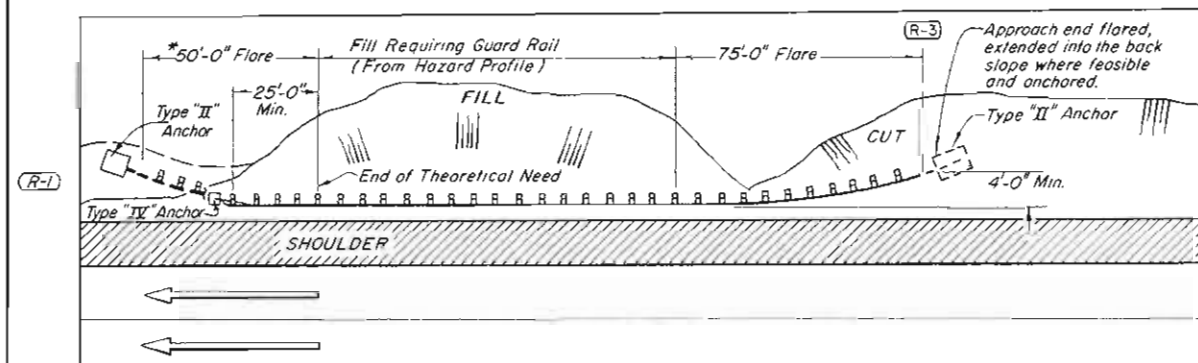

GUARD RAIL INSTALLATION ——— ROADSIDE CUT TO FILL CONDITION

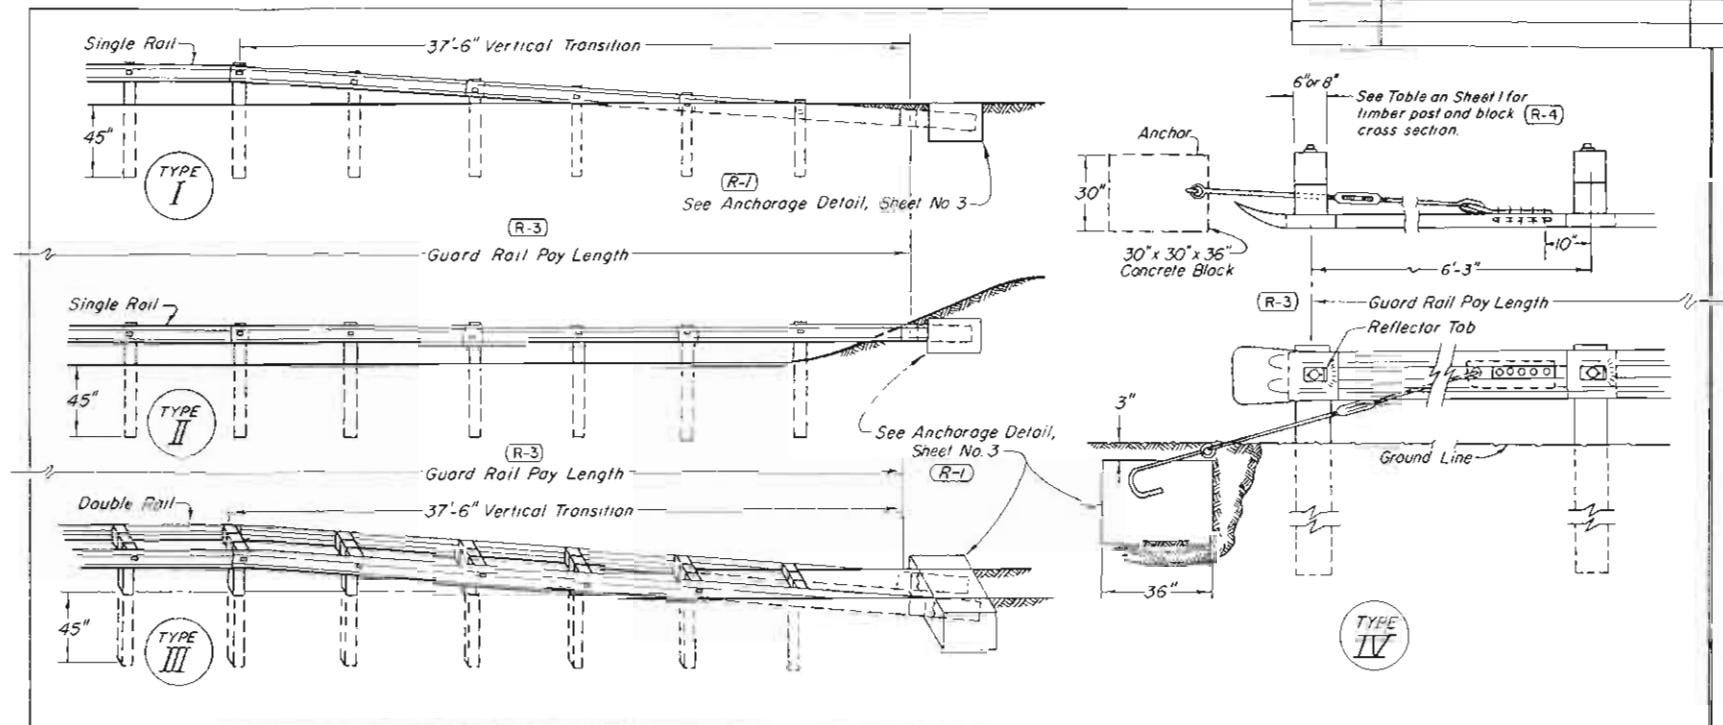

TYPICAL END ANCHORAGE

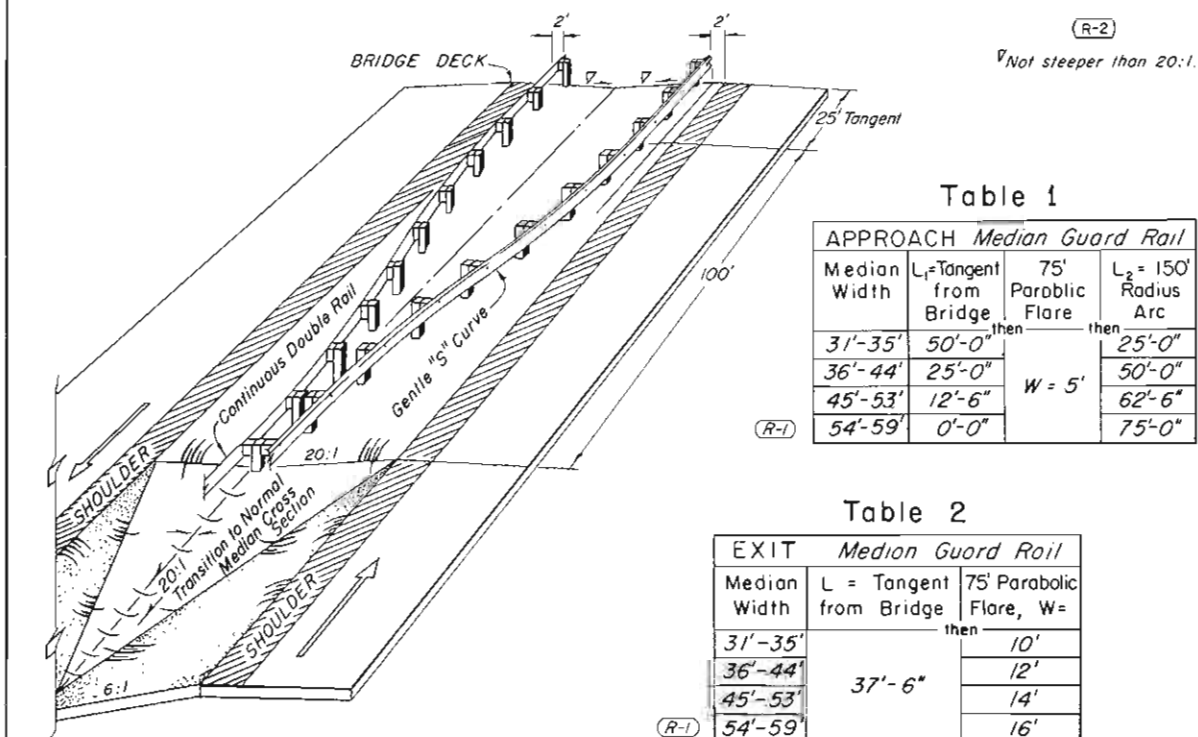


21' to 30' MEDIAN


Table 1 APPROACH Median Guard Rail			
Median Width	L_1 = Tangent from Bridge	75' Parabolic Flare, $W = 5'$	$L_2 = 150'$ Radius Arc
31'-35'	50'-0"	then 25'-0"	
36'-44'	25'-0"	50'-0"	
45'-53'	12'-6"	62'-6"	
54'-59'	0'-0"	75'-0"	

Table 2 EXIT Median Guard Rail		
Median Width	L = Tangent from Bridge	75' Parabolic Flare, $W =$
31'-35'	then 10'	
36'-44'	37'-6"	12'
45'-53'		14'
54'-59'		16'

GUARD RAIL AT BRIDGE APPROACH

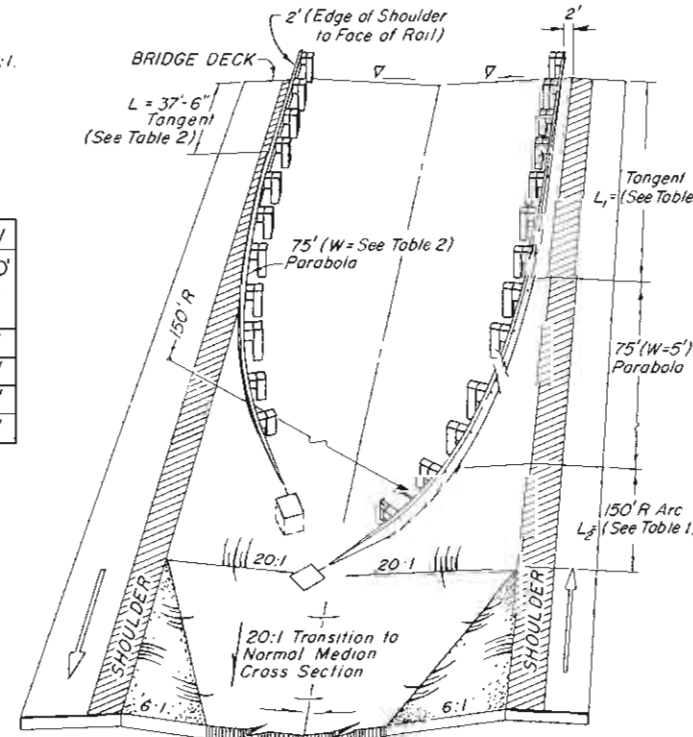

31' to 59' MEDIAN

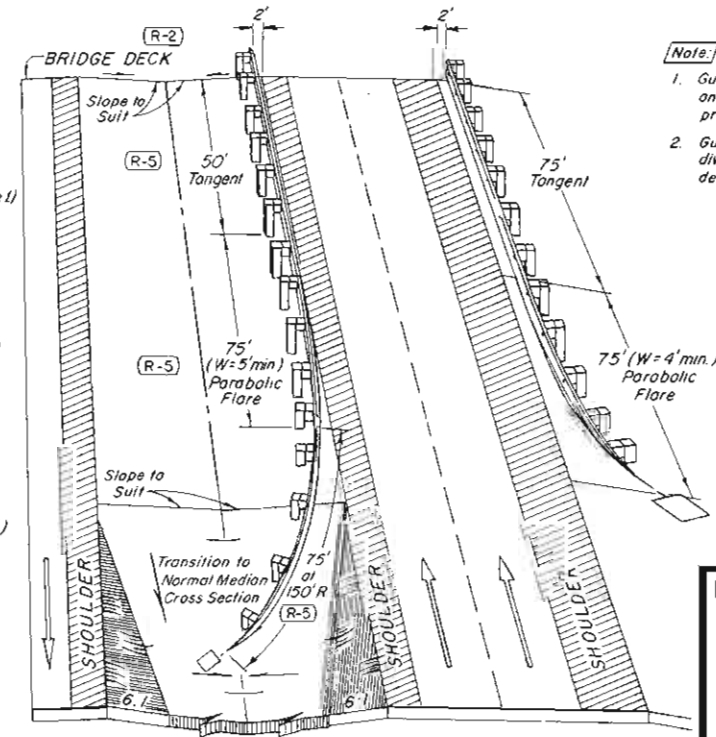

MEDIAN 60' AND OVER

- Note: EXIT FROM BRIDGES:
- Guard rail for OUTSIDE shoulders of exit end of bridges on divided highways to be determined from hazard profile.
 - Guard rail for INSIDE shoulders of exit end of bridges on divided highways with medians 60' and over to be determined from hazard profile.

DEPARTMENT OF HIGHWAYS
STATE OF COLORADO
DIVISION OF HIGHWAYS

GUARD RAIL
TYPE 3

Designed by M.R.H. Approved by J.R.B.
Made by J.R.B. Staff Design Engineer
Checked by P.S.M. Date: March 1, 1968


STANDARD M-606-AB

(MARCH 1, 1968)



(SHEET 3)

(R-1)



FEDERAL ROAD REGION NO.	DIVISION	PROJ NO.	SHEET NO.	TOTAL SHEETS
9	COLORADO			
REVISIONS				
(R-7)	10-21-71	Revision done only		M.R.H.

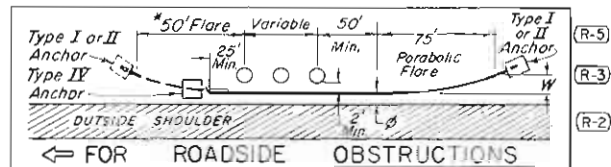

* 2-Lane Highways — The exit end of Guard Rail shall extend 50 ft past the end of the theoretical need and shall be tapered and anchored.

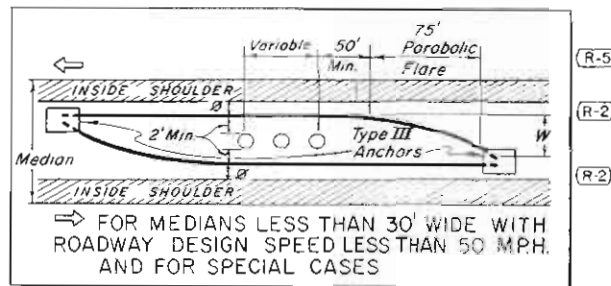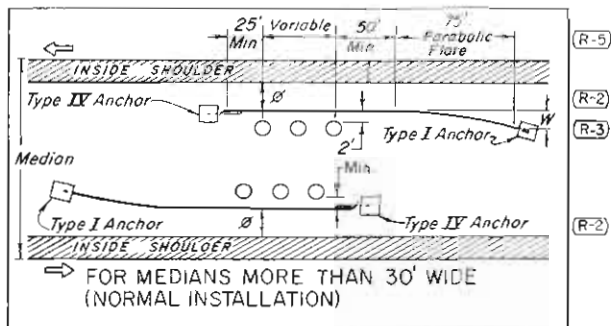


NON-CONTINUOUS RAIL

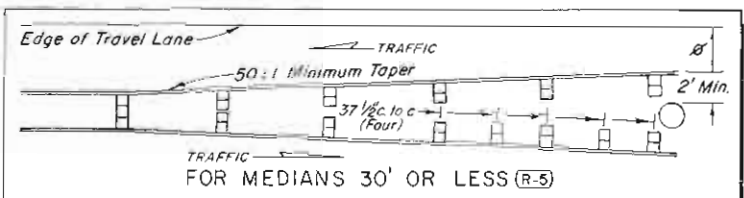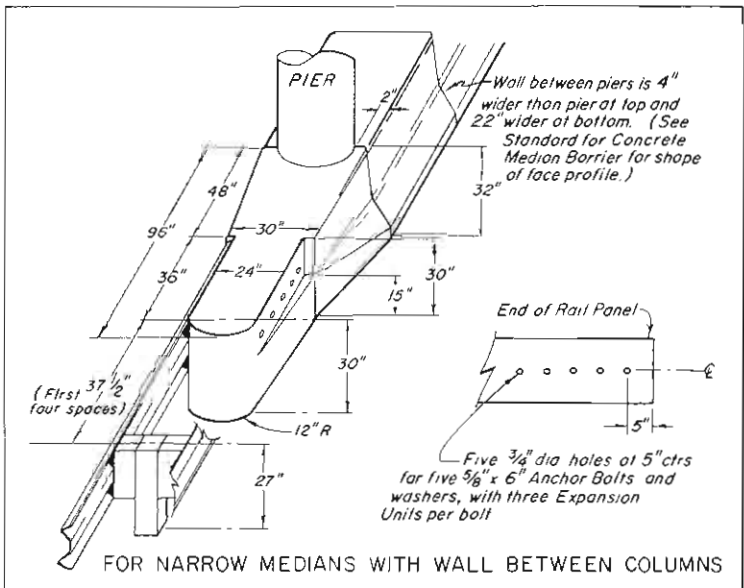


CONTINUOUS RAIL

When slope is 6:1 or flatter and an obstruction is present, increase where possible, to allow more area for vehicle recovery.

TYPICAL GUARD RAIL FOR OBSTRUCTIONS

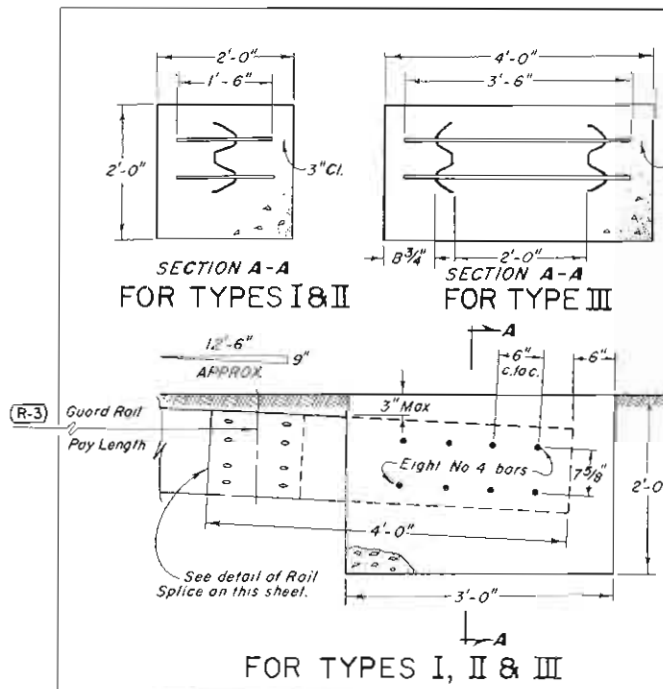


FOR TYPES I, II & III

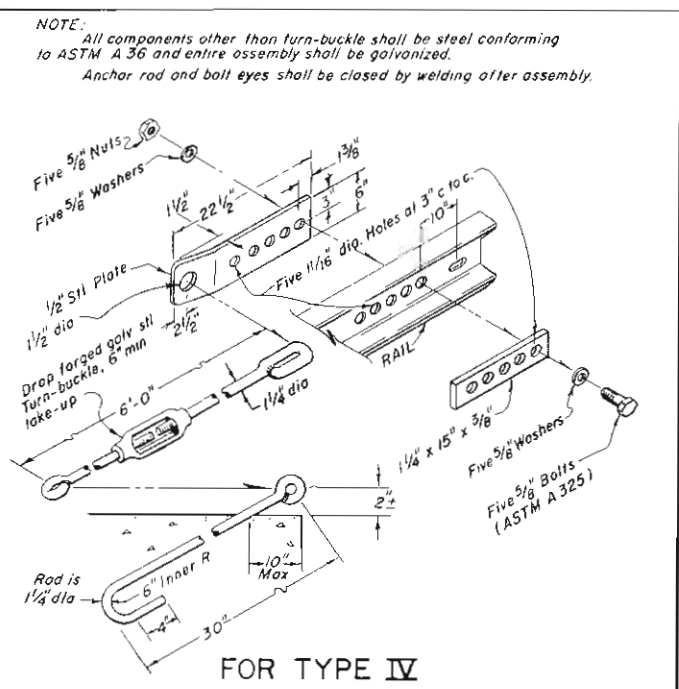


FOR TYPE IV

DETAILS FOR TYPICAL END ANCHORAGE

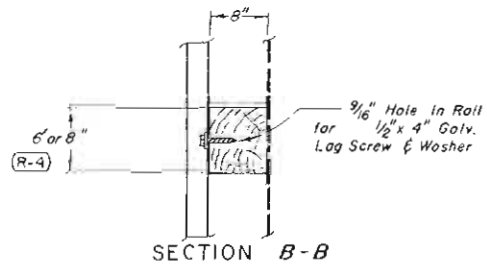


SECTION C-C


DETAIL OF RAIL AND SPLICE

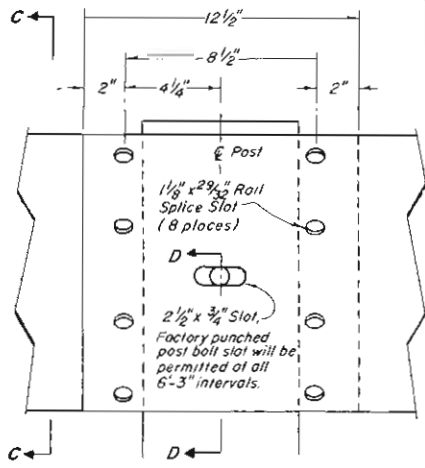


SECTION D-D

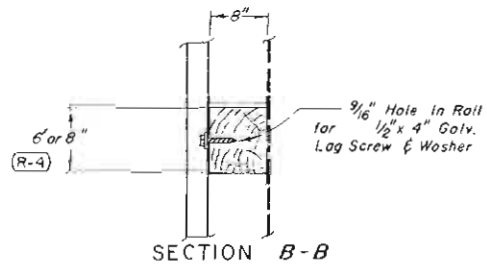


SECTION B-B

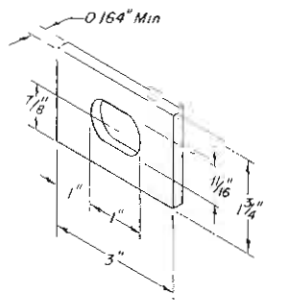

RECTANGULAR WASHER DETAIL

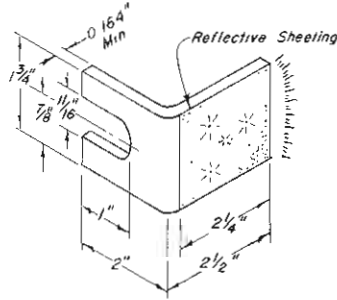


REFLECTOR TAB DETAIL

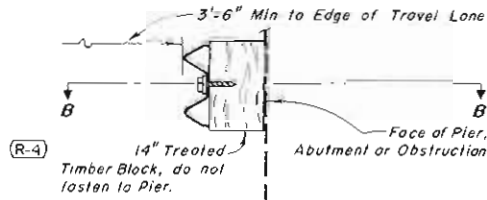


FOR NARROW MEDANS

(To be used only when 2' min clearance cannot be obtained.)
SEE TABLE ON SHEET 1 FOR TIMBER CROSS SECTION
NOTE: Four 37 1/2" post spaces shall be used at obstruction approach. Posts between piers shall be evenly spaced at 37 1/2" c to c or less. Timber blocks fastened to abutments or obstructions shall be spaced 37 1/2" c to c or less.

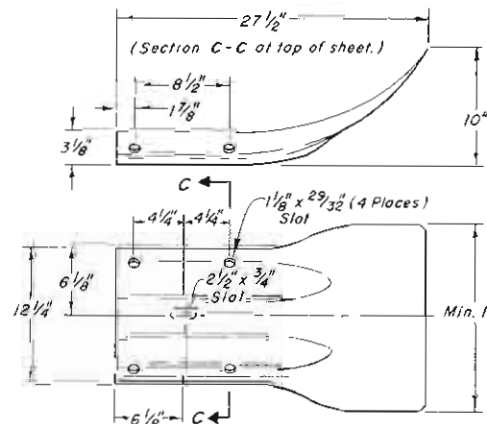


NOTE: Slots shown shall match outer 4 and center Rail end slots.

DETAIL OF TERMINAL SECTION

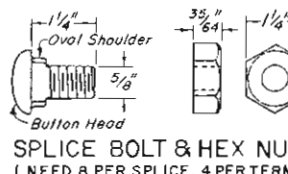

SPlice BOLT & HEX NUT

(NEED 8 PER SPLICE, 4 PER TERMINAL)

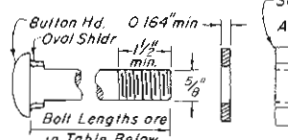


POST BOLT, WASHER & HEX NUT

TABLE OF POST BOLT SIZES

Block	Post	RAIL	BOLT SIZE
8" x 8"	Double	Double	5/8" x 25 3/4"
8" x 8"	Single	Single	5/8" x 17 1/2"

NOTE: When 6" x 8" timber is used, the 8" dimension shall be perpendicular to the roadway.

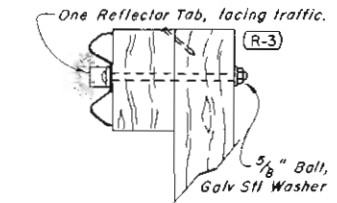

INSTALLATION DETAIL OF REFLECTOR TAB

DEPARTMENT OF HIGHWAYS STATE OF COLORADO DIVISION OF HIGHWAYS

GUARD RAIL TYPE 3

Designed by M.R.H. Approved by J.E.G.
Made by J.R.B. Staff Design Engineer
Checked by R.S.M. Date: March 1, 1968

STANDARD M-607-A





(SHEET 1 OF 2 SHEETS)
(JULY 1, 1965)

FED. ROAD REG. NO.	DIVISION	PROJECT NO.	SHEET NO.
9	COLORADO		





REVISIONS			
(R-1)	8-2-66	Vertical Dimensions and Note	M.R.H.
(R-2)	12-8-66	Vert. Dims., Std. and Alternate	M.R.H.
(R-3)	5-6-68	Eye-bolt Note and Title Block	M.R.H.
(R-4)	7-25-69	Revise post lengths	M.R.H.
(R-5)	9-15-69	Stays	M.R.H.
(R-6)	8-19-71	Delete corner post concrete note	M.R.H.

(R-1) NOTE:
See Sheet 2
for General Notes.

CROSS BRACE DOWELING DETAIL
3/8" X 4" STEEL PINS
Bore a 3/8" X 2" Hole in each Post and Brace
to receive the Pins. Wrap the ends of the Braces
tightly with several turns of 12 1/2 ga smooth
Galv. Wire to prevent splitting or Natch Post and
Nail with 40 d Common Nails

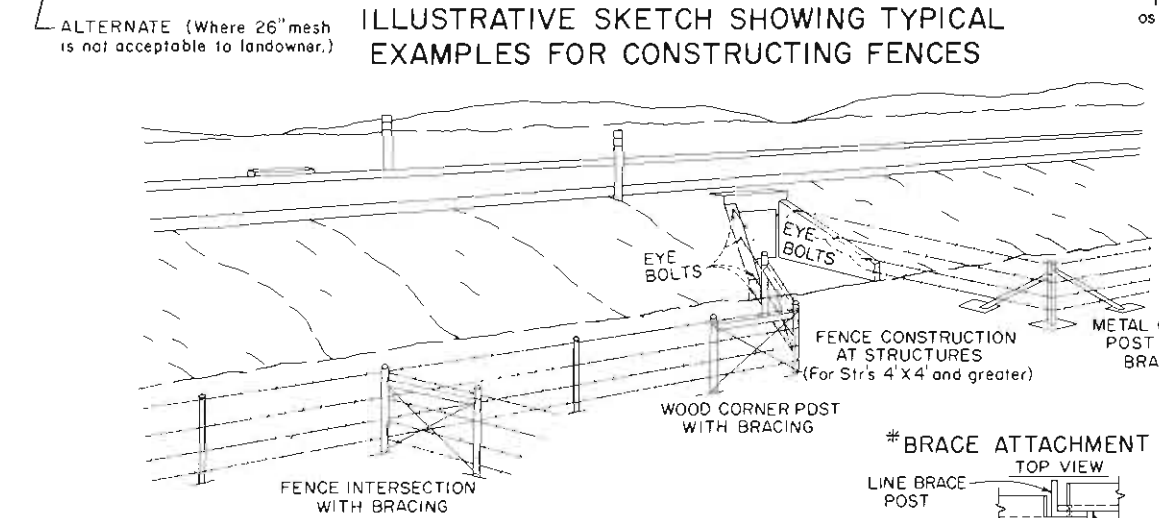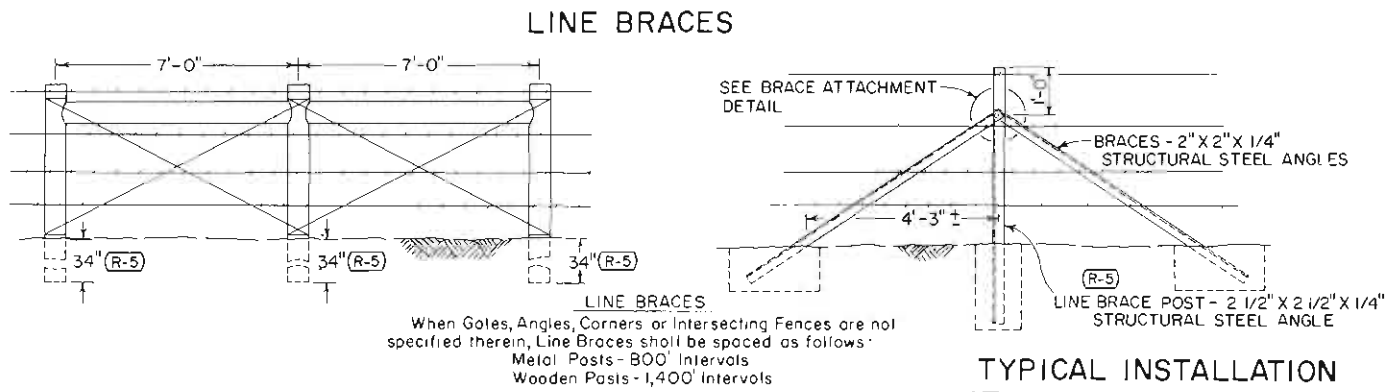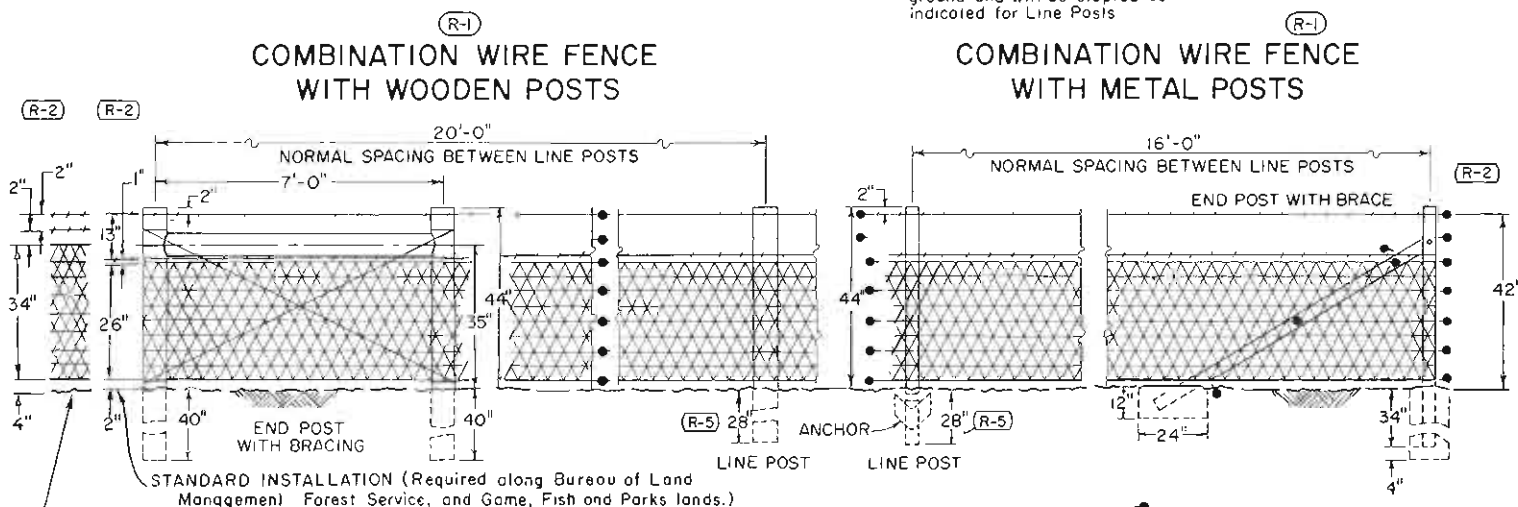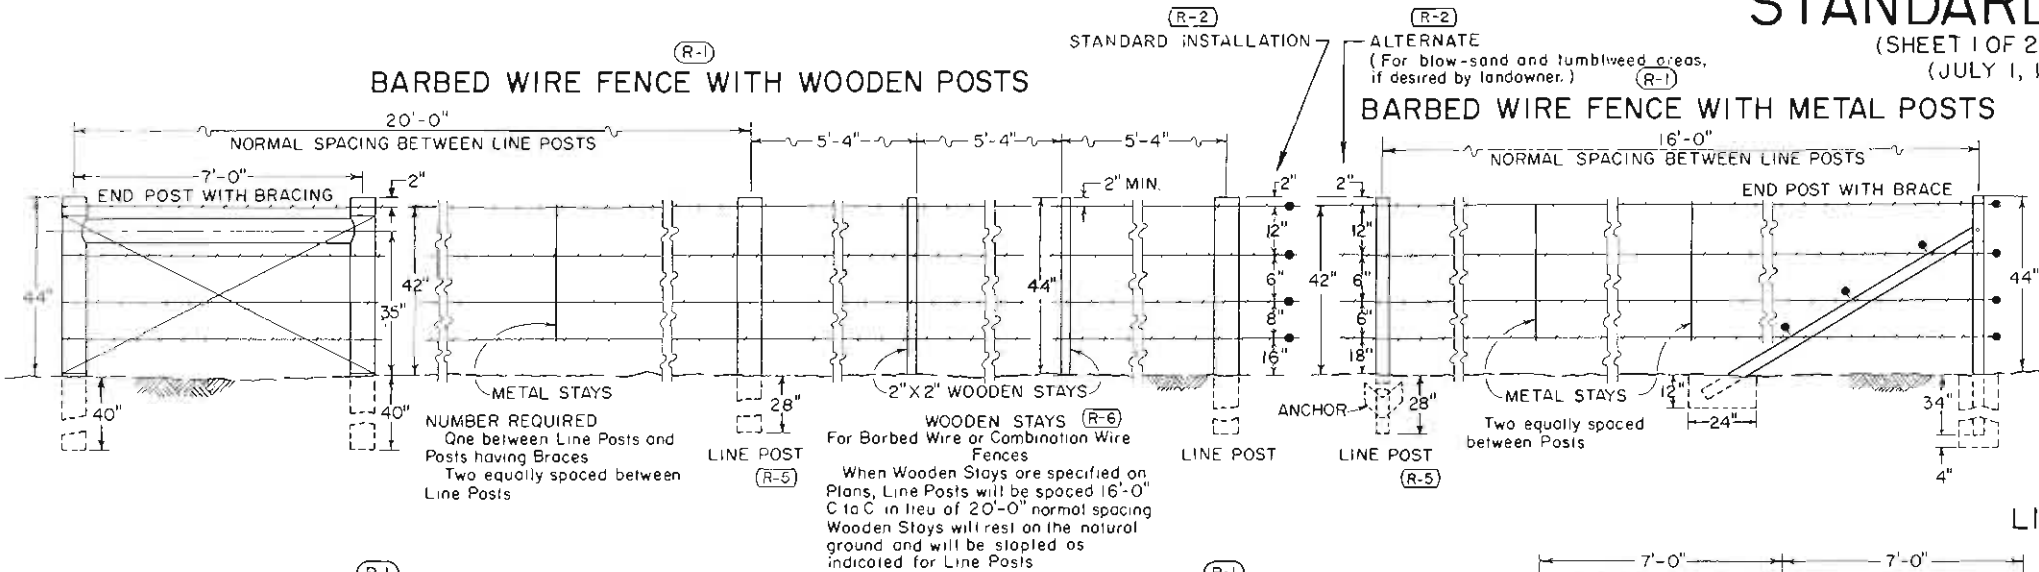

ILLUSTRATIVE SKETCH SHOWING TYPICAL
EXAMPLES FOR CONSTRUCTING FENCES

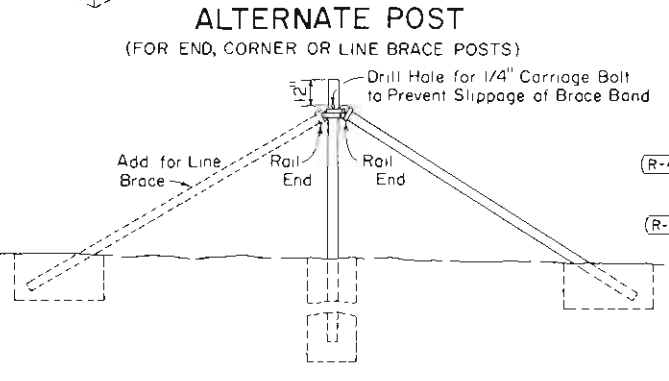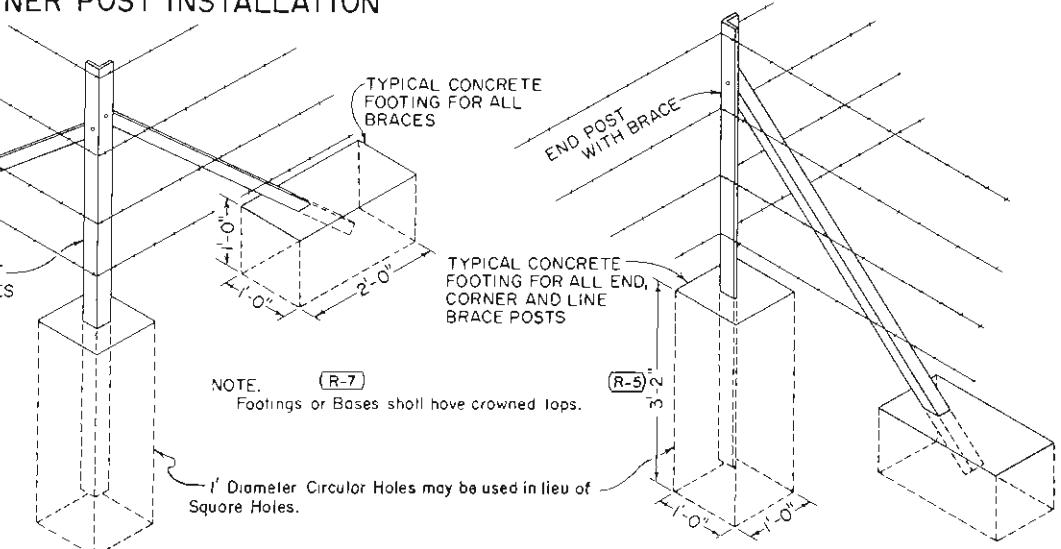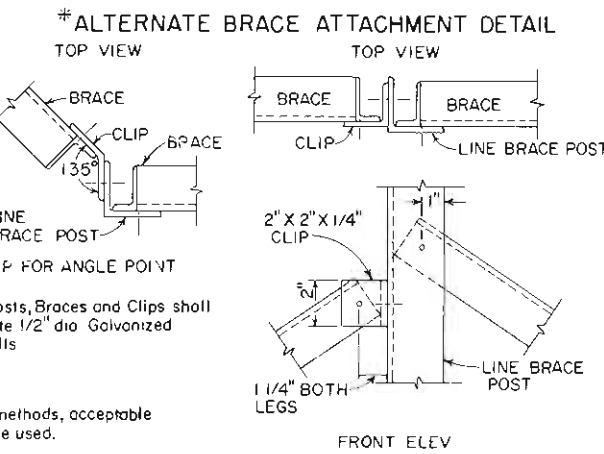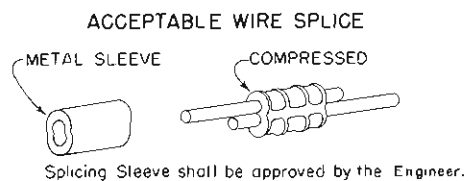

DEPARTMENT OF HIGHWAYS
STATE OF COLORADO
DIVISION OF HIGHWAYS
WIRE FENCES AND GATES
Designed by LEO Approved by J.E. Olson
Made by T.E.F. Staff Des. Eng'r
Checked by E.E.O. Date: July 1, 1965

STANDARD M-607-A



(SHEET 2)

(JULY 1, 1965)


REG NO	DIVISION	PROJECT NO	SHEET NO
9	COLO		

REVISIONS			
(R-1)	8-2-66	Verl Dims. & Gen'l. Notes	M.R.H.
(R-2)	12-8-66	Verl Dims., Std and Alternate	M.R.H.
(R-3)	2-6-67	Gate and General Notes	M.R.H.
(R-4)	5-6-68	General Notes and Title Block	M.R.H.
(R-5)	7-25-69	Revise post lengths, Gen. notes	M.R.H.
(R-6)	9-15-69	General Notes	M.R.H.
(R-7)	8-19-71	Gen Note, Panel Drwy Gate & Post	M.R.H.



POST POINTING DETAILS

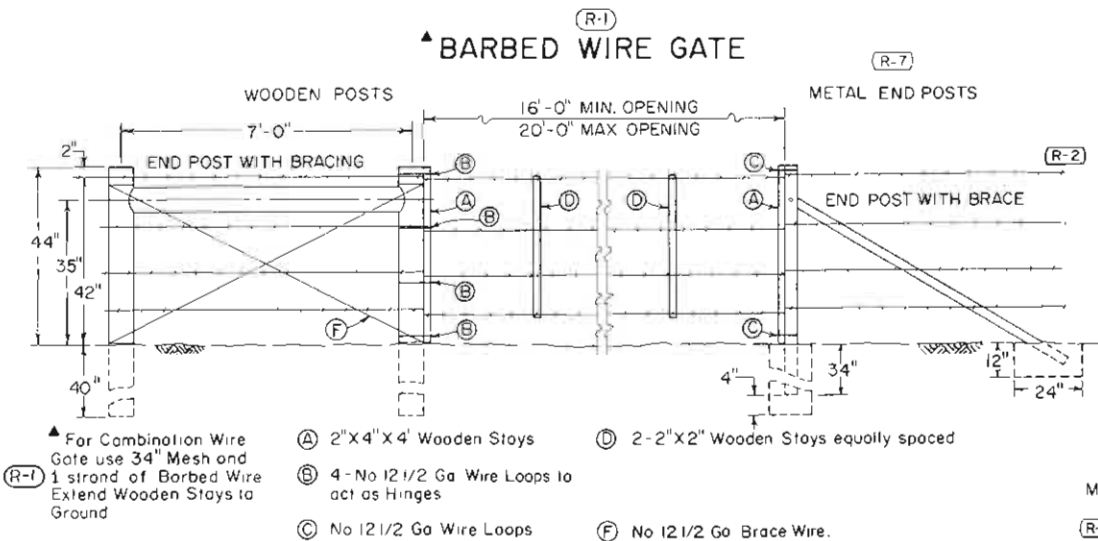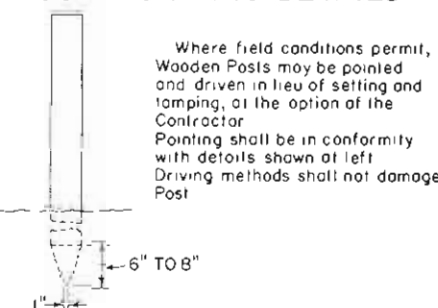

FENCE WIRE TIES

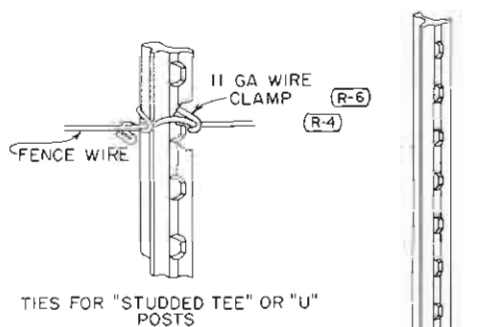

TYPICAL METAL POSTS

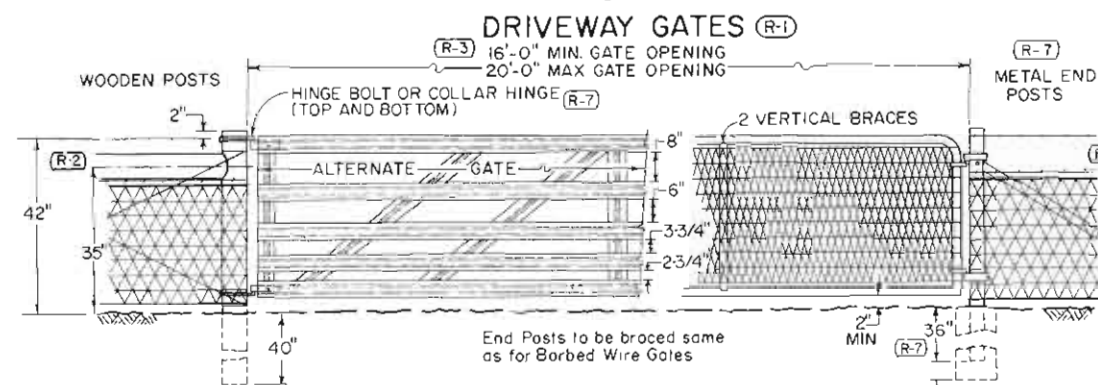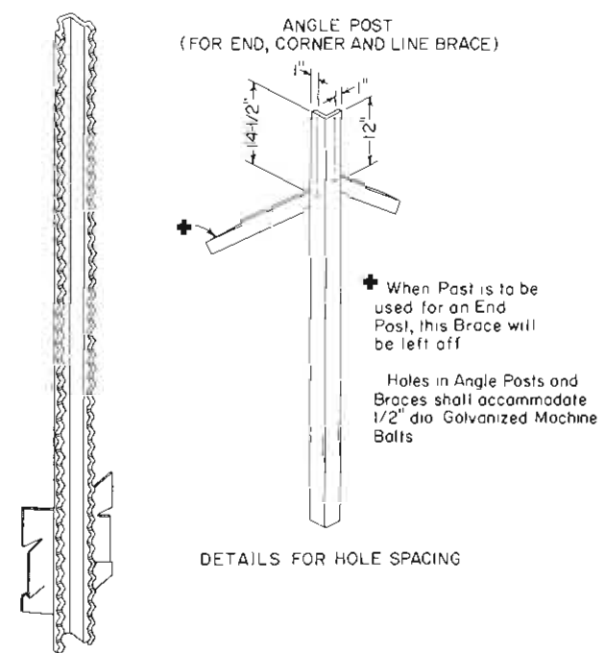

GENERAL NOTES

- (R-5) All work shall be done in accordance with the Standard Specifications applicable to the Project. All material dimensions and weights on this standard are nominal unless otherwise indicated.
- (R-1) At each location where an electric transmission, distribution or secondary line crosses a wood post fence the Contractor shall furnish and install a ground conforming to Section 9 of the National Electric Safety Code.
- (R-2) Dimensions shown for "Standard" and "Alternate" apply for both wooden and metal post fence.
- Fence wire shall be ended, double wrapped and tied off at end posts, angle posts and line brace posts. Fence to be continued shall then be restarted in like manner.
- Fence wire to be placed on either road or field side of posts depending on local conditions, i.e. on curves the wire should be placed on the side of the post which would prevent tension on fence ties. This will also apply where wind drift, tumble weeds or other conditions would exert unusual pressure against the wire.

WOOD POSTS

- All line posts shall have a min dia of four (4) inches & be 6'-0" long Min.
- All end, corner, intersection and brace posts shall have a minimum diameter of five (5) inches and be 7'-0" long.
- Fence wire will be stapled to wooden posts or tied to metal posts as shown marked on barbed wire or combination wire fence details. Staples shall be No 9 wire min, at least 1 1/2 inches long.

METAL POSTS

- All posts and braces shall be of the types and weights shown or acceptable equivalents.
- Holes to be provided in end, corner and gate posts as detailed.

CORNER AND LINE BRACE POSTS:

- Type - 2 1/2" X 2 1/2" X 1/4" Structural Steel Angles
- Weight - 3.81 lbs/lin ft
- Length - 6'-6" Min
- No of Braces - 2

LINE POSTS:



- Type - "Studded Tee" or "U"
- Weight - 1.28 lbs/lin ft (without Anchor)
- Length - 6'-0" Min.
- Anchor - Securely fastened, with bearing surface sufficient to resist movement of post. Weight - 0.57 lb Min.

METAL END POSTS AND GATE POSTS:

- Type - 2 1/2" X 2 1/2" X 1/4" Structural Steel Angles
- Weight - 3.81 lbs/lin ft
- Length - End, 6'-6" Min.; Panel Gate, 7'-0" Min.
- No of Braces - 1

BRACES (For Corner, End or Line Brace Posts)

- Type - 2" X 2" X 1/4" Structural Steel Angles
- Weight - 3.08 lbs/lin ft
- Length - Same as corner and end posts used.
- Posts shall meet requirements of For. 4.5 of U.S. Dept. of Commerce Commercial Standard 184-51. Acceptable material includes re-rolled railroad rails.

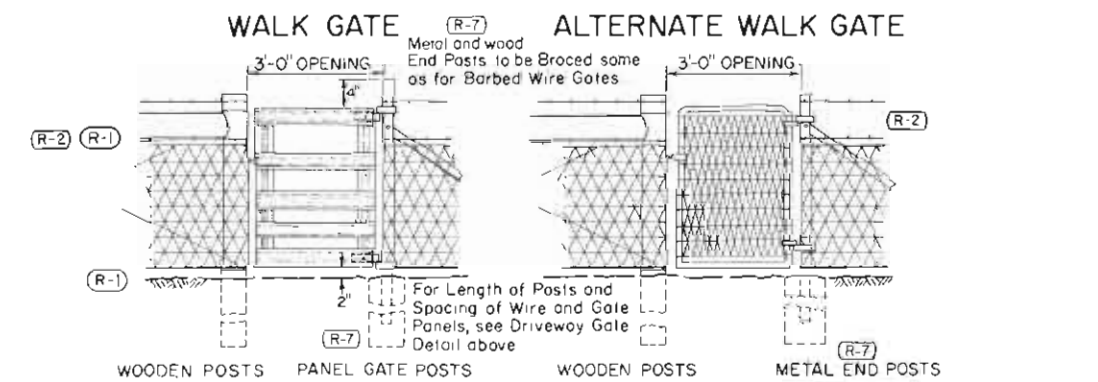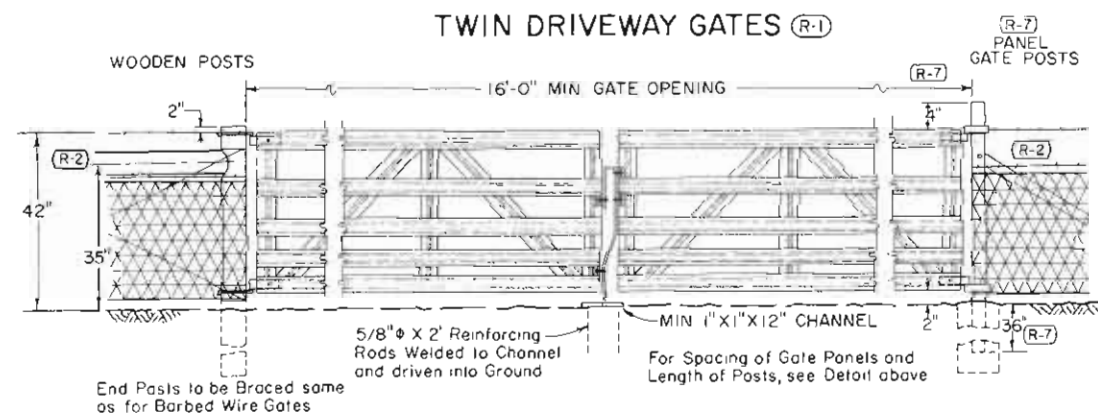

- (R-6) All fence wire ties, clips, clamps, staples and other wire appurtenances shall be galvanized in accordance with ASTM Designation A 116, Class 1.

ALTERNATE WALK GATES:

- Height - 42"
- Weight - Not less than 18 lbs complete with latch and hinges
- Width of gate opening - 3'-0"
- Gate Frame - 3/4" ID Standard Galvanized Pipe or acceptable equivalent and shall be of all welded construction
- Mesh to be of same construction as shown for Driveway Gate

Alternate equivalent standard metal gates other than shown will be acceptable subject to the Engineer's approval.

In lieu of galvanized finish on gate frames, Cadmium Plated pipe or Aluminum painting will be considered to be equivalent.

LATCHES AND HINGES

- Galvanized steel or Aluminum of standard make
- Hinges shall be placed as shown, to prevent theft.
- In lieu of standard make latches it will be permissible to use an electro-galvanized chain, eyebolt and snaphook type latch
- Eyeball, chain and snaphook assembly to be secured to latch side of gate. Gate closure effected by wrapping chain around end post and snapping hook into chain.

WOODEN STAYS

- Wooden stays shall be untreated native timber. Stay dimensions, including length, shall have a tolerance of $\pm 1/4$ ".

DEPARTMENT OF HIGHWAYS
STATE OF COLORADO
DIVISION OF HIGHWAYS


WIRE FENCES AND GATES

Designed by LEO Approved by EEO
Made by TEF Staff Des. Eng.
Checked by EEO Date: July 1, 1965


STANDARD M-607-B

(SHEET 2)
(JULY 13, 1970)


REVISIONS	DATE	BY	APP'D.
(R-5) 7-13-70	CHIEF ENGINEER	M.R.H.	
(R-6) 12-1-70	Add detail 6a and 13.	M.R.H.	
(R-7) 4-20-71	Line brace like tension wire clamp.	M.R.H.	

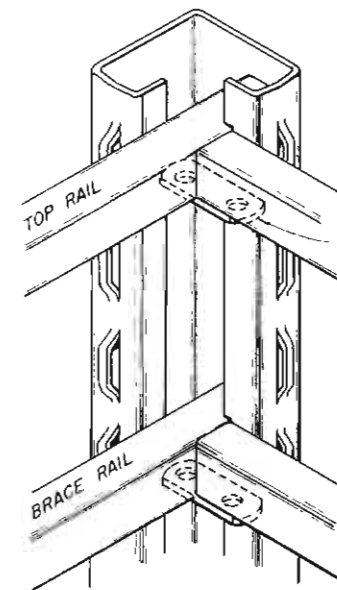

CORNER POST TREATMENT
①

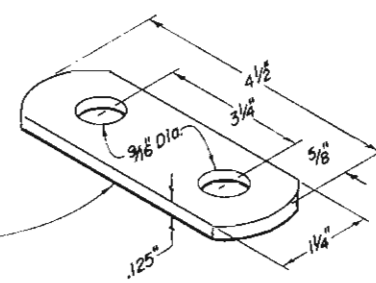


CONNECTOR PLATE
②

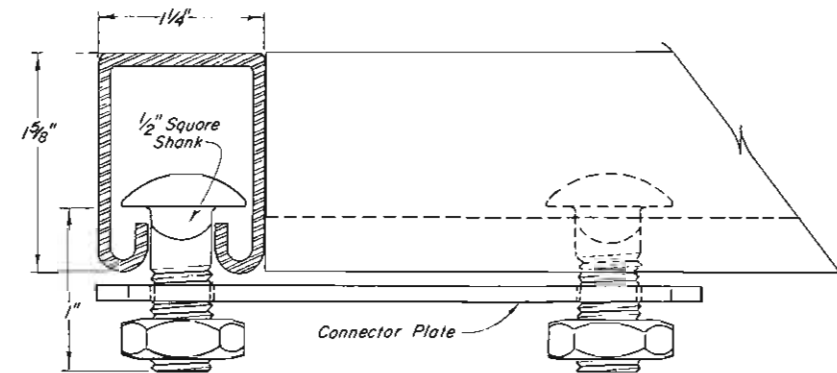


RAIL (Showing Corner Assembly)
③
1/4 GAGE ROLL FORMED STEEL, 20' LENGTHS, 1.35 LB. PER LIN. FT.




BARBED SELVAGE
⑧

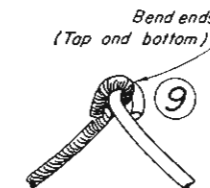


KNUCKLED SELVAGE
Alternate, use only when called for on plans.
⑨

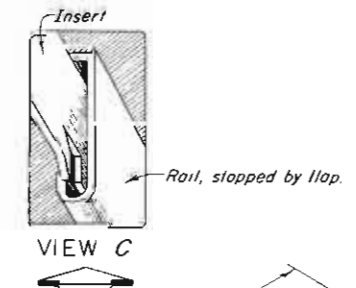



RAIL SPLICE INSERT
⑫

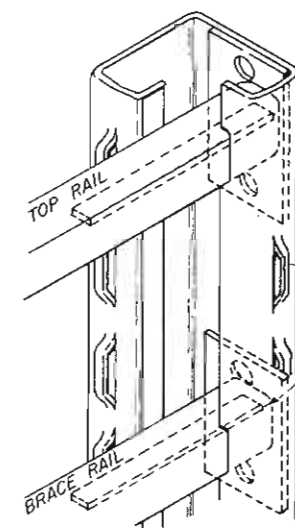


END POST TREATMENT
④

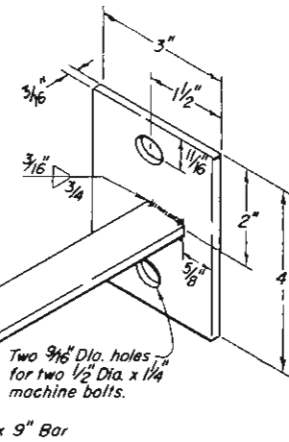


TORQUE BAR
⑤

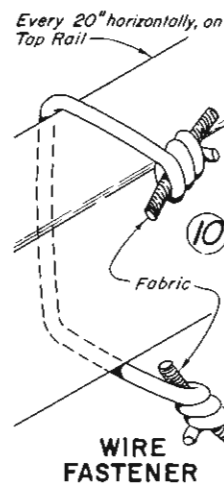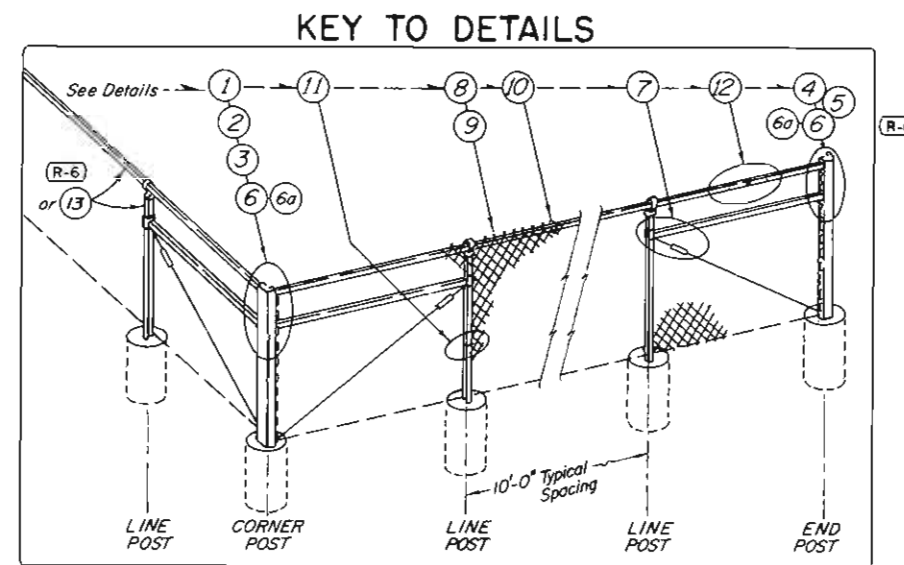


WIRE FASTENER
⑩

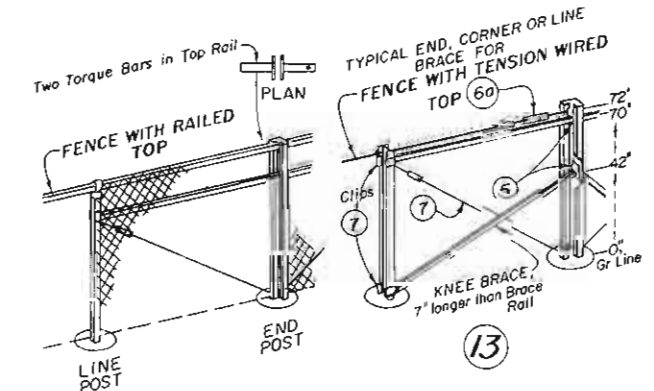


LINE BRACE (1/2 shown)
400 FT. INTERVALS
⑬

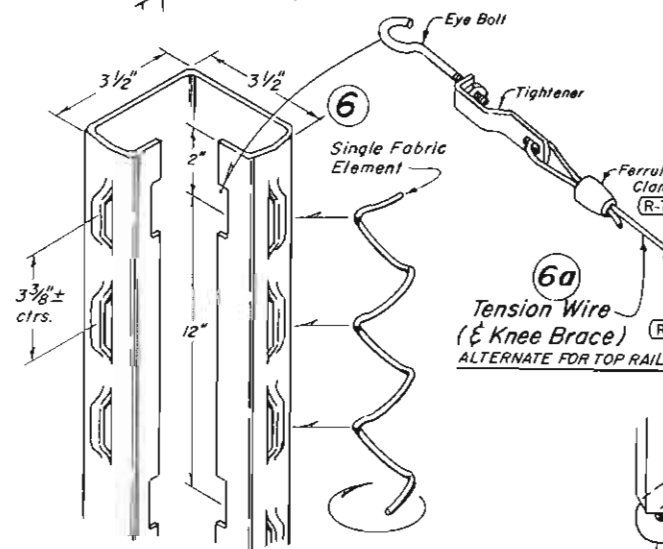


Tension Wire (Knee Brace)
ALTERNATE FOR TOP RAIL
⑥a

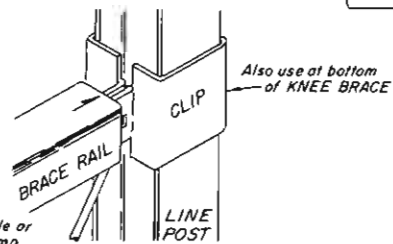

TYPICAL BRACING
⑦

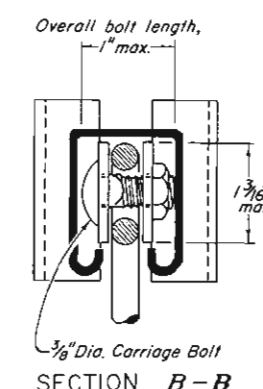

SECTION B-B

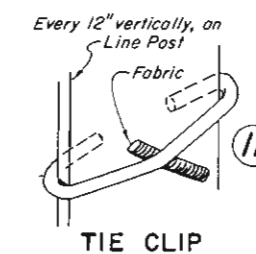

TIE CLIP
⑪

WIRE WORK


END POST OR CORNER POST
10 GAGE ROLL FORMED STEEL, 5.14 LB. PER LINEAR FOOT

DEPARTMENT OF HIGHWAYS
STATE OF COLORADO
DIVISION OF HIGHWAYS
CHAIN LINK FENCE
(ALTERNATE)
Designed by M.R.H. Approved by J.R.B. Staff Design Engineer
Made by J.R.B. Checked by R.S.M. Date July 13, 1970


STANDARD M-607-B

(SHEET 2)
(JULY 13, 1970)


Revision	Date	Description	By	App'd
1	7-13-70	Entire sheet	MRH	
2	12-11-70	Add details 6a and 13	MRH	
3	4-20-71	Line brace title, Tension wire clamp	MRH	

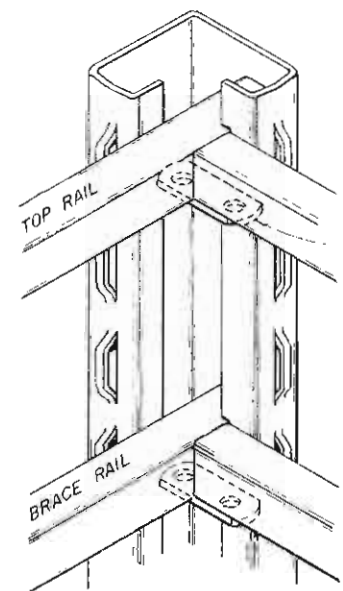

CORNER POST TREATMENT
①

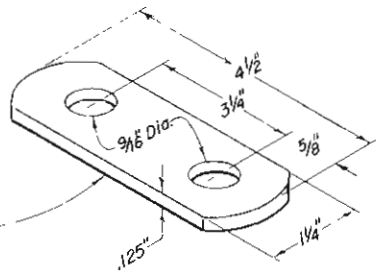


CONNECTOR PLATE
②

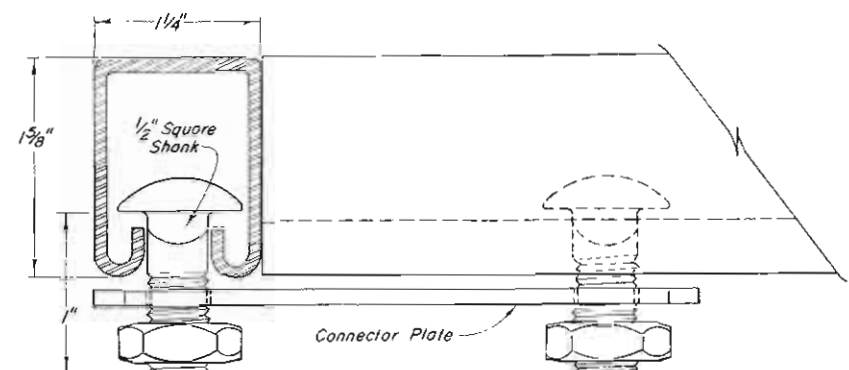


RAIL (Showing Corner Assembly)
③
14 GAGE ROLL FORMED STEEL, 20' LENGTHS, 1.35 LB. PER LIN. FT.




BARBED SELVAGE
⑧

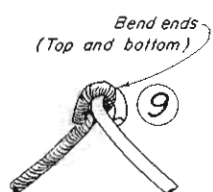


KNUCKLED SELVAGE
⑨
Alternate, use only when called for on plans.

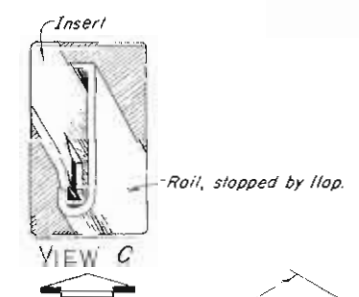



RAIL SPLICE INSERT
⑫

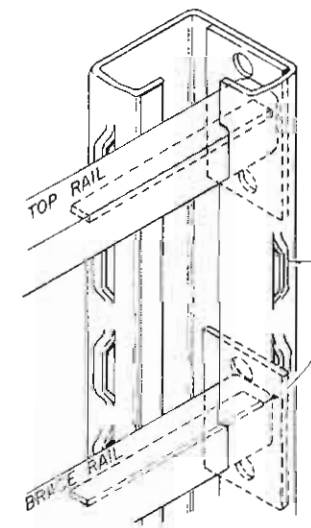


END POST TREATMENT
④

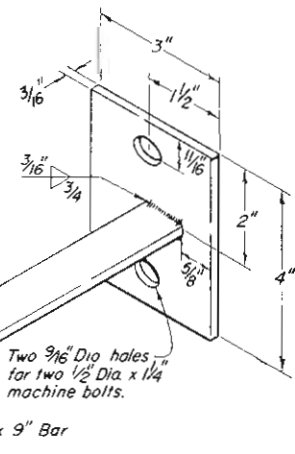


TORQUE BAR
⑤

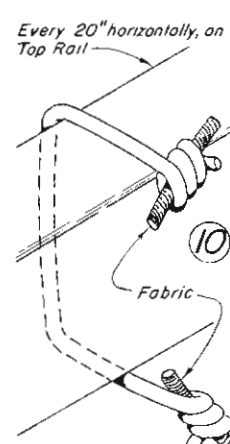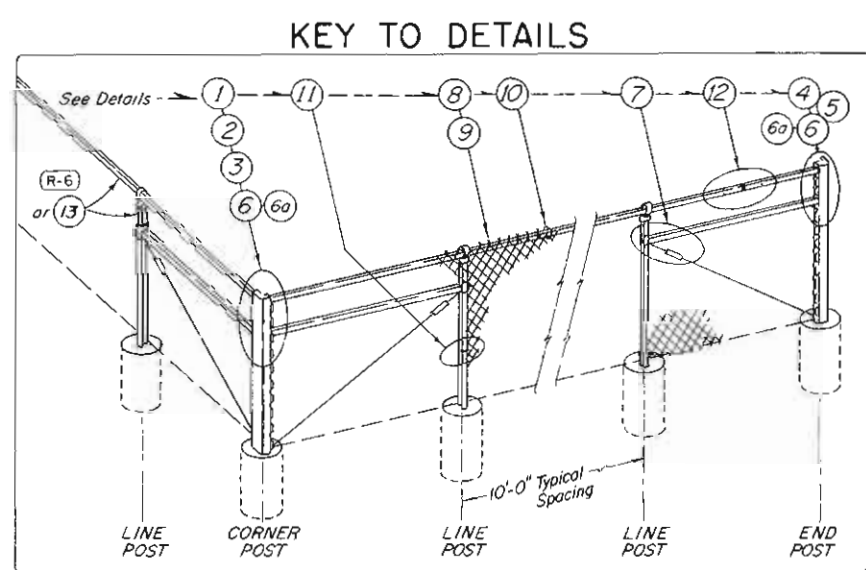


WIRE FASTENER
⑩

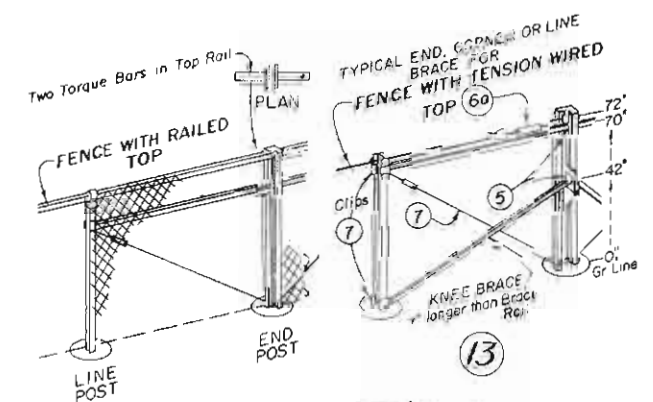


LINE BRACE (1/2 shown)
⑬
400 FT. INTERVALS
(R-6)

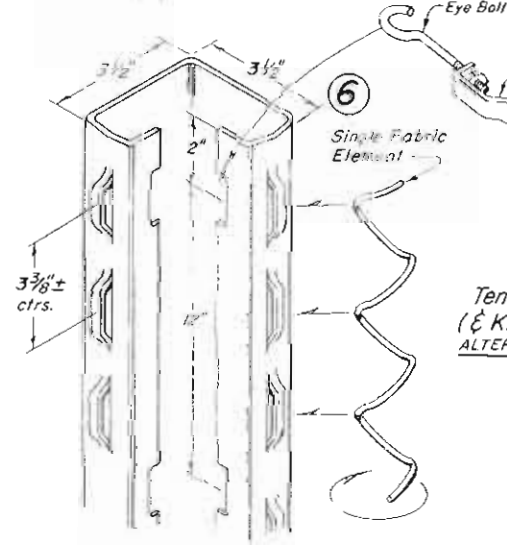


END POST OR CORNER POST
⑥a
10 GAGE ROLL FORMED STEEL, 5 1/4 LB. PER LINEAR FOOT

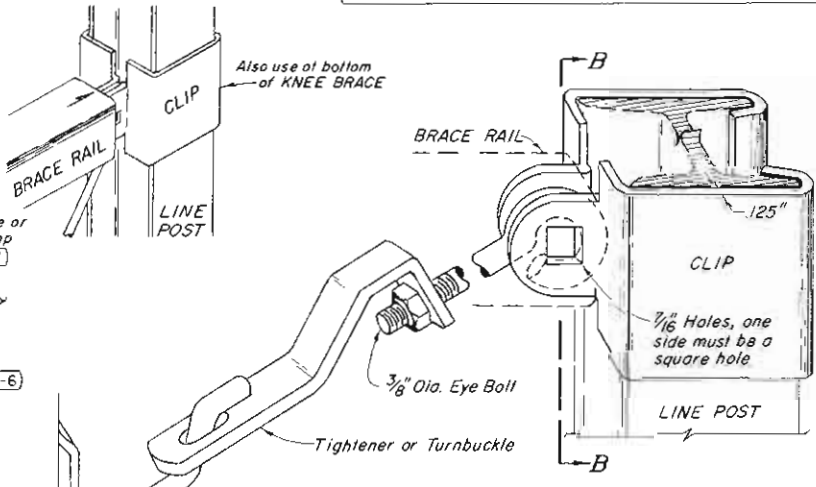

TYPICAL BRACING
⑦

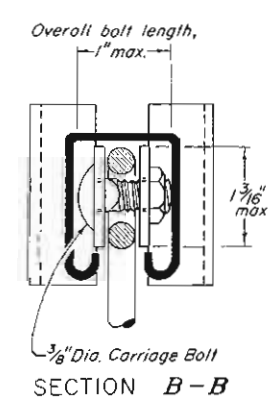

SECTION B-B
⑧a
3/8" Dia. Carriage Bolt

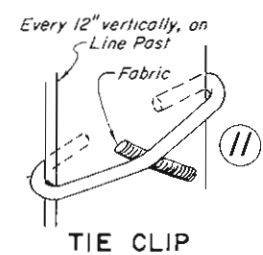

TIE CLIP
⑪

WIRE WORK

DEPARTMENT OF HIGHWAYS
STATE OF COLORADO
DIVISION OF HIGHWAYS

CHAIN LINK FENCE
(ALTERNATE)

Designed by: J. W. A. Approved by: S. D. S. Date: July 13, 1970
Made by: R. S. A.
Checked by: R. S. A.

STANDARD CURBS AND GUTTERS


STANDARD M-609-A

(JULY 1, 1965)


FED. ROAD REG. NO.	DIVISION	PROJECT NO.	SHEET NO.
9	COLC		

REVISIONS			
(R-1)	11-16-65	Submittals	M.R.H.
(R-2)	2-14-66	General Notes	M.R.H.
(R-3)	7-19-68	Dept Name and Rev. Gen'l. Note	M.R.H.
(R-4)	5-21-69	Provide variable width on conc. gtr.	M.R.H.
(R-5)	5-7-71	Add class B to conc. in Gen. Note	M.R.H.


CONCRETE PAVEMENT (DRIVEWAYS)

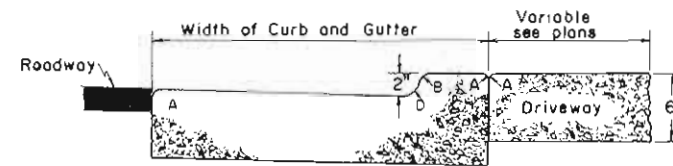


CONCRETE SIDEWALK

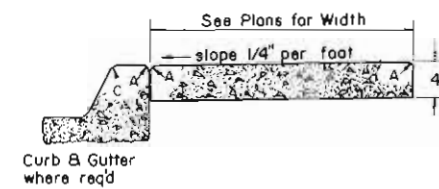

GUTTER Type 2

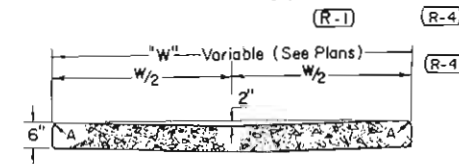


CURB AND GUTTER Type 2 (6" Barrier - 1' Gutter) (Section IB)

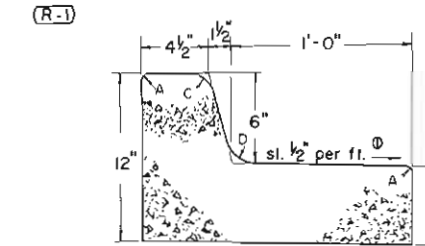


LEGEND FOR RADII	
A	= 1/8"
B	= 1"
C	= 1 1/2"
D	= 1 1/2" to 2"


CURB AND GUTTER (Type 2) (4" Mountable with Sidewalk) (Section MS)

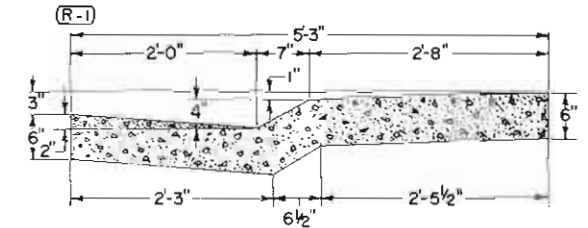


DETAIL OF CURB CUT FOR DRIVEWAYS

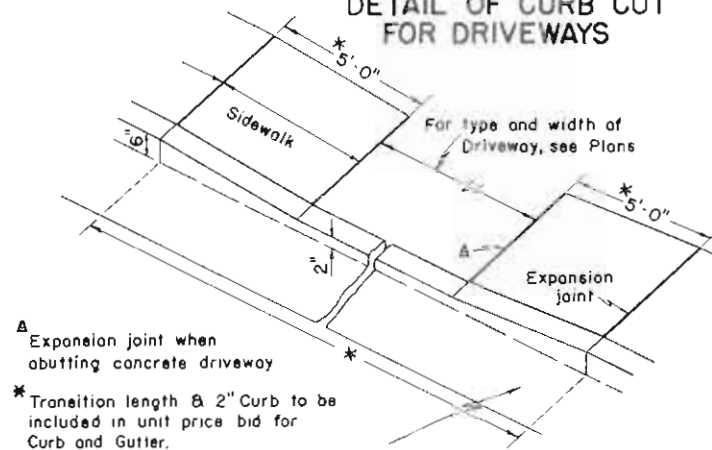

CURB Type 4 (6" Barrier) (Section B) CURB Type 4 (6" Mountable) (Section M)

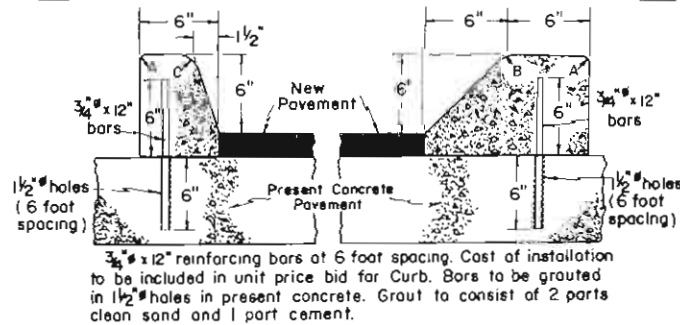


CURB AND GUTTER Type 2 (6" Mountable - 1' Gutter) (Section IM)

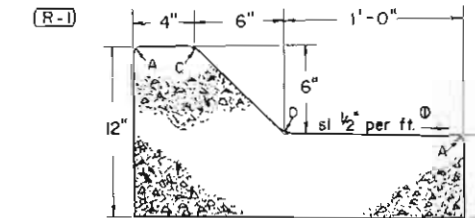


① Slope in opposite direction when required to fit field conditions.

CURB AND GUTTER Type 2 (6" Barrier - 2' Gutter) (Section IB)

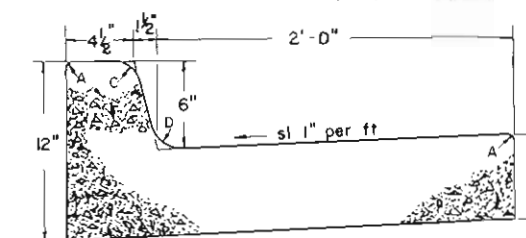

CURB AND GUTTER Type 2 (6" Mountable - 2' Gutter) (Section IM)

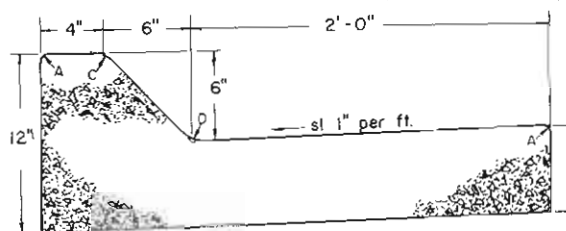

GENERAL NOTES

All work shall be done in accordance with the Standard Specifications applicable to the project.

On Curves 3 degrees and sharper, Curbs and/or Gutters are to be placed on the Arc of the Curve unless otherwise noted on plans. A maximum chord length of 10 feet may be used when the degree of curve is less than 3 degrees.


Expansion joints shall be installed between concrete curb and any fixed structure, sidewalk or bridge. Expansion joint material shall be 1/2" thick and shall extend the full depth of contact surface.

Concrete shall be Class A, B or D.

SIDEWALK EXPANSION JOINT




TRANSVERSE CONTRACTION JOINT FOR CONCRETE PAVEMENT (DRIVEWAYS)

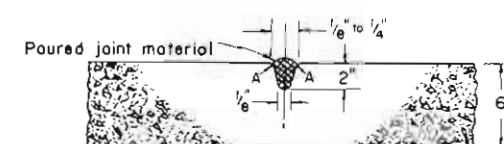


This joint required where length of slab exceeds 15 feet.

CONSTRUCTION OF CONCRETE GUTTERS AT INTERSECTIONS

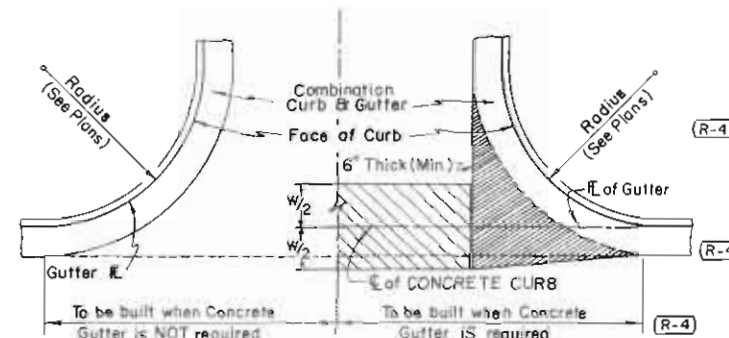

This area shall be poured monolithically with curb and gutter and paid for as Concrete Pavement of specified thickness.

CURB Type 6 (4" Mountable) (Section M)

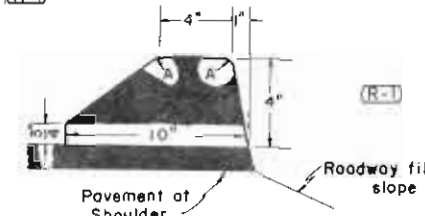

DEPARTMENT OF HIGHWAYS
STATE OF COLORADO
DIVISION OF HIGHWAYS

CURBS AND GUTTERS

Designed by *W.C.*
Made by *W.C.*
Checked by *W.C.*
Approved by *W.C.*
Staff Design Engr.
Date: July 1, 1965

RIGHT OF WAY MARKER POST

STANDARD M-612-A

(JULY 1, 1965)

FEDERAL ROAD REG. NO.	DIVISION	PROJECT NO.	SHEET NO.
9	COLORADO		

REVISIONS			
(R-1)	5-2-66	R.O.W. Marker Note	M.R.H.
(R-2)	7-24-68	Dept. Name	M.R.H.
(R-3)	5-7-71	Add note on concrete	M.R.H.
(R-4)	6-30-71	Bronze Tabl. dims. Rev all Dept to Div	M.R.H.

BENCH MARK

All work shall be done in accordance with Standard Specifications applicable to the project.

All exposed surfaces of the bronze tablet are to be ground to a smooth surface. All letters are to be depressed a minimum of 1/16 inch. Information on the bronze tablet indicated by pin lines is to be stamped in field by the engineering party after marker is placed. 3/16 inch letters and figures to be used. Project designation on tablets shall be properly shown (i.e., I for Fed Aid Interstate, F for Fed Aid Primary, S for Fed Aid Secondary, etc. B, C for State Projects. See details below).

(R-4) Bronze Bench Mark Tablets will be furnished by the Division at no expense to the Contractor.

Installation of Bronze Bench Mark Tablets will not be paid for directly, but shall be included in the price bid for Concrete.



NOTES FOR R.O.W. MARKER POSTS

All work shall be done in accordance with the Standard Specifications applicable to the project.


(R-3) Posts shall be Class A, B or D concrete. The upper 12 inches of marker posts shall be rubbed free of form marks, and the top surface of the post must be constructed to drain thoroughly.

(R-1) Light weight aggregate conforming to ASTM C 330 will be allowed.

All exposed surfaces of the bronze tablet are to be ground to a smooth surface. All letters are to be depressed a minimum of 1/16 inch. Information on the bronze tablet indicated by pin lines is to be stamped in field by the engineering party after post is placed. 3/16 inch letters and figures to be used. Project designations on tablets shall be properly shown (i.e., I for Fed Aid Interstate, F for Fed Aid Primary, S for Fed Aid Secondary, etc. B, C for State Projects. See detail below).

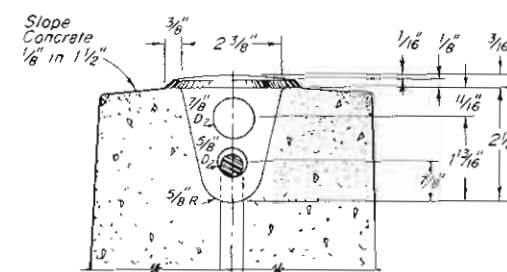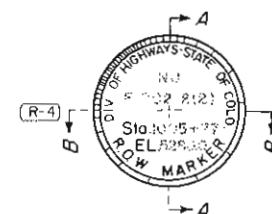


SECTION B-B

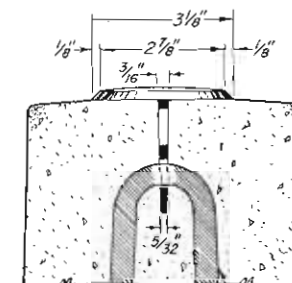


SECTION A-A


DETAIL OF BRONZE TABLET (R-4)
FOR RIGHT OF WAY MARKER POST AND BENCH MARK

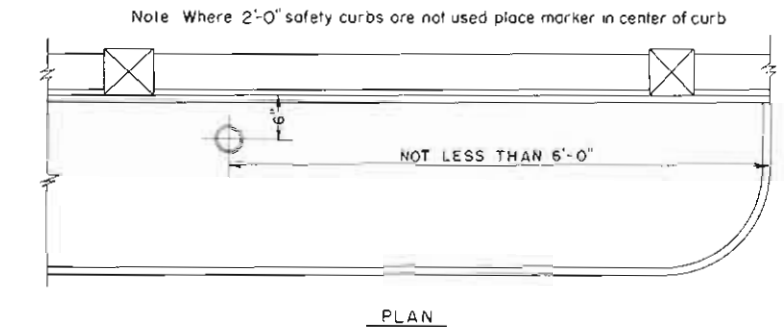

PLAN

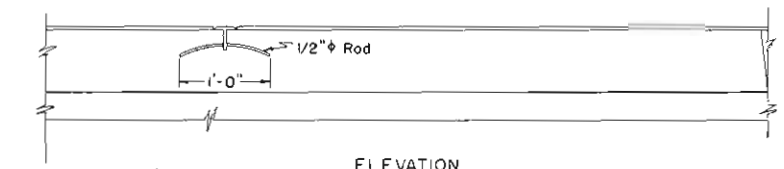

ELEVATION

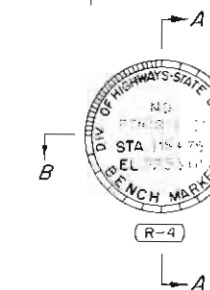

One marker to be placed on Bridges as shown. The station shown on marker shall be the center-line stationing directly opposite the marker.

(R-2)

DEPARTMENT OF HIGHWAYS
STATE OF COLORADO
DIVISION OF HIGHWAYS

MARKER POSTS
AND
BENCH MARKS

Designed by REL Approved by J.E. Olson
Made by EEO Staff Design Engr.
Checked by REL Date July 1, 1965

STANDARD M-612-C

(SHEET 1 OF 2 SHEETS)

JULY 1, 1965

FED. ROAD REG. NO.	DIVISION	PROJECT NO.	SHEET NO.
9	COLORADO		

REVISIONS			
(R-2)	1-9-68	Median Crossover, Gen'l Note	M.R.H.
(R-3)	7-1-68	Division Name	M.R.H.

GENERAL NOTES

All work shall be done in accordance with the Standard Specifications applicable to the project.

See tabulation in plans for delineator post requirements.

Spacing between Posts on acceleration and deceleration lanes and on relatively straight portions of interchange ramps shall be 100' on Interstate and 200' on Primary and Secondary Projects. Spacing between Posts on the outside of interchange ramp curves shall be as indicated in table for the appropriate degree of curve with a 24' min. spacing. Post spacing in advance and beyond curve shall not apply to ramp curves.

Posts shall meet requirements of Par. 4.5 of U.S. Dept. of Commerce Commercial Standard 184-51. Acceptable material includes re-rolled railroad rails.


When normal delineator spacing falls on a road approach or crossroad, move delineator either direction a distance not to exceed 1/4 normal spacing.

Type, location and spacing of delineators for tunnels and snow sheds shall be as directed by the Engineer.


Delineator Posts are not to be placed along Frontage Roads.

Color of Posts shall be Interstate Green.

(R-2) Delineators will not be required on tangents for Primary and Secondary roadways.

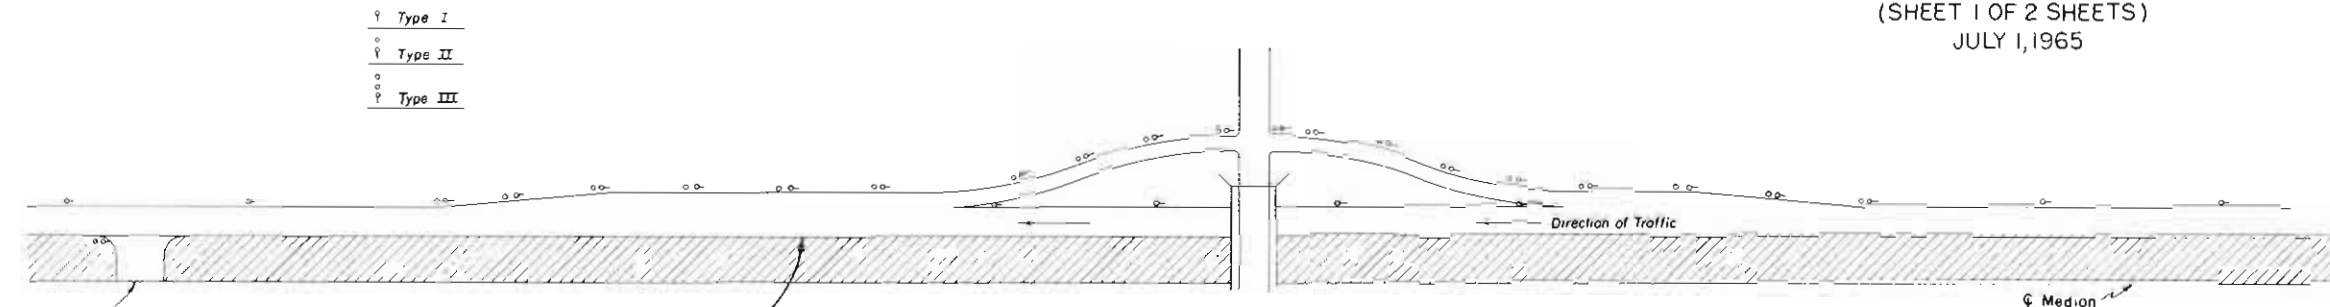

Typical Installation for Diamond Interchange.

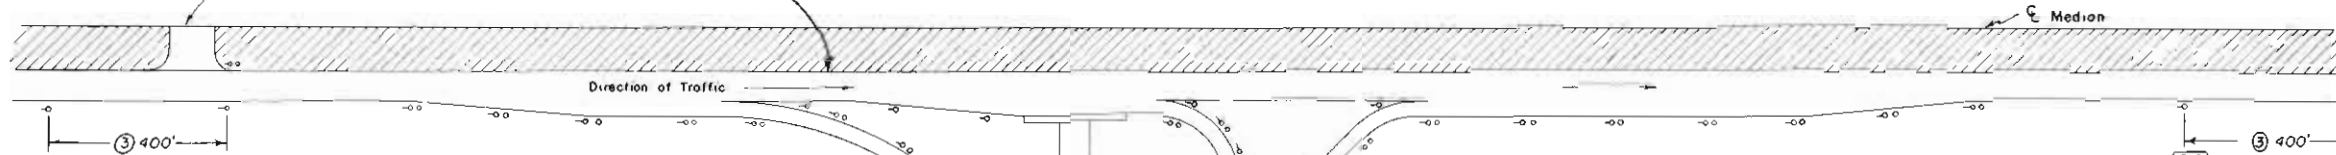

Typical Installation for Cloverleaf Interchange.


SPACING FOR DELINEATOR POSTS ON HORIZONTAL CURVES

DEGREE OF CURVE	RADIUS	① SPACING ON CURVE	② SPACING IN ADVANCE OF AND BEYOND CURVE			DEGREE OF CURVE	RADIUS	① SPACING ON CURVE	② SPACING IN ADVANCE OF AND BEYOND CURVE		
			FIRST SPACE	SECOND SPACE	THIRD SPACE				FIRST SPACE	SECOND SPACE	THIRD SPACE
0°30'	11460.0'	200	200	200	200	8°00'	716.3'	52	94	156	200
1°00'	5730.0'	151	200	200	200	8°30'	674.1'	50	90	150	200
1°30'	3820.0'	123	200	200	200	9°00'	636.7'	48	86	144	200
2°00'	2865.0'	106	191	200	200	9°30'	603.2'	47	85	141	200
2°30'	2292.0'	95	171	200	200	10°00'	573.0'	46	83	138	200
3°00'	1910.0'	86	155	200	200	10°30'	545.7'	45	81	135	200
3°30'	1637.1'	80	144	200	200	11°00'	520.9'	43	77	129	200
4°00'	1432.5'	74	133	200	200	11°30'	498.3'	42	76	126	200
4°30'	1273.3'	70	126	200	200	12°00'	477.5'	41	74	123	200
5°00'	1146.0'	66	119	198	200	15°00'	382.0'	36	65	108	200
5°30'	1041.8'	63	113	189	200	18°00'	318.3'	33	59	99	198
6°00'	955.0'	60	108	180	200	21°00'	272.9'	30	54	90	180
6°30'	881.5'	58	104	174	200	25°00'	229.2'	27	49	81	162
7°00'	818.6'	55	99	165	200	30°00'	191.0'	24	43	72	144
7°30'	764.0'	53	95	159	200						

① $S = 2 \sqrt{R - 50}$ 1-ST. SPACE = 18S 2-ND. SPACE = 3S 3-RD. SPACE = 6S
NO SPACES TO EXCEED 200 FT.

② Omit third space on Secondary and Primary Routes and double the distance on the curve and in advance of and beyond curve. For curves less than 2 degrees on Interstate through roadways use Interstate tangent spacing.

Typical Installation at Bridge Approaches

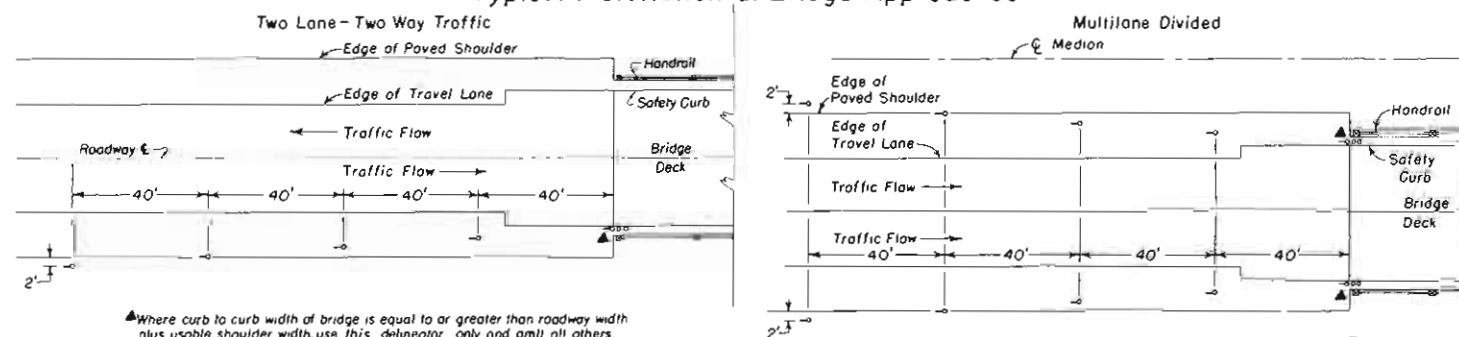

▲ Where curb to curb width of bridge is equal to or greater than roadway width plus usable shoulder width, use this delineator only and omit all others.
Note: Where guard rail is present, place delineators outside of guard rail and at height which will permit clear view of all three Delineator buttons.



When approach slab has curb, place Type III delineator immediately behind curb.

SECTION OF U-2 POST

Dimensions shown are approximate.
U-2 Post to weigh 2 Lbs./Ft.

Alternate post acceptable if section modulus is at least 0.200 in.³ about X-X axis or at least 0.250 in.³ about Y-Y axis.

▲ A mill tolerance of minus 3-1/2% of the weight of any one post will be allowed

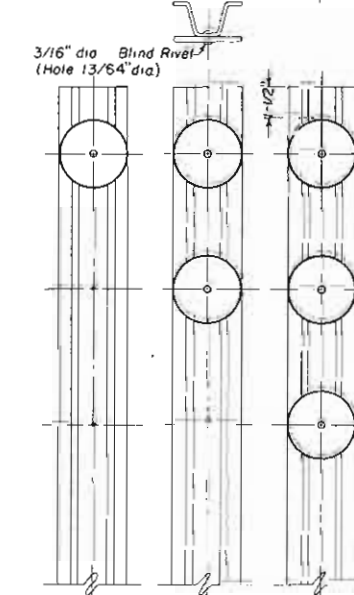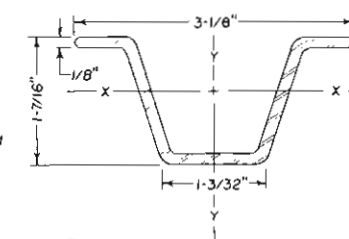

TYPE I
1-3" dia. Crystal Reflector on U-2 Post

TYPE II
2-3" dia. Yellow Reflectors on U-2 Post

TYPE III
3-3" dia. Yellow Reflectors on U-2 Post

Min 3 holes in all posts required as shown.

DEPARTMENT OF HIGHWAYS
STATE OF COLORADO
DIVISION OF HIGHWAYS

DELINEATORS

Designed by CKM
Made by WNC
Checked by LEO

Approved by [Signature]
Staff Design Engr.
Date July 1, 1965

STANDARD M-612-C


(SHEET 2)

(JULY 1, 1965)

FED. ROAD REG. NO.	DIVISION	PROJECT NO.	SHEET NO.
9	COLORADO		

REVISIONS			
(R-1)	5-4-67	Median and Island Delineators	M.R.H.
(R-2)	1-9-68	Median Crossover	M.R.H.
(R-3)	7-11-68	Division Name	M.R.H.


TYPICAL INSTALLATION FOR CHANNELIZED INTERSECTION

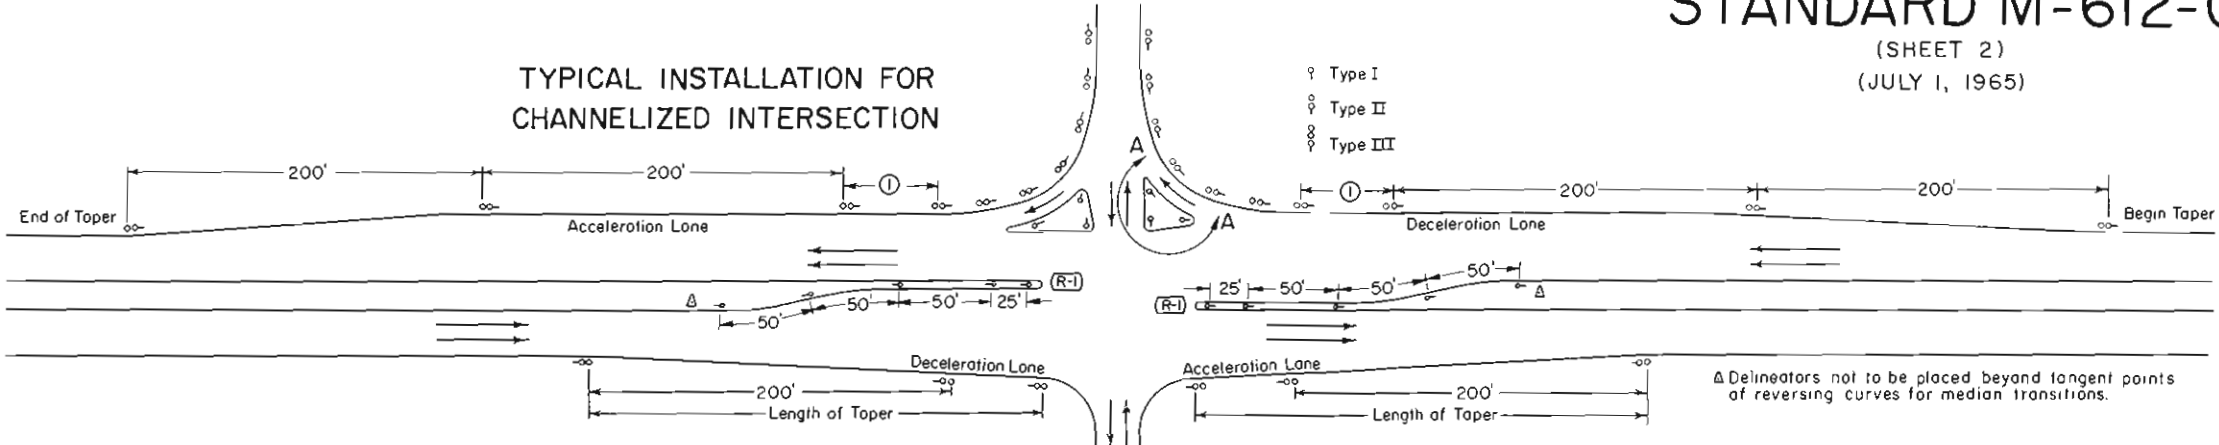


GENERAL NOTES

- For Radii greater than 200 Feet, use spacing from Table included on Sheet 1 of this Standard.
- For additional General Notes, see Sheet 1 of this Standard.
- Place face of button at 90° to C of roadway.
- Lengths of speed change lanes including tapers shall be as shown on plans.

TYPICAL INSTALLATION FOR CLIMBING LANE TRANSITION

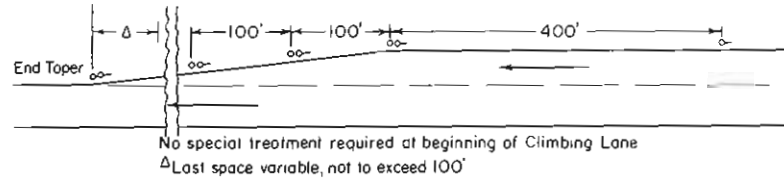


2 LANE - 2 WAY

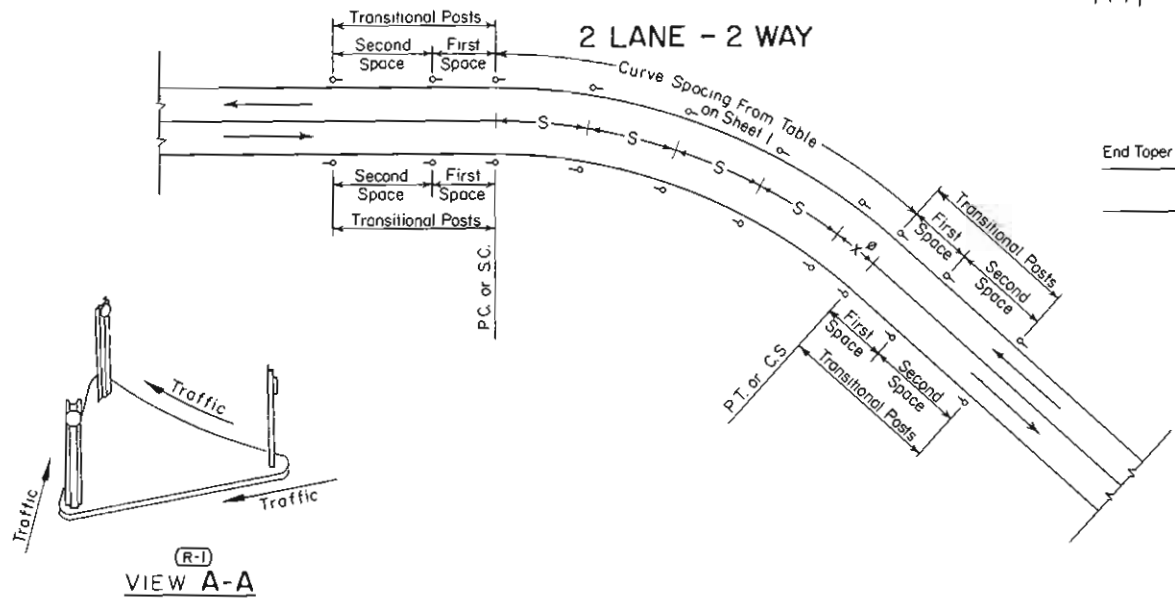

VIEW A-A

4 LANE DIVIDED (INTERSTATE)

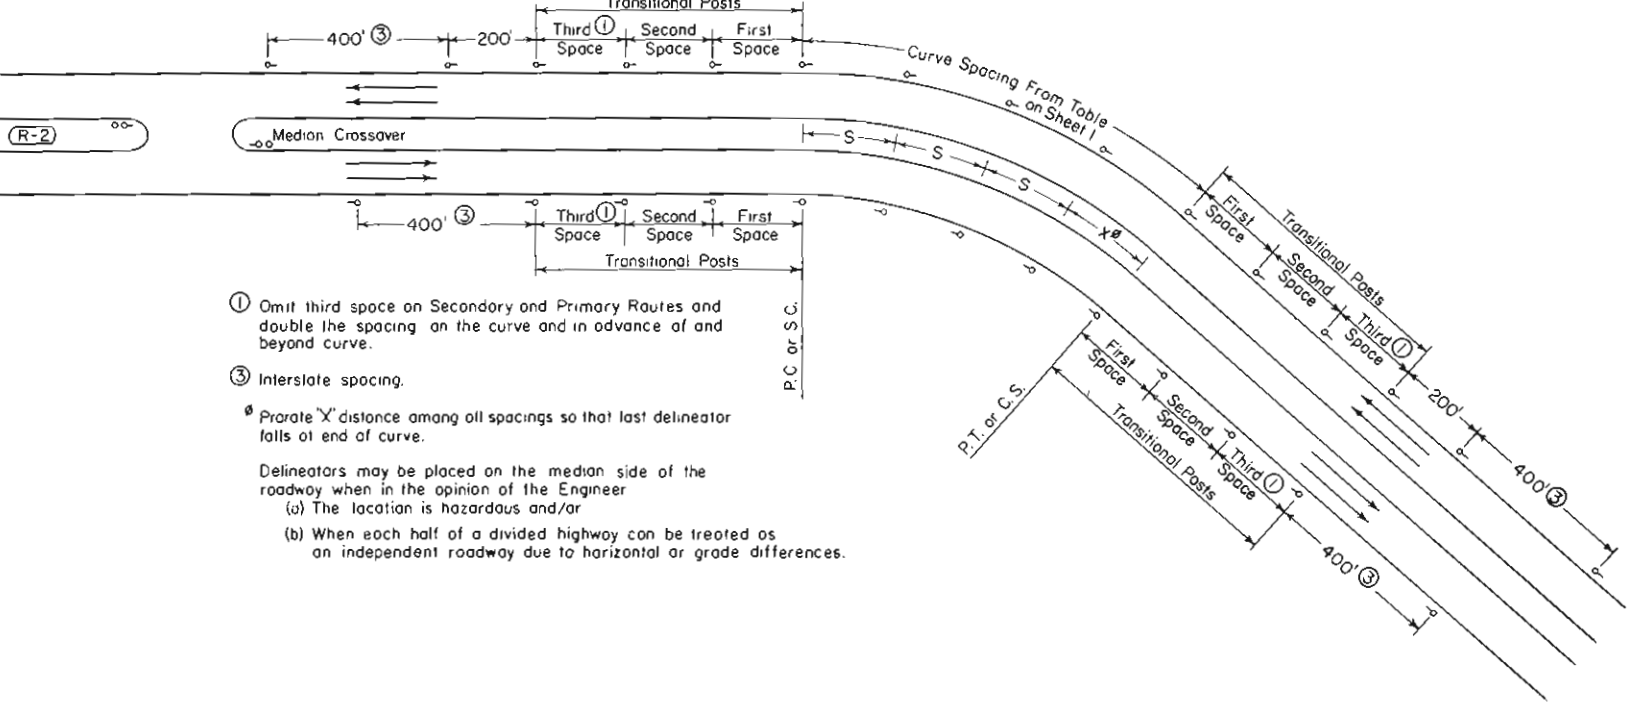

- ① Omit third space on Secondary and Primary Routes and double the spacing on the curve and in advance of and beyond curve.
 - ③ Interstate spacing.
 - ④ Prorate 'X' distance among all spacings so that last delineator falls at end of curve.
- Delineators may be placed on the median side of the roadway when in the opinion of the Engineer
- (a) The location is hazardous and/or
 - (b) When each half of a divided highway can be treated as an independent roadway due to horizontal or grade differences.

(R-3)


DEPARTMENT OF HIGHWAYS
STATE OF COLORADO
DIVISION OF HIGHWAYS

DELINEATORS


Designed by C.K.M.
Made by T.E.F.
Checked by L.E.O.
Approved by [Signature]
Staff Design Engr.
Date: July 1, 1965

CLASS I BARRICADES (3 RAILS)

MOVABLE


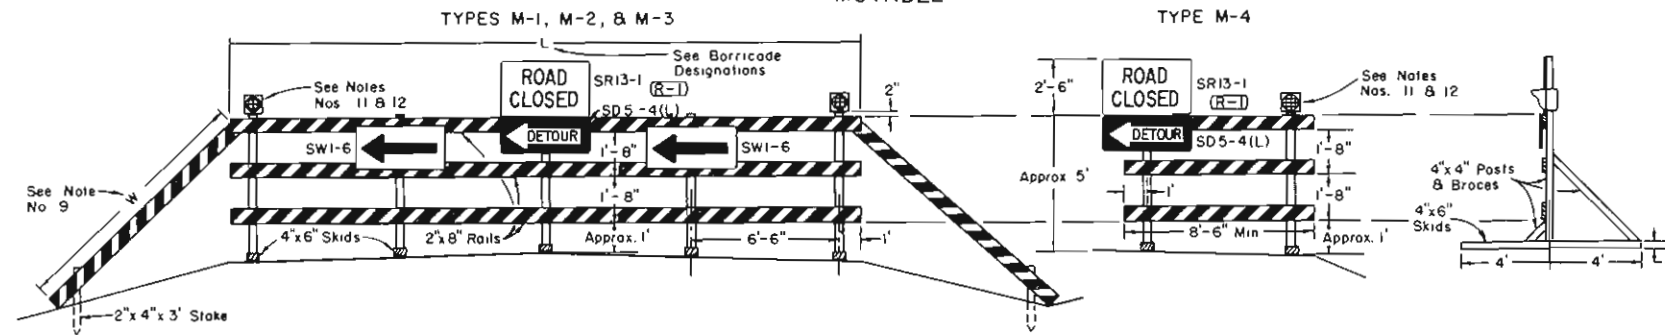


FIXED

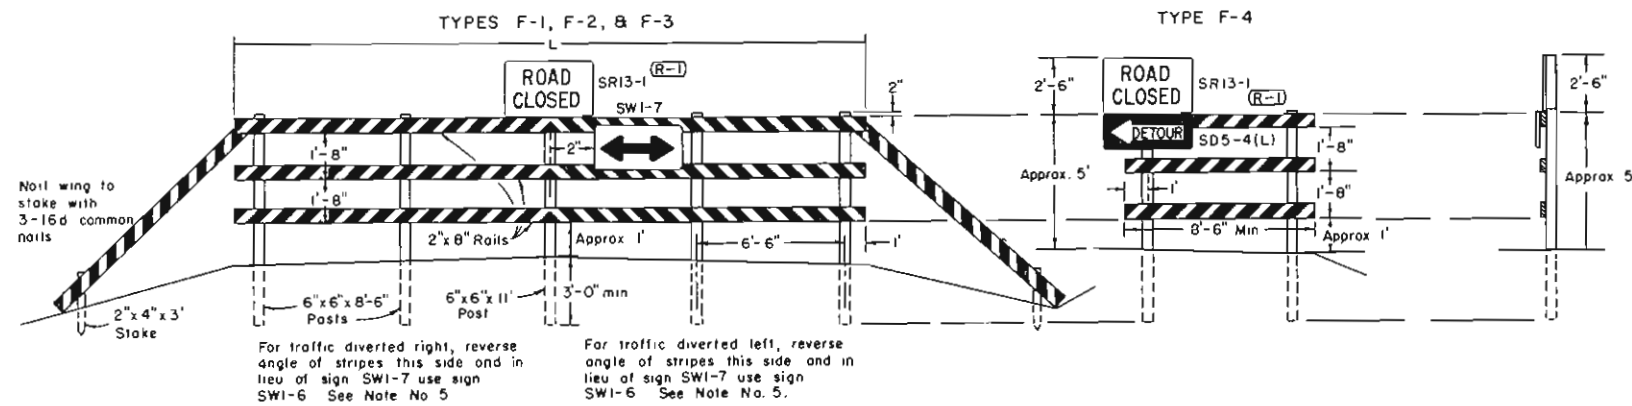


CLASS II BARRICADE (1 RAIL)


FIXED
TYPE F-6

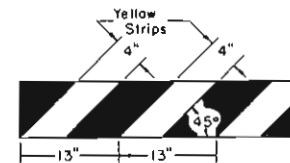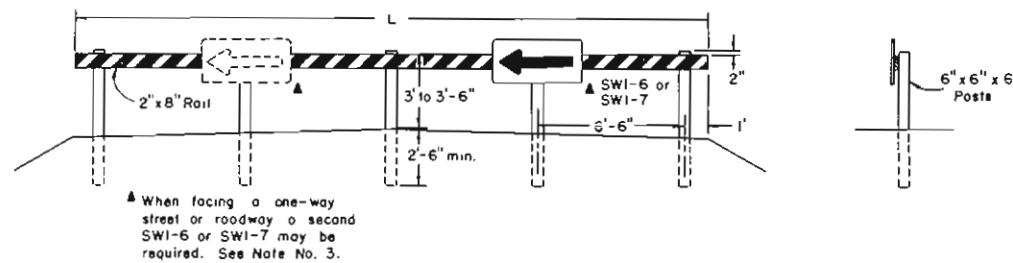

DETAIL OF RAIL
AND WING STRIPING

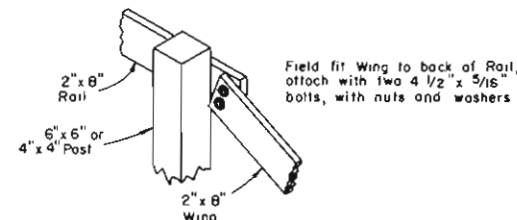



REAR VIEW OF BARRICADE
SHOWING WING ATTACHED
(See Note No. 9)

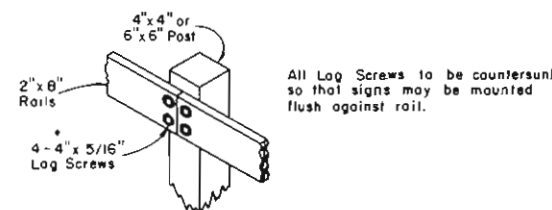

METHOD OF ATTACHING PLANKING
TO POSTS AT JOINTS

SITUATION A

SITUATION B

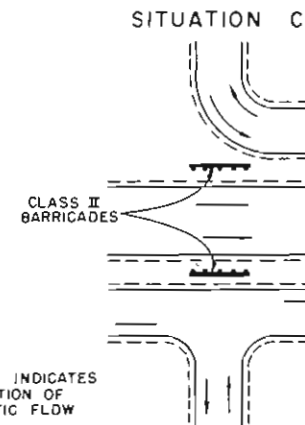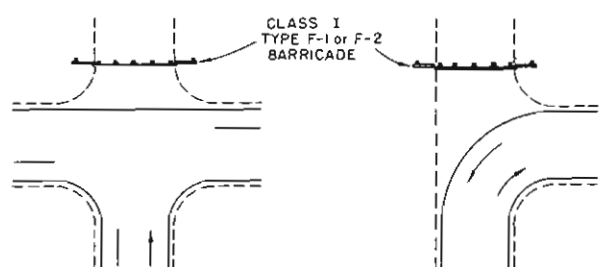

INDICATES
DIRECTION OF
TRAFFIC FLOW

STANDARD M-614-A

(JULY 1, 1965)

FEDERAL ROAD DISTRICT	PROJECT NO.	SHEET NO.
9 COLORADO		

REVISIONS		
Rev. No.	Rev. Date	Rev. Description
(R-1)	1-15-68	Rev. Dept. Code Nos. JLS
(R-2)	4-23-69	Rev. Code No. 8 Notes JLS

GENERAL NOTES

- All work shall be done in accordance with the Standard Specifications applicable to the Project.
- All signs and sign materials shall conform to the standards set forth in the "Manual on Uniform Traffic Control Devices for All Classes of Streets and Highways" published by the Division of Highways and this standard.
- The various types and combinations of approved Signs and Beacons for Barricades required for each project shall be governed by field conditions and subject to approval by the Engineer. All traffic controls shall be placed for best visibility and legibility and maintained in good condition at all times. Oversigning is to be avoided.
- Painting shall conform with Subsection 508.08 of the Standard Specifications. All skids, braces, and posts shall be painted with 2 coats of "Exterior Black Paint." Planking and wings on all barricades shall be painted with 2 coats of "Exterior Black Paint" on all sides before adding reflective strips. Reflective strips shall be "cut from smooth surface yellow reflective sheeting" of a type approved by the Division.
- Each barricade rail shall be striped on the face side only with reflective yellow strips slanting downward at a 45° angle toward the side to which traffic is to turn or pass. See "DETAIL OF RAIL AND WING STRIPING."
- When barricades are designated on plans the portion of the posts below ground line shall either be dipped in or painted with hot creosote oil. The portion of the post above ground line shall be painted with 2 coats of "Exterior Black Paint."
- All skids, braces, and posts shall be nailed together with No. 20d nails. All screws, bolts, nuts, and washers shall be galvanized or cadmium plated. Skids (bases) of movable barricades shall be weighted where necessary to provide stability.
- All timber shall be Standard Grade or better, S4S, Douglas Fir or Larch, as described in the 1965 Standard Grading Rules published by the Western Wood Products Association, and shall conform to paragraph 123c for the rails and paragraphs 122c and 125c for the posts.
- Detachable extension wings for bypassing of construction equipment are permitted. "W" is variable, length shall be adequate to provide closing of borrow pit and/or shoulder as required.
- Alternate materials or other reflective elements on Traffic signs or Barricades will be permitted only after approval of such material by the Division in writing.
- A Flashing Beacon for use on Barricades is a section of a standard traffic signal head or a similar-type device having a yellow lens in the face, which is illuminated by intermittent flashes. Where commercial power is not available, the beacon may be adapted to operate from storage batteries. Each signal unit lens shall have a visible diameter of not less than 8 inches. Each unit complete shall be of such design as to render the lens when illuminated clearly visible to traffic facing the signal at all distances up to 1000 feet under all atmospheric conditions except dense fog. The color of the yellow lens for caution shall be in accordance with Technical Report No. 1 of the Institute of Traffic Engineers. All beacon flashers shall be equipped with filters for suppression of radio interference. The illuminating element in a flashing yellow beacon shall be flashed at a rate of not less than 50 times nor more than 60 times per minute. The illuminated period of each flash shall be not less than half and not more than two-thirds of the total cycle. The use of Flashing Beacons will be governed by field conditions. Flashing Beacons when warranted generally should be operated continuously throughout the 24 hours of the day. Warrant for Flashing Beacons may be found in Sec. 3G of the "Manual on Uniform Traffic Control Devices for Streets and Highways" published by the U.S. Department of Commerce, Bureau of Public Roads, June, 1961 (or latest revision).
- Flashers are portable, power-operated, lens-directed, enclosed lights, illuminated by rapid intermittent flashes of short duration. Flashers may be used in connection with barricades when approved by the Engineer. An array of random flashers which tends to obscure rather than delineate the traveled way will not be permitted. The use of flashers on a job will be governed by Sec. 5D of the "Manual on Uniform Traffic Control Devices for Streets and Highways" published by the U.S. Department of Commerce, Bureau of Public Roads, June, 1961 (or latest revision). The color of the light emitted by a flasher shall be yellow.
- Flashing Beacons and Flashers, when used, shall be positioned above the top rail of the barricades to produce the most effective results.
- Barricades used as "Traffic Controls for Highway Construction" are not to be paid for separately.
- Barricades will be paid for separately when designated on plans as bid items.
- For additional general information on control of traffic through work areas refer to the "Manual on Uniform Traffic Control Devices for Streets and Highway", Part V, published by the U.S. Department of Commerce, Bureau of Public Roads, June, 1961 (or latest revision).

BARRICADE DESIGNATIONS						
Class	Type		Roadway	L	Description	
	Movable	Fixed	Width			
I	I	M-1	F-1	26'-34'	28'	Barricade complete with SR13-1 sign and SWI-6 or SWI-7 signs as required
2	I	M-2	F-2	35'-44'	41'	Barricade complete with SR13-1 sign and SWI-6 or SWI-7 signs as required
D	I	M-3	F-3	Variable	28'	Barricade (without extension wings) complete with SR13-1 sign and SWI-6 or SWI-7 signs as required
	I	M-4	F-4	Variable	Variable 8'-6" min.	Wing Barricade(signs only as appropriate).
	II	-	F-6	Variable	28'	Barricade complete with appropriate signs

DEPARTMENT OF HIGHWAYS
STATE OF COLORADO
DIVISION OF HIGHWAYS



TIMBER
BARRICADES

Designed By D.R.W.
Made By J.S.
Checked By J.B.
Approved By [Signature]
Date JULY 1, 1965

STANDARD M-614-1C


JULY 5, 1968
(SHEET 1 OF 2 SHEETS)

FEDERAL ROAD DISTRICT	PROJ NO	SHEET NO	TOTAL SHEETS
9 COLORADO			
REVISIONS			
(R-1)	7-26-68	Rev Legend and Notes	GWF
(R-2)	5-20-69	Rev Lateral Placement	J. J. B.
(R-3)	9-25-70	Rev Legend	J. J. B.

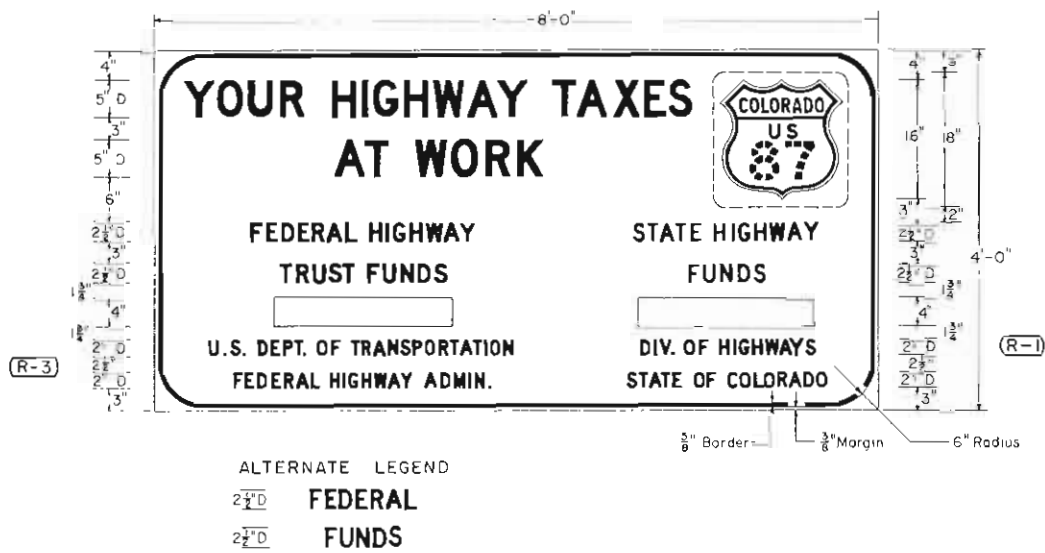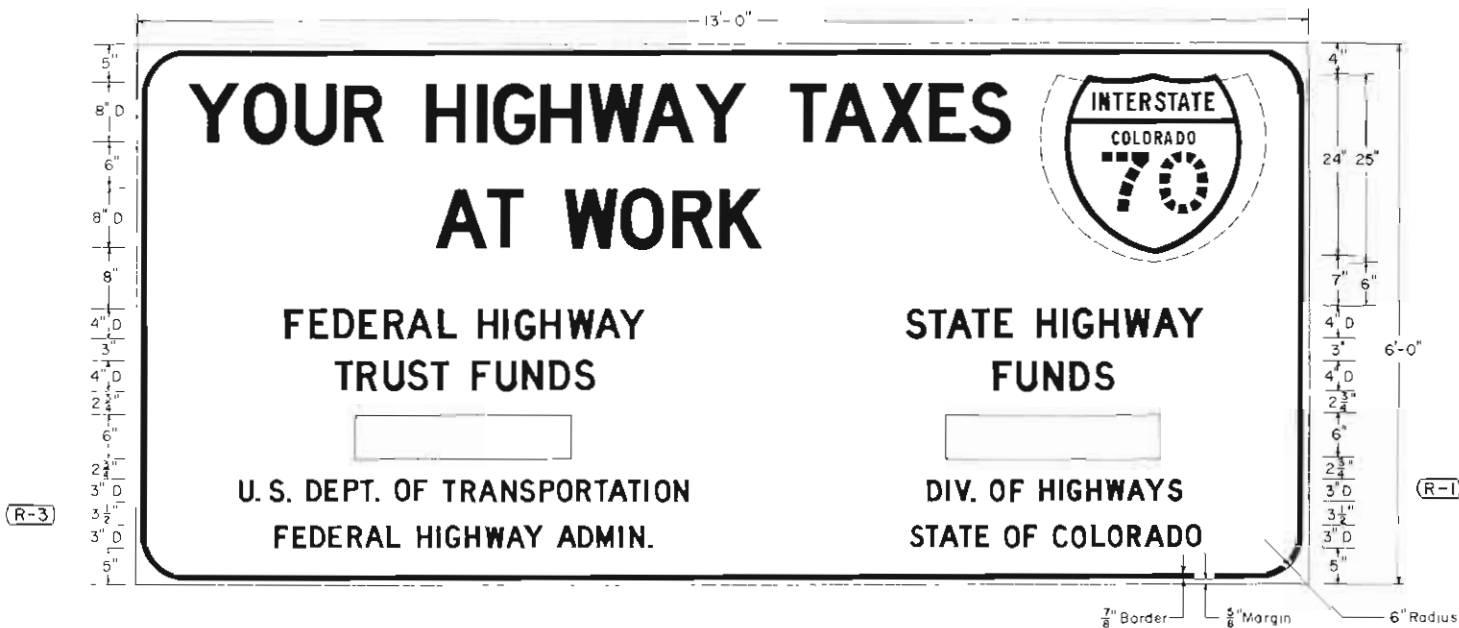


ALTERNATE LEGEND
4" FEDERAL
4" FUNDS

FABRICATION DETAILS

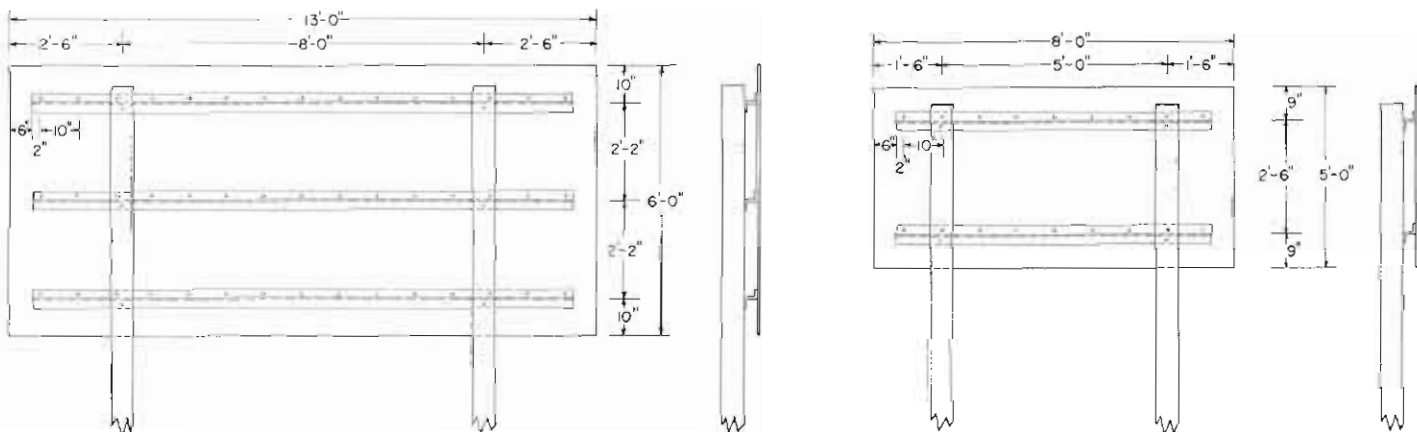


"AMOUNT OF FUNDS" PLAQUE DETAILS

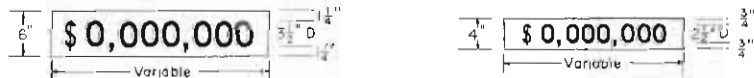

GENERAL NOTES

- These signs shall be furnished and installed by state forces.
- All work shall be done in accordance with Standard Specifications applicable to the Project.
- Signs are to be placed facing traffic approaching the Project. They shall be installed at a location where they will not obscure or detract from the effectiveness of other official signs.
- The lateral placement may be reduced to a minimum of 2 ft outside of the shoulder edge where necessary to fit field conditions.
- When these signs are used on Beautification Projects, the words "HIGHWAY" and "TRUST" in lines 3 and 4 shall be deleted and the words "FEDERAL" and "FUNDS" shall be used in accordance with the spacing as shown under "Alternate Legend".
- Sign panel shall be fabricated with 3/4" plywood.
- Route Marker plaques and "Amount of Funds" plaques shall be sheet aluminum 0.080" min thickness.
- Signs shall have a screen processed black legend and border on a plain white background. "Amount of Funds" plaques shall have a screen processed black legend on a plain white background.
- Route Marker plaques shall be plain as indicated on the applicable standards.
- Backing zeos shall be 3" x 2 3/4" x 1/4". Steel zeos shall weigh 6.7 lbs per ft and aluminum zeos shall be of 6061-T6 alloy weighing 2.33 lbs per ft.
- Posts shall be 6" x 6", S4S timber, pointed white.
- Each timber post shall be provided with two 2" diameter holes through the neutral axis, one at 6" and one at 18" above the ground level. The inside portion of each 2" diameter hole shall be painted white.
- Panels shall be fastened to backing zeos with 1/4" thrust head lockbolt fasteners.
- Backing zeos shall be fastened to posts with 3/8" machine bolts.
- Route Marker plaques and "Amount of Funds" plaques shall be fastened to the sign panels with 3/8" #9 round head wood screws.
- Exposed lockbolt fastener heads and wood screw heads on the face of the sign shall be dipped or painted to match the surrounding color.
- The underground portion of each timber post shall be treated with creosote.
- Where a third governmental agency is shown as participating, its official name should be included centrally in lines 6, 7, and 8.
- (R-1) It will not be necessary to change DEPT. to DIV. on any existing signs.

INSTALLATION DETAIL

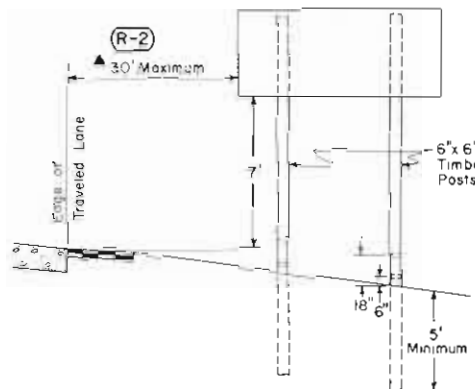

DEPARTMENT OF HIGHWAYS
STATE OF COLORADO
DIVISION OF HIGHWAYS
STANDARD
CONSTRUCTION
IDENTIFICATION
SIGNS


Designed By: J. J. B. Approved By: J. J. B.
Made By: J. J. B. Traffic Engineer
Checked By: J. J. B. Date: July 5, 1968

STANDARD M-614-IC

JULY 5, 1968
(SHEET 2 OF 2 SHEETS)

FILE NO.	DISTRICT	PROJECT NO.	SHEET NO.	TOTAL SHEETS
9	COLORADO			

REVISIONS			
(R-1)	7-26-68	Rev. Legend	G.W.F.
(R-2)	5-20-69	Rev. Lateral Placement	J.J.B.
(R-3)	9-25-70	Rev. Legend	J.J.B.

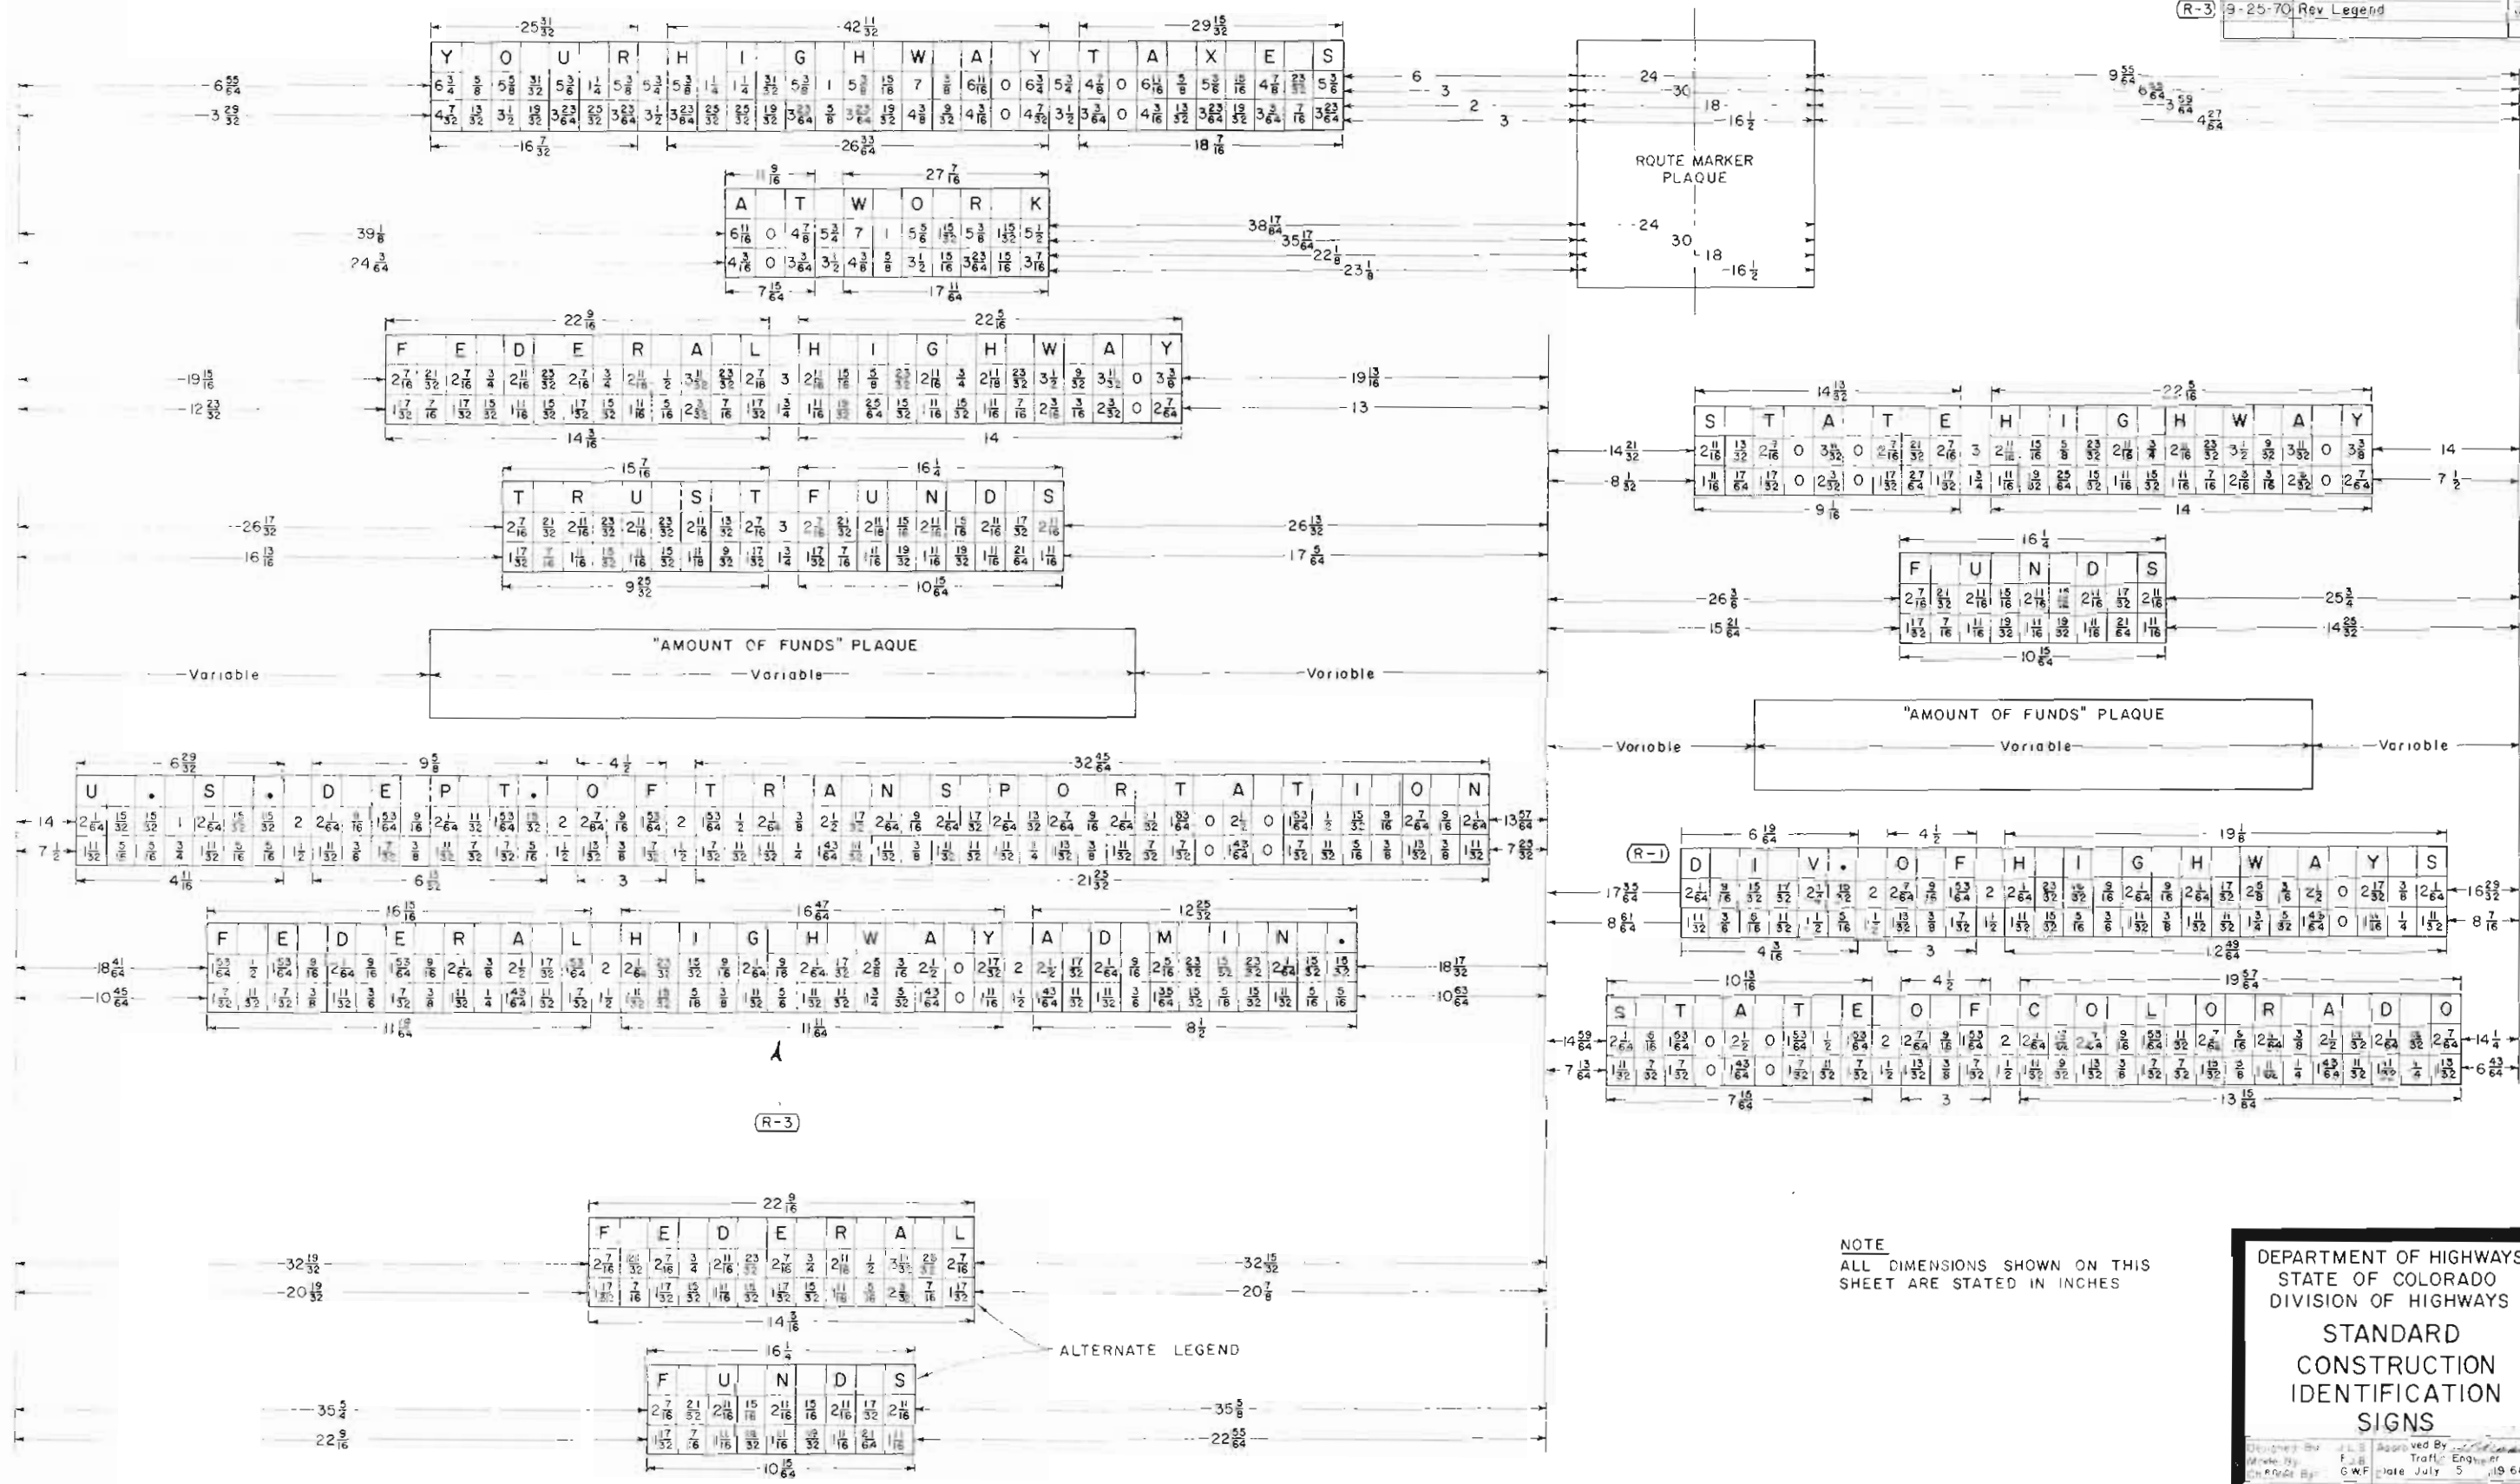

NOTE
ALL DIMENSIONS SHOWN ON THIS
SHEET ARE STATED IN INCHES

DEPARTMENT OF HIGHWAYS
STATE OF COLORADO
DIVISION OF HIGHWAYS
**STANDARD
CONSTRUCTION
IDENTIFICATION
SIGNS**
Designed By: J.L.S. Approved By: J.L.S.
Made By: F.B. Traffic Engineer
Checked By: G.W.F. Date: July 5, 1968

(AUGUST 22, 1968)

REVISIONS		

RAILROAD CROSSBUCK SIGN




- 1 All work shall be done in accordance with the Standard Specifications applicable to the Project.
- 2 All Crossbuck and Advance Warning Signs shall be fabricated and installed in accordance with details as shown on this sheet and in the following publications:
 - (a) "Uniform Traffic Control Devices for all Classes of Streets and Highways", Colorado Department of Highways, Planning and Research Division, 1968 (or latest revision).
 - (b) "Bulletin No 6, Railroad-Highway Grade Crossing Protection", Association of American Railroads, 1966 (or latest revision)
- 3 Details shown on this sheet take precedence over those shown in Bulletin No 6, AAR, referred to in 2 (b) above.
- 4 Postings of R.R. Warning Signs are required on both sides of each roadway on divided highways.
- 5 On sign installations where roadway grades are not level, it may be desirable to place signs out of plumb so as to keep the angle of view close to 90°.
- 6 All posts shall conform to Section 614 of the Standard Specifications.
- 7 Posts shall be painted white to conform to Section 508 of the Standard Specifications.
- 8 Length of Posts shall be determined by local conditions or from a cross-section of the roadway of the sign location
- 9 All reflective sheeting shall be wide angle Non-Exposed Lens Type
- 10 Panels made from alternate materials are acceptable if approved by the Engineer prior to their use on the Project
- 11 The exposed bolt heads on the face of the crossbuck sign shall be dipped or painted to match the surrounding color. Exposed countersunk lockbolt heads on the face of the advance warning sign shall be covered with a patch made from the same reflective sheeting material as the background and shall be the same diameter as the bolt head.
12. 6"x6" Timber posts shall be provided with two (2) 2" diameter holes drilled through the neutral axis. One shall be 6" and one shall 18" above the ground level. The inside portion of the drilled holes shall be painted.

STANDARD M-614-TB
(SHEET 1 OF 3 SHEETS)
(JULY 1, 1965)



FEDERAL ROAD REGION NO.	DIVISION	PROJECT NO.	SHEET NO.
9	COLORADO		
REVISIONS			
(R-1)	7-12-67	Note 23	G.W.F.
(R-2)	7-8-68	Rev. Break-away, Placement, Code Nos., & Dept. Name	G.W.F.
(R-3)	12-24-68	Rev U.S. Shields	J.L.S.

Typical Signing Where Traffic Is Prohibited Along Construction

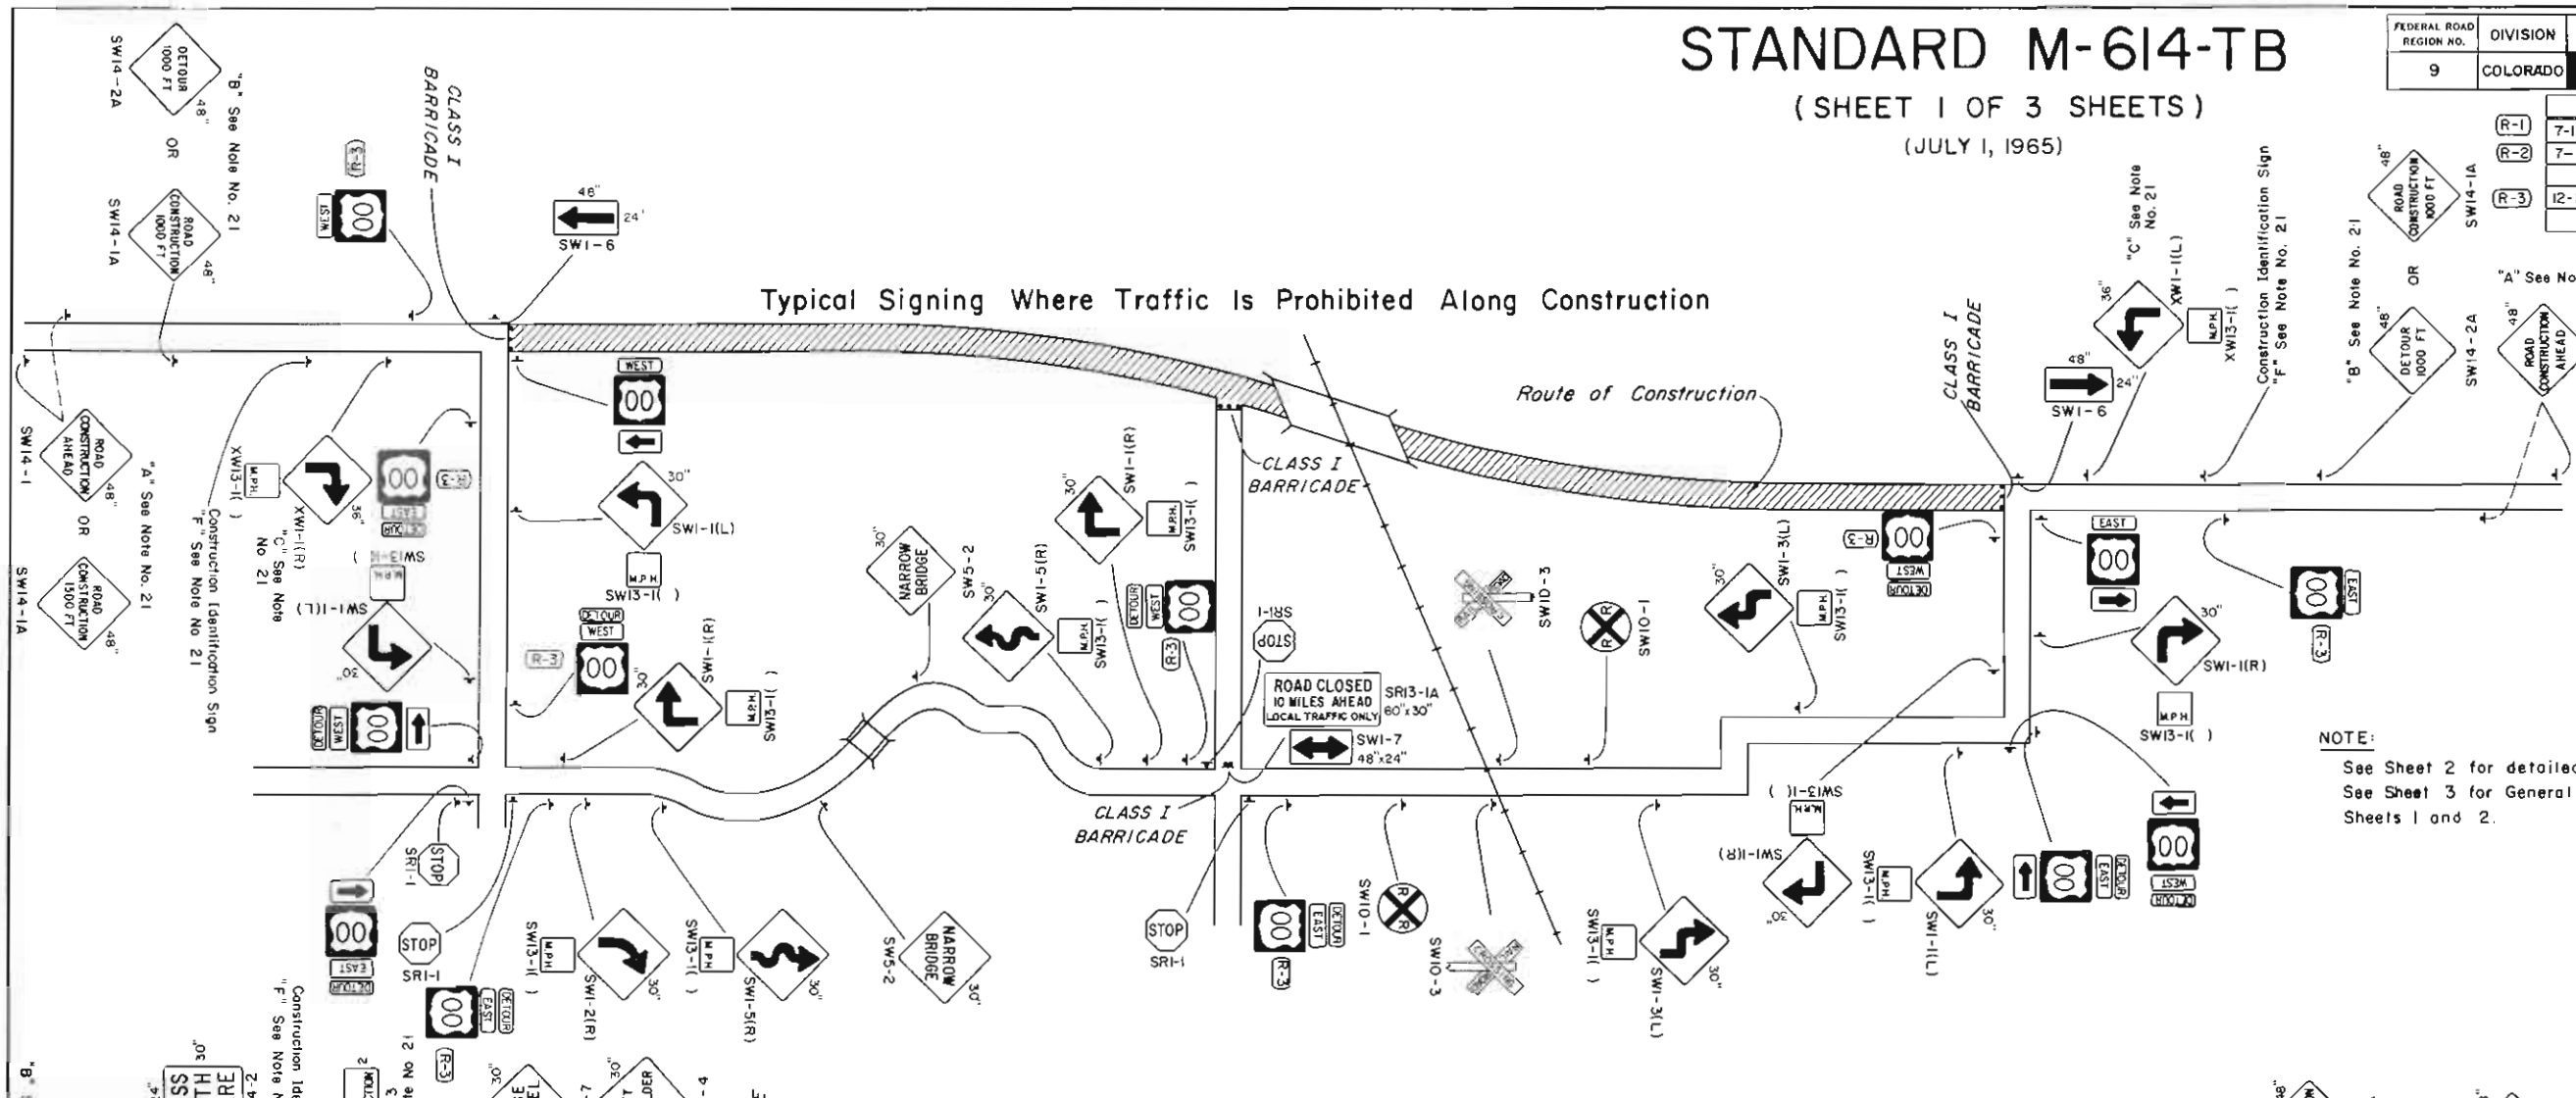

NOTE:
See Sheet 2 for detailed drawings of signs.
See Sheet 3 for General Notes applicable to Sheets 1 and 2.

Typical Signing Where Traffic Is Permitted Along Construction

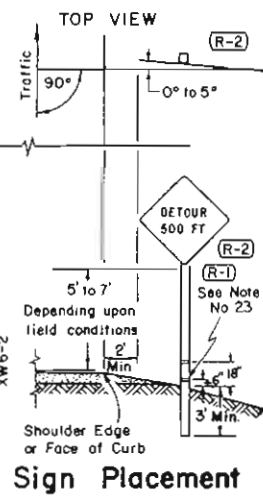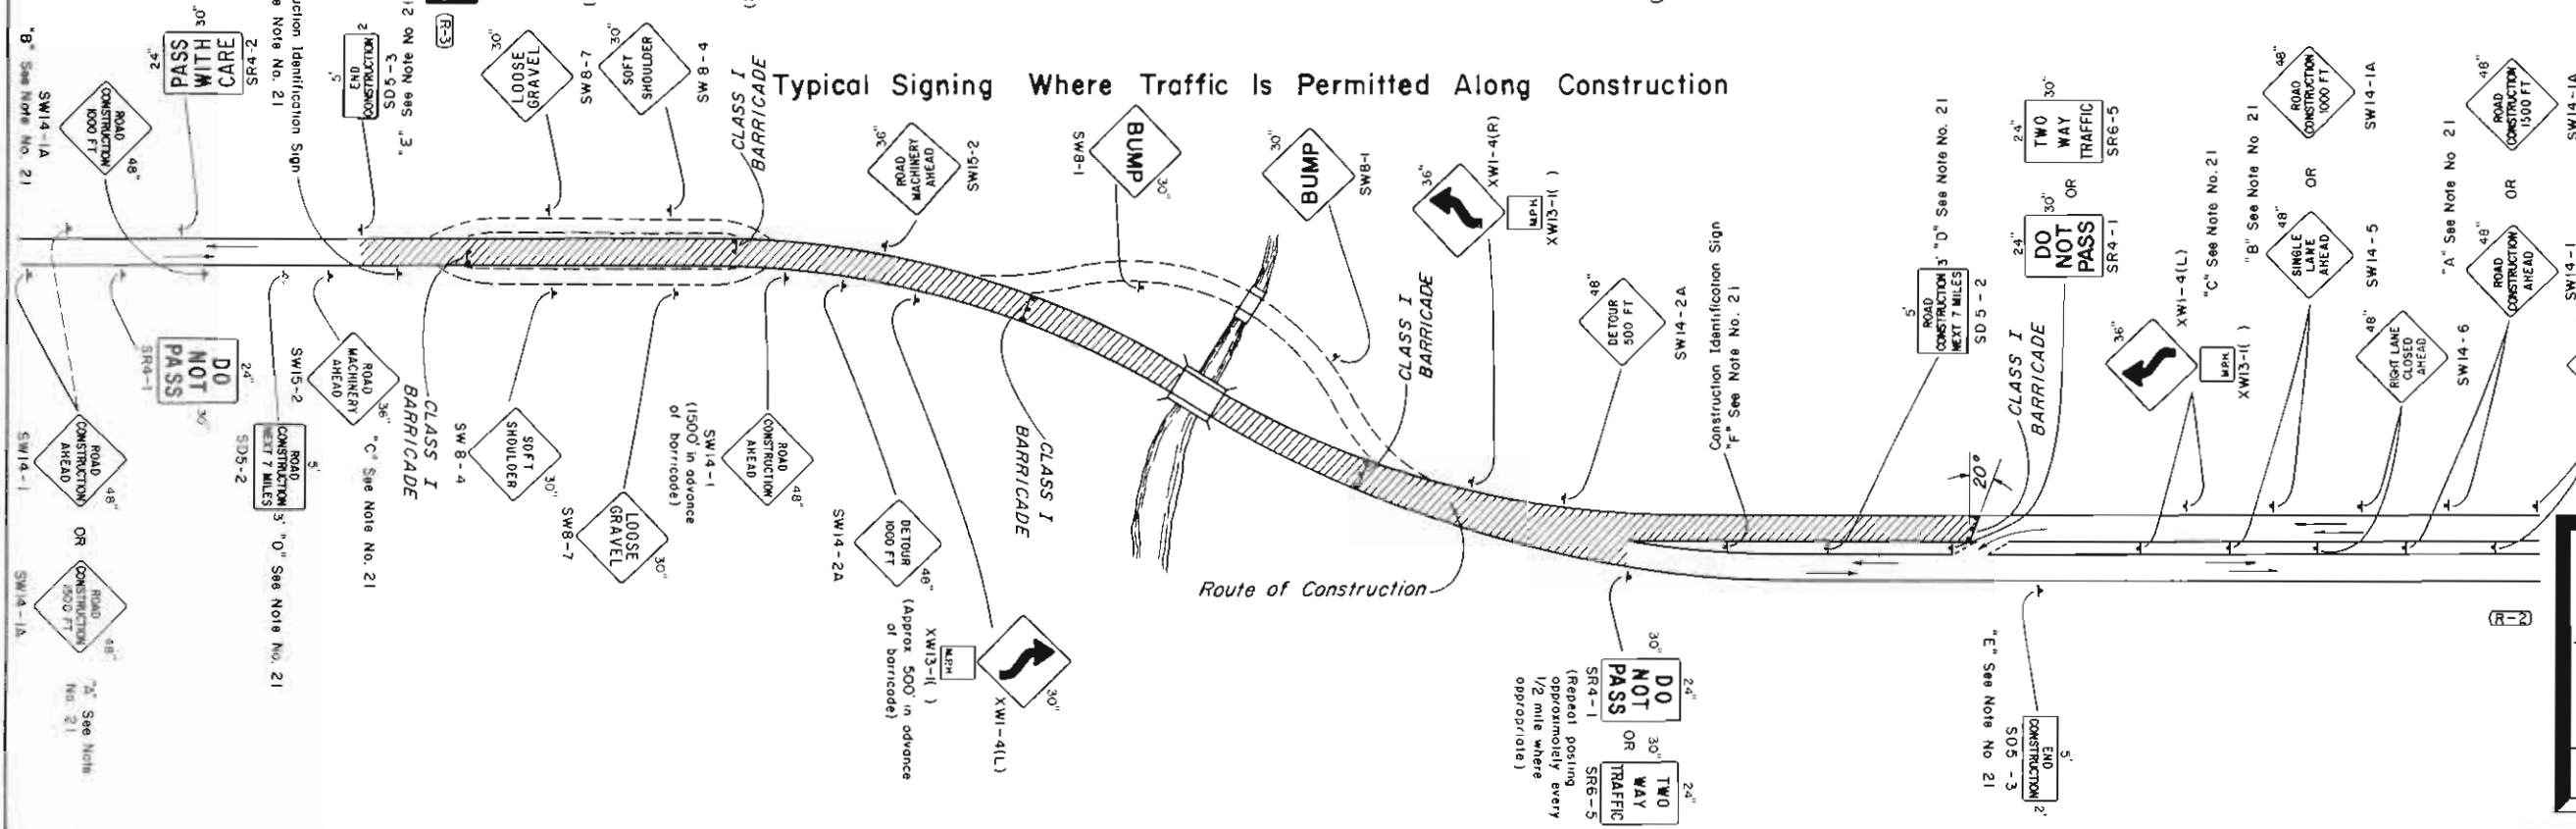

DEPARTMENT OF HIGHWAYS
STATE OF COLORADO
DIVISION OF HIGHWAYS
TRAFFIC SIGNING
FOR HIGHWAY
CONSTRUCTION

Designed By D.R.W.
Made By J.L.S.
Checked By J.B.

Approved By [Signature]
Traffic Engineer
Date AUGUST 9, 1965


STANDARD M-614-TB

(SHEET 2 OF 3 SHEETS)


(JULY 1, 1965)

REGULATORY SIGNS

See Note No. 9

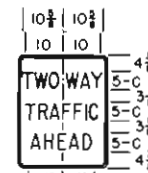


24"x30"
SR6-3
Margin: 3/8"
Border: 5/16"
Corner Radius: 1 1/4"

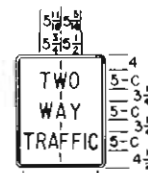

24"x30"
SR6-5
Margin: 3/8"
Border: 5/16"
Corner Radius: 1 1/4"




48"x30"
SR13-1
Margin: 1/2"
Border: 3/8"
Corner Radius: 1 1/4"

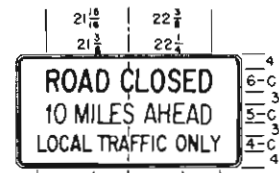


60"x30"
SR13-1A
Margin: 1/2"
Border: 3/8"
Corner Radius: 1 1/4"

WARNING SIGNS

See Note No. 10

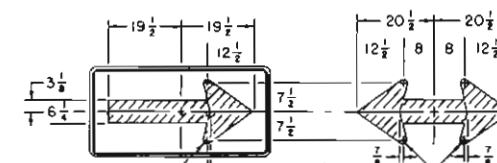

48"x24"
SW1-6
Margin: 1/2"
Border: 3/8"
Corner Radius: 1 1/4"

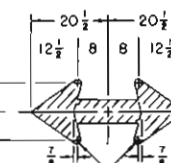

48"x24"
SW1-7
Margin: 1/2"
Border: 3/8"
Corner Radius: 1 1/4"




Margin: 1/2"
Border: 3/8"
Corner Radius: 1 1/4"


Panel	A	B	C	D	E	F	G	H	I	J
SW13-1	18"x18"	3/8"	5/16"	5/16"	5/16"	5/16"	5/16"	5/16"	5/16"	5/16"
XW13-1	24"x24"	3/8"	5/16"	5/16"	5/16"	5/16"	5/16"	5/16"	5/16"	5/16"

WARNING SIGNS


See Note No. 10

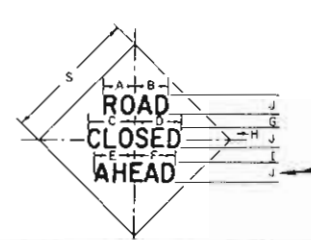


S	A	B	C	D	E	F	G	H	I	J
SW14-3	48	11 1/2	12 1/2	16 1/2	16 1/2	14 1/2	4 1/2	4 1/2	5 1/2	7-D
CW14-3	36	8 1/2	11 1/2	11 1/2	10 1/2	10 1/2	3 1/2	3 1/2	3 1/2	5-D

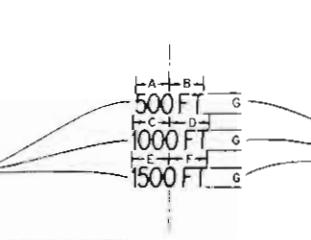


S	A	B	C	D	E	F	G
SW14-3A	48	12	12 1/2	13 1/2	14 1/2	13 1/2	7-C
CW14-3A	36	8 1/2	9 1/2	10 1/2	9 1/2	9 1/2	5-C
CW14-4A							

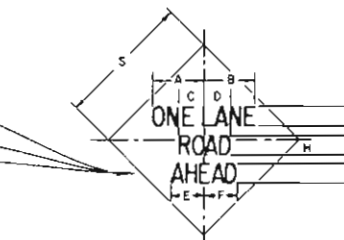


S	A	B	C	D	E	F	G	H	I	J
SW14-4	48	18 1/2	17 1/2	9 1/2	9 1/2	11 1/2	3 1/2	5 1/2	3 1/2	7-C
CW14-4	36	13 1/2	12 1/2	6 1/2	6 1/2	8 1/2	2 1/2	3 1/2	2 1/2	5-C

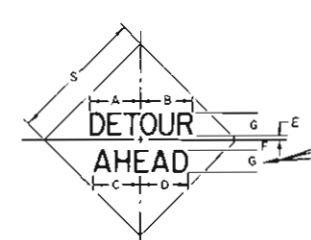


S	A	B	C	D	E	F	G
SW14-2	48	18 1/2	18 1/2	16 1/2	16 1/2	14 1/2	3 1/2
CW14-2	36	13 1/2	13 1/2	12 1/2	12 1/2	10 1/2	2 1/2

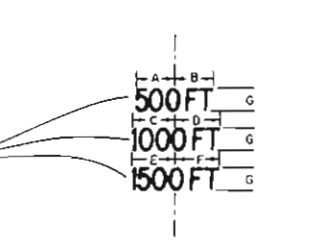


S	A	B	C	D	E	F	G
SW14-2A	48	13 1/2	13 1/2	15 1/2	15 1/2	15 1/2	8-C
CW14-2A	36	10 1/2	10 1/2	11 1/2	11 1/2	11 1/2	6-C

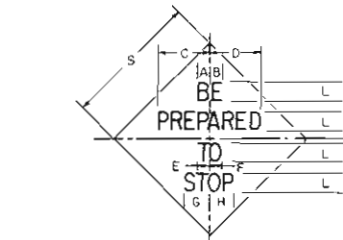


S	A	B	C	D	E	F	G	H	I	J	K	L
SW14-7B	36	2 1/2	3 1/2	3 1/2	3 1/2	3 1/2	2 1/2	6 1/2	6 1/2	3	2	1
CW14-7B	36	2 1/2	3 1/2	3 1/2	3 1/2	3 1/2	2 1/2	6 1/2	6 1/2	3	2	1

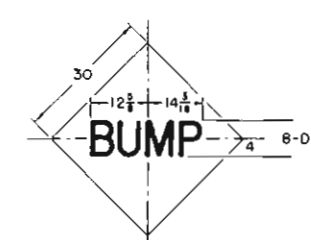


SW8-1

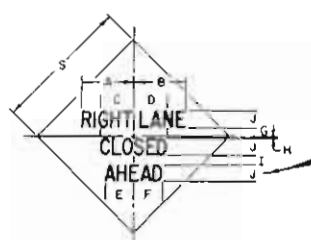


S	A	B	C	D	E	F	G	H	I	J
SW14-6(R)	48	18 1/2	18 1/2	11 1/2	11 1/2	10 1/2	2 1/2	3 1/2	3 1/2	6-C
CW14-6(R)	36	15 1/2	15 1/2	9 1/2	9 1/2	8 1/2	2 1/2	3 1/2	3 1/2	5-C

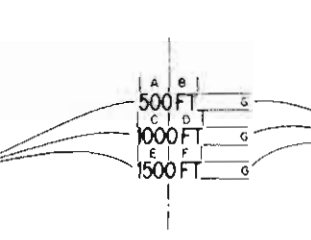


S	A	B	C	D	E	F	G
SW14-6A(R)	48	18 1/2	18 1/2	11 1/2	11 1/2	11 1/2	6-C
CW14-6A(R)	36	15 1/2	15 1/2	9 1/2	9 1/2	9 1/2	5-C
CW14-6A(L)							

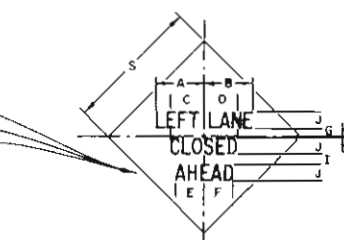


S	A	B	C	D	E	F	G	H	I	J
SW14-6(L)	48	17 1/2	17 1/2	11 1/2	11 1/2	10 1/2	2 1/2	3 1/2	3 1/2	6-C
CW14-6(L)	36	14 1/2	14 1/2	9 1/2	9 1/2	8 1/2	2 1/2	3 1/2	3 1/2	5-C

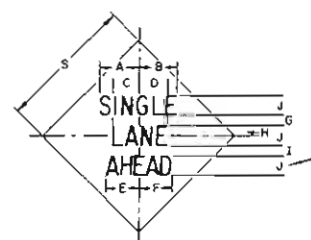


S	A	B	C	D	E	F	G	H	I	J
SW14-5	48	13 1/2	13 1/2	9 1/2	9 1/2	11 1/2	3 1/2	3 1/2	3 1/2	7-C
CW14-5	36	11 1/2	11 1/2	8 1/2	8 1/2	10 1/2	2 1/2	2 1/2	2 1/2	5-D

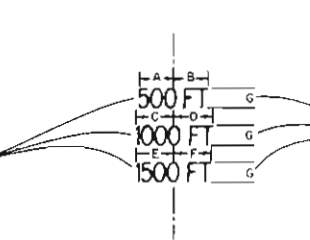


S	A	B	C	D	E	F	G
SW14-1A	48	12 1/2	12 1/2	13 1/2	13 1/2	13 1/2	7-C
CW14-1A	36	9 1/2	9 1/2	10 1/2	10 1/2	10 1/2	5-C
CW14-5A							

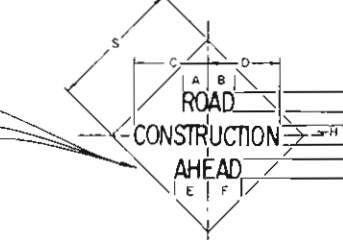


S	A	B	C	D	E	F	G	H	I	J
SW14-1	48	9 1/2	9 1/2	26 1/2	25 1/2	11 1/2	14 1/2	3 1/2	4 1/2	7-C
CW14-1	36	6 1/2	6 1/2	19 1/2	18 1/2	8 1/2	3 1/2	2 1/2	3 1/2	5-C

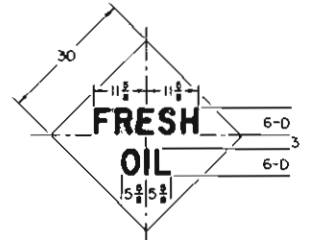


SW8-6

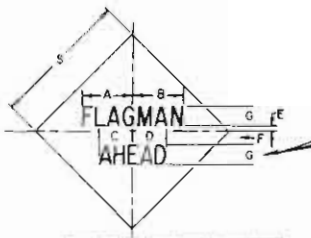


S	A	B	C	D	E	F	G
SW14-7	48	18 1/2	18 1/2	11 1/2	11 1/2	1 1/2	4 1/2
CW14-7	36	15 1/2	15 1/2	10 1/2	10 1/2	1 1/2	4 1/2

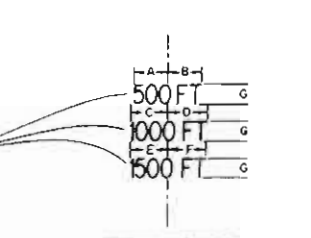


S	A	B	C	D	E	F	G
SW14-7A	48	12 1/2	12 1/2	13 1/2	13 1/2	13 1/2	7-C
CW14-7A	36	10 1/2	10 1/2	11 1/2	11 1/2	11 1/2	6-C

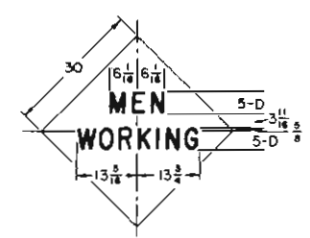

SW15-1

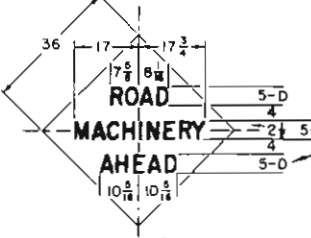


SW15-2

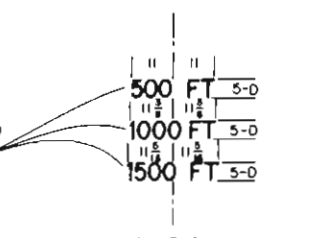


SW15-2A

PLATE DETAILS

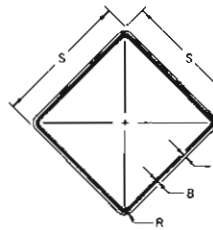

S	M	B	R
30	1 1/2	3/4	1 1/4
36	1 1/2	1 1/4	2 1/4
48	2 1/2	1 1/4	3

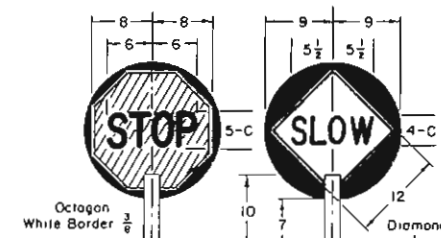

FLAGMAN SIGN
See Notes No. 20 and 22

NOTES:

SEE SHEET 1 FOR TYPICAL SIGNING AND SIGN PLACEMENT.
SEE SHEET 3 FOR GENERAL NOTES APPLICABLE TO SHEETS 1 AND 2.


ALL DIMENSIONS THAT ARE NOT LABELED ARE IN INCHES.

GUIDE SIGNS


See Note No. 11




Margin: 3/8"
Border: 5/16"
Corner Radius: 1 1/4"

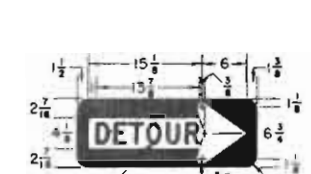


3-D Copy
24"x9"
SM5-7(R)
SM5-7(L)

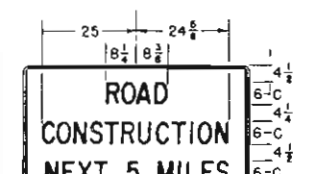


Margin: 1/2"
Border: 3/8"
Corner Radius: 1 1/4"

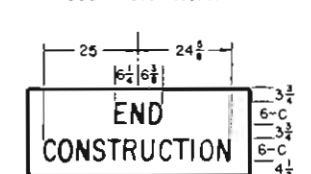


Margin: 3/8"
Border: 5/16"
Corner Radius: 1 1/4"

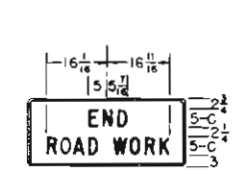

Margin: 3/8"
Border: 5/16"
Corner Radius: 1 1/4"

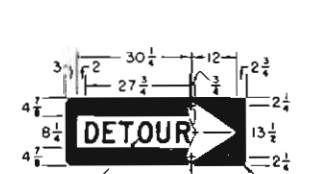

(R-3) Reverse Dimensions for Left Designation

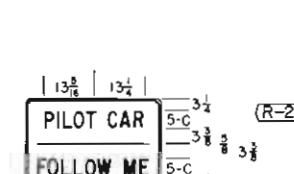

Margin: 3/8"
Border: 5/16"
Corner Radius: 1 1/4"

DEPARTMENT OF HIGHWAYS
STATE OF COLORADO
DIVISION OF HIGHWAYS
TRAFFIC SIGNING
FOR HIGHWAY
CONSTRUCTION

Designed By: D.R.W.
Made By: H.B.D.
Checked By: J.B.

Approved By: *[Signature]*
Traffic Engineer
Date: AUGUST 9, 1965

STANDARD M-614-TB

(SHEET 3 OF 3 SHEETS)

(JULY 1, 1965)

FEDERAL ROAD REGION NO.	DIVISION	PROJECT NO.	SHEET NO.
9	COLORADO		3

REVISIONS			
(R-1)	7-12-67	Adds Note 23	G.W.F.
(R-2)	7-5-68	Rev. Note 23 & Dept. Name -	G.W.F.
		Deleted Note	G.W.F.
(R-3)	10-24-68	Rev. Note No 18	J.L.S.

GENERAL NOTES

- All work shall be done in accordance with: (a) the Standard Specifications applicable to the Project, and (b) the "Manual on Uniform Traffic Control Devices for all Classes of Streets and Highways" published by the Department of Highways.
- Where traffic is maintained through or over any part of the Project the Contractor will be required to mark all hazards within the limits of the Project (including connecting roads) with well-maintained Barricades, Warning, and Guide Signs. All Barricades and Signs shall be moved, added to, changed or removed as required during the progress of construction and removed entirely when the Project is completed.
- Where traffic is prohibited from the Project the Detour will be marked by the Department except that the Contractor shall provide, erect and maintain Barricades, complete, (when required) at the ends of the Project, ends of the Detour and connecting roads. All U.S. or State Route Markers required for the Project will be furnished and installed by the Department. The location and positioning of Warning Signs, Barricades, and Regulatory Signs shall be as recommended by the appropriate District Engineering Forces of the Department.
- Work on the Project shall not be started until all required signs are in place and approved by the Engineer. Where speed control appears necessary such speed control shall be requested from the Engineer by the Contractor. Control of speed through a construction zone may be achieved by Advisory Speed plates in conjunction with Warning Signs (SW13-1 for use with 30" Warning Signs and XW13-1 for use with 36" and 48" Warning Signs). The Advisory Speed plate is to be posted only at those locations where the safe speed is lower than the imposed Regulatory speed limit.
- All Signs and Barricades shall be placed for best visibility and legibility, maintained in good condition and kept clean and free of dirt at all times. Contractor's and Engineer's vehicles and equipment must be parked so that signs and barricades are visible to approaching traffic at all times.
- Where two identical signs are used for dual posting they are to be staggered on the two sides of the roadway for a minimum distance of 75' to avoid a tunneling effect.
- Examples for marking Projects, as shown on Sheet 1, are typical of signs required and are subject to alteration to fit actual conditions encountered in the field. Locations for control devices are to be staked by the Engineer. In all cases Warning signs are to be placed well in advance of the hazard, the distance depending on topography and existing approach speeds. Additional markings and any special signs required for the guidance and protection of traffic will be placed as required on the Project at the Contractor's expense.
- Desirable sizes for signs are shown on Sheet 1 of this Standard. Larger or smaller signs shall be used where warranted. Detailed dimensions for signs normally used in connection with construction are shown on Sheet 2 of this Standard. For information on standard roadway signs not detailed on this Standard see the "Manual on Uniform Traffic Control Devices for all Classes of Streets and Highways" published by the Department of Highways.
- Signs with the prefix "R" in the sign code are Regulatory signs and as such impose legal compulsions or restrictions on drivers and should only be used as authorized by the Engineer.
- Signs with the prefix "W" in the sign code are Warning signs and are used to alert traffic to existing or potentially hazardous conditions.
- Signs with the prefix "D" or "M" in the sign code are Guide signs. Those with the prefix "D" convey general information and those with the prefix "M" are used for marking the traffic route.
- All signs shall be reflectorized unless otherwise specified on plans. Regulatory and Guide signs (unless otherwise specified) shall have a screen processed black legend and border on a white flexible reflective sheeting, non-exposed lens background. The back side of Regulatory and Guide signs shall be painted with two coats of "Exterior Sign White Paint." Warning signs shall have a screen processed black legend and border on a highway yellow flexible reflective sheeting, non-exposed lens background. The back side of Warning signs shall be painted with two coats of "Federal Yellow Synthetic Sign Enamel."
- Painting for wood surfaces shall conform with Section 508 of the Standard Specifications.
- Posts for regulatory, warning, and guide signs will normally be 4"x4" or 6"x6" and shall conform to the Standard Specifications for Untreated Timber-S4S. Timber shall conform to Construction grade Paragraph 123B or 125B of Standard No. 15 Grading & Dressing Rules for West Coast Douglas Fir (1956) or Dense Structural 5B and LL Structural 5B Paragraph 2B4 or 2B5 of 1956 Grading Rules for Southern Pine. Posts shall be painted with one coat of "White Wood Primer" and one coat of "Outside White Paint."
- Sign panels furnished by the Contractor for use only during construction may be fabricated from plywood, aluminum, steel or other suitable material but shall be stable and durable enough to meet other requirements of this Standard.
- All material shall be sound and durable. Barricades, signs, symbols, and lettering shall be of good workmanship. Uneven lettering will not be accepted.
- Alternate methods of processing signs or the substitution of symbols or other reflecting elements for painted symbols will be permitted only after approval by the Department.
- Lanterns and Torches - Lanterns, with red globes, shall be used only in low speed urban areas. Open-flame torches shall not be used under any circumstances.
- Barricades, Flashing Beacons and Flashers - Refer to appropriate "M" Standard (Timber Barricades) for details.
- Flagman Sign - This sign shall have a black painted background on both sides to form a contrast for the octagonal Stop sign and the diamond Warning sign. The "STOP" sign shall be fabricated by reverse screen process using transparent red paint on smooth surface silver reflective sheeting. The "SLOW" side of the Flagman Sign shall be black process point on smooth surface yellow reflective sheeting. Handle to be grooved on one side to indicate reading of sign to Flagman.
- Sign "A" - This is the first advance warning sign and shall be placed 1,500 feet ahead of Barricade or project terminal. Postings are required on both sides of the roadway on divided highways. Dual posting is required where warranted on two-lane, two-way highways.
Sign "B" - This is the second advance warning sign and shall be placed 1,000 feet ahead of barricade or project terminal. Postings are required on both sides of the roadway on divided highways and singly on two-lane, two-way highways.
Sign "C" - This is the third advance warning sign in cases where barricades are used and shall be placed 500 to 750 feet ahead of barricade or potentially hazardous condition. Postings are required on both sides of the roadway on divided highways and singly on two-lane, two-way highways.
Sign "D" - SD5-2 - This sign shall be placed to mark the beginning of a Project of more than 2 miles in extent, where traffic is maintained through the project. It shall be placed singly and near the beginning of construction.
Sign "E" - SD5-3 - This sign shall be placed to mark the end of the Project. It shall be placed singly and may be placed opposite barricade if desirable.
Sign "F" - Construction identification signs shall be furnished and installed by the Department on all Federal-Aid and Forest Highway Projects where actual construction is in progress and visible to highway users. These signs should be located so as not to obscure or detract from the effectiveness of other official signs. Where two or more projects are contiguous the appropriate data may be included in one set of signs. Refer to appropriate "M" Standard (Identification Signs) for sign details.
Signs A through F shall be furnished, installed and maintained by the Department.
- When Flags are used in lieu of the Flagman Sign, they shall be a minimum of 18"x18", made of a good grade of bright red material, and fastened securely to a staff of approximately 3 foot length. The free edge should be weighted to insure that the flag will hang vertically, even in heavy winds.
- Each 6"x6" timber sign post shall be provided with two 2" diameter holes through the neutral axis normal to the roadway, one hole at 6" and one hole at 18" above the ground level. The 4"x4" timber posts shall not be provided with any type of break-away device. The inside portion of each 2" diameter hole shall be painted white. The underground portion of each timber post shall be treated with creosote.

DEPARTMENT OF HIGHWAYS
STATE OF COLORADO
DIVISION OF HIGHWAYS
TRAFFIC SIGNING
FOR HIGHWAY
CONSTRUCTION

Designed By D.R.W.
Made By J.L.S.
Checked By J.B.

Approved By *[Signature]*
Traffic Engineer
Date AUGUST 9, 1965