

STATE DEPARTMENT OF HIGHWAYS DIVISION OF HIGHWAYS—STATE OF COLORADO

FEDERAL ROAD REGION NO.	DIVISION	PROJECT NO.	SHEET NO.
VIII	COLORADO	ER 80 (1)	1

AS CONSTRUCTED
REVISED DATE
MAY 2, 1974

See Standard M-100-A for Standard Symbols

PLAN AND PROFILE OF ~~PROPOSED~~ FEDERAL AID PROJECT NO. ER 80 (1) STATE HIGHWAY NO. 34 & 6 WELD & MORGAN COUNTIES

SCALES OF ORIGINAL DRAWINGS
ON PLAN, 1 IN. = 100 FT.
ON PROFILE { 1 IN. = 100 FT. HORIZONTAL
1 IN. = 10 FT. VERTICAL
GROUND LINE ON PROFILE IS SHOWN AS GRADE OF FINISHED ROAD
NO CENTERLINE LENGTH INVOLVED



SHEET NO

INDEX OF SHEETS

- 1 TITLE PAGE AND SKETCH MAP
 - 2 SUMMARY OF APPROXIMATE QUANTITIES
 - 3 STRUCTURE QUANTITIES, SUMMARY OF EARTHWORK AND GENERAL NOTES
 - 4 CULVERT WINGWALLS
 - 5-6 EXCAVATION AND BACKFILL FOR STRUCTURES (SPECIAL FOR THIS PROJECT ONLY)
 - 7 PLAN AND PROFILE
 - 8 STRUCTURE CROSS SECTION
 - 9 ROADWAY CROSS SECTIONS
- "M" STANDARDS**
- M-100-A STANDARD SYMBOLS (5-11-73)
 - M-601-A SINGLE AND DOUBLE CONCRETE BOX CULVERTS (5-10-71)
 - M-607-A WIRE FENCES AND GATES (2 SHEETS) (8-19-71)
 - M-614-TB TRAFFIC SIGNING FOR HIGHWAY CONSTRUCTION (3 SHEETS) (11-22-71)
- "S" STANDARDS**
- S-614-52A BARRICADES AND VERTICAL PANEL CHANNELIZING DEVICES (6-26-73)

100-3031-123456789101112131415
D.O.H.
DIST. 4
AUG 1974

LOCATIONS OF PROJECT ER 80 (1)

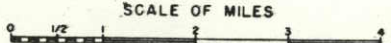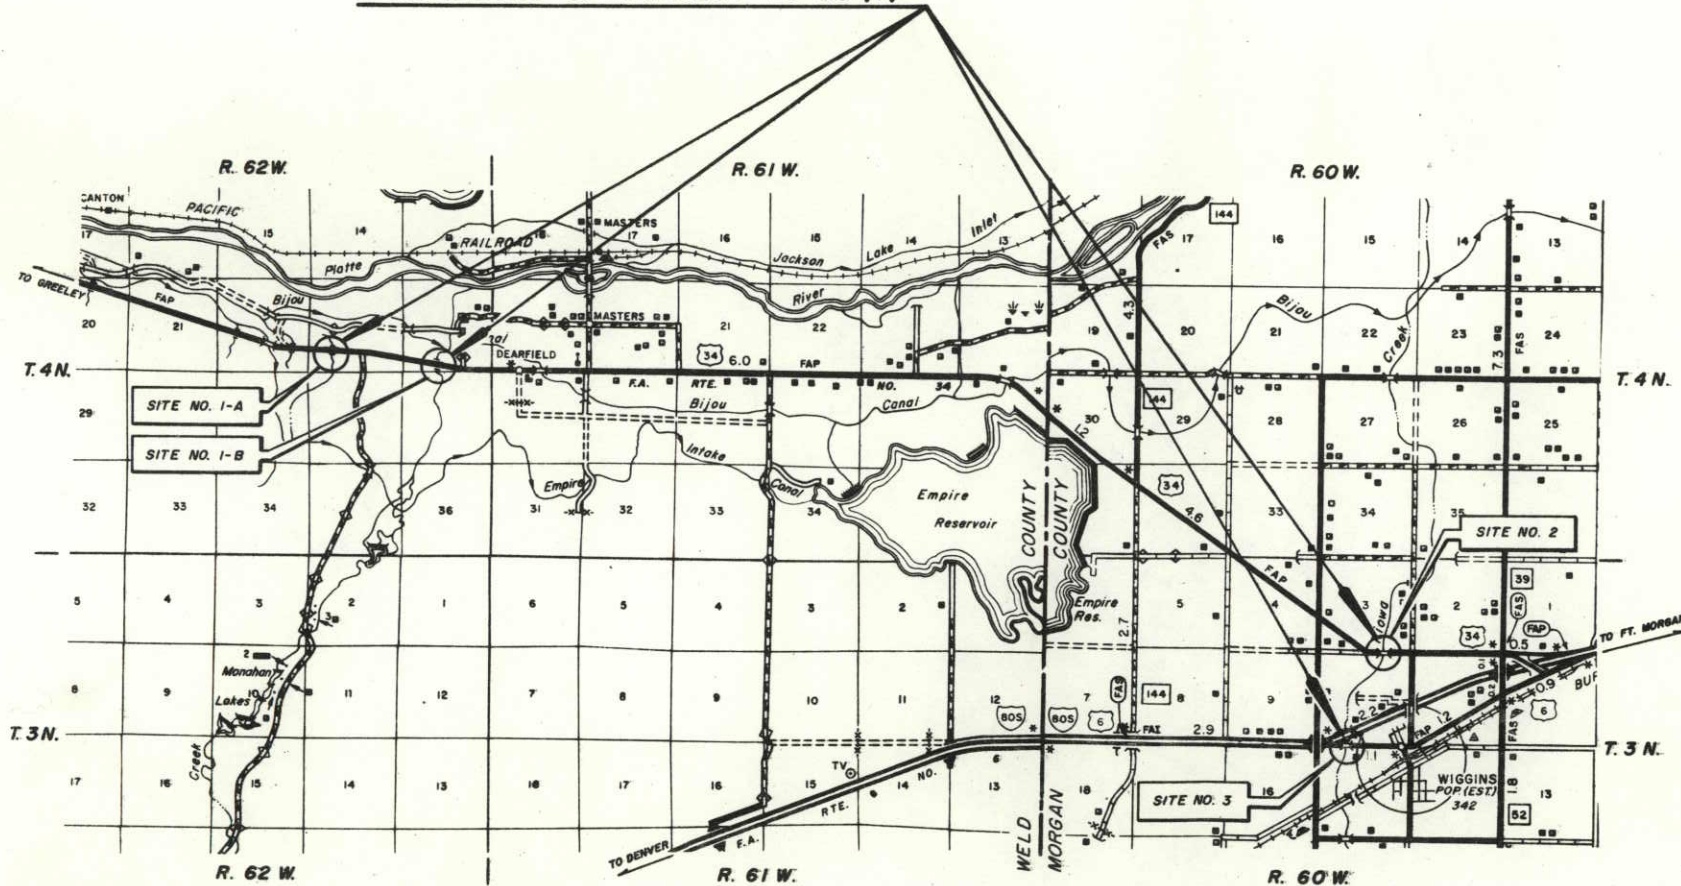

AS CONSTRUCTED PLANS
RETURN TO DIST. 4 DESIGN

DIVISION OF HIGHWAYS

APPROVED
E. N. Hane 11/8/73
CHIEF ENGINEER DATE

AS CONSTRUCTED INFORMATION

CONTRACTOR LARRY T. SMITH, INC.

RESIDENT ENGINEER M. H. GRICE
(Project or Resident)

PROJECT STARTED DECEMBER 20, 1973

PROJECT COMPLETED MAY 2, 1974

AS CONSTRUCTED PLANS
APPROVED J. C. Johnson by K. J. M...
DIST. CONST. ENG. 6-26-74
TITLE DATE

DEPARTMENT OF TRANSPORTATION
FEDERAL HIGHWAY ADMINISTRATION

APPROVED: _____ DATE _____

DIVISION ENGINEER

AS CONSTRUCTED
REVISED DATE MAY 2, 1974

FEDERAL ROAD REGION NO.	DIVISION	PROJ. NO.	SHEET NO.	TOTAL SHEETS
9	COLORADO	ER 80 (1)	3	9

GENERAL NOTES

- Depth of Moisture-Density control for the project shall be as follows:
Full depth of all embankments.
- Class "A" Concrete will be permitted on this project in lieu of Class "A". (Class "A" was used.)
- It is estimated that 50 Hours of Flagging for Controlling traffic will be required for this project. (10 hrs. was used.)
- Modified Compaction AASHTO T 180 will be required for this Project.

STRUCTURE QUANTITIES

INDEX		LOCATION	UNCLASSIFIED EXCAVATION		STRUCTURE EXCAVATION		STRUCTURE BACKFILL CLASS 2		H. B. P. GRADING E		CONCRETE CLASS A (BOX CULVERT)		REINFORCING STEEL POUNDS	"H" OVER CULVERT FEET	MISCELLANEOUS
BOOK	PAGE SHEET		CUBIC YARDS		CUBIC YARDS		CUBIC YARDS		TONS		CUBIC YARDS				
			PLAN	FINAL	PLAN	FINAL	PLAN	FINAL	PLAN	FINAL	PLAN	FINAL			
		1269+ To 1276+													1-Maintenance of Detour
		1270+ To 1276+													{ 650 Lin. Ft. - Remove 1035 Fence • 770 Lin. Ft. - Build 1188 Barbed Wire Fence 575 Lin. Ft. - Reset 1185 Fence }
		1273+00	120	128	351	360	120	120	25	35.10	102.3	102.3	7370	7400	/
TOTALS			120	128	351	360	120	120	25	35.10	102.3	102.3	7370	7400	

- It is estimated that 4 Corner and Line Brace Posts and 4 End Posts ^{was} will be required.
Two Barbed Wire Gates ^{was} will be required.

SUMMARY OF EARTHWORK

FINAL	PLAN
429	400 Cu. Yds. Embankment (H. & Comp.) - Widen Slopes on Roadway
128	120 Cu. Yds. Unclassified Excavation from Ramps
360	360 Cu. Yds. Structure Excavation
120	120 Cu. Yds. Structure Back fill

NOTE:
The 400 Cu Yds. of Embankment needed to widen Roadway Slopes ^{was} ~~may be~~ partially obtained from the Structure Excavation quantity and the remaining portion ~~may~~ was ~~be~~ obtained adjacent to the project.

S DATE
MAY 2, 1974

REVISIONS

Fill slope

5'-0" Max. for 1½:1 fill slopes,
unlimited for slopes flatter
than 1½:1.

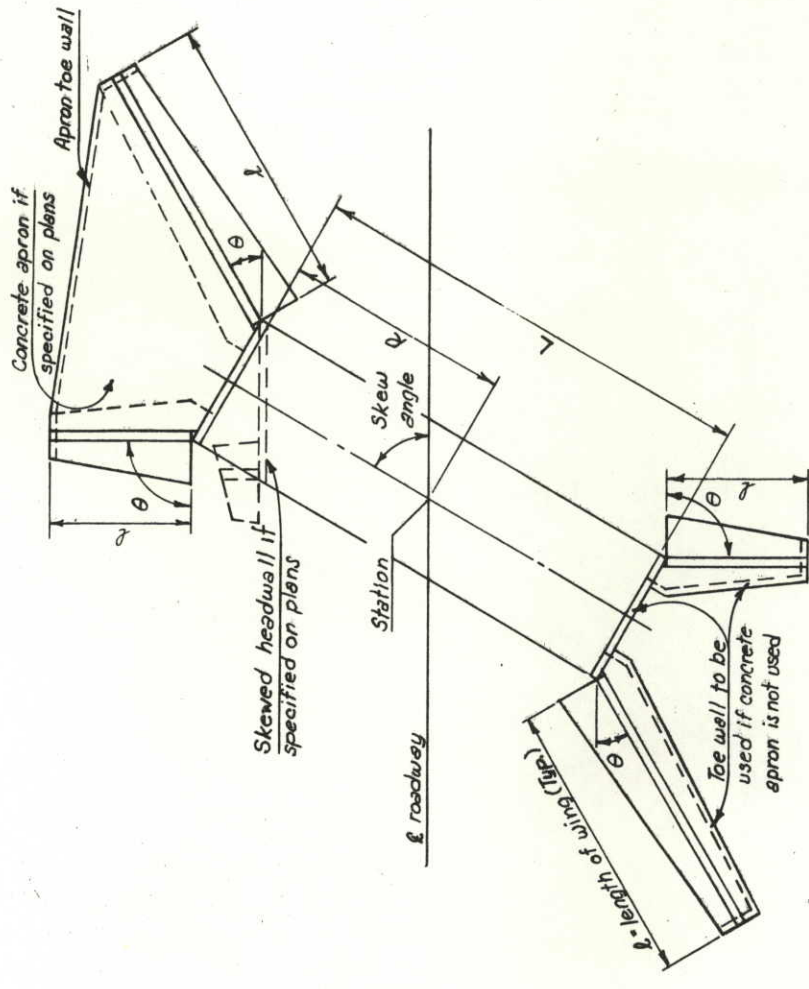


Diagram illustrating the cross-section of a gravity dam. The dam is shown with a vertical upstream face and a sloped downstream face. The water level is indicated by a horizontal line at the top of the dam. The dimensions of the dam are given as follows:

- Top of wall: $k = 4'0"$
- Water level: $h = 4'0"$
- Water level: $h = 5'$
- Water level: $h = 6'$
- Water level: $h = 7'$
- Water level: $h = 8'$
- Water level: $h = 9'$

The dimensions of the dam sections are given as follows:

- Section 1: $4'6"$ Max.
- Section 2: $5'6"$ Max.
- Section 3: $6'6"$ Max.
- Section 4: $7'6"$ Max.
- Section 5: $8'6"$ Max.
- Section 6: $9'6"$ Max.

3'-0"
 #4-bers
 3" Cl.
 #4x2'6" @ 1'-0"
 Conc. = .049 Cu Yd./Lin. Ft.
 Reinf. = 3.0 Lb./Lin. Ft.
 } Toe wall only
 WITH TOE WALL
 1'-0" Min.
 3'-0"
 WAF 4x4-W/4xW/4
 @ 31lb. per 100 sq. ft.
 3'-0"
 3'-0"

ELEVATION

WITH CONCRETE APRON

ALL WORK SHALL BE DONE IN ACCORDANCE WITH THE STANDARD SPECIFICATIONS APPLICABLE TO THE PROJECT.
ALL CONCRETE SHALL BE CLASS "A" (BOX CULVERT).

ALL EXPOSED CORNERS SHALL BE CHAMFERED 3/4".
SUPPORTING SOIL FOR WINGWALL FOOTINGS SHALL BE COMPACTED SOIL
OR UNDISTURBED NATURAL SOIL.
WINGWALL FOOTINGS AND FLOOR OF BOX CULVERT SHALL BE PLACED
MONOLITHICALLY.

FOOTINGS IN ROCK SHALL NOT BE FORMED BUT POURED AGAINST UN-
DISTURBED ROCK.
EXPANSION JOINT MATERIAL SHALL CONFORM TO AASHTO M-213 AND
PAYMENT THEREFORE SHALL BE INCLUDED IN THE PRICE FOR
ITEM 601.
THE MINIMUM SPLICE LENGTH FOR COMMON BAR SIZES SHALL BE:

BAR SIZE	#4	#5	#6
SPLICE LENGTH	1'-0"	1'-3"	1'-6"

DIMENSIONS "H", "L", "R", "k", "L" AND ANGLE θ SHALL BE AS SHOWN ON THE PLANS.


DESIGN DATA:

UNIT STRESSES: $f_s = 20,000$ PSI, $f_c = 1,200$ PSI, $n = 10$
EQUIVALENT FLUID PRESSURE = 30 PSI
MAXIMUM TOE PRESSURE = 1 TON/SQ. FT.


CULVERT WINGWALLS

Designer	Structure Numbers	of	Drawings
Detailer			
Drawing Number B			


CONCRETE BOX CULVERTS & WINGWALLS

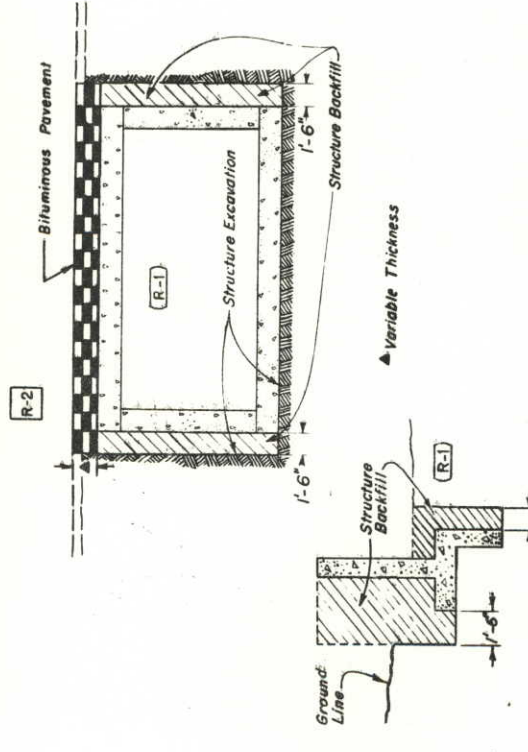


CAST IN PLACE CONDUIT

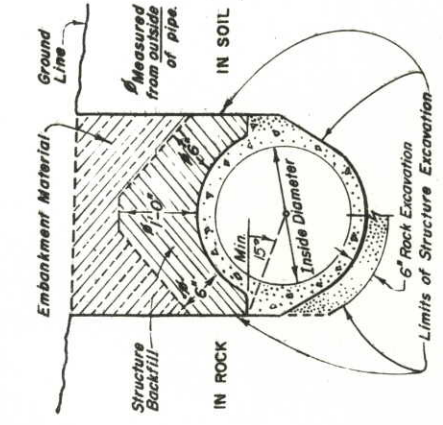


CIRCULAR CONDUIT

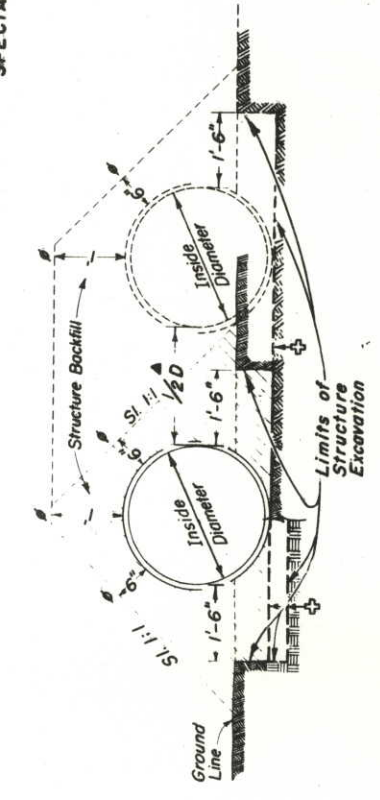


SIPHONS OR CONDUIT IN TRENCH

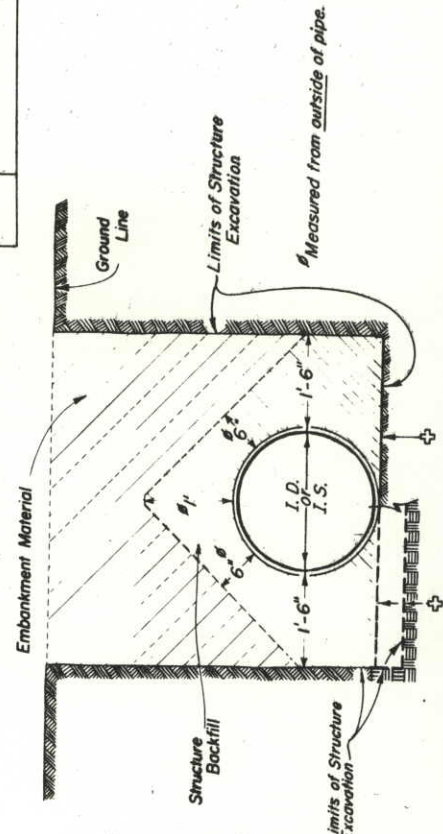


PIERS, ABUTMENTS, RETAINING WALLS ETC.

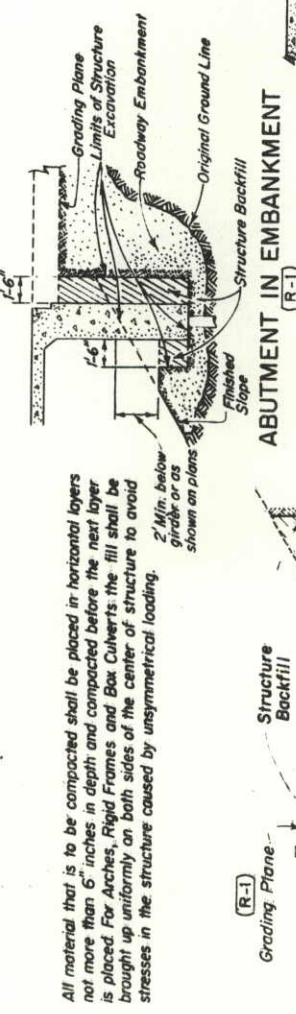


ELLIPTICAL OR ARCH CONDUIT

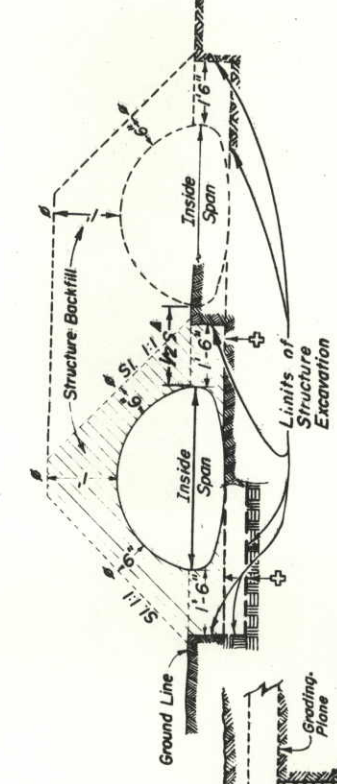

HEADWALLS AND END OF CULVERTS

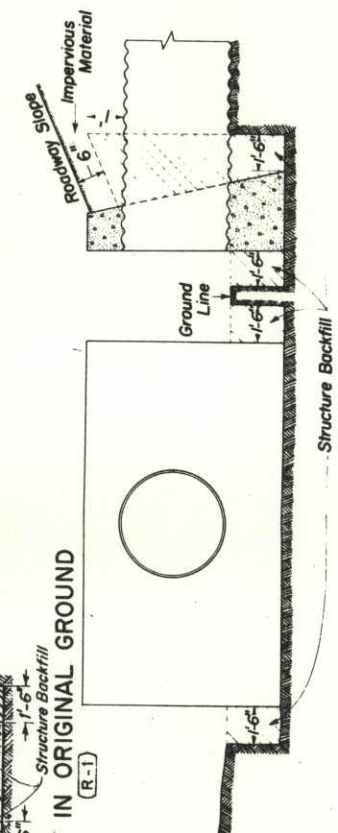

DROP INLETS, DIVISION BOXES, INTERCEPTING HEADWALLS, ETC.

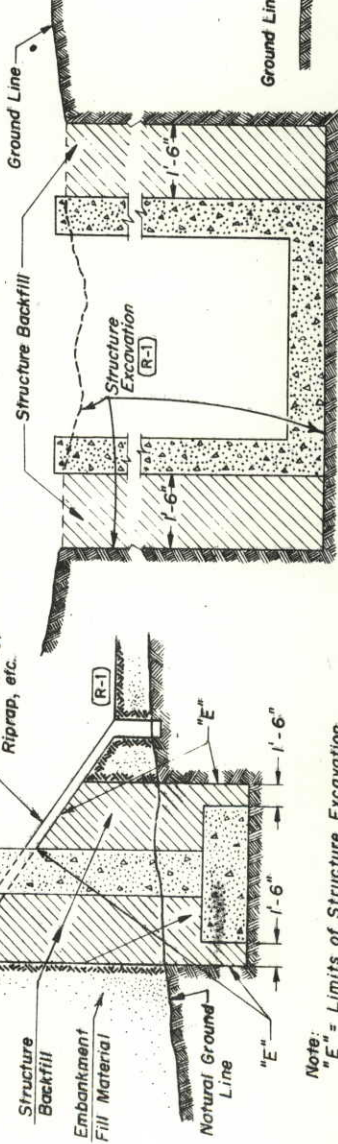

GENERAL NOTES

All work shall be done according to the Standard Specifications applicable to the Project.


Where the roadway cross section is in fill, excavation for concrete footings (except those in rock or those on piles) and for box culverts shall be done according to the following:

Embankment shall be built up and compacted to a point one foot above the bottom of the box or one foot above the bottom of the footing. The trench shall then be excavated to accommodate construction of the box or footing.

Excavation and backfill patterns different from those indicated on these sheets will be shown elsewhere on the plans.

Excavation for structure installation shall be classified as "Structure Excavation" unless otherwise shown on plans.

TRENCH FOR PIPE UNDERDRAIN

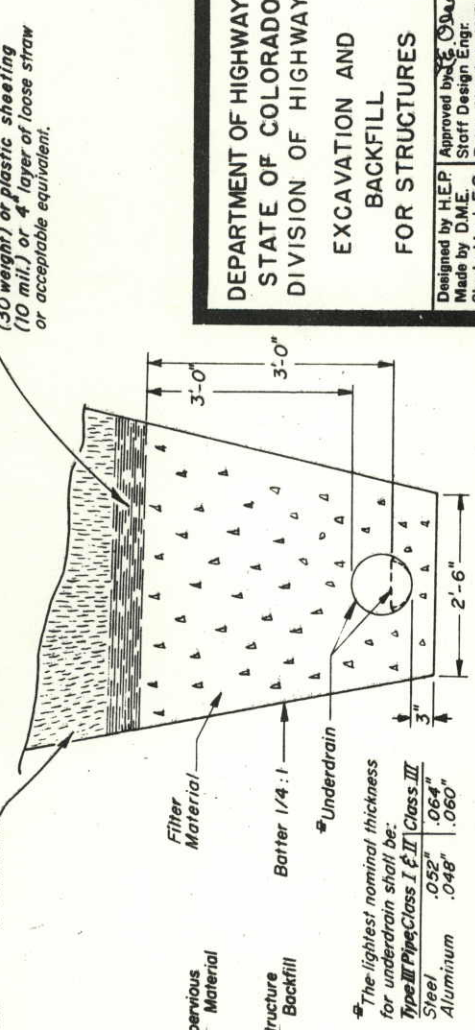

DEPARTMENT OF HIGHWAYS
STATE OF COLORADO
DIVISION OF HIGHWAYS

EXCAVATION AND BACKFILL FOR STRUCTURES

Designed by HEP
Made by DME
Checked by LEO

Approved by E. O'Day
Staff Design Engr.
Date: March 1, 1971

STRUCTURE EXCAVATION MEASUREMENT
FOR PIPE CULVERTS

~~STANDARD M-206-AA~~
(MARCH 1, 1971)
(SHEET 2)


FEDERAL ROAD REGION NO.	DIVISION	PROJ. NO.	SHEET NO.	TOTAL SHEETS
VIII	COLORADO	ER 80 (1)	6	9

REVISIONS:	
R-1	2-16-72 Revision date only. M.R.H.
R-2	11-2-73 Special This Project Only C.K.M.


AS CONSTRUCTED
NO REVISIONS DATE MAY 2, 1974

SPECIAL THIS PROJECT ONLY

STRUCTURE EXCAVATION MEASUREMENT
FOR CONCRETE BOX CULVERTS

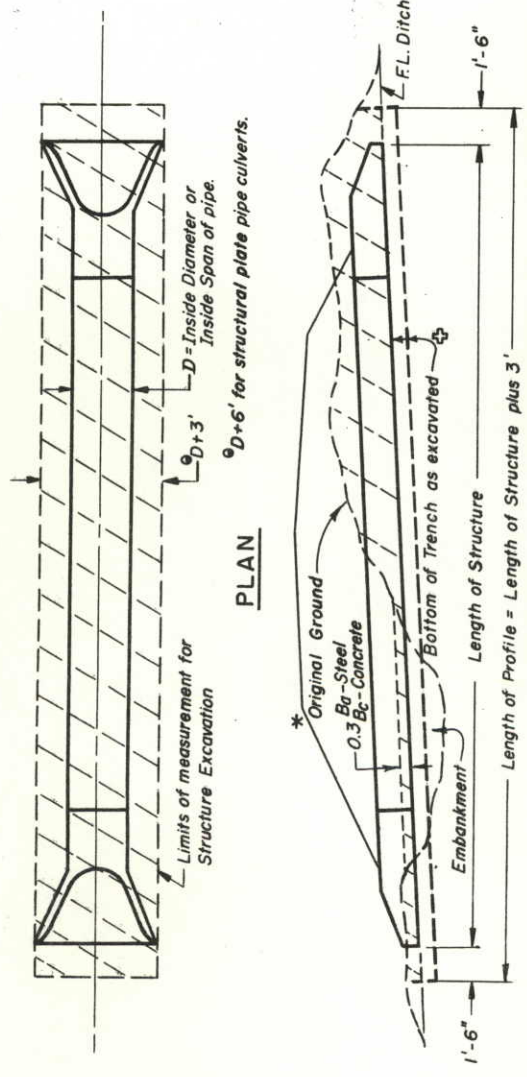



Without Channel Change or Channel Improvement

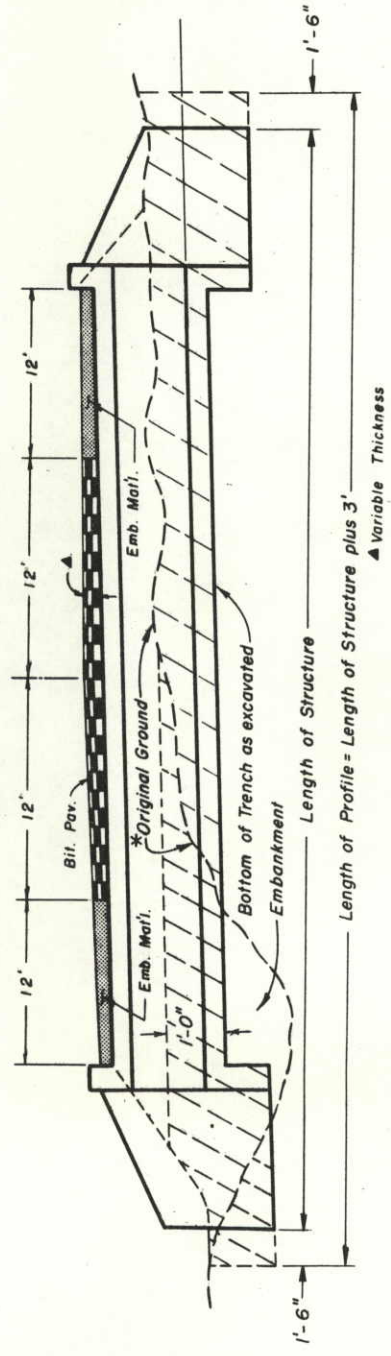

With Channel Change or Channel Improvement

NOTE:
See Sheet 1 for General Notes and Backfilling Details.

STRUCTURE EXCAVATION MEASUREMENT
FOR DIVERSION OR DIVISION BOXES

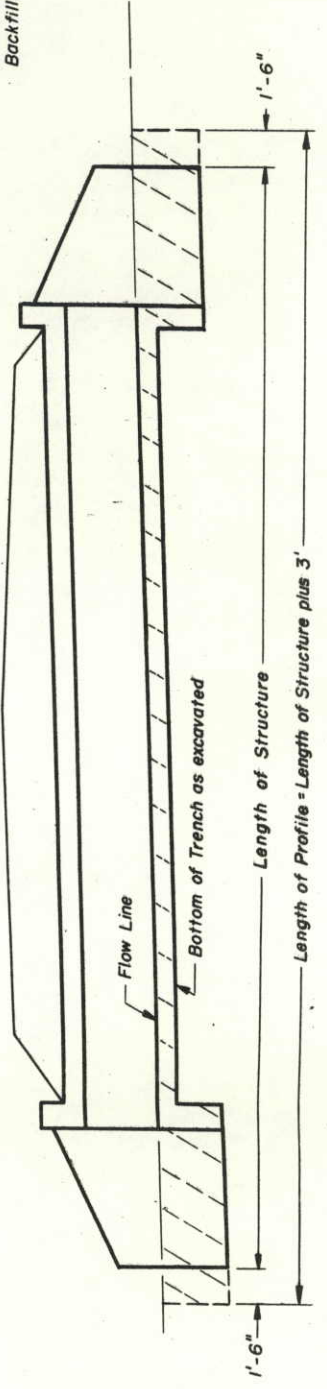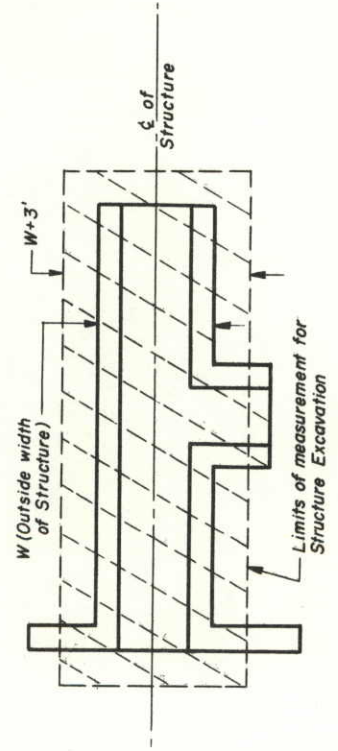

* Along ζ of Structure
Areas to be used for Structure Excavation computations.

DEPARTMENT OF HIGHWAYS
STATE OF COLORADO
DIVISION OF HIGHWAYS

EXCAVATION AND
BACKFILL
FOR STRUCTURES

Designed by: M.R.H. Approved by: C.K.M.
Made by: H.P.B. Staff Design Engineer
Checked by: [Signature] Date: March 1, 1971

FEDERAL ROAD DISTRICT NO.	VIII
DIVISION	COLORADO
PROJECT NO.	ER 80(1)
SHEET NO.	7
TOTAL SHEETS	9

REV C.M.M. 11-15-73
Added Names of Towns

AS CONSTRUCTED
NO REVISIONS DATE **MAY 2, 1974**

SITE NO. I-B

Sec. 24, T.4 N., R.62 W.

