

FED. ROAD DIST. NO.	STATE	F.A.G.M. PROJ. NO.	SHEET NO.	TOTAL SHEETS
3	COLO.	19-A (1)	1	

COLORADO STATE HIGHWAY DEPARTMENT

PLAN AND PROFILE OF PROPOSED FEDERAL AID GRADE CROSSING PROJECT NO. F.A.G.M. 19-A(1) (NOT ON FEDERAL AID SYSTEM) STATE HIGHWAY NO. 340 MESA COUNTY

INDEX OF SHEETS


- SHEET NO. 1 - TITLE SHEET
 " 2 - TYPICAL SECTION & SUMMARY
 " 3-12 - VIADUCT STA 33+32 TO 36+73
 " 13-15 - PEDESTRIAN UNDERPASS, MAIN ST.
 " NO 16 - STANDARD NAME PLATE
 " 17 - " HEADWALLS FOR C.M.P. CULVERTS
 " 18 - " TIMBER GUARD POSTS
 " 19 - " WIRE FENCES (UNTR. WOOD POSTS)
 " 20 - " CHAIN LINK WIRE MESH (SCHOOL) FENCE
 " 21 - " STRUCTURE NUMBER LETTERING
 " 22 - " METHODS FOR SUPERELEV & WIDENING
 " 23 - " TYPICAL SIDE APPR. ROADS - SIGNS
 " NO 24-25 - PLAN & PROFILE SHEETS
 " 26-47 - CROSS SECTION SHEETS
- M-6-D
M-102-E
M-19-A
M-24-FX
M-26-A
M-10-A
M-1-B
M-2-B

SCALES OF ORIGINAL TRACINGS

ON PLAN, 1 IN. = 100 FT.
 ON PROFILE, 1 IN. = 100 FT. HORIZONTAL
 1 IN. = 10 FT. VERTICAL
 GRADE LINE ON PROFILE IS SHOWN AS GRADE OF FINISHED ROAD
 GROSS LENGTH OF PROJECT } 2984.7 FT. = 0.565 MI.
 NET LENGTH OF PROJECT }

CONVENTIONAL SIGNS

CENTER LINE OF SURVEY _____ 25
 RIGHT OF WAY LINE _____
 SECTION LINE _____
 ONE QUARTER SECTION LINE _____
 CITY LIMITS _____
 BARBED WIRE FENCE _____
 COMBINATION WIRE FENCE _____
 BOARD FENCE _____
 POLE LINES _____
 WATER PIPE LINE _____
 SEWER PIPE LINE _____
 RAILROADS _____

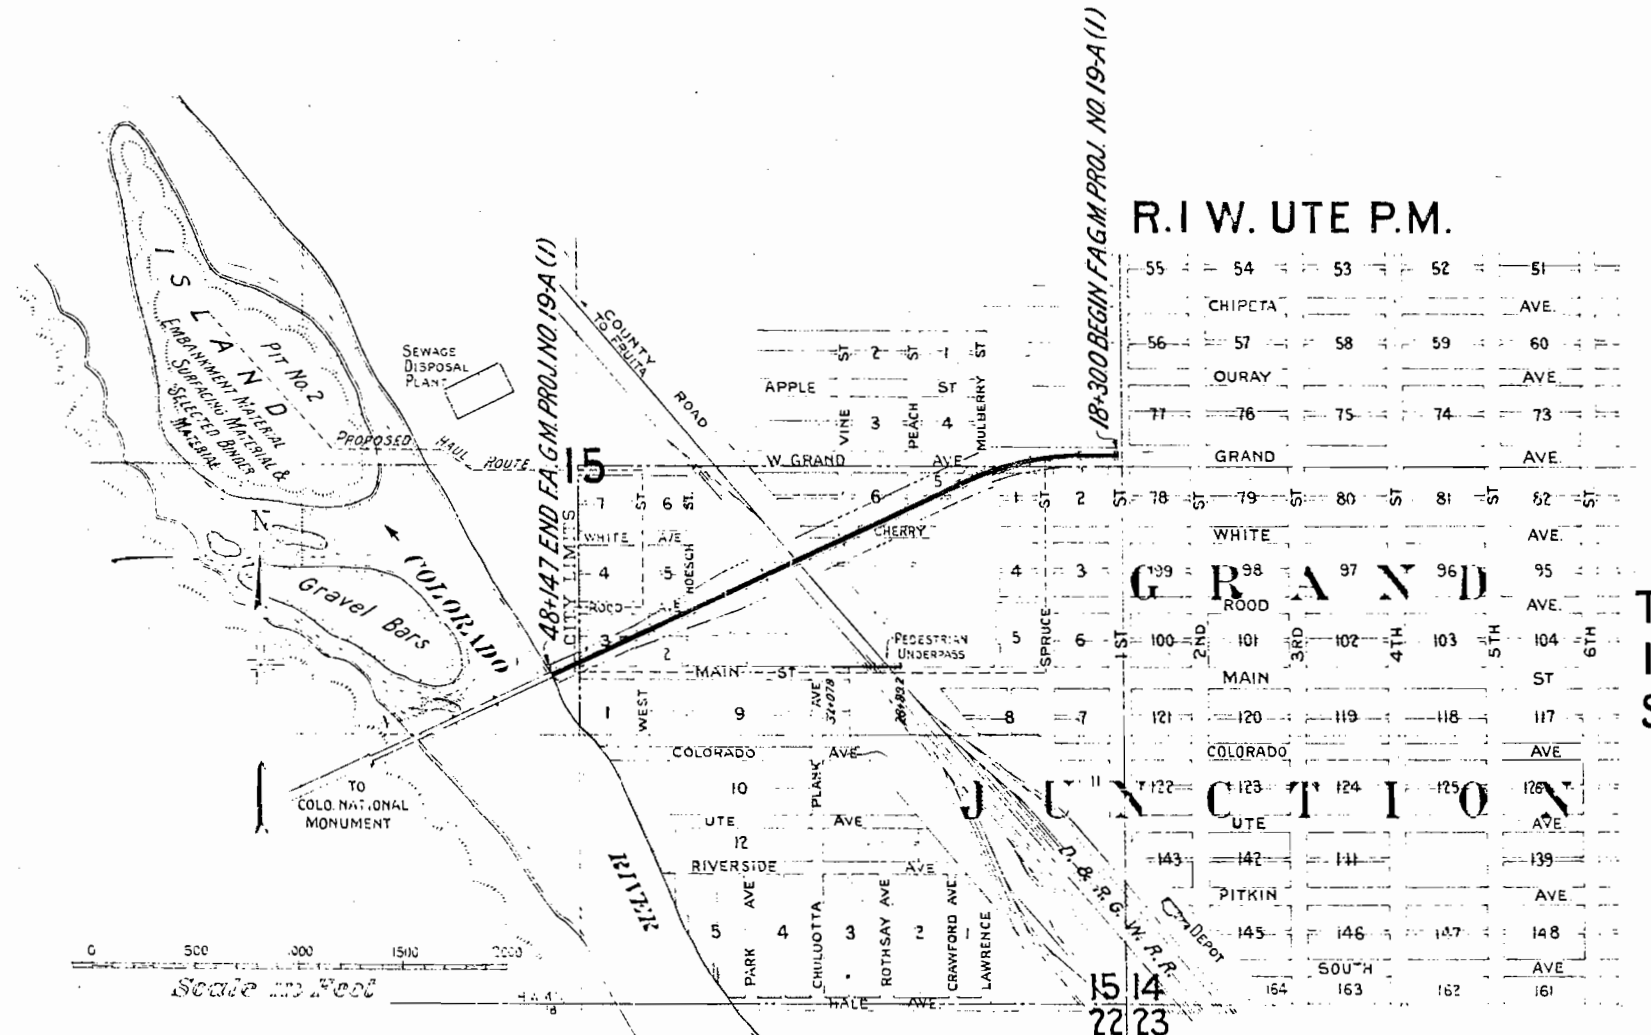

Note: It is recommended that bidders on this Project go over the plan details with one of the following field representatives of this Department.
 J. J. Vandemoer, Division Engineer, located at Grand Jct.
 A. H. Batten, Resident Engineer, located at Grand Jct.

RECOMMENDED FOR APPROVAL

APPROVED

RECOMMENDED FOR APPROVAL

APPROVED

FED. ROAD DIST. NO.	STATE	F.A.G.M. PROJ. NO.	SHEET NO.	TOTAL SHEETS
3	COLO.	19 A (1)	2	

Revised 11-19-38 S.B.L.
 1st sec. 1-20-36 A.F.F.
 Revised 1-4-39 S.B.L.
 Rev. sec. 1-14-39 S.B.L.

CUT SLOPE TREATMENT IN EARTH CUTS

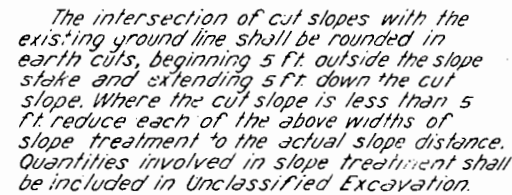

SELECTED BINDER MATERIAL for plating fill slopes as indicated on Typical Section shall be obtained from: Pit 102.

Sta 18+30-33+32	1530 Cu Yd. Pit #2 Overhaul-1690052 Yd.	3+32 Yd.
Sta 36+93-48+15	1500 " " " "	820 " "
Total	3030 " " " "	16500 " " 820 " "

R.O.W. MARKERS

Embankment Material required for this Project shall be obtained from Pit No.2 indicated on Title Sheet of plans.


ITEM	DESCRIPTION	UNIT	ROADWAY	OVERPASS STA 33+	UNDERPASS MAIN ST	TOTALS
	<i>FORCE ACCOUNT ITEMS</i> <i>Moving Pole Line (Wes Union Forces) Lmp Sta 33+</i> <i>Work by R R Co Forces</i>			.	.	.

STATIONS	SIDE	REMOVE FENCE	BUILD BW FENCE	BUILD SCHOOL FENCE
18+45-34+30	R		1,640	
20+75-23+35	L & R	515		
21+45	L & X	355		
24+70-33+78	L		{ 10 910	
29+80-32+05	L & R	1050		
32+25-34+15	L & R	515		
34+25	R		65	
31+30-38+55	L		130	
37+35	X	200		
37+40-46+65	R		930	
38+00-38+55	L	85		
38+55-40+55	L			200
40+55-43+50	L		300	
40+80-43+05	L & R	540		
TOTALS		3260	3985	200

LIST OF STRUCTURES

LOCATION		DESCRIPTION	REMOVE STRUCT	EXCAV. CU YDS.	* STRUCT EXCAV. CU. YDS	CORR MET CULV. L.F.	CL "B" CONC.	RD. APPR. SURF.	MISCELL.	
STATIONS			EACH	UNCL. EMB.		15' 18'	CU. YD.	TONS		
18+45		Project Marker							f-Project Marker	
20+60 - 27+30		Waste Ditch	R	70						
21+85		Road Approach	L	25				29		
24+75		C.M.P side dr. Hdwall	L		5	50	0.45			
" "		Remove Flume & Hd Box Culv		2						
28+66		C.M.P Cross Culv. 69° skew				50	136	1.10		
33+32 - 36+92.71		R.R. Overpass			Quantities in Summary					
43+70		Road aborch. L.						100		
43+80		Adjust Manhole Ring & Cover		1600					Adjust Manhole Ring & Cover.	
47+50		Road approach	R	700				17		
48+147		Project Marker							f-Project Marker	
TOTALS			2	2395		55	50	136	155	146

* Structural Excavation is estimated to be 10% Rock & 90% Common, each of which is estimated to be 40% Dry and 60% Wet

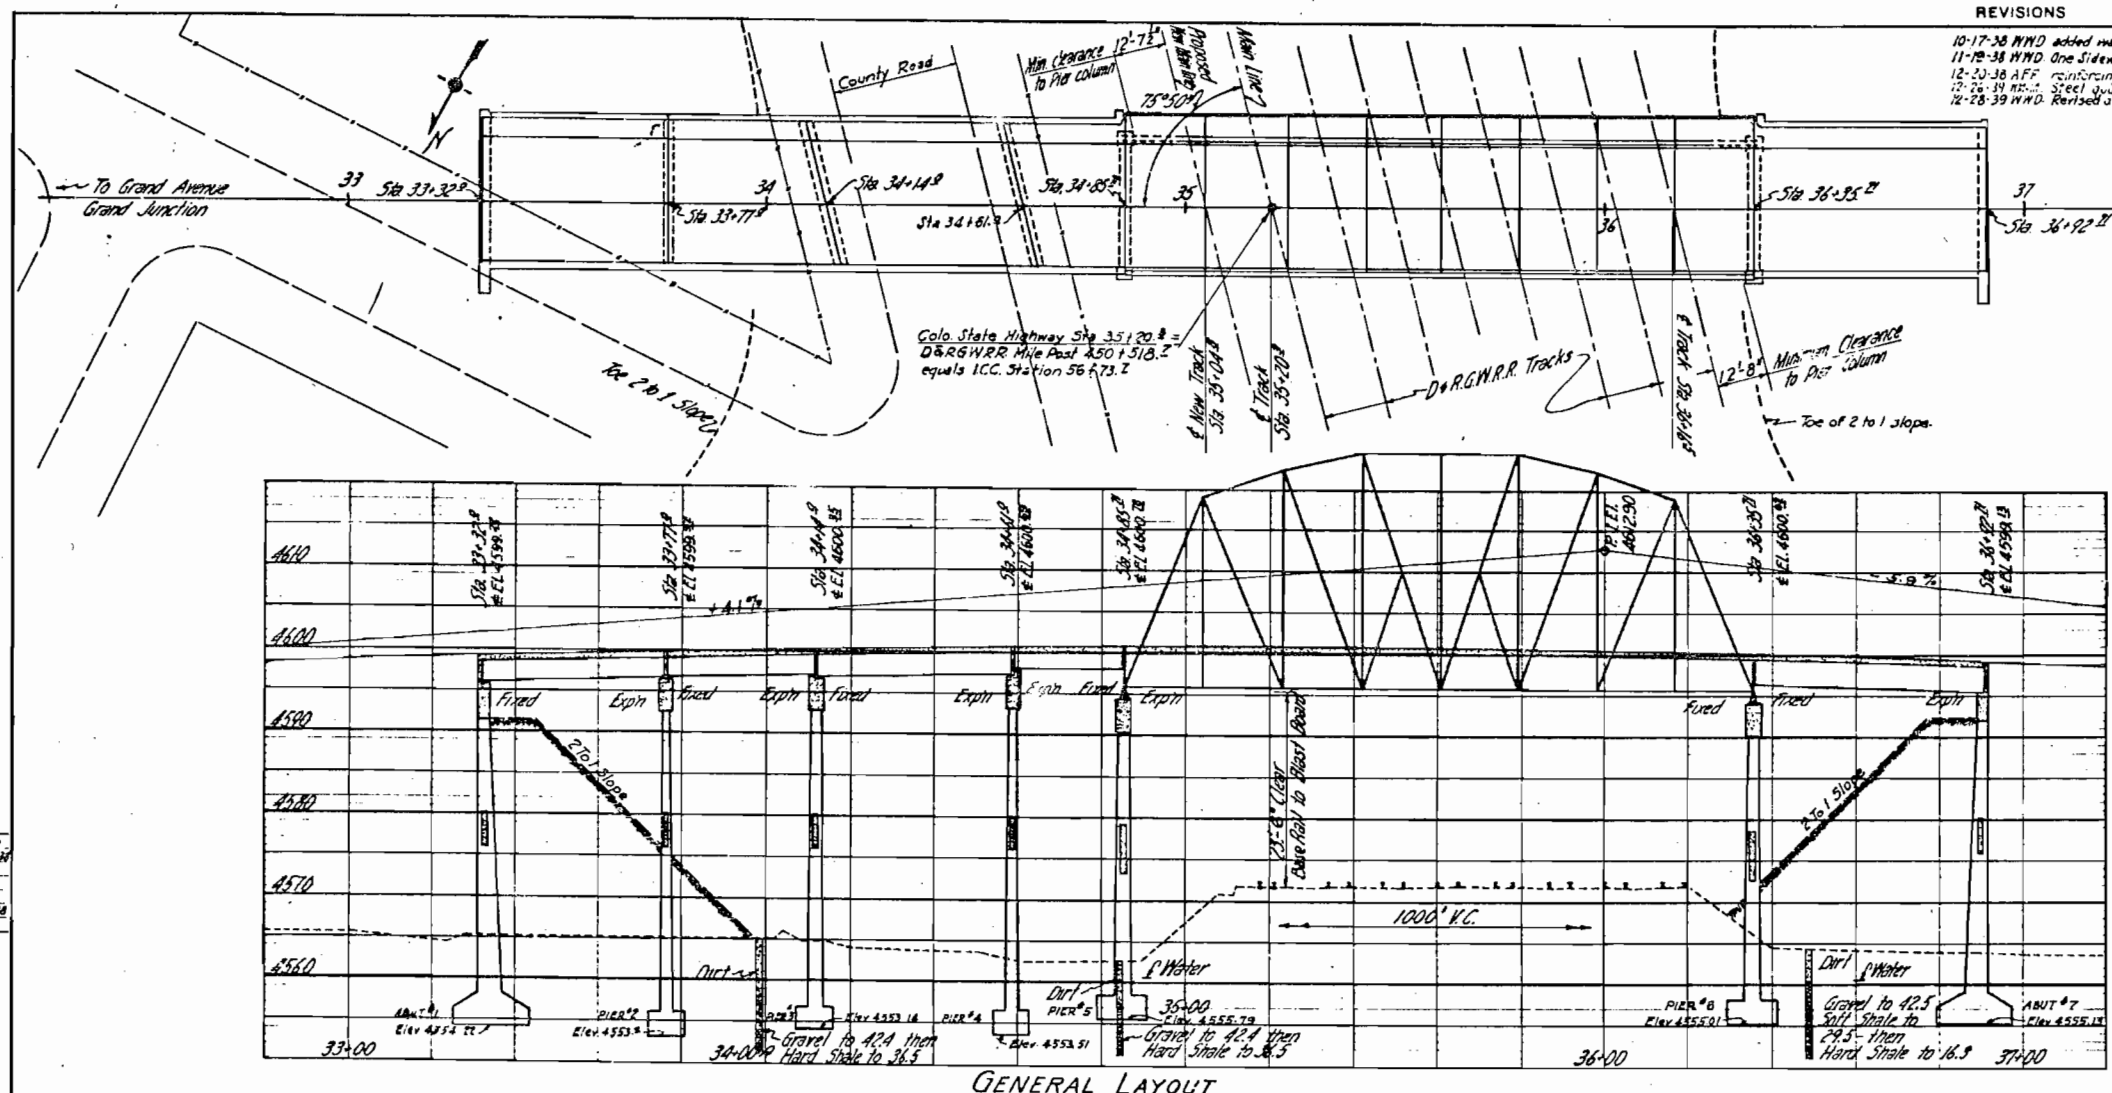

REVISIONS

10-17-38 NWD added waterproofing
 11-18-38 NWD One Sidewalk
 12-20-38 AFF reinforcing steel summary
 12-26-38 NWD Steel quantities
 12-28-39 NWD Revised as constructed.

FED. ROAD DIST. NO.	STATE	PROJECT	SHEET NO.	TOTAL SHEETS
3	COLO.	EAGM 19-A1	3	

BAR LIST FOR SUPERSTRUCTURE SPANS 1-2-3-4-5-6

BAR LIST					BENDING DIAGRAMS	
Span	Size	No.	Length	Type	I	II
1	3/8"	84	28'-9"	Str.		
2	3/8"	2Ea	19'-9"	Str.		
3	3/8"	84	28'-9"	Str.		
4	3/8"	2Ea	19'-9"	Str.		
5	3/8"	84	28'-9"	Str.		
100	3/8"	2Ea	19'-9"	Str.		

GENERAL LAYOUT

✓ TG

SUMMARY OF QUANTITIES												
ITEM	DESCRIPTION	UNIT	SUPR STR 150' THRU APP SPANS	TRUSS	ABUT #1	PIER #2	PIER #3	PIER #4	PIER #5	PIER #6	ABUT #7	TOTAL
14a	Dry Rock Excavation (Structural)	Cu.Yd.										0
14b	Dry Common " "	" "			75.8	33.1	29.3	174	196	78.4	85.9	339.5
14c	Wet Rock " "	" "										0
14d	Wet Common " "	" "			102.2	55.6	54.8	51.8	50.1	40.6	65.8	420.9
42a	Untreated Bridge Timber	M.Fibm.			0.180						0.180	0.360
46a	Class "A" Concrete	Cu.Yd.	230	148	85	54	55	57	73	73	98	873
46r	" " " (Handrail)	" "	22									22
47	Reinforcing Steel (Incl 1% for over'n)	Lb.	42686	25670	14,225	7,490	7,620	7,620	9,160	9,160	16,385	140,016
48	Structural Steel (Incl 1% for over'n 2% Truss)	" "	173,050	33,425	7,30	55	55	55			60	506,230
80b	Bronze Name Plate	Each	1									1
80c	Sheet Copper 38 oz.	Lb.	172									172
79a	Water-Gas Tar Waterproofing	Sq.Yds.			86.58	57.3	56.14	56.14	68.34	71.62	8508	481.2
89a	Drain Pipe (Conc. floor) 3" Diam	Each	9	16								25
90	Elec. Conduit with Junction Boxes	Lin.Ft.	1015									1015
98a	Elec. Lighting Unit (Mercury Vapor)	Each	5									5
*	No. 16 Ga. Galv. Sheet Metal	Lb.	285									285
*	3/4" Exp'n Joint Material	Sq.Ft.	86									86
*	1/4" " " "	" "	66									66

* To be included in bid price of Class "A" Concrete.
 † Includes 45,000 lbs. Structural Steel for Blast Board 39,000 lbs. of which is Wrought Iron, U.S. Cor-Ten Alloy Steel, or
 • Includes 350 lbs. reinforcing steel for lamp standards, see Sheet No. 6a.
 • Pay weight (From shop drawings)

REFERENCE DRAWINGS
 Sheet No. 4 Details of Superstructure Spans 1, 2, & 3.
 Sheet No. 5 Details of Superstructure Spans 3, 4 & 6.
 Sheet No. 6 Details of Superstructure. Sheet Nos. 8 Details of 150' Truss.
 Sheet No. 9 Details of Abutment No. 1.
 Sheet No. 10 Details of Piers 2, 3 & 4.
 Sheet No. 11 Details of Piers 5 & 6 and Blast Board.
 Sheet No. 12 Details of Abutment No. 7.

APPROVED *[Signature]* 10/10/1938
 BY *[Signature]*
 CHIEF ENGINEER D.R.G.W.R.

GENERAL NOTES
 ALL WORK SHALL BE DONE ACCORDING TO THE STANDARD SPECIFICATIONS OF THE COLORADO STATE HIGHWAY DEPARTMENT.
 ALL CONCRETE SHALL BE CLASS "A".
 FORMS FOR CONCRETE SURFACES EXPOSED IN THE FINISHED WORK SHALL BE CONSTRUCTED OF SHIP LAP OR TONGUE AND GROOVE LUMBER 3/4" UNLESS FACED WITH PANEL BOARD.
 CONCRETE GIRDERS, FLOOR SLABS AND CURB SHALL BE POURED MONOLITHICALLY.
 FOOTINGS IN ROCK SHALL BE POURED OUT TO THE ROCK AND NOT FORMED.
 ALL REINFORCING BARS SHALL BE DEFORMED WITH THE STATION NUMBER AND LETTER DESIGNATION. MAIN BARS SHALL NOT BE SPLICED.
 SOUNDINGS AND DEPTH OF FOOTINGS SHOWN ARE ACCORDING TO THE BEST AVAILABLE DATA IF ESSENTIALLY DIFFERENT CONDITIONS ARE ENCOUNTERED THE BRIDGE ENGINEER WILL INSPECT AND DETERMINE IF REDESIGN IS NECESSARY.
 ALL RIVETS TO BE 3/4" DIA. ALL RIVETS TO BE POWER DRIVEN.
 HANDRAIL TO BE BUILT ACCURATELY TO LINE AND GRADE.



LOADING DATA.
 LIVE LOAD - S. H. M. O. 1938 CLASS A (16-18)
 DEAD LOAD - ASSUMES 15 LBS. PER SQ. FT. ADDITIONAL WEARING SURFACE WHICH INCLUDES THE 4 INCH CONCRETE MONOLITHIC WEARING SURFACE SHOWN.

DESIGNING DATA.
 S. H. M. O. 1938 EXCEPT CONCRETE UNIT STRESSES PER A.S.H.M.O. AUG. 1938

COLORADO
STATE HIGHWAY DEPARTMENT
GRAND AVE VIADUCT
GENERAL LAYOUT
SUMMARY OF QUANTITIES
SUPERSTRUCTURE BAR LIST
 Across *[Signature]*
 Near GRAND JCT. Sta. 33+32.2 to 36+92.1
 Designed by *[Signature]* Approved by *[Signature]*
 Made by A.J.C. Bridge Engineer
 Checked by B.R. Date: Oct 5, 1938

STRUCTURE NO. H-2-N

FED. ROAD DIST. NO.	STATE	F.A.G.M.	SHEET NO.	TOTAL SHEETS
3	COLO.	19-A (1)	4	

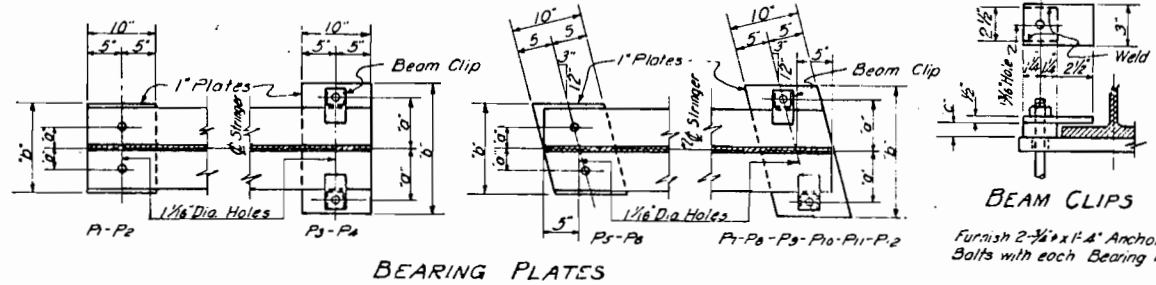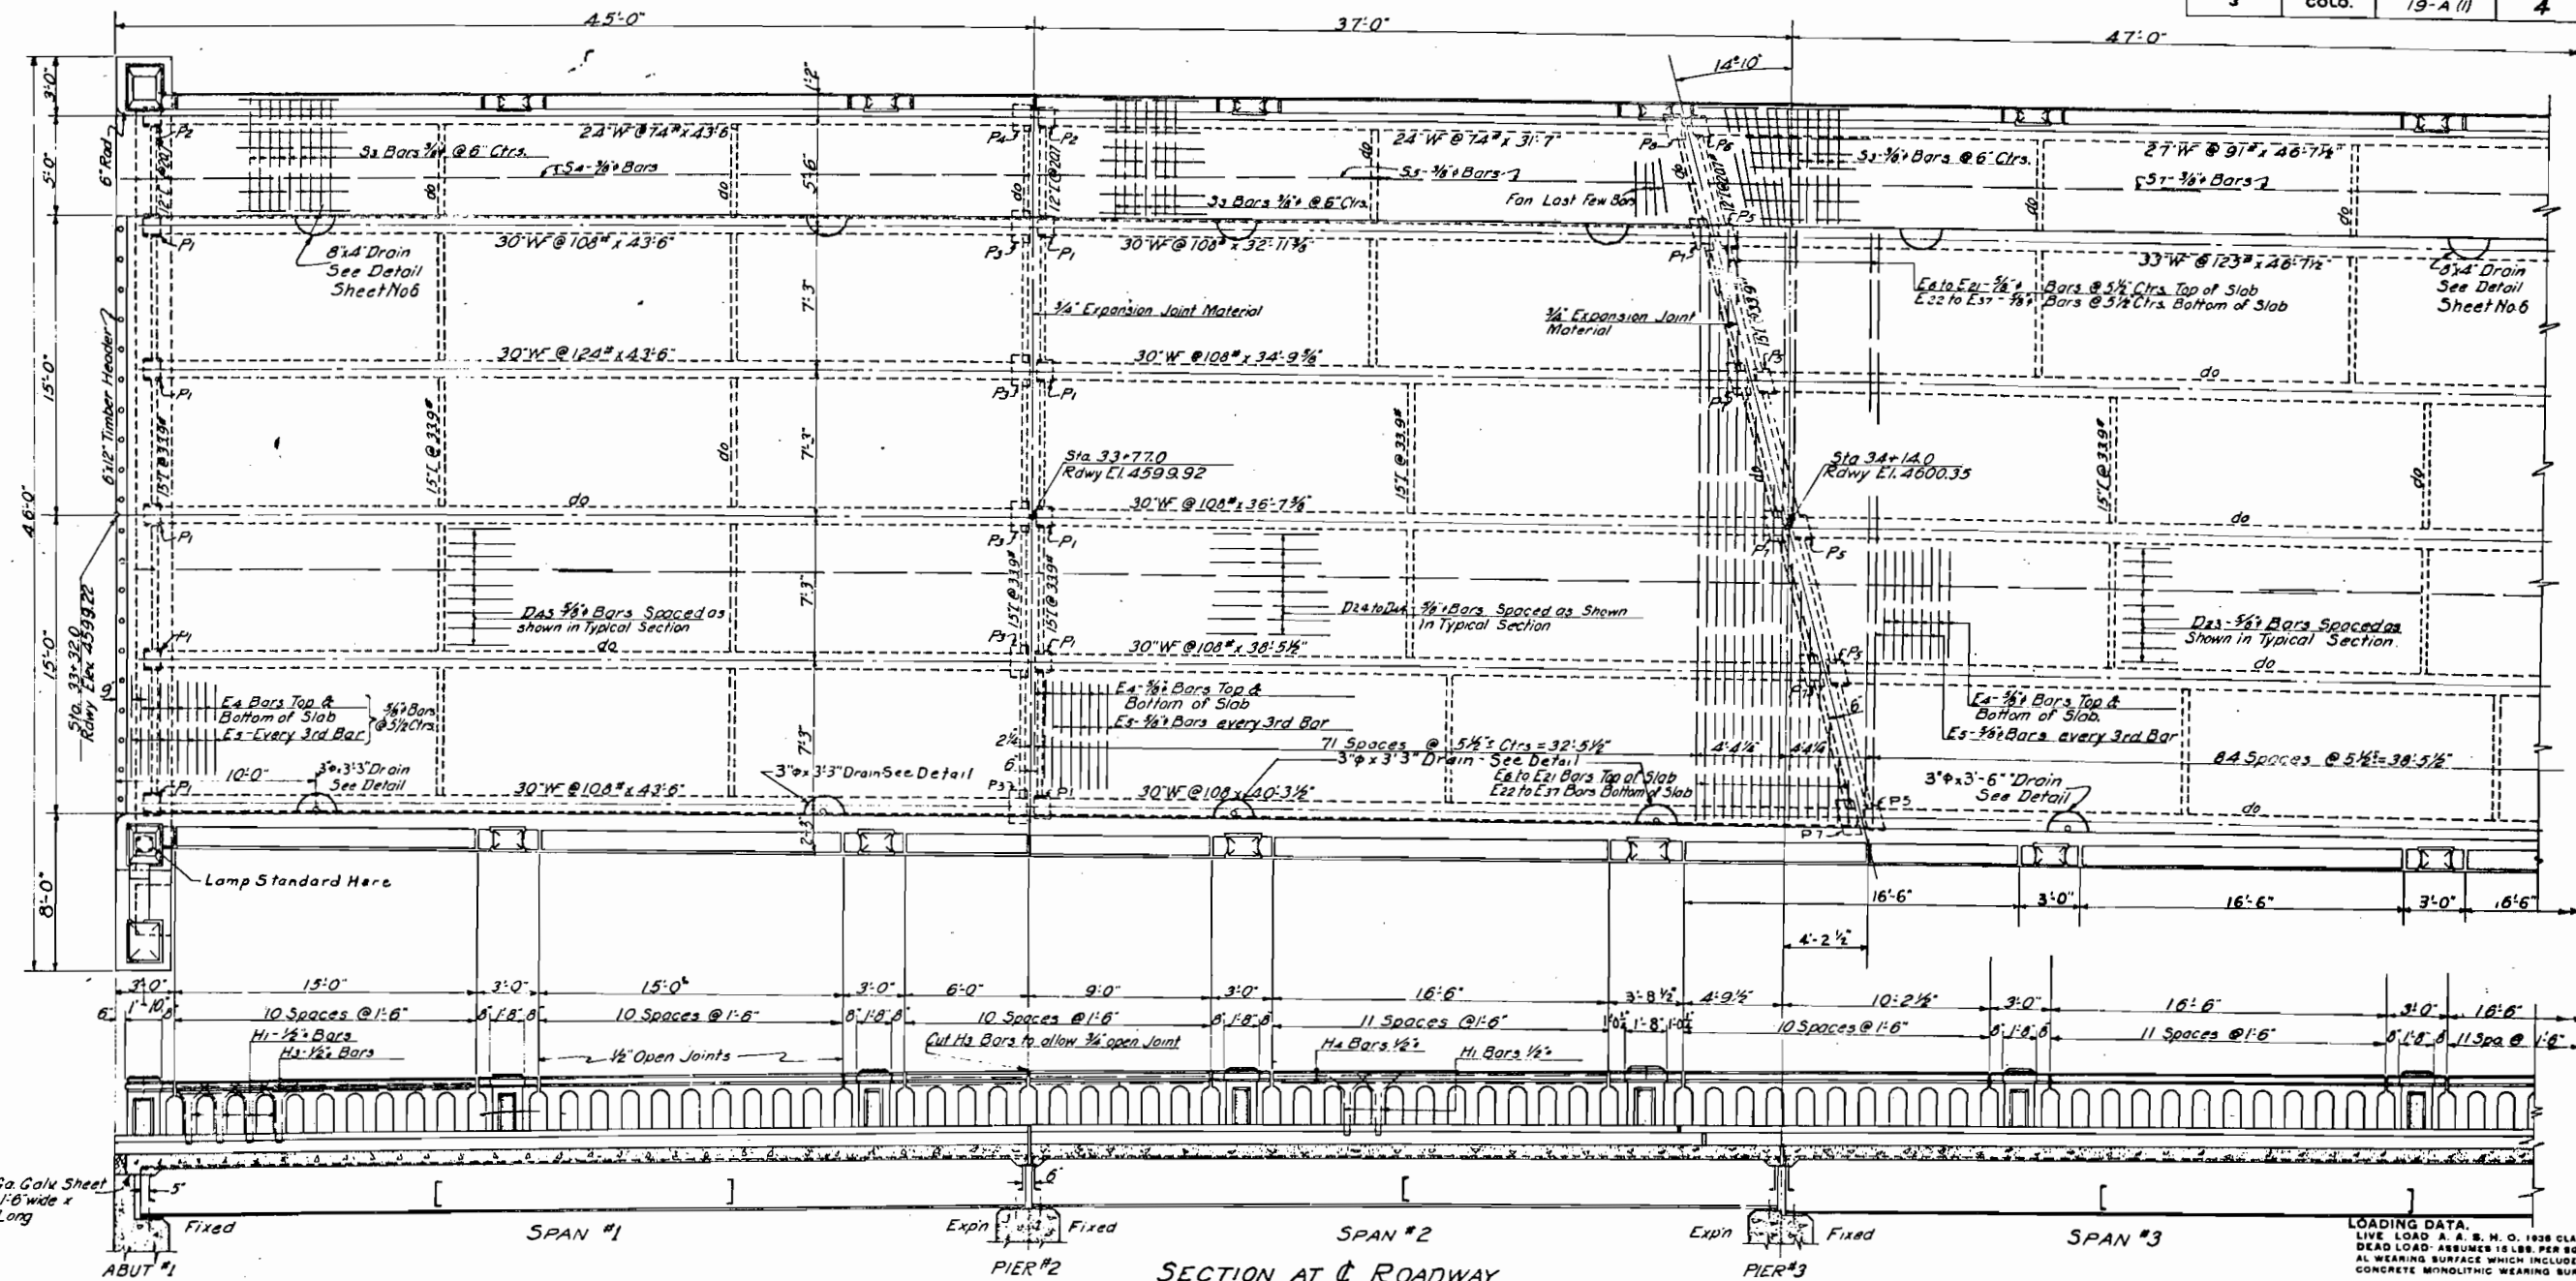

Mark	Read	Location	Read
P1	5 3/8"	1'-0" Abut #1	—
P2	1 3"	10' —	—
P3	5 6 3/4"	1'-5" Pier 2	10 1 1/8"
P4	1 6"	1'-3" —	2 2 7/8"
P5	5 3 1/2"	1'-0" —	2 —
P6	1 3"	10' —	2 —
P7	5 3 1/2"	11' —	3 —
P8	1 6"	1'-5" —	3 10 1/8"
P9	1 6"	1'-5" —	3 2 1/8"
P10	5 7 1/2"	1'-6" —	4 10 1"
P11	1 6 1/2"	1'-4" —	4 2 7/8"
P12	1 5 1/2"	1'-2" —	4 2 1/8"

REFERENCE DRAWINGS
For List see Sheet No. 3

LOADING DATA.
LIVE LOAD A. A. S. H. O. 1938 CLASS A, 1M-181
DEAD LOAD ASSUMES 15 LBS. PER SQ. FT. ADDITIONAL WEARING SURFACE WHICH INCLUDES THE 1/2 INCH CONCRETE MONOLITHIC WEARING SURFACE SHOWN.

DESIGNING DATA.
A. A. S. H. O. 1938 EXCEPT CONCRETE UNIT STRESSES PER A. A. S. H. O. AUG. 1928.

COLORADO
STATE HIGHWAY DEPARTMENT


GRAND AVE. VIADUCT
DETAILS OF SPANS #1, 2 & 3

Across D. & R. G. W. R. R.
Sta. 33+77.0 to 36+92.71
Near Grand Junction, Sec. 15 T. 13 S. R. 11 W.

Designed by D. R. Approved by C. J. Bailey
Made by W. W. O. Bridges Engineer
Checked by W. W. O. Date: Oct. 5, 1938.

REVISIONS
 Revised 11-19-38. Changed handrail, posts, lights
 & removed sidewalk on North side. H.A.L.F.

FED. ROAD DIST. NO.	STATE	F.A.G.M.	SHEET NO.	TOTAL SHEETS
3	COLO.	19-AQ	5	

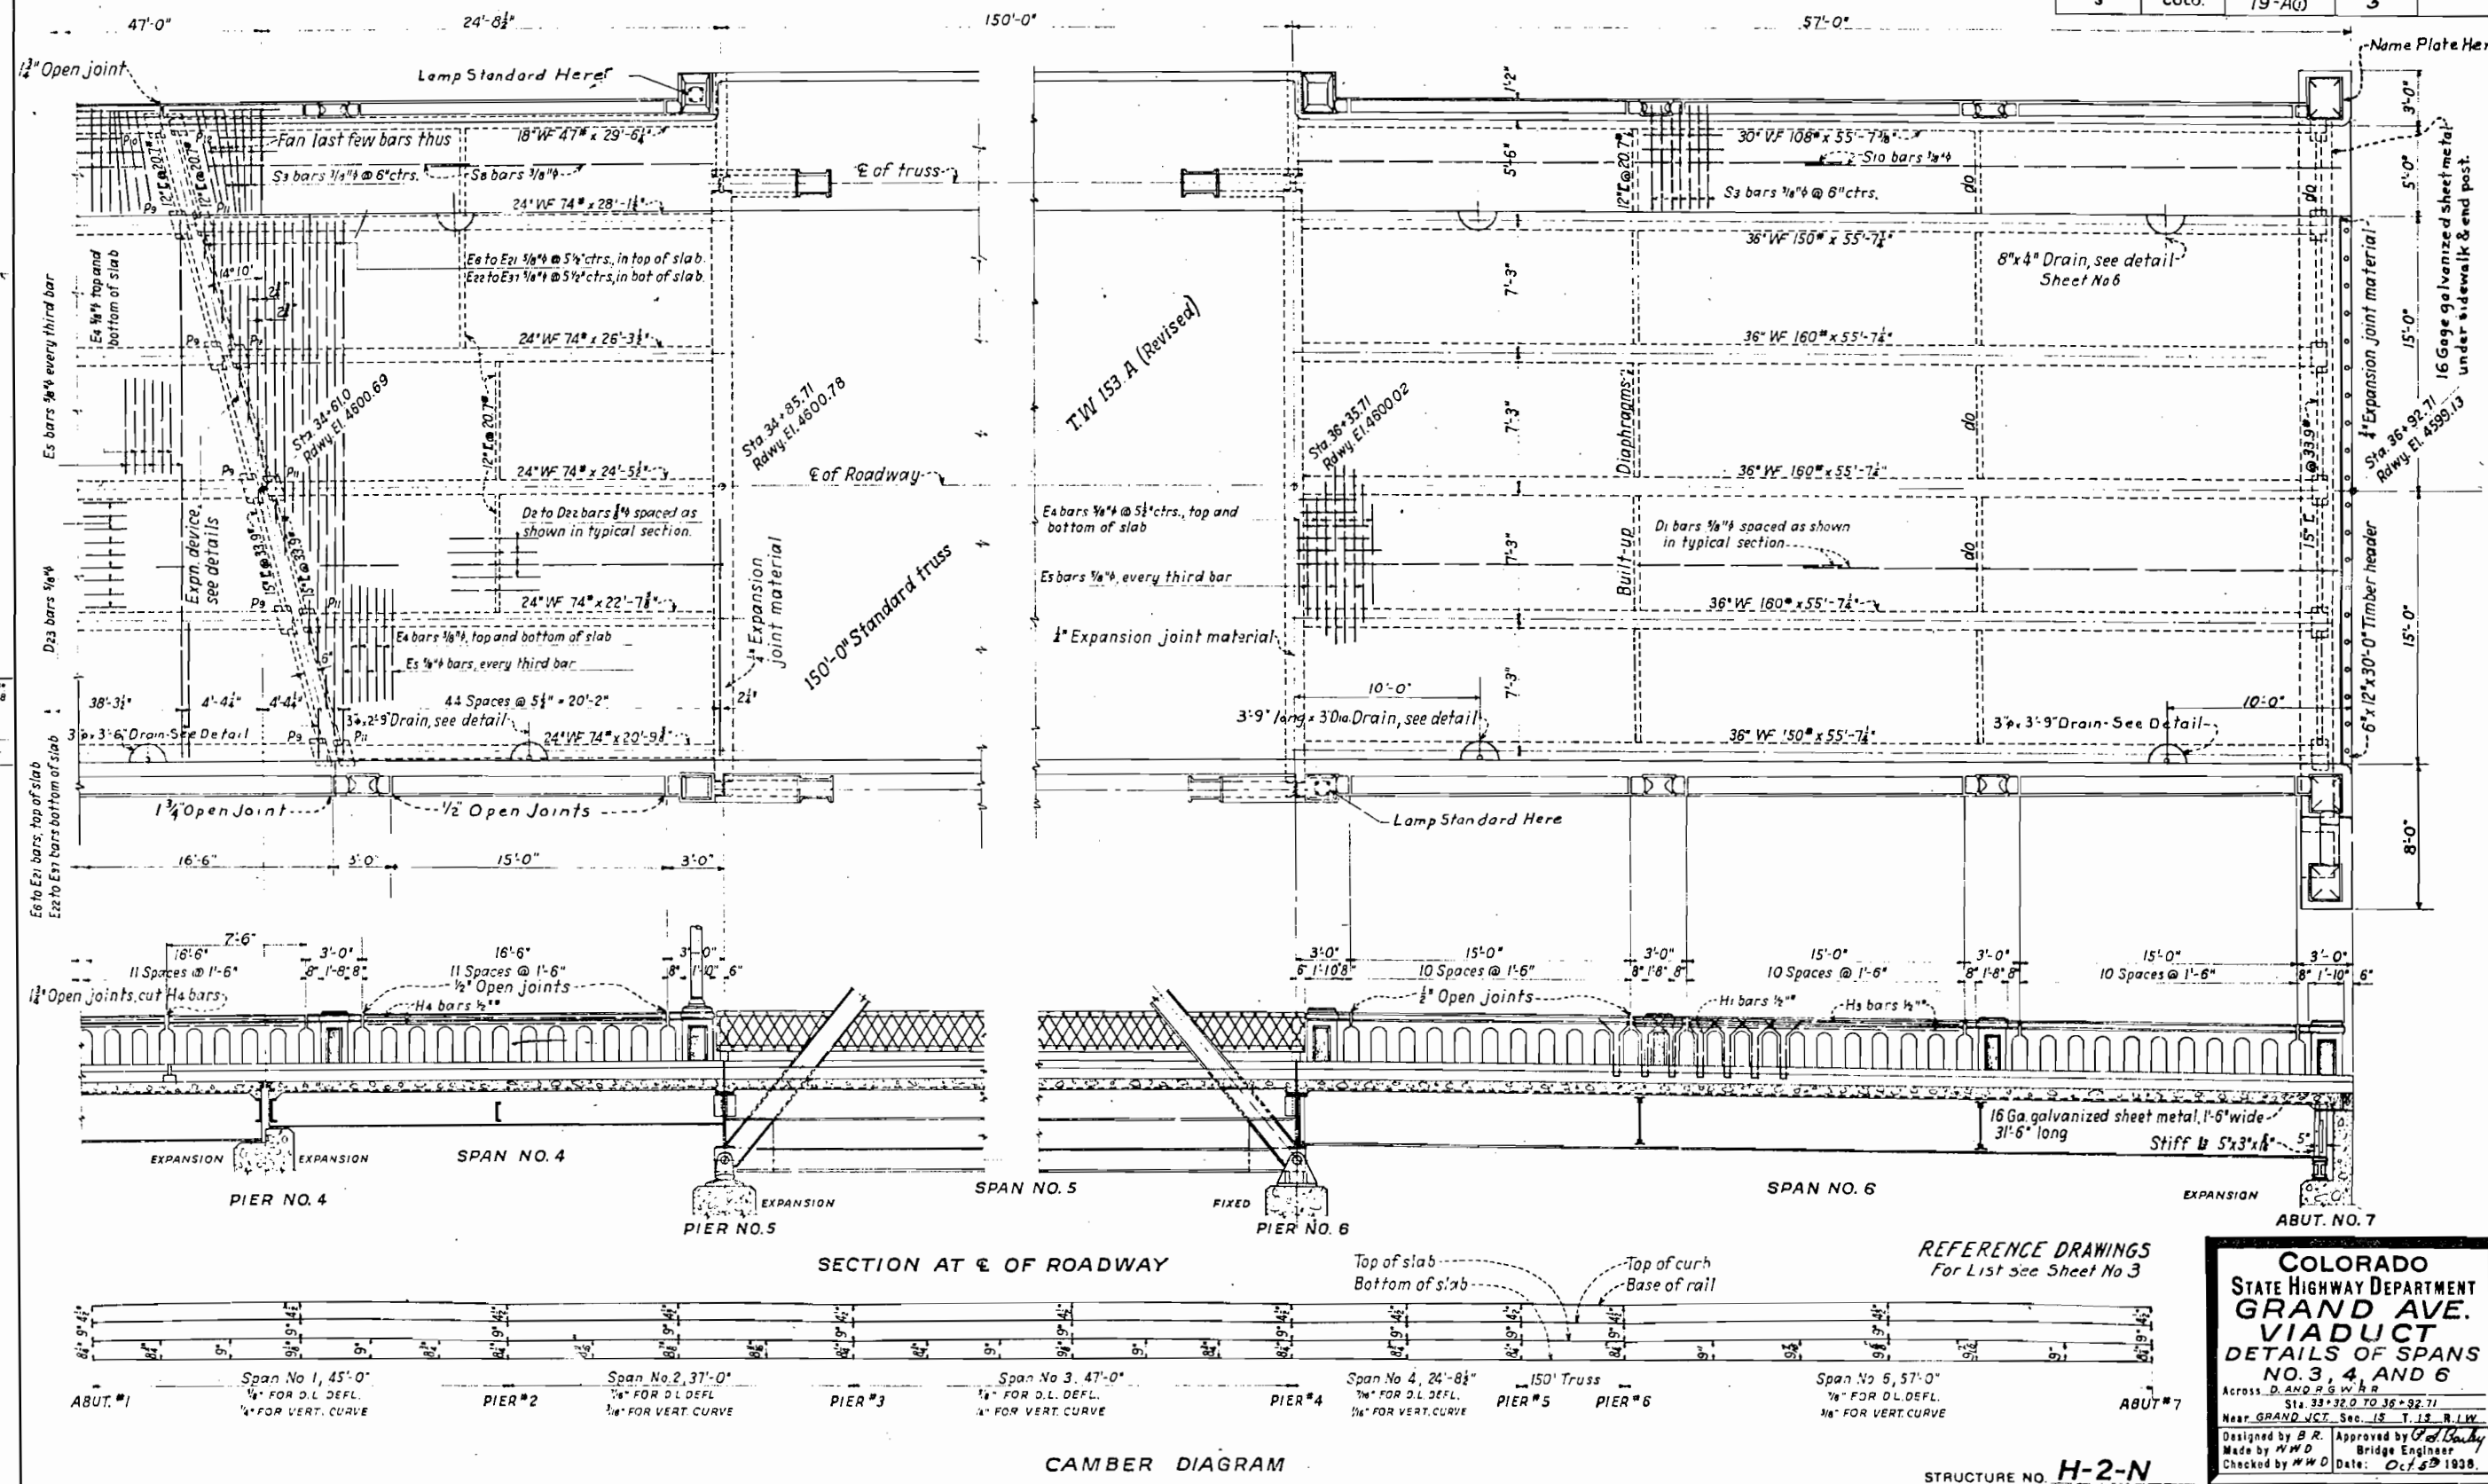















Designed By	Initial	Date
Checked By		
Drawn By		
Checked By		
Traced By		
Checked By		

COLORADO STATE HIGHWAY DEPARTMENT
GRAND AVE. VIADUCT
DETAILS OF SPANS NO. 3, 4, AND 6
 Across D. AND R. G. W. R.
 Sta. 33+32.0 TO 36+92.71
 Near GRAND JCT. Sec. 15 T. 12 S. R. 1 W.
 Designed by B. R. Made by W. W. D. Checked by W. W. D. Date: Oct 5 1938.
 Approved by C. D. Bailey Bridge Engineer

REFERENCE DRAWINGS
 For List see Sheet No 3



STRUCTURE NO. H-2-N

FED. ROAD DIST. NO.	STATE	F.A.G.M.	SHEET NO.	TOTAL SHEETS
3	COLO.	19A(1)	6	

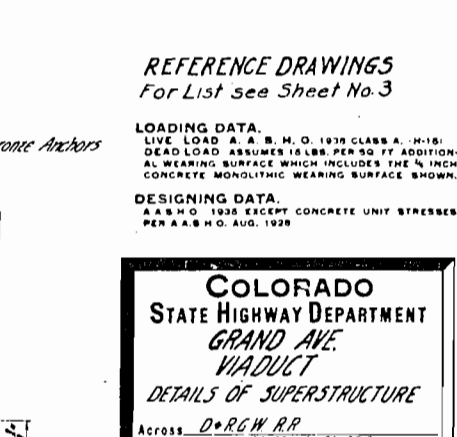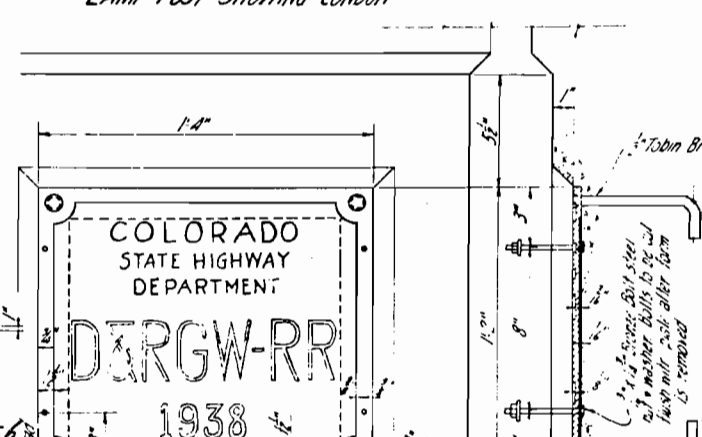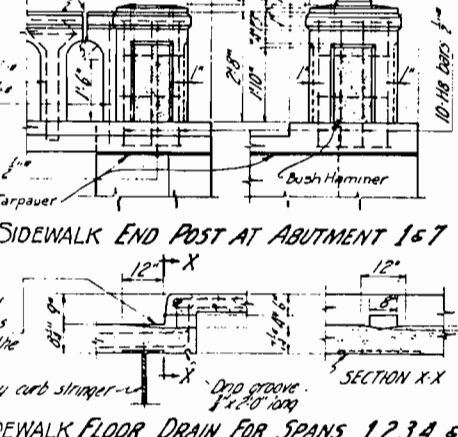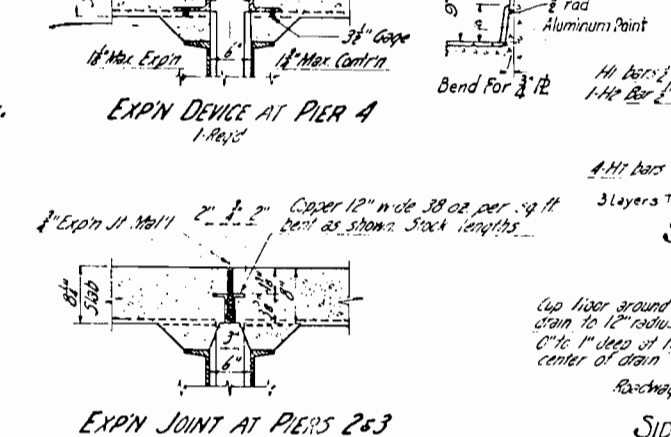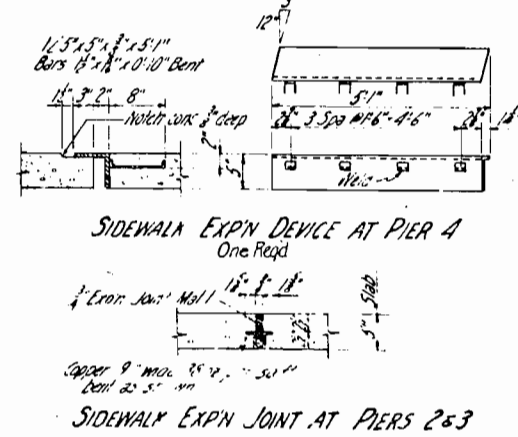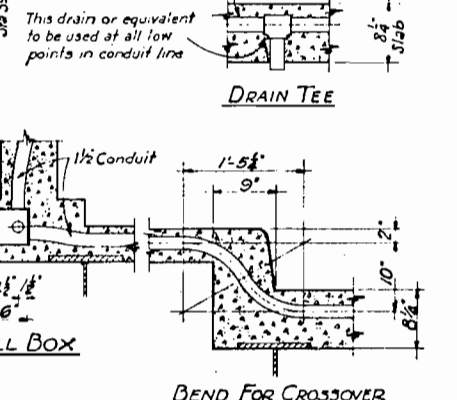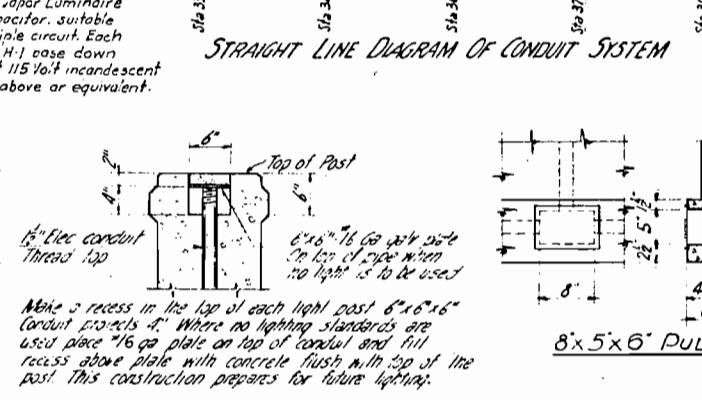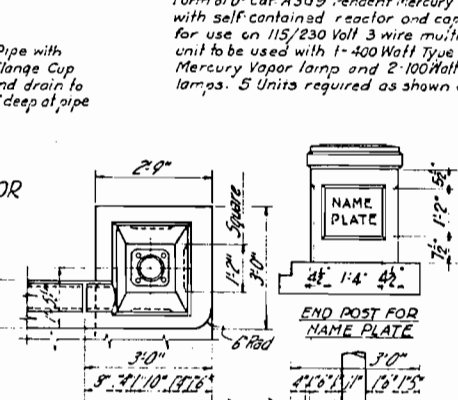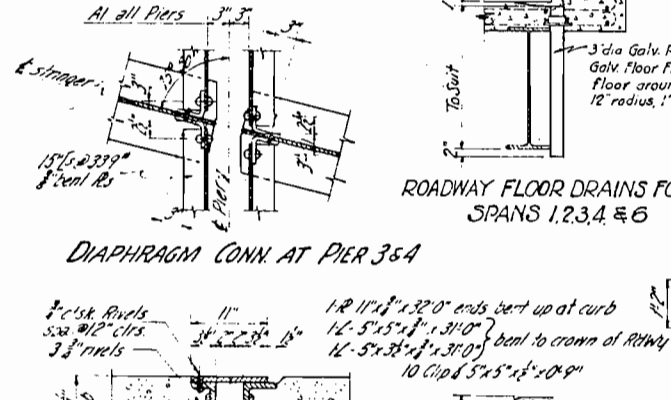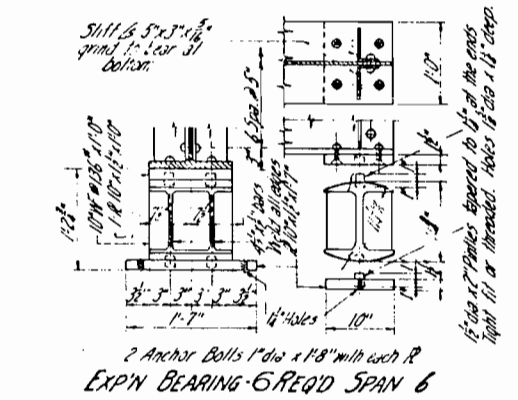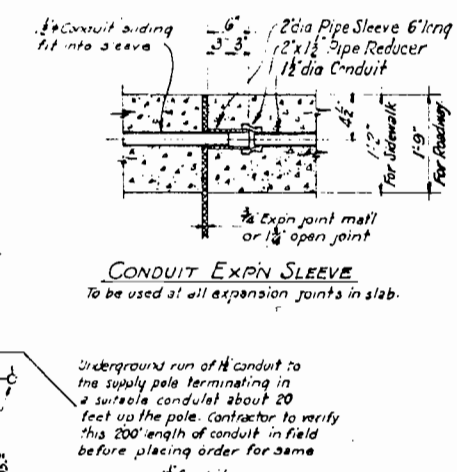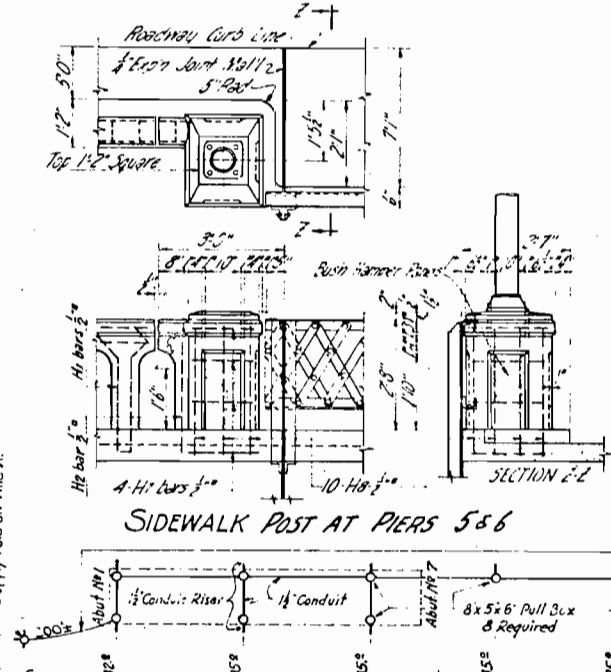
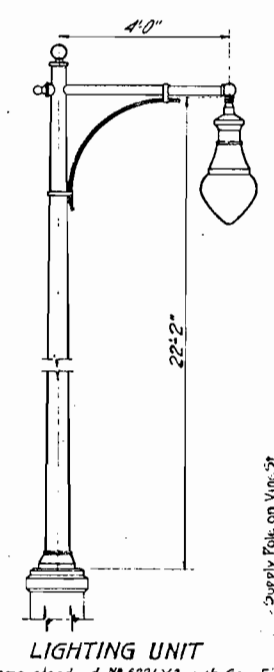
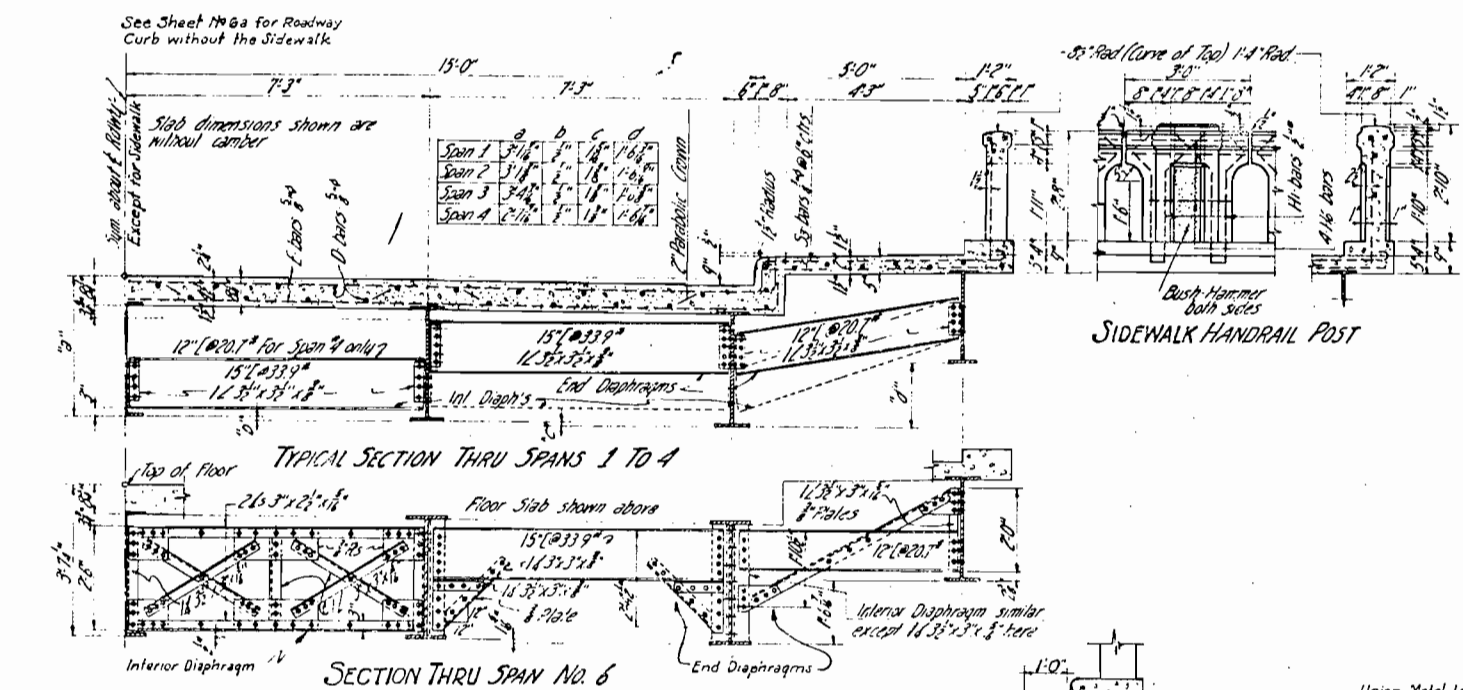


COLORADO STATE HIGHWAY DEPARTMENT
GRAND AVE. VIADUCT
DETAILS OF SUPERSTRUCTURE
Across D-GRW RR
Sta. 37+20 to 38+27.71
Near SWINDY Sec. 15 T. 13 S. R. 1 W.
Designed by HND Approved by G. D. Bailey
Made by ALC Bridge Engineer
Checked by HND Date: Oct. 5th, 1938.

FED. ROAD DIST. NO.	STATE	F.A.G.M.	SHEET NO.	TOTAL SHEETS
3	COLO.	19-A (1)	6a	

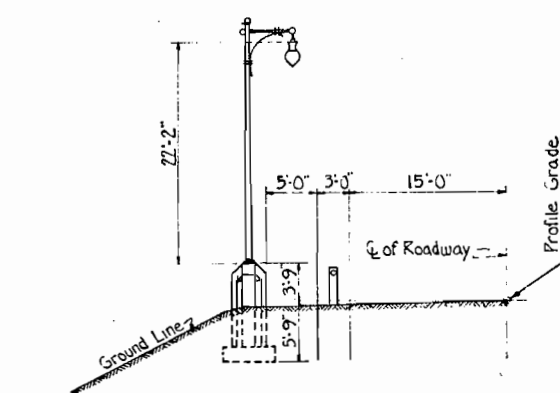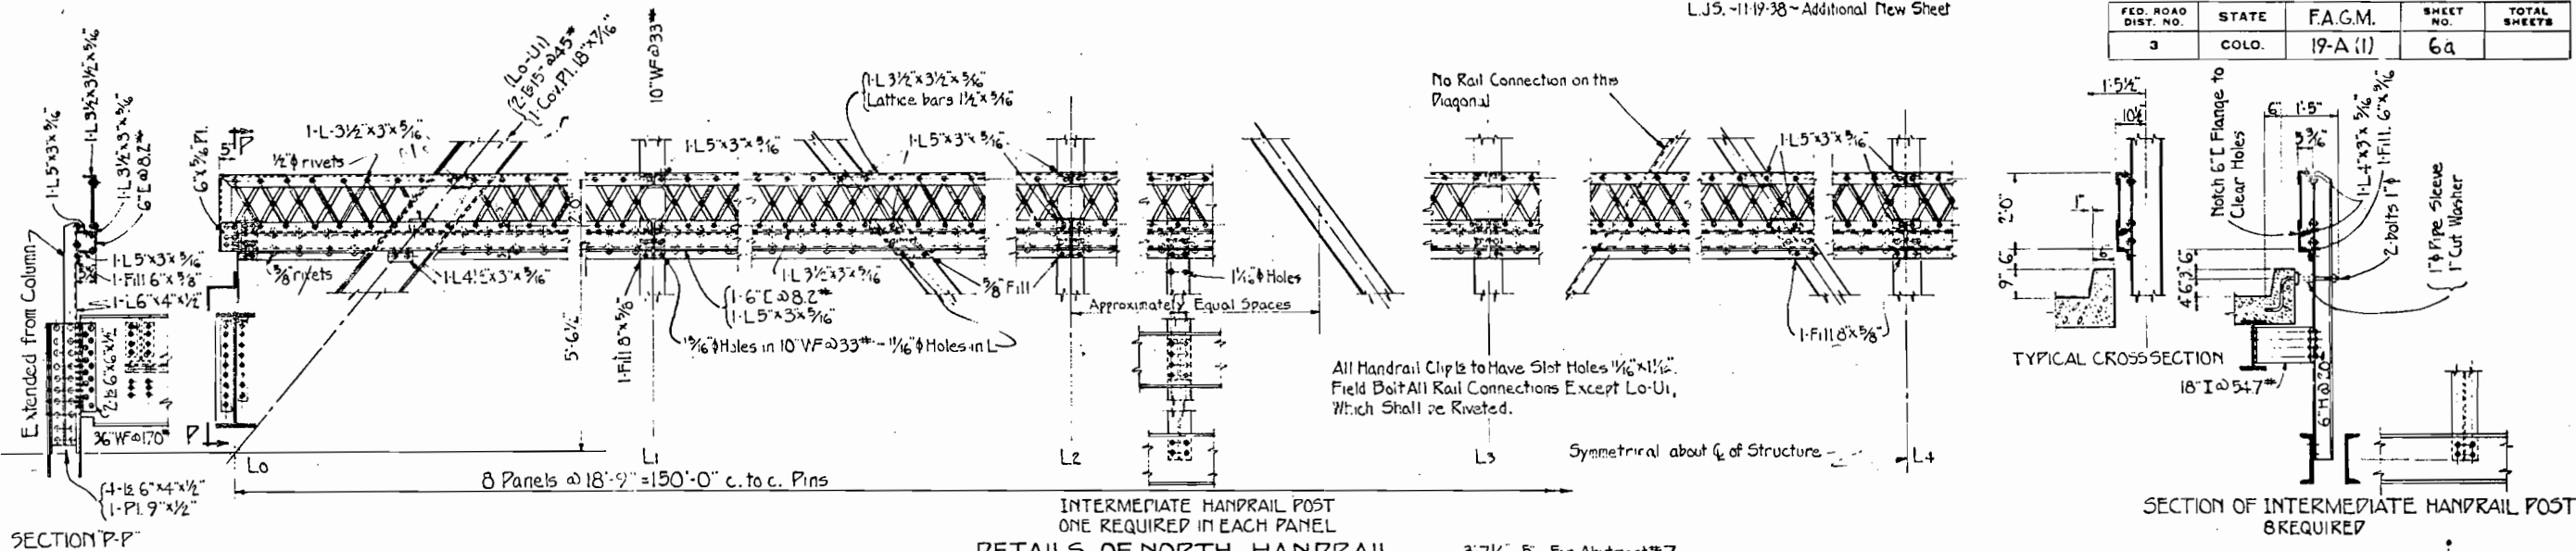

GENERAL LAYOUT OF INDEPENDENT LIGHTING UNIT ONE REQUIRED STA. 37+85.0 39+35.0 23'-0" Left of C.Roadway

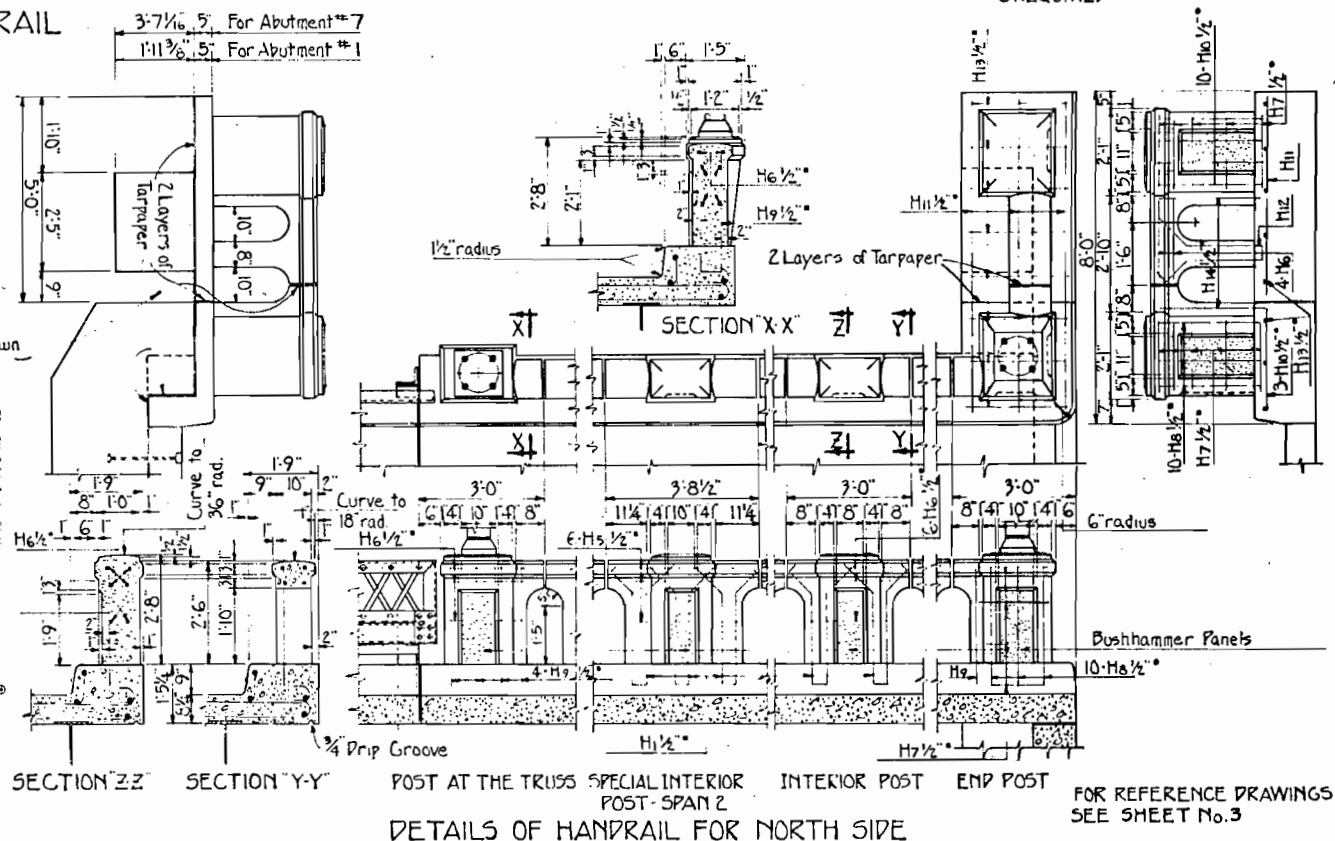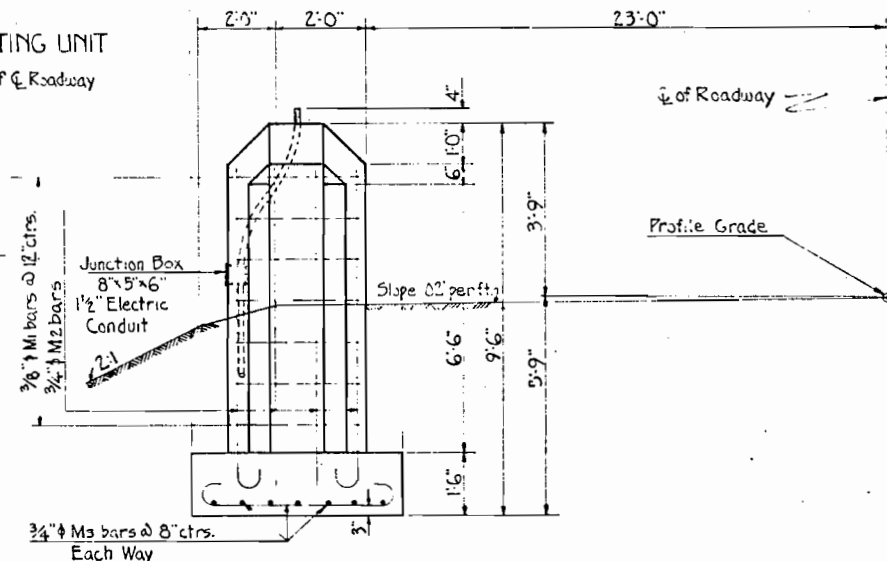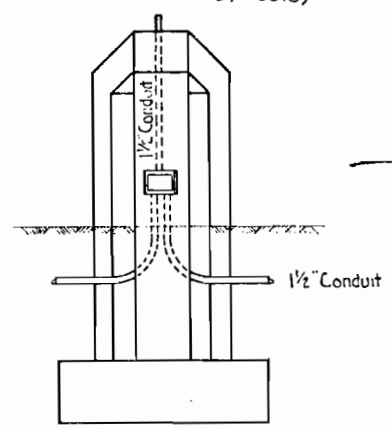

BAR LIST FOR 2 INDEPENDENT LIGHT STANDARD PEDESTALS

Mark	Size	Type	No. Req.	Length	Bending Diagrams
M1	3/8"	I	28	8'-6"	I
M2	3/4"	II	16	8'-6"	II
M3	3/4"	III	28	6'-0"	III

Summary

238 Lin. ft. 3/8" bars @ 0.376 Lbs. per Lin. ft. = 89 Lbs.

304 " " 3/4" " @ 1.502 " " " = 457 "

+1% = for Overrun = 4 "

Total = 550 "

COLORADO
STATE HIGHWAY DEPARTMENT
DETAILS
OF
HANDRAIL FOR NORTH SIDE

Across 7+K.G.W.R.R.

Sta. 33+32.0 to 36+92.71



Near GRANITE JCT. Sec. 15 T. 1-S. R. 1W

Designed by WWP Approved by R. Bailey

Made by L.J.S. Bridge Engineer

Checked by WWP Date: Oct. 2/2/1938

Special Revision for EAGM.19A(1) MSR. 8-31-38
Revised 10-27-38 B.R. Added Splice to top chord joints.
Revised 11-19-38 WND One Sidewalk
Revised 12-26-38 HMM Steel quantities

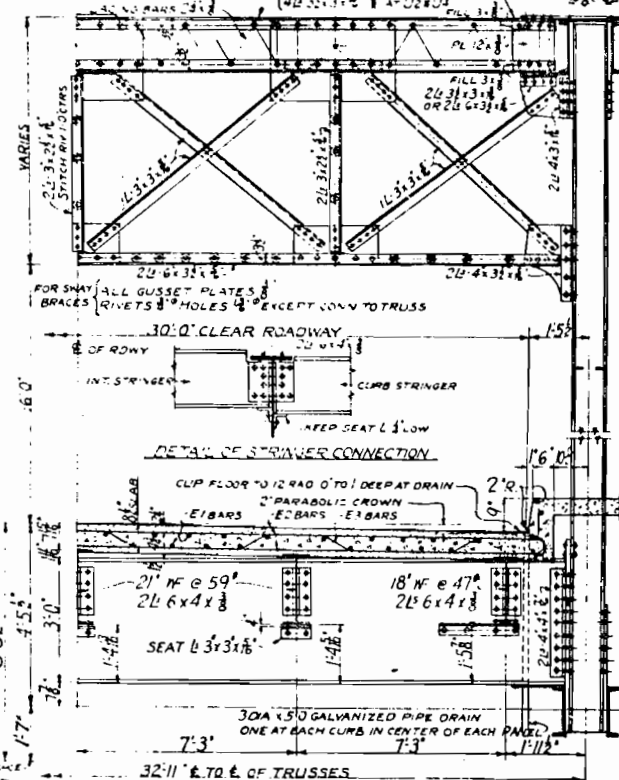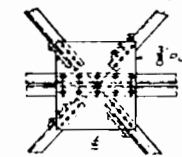

TYPICAL CROSS SECTION

BAR LIST FOR ONE SPAN OF SUPERSTRUCTURE 'BR.

MARK	NO.	SIZE	LENGTH	BENDING DIAGRAM
E1	336	8"	18'-6"	STRAIGHT
E2	406	8"	32'-0"	24'-0"
E3	97	8"	32'-8"	SYMM ABOUT E

22377 LIN FT OF 8" BARS @ 1.043 LBS PER LIN FT = 23339 LBS
PLUS 1% FOR OVERLAP = 261 LBS
TOTAL 23600 LBS

REFERENCE DRAWINGS SEE SHEET NO. 3

LOADING DATA.
LIVE LOAD: A. A. B. H. O. SUR. 1935 CLASS A (1918).
DEAD LOAD: 15 LBS PER SQ. FT. 11' ADDITIONAL WEARING SURFACE WHICH INCLUDES THE 4" IN. CONCRETE HOURLYING WEARING SURFACE.
DESIGN DATA: AASHO 1915 - CONC. UNIT STRESSES AUG. 1928

COLORADO
STATE HIGHWAY DEPARTMENT
150' x 30' STANDARD
STEEL THRU TRUSS
ONE 5' SIDEWALK
ACROSS DE RIVER
Sta. 33+32 To 36+92.71
Near GRAND JUNCTION


Designed by K.B. Approved by C.P. Bailey
Made by W.A.M. Bridge Engineer
Checked by B.R. Date July 14, 1938

GENERAL NOTES
ALL WORK SHALL BE DONE IN ACCORDANCE WITH THE STANDARD SPECIFICATIONS OF THE COLORADO STATE HIGHWAY DEPARTMENT ADOPTED JULY 1 1937.
ALL RIVETS SHALL BE 8" EXCEPT AS NOTED
ALL FIELD CONNECTIONS SHALL BE POWER RIVETED
FABRICATOR SHALL FURNISH ONE PLOT NUT AND ONE DRIVING NUT AS PER SPECIFICATIONS PAGE 196.
STRUCTURAL STEEL QUANTITIES ARE CALCULATED FROM DESIGN PLANS AND ARE THEREFORE APPROXIMATE ONLY
ROADWAY FLOOR SLAB AS SHOWN INCLUDES 8" MONOLITHIC HEARING SURFACE
A VERTICAL CONSTRUCTION JOINT IS REQUIRED TRANSVERSELY IN THE CONCRETE FLOOR ON EACH FLOOR BEAM.
ALL HOLES IN TOP AND BOTTOM CHORD SPICES SHALL BE SUB-PUNCHED 1/8" AND REAMED. ALL HOLES IN FLOOR BEAM AND STRINGER FIELD CONNECTIONS SHALL BE SUB-PUNCHED AND REAMED TO AN IRON TEMPLATE.
FOR GENERAL NOTES ON CONCRETE AND DETAILS OF SUBSTRUCTURE SEE SHEET NO. 3
FIELD PAINT - TWO COATS OF ALLUMINUM.



ESTIMATED QUANTITIES (INCLUDES 1 WALK)

ITEM	DESCRIPTION	UNIT	TRUSS	WALK	TOTAL
460	CLASS 'A' CONCRETE	CYD	129	19	148
47	REINFORCING STEEL (INCLUDES 1/4" DIA. OVERLAP)	LBS	23600	2400	26000
48	STRUCTURAL STEEL (INCLUDES 1/4" DIA. OVERLAP)	LBS	516,160	16,200	532,360
890	DRAIN PIPE (INCLUDES FLANGES)	EACH	16		16

* THIS INCLUDES 5260 LBS FOR CAST STEEL SHOES & 4100 LBS BLAST ROADS

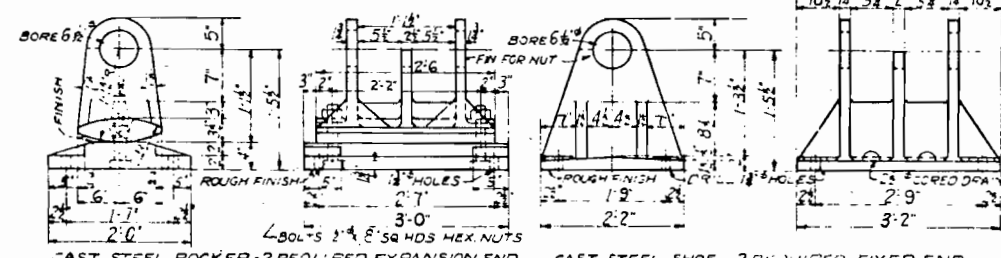

CAST STEEL ROCKER - 2 REQUIRED EXPANSION END
CAST STEEL SHOE - 2 REQUIRED FIXED END

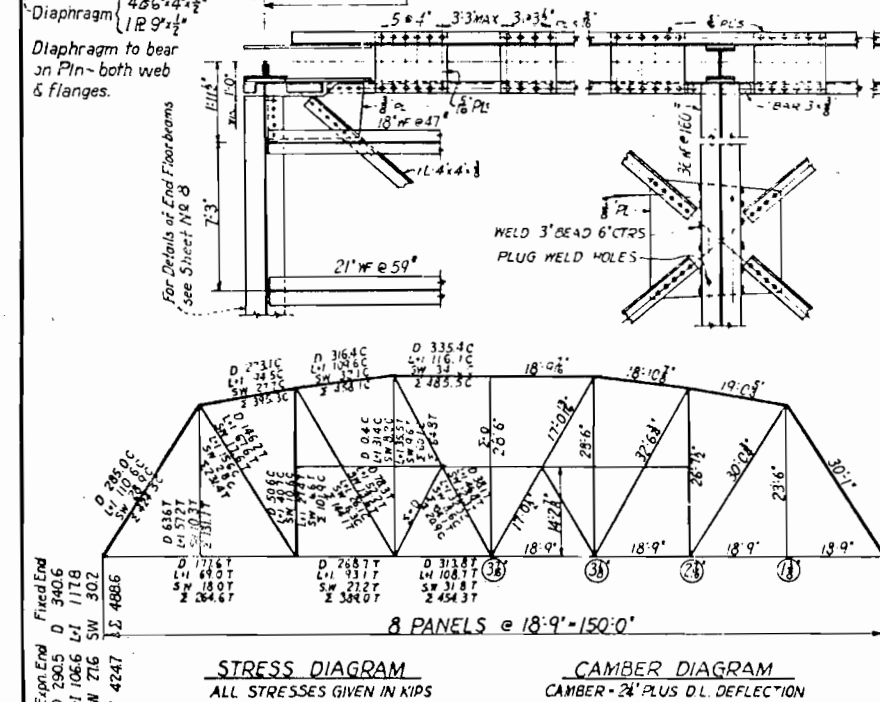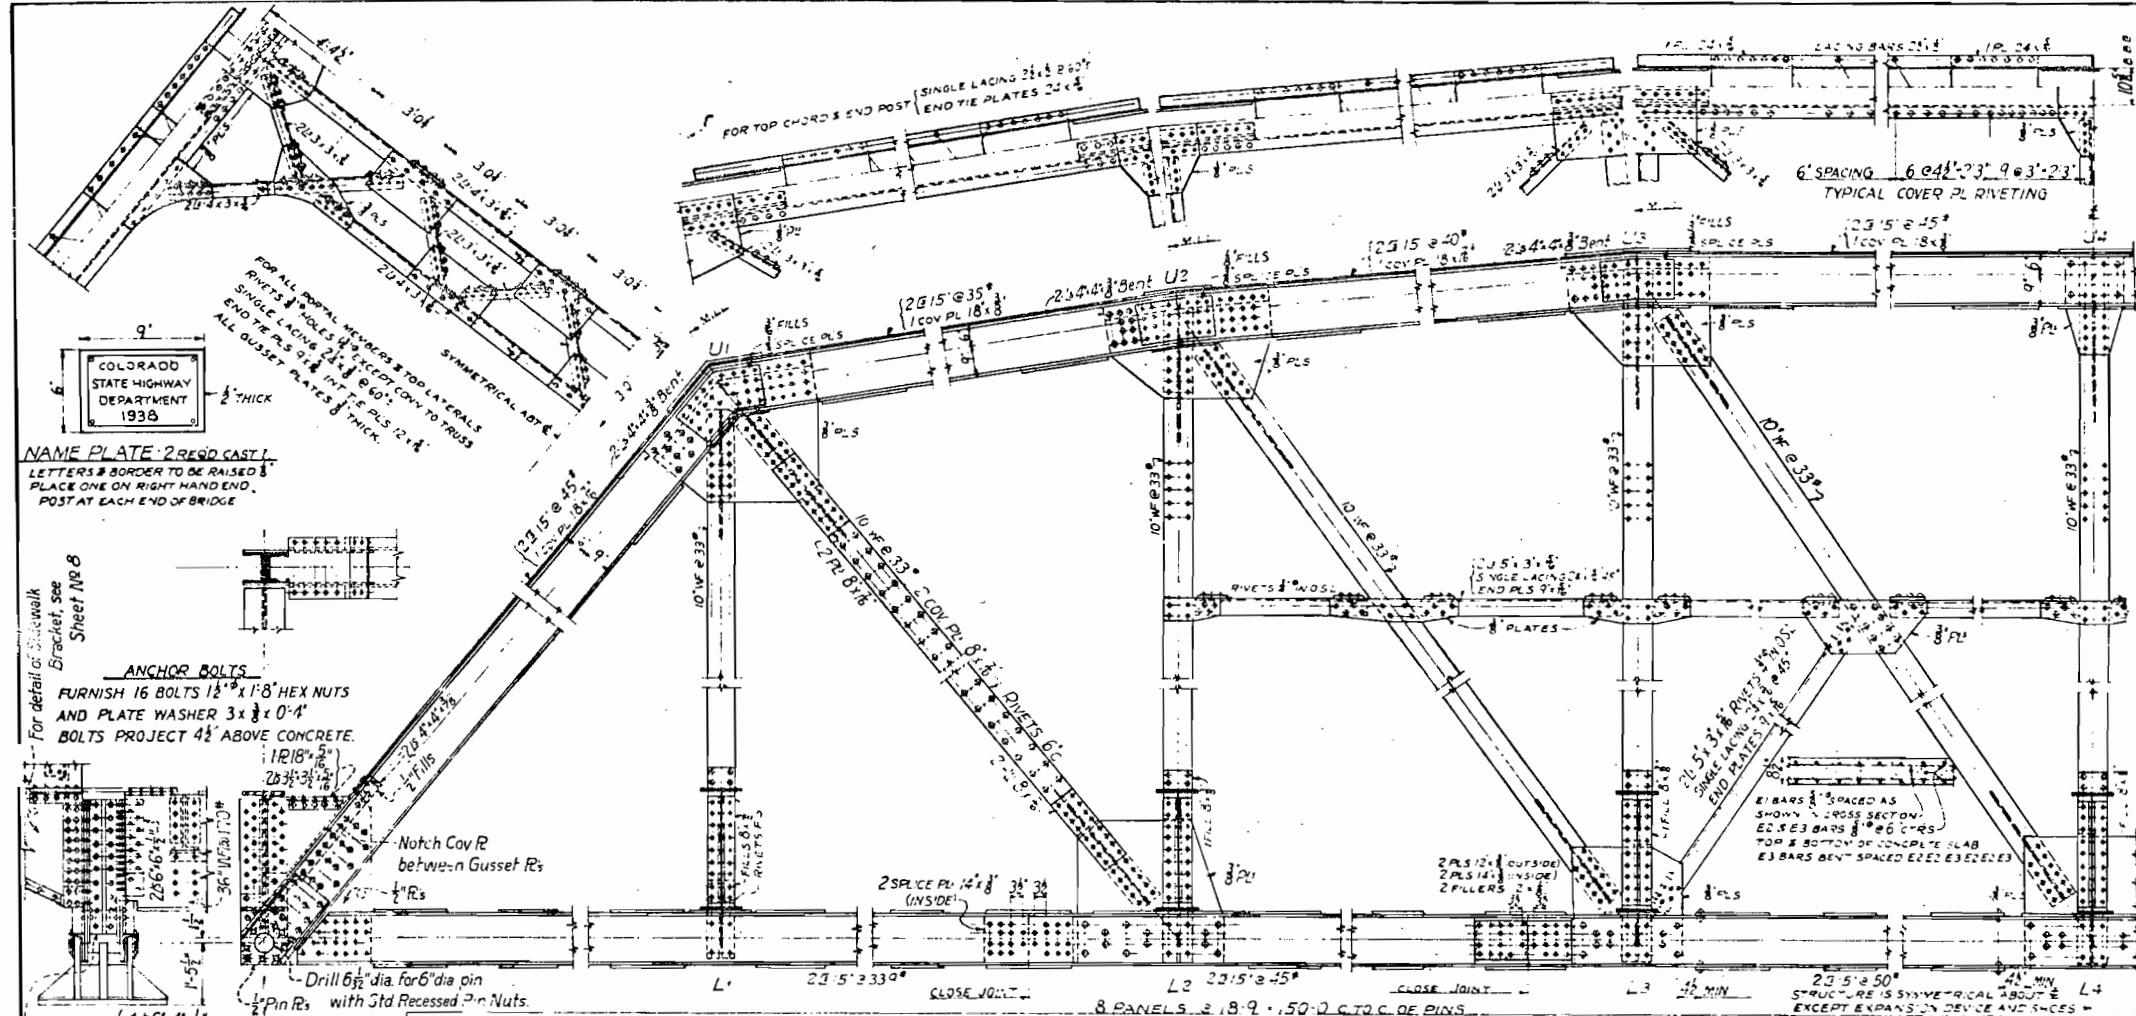


SHEET 2 OF 2

BAR LIST FOR ONE SIDEWALK - ONE 150FT. SPAN			
MARK	SIZE	REQD	LENGTH
S1	$\frac{3}{8}$ "	596	7'-11"
S2	$\frac{3}{8}$ "	80	18'-6"


BENDING DIAGRAM

STRAIGHT

6199 LIN. FT. OF $\frac{3}{8}$ " BARS @ 0.376 LBS. PER LIN. FT. = 2331 LBS.
 PLUS 1% FOR OVERRUN = 69 LBS.
 TOTAL = 2400 LBS.

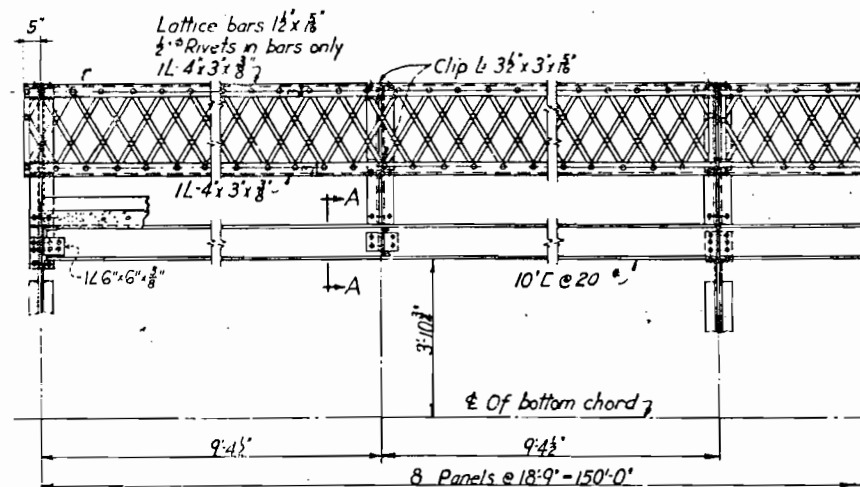


DETAIL OF SIDEWALK FOR SOUTH TRUSS

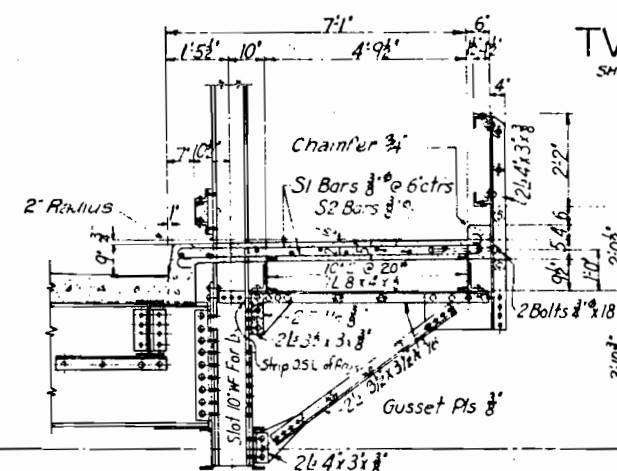


INTERMEDIATE BRACKET


All rivets in bracket $\frac{3}{4}$ " ϕ except
bracket to truss which are $\frac{7}{8}$ " ϕ

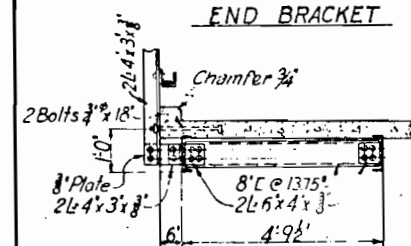

SECTION-A-A

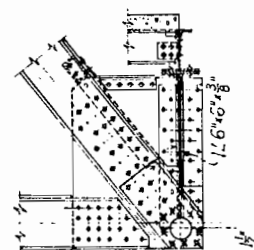


SECTION E-E

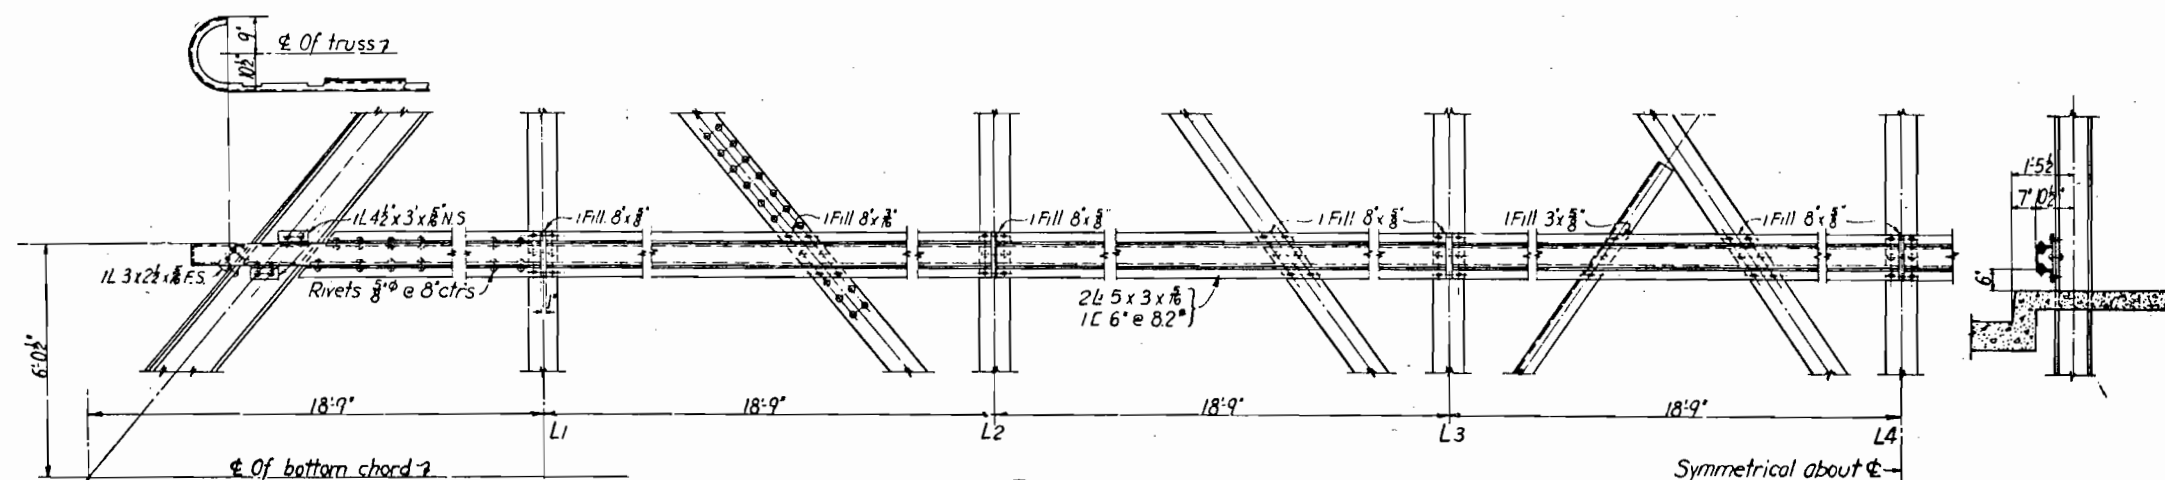


DETAIL OF GUARD RAIL FOR SOUTH TRUSS




VIEW B-B

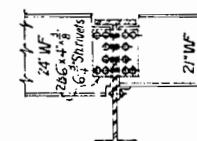

VIEW C-C

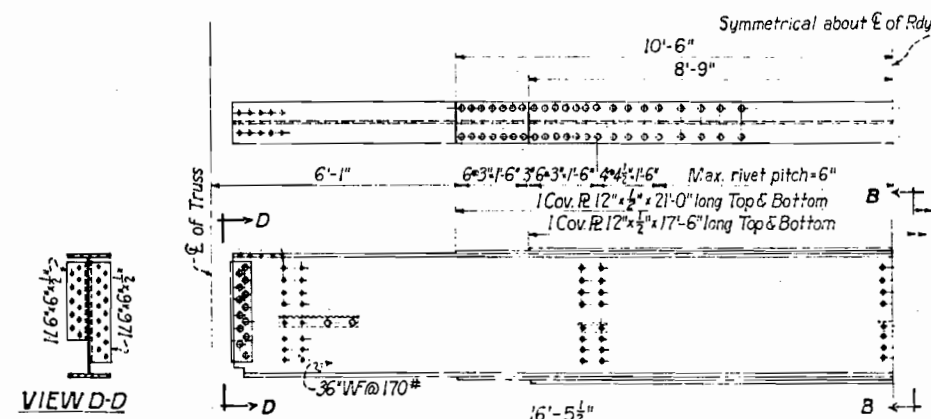

DETAIL OF END FLOORBEAM AT FIXED END OF TRUSS

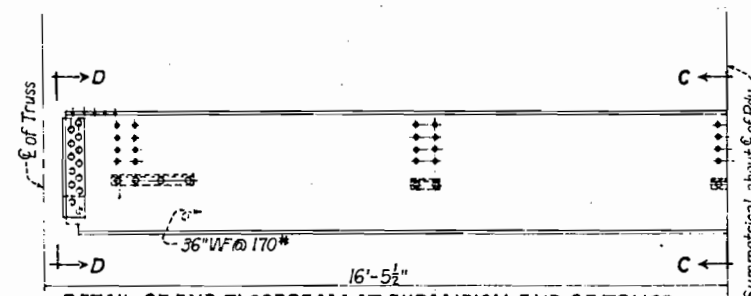

DETAIL OF END FLOORBEAM AT EXPANSION END OF TRUSS

Rivets $\frac{7}{8}" \phi$ except as noted.
All handrail and guard rail field connections to be
 $\frac{3}{4}" \phi$ bolts in $1\frac{1}{2}" \times 1\frac{1}{2}"$ slotted holes
A $\frac{3}{4}"$ space shall be left around all truss members
in concrete sidewalk.
A vertical construction joint is required transversely
in concrete sidewalk and curb over each bracket

Exposed concrete edges shall be chamfered.

REFERENCE DRAWINGS SEE SHEET NO 3

LOADING DATA.
LIVE LOAD A A. S. M. O. 1938 CLASS A. M-18'
DEAD LOAD ASSUMES 15 LBS PER SQ. FT. ADDITIONAL WEARING SURFACE WHICH INCLUDES THE 1/2 INCH CONCRETE MONOLITHIC WEARING SURFACE SHOWN.

DESIGNING DATA.
A A S H O 1235 EXCEPT CONCRETE UNIT STRESS
PER A A S H O AUG 1928

COLORADO
STATE HIGHWAY DEPARTMENT
150 FT. SPAN STEEL THRU TRUSS
30 FT. CLEAR ROADWAY
ONE 5 FT. SIDEWALK

Across D & RGW RR
Sta. 33 + 32 To 36 + 92.71
Near Grand Junction Sec. 15 T. 13 R. 1 W.

Designed by M.F.M. Approved by P. J. Bantley
Made by W.M.M. Bridge Engineer
Checked by BR Date: July 14th 1938

FED. ROAD DIST. NO.	STATE	F.A.G.M.	SHEET NO.	TOTAL SHEETS
3	COLO.	19-A(1)	9	

BAR LIST FOR ABUTMENT NO. 1, J.F.A.V.

Mark	Size	No. Req.	Length	Type	l	m	n	p	r	t
F1	3/8"	26	17'-4"	I	15'-0"				3 1/2"	3"
F2	3/8"	32	10'-10"	I	8'-10"				3"	2 1/2"
F3	1"	4	15'-2"	II	8'-3"	1'-0"	2'-1"	3'-3"	4"	3 1/2"
F4	1"	4	20'-2"	II	13'-3"	1'-0"	2'-1"	3'-3"	4"	3 1/2"
F5	1"	6	28'-5"	II	21'-6"	1'-0"	2'-1"	3'-3"	4"	3 1/2"
F6	1 1/2"	14	34'-10"	II	26'-3"	1'-9"	2'-5"	3'-10"	4 1/2"	4"
F7	1"	6	13'-3"	I	10'-7"				4"	3 1/2"
F8	1"	8	18'-0"	I	15'-4"				4"	3 1/2"
F9	1"	8	16'-0"							
F10	1"	8	30'-0"	III	28'-8"				4"	3 1/2"
F11	1"	4	16'-2"	III	14'-10"				4"	3 1/2"
F12	1 1/2"	24	14'-2"	IV	4'-7 1/2"	2'-1 1/2"			4"	4"
F13	1 1/2"	28	11'-2"	IV	3'-1 1/2"	2'-1 1/2"			4"	4"
F14	1 1/2"	14	9'-4"	IV	2'-2 1/2"	2'-1 1/2"			4"	4"
F15	3/8"	16	12'-3"	V	6'-2"	4'-11"	1'-10"		3 1/2"	3"
F16	3/8"	4	12'-0"	V	7'-8"	3'-3 1/2"	1'-2 1/2"		3"	2 1/2"
F17	3/8"	4	11'-10"	V	9'-3"	1'-7 1/2"	7"		3"	2 1/2"
F18	3/8"	4	11'-8"	III	10'-8"				3"	2 1/2"
F19	3/8"	14	12'-0"	VI	2'-4"	3'-9 1/2"	1'-9 1/2"		3"	2 1/2"
F20	3/8"	2	11'-10"	VI	3'-8"	3'-0 1/2"	1'-4 1/2"		3"	2 1/2"
F21	3/8"	2	11'-7"	VI	5'-0"	2'-3 1/2"	1'-1"		3"	2 1/2"
F22	3/8"	2	11'-5"	VI	6'-4"	1'-6 1/2"	0'-8 1/2"		3"	2 1/2"
F23	3/8"	2	11'-2"	VI	7'-8"	0'-9 1/2"	0'-4 1/2"		3"	2 1/2"
F24	3/8"	2	10'-10"	I	8'-10"				3"	2 1/2"
F25	1"	16	26'-8"	I	24'-0"				4"	3 1/2"
F26	1"	21	8'-2"	IV	1'-7 1/2"	2'-1 1/2"			4"	3 1/2"
F27	1"	6	13'-9"	VII	2'-3"	5'-9"			4"	3 1/2"
F28	1"	16	19'-4"	I	16'-8"				4"	3 1/2"
F29	1"	8	15'-6"	I	12'-10"				4"	3 1/2"
F30	1"	4	25'-8"	I	23'-0"				4"	3 1/2"
F31	1"	8	29'-8"	I	27'-0"				4"	3 1/2"
F32	1 1/2"	46	9'-3"	VIII	4'-4"	7"			2 1/2"	2"
F33	1 1/2"	8	6'-10"						2 1/2"	4"
F34	1 1/2"	4	36'-0"							
F35	3/8"	8	9'-10"	IX	3'-9"	5'-3"	2'-8 1/2"			
F36	3/8"	8	13'-8"	IX	4'-1"	2'-5"				
F37	3/8"	53	10'-8"	IX	2'-7"	2'-5"				

BENDING DIAGRAMS

BAR SUMMARY FOR ABUTMENT NO. 1

488	Lin. Ft.	- 1/8"	@ 4.303 Lbs. Per Ft.	= 2100 Lbs.
2252	"	- 1"	@ 3.400 "	= 7657 "
648	"	- 3/8"	@ 2.044 "	= 1325 "
770	"	- 1/2"	@ 1.502 "	= 1157 "
754	"	- 5/8"	@ 1.043 "	= 786 "
1580	"	- 1/4"	@ 0.850 "	= 1343 "

14368 "

Plus 1% for Overrun = 132 "

TOTAL = 14500 LBS.



REFERENCE DRAWINGS
For List See Sheet No. 3.

COLORADO
STATE HIGHWAY DEPARTMENT
GRAND AVE. VIADUCT
DETAILS OF ABUTMENT NO. 1.

Across D.R.G.W.R.R.
Sta. 33+32.0 to 36+92.71
Near GRAND JCTN. Sec. 15, T. 1-S. R. 1-W.

Designed by WND Approved by P.J. Bailey
Made by J.A.V. Bridge Engineer
Checked by R.S.S. Date: Oct 5th, 1938.

STRUCTURE NO. H-2-N.

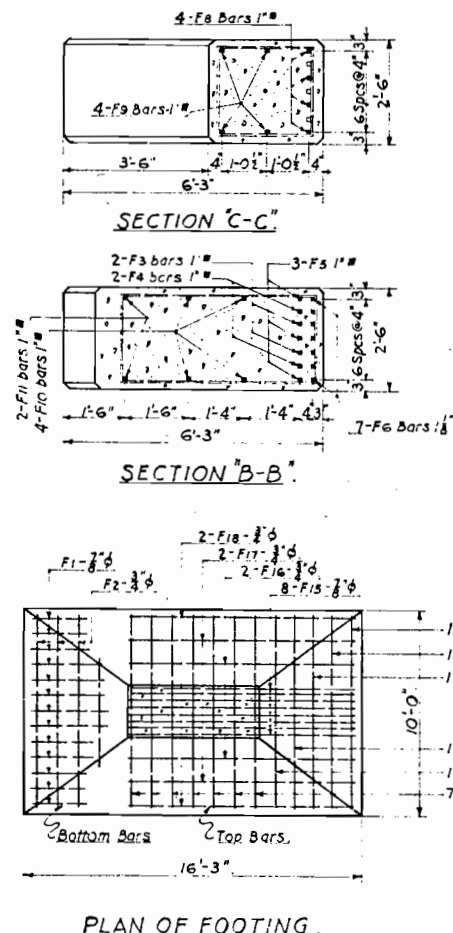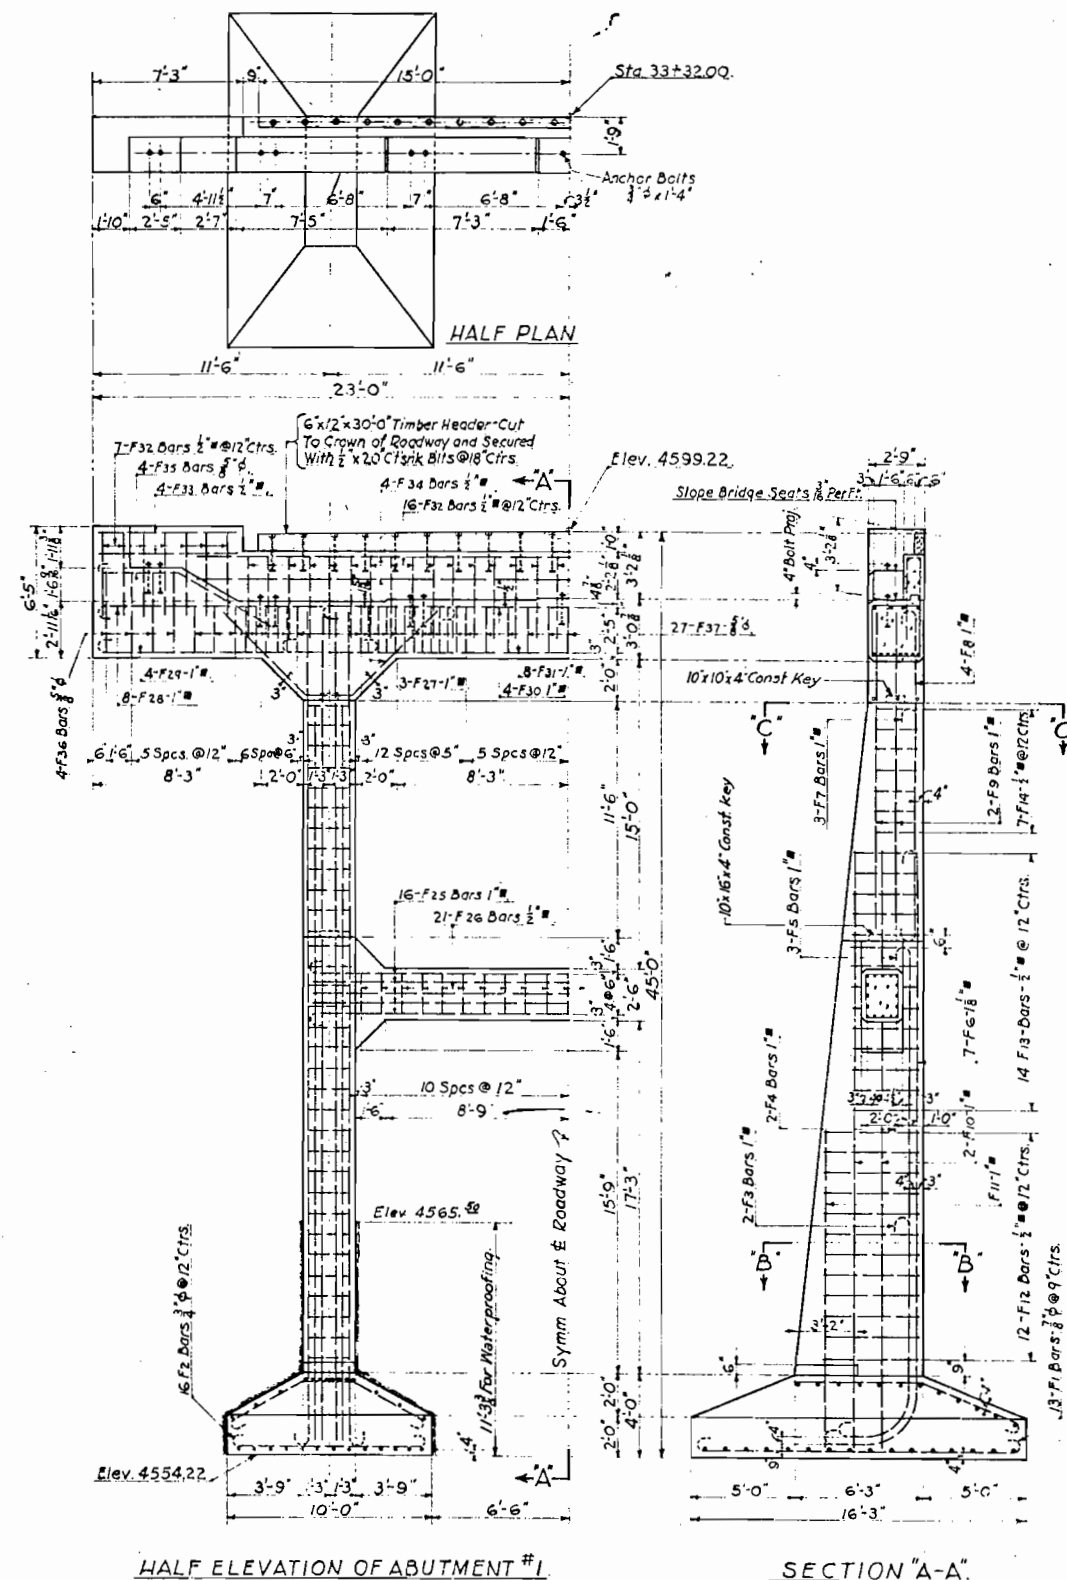


Designed By	Initial	Date
W.W.D.	W.W.D.	9/21/38
Checked By	Initial	Date
W.W.D.	W.W.D.	9/21/38
A.L.F.	A.L.F.	9/21/38
J.A.V.	J.A.V.	9/21/38
R.S.S.	R.S.S.	9/21/38

FED. ROAD DIST. NO.	STATE	F.A.G.M.	SHEET NO.	TOTAL SHEETS
3	COLO.	19-A-1	10	

BAR LIST FOR PIERS No. 2, 3 & 4.

Mark	Size	Wt. Req'd	Length	Type	ℓ	m	r	t
P1	1 1/2"	10	17'-5"	II	14'-5"			4 1/2"
P2	1 1/2"	6	37'-2"	I	17'-9"	12'-5"		4 1/2"
P3	1 1/2"	2	26'-10"	II	23'-10"			4 1/2"
P4	1 1/2"	2	25'-8"					4 1/2"
P5	1 1/2"	4	14'-8"	III	13'-4"			4 1/2"
P6	1 1/2"	18	11'-10"					2'-9 1/2"
P7	1 1/2"	127	12'-0"	V	2'-11 1/2"	2'-0 1/2"		
P8	1 1/2"	128	10'-6"	V	2'-11 1/2"	2'-0 1/2"		
P9	1 1/2"	12	38'-2"	I	18'-4"	12'-10"		4 1/2"
P10	1 1/2"	4	27'-7"	II	22'-7"			4 1/2"
P11	1 1/2"	20	17'-10"	II	14'-10"			4 1/2"
P12	1 1/2"	8	14'-11"	III	13'-7"			4 1/2"
P13	1 1/2"	4	26'-1"					4 1/2"
W1	3/8"	132	8'-7"	II	6'-11"			2 1/2"
W2	1 1/2"	72	7'-11"	III	6'-7"			4 1/2"
L3	1 1/2"	10	27'-9"	II	25'-1"			4 1/2"
L1	1 1/2"	48	40'-0"					
L2	1 1/2"	24	16'-0"					
L10	1 1/2"	66	7'-0"	I	1'-7 1/2"	1'-7 1/2"		
L11	1 1/2"	6	7'-0"	I	1'-7 1/2"	1'-7 1/2"		
L10	1 1/2"	6	9'-2 1/2"	I	by 7/16 to 2'-2 1/2"	by 7/16 to 2'-2 1/2"		
L4	1 1/2"	20	28'-6"	II	25'-10"			4 1/2"

BENDING DIAGRAMS


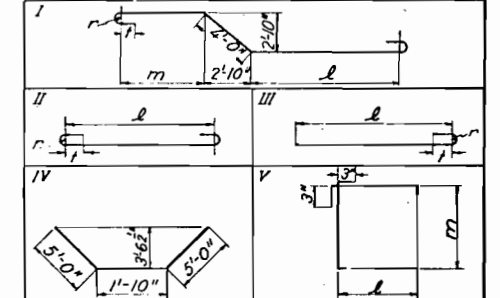


BAR SUMMARY FOR PIER NO. 2	
451 Lin ft. of 1 1/2" @ 4.303 lb. per lin. ft.	= 1941 lb.
1417 " " " 1 1/2" @ 2.670 " " "	= 3783 "
378 " " " 3/8" @ 1.043 " " "	= 394 "
1066 " " " 1/2" @ 0.850 " " "	= 906 "
583 " " " 1/2" @ 0.668 " " "	= 389 "
Plus 1% for Overrun	= 77 "
Total	= 7490 lb.
BAR SUMMARY FOR PIER NO. 3	
463 Lin ft. of 1 1/2" @ 4.303 lb. per lin. ft.	= 1992 lb.
1426 " " " 1 1/2" @ 2.670 " " "	= 3807 "
378 " " " 3/8" @ 1.043 " " "	= 394 "
1132 " " " 1/2" @ 0.850 " " "	= 962 "
583 " " " 1/2" @ 0.668 " " "	= 389 "
Plus 1% for Overrun	= 76 "
Total	= 7620 lb.

For REFERENCE DRAWINGS
See Sheet No. 3

COLORADO
STATE HIGHWAY DEPARTMENT
GRAND AVE
VIADUCT
DETAILS OF PIERS NO. 2, 3 & 4.
Across D & R. G. W. R. R.
Sta. 33+32.00 to 36+92.71
Near GRAND UCT. Sec. 15 T. 1 S. R. 1 W.
Designed by K.B. Approved by P. J. H. H. H.
Made by D.M.D. Bridge Engineer
Checked by Date: Oct 30, 1938.

STRUCTURE NO. H-2-N.

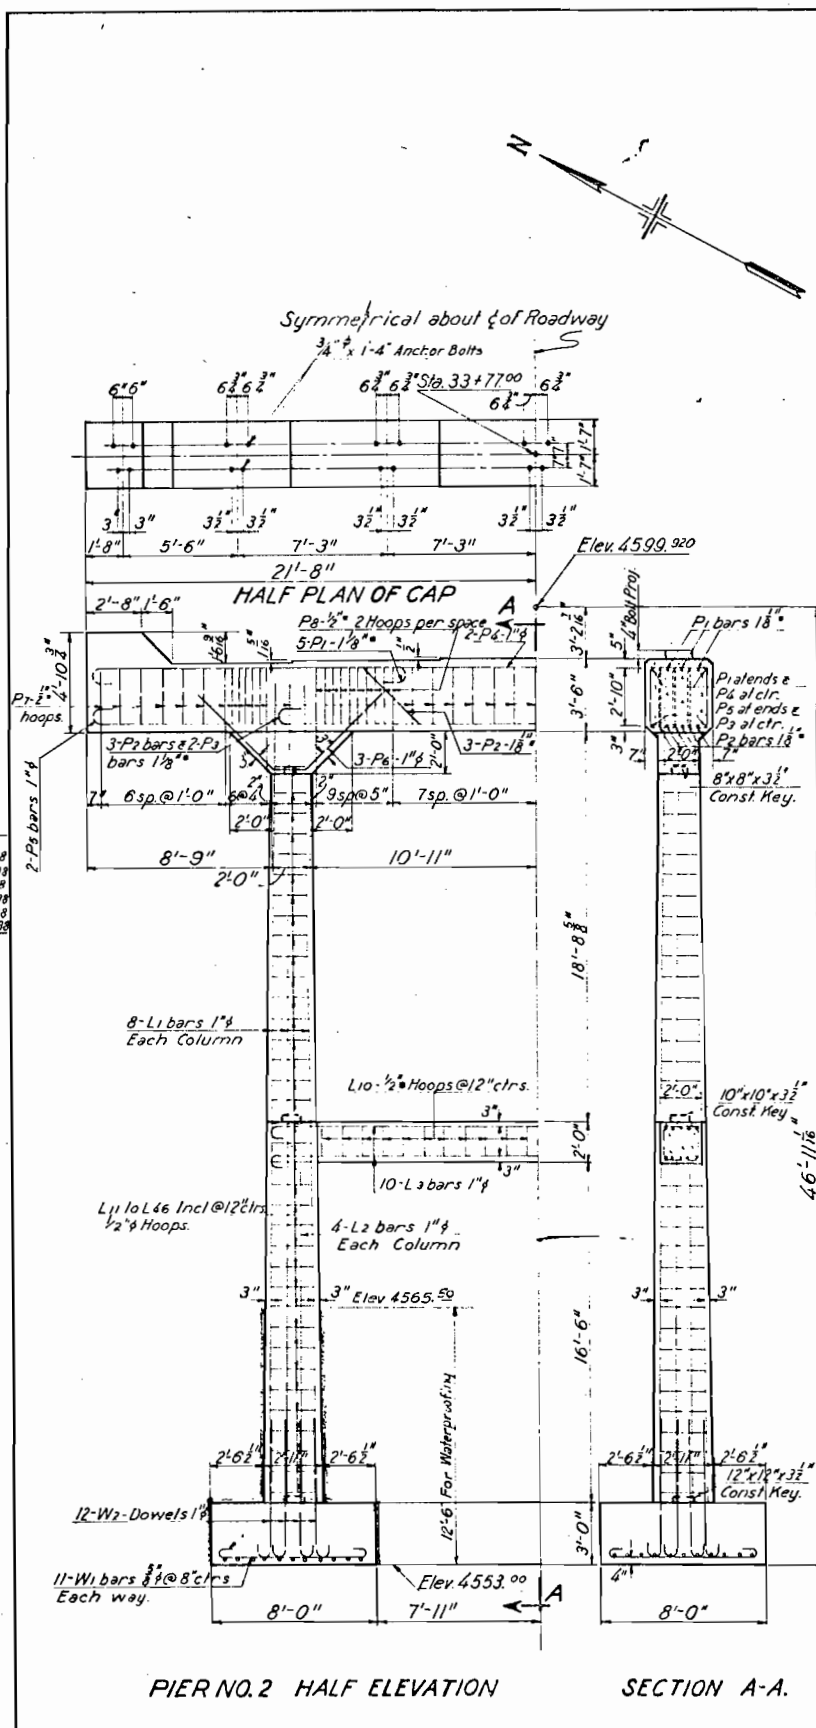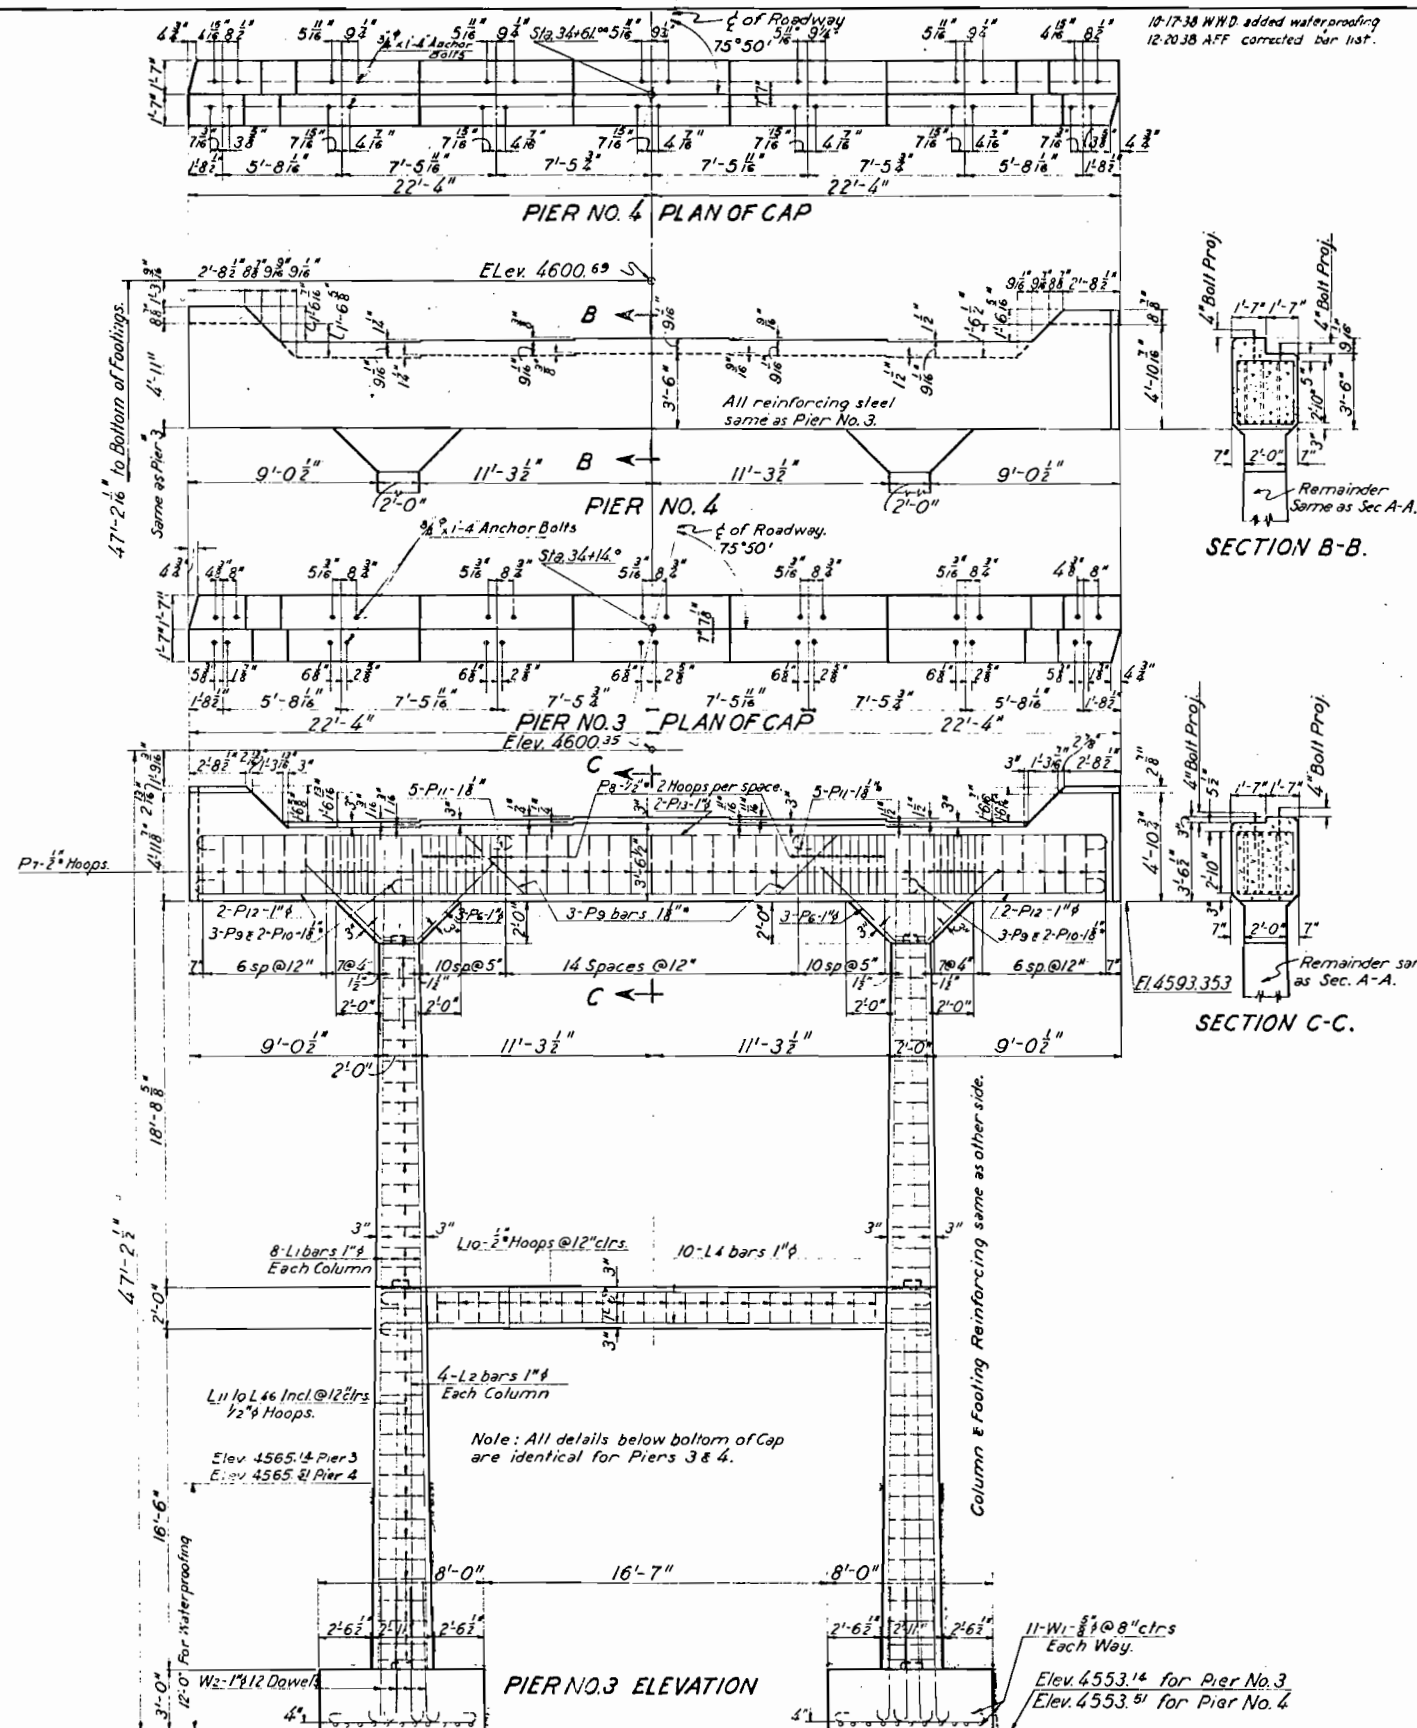

Designed By	Initial	Date
Checked By	K.B.	9-1-38
Drawn By	A.L.F.	9-20-38
Traced By	K.B.	9-28-38
Checked By	A.L.F.	9-20-38
Checked By	D.M.D.	9-28-38

FED. ROAD DIST. NO.	STATE	F.A.G.M.	SHEET NO.	TOTAL SHEETS
3	COLO.	19-A(1)	11	




BAR LIST FOR PIER NO. 5 (PIER NO. 6 IS SAME)										A.O.C.
MARK	SIZE	NO. REQD.	LENGTH	l	m	r	t	TYPE	SUMMARY FOR PIER NO. 5 (PIER NO. 6 IS SAME)	
L ₆	1"*	24	35'-0"					Str.	1952 Lin. Ft. of 1" bars @ 3.400 Lb. per Lin. Ft. = 6637 Lb.	
L ₇	1"*	8	12'-0"					Str.	847 " " " 3/8" " " 1.043 " " " = 883 "	
L ₈	1"*	8	37'-8"	35'-0"		4"	3 1/2"	I	1824 " " " 1/2" " " 0.850 " " " = 1550 "	
L ₉	1/2"*	8	36'-4"	35'-0"		2"	2"	I	+1% For over run = 90 "	
L ₁₀	1/2"*	29	14'-0"	5'-7 1/2"	1'-1 1/2"			II	TOTAL = 9160 "	
L ₄₁			10'-4"	2'-5 1/2"	2'-5 1/2"					
L ₁₀	1/2"*	2 Each	by 1 1/2" to 14'-1"	by 3/8" to 3'-4 1/2"	by 3/8" to 3'-4 1/2"			II		
L ₇₁										
P ₂₀	1"*	8	38'-9"	36'-7"		4"	3 1/2"	I		
P ₂₁	1"*	12	11'-6"					III		
P ₂₂	1/2"*	37	10'-0"	3'-1 1/2"	1'-7 1/2"			II		
W ₅	5/8"*	80	10'-7"	8'-11"		2 1/2"	2"	I		
W ₆	1"*	32	8'-4"					IV		

I


II

III


IV

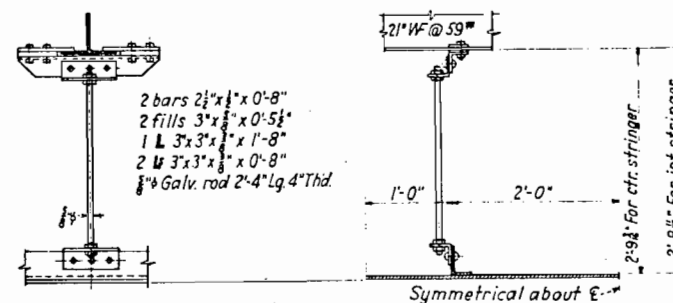


TYPICAL HANGER DETAIL

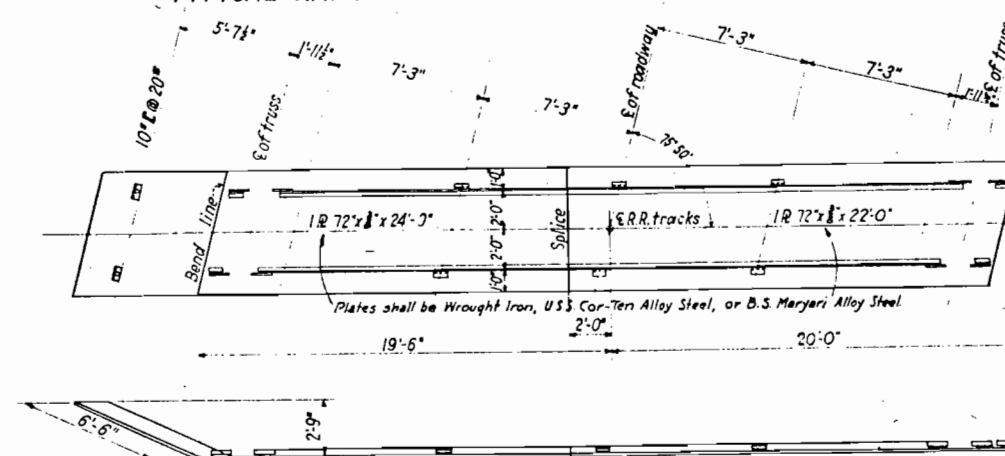


TYPICAL DETAIL OF BLAST PLATES-NINE REQUIRED

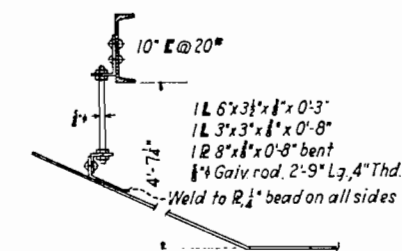

CONN. TO SIDEWALK STRINGER

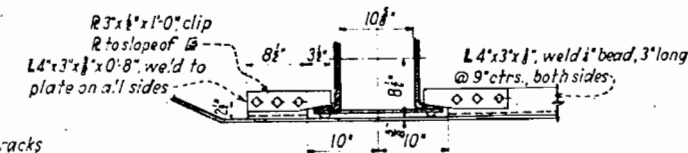

BLAST PLATE CONN. TO TRUSS

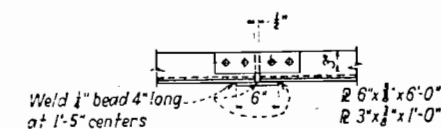

SPLICE DETAIL

REFERENCE DRAWINGS
For list of reference drawing see sheet No.3

COLORADO
STATE HIGHWAY DEPARTMENT
GRAND AVE. VIADUCT
DETAILS OF
PIER NO. 5 & PIER NO. 6
DETAILS OF BLAST BOARDS

Across D & R G W R R
Sta. 33+32.0 to 36+92.71
Near GRAND JCT. Sec. 15 T. 15 R. 1 W

Designed by <u>K.R.W.D.</u>	Approved by <u>G.D. Bailey</u>
Made by <u>A.Y.F.</u>	Bridge Engineer
Checked by <u>H.W.P.</u>	Date: <u>Oct. 5th, 1938.</u>

STRUCTURE NO. H-2-N

FED. ROAD DIST. NO.	STATE	F.A.G.M.	SHEET NO.	TOTAL SHEETS
3	COLO.	19A(1)	12	

BAR LIST FOR ABUTMENT No 7

MARK	SIZE	REQD	LENGTH	TYPE	l	m	n	o	r	t	BENDING DIAGRAMS
G1	1" ϕ	26	19'-4"	I	16'-8"				4'	3 1/2'	TYPE I
G2	3/8"	36	11'-1"	I	8'-9"				3 1/2'	3'	
G3	1/2"	4	15'-0"	II	7'-9"	1'-0"	2'-1"	3'-3"	4 1/2'	4'	
G4	1/2"	4	21'-0"	II	13'-9"	1'-0"	2'-1"	3'-3"	4 1/2'	4'	
G5	1/2"	6	27'-9"	II	20'-6"	1'-0"	2'-1"	3'-3"	4 1/2'	4'	
G6	1/2"	14	33'-10"	II	25'-3"	1'-9"	2'-5"	3'-0"	4 1/2'	4'	
G7	1/2"	6	11'-6"	I	8'-6"				4 1/2'	4'	
G8	1/2"	8	16'-6"	I	13'-6"				4 1/2'	4'	
G9	1"	8	14'-0"	STR.							TYPE II
G10	1"	8	28'-0"	"							
G11	1"	4	19'-6"	"							
G12	1"	4	10'-6"	"							
G13	1/2"	14	16'-2"	IV	5'-7 1/2"	2'-1 1/2"				4'	TYPE III
G14	1/2"	18	13'-8"	IV	4'-4 1/2"	2'-1 1/2"				4'	
G15	1/2"	16	11'-2"	IV	3'-1 1/2"	2'-1 1/2"				4'	
G16	1/2"	10	9'-4"	IV	2'-2 1/2"	2'-1 1/2"				4'	
G17	1"	16	13'-4"	V	6'-9"	5'-3"	1'-9"		4'	3 1/2'	
G18	3/8"	4	13'-2"	V	8'-6"	3'-6"	1'-2"		3 1/2'	3'	
G19	3/8"	4	13'-2"	V	10'-3"	1'-9"	0'-7"		3 1/2'	3'	TYPE IV
G20	3/8"	4	13'-2"	III	12'-0"				3 1/2'	3'	
G21	3/8"	14	11'-11"	VI	2'-3"	3'-8"	1'-9"		3 1/2'	3'	
G22	3/8"	2	11'-10"	VI	3'-8"	2'-11"	1'-5"		3 1/2'	3'	TYPE V
G23	3/8"	2	11'-7"	VI	4'-11"	2'-2"	1'-1"		3 1/2'	3'	
G24	3/8"	2	11'-5"	VI	6'-3"	1'-5"	0'-8"		3 1/2'	3'	
G25	3/8"	2	11'-5"	VI	7'-7"	0'-9"	0'-4"		3 1/2'	3'	
G26	3/8"	2	11'-1"	I	8'-9"				3 1/2'	3'	
G27	1"	16	27'-4"	I	24'-8"				4'	3 1/2'	
G28	1/2"	21	8'-2"	IV	1'-7 1/2"	2'-1 1/2"				4'	TYPE VI
G29	1"	6	13'-9"	VII	2'-3"	5'-9"	4'-0 1/2"				
G30	1/2"	8	19'-8"	I	16'-8"				4 1/2'	4'	
G31	1"	8	19'-4"	I	16'-8"				4'	3 1/2'	
G32	1"	8	15'-6"	I	12'-10"				4'	3 1/2'	
G33	1"	4	26'-2"	I	23'-6"				4'	3 1/2'	TYPE VII
G34	1/2"	4	30'-6"	I	27'-6"				4 1/2'	4'	
G35	1"	4	30'-2"	I	27'-6"				4'	3 1/2'	
G36	3/8"	8	14'-6"	IV	4'-6"	2'-5"				4'	
G37	3/8"	60	11'-4"	IV	2'-11"	2'-5"				4'	
G38	1/2"	46	11'-7"	VIII	5'-6"	0'-7"					TYPE VIII
G39	3/8"	8	9'-4"	IX	3'-6"	5'-0"			2 1/2'	2'	
G40	1/2"	12	6'-9"	STR.							TYPE IX
G41	1/2"	6	36'-0"	"							

1265 LIN. FT. 1/2" ϕ @ 4303#/FT. = 5443 LBS.
 1480 " " 1" ϕ @ 3400#/FT. = 5032 " "
 716 " " 1" ϕ @ 2670#/FT. = 1912 " "
 839 " " 3/8" ϕ @ 2044#/FT. = 1715 " "
 871 " " 3/8" ϕ @ 1043#/FT. = 908 " "
 1746 " " 1/2" ϕ @ 0.850#/FT. = 1484 " "
 1% OVERRUN = 166 " "
 TOTAL = 16660 LBS.



REFERENCE DRAWINGS
 FOR REFERENCE DRAWINGS SEE SHEET 3

COLORADO
 STATE HIGHWAY DEPARTMENT
 GRAND AVE. VIADUCT
 DETAILS OF ABUTMENT No 7

Across D & R.G.W. RR
 Sta. 33+32.0 to 36+92.0
 Near GRAND JUNCTION, CO. 19-115 R.1W.

Designed by W.D. Approved by P.D. Bailey
 Made by C.B.M. Bridge Engineer
 Checked by Date: Oct 5, 1938

STRUCTURE NO. **H-2-N**

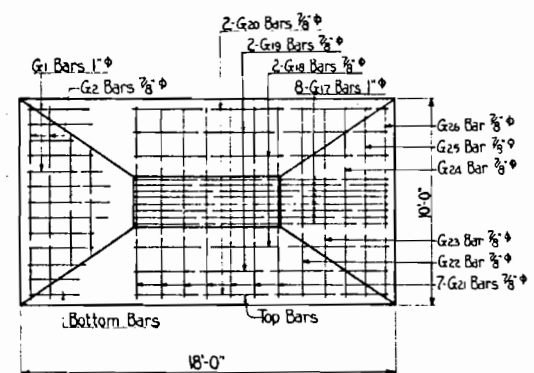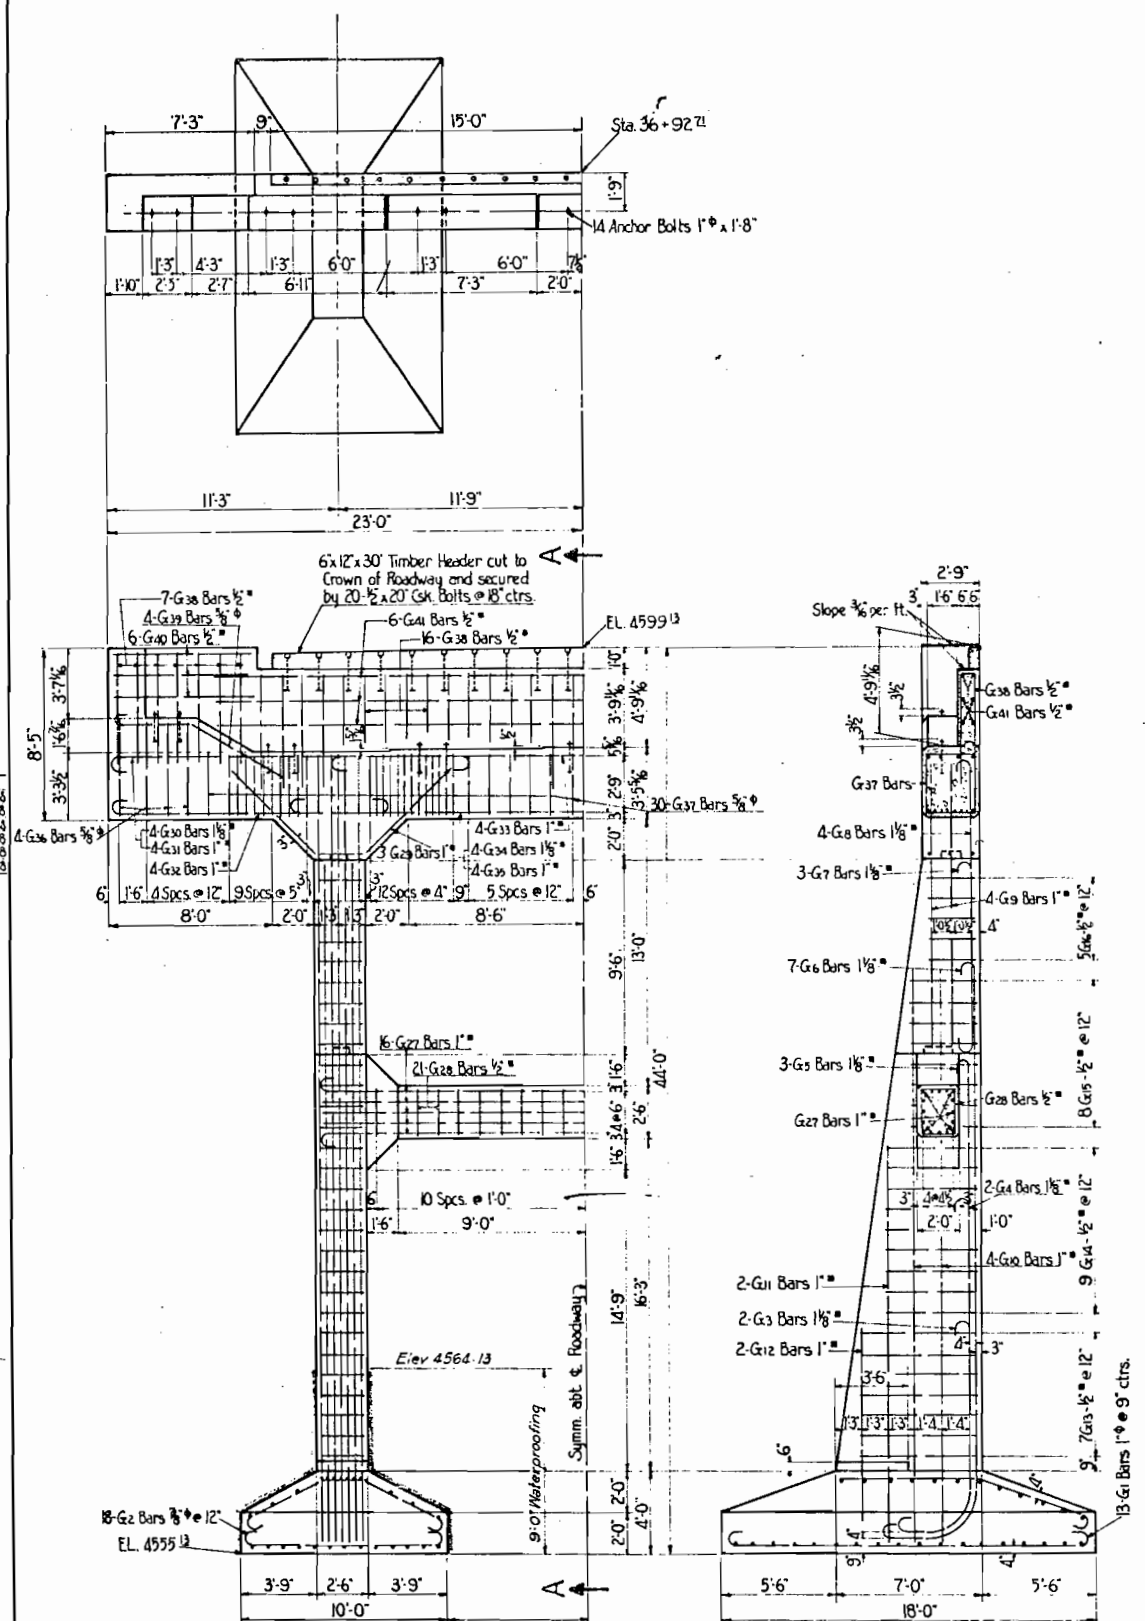

HALF ELEVATION OF ABUTMENT No 7


SECTION A-A

PLAN OF FOOTING



	Initial	Date
Designed By	W.W.D.	9-10-38
Checked By	H.W.P.	9-21-38
Drawn By	W.W.D.	9-18-38
Checked By	H.W.P.	9-21-38
Traced By	C.B.M.	9-27-38
Checked By	H.W.P.	9-28-38

Rev 10-26-38 N.W.D. Slab thickness.
Rev 1-10-39 N.W.D. Copper Seal.

FED. ROAD DIST. NO.	STATE	F.A.G.M.	SHEET NO.	TOTAL SHEETS
3	COLO.	19-A(1)	14	

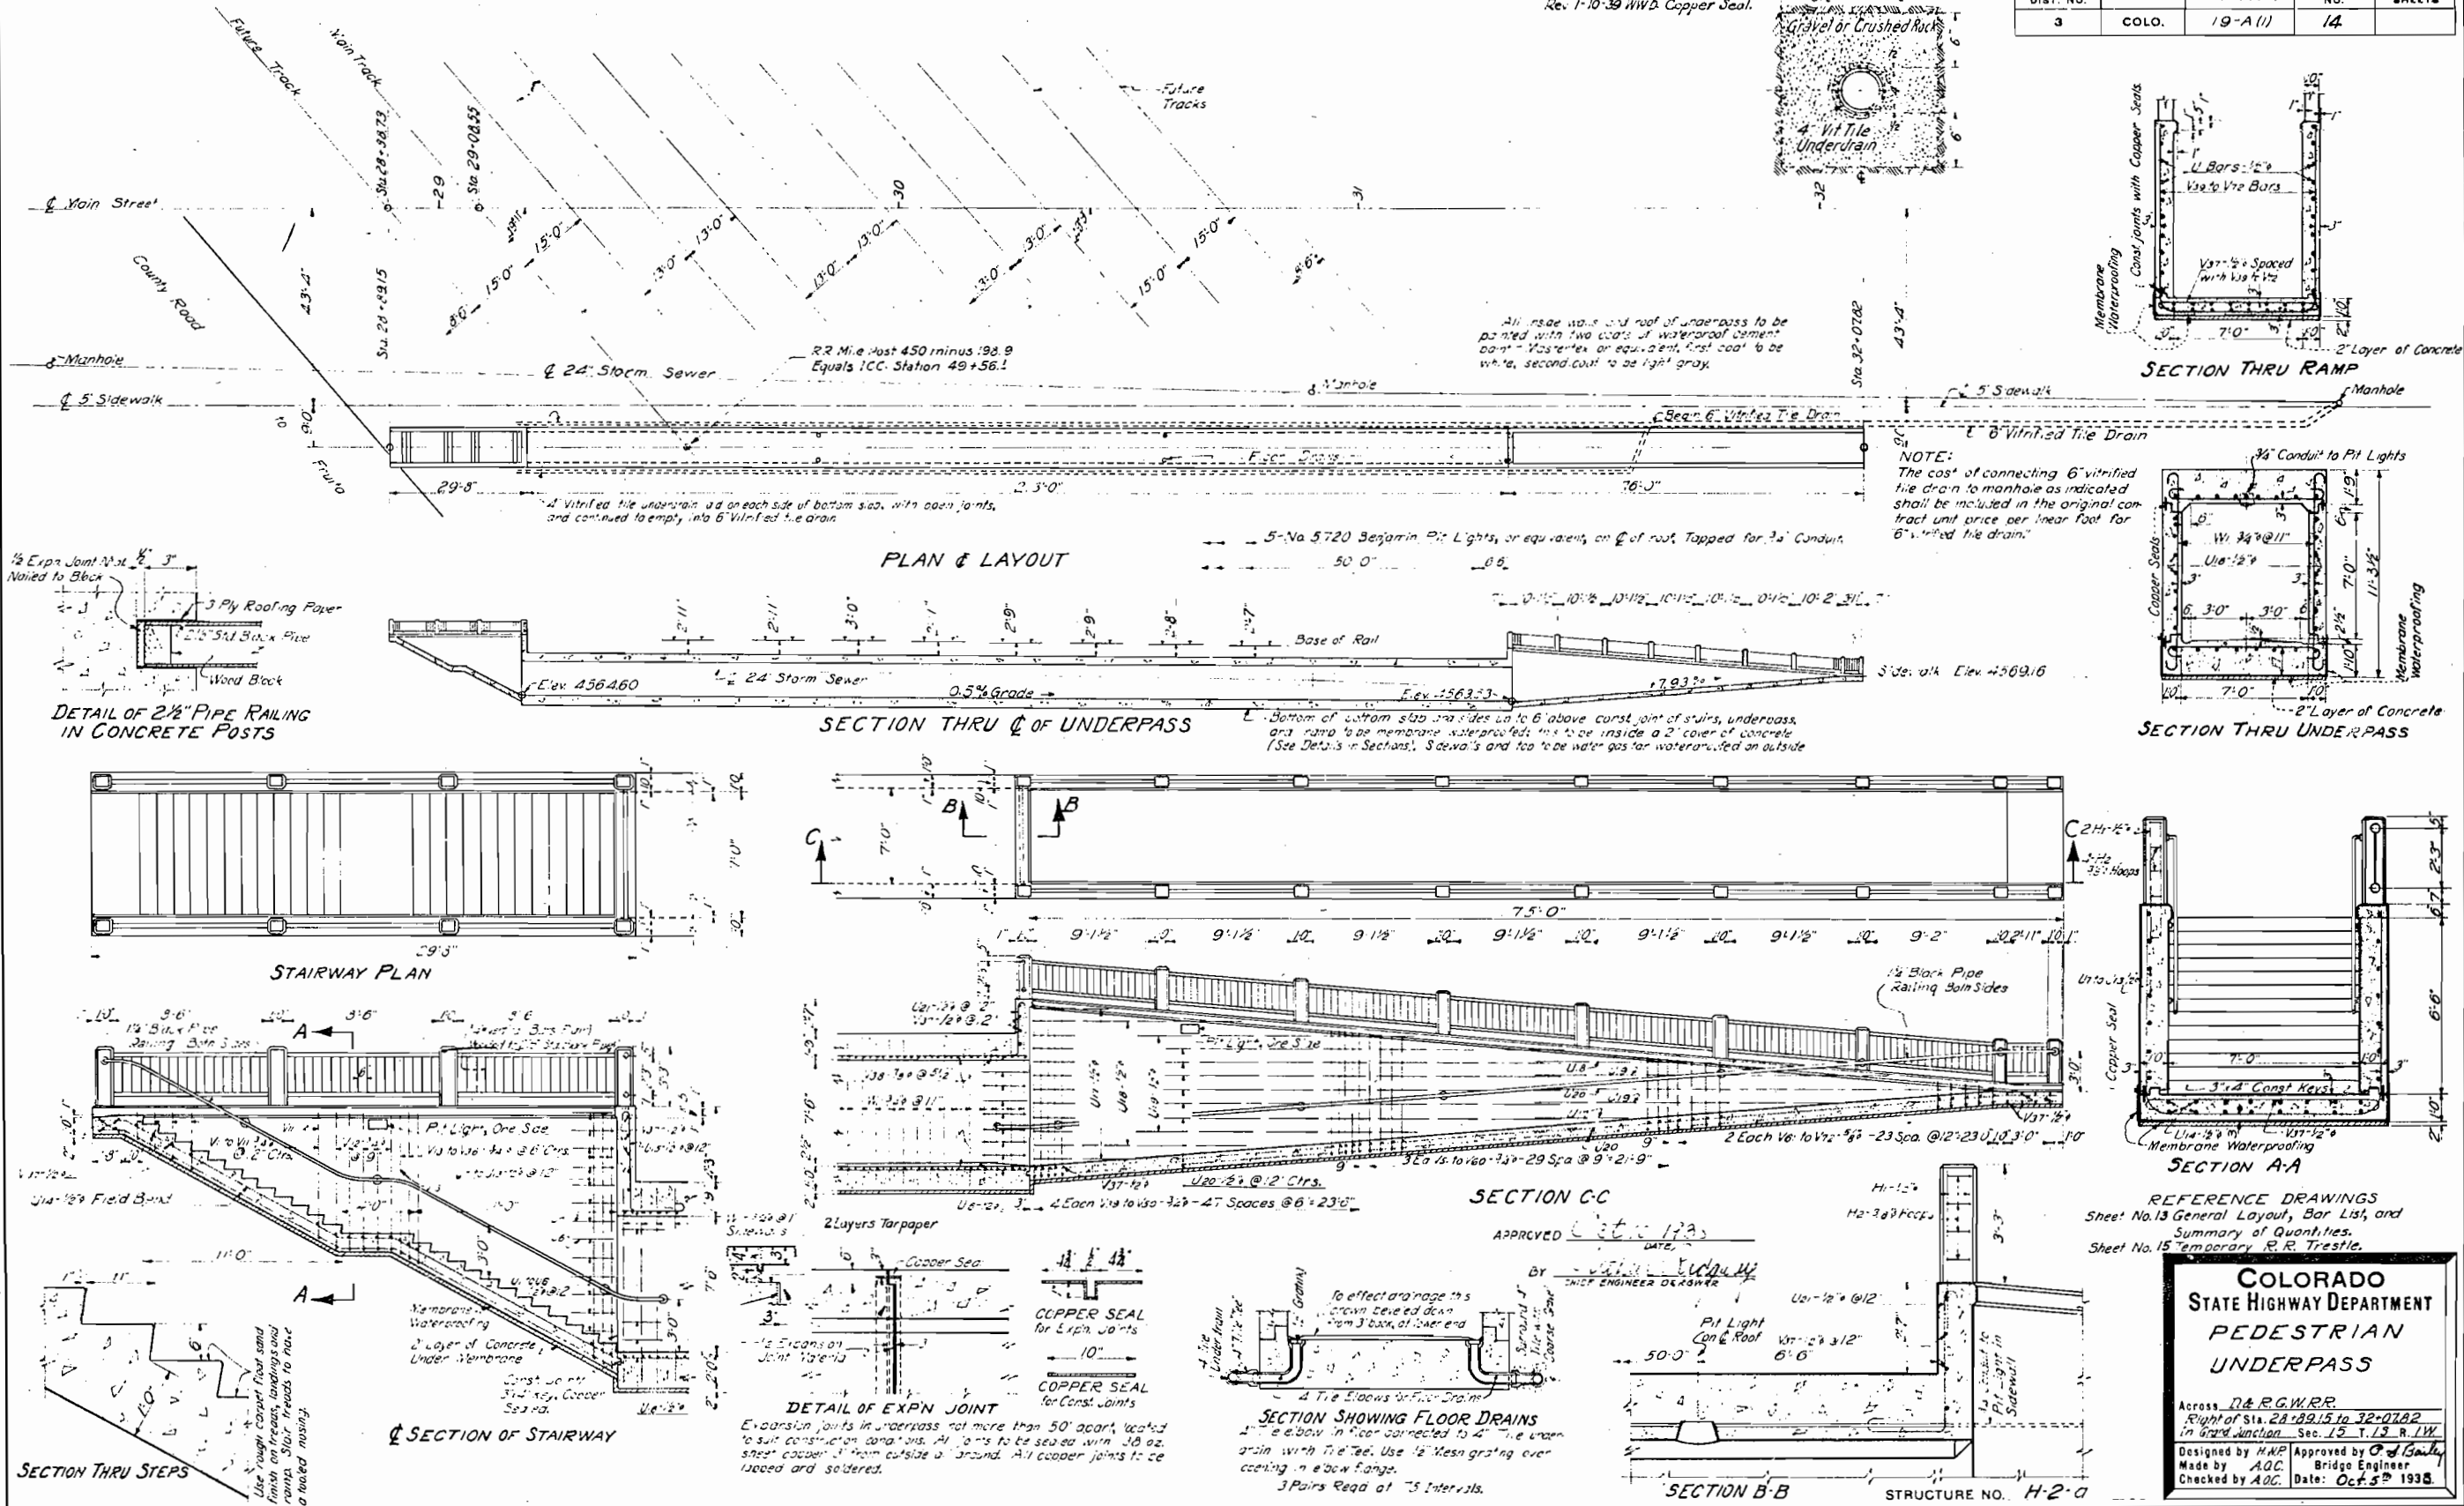

FED. ROAD DIST. NO.	STATE	F.A.G.M.	SHEET NO.	TOTAL SHEETS
3	COLO.	19 A-1	15	

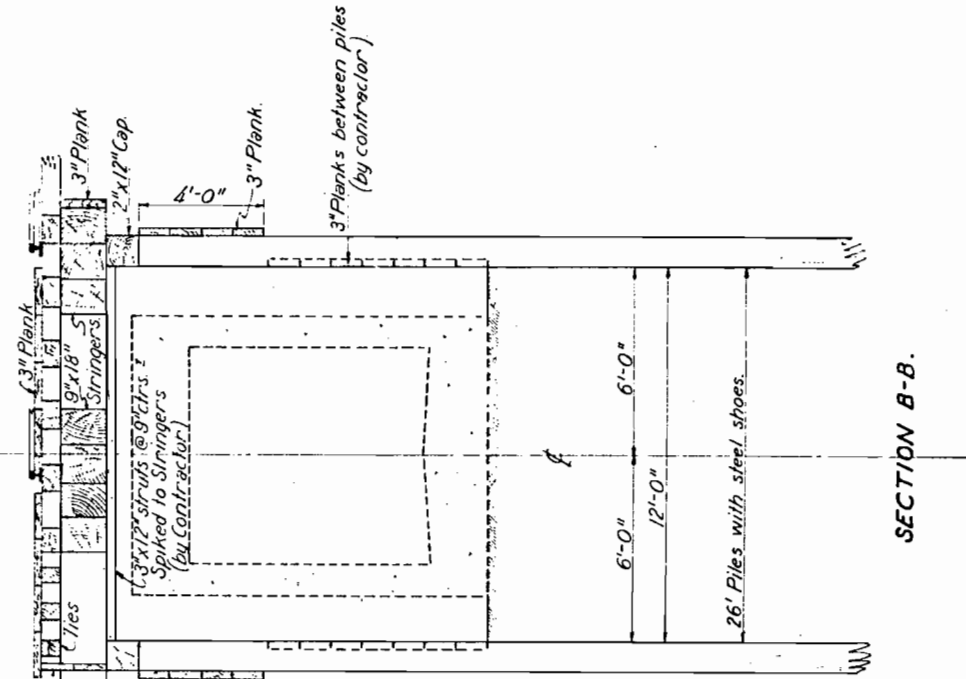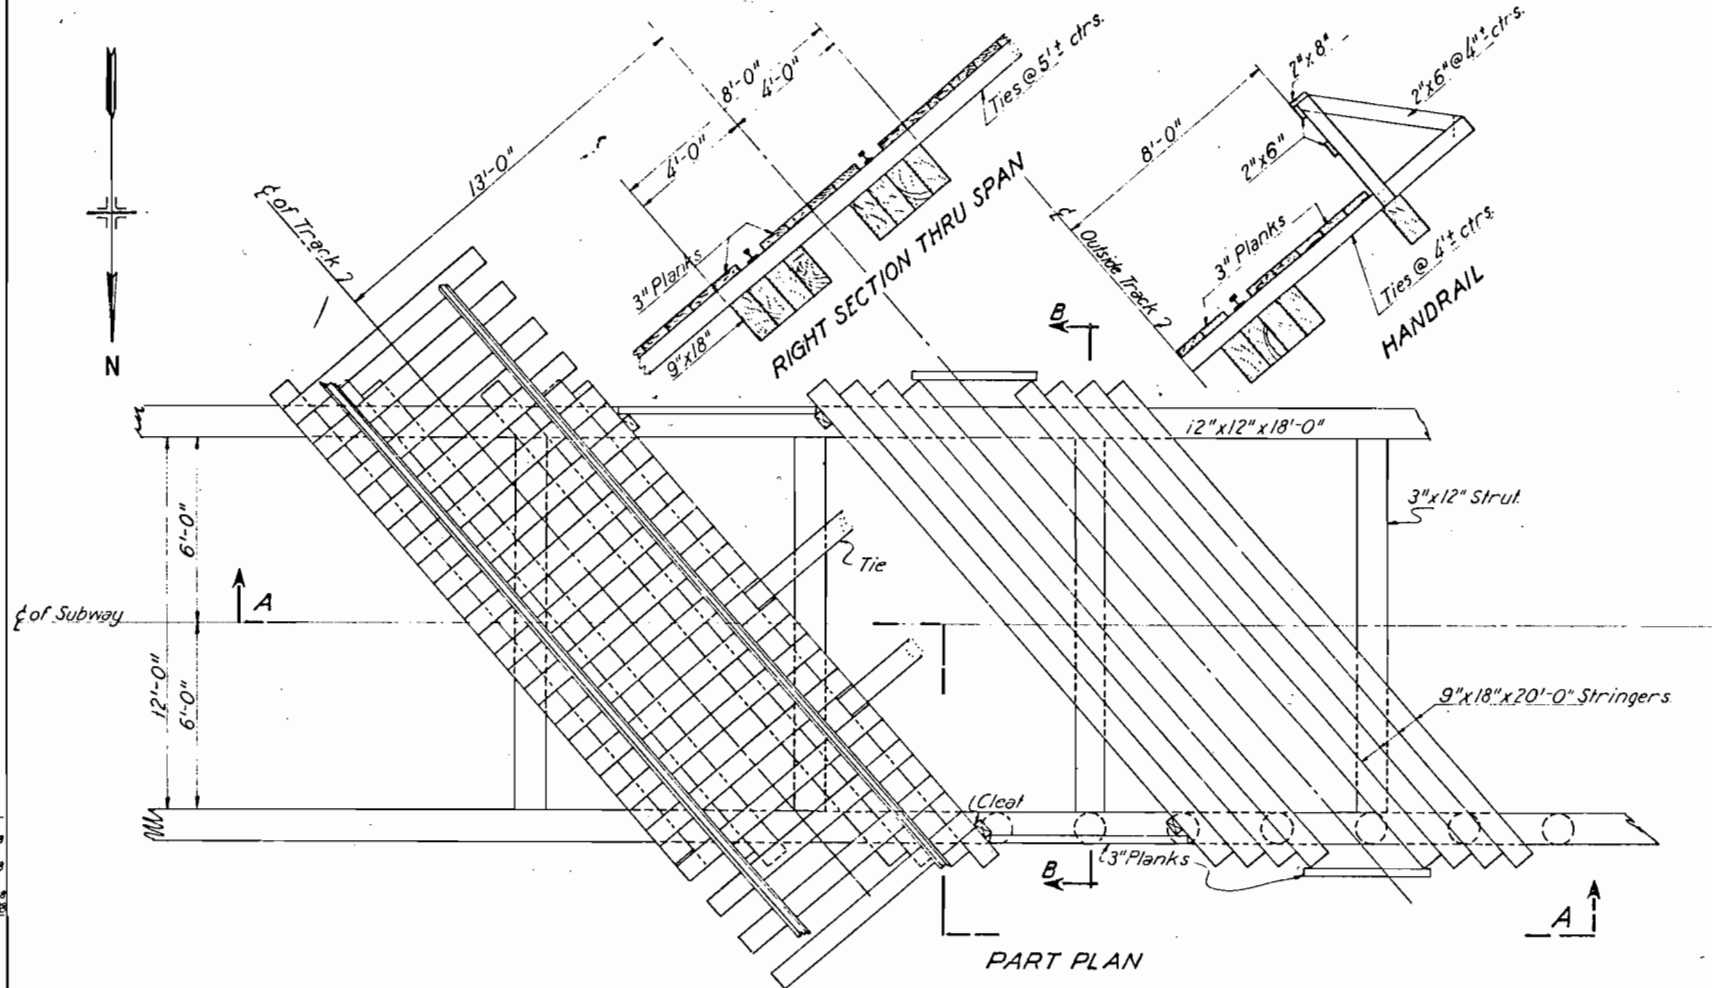

**BILL OF MATERIALS
FURNISHED IN PLACE BY R.R.CO.**

Item	Unit	Total
100 Timber Piles 26' long	Lin. ft.	2600
Oregon Untreated rough	M. ft. b.m.	18
Colorado "	M. ft. b.m.	12
100 Steel Pile Point	Each	100
Spikes, Drift pins, etc	lb.	1200

APPROVED *[Signature]*
DATE *10-1-38*
BY *[Signature]*
CHIEF ENGINEER S.E.R.R.

REFERENCE DRAWINGS
Sheet No. 13 General Layout, Bar List,
Summary of Quantities.
Sheet No. 14 Details of Underpass.


NOTES

Caps and Stringers untreated Oregon fir.
All other timber untreated Colorado.
Piles and all timber above 7ft. below base
of rail, except 3"x12" Struts, furnished in place
by R.R. Co.

**COLORADO
STATE HIGHWAY DEPARTMENT
PEDESTRIAN UNDERPASS
FALSE WORK**

Across *D. & R. G. W. R. R.*
Sta. *28+89.13* to *32+08.88*
Near *GRAND UCT.* Sec. *15.* T. *1 S. R. 1 W.*
Designed by *H.W.P.* Approved by *Ed. Bailey*
Made by *D.M.D.* Bridge Engineer
Checked by *[Signature]* Date: *Oct 5th, 1938.*

STRUCTURE NO. *H-2-a*

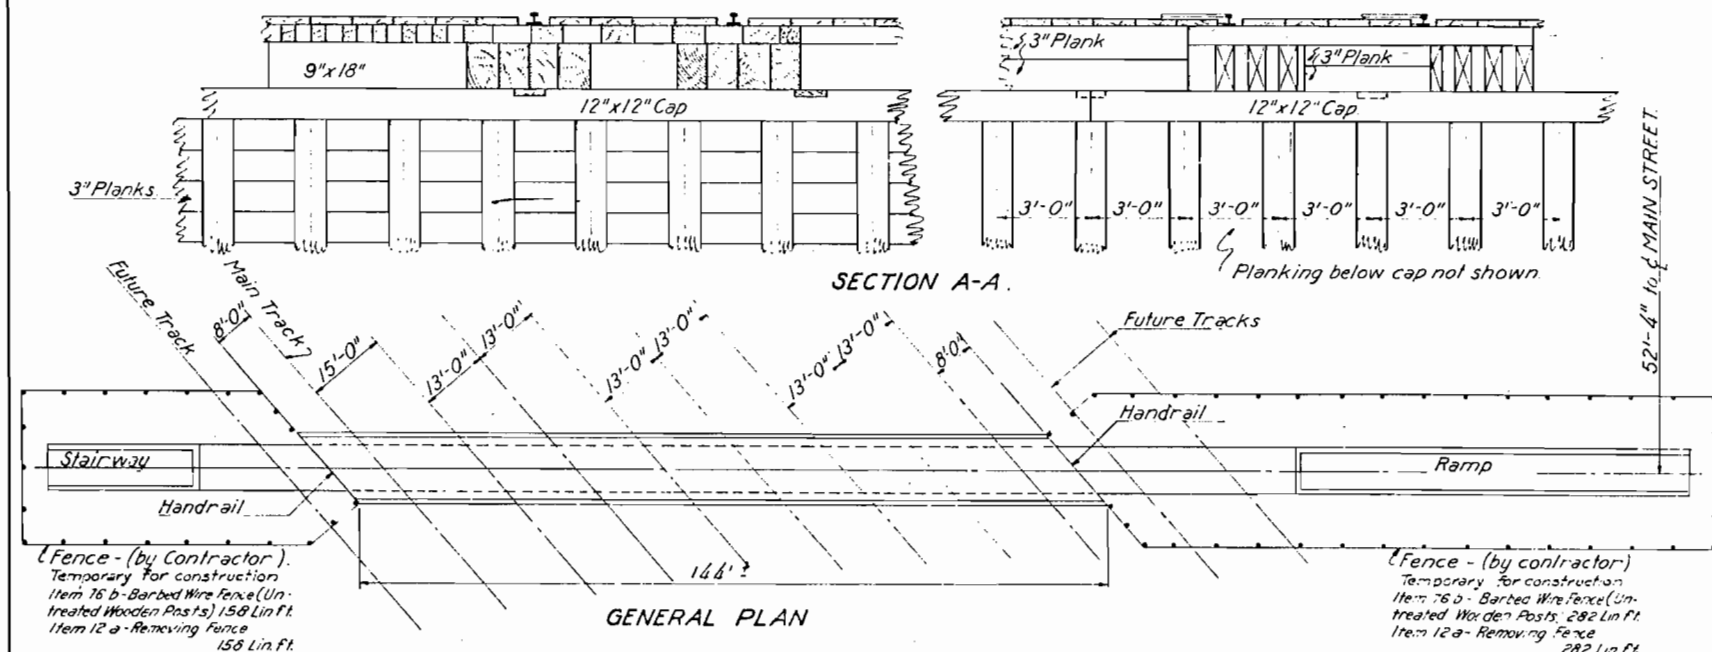


Fence - (by Contractor).
Temporary for construction
Item 76 b - Barbed Wire Fence (Un-
treated Wooden Posts) 158 Lin. Ft.
Item 12 a - Removing Fence
158 Lin. Ft.

Fence - (by contractor)
Temporary for construction
Item 76 b - Barbed Wire Fence (Un-
treated Wooden Posts) 282 Lin. Ft.
Item 12 a - Removing Fence
282 Lin. Ft.

FED. ROAD DIST. NO.	STATE	F.A.G.M. PROJ. NO.	SHEET NO.	TOTAL SHEETS
3	COLO.	19-A(1)	24	

R.O.W. REV. 10-17-38 S.B.L. 5-0-43(2)
SECTION REV. 11-19-38 S.B.L.

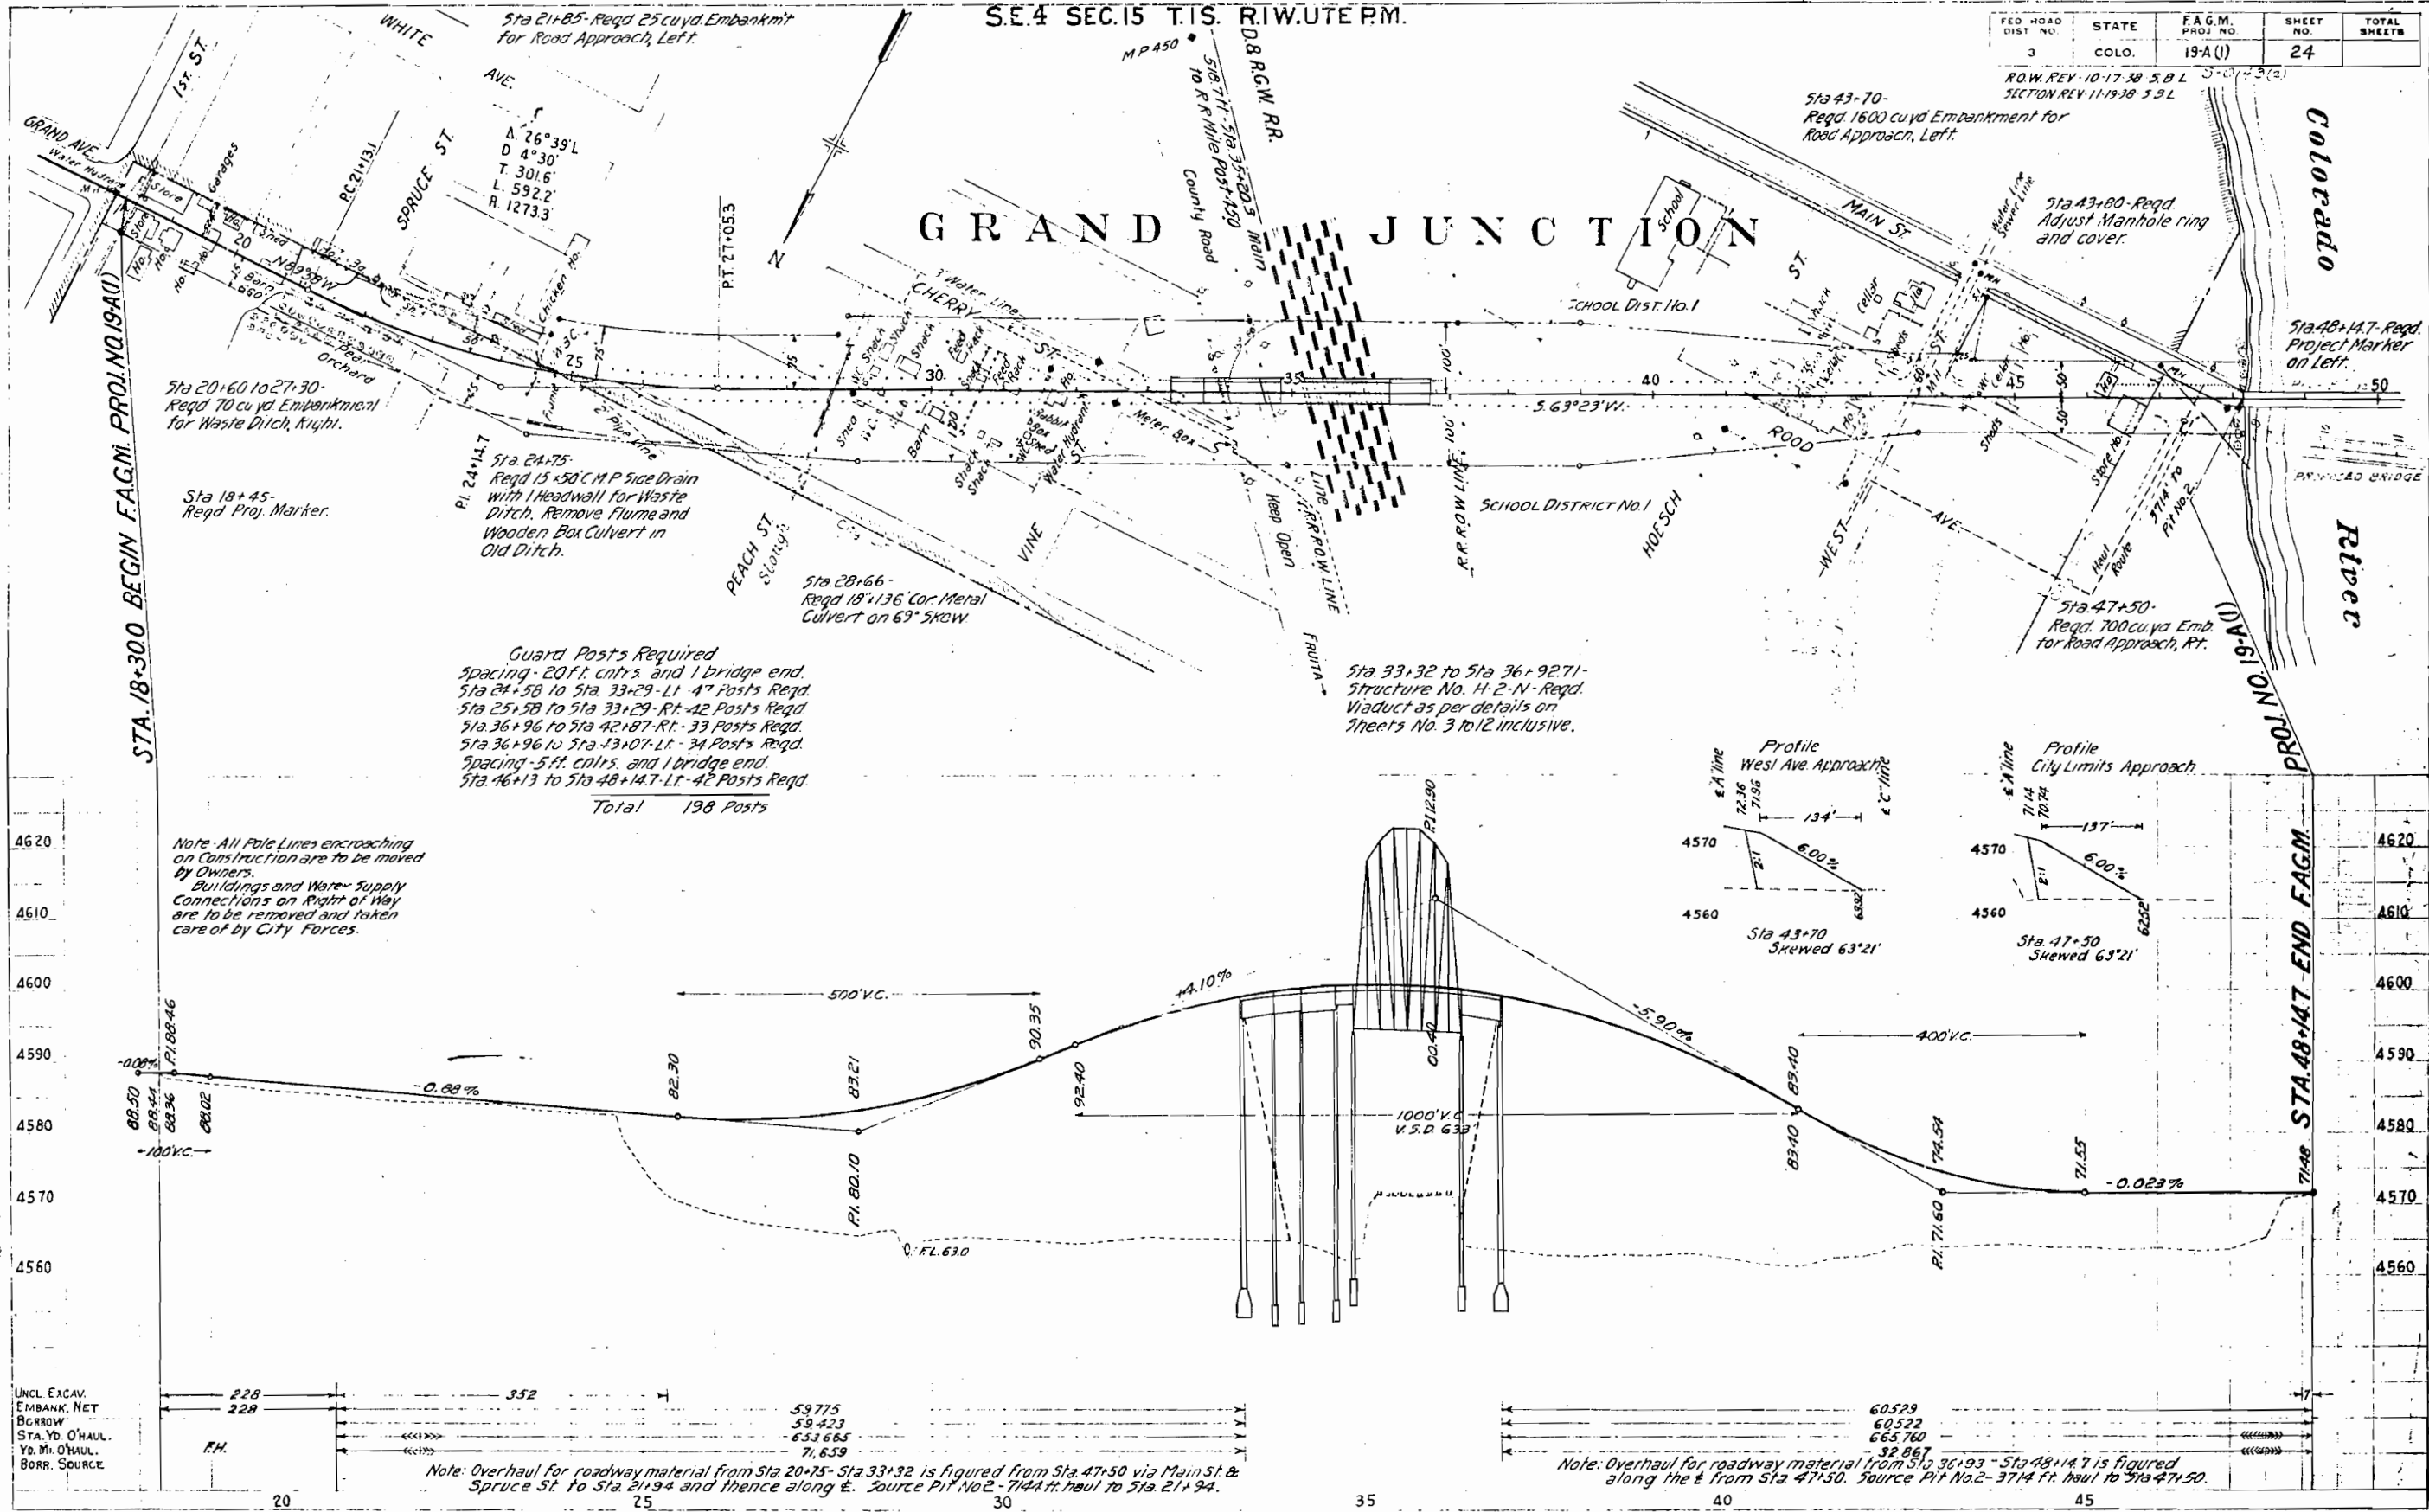


Colorado River

PROJ. NO. 19-A(1) END F.A.G.M.

UNCL. EXCAV.	228	352	59775	60529
EMBANK. NET	228		59423	60522
BORROW			653665	665760
STA. YD. O'HAUL.			71659	32867
YD. M. O'HAUL.				
BORR. SOURCE				

FED. ROAD DIST. NO.	STATE	F.A.G.M. PROJ. NO.	SHEET NO.	TOTAL SHEETS
3	COLO.	19-A (I)	25	

GRAND JUNCTION

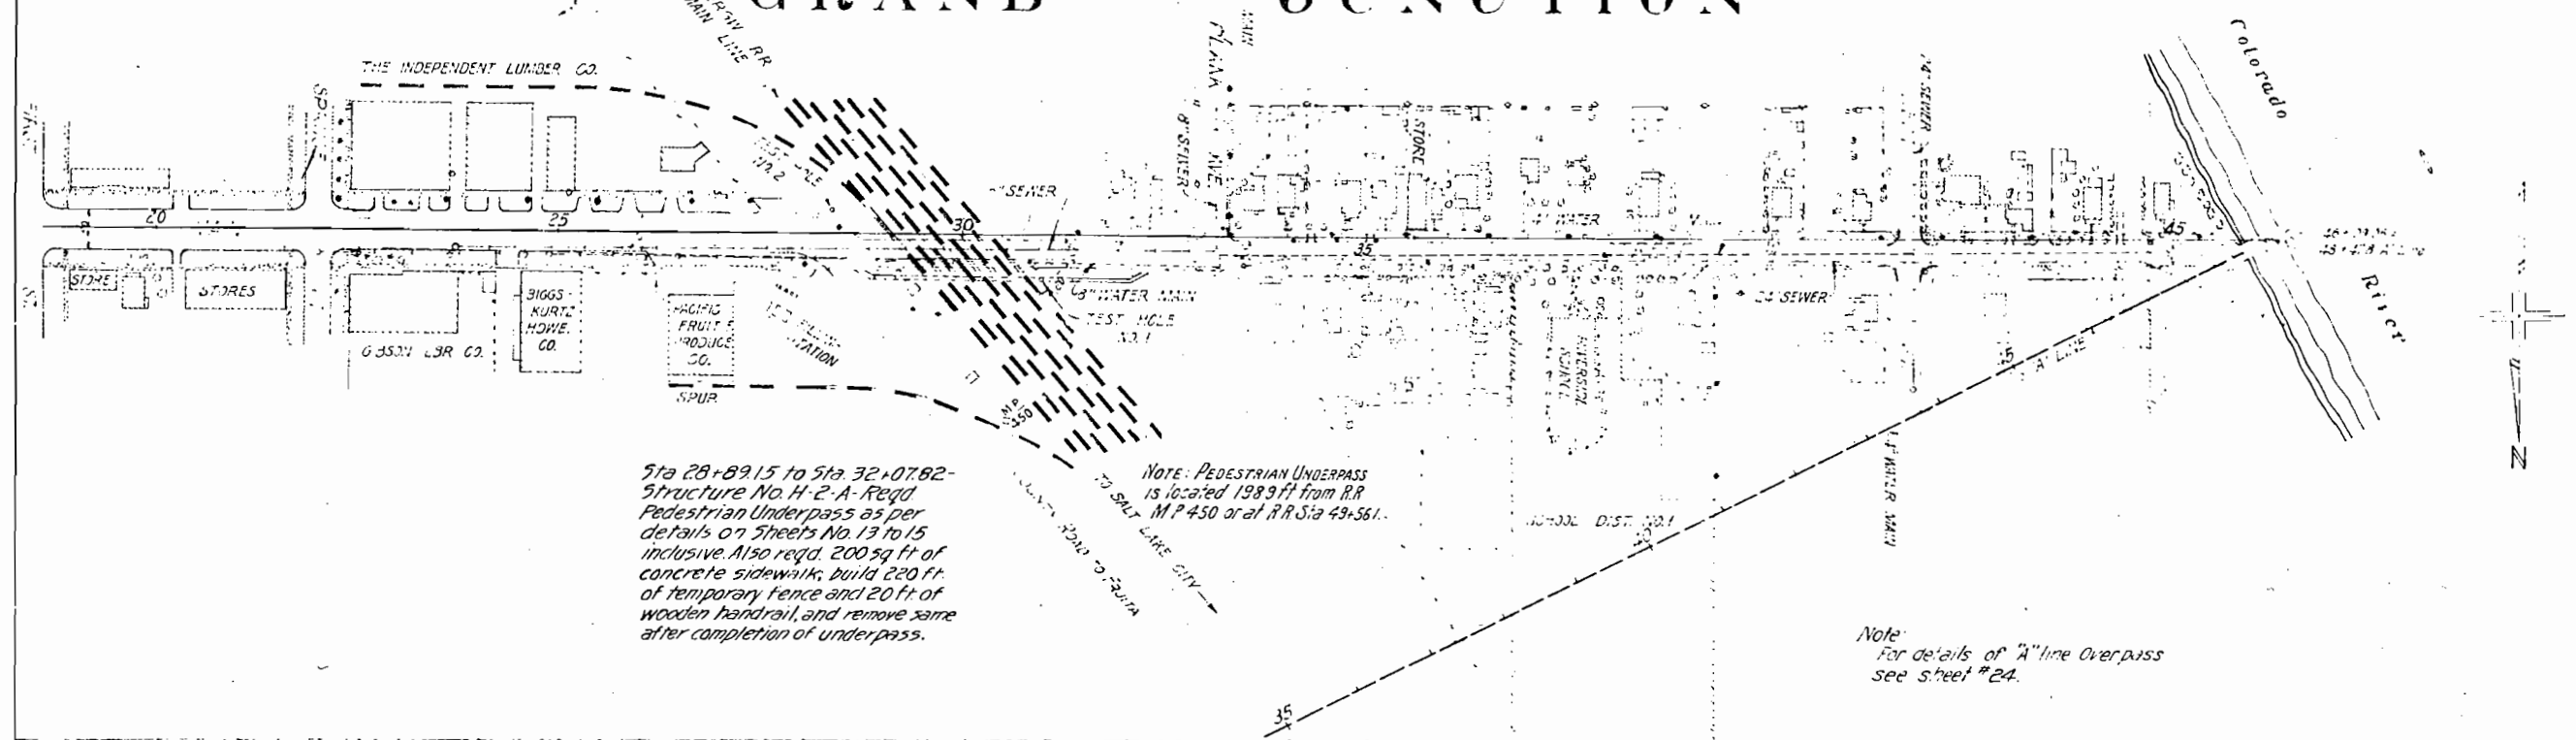

Sta 28+89.15 to Sta. 32+07.82-
Structure No. H-2-A-Regd.
Pedestrian Underpass as per
details on Sheets No. 13 to 15
inclusive. Also reqd. 200 sq ft of
concrete sidewalk, build 220 ft.
of temporary fence and 20 ft. of
wooden handrail, and remove same
after completion of underpass.

Note: Pedestrian Underpass
is located 1989 ft from R.R.
M.P. 450 or at R.R. Sta 49+561.

Note:
For details of "A" line Overpass
see sheet #24.

