

INDEX OF SHEETS


SHEET No.	TITLE SHEET	
1	CROSS SECTION AND SUMMARY SHEET	
2	BRIDGE DETAILS	
3	BRIDGE DETAILS	
4	DETAILS OF SPECIAL 6'x6' CONCRETE BOX CULV.	M-102 D.
5	STANDARD CORR. MET PIPE CULV. HEADWALLS	M-103 C.
6	" CONCRETE BOX CULVERTS	M-20 E.
7	" GUARD FENCE	M-25 A.
8	" PICKET SNOW FENCE	M-24 E.
9	" WIRE FENCE & MARKERS	
10	PLAN AND PROFILE	
11-17	CROSS SECTIONS	
18-33		

COLORADO STATE HIGHWAY DEPARTMENT PLAN AND PROFILE OF PROPOSED FEDERAL AID PROJECT NO. 134-D STATE HIGHWAY NO. 4 KIT CARSON COUNTY

CONVENTIONAL SIGNS

SURVEY LINE	---
RIGHT OF WAY LINE	---
SECTION LINE	---
ONE-QUARTER SEC. LINE	---
FENCE LINE	---
RAILROAD LINE	---
POLE LINE	---

SCALES
 ON PLAN, 1 IN. = 100 FT.
 ON PROFILE 1 IN. = 100 FT. HORIZONTAL
 1 IN. = 10 FT. VERTICAL
 GRADE LINE ON PROFILE IS SHOWN AS GRADE OF FINISHED ROAD
 GROSS LENGTH OF PROJECT } 26,800.0 FT. = 5.076 MI.
 NET LENGTH OF PROJECT }

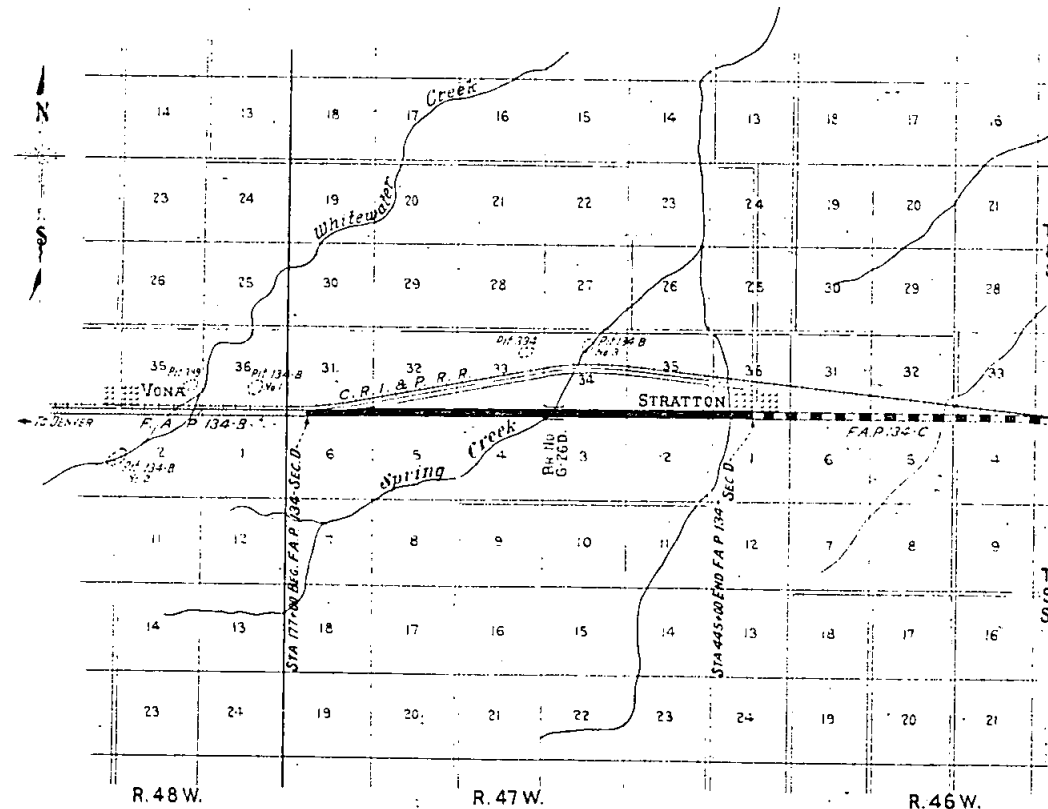


SCALE: 1 INCH = 1 MILE

RECOMMENDED FOR APPROVAL 2/14/31
J. J. Maloney
 ASSISTANT ENGINEER
 APPROVED
Chas. D. White
 STATE HIGHWAY ENGINEER
 RECOMMENDED FOR APPROVAL
 DIST. ENG. BUREAU PUBLIC ROADS
 RECOMMENDED FOR APPROVAL
 CHIEF ENG. BUREAU PUBLIC ROADS
 APPROVED
 DIST. ENG. BUREAU PUBLIC ROADS

FEB 1940 DST NO	RATE	FEB 80 DST NO	SHEET NO	TOTAL SHEETS
3	COLO	1340	2	

Corisat - 2-2-31 ~~21~~
 1944 16, 1952-54
 Revised as Constructed 4-22-33 MSK

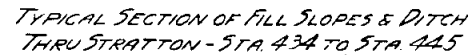

This Project is to be constructed in conformity with the Standard Specifications of the Colorado State Highway Department adopted January 1, 1930.

All quantities for preliminary plans are to be considered approximate only.

All final quantities required to construct the Project is to be obtained as indicated on the plans. Quantities involved beyond the limits of the ditch as shown on the Typical Section, either noted on the profile as "Optional", or on the plans and structure tabulation as "Optional", are to be obtained by the contractor. The existing topography, as to be classified and paid for as "Unimproved Excavation". These quantities are to be stated as part of the original estimate. Locations indicated on the plans, Slope stakes beyond the limits of the typical ditch as shown are subject to change at the Engineer to fit embankment conditions actually encountered during construction.

All Excavation Quantities in Embankments outside the limits of the Typical Section are to be paid for as "Unimproved Excavation". Excavation quantities are to be provided for by written order from the Department in the Contract.

Unless otherwise noted, all Cross Sections are to be provided with one shoulder, that at the inlet and. Side drains do not require foot walls.

No Overhaul on Surface Material will be paid on this Project. For contract prices covering surfacing shall include all work from Sta 177 to Sta 198 where the new work is upon the present finished roadway. The Contractor shall, at his own expense, so prepare construction that traffic can safely pass over the road while the Contractor shall maintain in safe condition and at his own expense all temporary approaches to and crossings of intersecting highways.

Sta. No.	Dist.	Amount	Balance
Sta. No.		Exp.	to Cr.
1931-32-204-96	P	6,124	
191-28-259-55	L		6,327
210-05	X	80	
260-08-410-05	L		15,377
260-08-260-10	P	2,022	
260-08-510-40	R		15,072
270-15-260-05	L	450	
281-05-206-33	P	470	
281-10-206-55	L	245	
310-35-410-00	L	10,545	
321-35-166-40	P	2,465	
370-35-410-00	X	4,845	
410-35-13-005	P		1,012
410-35-437-22	L		1,779
410-45-437-30	P	1,445	
410-45-437-22	L	1,777	
185-78-259-50	R		7,372
Totals		30,468	49,169

Station	First	Vo
211-70		
212-70	L & R	2
213-81	L & R	2
264-60	R	1
286-35	L & R	2
313-10	R	1
313-25	L	1
313-40	L	1
363-00	L	1
363-15	R	1
331-10	R	1
415-25	R	1
1000000 100000 10000 1000 100 10 1		
Total		15

Station	No
177+00	2
185+13	1
191+55	2
217+53	2
235+07	2
260+10	2
286+40	2
313+06	2
339+15	2
366+30	2
392+70	4
418+80	2
446+15	2
Total	29


No	Item	Unit	Quantity		
			Barren	Brum	Total
	CONSTRUCTION DIVISION NO. 1				
11a	Removing Structure, Sta 435+	Lump Sum	•	•	•
12a	" Fence	Lin Ft	3,469		3,464
11c	Unexcavated Excavation	Cu Yd	12,143		73,74
11a	Dry Rock Excavation (Structure)	"		41	
11b	" " " "	"	316	195	511
12a	Station Yard Overhaul	Sq Yd	189,306		189,3
12b	Ward Alley Overhaul	Sq Yd	29.5		29
10c	Gravel or Crushed Rock Surfacing	Tons	991,45		991,4
11a	Miscellaneous Untreated Timber	M.F.B.M		0.2	0.1
11a	Class "A" Concrete	Cu Yd	126.6		36,4
11b	" " " "	"	38.3		38
11c	Reinforcing Steel	Lbs.	11,629	36,451	48,08
11d	Structural	"		93,530	53,53
11a	15" Corr Metal Culvert Pipe	Lin Ft	260		26
11b	18" " " " "	"	362		36
11c	24" " " " "	"	162		16
11d	30" " " " "	"	32		3
11e	16" " " " "	"	172		17
11f	Precast Concrete Piling	"		116	116
72a	Wire Cable Guard Fence	"	2,520	600	3,100
72b	Galvanized Barbed Wire Fence	"	19,169		19,16
72c	Gates in " "	Each	15		26
72d	Picket Snow Fence	Lin Ft	2,268		2,26
72e	Properly Assembled	Each	1		1
72f	Right of Way Marker	"	29		29
72g	Sheet Copper	Lbs.		324	32
72h	Drain Pipes	Each		60	2
	ITEMS NOT RECEIVING FEDERAL AID				
	Removing Truck Dump, Sta 366+	Lump Sum	•	•	•
	Removing Pig Pen, Sta 390	"	•	•	•


31.0	FORMULA OIL PROCESSING PLANT	Ton	9051	9051
31.1	82% DUMP OILING	Ton	31,656	31,656
31.2	Oil Processing Base	Mile	5.041	5.041
31.2	MATERIALS TO BE FURNISHED IN WORK TO BE DONE BY STATE POWER			
	651-751, INCLUDING FEED OIL	Gal.	141,644	141,644
	Bunking & Shaping Straddlers	Lump Sum	•	•
	ITEMS NOT RELEVANT FEDERAL	AND		
32.0	Oil Process Just for Stock Piles/Contractors	Ton	249	249
31.0	651-751, Asphalt Road Oil (From by State)	Gal.	5,069	5,069
33.0	Oil Processing Base	Mile	2,019	2,019
31.0	Road Mix Oil Processed Surfacing	Ton	33	33
33.0	Base Course Oiling	Gal.	45	45
31.0	651-751 Asphaltic Road Oil	Gal.	365	365

Station	Description	Remove Structure	Excavation		Structural Excavation				Concrete		Reinf. Steel	Corrugated Metal Culvert Pipe				Wire Cable Guard Fence	Picket Snow Fence
			Culvert		Dry	Wet		Culvert		Lin. Ft.		Lin. Ft.					
			Under	Emph		Rock	Gravel	Culvert	Culvert			15"	18"	24"	36"		
177+00	Project Marker (1)																
211+60	Side Drain Road Approach Rt.					5											
213+70	Side Drains & 2 Rd Approaches, R & L					13											
219+00	C.M.P. Culvert, Outlet, 2 Handwalls								4.5								
222+00-224+50	Snow Fence																
230+30-231+50	"																252
231+00	414+30 Con. Str. Culv. 220 Dirs. 24 Dirs.		342			57			10.1	2.2	2200						108
236+90	C.M.P. Culvert, 2 Handwalls					6											
250+50-259+50	Snow Fence																
259+75	Side Drain Rt. 2 Rd Appro. 110 Dirs. Ditch		50			5											108
266+00	C.M.P. Culvert, 2 Handwalls					10				6.0							
268+03-270+50	Snow Fence																
274+66	C.M.P. Culvert, 2 Handwalls					9				2.2							204
287+50	"					3				2.2							
288+70-290+50	Snow Fence																
302+00	C.M.P. Culv. 2 Handw. Diversion Ditch		207			6				2.2							156
320+40-322+30	Guard Fence																
322+00	C.M.P. Culvert, 1 Hand.					5				1.7							500
336+80	"					6				1.7							
339+40-341+71	1 Beam Bridge (Quantities in summary)																
350+30-356+50	Guard Fence																
352+30	C.M.P. Culvert, 1 Hand.																
365+30-369+10	Guard Fence					42				3.3							1340
366+70	6x6x6 B.C.C. (3n"5), Diversion Ditch		128			56				76.5	9360						760
375+50-381+50	Snow Fence																
383+40	C.M.P. Culvert, 2 Handwalls									4.4							600
390+15	Side Drain Road Approach Rt.					11											
391+20	Side Drain & Road Approach Rt.					10											
403+50	C.M.P. Culvert, 2 Handwalls					8				2.2							
404+75-406+10	Snow Fence																144
407+10-410+40	"																252
412+30	C.M.P. Culvert, 1 Hand.					10				1.1							
416+00-417+50	Snow Fence																
418+50	C.M.P. Culvert, 1 Hand.					4				1.1							156
419+11	Side Drain Rt. 2 Rd Appro. R & L, Diversion Ditches		500			10											
423+23	C.M.P. Culvert, 1 Hand.					5				3.0							
430+00-432+80	Snow Fence																
435+85	Remove C.M.P. Build 18"x20" C.M.P. Culv																

At the locations tabulated below, oil producers suffering is to be placed, approximately 3" layer thickness, and compacted to produce a suitable approach to the project. The quantities wanted in these approaches are listed as follows:

LOCATION	SIDE	OIL PROPOSED SURF-FOOT
158	L1	20
259*	L1 & A1	40
287	L1	20
419*	L1 & A1	40
437*	" " "	40
441*	" " "	40
445	" " "	40
TOTAL	MEETING EST	240

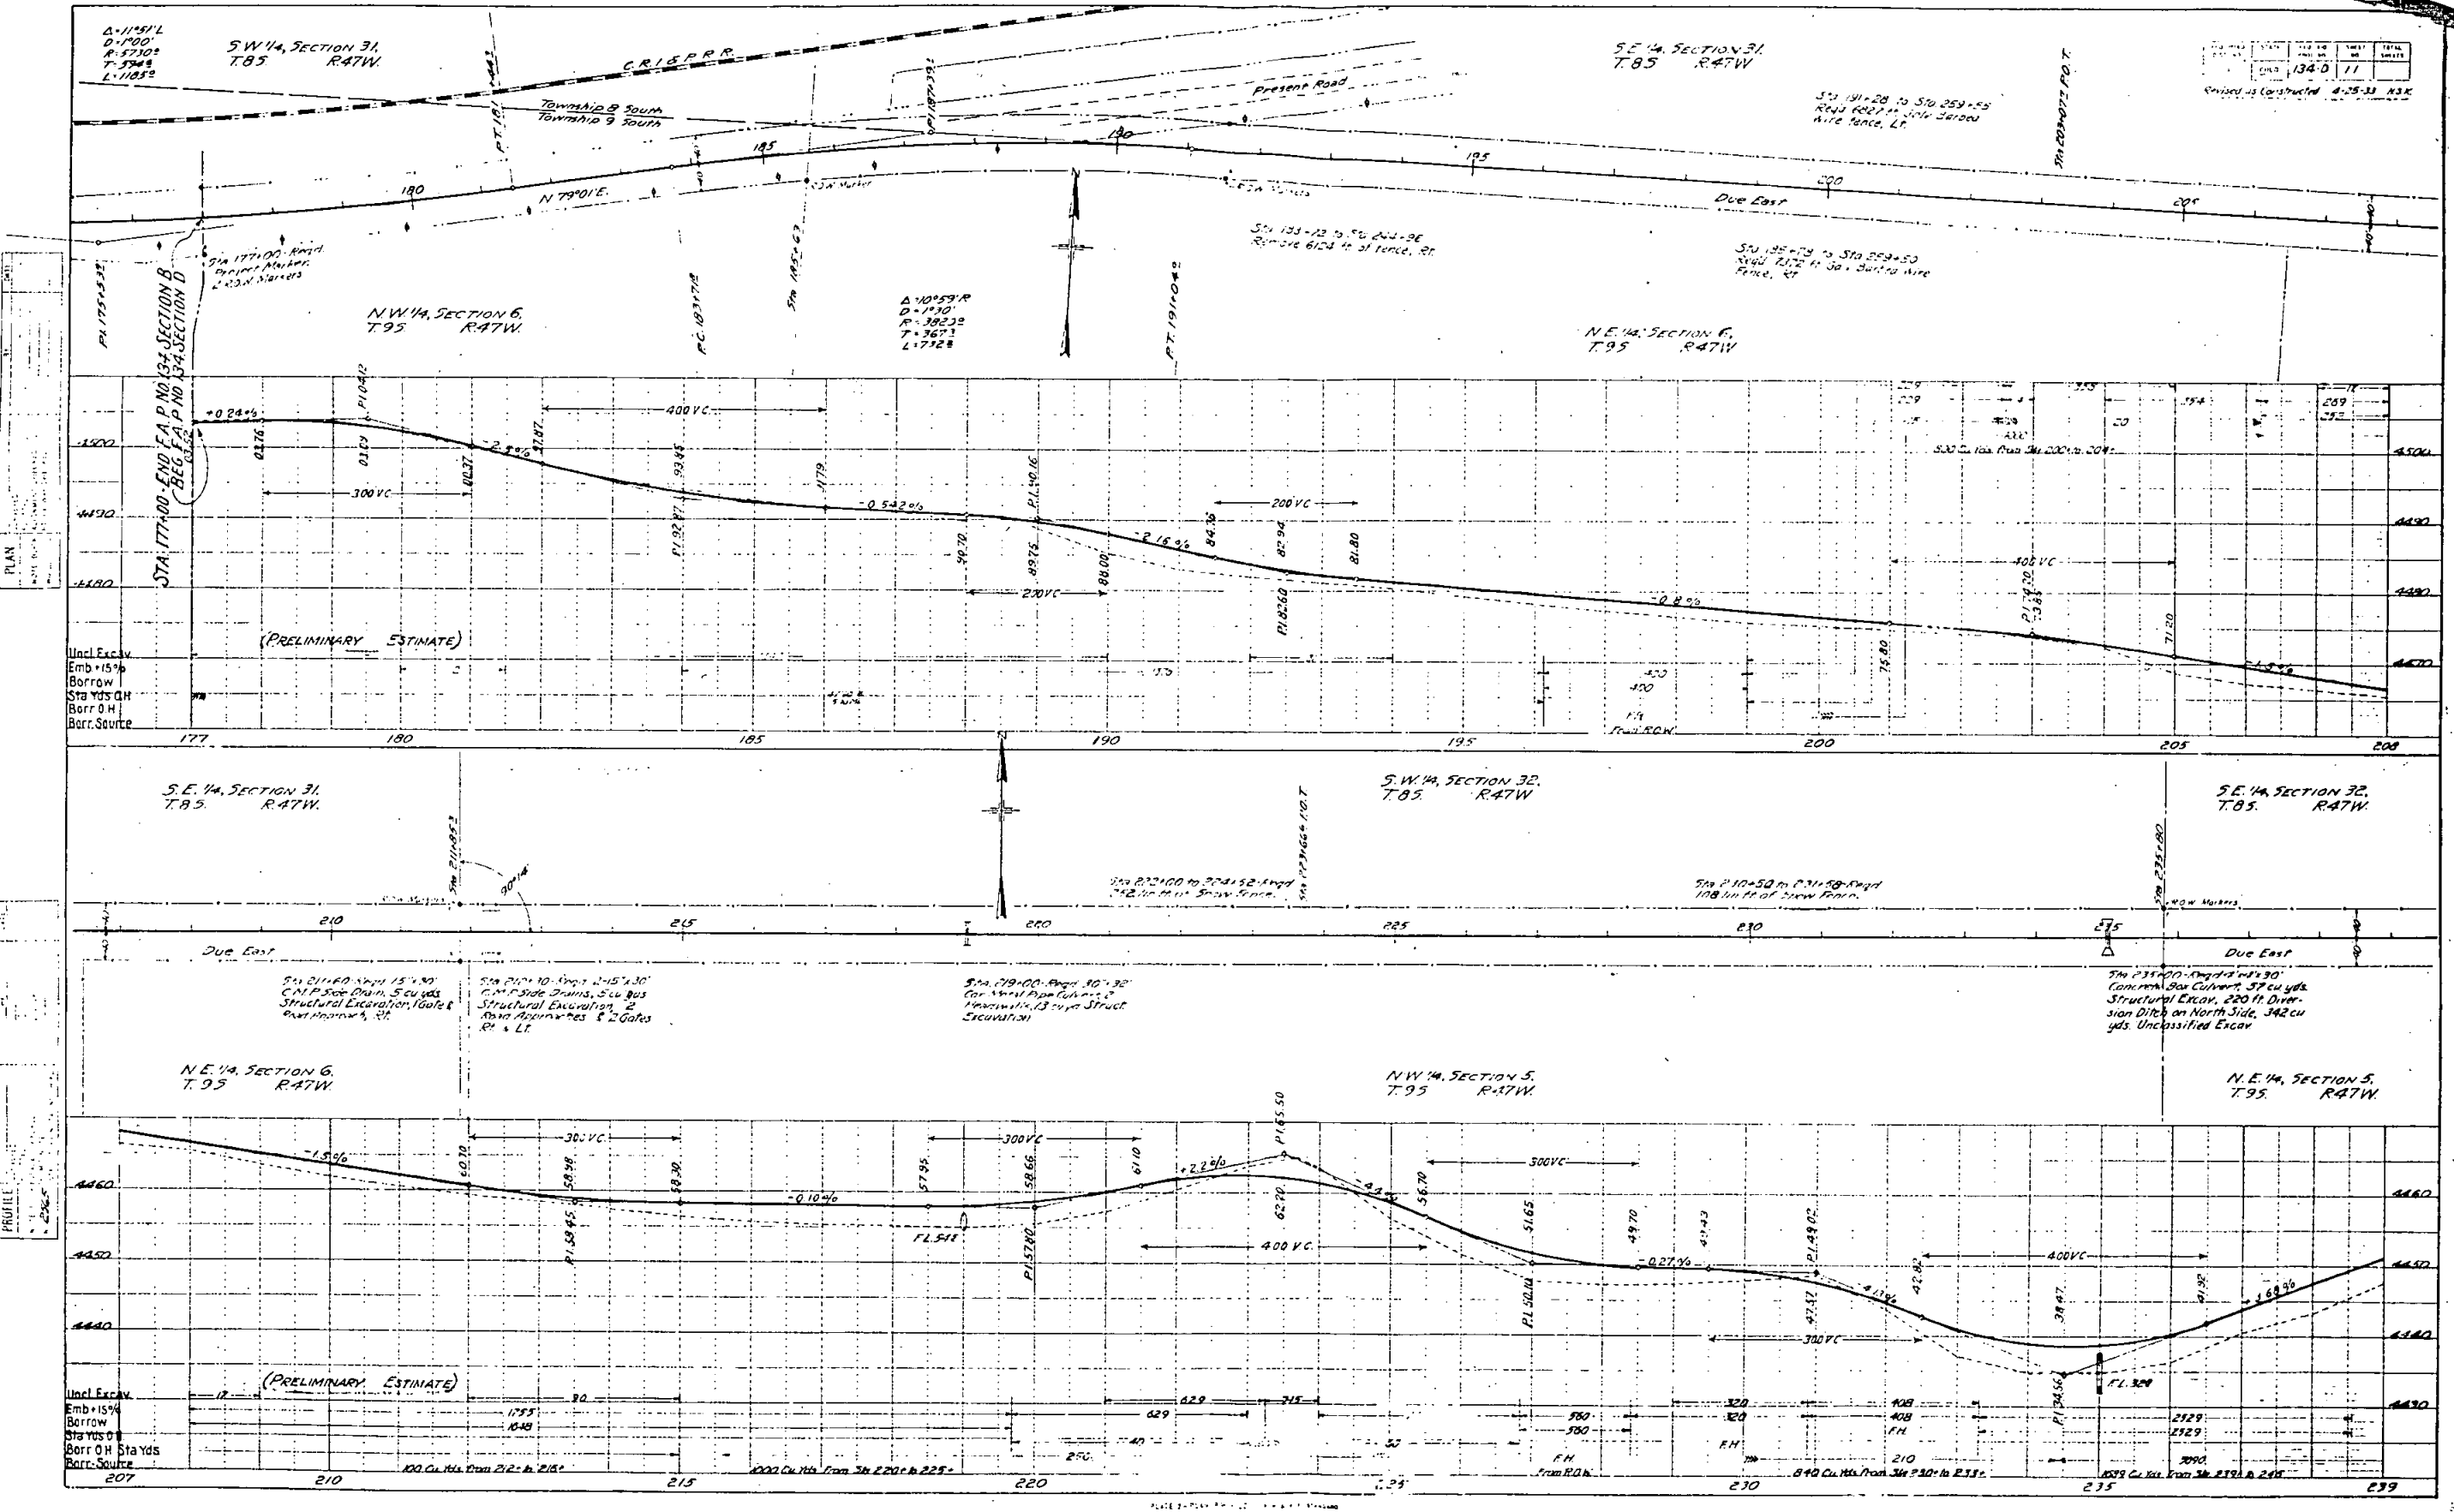

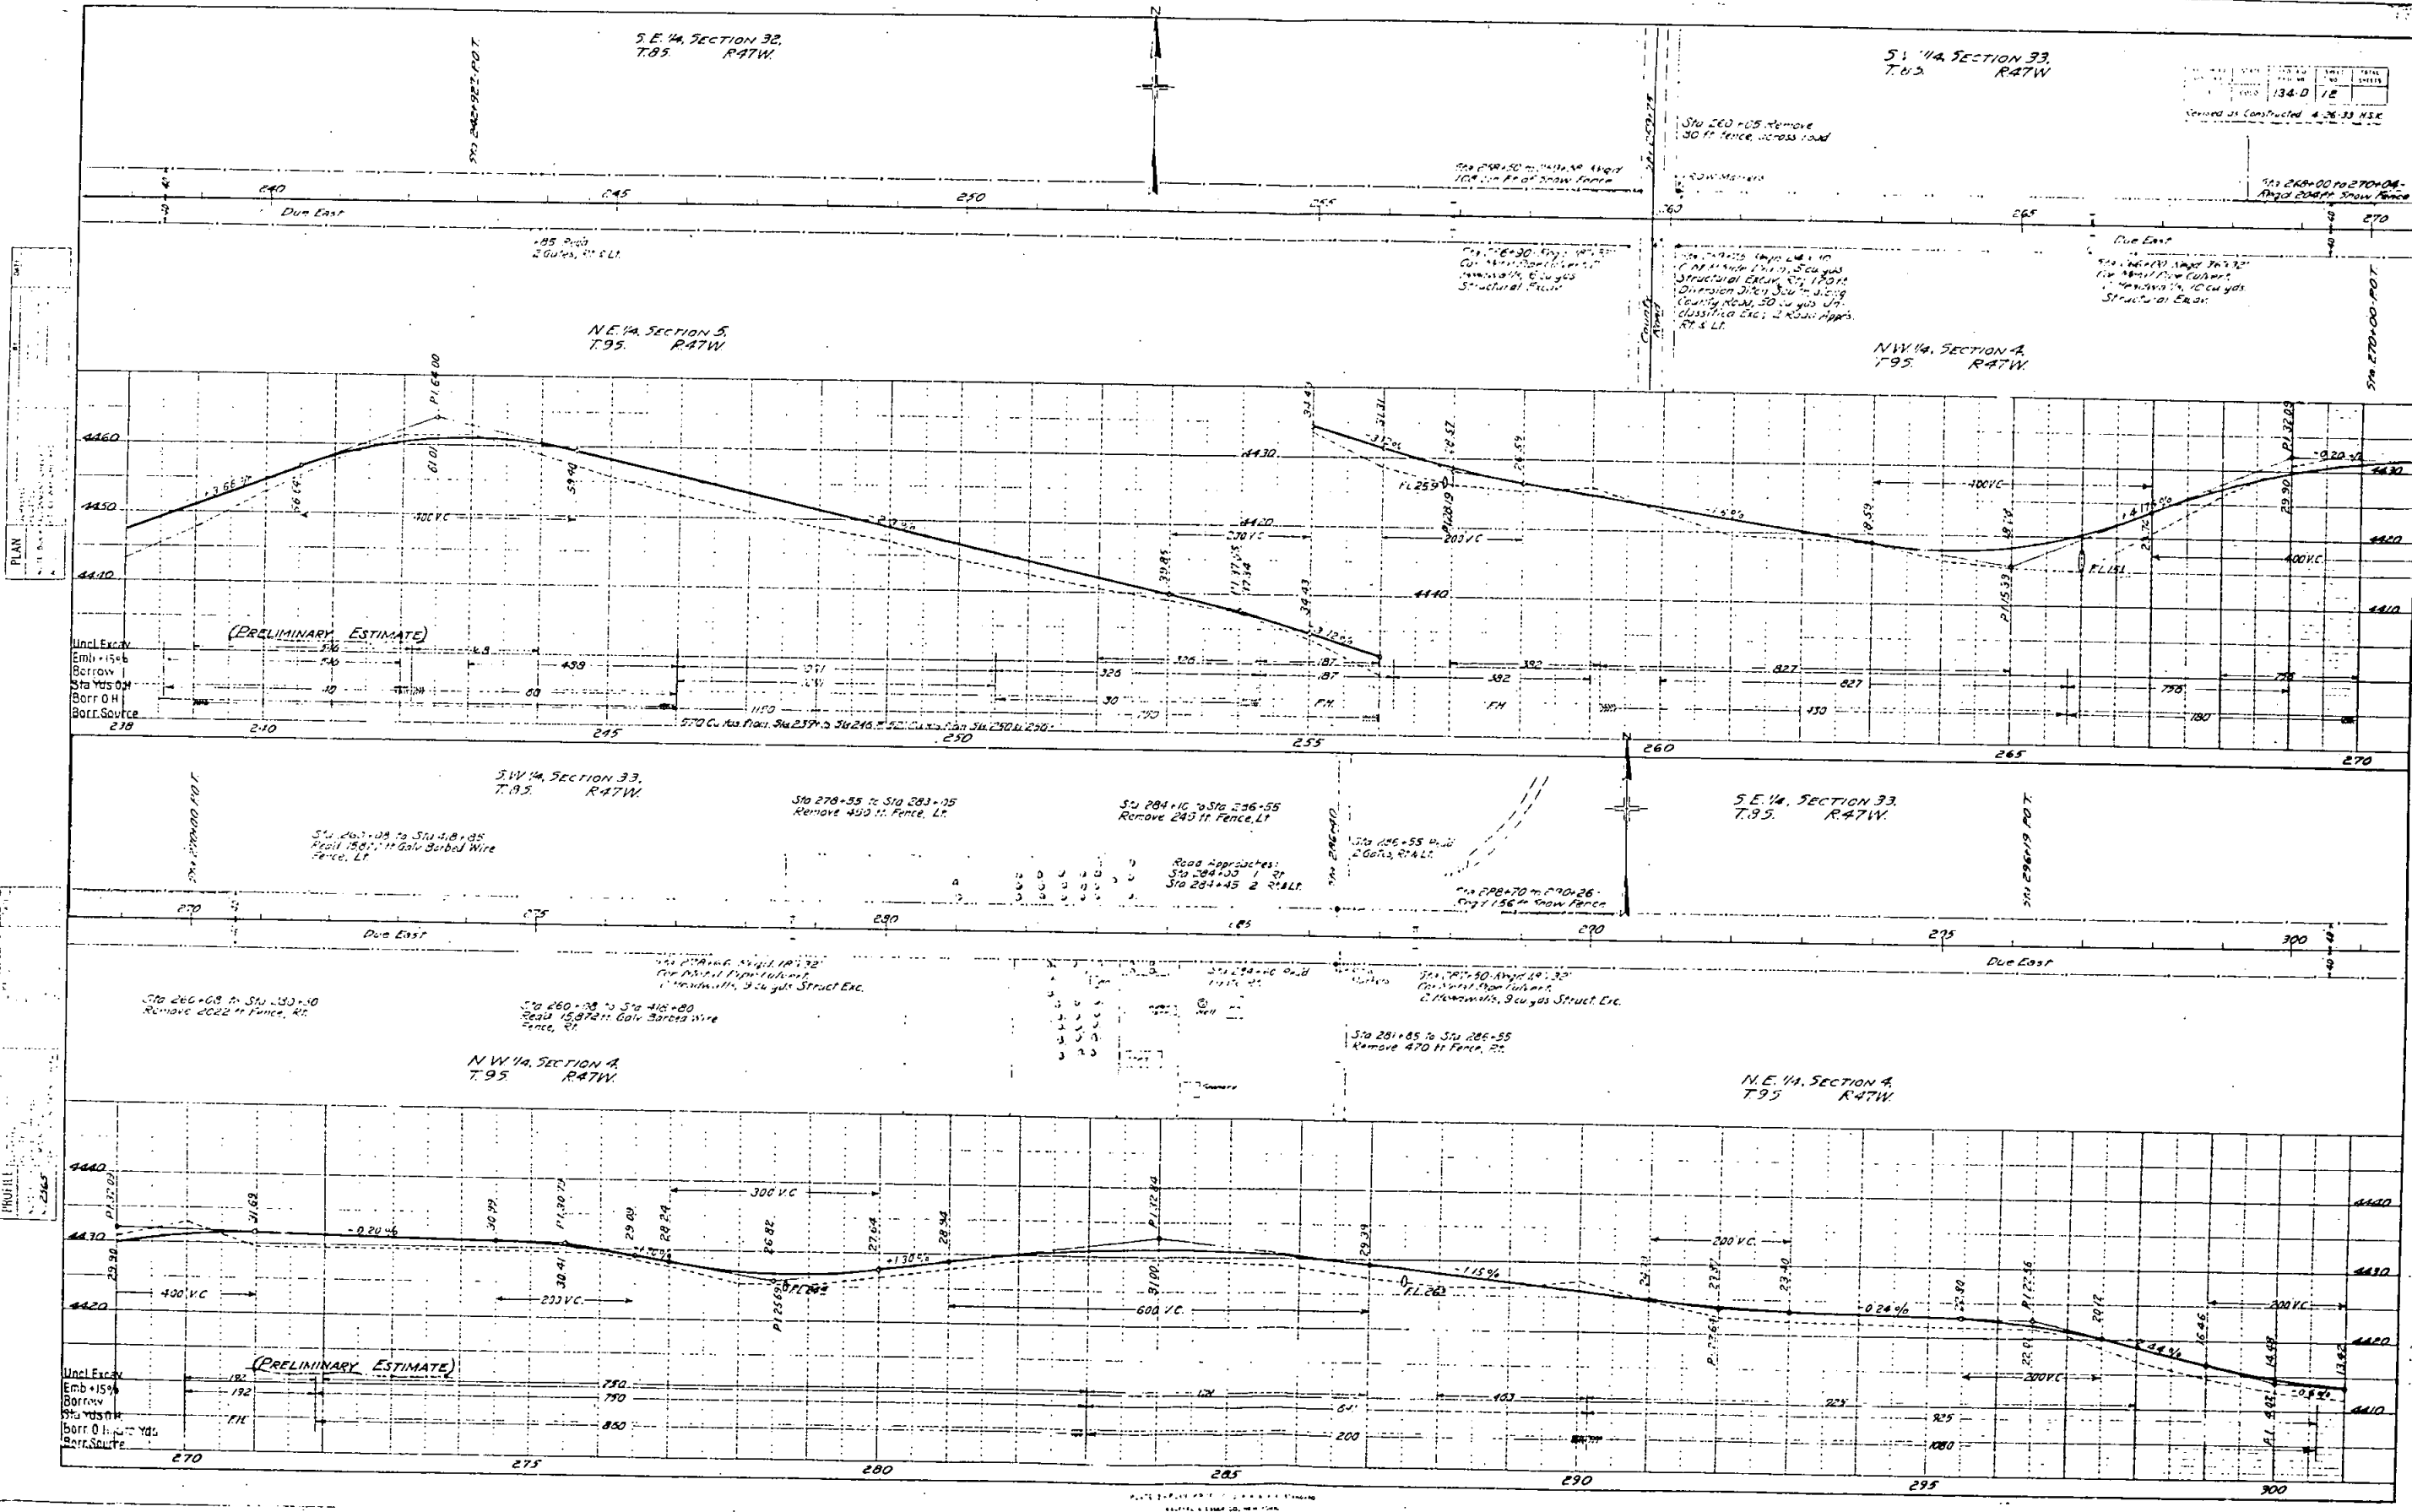


S.E. 1/4, SECTION 33,
T.85 R.47W

S.W. 1/4, SECTION 34,
T.85 R.47W.

NO.	DATE	NO.	DATE	NO.	DATE
1	1940	2	1941	3	1942

Revised as Constructed 4-26-33 H.S.K.

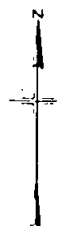

Sta. 315+25 to Sta. 410+30
Remove 10,545 sq. ft. of land

Sta. 315+25 to Sta. 410+30
Remove 10,545 sq. ft. of land

Sta. 315+25 to Sta. 410+30
Remove 10,545 sq. ft. of land


Sta. 315+25 to Sta. 410+30
Remove 10,545 sq. ft. of land

Sta. 315+25 to Sta. 410+30
Remove 10,545 sq. ft. of land

Sta. 315+25 to Sta. 410+30
Remove 10,545 sq. ft. of land

N.E. 1/4, SECTION 4,
T.95 R.47W.

N.W. 1/4, SECTION 3,
T.95 R.47W.

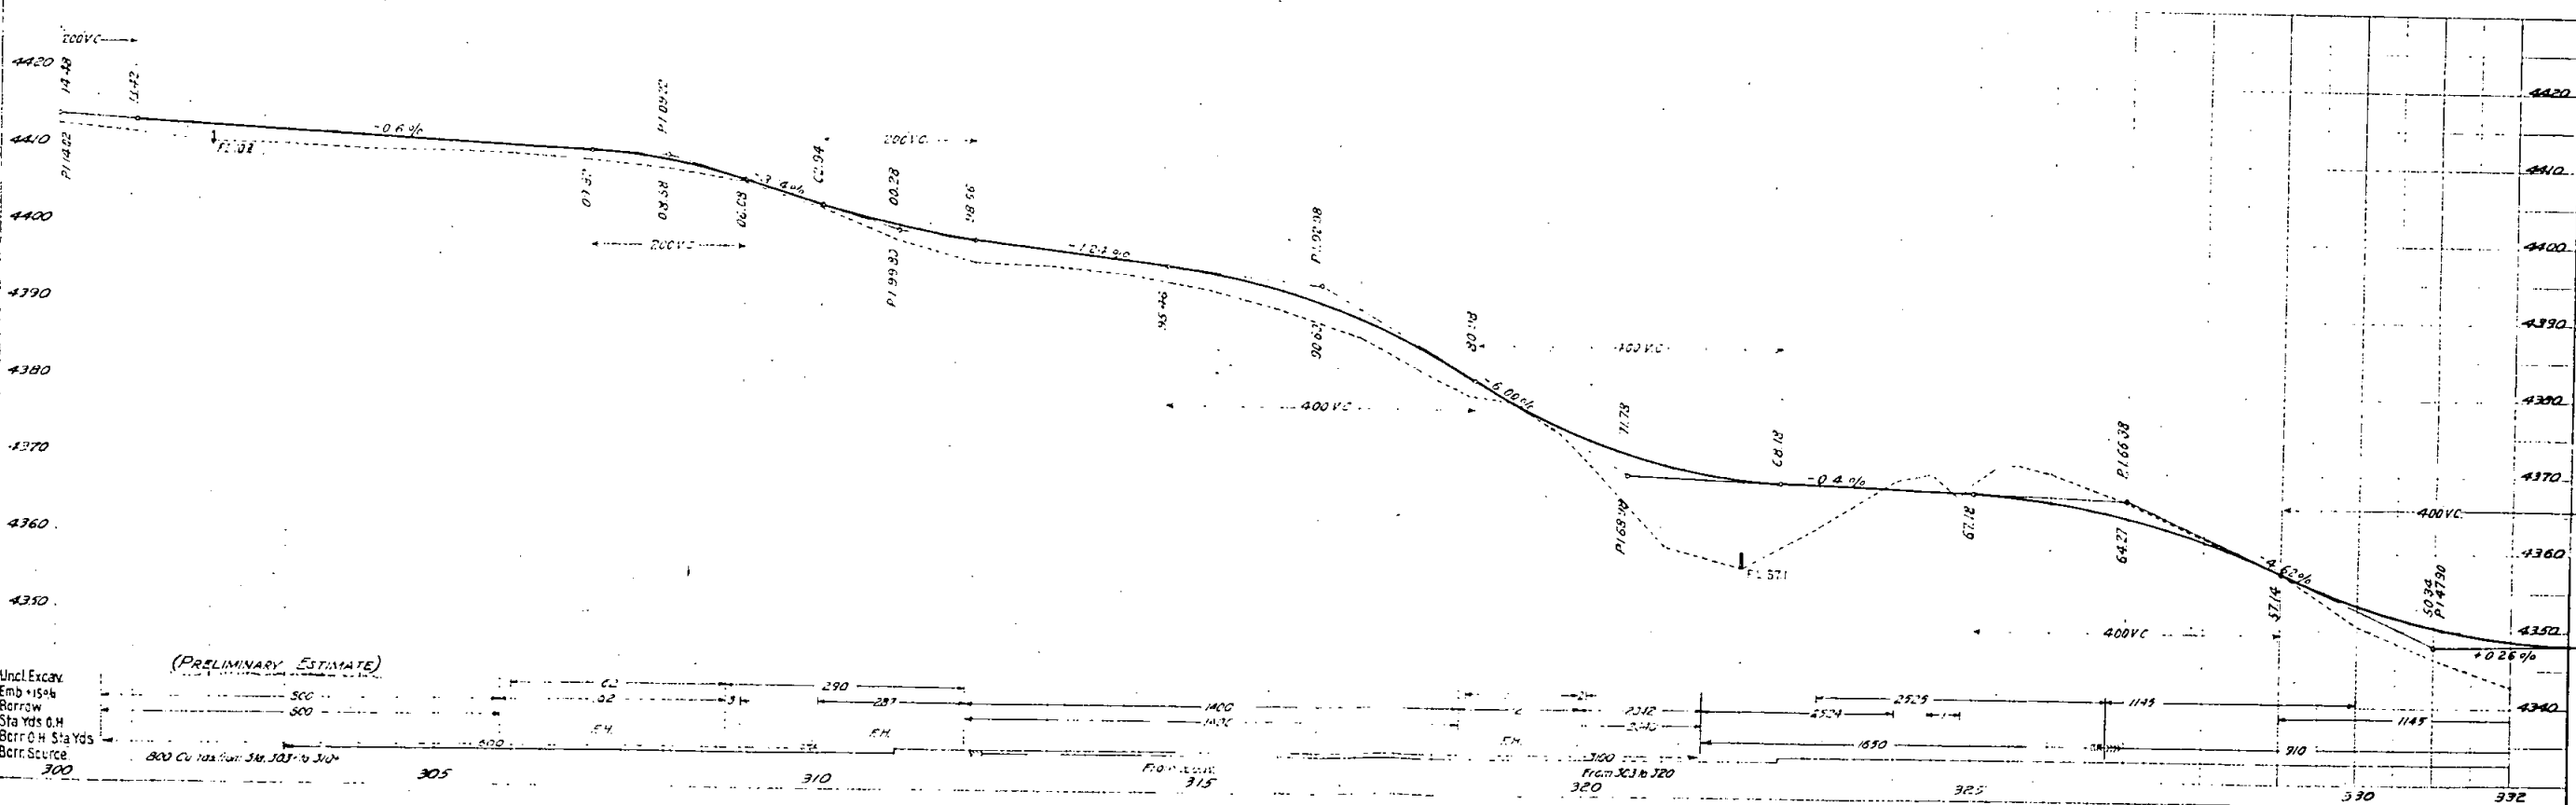

(PRELIMINARY ESTIMATE)

Uncl. Excav.
Emb. 15 ft.
Borrow
Sta. Yds. 6 ft.
Barr. 6 ft. Sta. Yds.
Barr. Source

300 305 310 315 320 325 330 332

SW 1/4 SECTION 34
T8S. R47W

SE 1/4 SEC 34 T8S. R47W

NW 1/4 SEC 3
T9S. R47W

NE 1/4 SEC 3 T9S. R47W


Sta 330+00 to 341+31
First S. Span E. Span Bridge
15 per. Sides No 3 and No 4
Also 200 Guard Rails each side
at West end and 200 each side of
East end of Bridge. 500 Lin Ft

Sta 350+00 to 356+50
Road Guard Rails each side
1240 Lin Feet

Sta 341+75 to Sta 366+40
Remote 2445 ft Fence R.R.

BRIDGE NOTES-STRUCTURE G-26-D

PRESENT STRUCTURE
Concrete Tied Beam Arch
STREAM DATA
Drainage Area in Sq. Mi. - 1.79
Velocity during High Water
Elevation of:
Maximum High Water - 4341.2 Low Water - 4335.8
Normal Stage - 4341.8 Stream Bed - 4335.5
Drift - Some
Scour - Light
PROPOSED STRUCTURE
Position referred to Present Structure - Span 100' - 40' 0" x 10' 0"
Clear Roadway - 20' 0"
Clear Waterway - 137' 0"
Type of Superstructure - Concrete Tied Beam Arch
Type of Substructure - Concrete Piers, 30' diam. Circular Piers
Spread Footings
Detail Structure Requirements - Use Old Line Bridge
P.R. Siding - Street 20' from to Jordan Side - E. Main St.
NEARBY STRUCTURES ON SAME STREAM
Location - 1/2 Mi. North - C.P. & D.P.R. Trust Co.
Waterway - 4000 Sq. Ft. (Temporary)
Record during Floods - Built after Flood of July 18, 1929

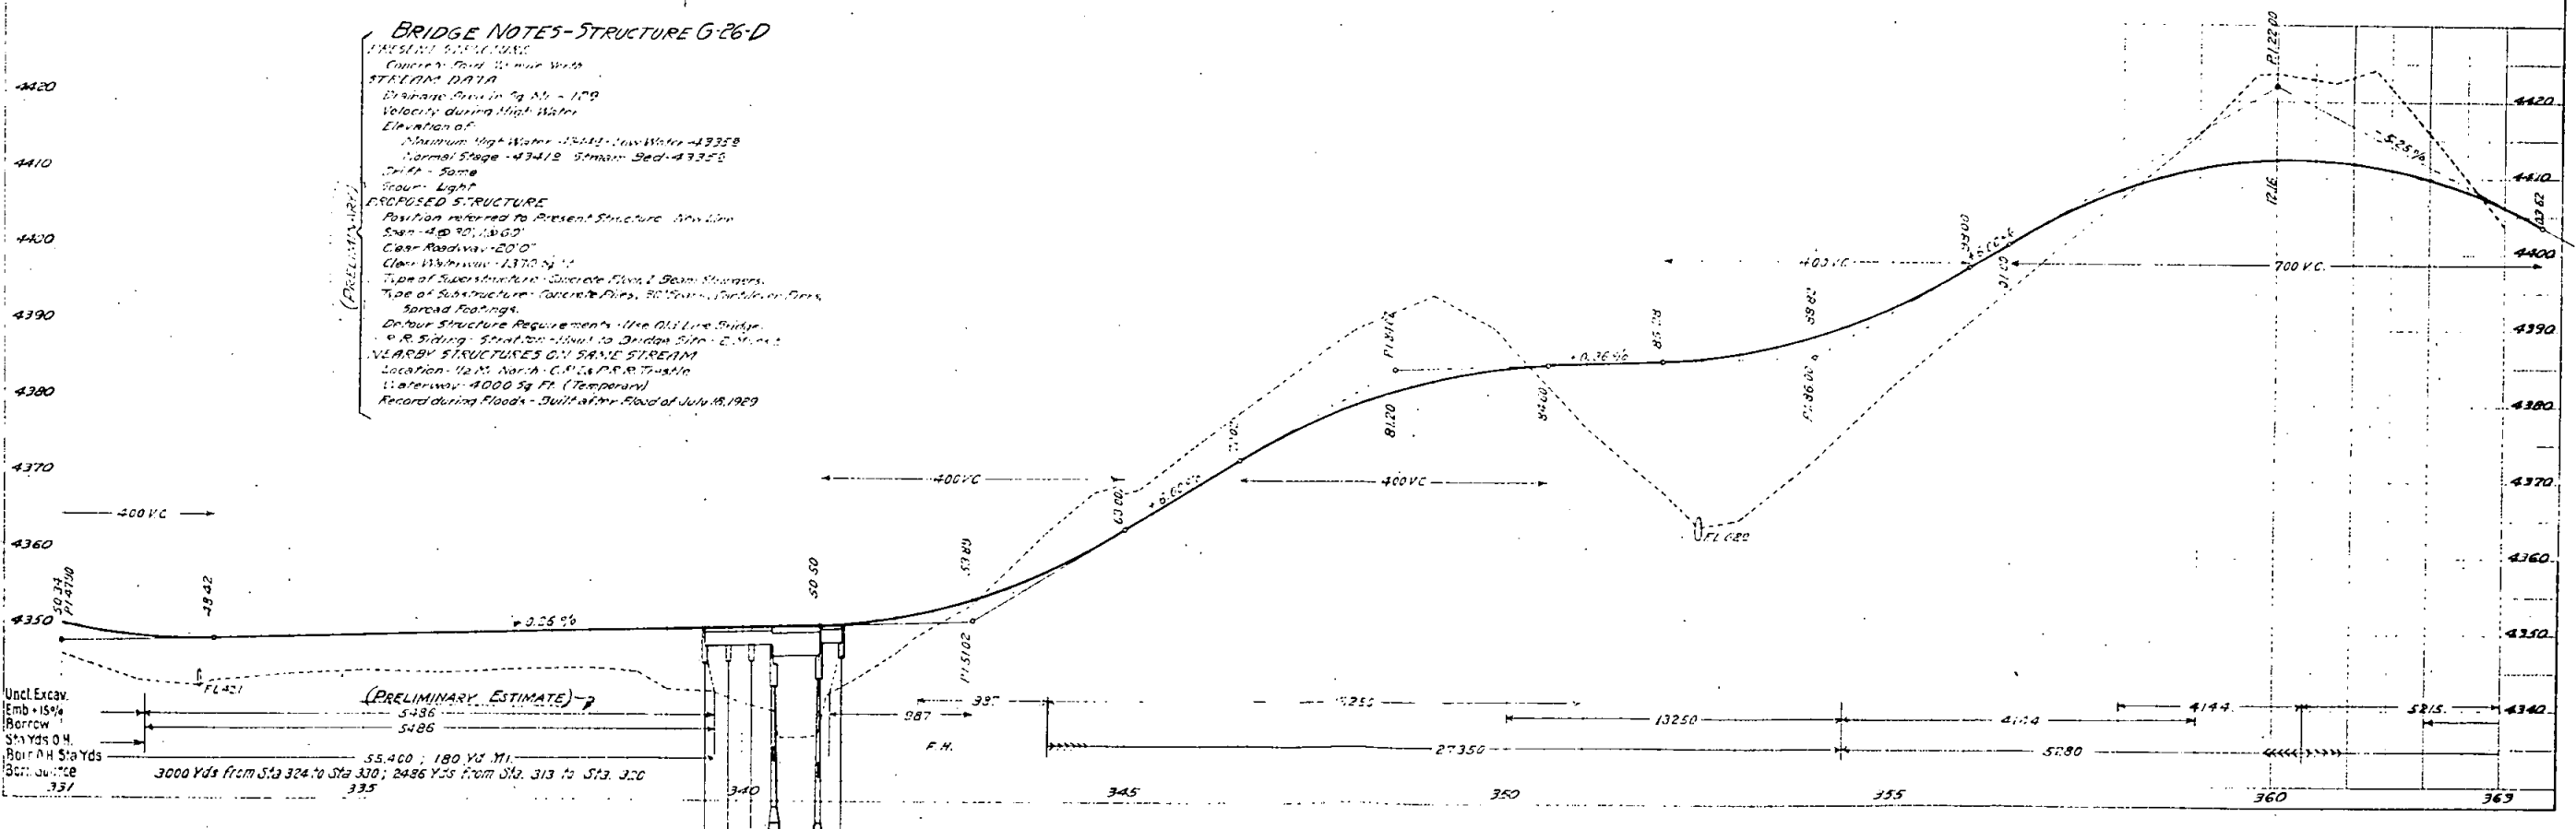

S.E. 1/4, SECTION 34,
T.85. R.47W.

S.W. 1/4, SECTION 35,
T.85. R.47W.

NO.	DATE	BY	NO.	TOTAL
1	1940	134-D	15	
Revised by County 4-27-33 H.B.K.				

Sta. 365+00 to Sta. 368+00
Reel Guard fence each side
760 Lin. feet

Sta. 370+00 to Sta. 374+00
Reel Guard fence each side

Sta. 380
Remove Fig. Pen

Sta. 390+00 Road
15" x 12" Cor. Man. pipe
Side ditch, 10 cu yds. Struct. Exc.
at 15' Road Approach, Rt.
Gates Req'd:
380+15 1 2'
391+10 1 2'

Sta. 363+00
Reel Gate LP

Sta. 366+
Remove Trash Dump

Sta. 366+00 Road
15" x 12" Cor. Man. pipe
(See Sheets No. 24 & 25)
36 cu yds. Struct. Exc.
Diversion Ditch, 128 cu yds
Unclassified Exc.

Sta. 370+35 to Sta. 378+80
Remove 4845 ft. Fence Railroad

Sta. 381+00 Road
15" x 12" Cor. Man. pipe
25 cu yds. Struct. Exc.
Structural Exc.


Sta. 390+00 Road
15" x 12" Cor. Man. pipe
Side ditch, 10 cu yds
Structural Exc.
Road Approach, Rt.

N.E. 1/4, SECTION 3,
T.25. R.47W.

N.W. 1/4, SECTION 2,
T.95. R.47W.

S.E. 1/4,
SECTION 35

N.E. 1/4,
SECTION 2

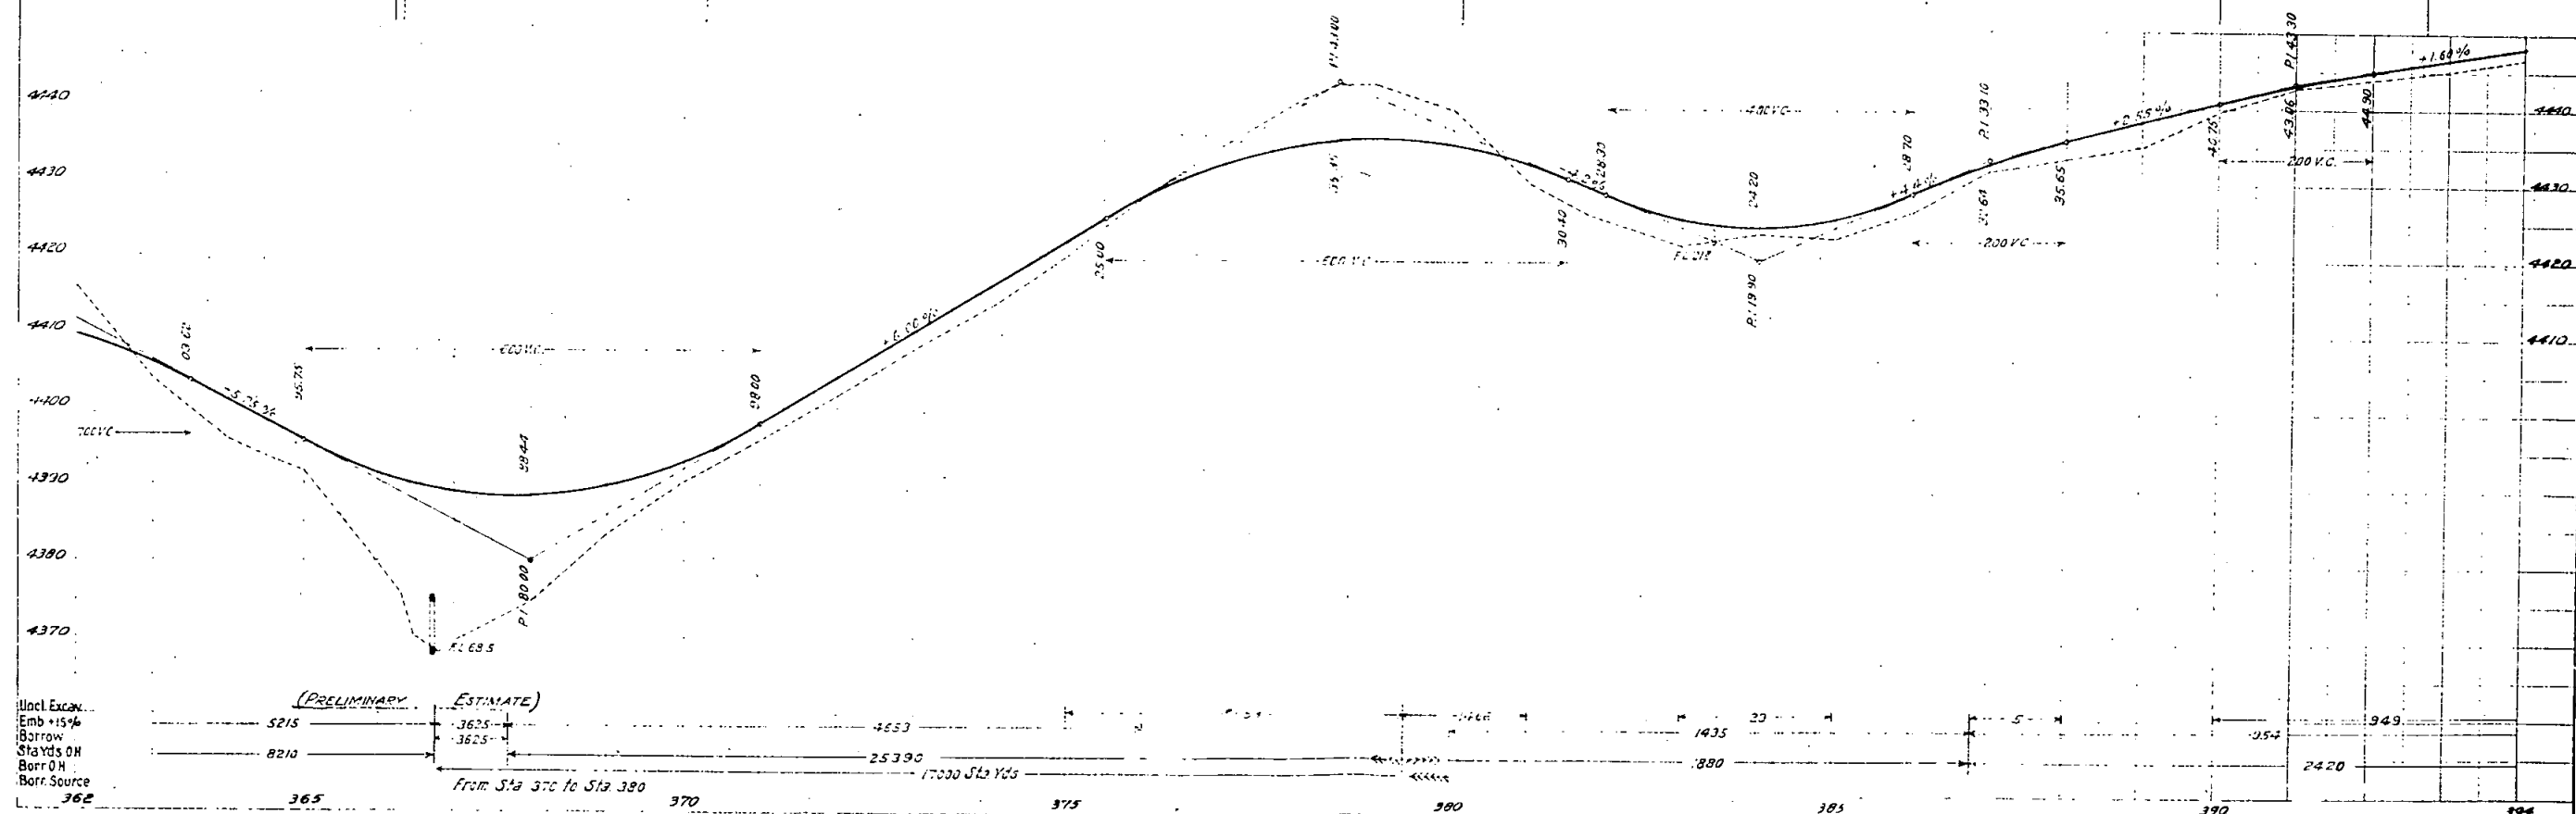

Revised at Construction 4-27-11 N.S.

[illegible]

Storöron

12/00/1971

59-45-25 (G) 20 48

1997/10/06 21:26 46.4KB


PAUL & CO. Kings "Wash"
Columbia River College, 1.2.20
106 W. 5th St. Portland, Ore.

Special Agent in Charge
U. S. Bureau of Customs
Kindly, New York Street
Excelsior.

Side Drive, 10 Cu. yds Struct. Exc. &
2 Road Approaches, RT. & LT.
Diversion Ditches on County Road:
270 ft N. 100 yds Unclass. Exc.
150 ft S. 100 yds " " "

Sta 423+33 Reqs 36 & 46
Corr. Metal Pipe Culvert.
1 Man all, 5 cu yds Struc.
Excavation

N.W. 1/4, SECTION 1,
T. 9 S. R. 47 W.

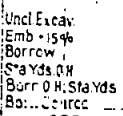

STRATTON

