

Rev. 11-19-41-P.B.B.-Net length of project; Str. D-13-H removed.
Rev. 1-22-46-S.H.L.-Tree Index
Rev. 5-13-47-W.H.M.-Chg. Div. and Res. Eng.

FED. ROAD DIST. NO.	STATE	FED. AID PROJ. NO.	SHEET NO.	TOTAL SHEETS
3	COLO.	151-A(3) 151-B(2) 151-C(3)	1	

COLORADO STATE HIGHWAY DEPARTMENT

PLAN AND PROFILE OF PROPOSED FEDERAL AID PROJECT NOS. 151-A(3) 151-B(2) 151-C(3) STATE HIGHWAY NO. 2 GRAND COUNTY

CONVENTIONAL SIGNS
CENTER LINE OF SURVEY 120
RIGHT OF WAY LINES
SECTION LINES
ONE QUARTER SECTION LINES
RAILROAD TRACKS (CENTER LINE)
WIRE CABLE GUARD FENCE
BARBED WIRE FENCE
TELEP, TELEG, & POWER LINES


INDEX OF SHEETS

- SHEET NO. 1..... SKETCH MAP AND TITLE PAGE
- 2..... TYPICAL CROSS SECTIONS AND SPECIAL DETAILS
- 3..... SUMMARY & LIST OF STRUCTURES/ROAD APPR. QUANTS. CONST. DIV. NO. 2
- 4..... SELECTED MATERIAL AND SURFACING PLANS
- 5..... STANDARD DOUBLE CONCRETE BOX CULVERT..... M-110-B
- 6..... " STRUCTURE NUMBER LETTERING..... M-10-A
- 7..... " YEAR NUMBER MARKING..... M-14-A
- 8..... " METHODS FOR SUPERELEVATION AND WIDENING OF CURVES..... M-1-B
- 9..... STAND. SIDE APPROACH ROADS, FLARING & SLOPE TREAT..... M-2-C
- 9A..... STANDARD ROAD CONSTRUCTION TRAFFIC SIGNS..... M-2-D
- 10..... STANDARD MANNER POST..... M-7-B
- 11..... " WIRE CABLE GUARD FENCE..... M-20-B
- 12-21..... PLAN AND PROFILE

SCALES ON ORIGINAL TRACINGS
ON PLAN, 1 IN. = 100 FT.
ON PROFILE (1 IN. = 100 FT. HORIZONTAL
1 IN. = 10 FT. VERTICAL

LENGTH OF PROJECTS

Stations	Roadway Lin. Ft.	Bridges Lin. Ft.
F.A.P. 151-C(3) BRIDGES OMITTED FROM PROJ.		
60+00.0 Begin		
156+87.4 Bk. EQ.	9,697.4	
157+03.7 An.		
162+22.0 Bk. EQ.	518.3	
162+03.7 An.		
170+51.0 Bridge End	847.3	
Bridge (Str. D-13-L)		58.0
171+09.0 Bridge End		
176+37.1 Bk. EQ.	528.1	
171+56.5 An.		
208+00.0 End	3,643.5	
Totals	15,224.6	58.0
Net Length 15,224.6 Ft. = 2.883 Mi.		
Bridges (omit) 58.0 Ft. = 0.011 Mi.		
Gross Length 15,282.6 Ft. = 2.894 Mi.		
F.A.P. 151-B(2) BRIDGES OMITTED FROM PROJ.		
208+00.0 Begin		
214+88.0 Bridge (Str. D-13-I)	688.0	
215+12.0 Bridge End		24.0
	11,193.8	
327+05.8 Bk. EQ.		
327+79.2 An.		
416+00.0 End	8,820.8	
Totals	20,702.6	24.0
Net Length 20,702.6 Ft. = 3.921 Mi.		
Bridges (omit) 24.0 Ft. = 0.004 Mi.		
Gross Length 20,726.6 Ft. = 3.925 Mi.		
F.A.P. 151-A(3) BRIDGES INCLUDED IN PROJ.		
416+00.0 Begin		
543+25.0 Bridge End	12,725.0	
C.B.C. (Str. D-13-F)		23.0
543+48.0 Bridge End		
544+00.0 End	52.0	
Totals	12,777.0	23.0
Gross and Net Length 12,800.0 Ft. = 2.424 Mi.		

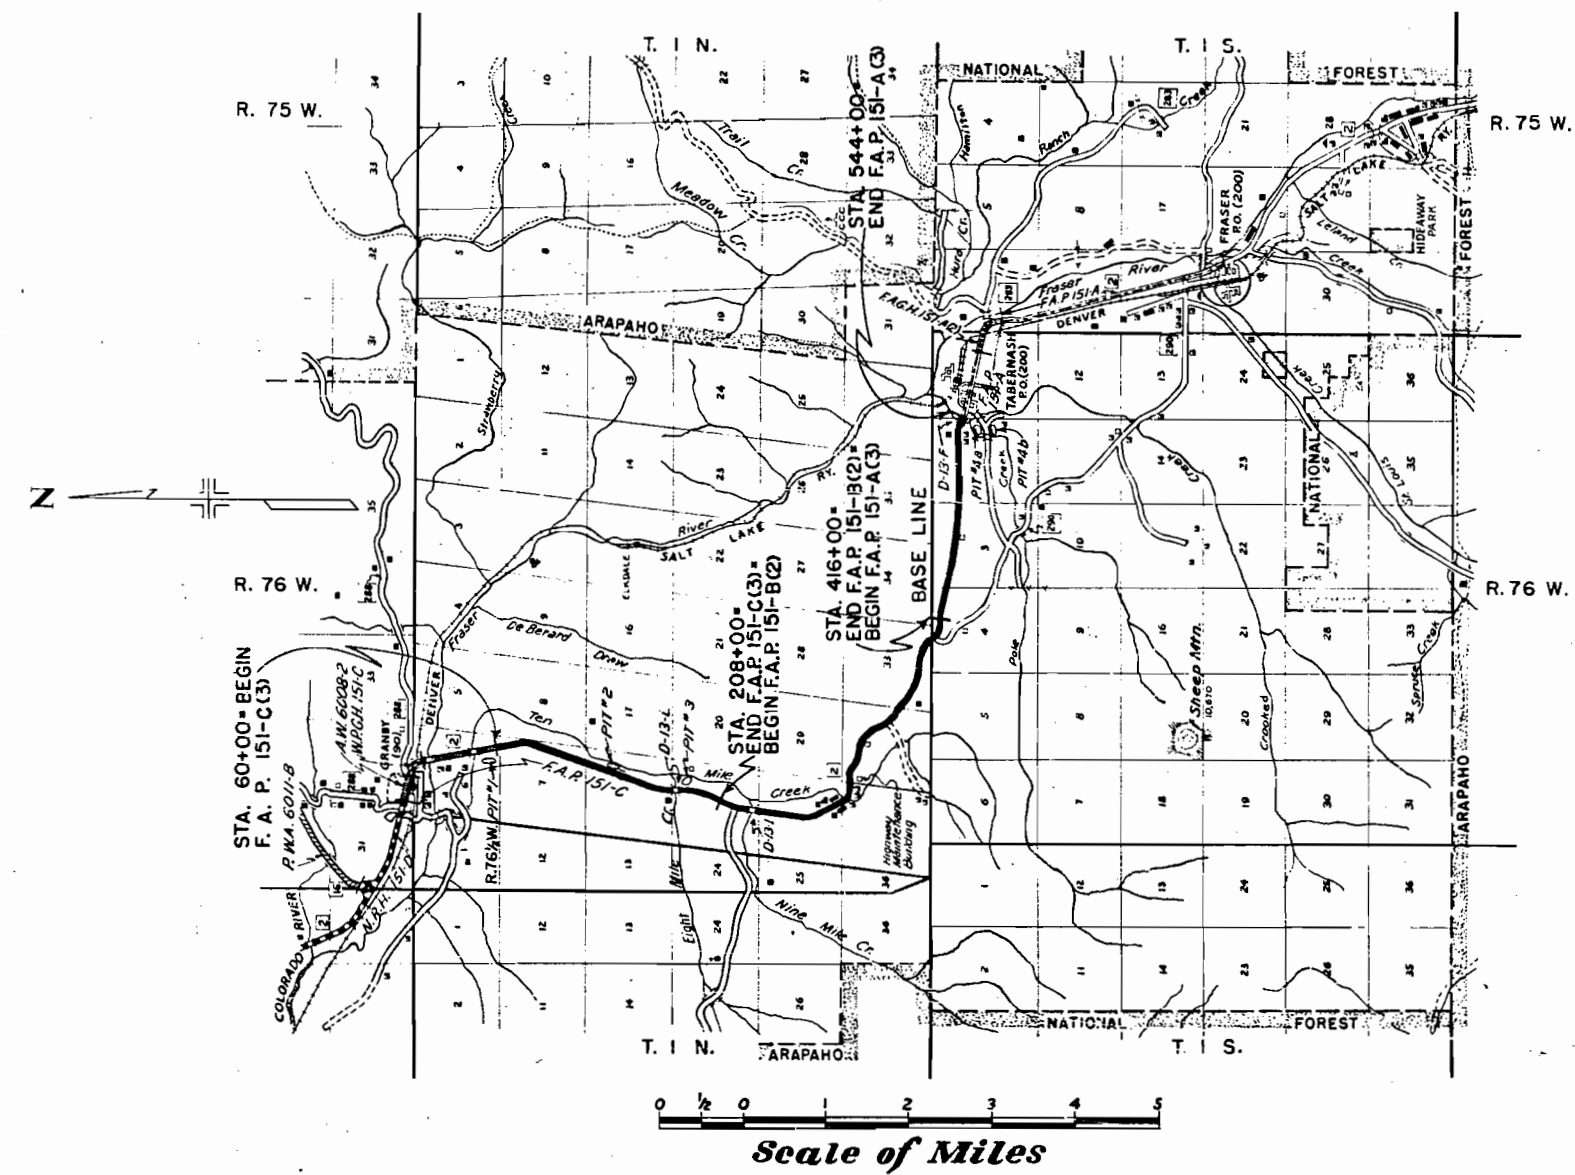

NOTE-
It is recommended that bidders on this Project go over the plan details with one of the following field representatives of this department:
E.E. Montgomery, Division Engineer, Denver, Colorado
F.W. Miller, Resident Engineer, Denver, Colorado.

RECOMMENDED FOR APPROVAL
A.F. Hewitt
ASSISTANT ENGINEER
DATE 9-17-41

APPROVED
Chas. J. J.
STATE HIGHWAY ENGINEER
DATE

RECOMMENDED FOR APPROVAL
DISTRICT ENGINEER
PUBLIC ROADS ADMINISTRATION
FEDERAL WORKS AGENCY

RECOMMENDED FOR APPROVAL
CHIEF, WESTERN REGION
PUBLIC ROADS ADMINISTRATION
FEDERAL WORKS AGENCY

APPROVED
COMMISSIONER
PUBLIC ROADS ADMINISTRATION
FEDERAL WORKS AGENCY

PRO FILE	BY	DATE
NOTE BOOK	SCHWARTZ	
	KLUTZ	
	GRADIS GILCHRIL	
	B. M. A. NOTIC	
40		



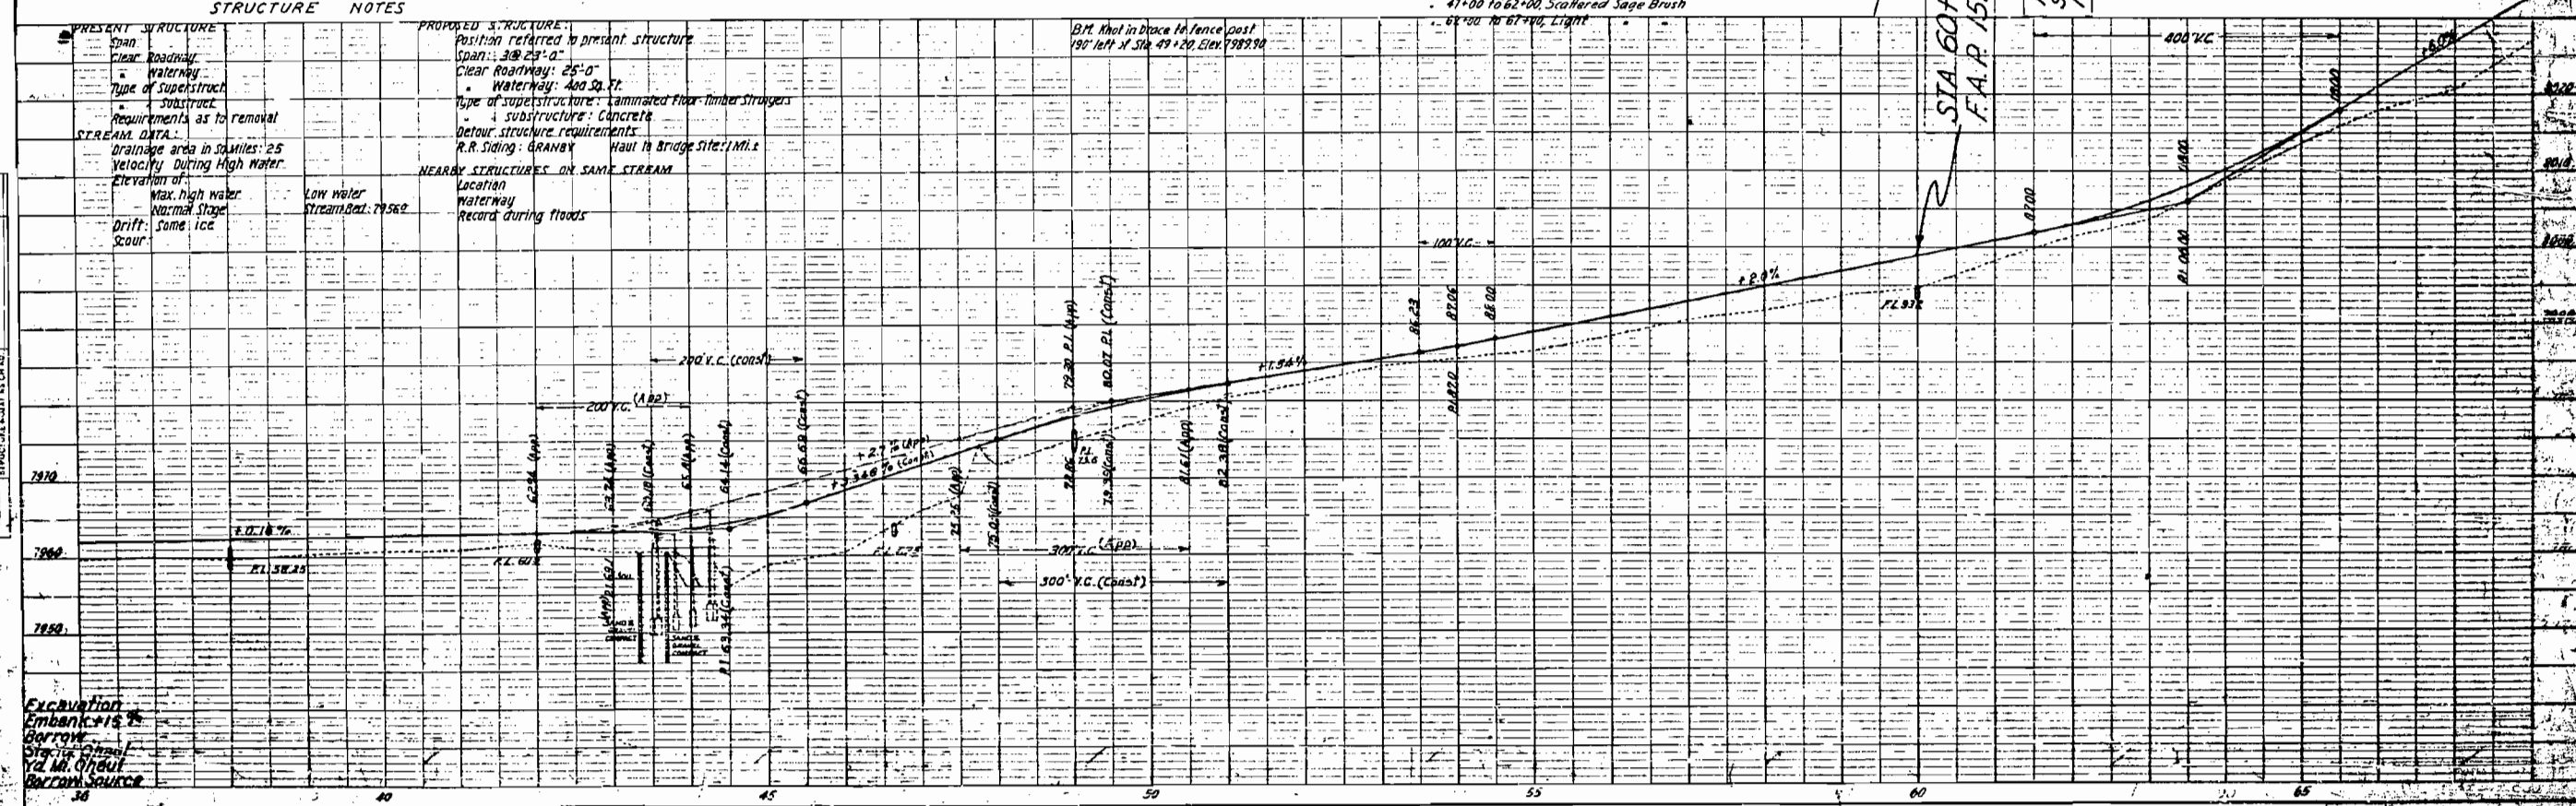


PLATE 1-PLAN-PROFILE C. P. P. & R. R. STATIONS
 COLLEGE ST. & 1000 S. W. 4. 10734

PLAN	BY	DATE
DESIGNED		
PLOTTED		
NOTED BOOK		
ALIGNMENT CHECKED		
RT OF WAY CHECKED		
NO. 632		

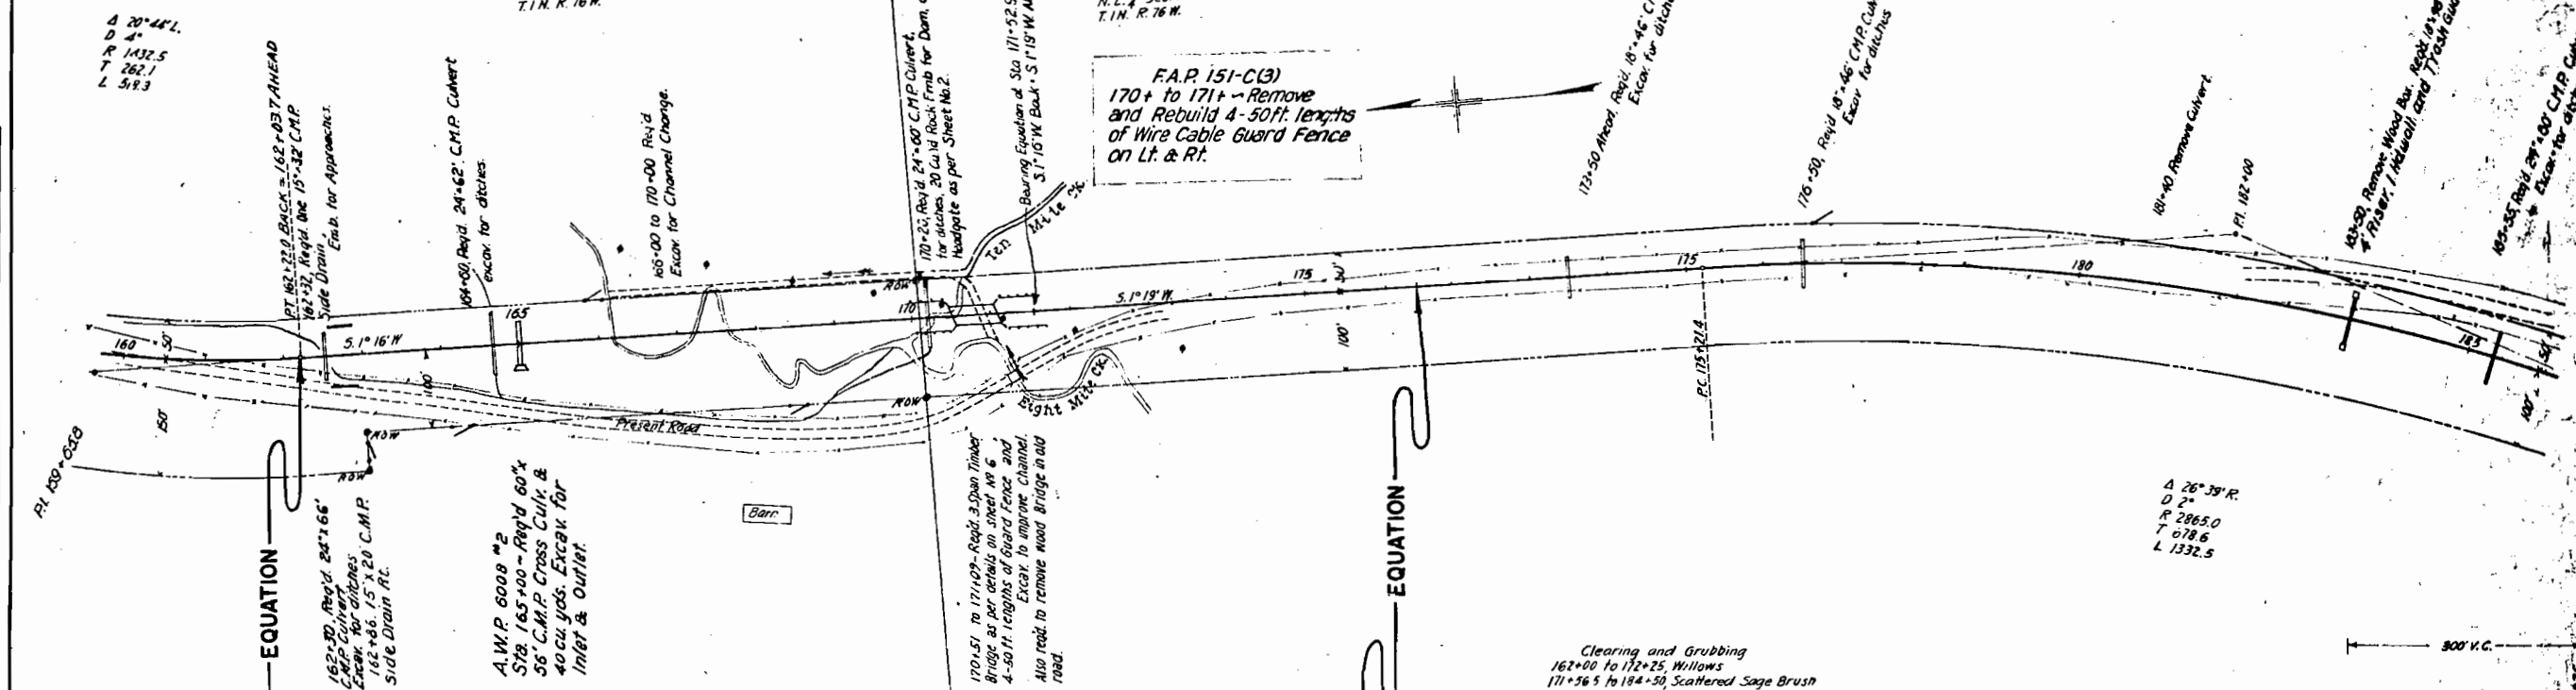


PROFILE	BY	DATE
SUNFIELD		
PLANT		
CAVING CHIEF		
B. M. MOTT		
STATION		

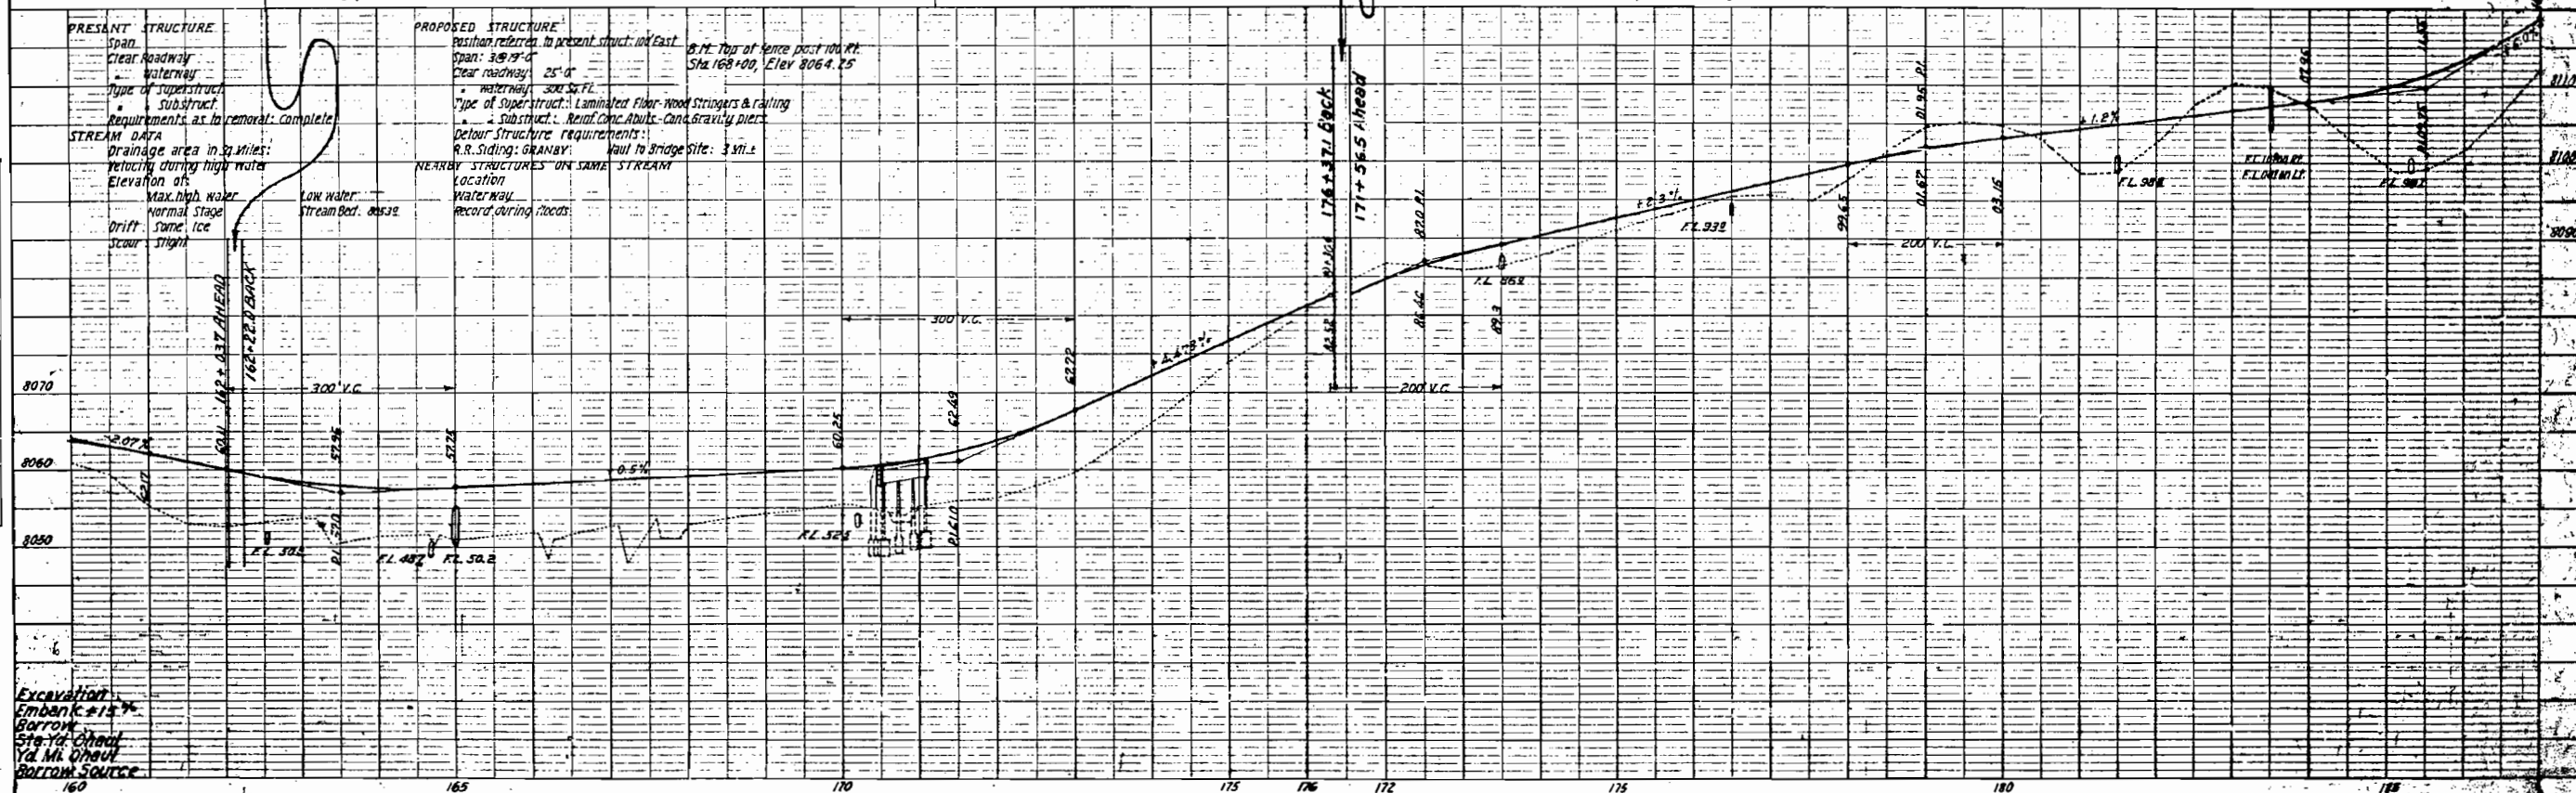


STATE	COUNTY	SHEET NO.	TOTAL SHEETS
IND.	CLAY	151 B	15
		F.A.R.	
		151-B(2)	

F.A.R. 151-B(2)
214+ to 215+ - Remove and
Rebuild 4-50 ft. lengths of
Wire Cable Guard Fence on
Lt. & Rt.

PLAN	DATE	BY	CHKD.
12-3-31	W.E.G.	H.S.D.	
12-3-31	W.E.G.	H.S.D.	
12-3-31	W.E.G.	H.S.D.	

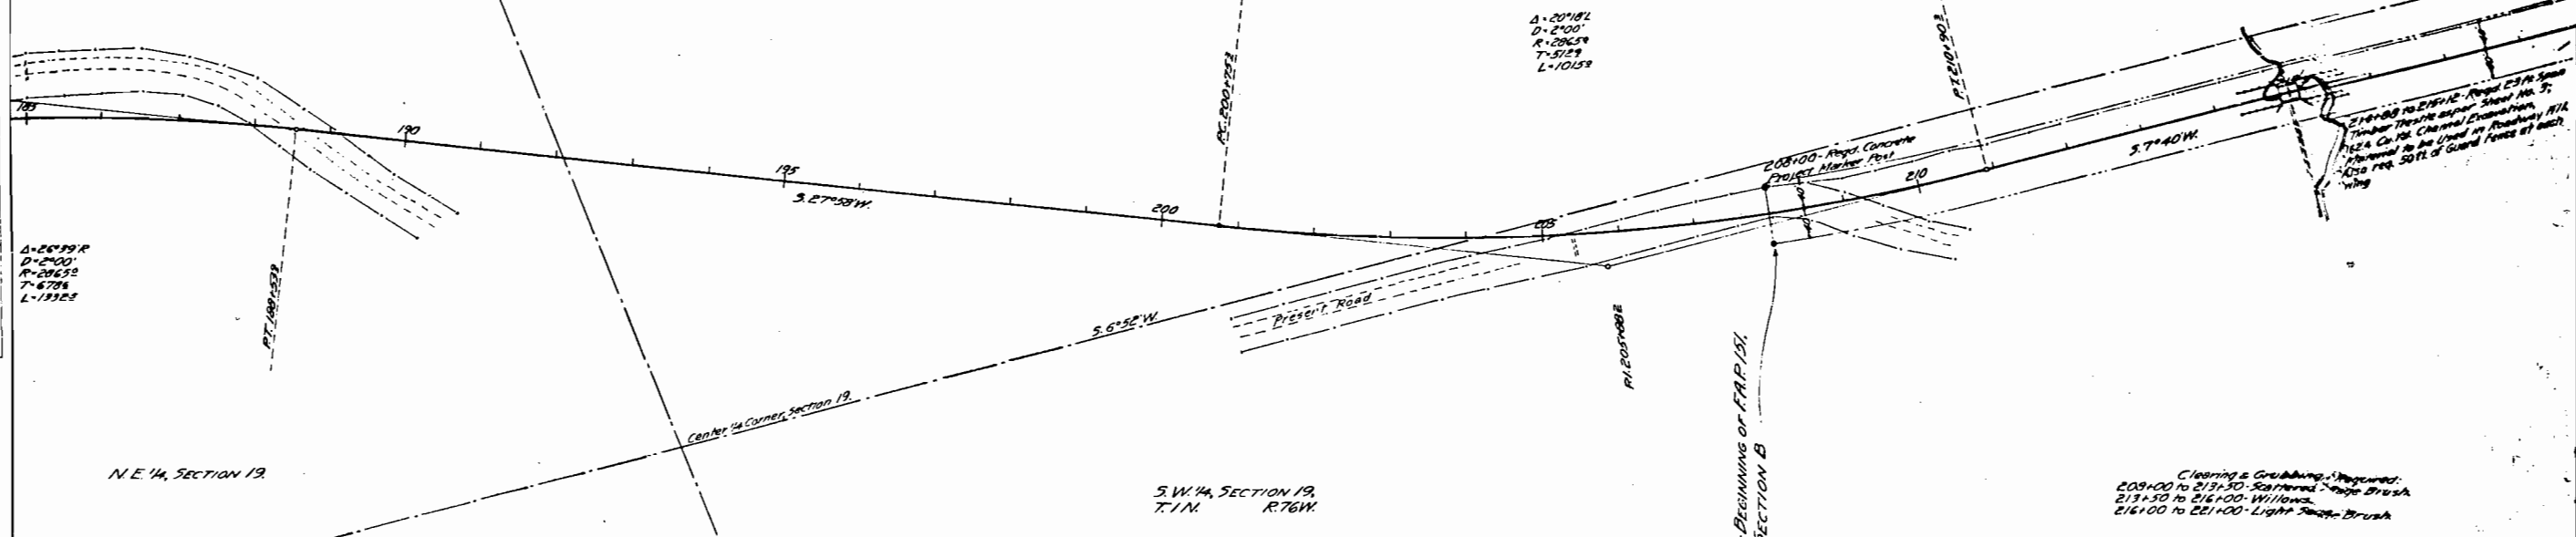


PROFILE	DATE	BY	CHKD.
12-3-31	W.E.G.	H.S.D.	
12-3-31	W.E.G.	H.S.D.	
12-3-31	W.E.G.	H.S.D.	

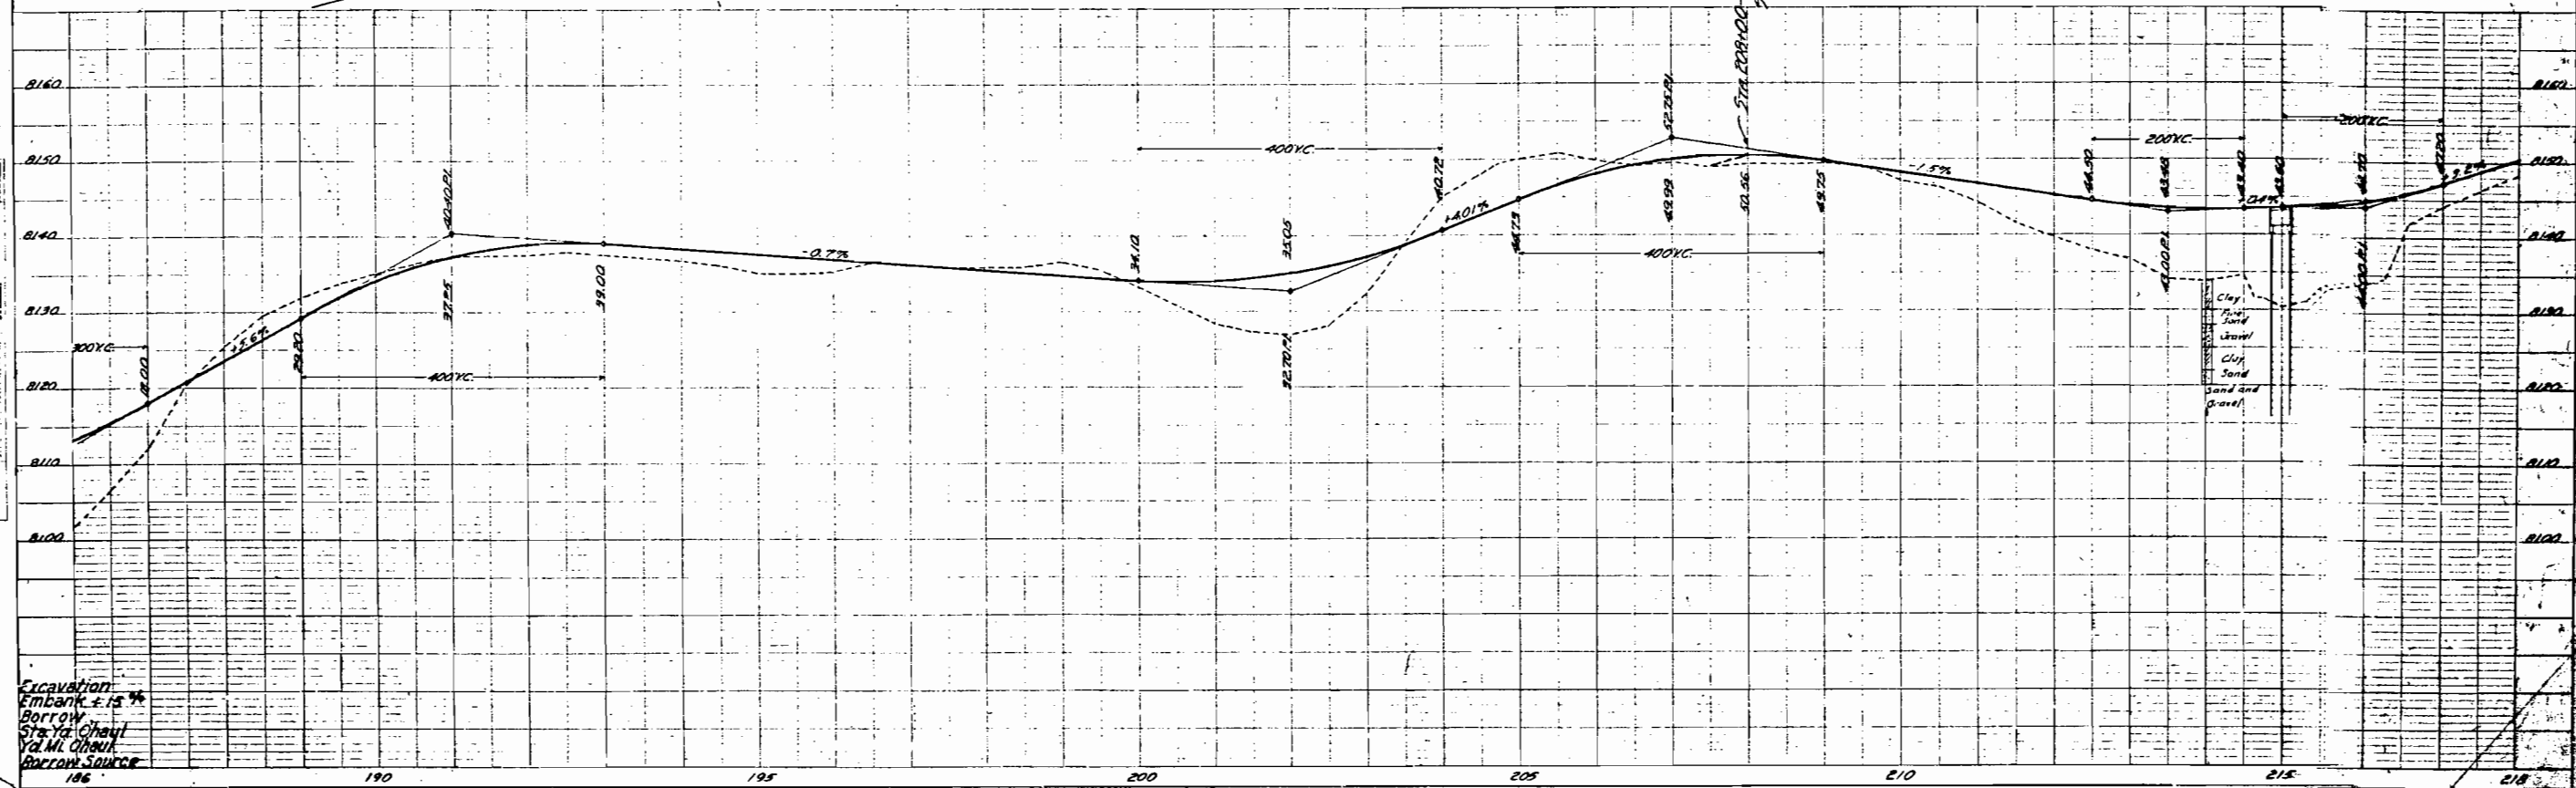

Excavation
Embankment
Borrow
Sta. 194 Chaul
Sta. 195 Chaul
Borrow Source

PROFILE	BY	DATE
WILSON		
PERIOD		
DATE BOOK		
DATE		
BY		
NO. FILE		

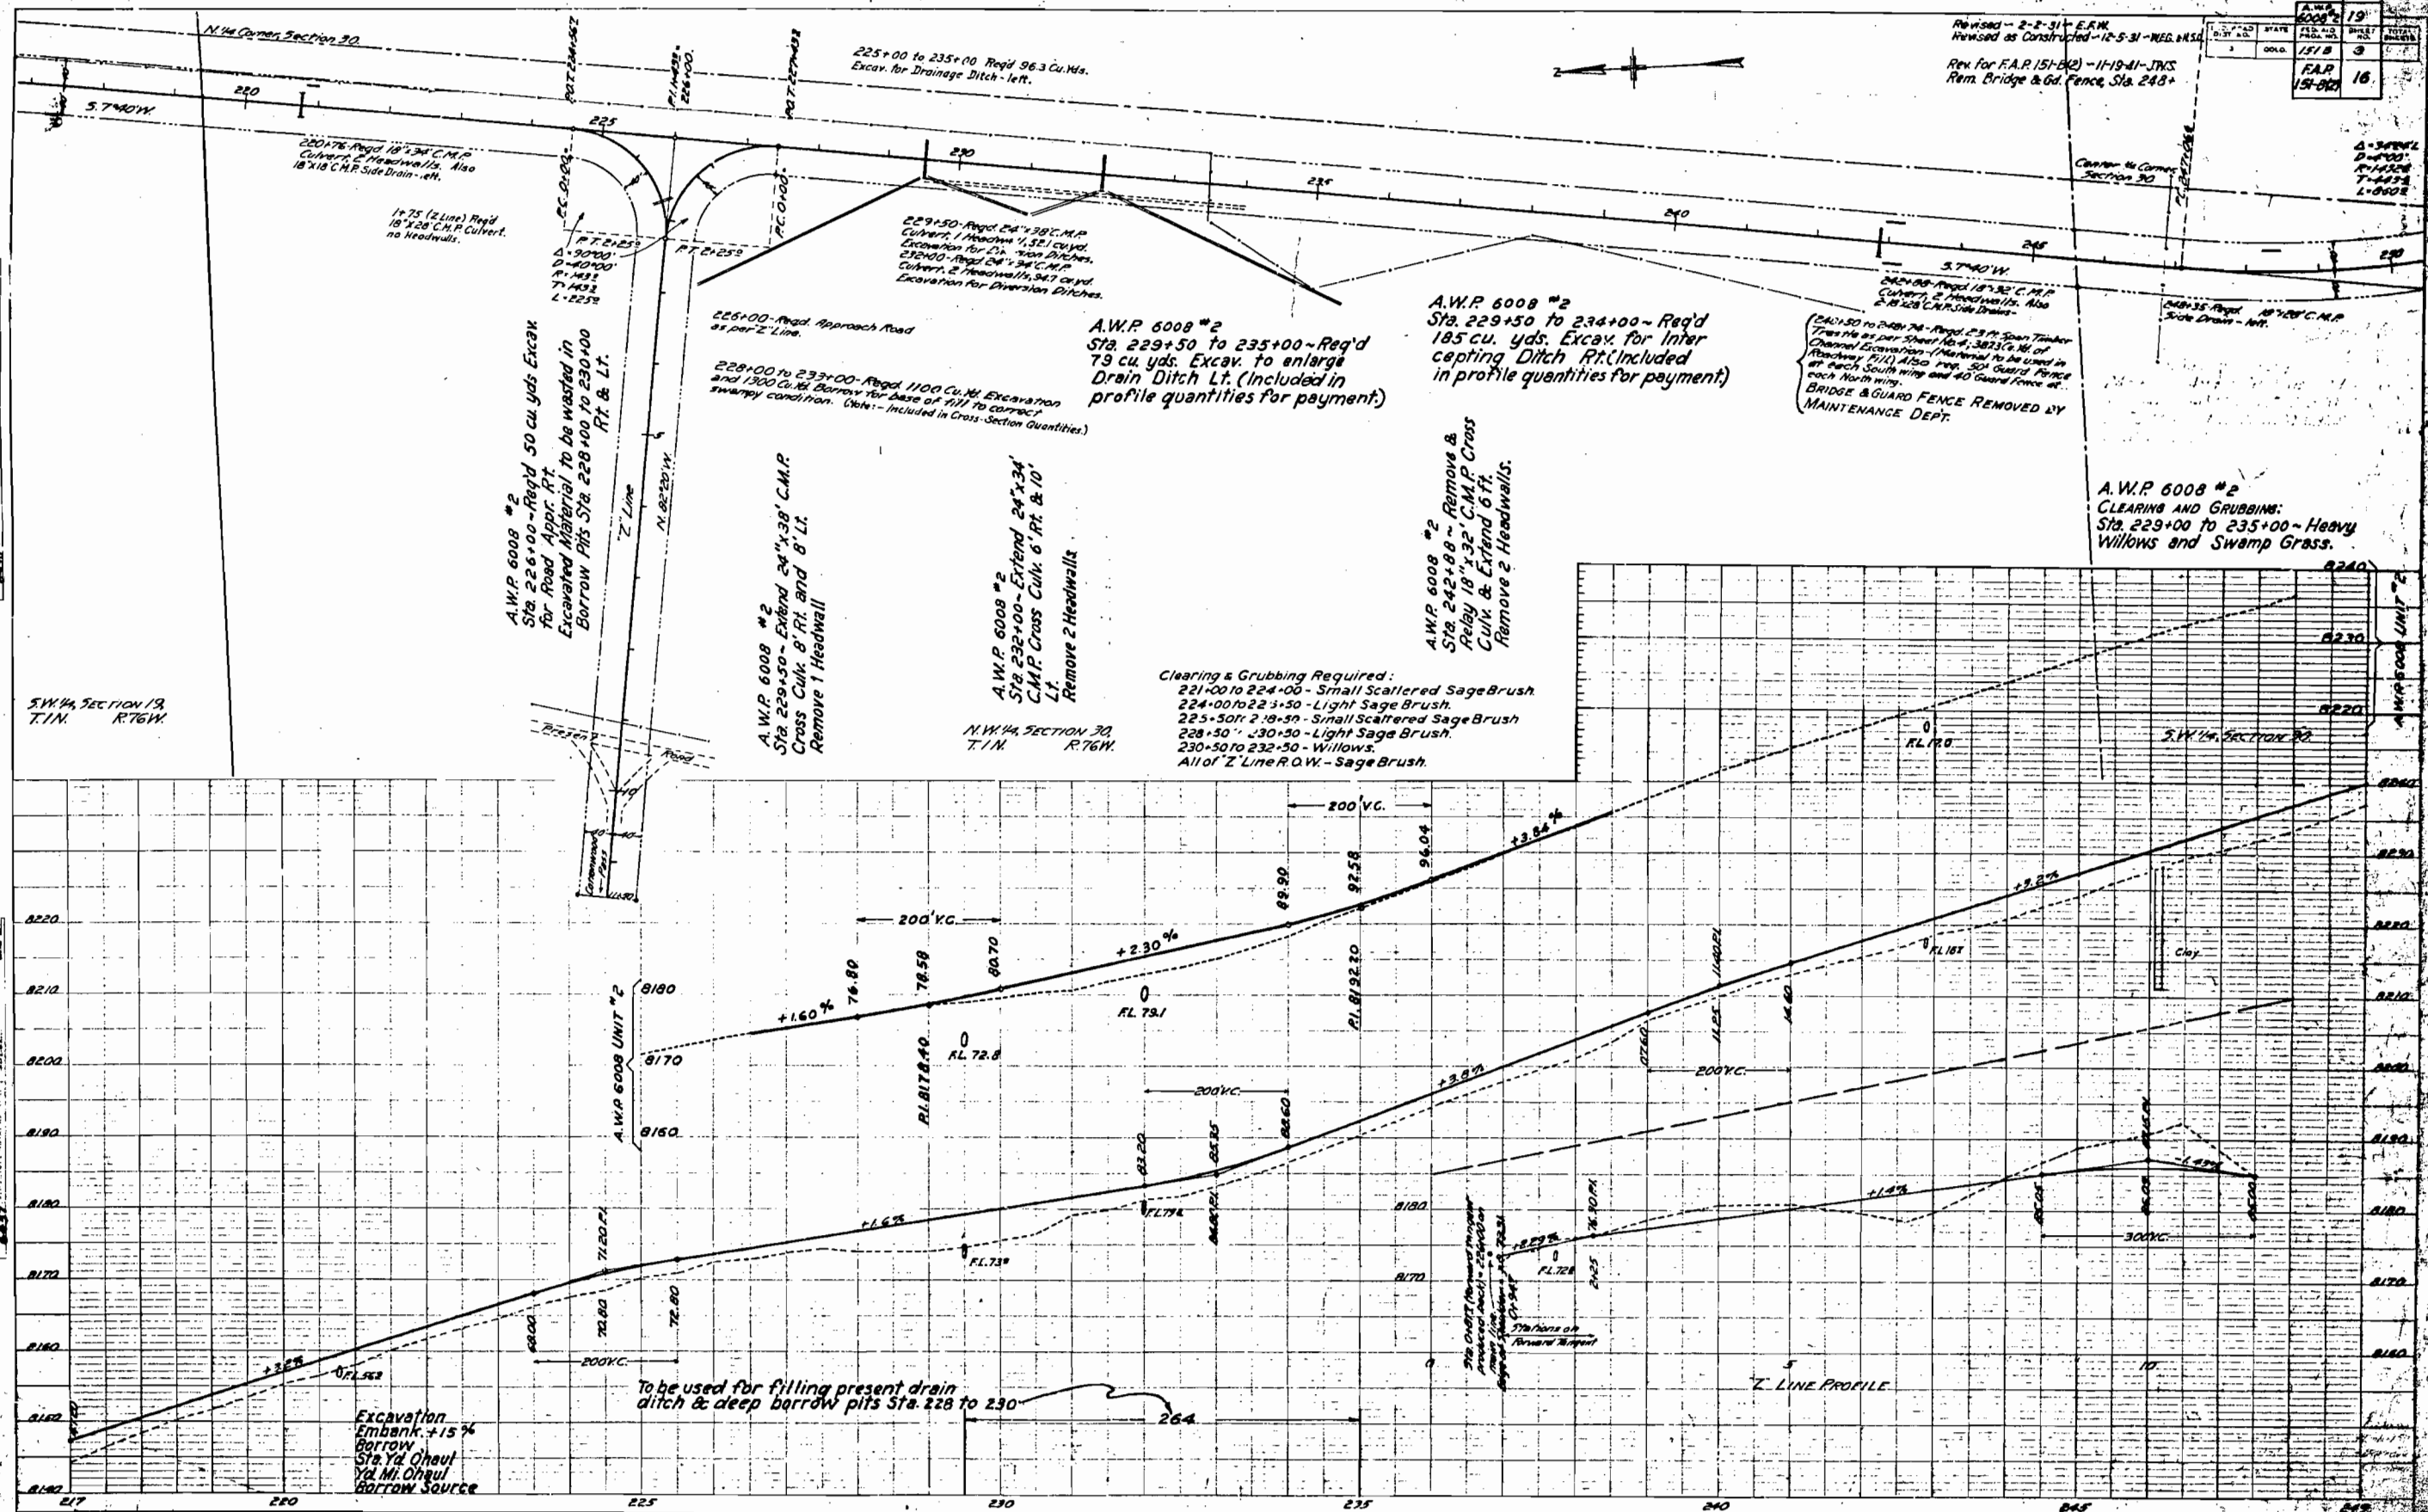

PROFILE	SURVIVED	BY	DATE
NOTE DOOR	PLOTTED		
B M 3 NOTED	GRADES CHECKED		
NO. 2256			
220			
STRUCTURE NOT AT NS CH'D.			
			10/1/51



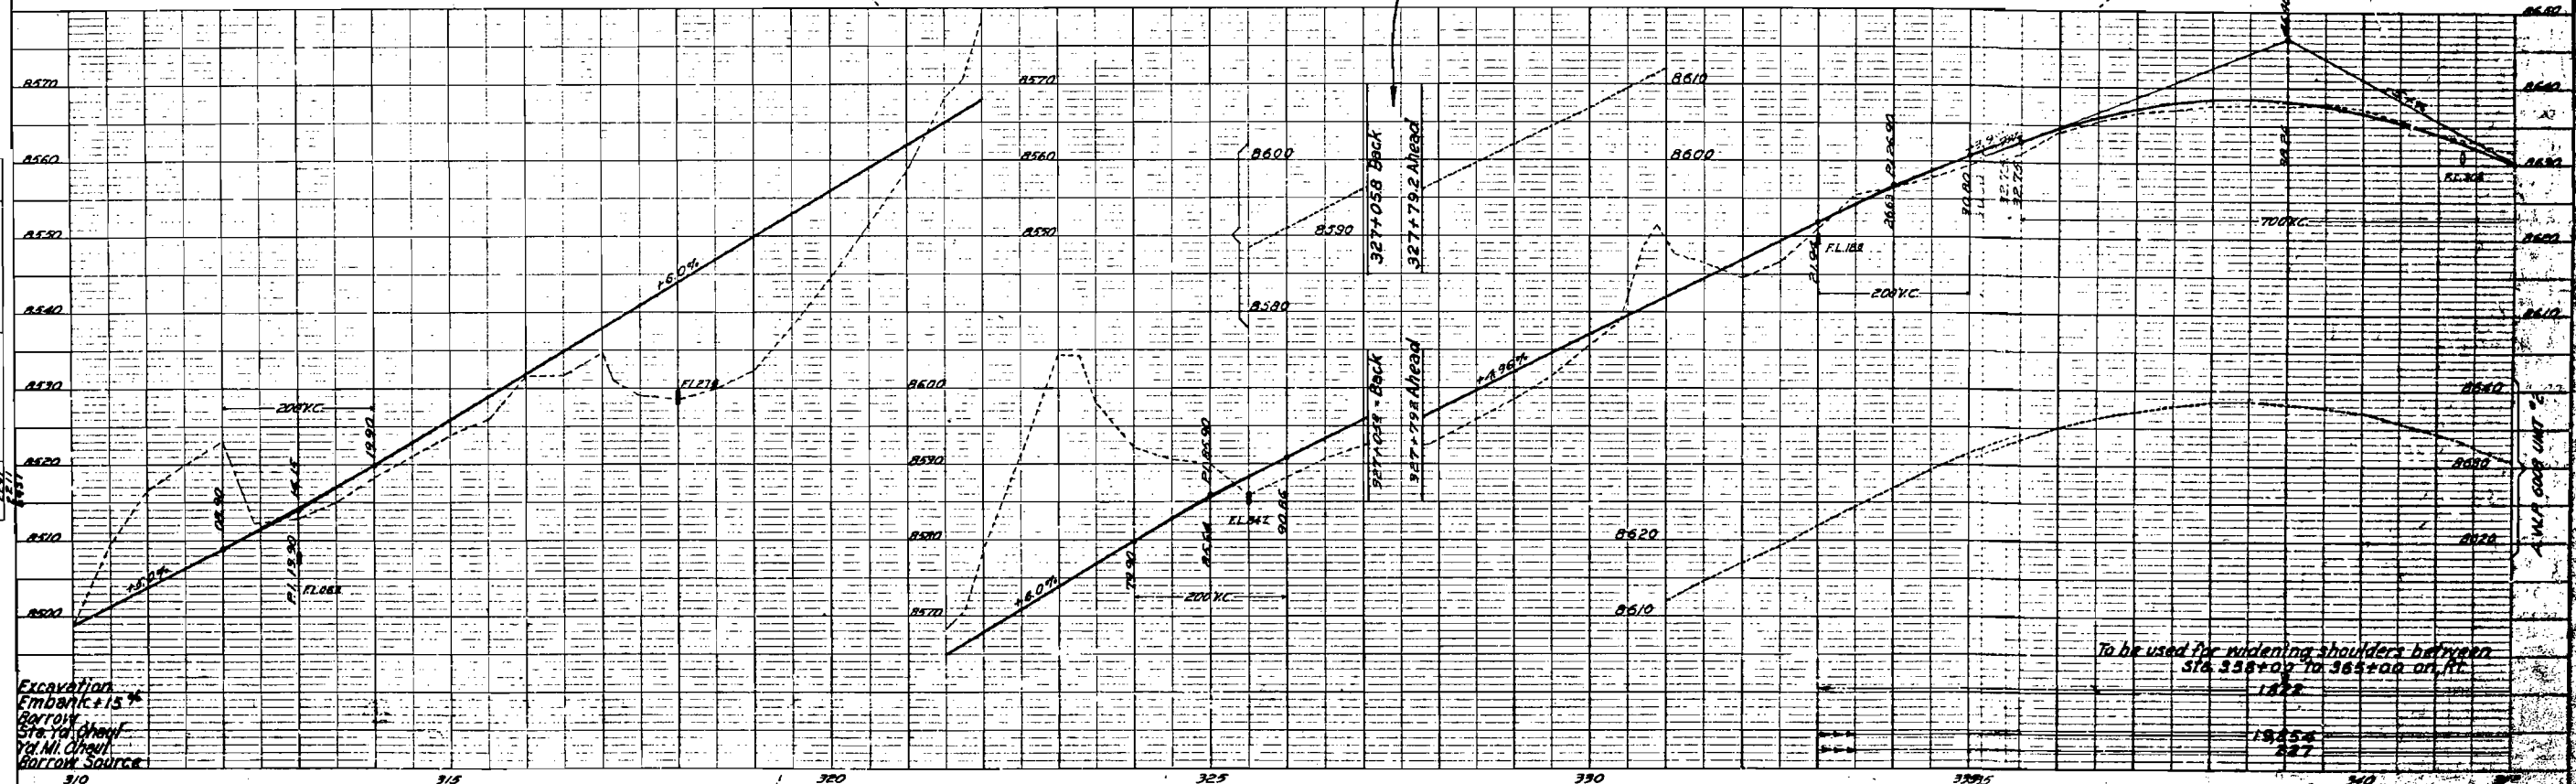



PLATE 1-PLAN-PROFILE O. P. R. & R. E. STANDARD
- M. E. E. & E. E. CO. NEW YORK -

PLAN	DATE	BY	DATE
DESIGNED			
CHECKED			
NOTED			
DATE			

PROFILE	DATE	BY	DATE
DESIGNED			
CHECKED			
NOTED			
DATE			

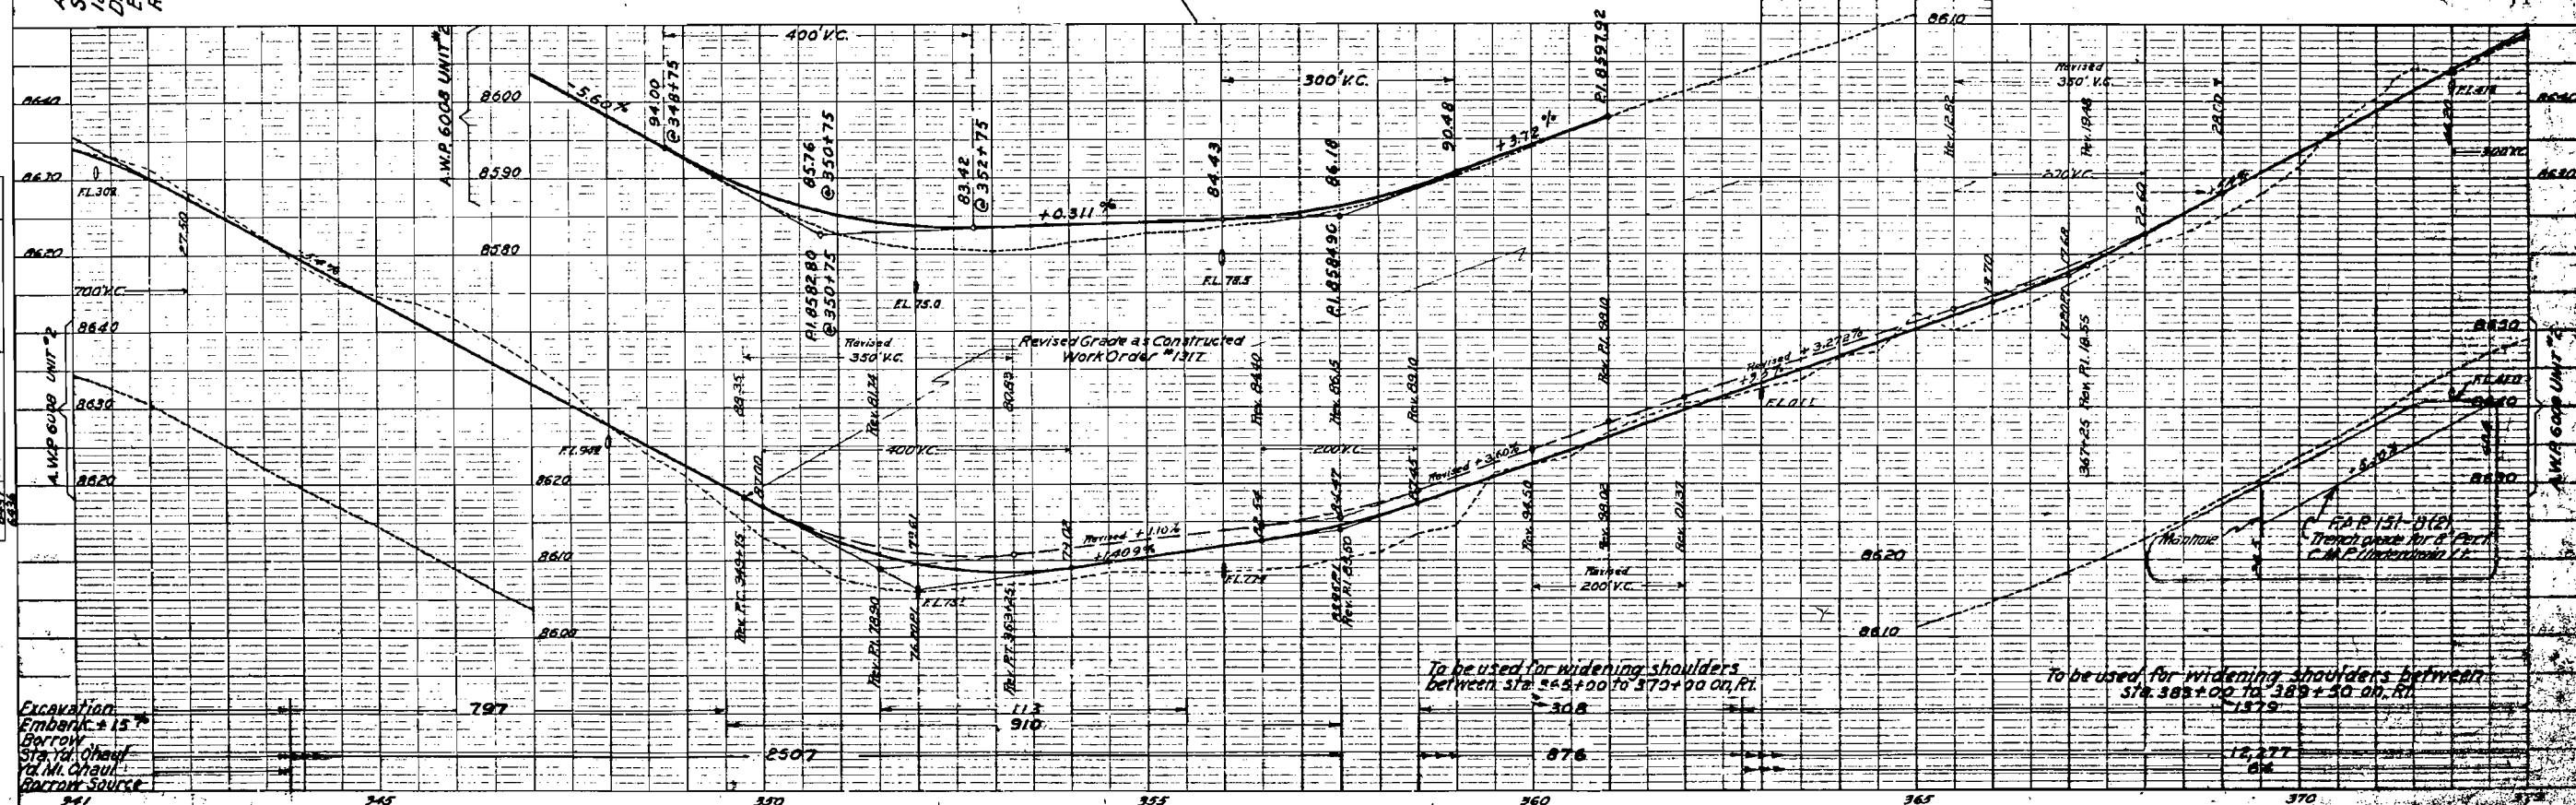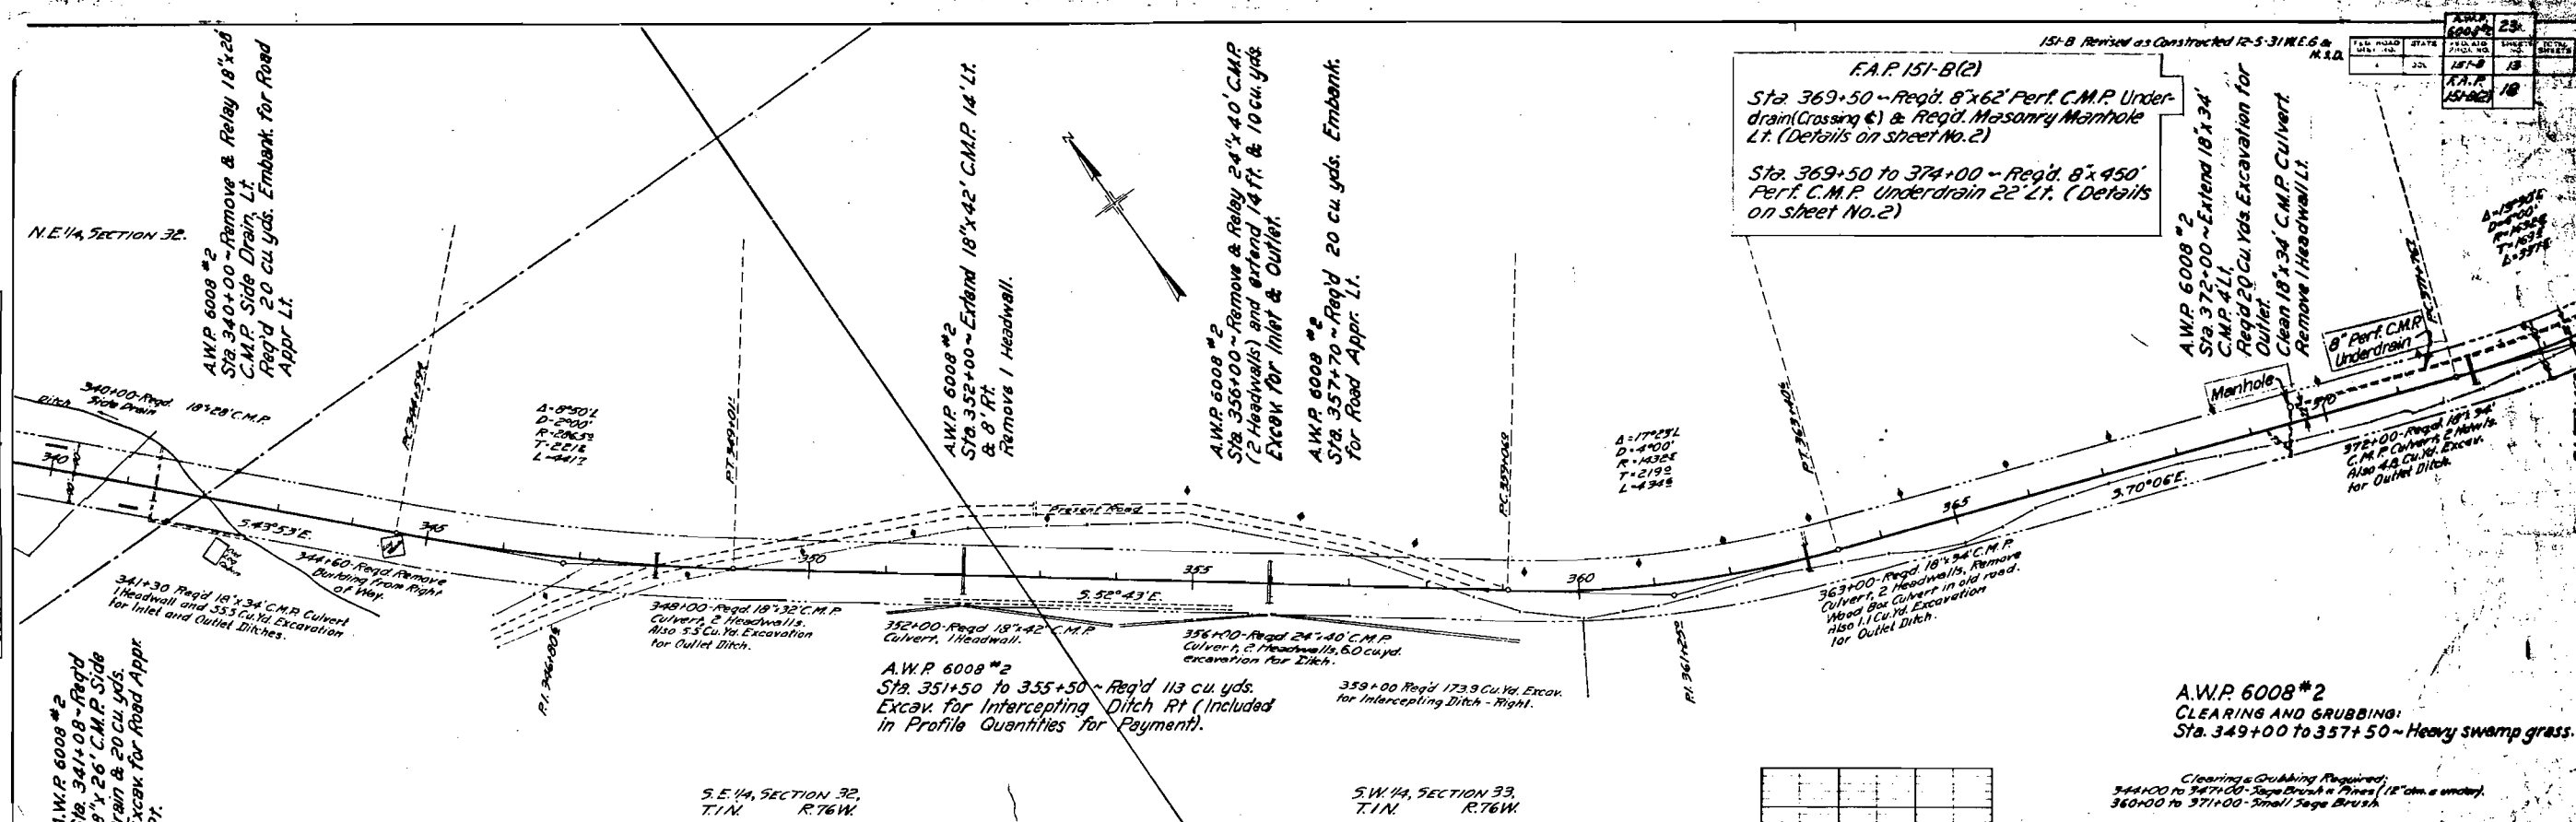

PROFILE	SUPPLIED	BY	DATE
NOTE FROM	PUTTED		
6 M3 NOTED	GOODS CHECKED		
NO. 2278			
6.17	STRUCTURE NOT AS CHD.	2.10.0	10/1/77

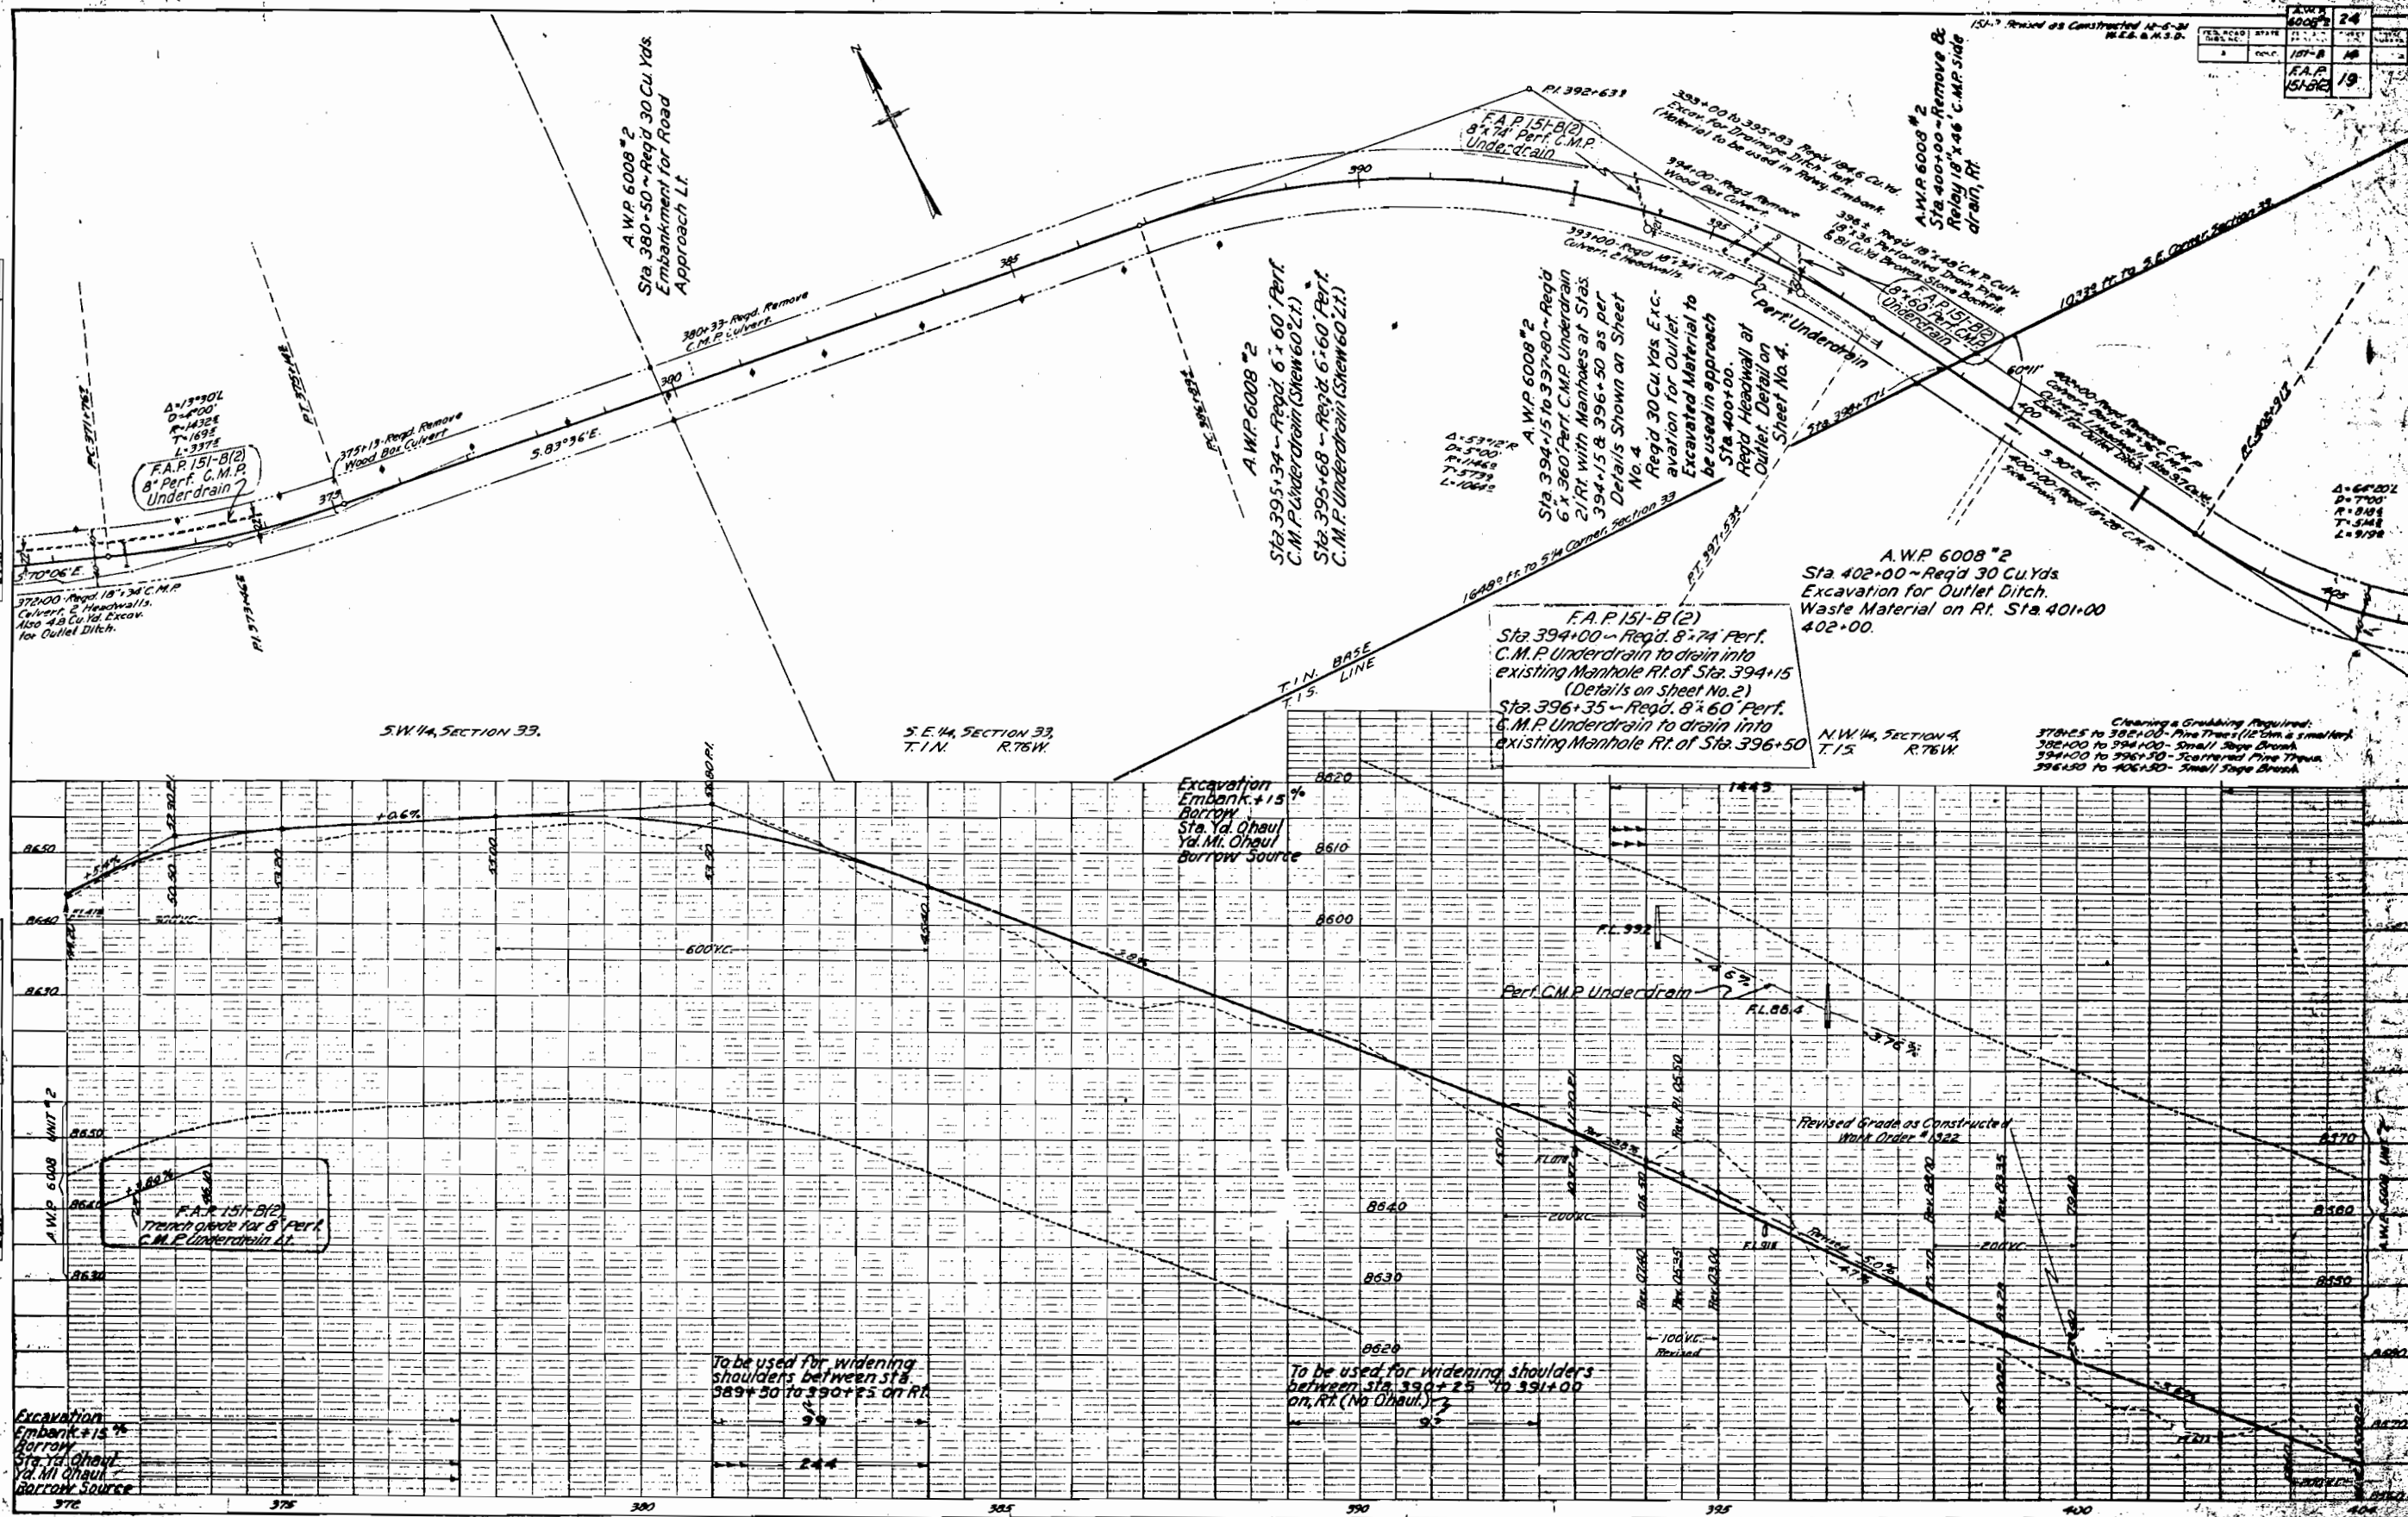


151-B Revised as Constructed 12-5-31 M.E.A. & H.S.D.

FED. ROAD DIST. NO.	STATE	FED. ROAD DIST. NO.	SHEET NO.	TOTAL SHEETS
151-B	PA	151-B	18	20

PLAN	DATE
NO. 2208	12-5-31
NO. 2208	12-5-31
NO. 2208	12-5-31

PROFILE	DATE
NO. 2208	12-5-31
NO. 2208	12-5-31
NO. 2208	12-5-31

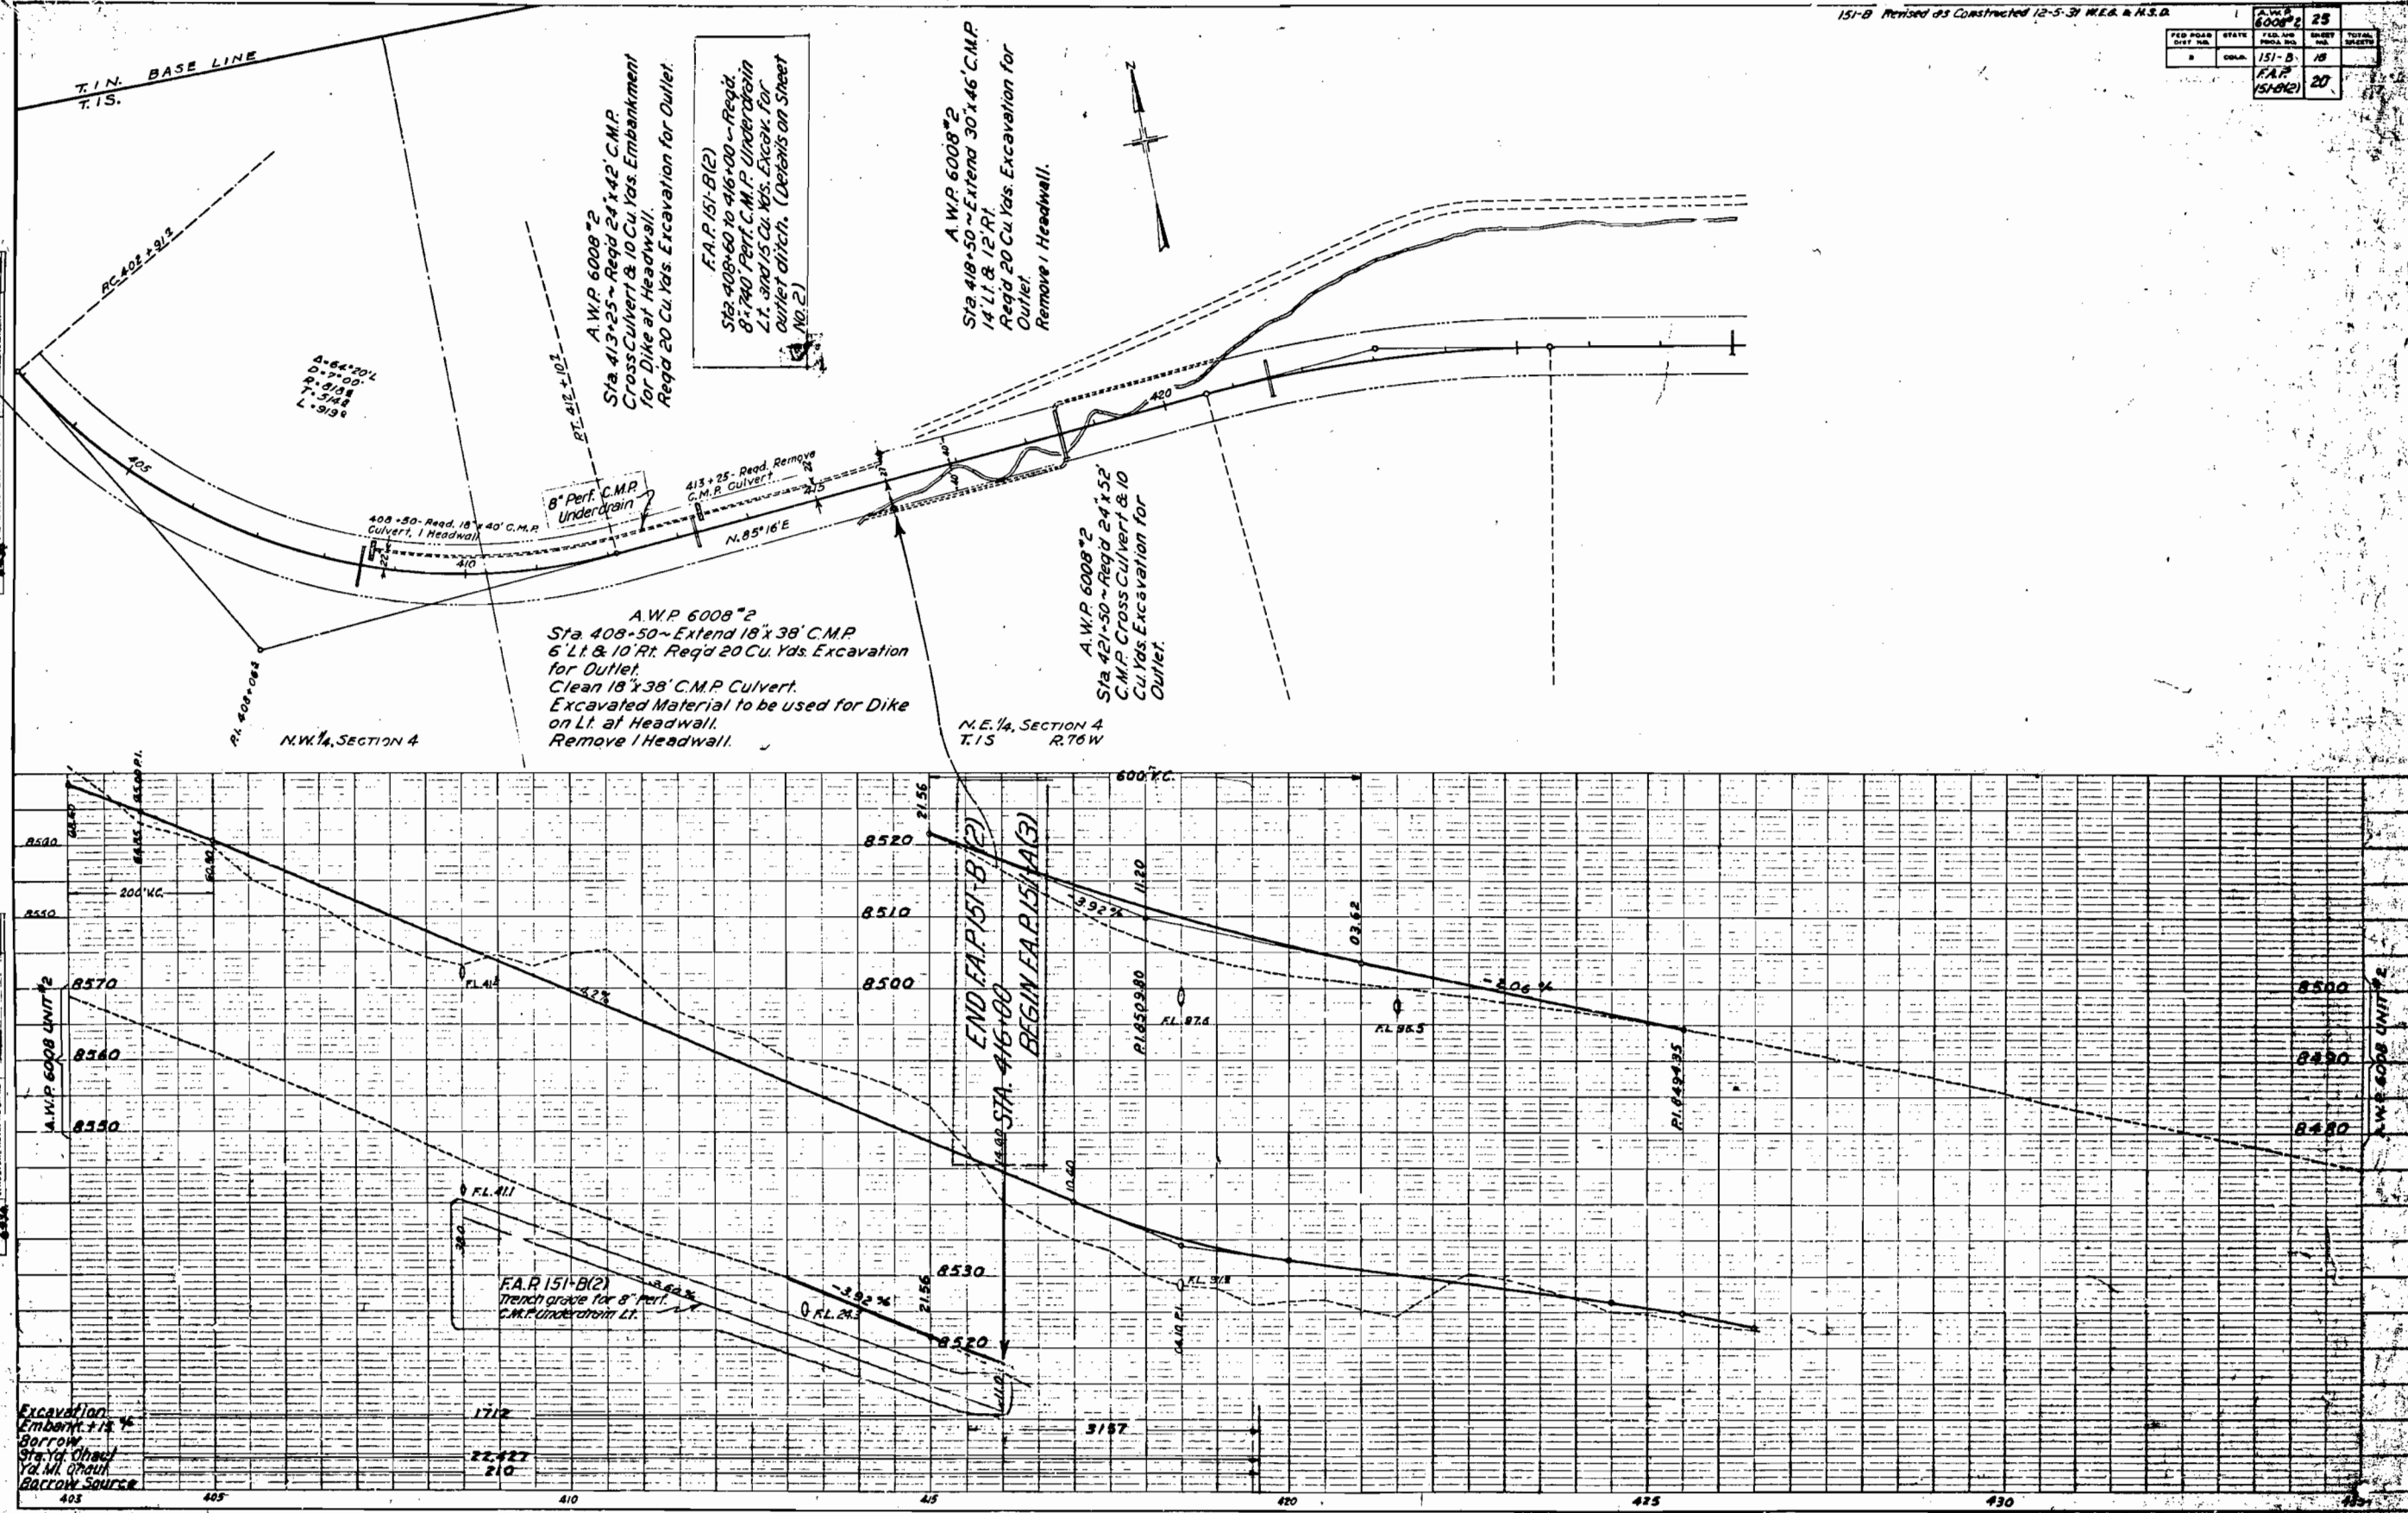

PROFILE	SUBMITTED	BY	DATE
NOTE (C-2)	LOT/L		
NO. 256	GRADERS CHECKED		
	M-3 NOTED		
	STRUCTURE NOTED AS CH. ED.	5.1.1	Nov 27

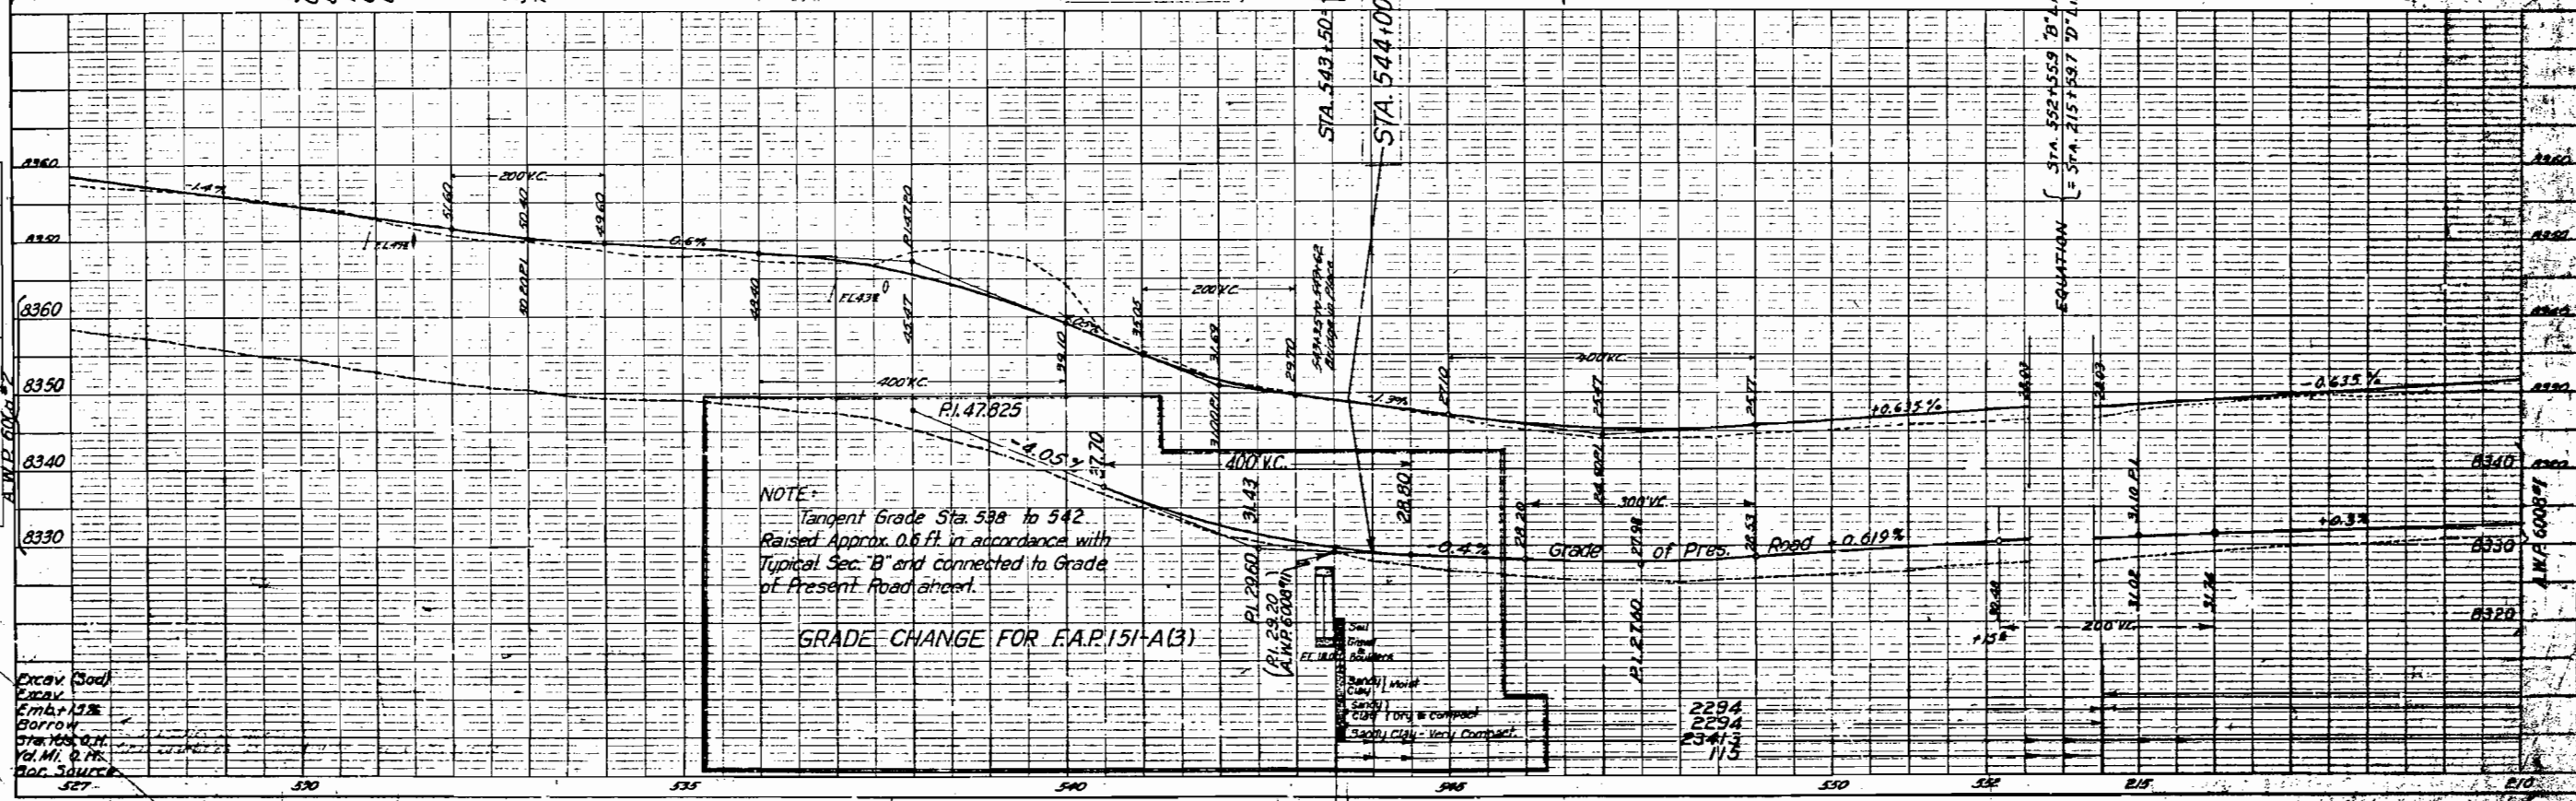


PLATE 1-PLAN-PROFILE D. P. R. L. R. C. STANDARD