

S.H. 7

REGION 9 STATE COLORADO
PROJECT 26-2(2), South St Vrain
SHEET 1 OF SHEETS

A.O.

INDEX TO SHEETS		
SHEET No	DESCRIPTION	STATION TO STATION
1	Title Sheet	
2	Typical Sections	
3	Summary	
22-24	Plan & Profile	569+70 606+00.60
Std. 108	Metal End Sections and Fill-Gage Tables	
Std. 108 A	Metal End Sections	
Std. 131	Maintenance Post and Delineators	
Std. 136	Wire Fences with Steel Posts	
Std. 143	Project Identification Signs	
Std. 163	Timber Guide Posts	
R9-SP. 141	Intersection Detail	579+20 588+57

Plans prepared by: B.P.R.
Date: January, 1966
Description of Project
Improvement: Grading
Roadbed Width:
Grading: 44'
Type Code: QQU
Traffic Volume
A.D.T. (1965): 560
A.D.T. (1985): 1500
D.H.V.: 225
D: 65%
T: 8%
V: 45





U.S. DEPARTMENT OF COMMERCE
BUREAU OF PUBLIC ROADS
REGION NO. 9 DENVER, COLORADO
APPROVED: _____ DATE _____
REGIONAL ENGINEER

U.S. DEPARTMENT OF COMMERCE
BUREAU OF PUBLIC ROADS

AS CONSTRUCTED
COLORADO FOREST HIGHWAY PROJECT 26-2(2)
SOUTH SAINT VRAIN
LENGTH 0.688 MILES
CLASS 2
ROOSEVELT NATIONAL FOREST
BOULDER COUNTY

AS CONSTRUCTED PLANS
RETURN TO DIST. 4 DESIGN

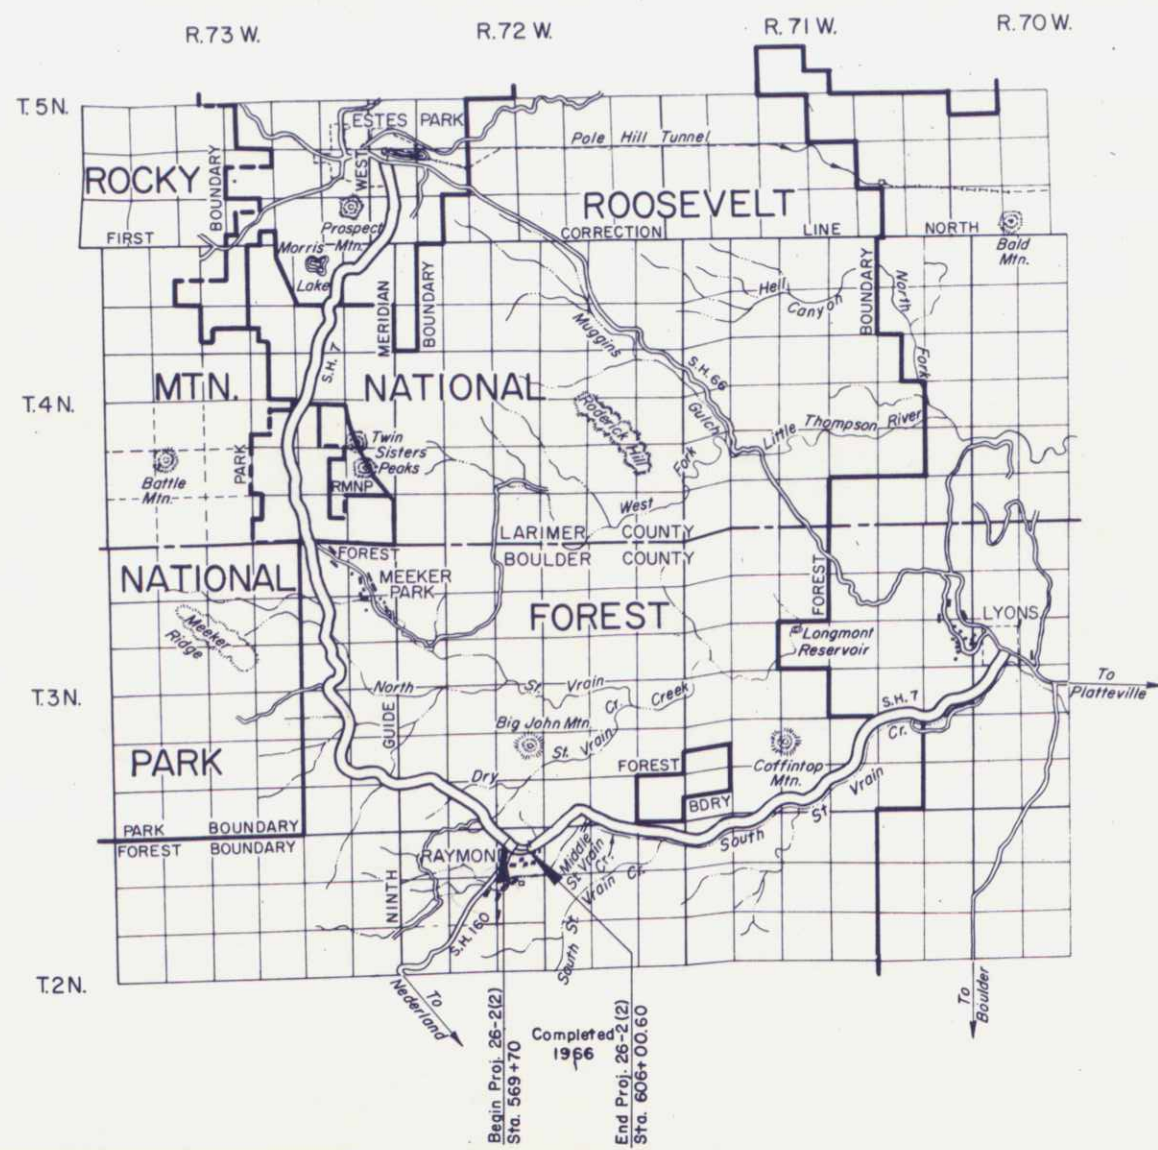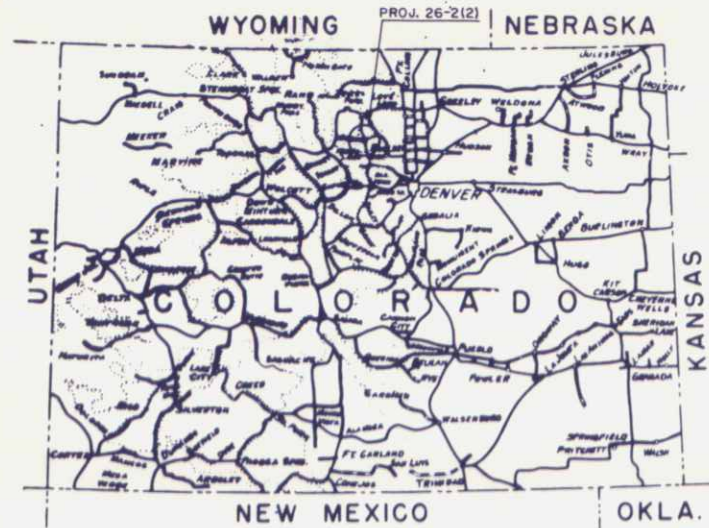

LEGEND


EXISTING ROAD	UNIMPROVED	GRADED	REINFORCED SUBGRADE	BASE COURSE	SURFACE TREATMENT	ROAD PLANT MIX BITUM.	CONCRETE
---------------	------------	--------	---------------------	-------------	-------------------	-----------------------	----------

B.P.R. 6093, J.K.C. 1-62


PLAN	SUBMITTED	DATE
	PLOTTED	BY
	ALIGNED CHECKED	
	RT. OF WAY CHECKED	
NOTE BOOK NO.		

PROFILE	SUBMITTED	DATE
	PLOTTED	BY
	GRADES CHECKED	
	RT. OF WAY CHECKED	
NOTE BOOK NO.		

T31N R72E
32 33
Section Corner


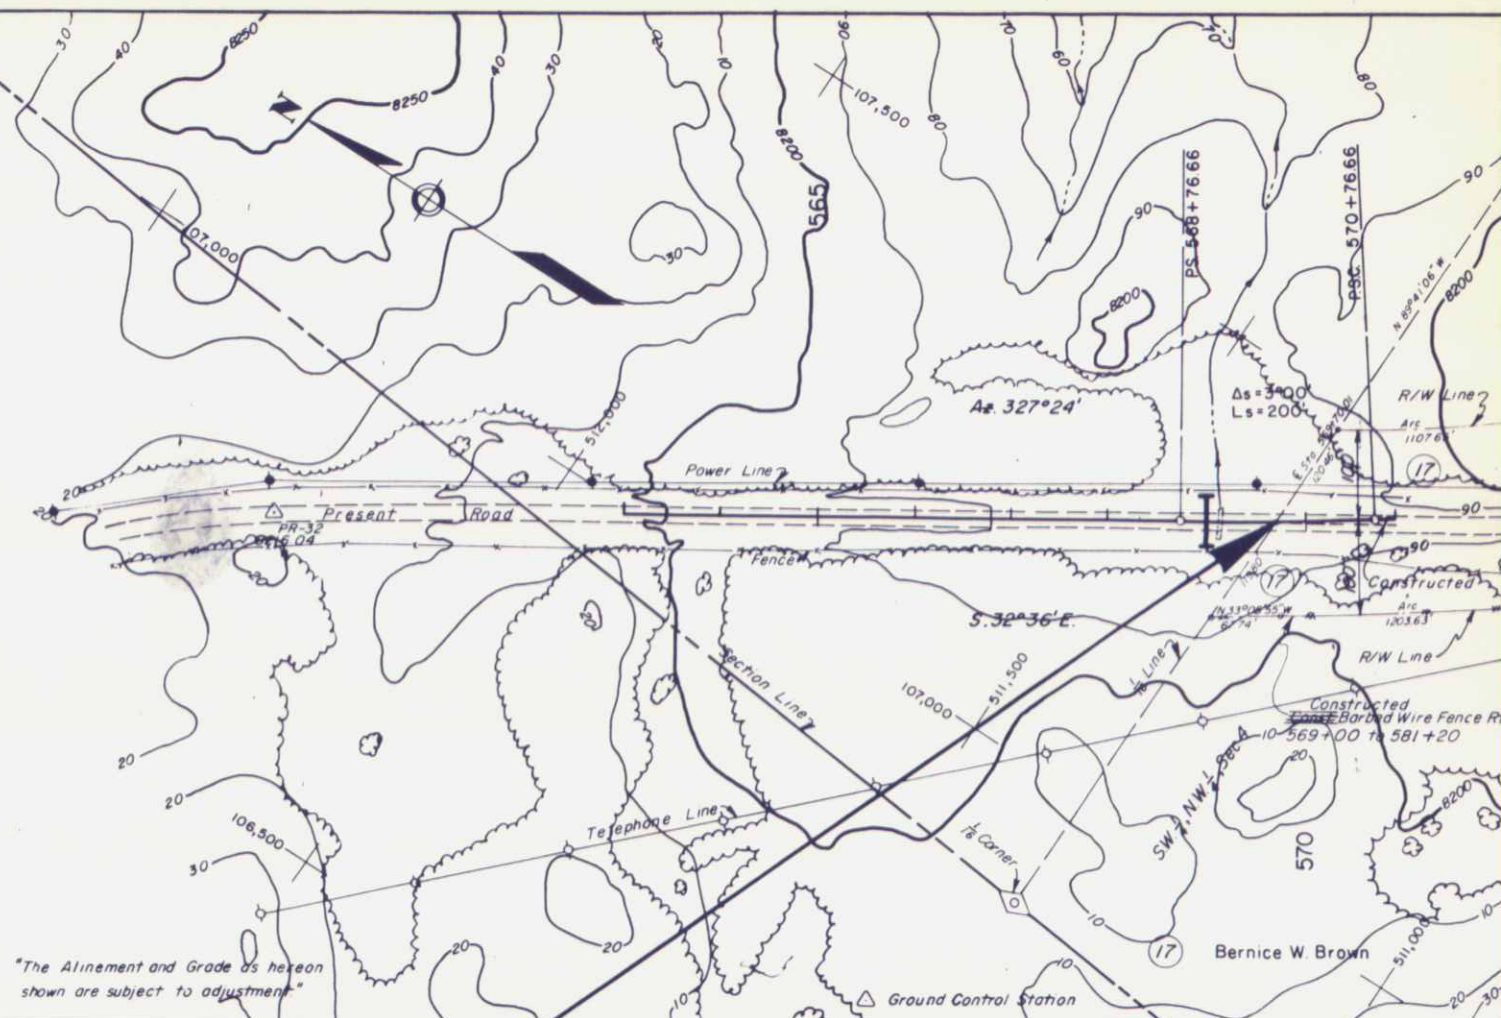


STA. 569+70 WEST END PROJ. 26-2(2)
1966 CONSTRUCTION

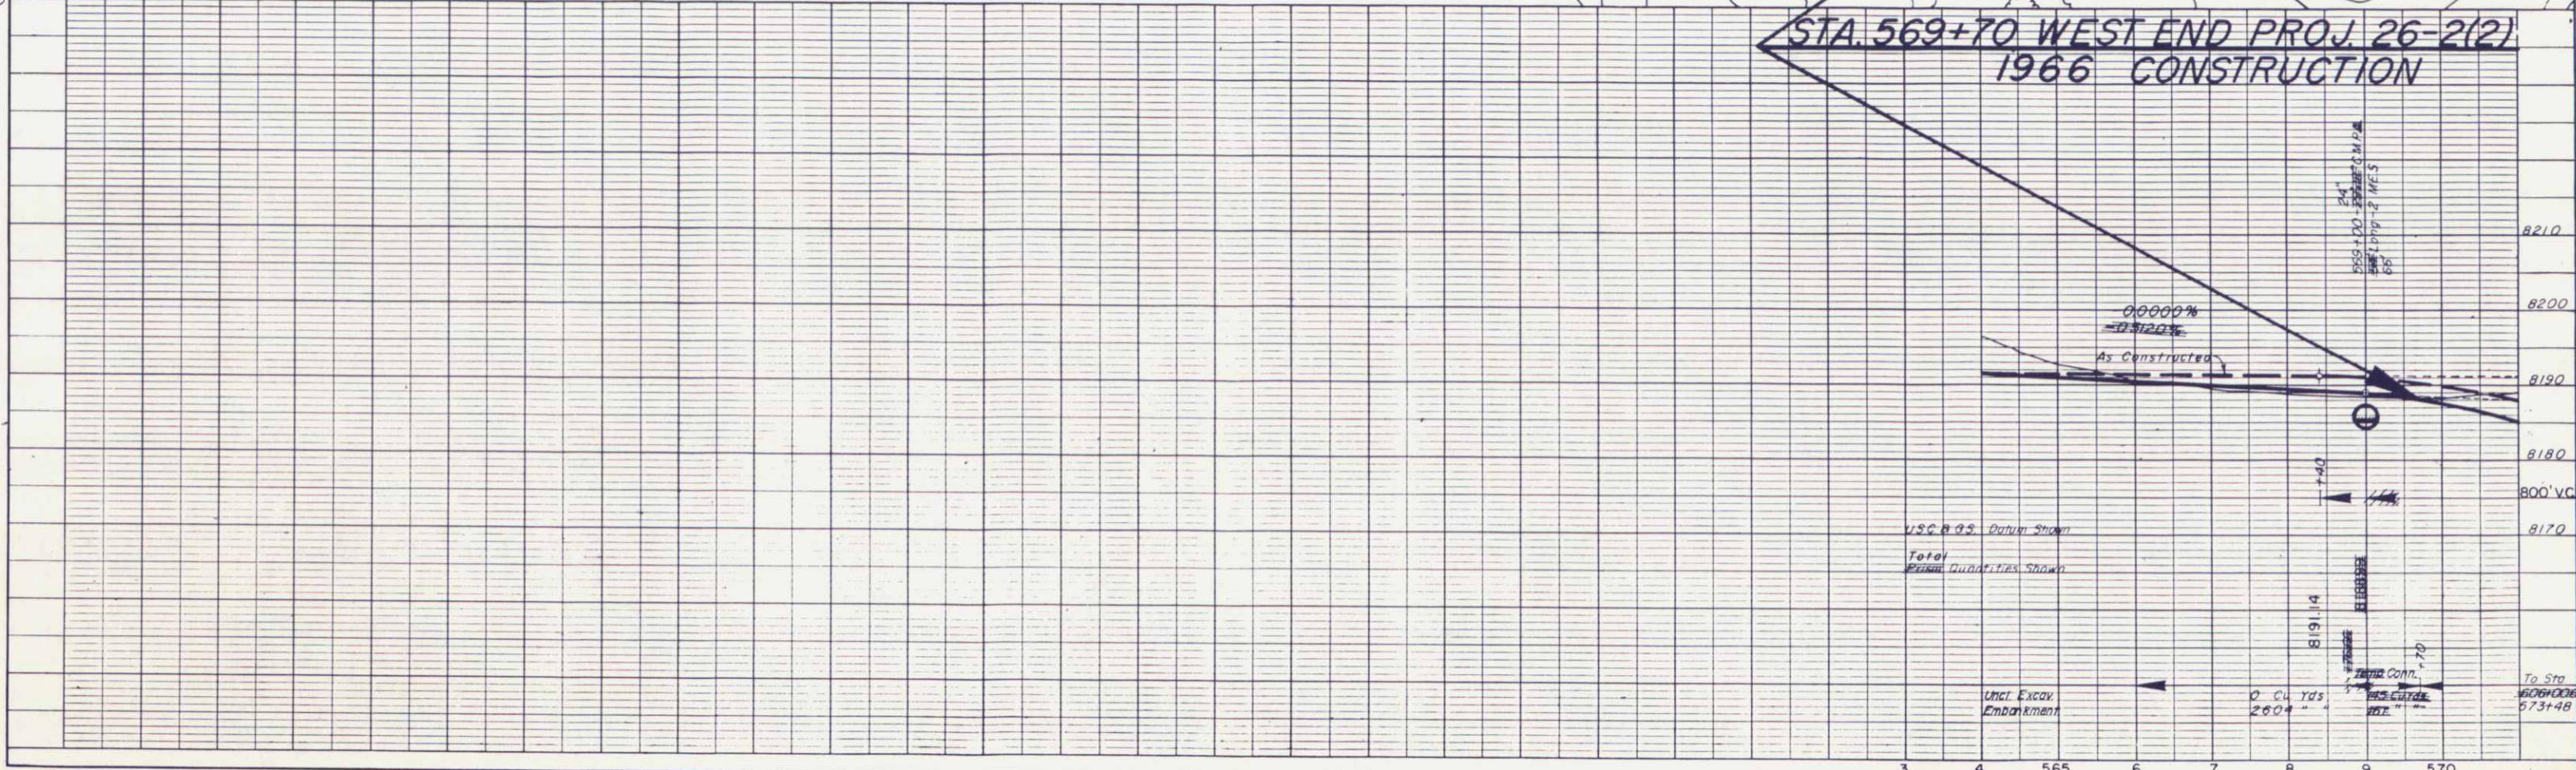


PLAN	SURVEYED	DATE
	PLOTTED	BY
	ALIGNED	CHECKED
	BY	NO.

PROFILE	SURVEYED	DATE
	PLOTTED	BY
	GRADES CHECKED	CHECKED
	BY	NO.

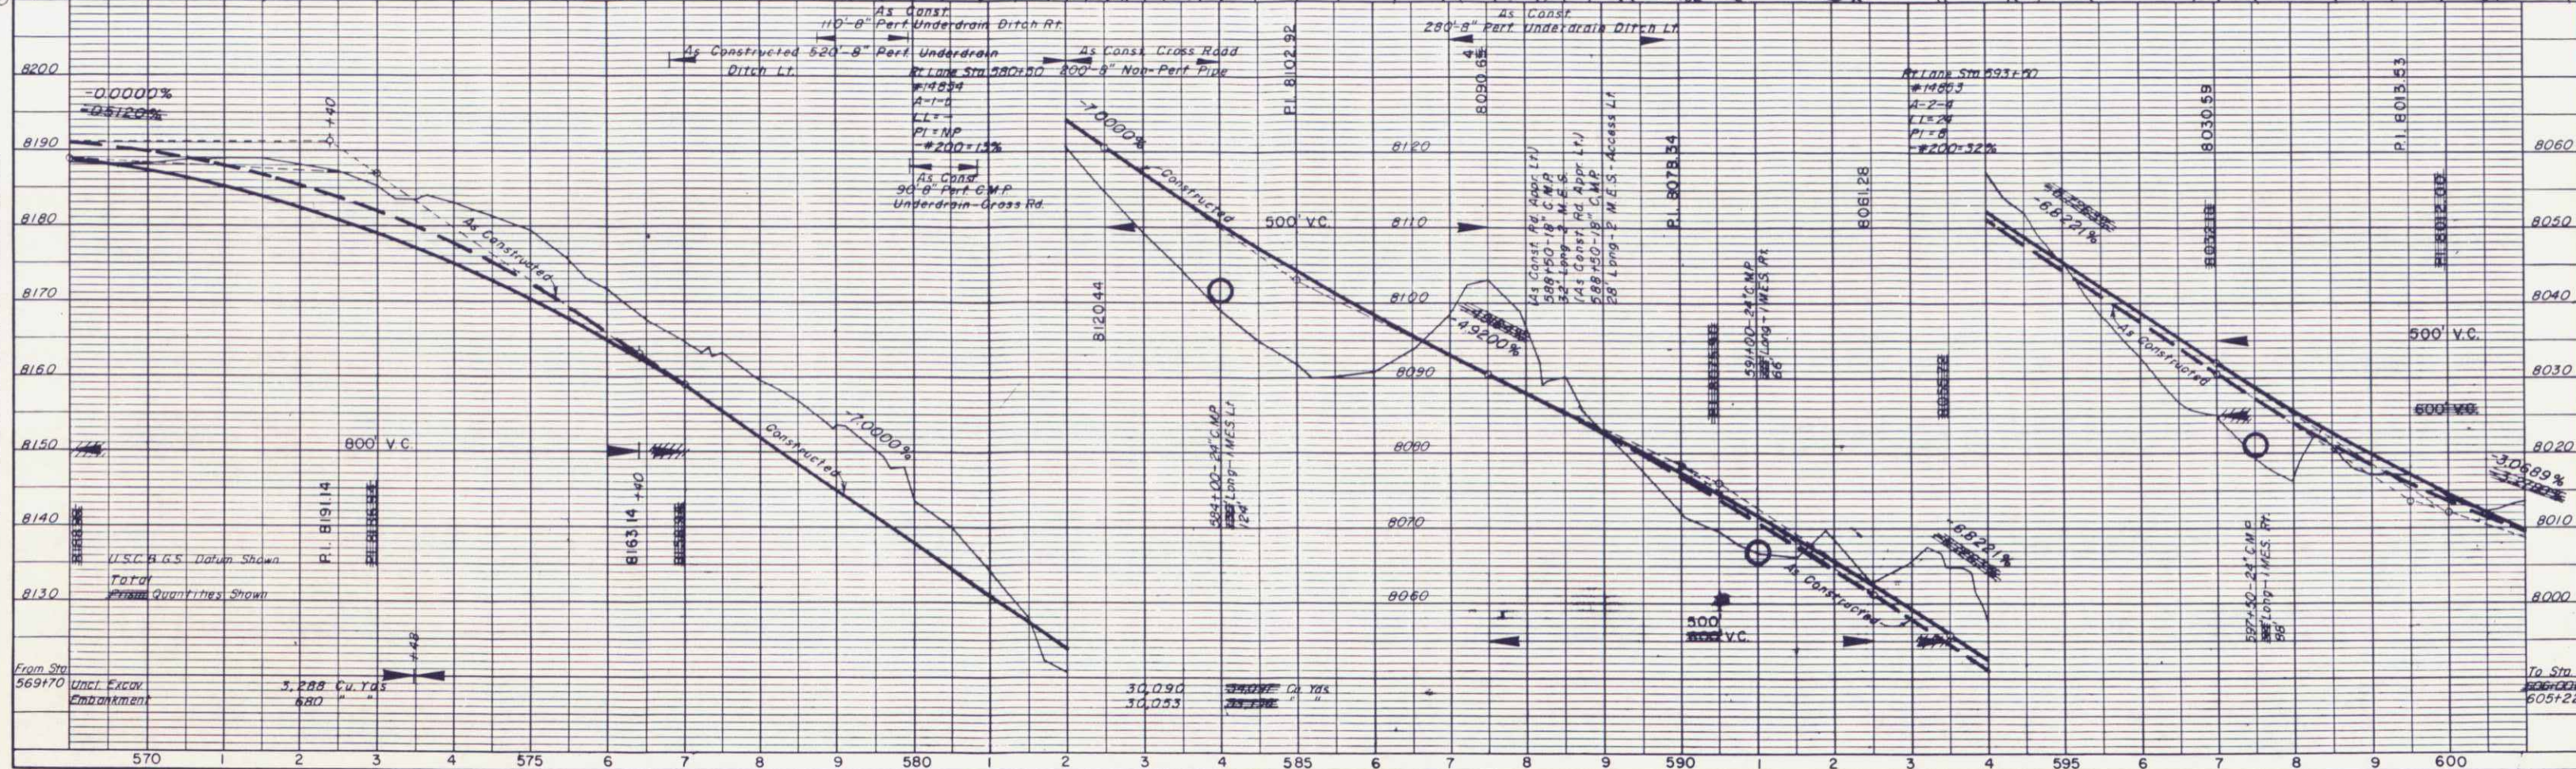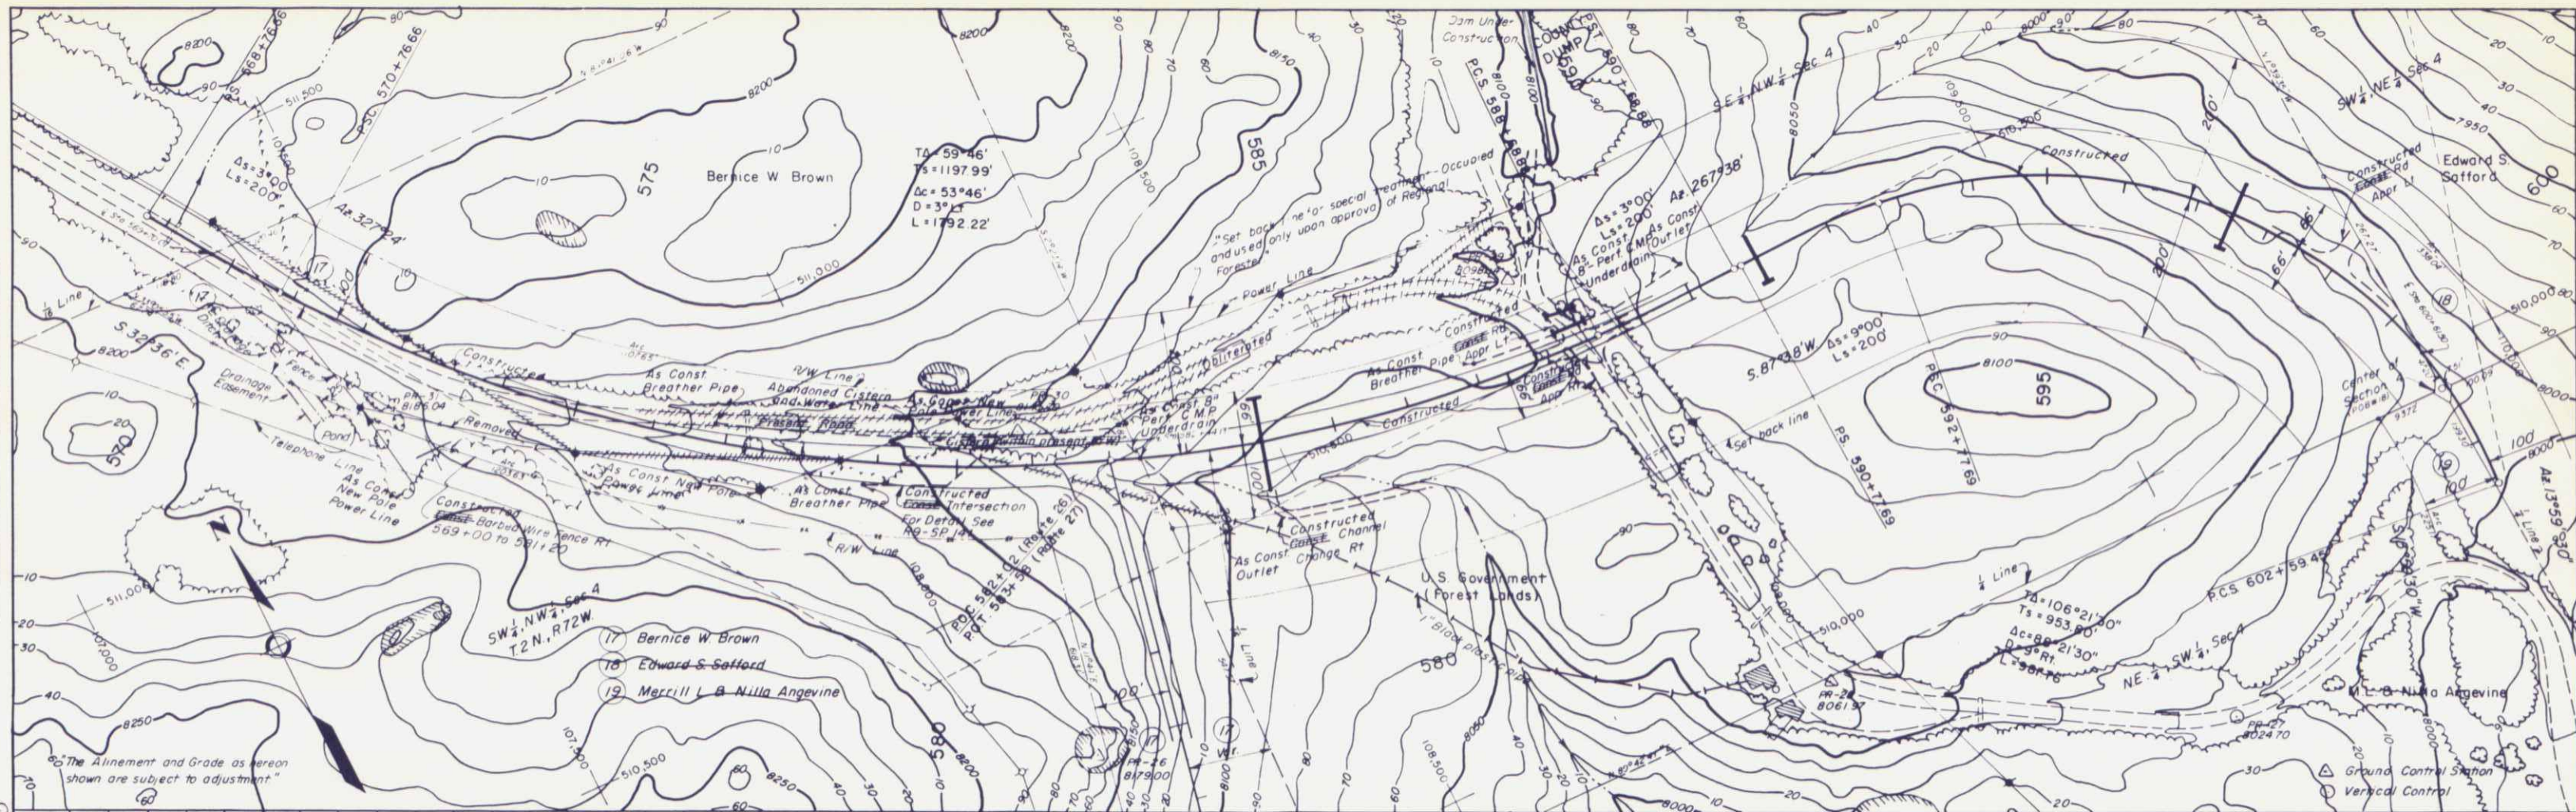

PLAN	SURVEYED	DATE
	BY	
	PLOTTED	
	CHECKED	
	REVIEWED	
	NO. OF WY. CHECKED	
	NO.	

PROFILE	SURVEYED	DATE
	BY	
	PLOTTED	
	CHECKED	
	REVIEWED	
	NO. OF WY. CHECKED	
	NO.	

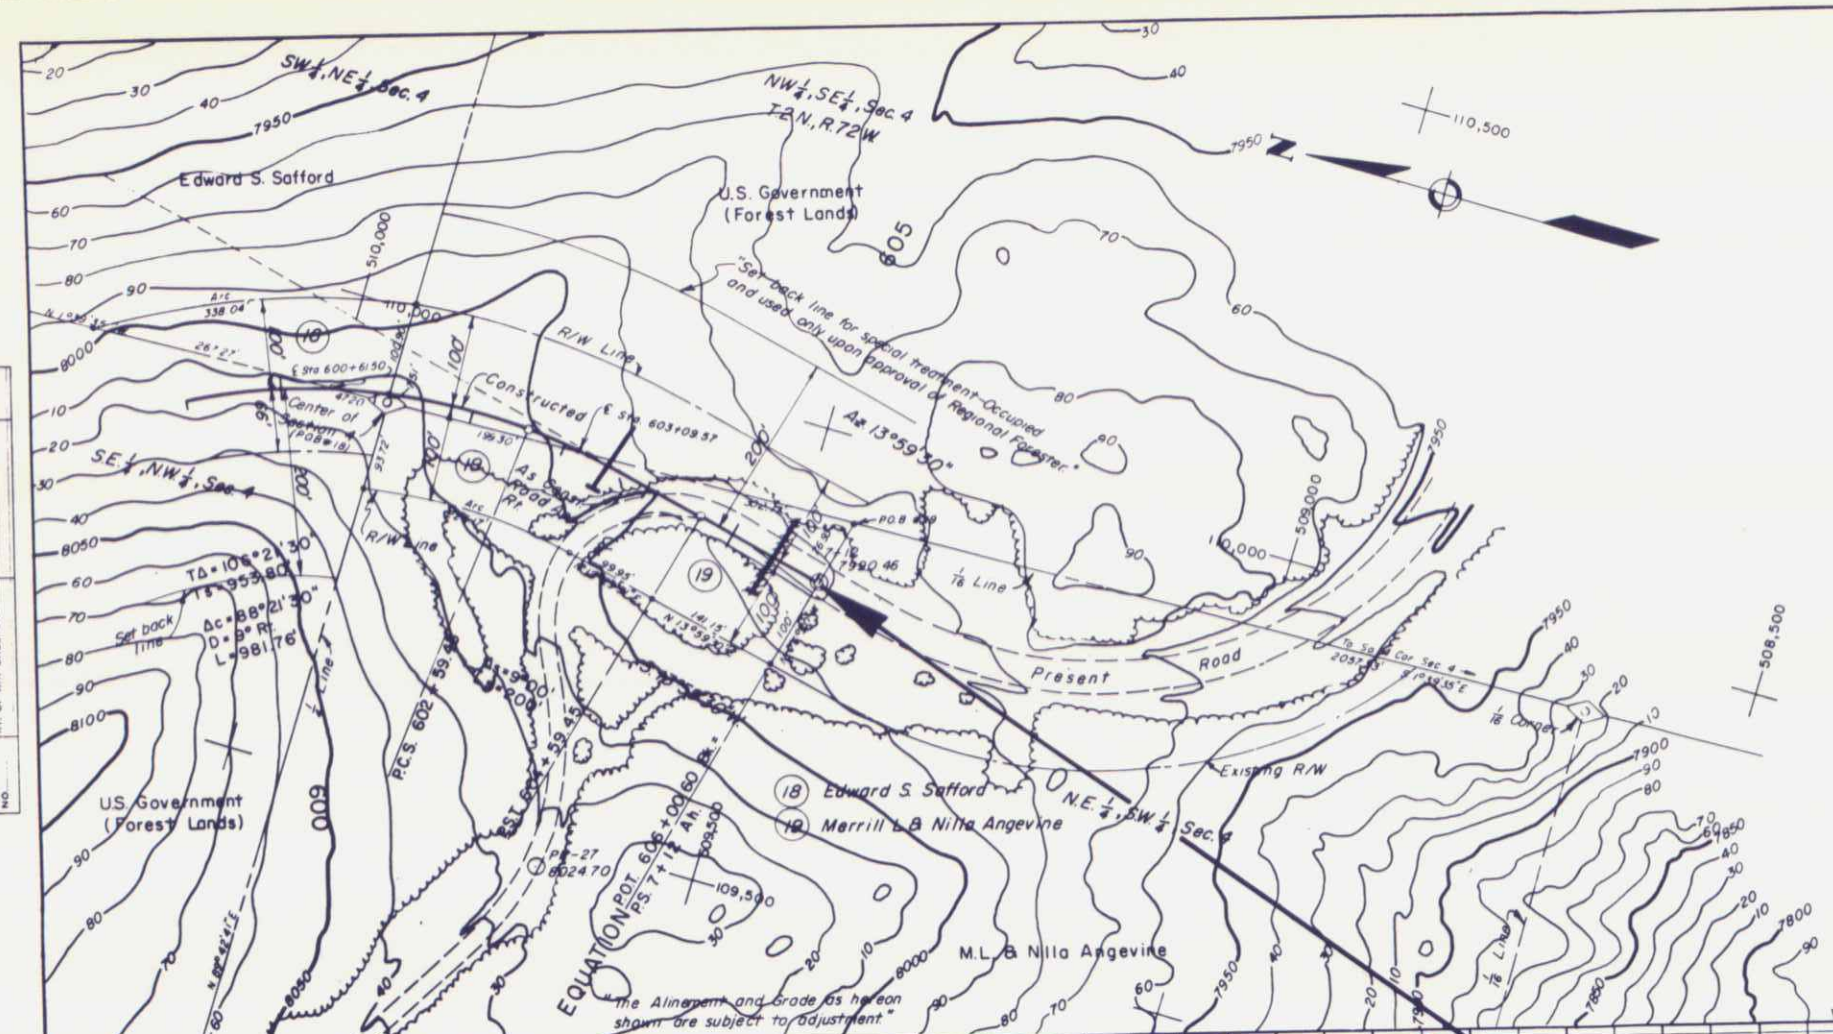

△ Ground Control Station
○ Vertical Control

STA. 606+00.60 EAST END PROJ. 26-2(2) 1966 CONSTRUCTION

