

COLORADO

STATE HIGHWAY DEPARTMENT

PLAN AND PROFILE OF PROPOSED FEDERAL AID PROJECT NO. 277 B STATE HIGHWAY NO. * 85-87 EL PASO COUNTY.


INDEX OF SHEETS

1. Title Sheet
2. Cross Section and Summary Sheet
3. Concrete Slab Bridge Details
4. Standard Concrete Box Culverts, M 103 B
5. " Barbed Wire Fence, M 24 A
6. " Culvert Headwalls, M 102 B
7. " Project Marker, M 100 A
8. " Wire Link Mesh Guard Fence, M 21 A
- 9-13. Plan and Profile Sheets
- 14-65. Cross Section Sheets

CONVENTIONAL SIGNS

- Survey Line
- Right of Way Line
- Section Line
- Half Section Line
- Fence Line
- Pole Line - Telegraph
- Ditch Line
- Railroad - Plan

SCALES
 ON PLAN, 1 IN. = 100 FT.
 ON PROFILE { 1 IN. = 100 FT. HORIZONTAL
 1 IN. = 10 FT. VERTICAL
 GRADE LINE ON PROFILE IS SHOWN AS GRADE OF FINISHED ROAD
 GROSS LENGTH OF PROJECT } 25693.9 FT. = 4.866 MILES
 NET LENGTH OF PROJECT }

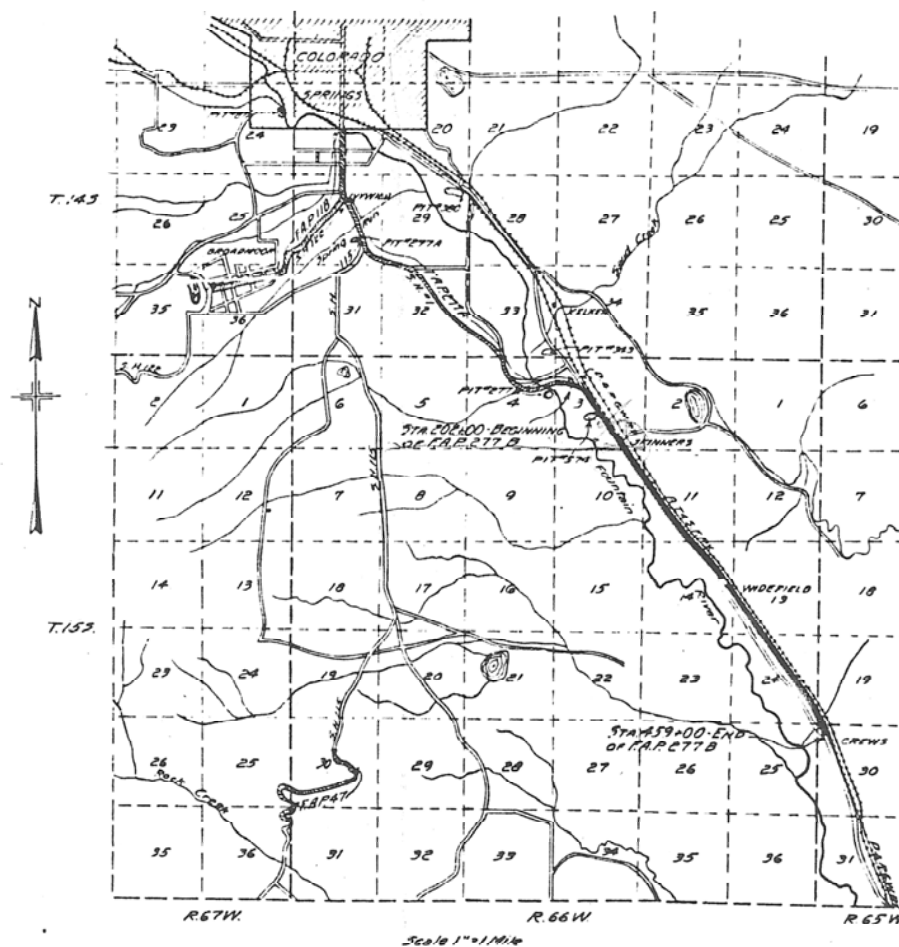

RECOMMENDED FOR APPROVAL

ASSISTANT ENGINEER

APPROVED

STATE HIGHWAY ENGINEER

RECOMMENDED FOR APPROVAL

DIST. ENG. BUREAU PUBLIC ROADS

RECOMMENDED FOR APPROVAL


CHIEF ENG. BUREAU PUBLIC ROADS

APPROVED



DIRECTOR BUREAU PUBLIC ROADS

TYPICAL CROSS SECTION OF IMPROVEMENT AND SUMMARY OF QUANTITIES

FED. ROAD DIST. NO.	STATE	FED. AID PROJ. NO.	SHEET NO.	TOTAL SHEETS
1	CLW	277-B	1	1

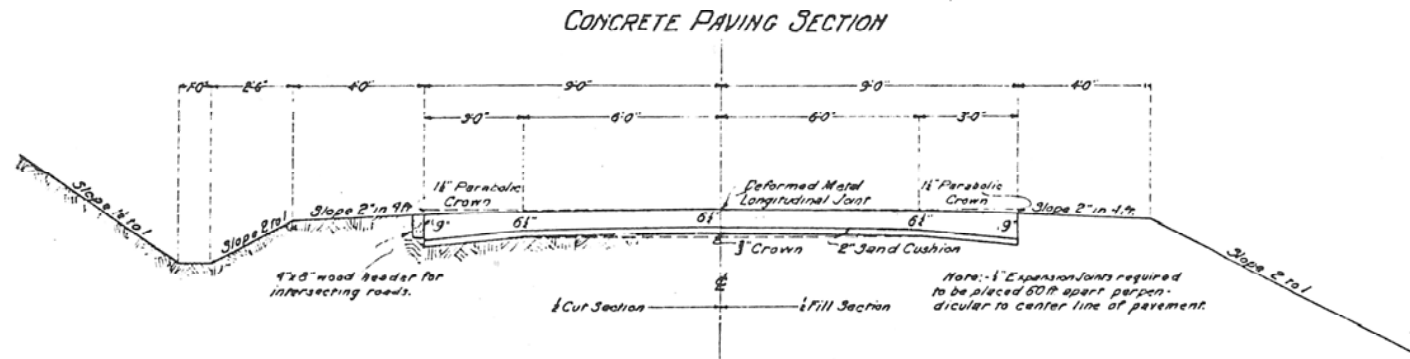

DEFORMED METAL LONGITUDINAL JOINT

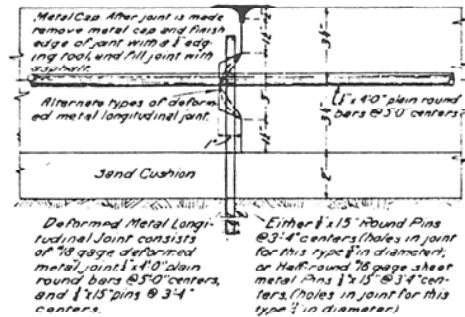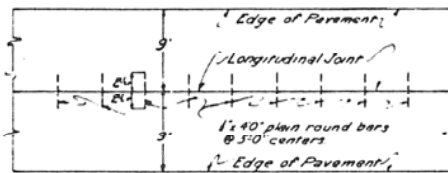


SUMMARY OF QUANTITIES

Item No.	ITEM	UNIT	QUANTITIES
1	Clearing and Grubbing	Lump Sum	
2	Removing eight structures	"	
3	Removing fences	Lin Ft	16200
3a	Common Excavation	Cu Yds	3100
3b	Rock Excavation	"	100
3c	Borrow Excavation	"	36500
6	Overhaul	Sfs	100
7a	Dry Common Structural Excavation	Cu Yds	200
7b	Wet Common Structural Excavation	"	200
7c	Dry Rock Structural Excavation	"	10
7d	Wet Rock Structural Excavation	"	10
11a	15\"/>		

GENERAL NOTES

All roadway excavation outside of ditch and cut slope shown by Standard Cross Section is to be classified and paid for as Borrow Excavation except slides, open break and special items of excavation as shown on plans.
 All borrow required for Project is available on Right of Way, or immediately adjacent thereto within 300 ft of where needed.
 Gravelly dirt as shown on plans is to be considered approximate only.
 All side drains are to be provided with Standard Headwalls.

DETAIL OF CONCRETE DITCH AND CULVERT




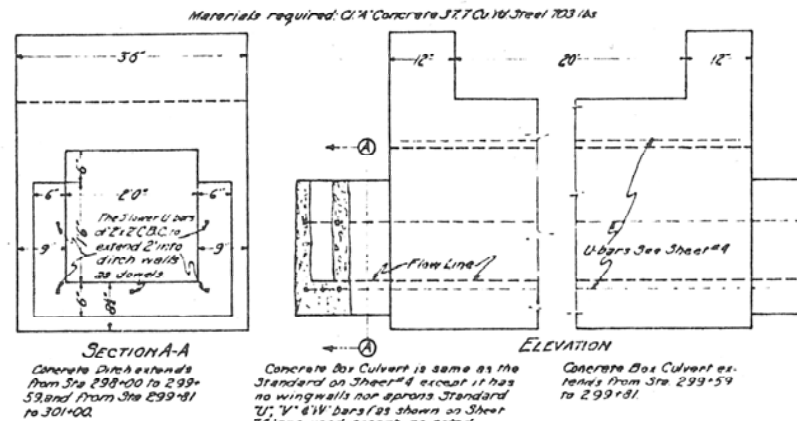


LIST OF STRUCTURES

Station	Station	Description	Corrugated Metal Culvert Pipe Linear Feet			Concrete Cu Yds		Reinforcing Steel Pounds	Struct Excav Cu Yds	Remove Fence Lin Ft	Build Fence Lin Ft	Timber Header Lin Ft	Common Excav Cu Yds	Remove Structure Lin Ft	Guard Fence Lin Ft
			15"	18"	24"	C1A	C1B								
202+00	220+00	Project Marker (1)													
202+00	220+00	Remove fence								1265					
202+00	220+30	Build fence									1890				
219+90	220+00	Side drain and Header	20			0.9		1328	2						
221+00	227+00	2x2x30 Conc Box Culvert				13.9									
221+35	227+00	Timber Header									600				
221+35	227+00	Side drain	50			4.9			2						
224+00	328+50	Build fence								10945					
224+35	328+50	Remove culvert									10470				
225+25	328+50	Side drain	30			0.9			2						
225+25	328+50	5x3x28 Conc Box Culv				26.4		2203	55						
226+20	328+50	Side drain	30			0.9			2						
236+00	328+50	Side drain and Header	30			0.9			2					40	
236+50	328+50	Side drain	30			0.9			2					80	
239+00	328+50	Side drain	20			0.9			2					32	
260+70	328+50	Side drain	20			0.9			2					32	
271+60	328+50	2x2x28 Conc Box Culv				13.3		1262	29						
277+25	328+50	Side drain and Header	20			0.9			2					32	
281+55	328+50	Side drain	20			0.9			2					32	
284+00	328+50	2x2x28 Conc Box Culv				13.3		1262	32						
284+00	328+50	Remove culvert													
284+00	328+50	Channel change													200
298+00	301+00	Remove concrete ditch				377		703	26						32
298+00	301+00	Concrete ditch and box culvert													32
301+35	301+00	Remove scales													200
303+55	301+00	Side drains and Headers (2)	90			1.8			4						32
323+35	301+00	Side drain	20			0.9			2						32
328+60	301+00	Remove pump house, fill well, & build new pump house, dig well													
328+70	301+00	Timber Header									160				
329+00	359+90	Remove fence								60					
329+90	351+50	Build fence									2160				
332+50	351+50	Remove fence								280					
333+25	351+50	Remove three buildings													3
334+92	351+50	2x2x28 Conc Box Culvert Channel change				13.3		1262	30						20
335+00	351+50	Ditch change													400
336+65	351+50	Remove fence													100
336+70	351+50	Remove fence													125
337+25	351+50	Remove fence													125
340+65	351+50	Remove fence													115
349+15	351+50	Remove fence													100
349+15	351+50	3 Side drains, 2 Headers	80	20		3.2			6						112
349+65	351+50	Remove fence													
350+13	370+13	Build fence								100					2000
350+80	370+13	Remove fence								170					
369+00	402+15	Build									3275				
369+50	412+50	Ditch change													1200
369+90	412+50	Remove fence													125
402+55	419+55	Build													125
402+55	419+55	2 Side drains, 1 Header	30	30		30.1	2.3	2282	23						1700
413+70	419+55	4x4x30 Conc Box Culvert													64
418+55	419+55	Remove fence													210
420+40	450+30	Build													3040
422+80	450+30	Concrete slab Bridge													
432+00	450+30	Ditch change													300
432+25	450+30	Remove fence													100
438+65	450+30	2x2x28 Conc Box Culvert				13.3		1262	18						
442+50	450+30	Remove fence													905
442+50	450+30	Build													815
451+00	459+00	Side drain and Header	80			0.9			2						120
451+25	459+00	Remove fence													795
451+25	459+00	Build													775
451+40	459+00	Ditch change													100
451+60	459+00	Remove culvert													
451+60	459+00	2x2x48 Conc Box Culvert				18.2		1917	58						
459+00	459+00	Timber Header													18
364+00	423+80	Remove five trees													
422+00	423+80	Wire Link Mesh Guard Fence													200
423+80	423+80	Wire Link Mesh Guard Fence													200

1 Work done and materials furnished by State Forces.
 2 Quantities in Summary.
 3 To be paid for as Clearing and Grubbing, Lump Sum.
 4 Structural excavation is estimated to be 30% dry and 50% wet.

Revised Quantities as Constructed 3-9-39 R.S.S.

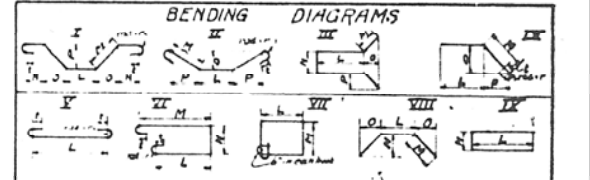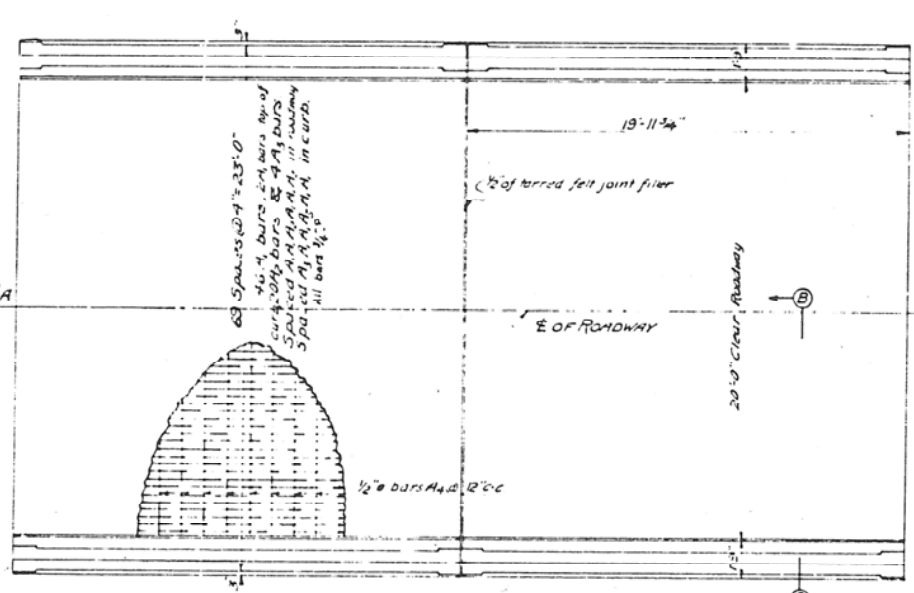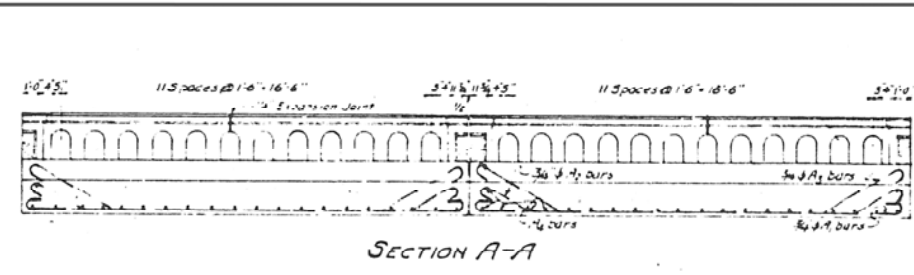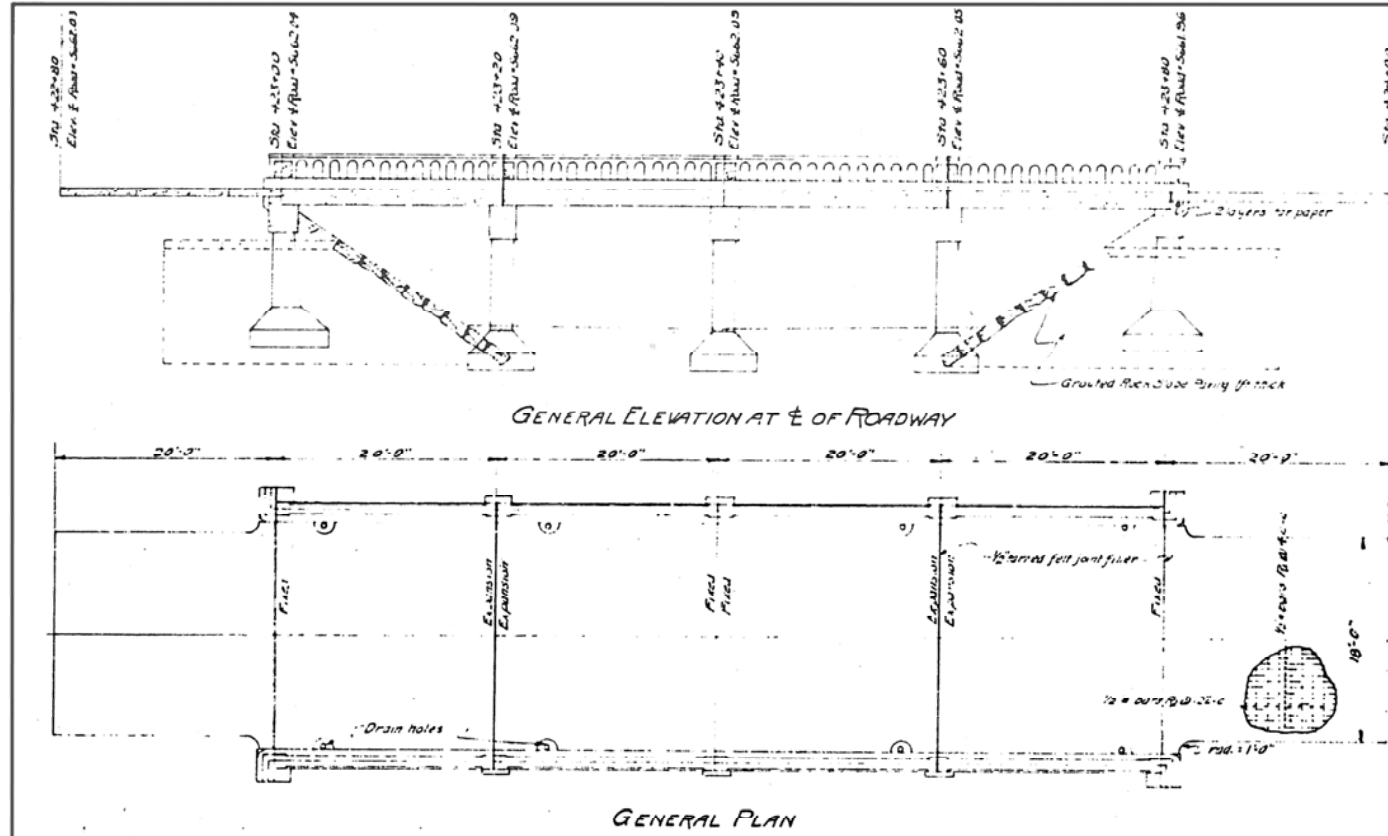

BAR LIST FOR FOUR SLAB SPANS

Mark	Size	Number	Length	Spec.	L	M	N	O	P	r	s
A1	3/8	22	27.0	V	19.0						3 1/2
A2	3/8	80	21.0	W	15.0	2.0		1.0	1.0	3 1/2	
A3	3/8	10	22.0	X	12.2	5.11 1/2		2.0	3.3	3 1/2	
A4	3/8	88	23.0	Straight							
A5	3/8	125	6.4	III	2.0	1.0	0.4	0.25	0.25		
A6	3/8	24	9.0	Straight							
A7	3/8	24	10.6	Straight							
A8	3/8	16	6.6	IX	3.0	0.6					

BAR LIST FOR TWO APPROACH SLABS

Mark	Size	Number	Length	Spec.	r	s
R1	3/8	108	20.6	V	19.2	2 1/2
R2	3/8	40	17.9	Straight		

BAR LIST FOR THREE PIERS

Mark	Size	Number	Length	Spec.	L	M	N	O	P	r	s
P1	3/8	18	25.7	V	23.0					3 1/2	3"
P2	3/8	6	27.7	W	6.0	3.6	6.0	2.6	2.6	3 1/2	3"
P3	3/8	12	25.0	V	23.0					3 1/2	3"
P4	3/8	138	7.7	VI	2.5	2.5	1.5			2"	2"
P5	3/8	72	16.0	Straight							
P6	3/8	72	7.4	Straight							
P7	3/8	108	6.9	X	3.1					2 1/2	2"
P8	3/8	33	3.6	Straight							





BAR LIST FOR TWO ABUTMENTS

Mark	Size	Number	Length	Spec.	L	M	N	O	P	r	s
A1	3/8	13	25.4	V	23.0					3 1/2	3"
A2	3/8	2	20.0	I	6.0	2.0	7.0	2.0	2.0	3 1/2	3"
A3	3/8	10	26.0	X	2.0					3 1/2	3"
A4	3/8	40	6.7	VI	2.0	2.0	1.5			2"	2"
A5	3/8	40	7.4	VI	2.0	2.0	1.5			2"	2"
A6	3/8	40	13.6	Straight							
A7	3/8	40	7.3	VII	1.7	1.6					
A8	3/8	40	7.0	X	6.2					2 1/2	2"
A9	3/8	20	6.0	X	5.2					2 1/2	2"
A10	3/8	16	3.0	IX	2.0	2.0	2.0	2.0		2 1/2	2"
A11	3/8	8	3.5	IV	2.5	1.8	1.8	1.2		2 1/2	2"
A12	3/8	8	4.0	IX	3.6	0.6	0.6	0.6		2 1/2	2"
A13	3/8	8	6.5	VIII	1.9	2.0	1.0	1.0			
A14	3/8	4	6.0	VIII	3.2	1.5	1.0	1.0			
A15	3/8	4	3.7	Straight							
A16	3/8	32	3.6	Straight							
A17	3/8	2	20.0	I	6.0	2.0	6.0	2.0	2.0	3 1/2	3"
A18	3/8	12	6.6	IX	3.0	0.6					

1331 Lin Ft of 3/8" bars @ 2.84 lbs per ft = 2719 lbs.
 8233 Lin Ft of 3/8" bars @ 1.52 lbs per ft = 12226 lbs.
 1372 Lin Ft of 3/8" bars @ 1.043 lbs per ft = 1430 lbs.
 8163 Lin Ft of 3/8" bars @ 0.850 lbs per ft = 6938 lbs.
 255 Lin Ft of 1/2" bars @ 2.37 lbs per ft = 578 lbs.
 + 3 1/2" for overlap = 762 lbs.
TOTAL = 24,403 lbs.

SUMMARY OF QUANTITIES FOR ENTIRE BRIDGE

ITEM	UNIT	ABUTMENTS	PIERS	APPROACH SLABS	4 SPANS	TOTALS
35 Concrete Class A	Cu Yd	38.2	50.0	18.6	112.2	219.0
35 Reinforcing Steel	Lbs	4250	5450	2530	12350	24680
47 Grouted Arch Slope Framing	Sq Yd	400				400
Excavation Joint Form	Sq Ft			40	100	140
76 Dry Excavation Common	Cu Yd	602	1082			1684
76 wet do	do	do	do	do	do	0
76 Dry do	Rock	do	do	do	do	0
76 wet do	do	do	do	do	do	0

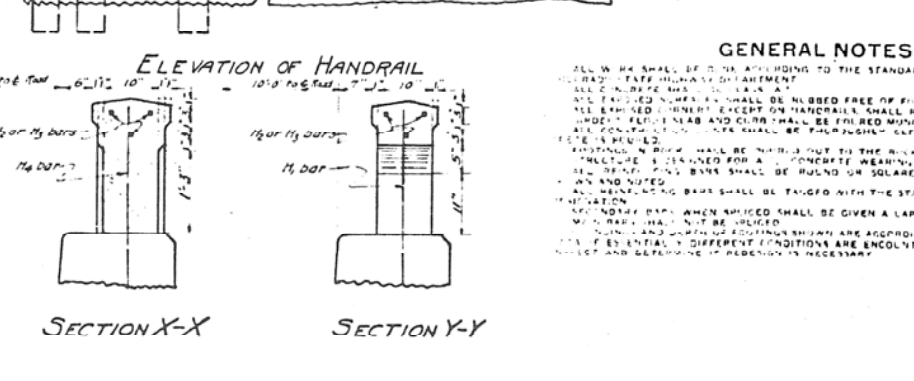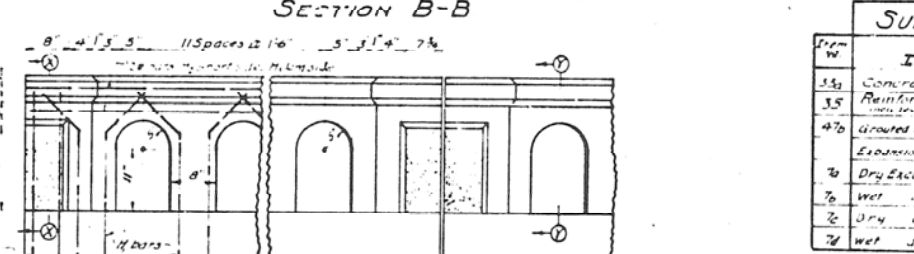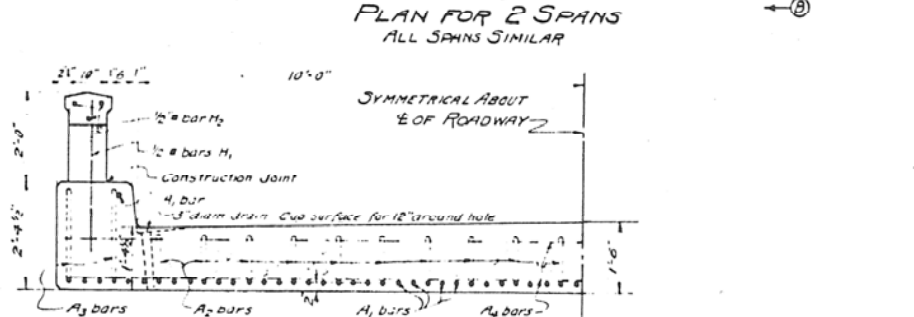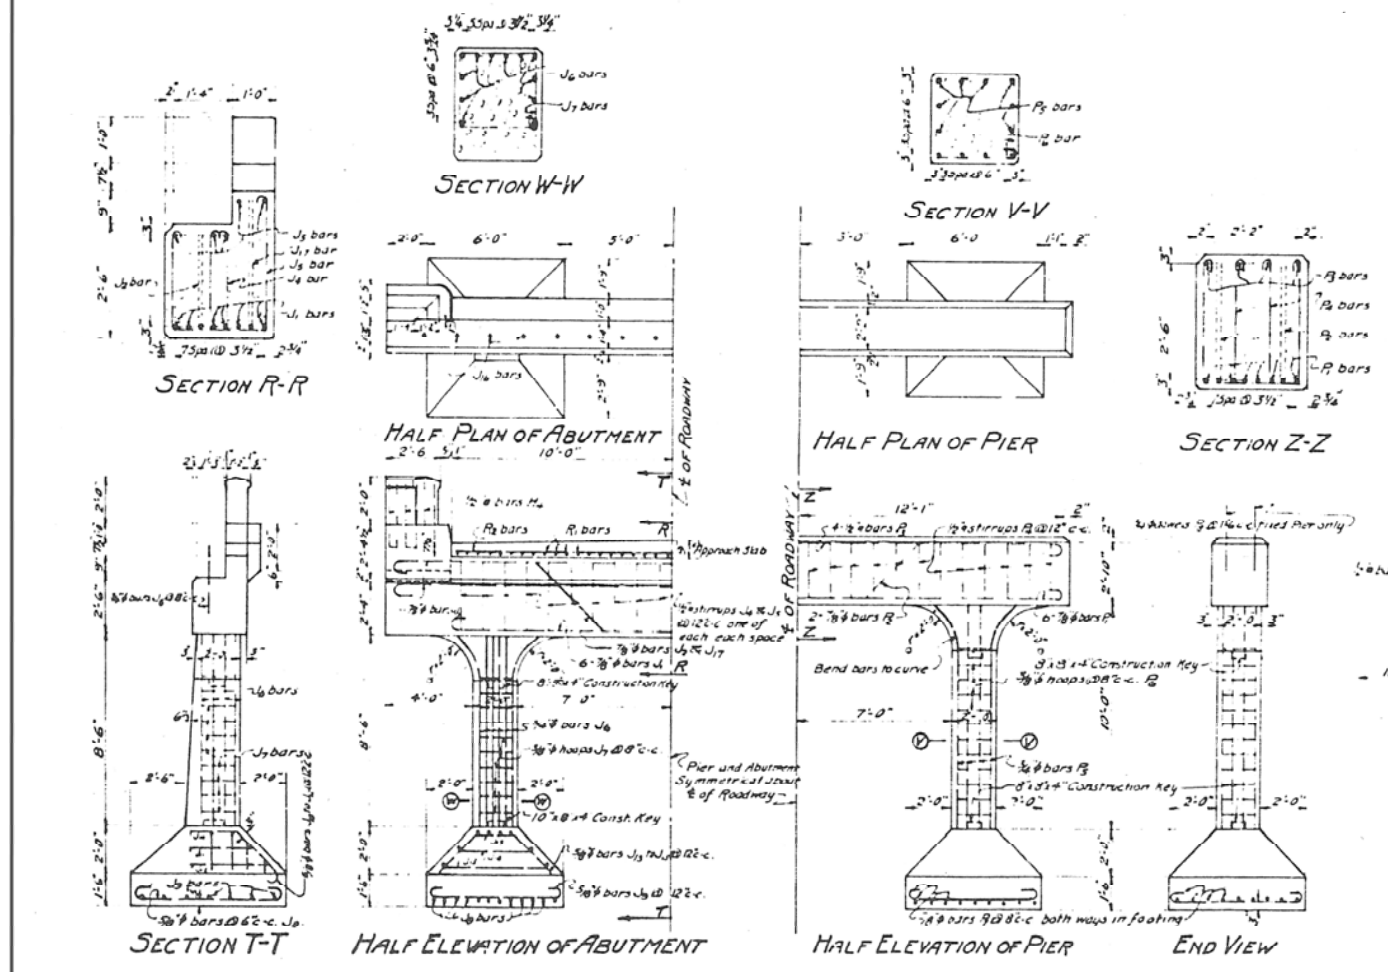

GENERAL NOTES

ALL WORK SHALL BE DONE ACCORDING TO THE STANDARD SPECIFICATIONS OF THE STATE OF COLORADO.

ALL REINFORCING STEEL SHALL BE FREE OF FIRM MARKS.

ALL EXPOSED CONCRETE SURFACES SHALL BE KEPT TO A FINISH FREE OF FORM OILS AND GREASE.

ALL REINFORCING STEEL SHALL BE PLACED IN POSITION BEFORE FORMWORK IS SET.

ALL REINFORCING STEEL SHALL BE TIED TO THE STATION NUMBER AND LETTER INDICATED.

NOTES: WHEN APPLICABLE SHALL BE GIVEN A LAP OF 40 DIAMETERS.

ALL DIMENSIONS SHALL BE AS SHOWN UNLESS OTHERWISE SPECIFIED.

IF ANY DIFFERENT CONDITIONS ARE ENCOUNTERED, THE ENGINEER WILL BE NOTIFIED AND A CHANGE ORDER WILL BE ISSUED.

LOADING: A.A.S.H.O. Oct. 1926 Class A.

COLORADO
STATE HIGHWAY DEPARTMENT
DETAILS FOR CONCRETE SLAB
BRIDGE

Across Crews Gulch
 Sta. 422+00 to 424+00
 Near Fountain Sec. 19 T. 15 S. R. 66 W

Designed by R.W.J. Approved by J.L. Gandy
 Made by R.W.J. Bridge Engineer
 Checked by P.S.B. Date: Nov. 10, 1927


FILE NO.	DATE	BY	SHEET NO.	TOTAL SHEETS
1	1913	W. J. B.	9	9

No. 25 25 1/2
 Rev. 7-11-28 W. J. B.
 10-23-28

Fences to be removed and built are indicated in List of Structures on Sheet #2.
 All Pole Lines encroaching on Right of Way are to be removed by owners.

N. E. 1/4, SECTION 3.

PLAN
 DRAWN BY
 CHECKED BY
 DATE
 PROJECT NUMBER
 SHEET NO.

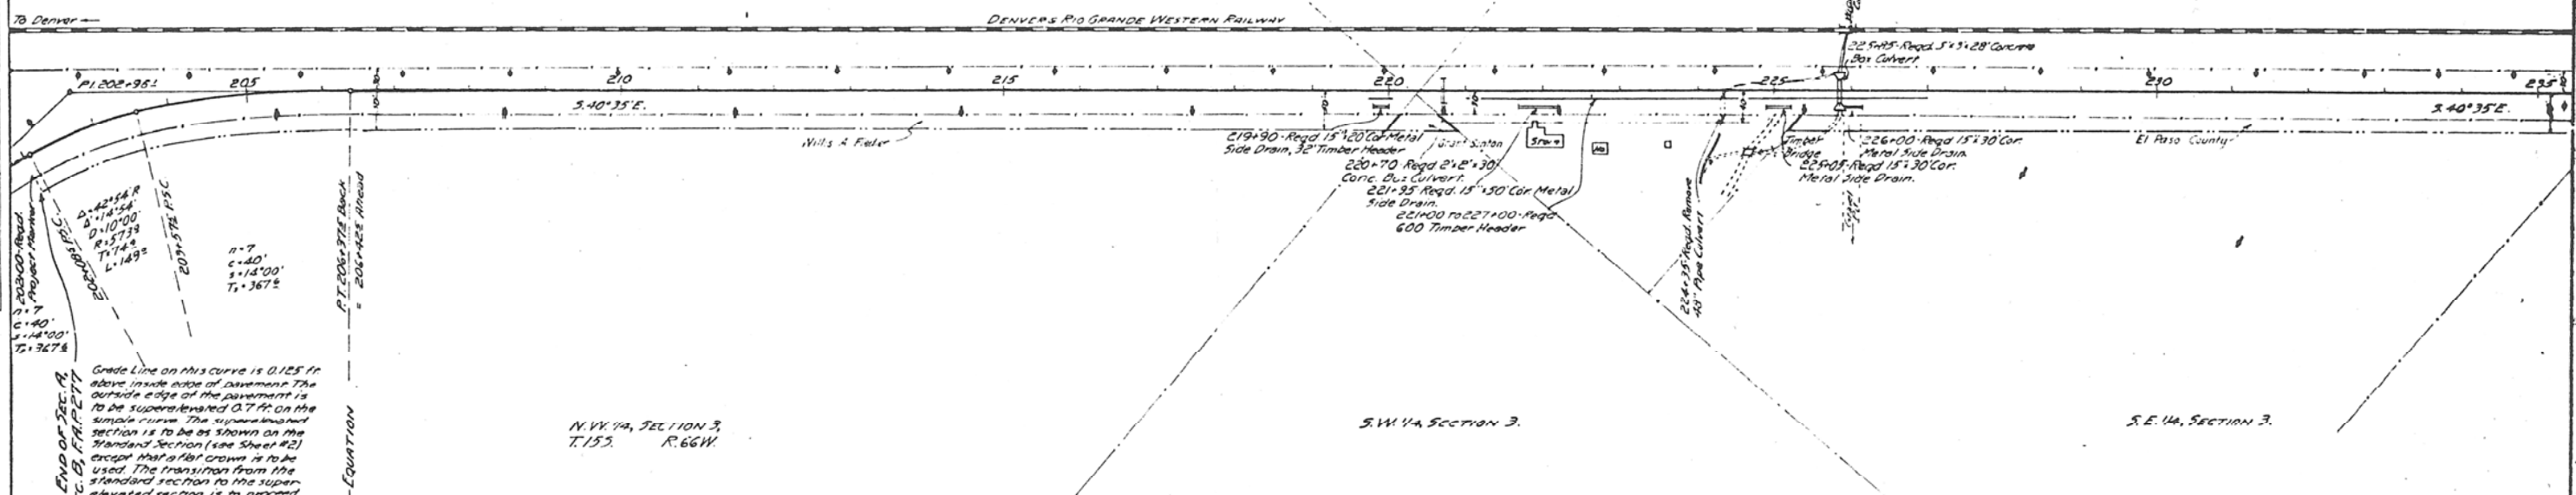


N. V. 1/4, SECTION 3,
 T. 153. R. 66W.

S. W. 1/4 SECTION 3.


S. E. 1/4, SECTION 3.

PROFILE
 DRAWN BY
 CHECKED BY
 DATE
 PROJECT NUMBER
 SHEET NO.

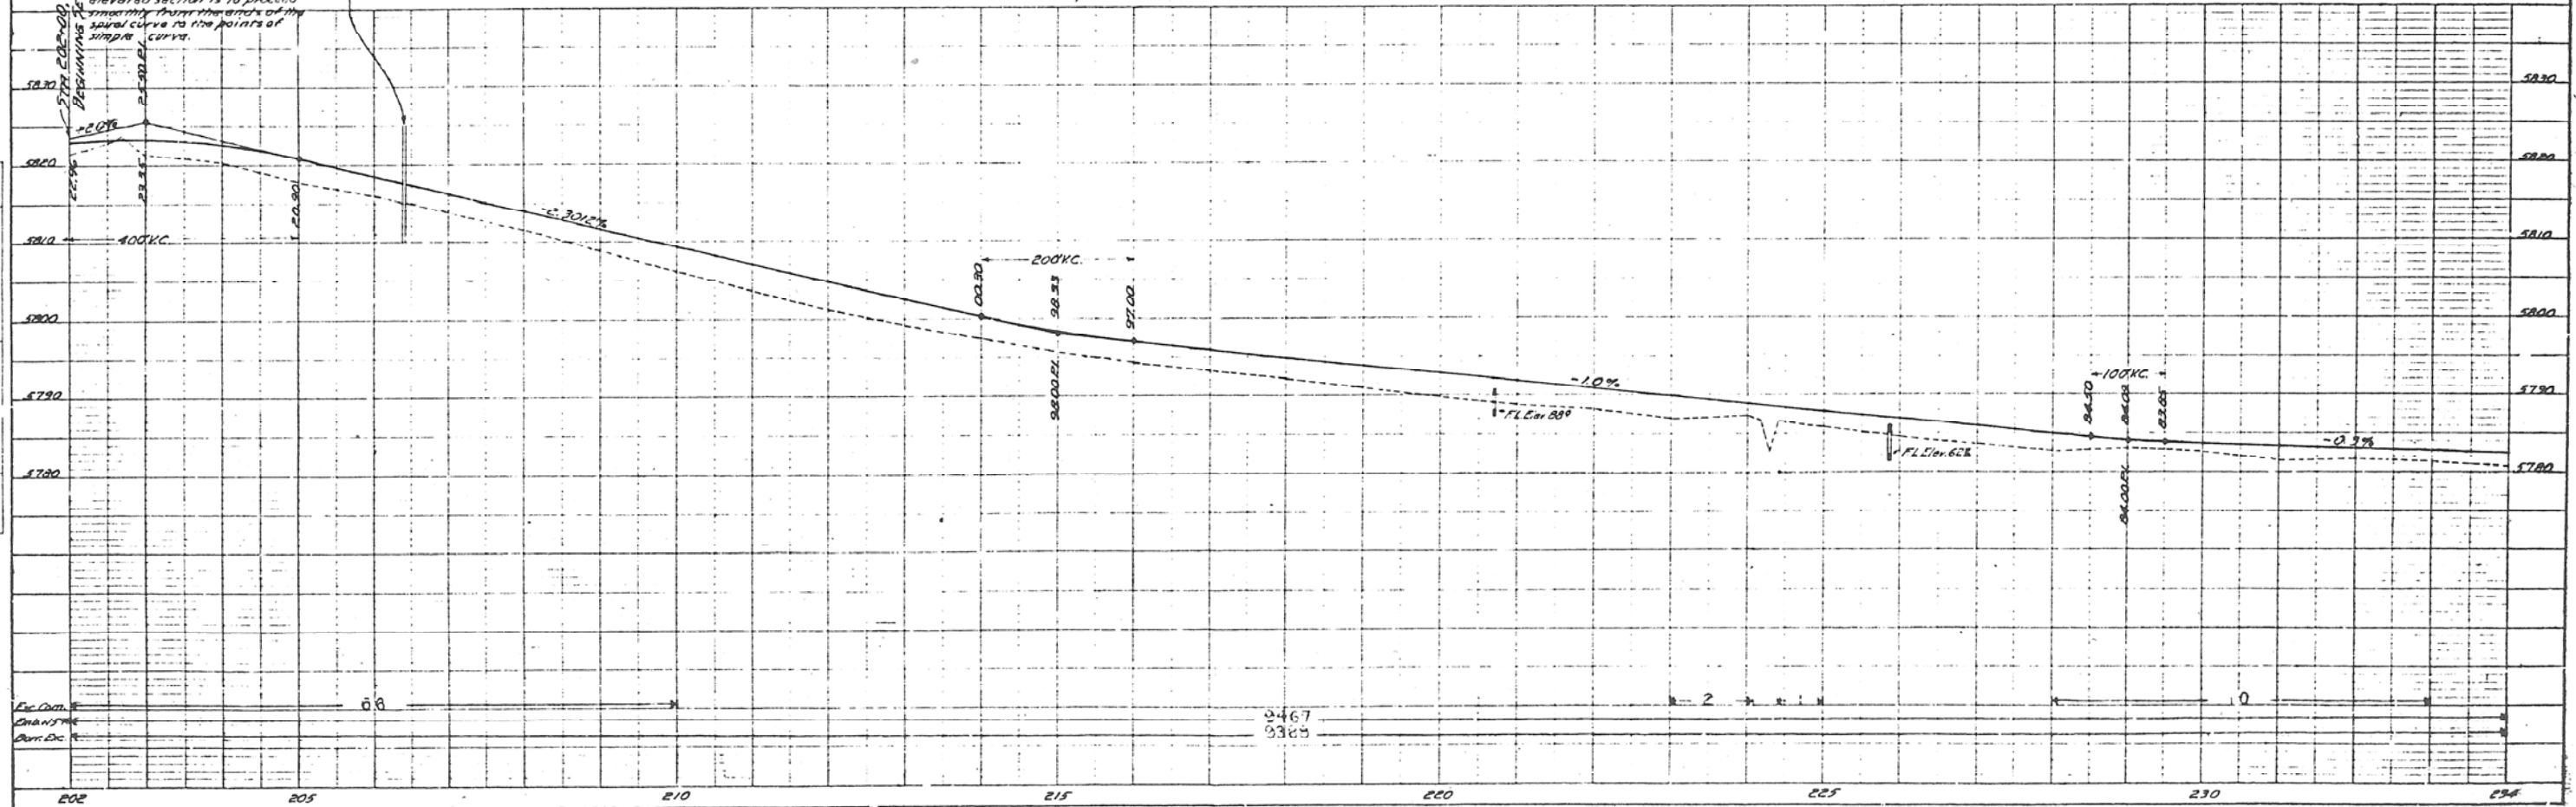


TID ROAD DIST. MI.	STATE	FED. NO.	SHEET NO.	TOTAL SHEETS
1	COLORADO	277 B	10	



Rev. 11-29-27 S.B.L.
REV. 2-28-1935.

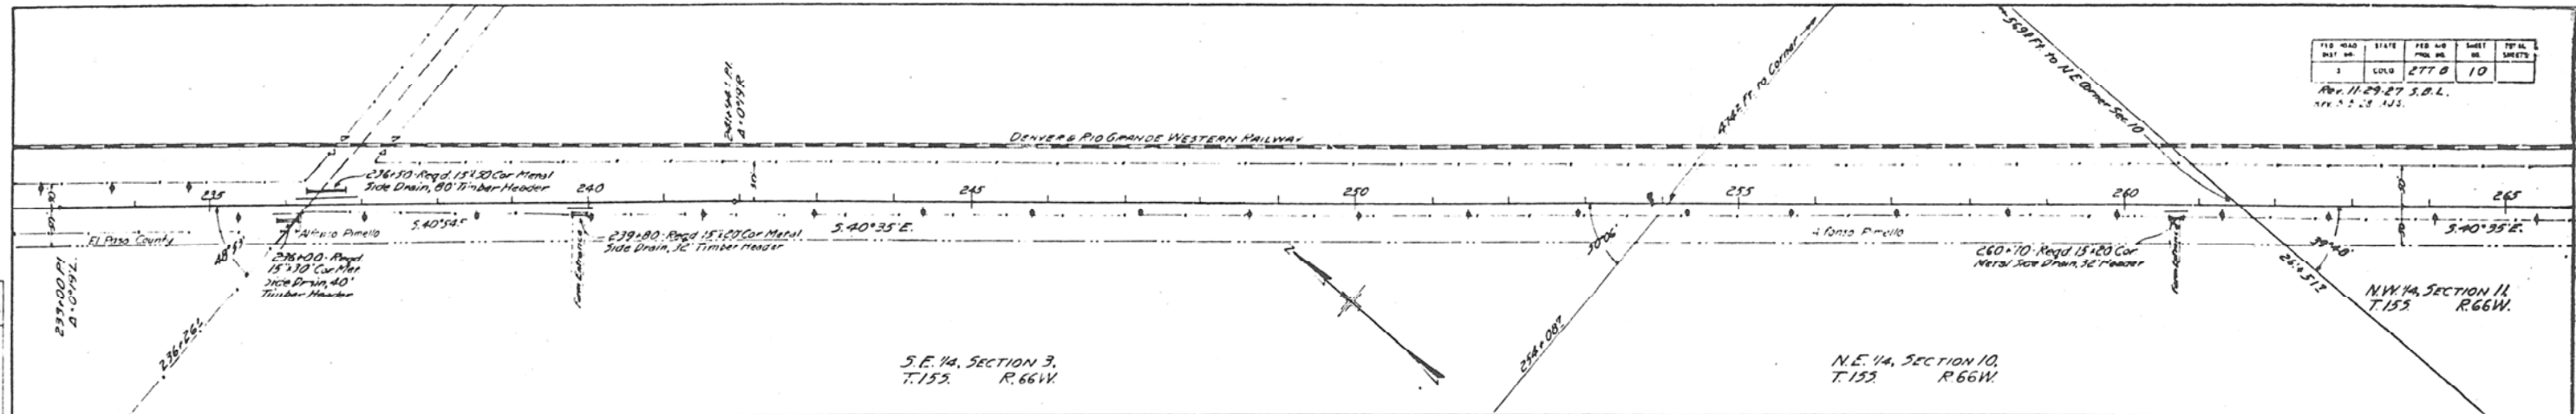

PLAN
 DRAWN BY: [Name]
 CHECKED BY: [Name]
 DATE: [Date]


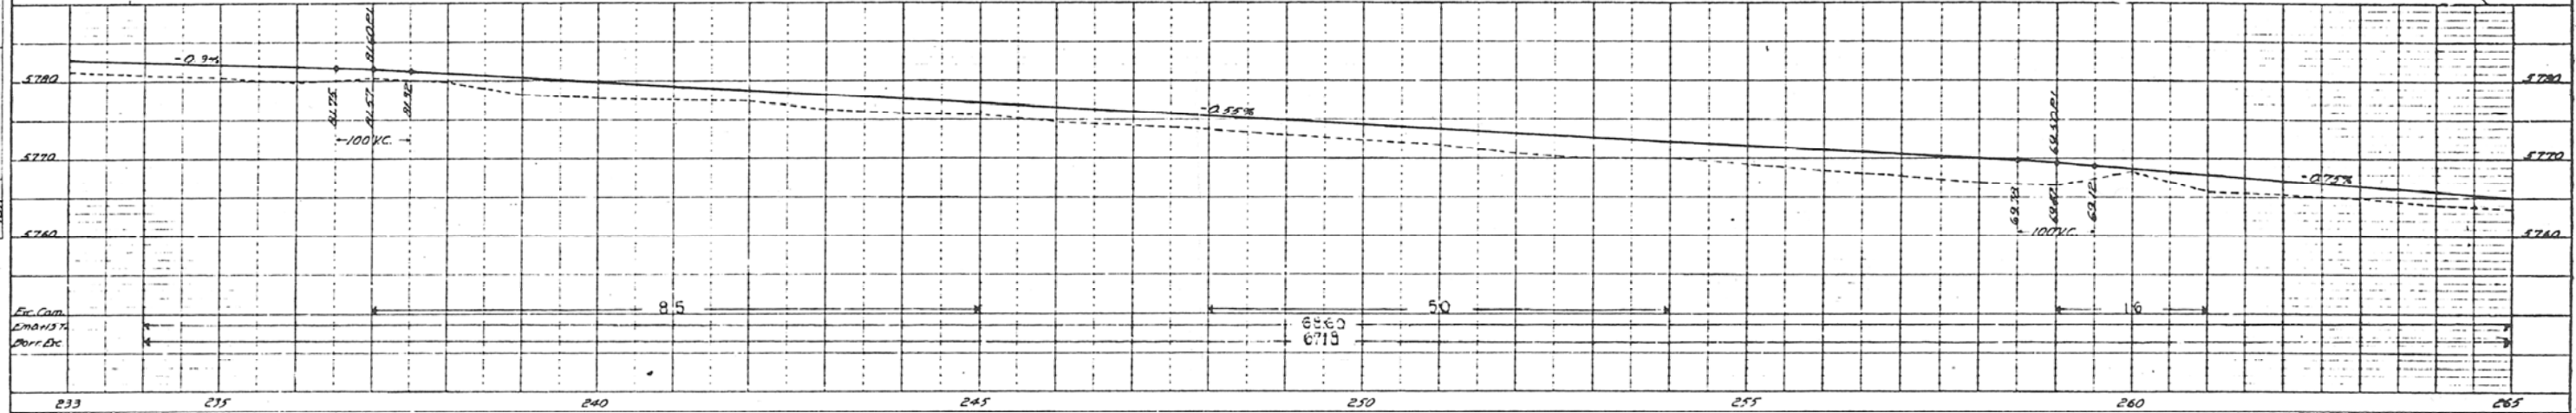


PROFILE
 DRAWN BY: [Name]
 CHECKED BY: [Name]
 DATE: [Date]

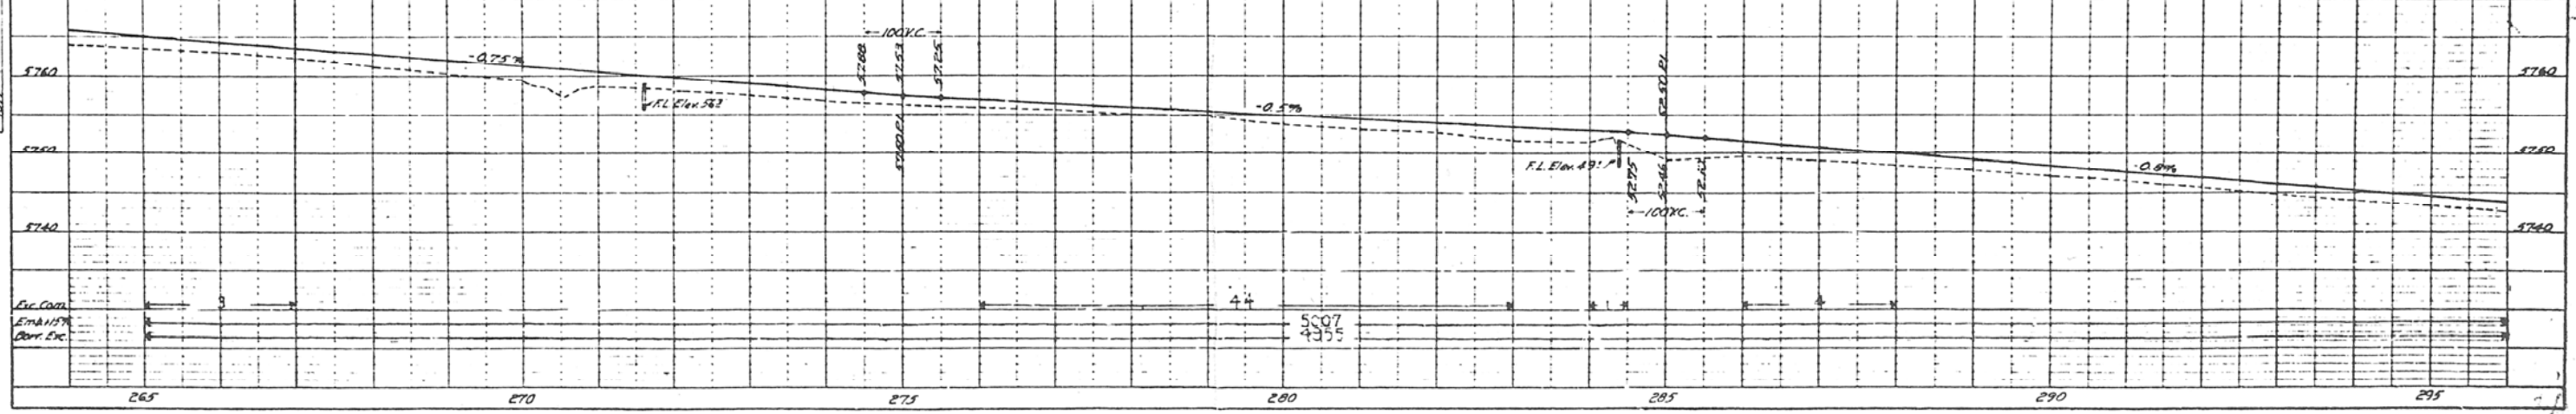
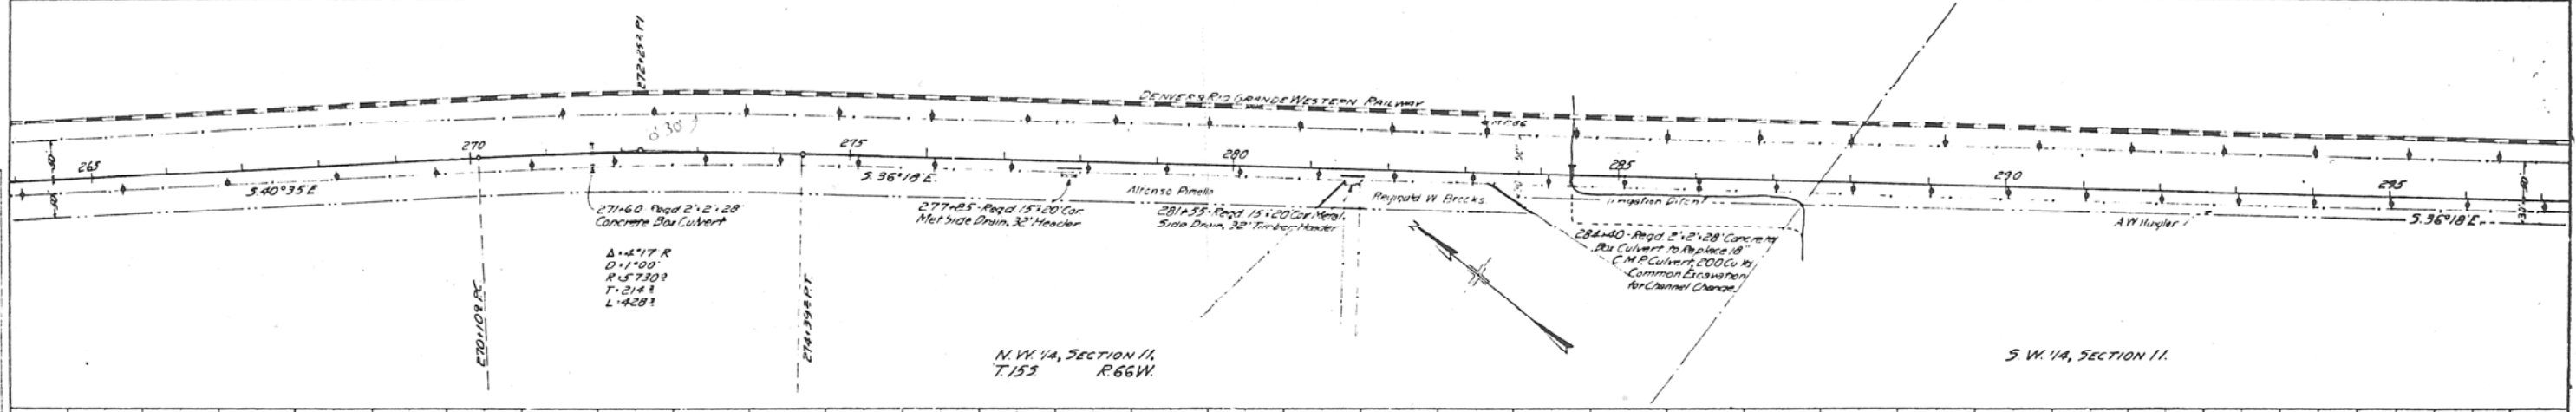


NO.	DATE	BY	REVISION
1	1911	J. H. B.	Original
2	1912	J. H. B.	Revised
3	1913	J. H. B.	Revised

PLAN	DATE	BY	REVISION
1	1911	J. H. B.	Original
2	1912	J. H. B.	Revised
3	1913	J. H. B.	Revised

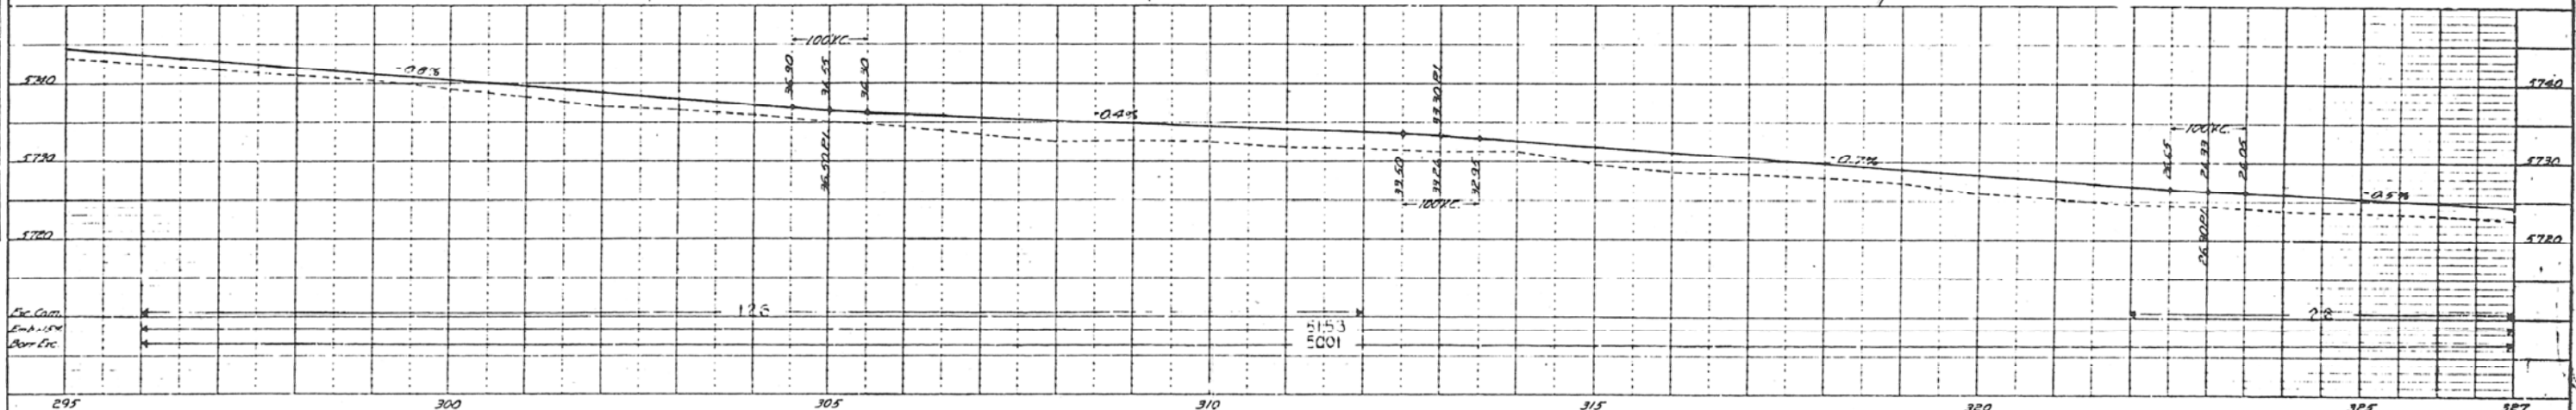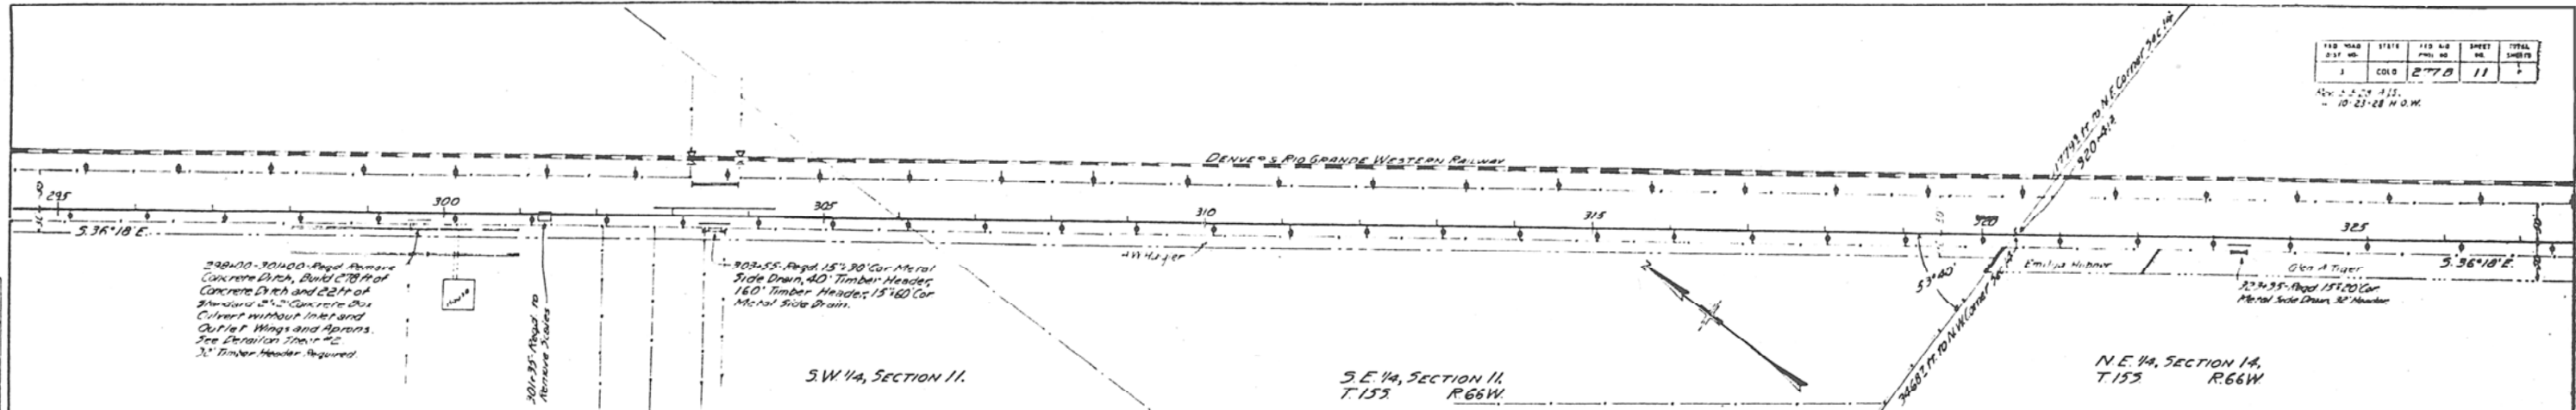

PROFILE	DATE	BY	REVISION
1	1911	J. H. B.	Original
2	1912	J. H. B.	Revised
3	1913	J. H. B.	Revised

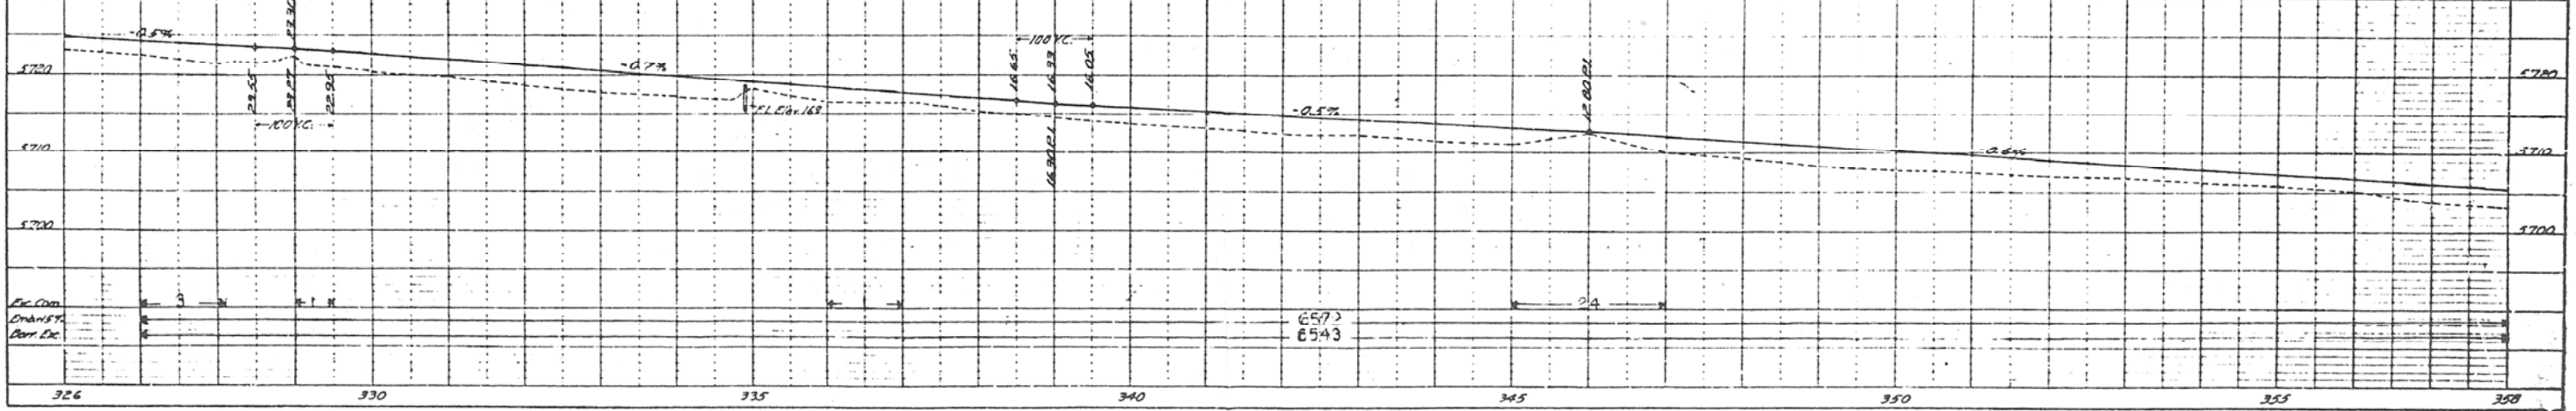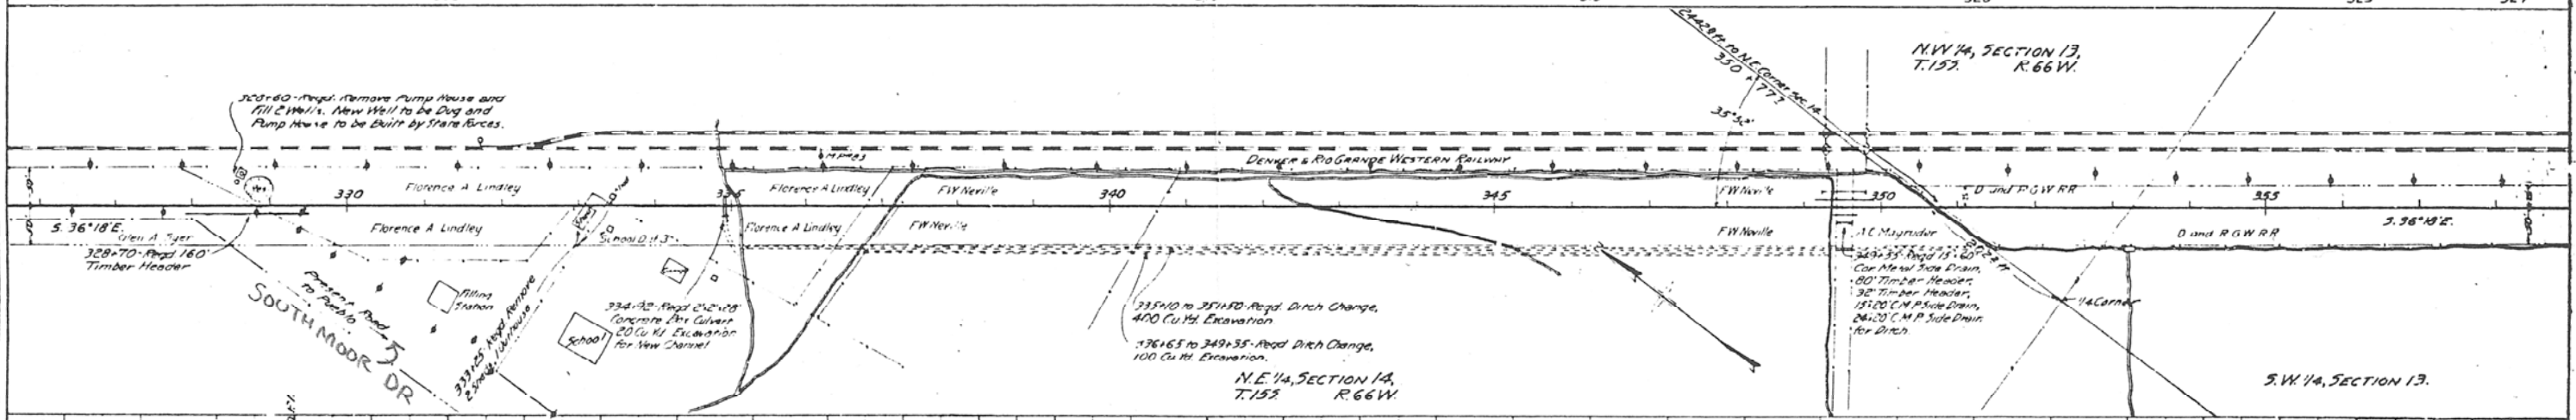

PRESENT STRUCTURE
Span 20' 10"
Clear Roadway 16'
Clear Waterway 23 3/4'
Type of Superstructure Timber
Type of Substructure Timber
Requirements as to Removal To be used for detour and then abandoned



PROPOSED STRUCTURE
Position referred to Present Structure
New Alignment - 800' Upstream
Span 40' 10"
Clear Roadway 20'
Clear Waterway 60 3/4'
Type of Superstructure Concrete
Type of Substructure Concrete

DETOUR STRUCTURE
None required

AVAILABLE RAILROAD SIDING
Name
Crews
Type of Bridge
1/4 Mile

NEARBY STRUCTURES ON SAME STREAM
Location 100' Upstream
Waterway 600 Sq. Ft.
Record during Floods

STREAM DATA
Channel Area in Square Miles
Velocity during High Water
Elevation of:
Maximum High Water Reported
Normal High Water
Extreme Low Water Dry Stream Bed
Drift Carried during Floods
Possible Depth of scour during Floods

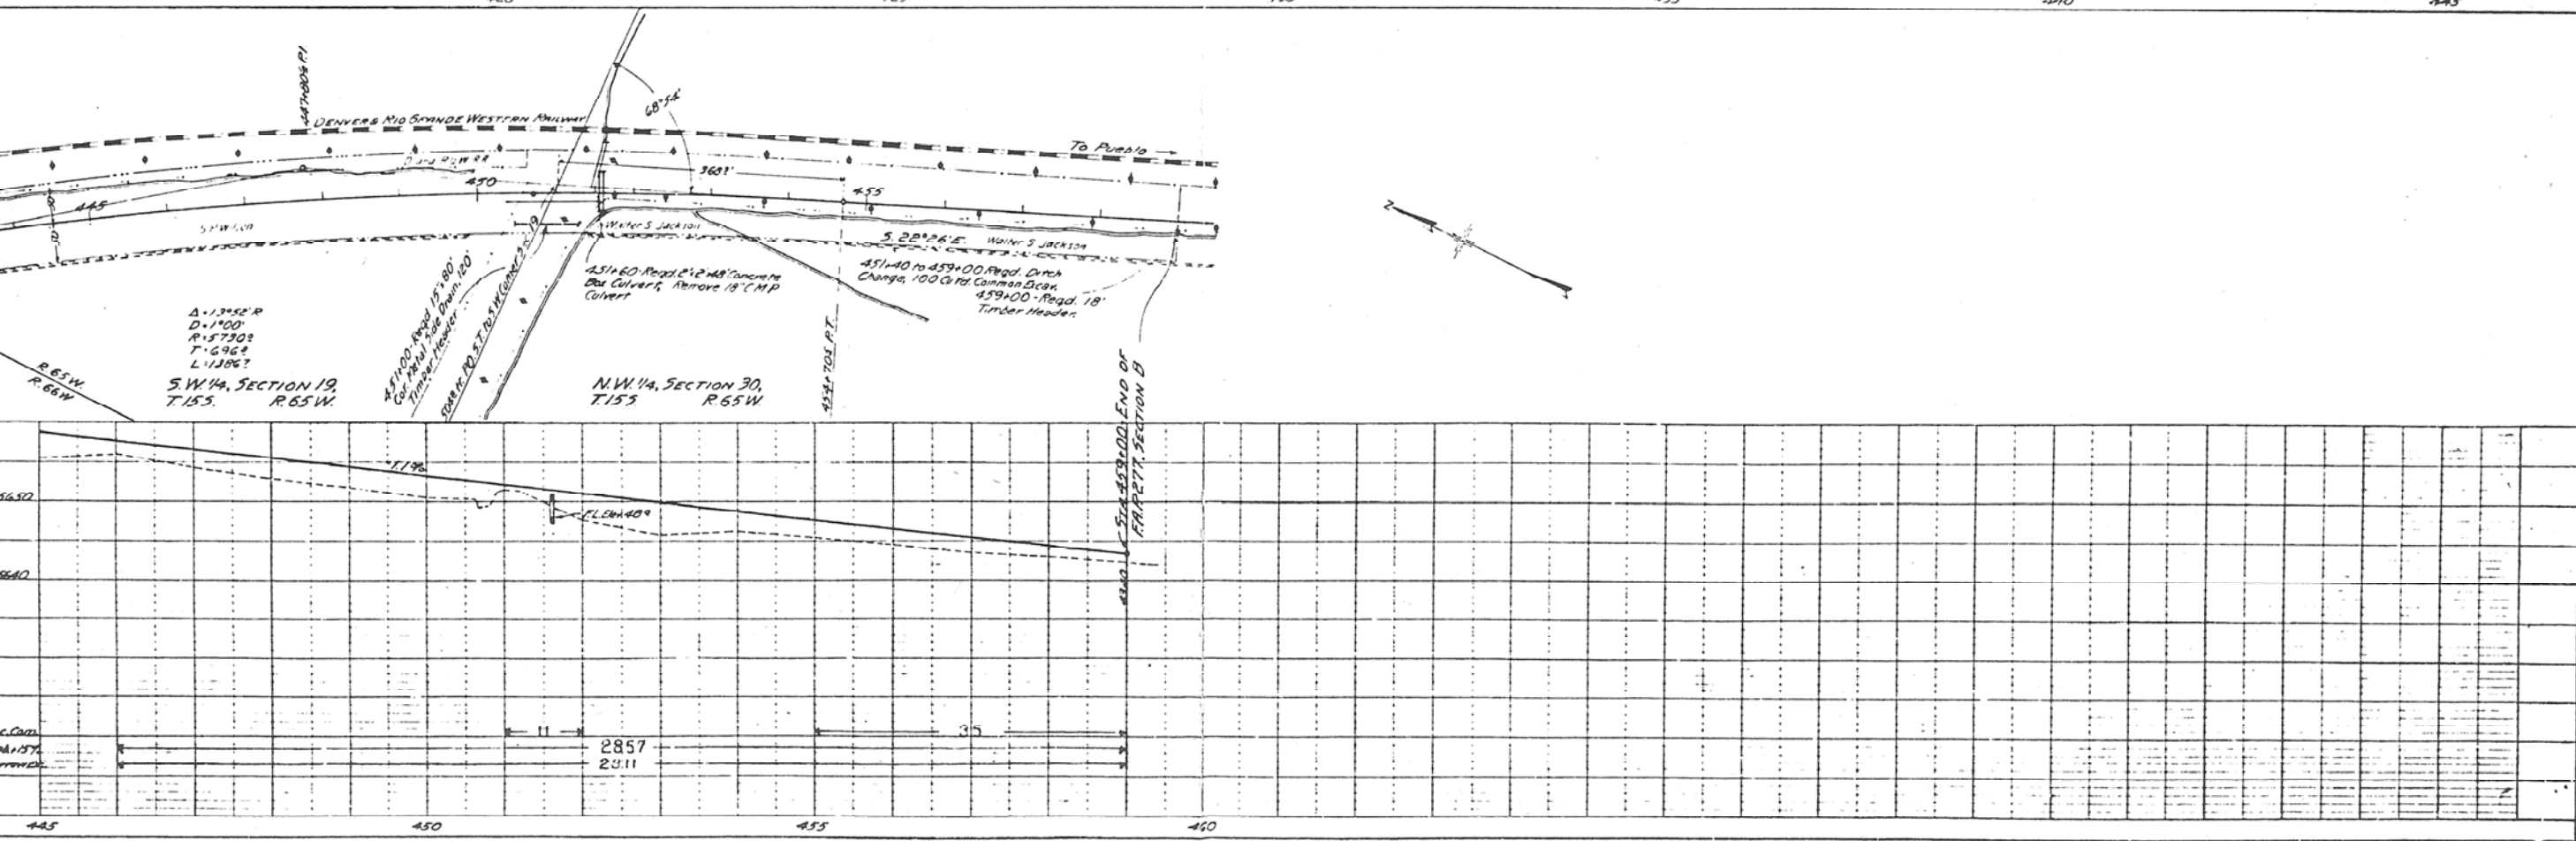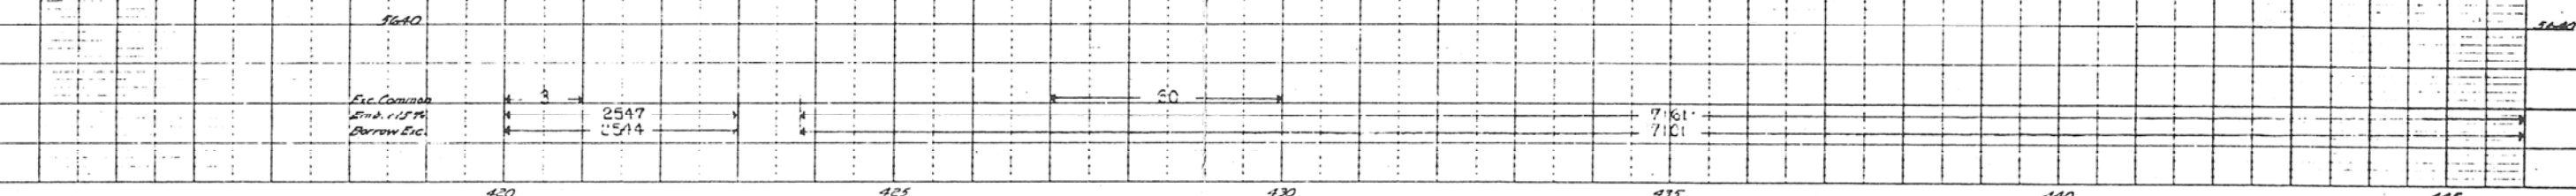

PLAN
BY
DATE

PROFILE
BY
DATE