



COLORADO
Department of
Transportation

DOCUMENT SEPARATOR SHEET

REGION 5 – JUNE 2017 CONVERSION

To be placed at the beginning of each separator sheet.



r500001538

Description:

ROW Plans 11X17

Route # and Mile Points:

SH 17

Originating Office:


ROW/Survey

File Name:

F.P. 5-2(2)_ROW(.PDF)

Box Location:

25 of 38

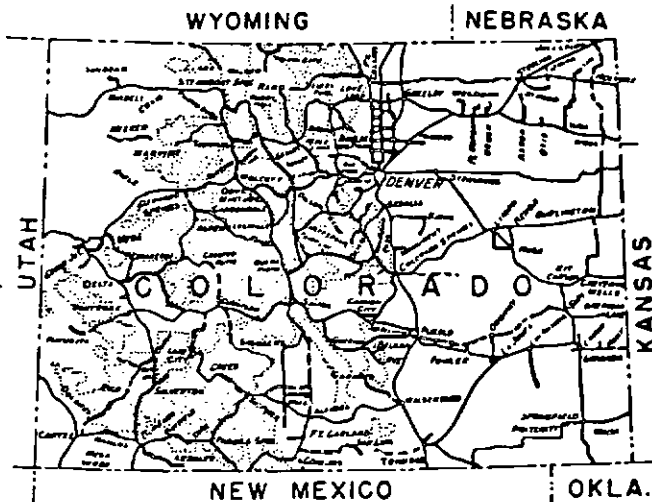

U.S. DEPARTMENT OF COMMERCE BUREAU OF PUBLIC ROADS

AS CONSTRUCTED COLORADO FOREST HIGHWAY PROJECT 5-2(2) CUMBRES PASS 021 LENGTH 5.012 MILES CLASS 2 RIO GRANDE NATIONAL FOREST CONEJOS COUNTY

REGION 9 STATE COLORADO
PROJECT 5-2(2), Cumbres Pass
SHEET 1 OF 1 SHEETS


INDEX TO SHEETS

SHEET NO.	DESCRIPTION	STATION TO STATION
1	Title Sheet	
2	Typical Sections	
3	Summary (2 Sheets)	
38-47	Plan & Profile	1050+00 1314+00
Std. 118	Concrete and Metal End Sections	
Std. 119	Underdrain	
Std. 131	Maintenance Posts & Delineators	
Std. 143	Project Identification Signs	
Sol. 136	Wire Fences with Steel Posts	

Plans prepared by: B.P.R.
Date: April, 1963

Description of Project
Improvement: Grading & Bit. Stab. Base
Roadbed Width:
Grading: 34'
Base: 28'
Type Code: 2013

Traffic Volume
A.T.T. (1961): 165
A.T.T. (1981): 550
D.M.V.: 80
D: 65%
T: 10%
V: 50

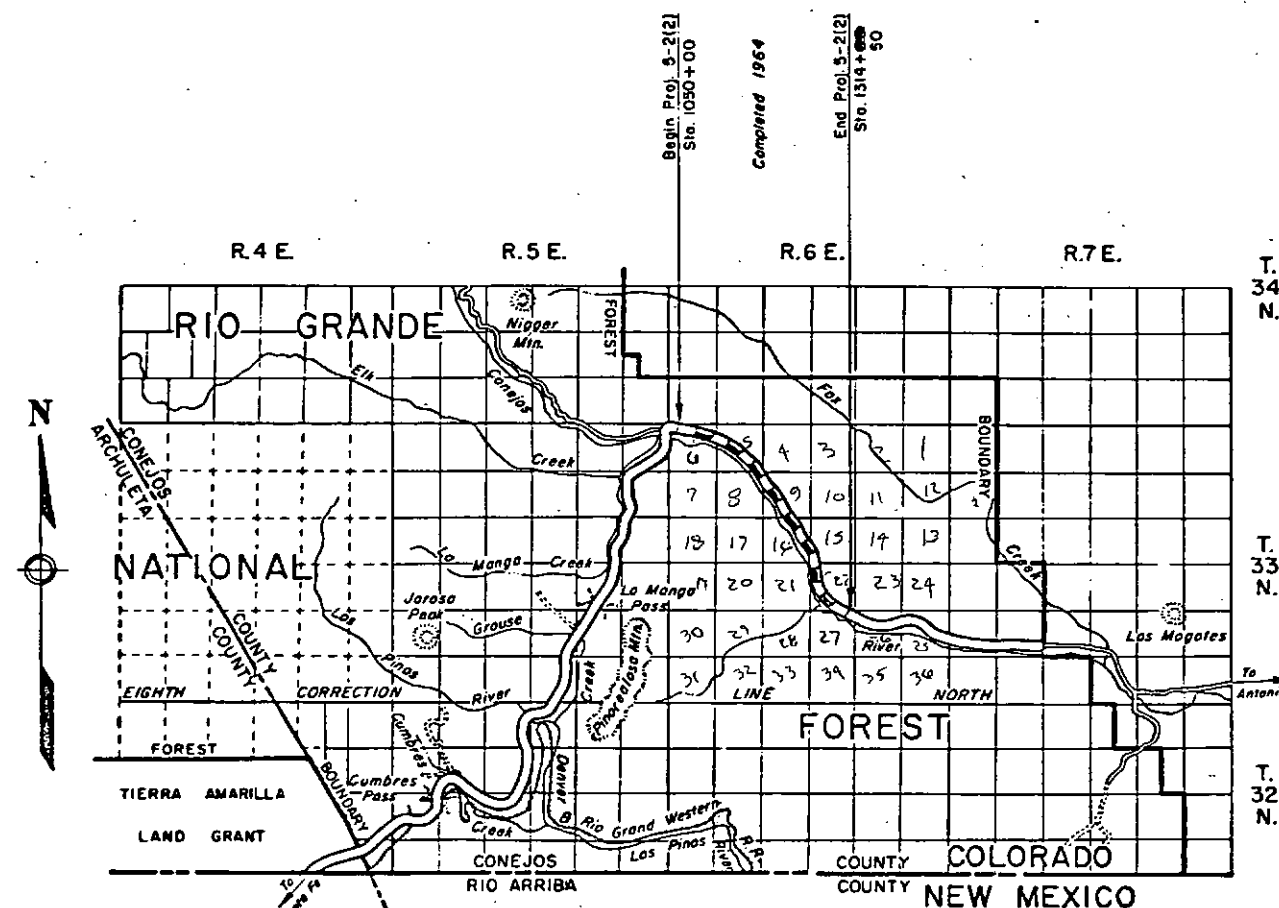

U.S. DEPARTMENT OF COMMERCE
BUREAU OF PUBLIC ROADS
REGION NO. 9 DENVER, COLORADO


APPROVED:

REGIONAL ENGINEER DATE 19

LEGEND

EXISTING ROAD	UNIMPROVED	GRADED	REINFORCED BASE	SURFACE TREATMENT	HOOR PLANT CONC. CONC.
			SUBGRADE	C.O.U.P.S.C.	M.S. BITUM.

U.S. Government
(Forest Lands)

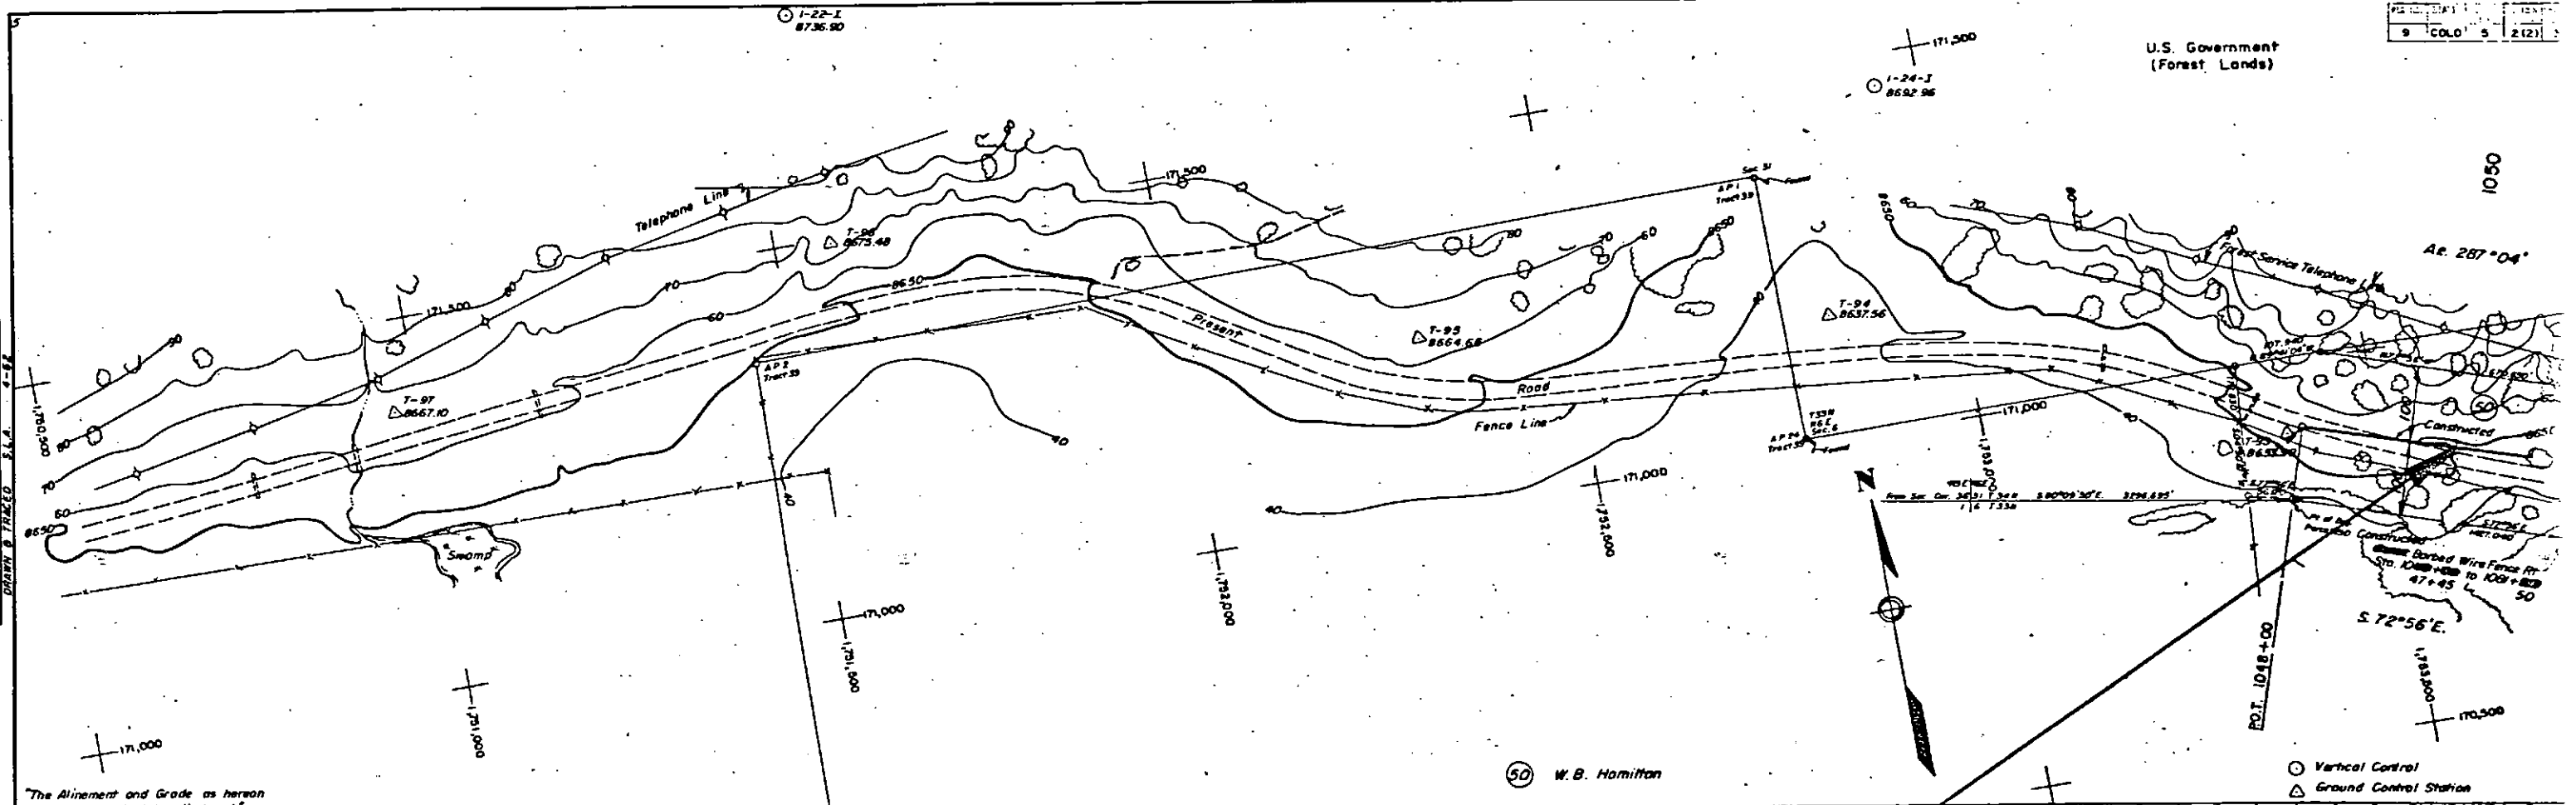


"The Alignment and Grade as hereon shown are subject to adjustment."

(50) W. B. Hamilton

Vertical Control
Ground Control Station


STA 1050+00 WEST END PROJ. 5-2(2)
1964 CONSTRUCTION

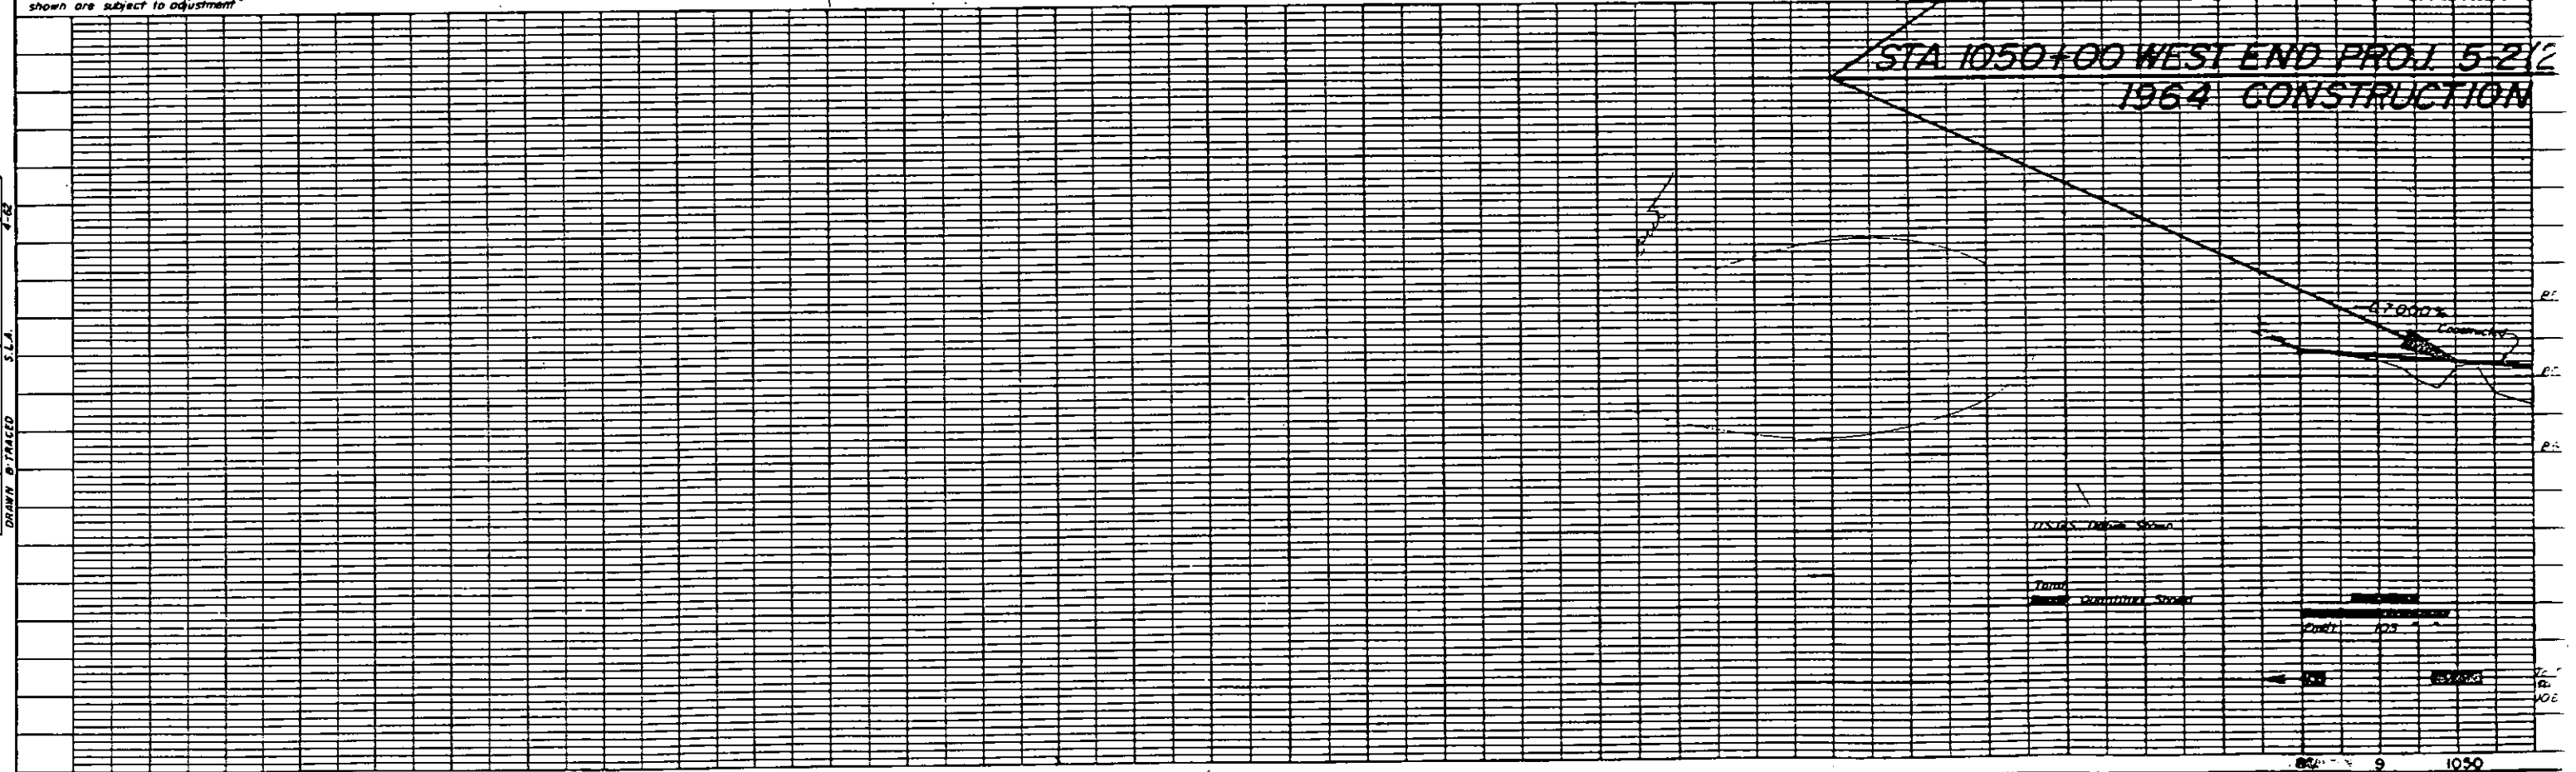

(As Constructed)


CUMBRES PASS 5-2(2)

PLAN	DATE	BY	CHECKED
DATE	BY	CHECKED	DATE
DATE	BY	CHECKED	DATE
DATE	BY	CHECKED	DATE


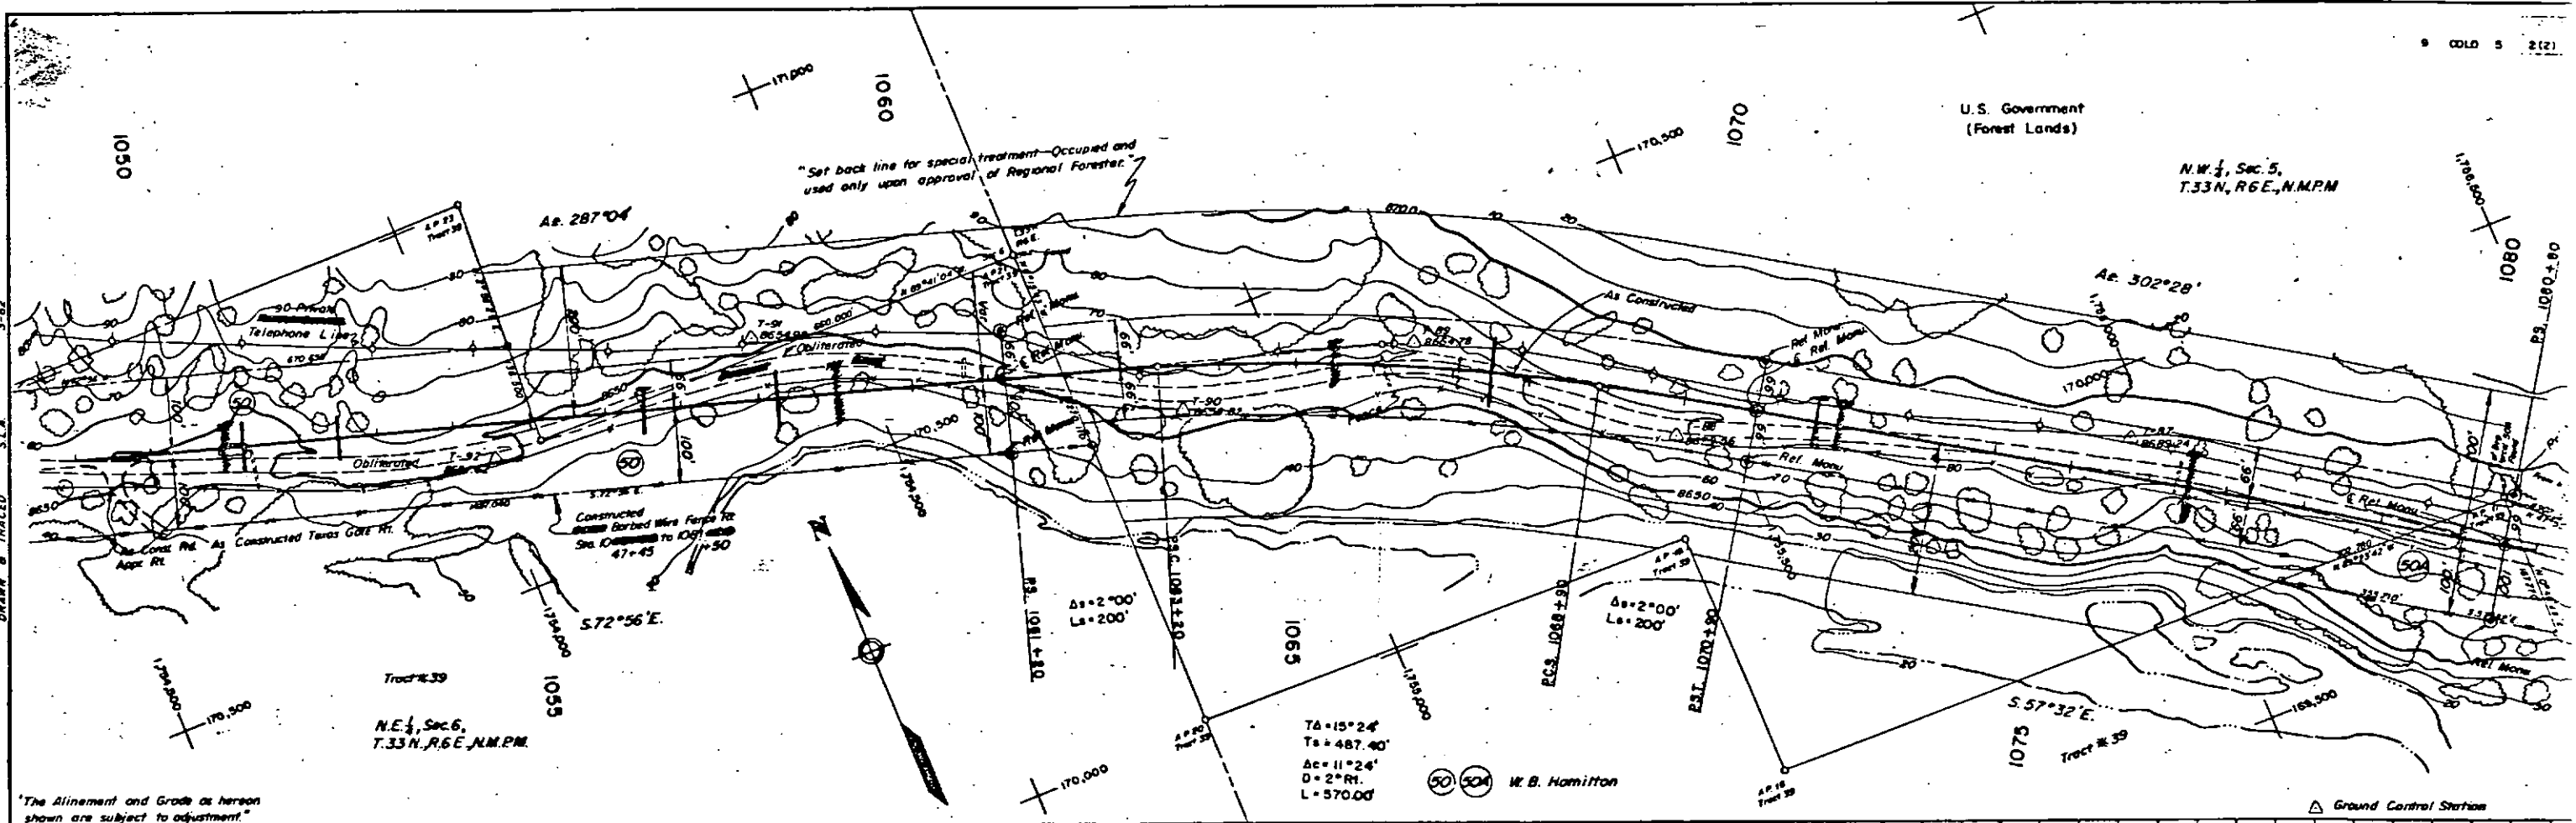


The Alignment and Grade as herein shown are subject to adjustment.



PROFILE	DATE	BY	CHECKED
DATE	BY	CHECKED	DATE
DATE	BY	CHECKED	DATE
DATE	BY	CHECKED	DATE

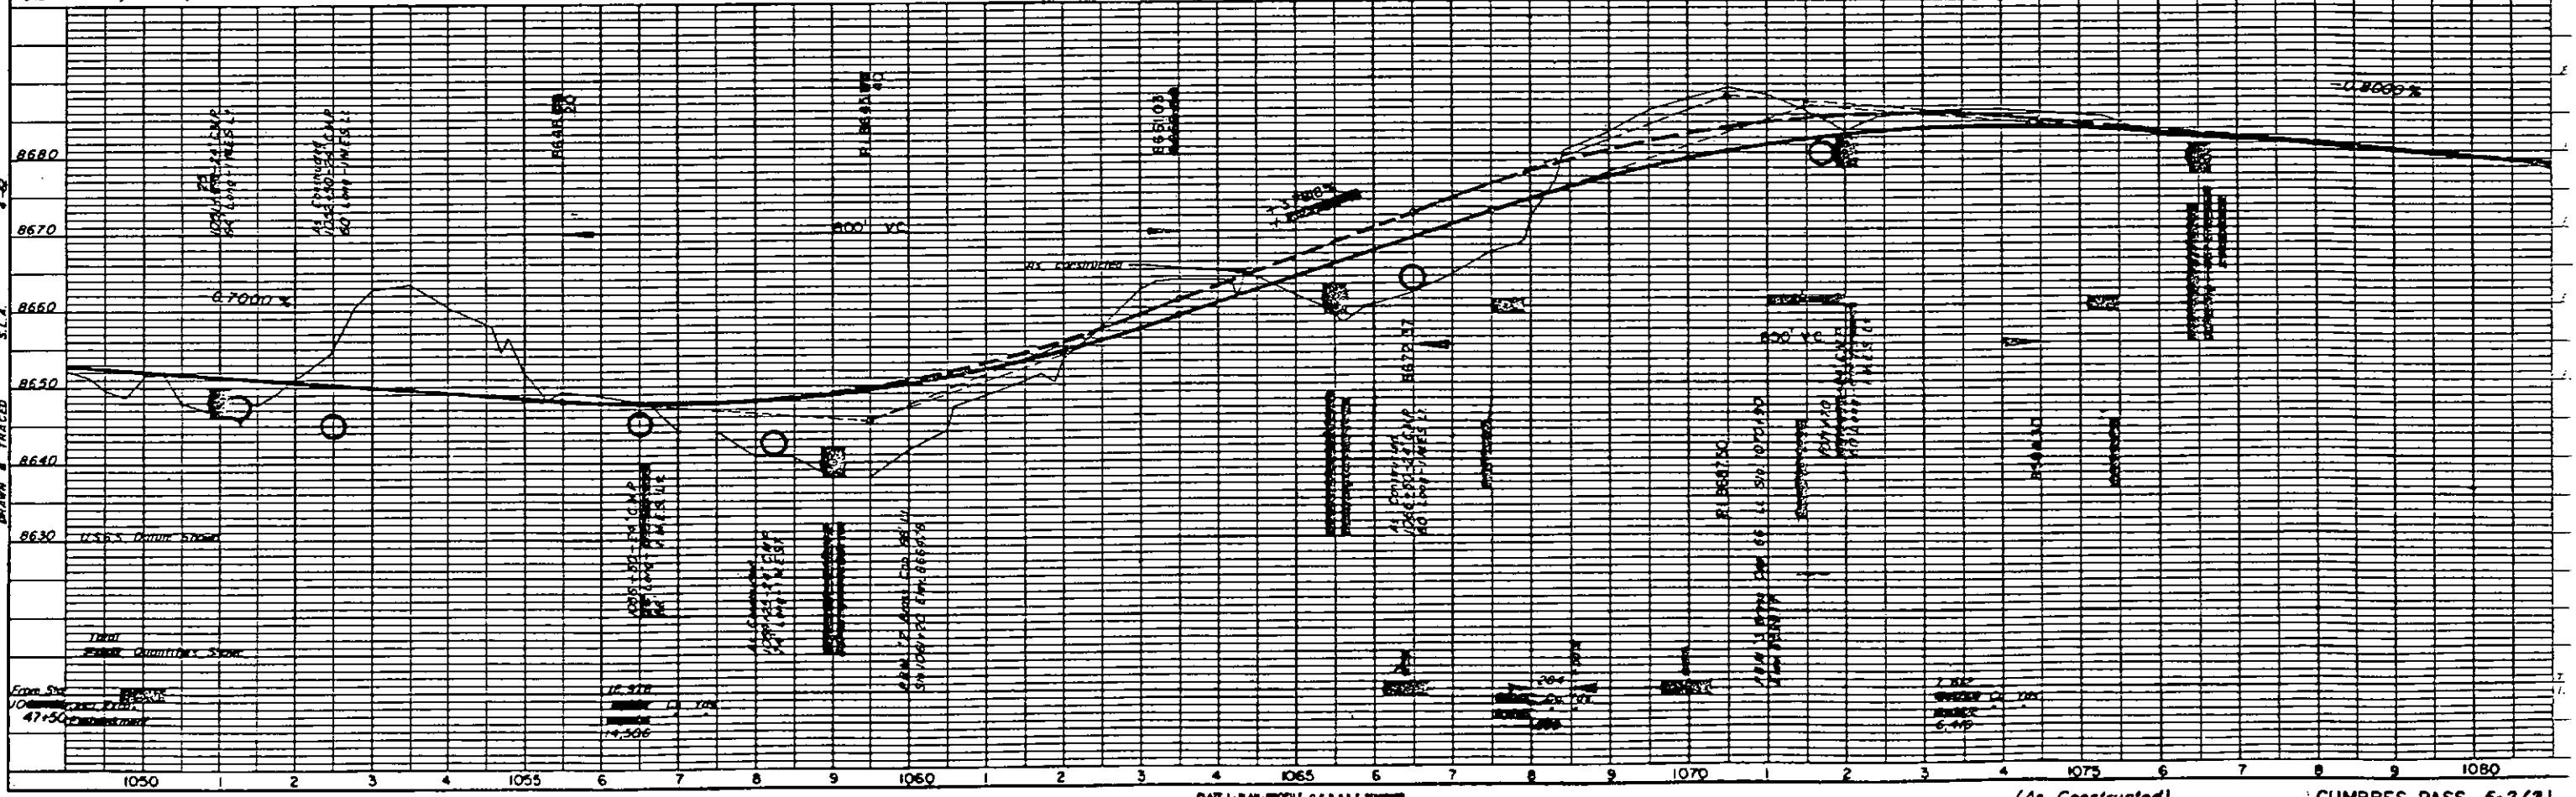

U.S. Government
(Forest Lands)

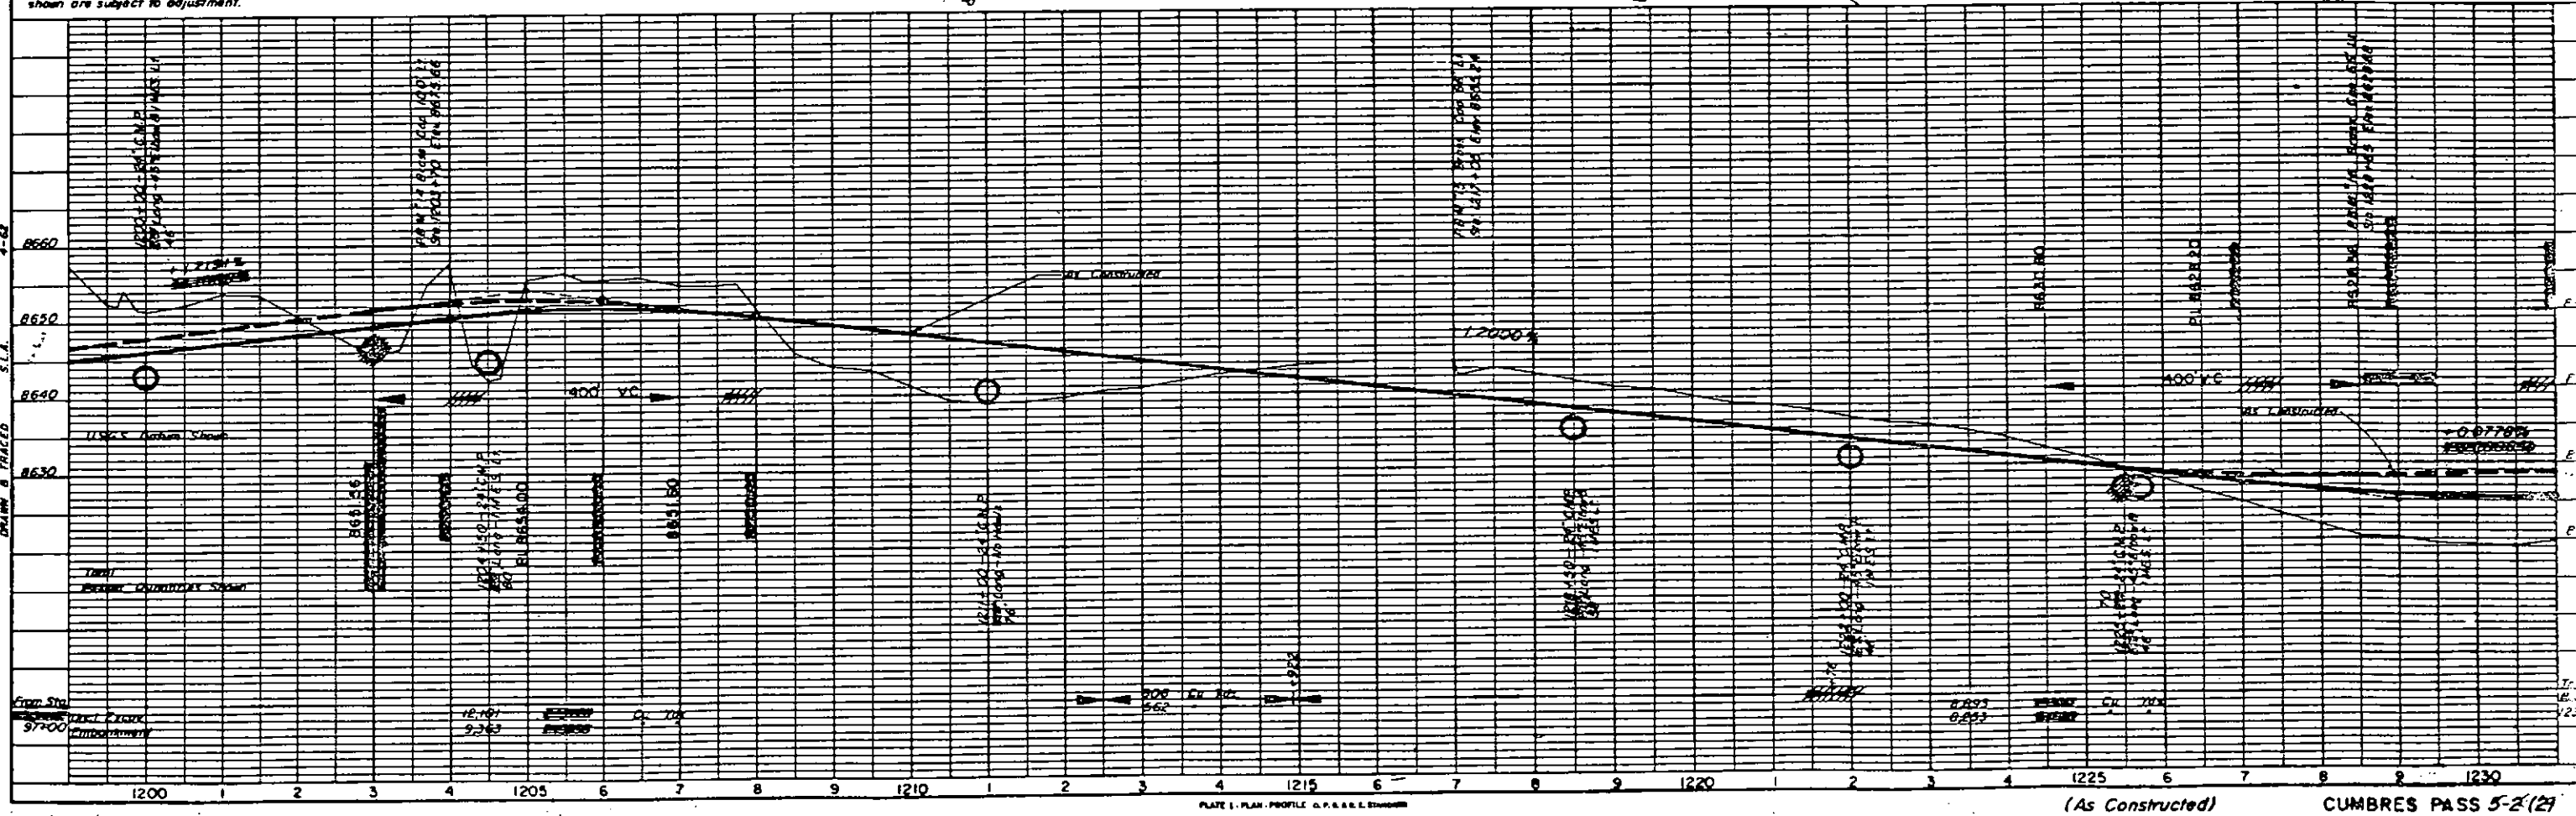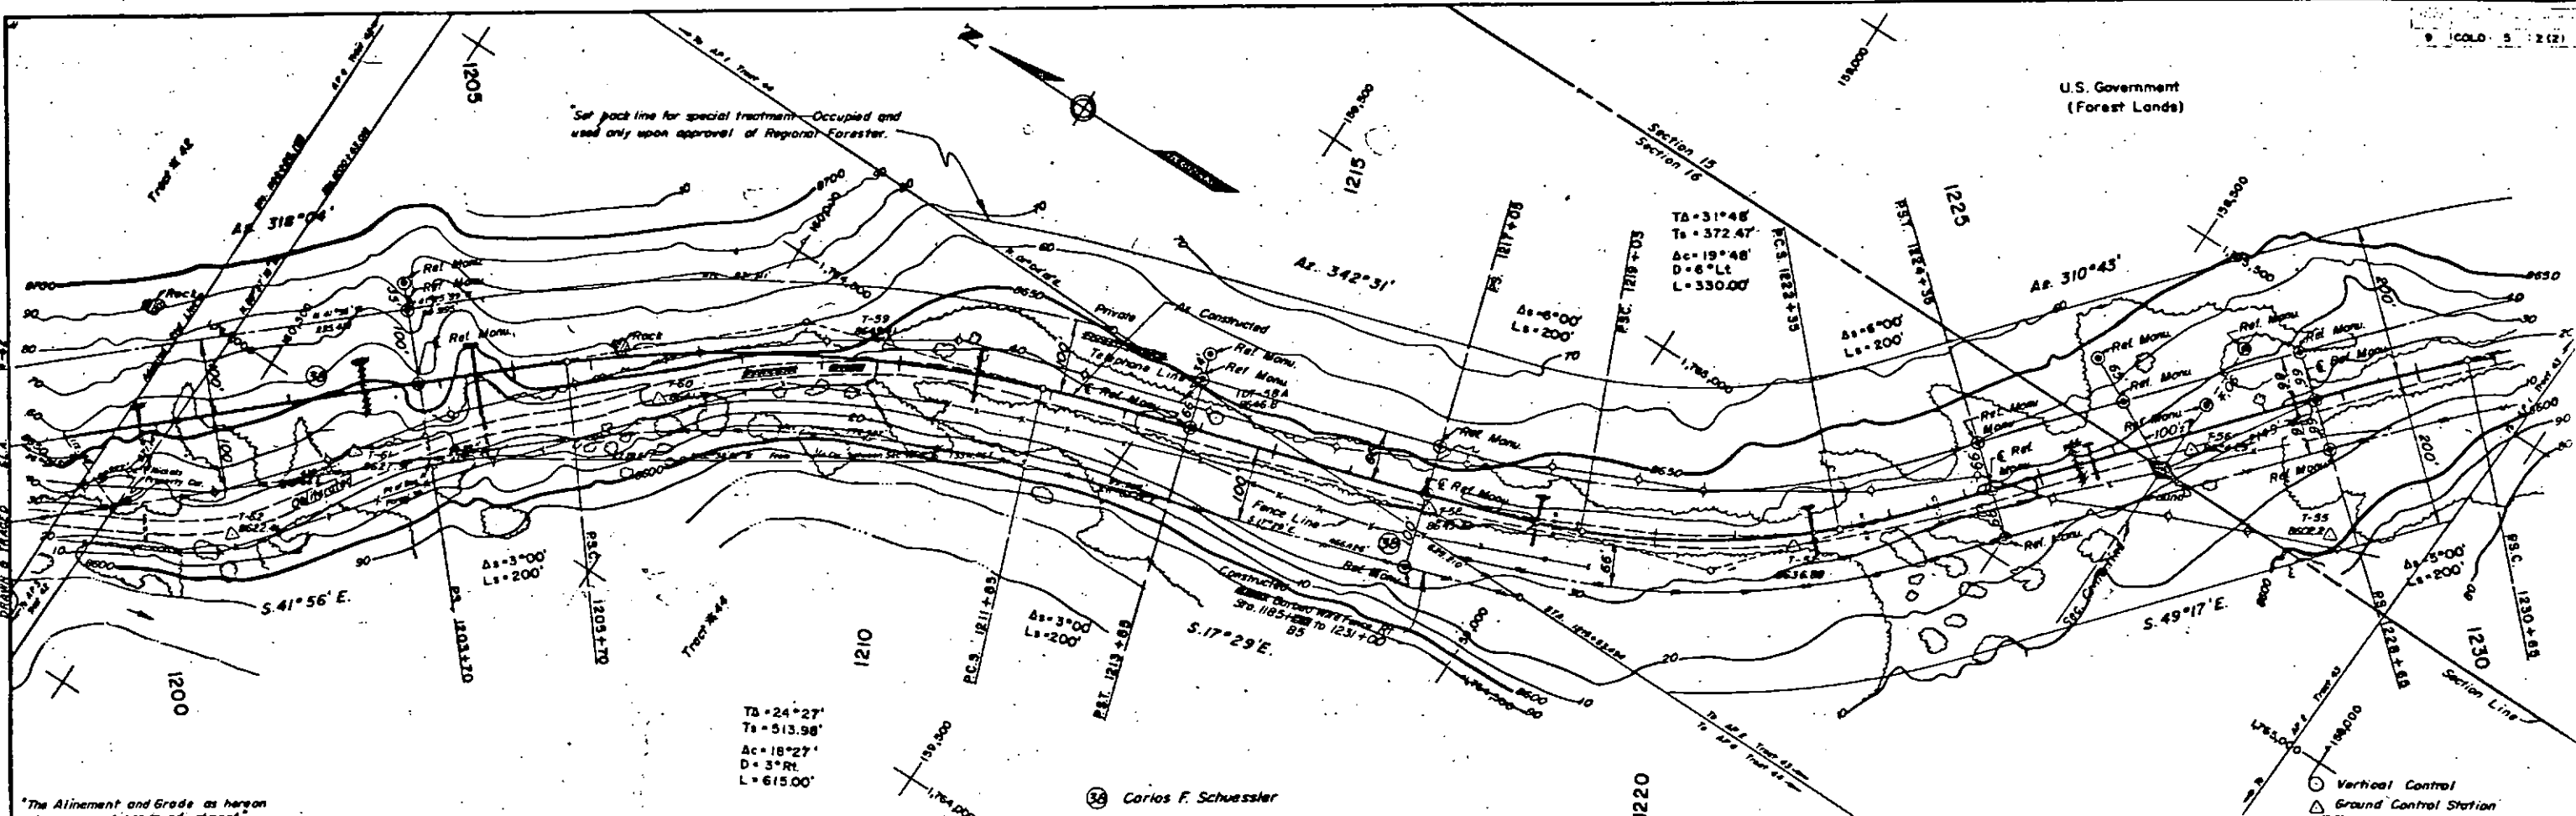


DESIGNED BY	NO. 1
CHECKED BY	NO. 2
APPROVED BY	NO. 3
DATE	NO. 4
PROJECT	NO. 5
SECTION	NO. 6
DATE	NO. 7
PROJECT	NO. 8
SECTION	NO. 9
DATE	NO. 10
PROJECT	NO. 11
SECTION	NO. 12
DATE	NO. 13
PROJECT	NO. 14
SECTION	NO. 15
DATE	NO. 16
PROJECT	NO. 17
SECTION	NO. 18
DATE	NO. 19
PROJECT	NO. 20
SECTION	NO. 21
DATE	NO. 22
PROJECT	NO. 23
SECTION	NO. 24
DATE	NO. 25
PROJECT	NO. 26
SECTION	NO. 27
DATE	NO. 28
PROJECT	NO. 29
SECTION	NO. 30
DATE	NO. 31
PROJECT	NO. 32
SECTION	NO. 33
DATE	NO. 34
PROJECT	NO. 35
SECTION	NO. 36
DATE	NO. 37
PROJECT	NO. 38
SECTION	NO. 39
DATE	NO. 40
PROJECT	NO. 41
SECTION	NO. 42
DATE	NO. 43
PROJECT	NO. 44
SECTION	NO. 45
DATE	NO. 46
PROJECT	NO. 47
SECTION	NO. 48
DATE	NO. 49
PROJECT	NO. 50
SECTION	NO. 51
DATE	NO. 52
PROJECT	NO. 53
SECTION	NO. 54
DATE	NO. 55
PROJECT	NO. 56
SECTION	NO. 57
DATE	NO. 58
PROJECT	NO. 59
SECTION	NO. 60
DATE	NO. 61
PROJECT	NO. 62
SECTION	NO. 63
DATE	NO. 64
PROJECT	NO. 65
SECTION	NO. 66
DATE	NO. 67
PROJECT	NO. 68
SECTION	NO. 69
DATE	NO. 70
PROJECT	NO. 71
SECTION	NO. 72
DATE	NO. 73
PROJECT	NO. 74
SECTION	NO. 75
DATE	NO. 76
PROJECT	NO. 77
SECTION	NO. 78
DATE	NO. 79
PROJECT	NO. 80
SECTION	NO. 81
DATE	NO. 82
PROJECT	NO. 83
SECTION	NO. 84
DATE	NO. 85
PROJECT	NO. 86
SECTION	NO. 87
DATE	NO. 88
PROJECT	NO. 89
SECTION	NO. 90
DATE	NO. 91
PROJECT	NO. 92
SECTION	NO. 93
DATE	NO. 94
PROJECT	NO. 95
SECTION	NO. 96
DATE	NO. 97
PROJECT	NO. 98
SECTION	NO. 99
DATE	NO. 100

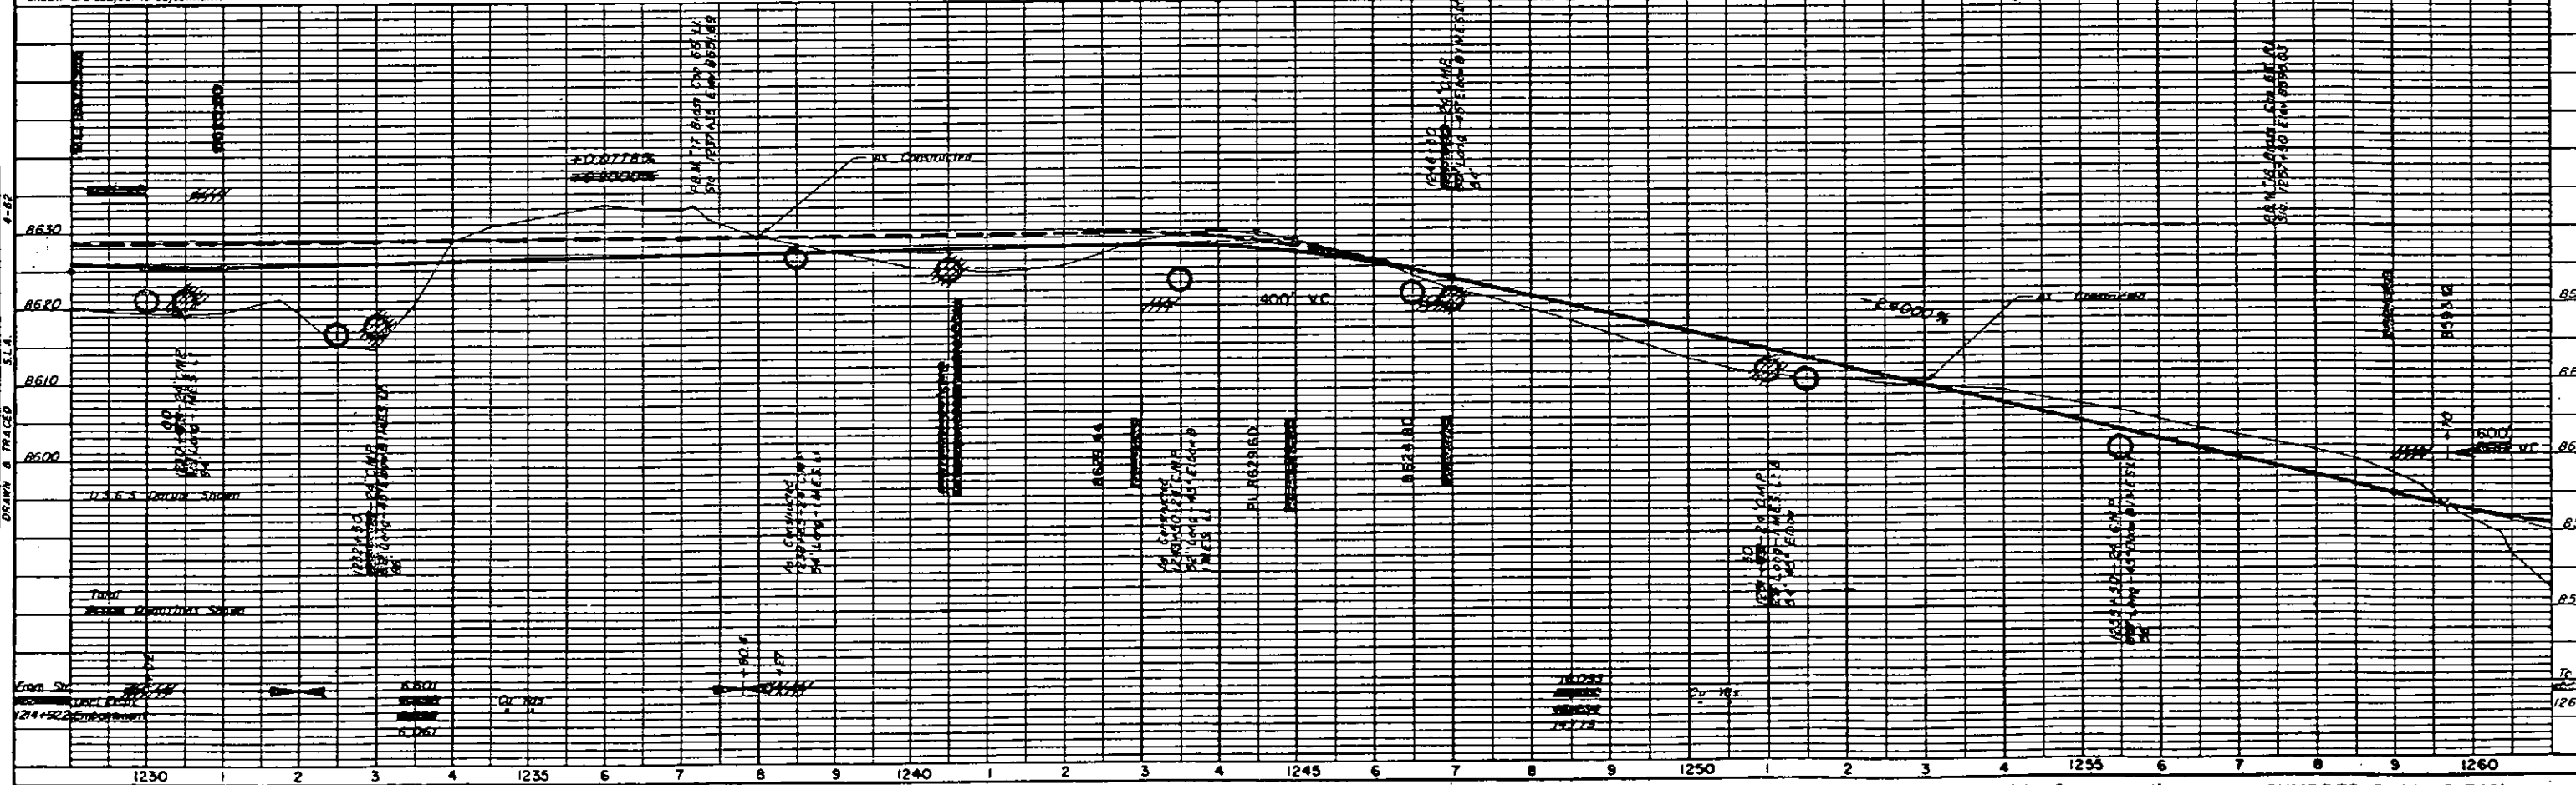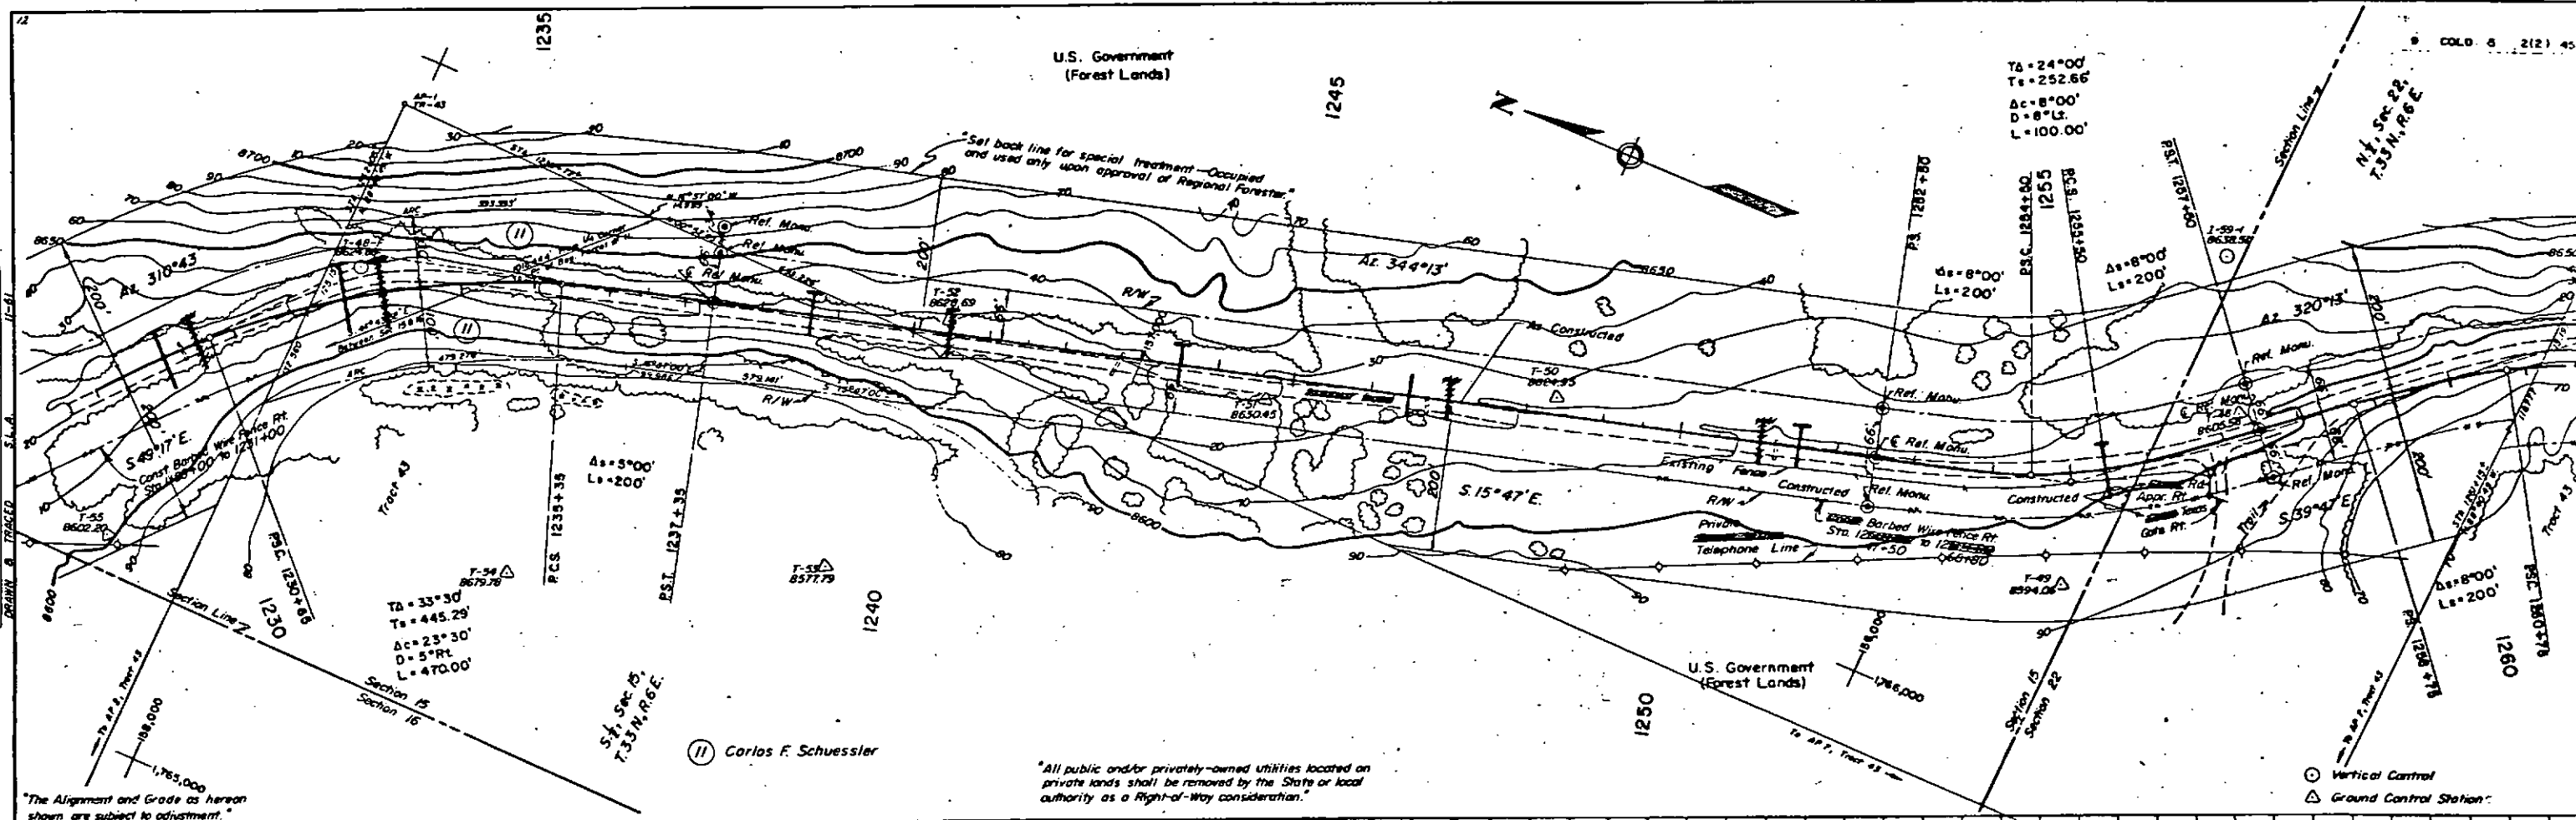

PLAN	DATE
SUPPLIED	
NOTE BOOK	
ALIGNED CHECKED	
NO. OF WAY CHECKED	
NO.	

PLAN	DATE
SUPPLIED	
NOTE BOOK	
ALIGNED CHECKED	
NO. OF WAY CHECKED	
NO.	

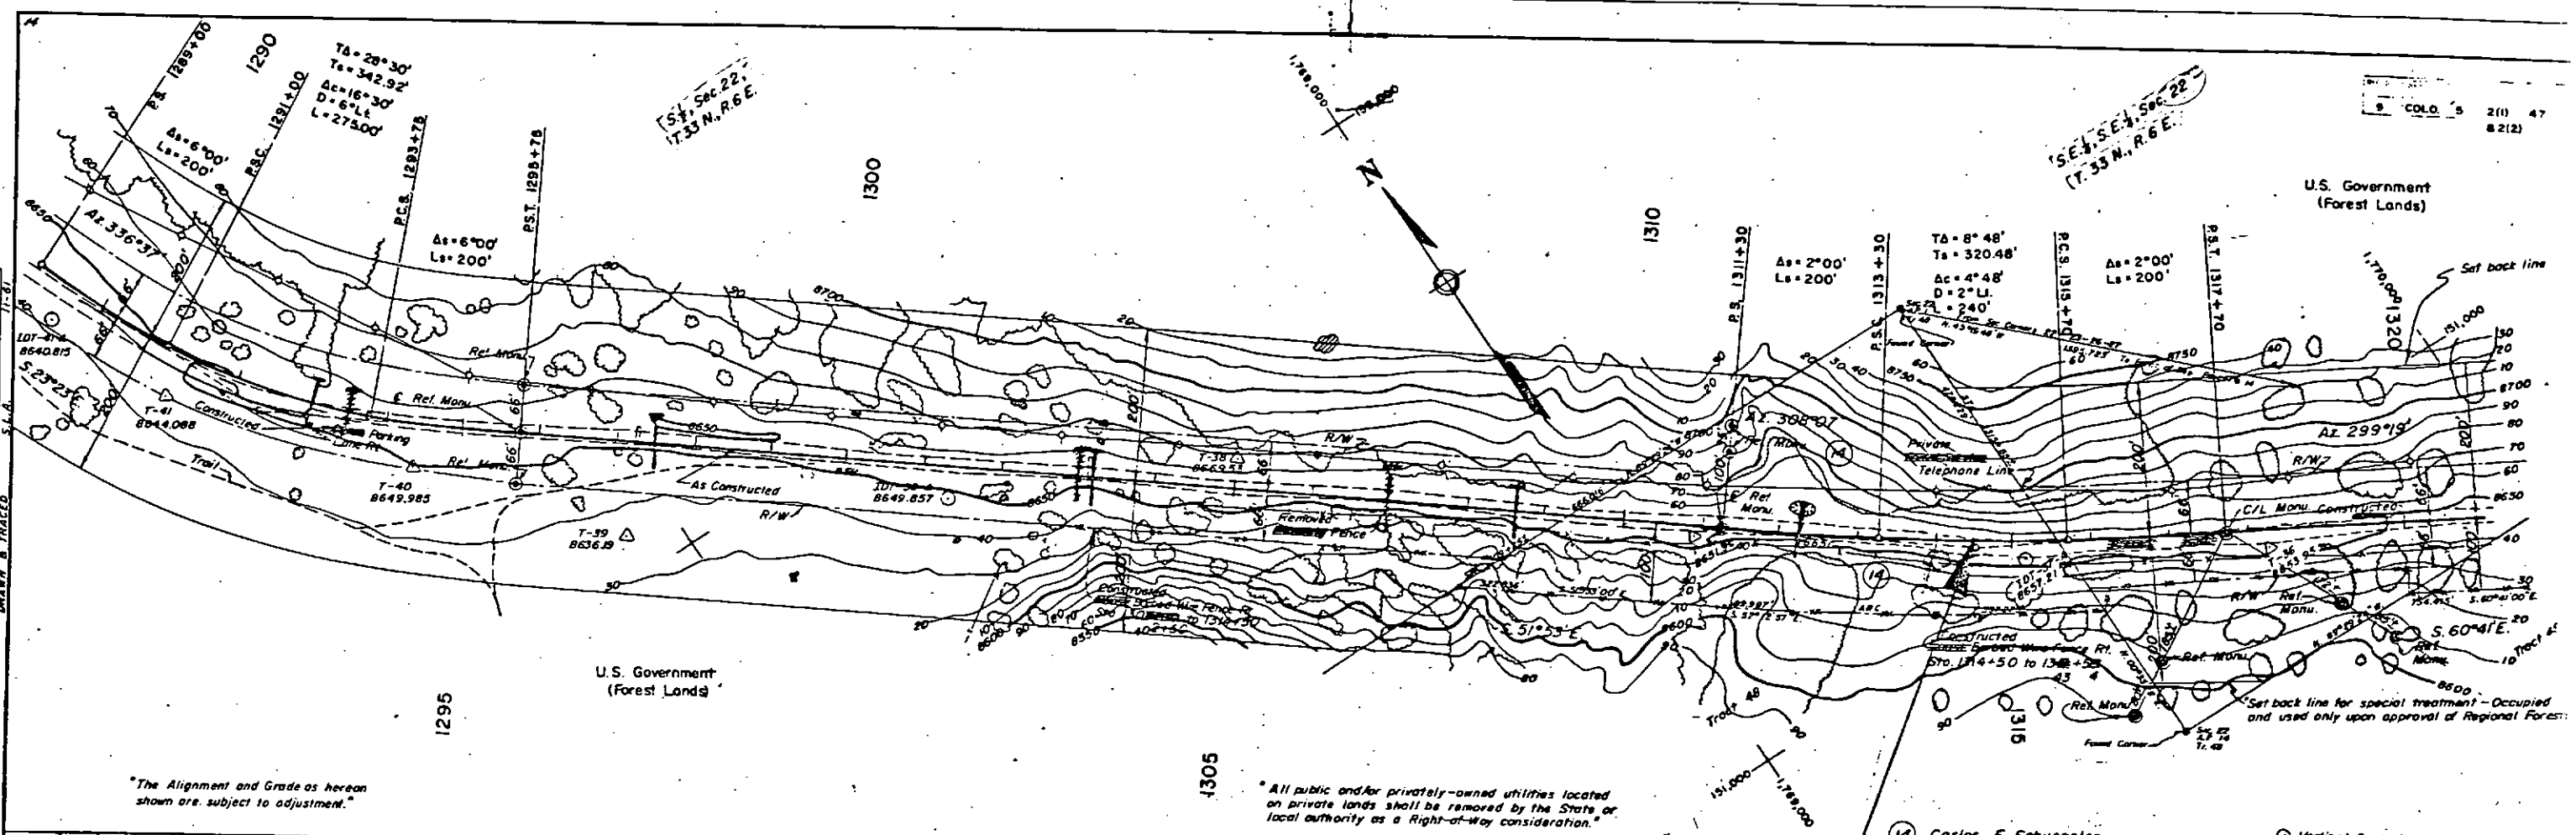

"The Alignment and Grade as hereon shown are subject to adjustment."

"All public and/or privately-owned utilities located on private lands shall be removed by the State or local authority as a Right-of-Way consideration."

(14) Carlos F. Schuessler

Vertical Control
Ground Control Station

STA 1314+50 EAST END PROJ 5-2(2) 1964 CONSTRUCTION

STA 1314+50 WEST END PROJ 5-2(1) 1963 CONSTRUCTION

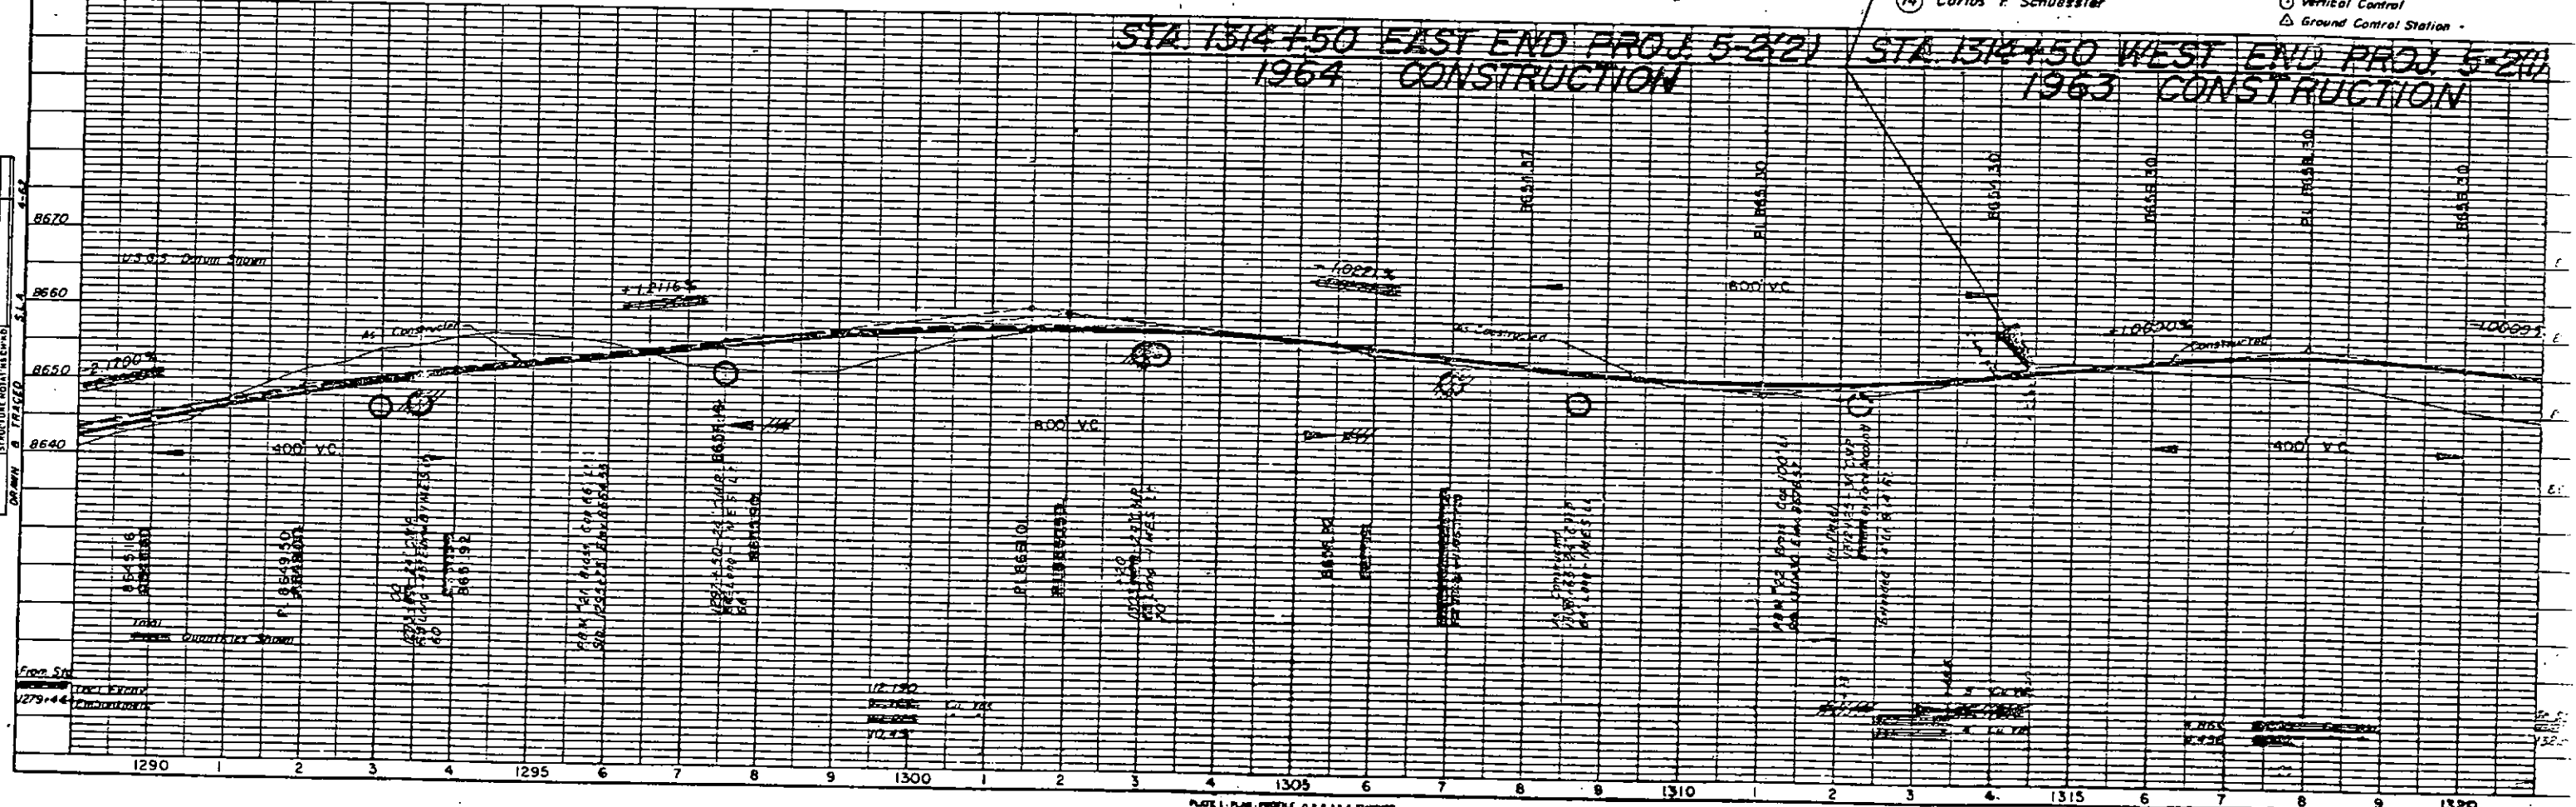


PLATE 1 - PLAN PROFILE GRADE ELEVATION
RECEIVED & CORRECTED 10/10/64

(As Constructed) CUMBRES PASS 5-2(2), 2(1) 4