


TYPICAL CROSS SECTION OF IMPROVEMENT AND SUMMARY OF QUANTITIES

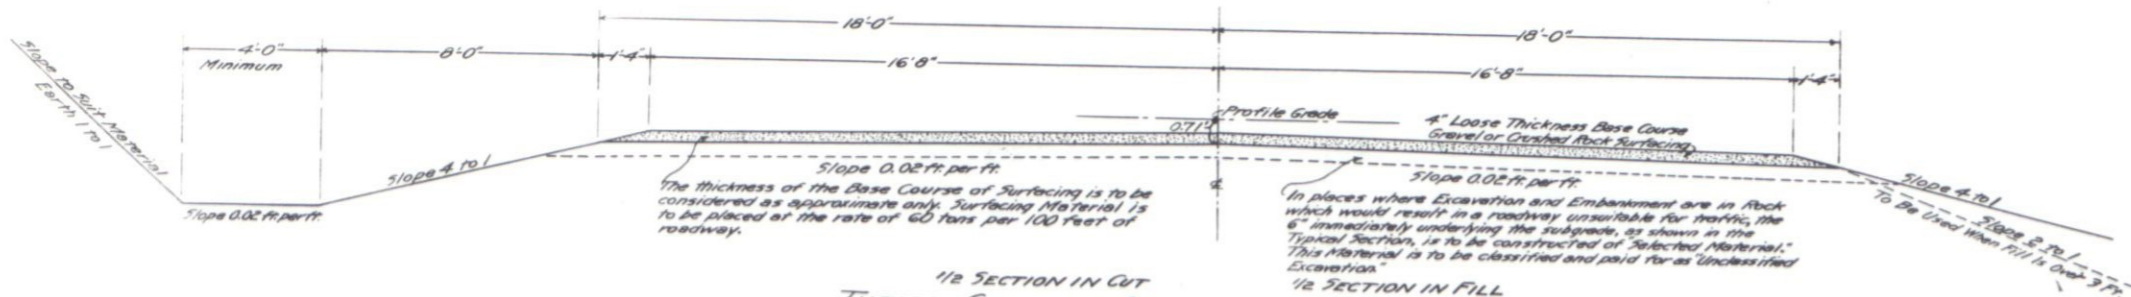

The thickness of the Base Course of Surfacing is to be considered as approximately 60. Surfacing Material is to be placed at the rate of 60 tons per 100 feet of roadway.

In places where Excavation and Embankment are in Rock which would result in a roadway unsuitable for traffic, the 6\"/>

1/2 SECTION IN CUT
 TYPICAL GRAVEL OR CRUSHED ROCK SURFACING SECTION
 1/2 SECTION IN FILL

GENERAL NOTES

This Project is to be constructed in conformity with the Specifications of the Colorado State Highway Department adopted January 1, 1930.
 All quantities on preliminary plans are to be considered approximate only.
 All Curves are to be Super-elevated as provided for by the Standard Super-elevation Sheet included with the plans.
 All Roadway excavation required to construct this Project is to be obtained as indicated on the plans. Quantities involved beyond the limits of the ditch as shown on the Typical Section, either noted on the plans as Embankment or on the List of Structures as Embankment, are to be classified and paid for as "Unclassified Excavation". This quantity is to be stated as part of the original excavation at locations indicated on the plans. Slope States beyond the limits of the Typical Section as shown are subject to change by the Engineer to fit embankment conditions actually encountered in construction.
 The Entire Project is to be cleared, grubbed for the full width of the right of way, and the cost thereof is to be included in the lump sum price for Clearing and Grubbing the Entire Project. Notes on the plans indicate the approximate location and character of the Clearing and Grubbing required.
 Unless otherwise noted on the plan sheets and list of structures, the inlet ends of all corrugated metal pipe cross culverts are to be protected by dry rubble slope paving 1 foot thick placed about the end of the pipe. The approximate yardage of dry rubble slope paving required is indicated in the list of structures.
 The Detour for this Project shall be over the route shown on the Title Sheet. The Contractor shall, at his own expense, maintain in safe condition all temporary approaches to, and crossings of, intersecting roads.
 Pole Lines encroaching on construction are to be moved by the Owners. The cost of moving power lines is to be included in the Project. Except as limited by the Special Provisions, power equipment may be used on this Project.

R.O.W. MARKERS & GATES

Sta.	Side	No. of R.O.W. Markers	No. Barbed Wire Gates	No. Driveway Gates
1200+00	R	2		
1201+42	R	4		2
1204+75	L			1
1206+50	R	1		
1215+00	R	2		
1216+10	R			1
1220+75	R		1	
1225+05	R	1		
1230+25	L	1		
1232+80	R		1	
1245+00	R	4		
1247+85	L		1	
1248+05	R		1	
1256+60	R	2		
1266+80	R	2		
1272+00	R		2	
Const. Div. #1 18 8 4				
1238+00	R	4		
1242+27	R	2		
Const. Div. #2 6				

WIRE AND GUARD FENCE


Stations	Side	Remove Wire Fence Lin. Ft.	Build Barbed Wire Fence Lin. Ft.	Build Comb. Wire Fence Lin. Ft.	Build Guard Fence Lin. Ft.	
1200+00 - 1204+75	R		590			
1204+75 - 1206+50	R		570		525	
1206+50 - 1207+10	L				815	
1207+10 - 1208+60	L				200	
1208+60 - 1209+45	R			135	205	
1209+45 - 1210+00	R				170	
1210+00 - 1210+90	L				90	
1210+90 - 1211+50	R		150			
1211+50 - 1212+80	L		115			
1212+80 - 1214+45	R		405			
1214+45 - 1216+10	L		555			
1216+10 - 1217+80	R		410			
1217+80 - 1219+30	L		105		210	
1219+30 - 1223+80	R		670			
1223+80 - 1224+65	R		490			
1224+65 - 1227+00	R		3,270			
1227+00 - 1229+05	L		3,350			
1229+05 - 1230+25	X		105			
1230+25 - 1232+80	X		100			
1232+80 - 1234+00	X		500			
1234+00 - 1237+75	R		175			
1237+75 - 1238+50	R		1,825		520	
1238+50 - 1239+75	L		1,725			
1239+75 - 1244+00	R		3,610	11,645	2,275	660
1244+00 - 1247+85	L					
1247+85 - 1248+05	X		40			
1248+05 - 1248+27	X		75			
1248+27 - 1249+00	L		430			
1249+00 - 1256+60	R		350			
1256+60 - 1277+00	L		30			
1277+00 - 1278+20	X		120			
1278+20 - 1279+37	L		290			
1279+37 - 1281+55	R		190			
1281+55 - 1279+30	X		290			
Const. Div. #2 485 1580						

LIST OF STRUCTURES FOR CONSTRUCTION DIVISION No. 1

Stations	Description	Remove Structures No.	Excavation Cu. Yds.	Structural Excavation Cu. Yds.		Class A Concrete Cu. Yds.	Reinforcing Steel Lbs.	Corrugated Metal Culvert Pipe Lin. Ft.					Dry Rubble Slope Paving Sq. Yds.	Corrugated Metal Siphon Pipe Lin. Ft.	Miscellaneous
				15"	18"			24"	30"	60"					
1200+00	Project Marker														
1201+32	Special 18" C.M.P. Siphon, 8" Tile Line, Remove Tile Siphons Drive Box Lower Water Pipe	2			60	3.5	255							89	Project Marker 2-18" Trash Guards 8-6" Wtr. Tile Pipe
1201+40	do														
1201+50	do														
1204+60	Cross Culvert		50												
1204+60	Road Approach														
1206+10	do														
1207+00	do														
1209+20	do														
1210+60	do														
1216+10	Side Drain, 2 Road Approaches		500		5										
1219+05	Side Drain, Road Approach		100		5										
1226+75	Cross Culvert							30							
1232+80	Road Approach														
1235+75	Cross Culvert		400		10										
1239+50 - 1244+20	Ditch Change		180		10										
1247+75	Side Drain, Road Approach														
1247+85	Side Drain		50		5										
1248+05	Side Drain, Road Approach														
1248+11	Cross Culvert, 2 Headwalls		50		10										
1250+70 - 1256+50	Ditch Change		120		5										
1256+44	Cross Culvert, 2 Headwalls, Divn. Box														
1256+60	2 Side Drains, 2 Road Approaches					2.1									
1257+00 - 1266+83	Ditch Change		200	100	10										
1266+83	Cross Culvert, 2 Headwalls, Ditch Changes, Division Box		20		20										
1267+59	do														
1269+90	Cross Culvert, No Headwalls				5										
1269+92	Road Approach		490												
1269+92	Remove Cor. Metal Pipe	1													
1269+92	do														
1270+75	Road Approach		400												
1270+75	Side Drain, Road Approach		150		5										
1277+75	Side Drain, 2 Road Approaches		600		5										
1277+75	do		225		5										
1278+00	2 Road Approaches		500		20										
1278+00	Side Drain, 2 Road Approaches														
Construction Division No. 1 Totals			3	1,520	2,600	385	383	282	368	526	150	74.5	174		(In Summary)

S.F. - Denotes Work to be done by State Forces.

* Structural Excavation is estimated to be 75% Common and 25% Rock, each of which is estimated to be 75% Dry and 25% Wet.

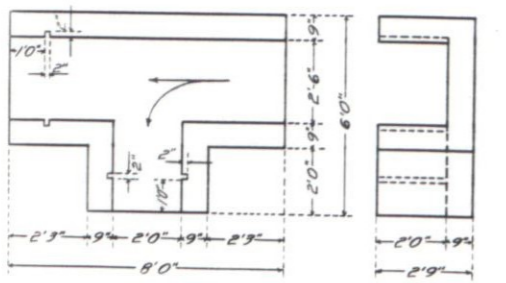

CONCRETE DIVISION BOX
 STA. 1256+44
 & STA. 1266+83
 2.1 Cu. Yd. Class A Concrete per Box

SUMMARY OF APPROXIMATE QUANTITIES - CONST. DIV. No. 1

No.	Item	Unit	Preliminary Quantity	Final Quantity
10a	Clearing & Grubbing the Entire Project	Lump Sum		
11	Removing 3 Structures	"		
12a	Removing Fence	"	3,700	
13c	Unclassified Excavation	Lin. Ft.	63,000	
14a	Dry Rock Excavation (Structural)	Cu. Yd.		
14b	Common	"		
14c	Wet Rock	"	230	
14d	Common	"	50	
18a	Station Yard Overhaul	Sq. Yd.	100	
18b	Yard Mile Overhaul	Yd. Mi.	294,000	
18c	Yard Mile	"	2,000	
30x	Gravel or Crushed Rock Surfacing	Tons	4,840	
46a	Class A Concrete	Cu. Yd.	1	
47	Reinforcing Steel	Lbs.	400	
53a	15" Corrugated Metal Culvert Pipe	Lin. Ft.	292	
53b	18"	"	368	
53c	24"	"	526	
53d	60"	"	150	
65	Dry Rubble Slope Paving (1 ft. thick)	Sq. Yd.	75	
72	Wire Cable Guard Fence	Lin. Ft.	660	
75a	Galvanized Barbed Wire Fence (Wd. Barb)	"		
75b	Gates in Barbed Wire Fence	Each	11,700	
76	Project Marker	"	8	
78	Right of Way Markers	"	1	
85b	Trash Guards for 48" Siphons	"	18	
85c	do	"	3	
95a	Combination Wire Fence (Wood Posts)	Lin. Ft.	2,300	
95b	Driveway Gates	"	4	
96b	18" Corrugated Metal Siphon Pipe	Lin. Ft.	174	
54 x	8" Vitrified Clay Culvert Pipe	"	8	
54 y	10"	"	56	
Materials to be Furnished & Work to be Done by State Forces				
Lower Water Pipe, Sta. 1201+				
Moving Power Line				


SUMMARY OF APPROXIMATE QUANTITIES - CONST. DIV. No. 2

No.	Item	Unit	Bridge & Appro. 1277+75-1278+00	Bridge & Appro. 1278+00-1279+30	Totals	
10a	Clearing & Grubbing (Bridge Section)	Lump Sum				
10b	do	"				
12a	Removing Fence	Lin. Ft.	500	500	1,000	
13c	Unclassified Excavation	Cu. Yd.	950	3,000	3,950	
14a	Dry Rock Excavation (Structural)	"				
14b	Common	"				
14c	Wet Rock	"	230	508	738	
14d	Common	"	175	245	420	
18a	Station Yard Overhaul	Sq. Yd.	100	630	730	
18b	Yard Mile	Yd. Mi.	1,930,000	4,000	1,934,000	
18c	Yard Mile	"	2,000		2,000	
30x	Gravel or Crushed Rock Surfacing	Tons	2,400	100	2,500	
42a	Untreated Bridge Timber	M. H. B.M.	545.41	507.180	1,052.59	
46a	Class 79 Concrete	Cu. Yd.	728	85	813	
46b	" 8"	"	27	172	199	
48	Reinforcing Steel	Lbs.	8,032	86,800	94,832	
72	Wire Cable Guard Fence	Lin. Ft.	1,215,300	152,200	1,367,500	
75a	Galv. Barbed Wire Fence (Wood Posts)	Lin. Ft.	200	330	530	
81	Bronze Name Plates	Each	1,665	700	2,365	
82	Sheet Copper	Lbs.	460	300	760	
84	Removal of Dissused Bridge Sls 1278+	Lump Sum				
85a	Drain Pipes (3"x4'-0")	Each	6		6	
85b	do (3"x2'-6")	"		3	3	
79	R.O.W. Markers	Each	6		6	
MATERIALS TO BE FURNISHED BY STATE						
Borrow Material						
			Cu. Yds.	11,000	3,000	14,000


CONSTRUCTION DIVISION N^o 2.
 REVISED R.A. 1933 S.M.D. DIMENSIONING OF ANCHOR BOLTS AND ENLARGING OF PIER CAPS, & CLASS-A CONCRETE QUANTITY.
 Revised Quantities As Constructed. 5-17-38 R.A.D.




PLAN OF PIER N° 2

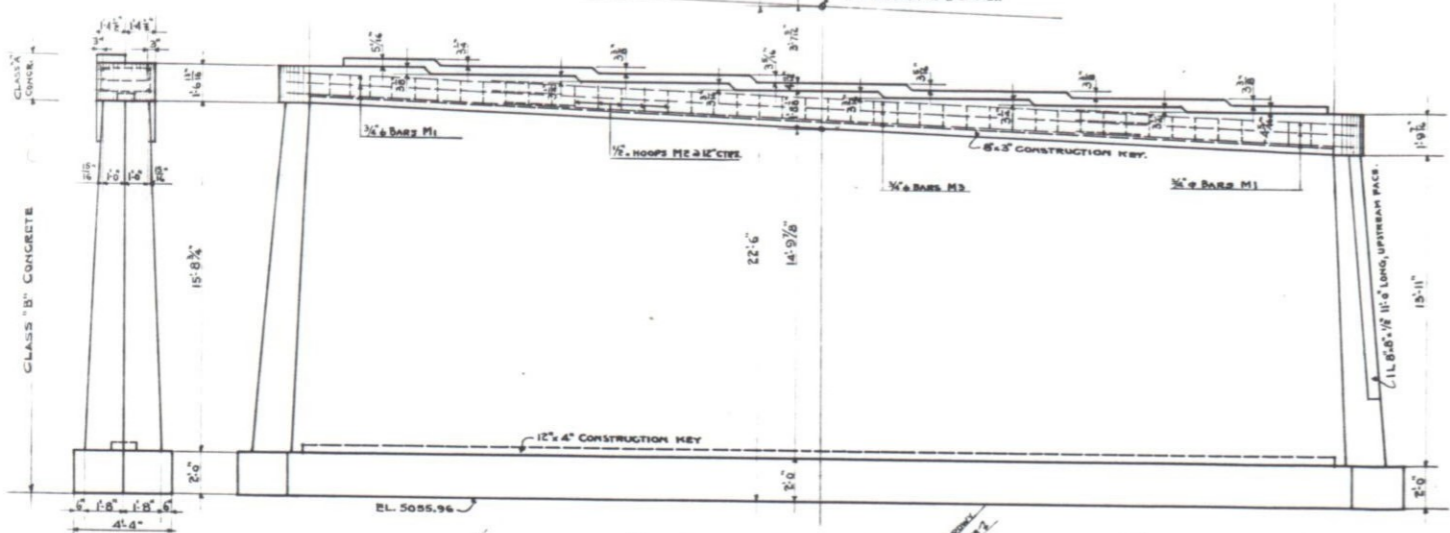


ELEVATION OF PIER N° 2

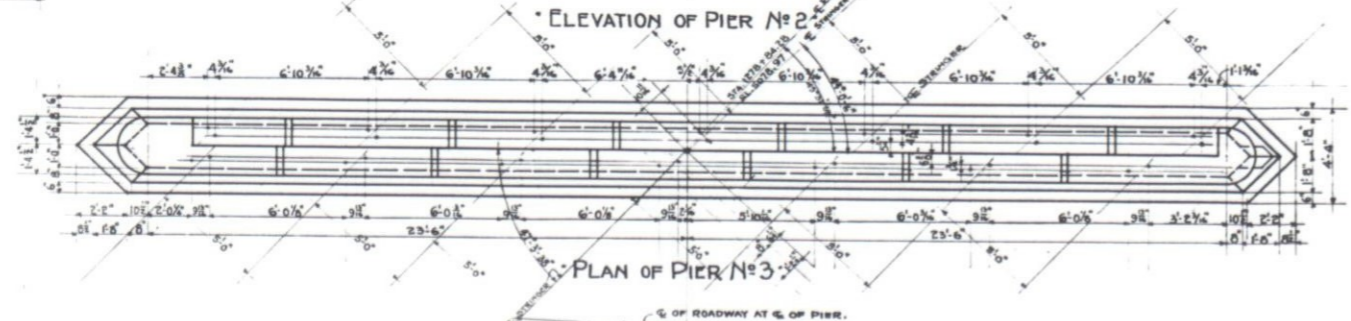

PLAN OF PIER N° 3

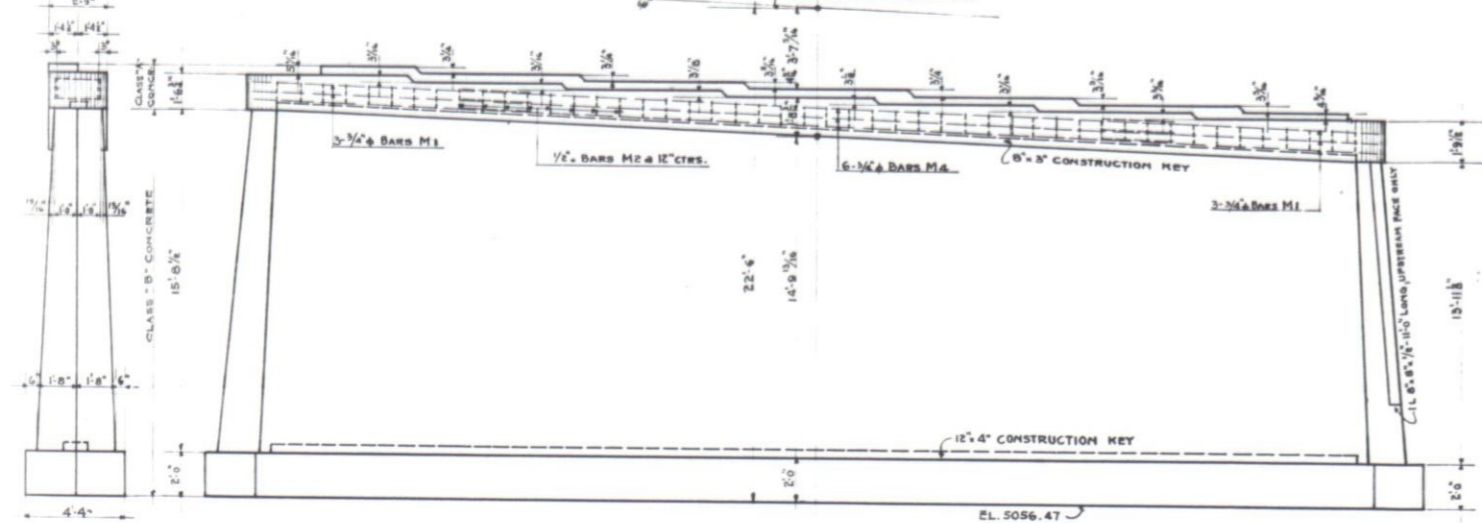


ELEVATION OF PIER N° 3

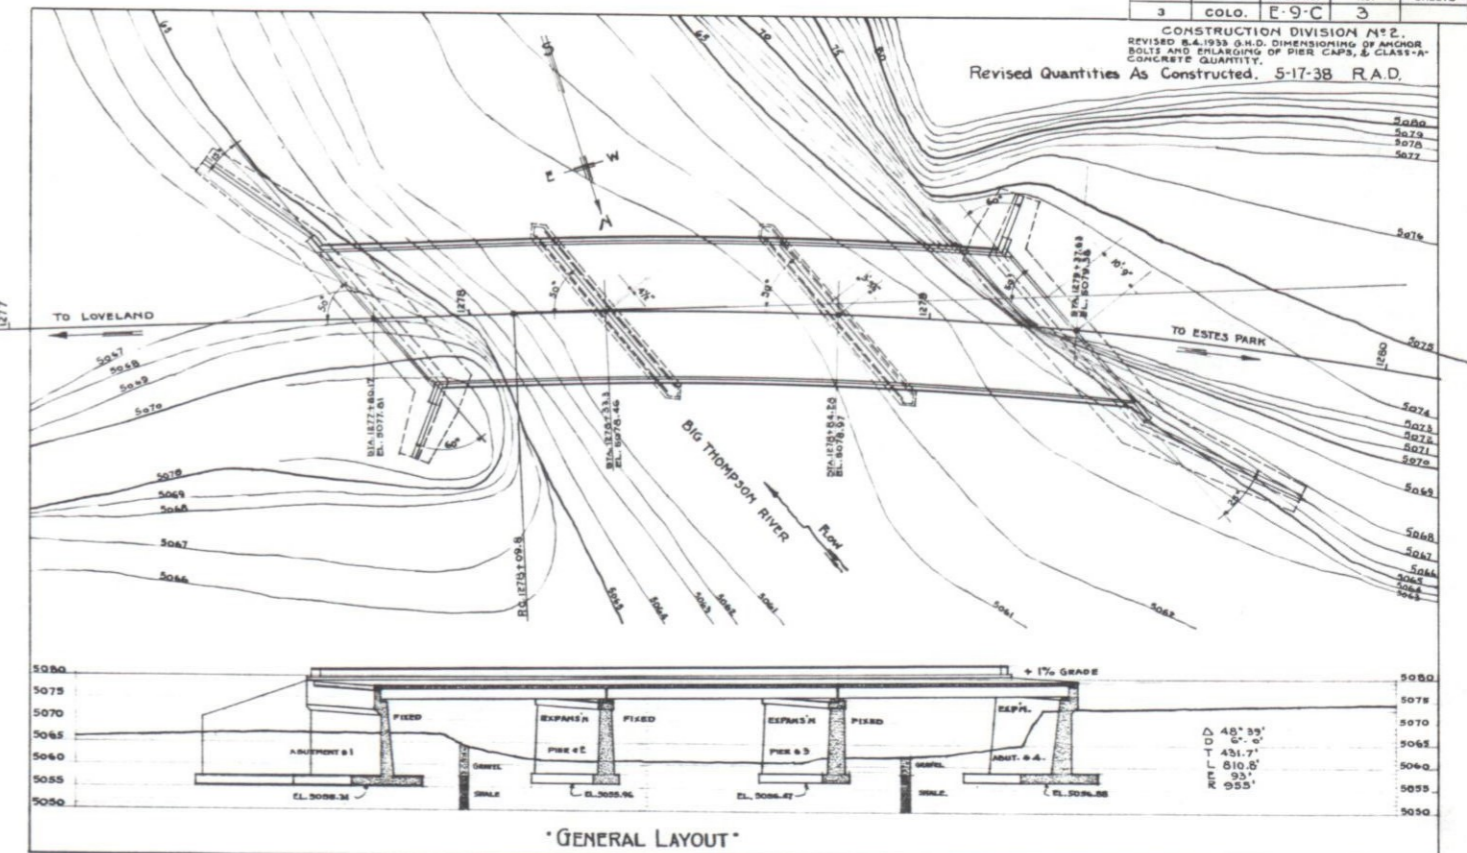


GENERAL LAYOUT

BAR LIST FOR PIER N° 2							BENDING TYPES.		
MARK	SIZE	NO.	LENGTH	TYPE	l	m	r	t	
M1	3/4"	6	25'-6"	VIII	11'-1 1/2"	2'-1"			VIII
M2	1/2"	40	7'-0"	IX	1'-0"	2'-2 1/2"		4"	
M3	3/4"	6	28'-8"						
324 LIN. FT. 3/4" BARS @ 0.850 LBS. PER LIN. FT. =					276 LBS.				
315 LIN. FT. 1/2" BARS @ 1.502 LBS. PER LIN. FT. =					470 LBS.				
1% FOR OVERRUN =					9 LBS.				
TOTAL =					755 LBS.				

BAR LIST FOR PIER N° 3							BENDING TYPES.		
MARK	SIZE	NO.	LENGTH	TYPE	l	m	r	t	
M1	3/4"	6	25'-6"	VIII	11'-1 1/2"	2'-1"			IX
M2	1/2"	40	7'-0"	IX	1'-0"	2'-2 1/2"		4"	
M4	3/4"	6	31'-0"						
338 LIN. FT. 3/4" BARS @ 0.850 LBS. PER LIN. FT. =					287 LBS.				
339 LIN. FT. 1/2" BARS @ 1.502 LBS. PER LIN. FT. =					509 LBS.				
1% FOR OVERRUN =					9 LBS.				
TOTAL =					805 LBS.				

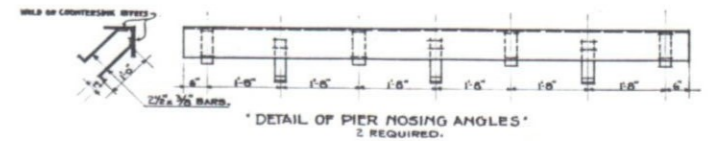

DETAIL OF PIER NOSING ANGLES
 2 REQUIRED.

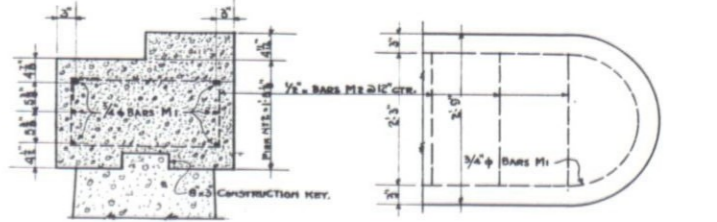

DETAIL OF PIER CAP (CLASS "A" CONCRETE).

SUMMARY OF QUANTITIES FOR ENTIRE BRIDGE								
ITEM NUMBER	DESCRIPTION	UNIT	SUPER STRUCTURE	ABUTMENT#1	PIER #2	PIER #3	ABUTMENT#4	TOTAL
14 a	DRY ROCK EXCAVATION	CU.YDS.					770	770
14 b	DRY COMMON EXCAVATION	CU.YDS.		225.5				225.5
14 c	WET ROCK EXCAVATION	CU.YDS.		90.8	28.1	30.1	169.1	318.1
14 d	WET COMMON EXCAVATION	CU.YDS.		270.5	40.5	45.3	258.6	614.9
42 a	UNTREATED BRIDGE TIMBER	M.T.S.M.	0.430					0.430
46 a	CLASS "A" CONCRETE	CU.YDS.	159.6	167	8.9	9.0	184	528.5
46 b	CLASS "B" CONCRETE	CU.YDS.			83.6	88.4		172
47	REINFORCING STEEL (OVERRUN INCLUDED)	LBS.	3110	16270	755	805	17860	66754
48	STRUCTURAL STEEL (OVERRUN INCLUDED)	LBS.	150582	104	540	540	104	151870
81	BRONZE NAME PLATES	PIECES						2
82	SHEET COPPER D.&S. GAUGE N° 16	LBS.	300					300
84	REMOVAL OF DISUSED BRIDGE	LUMP SUM						
89	GALV. PIPE DRAINS 3" DIA. 2'-6" LONG	PIECES						3
	3/4"x10" EXPANSION JOINT MATERIAL	LIN. FT.	135					135

* WATERLINE AS SHOWN ON FIELD PLANS.
 ♦ Scale Weight.


REFERENCE DRAWINGS.
 SHEET N° 4 DETAILS OF SUPER STRUCTURE.
 SHEET N° 5 DETAILS OF ABUTMENT N° 1.
 SHEET N° 6 DETAILS OF ABUTMENT N° 4.

LOADING DATA.
 LIVE LOAD = A. A. S. H. O. AUG. 1928. CLASS A, (H-15)
 DEAD LOAD = REQUIRES 10 LBS. PER SQ. FT. ADDITIONAL WEARING SURFACE, WHICH INCLUDES THE 5 IN. CONCRETE MONOLITHIC WEARING SURFACE.


COLORADO
STATE HIGHWAY DEPARTMENT
 3 SPAN 31'-0" x 30'-0" CONCRETE
 I BEAM BRIDGE
 DETAILS OF PIERS N° 2 & 3. SUMMARY.
 Across Big Thompson River.
 Sta. 1277 + 80.17 TO 1279 + 37.63
 Near LOVELAND Sec. 7 T. 5N. R. 69W.

Designed by K.S. Approved by G.H.D.
 Made by G.H.D. Bridge Engr.
 Checked by K.S. Date: JUNE 2

CONSTRUCTION DIVISION #12.
REVISED 8-4-33 G.H.D. DIMENSIONING OF ANCHOR BOLTS.

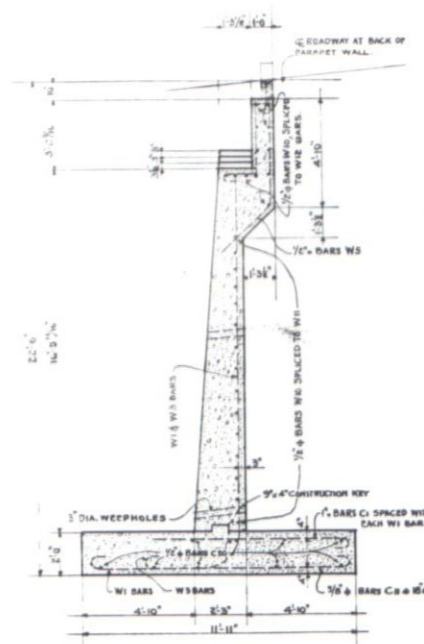


SECTION D-D

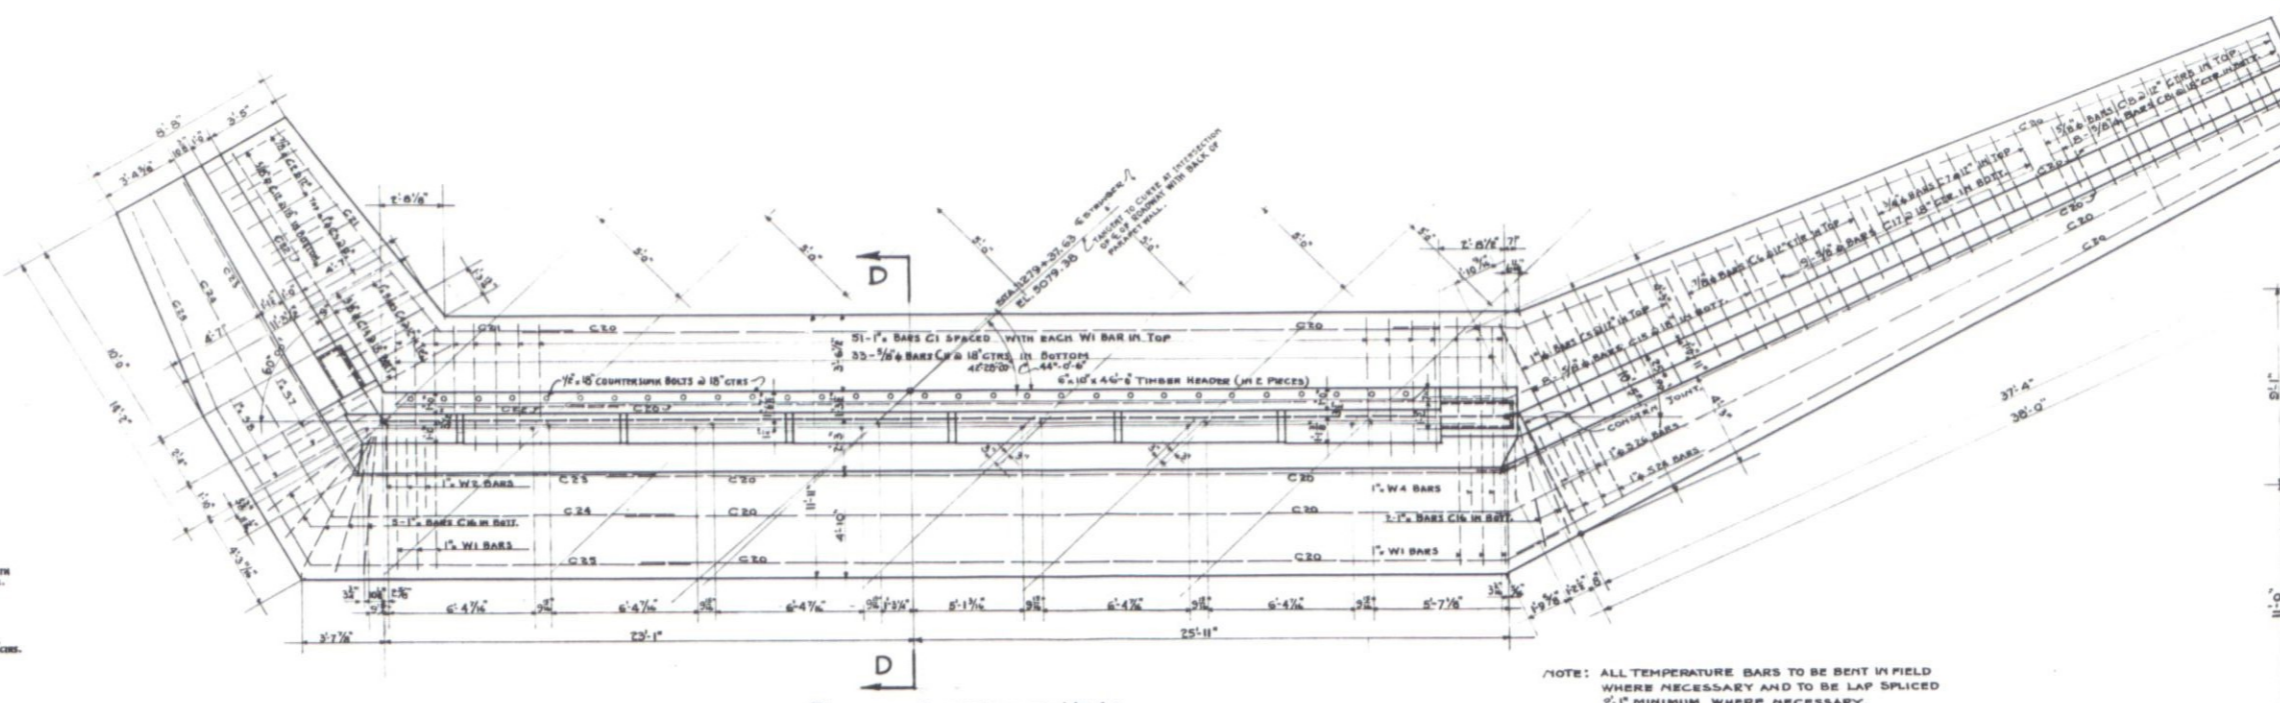


PLAN OF ABUTMENT N°4
MAXIMUM TOP PRESSURE 3570 LBS.


NOTE: ALL TEMPERATURE BARS TO BE BENT IN FIELD WHERE NECESSARY AND TO BE LAP SPICED 2' MINIMUM WHERE NECESSARY.

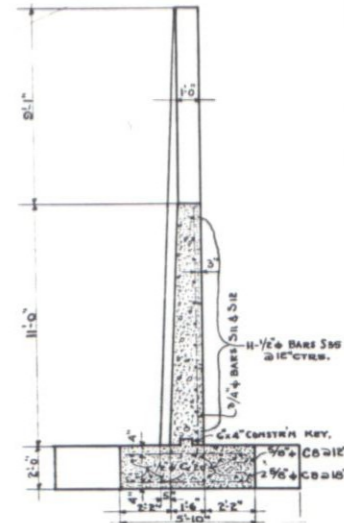


SECTION F-F

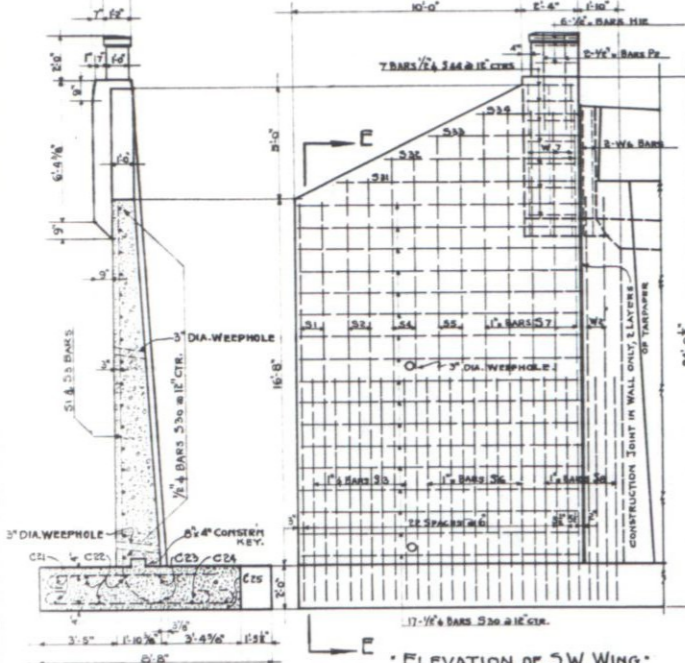


SECTION E-E

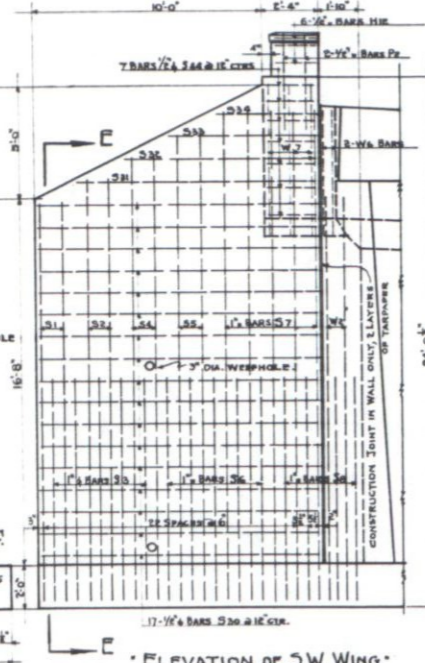

ELEVATION OF S.W. WING

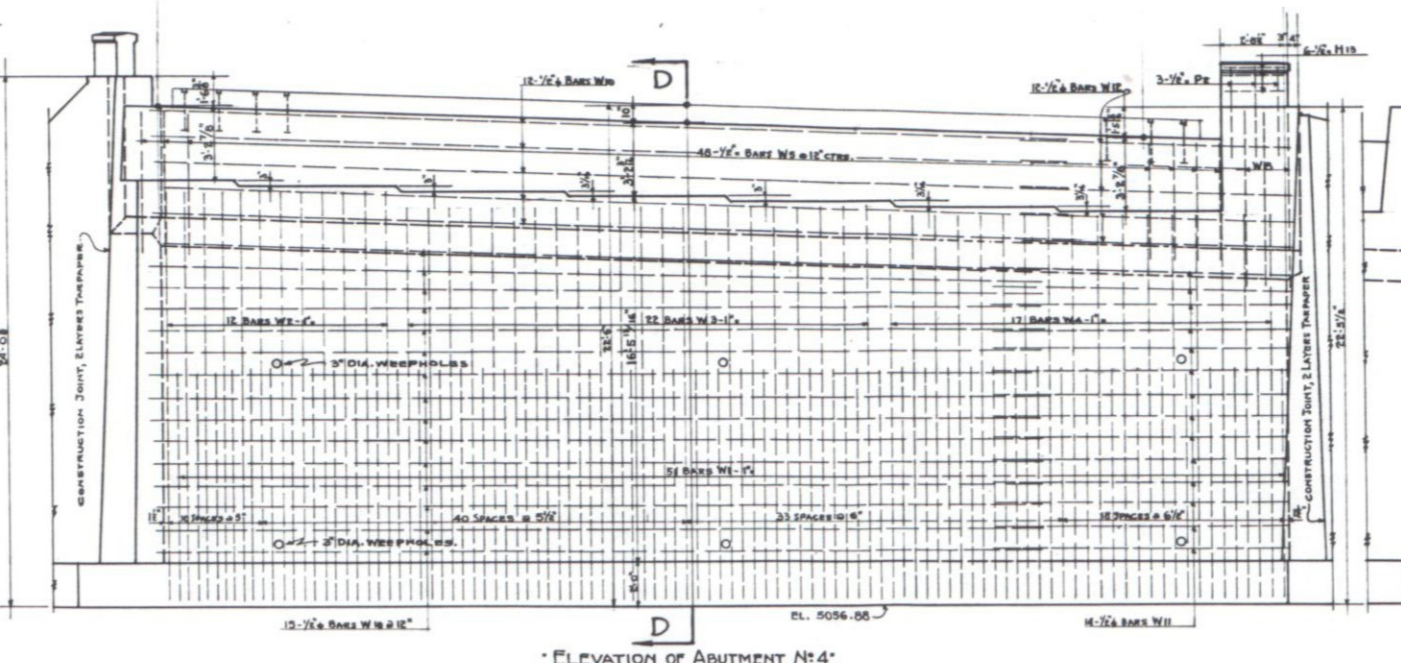

ELEVATION OF ABUTMENT N°4

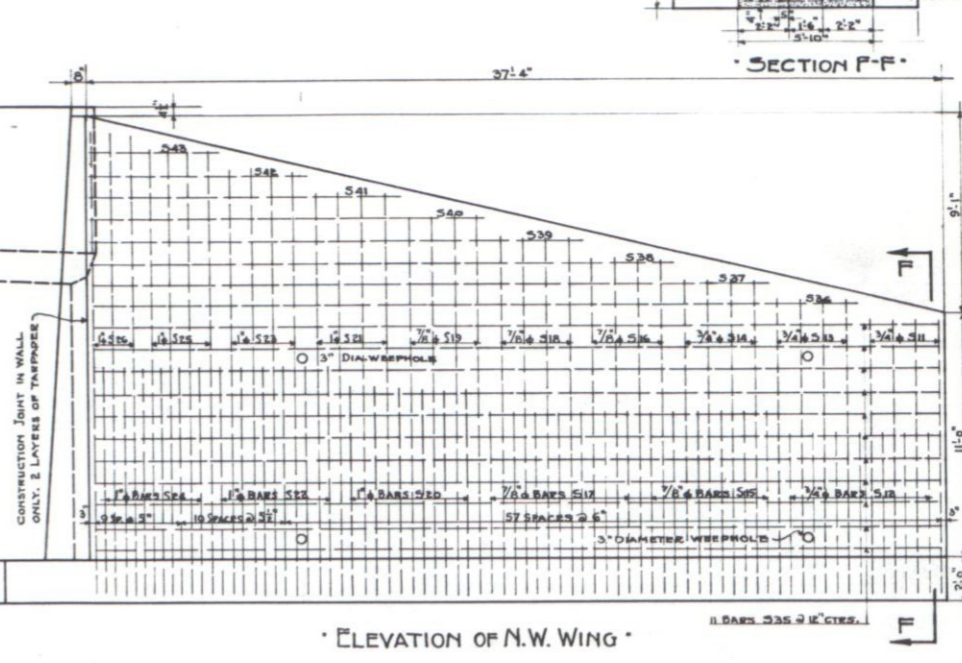

ELEVATION OF N.W. WING


BAR LIST FOR ABUTMENT N°4										BENDING TYPES.									
MARK	SIZE	N°	LENGTH	TYPE	L	ITL	F	T		MARK	SIZE	N°	LENGTH	TYPE	L	ITL	F	T	
W1	1"	52	17'-11"	I	8'-0"	4'-6"	4"	3/4"		S38	3/4"	11	37'-0"						
W2	1"	14	22'-8"	I	16'-0"	2'-0"	4"	3/4"		S38	3/4"	11	37'-0"						
W3	1"	22	21'-11"	I	16'-0"	2'-0"	4"	3/4"		S38	3/4"	11	37'-0"						
W4	1"	18	21'-5"	I	15'-6"	2'-0"	4"	3/4"		S38	3/4"	11	37'-0"						
W5	1/2"	48	13'-4"	IV	2'-4"	4'-4"	2"	2"		C1	1"	51	9'-8"	III	8'-4"	4"	3/4"		
W6	1/2"	2	7'-4"	VII	2'-4"	4'-4"	2"	2"		C2	1/2"	4	8'-11"	III	6'-10"	3/4"	3"		
W7	1/2"	3	8'-10"	VII	2'-4"	5'-10"	2"	2"		C3	1"	4	8'-11"	III	7'-7"	4"	3/4"		
W8	1/2"	3	9'-7"	VII	3'-0"	5'-11"	2"	2"		C4	1"	5	9'-5"	III	8'-1"	4"	3/4"		
W9	1/2"	27	40'-0"							C5	1"	8	9'-0"	III	7'-8"	4"	3/4"		
W10	1/2"	14	13'-4"							C6	3/4"	8	9'-0"	III	6'-8"	3/4"	3"		
W11	1/2"	12	12'-0"							C7	3/4"	8	6'-10"	III	5'-10"	3"	2 1/2"		
S1	1"	2	22'-5"	I	16'-6"	2'-0"	4"	3/4"		C8	7/8"	20	5'-9"	III	4'-11"	2 1/2"	2"		
S2	1"	2	23'-5"	I	17'-6"	2'-0"	4"	3/4"		C9	7/8"	33	5'-9"	III	4'-11"	2 1/2"	2"		
S3	1"	5	15'-4"	I	8'-8"	2'-0"	4"	3/4"		C10	7/8"	5	6'-11"	III	6'-1"	2 1/2"	2"		
S4	1"	2	25'-5"	I	18'-6"	2'-0"	4"	3/4"		C11	7/8"	5	6'-11"	III	6'-1"	2 1/2"	2"		
S5	1"	2	25'-5"	I	19'-6"	2'-0"	4"	3/4"		C12	7/8"	5	6'-11"	III	6'-1"	2 1/2"	2"		
S6	1"	5	15'-11"	I	8'-8"	3'-4"	4"	3/4"		C13	7/8"	8	7'-1"	III	6'-3"	2 1/2"	2"		
S7	1"	5	26'-5"	I	20'-6"	2'-0"	4"	3/4"		C14	1"	7	10'-5"	III	9'-1"	4"	3/4"		
S8	1"	4	16'-6"	I	8'-8"	3'-11"	4"	3/4"		C17	3/8"	9	6'-5"	III	5'-7"	2 1/2"	2"		
										C20	7/8"	18	40'-0"						

LOADING DATA.
LIVE LOAD - A. A. S. H. O. AUG. 1928. CLASS A. (H-15)
DEAD LOAD - ASSUMED 15 LBS. PER SQ. FT. ADDITIONAL WEARING SURFACE, WHICH INCLUDES THE 1/2\"/>


REFERENCE DRAWINGS.
SHEET #13 GENERAL LAYOUT, SUMMARY OF QUANTITIES AND DETAILS OF PIER #12 E.D.
SHEET #14 DETAILS OF SUPER STRUCTURE.
SHEET #15 DETAILS OF ABUTMENT #1.

COLORADO
STATE HIGHWAY DEPARTMENT
3 SPAN 51'-0" X 30'-0" CONCRETE
I-BEAM BRIDGE.
DETAILS OF ABUTMENT N°4
ACROSS BIG THOMPSON RIVER
Sta. 1277+80.17 TO 1279+37.63
Near LOVELAND Sec. 7 T. 5N. R. 69W.
Designed by G.H.D. Approved by *Paul Baer*
Made by G.H.D. Bridge Engineer
Checked by G.H.D. Date: June 24, 1933.


CONSTRUCTION DIVISION FILE
 REVISED 5-2-33 BY G.M.D. DIMENSIONS OF END POST AND QUANTITIES OF STRUCTURAL AND REINFORCING STEEL & CONCRETE. REVISED 5-2-33 BY G.M.D. NOTE ABOUT LONGITUDINAL DIMENSIONS ADDED.
 Revised Quantities As Constructed, 5-17-38 R.A.D.

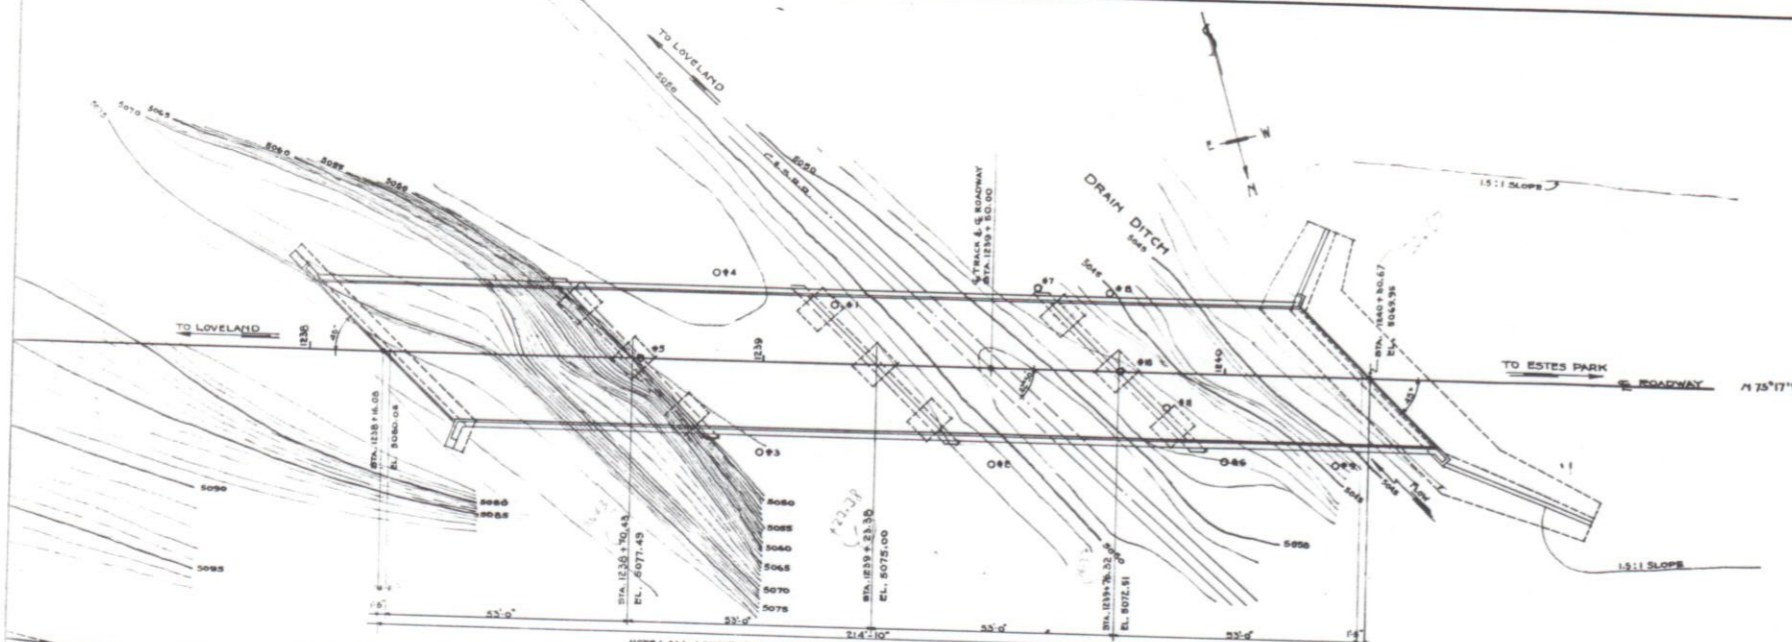


NOTE: ALL LONGITUDINAL DIMENSIONS TO BE MEASURED AS SHOWN ON -4.7% GRADE.

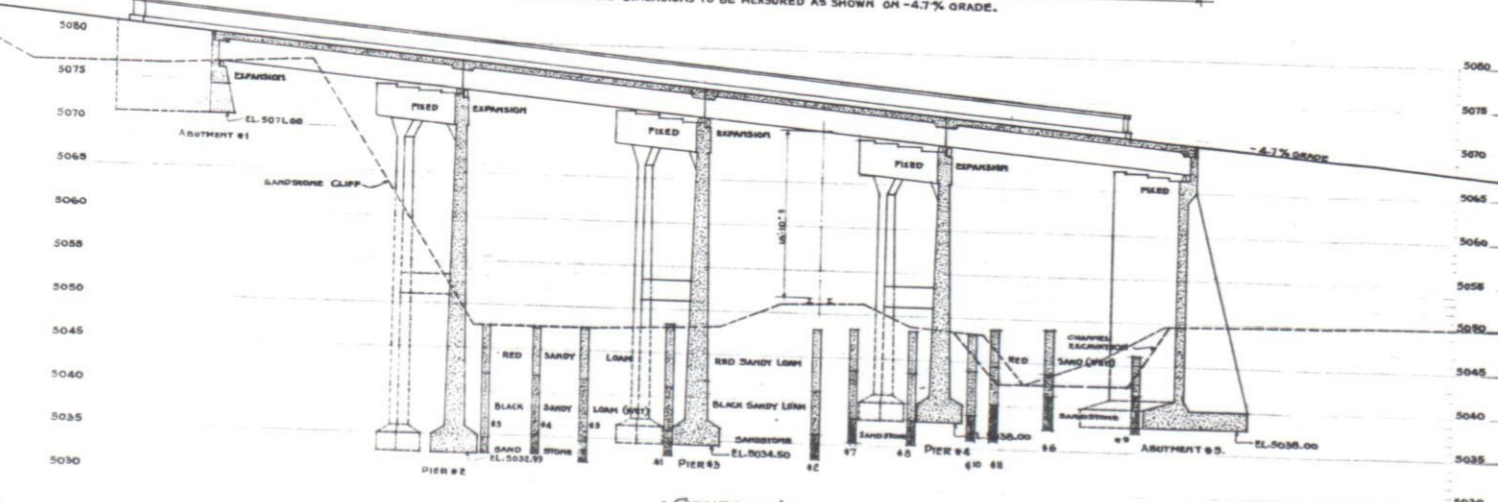


GENERAL LAYOUT

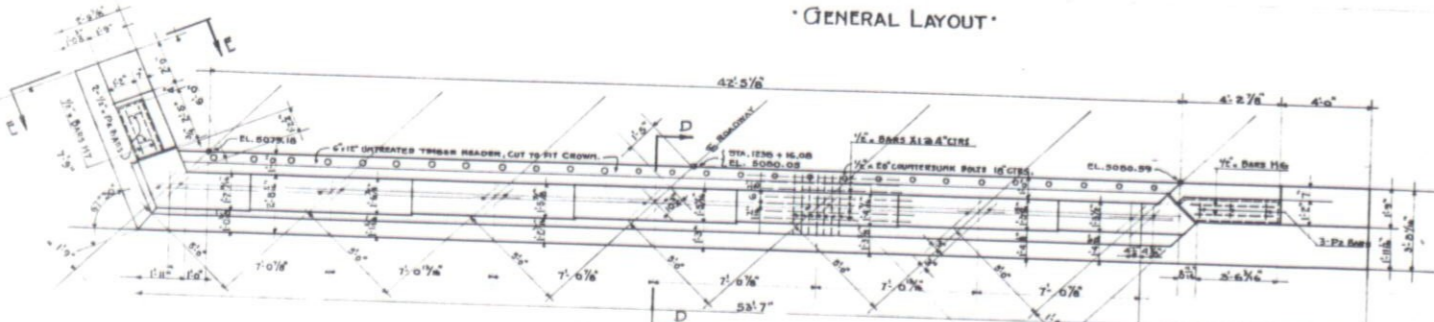


PLAN OF ABUTMENT #1

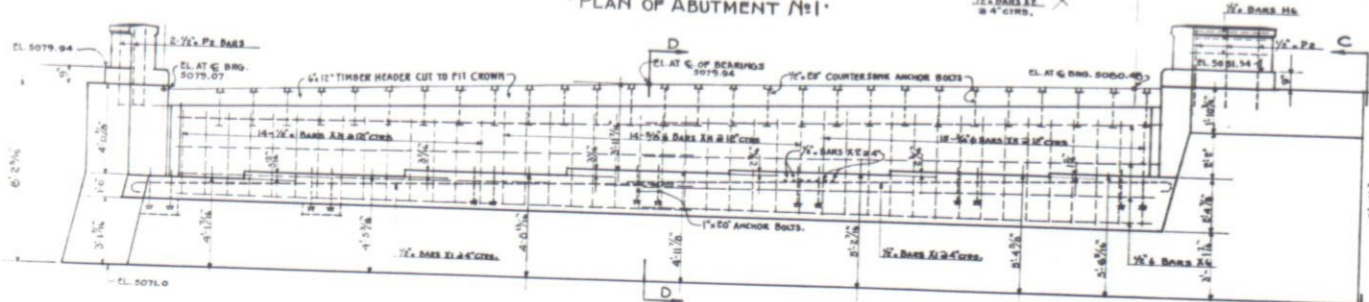

ELEVATION OF ABUTMENT #1

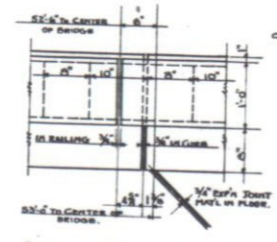


DETAIL OF EXPANSION JOINT AT CURB OF PIER #4.

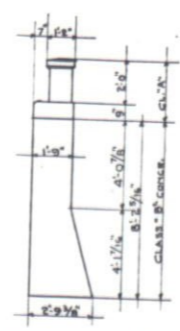


END ELEVATION E-E



END ELEVATION C-C

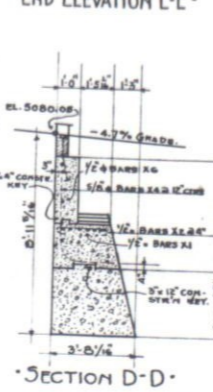

SECTION D-D

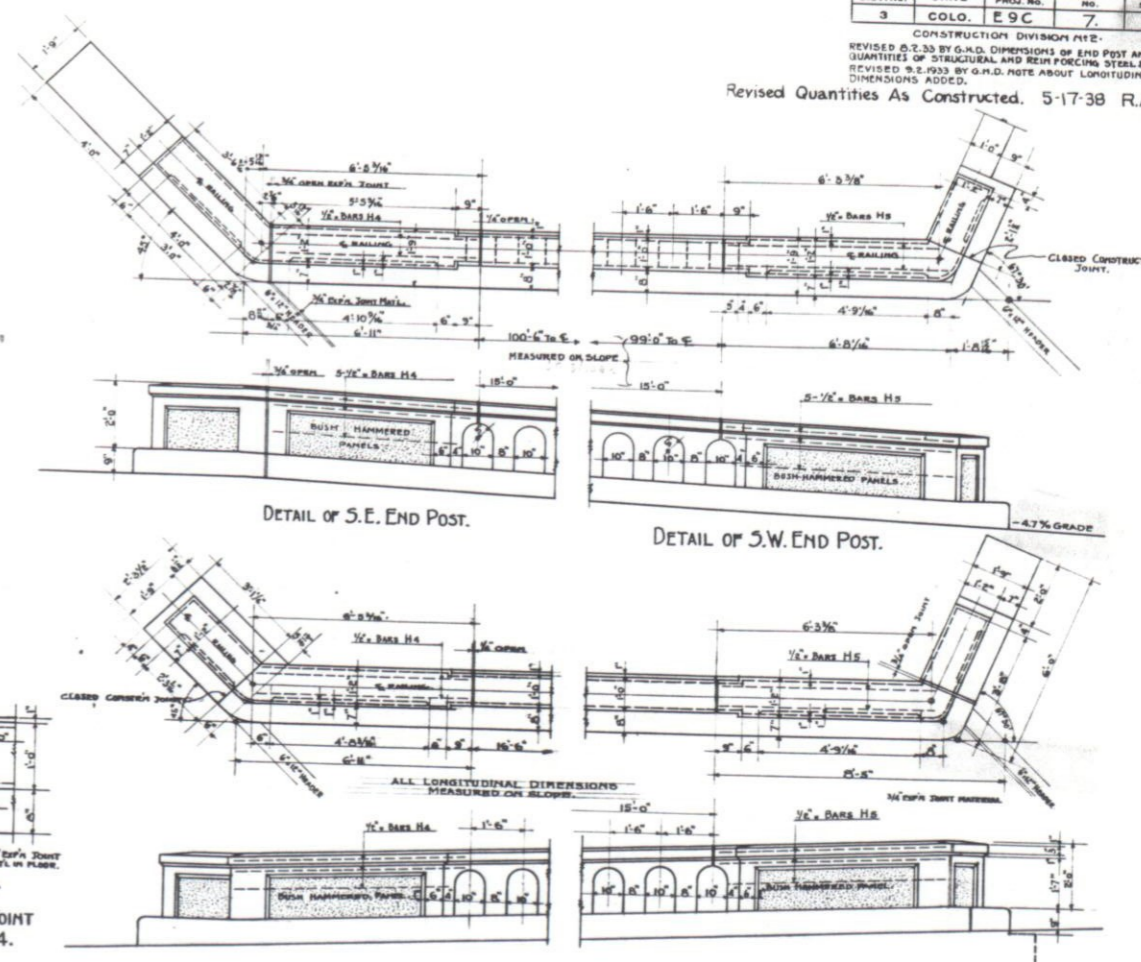

DETAIL OF S.E. END POST.

DETAIL OF S.W. END POST.

DETAIL OF N.W. END POST.

DETAIL OF N.E. END POST.

SUMMARY OF QUANTITIES FOR ENTIRE STRUCTURE

ITEM NO.	DESCRIPTION	UNIT	SUPER STRUCTURE	SUB STRUCTURE					TOTAL	W.M.H. G.H.D.
				ABUT. #1	PIER #2	PIER #3	PIER #4	ABUT. #5		
14a	DRY ROCK EXCAVATION	CU. YDS.	70.2	56.3	191.5				318.0	
14b	DRY COMMON	"		1.32	24.6	34.9	33.4	328.4	434.5	
14c	WET ROCK	"			117.9				117.9	
14d	WET COMMON	"				32.4	81.5	49.8	353.7	
42a	UNTREATED BRIDGE TIMBER	M.F.B.M.		.264					.264	
46a	CLASS "A" CONCRETE	CU. YDS.	212.3		59.3	55.5	50.3	340.9	758.0	
46b	CLASS "B" CONCRETE	"								
47	REINFORCING STEEL (OVERRUN INCLUDED)	LBS.	35290	92		20300			27260	85932
48	STRUCTURAL STEEL	"	213946							214730
B2	SHEET COPPER 3/8\"/>									
B9	GALV. DRAIN PIPE 3\"/>									
	EXPANSION JOINT MATERIAL	LN. FT.		45	45	45	45		180	

WET LINE AS SHOWN ON FIELD PLANS

GENERAL NOTES

ALL WORK SHALL BE DONE ACCORDING TO THE STANDARD SPECIFICATIONS OF THE COLORADO STATE HIGHWAY DEPARTMENT, ADOPTED JAN. 1, 1930.

ALL CONCRETE SHALL BE CLASS "A".

ALL EXPOSED SURFACES SHALL BE RUBBED FREE OF FORM MARKS.

GIRERS, FLOOR SLABS AND CURBS SHALL BE BEVELED TO A 3\"/>

ALL CONSTRUCTION JOINTS SHALL BE THOROUGHLY CLEANED BEFORE FRESH CONCRETE IS POURED.

FOOTINGS IN ROCK SHALL BE ROUNDED OUT TO THE ROCK AND NOT FORMED.

THICKNESS OF FLOOR SLAB SHALL BE SHOWN ON THE CONCRETE WEARING SURFACE.

ALL REINFORCING BARS SHALL BE ROUNDED OR SQUARE, PLAIN OR DEFORMED AS SHOWN AND NOTED.

ALL REINFORCING BARS SHALL BE TAGGED WITH THE STATION NUMBER AND LETTER DESIGNATION.

SECONDARY BARS WHEN SPLICED SHALL BE GIVEN A LAP OF 50 DIAMETERS.

MAIN BARS SHALL NOT BE SPLICED.

SOUNDINGS AND DEPTH OF FOOTINGS SHOWN ARE ACCORDING TO THE BEST AVAILABLE DATA. IF ESSENTIALLY DIFFERENT CONDITIONS ARE ENCOUNTERED, THE BRIDGE ENGINEER WILL INSPECT AND DETERMINE IF REDESIGN IS NECESSARY.

ALL RIVETS TO BE 3/4\"/>

FORMS FOR CONCRETE SURFACES EXPOSED IN THE FINISHED WORK SHALL BE CONSTRUCTED OF 2\"/>

THE EQUIVALENT OF AT LEAST TWO (2) ONE HALF (1/2) CUBIC YARD CAPACITY MIXERS MUST BE MAINTAINED IN RUNNING ORDER ON THIS JOB BY THE CONTRACTOR WHILE POURING THIS BRIDGE.

CAMBER ALL CURBS & HANDRAILS WITH PARABOLIC CROWN, AS SHOWN IN DIAGRAM OR SHEET #9.

REFERENCE DRAWINGS.

SHEET #70 DETAILS OF SUPER STRUCTURE.



SHEET #79 DETAILS OF PIERS #2, 3, 4 AND BAR LIST OF ABUTMENT #1.

SHEET #710 DETAILS OF ABUTMENT #1.

COLORADO
 STATE HIGHWAY DEPARTMENT
 4 SPAN 53'-0" x 30'-0" CONCRETE
 I BEAM BRIDGE
 GENERAL LAYOUT, SUMMARY & ABUTMENT #1
 ACROSS DRAIN DITCH & C. & S. R.R.
 Sta. 1236 + 16.08 to 1240 + 30.67
 Near LOVELAND, Sec. 8 T. 6 N. R. 69 W.
 Designed by G.M.D. Approved by P. J. Bailey
 Made by G.M.D. Bridge Engineer
 Checked by W.M.H. Date: June 24th 1933.


FED. ROAD DIST. NO.	STATE	FED. AID PROJ. NO.	SHEET NO.	TOTAL SHEETS
3	COLO.	9C	8	10

CONSTRUCTION DIVISION No. 2.
REVISED 8.2.33 BY G.H.D. DIMENSIONS OF CURB AND DIAPHRAGM CONNECTION ANGLES.
REVISED 9.2.1935 BY G.H.D. NOTE ABOUT LONGITUDINAL DIMENSIONS ADDED.

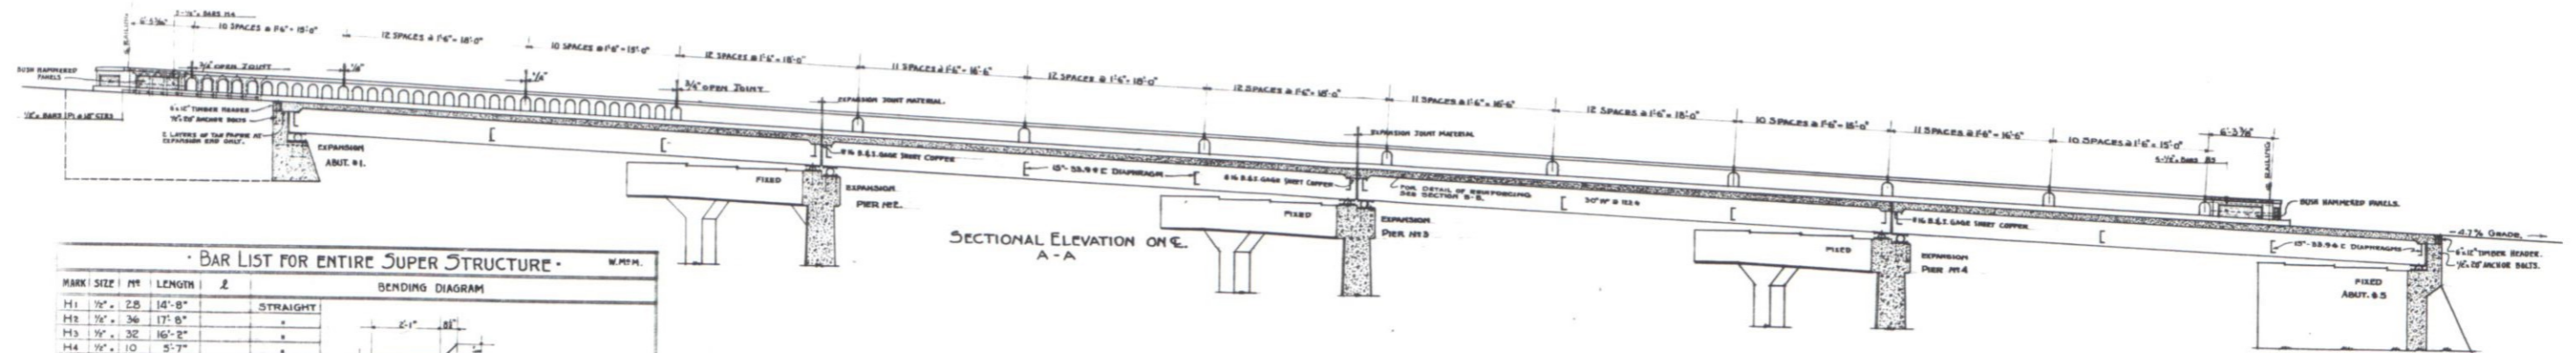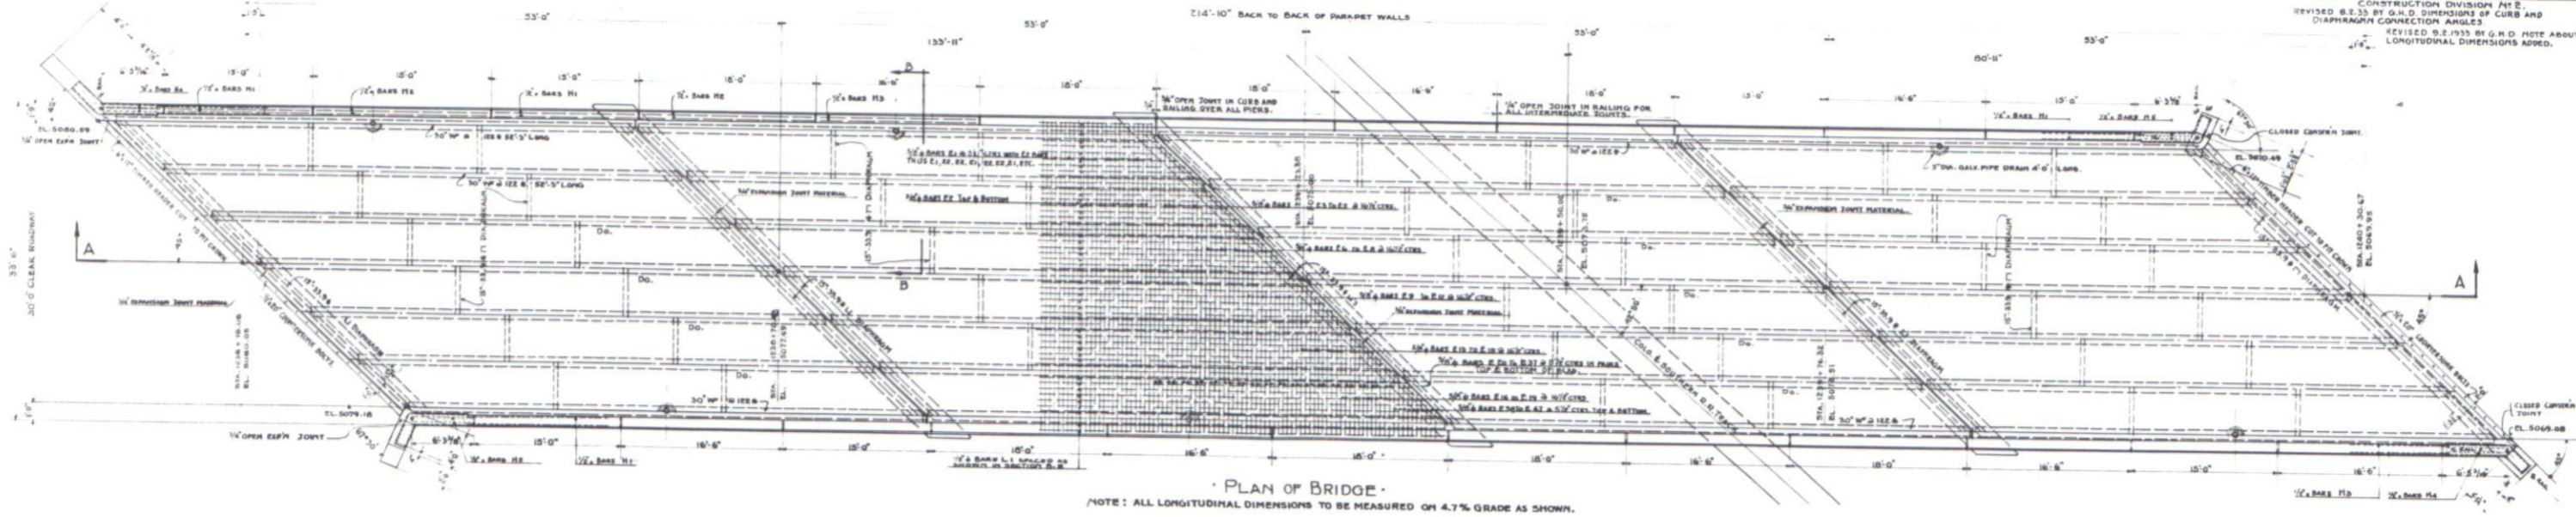

BAR LIST FOR ENTIRE SUPER STRUCTURE


MARK	SIZE	NO.	LENGTH	BENDING DIAGRAM
H1	1/2"	25	14'-8"	STRAIGHT
H2	1/2"	36	17'-8"	
H3	1/2"	32	16'-2"	
H4	1/2"	10	5'-7"	
H5	1/2"	10	6'-0"	
L1	1/2"	304	27'-4"	
D1	1/2"	254	6'-6"	
E1	5/8"	60	34'-0 1/2"	
E2	5/8"	60	34'-0 1/2"	
E3	5/8"	60	34'-0 1/2"	
E224	5/8"	60	34'-0 1/2"	
E225	5/8"	60	34'-0	

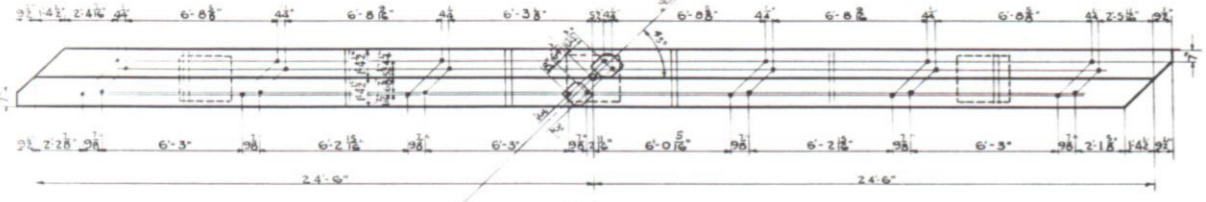

PLAN.



DIAGRAM OF ARRANGEMENT OF BENT BARS.

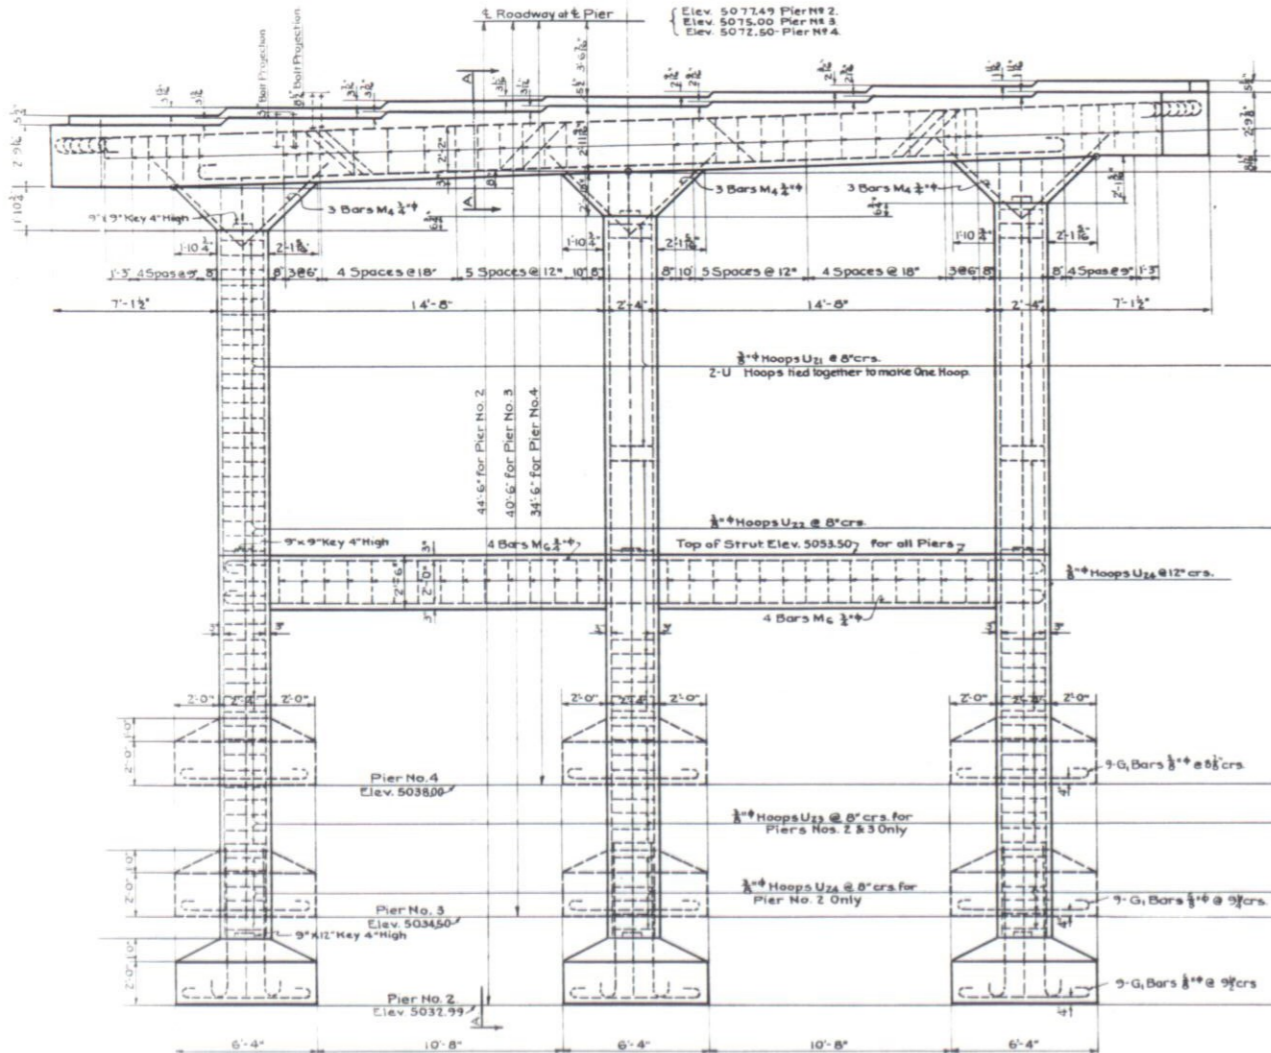

ELEVATION-Piers Nos 2, 3, & 4.

NOTE.
 All Pier Footings must rest on solid rock. If solid Rock is not encountered at the elevations shown for the three footings on each Pier, the Engineer must be notified.

BAR LIST FOR ABUTMENT No. 1.


MARK	SIZE	NO.	LENGTH	BENDING DIAGRAM
H6	1/2"	5	3'-5"	STRAIGHT
H7	1/2"	5	2'-1"	STRAIGHT
X1	1/2"	14	24'-2"	RAD. = 2'
X2	1/2"	49	3'-0"	RADIUS = 2'
X3	1/2"	14	5'-10"	RADIUS = 3'
X4	3/8"	14	6'-4"	RADIUS = 3'
X5	3/8"	15	6'-10"	RADIUS = 3'
X6	1/2"	5	22'-6"	STRAIGHT
PE	1/2"	5	7'-7"	STRAIGHT

160 LIN. FT. 1/2" BARS @ 0.665 LBS. PER LIN. FT. = 120 LBS.
 633 LIN. FT. 1/2" " @ 0.850 " " " = 538 " "
 89 LIN. FT. 3/8" " @ 1.043 " " " = 93 " "
 103 LIN. FT. 3/8" " @ 1.502 " " " = 155 " "
 1% FOR OVERRUN = 9 " "
TOTAL = 915 LBS.


BAR LIST FOR PIERS Nos 2, 3, & 4.

MARK	SIZE	NUMBER	LENGTH	BENDING DIAGRAMS	R.M.A.
D1	1"	12	16'-8"	Radius 4'	
D2	1"	12	33'-8"	Radius 4'	
D3	1"	9	22'-11"	Radius 4'	
D4	1"	9	32'-4"	Radius 4'	
D5	1"	12	40'-0"	Radius 4'	
M1	1"	108	7'-10"	Straight	
M2	1"	24	34'-0"	do	
M3	1"	24	30'-0"	do	
M4	1"	24	24'-0"	do	
M5	1"	27	10'-0"	do	
M6	1"	24	37'-4"	Radius 3'	
M12	1"	12	18'-6"	Straight	
M13	1"	12	14'-0"	do	
M14	1"	12	8'-6"	do	
U20	1"	240	8'-0"	Radius 12'	
U21	1"	288	5'-8"		
U22	1"	324	6'-2"		
U23	1"	144	6'-8"		
U24	1"	90	8'-0"		
G1	3/8"	81	6'-11"	Radius 2'	
G2	3/8"	24	8'-0"		
G3	3/8"	24	7'-10"		
G4	3/8"	24	7'-7"		

5310 Lin. Ft. 3/8" BARS @ 0.376 Lbs. per Ft. = 1997 Lbs.
 2040 Lin. Ft. 1/2" " @ 0.850 " " " = 1734 " "
 1722 Lin. Ft. 3/8" " @ 1.043 " " " = 1170 " "
 1166 Lin. Ft. 3/4" " @ 1.502 " " " = 1751 " "
 5037 Lin. Ft. 1" " @ 2.670 " " " = 13449 " "
 1% for overrun = 199 " "
Total 20300 Lbs.

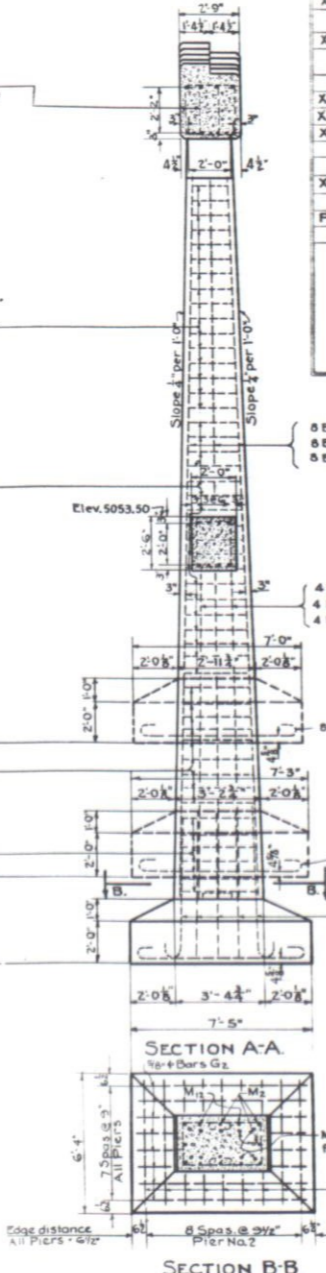

SECTION B-B.

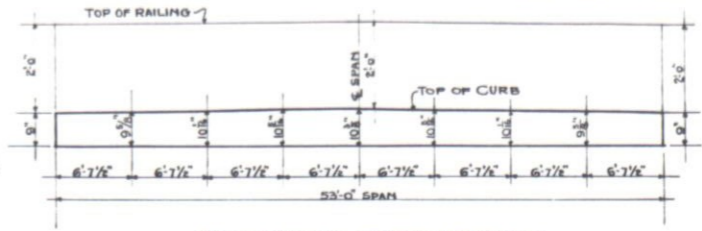


CAMBER DIAGRAM FOR CURB AND RAILING.

REFERENCE DRAWINGS.
 GENERAL LAYOUT, GENERAL NOTES, AND SUMMARY OF QUANTITIES FOR ENTIRE STRUCTURE, SHEET No. 7.
 SUPERSTRUCTURE DETAILS, SHEET No. 8.
 ABUTMENT No. 5 DETAILS SHEET No. 10.

LOADING DATA.
 LIVE LOAD = A. A. B. H. O. AUG. 1929, CLASS A. (19-15)
 DEAD LOAD = ASSUMED 12 LBS. PER SQ. FT. ADDITIONAL WEARING SURFACE, WHICH INCLUDES THE 5 IN. CONCRETE MONOLITHIC WEARING SURFACE.

COLORADO
STATE HIGHWAY DEPARTMENT
 4 SPAN @ 53'-0" x 30'-0" CONCRETE
 I-BEAM BRIDGE
 DETAILS FOR PIERS NOS. 2, 3, & 4
 Across C. & S. R.R. & DRAIN DITCH
 Sta. 1238+16.08 to 1240+30.67
 Near LOVELAND Sec. 8 T. 6 N. R. 69 W.
 Designed by K.B. Approved by P. H. Bailey
 Made by K.B. Bridge Engineer
 Checked by R.M.A. Date: June 24th, 1933.

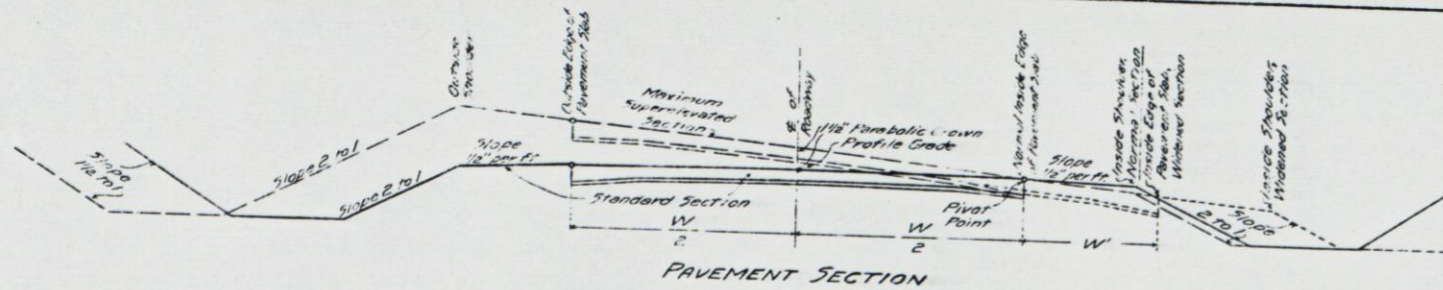


SUPERELEVATION AND WIDENING NOTES FOR PAVEMENT SECTION
 Curves on projects using the pavement section are to be super-elevated and widened as indicated in the accompanying drawings and table.
 The normal inside edge of the pavement slab is to remain at the standard elevation of 0.125 ft. below the profile grade, and the outside edge of the slab is to be super-elevated at the rate per foot width of roadway given in the table or graph. The section is to be rotated about the normal inside edge of the pavement.
 When the degree of curvature exceeds 10, the inside portion of the pavement slab is to be widened from the normal inside edge as per the table below. Curves of 10° or less are not to be widened. The 1/8" parabolic crown is to be used for curves of 10° and under. The widened section is to have a flat crown.


The slope of the shoulder shall conform to the rate per foot width of roadway required except that the inside shoulder shall maintain the standard slope of 0.0417 ft per foot width until the super-elevation rate exceeds this standard slope.
 The outside ditch along a super-elevated section is to be modified from the standard where a deeper ditch is required to provide drainage.
 Details of plans for super-elevating and widening are shown on the General Plan for Widening and the Graph of Super-elevation Factors.
 The subgrade for future pavement is to be constructed to conform to the super-elevation and widening requirements for the pavement section.

SUPERELEVATION FACTORS AND OFFSETS FOR WIDENING FOR PAVEMENT SECTION

Distance from B.T.	20 FT.	40 FT.	60 FT.	80 FT.	100 FT. = PC	120 FT.	140 FT.	160 FT.	180 FT.	200 FT. = E.T.	On Curve
Factor	0.02	0.08	0.16	0.32	0.50	0.68	0.82	0.92	0.98	1.00	1.00
Rate of Super-elevation (in Feet per Foot Width of Roadway)											
Degree of Curve	Rate of Super-elevation (in Feet per Foot Width of Roadway)										
2° and Under	0.0004	0.0017	0.0038	0.0067	0.0105	0.0143	0.0172	0.0193	0.0206	0.0210	0.0210
3°	0.0006	0.0025	0.0057	0.0101	0.0159	0.0214	0.0258	0.0290	0.0309	0.0315	0.0315
4°	0.0008	0.0034	0.0076	0.0134	0.0210	0.0286	0.0344	0.0386	0.0412	0.0420	0.0420
5°	0.0010	0.0042	0.0094	0.0168	0.0262	0.0344	0.0400	0.0436	0.0454	0.0460	0.0460
6°	0.0013	0.0050	0.0113	0.0202	0.0315	0.0428	0.0517	0.0580	0.0617	0.0630	0.0630
7°	0.0015	0.0059	0.0132	0.0245	0.0376	0.0500	0.0613	0.0706	0.0756	0.0775	0.0775
8°	0.0017	0.0067	0.0151	0.0282	0.0430	0.0571	0.0702	0.0796	0.0853	0.0880	0.0880
9°	0.0019	0.0076	0.0170	0.0322	0.0492	0.0643	0.0775	0.0869	0.0926	0.0945	0.0945
10° and Over	0.0020	0.0080	0.0180	0.0340	0.0520	0.0680	0.0820	0.0920	0.0980	0.1000	0.1000
Offsets for Widening W' (in Feet)											
0. or 10° - Under 12°	0.06	0.24	0.54	0.96	1.50	2.04	2.46	2.76	2.94	3.00	3.00
12° - " 15°	0.08	0.32	0.72	1.28	2.00	2.72	3.28	3.76	3.96	4.00	4.00
15° - " 20°	0.10	0.40	0.90	1.60	2.50	3.40	4.10	4.60	4.92	5.00	5.00
Over 20°	0.12	0.48	1.08	1.92	3.00	4.08	4.92	5.52	5.88	6.00	6.00

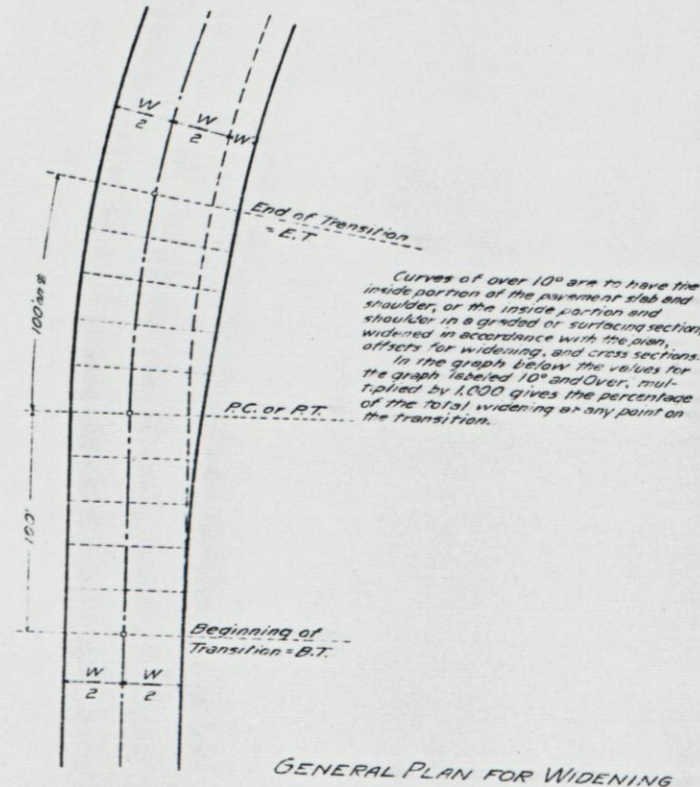

Curves of over 10° are to have the inside portion of the pavement slab and shoulder, or the inside portion and shoulder in a graded or surfacing section, widened in accordance with the plan, offsets for widening, and cross sections. In the graph below the values for the graph labeled 10° and Over, multiplied by 1,000 gives the percentage of the total widening at any point on the transition.

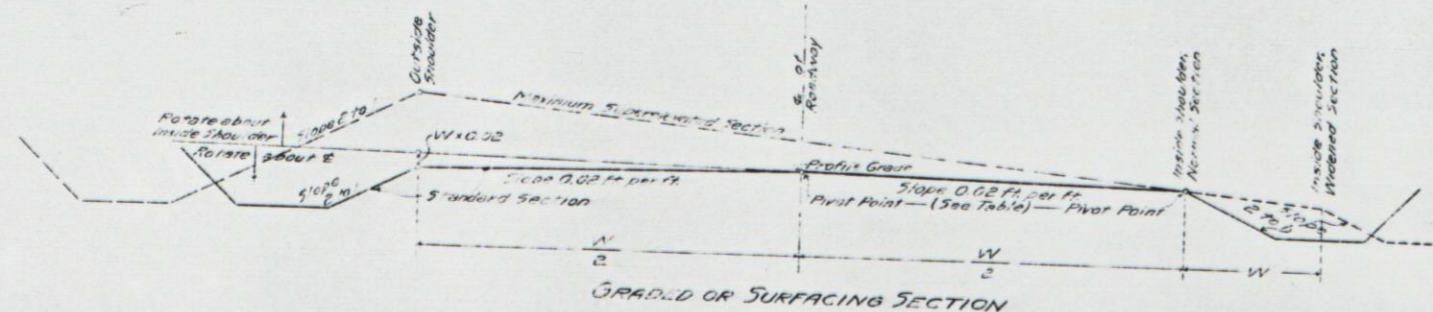


SUPERELEVATION AND WIDENING NOTES FOR GRADED OR SURFACING SECTIONS
 Curves on projects using the graded or surfacing section are to be super-elevated and widened as indicated in the accompanying sketches and table.
 The normal inside shoulder and ditch are to remain as shown in the typical section shown on sheet #2. The outside shoulder is to be the high point of the section.
 The outside ditch along a super-elevated section is to be modified from the standard where a deeper ditch is required to provide drainage.

The center line pivot point is to be used as long as the super-elevation does not exceed 0.02 feet per foot width of roadway. The normal inside shoulder pivot point is to be used for a super-elevation rate in excess of 0.02 feet per foot width of roadway.
 When the degree of curvature exceeds 10° the inside shoulder is to be widened from the normal inside shoulder line as shown in the table and cross section. Curves of 10° and less are not to be widened.
 Details of plans for super-elevating and widening are shown on the General Plan for Widening and the Graph of Super-elevation Factors.

SUPERELEVATION FACTORS AND OFFSETS FOR WIDENING FOR GRADED OR SURFACING SECTIONS

Distance from B.T.	20 FT.	40 FT.	60 FT.	80 FT.	100 FT. = PC	120 FT.	140 FT.	160 FT.	180 FT.	200 FT. = E.T.	On Curve	Length of Transition Rotated about
Factor	0.02	0.08	0.16	0.32	0.50	0.68	0.82	0.92	0.98	1.00	1.00	Center Line Inside Shoulder
Rate of Super-elevation (in Feet) per Foot Width of Roadway												
Degree of Curve	Rate of Super-elevation (in Feet) per Foot Width of Roadway											
2° and Under	0.0004	0.0017	0.0038	0.0067	0.0105	0.0143	0.0172	0.0193	0.0206	0.0210	0.0210	169 ft.
3°	0.0006	0.0025	0.0057	0.0101	0.0159	0.0214	0.0258	0.0290	0.0309	0.0315	0.0315	115 "
4°	0.0008	0.0034	0.0076	0.0134	0.0210	0.0286	0.0344	0.0386	0.0412	0.0420	0.0420	98 "
5°	0.0010	0.0042	0.0094	0.0168	0.0262	0.0344	0.0400	0.0436	0.0454	0.0460	0.0460	87 "
6°	0.0013	0.0050	0.0113	0.0202	0.0315	0.0428	0.0517	0.0580	0.0617	0.0630	0.0630	80 ft.
7°	0.0015	0.0059	0.0132	0.0245	0.0376	0.0500	0.0613	0.0706	0.0756	0.0775	0.0775	74 "
8°	0.0017	0.0067	0.0151	0.0282	0.0430	0.0571	0.0702	0.0796	0.0853	0.0880	0.0880	69 "
9°	0.0019	0.0076	0.0170	0.0322	0.0492	0.0643	0.0775	0.0869	0.0926	0.0945	0.0945	65 "
10° and Over	0.0020	0.0080	0.0180	0.0340	0.0520	0.0680	0.0820	0.0920	0.0980	0.1000	0.1000	63 "
Offsets for Widening W' (in Feet)												
Over 10° - Under 12°	0.06	0.24	0.54	0.96	1.50	2.04	2.46	2.76	2.94	3.00	3.00	
12° - " 15°	0.08	0.32	0.72	1.28	2.00	2.72	3.28	3.76	3.96	4.00	4.00	
15° - " 20°	0.10	0.40	0.90	1.60	2.50	3.40	4.10	4.60	4.92	5.00	5.00	
Over 20°	0.12	0.48	1.08	1.92	3.00	4.08	4.92	5.52	5.88	6.00	6.00	

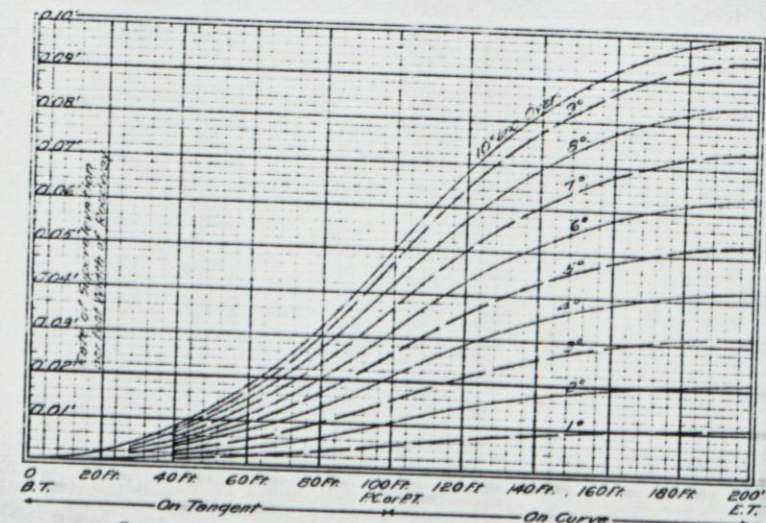







The rate of super-elevation per foot width of roadway to be applied at the outside edge of the pavement slab, and at the outside shoulder of the roadway, is computed as follows:
 The full super-elevation per foot width of roadway rate for a given degree of curvature is
 $0.0105 \text{ ft} \times \text{Degree of Curvature}$
 The maximum super-elevation of 0.10 ft. per foot width, applying to curves of 10° and over, is not to be exceeded.
 The above graph has been prepared from the rates of super-elevation shown in the tabulations.

COLORADO STATE HIGHWAY DEPARTMENT
STANDARD METHODS FOR SUPERELEVATION AND WIDENING OF CURVES
 Designed by S.B.L. Approved by
 Made by S.B.L.
 Checked by S.B.L. Date: Aug. 17, 1932.

STANDARD M-24-F

FED. ROAD DIST. NO.	STATE	FED. AID PROJ. NO.	SHEET NO.	TOTAL SHEETS
3	COLO.	F5C	12	12

Revised Aug. 8, 1932. A.G.K. Added note for intersecting fences.
 Revised Oct. 11, 1932. A.G.K. Changed Staples to be 1 1/2 long and to be galvanized.
 Revised 12-14-32. A.G.K. Galvanized Gate Frames.
 Revised 3-7-33. A.G.K. Changed Braces & Post Details.

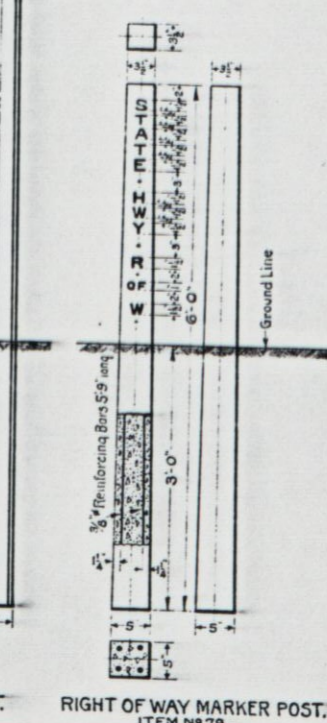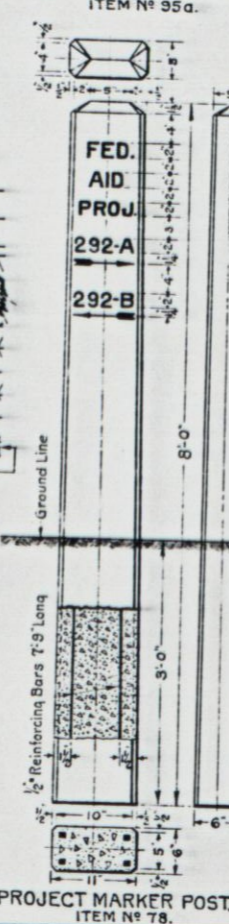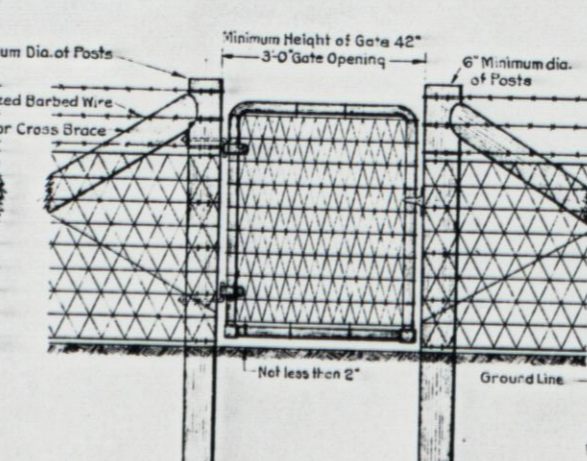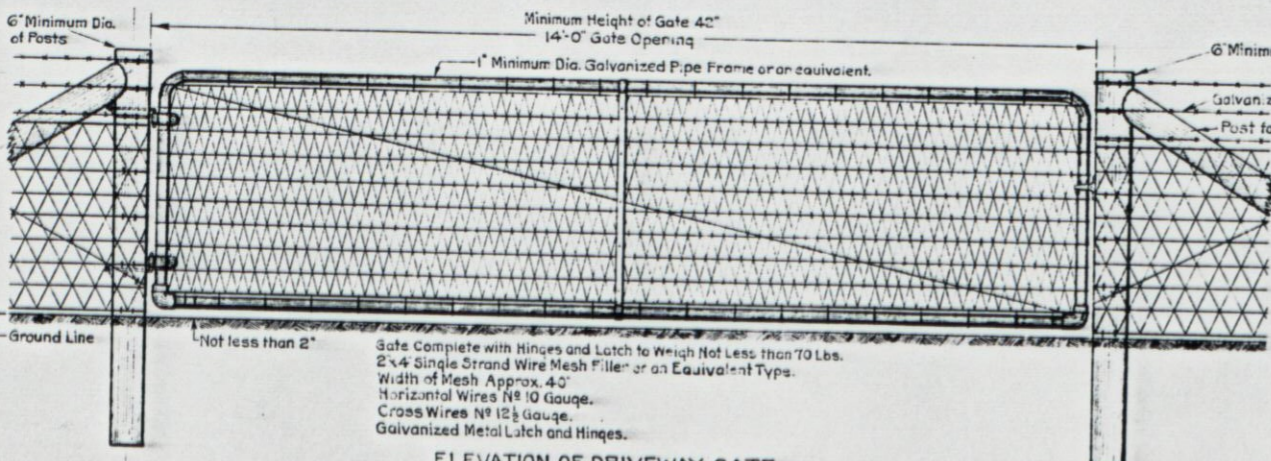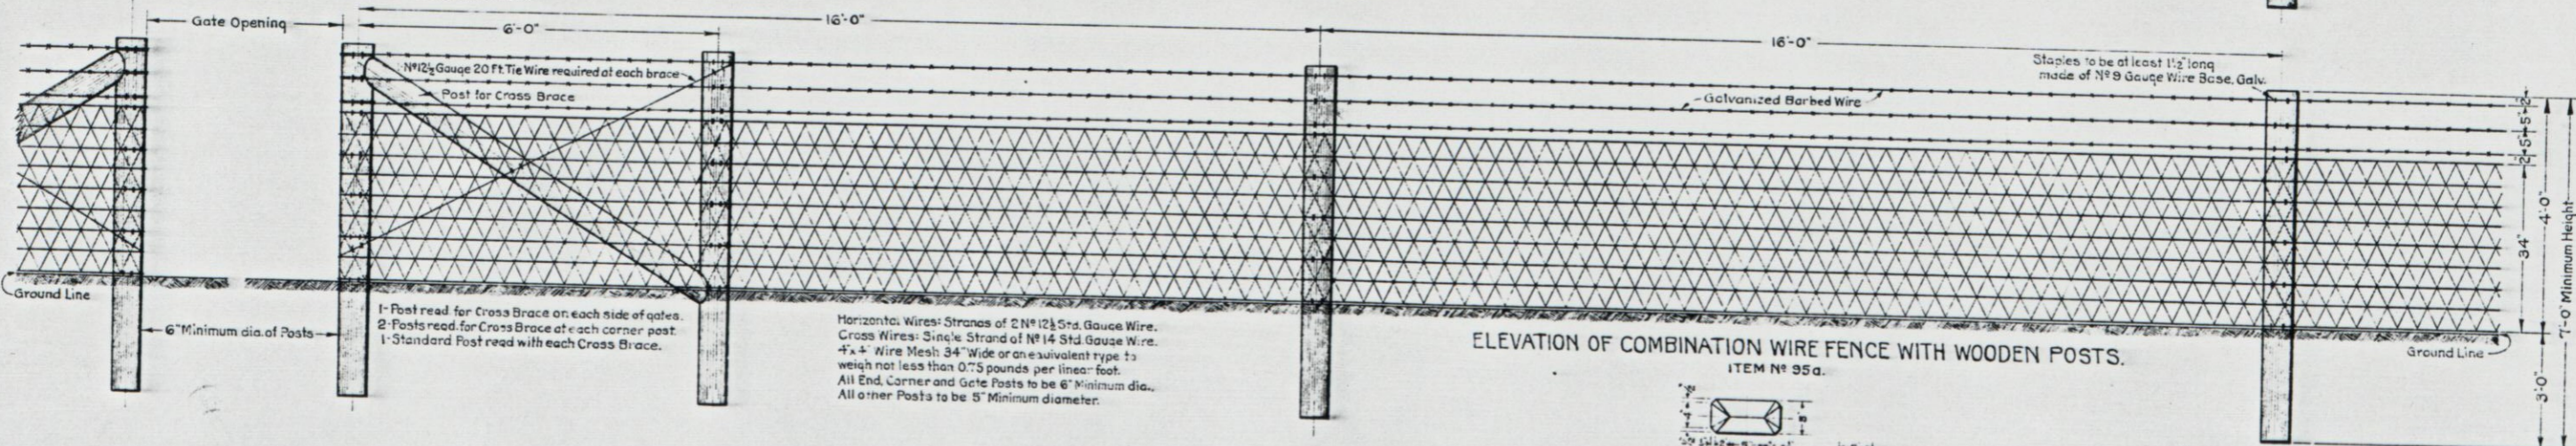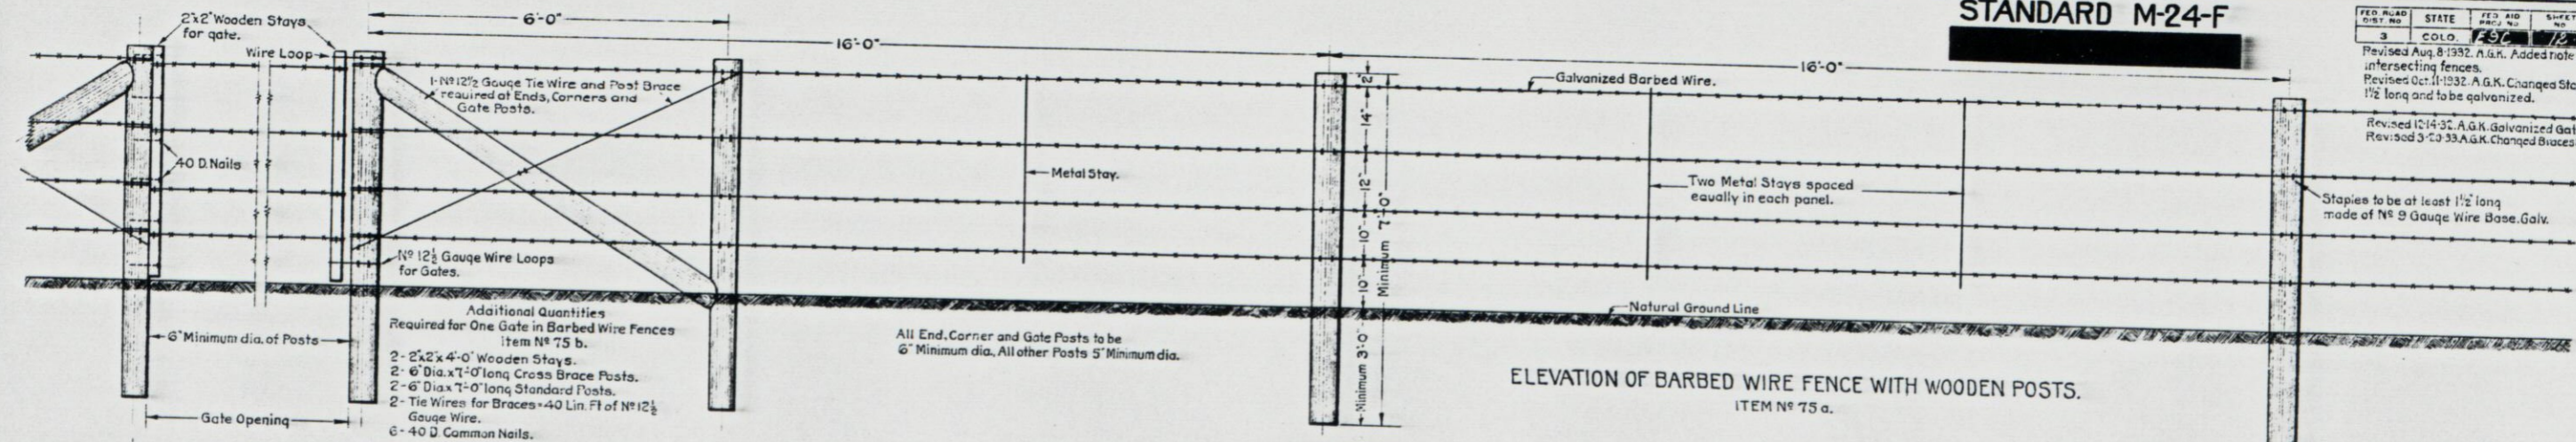

NOTES FOR PROJECT MARKER POSTS.
 All Letters and Numbers shall be 2" Plain Upright Block, Painted or Stenciled on the Concrete with a good quality of Black Paint. See Item No. 41 "Second Field Coat-Dark".
 Numbers and arrows shall show the proper numbers and directions of the projects each way from where the post is placed.
 Post is to be set with sign facing the road at the end of the project, five feet beyond edge of shoulder in such a position that the sign will properly indicate the projects to which it refers.

NOTES FOR RIGHT OF WAY MARKER POSTS.
 All Letters shall be 1 1/2" Plain and Depressed 1/4 inch.
 Post shall be set with Lettering Facing the Road at Points indicated on the Plans.


GENERAL NOTES FOR MARKER POSTS.
 All Work shall be done in accordance with the Standard Specifications of the Colorado State Highway Department, Adopted January 1-1930.
 Posts shall be made of Class "D" Concrete (Slump 3 to 6") except use White Portland Cement.
 Reinforcing Bars shall be round or square, plain or deformed as shown and noted.
 All Exposed Surfaces shall be rubbed free of form marks.

GENERAL NOTES FOR WIRE FENCES.
 All work shall be done in accordance with the Standard Specifications of the Colorado State Highway Department, Adopted January 1-1930.
 Barbed Wire shall be of Standard Wire, not lighter than No. 12 1/2 Gauge, Galvanized and with Two Point Barbs spaced not more than 5" apart.
 Wire Mesh must be galvanized and not lighter than shown and noted on this plan.
 Wire Mesh used in Driveway Gates shall be painted with an approved waterproof asphalt or mineral paint.
 Staples shall be at least 1 1/2 long, made of No. 9 Gauge Wire Base Galv. 8 staples reqd. per post for barbed wire fence and 14 Staples per post for Combination Wire Fence.
 All Wooden Posts shall be made from seasoned, straight, sound Lodge Pole Pine, Southern Yellow Pine or XXXXXXXXXX
 All Wooden Posts shall be entirely peeled and saved, thoroughly seasoned and dry before treatment.
 All Wooden Posts shall be pressure treated with Creosote Oil for the full length of posts as provided in the specifications.
 Cross Braces, Brace Posts and Tie Wires are to be used at all places where intersecting fences are encountered.

ORIGINAL BY	INITIAL	DATE
CHECKED BY		
VANDYKE BY		
CHECKED BY		


COLORADO
STATE HIGHWAY DEPARTMENT
STANDARD
WIRE FENCES
AND
MARKER POSTS

Designed by AGK | Approved by *Ed Bailey*
 Made by AGK | Bridge Engineer
 Checked by GHD | Date: Feb. 1, 1932.

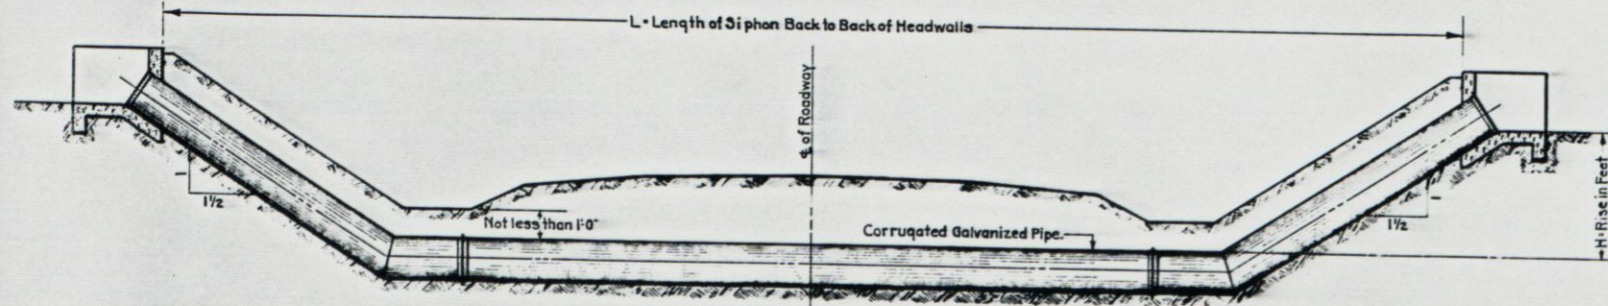


SECTIONAL ELEVATION OF SIPHON

DIAMETER OF SIPHON IN FEET	A	B	C	D	E
18"	6'-1 1/2"	8'-1 1/2"	0'-10"	2'-6"	1'-5"
24"	7'-6"	9'-0"	1'-1 1/2"	3'-0"	1'-11"
30"	8'-4 1/2"	9'-10 1/2"	1'-4 1/2"	3'-6"	2'-5"
36"	9'-3"	10'-9"	1'-8"	4'-0"	2'-11"

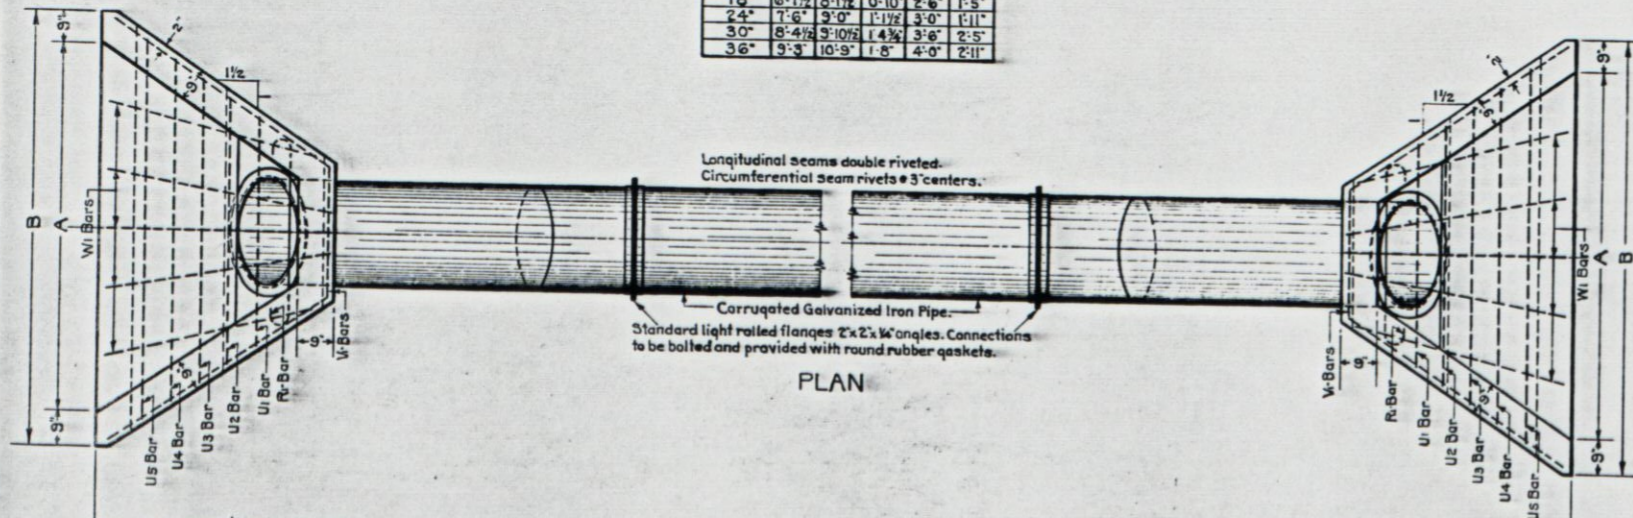


PLAN

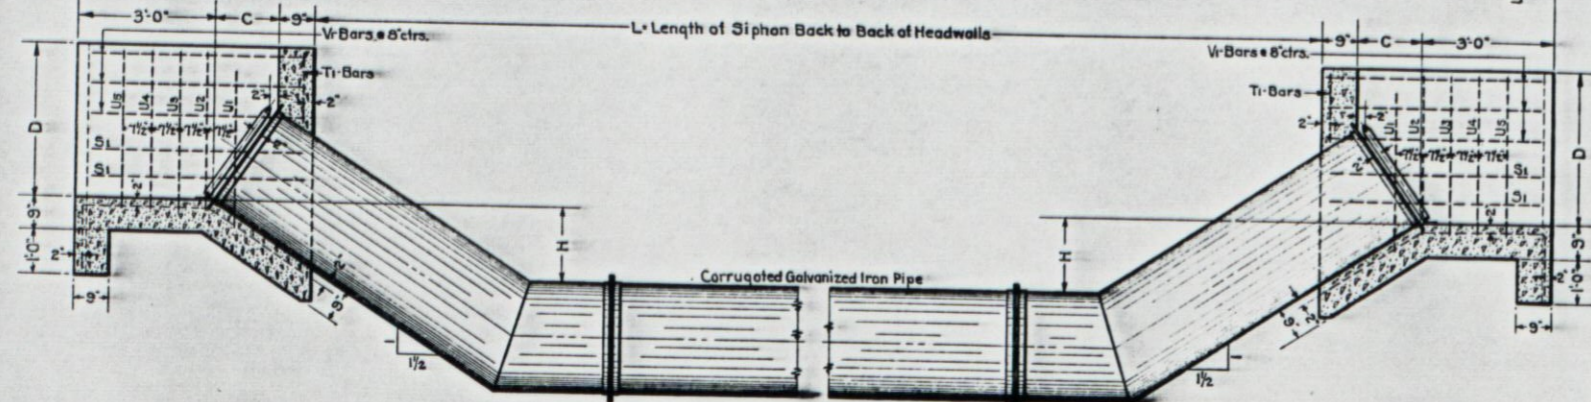


SECTIONAL ELEVATION

DIAMETER 18" AND 24"		BAR LIST FOR ONE SIPHON		DIAMETER 30" AND 36"		
MARK	NUMBER	LENGTH	BENDING DIAGRAM	LENGTH	NUMBER	MARK
18" Ri	2	4'-11"		5'-11"	2	30" Ri
24" Ri	2	5'-5"		6'-5"	2	36" Ri
18" Si	8	4'-2"		4'-9"	8	30" Si
24" Si	8	4'-5"		5'-0"	8	36" Si
18" Ti	4	4'-0"		5'-4"	4	30" Ti
24" Ti	4	4'-6"		5'-10"	4	36" Ti
18" & 24" U1 & U2	2 Each	8'-6" & 11'-0" Increase by 10"		12'-4" & 15'-8" Increase by 10"	2 Each	30" & 36" U1 & U2
18" V1	6	12'-0"		14'-0"	6	30" V1
24" V1	6	13'-0"		15'-0"	6	36" V1
18" & 24" W1	10	5'-6"		6'-0"	10	30" & 36" W1

QUANTITIES FOR ONE SIPHON				
SIPHON SIZES	ITEM N° 96 PIPE GAUGE U.S. STD.	ITEM N° 46a CONCRETE CLASS 'A'	ITEM N° 41 REINFORCING STEEL	ITEM N° 85 TRASH GUARDS
18" Diameter	16	3.50 Cu. Yds.	255 Lbs.	2# 30 Lbs. Each
24" Diameter	14	4.25 Cu. Yds.	260 Lbs.	2# 40 Lbs. Each
30" Diameter	14	5.25 Cu. Yds.	310 Lbs.	2# 60 Lbs. Each
36" Diameter	12	6.25 Cu. Yds.	320 Lbs.	2# 80 Lbs. Each

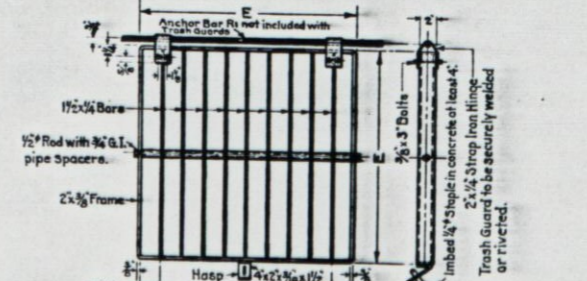

DETAIL OF TRASH GUARD

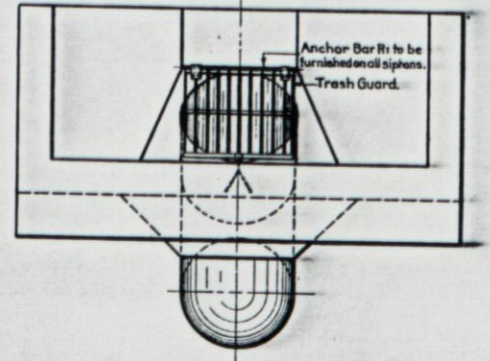

FRONT ELEVATION

TABLE OF PIPE LENGTHS IN FEET MEASURED ON E OF SIPHON	
18" DIAMETER	
L	22 25 28 31 34 37 40 43 46 49 52 55 58 61 64 67 70 73 76 79 82 85
0	25.2 28.2 31.2 34.2 37.2 40.2 43.2 46.2 49.2 52.2 55.2 58.2 61.2 64.2 67.2 70.2 73.2 76.2 79.2 82.2 85.2
1	28.8 31.8 34.8 37.8 40.8 43.8 46.8 49.8 52.8 55.8 58.8 61.8 64.8 67.8 70.8 73.8 76.8 79.8 82.8 85.8
2	32.4 35.4 38.4 41.4 44.4 47.4 50.4 53.4 56.4 59.4 62.4 65.4 68.4 71.4 74.4 77.4 80.4 83.4 86.4 89.4
3	36.0 39.0 42.0 45.0 48.0 51.0 54.0 57.0 60.0 63.0 66.0 69.0 72.0 75.0 78.0 81.0 84.0 87.0 90.0
4	39.6 42.6 45.6 48.6 51.6 54.6 57.6 60.6 63.6 66.6 69.6 72.6 75.6 78.6 81.6 84.6 87.6 90.6
5	43.2 46.2 49.2 52.2 55.2 58.2 61.2 64.2 67.2 70.2 73.2 76.2 79.2 82.2 85.2 88.2 91.2
6	46.8 49.8 52.8 55.8 58.8 61.8 64.8 67.8 70.8 73.8 76.8 79.8 82.8 85.8 88.8 91.8
7	50.4 53.4 56.4 59.4 62.4 65.4 68.4 71.4 74.4 77.4 80.4 83.4 86.4 89.4
8	54.0 57.0 60.0 63.0 66.0 69.0 72.0 75.0 78.0 81.0 84.0 87.0 90.0 93.0
9	57.6 60.6 63.6 66.6 69.6 72.6 75.6 78.6 81.6 84.6 87.6 90.6 93.6
10	61.2 64.2 67.2 70.2 73.2 76.2 79.2 82.2 85.2 88.2 91.2 94.2


24" DIAMETER	
L	22 25 28 31 34 37 40 43 46 49 52 55 58 61 64 67 70 73 76 79 82 85
0	25.7 28.7 31.7 34.7 37.7 40.7 43.7 46.7 49.7 52.7 55.7 58.7 61.7 64.7 67.7 70.7 73.7 76.7 79.7 82.7 85.7
1	29.3 32.3 35.3 38.3 41.3 44.3 47.3 50.3 53.3 56.3 59.3 62.3 65.3 68.3 71.3 74.3 77.3 80.3 83.3 86.3 89.3
2	32.9 35.9 38.9 41.9 44.9 47.9 50.9 53.9 56.9 59.9 62.9 65.9 68.9 71.9 74.9 77.9 80.9 83.9 86.9 89.9
3	36.5 39.5 42.5 45.5 48.5 51.5 54.5 57.5 60.5 63.5 66.5 69.5 72.5 75.5 78.5 81.5 84.5 87.5 90.5
4	40.1 43.1 46.1 49.1 52.1 55.1 58.1 61.1 64.1 67.1 70.1 73.1 76.1 79.1 82.1 85.1 88.1 91.1
5	43.7 46.7 49.7 52.7 55.7 58.7 61.7 64.7 67.7 70.7 73.7 76.7 79.7 82.7 85.7 88.7 91.7
6	47.3 50.3 53.3 56.3 59.3 62.3 65.3 68.3 71.3 74.3 77.3 80.3 83.3 86.3 89.3
7	50.9 53.9 56.9 59.9 62.9 65.9 68.9 71.9 74.9 77.9 80.9 83.9 86.9 89.9
8	54.5 57.5 60.5 63.5 66.5 69.5 72.5 75.5 78.5 81.5 84.5 87.5 90.5 93.5
9	58.1 61.1 64.1 67.1 70.1 73.1 76.1 79.1 82.1 85.1 88.1 91.1 94.1
10	61.7 64.7 67.7 70.7 73.7 76.7 79.7 82.7 85.7 88.7 91.7 94.7

30" DIAMETER	
L	22 25 28 31 34 37 40 43 46 49 52 55 58 61 64 67 70 73 76 79 82 85
0	26.3 29.3 32.3 35.3 38.3 41.3 44.3 47.3 50.3 53.3 56.3 59.3 62.3 65.3 68.3 71.3 74.3 77.3 80.3 83.3 86.3 89.3
1	29.9 32.9 35.9 38.9 41.9 44.9 47.9 50.9 53.9 56.9 59.9 62.9 65.9 68.9 71.9 74.9 77.9 80.9 83.9 86.9 89.9
2	33.5 36.5 39.5 42.5 45.5 48.5 51.5 54.5 57.5 60.5 63.5 66.5 69.5 72.5 75.5 78.5 81.5 84.5 87.5 90.5
3	37.1 40.1 43.1 46.1 49.1 52.1 55.1 58.1 61.1 64.1 67.1 70.1 73.1 76.1 79.1 82.1 85.1 88.1 91.1
4	40.7 43.7 46.7 49.7 52.7 55.7 58.7 61.7 64.7 67.7 70.7 73.7 76.7 79.7 82.7 85.7 88.7 91.7
5	44.3 47.3 50.3 53.3 56.3 59.3 62.3 65.3 68.3 71.3 74.3 77.3 80.3 83.3 86.3 89.3
6	47.9 50.9 53.9 56.9 59.9 62.9 65.9 68.9 71.9 74.9 77.9 80.9 83.9 86.9 89.9
7	51.5 54.5 57.5 60.5 63.5 66.5 69.5 72.5 75.5 78.5 81.5 84.5 87.5 90.5
8	55.1 58.1 61.1 64.1 67.1 70.1 73.1 76.1 79.1 82.1 85.1 88.1 91.1 94.1
9	58.7 61.7 64.7 67.7 70.7 73.7 76.7 79.7 82.7 85.7 88.7 91.7 94.7
10	62.3 65.3 68.3 71.3 74.3 77.3 80.3 83.3 86.3 89.3 92.3 95.3

36" DIAMETER	
L	22 25 28 31 34 37 40 43 46 49 52 55 58 61 64 67 70 73 76 79 82 85
0	26.8 29.8 32.8 35.8 38.8 41.8 44.8 47.8 50.8 53.8 56.8 59.8 62.8 65.8 68.8 71.8 74.8 77.8 80.8 83.8 86.8 89.8
1	30.4 33.4 36.4 39.4 42.4 45.4 48.4 51.4 54.4 57.4 60.4 63.4 66.4 69.4 72.4 75.4 78.4 81.4 84.4 87.4 90.4
2	34.0 37.0 40.0 43.0 46.0 49.0 52.0 55.0 58.0 61.0 64.0 67.0 70.0 73.0 76.0 79.0 82.0 85.0 88.0 91.0
3	37.6 40.6 43.6 46.6 49.6 52.6 55.6 58.6 61.6 64.6 67.6 70.6 73.6 76.6 79.6 82.6 85.6 88.6 91.6
4	41.2 44.2 47.2 50.2 53.2 56.2 59.2 62.2 65.2 68.2 71.2 74.2 77.2 80.2 83.2 86.2 89.2 92.2
5	44.8 47.8 50.8 53.8 56.8 59.8 62.8 65.8 68.8 71.8 74.8 77.8 80.8 83.8 86.8 89.8
6	48.4 51.4 54.4 57.4 60.4 63.4 66.4 69.4 72.4 75.4 78.4 81.4 84.4 87.4 90.4
7	52.0 55.0 58.0 61.0 64.0 67.0 70.0 73.0 76.0 79.0 82.0 85.0 88.0 91.0 94.0
8	55.6 58.6 61.6 64.6 67.6 70.6 73.6 76.6 79.6 82.6 85.6 88.6 91.6 94.6
9	59.2 62.2 65.2 68.2 71.2 74.2 77.2 80.2 83.2 86.2 89.2 92.2 95.2
10	62.8 65.8 68.8 71.8 74.8 77.8 80.8 83.8 86.8 89.8 92.8 95.8

GENERAL NOTES.
 All work shall be done according to the Standard Specifications of The Colorado State Highway Department, Adopted January 1-1930.
 All concrete shall be Class 'A'.
 All walls shall have forms on both sides.
 All reinforcing bars shall be round or square, plain or deformed as shown and noted.
 All reinforcing bars shall be tagged with the station number and letter designation.
 All exposed corners in concrete shall be beveled to a 2" face.
 All corrugated pipe to conform to the Colorado State Highway Specifications.
 All flanges to be 2x2x1/4" standard light rolled, securely riveted to corrugated pipe.
 Trash guards to be furnished only when called for on sheet N° 2.
 For siphons required and governing dimensions see sheet N° 2.
 Trash guards to be painted as per specifications for structural steel.

COLORADO STATE HIGHWAY DEPARTMENT
STANDARD SIPHON
 CORRUGATED GALVANIZED IRON PIPE WITH CONCRETE INLET & OUTLET BOXES
 SIZES 18"-24"-30"-36"
 Designed by A.G.K. Approved by *Ed. S. Baskin*
 Made by A.G.K. Bridge Engineer
 Checked by W.M.M. Date: Dec. 6, 1932

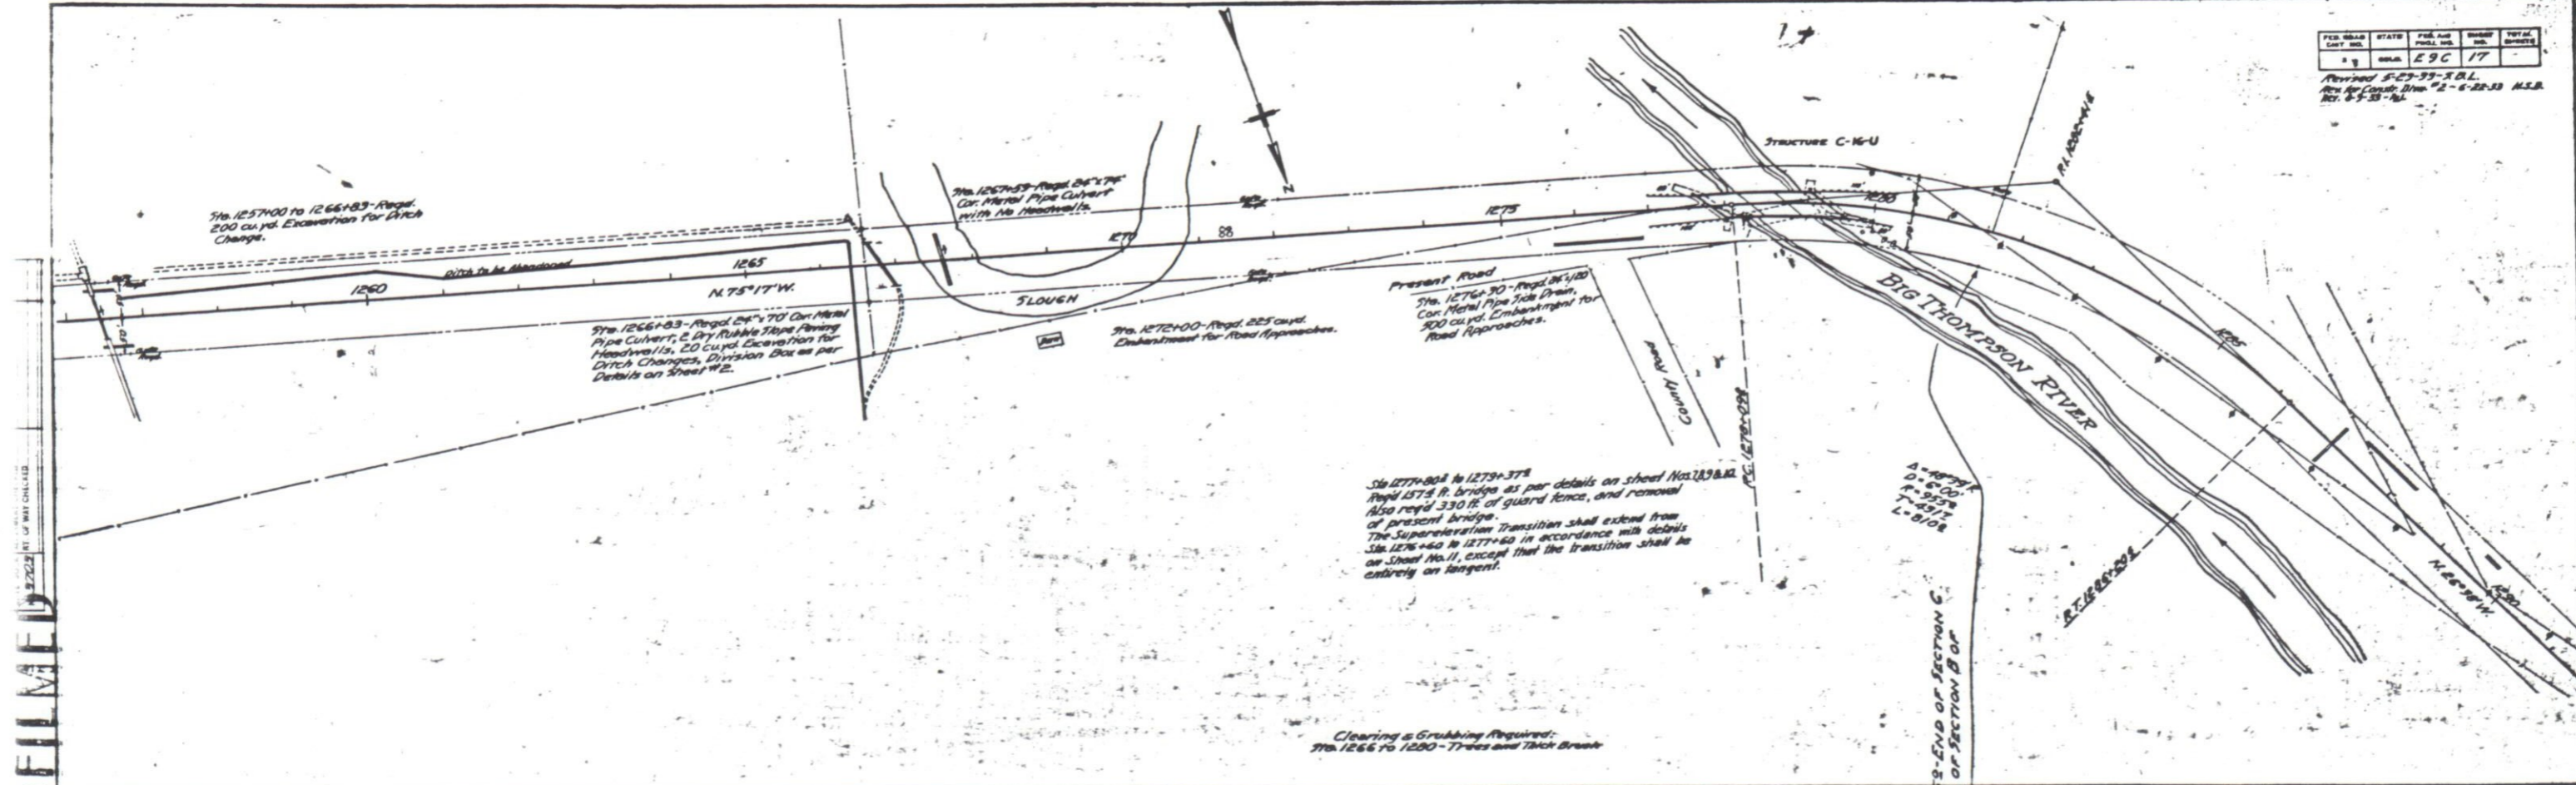

MICROFILMED

NOTE: ROAD GRADE CHECKED BY S.B.L. 8-18-58. ROAD STRUCTURE CHECKED BY S.B.L. 8-18-58.

