

SHEET NO. 26	
PROJECT NO. FC 034-2(6)	
DIVISION COLORADO	
FEDERAL ROAD REGION NO. III	
AS CONSTRUCTED	
NO REVISIONS	REVISED 2-2-74
VOID	



SW 1/4 SEC. 16
T5N. R65W

497+00 ~ Modify Inlet Lt.
(See Detail Sheet No. 9)

4-12' 11"
D=0' 4' 5"
T=8' 15' 30"
L=160' 00"
R=76' 55' 00"
S=0' 02' 9 1/4"
MDS=70 m.p.h.



3" Dia. Steel Casing Installed
By Greeley Gas Co.

FRONTAGE ROAD

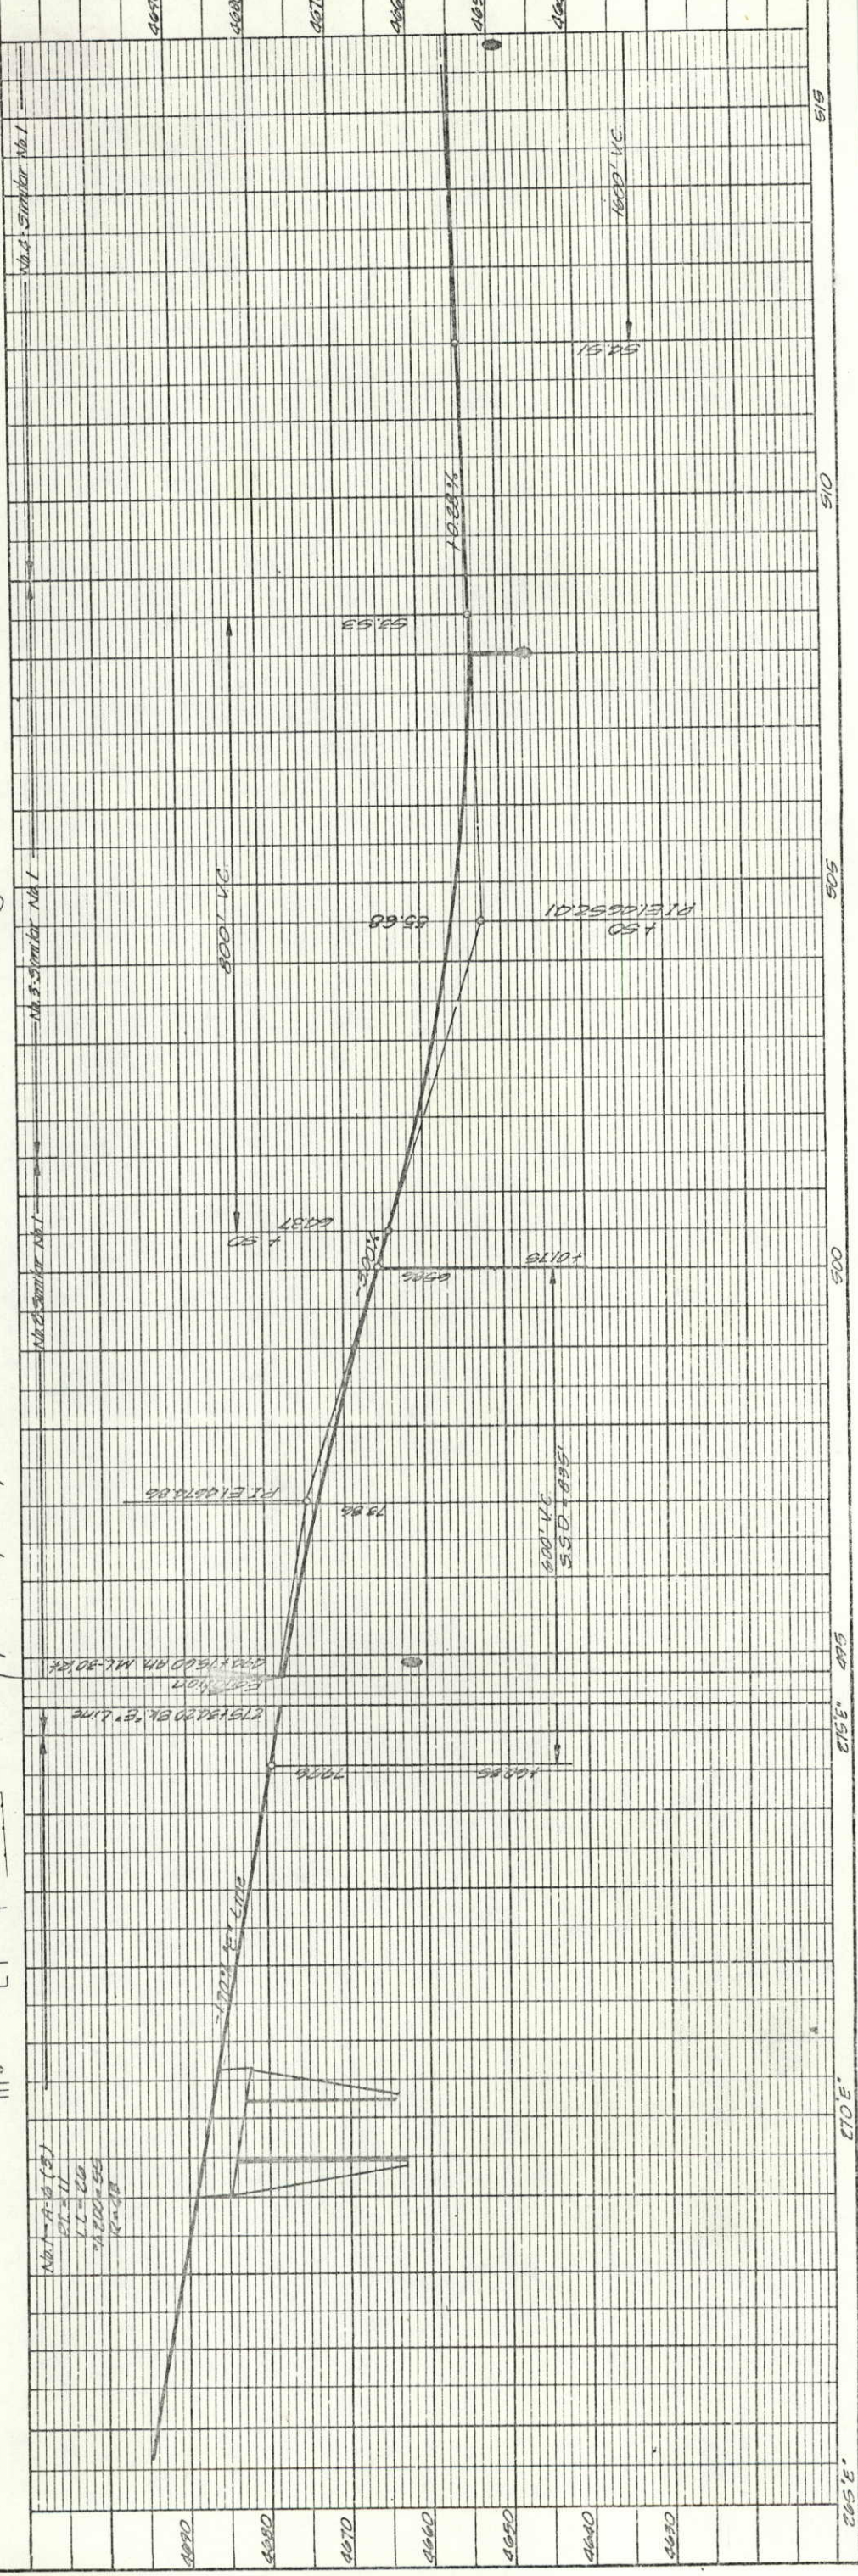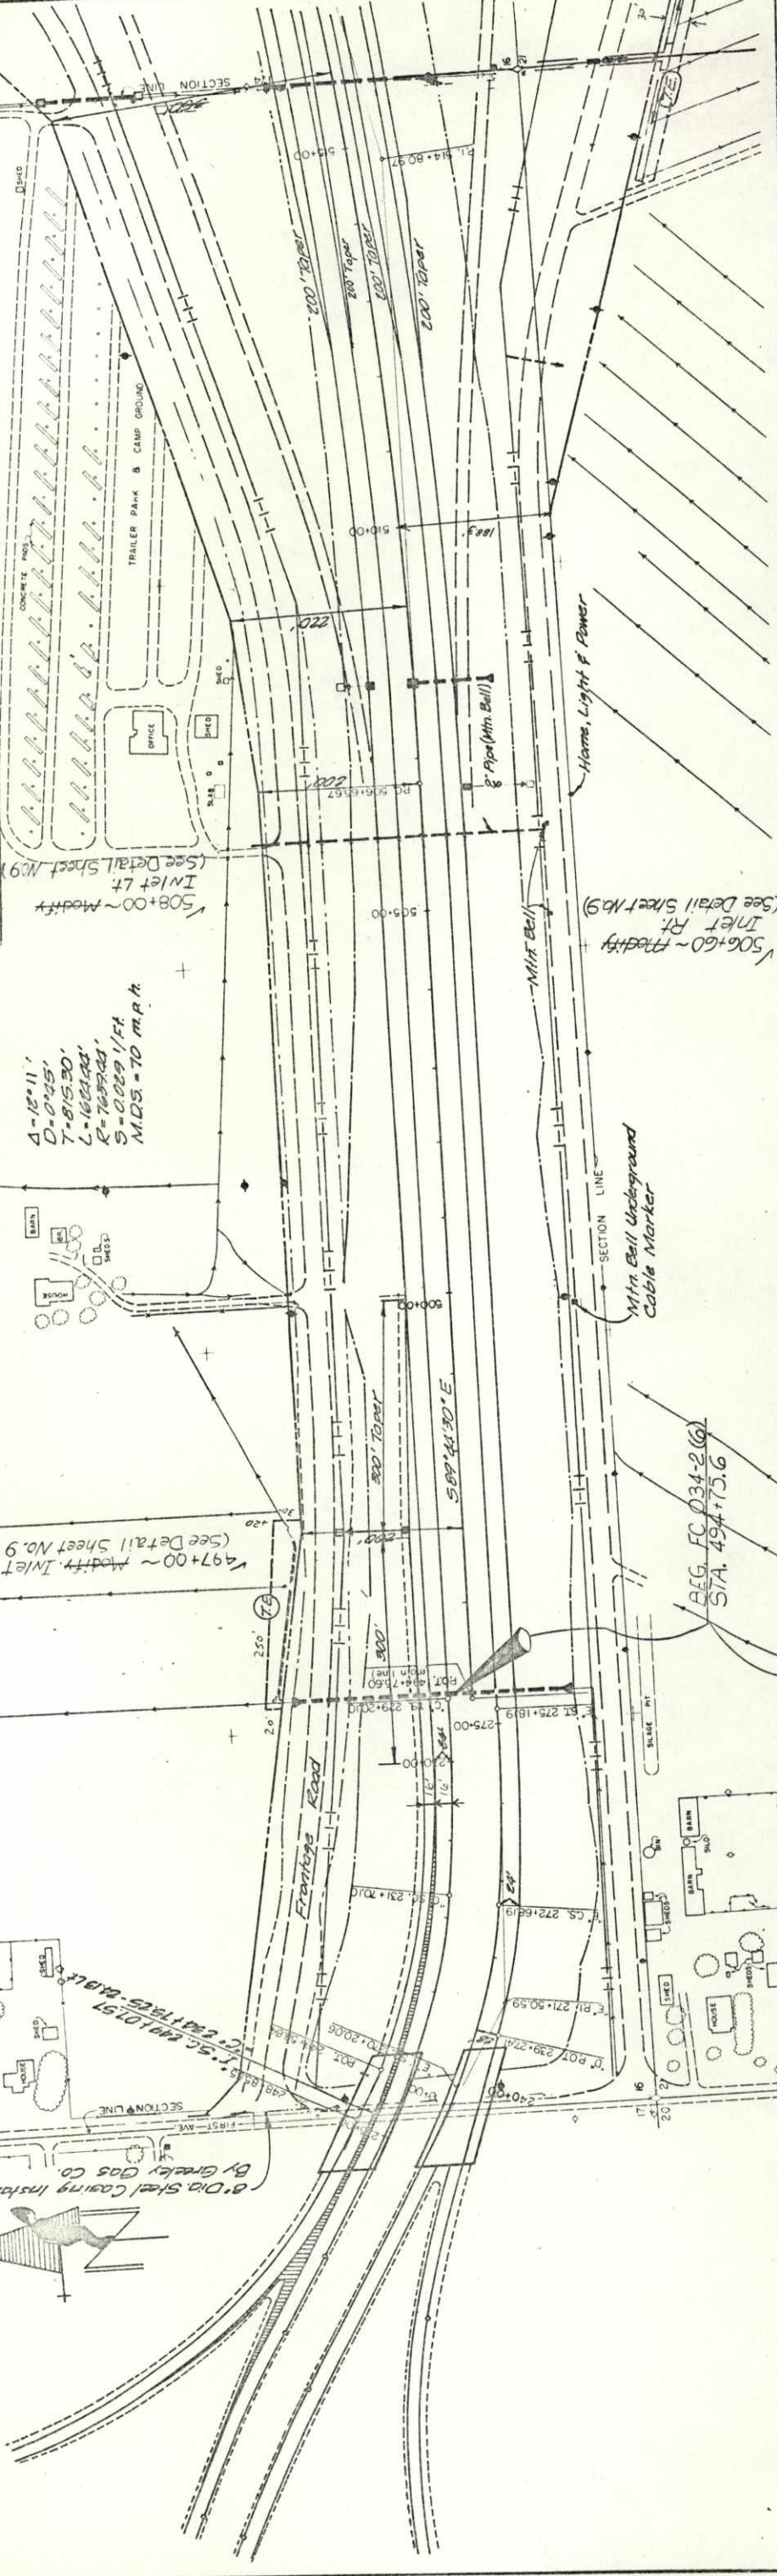

NO.	DATE	BY	REVISION
1	2-2-74	WJ	REVISED

NO.	DATE	BY	REVISION
1	2-2-74	WJ	REVISED

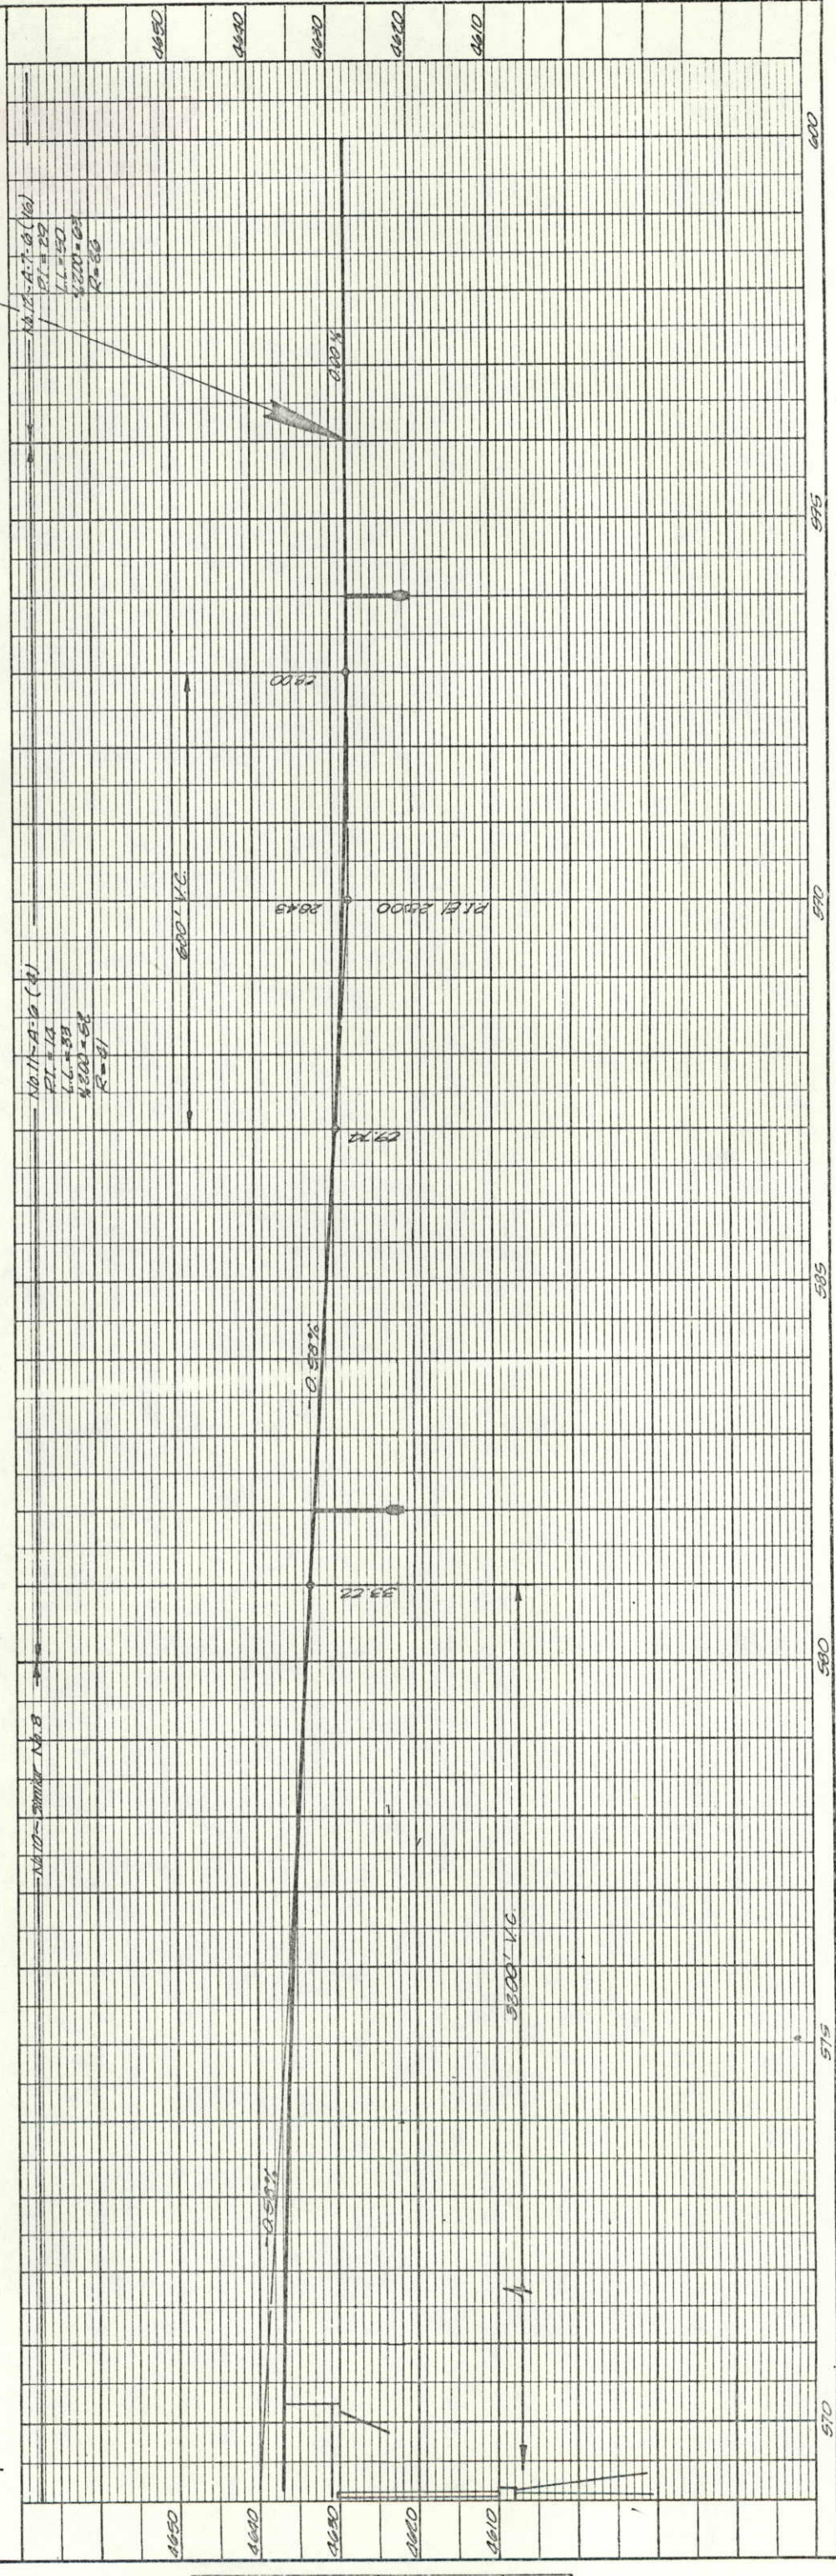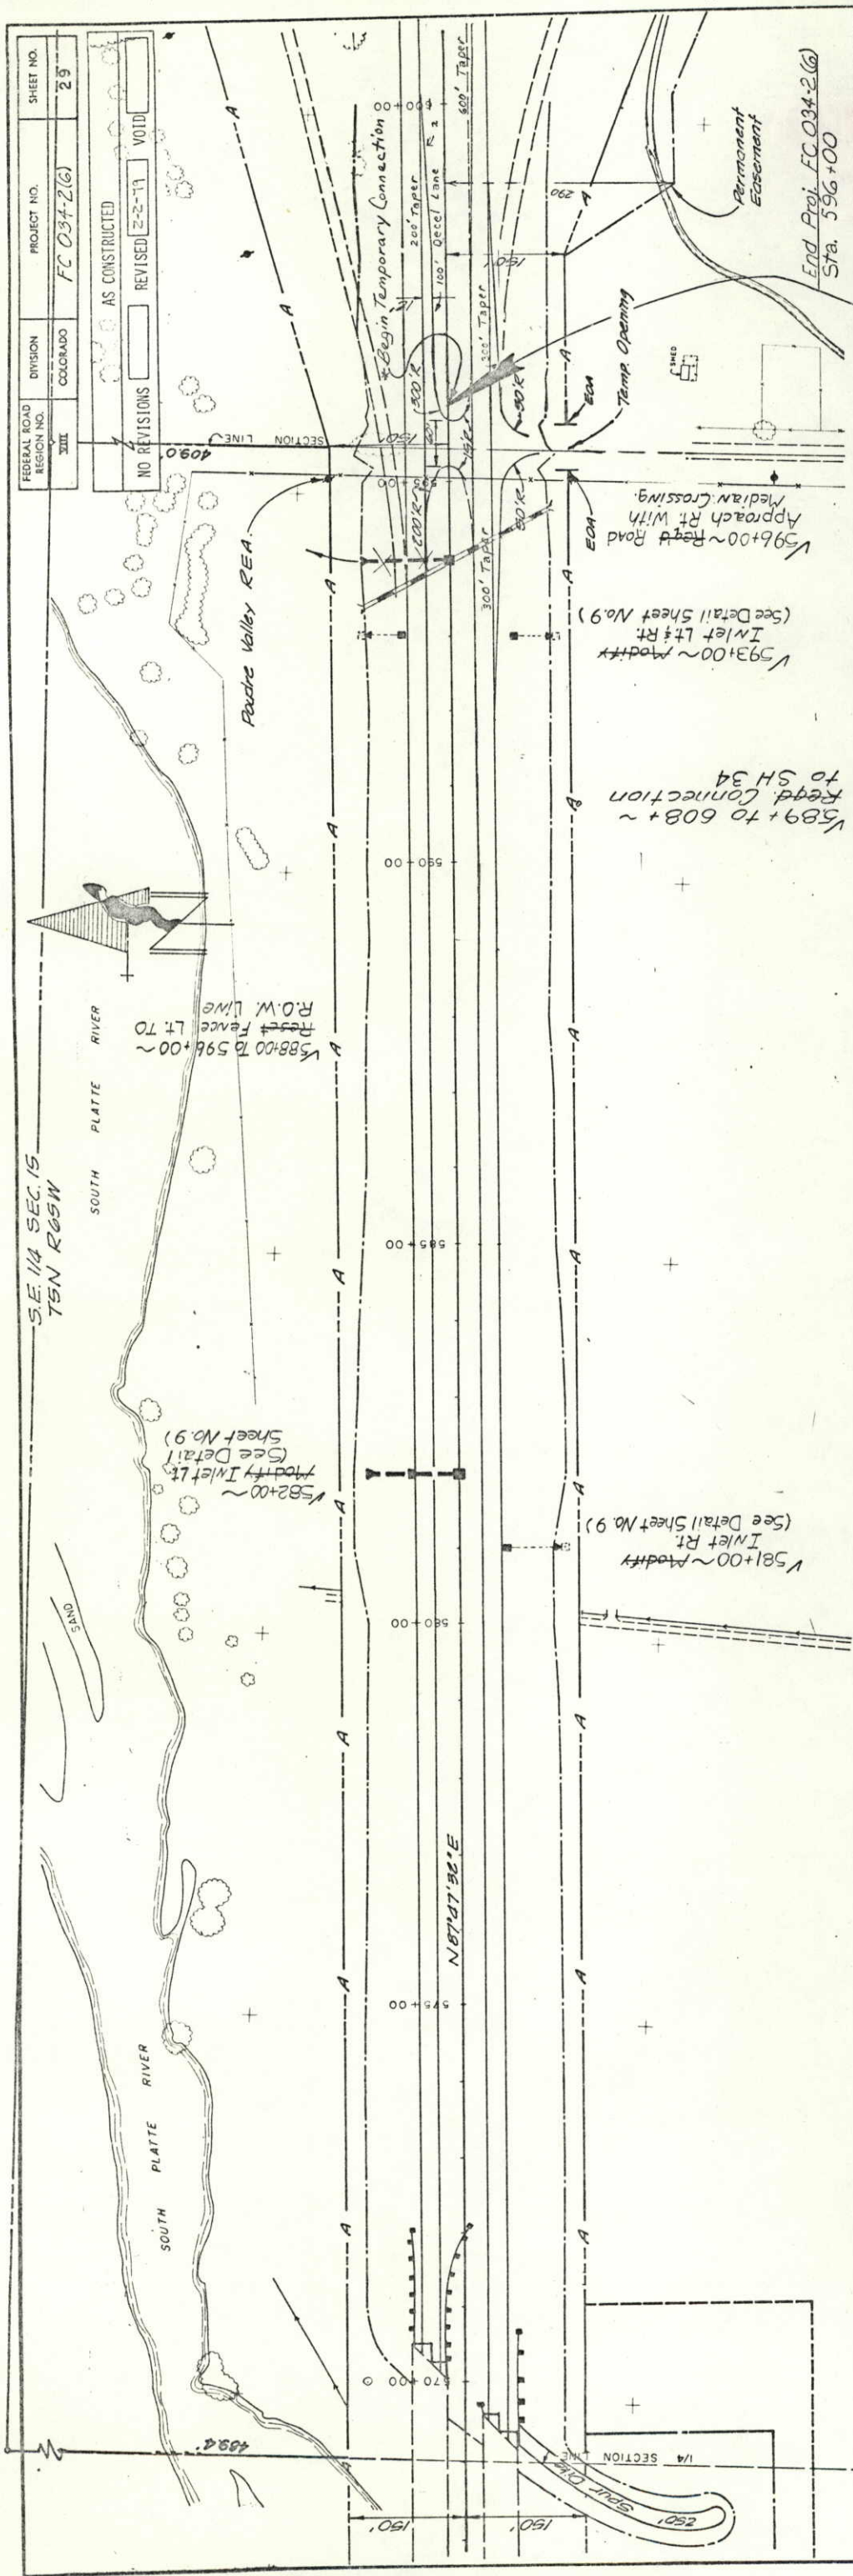

FEDERAL ROAD REGION NO.	DIVISION	PROJECT NO.	SHEET NO.
III	COLORADO	FC 034-2(6)	29

NO REVISIONS	AS CONSTRUCTED	REVISED 2-2-77	VOID
--------------	----------------	----------------	------

NO. 11-A-2 (A)	PI = 588.00	LI = 588.00	HI = 588.00	R = 50
NO. 11-A-2 (B)	PI = 596.00	LI = 596.00	HI = 596.00	R = 50

PLAN	NOTE BOOK	RT. OF WAY CHECKED	DATE
PLANNED	ALIGNED	CHANGED	
PLANNED	ALIGNED	CHANGED	
PLANNED	ALIGNED	CHANGED	
PLANNED	ALIGNED	CHANGED	

PROFILE	NOTE BOOK	STRUCTURE NOTATIONS ON 2D	DATE
PLANNED	ALIGNED	CHANGED	
PLANNED	ALIGNED	CHANGED	
PLANNED	ALIGNED	CHANGED	
PLANNED	ALIGNED	CHANGED	

