


AS CONSTRUCTED		
NO REVISIONS	REVISED	VOID

FED. ROAD REGION	DIVISION	PROJ. NO.	SHEET NO.	SHEET TOTALS
VIII	COLG.	FC 050-1(23)		

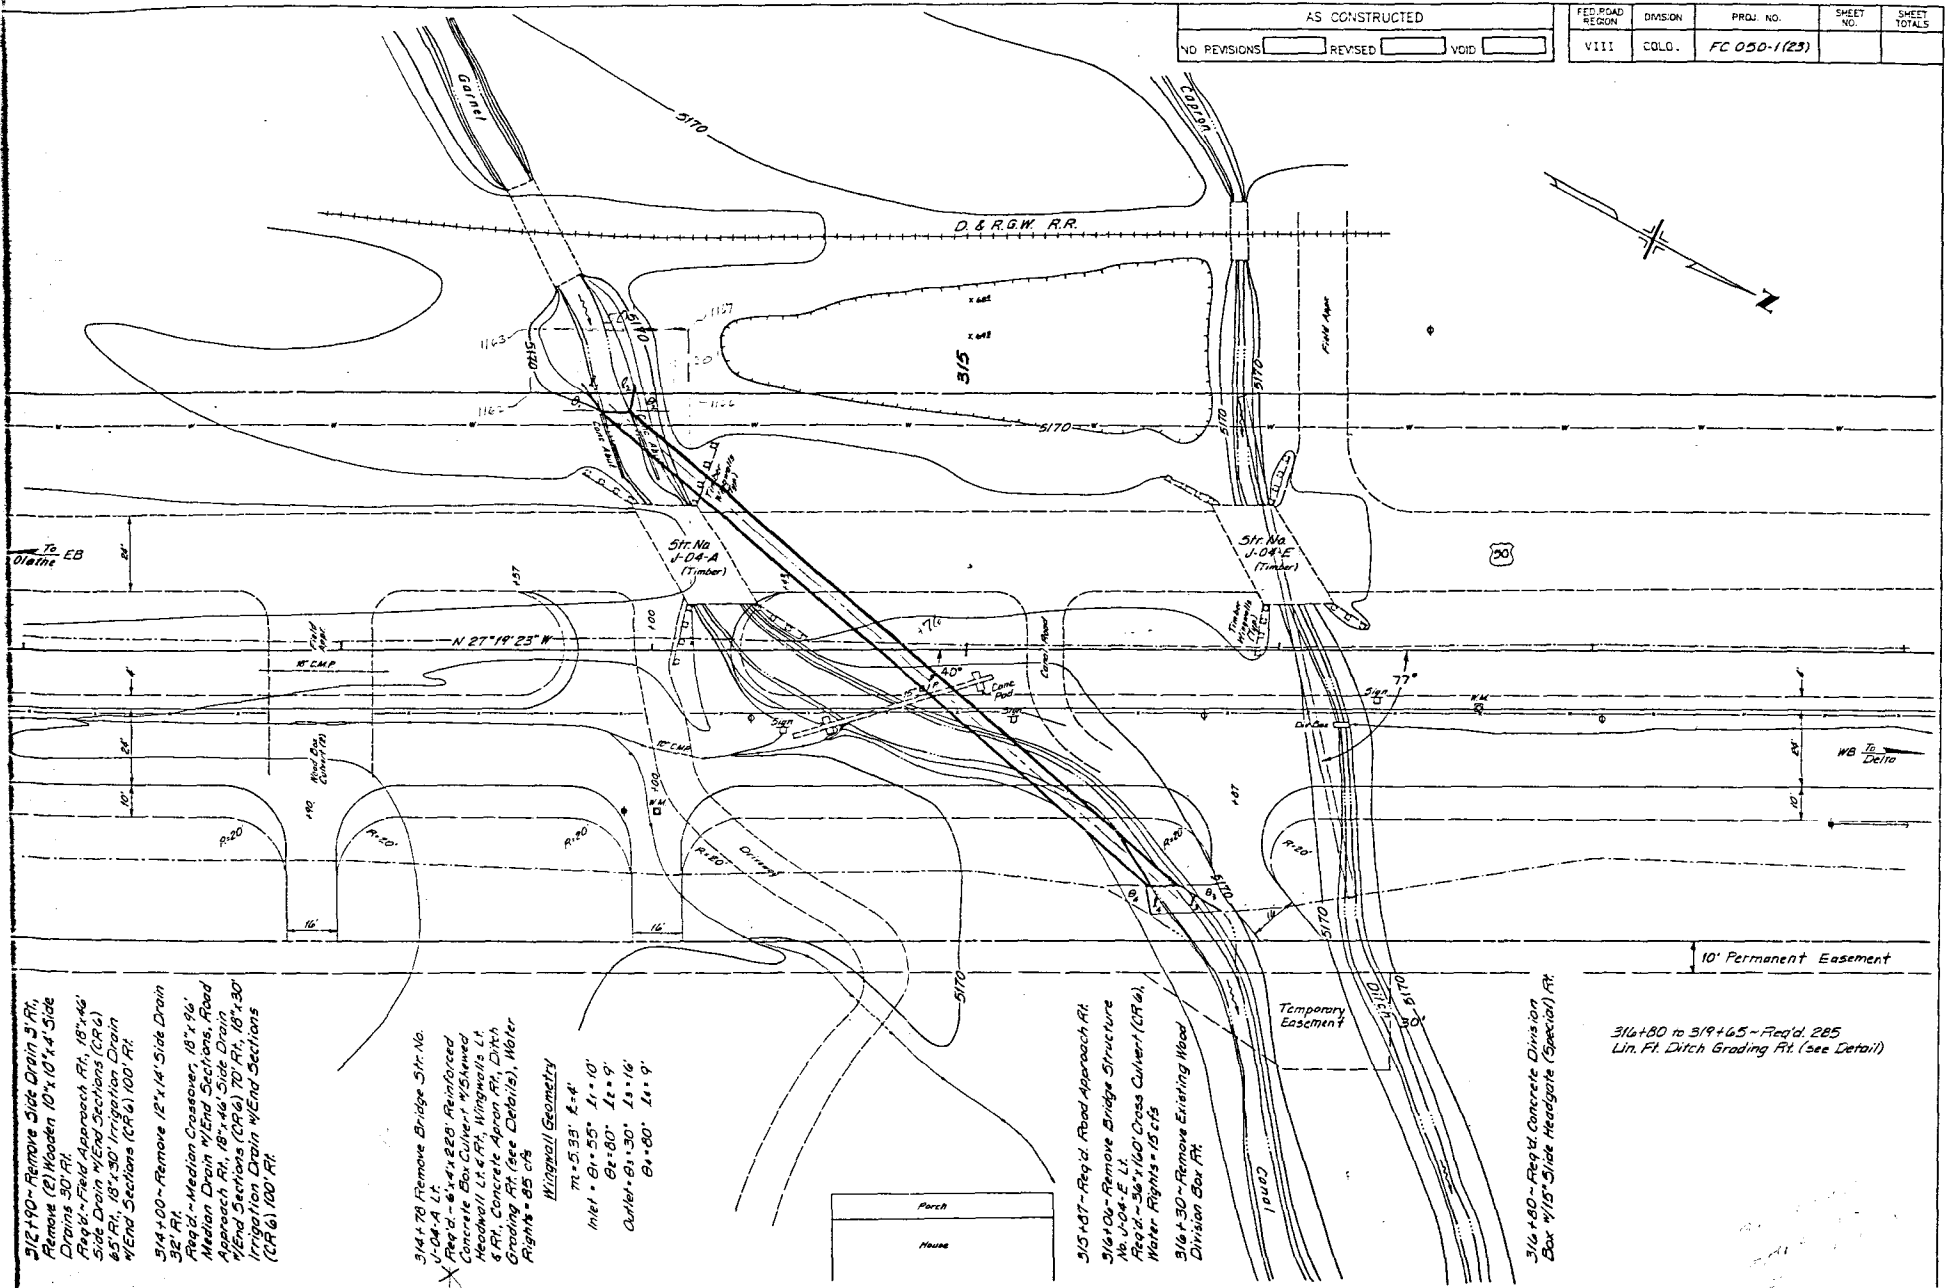

314+40- Remove Side Drain S.R.,
Remove (2) Wooden 10"x10"x4" Side
Drains 30 Ft.
Repl. Field Approach Rt. 18"x14"
Side Drain W/End Sections (CR 6)
65 Ft., 18"x30" Irrigation Drain
W/End Sections (CR 6) 100 Ft.
314+00- Remove 12"x14" Side Drain
32 Ft.
Repl. Median Crossover, 18"x14"
Median Drain W/End Sections, Road
Approach Rt., 18"x14" Side Drain
W/End Sections (CR 6) 70 Ft., 18"x30"
Irrigation Drain W/End Sections
(CR 6) 100 Ft.

314+70 Remove Bridge Str. No.
J-D4-A Lt.
Repl. 6"x4" 280' Reinforced
Concrete Box Culvert W/Shoulders
Headwall Lt. & Rt., Wingwalls Lt.
& Rt., Concrete Apron Rt., Ditch
Grading Rt. (see Detail 5), Water
Rights = 85 cfs
Wingwall Geometry
m=5.33' k=4'
Inlet = 81' 55" Lt = 10'
82' 80" Lt = 9'
Outlet = 81' 30" Lt = 16'
81' 80" Lt = 9'

315+07- Repl. Road Approach Rt.
316+00- Remove Bridge Structure
No. J-D4-E Lt.
Repl. 56"x160" Cross Culvert (CR 6),
Water Rights = 15 cfs
316+30- Remove Existing Road
Division Box Rt.

316+40- Repl. Concrete Division
Box w/15' Side Headgate (Special Rt.)

316+80 to 319+65- Repl. 285'
Lin. Ft. Ditch Grading Rt. (see Detail)