



COLORADO
Department of
Transportation

DOCUMENT SEPARATOR SHEET

REGION 5 – JUNE 2017 CONVERSION

To be placed at the beginning of each separator sheet.



r500001450

Description:

ROW Plans 24X36

Route # and Mile Points:

US 550

Originating Office:

ROW/Survey

File Name:

FC 550-2(9) SEC 2 _ROW(.PDF)

Box Location:

24 (TUBE-12)of 38

FC 550-2(a)
Sec 2

STATE DEPARTMENT OF HIGHWAYS

DIVISION OF HIGHWAYS—STATE OF COLORADO

CONVENTIONAL SIGNS

County Line
Township or Range Line
Land Lines
Property or Tract Line
City Limits
Railroad
Existing Road
New Road

Control of Access
Access denied by Dead
Right of Way Line
Protected by Freeway (Virgin Location)
Top of Cuts
Toe of Fills
Barbed Wire Fence
Chain Link Fence
Woven Wire-Combination Fence
Snow Fence
Wood Fence
Dear Fence

Trees
Deciduous
Coniferous

Tel & Teleg. Lines
Electric Lines
Elec. Trans. Tower
Buried Tel Cable
Buried Electric Cable
Gas Main
Oil Main
Water Main
Sanitary Sewers
Storm Sewers

Road Approaches
Section Corner
Center of Section

Culverts & Drains
Proposed
Existing
Proposed
Existing (To be dashed)

Bridges

RIGHT OF WAY PLAN OF PROPOSED FEDERAL AID PROJECT NO. FC 550-2(9) Sec. 2 STATE HIGHWAY NO. 550 LA PLATA COUNTY

RIGHT OF WAY


SCALE OF ORIGINAL DRAWINGS

PLAN SHEETS 1" = 100'
TOTAL OWNERSHIP MAP 1" = 500'

LENGTH OF PROJECT = 2.52 MILES

STA. 403+12.61 END R.O.W. PROJ. FC 550-2(9) Sec. 2

STA. 270+01.61 BEGIN R.O.W. PROJ. FC 550-2(9) Sec. 2

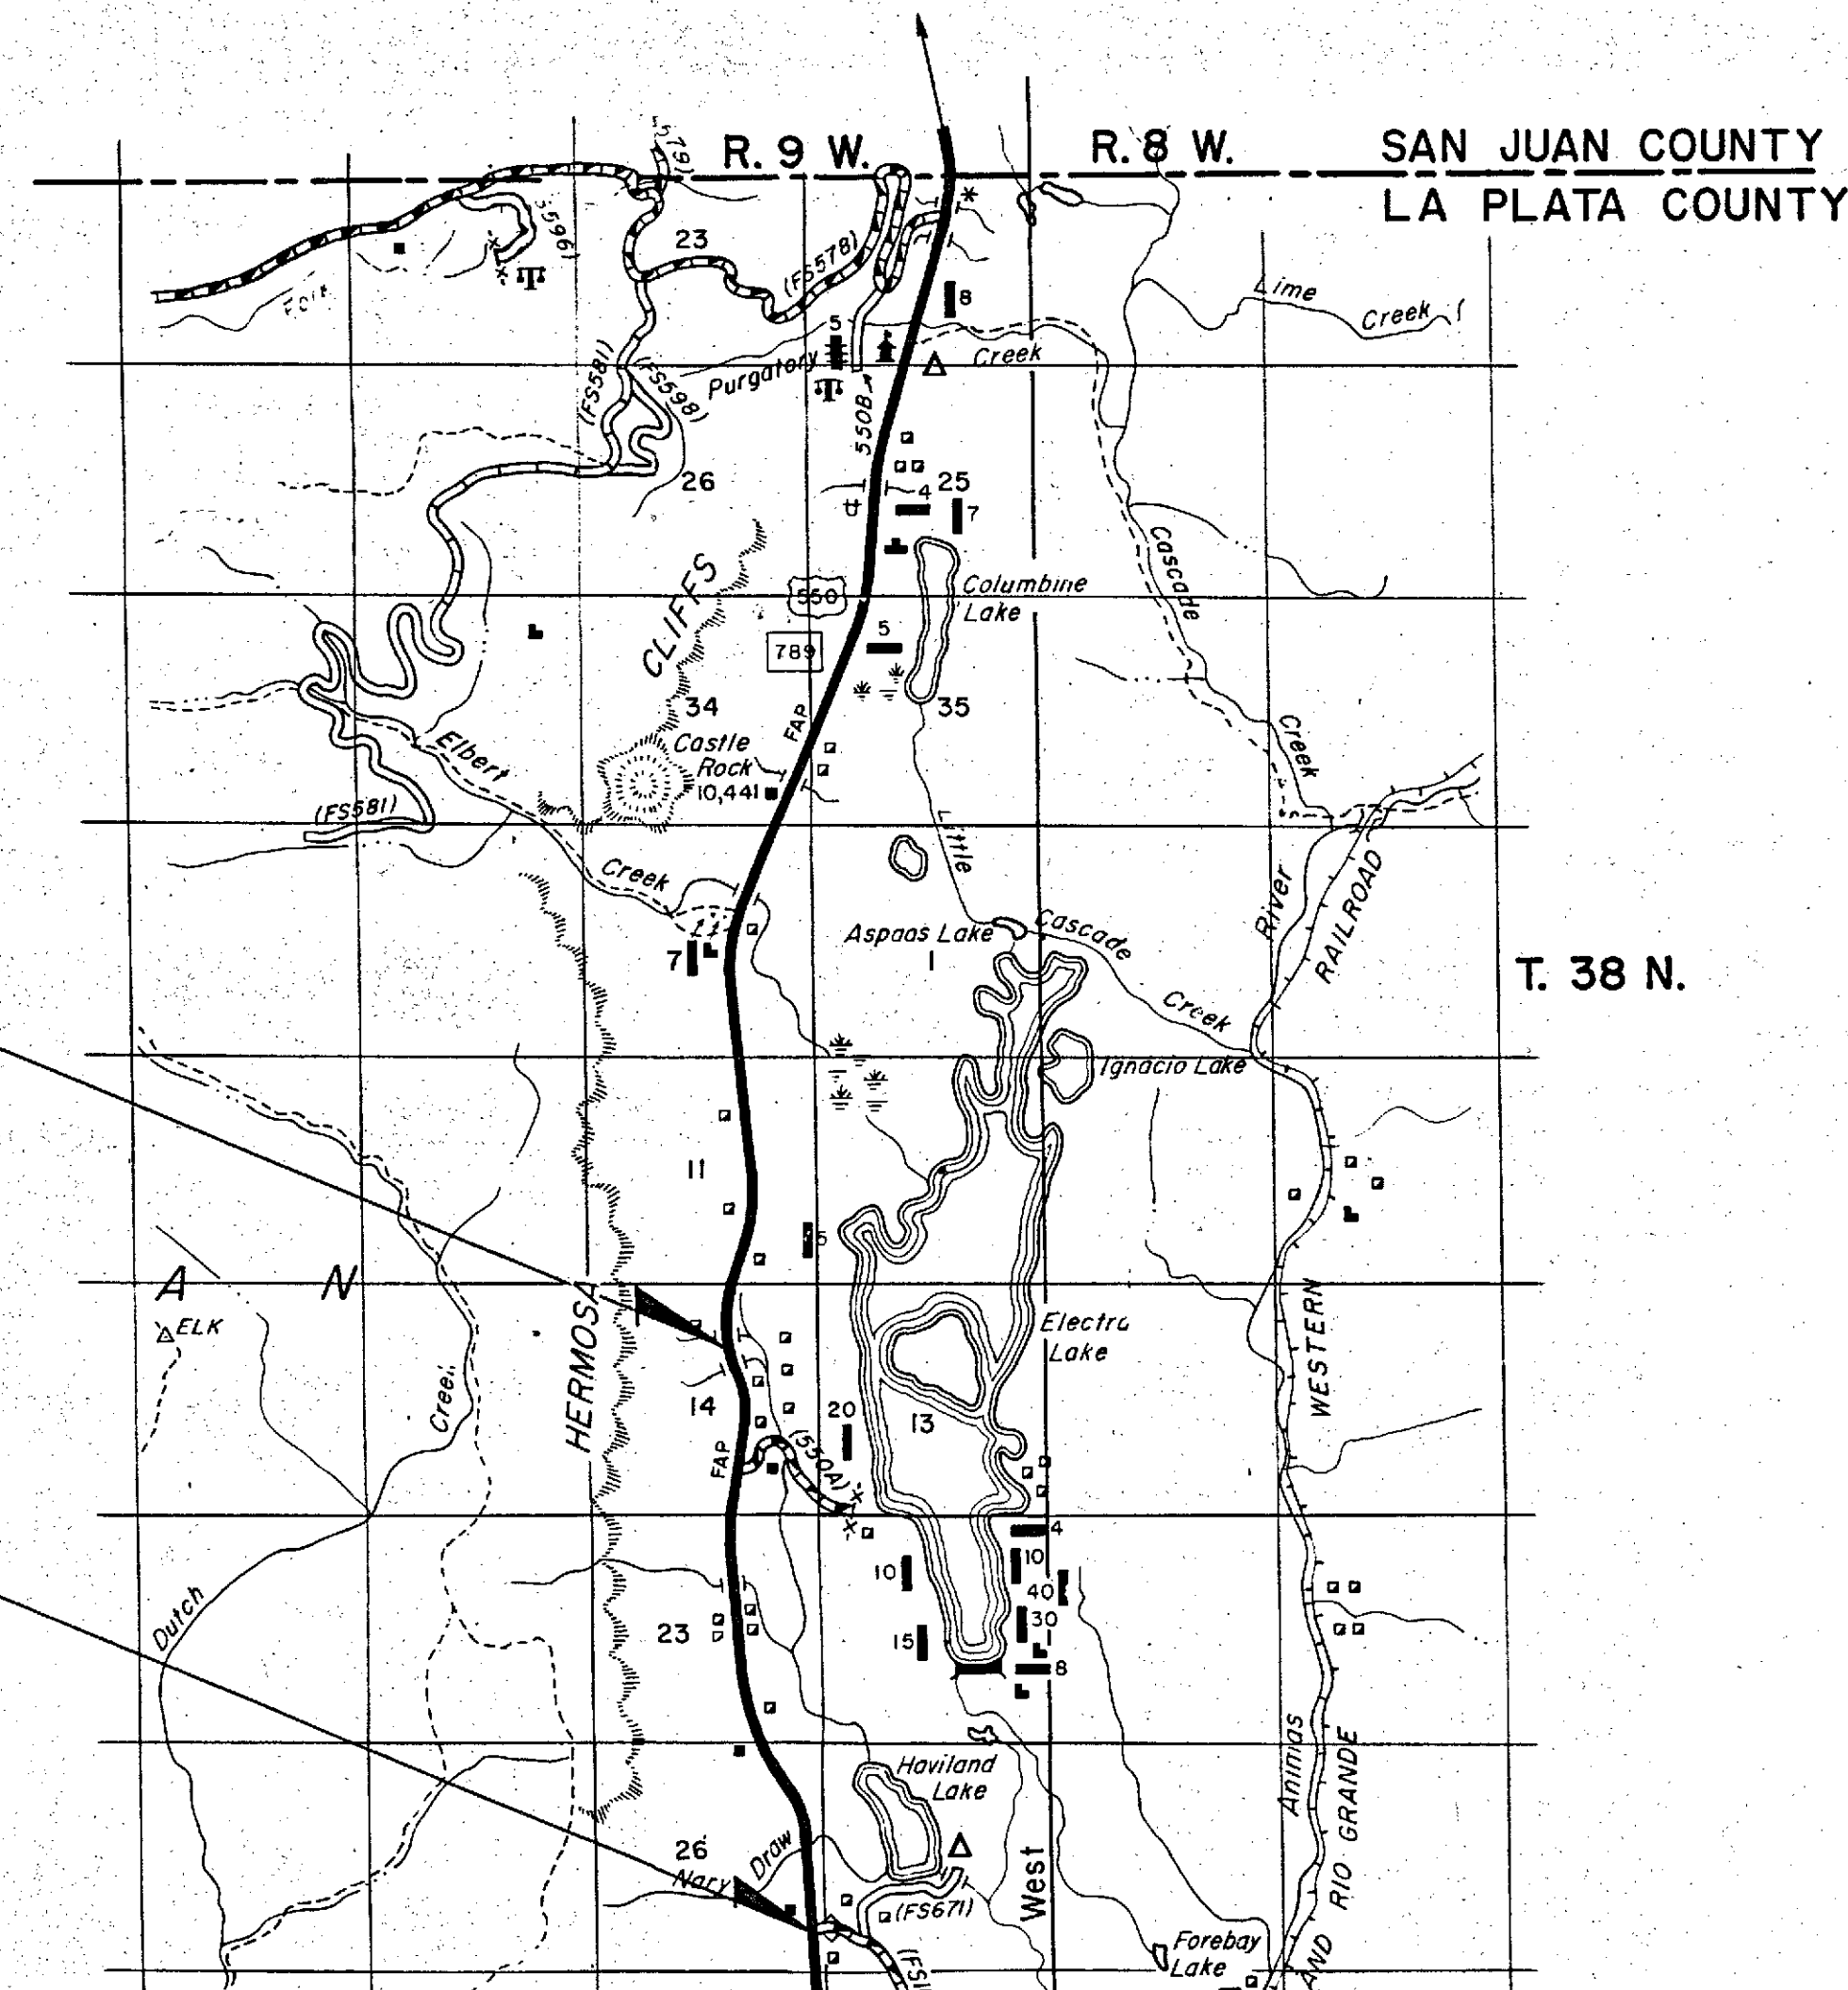

0 1 2
SCALE IN MILES

FEDERAL ROAD REGION NO.	DIVISION	PROJECT NO.	SHEET NO.
VIII	COLORADO	FC 550-2(9) Sec. 2	1

RIGHT OF WAY
ROCKWOOD TO PURGATORY

REVISIONS

INDEX OF SHEETS

- (1) TITLE SHEET
- (2-2F) TABULATION OF PROPERTIES
- (3-8) PLAN SHEETS
- (9) TOTAL OWNERSHIP MAP

DIVISION OF HIGHWAYS

APPROVED:

CHIEF ENGINEER

4/1/82
DATEDEPARTMENT OF TRANSPORTATION
FEDERAL HIGHWAY ADMINISTRATION

APPROVED:


DATE

DIVISION ADMINISTRATOR

FEDERAL ROAD REGION NO.	DIVISION	PROJ. NO.	SHEET NO.	TOTAL SHEETS
VIII	COLORADO	FC 550-2(9) Sec. 2	3	9

RIGHT OF WAY
ROCKWOOD TO PURGATORY

REVISIONS	

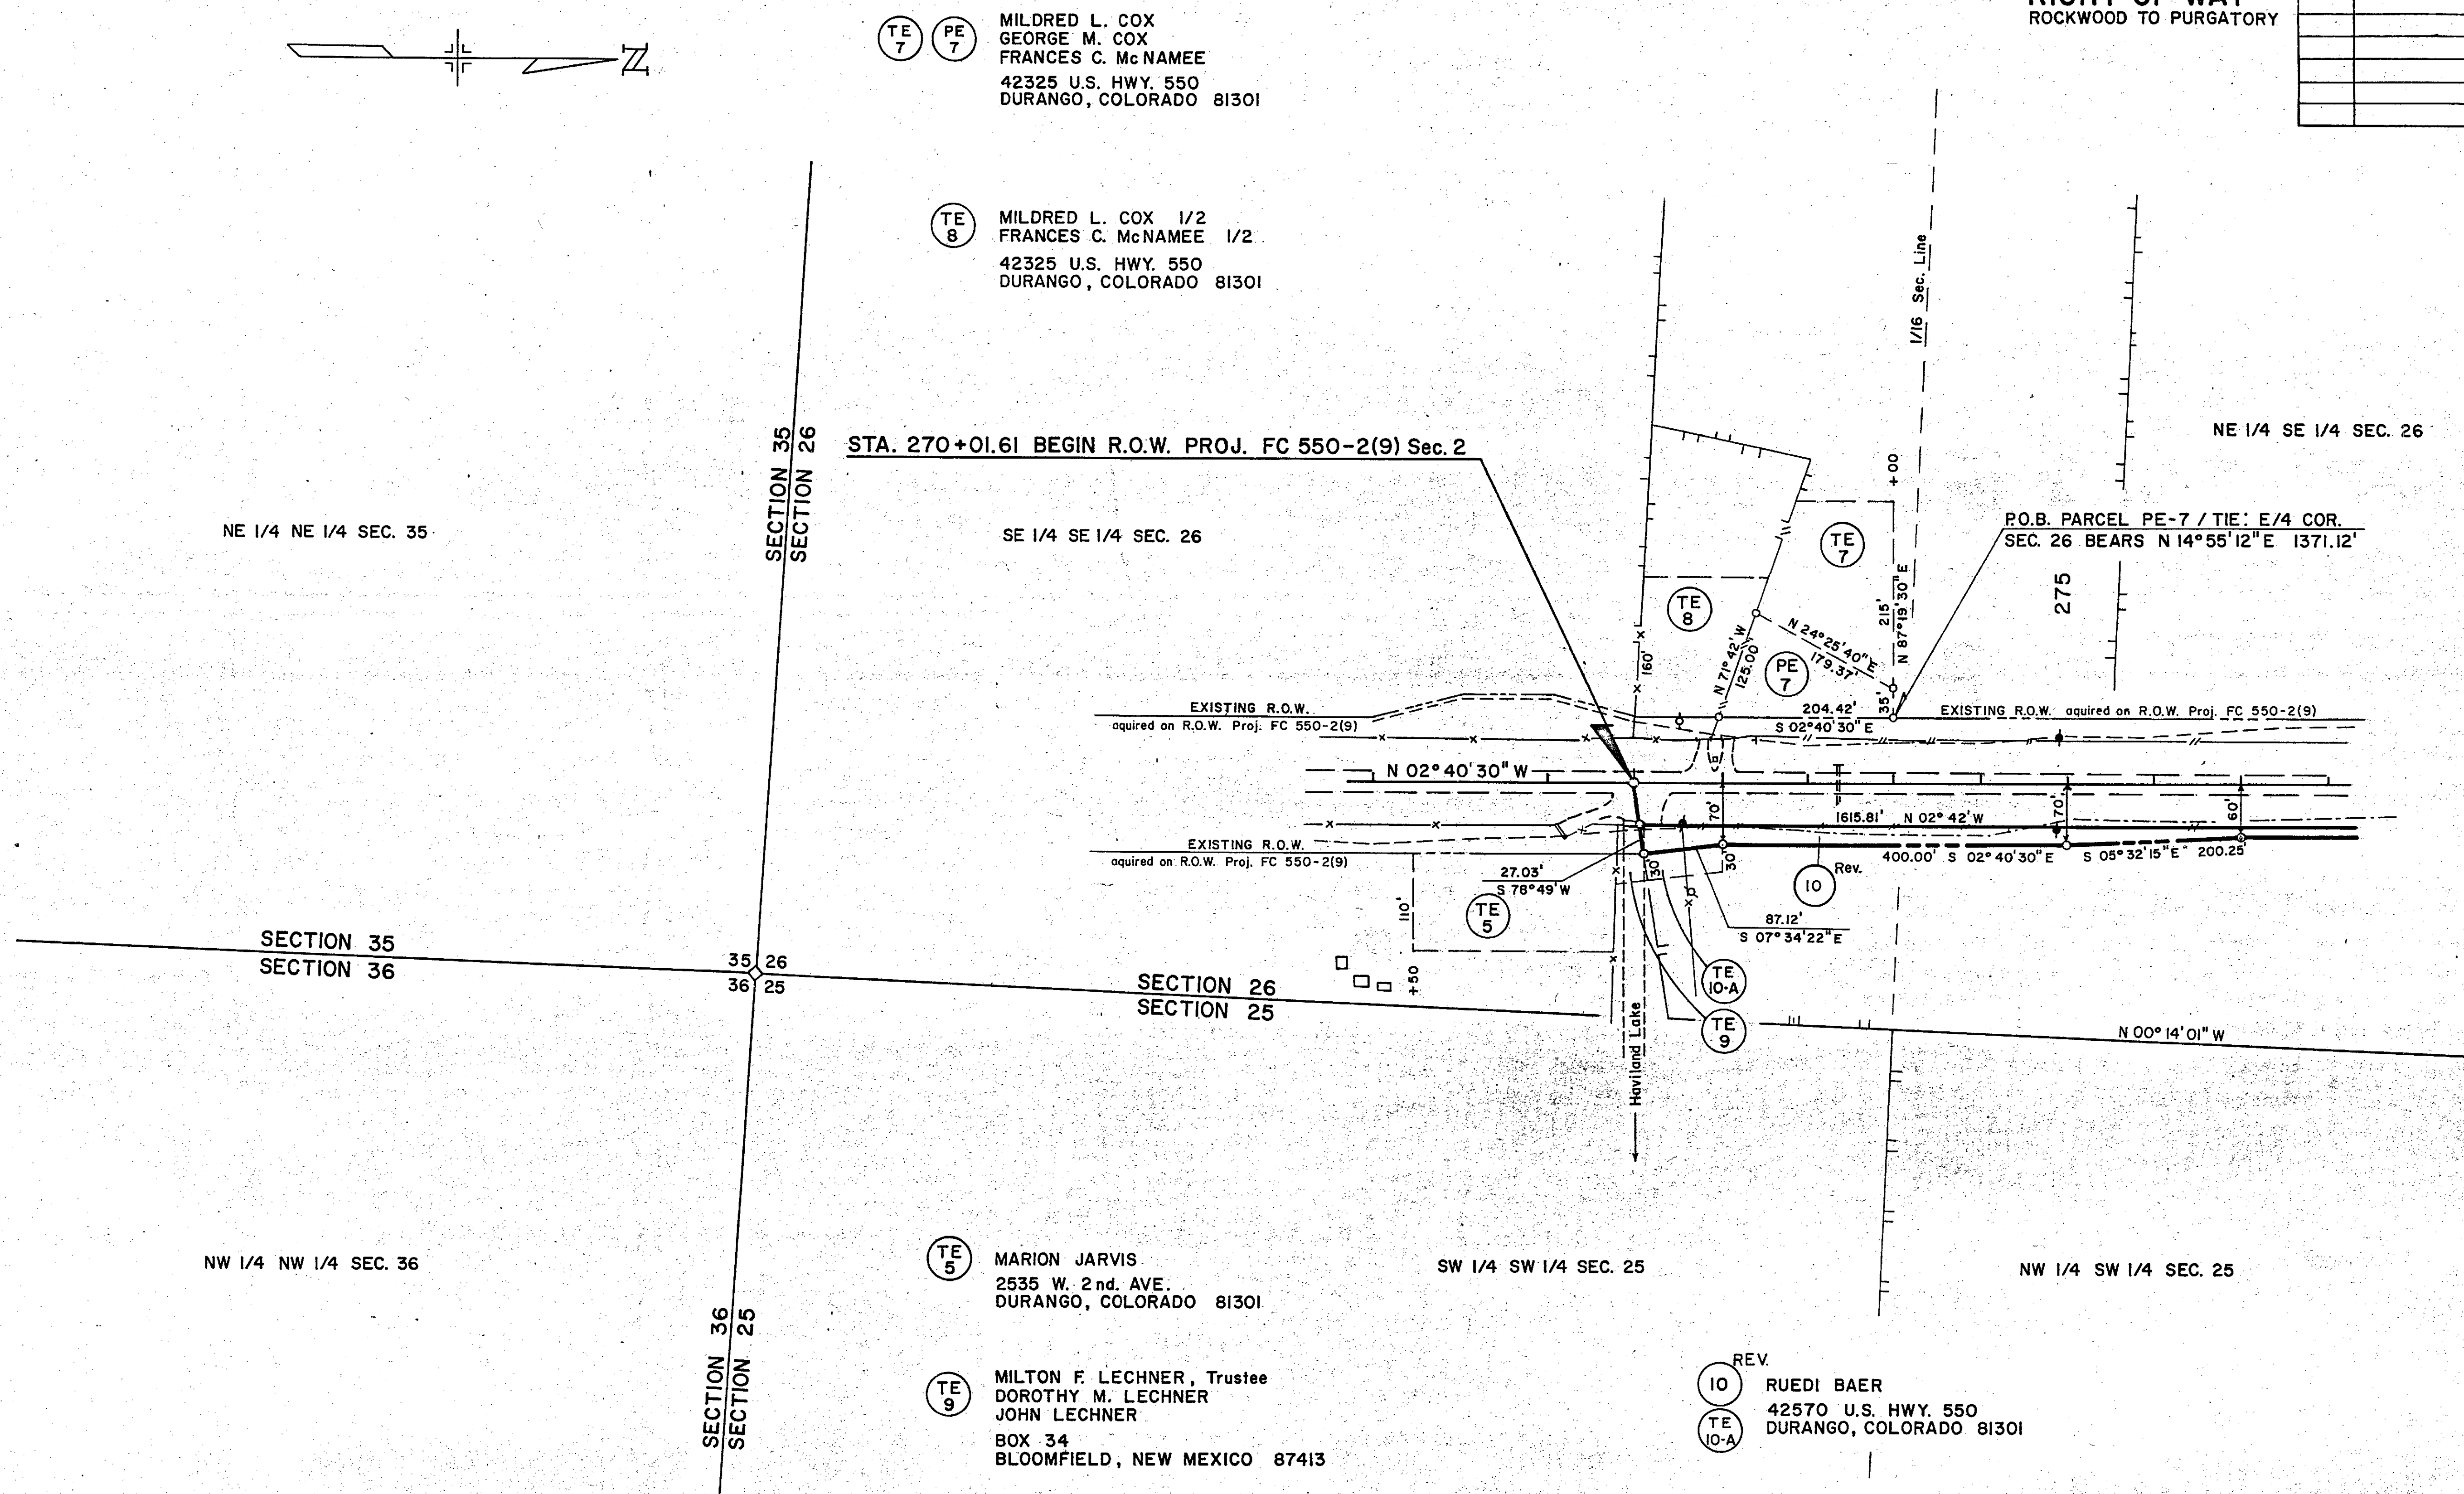

FEDERAL ROAD REGION NO.	DIVISION	PROJ. NO.	SHEET NO.	TOTAL SHEETS
VIII	COLORADO	FC 550-2(9) Sec. 2	4	9


RIGHT OF WAY
ROCKWOOD TO PURGATORY

REVISIONS	

13 STATE OF COLORADO (GAME & FISH)
151 EAST 16th STREET
DURANGO, COLO. 81301

$\Delta = 34^{\circ}00'$
 $\Delta_c = 27^{\circ}00'$
 $D_c = 3^{\circ}30'$
 $R_c = 1637.02'$
 $L_c = 771.43'$
 $T_s = 600.79'$
 $E = 75.90'$
 $\theta_s = 3^{\circ}30'$
 $L_s = 200.00'$
 $L.T. = 133.36'$
 $S.T. = 66.69'$

PROJ.
 $\Delta = 34^{\circ}00'$
 $T_s = 800.90'$
 $\Delta_c = 29^{\circ}00'$
 $D_c = 2^{\circ}30'$
 $L_c = 1160.00'$
 $R_c = 2291.83'$
 $\theta_s = 2^{\circ}30'$
 $L_s = 200.00'$
 $L.T. = 133.35'$
 $S.T. = 66.68'$

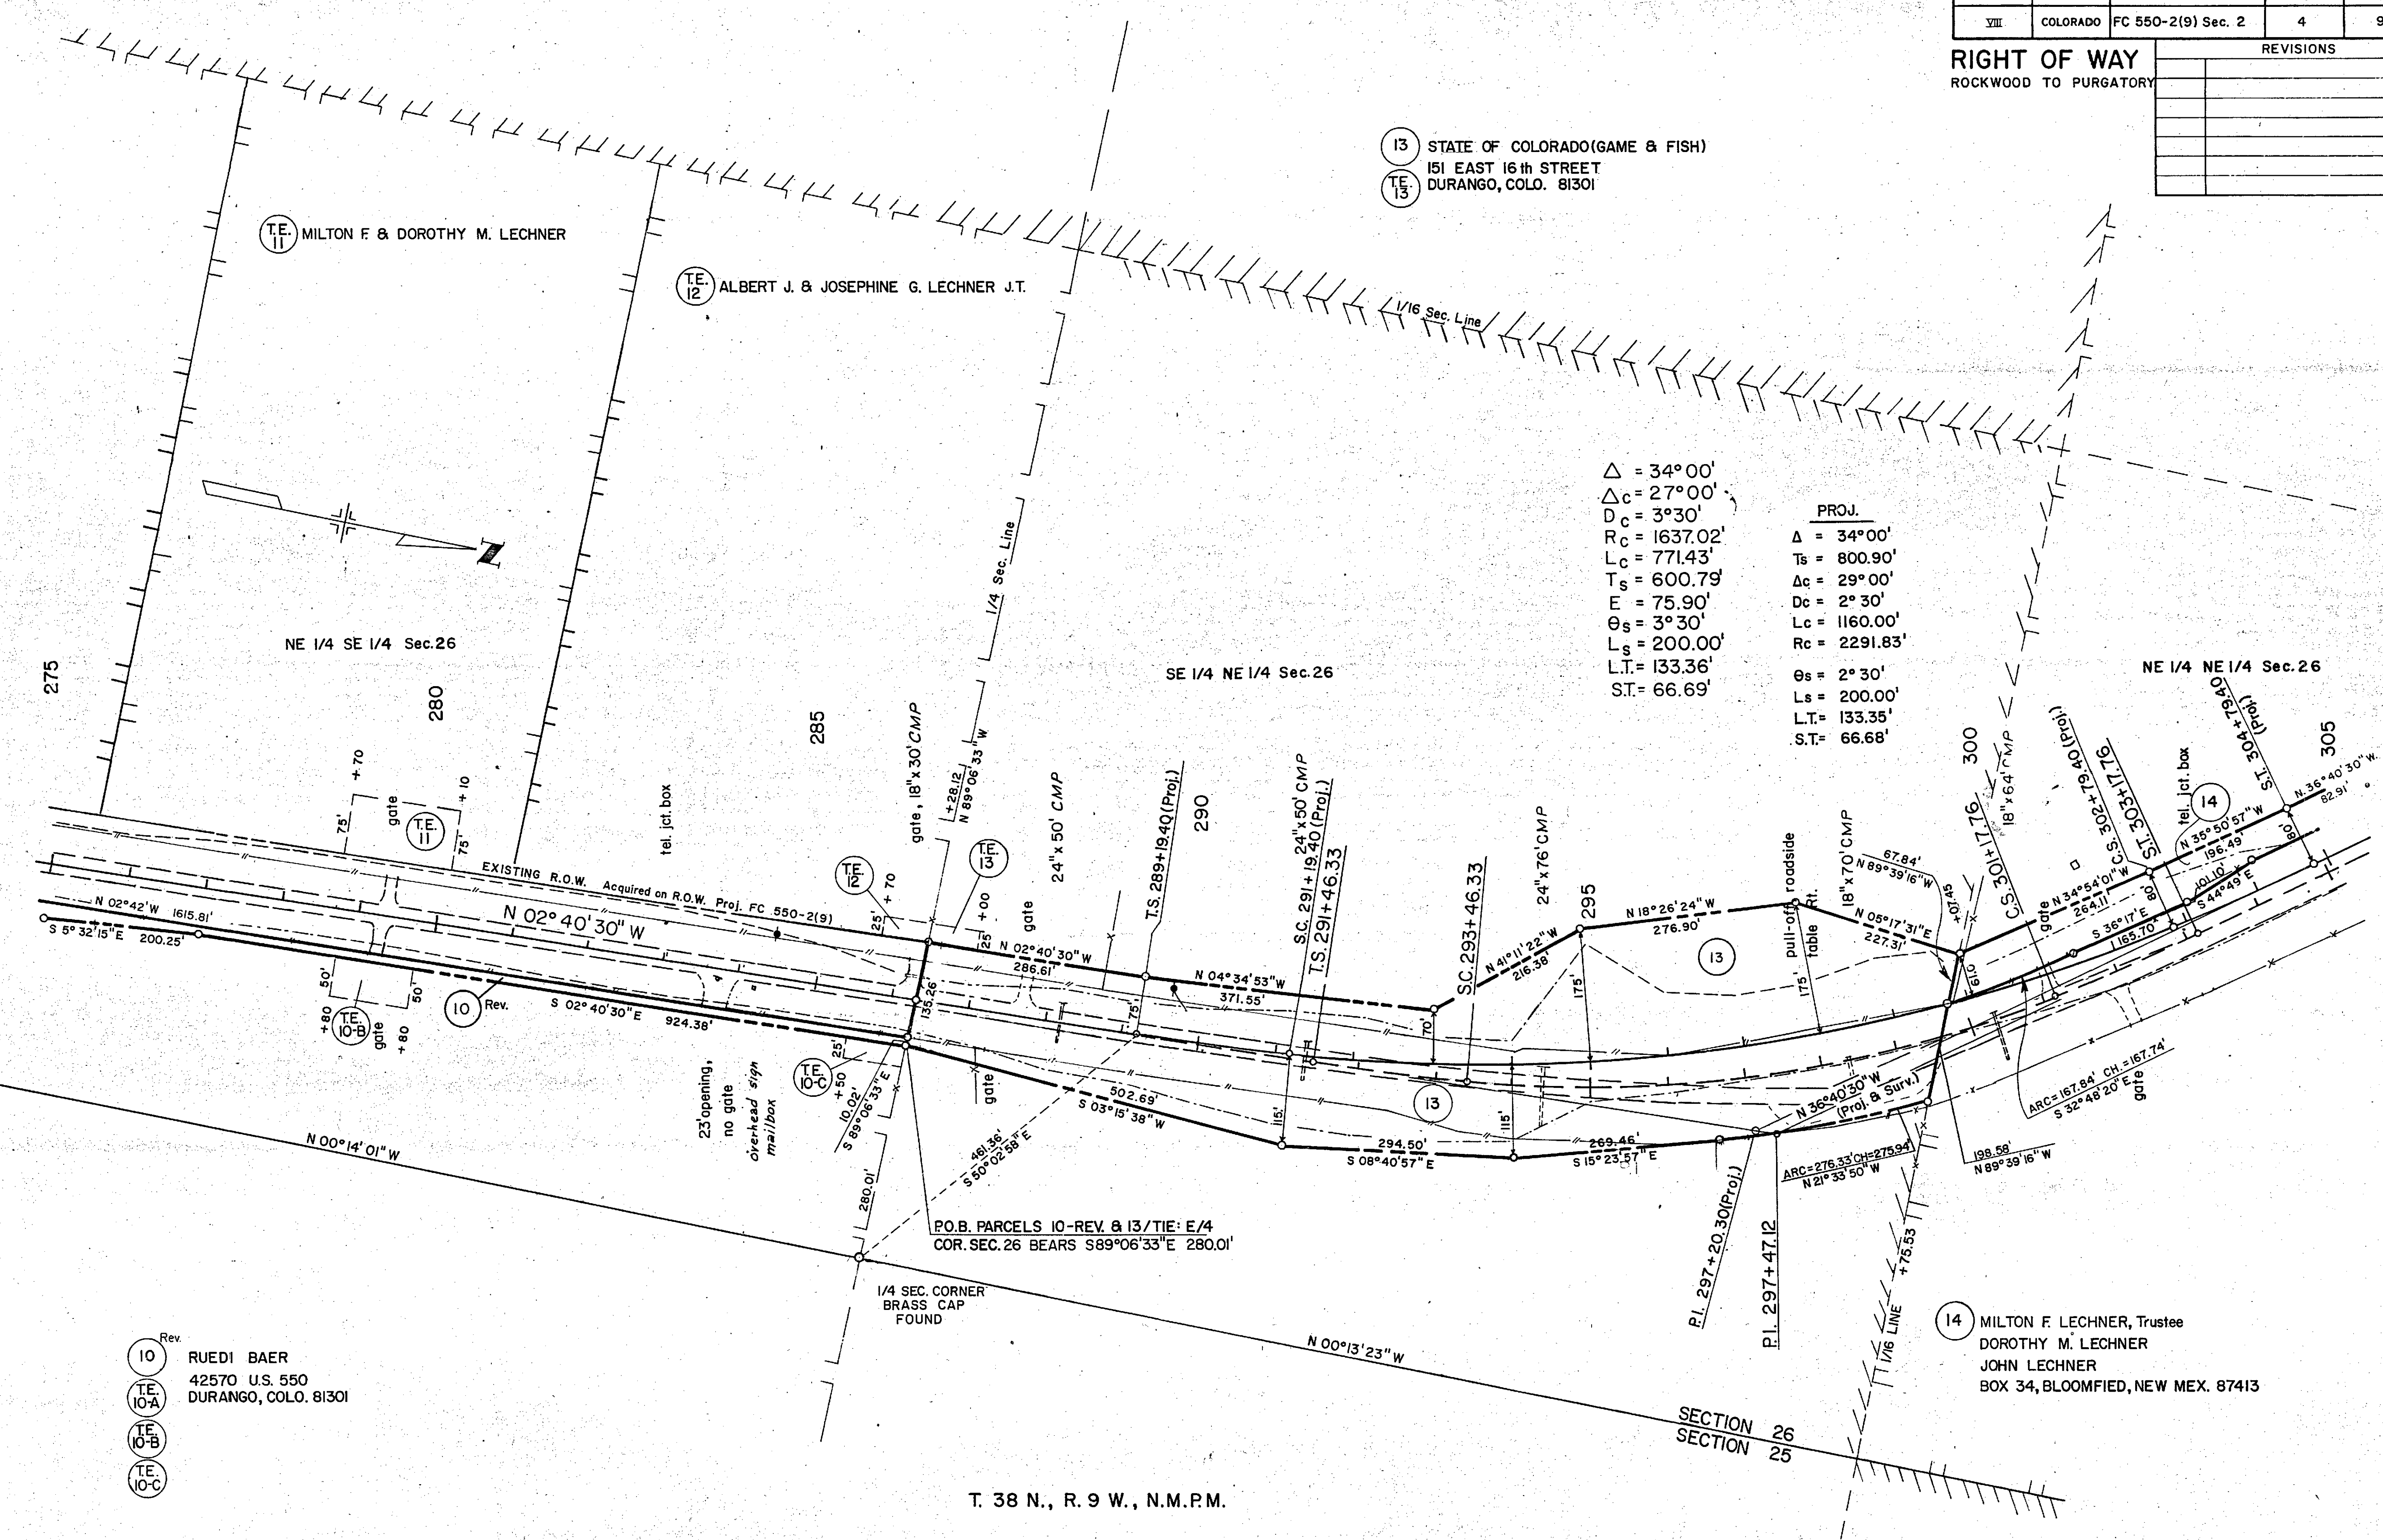

Rev.
10 RUEDI BAER
TE 10-A 42570 U.S. 550
TE 10-B DURANGO, COLO. 81301
TE 10-C


14 MILTON F. LECHNER, Trustee
DOROTHY M. LECHNER
JOHN LECHNER
BOX 34, BLOOMFIED, NEW MEX. 87413

T. 38 N., R. 9 W., N.M.P.M.

FEDERAL ROAD REGION NO.	DIVISION	PROJ. NO.	SHEET NO.	TOTAL SHEETS
VIII	COLORADO	FC 550-2(9) Sec. 2	5	9

RIGHT OF WAY
ROCKWOOD TO PURGATORY


REVISIONS		
6-7-84	Correct bearing of CL	C.P.
9-11-84	Correct Par 17, 18, 19	E.M.

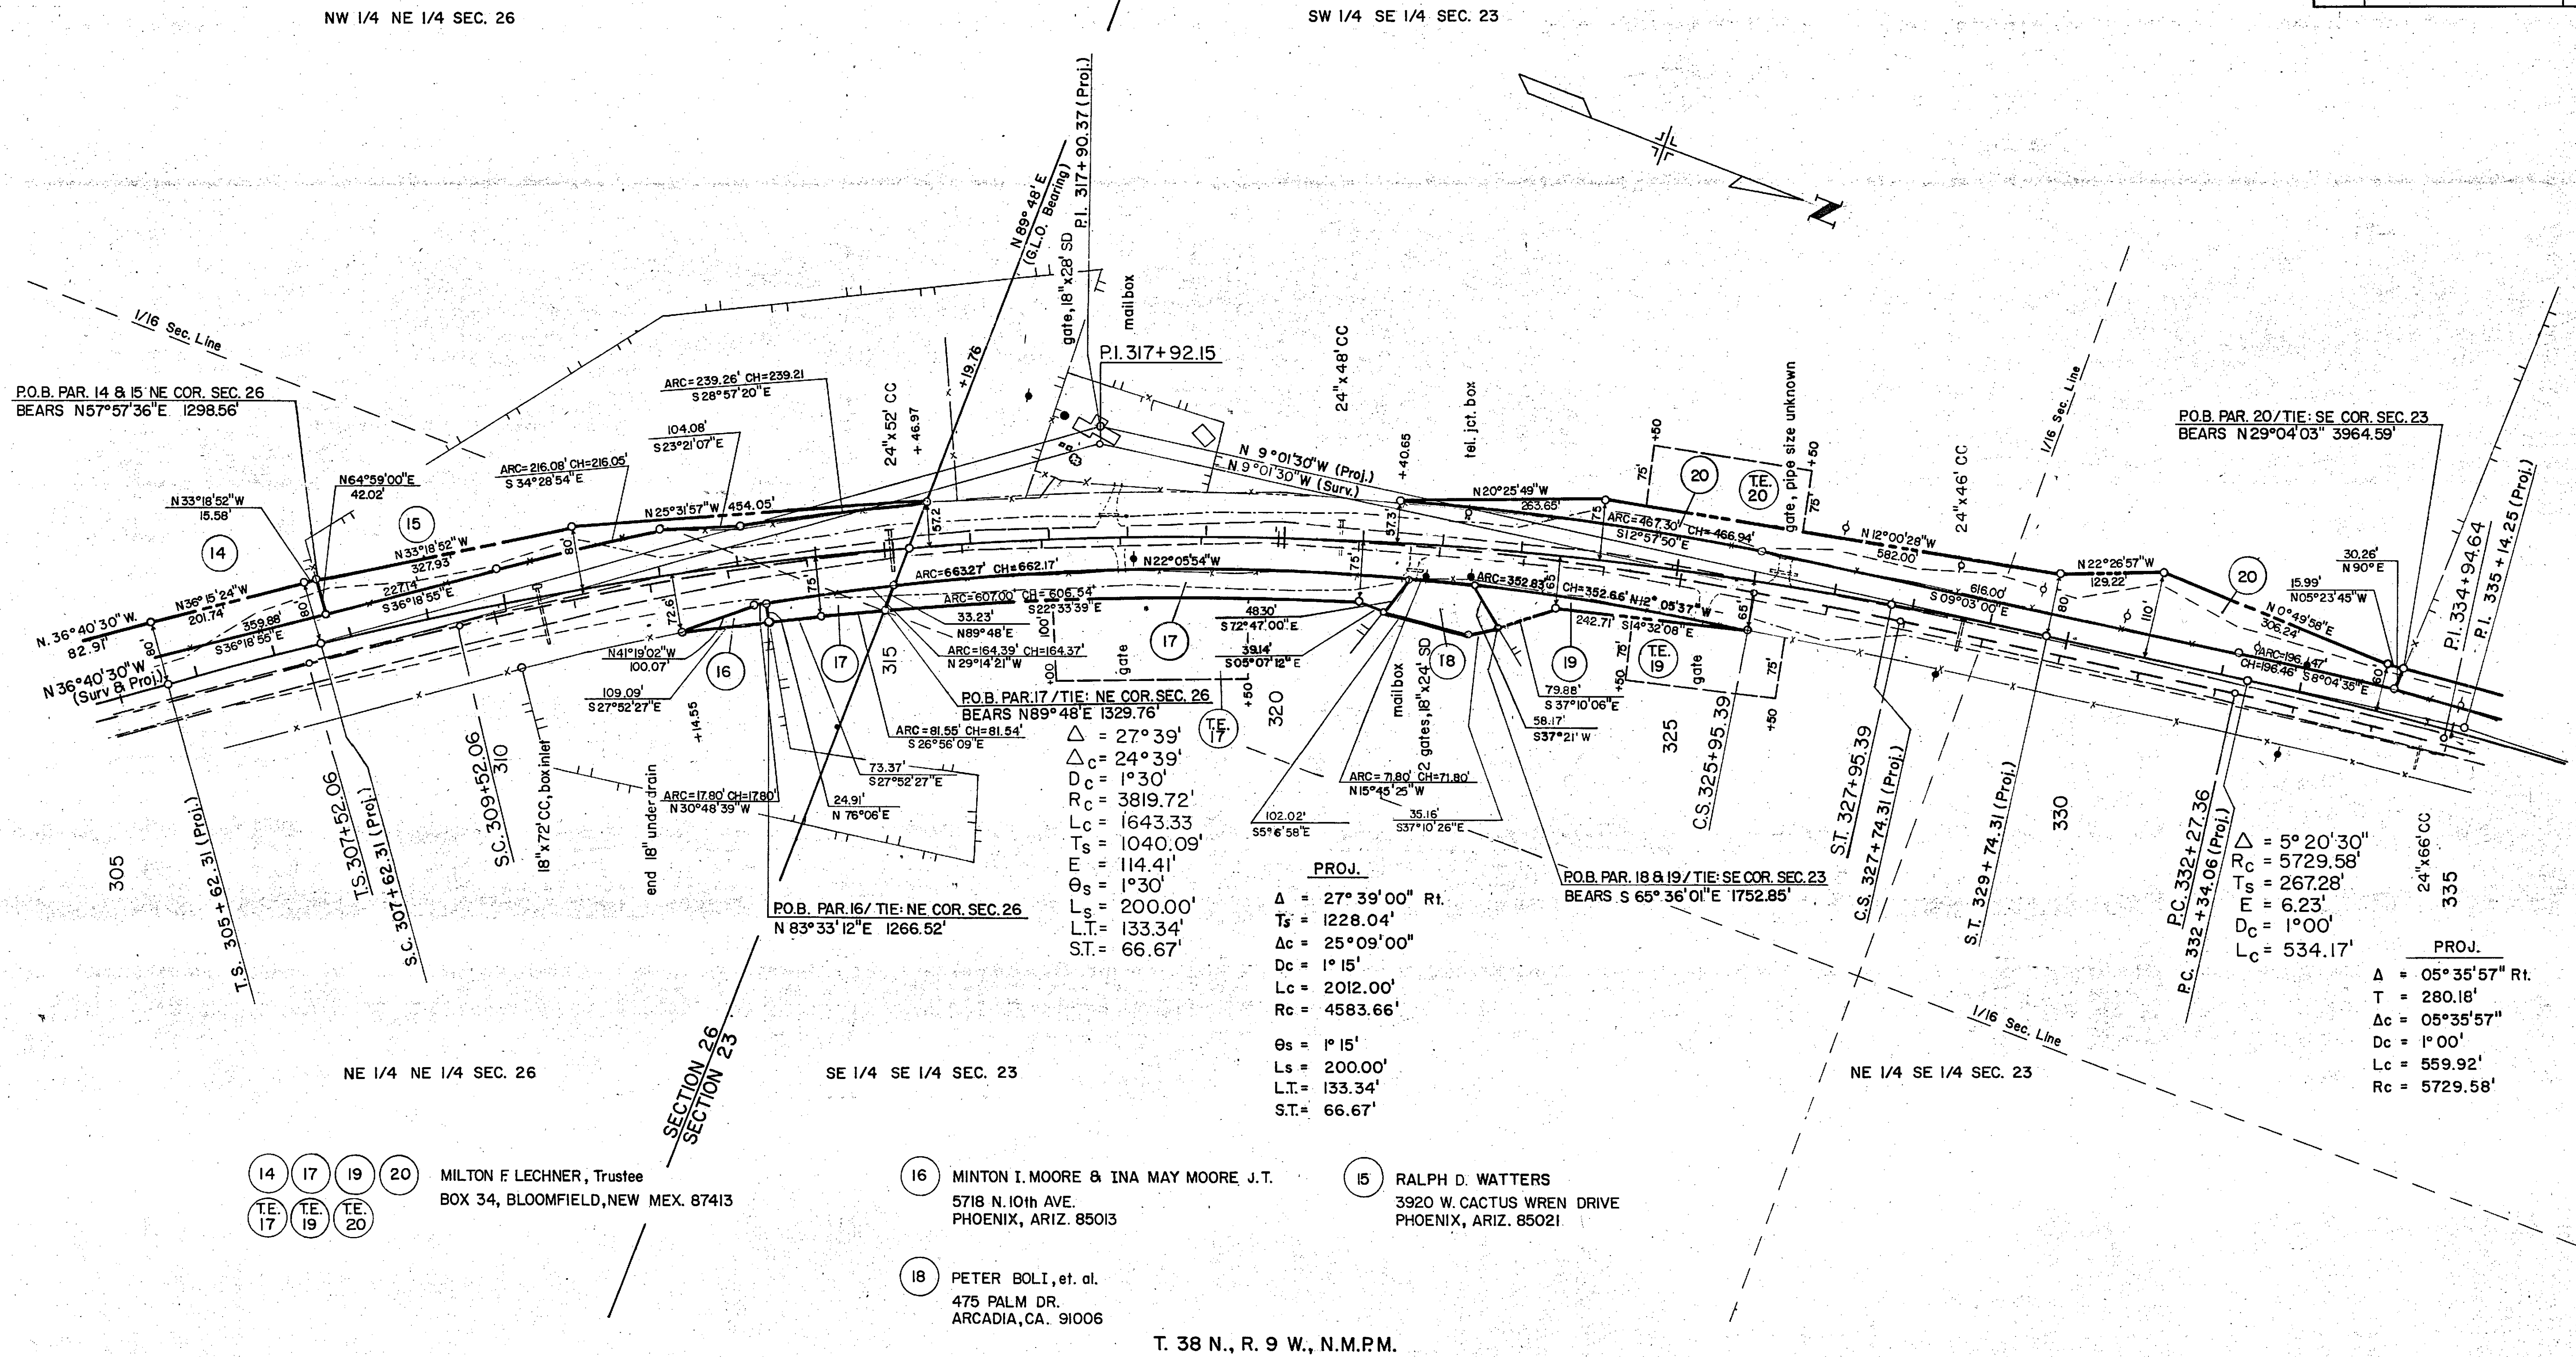

NOTE: PARCEL 21-A ~ JAMES R. FLACK to PAUL REED

FEDERAL ROAD REGION NO.	DIVISION	PROJ. NO.	SHEET NO.	TOTAL SHEETS
VIII	COLORADO	FC 550-2(9) Sec. 2	6	9

RIGHT OF WAY		REVISIONS	
ROCKWOOD TO PURGATORY		9/17/82	Name Change 23 & TE-23
		3-14-83	Rev. Par. 29, Added 29A
		12-9-85	Added PAR. 21-A
			Show Transfer of PAR. PE. 26

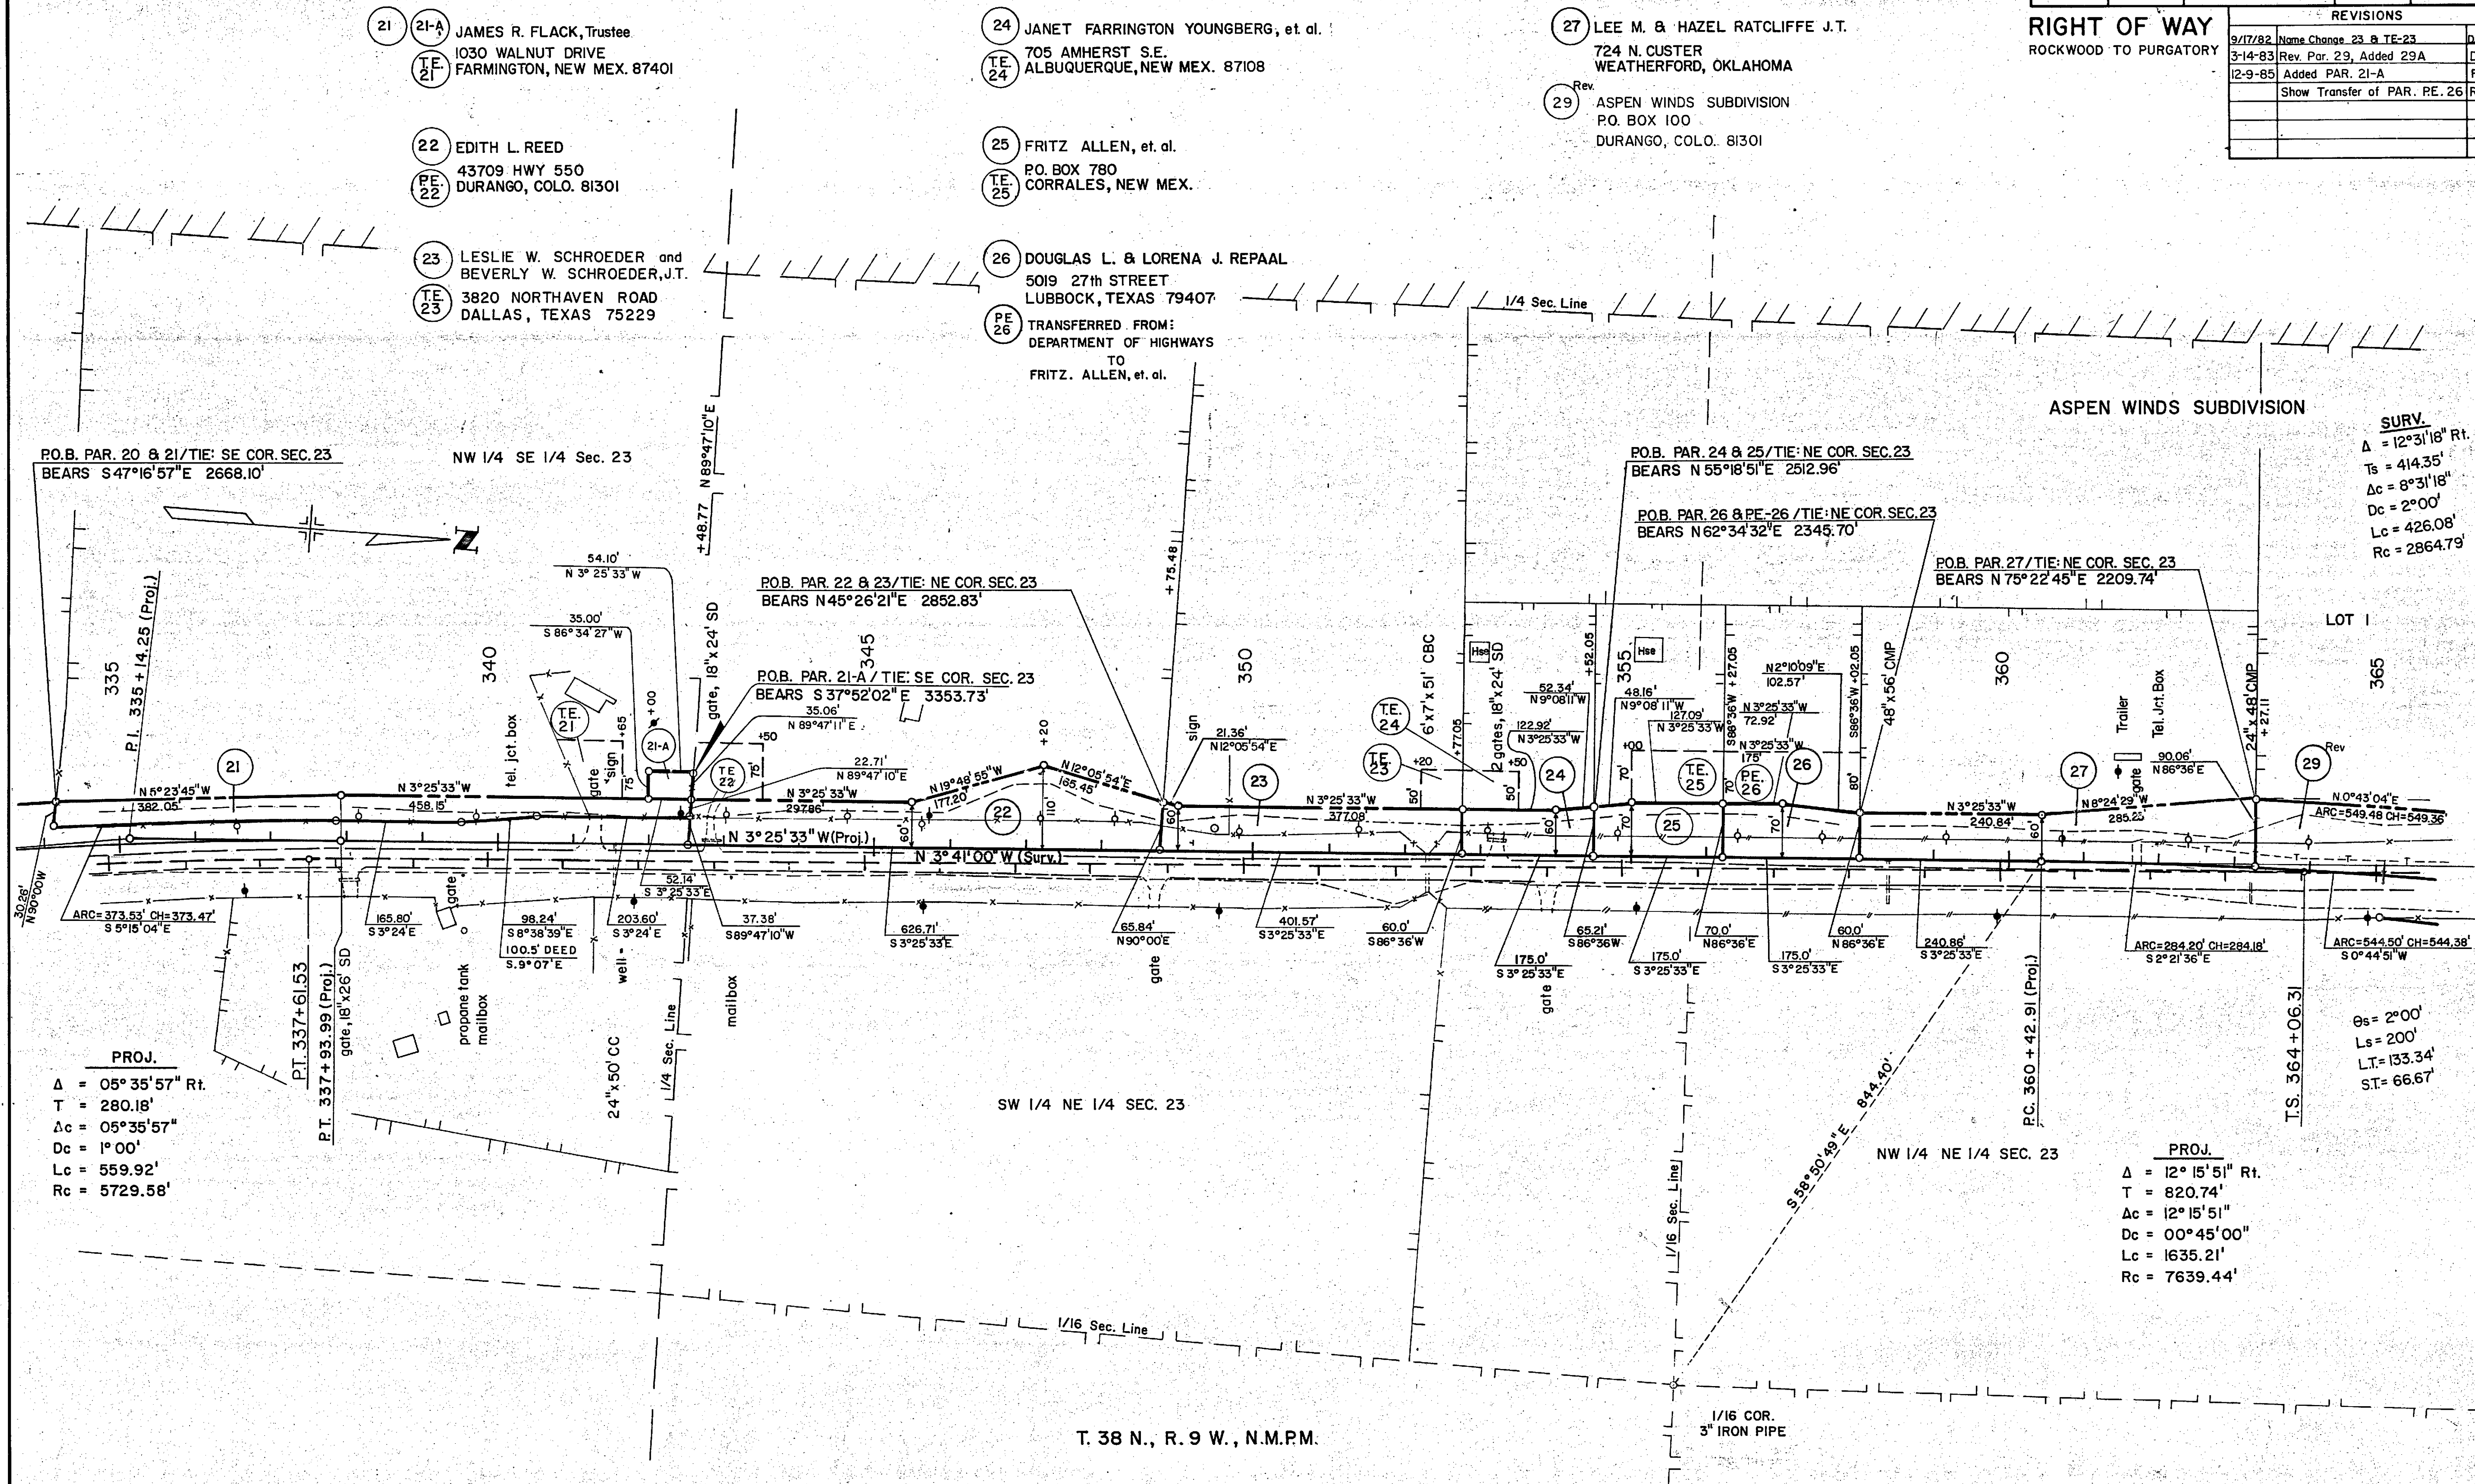


FEDERAL ROAD REGION NO.	DIVISION	PROJ. NO.	SHEET NO.	TOTAL SHEETS
VIII	COLORADO	FC 550-2(9) Sec. 2	7	9


REVISIONS		
3-14-83	Rev. Par. 29, Added 29A	D.M.
6-7-84	Par. 28, Corr. course 3	C.P.

RIGHT OF WAY
ROCKWOOD TO PURGATORY

PROJ. & SURV.

$\Delta = 31^{\circ}39'10''$ Lt.
Ts = 564.32'
 $\Delta c = 24^{\circ}39'10''$
Dc = $3^{\circ}30'$
Lc = 704.37'
Rc = 1637.02'
 $\theta s = 3^{\circ}30'$
Ls = 200'
L.T. = 133.36'
S.T. = 66.69'

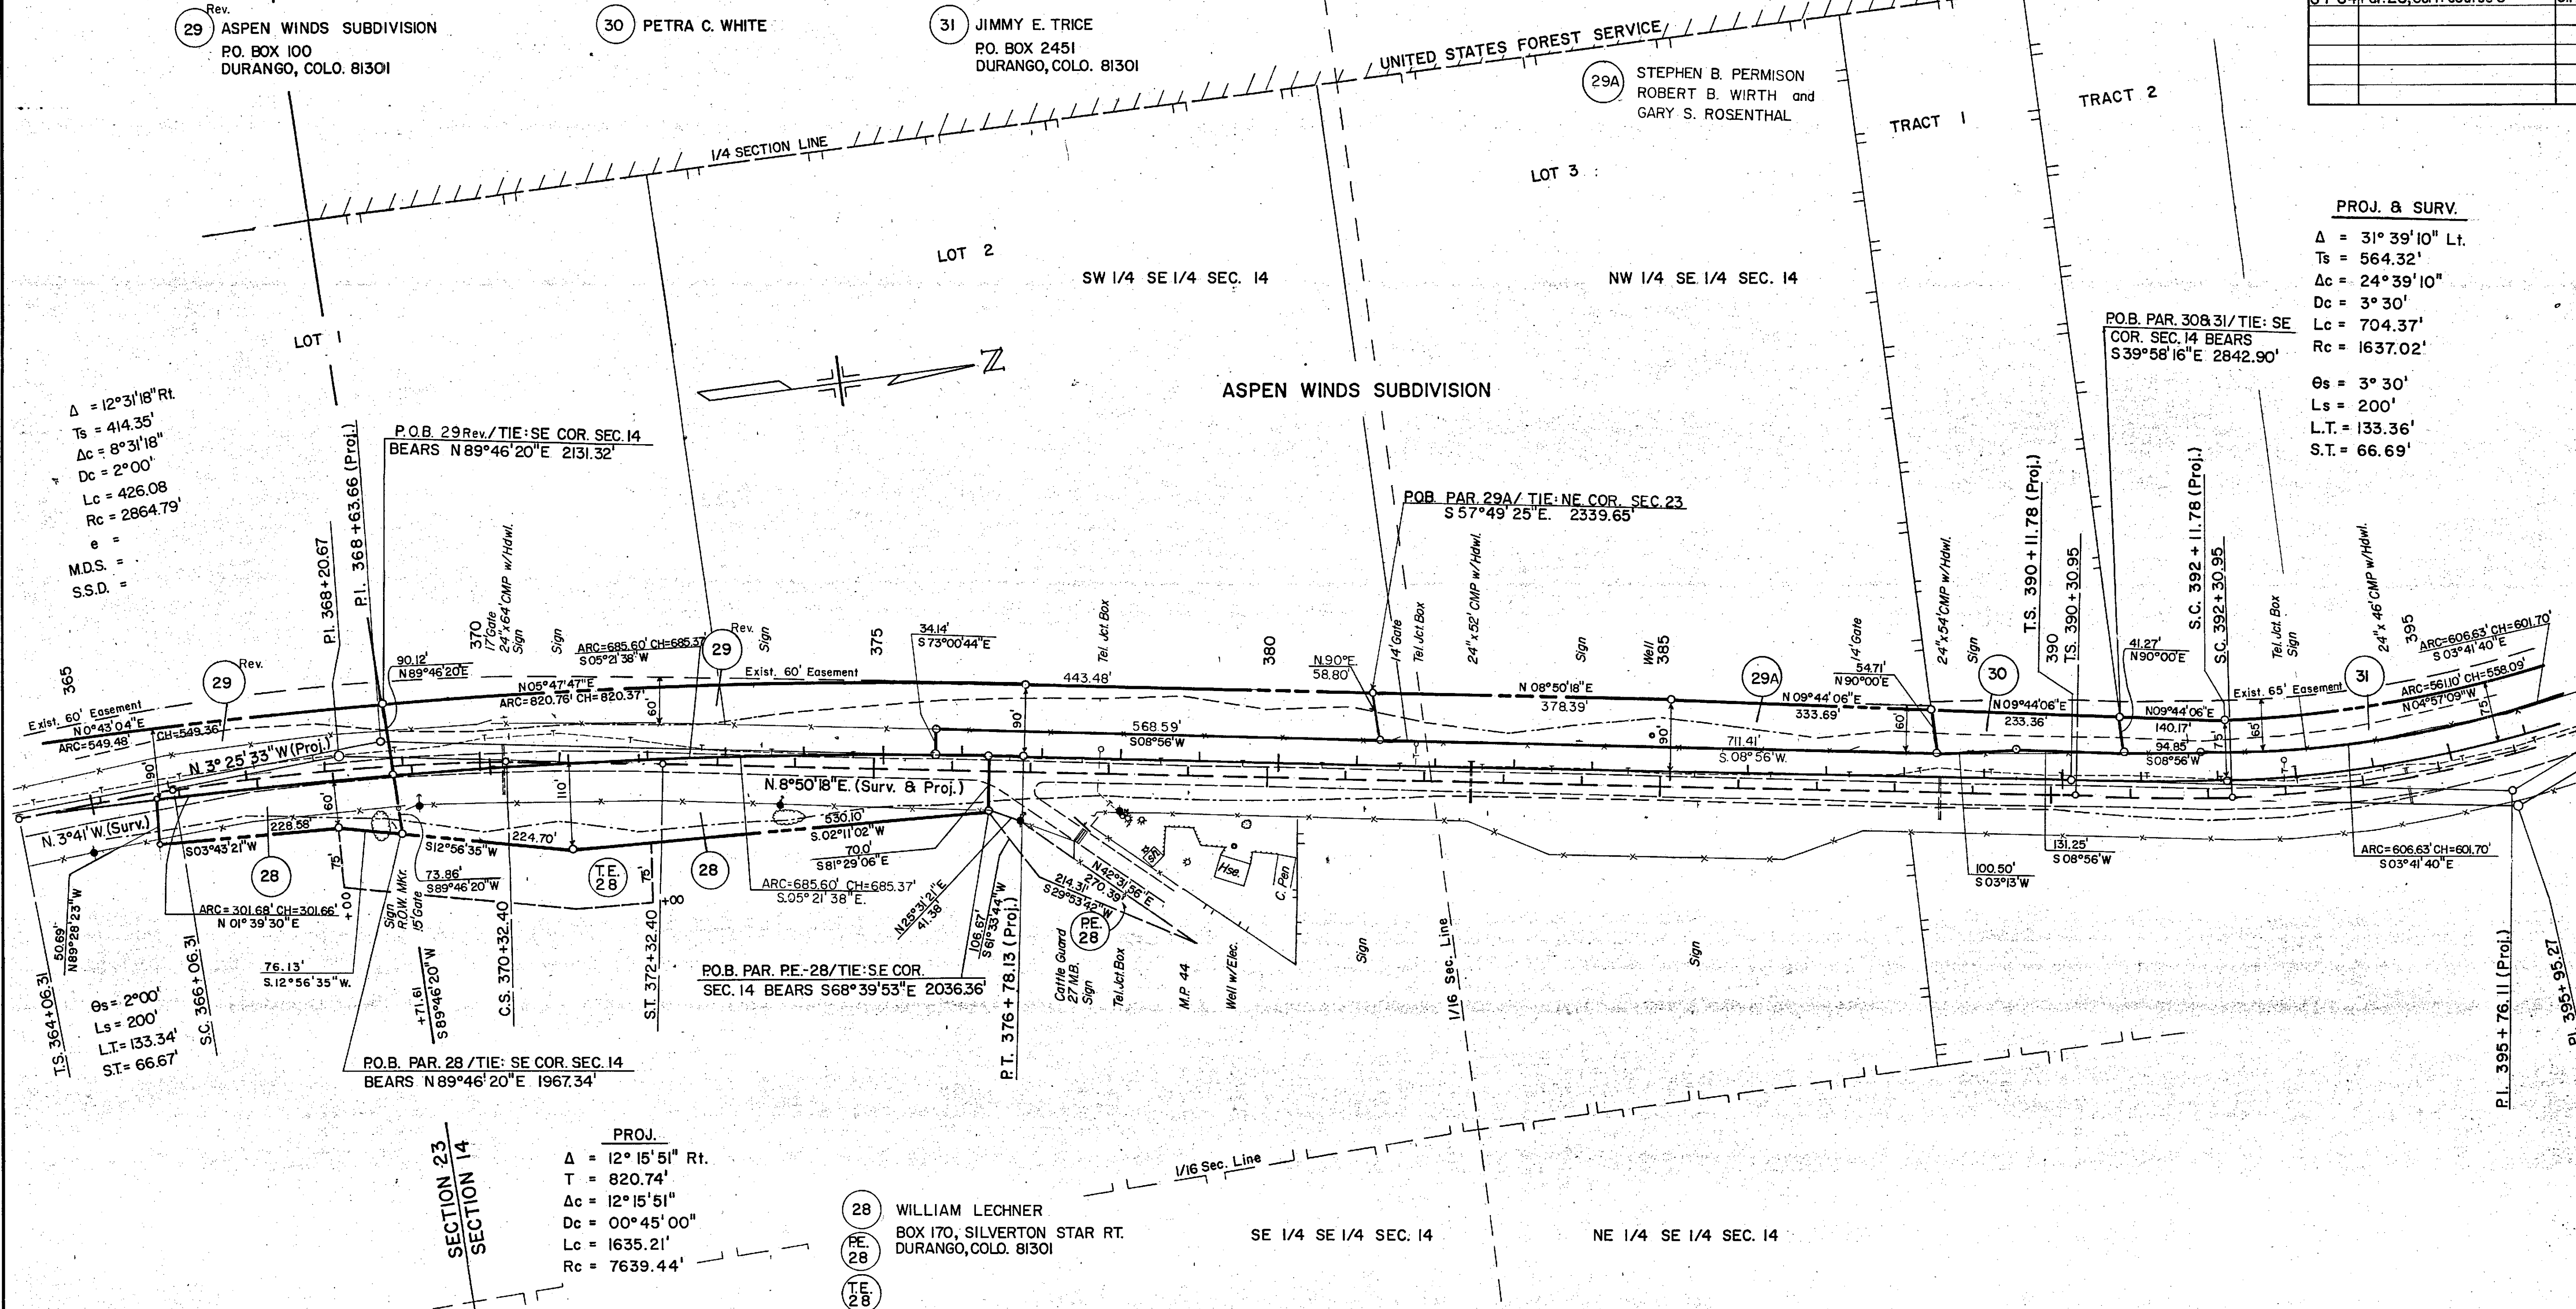

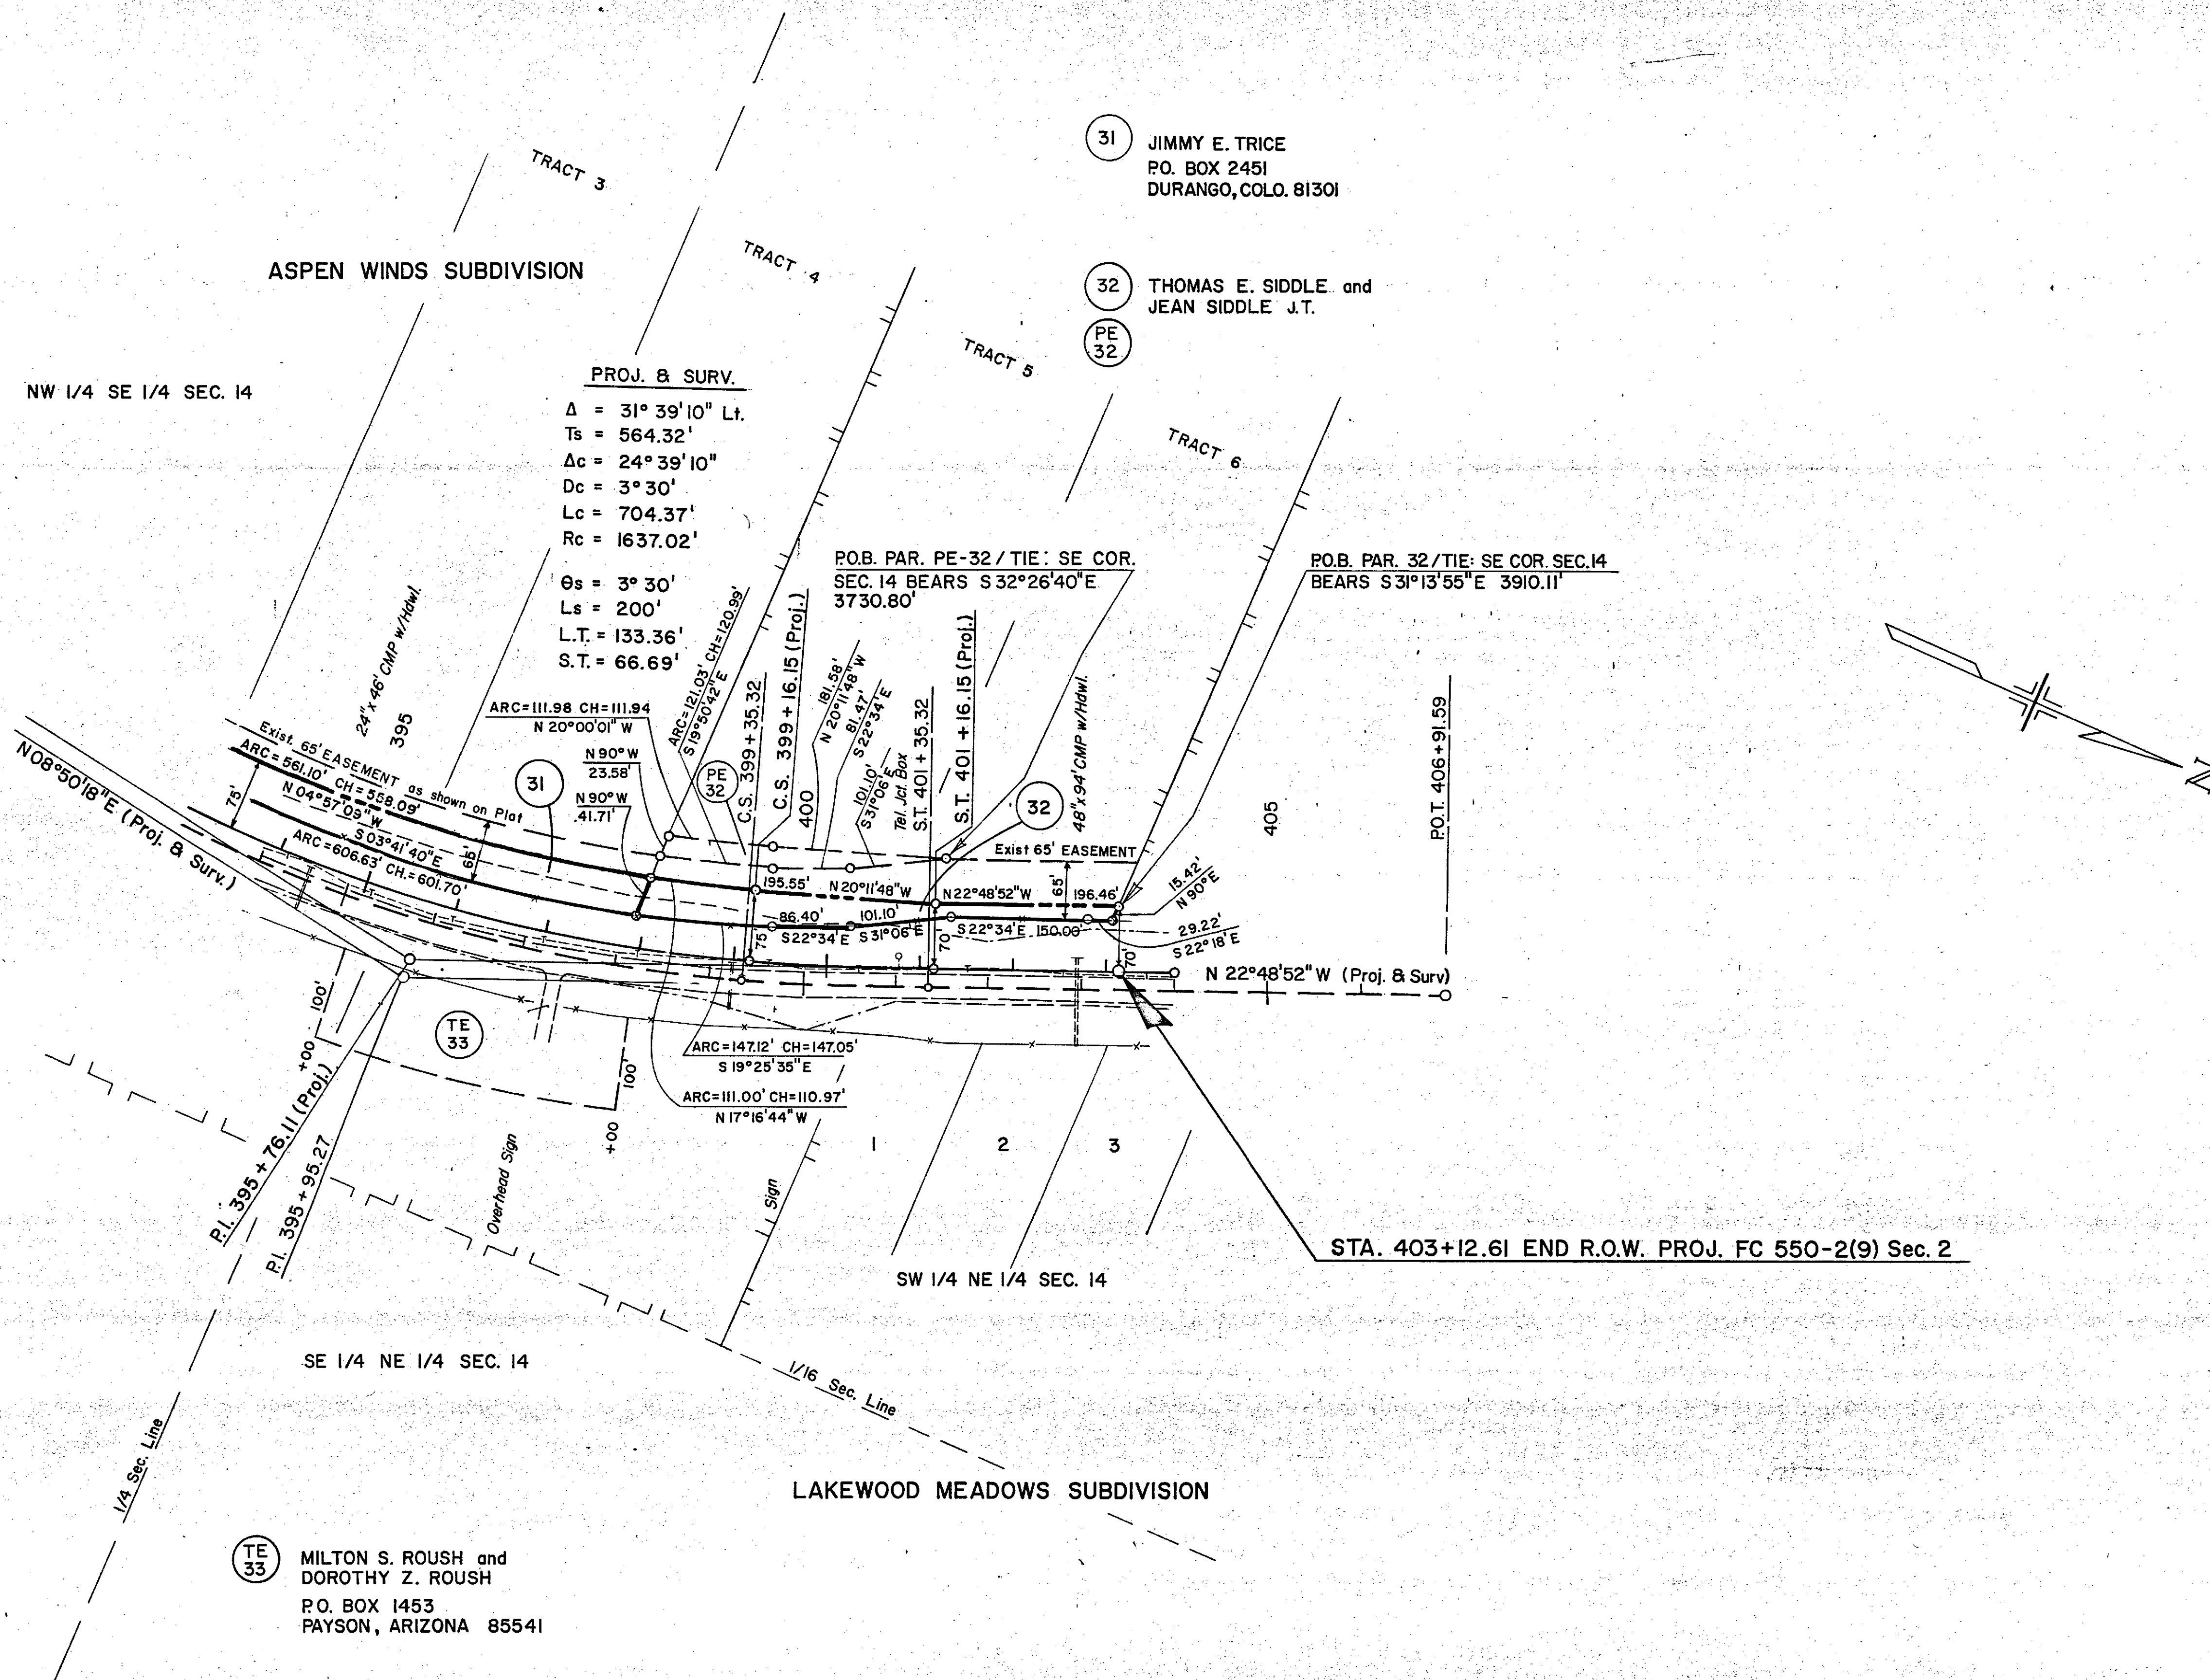

T. 38 N., R. 9 W., N.M.P.M.


KEY TO OWNERSHIP

MILDRED L. COX (1/2) FRANCES C. McNAMEE (1/2)	RALPH D. WATTERS, Trustee	EDITH L. REED	JANE RAPP
MILDRED L. COX GEORGE M. COX FRANCES C. McNAMEE	MINTON I. MOORE & INA MAY MOORE J.T.	E. HOLT WYCKOFF and CHARLENE WYCKOFF	UTAH POWER & LIGHT COMPANY
MILTON F. LECHNER, DOROTHY M. LECHNER, JOHN M. LECHNER & ROBERT E. LECHNER	JACK M. DOYLE, ADVERTISING INCORPORATED	ASPEN WINDS II, a limited partnership	PETRA C. WHITE
ALBERT J. & JOSEPHINE G. LECHNER	ROBERT L. FRAZER & DOROTHY B. FRAZER	I. J. JARVIS	LAKEWOOD MEADOWS SUBDIVISION
STATE OF COLORADO (GAME & FISH)	PETER K. BOLI, W. JILL BOLI, BRADNEY A. BOLI and TIFFANI K. BOLI J.T.	JANET FARRINGTON YOUNGBERG NANCY FARRINGTON HIGGINS ANTHONY S. FARRINGTON J.C. FARRINGTON III.	MILTON S. ROUSH & DOROTHY Z. ROUSH
UNITED STATES FOREST SERVICE (FOREST SERVICE)	EARL V. MASON and KORLEEN MASON	DOUGLAS L. REPAAL and LORENA J. REPAAL	JIMMY E. TRICE
RUEDI BAER	PAUL E. FOLWELL SARA C. FOLWELL	WILLIAM LECHNER	THOMAS E. SIDDLER & JEAN SIDDLER J.T.
MILTON F. LECHNER, Trustee DOROTHY M. LECHNER JOHN LECHNER	JAMES R. FLACK, Trustee	LEE M. & HAZEL RATCLIFFE J.T.	HERSHEL H. WHITE and VIRGINIA L. WHITE

FEDERAL ROAD REGION NO.	DIVISION	PROJ. NO.	SHEET NO.	TOTAL SHEETS
VIII	COLORADO	FC 550-2(9) Sec 2	9	9

RIGHT OF WAY ROCKWOOD TO PURGATORY

REVISIONS		
9/17/82	Name Change 23 & TE-23	D.A.Z.
3-14-83	Rev. Per. 29, Added 29A	D.M.

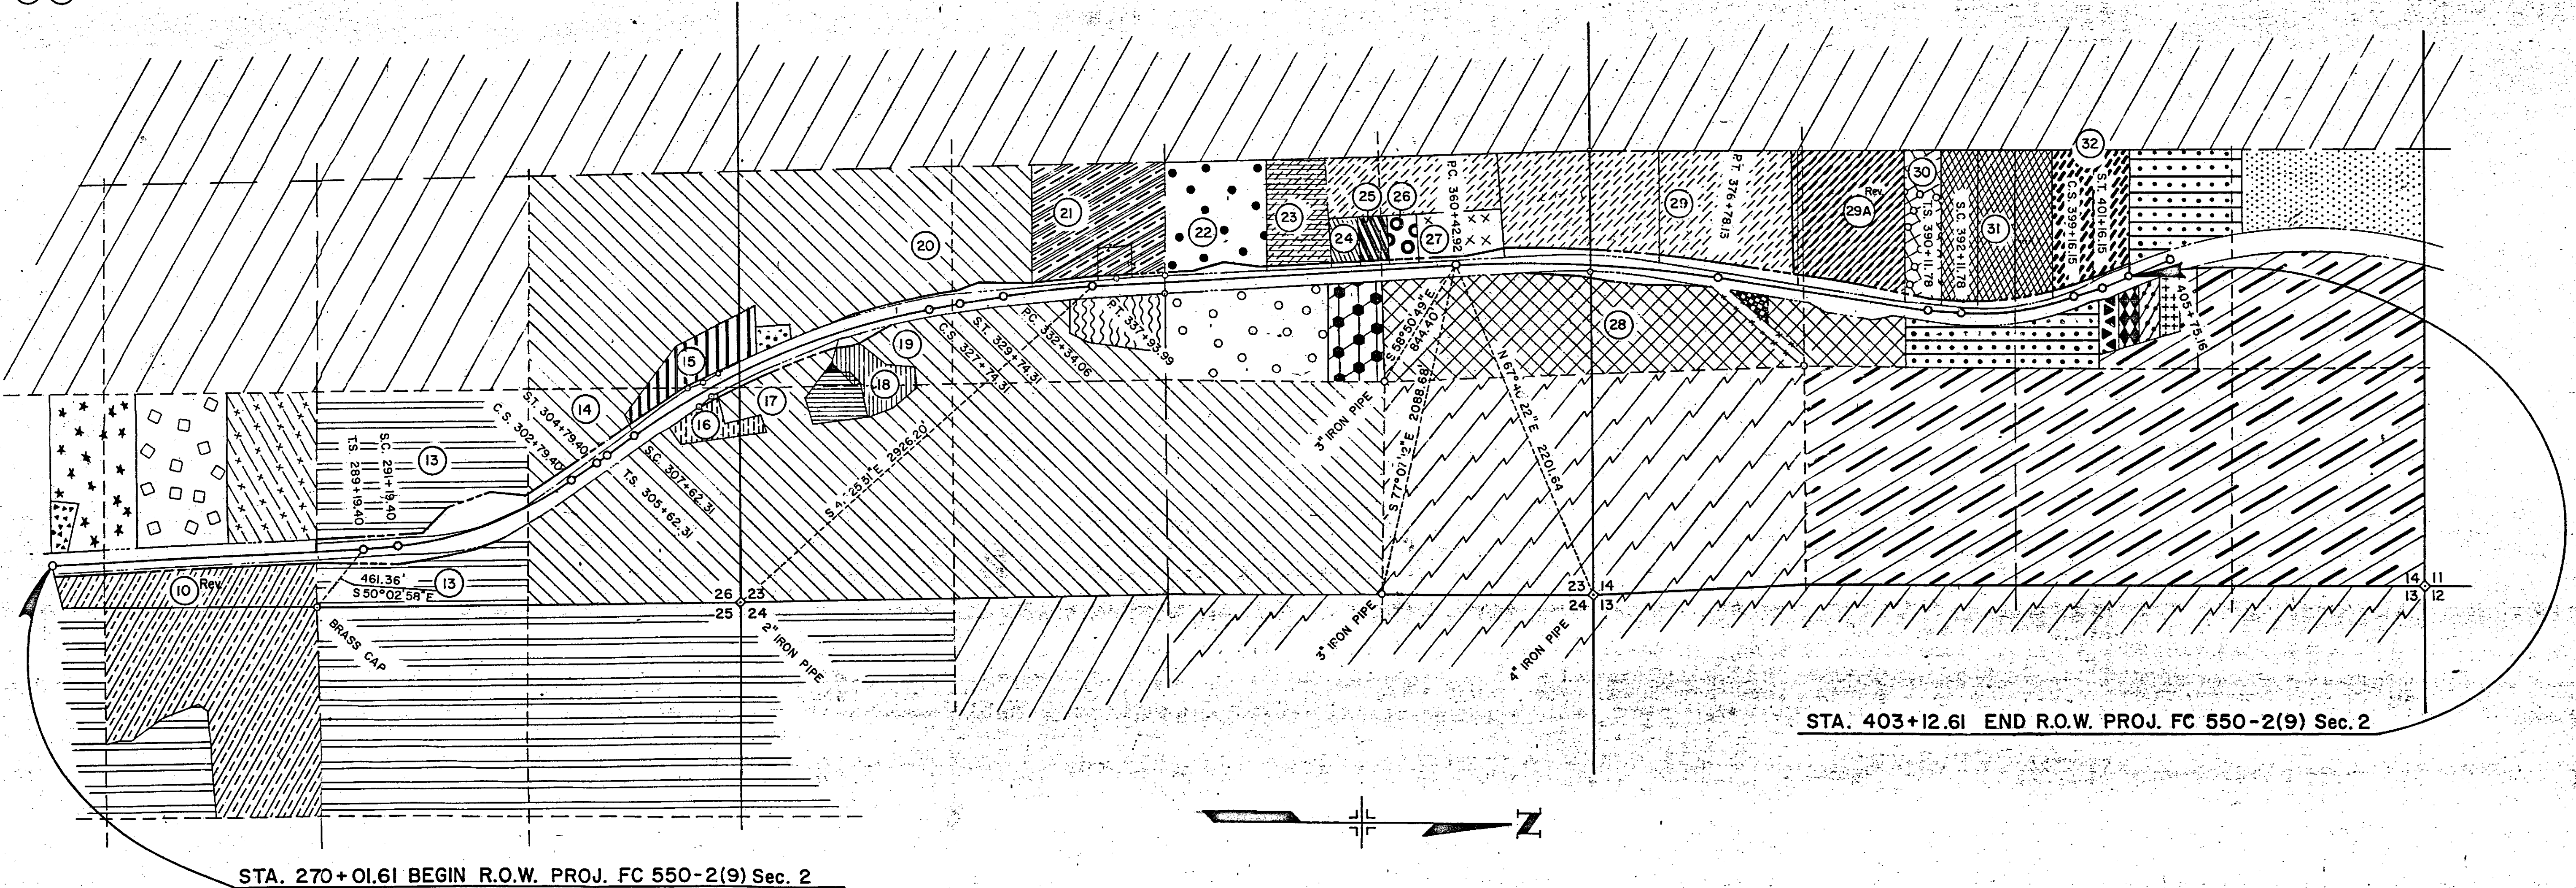

T. 38 N., R. 9 W., N.M.P.M.

R. O. W. TABULATION OF PROPERTIES IN

LA PLATA

COUNTY

S. H. NO. 550

FEDERAL ROAD SECTION NO.	DIVISION	PROJECT NO.	SHEET NO.
550	COLORADO	FC 550-2(9) Sec. 2	2

RIGHT OF WAY
ROCKWOOD TO PURGATORY

ROCKWOOD TO PURGATORY												
PARCEL NO.	OWNER	ADDRESS	LOCATION	AREA IN ACRES				PARCEL NO.	REMARKS	REVISIONS		
				PARCEL	TO BE ACQUIRED	REMAINDER						
						LEFT	RIGHT					
			T.38N., R.9W., N.M.P.M.									
TE-5	MARION JARVIS		SE½ SE½, Sec. 26	0.610				TE-5	Easement for			
									road approach construction.			
PE-7	MILDRED L. COX		SE½ SE½, Sec. 26	0.338	0.338	11.399	—	PE-7	Easement for road approach construction			
	GEORGE M. COX								(permanent easement).			
	FRANCES C. McNAMEE											
TE-7	MILDRED L. COX		SE½ SE½, Sec. 26	0.545				TE-7	Easement for road approach construction.			
	GEORGE M. COX											
	FRANCES C. McNAMEE											
TE-8	MILDRED L. COX		SE½ SE½, Sec. 26	0.423				TE-8	Easement for road approach construction.			
	FRANCES C. McNAMEE											
TE-9	MILTON F. LECHNER, TRUSTEE		SE½ SE½, Sec. 26	0.024				TE-9	Easement for resetting cattle guards, gate,			
									and fence posts.			
10 REV.	RUEDI BAER	42570 U.S. HIGHWAY 550	SE½ SE½ and	0.500			39.839	10 REV.				
		DURANGO, COLORADO 81301	NE½ SE½, Sec. 26									
TE-10A	RUEDI BAER	42570 U.S. HIGHWAY 550	SE½ SE½, Sec. 26	0.061				TE-10A	Easement for resetting cattle guard, gate,			
		DURANGO, COLORADO 81301							and fence posts.			
TE-10B	REUDI BAER	42570 U.S. HIGHWAY 550	NE½ SE½, Sec. 26	0.115				TE-10B	Road approach.			
		DURANGO, COLORADO 81301										

R.O.W. TABULATION OF PROPERTIES IN

LA PLATA

COUNTY

S.H. NO.

550

FEDERAL ROAD DISTRICT NO.	DIVISION	PROJECT NO.	SHEET NO.
III	COLORADO	FC 550-2(9) Sec. 2	2A

RIGHT OF WAY
ROCKWOOD TO PURGATORY

PARCEL NO.	OWNER	ADDRESS	LOCATION	AREA IN ACRES				PARCEL NO.	REMARKS	REVISIONS		
				PARCEL	TO BE ACQUIRED	REMAINDER						
						LEFT	RIGHT					
			T.38N., R.9W., N.M.P.M.									
TE-10C	RUEDI BAER	42570 U.S. HIGHWAY 550 DURANGO, COLORADO 81301	NE½ SE½, Sec. 26	0.046				TE-10C	Road approach.			
TE-11	MILTON F. AND DOROTHY M. LECHNER		NE½ SE½, Sec. 26	0.241				TE-11	Road approach.			
TE-12	ALBERT J. AND JOSEPHINE G. LECHNER, J.T.		NE½ SE½, Sec. 26	, 0.034				TE-12	Road approach.			
13	STATE OF COLORADO (FISH & GAME)	151 EAST 16th DURANGO, COLORADO 81301	SE½ NE½, Sec. 26	6.629	3.220	25.00±	9.187±	13	Plus land in sections 24 and 25.			
TE-13	STATE OF COLORADO (FISH & GAME)	151 EAST 16th DURANGO, COLORADO 81301	SE½ NE½, Sec. 26	.041				TE-13	Road approach.			
14	MILTON F. LECHNER, TRUSTEE DOROTHY M. LECHNER JOHN LECHNER	BOX 34 BLOOMFIELD, NEW MEXICO 87413	NE½ NE½, Sec. 26	0.899	0.899	79±	161±	14				
15	RALPH D. WATTERS, TRUSTEE OF DONALD R. HOEL AND JUANITA A. HOEL REVOCABLE TRUST		N½ NE½, Sec. 26	0.356	0.356	4.430	—	15				

R. O. W. TABULATION OF PROPERTIES IN

LA PLATA

COUNTY

S. H. NO. 550

FEDERAL ROAD REVISION NO.	DIVISION	PROJECT NO.	SHEET NO.
22	COLORADO	EC 550-2(9) Sec. 2	2B

RIGHT OF WAY
ROCKWOOD TO PURBATORY

PARCEL NO.	OWNER	ADDRESS	LOCATION	AREA IN ACRES				PARCEL NO.	REMARKS	REVISIONS		
				PARCEL	TO BE ACQUIRED	REMAINDER				9/11/84	Correct Par 17,18,19	E.M.
						LEFT	RIGHT					
			T.38N., R.9W., N.M.P.M.									
16	MINTON I. MOORE AND INA MAY MOORE, J.T.	5718 N. 10th AVENUE PHOENIX, ARIZONA 85013	NE½ NE½, Sec. 26	0.034	0.034	—	1.861	16				
17	MILTON F. LECHNER, TRUSTEE DOROTHY M. LECHNER JOHN LECHNER	BOX 34 BLOOMFIELD, NEW MEXICO 87413	NE½ NE½, Sec. 26	0.099	0.099	SEE PARCEL 14		17				
17	MILTON F. LECHNER, TRUSTEE DOROTHY M. LECHNER JOHN LECHNER	BOX 34 BLOOMFIELD, NEW MEXICO 87413	SE½ SE½, Sec. 23 SW½ SE½, Sec. 23	0.504 0.603	0.504 0.603	SEE PARCEL 14 TOTAL		17				
TE-17	MILTON F. LECHNER, TRUSTEE DOROTHY M. LECHNER JOHN LECHNER	BOX 34 BLOOMFIELD, NEW MEXICO 87413	SW½ SE½, Sec. 23	0.564				TE-17	Road approach.			
18	PETER K. BOLI, W. JILL BOLI, BRADNEY A. BOLI, AND TIFFANI K. BOLI, J.T.	475 PALM DRIVE ARCADIA, CALIFORNIA 91006	SW½ SE½, Sec. 23	0.124	0.124	—	3.0±	18				
19	MILTON F. LECHNER, TRUSTEE DOROTHY M. LECHNER JOHN LECHNER	BOX 34 BLOOMFIELD, NEW MEXICO 87413	SW½ SE½, Sec. 23	0.119	0.119	SEE PARCEL 14		19				

RIGHT OF WAY
ROCKWOOD TO PURGATORY

[illegible]

R.O.W. TABULATION OF PROPERTIES IN

LA PLATA

COUNTY

S.H. NO.

550

FEDERAL ROAD SECTION NO.	DIVISION	PROJECT NO.	SHEET NO.
XXI	COLORADO	FC 550-2(9) Sec. 2	2D

RIGHT OF WAY
ROCKWOOD TO PURGATORY

PARCEL NO.	OWNER	ADDRESS	LOCATION	AREA IN ACRES				PARCEL NO.	REMARKS	REVISIONS		
				PARCEL	TO BE ACQUIRED	REMAINDER				9/17/82	Name Chg. 23@ TE-23	DAZ
						LEFT	RIGHT					
			T.38N., R.9W., N.M.P.M.									
23	LESLIE W. SCHROEDER AND BEVERLY W. SCHROEDER, J.T.	3820 NORTHAVEN ROAD DALLAS, TEXAS 75229	SW 1/4 NE 1/4, Sec. 23	0.552	0.253	8.0 [±]	—	23				
TE-23	LESLIE W. SCHROEDER AND BEVERLY W. SCHROEDER, J.T.	3820 NORTHAVEN ROAD DALLAS, TEXAS 75229	SW 1/4 NE 1/4, Sec. 23	0.066				TE-23	Road approach.			
24	JANET FARRINGTON YOUNGBERG NANCY FARRINGTON HIGGINS ANTHONY S. FARRINGTON J. C. FARRINGTON III	705 AMHERST S.E. ALBUQUERQUE, NEW MEXICO 87108	SW 1/4 NE 1/4, Sec. 23	0.244	0.116	1.089	—	24				
TE-24	JANET FARRINGTON YOUNGBERG NANCY FARRINGTON HIGGINS ANTHONY S. FARRINGTON J. C. FARRINGTON III	705 AMHERST S.E. ALBUQUERQUE, NEW MEXICO 87108	SW 1/4 NE 1/4, Sec. 23	0.084				TE-24	Road approach.			
25	FRITZ ALLEN, et al	P.O. BOX 780 CORRALES, NEW MEXICO	SW 1/4 NE 1/4 and NW 1/4 NE 1/4, Sec. 23	0.279	0.151	1.054	—	25				
TE-25	FRITZ ALLEN, et al	P.O. BOX 780 CORRALES, NEW MEXICO	SW 1/4 NE 1/4 and NW 1/4 NE 1/4, Sec. 23	0.204				TE-25	Road approach.			
26	DOUGLAS L. AND LORENA J. REPAAL	5019 27th STREET LUBBOCK, TEXAS 49407	NW 1/4 NE 1/4, Sec. 23	0.270	0.142	1.063	—	26				

R. O. W. TABULATION OF PROPERTIES IN

LA PLATA

COUNTY

S. H. NO.

550

FEDERAL ROAD REGION NO.	DIVISION	PROJECT NO.	SHEET NO.
III	COLORADO	FC 550-2(9) Sec. 2	2E

RIGHT OF WAY
ROCKWOOD TO PURGATORY

PARCEL NO.	OWNER	ADDRESS	LOCATION	AREA IN ACRES				PARCEL NO.	REMARKS	REVISIONS		
				PARCEL	TO BE ACQUIRED	REMAINDER				3/14/83	Rev. Par. 29, Add Par. 29A	DM
						LEFT	RIGHT					
			T.38N., R.9W., N.M.P.M.									
PE-26	DOUGLAS L. AND LORENA J. REPAAL	5019 27th STREET LUBBOCK, TEXAS 49407	NW¼ NE¼, Sec. 23	0.293	0.293			PE-26	Road approach. (permanent access)			
27	LEE M. AND HAZEL RATCLIFFE, J.T.	724 N. CUSTER WEATHERFORD, OKLAHOMA	NW¼ NE¼, Sec. 23	0.815	0.425	3.191	—	27				
28	WILLIAM LECHNER	BOX 170, SILVERTON STAR RT. DURANGO, COLORADO 81301	NW¼ NE¼, Sec. 23	0.407	0.130	—	37±	28				
28	WILLIAM LECHNER	BOX 170, SILVERTON STAR RT. DURANGO, COLORADO 81301	SW¼ SE¼, Sec. 14	1.613	0.630			28				
				2.020	0.790	TOTAL						
PE-28	WILLIAM LECHNER	BOX 170, SILVERTON STAR RT. DURANGO, COLORADO 81301	SW¼ SE¼, Sec. 14	0.175	0.175			PE-28	Road approach. (permanent access)			
			Lots 1, 2, & 3 ASPEN WINDS NO. II SUB.									
29 Rev.	ASPEN WINDS II A LIMITED PARTNERSHIP	P.O. BOX 100 DURANGO, COLORADO 81301	NW¼ NE¼, Sec. 23	1.130	0.490			29 Rev.				
	ASPEN WINDS II A LIMITED PARTNERSHIP		E¼ SE¼, Sec. 14	2.185	1.502							
				3.315	1.992	27,490	Total					
29A	STEPHEN B. PERMISON ROBERT B. WIRTH, AND GARY S. ROSENTHAL			0.938	0.938	13,320		29A				
			Tract 1 ASPEN WINDS SUBDIVISION									
30	PETRA C. WHITE		NW¼ SE¼, Sec. 14	0.238	0.238	4.774	—	30				

RIGHT OF WAY ROCKWOOD TO PURGATORY

[illegible]



COLORADO
Department of
Transportation

DOCUMENT SEPARATOR SHEET

REGION 5 – JUNE 2017 CONVERSION

To be placed at the beginning of each separator sheet.



r500001453

Description:

ROW Plans 24X36

Route # and Mile Points:

US 550

Originating Office:

ROW/Survey

File Name:

FC 550-2(9) SEC 2_ROW(.PDF)

Box Location:

24 (TUBE-13)of 38

FC 550-2(a) Sec. 2

STATE DEPARTMENT OF HIGHWAYS

DIVISION OF HIGHWAYS—STATE OF COLORADO

CONVENTIONAL SIGNS

County Line
Township or Range Line
Land Lines
Property or Tract Line
City Limits
Railroad
Existing Road
New Road

Control of Access
Access denied by Deed
Right of Way Line
Protected by Freeway (Virgin Location)
Top of Cuts
Toe of Fills
Barbed Wire Fence
Chain Link Fence
Woven Wire-Combination Fence
Snow Fence
Wood Fence
Deer Fence

Trees
Deciduous
Coniferous

Tel & Teleg. Lines
Electric Lines
Elec. Trans. Tower
Buried Tel. Cable
Buried Electric Cable
Gas Main
Oil Main
Water Main
Sanitary Sewers
Storm Sewers

Road Approaches
Section Corner
Center of Section

Culverts & Drains
Proposed
Existing
Proposed
Existing (To be dashed)

Bridges

RIGHT OF WAY PLAN OF PROPOSED FEDERAL AID PROJECT NO. FC 550-2(9) Sec. 2 STATE HIGHWAY NO. 550 LA PLATA COUNTY

RIGHT OF WAY

SCALE OF ORIGINAL DRAWINGS


PLAN SHEETS 1" = 100'

TOTAL OWNERSHIP MAP 1" = 500'

LENGTH OF PROJECT = 2.52 MILES

STA. 403+12.61 END R.O.W. PROJ. FC 550-2(9) Sec. 2

STA. 270+01.61 BEGIN R.O.W. PROJ. FC 550-2(9) Sec. 2

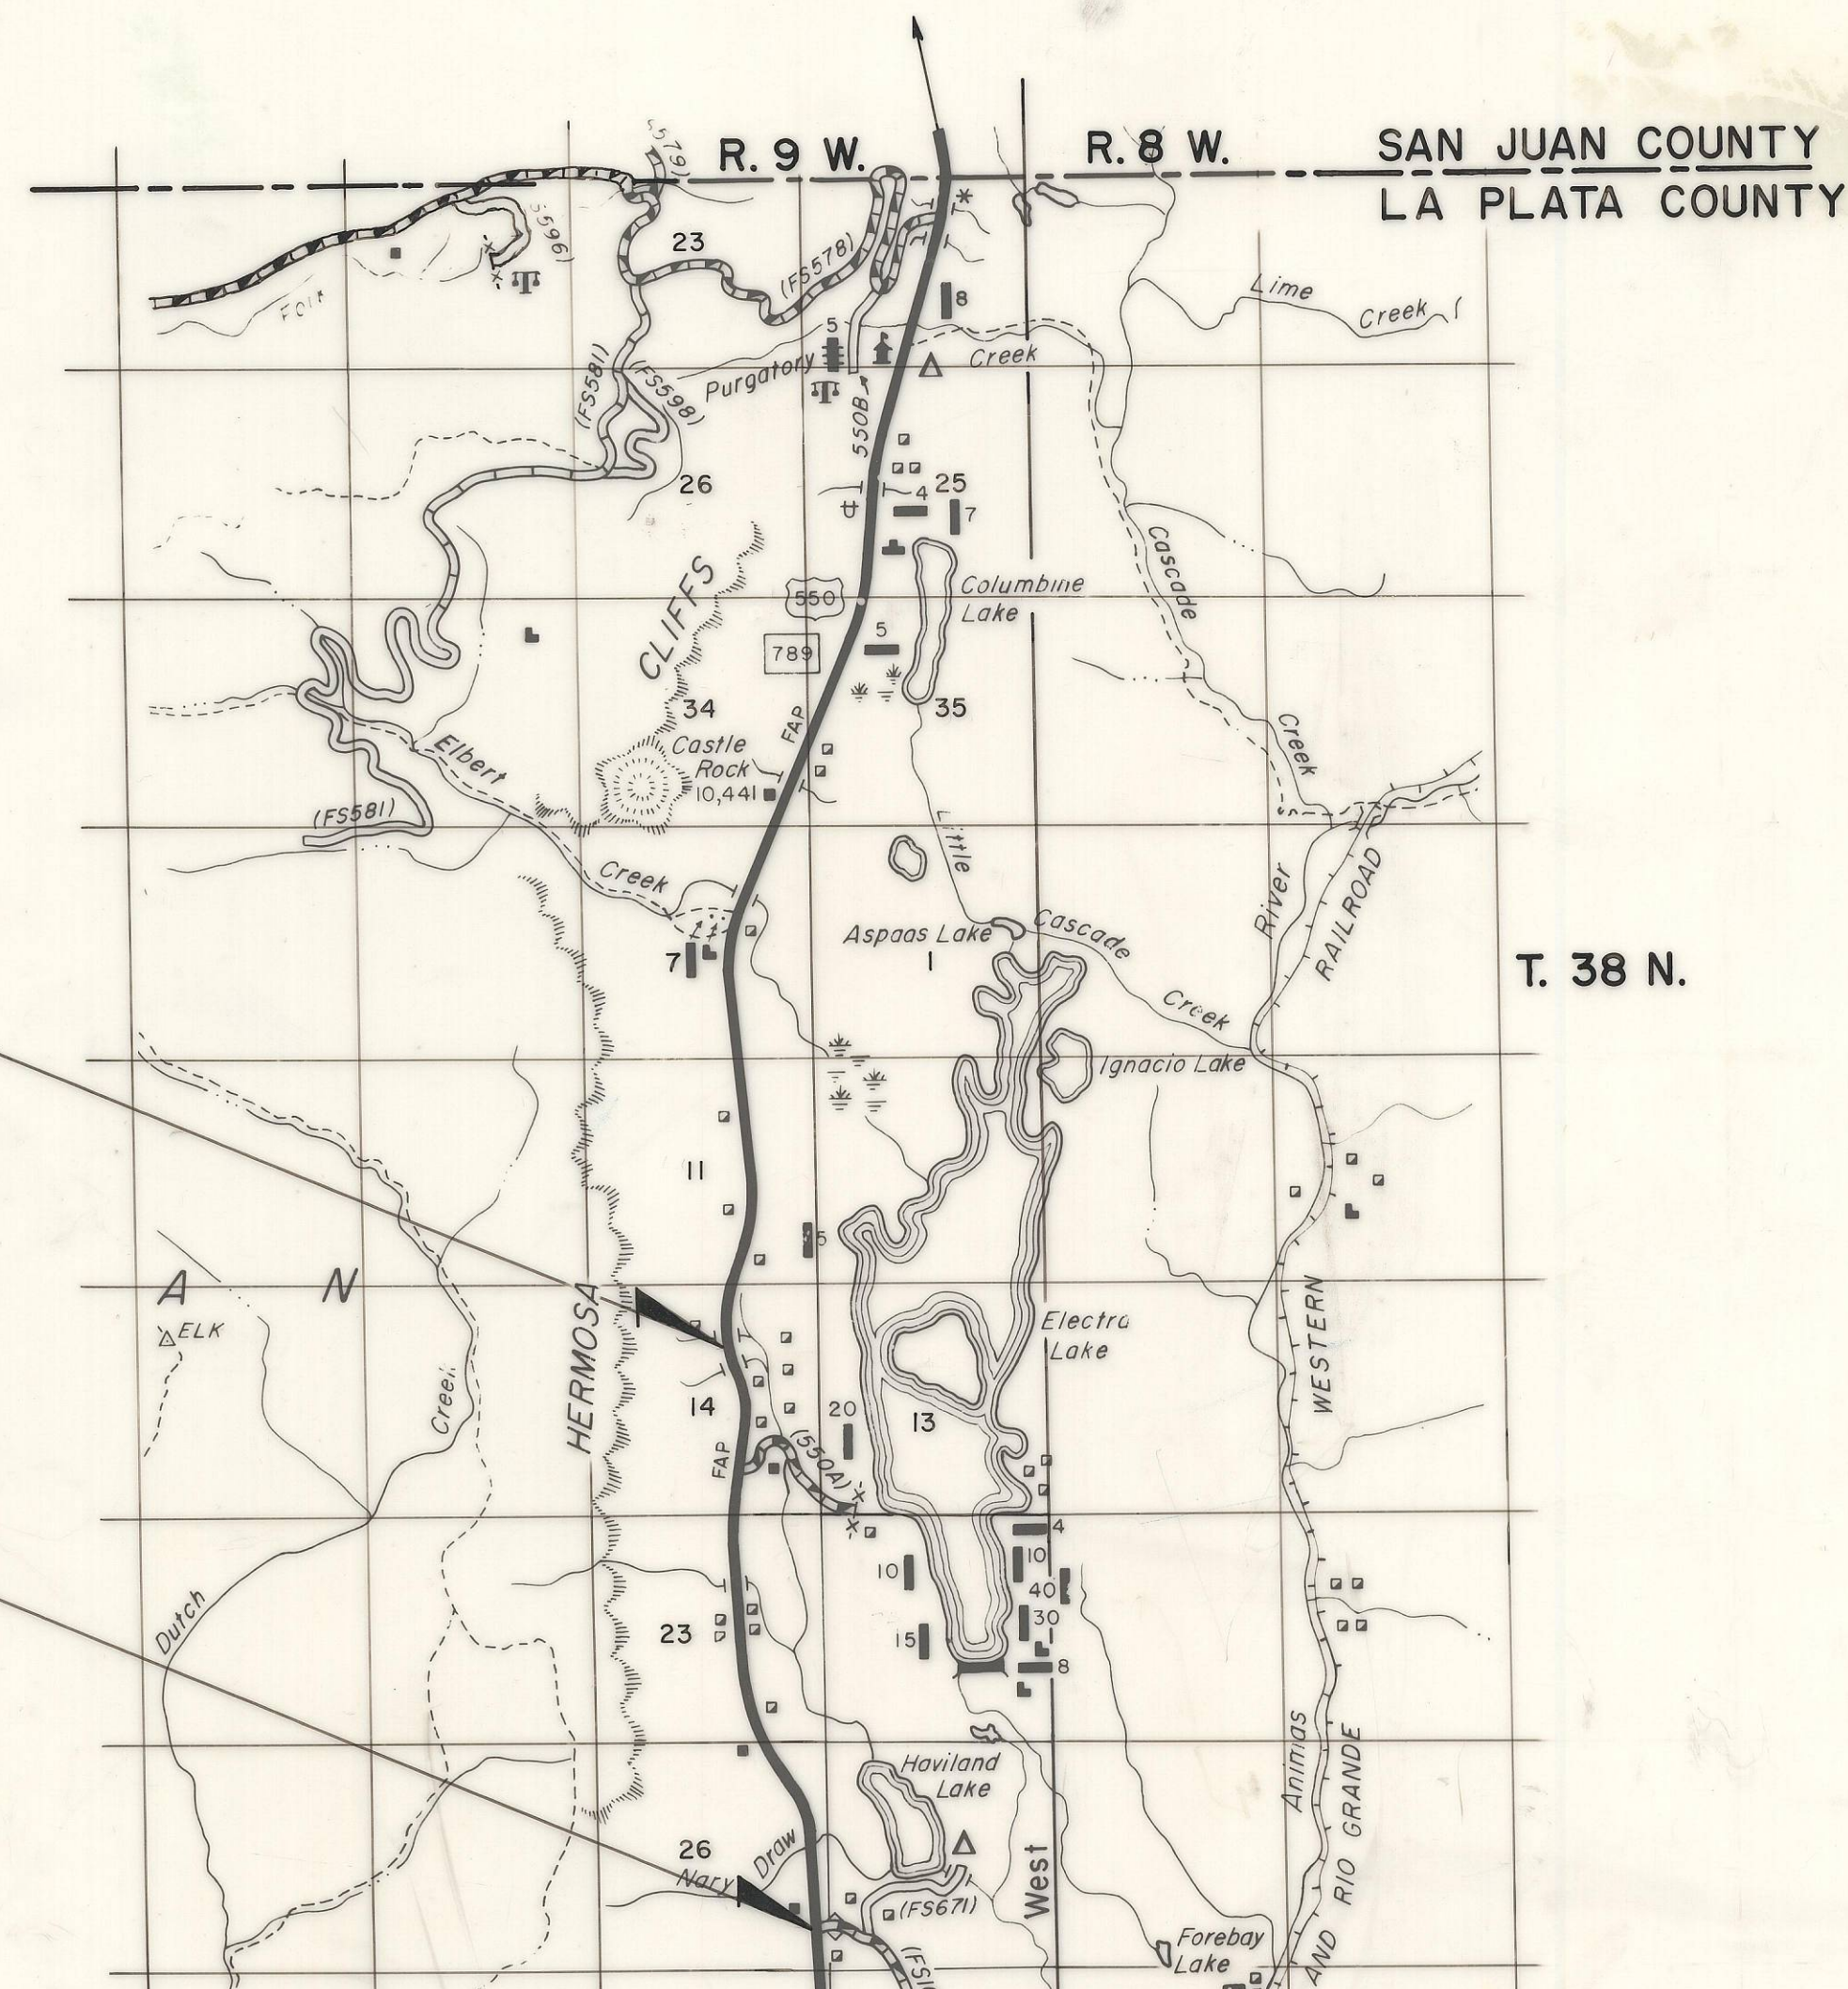

FEDERAL ROAD REGION NO.	DIVISION	PROJECT NO.	SHEET NO.
VIII	COLORADO	FC 550-2(9) Sec. 2	1

RIGHT OF WAY
ROCKWOOD TO PURGATORY

REVISIONS

INDEX OF SHEETS

- (1) TITLE SHEET
- (2-2F) TABULATION OF PROPERTIES
- (3-8) PLAN SHEETS
- (9) TOTAL OWNERSHIP MAP

DIVISION OF HIGHWAYS

APPROVED:


E. W. Hesse 4/1/82
CHIEF ENGINEER DATE


DEPARTMENT OF TRANSPORTATION
FEDERAL HIGHWAY ADMINISTRATION

APPROVED:

DATE


DIVISION ADMINISTRATOR

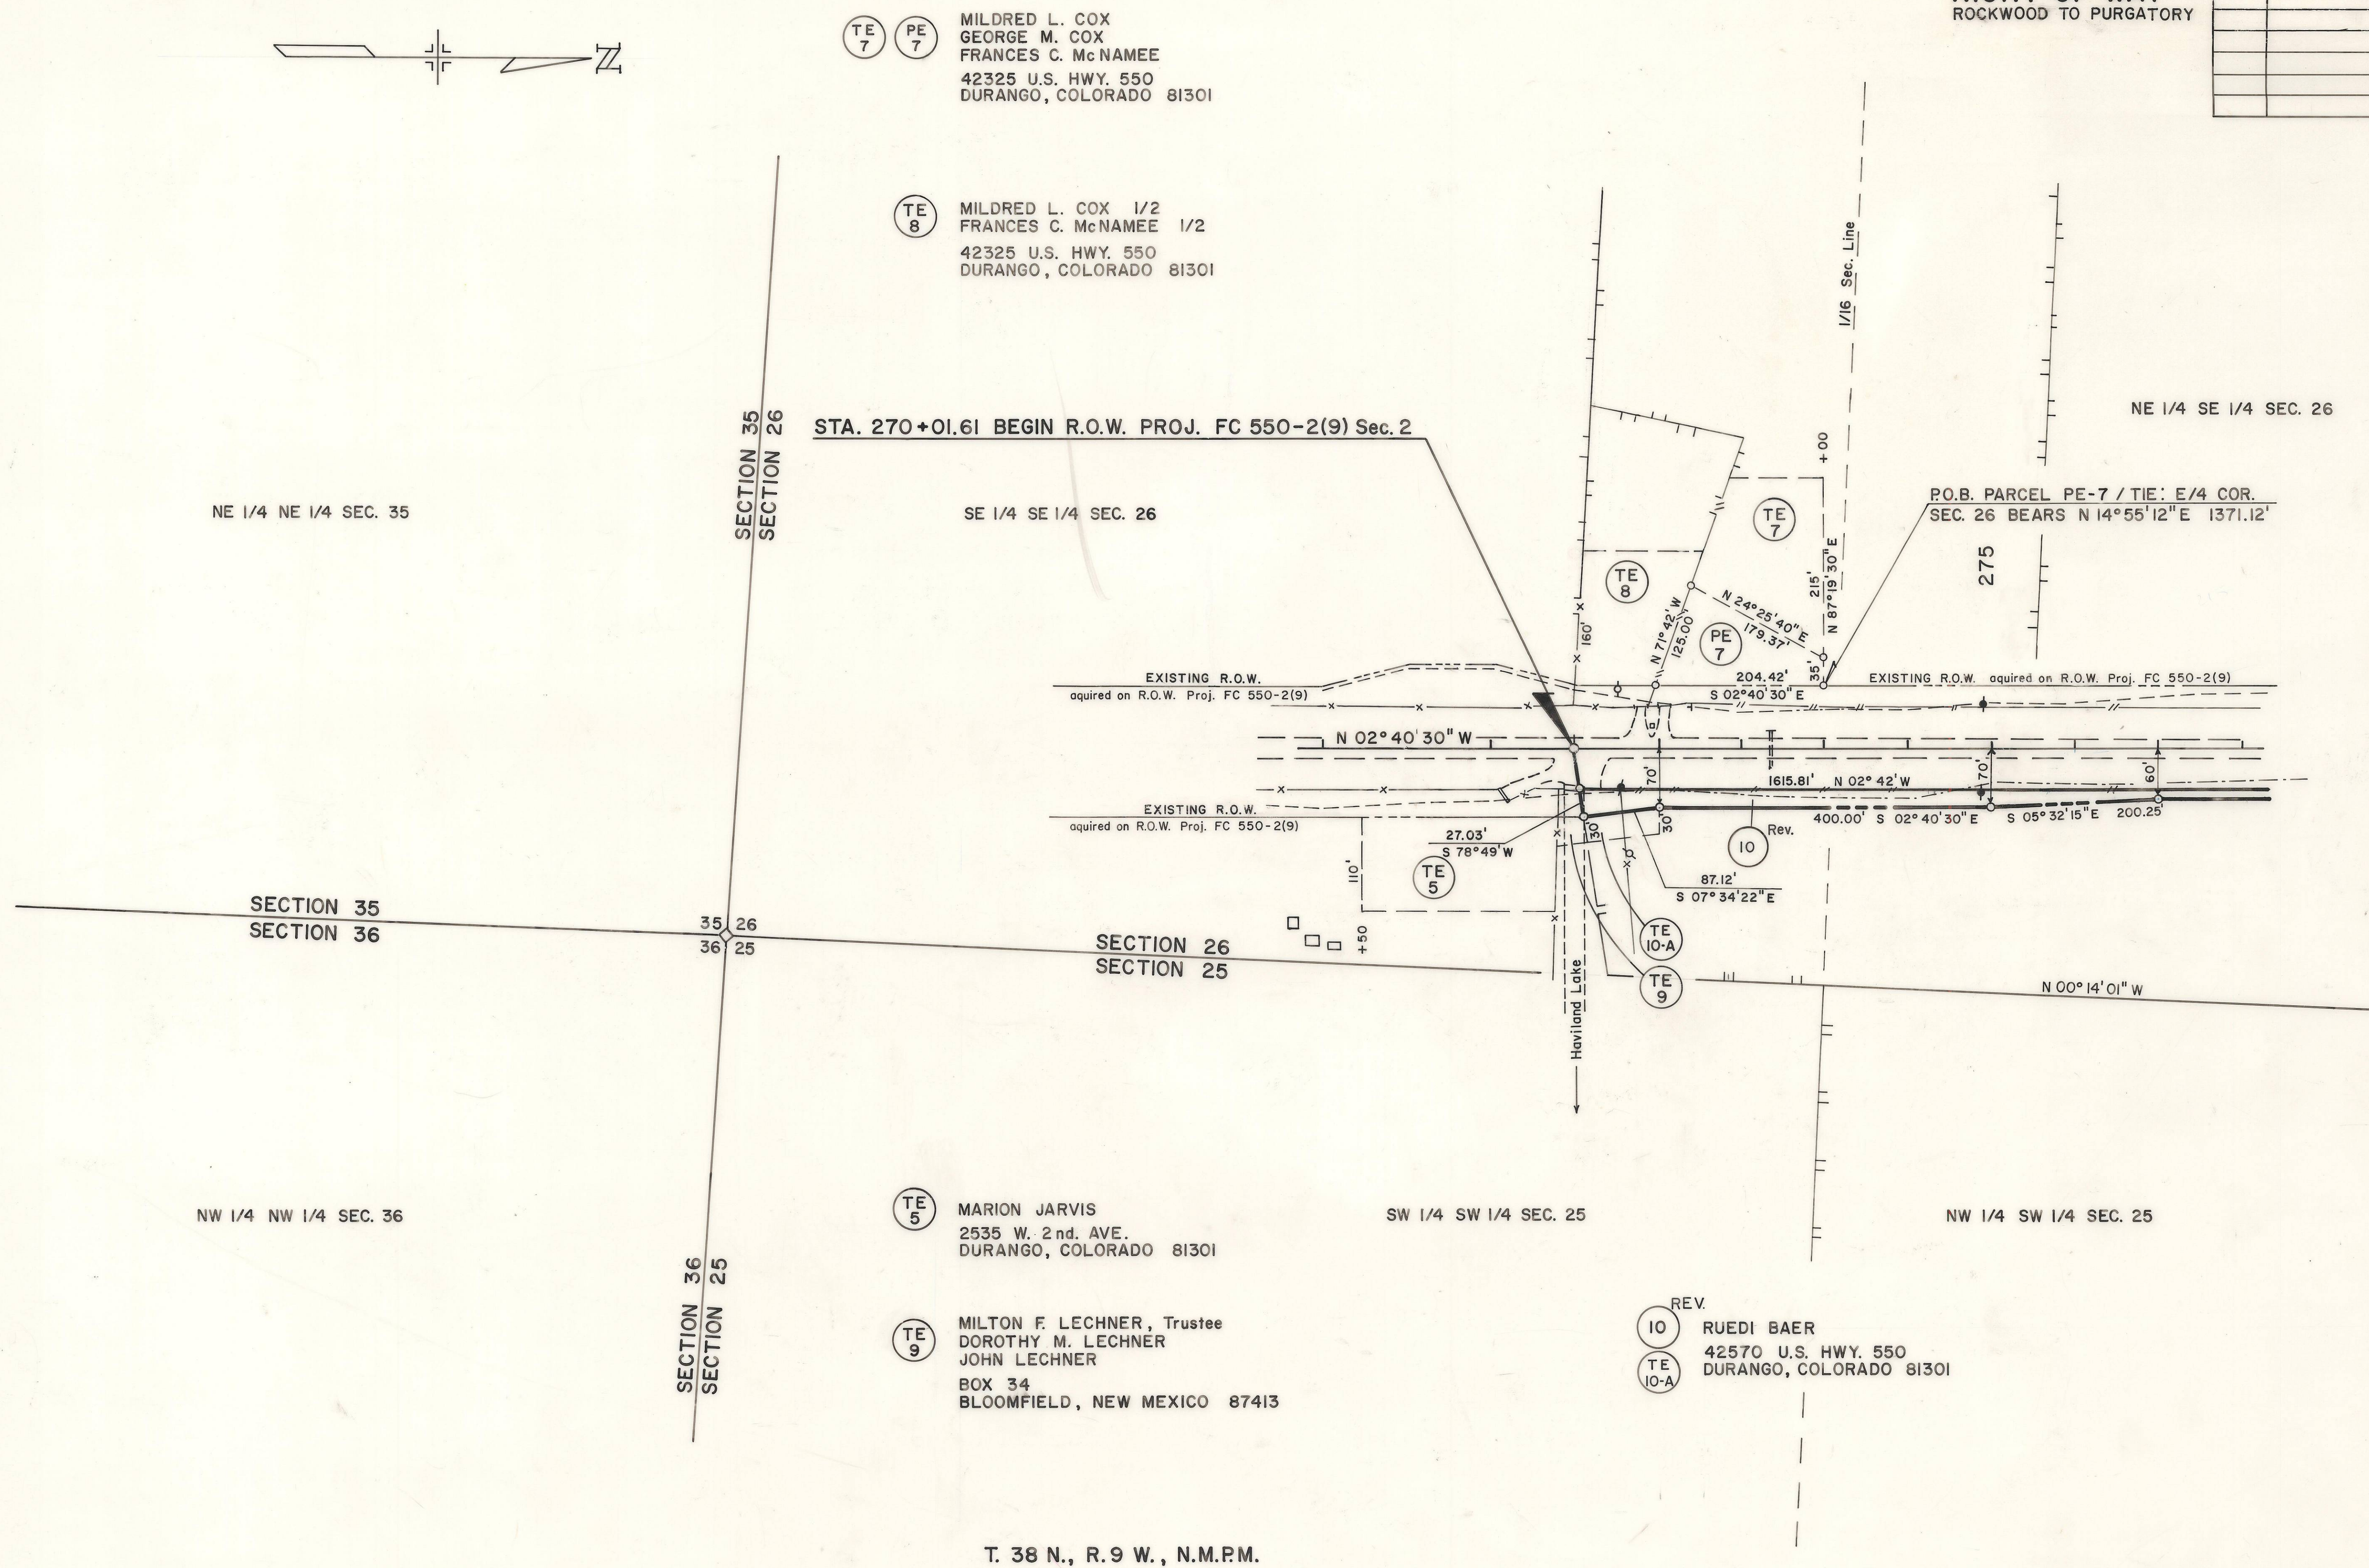

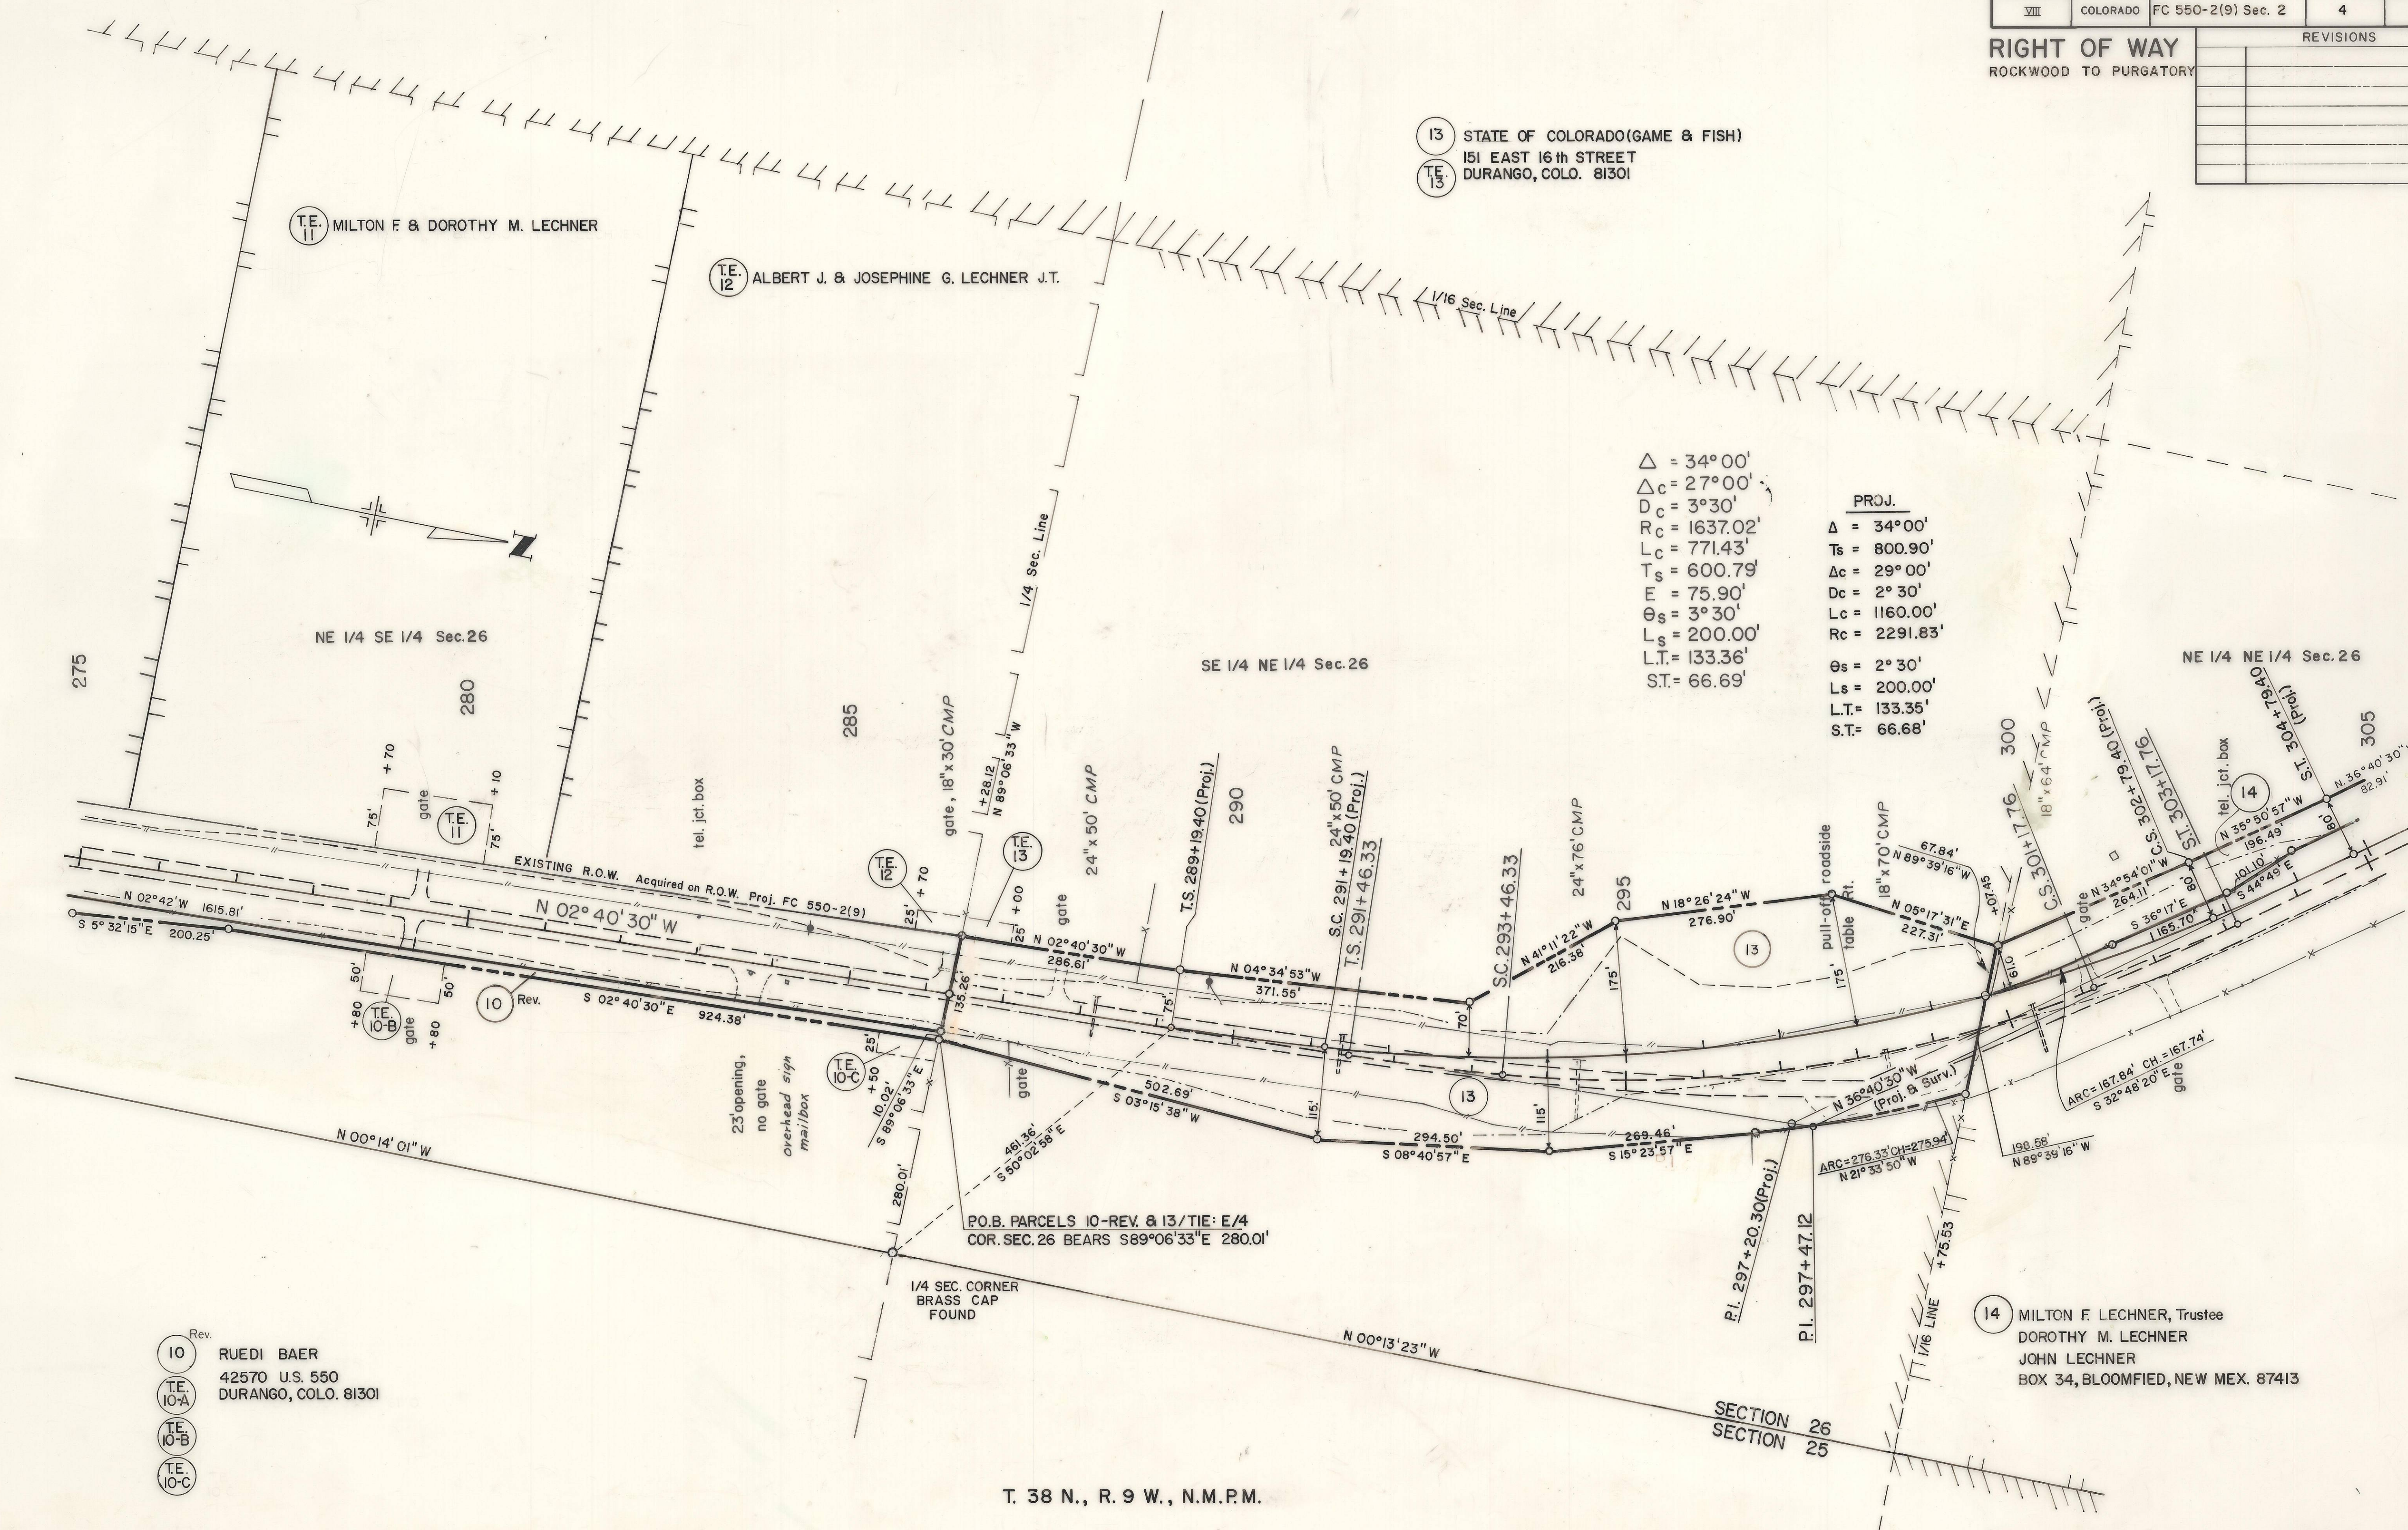

FEDERAL ROAD REGION NO.	DIVISION	PROJ. NO.	SHEET NO.	TOTAL SHEETS
VIII	COLORADO	FC 550-2(9) Sec. 2	5	9

RIGHT OF WAY		
ROCKWOOD TO PURGATORY		
REVISIONS		
6-7-84	Correct bearing of CL	C.P.
9-11-84	Correct Par 17, 18, 19	E.M.

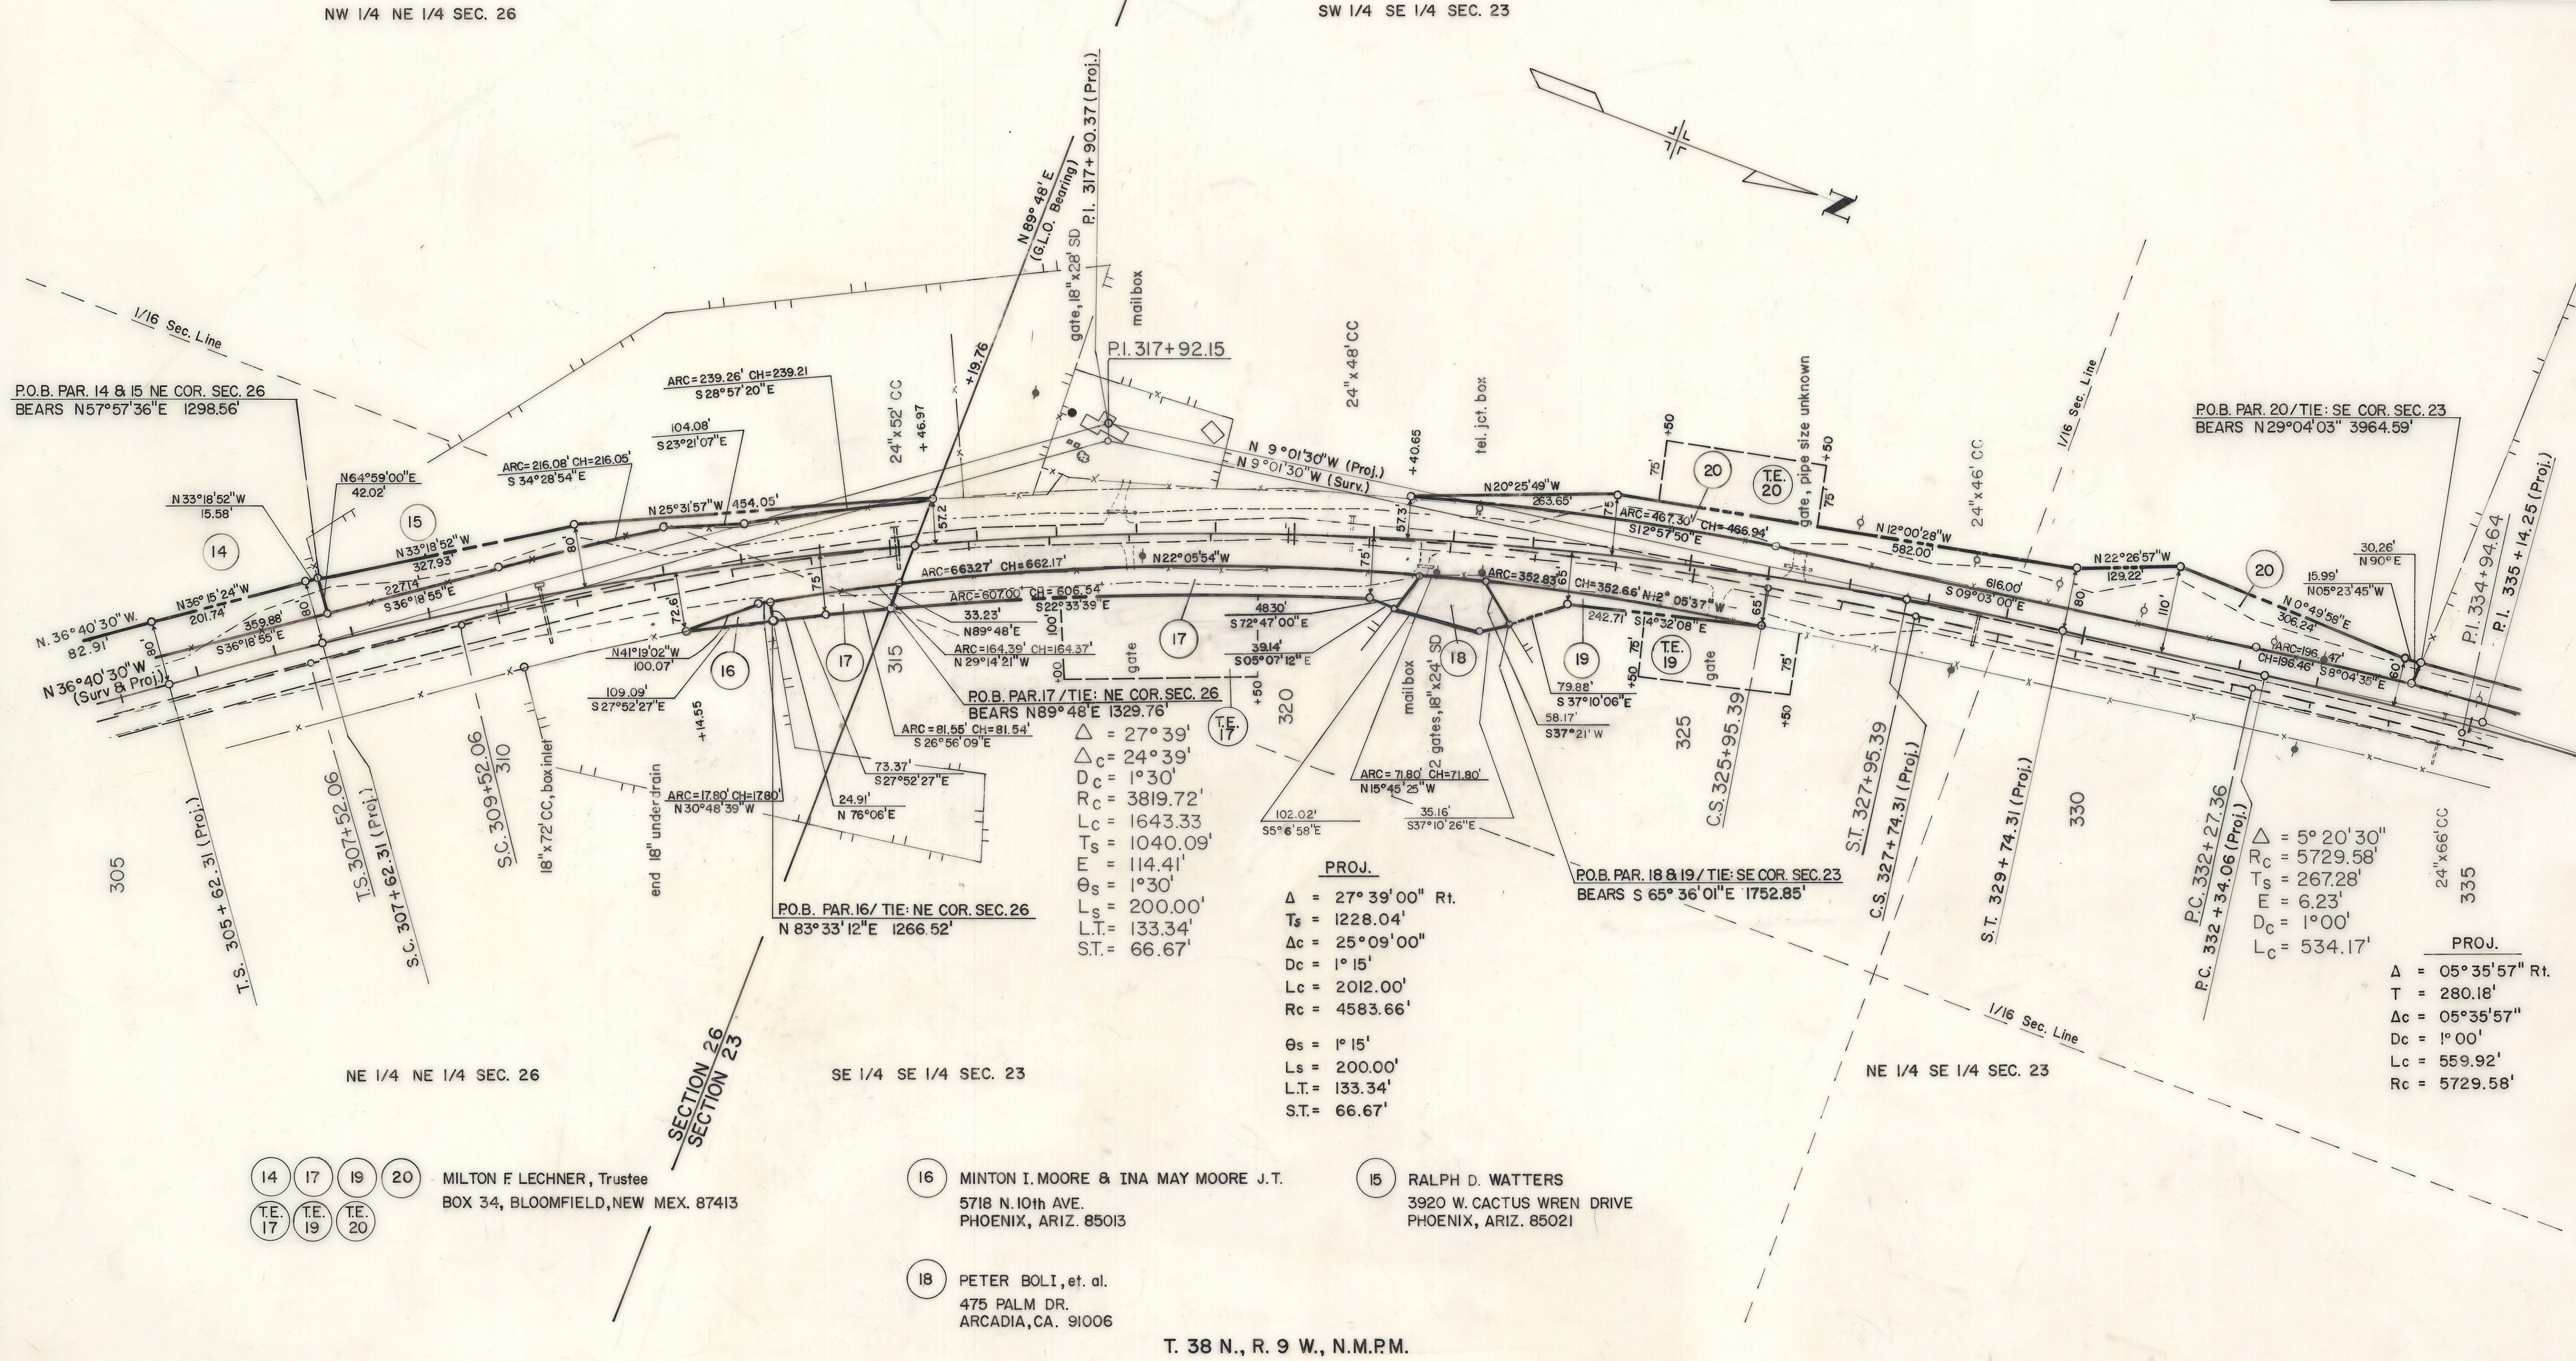

FEDERAL ROAD REGION NO.	DIVISION	PROJECT NO.	SHEET NO.
VIII	COLORADO	FC 550-2(9) Sec. 2	2A

R. O. W. TABULATION OF PROPERTIES IN

LA PLATA

COUNTY

S. H. NO.

550

RIGHT OF WAY

ROCKWOOD TO PURGATORY

PARCEL NO.	OWNER	ADDRESS	LOCATION	AREA IN ACRES				PARCEL NO.	REMARKS	REVISIONS		
				PARCEL	TO BE ACQUIRED	REMAINDER						
						LEFT	RIGHT					
			T.38N., R.9W., N.M.P.M.									
TE-10C	RUEDI BAER	42570 U.S. HIGHWAY 550 DURANGO, COLORADO 81301	NE $\frac{1}{4}$ SE $\frac{1}{4}$, Sec. 26	0.046				TE-10C	Road approach.			
TE-11	MILTON F. AND DOROTHY M. LECHNER		NE $\frac{1}{4}$ SE $\frac{1}{4}$, Sec. 26	0.241				TE-11	Road approach.			
TE-12	ALBERT J. AND JOSEPHINE G. LECHNER, J.T.		NE $\frac{1}{4}$ SE $\frac{1}{4}$, Sec. 26	0.034				TE-12	Road approach.			
13	STATE OF COLORADO (FISH & GAME)	151 EAST 16th DURANGO, COLORADO 81301	SE $\frac{1}{4}$ NE $\frac{1}{4}$, Sec. 26	6.629	3.220	25.00 $\pm$	9.187 $\pm$	13	Plus land in sections 24 and 25.			
TE-13	STATE OF COLORADO (FISH & GAME)	151 EAST 16th DURANGO, COLORADO 81301	SE $\frac{1}{4}$ NE $\frac{1}{4}$, Sec. 26	.041				TE-13	Road approach.			
14	MILTON F. LECHNER, TRUSTEE DOROTHY M. LECHNER JOHN LECHNER	BOX 34 BLOOMFIELD, NEW MEXICO 87413	NE $\frac{1}{4}$ NE $\frac{1}{4}$, Sec. 26	0.899	0.899	79 $\pm$	161 $\pm$	14				
15	RALPH D. WATTERS, TRUSTEE OF DONALD R. HOEL AND JUANITA A. HOEL REVOCABLE TRUST		N $\frac{1}{2}$ NE $\frac{1}{4}$, Sec. 26	0.356	0.356	4.430	—	15				

NOTE: PARCEL 21-A ~ JAMES R. FLACK to PAUL REED

21 (21-A) JAMES R. FLACK, Trustee
1030 WALNUT DRIVE
FARMINGTON, NEW MEX. 87401

22 EDITH L. REED
43709 HWY 550
DURANGO, COLO. 81301

23 LESLIE W. SCHROEDER and
BEVERLY W. SCHROEDER, J.T.
3820 NORTHAVEN ROAD
DALLAS, TEXAS 75229

24 JANET FARRINGTON YOUNGBERG, et. al.
705 AMHERST S.E.
ALBUQUERQUE, NEW MEX. 87108

25 FRITZ ALLEN, et. al.
P.O. BOX 780
CORRALES, NEW MEX.

26 DOUGLAS L. & LORENA J. REPAAL
5019 27th STREET
LUBBOCK, TEXAS 79407


26 TRANSFERRED FROM:
DEPARTMENT OF HIGHWAYS
TO
FRITZ. ALLEN, et. al.

27 LEE M. & HAZEL RATCLIFFE J.T.
724 N. CUSTER
WEATHERFORD, OKLAHOMA

29 Rev.
ASPEN WINDS SUBDIVISION
P.O. BOX 100
DURANGO, COLO. 81301

FEDERAL ROAD REGION NO.	DIVISION	PROJ. NO.	SHEET NO.	TOTAL SHEETS
VIII	COLORADO	FC 550-2(9) Sec. 2	6	9

RIGHT OF WAY ROCKWOOD TO PURGATORY			
REVISIONS			
9/17/82	Name Change 23 & TE-23	D.A.Z.	
3-14-83	Rev. Par. 29, Added 29A	D.M.	
12-9-85	Added PAR. 21-A	R.C.	
	Show Transfer of PAR. RE. 26	R.C.	

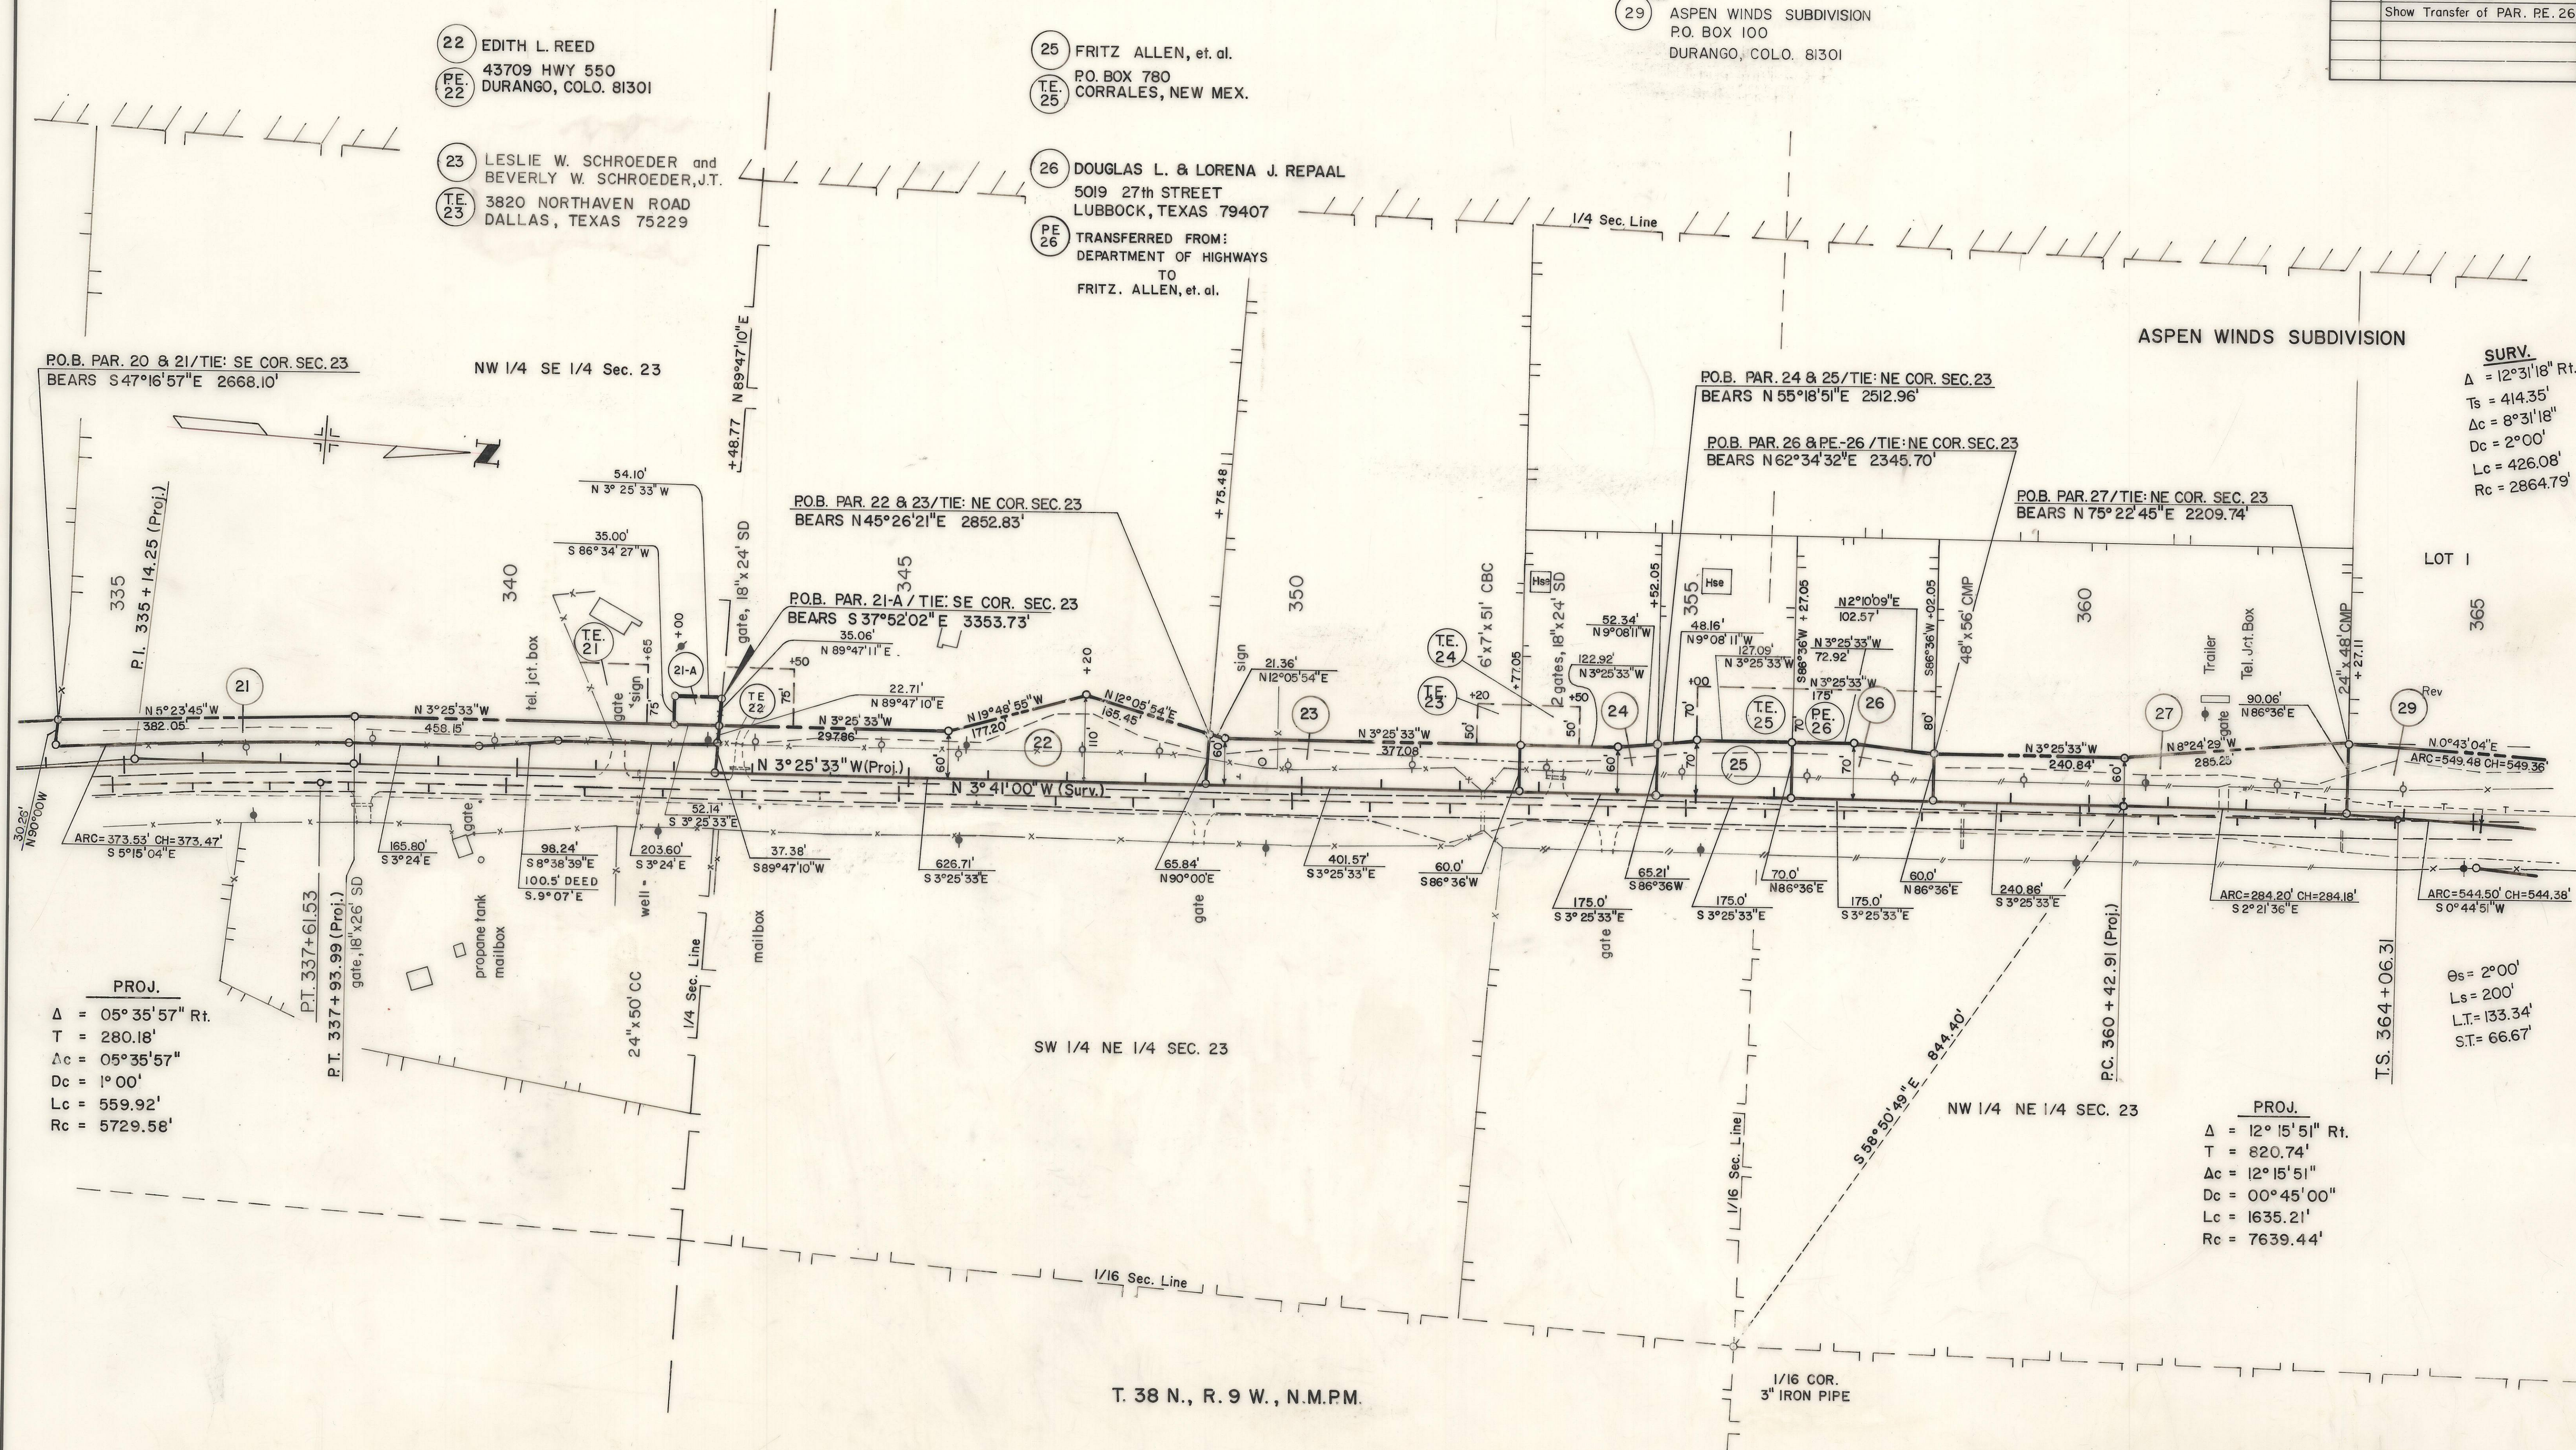


FEDERAL ROAD REGION NO.	DIVISION	PROJ. NO.	SHEET NO.	TOTAL SHEETS
VIII	COLORADO	FC 550-2(9) Sec. 2	7	9

RIGHT OF WAY		
ROCKWOOD TO PURGATORY		
REVISIONS		
3-4-83	Rev. Par. 29, Added 29A	D.M.
6-7-84	Par. 28, Corr. course 3	C.P.

PROJ. & SURV.
 $\Delta = 31^{\circ} 39' 10''$ Lt.
Ts = 564.32'
 $\Delta c = 24^{\circ} 39' 10''$
Dc = $3^{\circ} 30'$
Lc = 704.37'
Rc = 1637.02'

 $\theta s = 3^{\circ} 30'$
Ls = 200'
L.T. = 133.36'
S.T. = 66.69'

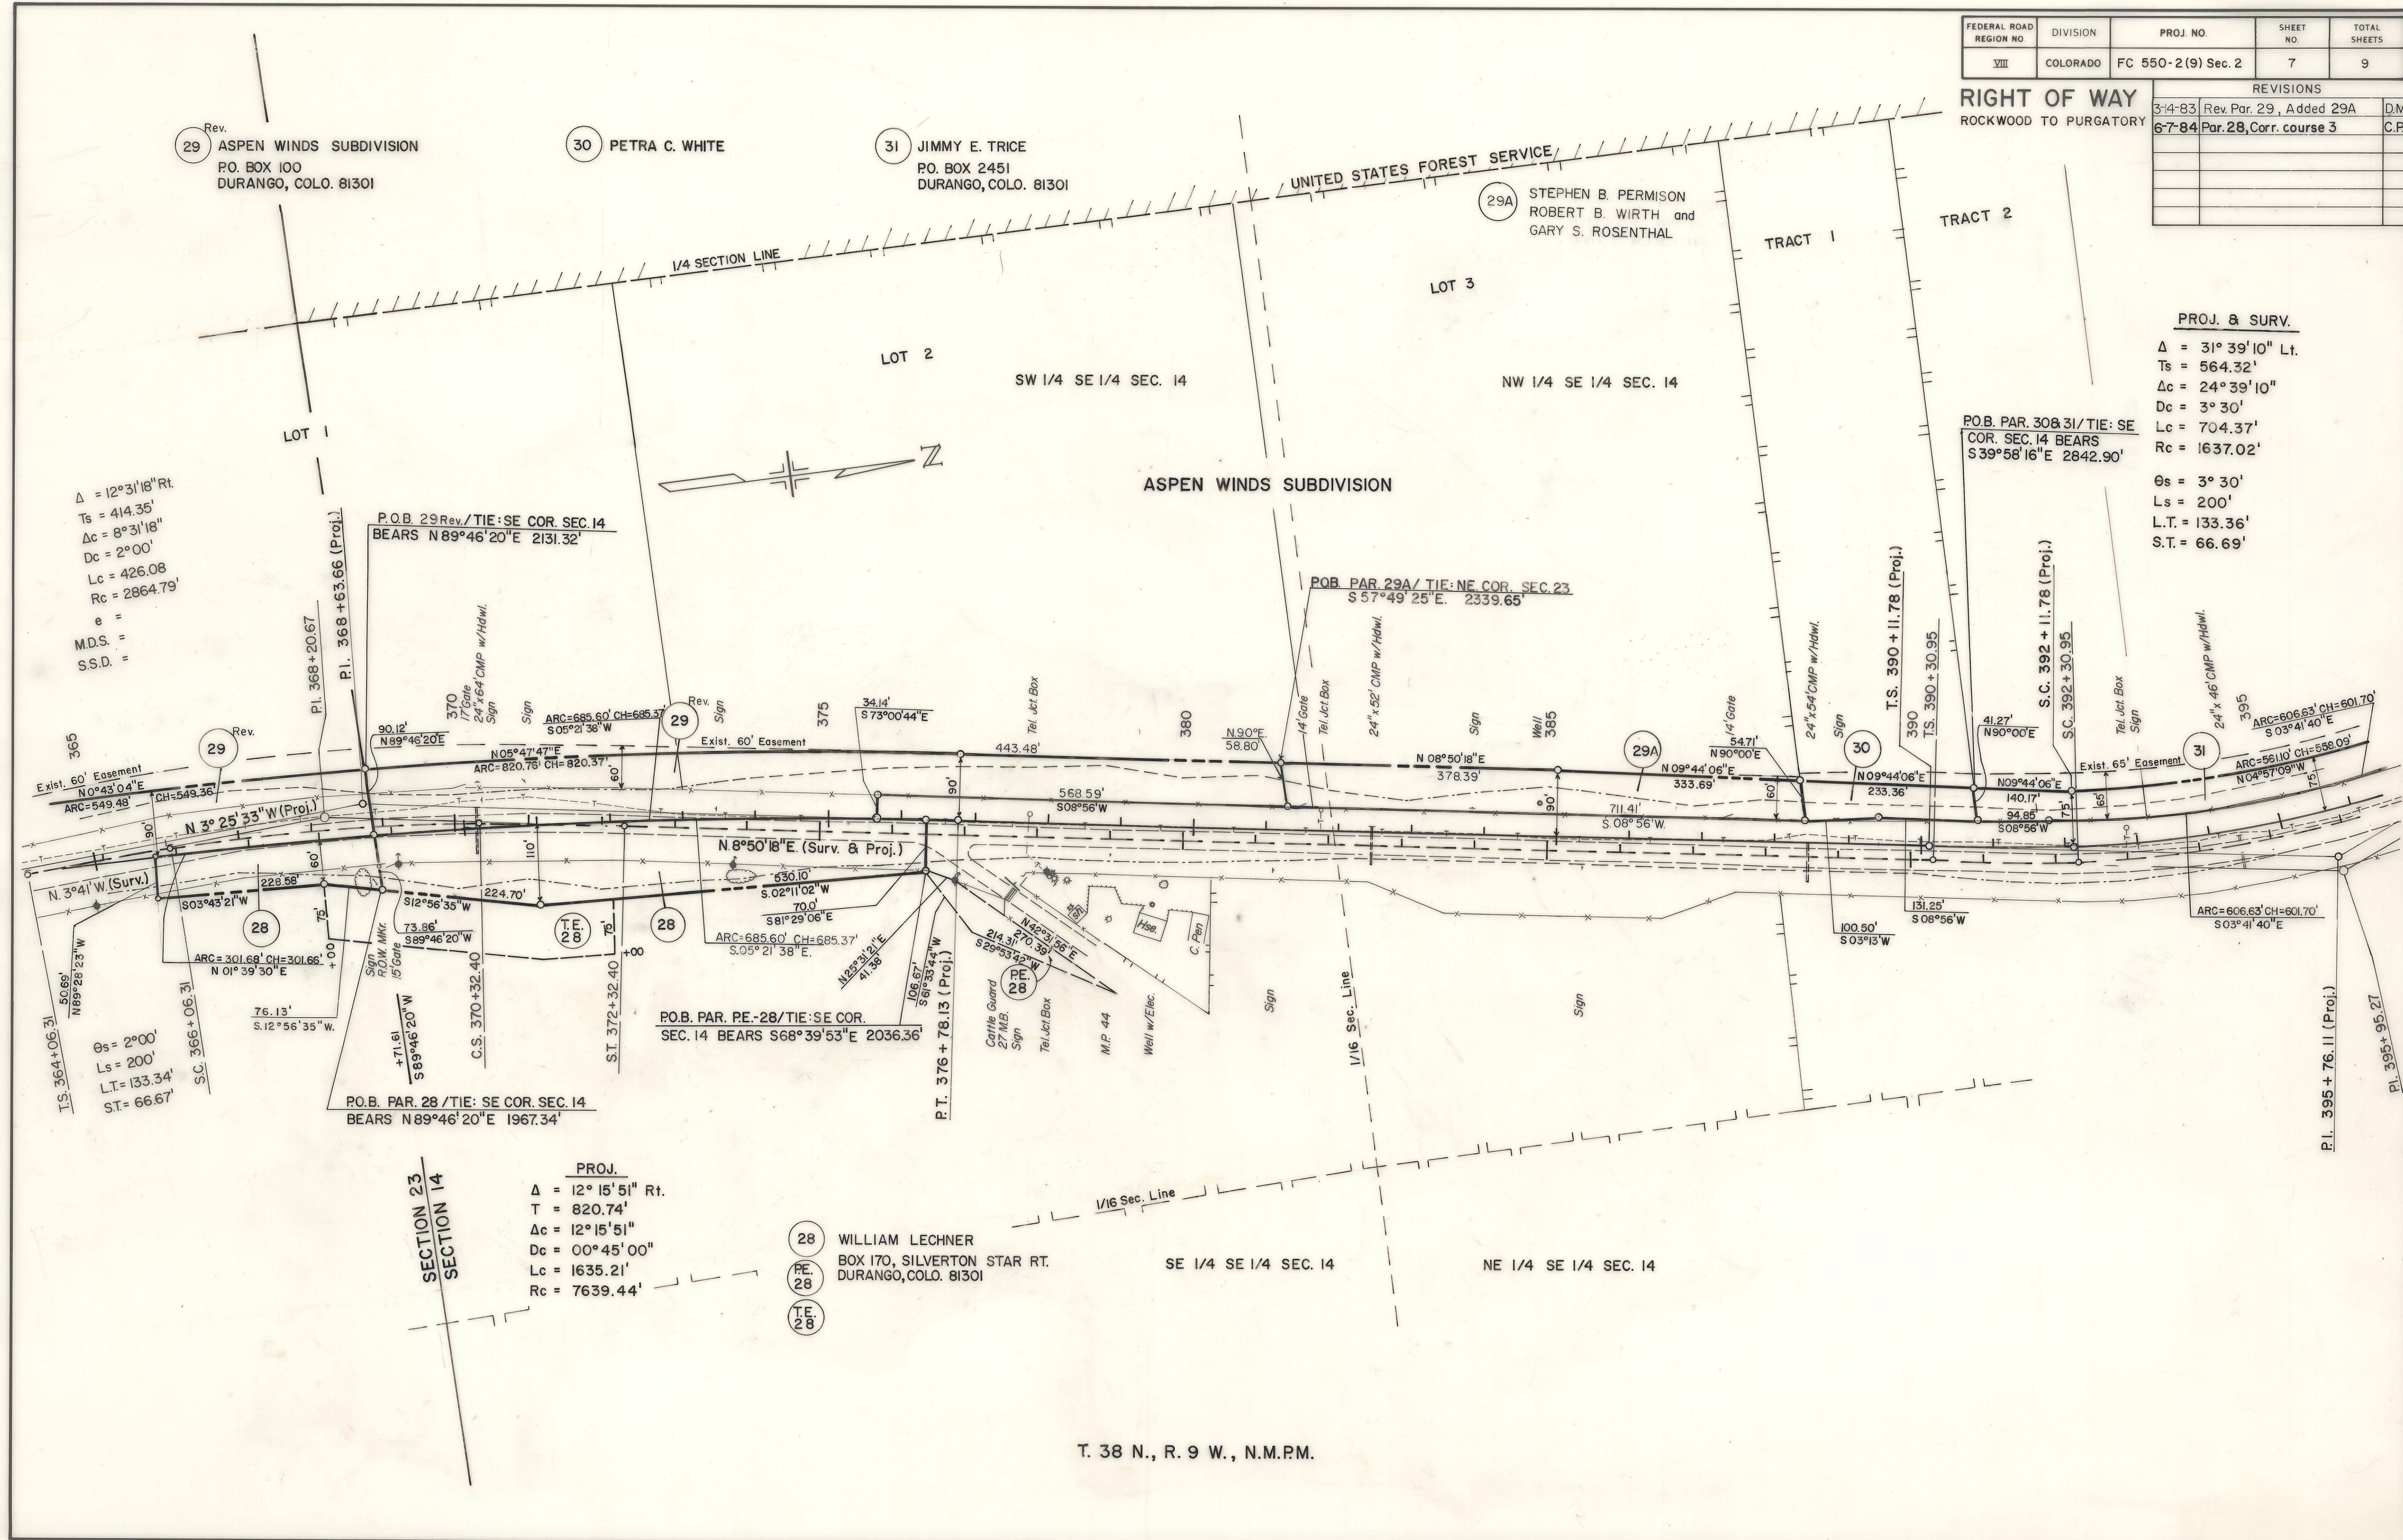

T. 38 N., R. 9 W., N.M.P.M.

[illegible]

KEY TO OWNERSHIP

FEDERAL ROAD REGION NO.	DIVISION	PROJ. NO.	SHEET NO.	TOTAL SHEETS
VIII	COLORADO	FC 550-2(9) Sec 2	9	9

RIGHT OF WAY ROCKWOOD TO PURGATORY			
REVISIONS			
9/17/82	Name Change 23 & TE-23	DAZ	
3-14-83	Rev. Par. 29, Added 29A	D.M.	

- 15

RALPH D. WATTERS, Trustee

16

MINTON I. MOORE &
INA MAY MOORE J.T.

18

PETER K. BOLI, W. JILL BOLI,
BRADNEY A. BOLI and TIFFANI K. BOLI J.T.

21

JAMES R. FLACK, Trustee

22

EDITH L. REED

24

JANET FARRINGTON YOUNGBERG
NANCY FARRINGTON HIGGINS
ANTHONY S. FARRINGTON
J.C. FARRINGTON III.

27

LEE M. & HAZEL RATCLIFFE J.T.

29

ASPEN WINDS II, a limited partnership

31

JIMMY E. TRICE

32

THOMAS E. SIDDLE & JEAN SIDDLE J.T.

33

HERSHEL H. WHITE and
VIRGINIA L. WHITE

34

JANE RAPP

35

UTAH POWER & LIGHT COMPANY

36

PETRA C. WHITE

37

LAKEWOOD MEADOWS SUBDIVISION

38

MILTON S. ROUSH &
DOROTHY Z. ROUSH

39

STEPHEN B. PERMISON
ROBERT B. WIRTH and
GARY S. ROSENTHAL

40

LESLIE W. SCHROEDER
BEVERLY W. SCHROEDER, J.T.

41

FRITZ ALLEN, et. al.

42

JOSEPH J. CNOVANEK &
LYDIA J. CNOVANEK

43

DAVID G. McEWEN &
SANDRA K. McEWEN

44

PAUL R. CULWELL &
MARTHA N. CULWELL

45

DON D. ROSELIUS and
CAMILLE Y. ROSELIUS

46

MILDRED L. COX (1/2)
FRANCES C. McNAMEE (1/2)

47

MILTON F. LECHNER, DOROTHY M. LECHNER,
JOHN M. LECHNER & ROBERT E. LECHNER

48

ALBERT J. & JOSEPHINE G. LECHNER

49

STATE OF COLORADO
(GAME & FISH)

50

UNITED STATES FOREST SERVICE
(FOREST SERVICE)

51

RUEDI BAER

52

MILTON F. LECHNER, Trustee
DOROTHY M. LECHNER
JOHN LECHNER

53

JACK M. DOYLE,
ADVERTISING INCORPORATED

54

ROBERT L. FRAZER &
DOROTHY B. FRAZER

55

EARL V. MASON and KORLEEN MASON

56

PAUL E. FOLWELL
SARA C. FOLWELL

57

E. HOLT WYCKOFF and
CHARLENE WYCKOFF

58

I. J. JARVIS

59

DOUGLAS L. REPAAL and
LORENA J. REPAAL

60

WILLIAM LECHNER
-
- T. 38 N., R. 9 W., N.M.P.M.



COLORADO
Department of
Transportation

DOCUMENT SEPARATOR SHEET

REGION 5 – JUNE 2017 CONVERSION

To be placed at the beginning of each separator sheet.



r500002077

Description:

ROW Plans 11X17

Route # and Mile Points:

US 550

Originating Office:

ROW/Survey

File Name:

FC 550-2(9) Sec 2_ROW(.PDF)

Box Location:

32 of 38

RIGHT OF WAY
TO BE ACQUIRED
FROM

PARCEL NO. 10 REV.
STA. 270+ TO STA. 286+

RUEDI BEAR

FOR

PROJ. NO. FC 550-2(9) Sec. 2
ROCKWOOD TO PURGATORY

STATE HIGHWAY NO. 550

DESCRIPTION

A tract or parcel of land No. 10 Rev. of the State Department of Highways, Division of Highways, State of Colorado, Project No. FC 550-2(9) Sec. 2 containing 0.500 acres, more or less, in the NE 1/4 of the SE 1/4 and the SE 1/4 of the SE 1/4 of Section 26, Township 38 North, Range 9 West, of the New Mexico Principal Meridian, in La Plata County, Colorado, said tract or parcel being more particularly described as follows:

Beginning at a point from which the east 1/4 corner of said Sec. 26 bears S. 89° 06' 33" E., a distance of 280.01 feet;

1. Thence N. 89° 06' 33" W. along the north line of the NE 1/4 of the SE 1/4 of Sec. 26 a distance of 10.02 feet to a point on the easterly right of way line of SH 550 (Dec. 17, 1981);
2. Thence S. 02° 42' E. along said right of way line a distance of 1,615.81 feet;
3. Thence N. 78° 49' E., a distance of 27.03 feet;
4. Thence N. 07° 34' 22" W. a distance of 87.12 feet;
5. Thence N. 02° 40' 30" W., a distance of 400.00 feet;
6. Thence N. 05° 32' 15" W., a distance of 200.25 feet;
7. Thence N. 02° 40' 30" W., a distance of 924.38 feet, more or less, to the point of beginning.

The above described parcel contains 0.500 acres, more or less.

RIGHT OF WAY
TO BE ACQUIRED
FROM

PARCEL NO. 13
STA. 286+ TO STA. 299+

STATE OF COLORADO
(FISH & GAME)

FOR

PROJ. NO. FC 550-2(9) Sec. 2
ROCKWOOD TO PURGATORY

STATE HIGHWAY NO. 550

DESCRIPTION

A tract or parcel of land No. 13 of the State Department of Highways, Division of Highways, State of Colorado, Project No. FC 550-2(9) Sec. 2 containing 6.629 acres, more or less, in the SE 1/4 of the NE 1/4 of Section 26, Township 38 North, Range 9 West, of the New Mexico Principal Meridian, in La Plata County, Colorado, said tract or parcel being more particularly described as follows:

Beginning at a point from which the east 1/4 corner of said Sec. 26 bears S. 89° 06' 33" E., a distance of 280.01 feet;

1. Thence N. 03° 15' 38" E., a distance of 502.69 feet;
2. Thence N. 08° 40' 57" W., a distance of 294.50 feet;
3. Thence N. 15° 23' 57" W., a distance of 269.46 feet to a point on the easterly right of way line of SH 550 (Dec. 18, 1981);
4. Thence along said right of way line along the arc of a curve to the left, with a radius of 1,497.49 feet, a distance of 276.33 feet (the chord of this arc bears N. 21° 33' 50" W., a distance of 275.94 feet) to a point on the north line of the SE 1/4 of the NE 1/4 of said Sec. 26;
5. Thence N. 89° 39' 16" W. along said 1/16th section line a distance of 198.58 feet;
6. Thence S. 05° 17' 31" W., a distance of 227.31 feet;
7. Thence S. 18° 26' 24" E., a distance of 276.90 feet;
8. Thence S. 41° 11' 22" E., a distance of 216.38 feet;
9. Thence S. 04° 34' 53" E., a distance of 371.55 feet;
10. Thence S. 02° 40' 30" E., a distance of 286.61 feet to a point on the south line of the NE 1/4 of said Sec. 26;
11. Thence S. 89° 06' 33" E. along said 1/4 section line a distance of 135.26 feet, more or less, to the point of beginning.

The above described parcel contains 6.629 acres, more or less, of which 3.409 acres are in the right of way of the present road.

RIGHT OF WAY
TO BE ACQUIRED
FROM

PARCEL NO. 14
STA. 299+ TO STA. 307+

MILTON F. LECHNER, Trustee

FOR

PROJ. NO. FC 550-2(9) Sec. 2
ROCKWOOD TO PURGATORY

STATE HIGHWAY NO. 550

DESCRIPTION

A tract or parcel of land No. 14 of the State Department of Highways, Division of Highways, State of Colorado, Project No. FC 550-2(9) Sec. 2 containing 0.899 acres, more or less, in the NE 1/4 of the NE 1/4 of Section 26, Township 38 North, Range 9 West, of the New Mexico Principal Meridian, in La Plata County, Colorado, said tract or parcel being more particularly described as follows:

Beginning at a point from which the NE corner of Sec. 26 bears N. 57° 57' 36" E., a distance of 1,298.56 feet;

1. Thence N. 64° 59' 00" E., a distance of 42.02 feet to a point on the westerly right of way line of SH 550 (Dec. 18, 1981);
2. Thence along said right of way line S. 36° 18' 55" E. (Deed Bearing S. 36° 17' E.) a distance of 359.88 feet;
3. Thence along said right of way line S. 44° 49' E., a distance of 101.10 feet;
4. Thence along said right of way line S. 36° 17' E., a distance of 165.70 feet;
5. Thence along said right of way line along the arc of a curve to the right, with a radius of 1,382.47 feet, a distance of 167.84 feet (the chord of this arc bears S. 32° 48' 20" E., a distance of 167.74 feet) to a point on the south line of the NE 1/4 of the NE 1/4 of said Sec. 26;
6. Thence N. 89° 39' 16" W. along said 1/16th section line a distance of 67.84 feet;
7. Thence N. 34° 54' 01" W., a distance of 264.11 feet;
8. Thence N. 35° 50' 57" W., a distance of 196.49 feet;
9. Thence N. 36° 40' 30" W., a distance of 82.91 feet;
10. Thence N. 36° 15' 24" W., a distance of 201.74 feet;
11. Thence N. 33° 18' 52" W., a distance of 15.58 feet, more or less, to the point of beginning.

The above described parcel contains 0.899 acres, more or less.

RIGHT OF WAY
TO BE ACQUIRED
FROM

PARCEL NO. 15
STA. 307+ TO STA. 315+

FOR

RALPH D. WATTERS, Trustee
DONALD R. HOEL and
JUANITA A. HOEL

PROJ. NO. FC 550-2(9) Sec. 2
ROCKWOOD TO PURGATORY

STATE HIGHWAY NO. 550

DESCRIPTION

A tract or parcel of land No. 15 of the State Department of Highways, Division of Highways, State of Colorado, Project No. FC 550-2(9) Sec. 2 containing 0.356 acres, more or less, in the N 1/2 of the NE 1/4 of Section 26, Township 38 North, Range 9 West, of the New Mexico Principal Meridian, in LaPlata County, Colorado, said tract or parcel being more particularly described as follows:

Beginning at a point from which the NE corner of Sec. 26 bears N. 57° 57' 36" E., a distance of 1,298.56 feet;

1. Thence N. 33° 18' 52" W., a distance of 327.93 feet;
2. Thence N. 25° 31' 57" W., a distance of 454.05 feet to a point on the westerly right of way line of SH 550 (Jan. 11, 1982);
3. Thence along said right of way line along the arc of a curve to the left, with a radius of 3,420.64 feet, a distance of 239.26 feet (the chord of this arc bears S. 28° 57' 20" E., a distance of 239.21 feet);
4. Thence along said westerly right of way line S. 23° 21' 07" E., a distance of 104.08 feet;
5. Thence along said right of way line along the arc of a curve to the left, with a radius of 3,435.93 feet, a distance of 216.08 feet (the chord of this arc bears S. 34° 28' 54" E., a distance of 216.05 feet);
6. Thence S. 36° 18' 55" E. along said right of way line a distance of 227.14 feet;
7. Thence S. 64° 59' 00" W., a distance of 42.02 feet, more or less, to the point of beginning.

The above described parcel contains 0.356 acres, more or less.

RIGHT OF WAY
TO BE ACQUIRED
FROM

PARCEL NO. 16
STA. 312+ TO STA. 313+

MINTON I. MOORE and
INA MAY MOORE, J.T.

FOR

PROJ. NO. FC 550-2(9) Sec. 2
ROCKWOOD TO PURGATORY

STATE HIGHWAY NO. 550

DESCRIPTION

A tract or parcel of land No. 16 of the State Department of Highways, Division of Highways, State of Colorado, Project No. FC 550-2(9) Sec. 2 containing 0.034 acres, more or less, in the NE 1/4 of the NE 1/4 of Section 26, Township 38 North, Range 9 West, of the New Mexico Principal Meridian, in La Plata County, Colorado, said tract or parcel being more particularly described as follows:

Beginning at a point from which the NE corner of said Sec. 26 bears N. 83° 33' 12" E., a distance of 1,266.52 feet;

1. Thence S. 27° 52' 27" E., a distance of 109.09 feet to a point on the easterly right of way line of SH 550 (Jan. 11, 1982);
2. Thence N. 41° 19' 02" W., a distance of 100.07 feet;
3. Thence along the arc of a curve to the right, with a radius of 3,320.64 feet, a distance of 17.80 feet (the chord of this arc bears N. 30° 48' 39" W., a distance of 17.80 feet);
4. Thence N. 76° 06' 00" E., a distance of 24.91 feet, more or less, to the point of beginning.

The above described parcel contains 0.034 acres, more or less.

RIGHT OF WAY
TO BE ACQUIRED
FROM

PARCEL NO. 17
STA. 313+ TO STA. 321+

MILTON F. LECHNER, Trustee

FOR
PROJ. NO. FC 550-2(9) Sec. 2
ROCKWOOD TO PURGATORY

STATE HIGHWAY NO. 550

DESCRIPTION

A tract or parcel of land No. 17 of the State Department of Highways, Division of Highways, State of Colorado, Project No. FC 550-2(9) Sec. 2 containing 0.593 acres, more or less, in the NE 1/4 of the NE 1/4 of Section 26 and the S 1/2 of the SE 1/4 of Section 23, Township 38 North, Range 9 West, of the New Mexico Principal Meridian, in La Plata County, Colorado, said tract or parcel being more particularly described as follows:

Beginning at a point on the north line of Sec. 26, T. 38 N., R. 9 W., N.M.P.M., from which the NE corner of said Sec. 26 bears N. 89° 48' 00" E., a distance of 1,329.76 feet;

1. Thence along the arc of a curve to the left, with a radius of 4,508.66 feet, a distance of 81.55 feet (the chord of this arc bears S. 26° 56' 09" E., a distance of 81.54 feet);
2. Thence S. 27° 52' 27" E., a distance of 73.37 feet;
3. Thence S. 76° 06' 00" W., a distance of 24.91 feet to a point on the easterly right of way line of SH 550 (Dec. 19, 1981)
4. Thence along said right of way line along the arc of a curve to the right, with a radius of 3,320.64 feet, a distance of 164.39 feet (the chord of this arc bears N. 29° 14' 21" W., a distance of 164.37 feet) to a point on the north line of said Sec. 26;
5. Thence N. 89° 48' 00" E., along said north section line a distance of 33.23 feet, more or less, to the point of beginning.


The above described portion of Parcel 17 contains 0.099 acres, more or less.

ALSO

Beginning at a point on the south line of Sec. 23, T. 38 N., R. 9 W., N.M.P.M., from which the SE corner of said Sec. 23 bears N. 89° 48' 00" E., a distance of 1,329.76 feet;

1. Thence S. 89° 48' 00" W. along said section line a distance of 33.23 feet to a point on the easterly right of way line of SH 550 (Dec. 19, 1981);

PARCEL NO. 17
STA. 313+ TO STA. 321+
PROJ. NO. 550-2(9) Sec. 2
ROCKWOOD TO PURGATORY
Page Two

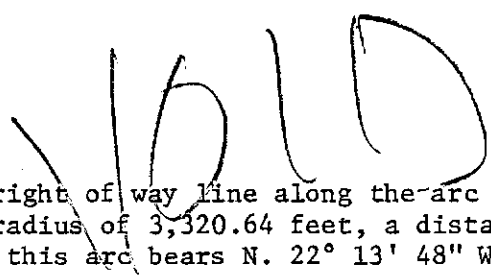- 
2. Thence along said right of way line along the arc of a curve to the right, with a radius of 3,320.64 feet, a distance of 648.05 feet (the chord of this arc bears N. 22° 13' 48" W., a distance of 647.03 feet);
 3. Thence S. 82° 40' 00" E., a distance of 42.68 feet;
 4. Thence S. 05° 07' 12" E., a distance of 33.38 feet;
 5. Thence along the arc of a curve to the left, with a radius of 4508.66 feet, a distance of 607.00 feet (the chord of this arc bears S. 22° 33' 39" E., a distance of 606.54 feet), more or less, to the point of beginning.

The above described portion of Parcel 17 contains 0.494 acres, more or less.

The above described parcel contains a total of 0.593 acres, more or less.

RIGHT OF WAY
TO BE ACQUIRED
FROM

PARCEL NO. 18
STA. 321+ TO STA. 322+

PETER K. BOLI; W. JILL BOLI;
BRADNEY A. BOLI;
TIFFANI K. BOLI

FOR

PROJ. NO. FC 550-2(9) Sec. 2
ROCKWOOD TO PURGATORY

STATE HIGHWAY NO. 550

DESCRIPTION

A tract or parcel of land No. 18 of the State Department of Highways, Division of Highways, State of Colorado, Project No. FC 550-2(9) Sec. 2 containing 0.103 acres, more or less, in the SW 1/4 of the SE 1/4 of Section 23, Township 38 North, Range 9 West, of the New Mexico Principal Meridian, in La Plata County, Colorado, said tract or parcel being more particularly described as follows:

Beginning at a point from which the SE corner of said Sec. 23 bears S. 66° 09' 26" E., a distance of 1,722.01 feet;

1. Thence S. 05° 07' 12" E., a distance of 107.78 feet;
2. Thence N. 82° 40' 00" W., a distance of 42.68 feet to a point on the easterly right of way of SH 550 (Jan. 11, 1982);
3. Thence along said right of way along the arc of a curve to the right, with a radius of 3,320.64 feet, a distance of 74.65 feet (the chord of this arc bears N. 15° 59' 42" W., a distance of 74.65 feet);
4. Thence N. 60° 30' 00" E., a distance of 61.22 feet, more or less, to the point of beginning.

The above described parcel contains 0.103 acres, more or less.

RIGHT OF WAY
TO BE ACQUIRED
FROM

PARCEL NO. 19
STA. 322+ TO STA. 326+

MILTON F. LECHNER, Trustee

PROJ. NO. FC 550-2(9) Sec. 2
ROCKWOOD TO PURGATORY

STATE HIGHWAY NO. 550

FOR

DESCRIPTION

A tract or parcel of land No. 19 of the State Department of Highways, Division of Highways, State of Colorado, Project No. FC 550-2(9) Sec. 2 containing 0.150 acres, more or less, in the SW 1/4 of the SE 1/4 of Section 23, Township 38 North, Range 9 West, of the New Mexico Principal Meridian, in LaPlata County, Colorado, said tract or parcel being more particularly described as follows:

Beginning at a point from which the SE corner of said Sec. 23 bears S. 66° 09' 26" E., a distance of 1,722.01 feet;

1. Thence S. 60° 30' 00" W., a distance of 61.22 feet to a point on the easterly right of way line of SH 550 (Dec. 19, 1981);
2. Thence along said right of way line along the arc of a curve to the right, with a radius of 3,320.64 feet, a distance of 365.18 feet (the chord of this arc bears N. 12° 12' 02" W., a distance of 365.00 feet);
3. Thence S. 14° 32' 08" E., a distance of 242.71 feet;
4. Thence S. 37° 10' 06" E., a distance of 115.04 feet, more or less, to the point of beginning.

The above described parcel contains 0.150 acres, more or less.

RIGHT OF WAY
TO BE ACQUIRED
FROM

PARCEL NO. 20
STA. 321+ TO STA. 334+

MILTON F. LECHNER, Trustee

FOR

PROJ. NO. FC 550-2(9) Sec. 2
ROCKWOOD TO PURGATORY

STATE HIGHWAY NO. 550

DESCRIPTION

A tract or parcel of land No. 20 of the State Department of Highways, Division of Highways, State of Colorado, Project No. FC 550-2(9) Sec. 2 containing 1.123 acres, more or less, in the W. 1/2 of the SE 1/4 of Section 23, Township 38 North, Range 9 West, of the New Mexico Principal Meridian, in La Plata County, Colorado, said tract or parcel being more particularly described as follows:

Beginning at a point from which the SE corner of Sec. 23 bears S. 47° 16' 57" E., a distance of 2,668.10 feet;

1. Thence N. 90° E., a distance of 30.26 feet to a point on the westerly right of way line of SH 550 (Dec. 19, 1981);
2. Thence along said right of way line along the arc of a curve to the left, with a radius of 5,779.35 feet, a distance of 196.47 feet (the chord of this arc bears S. 08° 04' 35" E., a distance of 196.46 feet);
3. Thence S. 09° 03' E. along said right of way line a distance of 616.00 feet;
4. Thence along said right of way line along the arc of a curve to the left, with a radius of 3,420.64 feet, a distance of 467.30 feet (the chord of this arc bears S. 12° 57' 50" E., a distance of 466.94 feet);
5. Thence N. 20° 25' 49" W., a distance of 263.65 feet;
6. Thence N. 12° 00' 28" W., a distance of 582.00 feet;
7. Thence N. 22° 26' 57" W., a distance of 129.22 feet;
8. Thence N. 00° 49' 58" E., a distance of 306.24 feet;
9. Thence N. 05° 23' 45" W., a distance of 15.99 feet, more or less, to the point of beginning.

The above described parcel contains 1.123 acres, more or less.

RIGHT OF WAY
TO BE ACQUIRED
FROM

PARCEL NO. 21
STA. 334+ TO STA. 342+

JAMES R. FLACK, trustee

FOR

PROJ. NO. FC 550-2(9) SEC. 2
ROCKWOOD-PURGATORY

STATE HIGHWAY NO. 550

DESCRIPTION

A tract or parcel of land No. 21 of the State Department of Highways, Division of Highways, State of Colorado, Project No. FC 550-2(9) Sec. 2 containing 0.531 acres, more or less, in the NW 1/4 of the SE 1/4 of Section 23, Township 38 North, Range 9 West, of the New Mexico Principal Meridian, in LaPlata County, Colorado, said tract or parcel being more particularly described as follows:

Beginning at a point from which the SE corner of said Sec. 23 bears S. 47° 16' 57" E., a distance of 2,668.10 feet;

1. Thence N. 05° 23' 45" W., a distance of 382.05 feet;
2. Thence N. 03° 25' 33" W., a distance of 458.15 feet to a point on the north line of the SE 1/4 of said Sec. 23;
3. Thence N. 89° 47' 10" E. along said 1/4 section line a distance of 22.71 feet to a point on the westerly right of way line of SH 550 (Dec. 19, 1981);
4. Thence S. 03° 24' 00" E. along said right of way line a distance of 203.60 feet;
5. Thence S. 08° 38' 39" E. along said right of way line a distance of 98.24 feet (Deed: S. 09° 07' E. a distance of 100.5 feet);
6. Thence S. 03° 24' E. along said right of way line a distance of 165.80 feet;
7. Thence along said right of way line along the arc of a curve to the left, with a radius of 5,779.35 feet, a distance of 373.53 feet (the chord of this arc bears S. 05° 15' 04" E., a distance of 373.47 feet);
8. Thence N. 90° W., a distance of 30.26 feet, more or less, to the point of beginning.

The above described parcel contains 0.531 acres, more or less.

RIGHT OF WAY
TO BE ACQUIRED
FROM

PARCEL NO. 22
STA. 342+ TO STA. 348+

EDITH L. REED

FOR

PROJ. NO. FC 550-2(9) Sec. 2
ROCKWOOD - PURGATORY

STATE HIGHWAY NO. 550

DESCRIPTION

A tract or parcel of land No. 22 of the State Department of Highways, Division of Highways, State of Colorado, Project No. FC 550-2(9) Sec. 2 containing 1.063 acres, more or less, in the SW 1/4 of the NE 1/4 of Section 23, Township 38 North, Range 9 West, of the New Mexico Principal Meridian, in La Plata County, Colorado, said tract or parcel being more particularly described as follows:

Beginning at a point from which the NE corner of said Sec. 23 bears N. 45° 26' 21" E., a distance of 2,852.83 feet;

1. Thence N. 90° E., a distance of 65.84 feet;
2. Thence S. 03° 25' 33" E., a distance of 626.71 feet to a point on the south line of the NE 1/4 of said Sec. 23;
3. Thence S. 89° 47' 10" W. along said 1/4 section line a distance of 60.09 feet;
4. Thence N. 03° 25' 33" W., a distance of 297.86 feet;
5. Thence N. 19° 48' 55" W., a distance of 177.20 feet;
6. Thence N. 12° 05' 54" E., a distance of 165.45 feet, more or less, to the point of beginning.

The above described parcel contains 1.063 acres, more or less, of which 0.572 acres are in the right of way of the present road.

4/9/82

dm/M

RIGHT OF WAY
TO BE ACQUIRED
FROM

PARCEL NO. 23
STA. 348+ TO STA. 352+

ASPEN WINDS II, a
limited partnership

FOR

PROJ. NO. FC 550-2(9) Sec. 2
ROCKWOOD TO PURGATORY

STATE HIGHWAY NO. 550

DESCRIPTION

A tract or parcel of land No. 23 of the State Department of Highways, Division of Highways, State of Colorado, Project No. FC 550-2(9) Sec. 2 containing 0.552 acres, more or less, in the SW 1/4 of the NE 1/4 of Section 23, Township 38 North, Range 9 West, of the New Mexico Principal Meridian, in La Plata County, Colorado, said tract or parcel being more particularly described as follows:

Beginning at a point from which the NE corner of said Sec. 23 bears N. 45° 26' 21" E., a distance of 2,852.83 feet;

1. Thence N. 12° 05' 54" E., a distance of 21.36 feet;
2. Thence N. 03° 25' 33" W., a distance of 377.08 feet;
3. Thence N. 86° 36' 00" E., a distance of 60.00 feet;
4. Thence S. 03° 25' 33" E., a distance of 401.57 feet;
5. Thence S. 90° 00' 00" W., a distance of 65.84 feet, more or less, to the point of beginning.

The above described parcel contains 0.552 acres of which 0.299 acres are in the right of way of the present road.

RIGHT OF WAY
TO BE ACQUIRED
FROM

PARCEL NO. 24
STA. 352+ TO STA. 354+

ANTHONY S. FARRINGTON,
JANET FARRINGTON YOUNGBERG,
NANCY FARRINGTON HIGGINS,
J. C. FARRINGTON

FOR

PROJ. NO. FC 550-2(9) Sec. 2
ROCKWOOD TO PURGATORY

STATE HIGHWAY NO. 550

DESCRIPTION

A tract or parcel of land No. 24 of the State Department of Highways, Division of Highways, State of Colorado, Project No. FC 550-2(9) Sec. 2 containing 0.244 acres, more or less, in the SW 1/4 of the NE 1/4 of Section 23, Township 38 North, Range 9 West, of the New Mexico Principal Meridian, in La Plata County, Colorado, said tract or parcel being more particularly described as follows:

Beginning at a point from which the NE corner of said Sec. 23 bears N. 55° 18' 51" E., a distance of 2,512.96 feet;

1. Thence N. 86° 36' 00" E., a distance of 65.21 feet;
2. Thence S. 03° 25' 33" E., a distance of 175.00 feet;
3. Thence S. 86° 36' 00" W., a distance of 60.00 feet;
4. Thence N. 03° 25' 33" W., a distance of 122.92 feet;
5. Thence N. 09° 08' 11" W., a distance of 52.34 feet, more or less, to the point of beginning.

The above described parcel contains 0.244 acres, more or less, of which 0.128 acres are in the right of way of the present road.

RIGHT OF WAY
TO BE ACQUIRED
FROM

PARCEL NO. 25
STA. 354+ TO STA. 356+

FRITZ ALLEN, et al.

FOR

PROJ. NO. FC 550-2(9) Sec. 2
ROCKWOOD TO PURGATORY

STATE HIGHWAY NO. 550

DESCRIPTION

A tract or parcel of land No. 25 of the State Department of Highways, Division of Highways, State of Colorado, Project No. FC 550-2(9) Sec. 2 containing 0.279 acres, more or less, in the W. 1/2 of the NE 1/4 of Section 23, Township 38 North, Range 9 West, of the New Mexico Principal Meridian, in La Plata County, Colorado, said tract or parcel being more particularly described as follows:

Beginning at a point from which the NE corner of said Sec. 23 bears N. 55° 18' 51" E., a distance of 2,512.96 feet;

1. Thence N. 09° 08' 11" W., a distance of 48.16 feet;
2. Thence N. 03° 25' 33" W., a distance of 127.09 feet;
3. Thence N. 86° 36' 00" E., a distance of 70.00 feet;
4. Thence S. 03° 25' 33" E., a distance of 175.00 feet;
5. Thence S. 86° 36' 00" W., a distance of 65.21 feet, more or less, to the point of beginning.

The above described parcel contains 0.279 acres, more or less, of which 0.128 acres are in the right of way of the present road.

RIGHT OF WAY
TO BE ACQUIRED
FROM

PARCEL NO. 26
STA. 356+ TO STA. 358+

DOUGLAS L. REPAAL and
LORENA J. REPAAL

FOR

PROJ. NO. FC 550-2(9) Sec. 2
ROCKWOOD TO PURGATORY

STATE HIGHWAY NO. 550

DESCRIPTION

A tract or parcel of land No. 26 of the State Department of Highways, Division of Highways, State of Colorado, Project No. FC 550-2(9) Sec. 2 containing 0.270 acres, more or less, in the NW 1/4 of the NE 1/4 of Section 23, Township 38 North, Range 9 West, of the New Mexico Principal Meridian, in La Plata County, Colorado, said tract or parcel being more particularly described as follows:

Beginning at a point from which the NE corner of said Sec. 23 bears N. 62° 34' 32" E., a distance of 2,345.70 feet;

1. Thence N. 86° 36' 00" E., a distance of 60.00 feet;
2. Thence S. 03° 25' 33" E., a distance of 175.00 feet;
3. Thence S. 86° 36' 00" W., a distance of 70.00 feet;
4. Thence N. 03° 25' 33" W., a distance of 72.92 feet;
5. Thence N. 02° 10' 09" E., a distance of 102.57 feet, more or less, to the point of beginning.

The above described parcel contains 0.270 acres, more or less, of which 0.128 acres are in the right of way of the present road.

PERMANENT EASEMENT
TO BE ACQUIRED
FROM

PARCEL NO. PE-26
STA. 356+ TO STA. 358+

DOUGLAS L. REPAAL and
LORENA J. REPAAL

FOR

PROJ. NO. FC 550-2(9) Sec. 2
ROCKWOOD TO PURGATORY

STATE HIGHWAY NO. 550

DESCRIPTION

A tract or parcel of land No. PE-26 of the State Department of Highways, Division of Highways, State of Colorado, Project No. FC 550-2(9) Sec. 2 containing 0.293 acres, more or less, in the NW 1/4 of the NE 1/4 of Section 23, Township 38 North, Range 9 West, of the New Mexico Principal Meridian, in LaPlata County, Colorado, said tract or parcel being more particularly described as follows:

Beginning at a point from which the NE corner of said Sec. 23 bears N. 62° 34' 32" E., a distance of 2,345.70 feet;

1. Thence S. 02° 10' 09" W., a distance of 102.57 feet;
2. Thence S. 03° 25' 33" E., a distance of 72.92 feet;
3. Thence S. 86° 36' 00" W., a distance of 70.00 feet;
4. Thence N. 03° 25' 33" W., a distance of 175.00 feet;
5. Thence N. 86° 36' 00" E., a distance of 80.00 feet, more or less, to the point of beginning.

The above described permanent easement contains 0.293 acres, more or less.

RIGHT OF WAY
TO BE ACQUIRED
FROM

PARCEL NO. 27
STA. 358+ TO STA. 363+

LEE M. RATCLIFFE and
HAZEL RATCLIFFE

FOR

PROJ. NO. FC 550-2(9) Sec. 2
ROCKWOOD TO PURGATORY

STATE HIGHWAY NO. 550

DESCRIPTION

A tract or parcel of land No. 27 of the State Department of Highways, Division of Highways, State of Colorado, Project No. FC 550-2(9) Sec. 2 containing 0.815 acres, more or less, in the NW 1/4 of the NE 1/4 of Section 23, Township 38 North, Range 9 West, of the New Mexico Principal Meridian, in LaPlata County, Colorado, said tract or parcel being more particularly described as follows:

Beginning at a point from which the NE corner of said Sec. 23 bears N. 75° 22' 45" E., a distance of 2,209.74 feet;

1. Thence N. 86° 36' E., a distance of 90.06 feet;
2. Thence along the arc of a curve to the left, with a radius of 7,639.44 feet, a distance of 284.20 feet (the chord of this arc bears S. 02° 21' 36" E., a distance of 284.18 feet);
3. Thence S. 03° 25' 33" E., a distance of 240.86 feet;
4. Thence S. 86° 36' 00" W., a distance of 60.00 feet;
5. Thence N. 03° 25' 33" W., a distance of 240.84 feet;
6. Thence N. 08° 24' 29" W., a distance of 285.25 feet, more or less, to the point of beginning.

The above described parcel contains 0.815 acres, more or less, of which 0.390 acres are in the right of way of the present road.

RIGHT OF WAY
TO BE ACQUIRED
FROM

PARCEL NO. 28
STA. 365+ TO STA. 376+

WILLIAM LECHNER

FOR

PROJ. NO. FC 550-2(9) Sec. 2
ROCKWOOD-PURGATORY

STATE HIGHWAY NO. 550

DESCRIPTION

A tract or parcel of land No. 28 of the State Department of Highways, Division of Highways, State of Colorado, Project No. FC 550-2(9) Sec. 2 containing 2.020 acres, more or less, in the NW 1/4 of the NE 1/4 of Section 23 and the SW 1/4 of the SE 1/4 of Section 14, Township 38 North, Range 9 West, of the New Mexico Principal Meridian, in LaPlata County, Colorado, said tract or parcel being more particularly described as follows:

Beginning at a point on the north line of Sec. 23, T. 38 N., R. 9 W., N.M.P.M., from which the NE corner of said Sec. 23 bears N. 89° 46' 20" E., a distance of 1,967.34 feet;

1. Thence S. 12° 56' 35" W., a distance of 76.13 feet;
2. Thence S. 03° 43' 21" W., a distance of 228.58 feet;
3. Thence N. 89° 28' 23" W., a distance of 50.69 feet;
4. Thence along the arc of a curve to the right, with a radius of 7,639.44 feet, a distance of 301.68 feet (the chord of this arc bears N. 01° 39' 30" E., a distance of 301.66 feet) to a point on the north line of Sec. 23;
5. Thence N. 89° 46' 20" E. along said section line a distance of 73.86 feet, more or less, to the point of beginning.

The above described portion of Parcel 28 contains 0.407 acres of which 0.277 acres are in the right of way of the present road.

ALSO

Beginning at a point on the south line of Sec. 14, T. 38 N., R. 9 W., N.M.P.M., from which the SE corner of said Sec. 14 bears N. 89° 46' 20" E., a distance of 1,967.34 feet;

1. Thence S. 89° 46' 20" W. along said section line a distance of 73.86 feet;
2. Thence along the arc of a curve to the right, with a radius of 7,639.44 feet, a distance of 763.39 feet (the chord of this arc bears N. 05° 39' 08" E., a distance of 763.07 feet);

PROJECT NO. FC 550-2(9) Sec. 2

PARCEL NO. 28

ROCKWOOD-PURGATORY

PAGE TWO

3. Thence S. $81^{\circ} 29' 06''$ E., a distance of 70.00 feet;
4. Thence S. $02^{\circ} 11' 02''$ W., a distance of 530.10 feet;
5. Thence S. $12^{\circ} 56' 35''$ W., a distance of 224.70 feet, more or less, to the point of beginning.

The above described portion of Parcel 28 contains 1.613 acres of which 0.983 acres are in the right of way of the present road.

The above described parcel contains a total of 2.020 acres, more or less, of which 1.260 acres are in the right of way of the present road.

PERMANENT EASEMENT
TO BE ACQUIRED
FROM

PARCEL NO. PE-28
STA. 376+ TO STA. 379+

WILLIAM LECHNER

FOR

PROJ. NO. FC 550-2(9) Sec. 2
ROCKWOOD-PURGATORY

STATE HIGHWAY NO. 550

DESCRIPTION

A tract or parcel of land No. PE-28 of the State Department of Highways, Division of Highways, State of Colorado, Project No. FC 550-2(9) Sec. 2 containing 0.175 acres, more or less, in the SW 1/4 of the SE 1/4 of Section 14, Township 38 North, Range 9 West, of the New Mexico Principal Meridian, in LaPlata County, Colorado, said tract or parcel being more particularly described as follows:

Beginning at a point from which the SE corner of Sec. 14 bears S.68°39'53" E. a distance of 2,036.36 feet;

1. Thence N. 25° 31' 21" E., a distance of 41.38 feet;
2. Thence N. 42° 31' 56" E., a distance of 270.39 feet;
3. Thence S. 29° 53' 42" W., a distance of 214.31 feet;
4. Thence S. 61° 33' 44" W., a distance of 106.67 feet, more or less, to the point of beginning.

The above described parcel contains 0.175 acres, more or less.

For the purpose of a road approach (Permanent Access).

RIGHT OF WAY
TO BE ACQUIRED
FROM

PARCEL NO. 29
STA. 363+ TO STA. 288+

ASPEN WINDS II, a
Limited Partnership

FOR

PROJ. NO. FC 550-2(9) Sec. 2
ROCKWOOD-PURGATORY

STATE HIGHWAY NO. 550

DESCRIPTION

A tract or parcel of land No. 29 of the State Department of Highways, Division of Highways, State of Colorado, Project No. FC 550-2(9) Sec. 2 containing 4.253 acres, more or less, in Lots 1, 2 and 3 ASPEN WINDS NO. II SUBDIVISION in the NW 1/4 of the NE 1/4 of Sec. 23 and the W. 1/2 of the SE 1/4 of Section 14, Township 38 North, Range 9 West, of the New Mexico Principal Meridian, in La Plata County, Colorado, said tract or parcel being more particularly described as follows:

Beginning at a point on the north line of Sec. 23, T. 38 N., R. 9 W., N.M.P.M., from which the NE corner of said Sec. 23 bears N. 89° 46' 20" E., a distance of 2,131.32 feet;

1. Thence N. 89° 46' 20" E., a distance of 90.12 feet;
2. Thence along the arc of a curve to the left, with a radius of 7,639.44 feet, a distance of 544.50 feet (the chord of this arc bears S. 00° 44' 51" W., a distance of 544.38 feet);
3. Thence S. 86° 36' 00" W., a distance of 90.06 feet;
4. Thence along the arc of a curve to the right, with a radius of 7,729.44 feet, a distance of 549.48 feet (the chord of this arc bears N. 00° 43' 04" E., a distance of 549.36 feet), more or less, to the point of beginning.

The above described portion of Parcel 29 contains 1.130 acres of which 0.640 acres are in the right of way of the present road.

ALSO

Beginning at a point on the south line of Sec. 14, T. 38 N., R. 9 W., N.M.P.M. from which the SE corner of said Sec. 14 bears N. 89° 46' 20" E., a distance of 2,131.32 feet;

1. Thence along the arc of a curve to the right, with a radius of 7,729.44 feet, a distance of 820.76 feet (the chord of this arc bears N. 05° 47' 47" E., a distance of 820.37 feet);
2. Thence N. 08° 50' 18" E., a distance of 821.87 feet;

(Continued)

3. Thence N. $09^{\circ} 44' 06''$ E., a distance of 333.69 feet;
4. Thence N. 90° E., a distance of 54.71 feet to a point on the westerly right of way line of SH 550 (Dec. 21, 1981);
5. Thence S. $08^{\circ} 56'$ W. along said right of way line a distance of 1,280.00 feet;
6. Thence S. $73^{\circ} 00' 44''$ E., a distance of 34.14 feet;
7. Thence along the arc of a curve to the left, with a radius of 7,639.44 feet, a distance of 685.60 feet (the chord of this arc bears S. $05^{\circ} 21' 38''$ W., a distance of 685.37 feet) to a point on the south line of said Sec. 14;
8. Thence S. $89^{\circ} 46' 20''$ W. along said Section line a distance of 90.12 feet, more or less, to the point of beginning.

The above described portion of Parcel 29 contains 3.123 acres of which 0.683 acres are in the right of way of the present road.

The above above described parcel contains a total of 4.253 acres of which 1.323 acres are in the right of way of the present road.

RIGHT OF WAY
TO BE ACQUIRED
FROM

PARCEL NO. 30
STA. 388+ TO STA. 390+

PETRA C. WHITE

FOR

PROJ. NO. FC 550-2(9) Sec. 2
ROCKWOOD TO PURGATORY

STATE HIGHWAY NO. 550

DESCRIPTION

A tract or parcel of land No. 30 of the State Department of Highways, Division of Highways, State of Colorado, Project No. FC 550-2(9) Sec. 2 containing 0.238 acres, more or less, in Tract 1, ASPEN WINDS SUBDIVISION, in the NW 1/4 of the SE 1/4 of Section 14, Township 38 North, Range 9 West, of the New Mexico Principal Meridian, in La Plata County, Colorado, said tract or parcel being more particularly described as follows:

Beginning at a point from which the SE. corner of said Sec. 14 bears S. 39° 58' 16" E., a distance of 2,842.90 feet;

1. Thence N. 90° 00' 00" E., a distance of 41.27 feet to a point on the westerly right of way line of SH 550 (Jan. 11, 1982);
2. Thence S. 08° 56' 00" W. along said right of way, a distance of 131.25 feet;
3. Thence S. 03° 13' 00" W. along said right of way line a distance of 100.50 feet;
4. Thence N. 90° 00' 00" W., a distance of 54.71 feet;
5. Thence N. 09° 44' 06" E., a distance of 233.36 feet, more or less, to the point of beginning.

The above described parcel contains 0.238 acres, more or less.

RIGHT OF WAY
TO BE ACQUIRED
FROM

PARCEL NO. 31
STA. 391+ TO STA. 397+

JIMMY E. TRICE

FOR

PROJ. NO. FC 550-2(9) Sec. 2
ROCKWOOD TO PURGATORY

STATE HIGHWAY NO. 550

DESCRIPTION

A tract or parcel of land No. 31 of the State Department of Highways, Division of Highways, State of Colorado, Project No. FC 550-2(9) Sec. 2 containing 0.670 acres, more or less, in Tracts 2, 3 and 4 ASPEN WINDS SUBDIVISION in the NW 1/4 of the SE 1/4 and the SW 1/4 of the NE 1/4 of Section 14, Township 38 North, Range 9 West, of the New Mexico Principal Meridian, in LaPlata County, Colorado, said tract or parcel being more particularly described as follows:

Beginning at a point from which the SE corner of said Sec. 14 bears S. 39° 58' 16" E., a distance of 2,842.90 feet;

1. Thence N. 09° 44' 06" E., a distance of 140.17 feet;
2. Thence along the arc of a curve to the left with a radius of 1,562.02 feet, a distance of 561.10 feet (the chord of this arc bears N. 04° 57' 09" W., a distance of 558.09 feet);
3. Thence N. 90° E., a distance of 41.71 feet to a point on the westerly right of way line of SH 550 (Jan. 11, 1982);
4. Thence along said right of way line along the arc of a curve to the right, with a radius of 1,372.54 feet, a distance of 606.63 feet (the chord of this arc bears S. 03° 41' 40" E., a distance of 601.70 feet);
5. Thence S. 08° 56' 00" W. along said right of way line a distance of 94.85 feet;
6. Thence N. 90° 00' 00" W., a distance of 41.27 feet, more or less, to the point of beginning.

The above described parcel contains 0.670 acres, more or less.

RIGHT OF WAY
TO BE ACQUIRED
FROM

PARCEL NO. 32
STA. 397+ TO STA. 403+

THOMAS E. SIDDLE AND
JEAN SIDDLE, J.T.

FOR

PROJ. NO. FC 550-2(9) Sec. 2
ROCKWOOD TO PURGATORY

STATE HIGHWAY NO. 550

DESCRIPTION

A tract or parcel of land No. 32 of the State Department of Highways, Division of Highways, State of Colorado, Project No. FC 550-2(9) Sec. 2 containing 0.297 acres, more or less, in Tracts 5 and 6, ASPEN WINDS SUB-DIVISION, in the SW 1/4 of the NE 1/4 of Section 14, Township 38 North, Range 9 West, of the New Mexico Principal Meridian, in LaPlata County, Colorado, said tract or parcel being more particularly described as follows:

Beginning at a point from which the SE. corner of said Sec. 14 bears S. 31° 13' 55" E., a distance of 3,910.11 feet;

1. Thence N. 90° E., a distance of 15.42 feet to a point on the westerly right of way line of SH 550 (Jan. 11, 1982);
2. Thence S. 22° 18' 00" E. along said right of way a distance of 29.22 feet;
3. Thence S. 22° 34' 00" E. along said right of way line a distance of 150.00 feet;
4. Thence S. 31° 06' 00" E. along said right of way a distance of 101.10 feet;
5. Thence S. 22° 34' 00" E. along said right of way a distance of 86.40 feet;
6. Thence along said right of way line along the arc of a curve to the right, with a radius of 1,372.54 feet, a distance of 147.12 feet (the chord of this arc bears S. 19° 25' 35" E., a distance of 147.05 feet);
7. Thence N. 90° W., a distance of 41.71 feet;
8. Thence along the arc of a curve to the left, with a radius of 1,562.02 feet, a distance of 111.00 feet (the chord of this arc bears N. 17° 16' 44" W., a distance of 110.97 feet);
9. Thence N. 20° 11' 48" W., a distance of 195.55 feet;
10. Thence N. 22° 48' 52" W., a distance of 196.46 feet, more or less, to the point of beginning.

The above described parcel contains 0.297 acres, more or less.

PERMANENT EASEMENT

TO BE ACQUIRED
FROMPARCEL NO. PE-32
STA. 397+ TO STA. 401+THOMAS E. SIDDLE AND
JEAN SIDDLE, J.T.

FOR

PROJ. NO. FC 550-2(9) Sec. 2
ROCKWOOD TO PURGATORY

STATE HIGHWAY NO. 550

DESCRIPTION

A tract or parcel of land No. PE-32 of the State Department of Highways, Division of Highways, State of Colorado, Project No. FC 550-2(9) Sec. 2 containing 0.121 acres, more or less, in Tracts 5 and 6, ASPEN WINDS SUB-DIVISION, in the SW 1/4 of the NE 1/4 of Section 14, Township 38 North, Range 9 West, of the New Mexico Principal Meridian, in LaPlata County, Colorado, said tract or parcel being more particularly described as follows:

Beginning at a point from which the SE. corner of said Sec. 14 bears S. 32° 26' 40" E., a distance of 3,730.80 feet;

1. Thence S. 31° 06' 00" E., a distance of 101.10 feet;
2. Thence S. 22° 34' 00" E., a distance of 81.47 feet;
3. Thence along the arc of a curve to the right, with a radius of 1,307.54 feet, a distance of 121.03 feet (the chord of this arc bears S. 19° 50' 42" E., a distance of 120.99 feet);
4. Thence N. 90° W., a distance of 23.58 feet;
5. Thence along the arc of a curve to the left, with a radius of 1,285.03 feet, a distance of 111.98 feet (the chord of this arc bears N. 20° 00' 01" W., a distance of 111.94 feet);
6. Thence N. 20° 11' 48" W., a distance of 181.58 feet, more or less, to the point of beginning;

The above described permanent easement contains 0.121 acres, more or less.

For the purpose of a road approach (Permanent Access).

PERMANENT EASEMENT

TO BE ACQUIRED
FROMPARCEL NO. PE-7
STA. 270+ TO STA. 271+00MILDRED L. COX
GEORGE M. COX
FRANCES C. McNAMEE

FOR

PROJ. NO. FC 550-2(9) Sec. 2
ROCKWOOD TO PURGATORY

STATE HIGHWAY NO. 550

DESCRIPTION

A tract or parcel of land No. PE-7 of the State Department of Highways, Division of Highways, State of Colorado, Project No. FC 550-2(9) Sec. 2 containing 0.338 acres, more or less, in the SE 1/4 of the SE 1/4 of Section 26, Township 38 North, Range 9 West, of the New Mexico Principal Meridian, in La Plata County, Colorado, said tract or parcel being more particularly described as follows:

Beginning at a point on the westerly right of way line of SH 550 (Jan. 11, 1982) from which the east 1/4 corner of said Sec. 26 bears N. 14° 55' 12" E., a distance of 1,371.12 feet;

1. Thence S. 02° 40' 30" E. along said right of way line a distance of 204.42 feet;
2. Thence N. 71° 42' 00" W., a distance of 125.00 feet;
3. Thence N. 24° 25' 40" E., a distance of 179.37 feet;
4. Thence N. 87° 19' 30" E., a distance of 35.00 feet, more or less, to the point of beginning.

The above described permanent easement contains 0.338 acres, more or less.

RIGHT OF WAY
TO BE ACQUIRED
FROM

PARCEL NO. 10 REV.
STA. 270+ TO STA. 286+

RUEDI BEAR

FOR

PROJ. NO. FC 550-2(9) Sec. 2
ROCKWOOD TO PURGATORY

STATE HIGHWAY NO. 550

DESCRIPTION

A tract or parcel of land No. 10 Rev. of the State Department of Highways, Division of Highways, State of Colorado, Project No. FC 550-2(9) Sec. 2 containing 0.500 acres, more or less, in the NE 1/4 of the SE 1/4 and the SE 1/4 of the SE 1/4 of Section 26, Township 38 North, Range 9 West, of the New Mexico Principal Meridian, in La Plata County, Colorado, said tract or parcel being more particularly described as follows:

Beginning at a point from which the east 1/4 corner of said Sec. 26 bears S. 89° 06' 33" E., a distance of 280.01 feet;

1. Thence N. 89° 06' 33" W. along the north line of the NE 1/4 of the SE 1/4 of Sec. 26 a distance of 10.02 feet to a point on the easterly right of way line of SH 550 (Dec. 17, 1981);
2. Thence S. 02° 42' E. along said right of way line a distance of 1,615.81 feet;
3. Thence N. 78° 49' E., a distance of 27.03 feet;
4. Thence N. 07° 34' 22" W. a distance of 87.12 feet;
5. Thence N. 02° 40' 30" W., a distance of 400.00 feet;
6. Thence N. 05° 32' 15" W., a distance of 200.25 feet;
7. Thence N. 02° 40' 30" W., a distance of 924.38 feet, more or less, to the point of beginning.

The above described parcel contains 0.500 acres, more or less.

RIGHT OF WAY
TO BE ACQUIRED
FROM

PARCEL NO. 13
STA. 286+ TO STA. 299+

STATE OF COLORADO
(FISH & GAME)

FOR

PROJ. NO. FC 550-2(9) Sec. 2
ROCKWOOD TO PURGATORY

STATE HIGHWAY NO. 550

DESCRIPTION

A tract or parcel of land No. 13 of the State Department of Highways, Division of Highways, State of Colorado, Project No. FC 550-2(9) Sec. 2 containing 6.629 acres, more or less, in the SE 1/4 of the NE 1/4 of Section 26, Township 38 North, Range 9 West, of the New Mexico Principal Meridian, in La Plata County, Colorado, said tract or parcel being more particularly described as follows:

Beginning at a point from which the east 1/4 corner of said Sec. 26 bears S. 89° 06' 33" E., a distance of 280.01 feet;

1. Thence N. 03° 15' 38" E., a distance of 502.69 feet;
2. Thence N. 08° 40' 57" W., a distance of 294.50 feet;
3. Thence N. 15° 23' 57" W., a distance of 269.46 feet to a point on the easterly right of way line of SH 550 (Dec. 18, 1981);
4. Thence along said right of way line along the arc of a curve to the left, with a radius of 1,497.49 feet, a distance of 276.33 feet (the chord of this arc bears N. 21° 33' 50" W., a distance of 275.94 feet) to a point on the north line of the SE 1/4 of the NE 1/4 of said Sec. 26;
5. Thence N. 89° 39' 16" W. along said 1/16th section line a distance of 198.58 feet;
6. Thence S. 05° 17' 31" W., a distance of 227.31 feet;
7. Thence S. 18° 26' 24" E., a distance of 276.90 feet;
8. Thence S. 41° 11' 22" E., a distance of 216.38 feet;
9. Thence S. 04° 34' 53" E., a distance of 371.55 feet;
10. Thence S. 02° 40' 30" E., a distance of 286.61 feet to a point on the south line of the NE 1/4 of said Sec. 26;
11. Thence S. 89° 06' 33" E. along said 1/4 section line a distance of 135.26 feet, more or less, to the point of beginning.

The above described parcel contains 6.629 acres, more or less, of which 3.409 acres are in the right of way of the present road.

RIGHT OF WAY
TO BE ACQUIRED
FROM

PARCEL NO. 14
STA. 299+ TO STA. 307+

MILTON F. LECHNER, Trustee

FOR

PROJ. NO. FC 550-2(9) Sec. 2
ROCKWOOD TO PURGATORY

STATE HIGHWAY NO. 550

DESCRIPTION

A tract or parcel of land No. 14 of the State Department of Highways, Division of Highways, State of Colorado, Project No. FC 550-2(9) Sec. 2 containing 0.899 acres, more or less, in the NE 1/4 of the NE 1/4 of Section 26, Township 38 North, Range 9 West, of the New Mexico Principal Meridian, in La Plata County, Colorado, said tract or parcel being more particularly described as follows:

Beginning at a point from which the NE corner of Sec. 26 bears N. 57° 57' 36" E., a distance of 1,298.56 feet;

1. Thence N. 64° 59' 00" E., a distance of 42.02 feet to a point on the westerly right of way line of SH 550 (Dec. 18, 1981);
2. Thence along said right of way line S. 36° 18' 55" E. (Deed Bearing S. 36° 17' E.) a distance of 359.88 feet;
3. Thence along said right of way line S. 44° 49' E., a distance of 101.10 feet;
4. Thence along said right of way line S. 36° 17' E., a distance of 165.70 feet;
5. Thence along said right of way line along the arc of a curve to the right, with a radius of 1,382.47 feet, a distance of 167.84 feet (the chord of this arc bears S. 32° 48' 20" E., a distance of 167.74 feet) to a point on the south line of the NE 1/4 of the NE 1/4 of said Sec. 26;
6. Thence N. 89° 39' 16" W. along said 1/16th section line a distance of 67.84 feet;
7. Thence N. 34° 54' 01" W., a distance of 264.11 feet;
8. Thence N. 35° 50' 57" W., a distance of 196.49 feet;
9. Thence N. 36° 40' 30" W., a distance of 82.91 feet;
10. Thence N. 36° 15' 24" W., a distance of 201.74 feet;
11. Thence N. 33° 18' 52" W., a distance of 15.58 feet, more or less, to the point of beginning.

The above described parcel contains 0.899 acres, more or less.

RIGHT OF WAY
TO BE ACQUIRED
FROM

PARCEL NO. 15
STA. 307+ TO STA. 315+

FOR

RALPH D. WATTERS, Trustee
DONALD R. HOEL and
JUANITA A. HOEL

PROJ. NO. FC 550-2(9) Sec. 2
ROCKWOOD TO PURGATORY

STATE HIGHWAY NO. 550

DESCRIPTION

A tract or parcel of land No. 15 of the State Department of Highways, Division of Highways, State of Colorado, Project No. FC 550-2(9) Sec. 2 containing 0.356 acres, more or less, in the N 1/2 of the NE 1/4 of Section 26, Township 38 North, Range 9 West, of the New Mexico Principal Meridian, in LaPlata County, Colorado, said tract or parcel being more particularly described as follows:

Beginning at a point from which the NE corner of Sec. 26 bears N. 57° 57' 36" E., a distance of 1,298.56 feet;

1. Thence N. 33° 18' 52" W., a distance of 327.93 feet;
2. Thence N. 25° 31' 57" W., a distance of 454.05 feet to a point on the westerly right of way line of SH 550 (Jan. 11, 1982);
3. Thence along said right of way line along the arc of a curve to the left, with a radius of 3,420.64 feet, a distance of 239.26 feet (the chord of this arc bears S. 28° 57' 20" E., a distance of 239.21 feet);
4. Thence along said westerly right of way line S. 23° 21' 07" E., a distance of 104.08 feet;
5. Thence along said right of way line along the arc of a curve to the left, with a radius of 3,435.93 feet, a distance of 216.08 feet (the chord of this arc bears S. 34° 28' 54" E., a distance of 216.05 feet);
6. Thence S. 36° 18' 55" E. along said right of way line a distance of 227.14 feet;
7. Thence S. 64° 59' 00" W., a distance of 42.02 feet, more or less, to the point of beginning.

The above described parcel contains 0.356 acres, more or less.

RIGHT OF WAY
TO BE ACQUIRED
FROM

PARCEL NO. 16
STA. 312+ TO STA. 313+

MINTON I. MOORE and
INA MAY MOORE, J.T.

FOR

PROJ. NO. FC 550-2(9) Sec. 2
ROCKWOOD TO PURGATORY

STATE HIGHWAY NO. 550

DESCRIPTION

A tract or parcel of land No. 16 of the State Department of Highways, Division of Highways, State of Colorado, Project No. FC 550-2(9) Sec. 2 containing 0.034 acres, more or less, in the NE 1/4 of the NE 1/4 of Section 26, Township 38 North, Range 9 West, of the New Mexico Principal Meridian, in La Plata County, Colorado, said tract or parcel being more particularly described as follows:

Beginning at a point from which the NE corner of said Sec. 26 bears N. 83° 33' 12" E., a distance of 1,266.52 feet;

1. Thence S. 27° 52' 27" E., a distance of 109.09 feet to a point on the easterly right of way line of SH 550 (Jan. 11, 1982);
2. Thence N. 41° 19' 02" W., a distance of 100.07 feet;
3. Thence along the arc of a curve to the right, with a radius of 3,320.64 feet, a distance of 17.80 feet (the chord of this arc bears N. 30° 48' 39" W., a distance of 17.80 feet);
4. Thence N. 76° 06' 00" E., a distance of 24.91 feet, more or less, to the point of beginning.

The above described parcel contains 0.034 acres, more or less.

RIGHT OF WAY
TO BE ACQUIRED
FROM

PARCEL NO. 17
STA. 313+ TO STA. 321+

MILTON F. LECHNER, Trustee

FOR

PROJ. NO. FC 550-2(9) Sec. 2
ROCKWOOD TO PURGATORY

STATE HIGHWAY NO. 550

DESCRIPTION

A tract or parcel of land No. 17 of the State Department of Highways, Division of Highways, State of Colorado, Project No. FC 550-2(9) Sec. 2 containing 0.593 acres, more or less, in the NE 1/4 of the NE 1/4 of Section 26 and the S 1/2 of the SE 1/4 of Section 23, Township 38 North, Range 9 West, of the New Mexico Principal Meridian, in La Plata County, Colorado, said tract or parcel being more particularly described as follows:

Beginning at a point on the north line of Sec. 26, T. 38 N., R. 9 W., N.M.P.M., from which the NE corner of said Sec. 26 bears N. 89° 48' 00" E., a distance of 1,329.76 feet;

1. Thence along the arc of a curve to the left, with a radius of 4,508.66 feet, a distance of 81.55 feet (the chord of this arc bears S. 26° 56' 09" E., a distance of 81.54 feet);
2. Thence S. 27° 52' 27" E., a distance of 73.37 feet;
3. Thence S. 76° 06' 00" W., a distance of 24.91 feet to a point on the easterly right of way line of SH 550 (Dec. 19, 1981)
4. Thence along said right of way line along the arc of a curve to the right, with a radius of 3,320.64 feet, a distance of 164.39 feet (the chord of this arc bears N. 29° 14' 21" W., a distance of 164.37 feet) to a point on the north line of said Sec. 26;
5. Thence N. 89° 48' 00" E., along said north section line a distance of 33.23 feet, more or less, to the point of beginning.

The above described portion of Parcel 17 contains 0.099 acres, more or less.

ALSO

Beginning at a point on the south line of Sec. 23, T. 38 N., R. 9 W., N.M.P.M., from which the SE corner of said Sec. 23 bears N. 89° 48' 00" E., a distance of 1,329.76 feet;

1. Thence S. 89° 48' 00" W. along said section line a distance of 33.23 feet to a point on the easterly right of way line of SH 550 (Dec. 19, 1981);

COT

PARCEL NO. 17
STA. 313+ TO STA. 321+
PROJ. NO. 550-2(9) Sec. 2
ROCKWOOD TO PURGATORY
Page Two

2. Thence along said right of way line along the arc of a curve to the right, with a radius of 3,320.64 feet, a distance of 648.05 feet (the chord of this arc bears N. 22° 13' 48" W., a distance of 647.03 feet);
3. Thence S. 82° 40' 00" E., a distance of 42.68 feet;
4. Thence S. 05° 07' 12" E., a distance of 33.38 feet;
5. Thence along the arc of a curve to the left, with a radius of 4508.66 feet, a distance of 607.00 feet (the chord of this arc bears S. 22° 33' 39" E., a distance of 606.54 feet), more or less, to the point of beginning.

The above described portion of Parcel 17 contains 0.494 acres, more or less.

The above described parcel contains a total of 0.593 acres, more or less.

RIGHT OF WAY
TO BE ACQUIRED
FROM

PARCEL NO. 18
STA. 321+ TO STA. 322+

PETER K. BOLI; W. JILL BOLI;
BRADNEY A. BOLI;
TIFFANI K. BOLI

FOR

PROJ. NO. FC 550-2(9) Sec. 2
ROCKWOOD TO PURGATORY

STATE HIGHWAY NO. 550

DESCRIPTION

A tract or parcel of land No. 18 of the State Department of Highways, Division of Highways, State of Colorado, Project No. FC 550-2(9) Sec. 2 containing 0.103 acres, more or less, in the SW 1/4 of the SE 1/4 of Section 23, Township 38 North, Range 9 West, of the New Mexico Principal Meridian, in La Plata County, Colorado, said tract or parcel being more particularly described as follows:

Beginning at a point from which the SE corner of said Sec. 23 bears S. 66° 09' 26" E., a distance of 1,722.01 feet;

1. Thence S. 05° 07' 12" E., a distance of 107.78 feet;
2. Thence N. 82° 40' 00" W., a distance of 42.68 feet to a point on the easterly right of way of SH 550 (Jan. 11, 1982);
3. Thence along said right of way along the arc of a curve to the right, with a radius of 3,320.64 feet, a distance of 74.65 feet (the chord of this arc bears N. 15° 59' 42" W., a distance of 74.65 feet);
4. Thence N. 60° 30' 00" E., a distance of 61.22 feet, more or less, to the point of beginning.

The above described parcel contains 0.103 acres, more or less.

RIGHT OF WAY
TO BE ACQUIRED
FROM

PARCEL NO. 19
STA. 322+ TO STA. 326+

MILTON F. LECHNER, Trustee

FOR

PROJ. NO. FC 550-2(9) Sec. 2
ROCKWOOD TO PURGATORY

STATE HIGHWAY NO. 550

DESCRIPTION

A tract or parcel of land No. 19 of the State Department of Highways, Division of Highways, State of Colorado, Project No. FC 550-2(9) Sec. 2 containing 0.150 acres, more or less, in the SW 1/4 of the SE 1/4 of Section 23, Township 38 North, Range 9 West, of the New Mexico Principal Meridian, in LaPlata County, Colorado, said tract or parcel being more particularly described as follows:

Beginning at a point from which the SE corner of said Sec. 23 bears S. 66° 09' 26" E., a distance of 1,722.01 feet;

1. Thence S. 60° 30' 00" W., a distance of 61.22 feet to a point on the easterly right of way line of SH 550 (Dec. 19, 1981);
2. Thence along said right of way line along the arc of a curve to the right, with a radius of 3,320.64 feet, a distance of 365.18 feet (the chord of this arc bears N. 12° 12' 02" W., a distance of 365.00 feet);
3. Thence S. 14° 32' 08" E., a distance of 242.71 feet;
4. Thence S. 37° 10' 06" E., a distance of 115.04 feet, more or less, to the point of beginning.

The above described parcel contains 0.150 acres, more or less.

RIGHT OF WAY
TO BE ACQUIRED
FROM

PARCEL NO. 20
STA. 321+ TO STA. 334+

MILTON F. LECHNER, Trustee

FOR

PROJ. NO. FC 550-2(9) Sec. 2
ROCKWOOD TO PURGATORY

STATE HIGHWAY NO. 550

DESCRIPTION

A tract or parcel of land No. 20 of the State Department of Highways, Division of Highways, State of Colorado, Project No. FC 550-2(9) Sec. 2 containing 1.123 acres, more or less, in the W. 1/2 of the SE 1/4 of Section 23, Township 38 North, Range 9 West, of the New Mexico Principal Meridian, in La Plata County, Colorado, said tract or parcel being more particularly described as follows:

Beginning at a point from which the SE corner of Sec. 23 bears S. 47° 16' 57" E., a distance of 2,668.10 feet;

1. Thence N. 90° E., a distance of 30.26 feet to a point on the westerly right of way line of SH 550 (Dec. 19, 1981);
2. Thence along said right of way line along the arc of a curve to the left, with a radius of 5,779.35 feet, a distance of 196.47 feet (the chord of this arc bears S. 08° 04' 35" E., a distance of 196.46 feet);
3. Thence S. 09° 03' E. along said right of way line a distance of 616.00 feet;
4. Thence along said right of way line along the arc of a curve to the left, with a radius of 3,420.64 feet, a distance of 467.30 feet (the chord of this arc bears S. 12° 57' 50" E., a distance of 466.94 feet);
5. Thence N. 20° 25' 49" W., a distance of 263.65 feet;
6. Thence N. 12° 00' 28" W., a distance of 582.00 feet;
7. Thence N. 22° 26' 57" W., a distance of 129.22 feet;
8. Thence N. 00° 49' 58" E., a distance of 306.24 feet;
9. Thence N. 05° 23' 45" W., a distance of 15.99 feet, more or less, to the point of beginning.

The above described parcel contains 1.123 acres, more or less.

RIGHT OF WAY
TO BE ACQUIRED
FROM

PARCEL NO. 21
STA. 334+ TO STA. 342+

JAMES R. FLACK, trustee

FOR

PROJ. NO. FC 550-2(9) SEC. 2
ROCKWOOD-PURGATORY

STATE HIGHWAY NO. 550

DESCRIPTION

A tract or parcel of land No. 21 of the State Department of Highways, Division of Highways, State of Colorado, Project No. FC 550-2(9) Sec. 2 containing 0.531 acres, more or less, in the NW 1/4 of the SE 1/4 of Section 23, Township 38 North, Range 9 West, of the New Mexico Principal Meridian, in LaPlata County, Colorado, said tract or parcel being more particularly described as follows:

Beginning at a point from which the SE corner of said Sec. 23 bears S. 47° 16' 57" E., a distance of 2,668.10 feet;

1. Thence N. 05° 23' 45" W., a distance of 382.05 feet;
2. Thence N. 03° 25' 33" W., a distance of 458.15 feet to a point on the north line of the SE 1/4 of said Sec. 23;
3. Thence N. 89° 47' 10" E. along said 1/4 section line a distance of 22.71 feet to a point on the westerly right of way line of SH 550 (Dec. 19, 1981);
4. Thence S. 03° 24' 00" E. along said right of way line a distance of 203.60 feet;
5. Thence S. 08° 38' 39" E. along said right of way line a distance of 98.24 feet (Deed: S. 09° 07' E. a distance of 100.5 feet);
6. Thence S. 03° 24' E. along said right of way line a distance of 165.80 feet;
7. Thence along said right of way line along the arc of a curve to the left, with a radius of 5,779.35 feet, a distance of 373.53 feet (the chord of this arc bears S. 05° 15' 04" E., a distance of 373.47 feet);
8. Thence N. 90° W., a distance of 30.26 feet, more or less, to the point of beginning.

The above described parcel contains 0.531 acres, more or less.

4/9/82

dm/M

086

RIGHT OF WAY
TO BE ACQUIRED
FROM

PARCEL NO. 22
STA. 342+ TO STA. 348+

EDITH L. REED

FOR

PROJ. NO. FC 550-2(9) Sec. 2
ROCKWOOD - PURGATORY

STATE HIGHWAY NO. 550

DESCRIPTION

A tract or parcel of land No. 22 of the State Department of Highways, Division of Highways, State of Colorado, Project No. FC 550-2(9) Sec. 2 containing 1.063 acres, more or less, in the SW 1/4 of the NE 1/4 of Section 23, Township 38 North, Range 9 West, of the New Mexico Principal Meridian, in La Plata County, Colorado, said tract or parcel being more particularly described as follows:

Beginning at a point from which the NE corner of said Sec. 23 bears N. 45° 26' 21" E., a distance of 2,852.83 feet;

1. Thence N. 90° E., a distance of 65.84 feet;
2. Thence S. 03° 25' 33" E., a distance of 626.71 feet to a point on the south line of the NE 1/4 of said Sec. 23;
3. Thence S. 89° 47' 10" W. along said 1/4 section line a distance of 60.09 feet;
4. Thence N. 03° 25' 33" W., a distance of 297.86 feet;
5. Thence N. 19° 48' 55" W., a distance of 177.20 feet;
6. Thence N. 12° 05' 54" E., a distance of 165.45 feet, more or less, to the point of beginning.

The above described parcel contains 1.063 acres, more or less, of which 0.572 acres are in the right of way of the present road.

RIGHT OF WAY
TO BE ACQUIRED
FROM

PARCEL NO. 23
STA. 348+ TO STA. 352+

ASPEN WINDS II, a
limited partnership

FOR

PROJ. NO. FC 550-2(9) Sec. 2
ROCKWOOD TO PURGATORY

STATE HIGHWAY NO. 550

DESCRIPTION

A tract or parcel of land No. 23 of the State Department of Highways, Division of Highways, State of Colorado, Project No. FC 550-2(9) Sec. 2 containing 0.552 acres, more or less, in the SW 1/4 of the NE 1/4 of Section 23, Township 38 North, Range 9 West, of the New Mexico Principal Meridian, in La Plata County, Colorado, said tract or parcel being more particularly described as follows:

Beginning at a point from which the NE corner of said Sec. 23 bears N. 45° 26' 21" E., a distance of 2,852.83 feet;

1. Thence N. 12° 05' 54" E., a distance of 21.36 feet;
2. Thence N. 03° 25' 33" W., a distance of 377.08 feet;
3. Thence N. 86° 36' 00" E., a distance of 60.00 feet;
4. Thence S. 03° 25' 33" E., a distance of 401.57 feet;
5. Thence S. 90° 00' 00" W., a distance of 65.84 feet, more or less, to the point of beginning.

The above described parcel contains 0.552 acres of which 0.299 acres are in the right of way of the present road.

RIGHT OF WAY
TO BE ACQUIRED
FROM

PARCEL NO. 24
STA. 352+ TO STA. 354+

ANTHONY S. FARRINGTON,
JANET FARRINGTON YOUNGBERG,
NANCY FARRINGTON HIGGINS,
J. C. FARRINGTON

FOR

PROJ. NO. FC 550-2(9) Sec. 2
ROCKWOOD TO PURGATORY

STATE HIGHWAY NO. 550

DESCRIPTION

A tract or parcel of land No. 24 of the State Department of Highways, Division of Highways, State of Colorado, Project No. FC 550-2(9) Sec. 2 containing 0.244 acres, more or less, in the SW 1/4 of the NE 1/4 of Section 23, Township 38 North, Range 9 West, of the New Mexico Principal Meridian, in La Plata County, Colorado, said tract or parcel being more particularly described as follows:

Beginning at a point from which the NE corner of said Sec. 23 bears N. 55° 18' 51" E., a distance of 2,512.96 feet;

1. Thence N. 86° 36' 00" E., a distance of 65.21 feet;
2. Thence S. 03° 25' 33" E., a distance of 175.00 feet;
3. Thence S. 86° 36' 00" W., a distance of 60.00 feet;
4. Thence N. 03° 25' 33" W., a distance of 122.92 feet;
5. Thence N. 09° 08' 11" W., a distance of 52.34 feet, more or less, to the point of beginning.

The above described parcel contains 0.244 acres, more or less, of which 0.128 acres are in the right of way of the present road.

RIGHT OF WAY
TO BE ACQUIRED
FROM

PARCEL NO. 25
STA. 354+ TO STA. 356+

FRITZ ALLEN, et al.

FOR

PROJ. NO. FC 550-2(9) Sec. 2
ROCKWOOD TO PURGATORY

STATE HIGHWAY NO. 550

DESCRIPTION

A tract or parcel of land No. 25 of the State Department of Highways, Division of Highways, State of Colorado, Project No. FC 550-2(9) Sec. 2 containing 0.279 acres, more or less, in the W. 1/2 of the NE 1/4 of Section 23, Township 38 North, Range 9 West, of the New Mexico Principal Meridian, in La Plata County, Colorado, said tract or parcel being more particularly described as follows:

Beginning at a point from which the NE corner of said Sec. 23 bears N. 55° 18' 51" E., a distance of 2,512.96 feet;

1. Thence N. 09° 08' 11" W., a distance of 48.16 feet;
2. Thence N. 03° 25' 33" W., a distance of 127.09 feet;
3. Thence N. 86° 36' 00" E., a distance of 70.00 feet;
4. Thence S. 03° 25' 33" E., a distance of 175.00 feet;
5. Thence S. 86° 36' 00" W., a distance of 65.21 feet, more or less, to the point of beginning.

The above described parcel contains 0.279 acres, more or less, of which 0.128 acres are in the right of way of the present road.

4/9/82

dm/M

CDS

RIGHT OF WAY
TO BE ACQUIRED
FROM

PARCEL NO. 26
STA. 356+ TO STA. 358+

DOUGLAS L. REPAAL and
LORENA J. REPAAL

FOR

PROJ. NO. FC 550-2(9) Sec. 2
ROCKWOOD TO PURGATORY

STATE HIGHWAY NO. 550

DESCRIPTION

A tract or parcel of land No. 26 of the State Department of Highways, Division of Highways, State of Colorado, Project No. FC 550-2(9) Sec. 2 containing 0.270 acres, more or less, in the NW 1/4 of the NE 1/4 of Section 23, Township 38 North, Range 9 West, of the New Mexico Principal Meridian, in La Plata County, Colorado, said tract or parcel being more particularly described as follows:

Beginning at a point from which the NE corner of said Sec. 23 bears N. 62° 34' 32" E., a distance of 2,345.70 feet;

1. Thence N. 86° 36' 00" E., a distance of 60.00 feet;
2. Thence S. 03° 25' 33" E., a distance of 175.00 feet;
3. Thence S. 86° 36' 00" W., a distance of 70.00 feet;
4. Thence N. 03° 25' 33" W., a distance of 72.92 feet;
5. Thence N. 02° 10' 09" E., a distance of 102.57 feet, more or less, to the point of beginning.

The above described parcel contains 0.270 acres, more or less, of which 0.128 acres are in the right of way of the present road.

4/9/82

dm/M

653

PERMANENT EASEMENT
TO BE ACQUIRED
FROM

PARCEL NO. PE-26
STA. 356+ TO STA. 358+

DOUGLAS L. REPAAL and
LORENA J. REPAAL

FOR

PROJ. NO. FC 550-2(9) Sec. 2
ROCKWOOD TO PURGATORY

STATE HIGHWAY NO. 550

DESCRIPTION

A tract or parcel of land No. PE-26 of the State Department of Highways, Division of Highways, State of Colorado, Project No. FC 550-2(9) Sec. 2 containing 0.293 acres, more or less, in the NW 1/4 of the NE 1/4 of Section 23, Township 38 North, Range 9 West, of the New Mexico Principal Meridian, in LaPlata County, Colorado, said tract or parcel being more particularly described as follows:

Beginning at a point from which the NE corner of said Sec. 23 bears N. 62° 34' 32" E., a distance of 2,345.70 feet;

1. Thence S. 02° 10' 09" W., a distance of 102.57 feet;
2. Thence S. 03° 25' 33" E., a distance of 72.92 feet;
3. Thence S. 86° 36' 00" W., a distance of 70.00 feet;
4. Thence N. 03° 25' 33" W., a distance of 175.00 feet;
5. Thence N. 86° 36' 00" E., a distance of 80.00 feet, more or less, to the point of beginning.

The above described permanent easement contains 0.293 acres, more or less.

RIGHT OF WAY
TO BE ACQUIRED
FROM

PARCEL NO. 27
STA. 358+ TO STA. 363+

LEE M. RATCLIFFE and
HAZEL RATCLIFFE

FOR

PROJ. NO. FC 550-2(9) Sec. 2
ROCKWOOD TO PURGATORY

STATE HIGHWAY NO. 550

DESCRIPTION

A tract or parcel of land No. 27 of the State Department of Highways, Division of Highways, State of Colorado, Project No. FC 550-2(9) Sec. 2 containing 0.815 acres, more or less, in the NW 1/4 of the NE 1/4 of Section 23, Township 38 North, Range 9 West, of the New Mexico Principal Meridian, in LaPlata County, Colorado, said tract or parcel being more particularly described as follows:

Beginning at a point from which the NE corner of said Sec. 23 bears N. 75° 22' 45" E., a distance of 2,209.74 feet;

1. Thence N. 86° 36' E., a distance of 90.06 feet;
2. Thence along the arc of a curve to the left, with a radius of 7,639.44 feet, a distance of 284.20 feet (the chord of this arc bears S. 02° 21' 36" E., a distance of 284.18 feet);
3. Thence S. 03° 25' 33" E., a distance of 240.86 feet;
4. Thence S. 86° 36' 00" W., a distance of 60.00 feet;
5. Thence N. 03° 25' 33" W., a distance of 240.84 feet;
6. Thence N. 08° 24' 29" W., a distance of 285.25 feet, more or less, to the point of beginning.

The above described parcel contains 0.815 acres, more or less, of which 0.390 acres are in the right of way of the present road.

RIGHT OF WAY
TO BE ACQUIRED
FROM

PARCEL NO. 28
STA. 365+ TO STA. 376+

WILLIAM LECHNER

FOR

PROJ. NO. FC 550-2(9) Sec. 2
ROCKWOOD-PURGATORY

STATE HIGHWAY NO. 550

DESCRIPTION

A tract or parcel of land No. 28 of the State Department of Highways, Division of Highways, State of Colorado, Project No. FC 550-2(9) Sec. 2 containing 2.020 acres, more or less, in the NW 1/4 of the NE 1/4 of Section 23 and the SW 1/4 of the SE 1/4 of Section 14, Township 38 North, Range 9 West, of the New Mexico Principal Meridian, in LaPlata County, Colorado, said tract or parcel being more particularly described as follows:

Beginning at a point on the north line of Sec. 23, T. 38 N., R. 9 W., N.M.P.M., from which the NE corner of said Sec. 23 bears N. 89° 46' 20" E., a distance of 1,967.34 feet;

1. Thence S. 12° 56' 35" W., a distance of 76.13 feet;
2. Thence S. 03° 43' 21" W., a distance of 228.58 feet;
3. Thence N. 89° 28' 23" W., a distance of 50.69 feet;
4. Thence along the arc of a curve to the right, with a radius of 7,639.44 feet, a distance of 301.68 feet (the chord of this arc bears N. 01° 39' 30" E., a distance of 301.66 feet) to a point on the north line of Sec. 23;
5. Thence N. 89° 46' 20" E. along said section line a distance of 73.86 feet, more or less, to the point of beginning.

The above described portion of Parcel 28 contains 0.407 acres of which 0.277 acres are in the right of way of the present road.

ALSO

Beginning at a point on the south line of Sec. 14, T. 38 N., R. 9 W., N.M.P.M., from which the SE corner of said Sec. 14 bears N. 89° 46' 20" E., a distance of 1,967.34 feet;

1. Thence S. 89° 46' 20" W. along said section line a distance of 73.86 feet;
2. Thence along the arc of a curve to the right, with a radius of 7,639.44 feet, a distance of 763.39 feet (the chord of this arc bears N. 05° 39' 08" E., a distance of 763.07 feet);

3. Thence S. $81^{\circ} 29' 06''$ E., a distance of 70.00 feet;
4. Thence S. $02^{\circ} 11' 02''$ W., a distance of 530.10 feet;
5. Thence S. $12^{\circ} 56' 35''$ W., a distance of 224.70 feet, more or less, to the point of beginning.

The above described portion of Parcel 28 contains 1.613 acres of which 0.983 acres are in the right of way of the present road.

The above described parcel contains a total of 2.020 acres, more or less, of which 1.260 acres are in the right of way of the present road.

4/9/82

dm/M

PERMANENT EASEMENT
TO BE ACQUIRED
FROM

PARCEL NO. PE-28
STA. 376+ TO STA. 379+

WILLIAM LECHNER

FOR

PROJ. NO. FC 550-2(9) Sec. 2
ROCKWOOD-PURGATORY

STATE HIGHWAY NO. 550

DESCRIPTION

A tract or parcel of land No. PE-28 of the State Department of Highways, Division of Highways, State of Colorado, Project No. FC 550-2(9) Sec. 2 containing 0.175 acres, more or less, in the SW 1/4 of the SE 1/4 of Section 14, Township 38 North, Range 9 West, of the New Mexico Principal Meridian, in LaPlata County, Colorado, said tract or parcel being more particularly described as follows:

Beginning at a point from which the SE corner of Sec. 14 bears S.68°39'53" E. a distance of 2,036.36 feet;

1. Thence N. 25° 31' 21" E., a distance of 41.38 feet;
2. Thence N. 42° 31' 56" E., a distance of 270.39 feet;
3. Thence S. 29° 53' 42" W., a distance of 214.31 feet;
4. Thence S. 61° 33' 44" W., a distance of 106.67 feet, more or less, to the point of beginning.

The above described parcel contains 0.175 acres, more or less.

For the purpose of a road approach (Permanent Access).

RIGHT OF WAY
TO BE ACQUIRED
FROM

PARCEL NO. 29
STA. 363+ TO STA. 288+

ASPEN WINDS II, a
Limited Partnership

FOR

PROJ. NO. FC 550-2(9) Sec. 2
ROCKWOOD-PURGATORY

STATE HIGHWAY NO. 550

DESCRIPTION

A tract or parcel of land No. 29 of the State Department of Highways, Division of Highways, State of Colorado, Project No. FC 550-2(9) Sec. 2 containing 4.253 acres, more or less, in Lots 1, 2 and 3 ASPEN WINDS NO. II SUBDIVISION in the NW 1/4 of the NE 1/4 of Sec. 23 and the W. 1/2 of the SE 1/4 of Section 14, Township 38 North, Range 9 West, of the New Mexico Principal Meridian, in La Plata County, Colorado, said tract or parcel being more particularly described as follows:

Beginning at a point on the north line of Sec. 23, T. 38 N., R. 9 W., N.M.P.M., from which the NE corner of said Sec. 23 bears N. 89° 46' 20" E., a distance of 2,131.32 feet;

1. Thence N. 89° 46' 20" E., a distance of 90.12 feet;
2. Thence along the arc of a curve to the left, with a radius of 7,639.44 feet, a distance of 544.50 feet (the chord of this arc bears S. 00° 44' 51" W., a distance of 544.38 feet);
3. Thence S. 86° 36' 00" W., a distance of 90.06 feet;
4. Thence along the arc of a curve to the right, with a radius of 7,729.44 feet, a distance of 549.48 feet (the chord of this arc bears N. 00° 43' 04" E., a distance of 549.36 feet), more or less, to the point of beginning.

The above described portion of Parcel 29 contains 1.130 acres of which 0.640 acres are in the right of way of the present road.

ALSO

Beginning at a point on the south line of Sec. 14, T. 38 N., R. 9 W., N.M.P.M. from which the SE corner of said Sec. 14 bears N. 89° 46' 20" E., a distance of 2,131.32 feet;

1. Thence along the arc of a curve to the right, with a radius of 7,729.44 feet, a distance of 820.76 feet (the chord of this arc bears N. 05° 47' 47" E., a distance of 820.37 feet);
2. Thence N. 08° 50' 18" E., a distance of 821.87 feet;

(Continued)

3. Thence N. $09^{\circ} 44' 06''$ E., a distance of 333.69 feet;
4. Thence N. 90° E., a distance of 54.71 feet to a point on the westerly right of way line of SH 550 (Dec. 21, 1981);
5. Thence S. $08^{\circ} 56'$ W. along said right of way line a distance of 1,280.00 feet;
6. Thence S. $73^{\circ} 00' 44''$ E., a distance of 34.14 feet;
7. Thence along the arc of a curve to the left, with a radius of 7,639.44 feet, a distance of 685.60 feet (the chord of this arc bears S. $05^{\circ} 21' 38''$ W., a distance of 685.37 feet) to a point on the south line of said Sec. 14;
8. Thence S. $89^{\circ} 46' 20''$ W. along said Section line a distance of 90.12 feet, more or less, to the point of beginning.

The above described portion of Parcel 29 contains 3.123 acres of which 0.683 acres are in the right of way of the present road.

The above above described parcel contains a total of 4.253 acres of which 1.323 acres are in the right of way of the present road.

4/14/82

dm/M

RIGHT OF WAY
TO BE ACQUIRED
FROM

PARCEL NO. 30
STA. 388+ TO STA. 390+

PETRA C. WHITE

FOR

PROJ. NO. FC 550-2(9) Sec. 2
ROCKWOOD TO PURGATORY

STATE HIGHWAY NO. 550

DESCRIPTION

A tract or parcel of land No. 30 of the State Department of Highways, Division of Highways, State of Colorado, Project No. FC 550-2(9) Sec. 2 containing 0.238 acres, more or less, in Tract 1, ASPEN WINDS SUBDIVISION, in the NW 1/4 of the SE 1/4 of Section 14, Township 38 North, Range 9 West, of the New Mexico Principal Meridian, in La Plata County, Colorado, said tract or parcel being more particularly described as follows:

Beginning at a point from which the SE. corner of said Sec. 14 bears S. 39° 58' 16" E., a distance of 2,842.90 feet;

1. Thence N. 90° 00' 00" E., a distance of 41.27 feet to a point on the westerly right of way line of SH 550 (Jan. 11, 1982);
2. Thence S. 08° 56' 00" W. along said right of way, a distance of 131.25 feet;
3. Thence S. 03° 13' 00" W. along said right of way line a distance of 100.50 feet;
4. Thence N. 90° 00' 00" W., a distance of 54.71 feet;
5. Thence N. 09° 44' 06" E., a distance of 233.36 feet, more or less, to the point of beginning.

The above described parcel contains 0.238 acres, more or less.

RIGHT OF WAY
TO BE ACQUIRED
FROM

PARCEL NO. 31
STA. 391+ TO STA. 397+

JIMMY E. TRICE

FOR

PROJ. NO. FC 550-2(9) Sec. 2
ROCKWOOD TO PURGATORY

STATE HIGHWAY NO. 550

DESCRIPTION

A tract or parcel of land No. 31 of the State Department of Highways, Division of Highways, State of Colorado, Project No. FC 550-2(9) Sec. 2 containing 0.670 acres, more or less, in Tracts 2, 3 and 4 ASPEN WINDS SUBDIVISION in the NW 1/4 of the SE 1/4 and the SW 1/4 of the NE 1/4 of Section 14, Township 38 North, Range 9 West, of the New Mexico Principal Meridian, in LaPlata County, Colorado, said tract or parcel being more particularly described as follows:

Beginning at a point from which the SE corner of said Sec. 14 bears S. 39° 58' 16" E., a distance of 2,842.90 feet;

1. Thence N. 09° 44' 06" E., a distance of 140.17 feet;
2. Thence along the arc of a curve to the left with a radius of 1,562.02 feet, a distance of 561.10 feet (the chord of this arc bears N. 04° 57' 09" W., a distance of 558.09 feet);
3. Thence N. 90° E., a distance of 41.71 feet to a point on the westerly right of way line of SH 550 (Jan. 11, 1982);
4. Thence along said right of way line along the arc of a curve to the right, with a radius of 1,372.54 feet, a distance of 606.63 feet (the chord of this arc bears S. 03° 41' 40" E., a distance of 601.70 feet);
5. Thence S. 08° 56' 00" W. along said right of way line a distance of 94.85 feet;
6. Thence N. 90° 00' 00" W., a distance of 41.27 feet, more or less, to the point of beginning.

The above described parcel contains 0.670 acres, more or less.

4/14/82

dm/M

RIGHT OF WAY
TO BE ACQUIRED
FROM

PARCEL NO. 32
STA. 397+ TO STA. 403+

THOMAS E. SIDDLE AND
JEAN SIDDLE, J.T.

FOR

PROJ. NO. FC 550-2(9) Sec. 2
ROCKWOOD TO PURGATORY

STATE HIGHWAY NO. 550

DESCRIPTION

A tract or parcel of land No. 32 of the State Department of Highways, Division of Highways, State of Colorado, Project No. FC 550-2(9) Sec. 2 containing 0.297 acres, more or less, in Tracts 5 and 6, ASPEN WINDS SUB-DIVISION, in the SW 1/4 of the NE 1/4 of Section 14, Township 38 North, Range 9 West, of the New Mexico Principal Meridian, in LaPlata County, Colorado, said tract or parcel being more particularly described as follows:

Beginning at a point from which the SE. corner of said Sec. 14 bears S. 31° 13' 55" E., a distance of 3,910.11 feet;

1. Thence N. 90° E., a distance of 15.42 feet to a point on the westerly right of way line of SH 550 (Jan. 11, 1982);
2. Thence S. 22° 18' 00" E. along said right of way a distance of 29.22 feet;
3. Thence S. 22° 34' 00" E. along said right of way line a distance of 150.00 feet;
4. Thence S. 31° 06' 00" E. along said right of way a distance of 101.10 feet;
5. Thence S. 22° 34' 00" E. along said right of way a distance of 86.40 feet;
6. Thence along said right of way line along the arc of a curve to the right, with a radius of 1,372.54 feet, a distance of 147.12 feet (the chord of this arc bears S. 19° 25' 35" E., a distance of 147.05 feet);
7. Thence N. 90° W., a distance of 41.71 feet;
8. Thence along the arc of a curve to the left, with a radius of 1,562.02 feet, a distance of 111.00 feet (the chord of this arc bears N. 17° 16' 44" W., a distance of 110.97 feet);
9. Thence N. 20° 11' 48" W., a distance of 195.55 feet;
10. Thence N. 22° 48' 52" W., a distance of 196.46 feet, more or less, to the point of beginning.

The above described parcel contains 0.297 acres, more or less.

PERMANENT EASEMENT

TO BE ACQUIRED
FROMPARCEL NO. PE-32
STA. 397+ TO STA. 401+THOMAS E. SIDDLE AND
JEAN SIDDLE, J.T.

FOR

PROJ. NO. FC 550-2(9) Sec. 2
ROCKWOOD TO PURGATORY

STATE HIGHWAY NO. 550

DESCRIPTION

A tract or parcel of land No. PE-32 of the State Department of Highways, Division of Highways, State of Colorado, Project No. FC 550-2(9) Sec. 2 containing 0.121 acres, more or less, in Tracts 5 and 6, ASPEN WINDS SUB-DIVISION, in the SW 1/4 of the NE 1/4 of Section 14, Township 38 North, Range 9 West, of the New Mexico Principal Meridian, in LaPlata County, Colorado, said tract or parcel being more particularly described as follows:

Beginning at a point from which the SE. corner of said Sec. 14 bears S. 32° 26' 40" E., a distance of 3,730.80 feet;

1. Thence S. 31° 06' 00" E., a distance of 101.10 feet;
2. Thence S. 22° 34' 00" E., a distance of 81.47 feet;
3. Thence along the arc of a curve to the right, with a radius of 1,307.54 feet, a distance of 121.03 feet (the chord of this arc bears S. 19° 50' 42" E., a distance of 120.99 feet);
4. Thence N. 90° W., a distance of 23.58 feet;
5. Thence along the arc of a curve to the left, with a radius of 1,285.03 feet, a distance of 111.98 feet (the chord of this arc bears N. 20° 00' 01" W., a distance of 111.94 feet);
6. Thence N. 20° 11' 48" W., a distance of 181.58 feet, more or less, to the point of beginning;

The above described permanent easement contains 0.121 acres, more or less.

For the purpose of a road approach (Permanent Access).

PERMANENT EASEMENT

TO BE ACQUIRED
FROMPARCEL NO. PE-7
STA. 270+ TO STA. 271+00MILDRED L. COX
GEORGE M. COX
FRANCES C. McNAMEE

FOR

PROJ. NO. FC 550-2(9) Sec. 2
ROCKWOOD TO PURGATORY

STATE HIGHWAY NO. 550

DESCRIPTION

A tract or parcel of land No. PE-7 of the State Department of Highways, Division of Highways, State of Colorado, Project No. FC 550-2(9) Sec. 2 containing 0.338 acres, more or less, in the SE 1/4 of the SE 1/4 of Section 26, Township 38 North, Range 9 West, of the New Mexico Principal Meridian, in La Plata County, Colorado, said tract or parcel being more particularly described as follows:

Beginning at a point on the westerly right of way line of SH 550 (Jan. 11, 1982) from which the east 1/4 corner of said Sec. 26 bears N. 14° 55' 12" E., a distance of 1,371.12 feet;

1. Thence S. 02° 40' 30" E. along said right of way line a distance of 204.42 feet;
2. Thence N. 71° 42' 00" W., a distance of 125.00 feet;
3. Thence N. 24° 25' 40" E., a distance of 179.37 feet;
4. Thence N. 87° 19' 30" E., a distance of 35.00 feet, more or less, to the point of beginning.

The above described permanent easement contains 0.338 acres, more or less.

STATE DEPARTMENT OF HIGHWAYS
DIVISION OF HIGHWAYS, STATE OF COLORADO
4201 East Arkansas Avenue
Denver, Colorado 80222

Project PC 550-2(9) Sec. 2
Location Rockwood to Purgatory
Date June 13, 1984

TO: Dan Knight, District 5
FROM: STAFF RIGHT OF WAY
SUBJECT: TRANSMITTAL OF (XX) PRINTS
() DESCRIPTIONS

Transmitted herewith are the following:

 Copies of Parcel Descriptions for Parcel(s) No(s).

 Reduced Sets of Original Prints.

 9 Reduced Prints of Each of the Following Revised

Sheets: 5, 7

For action by your office as follows:

(XX) For your Files and Information.

(XX) 2 Sets of Prints for your Maintenance Superintendents.

Asst. Chief Engineer - Operations

Attach.

By: 
Staff Right of Way

cc: Al Shablo

J. T. Vickers

See Standard M-100-1 for STANDARD SYMBOLS

STATE DEPARTMENT OF HIGHWAYS DIVISION OF HIGHWAYS—STATE OF COLORADO

RE: R.O.W.
under FC 550-2(9)

FEDERAL ROAD REGION NO.	DIVISION	PROJECT NO.	SHEET NO.
XIII	COLORADO	FC 550-2(12)	1

AS CONSTRUCTED		
NO REVISIONS	REVISED	VOID

PLAN AND PROFILE OF PROPOSED FEDERAL AID PROJECT NO. FC 550-2(12) STATE HIGHWAY NO. 550 LA PLATA COUNTY

INDEX OF SHEETS

1. Title Page, Sketch Map and Tabulation of Length and Design Data
2. Standard Plans List
3. Typical Section, General Notes, Detail of Ditch Widening
- 4-5. Summary of Approximate Quantities
- 6-7. Structure Quantities
8. Summary of Earthwork Quantities, Wetting Quantities, Subbase Plan, Surfacing Plan and Guard Rail
9. Fencing, Detail of Mailbox Turnout, Schedule of Const. Traffic Control Devices, Delineators (Flexible), Details of French Drain and Inlet Basin
10. Detail of Accel. and Decel. Lanes Sta. 270+ and Traffic Data Sta. 377+
- 11.
12. Details of Combined Road Approaches
- 13-14. Wire Fences and Gates - Std. M-607-1 (Special This Project Only)
- 15-19. Earthwork Data (For Information Only)
- 20-25. Plan and Profile Sheets


SCALES OF ORIGINAL DRAWINGS
ON PLAN, 1 IN. = 100 FT.
ON PROFILE { 1 IN. = 100 FT. HORIZONTAL
1 IN. = 10 FT. VERTICAL
GRADE LINE ON PROFILE IS SHOWN AS GRADE OF FINISHED ROAD

T. 39 N.
STA 404+00 END PROJ 550-2(12)
MILE POST = 44.395
T. 38 N.
STA 245+00 BEG. PROJ. 550-2(12) =
STA. 245+00 END PROJ. FC 550-2(11)
MILE POST = 41.384

TABULATION OF LENGTH & DESIGN DATA

STATION	ROADWAY	
	LINE FT.	
STA. 245+00 BEGIN FC 550-2(12) = STA. 245+00 END FC 550-2(11) STA. 404+00 END FC 550-2(12)	15,900	
SUMMARY		
	LINE FT.	MILES
ROADWAY (NET & GROSS LENGTH)	15,900	3.011
DESIGN DATA		
MAXIMUM DEGREE OF CURVE	5°30'	
MAXIMUM GRADE	6.00 %	
MINIMUM S.S.D. VERTICAL	460'	
MINIMUM S.S.D. HORIZONTAL	667'	
MAXIMUM DESIGN SPEED	60 MPH	
2003 DESIGN TRAFFIC VOLUME	ADT = 2350 DNV = 500	

T. 37 N.

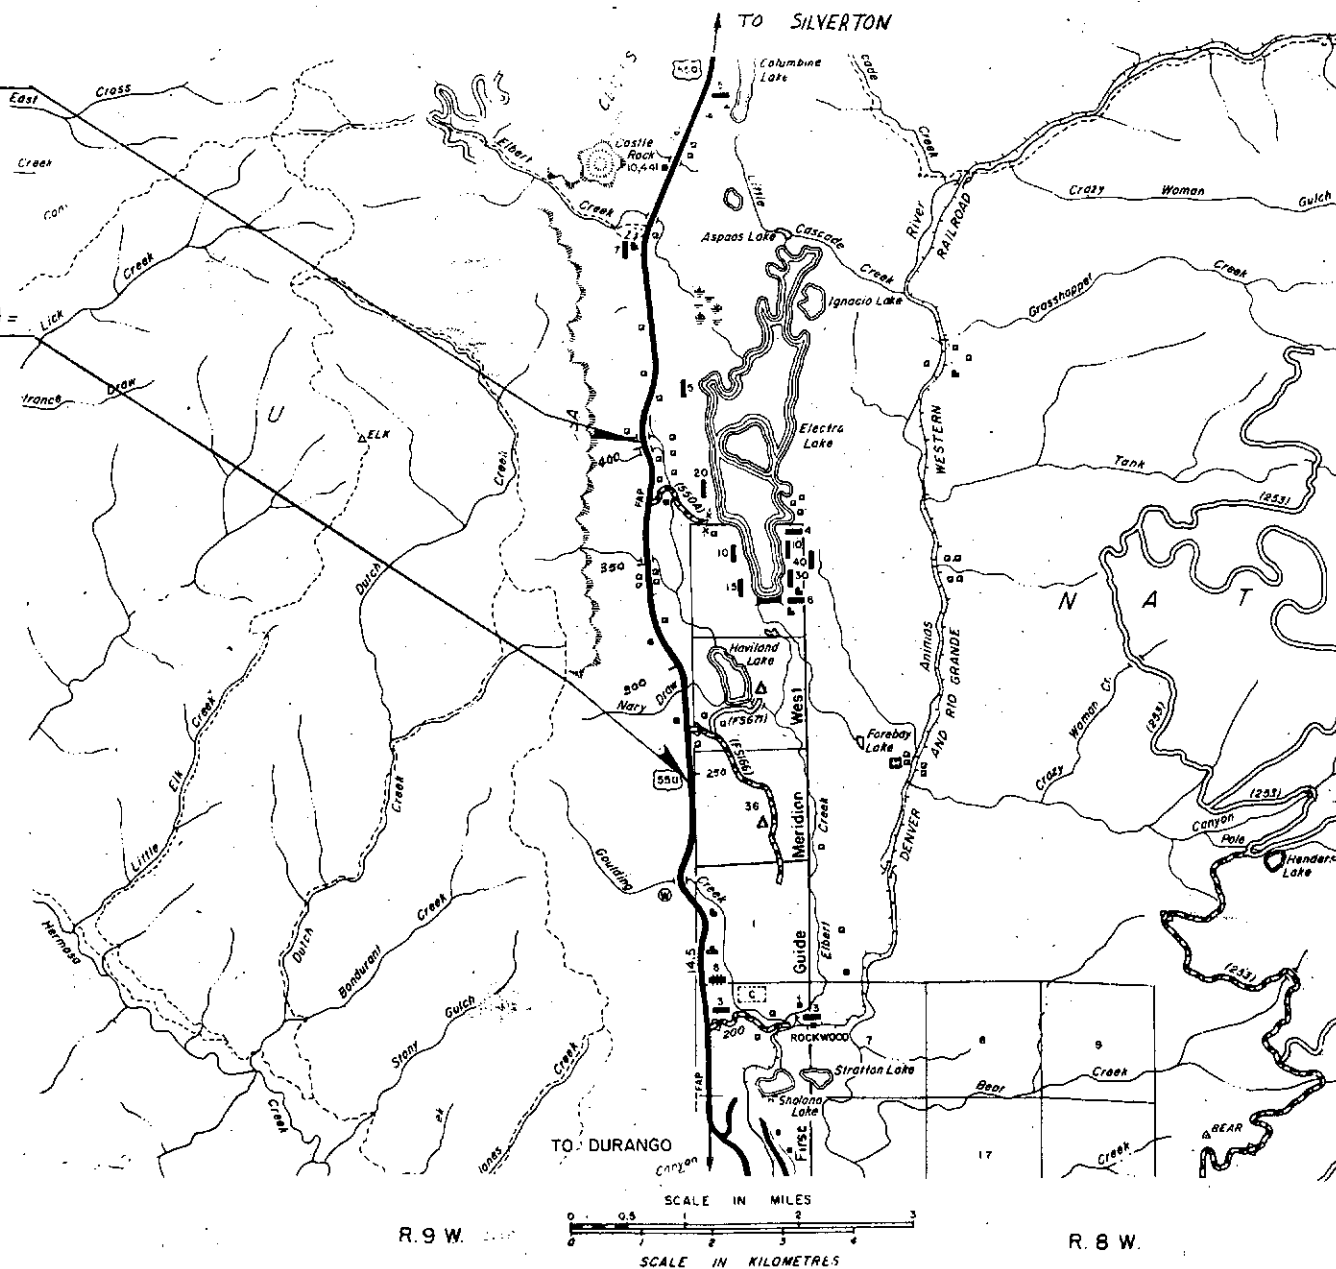

GLM.

DIVISION OF HIGHWAYS


APPROVED: J. E. Siebel 11-8-83
Asst. CHIEF ENGINEER DATE


AS CONSTRUCTED INFORMATION



CONTRACTOR _____
ENGINEER _____
(Project or Resident)
PROJECT STARTED _____
PROJECT COMPLETED _____
AS CONSTRUCTED PLANS APPROVED _____
TITLE _____ DATE _____

PLAN
DATE: 10/1/72
BY: J. Smith
CHECKED: J. Smith
NOTED: J. Smith
NO. 33282
SECTION: 33282

PROFILE
DATE: 10/1/72
BY: J. Smith
CHECKED: J. Smith
NOTED: J. Smith
NO. 33282
SECTION: 33282

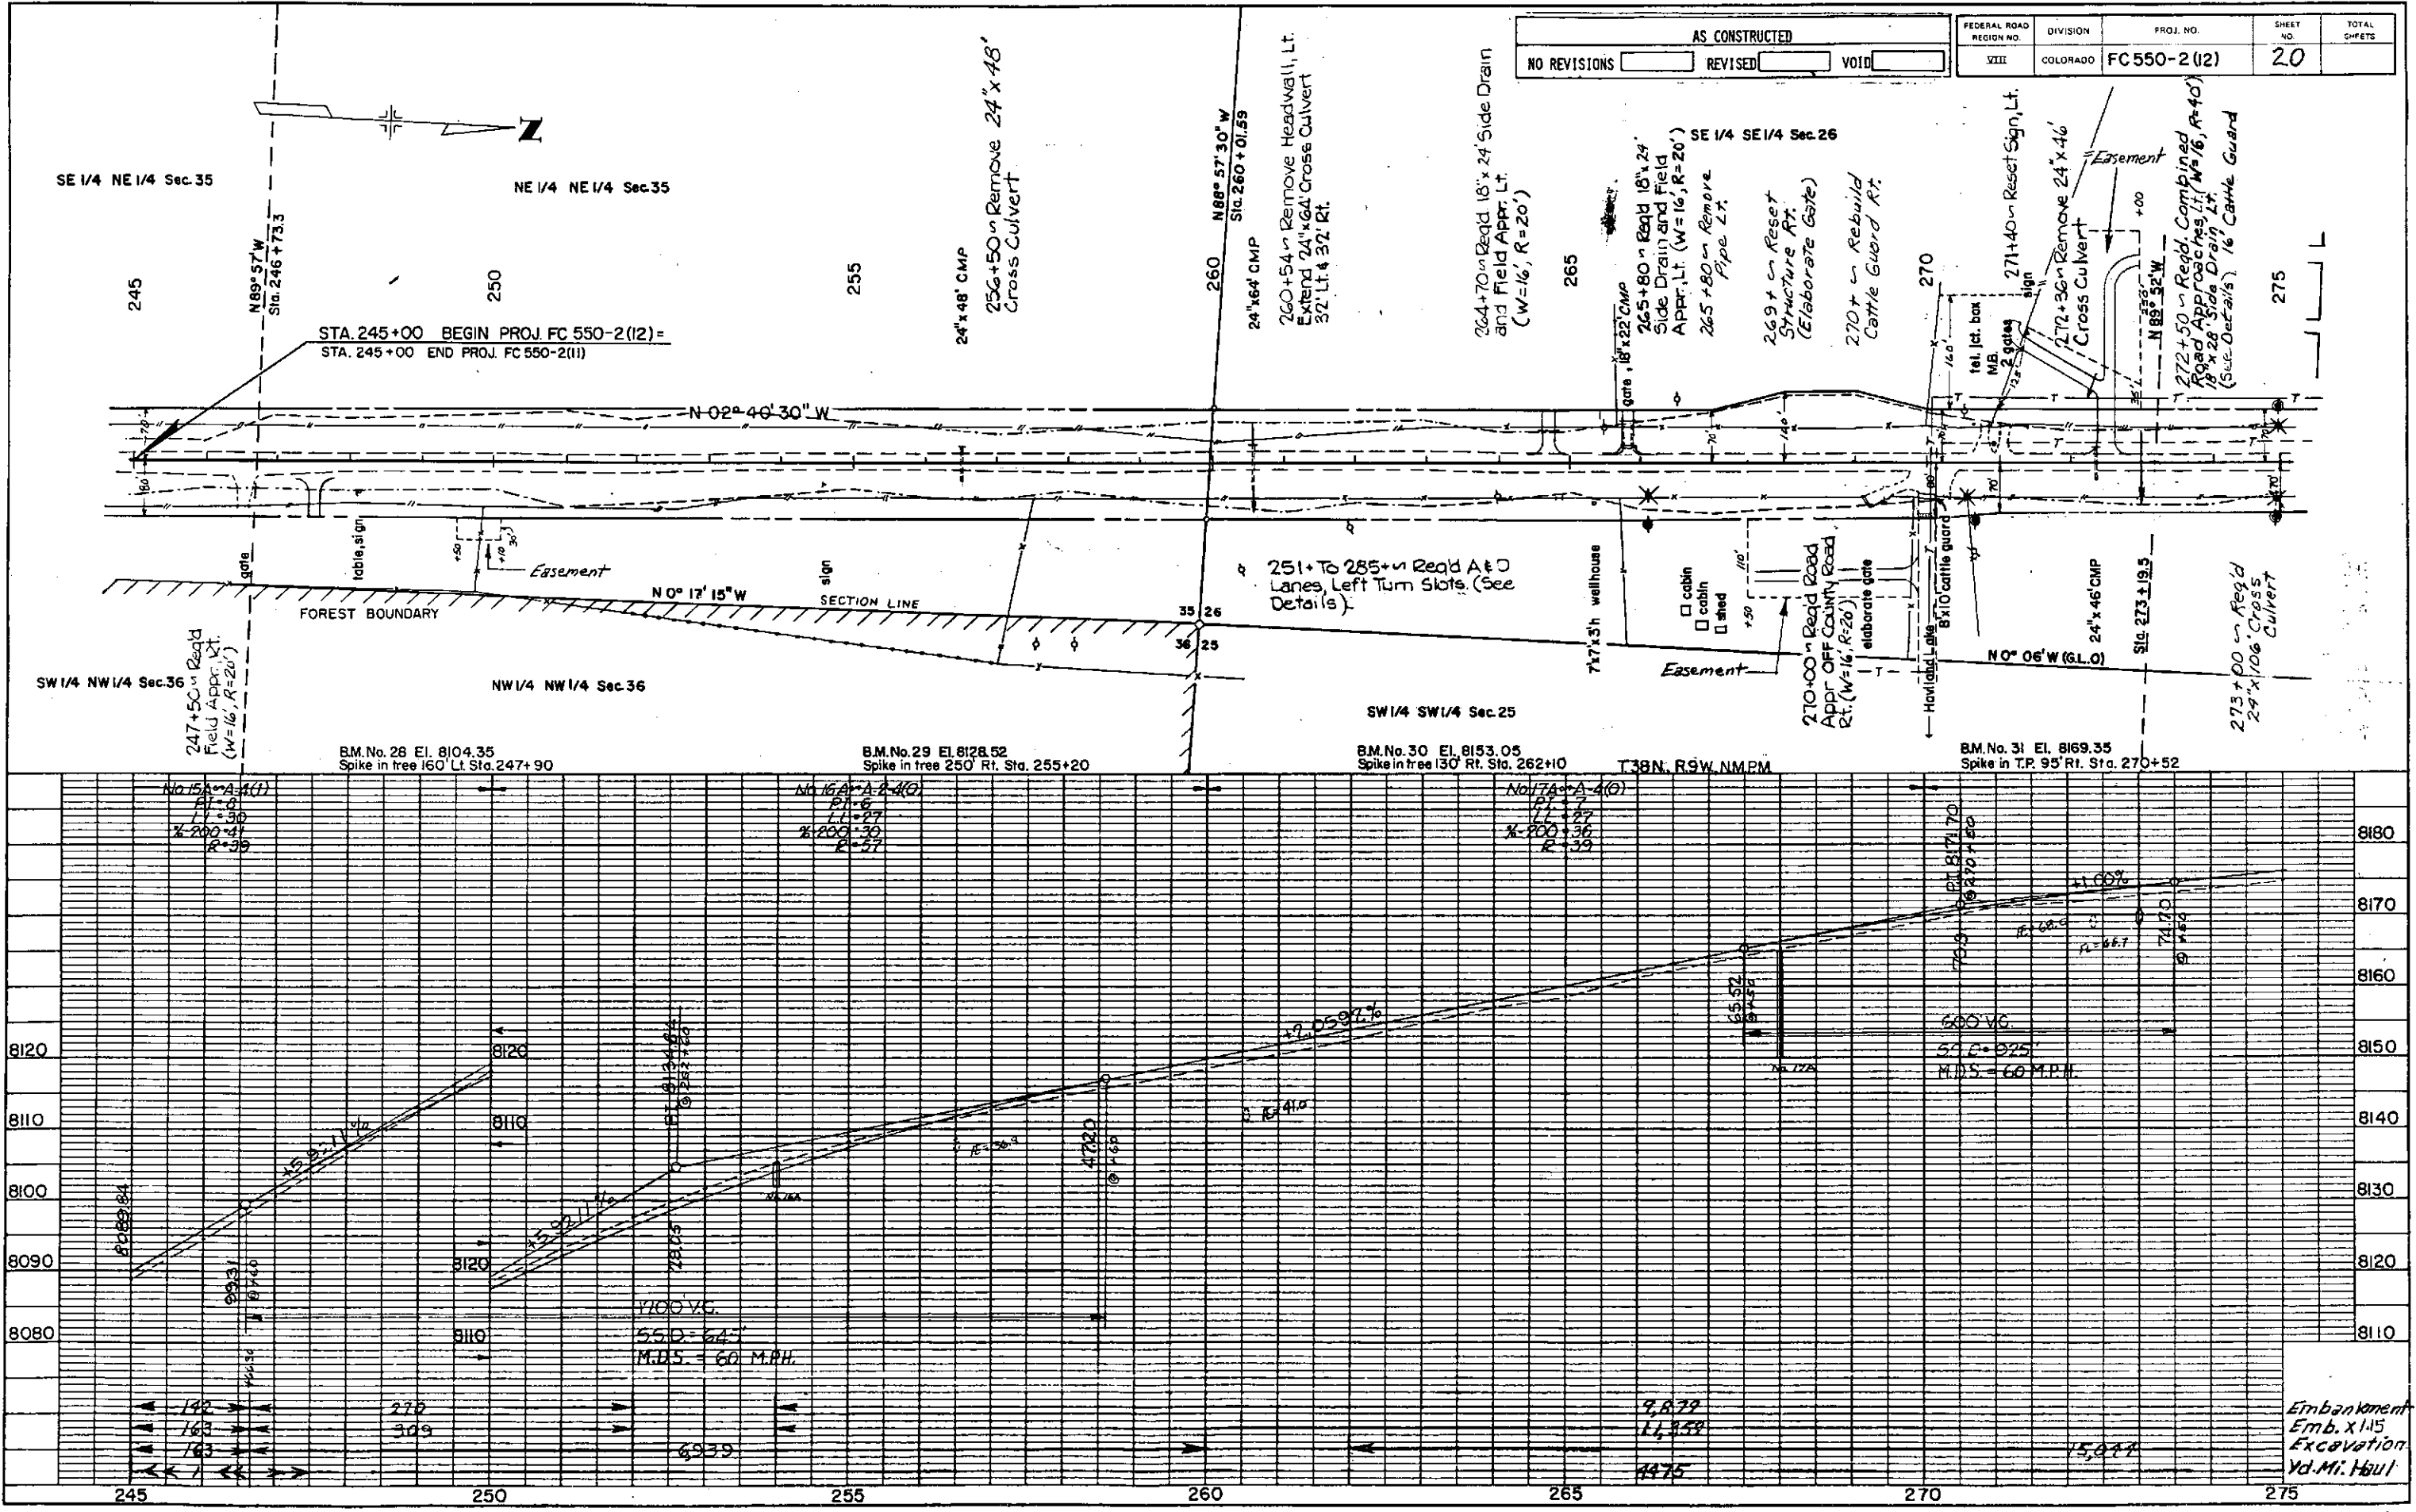

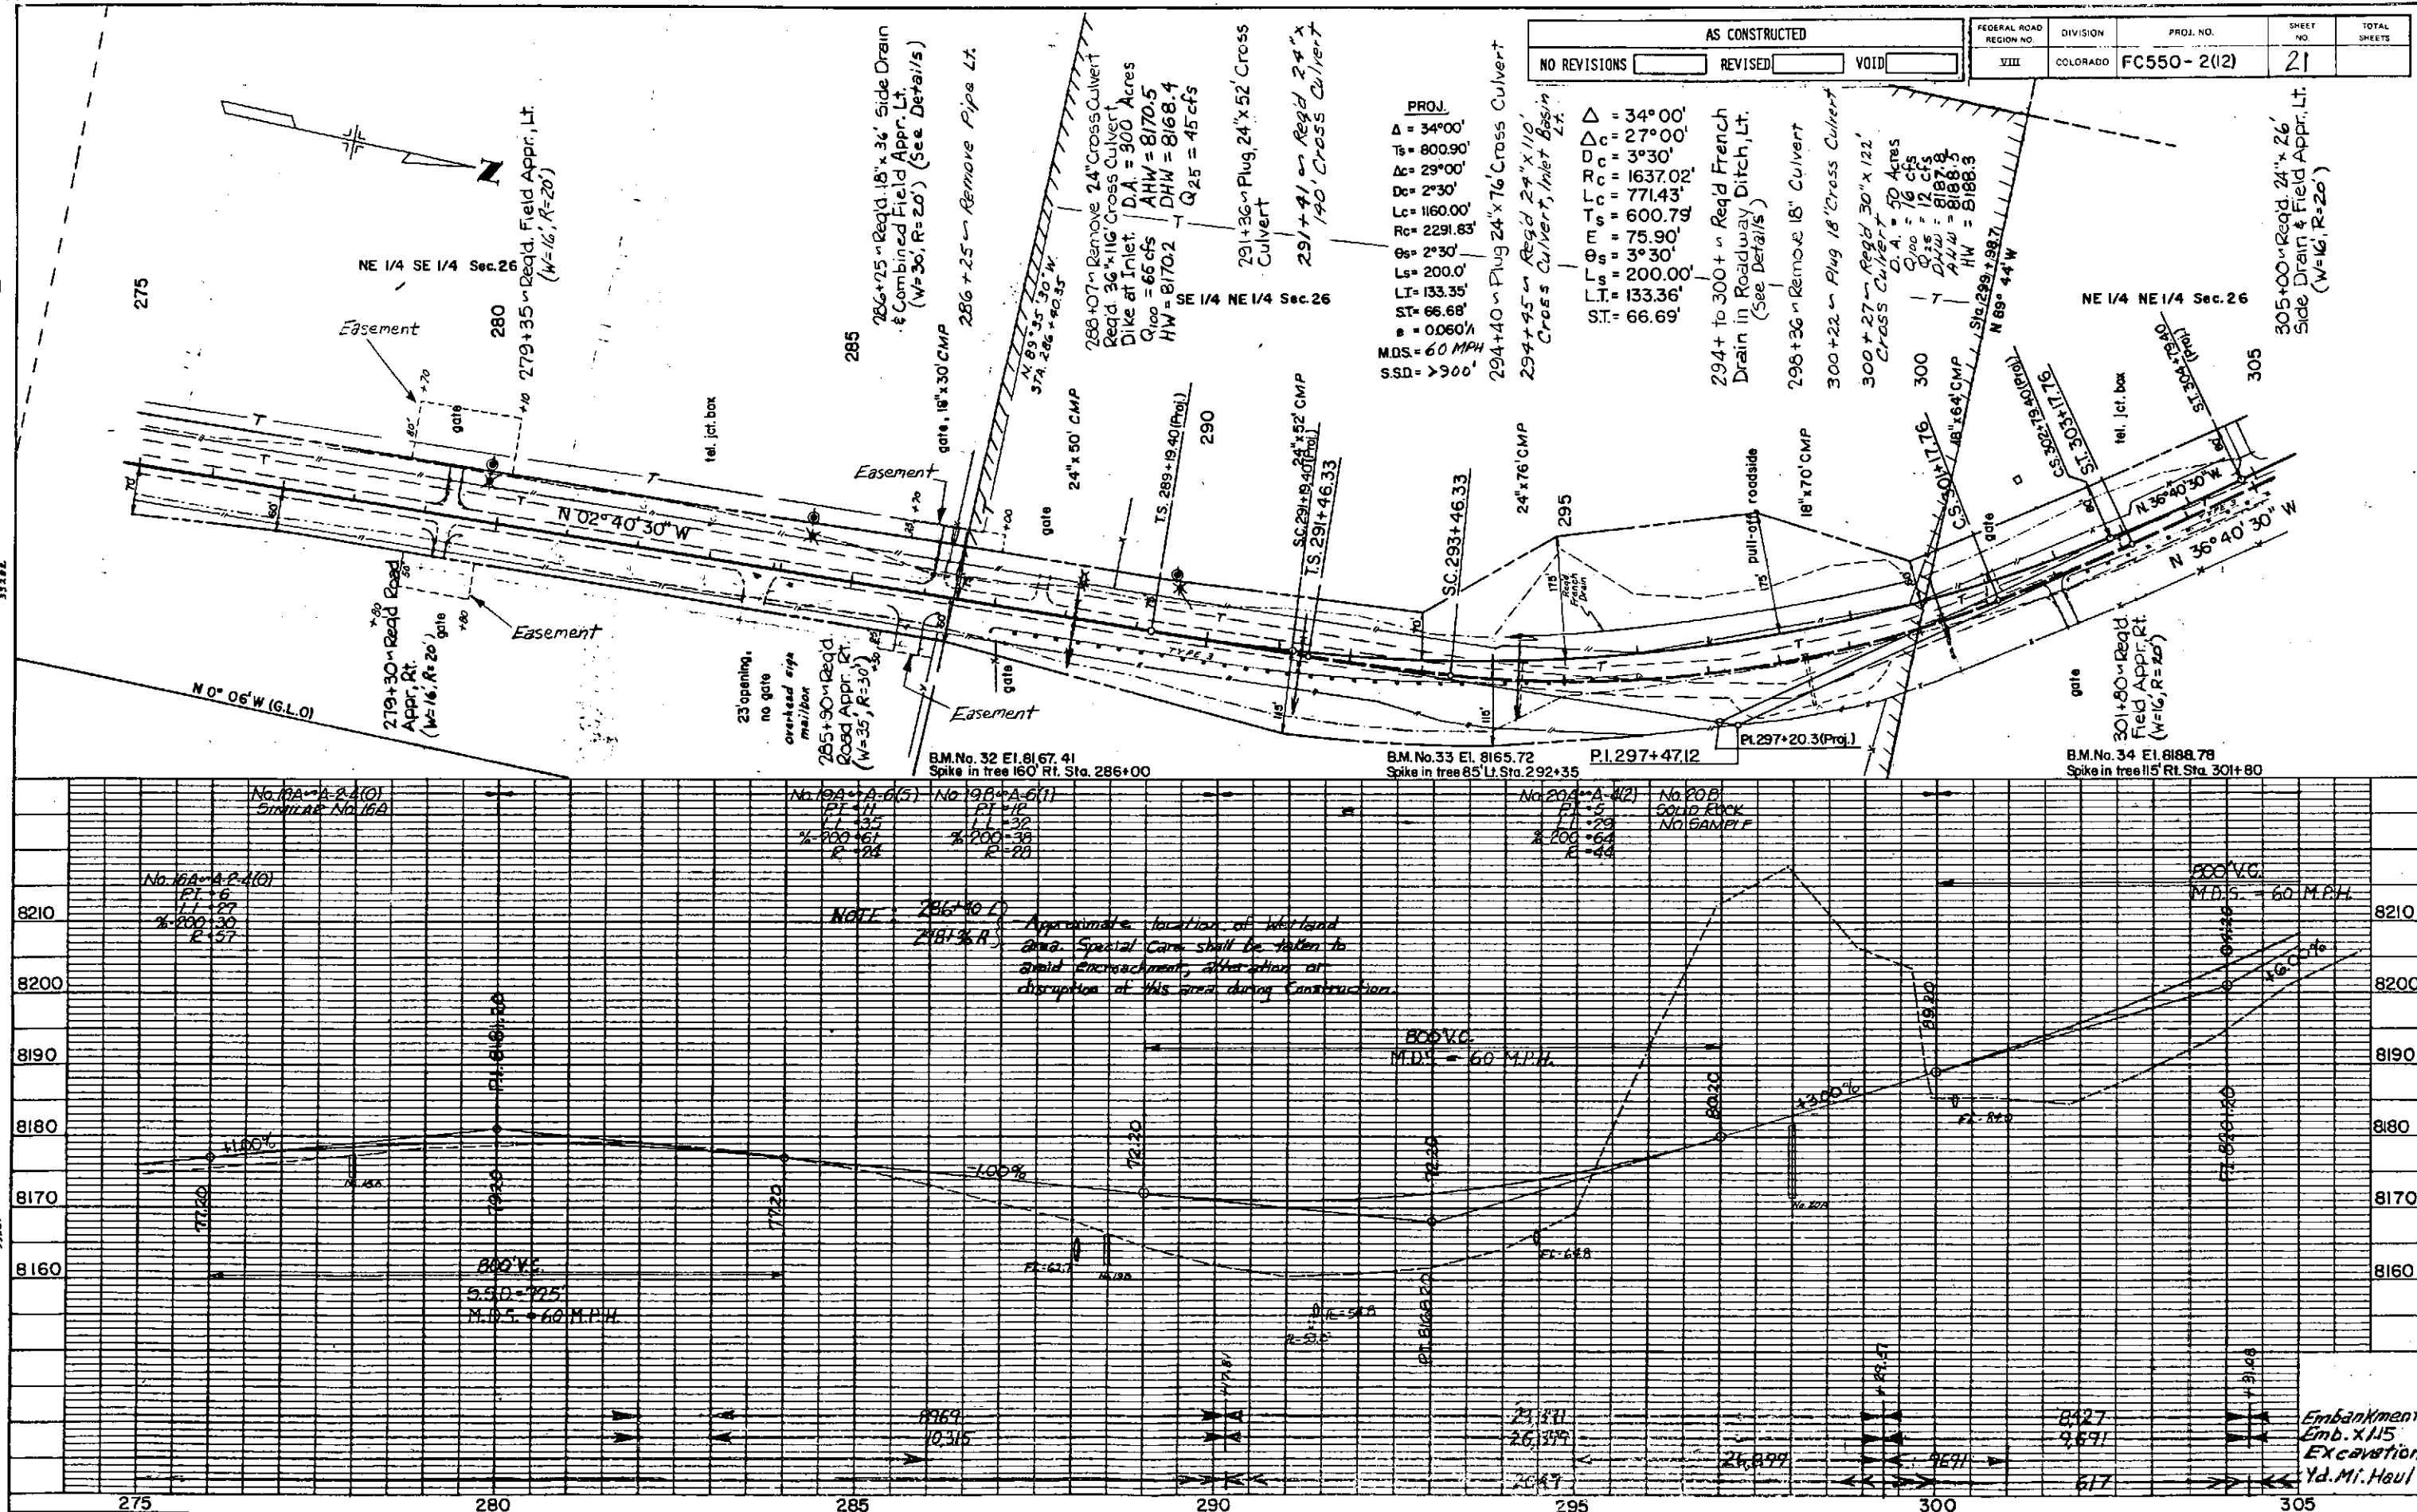

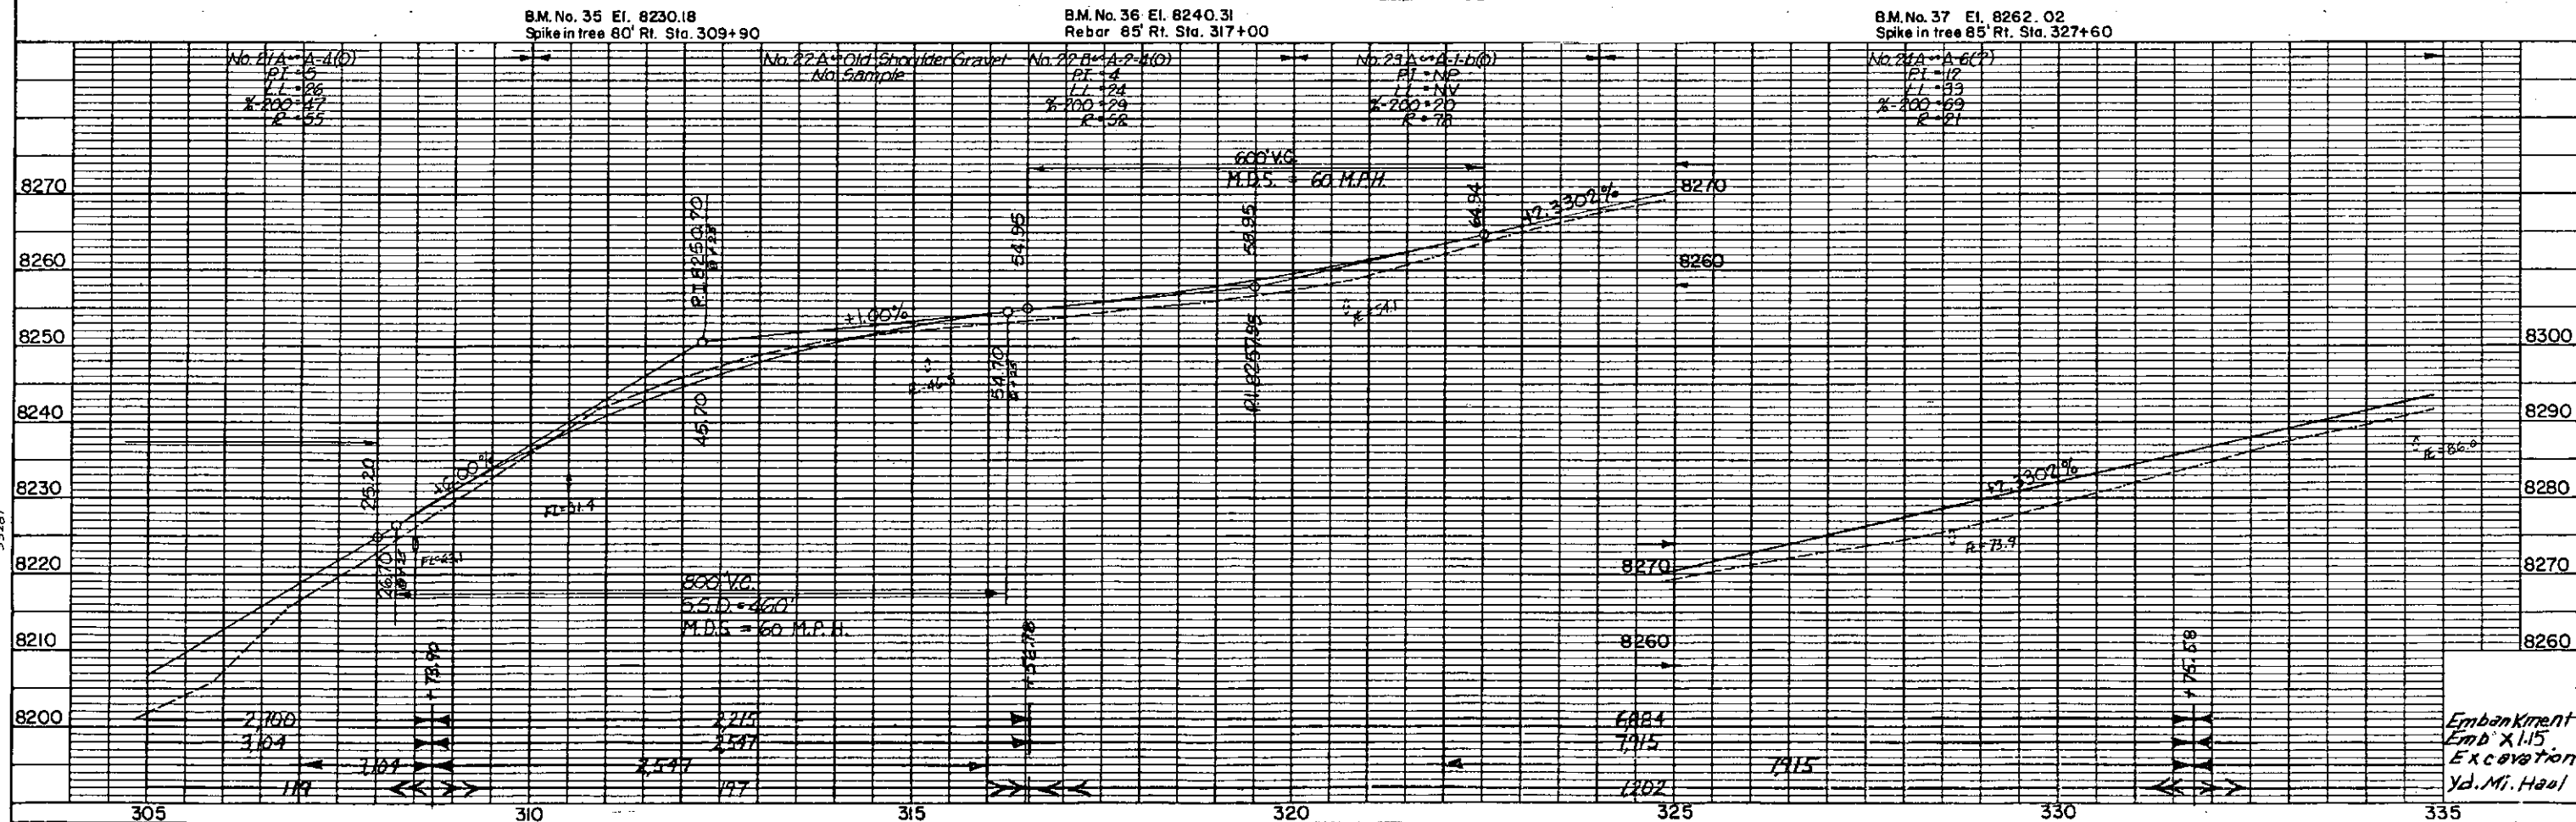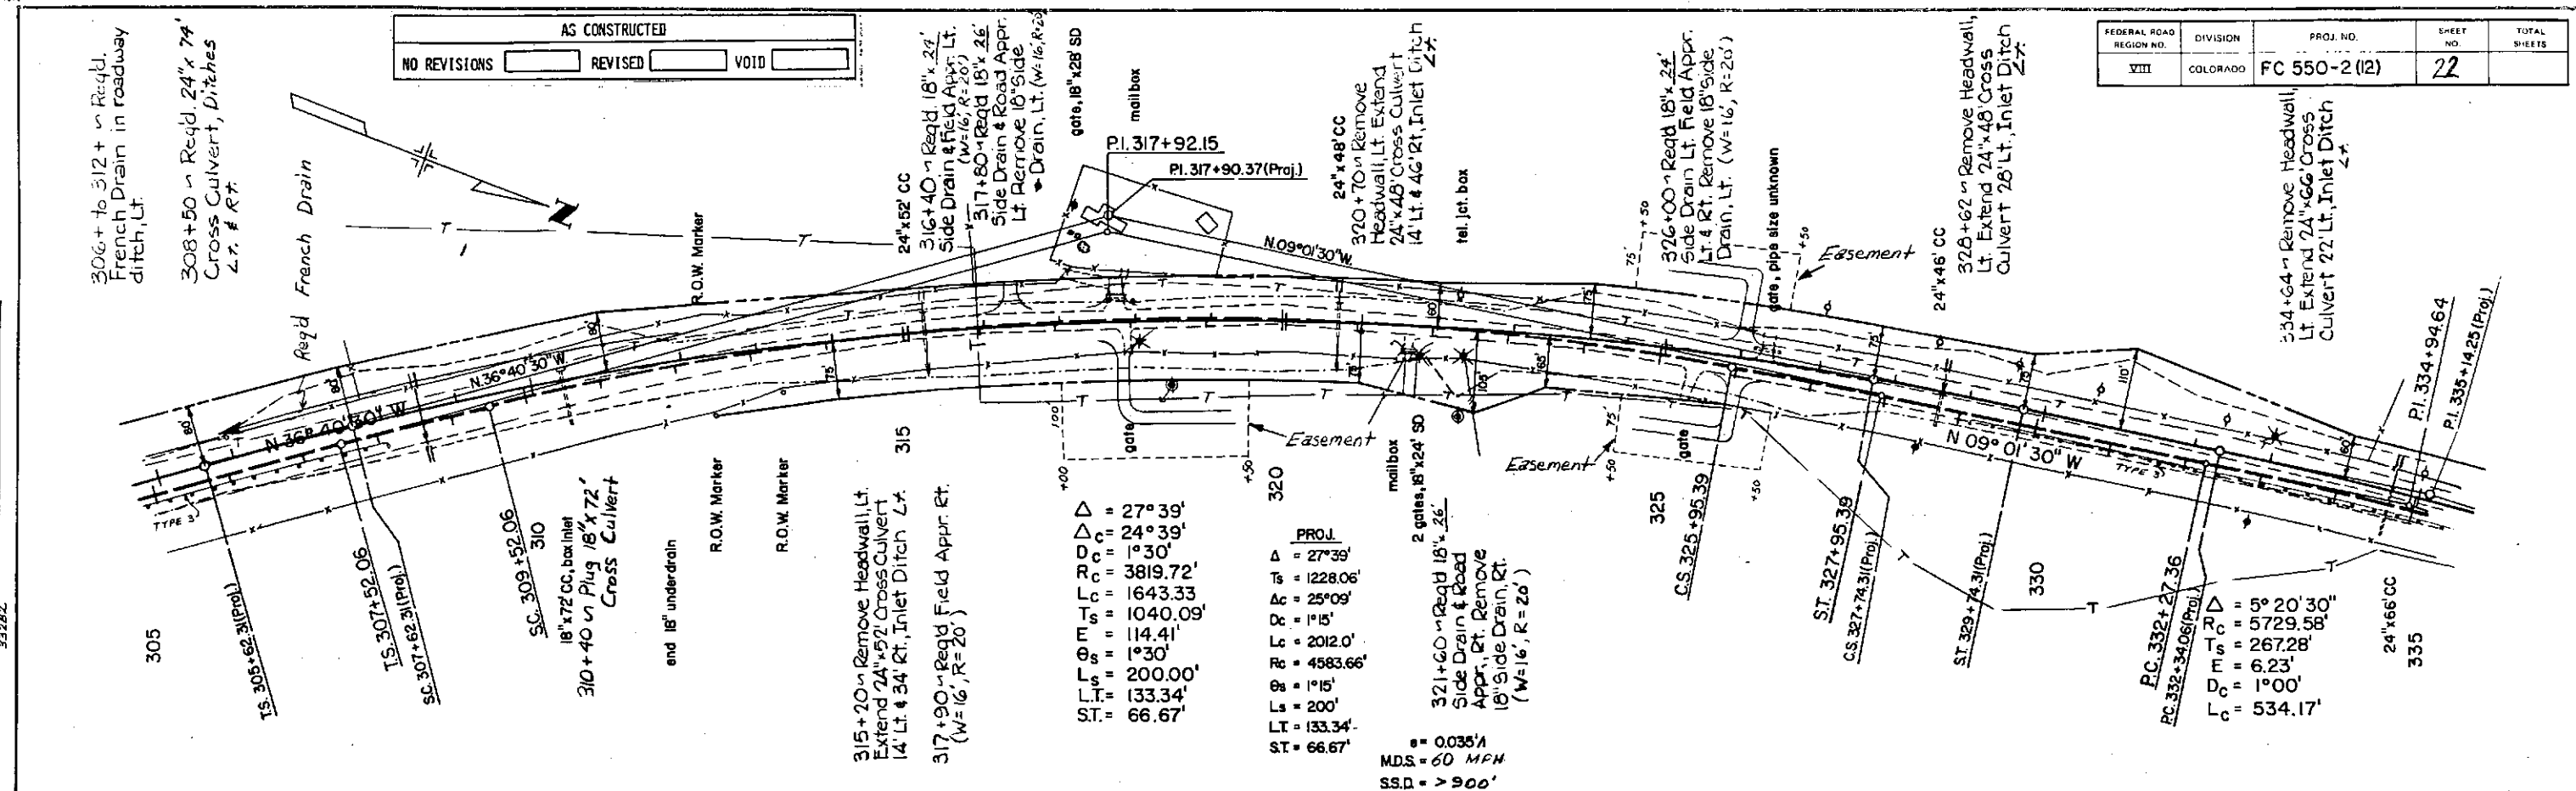

370+00 ~ Req'd. Field.
Appr. Lt. (W=16', R=20')

PROJ.
 $\Delta = 12^\circ 15' 51''$
 $D = 0^\circ 45'$
 $T = 820.74'$
 $L = 1635.21'$
 $R = 7639.44'$
 $e = 0.022\%$
M.D.S. = 60 MPH
S.S.D. = 900'

B.M. No. 43 EL. 8340.17
Spike in P.P. 52' Rt. STA. 369+19

B.M. No. 44 EL. 8354.36
Spike in PP 49' Rt STA. 373+82

B.M. No. 45 EL. 8374.73
Spike in PP 62' Rt. STA. 376+89

B.M. No. 46 EL. 8398.19
H. & G. 49' R. STA. 381+59

B.M. No. 47 EL. 8435.92
H. & G. 49' Lt. STA. 387+38


PROJ.
 $\Delta = 31^{\circ}39'10''$
 $T_s = 564.32'$
 $\Delta c = 24^{\circ}39'10''$
 $Dc = 3^{\circ}30'$
 $Lc = 704.37'$
 $Rc = 1637.02'$
 $\theta_s = 3^{\circ}30'$
 $LS = 200.0'$
 $LT = 133.36'$
 $ST = 66.69'$
 $e = 0.073\%$
 MDS. = 60 mph
 SSD = 667'

394 + 48 = Remove Headwall Lt.
 Extend 24' + 46' Cross Culvert
 38' Lt. Inlet Ditch Lt.

Embankment	
Emb. x 1.5	
Excavation	
Yd. Mi. Haul	

AS CONSTRUCTED		
NO REVISIONS	REVISED	VOID


FEDERAL ROAD REGION NO.	DIVISION	PROJECT NO.	SHEET NO.	TOTAL SHEETS
VIII	COLORADO	FC 550-2(12)	25	

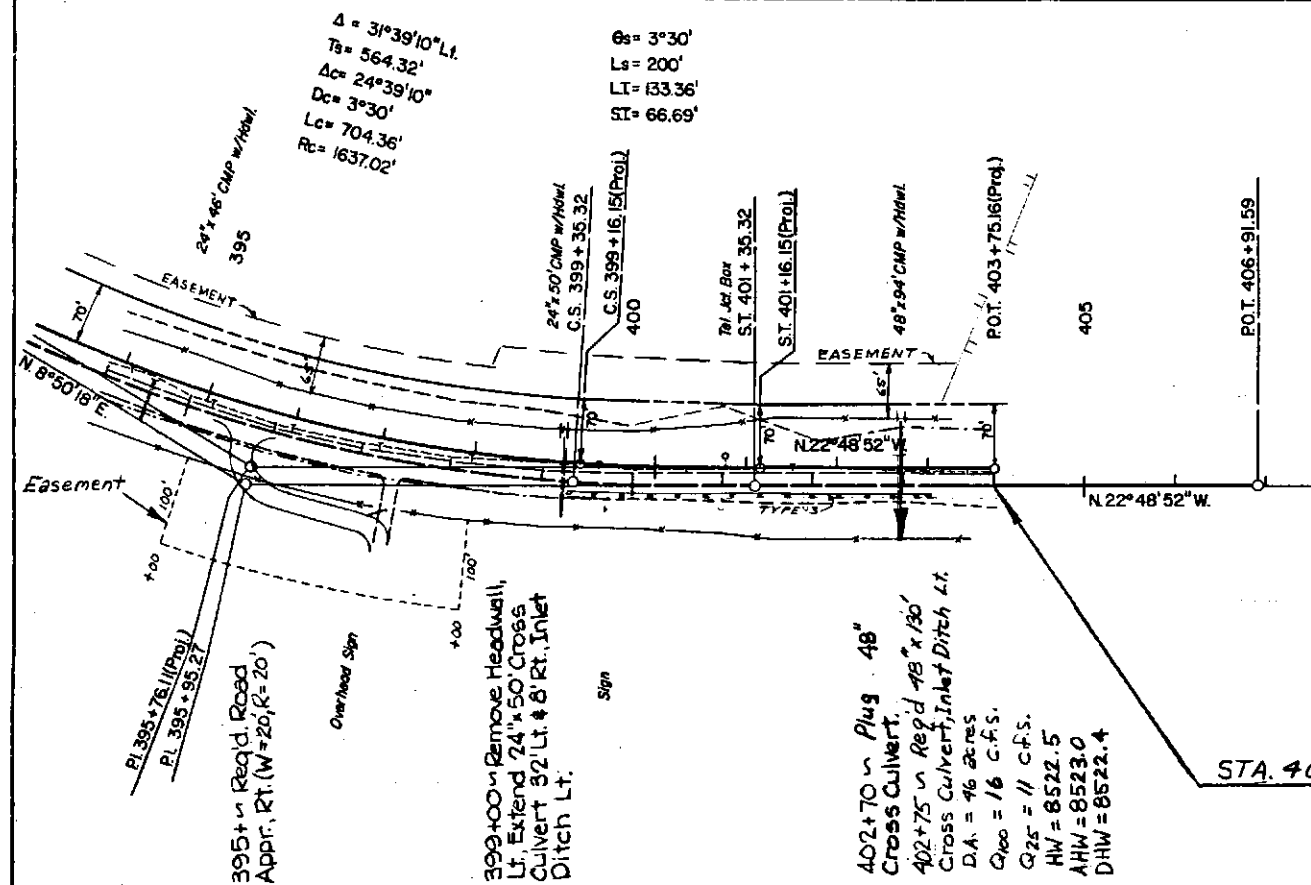

STA. 404+00 END FC 550-2(12)

B.M. No. 48 EL. 8491.15
H.B.G. 57' RT. STA. 397+25

B.M. No. 49 EL. 8523.65
H.B.G. 75' LT. STA. 402+00

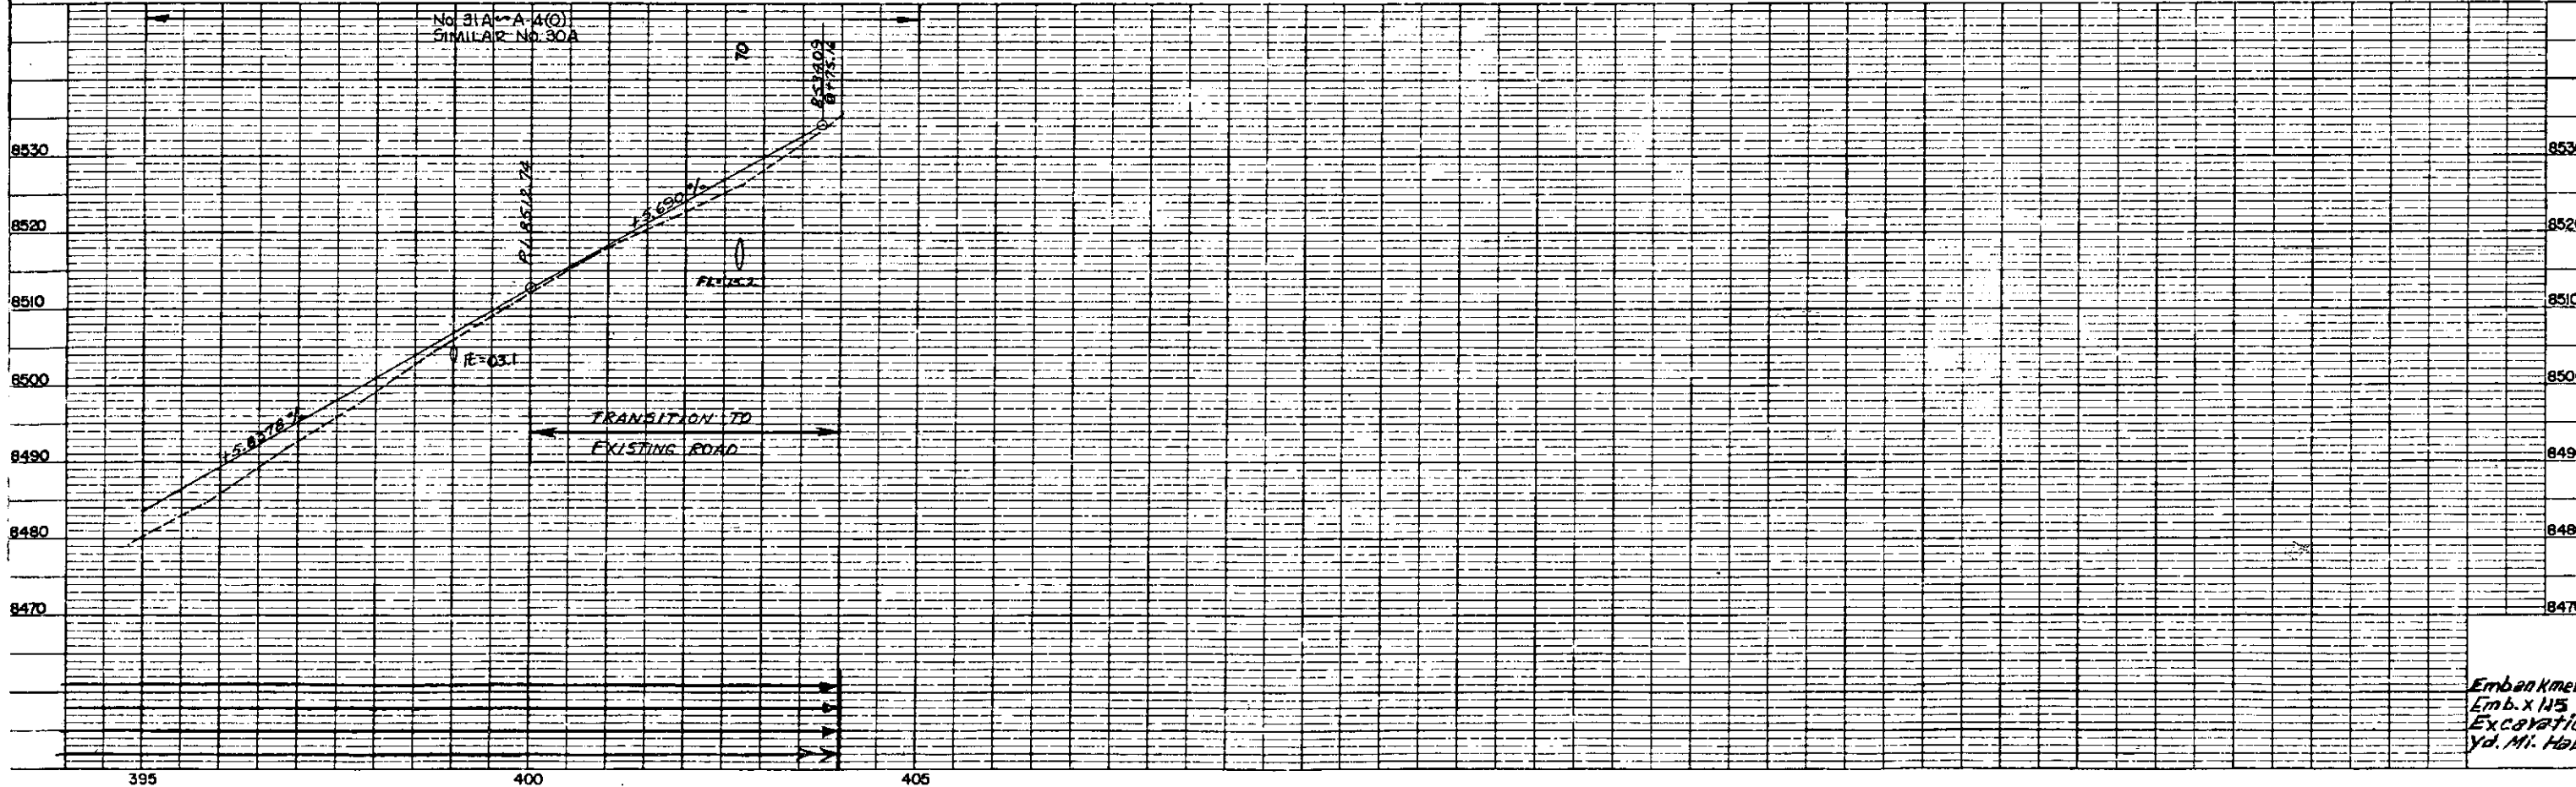

370+00 ~ Regd. Field
Appr. Lt. (W=16; R=20')

PROJ

$\Delta = 12^\circ 15' 51''$
 $D = 0^\circ 45'$
 $T = 820.74'$
 $L = 1635.21'$
 $R = 7539.44'$
 $e = 0.02271$
M.D.S. = 0.0144
S.S.D. = 900'

B.M. No. 43 EL. 8340.17
Spike in PP 52' Rt. STA. 369+19

B.M. No. 44 EL. 8354.36
Spike in PP 49' RL STA. 373+82


B.M. No. 45 EL. 8374.73
Spike in P.P. 62' Rt. STA. 376+89

B.M. No. 46 EL. 8398.19
H. & G. 49' Rt. STA. 381+59

B.M. No. 47 EL. 8435.92
H. & G. 49' Lt. STA. 387+38

PROJ.
 $\Delta = 3^{\circ}39'10''$
 $T_s = 564.32'$
 $\Delta c = 24^{\circ}39'10''$
 $Dc = 3^{\circ}30'$
 $Lc = 704.37'$
 $Rc = 1637.02'$
 $\theta_s = 3^{\circ}30'$
 $L_s = 200.0'$
 $LT = 133.36'$
 $ST = 66.69'$
 $e = 0.073\%$
M.S.D. = 60 mph
S.S.D. = 667'

304 + 42.00 Concrete Headwall, Lt.
Extend 24' x 46" Culvert
39' Lt. Inlet Ditch Lt.
39'

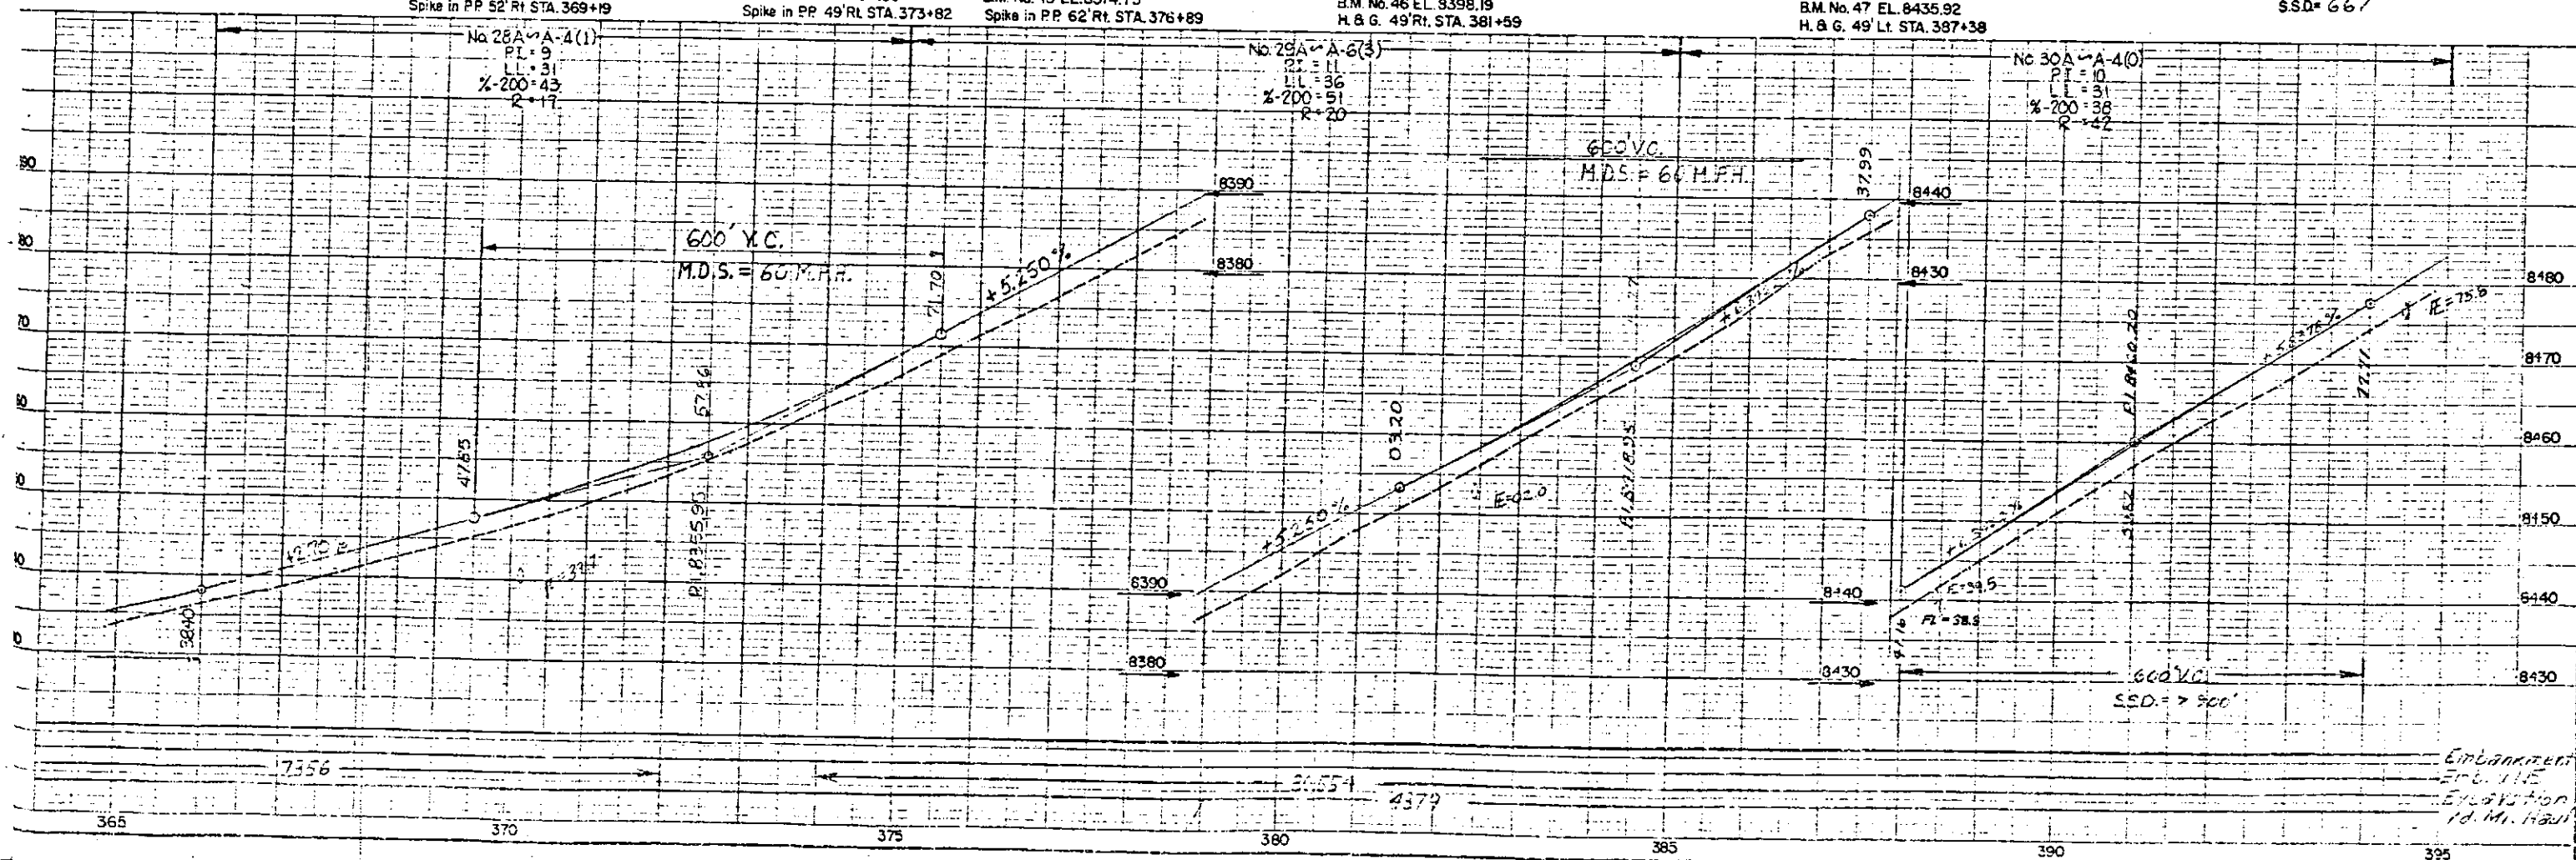

STATE DEPARTMENT OF HIGHWAYS

DIVISION OF HIGHWAYS—STATE OF COLORADO

FEDERAL ROAD DIST. NO.	DIVISION	PROJECT NO.	SHEET NO.
22	COLORADO	FC 550-2(9) Sec. 2	1

REVISIONS	

RIGHT OF WAY
ROCKWOOD TO PURGATORY

CONVENTIONAL SIGNS

County Line
Township or Range Line
Land Lines
Property or Tract Line
City Limits
Railroad
Existing Road
New Road

Control of Access
Access denied by Ceed
Right of Way Line
Protected by Freeway (Virgin Location)
Top of Cuts
Toe of Fills
Barbed Wire Fence
Chain Link Fence
Woven Wire-Combination Fence
Snow Fence
Wood Fence
Dear Fence

Trees
Deciduous
Coniferous

Tel. & Teleg. Lines
Electric Lines
Elec. Trans. Tower
Buried Tel. Cable
Buried Electric Cable
Gas Main
Oil Main
Water Main
Sanitary Sewers
Storm Sewers

Road Approaches
Section Corner
Center of Section

Culverts & Drains
Proposed
Existing
Proposed
Existing (To be done)

Bridges
Existing

RIGHT OF WAY PLAN OF PROPOSED FEDERAL AID PROJECT NO. FC 550-2(9) Sec. 2 STATE HIGHWAY NO. 550 LA PLATA COUNTY

RIGHT OF WAY

SCALE OF ORIGINAL DRAWINGS

PLAN SHEETS 1" = 100'
TOTAL OWNERSHIP MAP 1" = 500'


LENGTH OF PROJECT = 2.52 MILES

INDEX OF SHEETS

- (1) TITLE SHEET
- (2-2F) TABULATION OF PROPERTIES
- (3-8) PLAN SHEETS
- (9) TOTAL OWNERSHIP MAP

STA. 403+12.61 END R.O.W. PROJ. FC 550-2(9) Sec. 2

STA. 270+01.61 BEGIN R.O.W. PROJ. FC 550-2(9) Sec. 2

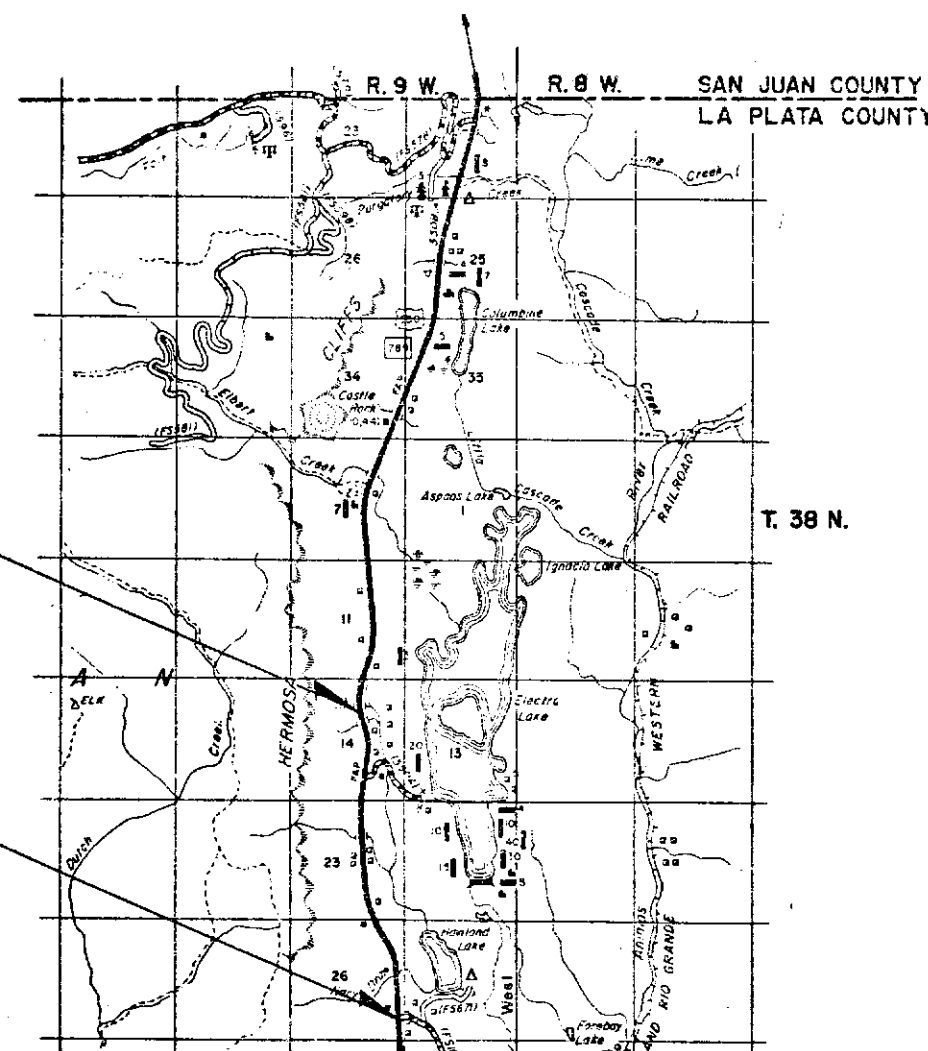

0 1 2
SCALE IN MILES

DIVISION OF HIGHWAYS	
APPROVED: <i>[Signature]</i> CHIEF ENGINEER	4/1/52 DATE

DEPARTMENT OF TRANSPORTATION FEDERAL HIGHWAY ADMINISTRATION	
APPROVED:	DATE
DIVISION ADMINISTRATOR	

R. O. W. TABULATION OF PROPERTIES IN

LA PLATA

COUNTY

S. H. NO.

550

FEDERAL ROAD REGION NO.	DIVISION	PROJECT NO.	SHEET NO.
VIII	COLORADO	FC 550-2(9) Sec. 2	2A

RIGHT OF WAY
ROCKWOOD TO PURGATORY

PARCEL NO.	OWNER	ADDRESS	LOCATION	AREA IN ACRES				PARCEL NO.	REMARKS	REVISIONS		
				PARCEL	TO BE ACQUIRED	REMAINDER						
						LEFT	RIGHT					
			T.38N., R.9W., N.M.P.M.									
TE-10C	RUEDI BAER	42570 U.S. HIGHWAY 550 DURANGO, COLORADO 81301	NE½ SE½, Sec. 26	0.046				TE-10C	Road approach.			
TE-11	MILTON F. AND DOROTHY M. LECHNER		NE½ SE½, Sec. 26	0.241				TE-11	Road approach.			
TE-12	ALBERT J. AND JOSEPHINE G. LECHNER, J.T.		NE½ SE½, Sec. 26	0.034				TE-12	Road approach.			
13	STATE OF COLORADO (FISH & GAME)	151 EAST 16th DURANGO, COLORADO 81301	SE½ NE½, Sec. 26	6.629	3.220	25.00±	9.187±	13	Plus land in sections 24 and 25.			
TE-13	STATE OF COLORADO (FISH & GAME)	151 EAST 16th DURANGO, COLORADO 81301	SE½ NE½, Sec. 26	.041				TE-13	Road approach.			
14	MILTON F. LECHNER, TRUSTEE DOROTHY M. LECHNER JOHN LECHNER	BOX 34 BLOOMFIELD, NEW MEXICO 87413	NE½ NE½, Sec. 26	0.899	0.899	79±	161±	14				
15	RALPH D. WATTERS, TRUSTEE OF DONALD R. HOEL AND JUANITA A. HOEL REVOCABLE TRUST		N½ NE½, Sec. 26	0.356	0.356	4.430	—	15				

R. O. W. TABULATION OF PROPERTIES IN

LA PLATA

COUNTY

S.H. NO. 550

FEDERAL ROAD REGION NO.	DIVISION	PROJECT NO.	SHEET NO.
VIII	COLORADO	EC 550-2(9) Sec. 2	2B

RIGHT OF WAY
ROCKWOOD TO PURBATORY

PARCEL NO.	OWNER	ADDRESS	LOCATION	AREA IN ACRES				PARCEL NO.	REMARKS	REVISIONS		
				PARCEL	TO BE ACQUIRED	REMAINDER				9/11/84	Correct Pos 17,18,19	E.M.
						LEFT	RIGHT					
			T.38N., R.9W., N.M.P.M.									
16	MINTON I. MOORE AND INA MAY MOORE, J.T.	5718 N. 10th AVENUE PHOENIX, ARIZONA 85013	NE½ NE½, Sec. 26	0.034	0.034	—	1.861	16				
17	MILTON F. LECHNER, TRUSTEE DOROTHY M. LECHNER JOHN LECHNER	BOX 34 BLOOMFIELD, NEW MEXICO 87413	NE½ NE½, Sec. 26	0.099	0.099	SEE PARCEL 14		17				
17	MILTON F. LECHNER, TRUSTEE DOROTHY M. LECHNER JOHN LECHNER	BOX 34 BLOOMFIELD, NEW MEXICO 87413	SE½ SE½, Sec. 23 SW½ SE½, Sec. 23	0.504 0.603	0.504 0.603	SEE PARCEL 14 TOTAL		17				
TE-17	MILTON F. LECHNER, TRUSTEE DOROTHY M. LECHNER JOHN LECHNER	BOX 34 BLOOMFIELD, NEW MEXICO 87413	SW½ SE½, Sec. 23	0.564				TE-17	Road approach.			
18	PETER K. BOLI, W. JILL BOLI, BRADNEY A. BOLI, AND TIFFANI K. BOLI, J.T.	475 PALM DRIVE ARCADIA, CALIFORNIA 91006	SW½ SE½, Sec. 23	0.124	0.124	—	3.0±	18				
19	MILTON F. LECHNER, TRUSTEE DOROTHY M. LECHNER JOHN LECHNER	BOX 34 BLOOMFIELD, NEW MEXICO 87413	SW½ SE½, Sec. 23	0.119	0.119	SEE PARCEL 14		19				

RIGHT OF WAY
ROCKWOOD TO PURGATORY

PARCEL NO.	OWNER	ADDRESS	LOCATION	AREA IN ACRES				PARCEL NO.	REMARKS	REVISIONS		
				PARCEL	TO BE ACQUIRED	REMAINDER						
						LEFT	RIGHT					
			T.38N., R.9W., N.M.P.M.									
23	ASPEN WINDS II A LTD. PARTNERSHIP TO ROBERT GRAHAM - KATE STORY KESSLER	P.O. BOX 100	SW $\frac{1}{4}$ NE $\frac{1}{4}$, Sec. 23	0.552	0.253	8.0 $\pm$	—	23				
TE-23	ASPEN WINDS II A LTD. PARTNERSHIP TO ROBERT GRAHAM - KATE STORY KESSLER	P.O. BOX 100	SW $\frac{1}{4}$ NE $\frac{1}{4}$, Sec. 23	0.066				TE-23	Road approach.			
24	JANET FARRINGTON YOUNGBERG NANCY FARRINGTON HIGGINS ANTHONY S. FARRINGTON J. C. FARRINGTON III	705 AMHERST S.E. ALBUQUERQUE, NEW MEXICO 87108	SW $\frac{1}{4}$ NE $\frac{1}{4}$, Sec. 23	0.244	0.116	1.089	—	24				
TE-24	JANET FARRINGTON YOUNGBERG NANCY FARRINGTON HIGGINS ANTHONY S. FARRINGTON J. C. FARRINGTON III	705 AMHERST S.E. ALBUQUERQUE, NEW MEXICO 87108	SW $\frac{1}{4}$ NE $\frac{1}{4}$, Sec. 23	0.084				TE-24	Road approach.			
25	FRITZ ALLEN, et al	P.O. BOX 780 CORRALES, NEW MEXICO	SW $\frac{1}{4}$ NE $\frac{1}{4}$ and NW $\frac{1}{4}$ NE $\frac{1}{4}$, Sec. 23	0.279	0.151	1.054	—	25				
TE-25	FRITZ ALLEN, et al	P.O. BOX 780 CORRALES, NEW MEXICO	SW $\frac{1}{4}$ NE $\frac{1}{4}$ and NW $\frac{1}{4}$ NE $\frac{1}{4}$, Sec. 23	0.204				TE-25	Road approach.			
26	DOUGLAS L. AND LORENA J. REPAAL	5019 27th STREET LUBBOCK, TEXAS 49407	NW $\frac{1}{4}$ NE $\frac{1}{4}$, Sec. 23	0.270	0.142	1.063	—	26				

R.O.W. TABULATION OF PROPERTIES IN

LA PLATA

COUNTY

S.H. NO.

550

FEDERAL ROAD REGION NO.	DIVISION	PROJECT NO.	SHEET NO.
XIII	COLORADO	FC 550-2(9) Sec. 2	2E

RIGHT OF WAY
ROCKWOOD TO PURGATORY

PARCEL NO.	OWNER	ADDRESS	LOCATION	AREA IN ACRES				PARCEL NO.	REMARKS	REVISIONS		
				PARCEL	TO BE ACQUIRED	REMAINDER						
						LEFT	RIGHT					
			T.38N., R.9W., N.M.P.M.									
PE-26	DOUGLAS L. AND LORENA J. REPAAL	5019 27th STREET LUBBOCK, TEXAS 49407	NW¼ NE¼, Sec. 23	0.293	0.293			PE-26	Road approach. (permanent access)			
27	LEE M. AND HAZEL RATCLIFFE, J.T.	724 N. CUSTER WEATHERFORD, OKLAHOMA	NW¼ NE¼, Sec. 23	0.815	0.425	3.191	—	27				
28	WILLIAM LECHNER	BOX 170, SILVERTON STAR RT. DURANGO, COLORADO 81301	NW¼ NE¼, Sec. 23	0.407	0.130	—	37±	28				
28	WILLIAM LECHNER	BOX 170, SILVERTON STAR RT. DURANGO, COLORADO 81301	SW¼ SE¼, Sec. 14	1.613 2.020	0.630 0.790 TOTAL			28				
PE-28	WILLIAM LECHNER	BOX 170, SILVERTON STAR RT. DURANGO, COLORADO 81301	SW¼ SE¼, Sec. 14	0.175	0.175			PE-28	Road approach. (permanent access)			
			Lots 1, 2 & 3									
			ASPEN WINDS NO. II SUB									
29	ASPEN WINDS II A LIMITED PARTNERSHIP	P.O. BOX 100 DURANGO, COLORADO 81301	NW¼ NE¼, Sec. 23 SW¼ SE¼ and	1.130	0.490	40±	—	29				
29	ASPEN WINDS II A LIMITED PARTNERSHIP		NW¼ SE¼, Sec. 14	3.123 4.253	2.440 2.930 TOTAL			29				
			Tract 1									
			ASPEN WINDS SUBDIVISION									
30	PETRA C. WHITE		NW¼ SE¼, Sec. 14	0.238	0.238	4.774	—	30				

[illegible]

REVISIONS

REVISIONS		



TE 8 MILORED L. COX 1/2
FRANCES C. McNAMEE 1/2
42325 U.S. HWY. 550
DURANGO, COLORADO 81301

STA. 270+01.61 BEGIN R.O.W. PROJ. FC 550-2(9) Sec. 2

SE 1/4 SE 1/4 SEC. 26

NE 1/4 SE 1/4 SEC. 26

P.O.B. PARCEL PE-7 / TIE: E/4 COR.
/ SEC. 26 BEARS N 14°55'12" E 1371.12'

SECTION 35
SECTION 36

SECTION 26
SECTION 25

NW 1/4 NW 1/4 SEC. 36

TE
5 MARION JARVIS
2535 W. 2nd. AVE.
DURANGO, COLORADO 81301

SW 1/4 SW 1/4 SEC. 25


NW 1/4 SW 1/4 SEC. 25

TE
9
MILTON F. LECHNER, Trustee
DOROTHY M. LECHNER
JOHN LECHNER
BOX 34
BLOOMFIELD, NEW MEXICO 87413

REV.
 IO RUEDI BAER
 TE 42570 U.S. HWY. 550
 JO-A DURANGO, COLORADO 81301

T. 38 N., R. 9 W., N.M.P.M.

REVISIONS	
6-7-84	Correct bearing of CL
9-11-84	Correct Par 17, 18, 19

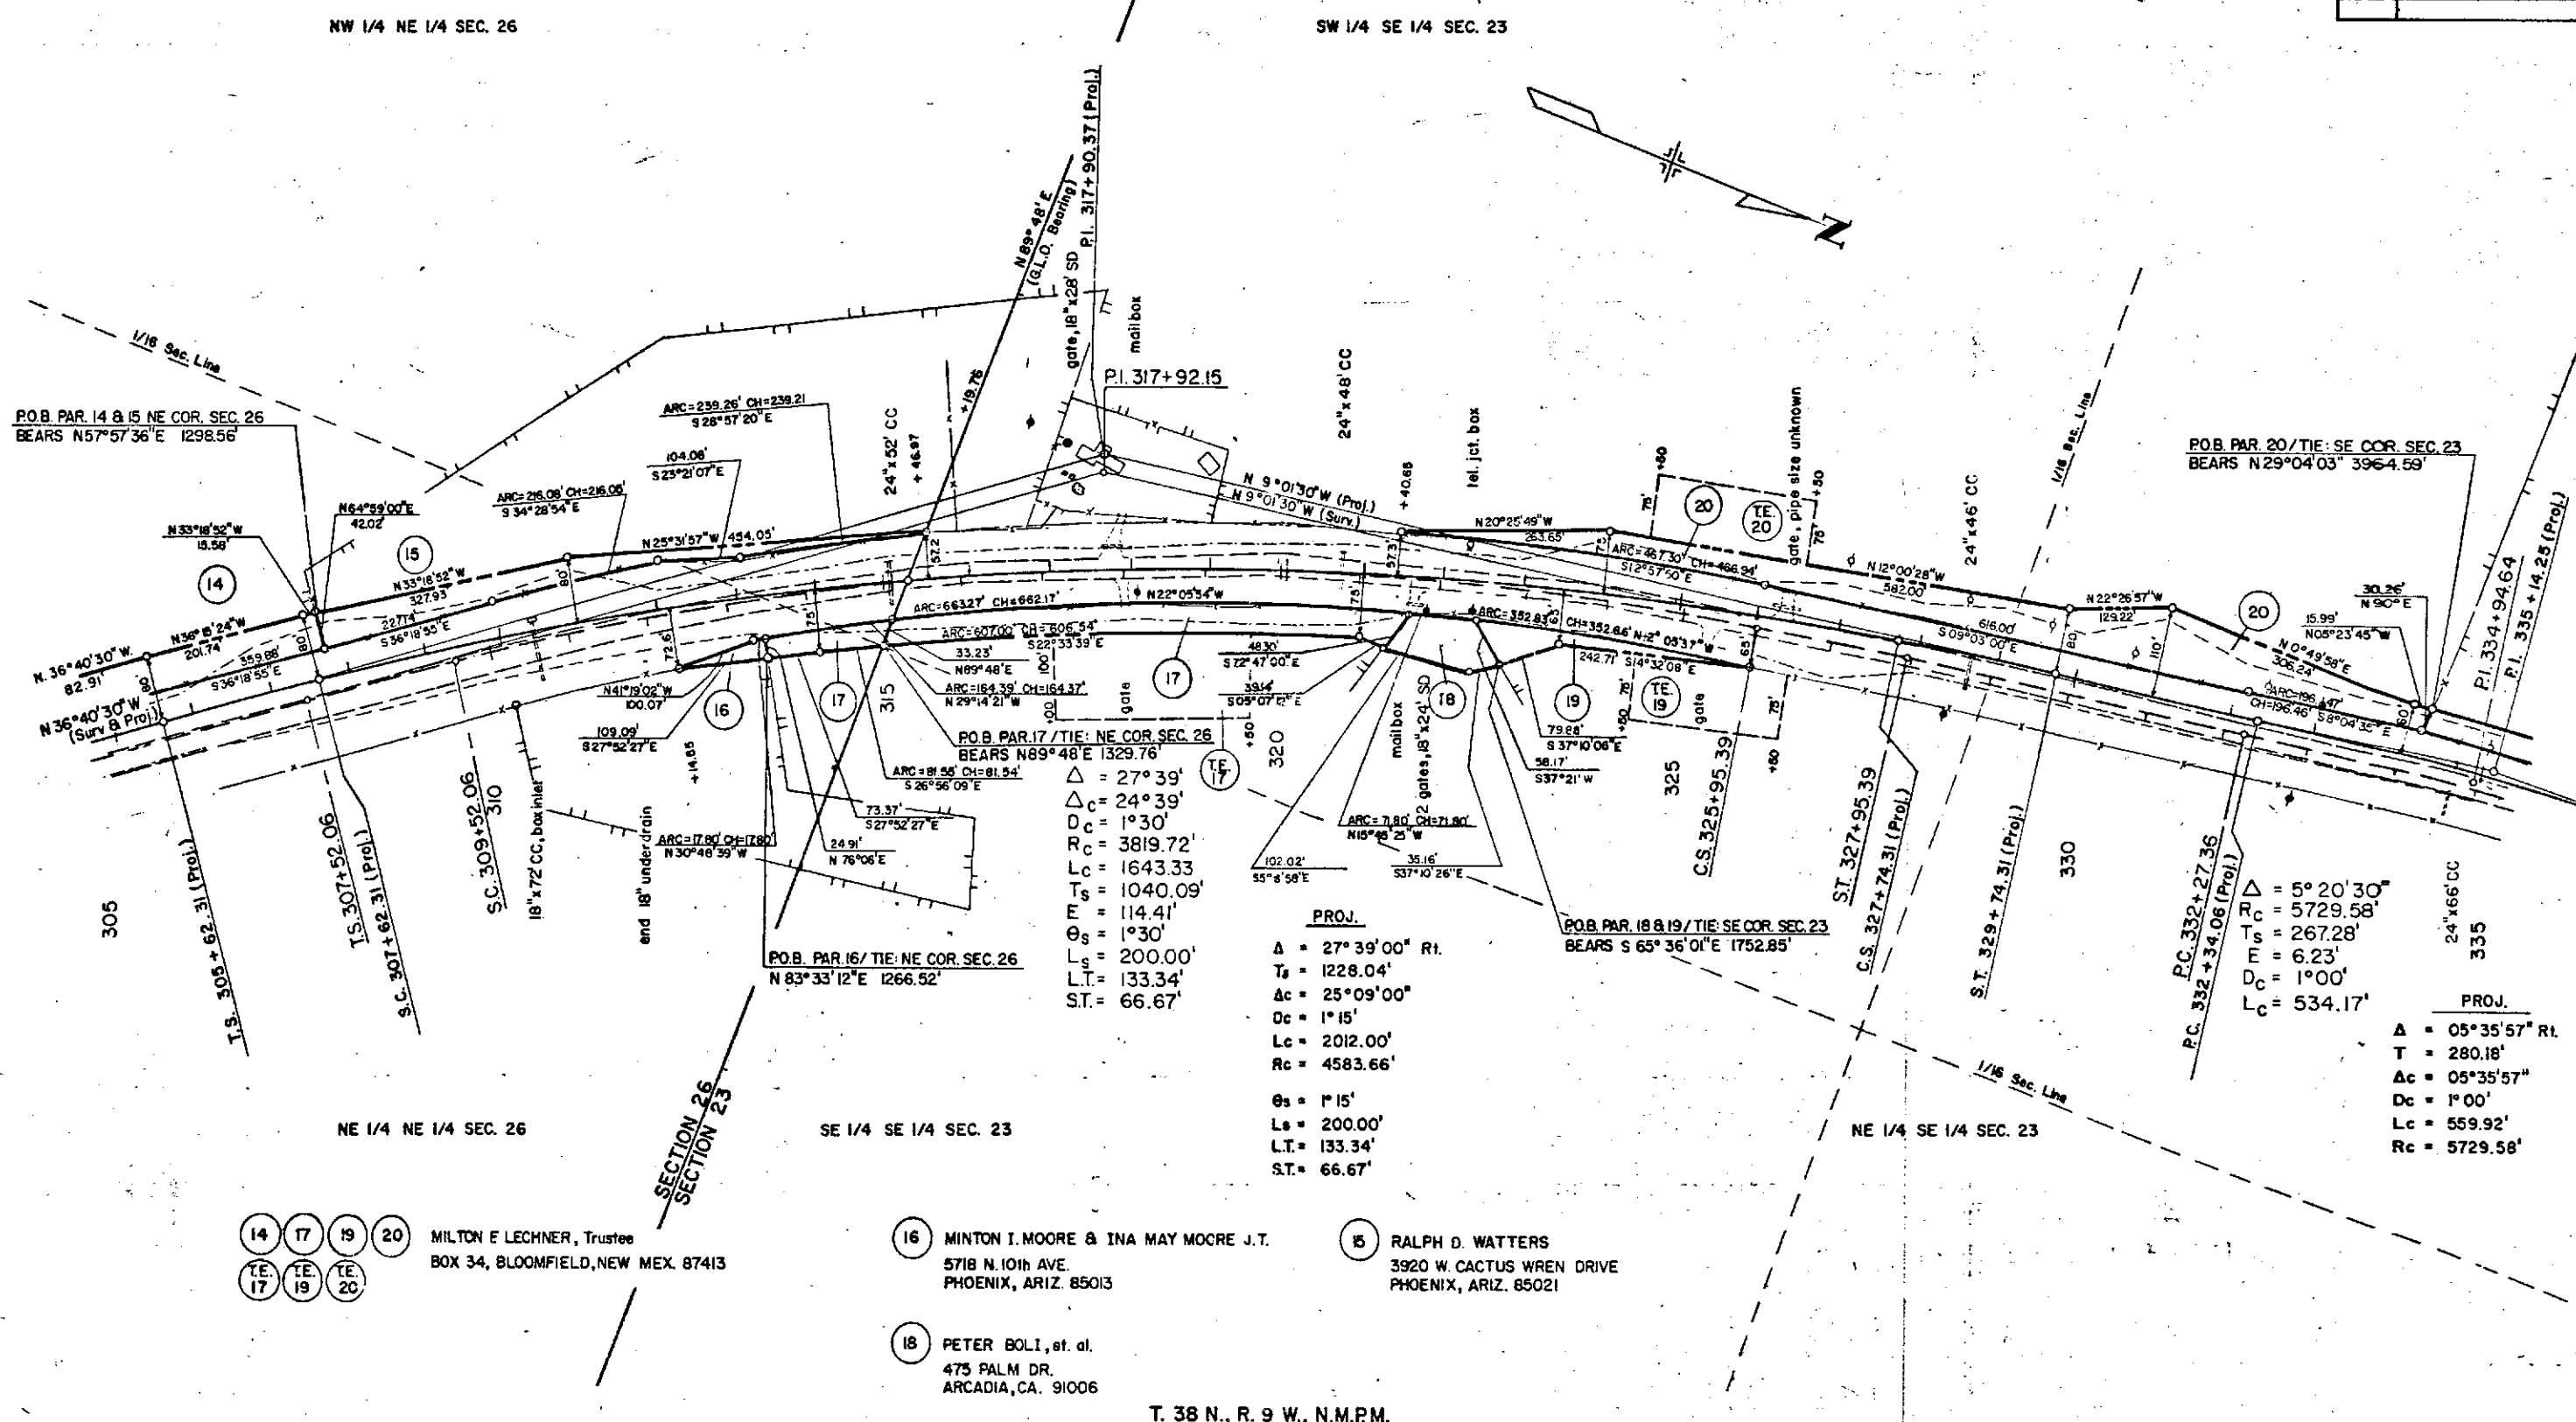

FEDERAL ROAD REGION NO.	DIVISION	PROJ. NO.	SHEET NO.	TOTAL SHEETS
XX	COLORADO	FC 550-2(9) Sec. 2	6	9

RIGHT OF WAY
ROCKWOOD TO PURGATORY

REVISIONS

NO.	DESCRIPTION

21 JAMES R. FLACK, Trustee
1030 WALNUT DRIVE
FARMINGTON, NEW MEX. 87401

22 EDITH L. REED
43705 HWY 550
DURANGO, COLO. 81301


23 ASPEN WINDS II To
ROBERT GRAHAM KESSLER
KATE STACEY KESSLER

24 JANET FARRINGTON YOUNGBERG, et. al.
705 AMHERST S.E.
ALBUQUERQUE, NEW MEX. 87108

25 FRITZ ALLEN, et. al.
P.O. BOX 780
CORRALES, NEW MEX.

26 DOUGLAS L. & LORENA J. REPAAL
5019 27th STREET
LUBBOCK, TEXAS 79407

27 LEE M. & HAZEL RATCLIFFE J.T.
724 N. CUSTER
WEATHERFORD, OKLAHOMA

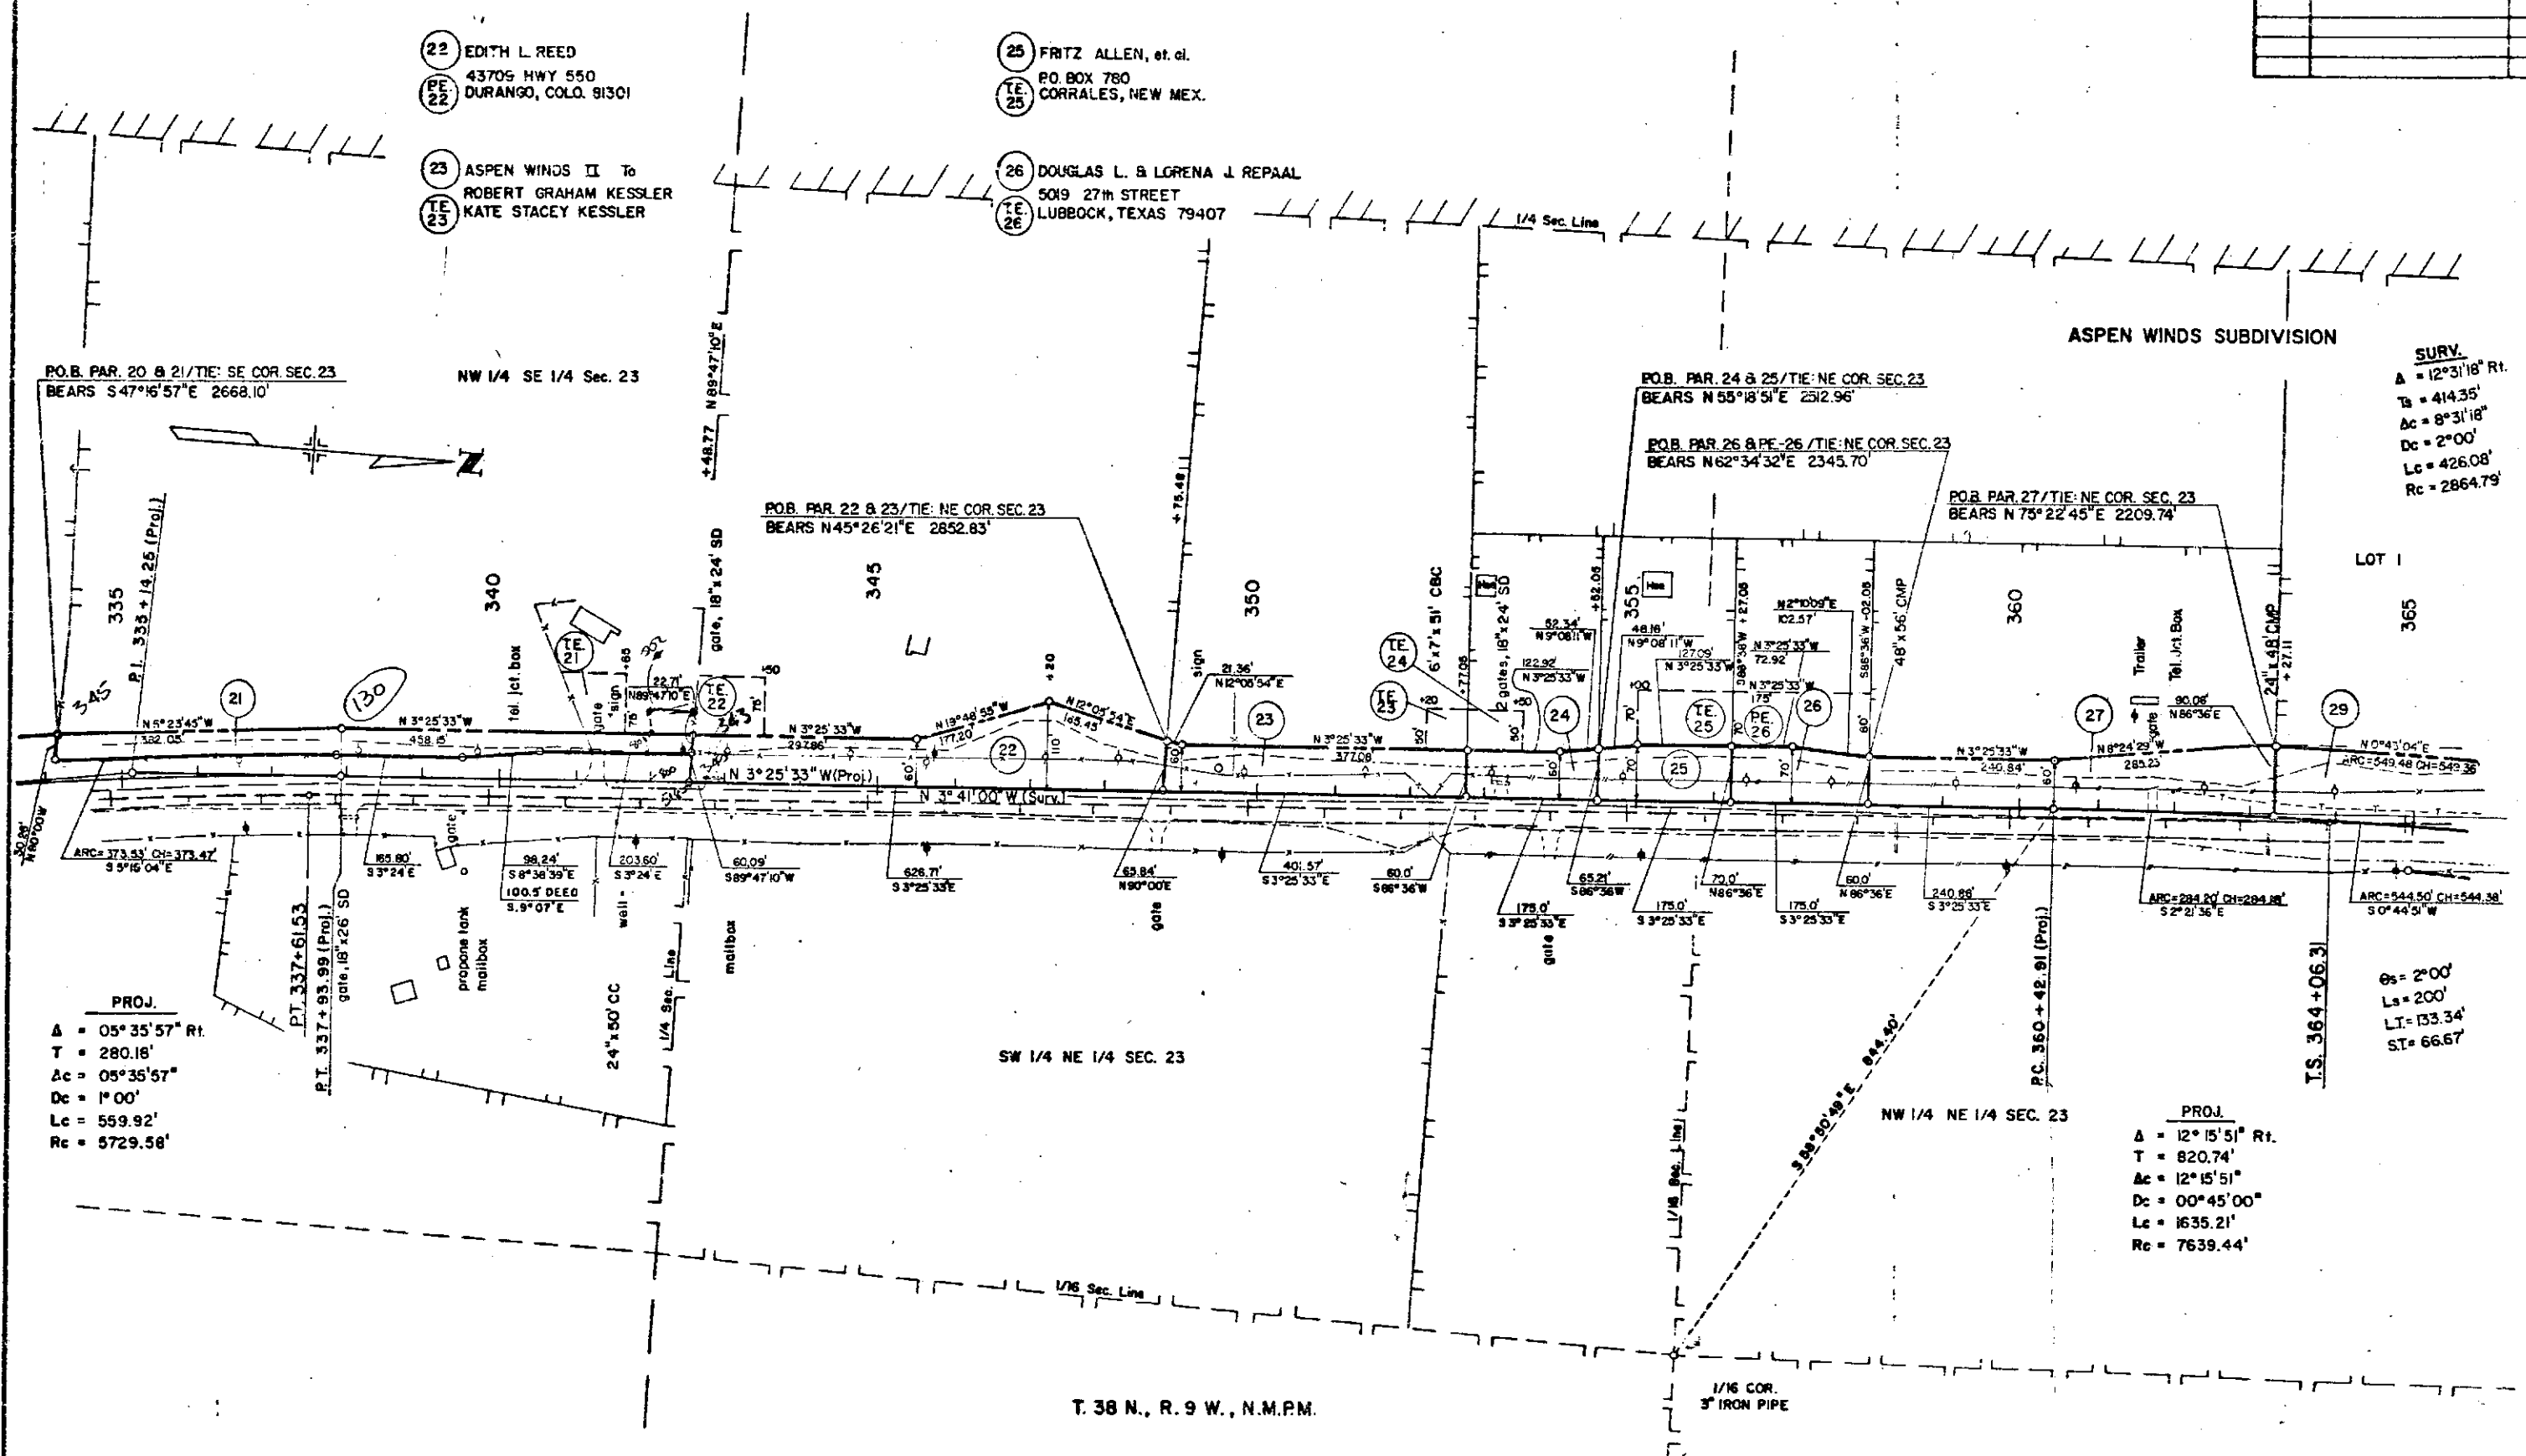

SURV.
Δ = 12°31'18" Rt.
Ts = 414.35'
Ac = 8°31'18"
Dc = 2°00'
Lc = 426.08'
Rc = 2864.79'

LOT 1
365

Os = 2°00'
Ls = 200'
LI = 133.34'
ST = 66.67'

P.O.B. PAR. 20 & 21/TIE: SE COR. SEC. 23
BEARS S 47°16'57"E 2668.10'

NW 1/4 SE 1/4 Sec. 23

P.O.B. PAR. 22 & 23/TIE: NE COR. SEC. 23
BEARS N 45°26'21"E 2852.83'

P.O.B. PAR. 24 & 25/TIE: NE COR. SEC. 23
BEARS N 55°18'51"E 2512.96'

P.O.B. PAR. 26 & 27/TIE: NE COR. SEC. 23
BEARS N 62°34'32"E 2345.70'

P.O.B. PAR. 27/TIE: NE COR. SEC. 23
BEARS N 75°22'45"E 2209.74'

SW 1/4 NE 1/4 SEC. 23

NW 1/4 NE 1/4 SEC. 23

T. 38 N., R. 9 W., N.M.P.M.

1/16 COR.
3" IRON PIPE

PROJ.
Δ = 05°35'57" Rt.
T = 280.18'
Ac = 05°35'57"
Dc = 1°00'
Lc = 559.92'
Rc = 5729.58'


PROJ.
Δ = 12°15'51" Rt.
T = 820.74'
Ac = 12°15'51"
Dc = 00°45'00"
Lc = 1635.21'
Rc = 7639.44'

FEDERAL ROAD DISTRICT NO.	DIVISION	PROJ. NO.	SHEET NO.	TOTAL SHEETS
VII	COLORADO	FC 550-2(9) Sec. 2	7	9

REVISIONS	
5-4-83	Rev. Par. 29, Added 29A
6-7-84	Par. 28, Corr. course 3

RIGHT OF WAY
ROCKWOOD TO PURGATORY

PROJ. & SURV.
Δ = 31° 39' 10" Lt.
Ts = 564.32'
Ac = 24° 39' 10"
Dc = 3° 30'
Lc = 704.37'
Rc = 1637.02'
Θs = 3° 30'
Ls = 200'
L.T. = 133.36'
S.T. = 66.69'

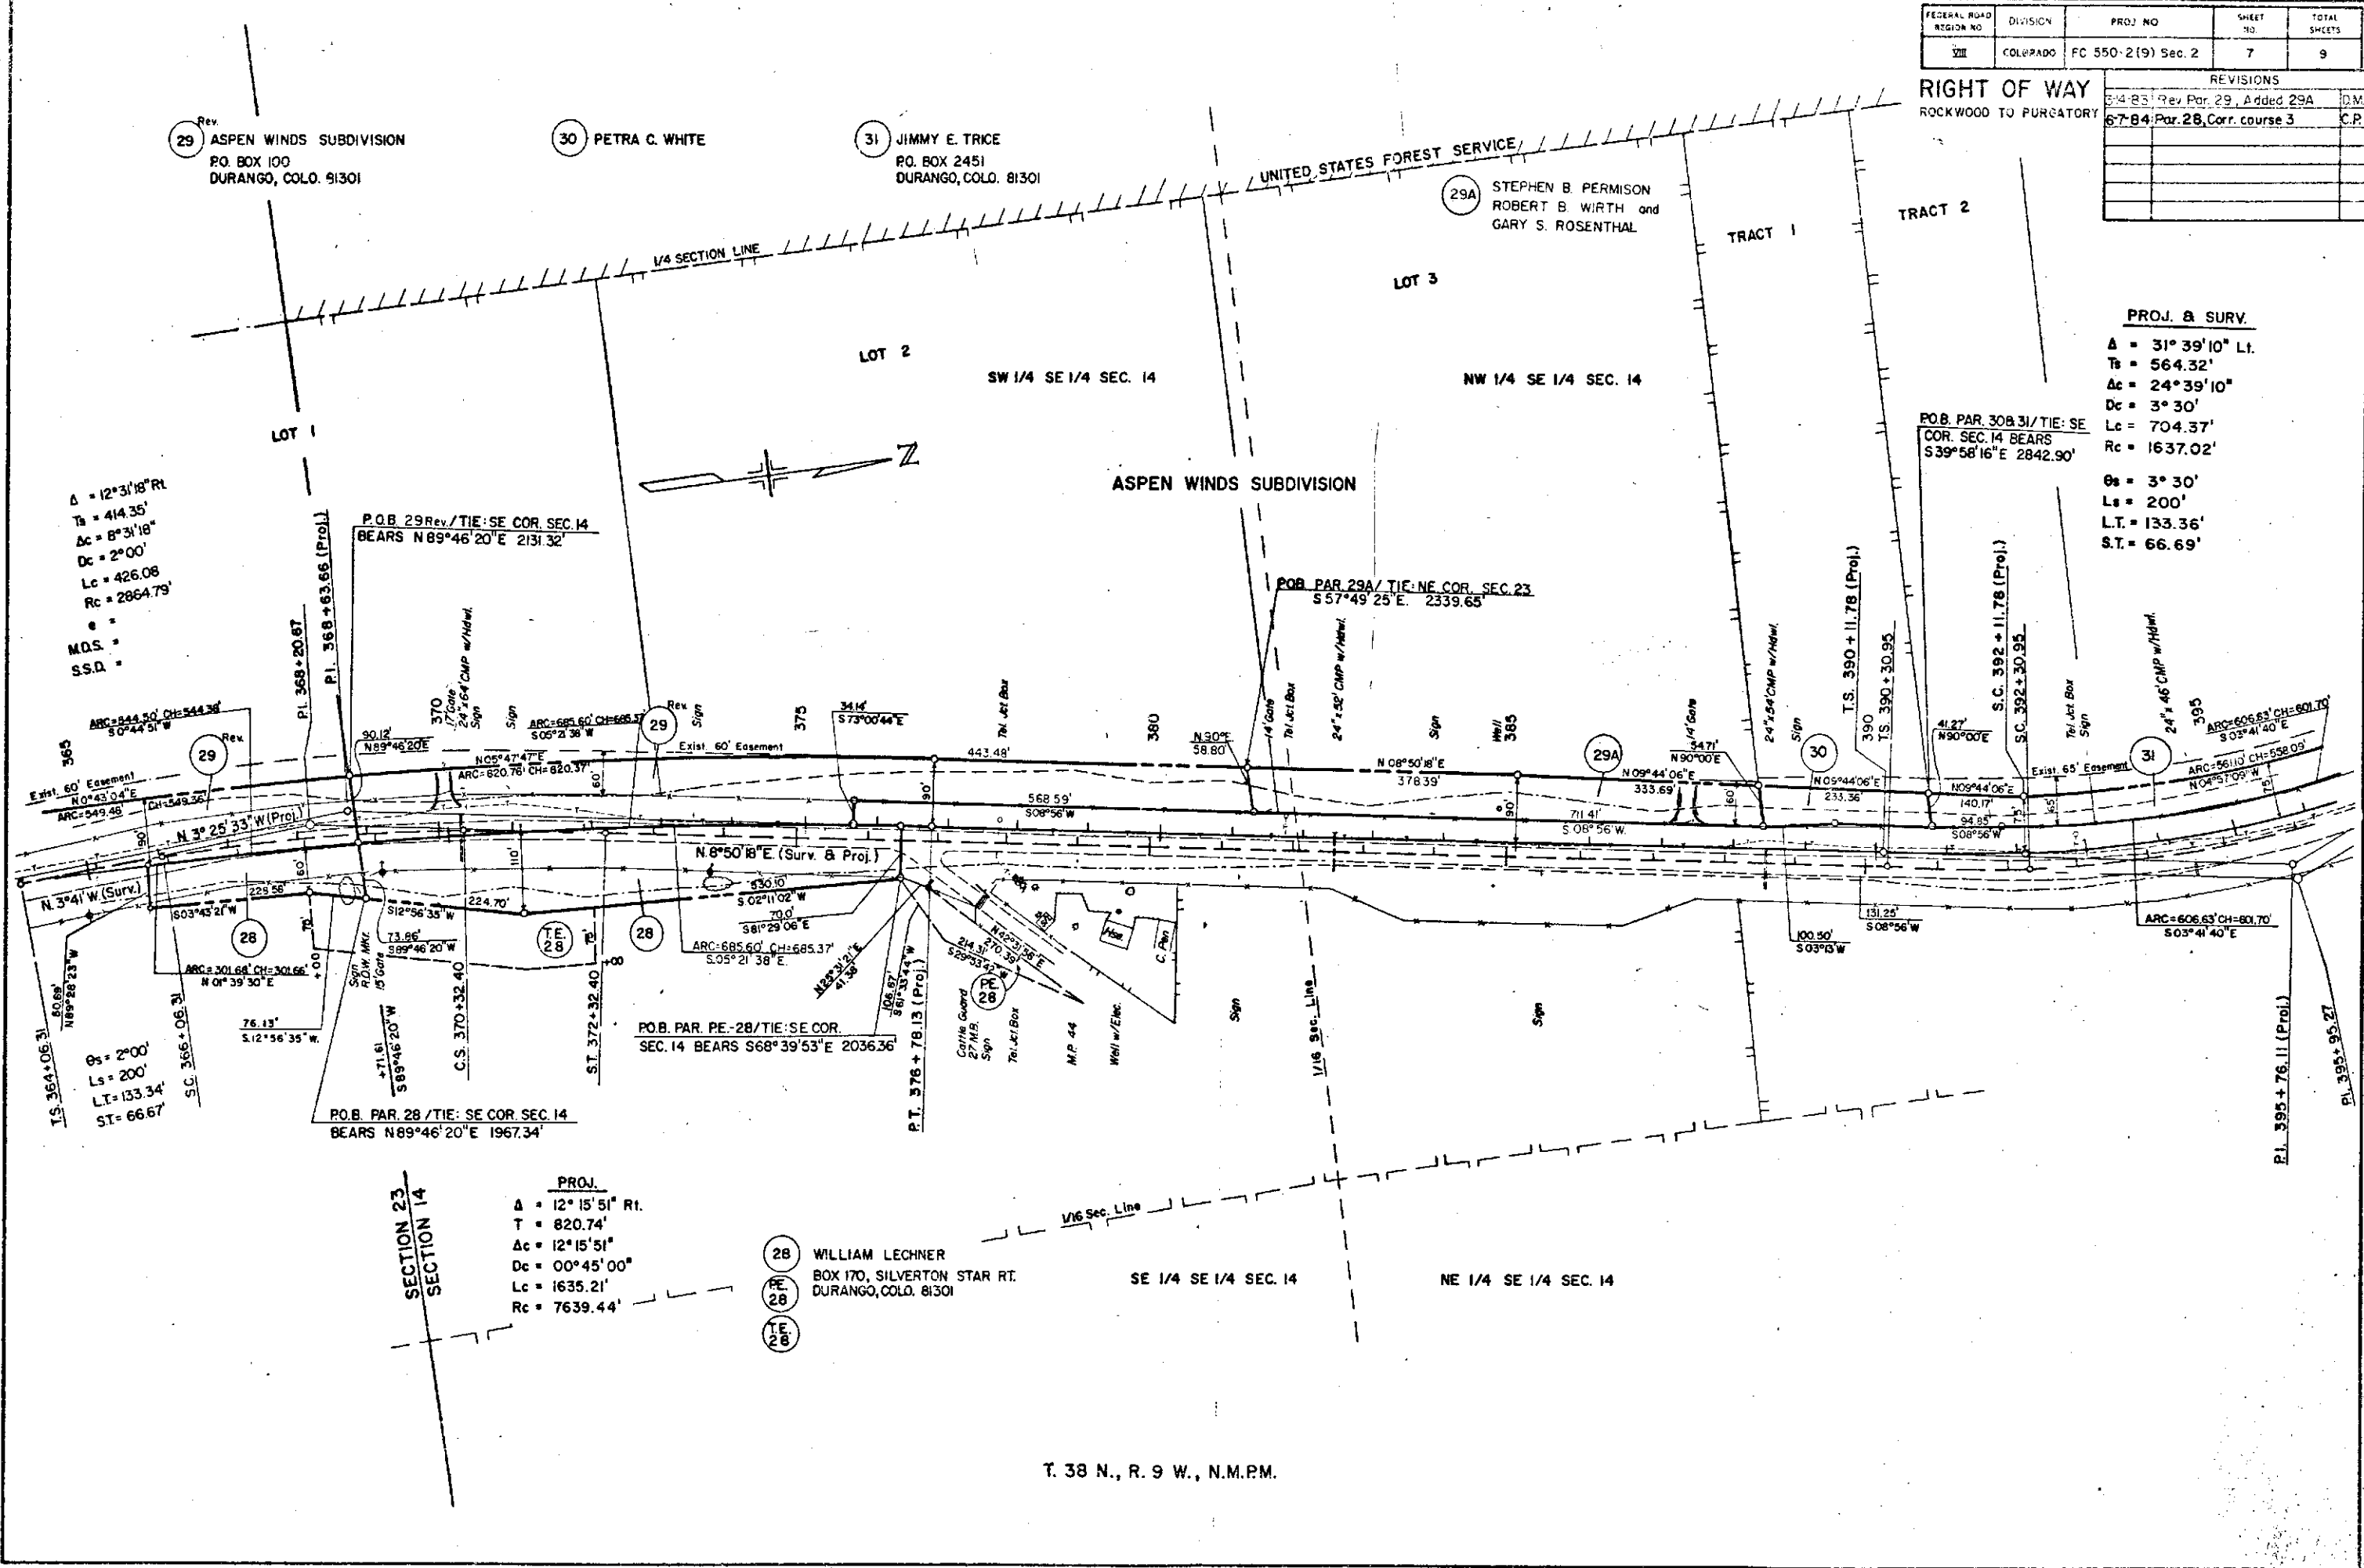


SECTION 23
SECTION 14

PROJ.
Δ = 12° 15' 51" Rt.
Ts = 820.74'
Ac = 12° 15' 51"
Dc = 00° 45' 00"
Lc = 1635.21'
Rc = 7639.44'

(28) WILLIAM LECHNER
BOX 170, SILVERTON STAR RT.
DURANGO, COLO. 81301
(PE 28)
(TE 28)

T. 38 N., R. 9 W., N.M.P.M.

REVISIONS

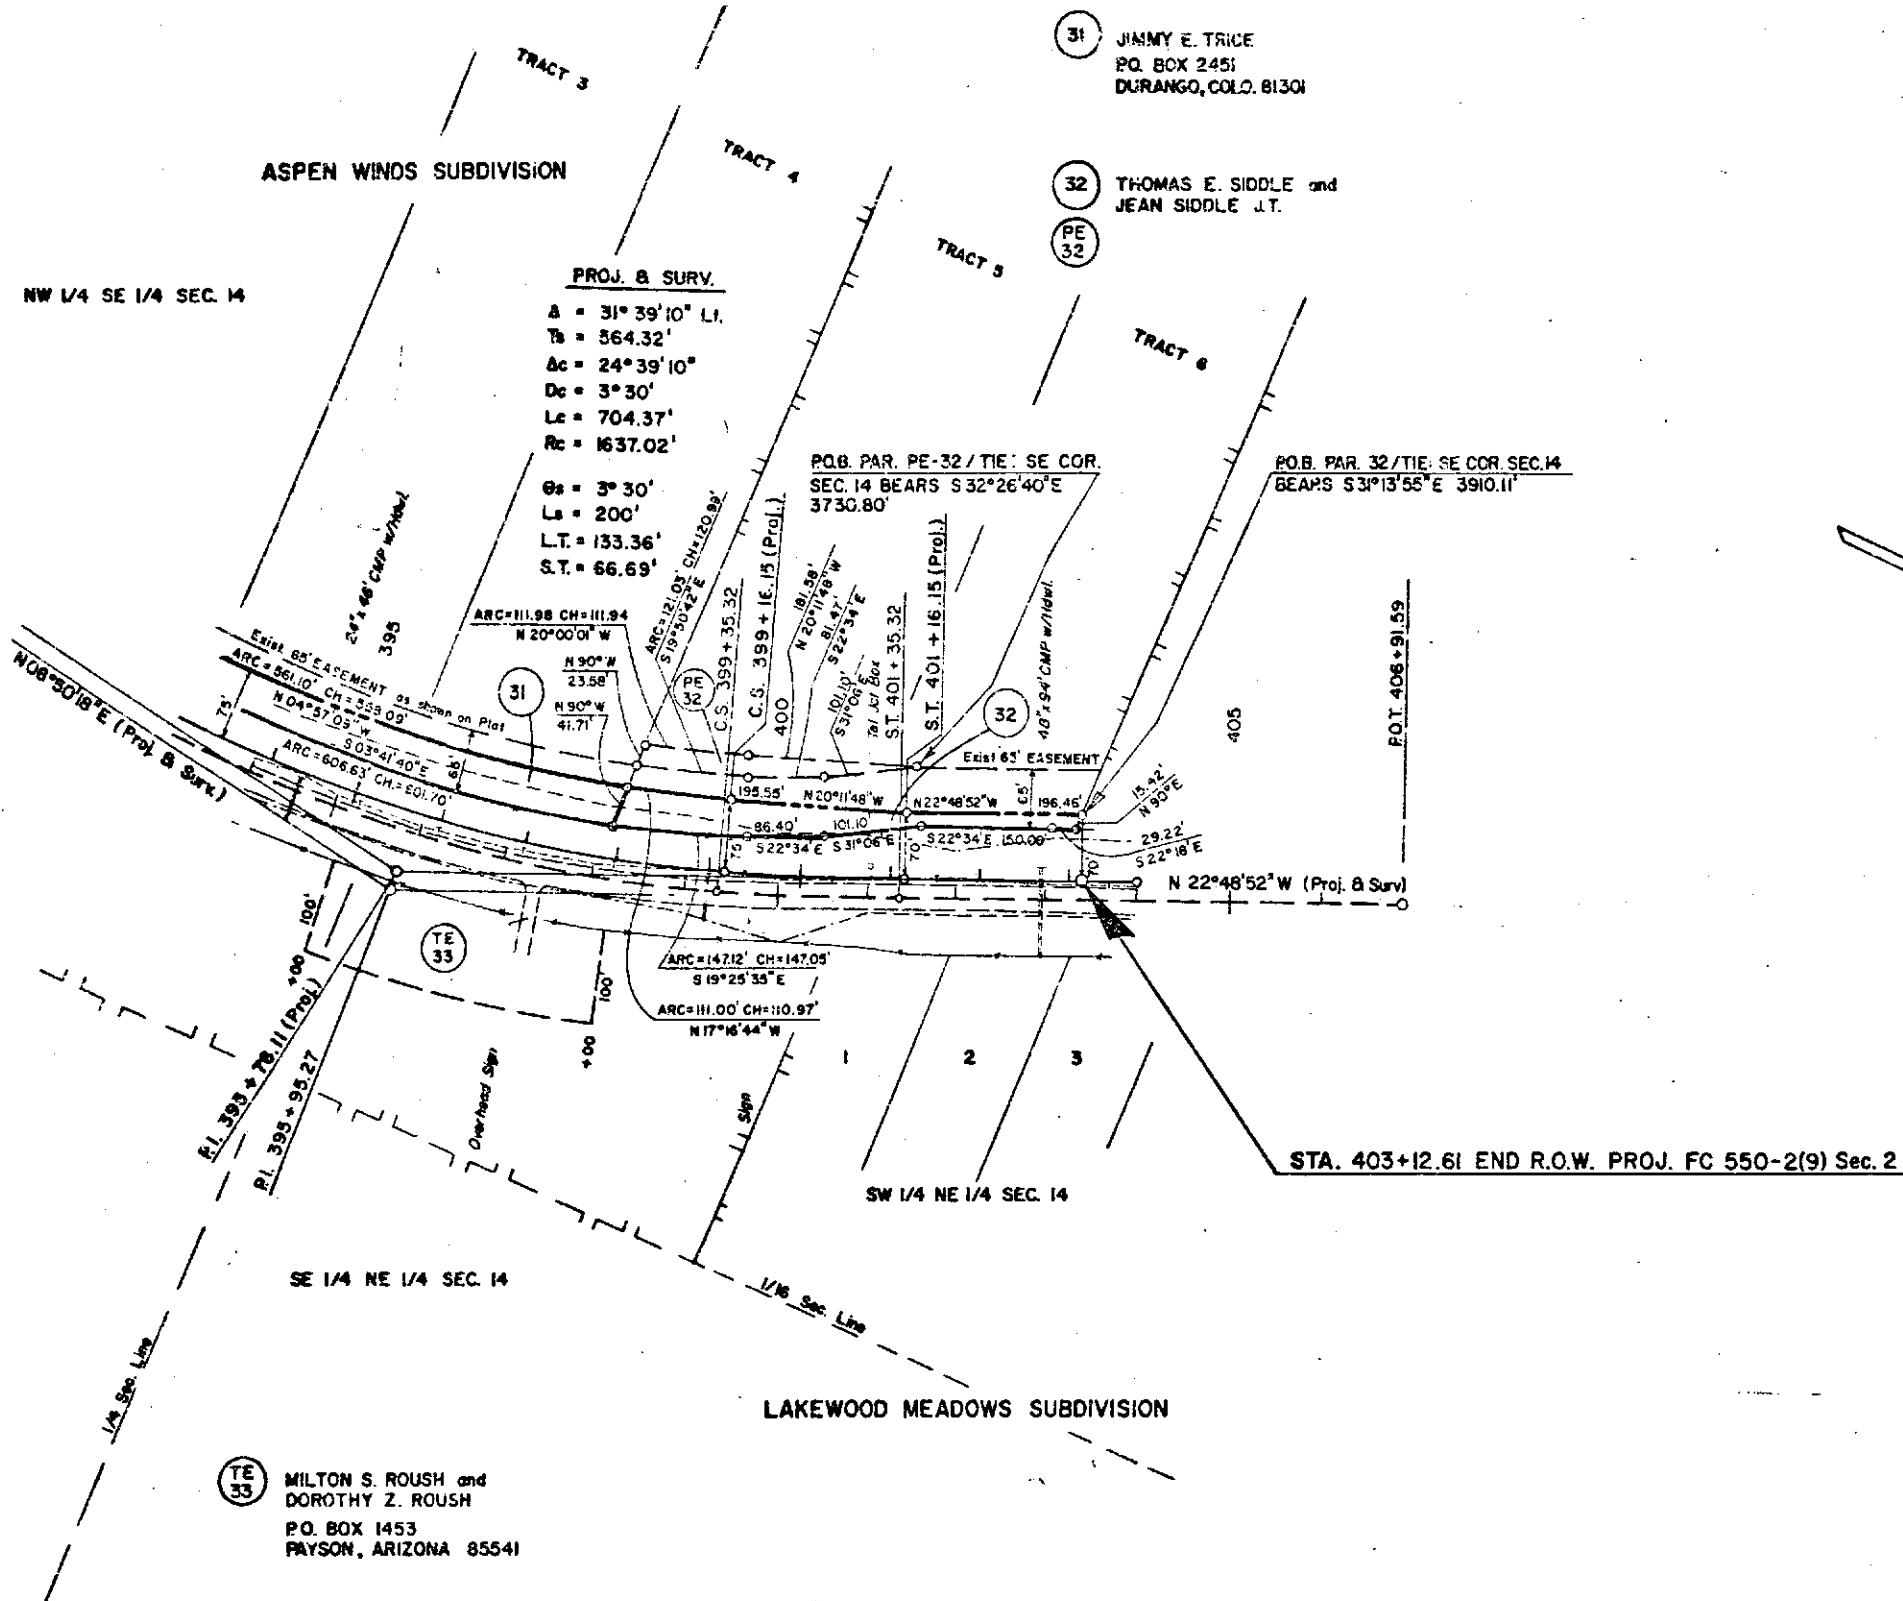[illegible]

T. 38 N., R. 9 W., N.M.P.M.


KEY TO OWNERSHIP

FEDERAL ROAD DISTRICT NO.	DIVISION	PROJ. NO.	SHEET NO.	TOTAL SHEETS
VIII	COLORADO	FC 550-2(9) Sec 2	9	9

RIGHT OF WAY
ROCKWOOD TO PURGATORY

REVISIONS		
5/17/82	Minor Change 23 A-E-23	DA 2
3/14/83	Rev. Par. 29, Added 29A	DA 1

- | | | | |
|---|--|---|--|
| MILDRED L. COX (1/2)
FRANCES C. McNAMEE (1/2) | RALPH D. WATTERS, Trustee | EDITH L. REED | JANE RAPP |
| MILDRED L. COX
GEORGE M. COX
FRANCES C. McNAMEE | MINTON I. MOORE &
INA MAY MOORE J.T. | E. HOLT WYCKOFF and
CHARLENE WYCKOFF | UTAH POWER & LIGHT COMPANY |
| MILTON F. LECHNER, DOROTHY M. LECHNER,
JOHN M. LECHNER & ROBERT E. LECHNER | JACK M. DOYLE,
ADVERTISING INCORPORATED | ASPEN WINDS II, a limited partnership | PETRA C. WHITE |
| ALBERT J. & JOSEPHINE G. LECHNER | ROBERT L. FRAZER &
DOROTHY B. FRAZER | I. J. JARVIS | LAKEWOOD MEADOWS SUBDIVISION |
| STATE OF COLORADO
(GAME & FISH) | PETER K. BOLI, W. JILL BOLI,
BRADNEY A. BOLI and TIFFANI K. BOLI J.T. | JANET FARRINGTON YOUNGBERG
NANCY FARRINGTON HIGGINS
ANTHONY S. FARRINGTON
J.C. FARRINGTON III. | MILTON S. ROUSH &
DOROTHY Z. ROUSH |
| UNITED STATES FOREST SERVICE
(FOREST SERVICE) | EARL V. MASON and KORLEEN MASON | DOUGLAS L. REPAAL and
LORENA J. REPAAL | JIMMY E. TRICE |
| RUEL BAER | PAUL E. FOLWELL
SARA C. FOLWELL | THOMAS E. SIDDLE & JEAN SIDDLE J.T. | HERSEL H. WHITE and
VIRGINIA L. WHITE |
| MILTON F. LECHNER, Trustee
DOROTHY M. LECHNER
JOHN LECHNER | JAMES R. FLACK, Trustee | WILLIAM LECHNER | DAVID G. McEWEN &
SANDRA K. McEWEN |
| | | LEE M. & HAZEL RATCLIFFE J.T. | PAUL R. CULWELL &
MARTHA N. CULWELL |
| | | | DON D. ROSELIUS and
CAMILLE Y. ROSELIUS |

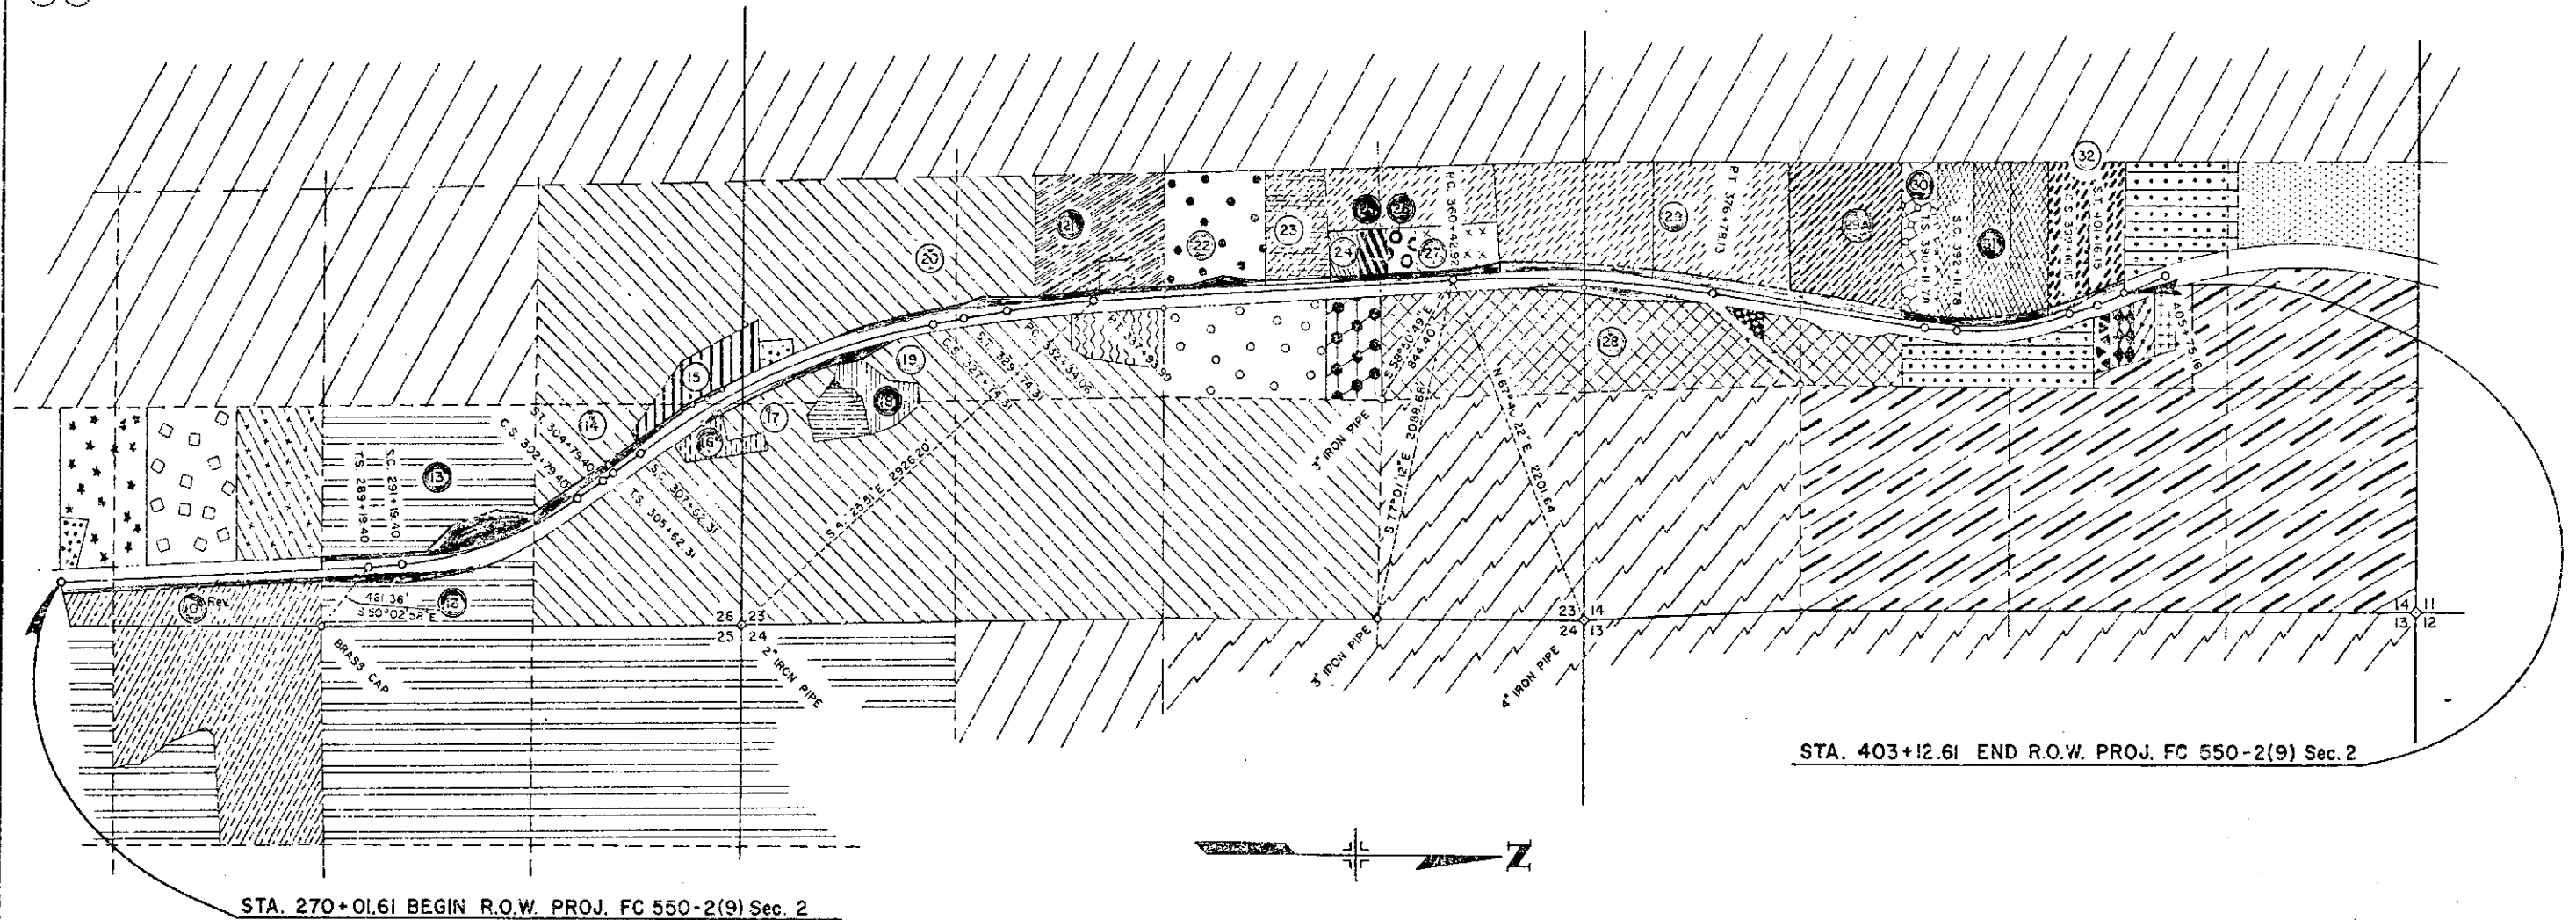

T. 38 N., R. 9 W., N.M.P.M.


KEY TO OWNERSHIP

FEDERAL ROAD DISTRICT NO.	DIVISION	PROJ. NO.	SHEET NO.	TOTAL SHEETS
VIII	COLORADO	FC 550-2(9) Sec 2	9	9

RIGHT OF WAY
ROCKWOOD TO PURGATORY

REVISIONS

- | | | | | |
|---|--|--|---|---|
| <p>1 MILDRED L. COX (1/2)
FRANCES C. McNAMEE (1/2)</p> <p>2 MILDRED L. COX
GEORGE M. COX
FRANCES C. McNAMEE</p> <p>3 MILTON F. LECHNER, DOROTHY M. LECHNER,
JOHN M. LECHNER & ROBERT E. LECHNER</p> <p>4 ALBERT J. & JOSEPHINE G. LECHNER</p> <p>5 STATE OF COLORADO
(GAME & FISH)</p> <p>6 UNITED STATES FOREST SERVICE
(FOREST SERVICE)</p> <p>7 RUEDI BAER</p> <p>8 MILTON F. LECHNER, Trustee
DOROTHY M. LECHNER
JOHN LECHNER</p> | <p>9 RALPH O. WATTERS, Trustee</p> <p>10 WINTON I. MOORE &
INA MAY MOORE J.T.</p> <p>11 JACK M. DOYLE,
ADVERTISING INCORPORATED</p> <p>12 ROBERT L. FRAZER &
DOROTHY B. FRAZER</p> <p>13 PETER K. BOLI, W. JILL BOLI,
BRADNEY A. BOLI and TIFFANI K. BOLI J.T.</p> <p>14 EARL V. MASON and KORLEEN MASON</p> <p>15 PAUL E. FOLWELL
SARA C. FOLWELL</p> <p>16 JAMES R. FLACK, Trustee</p> | <p>17 EDITH L. REED</p> <p>18 E. HOLT WYCKOFF and
CHARLENE WYCKOFF</p> <p>19 ASPEN WINDS II, a limited partnership</p> <p>20 I. J. JARVIS</p> <p>21 JANET FARRINGTON YOUNGBERG
NANCY FARRINGTON HIGGINS
ANTHONY S. FARRINGTON
J.C. FARRINGTON III</p> <p>22 DOUGLAS L. REPAAL and
LORENA J. REPAAL</p> <p>23 WILLIAM LECHNER</p> <p>24 LEE M. & HAZEL RATCLIFFE J.T.</p> | <p>25 JANE RAPP</p> <p>26 UTAH POWER & LIGHT COMPANY</p> <p>27 PETRA C. WHITE</p> <p>28 LAKEWOOD MEADOWS SUBDIVISION</p> <p>29 MILTON S. ROUSH &
DOROTHY Z. ROUSH</p> <p>30 JIMMY E. TRICE</p> <p>31 THOMAS E. SIDDLE & JEAN SIDDLE J.T.</p> <p>32 HERSHEL H. WHITE and
VIRGINIA L. WHITE</p> | <p>33 ASPEN WINDS II to
ROBERT GRAHAM KESSLER and
KATE STORY KESSLER</p> <p>34 FRITZ ALLEN, et. al.</p> <p>35 JOSEPH J. CNOVANEK &
LYDIA J. CNOVANEK</p> <p>36 DAVID G. McEWEN &
SANDRA K. McEWEN</p> <p>37 PAUL R. CULWELL &
MARTHA N. CULWELL</p> <p>38 DON D. ROSELIUS and
CAMILLE Y. ROSELIUS</p> |
|---|--|--|---|---|

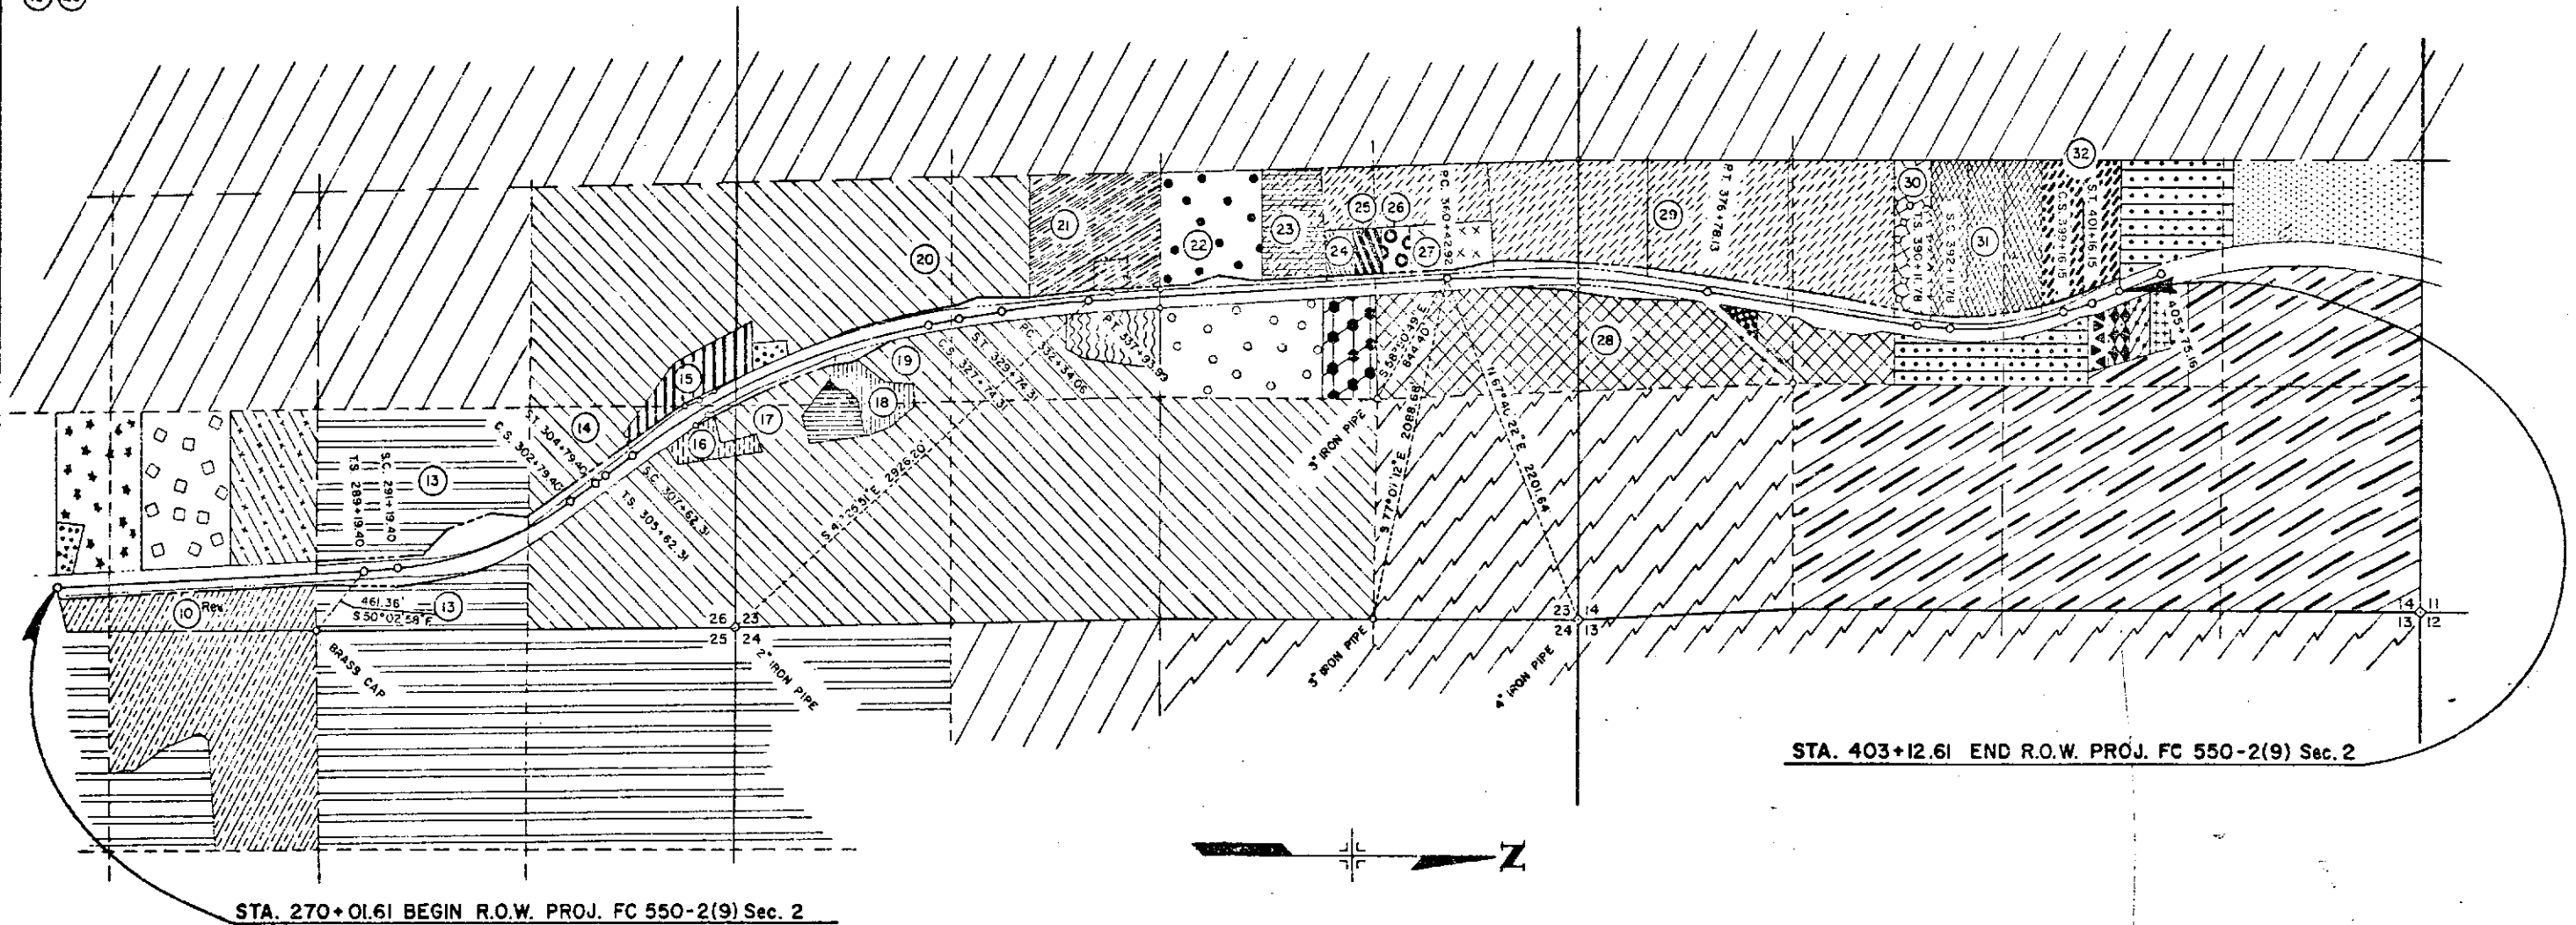

STA. 270+01.61 BEGIN R.O.W. PROJ. FC 550-2(9) Sec. 2

STA. 403+12.61 END R.O.W. PROJ. FC 550-2(9) Sec. 2

T. 38 N., R. 9 W., N.M.P.M.