

PLAN	SURVEYED	BY	DATE
NOTE BOOK	PLOTTED		
	ALIGNED CHECKED		
	ST. OF WAY CHECKED		

PROFILE	SURVEYED	BY	DATE
NOTE BOOK	PLOTTED		
	GRADES CHECKED		
	A. B. & V. NOTES		
	STRUCTURE NOTATIONS CHECKED		

(R-1) Deleted Notes, Added ROW Dimensions
and Direction Information.
9-9-76, P.D.L.

141+00 to 141+90 ~
8" x 20' PCSP UNDERDRAIN Rt.

142+00 to 144+30 ~
8" x 230' PCSP UNDERDRAIN, Rt.


144+50 ~ 24" x 82' CROSS CULVERT w/
INTERCEPTING HEADWALL & INLET BASIN Rt.
RIPRAP AT OUTLET.

Sta. 140+94.0 A/R Begin FHP 022-1(2) =
Sta. 141+03.76 Bk. End FHP 022-1(1)

133+30 to 136+70 ~
8" x 340' PCSP
UNDERDRAIN Rt.


142+00 ~ 24" x 88'
CROSS CULVERT, INTERCEPTING
HEADWALL & INLET BASIN Rt.
RIPRAP AT OUTLET

Note: Soil Survey was
accomplished by Federal
Highway Administration
March 29, 1972.

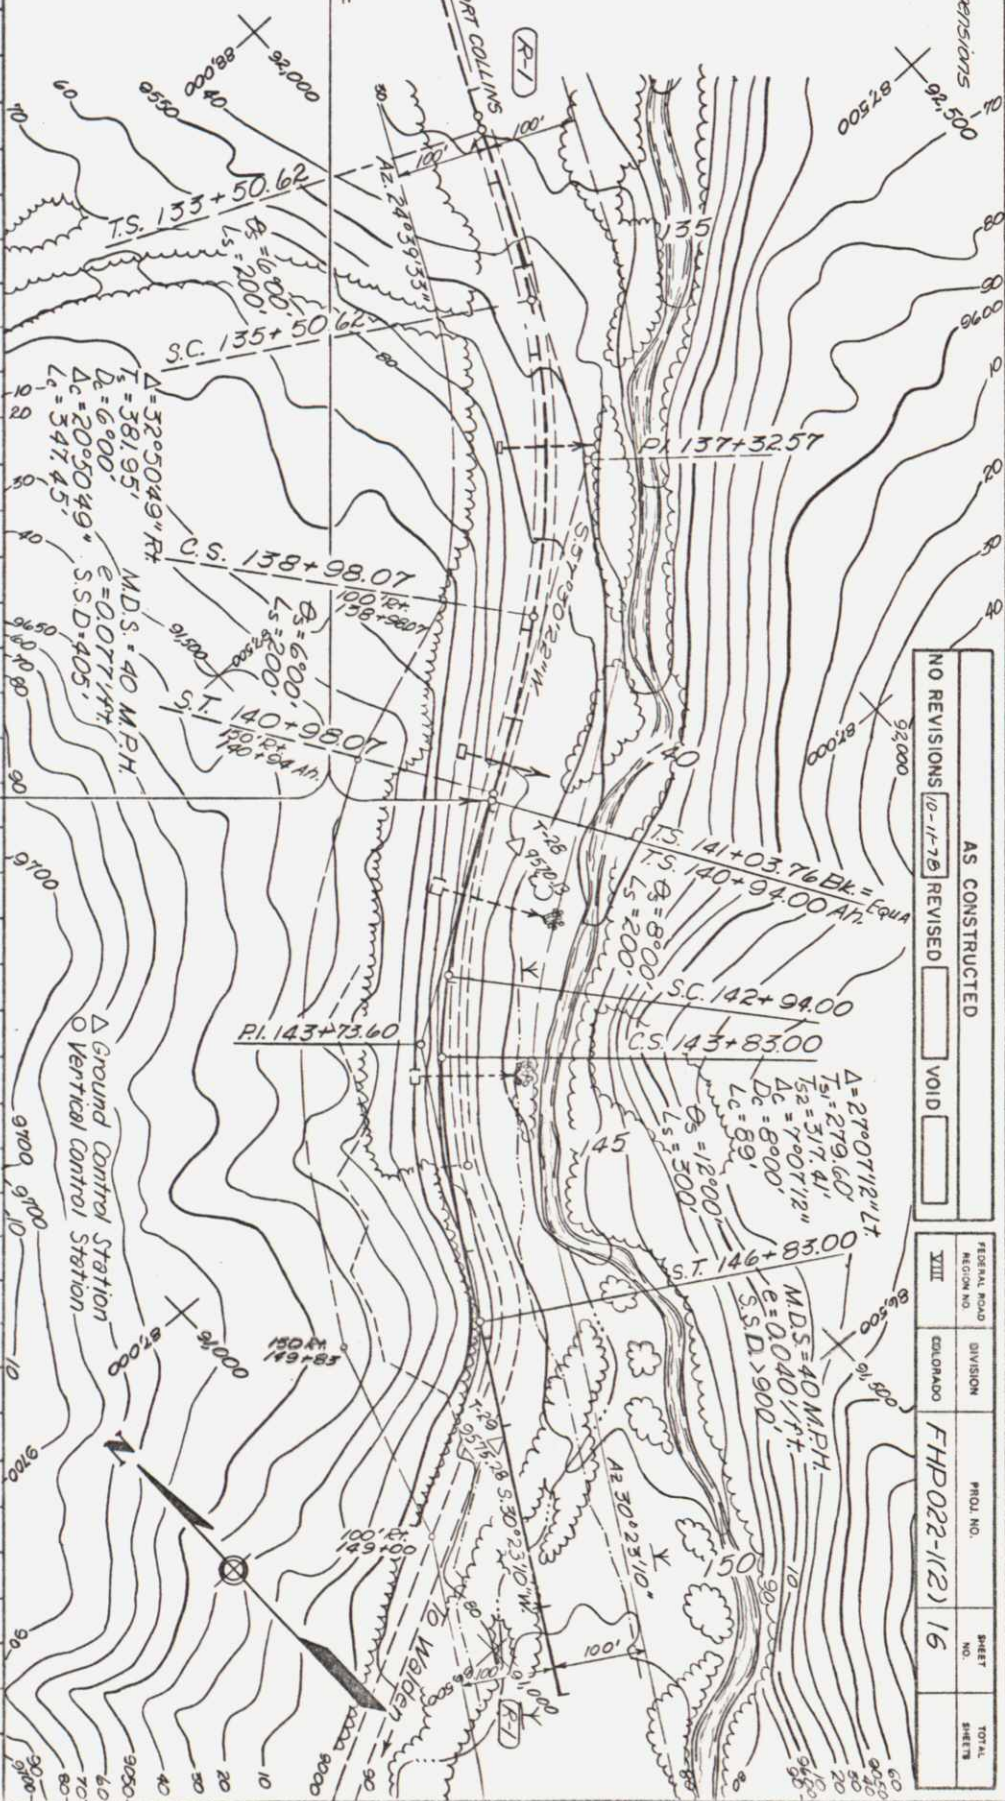


AS CONSTRUCTED
NO REVISIONS (0-1-72) REVISED ☐ VOID ☐

FEDERAL ROAD DISTRICT NO.	DIVISION	PROJECT NO.	SHEET NO.	TOTAL SHEETS
XIII	COLORADO	FHP 022-1(2)	16	

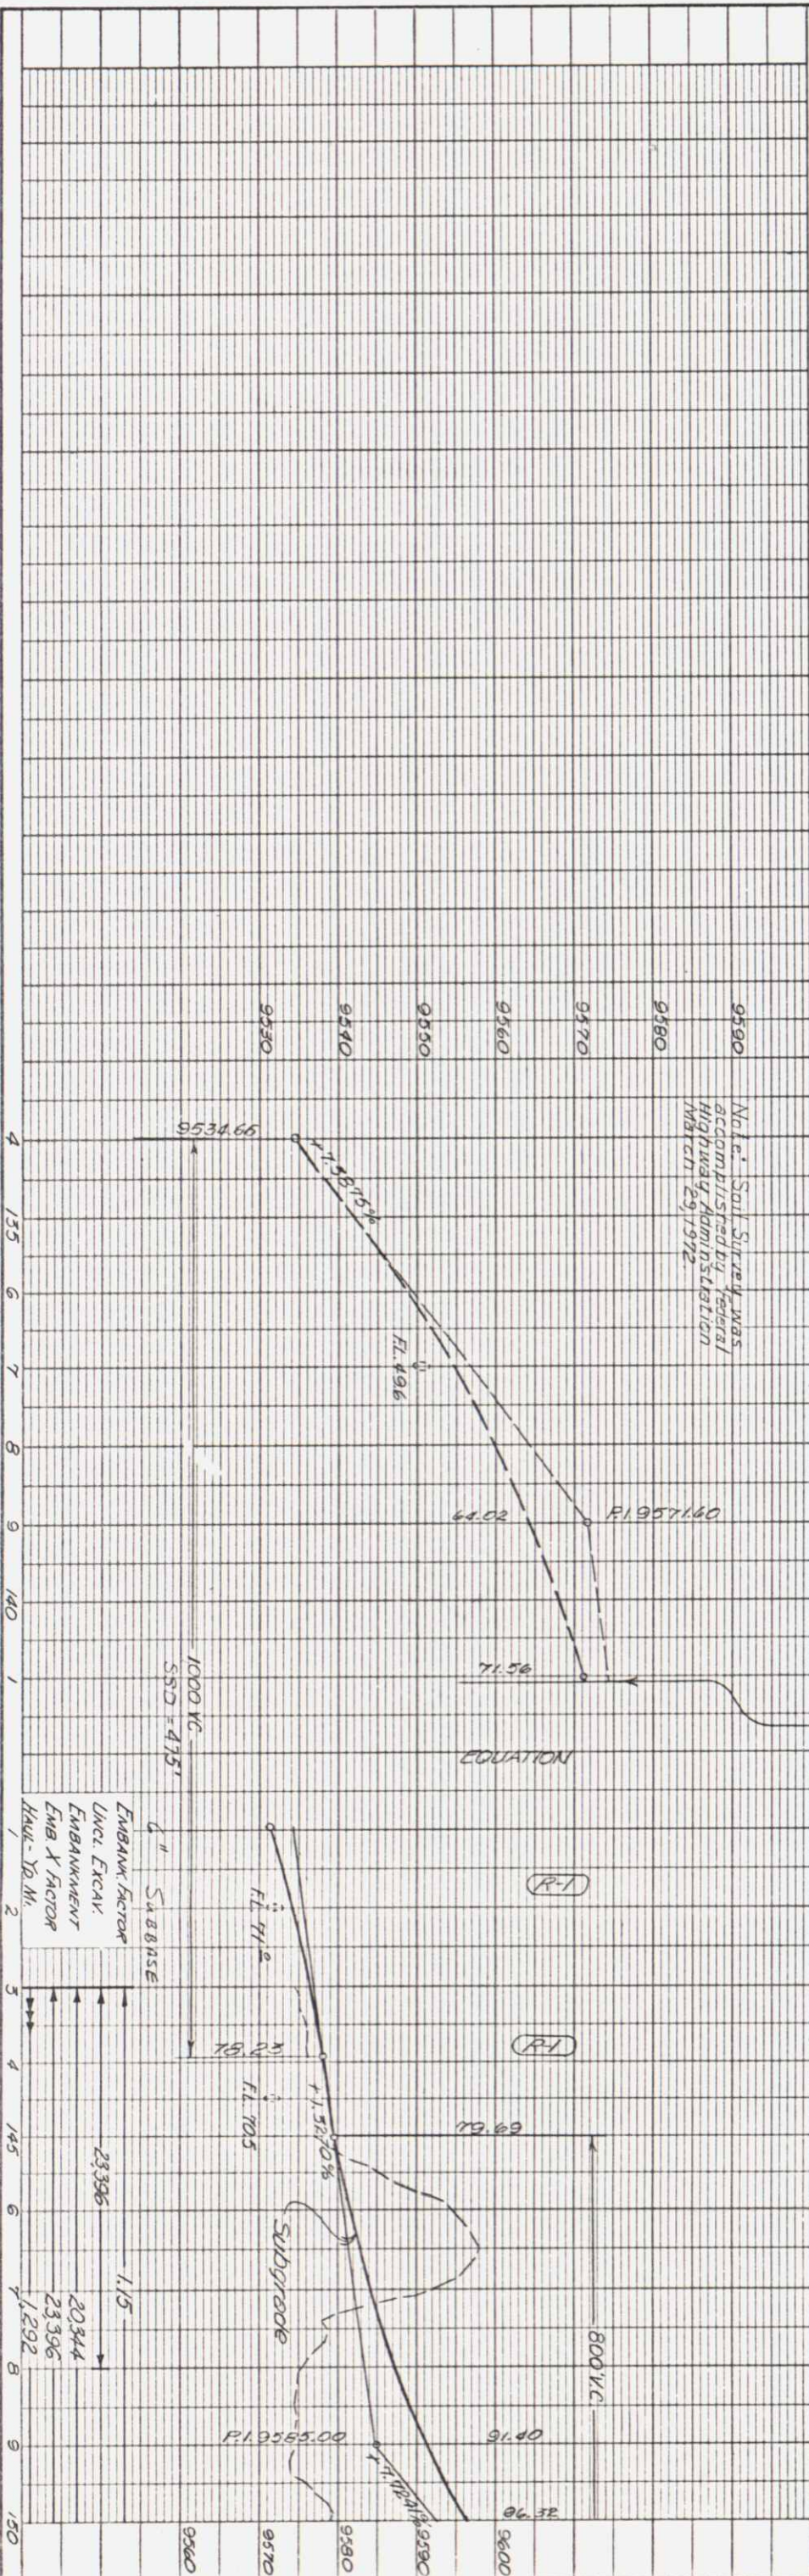

PROFILE		BY		DATE	
NOTE BOOK					
NO.					
SURVEYED		PLOTTED		GRADES CHECKED	
B. M. NOTED		STRUCTURE NOTATIONS CHECKED			


PLAN		BY		DATE	
NOTE BOOK					
NO.					
SURVEYED		PLOTTED		ALIGNMENT CHECKED	
RT. OF WAY CHECKED					

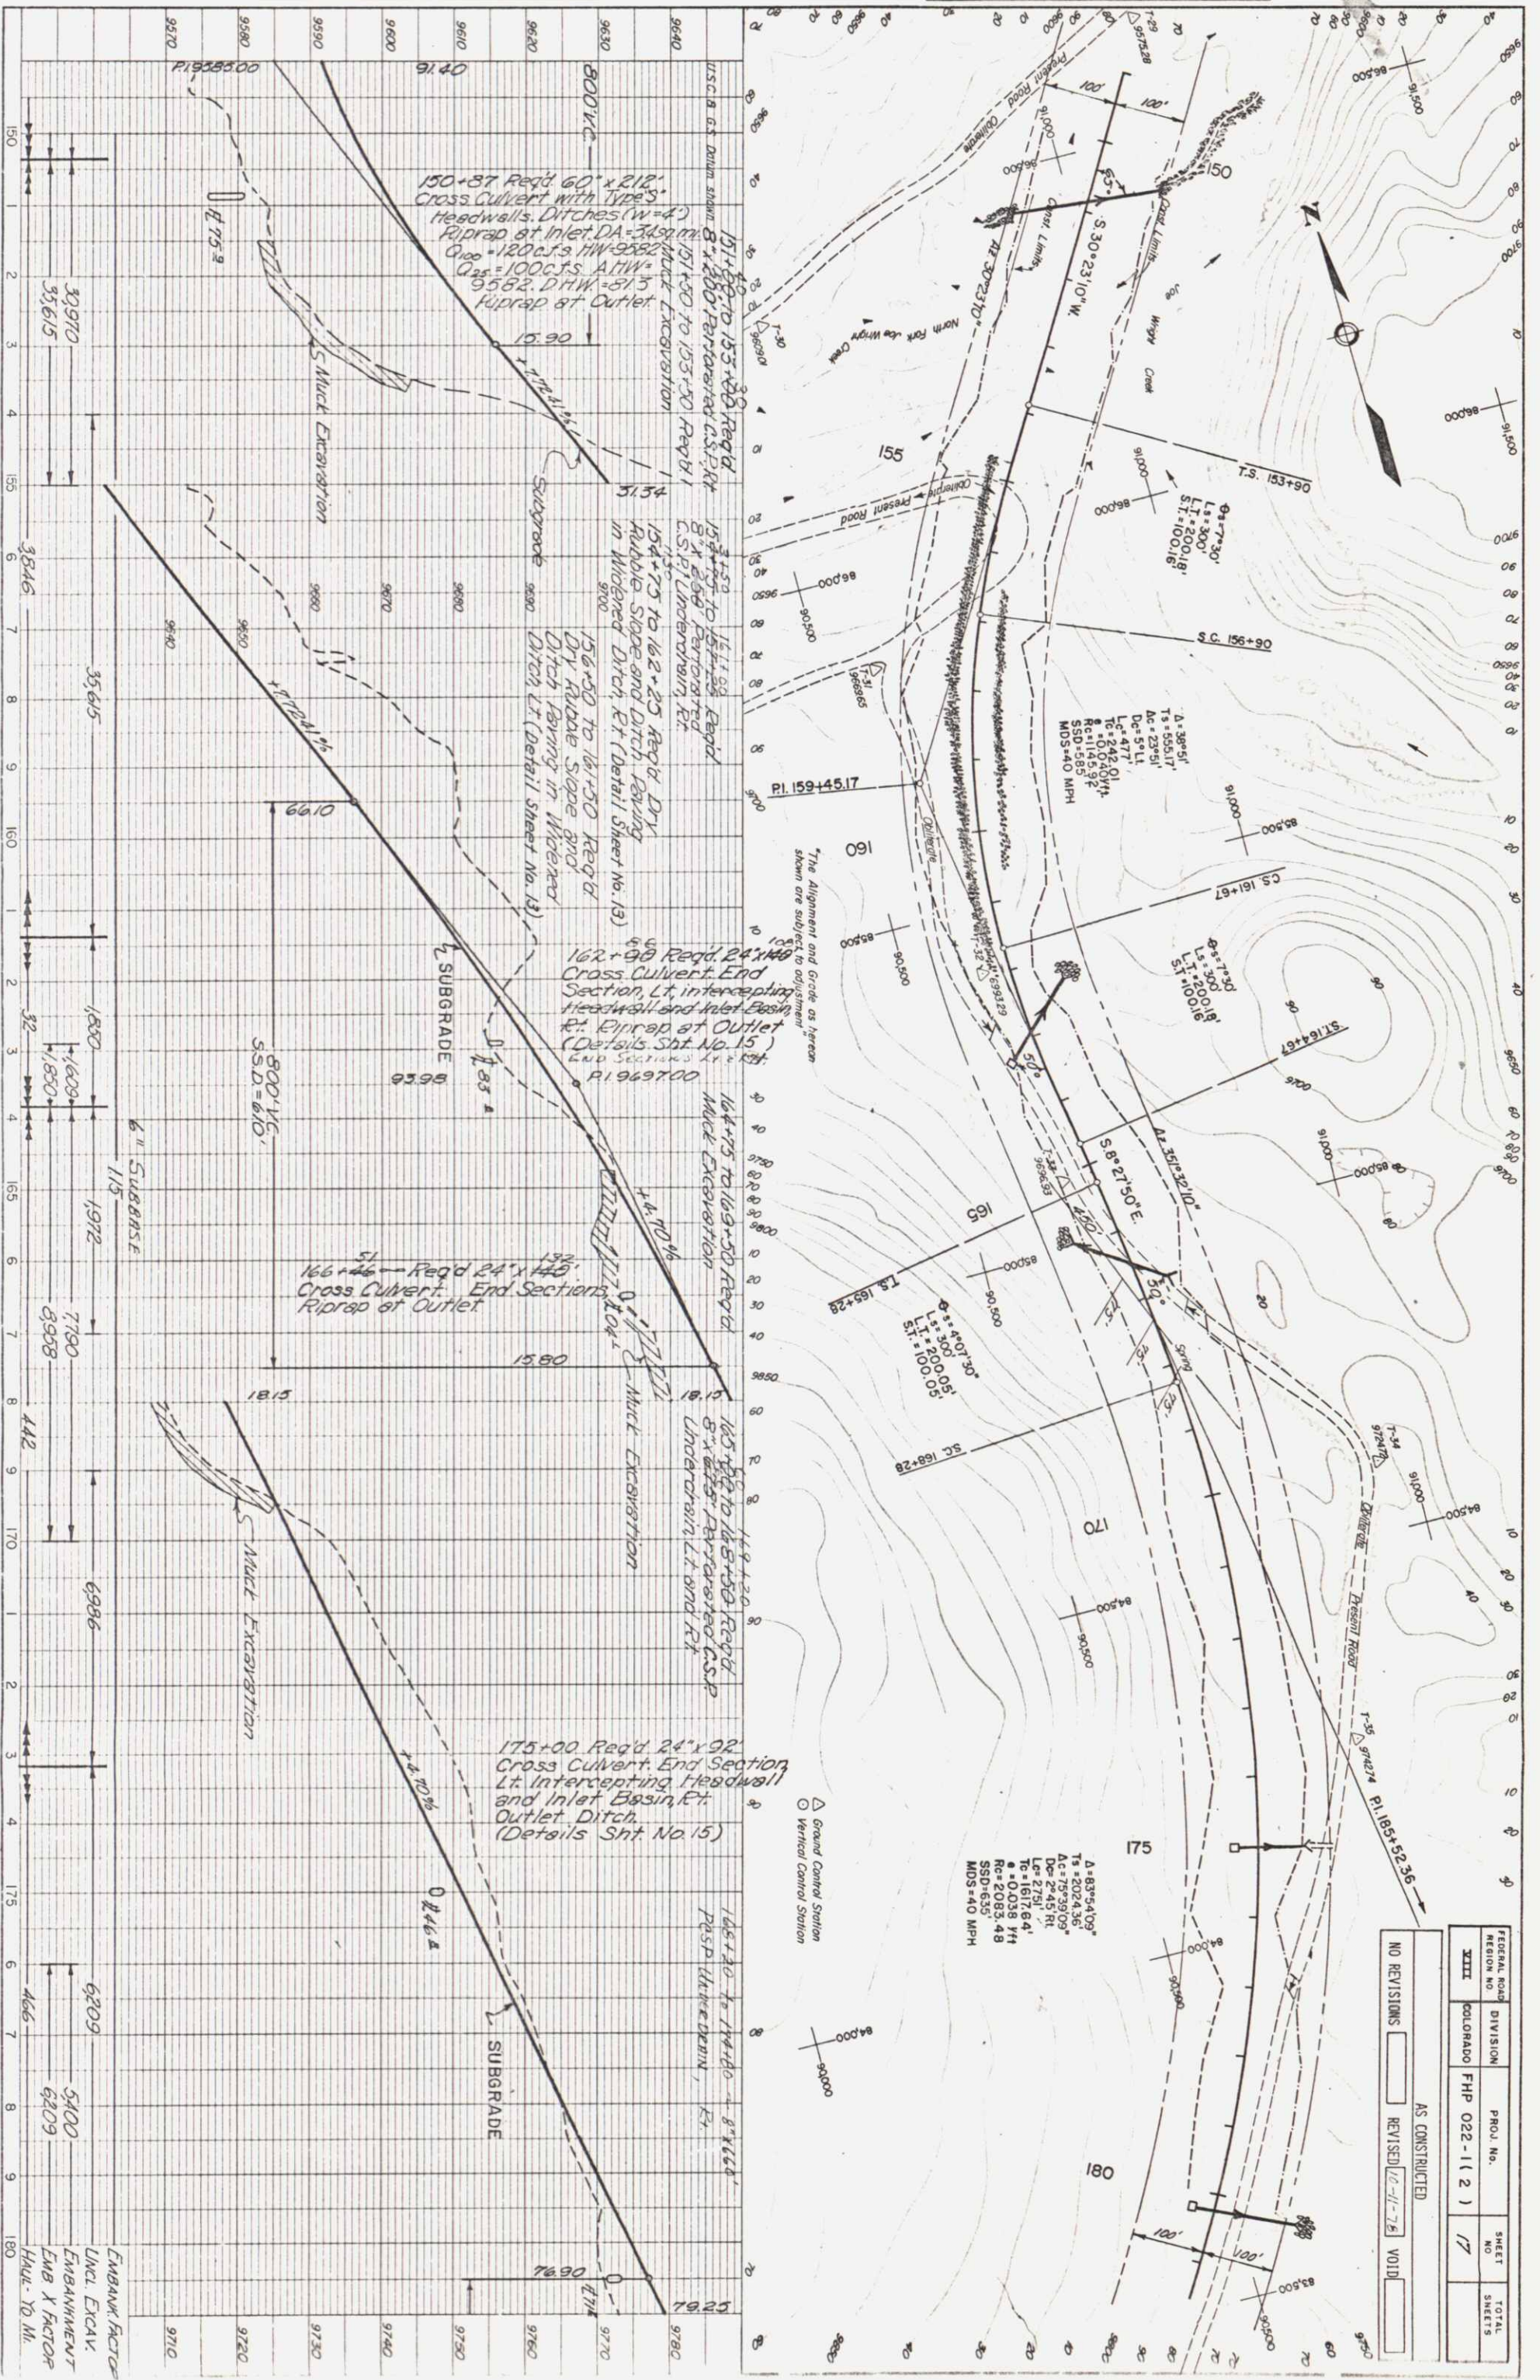

FEDERAL ROAD	DIVISION	PROJ. NO.	SHEET NO.	TOTAL SHEETS
III	COLORADO	FHP 022-1(2)	17	
NO REVISIONS				
AS CONSTRUCTED				
REVISED 12-11-76 VOID				

PROFILE
SURVEYED
NOTE BOOK
NO.

PLAN
SURVEYED
NOTE BOOK
NO.

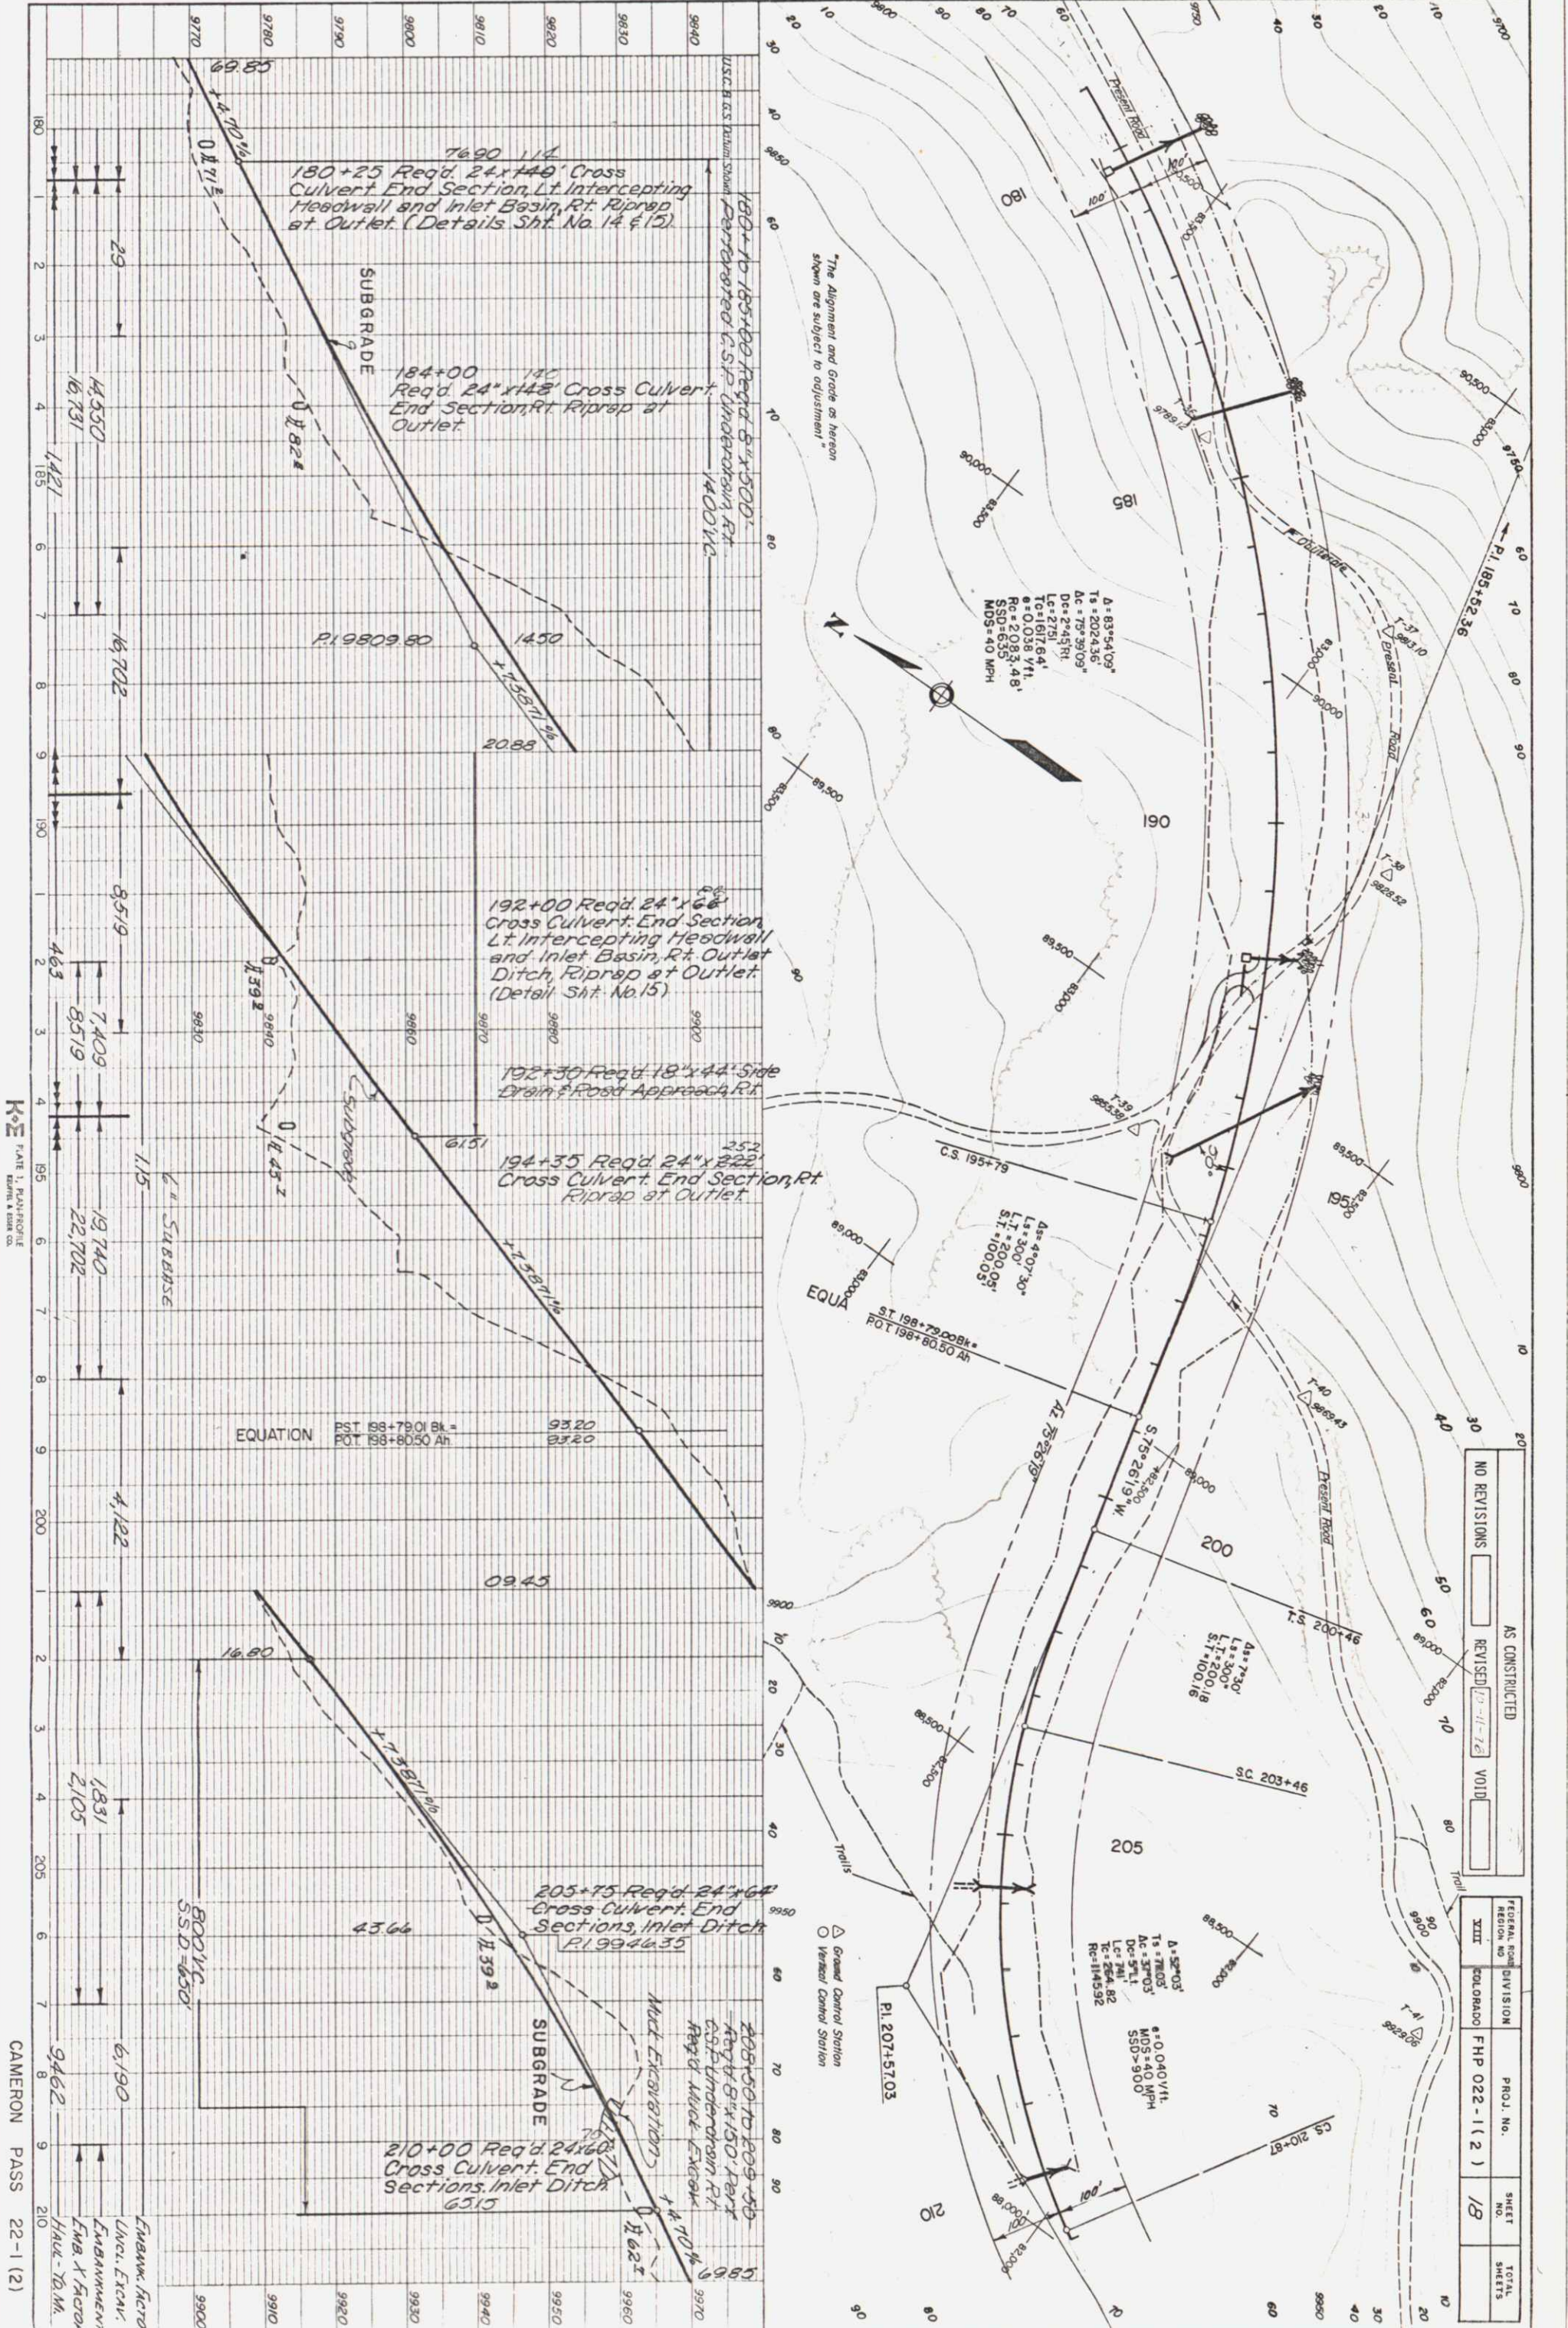


K&E
PLATE 1, PLAN/PROFILE
REPAIRS & IMPROVEMENTS

CAMERON PASS
22-1 (2)

NO REVISIONS		AS CONSTRUCTED	
REVISED		VOID	
FEDERAL ROAD DIVISION		PROJ. NO.	
COLORADO		FHP 022-1(2)	
SHEET NO.		18	
TOTAL SHEETS			

PROFILE
SURVEYED
PLOTTED
GRADES CHECKED
BY
DATE

PLAN
SURVEYED
PLOTTED
ALIGNMENT CHECKED
BY
DATE

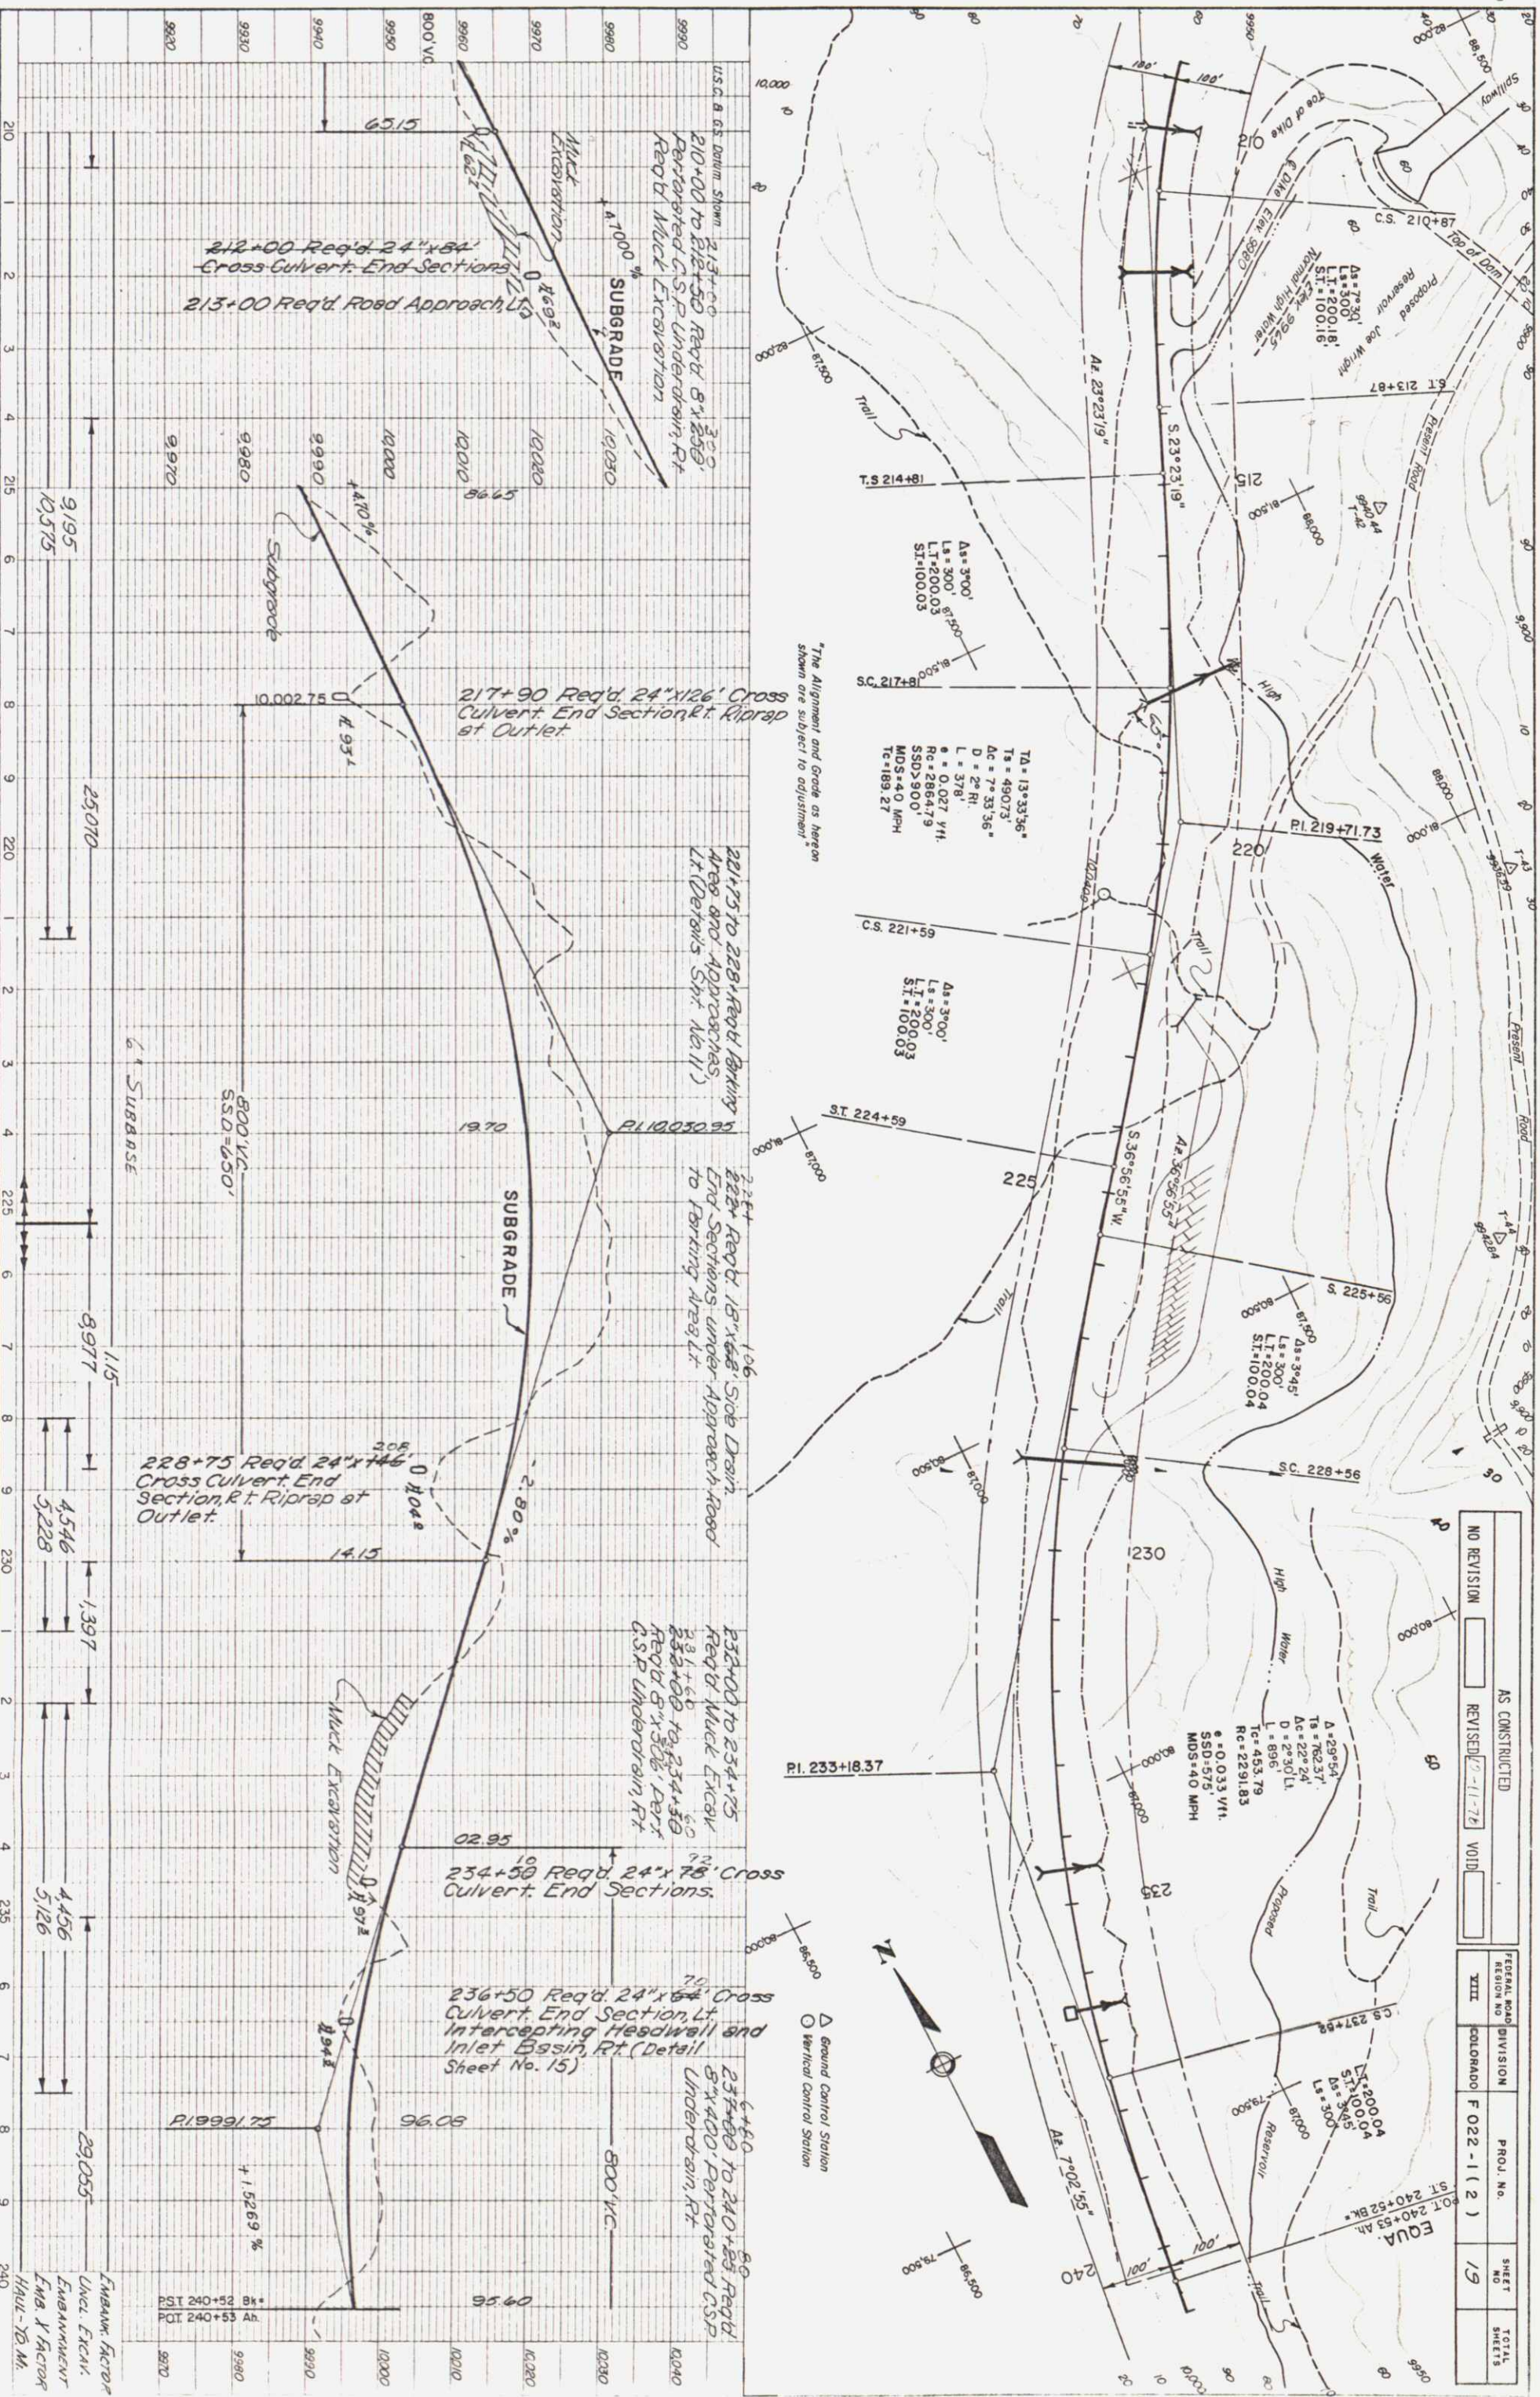


AS CONSTRUCTED		FEDERAL ROAD DIVISION		PROJ. No.		SHEET NO.		TOTAL SHEETS	
NO REVISION	REVISED 10-11-72	VOID	XIII	COLORADO	F 022-1(2)	19			

PLAN		BY	DATE
	SURVEYED		
NOTE BOOK	PLOTTED		
	ALIGNMENT CHECKED		
NO.	RT. OF WAY CHECKED		




PLAN		BY	DATE
NOTE BOOK	SURVEYED		
	PLOTTED		
	ALIGNMENT CHECKED		
NO.	RT. OF WAY CHECKED		

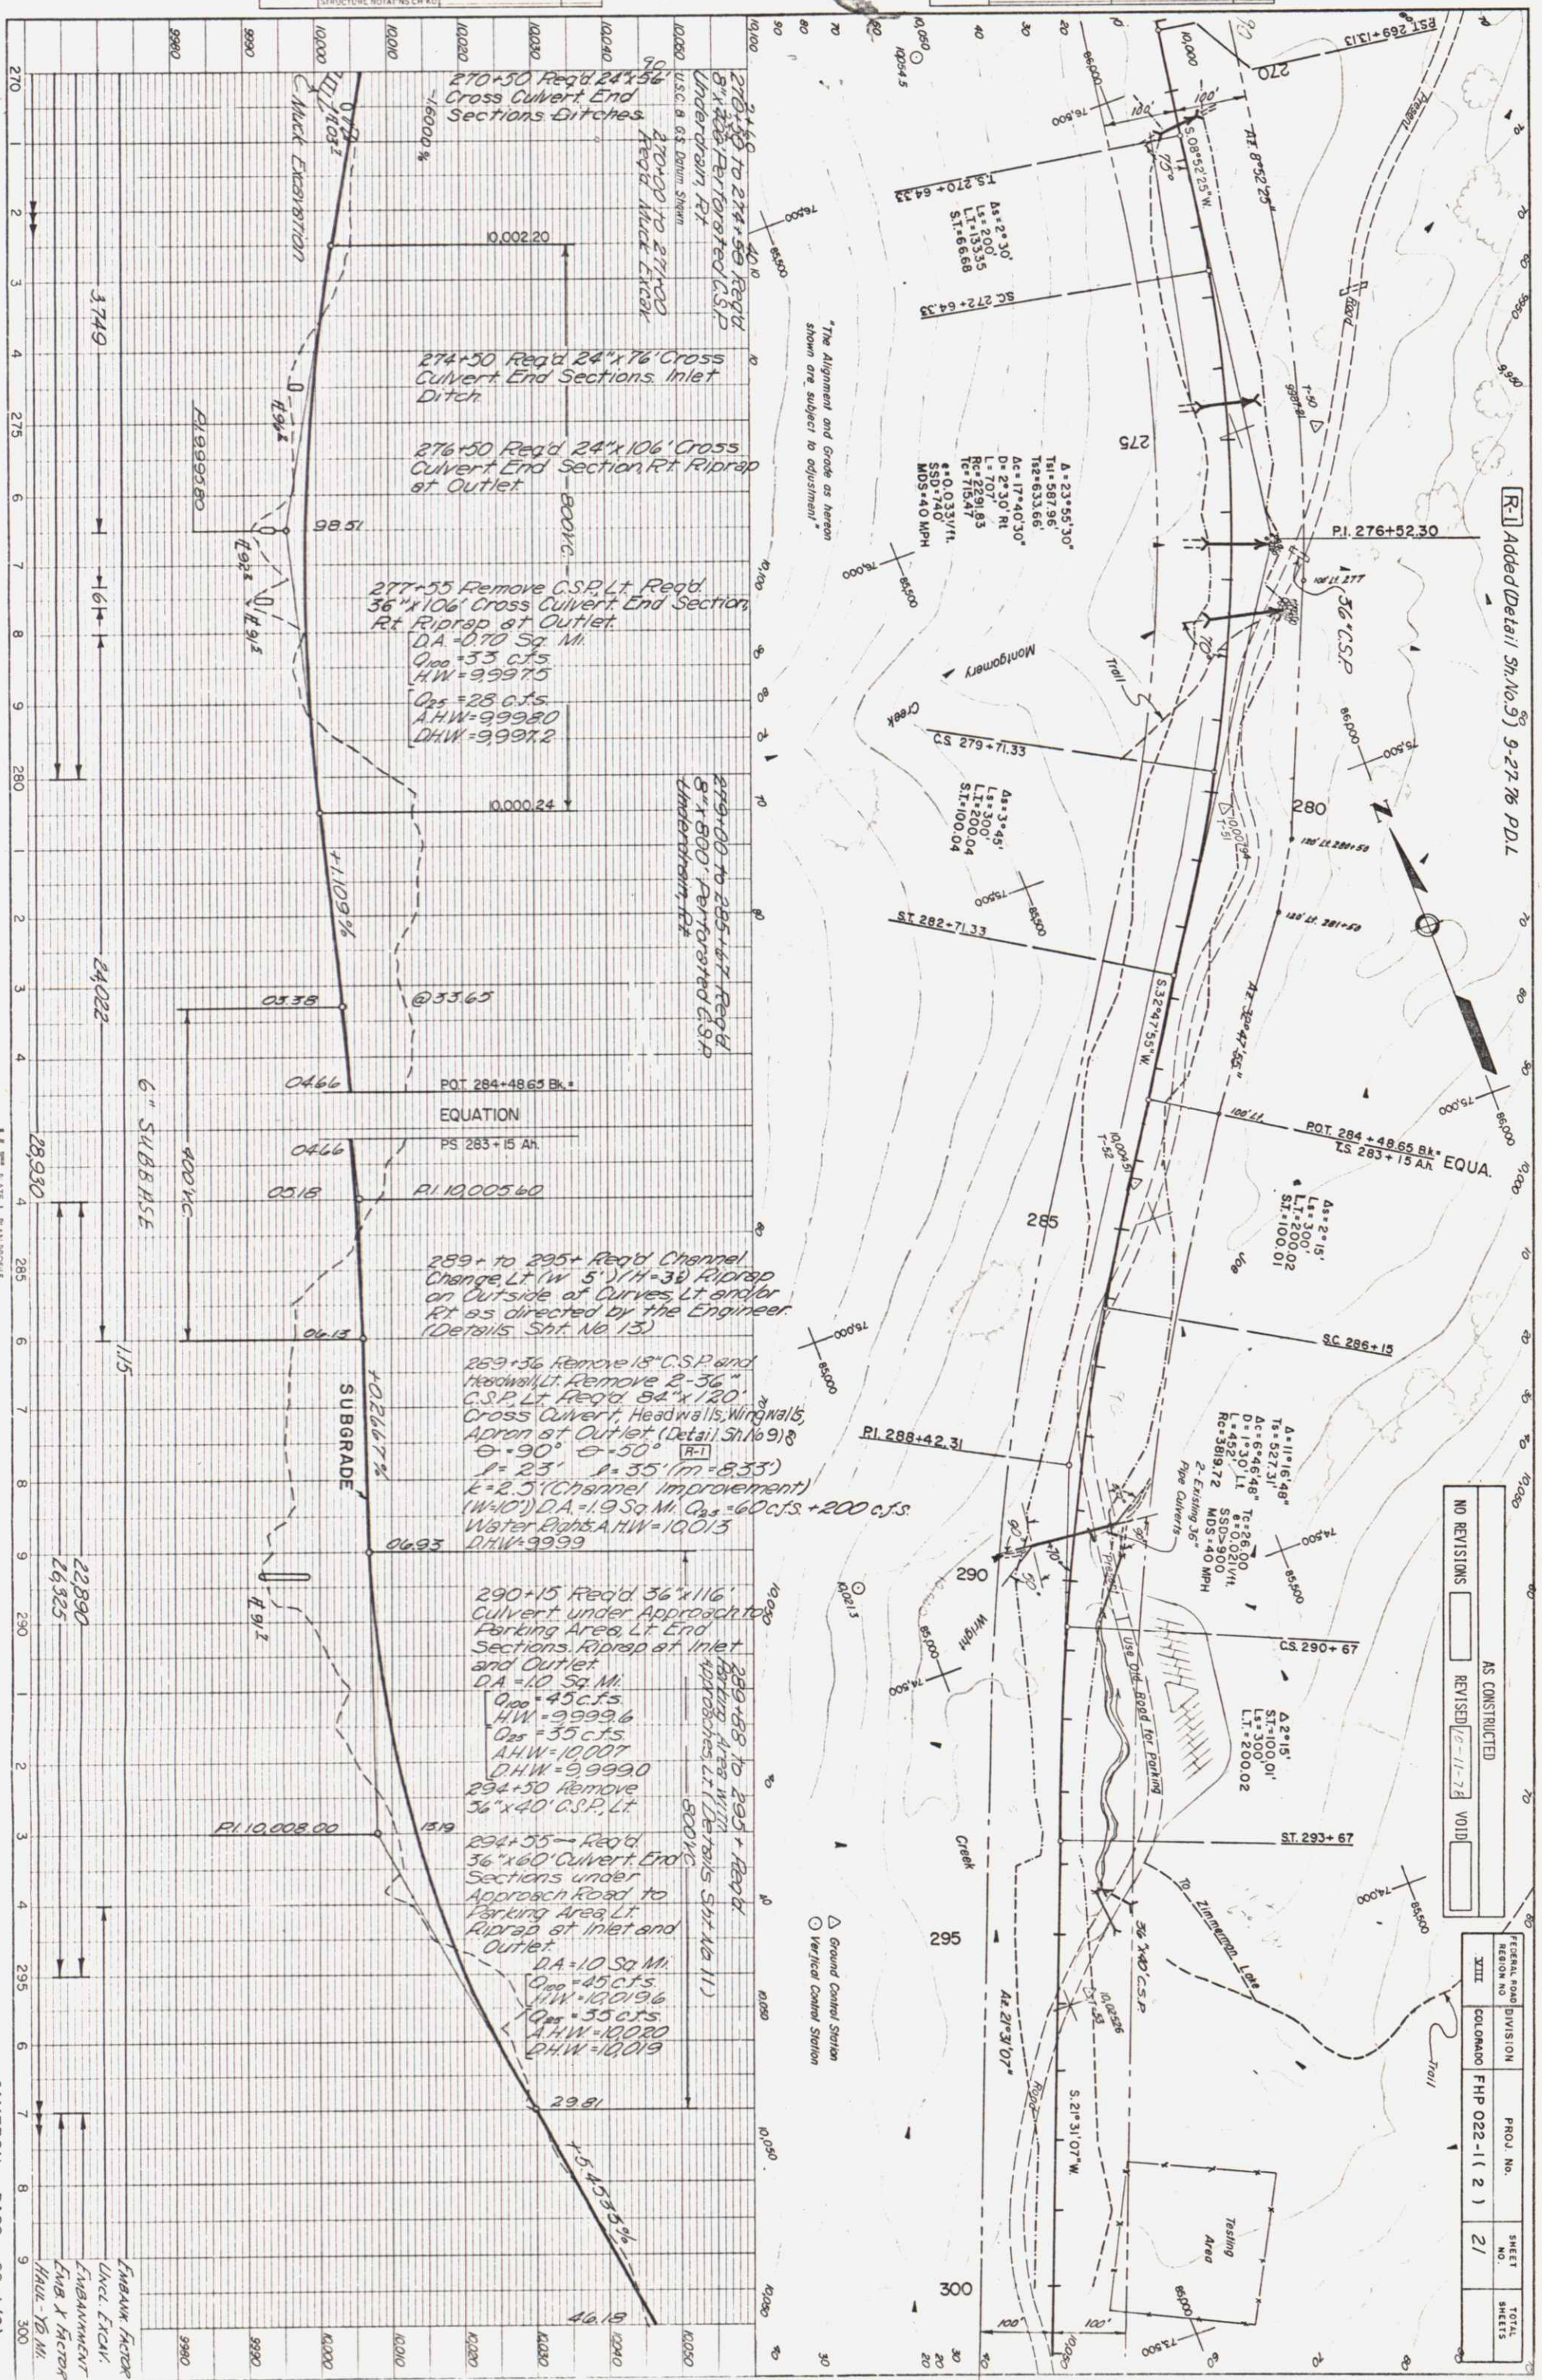

PROFILE	SURVEYED	BY	DATE
NOTE BOOK	PLOTTED		
	GRADES CHECKED		
	BY M & N		
	STRUCTURE NOTATIONS CHECKED		


PLAN	SURVEYED	BY	DATE
NOTE BOOK	PLOTTED		
	ALIGNMENT CHECKED		
	RT. OF WAY CHECKED		

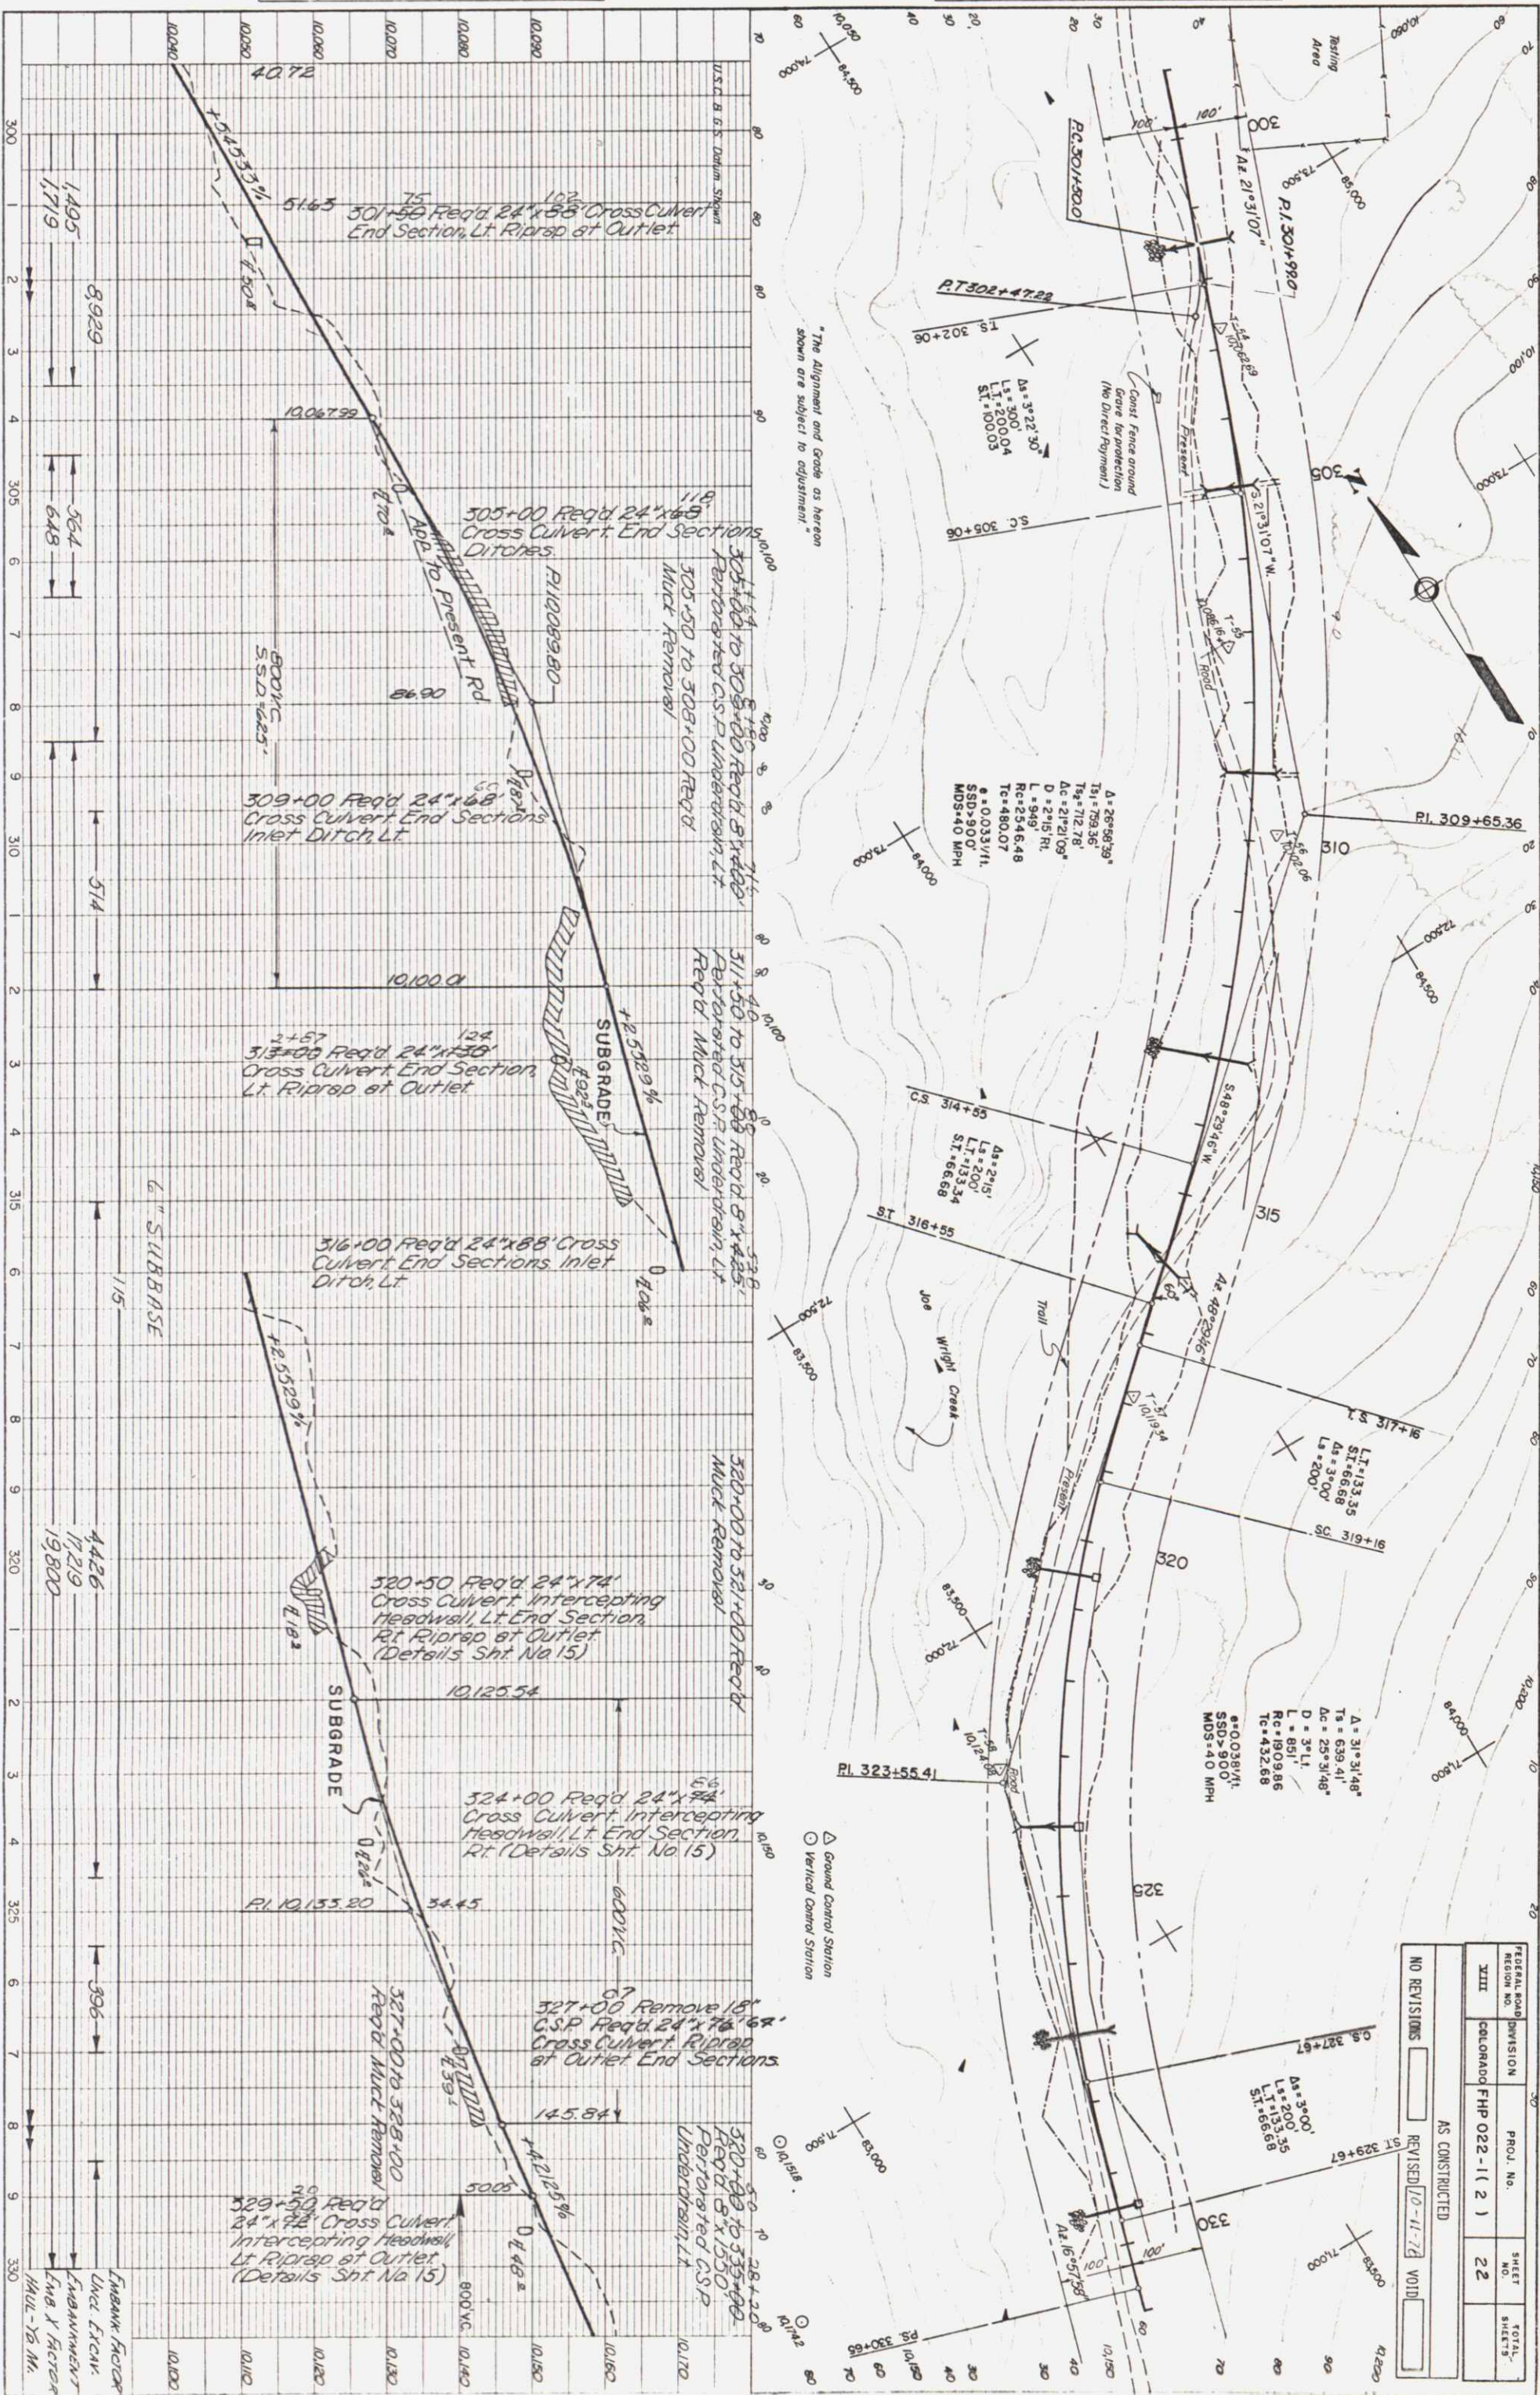

FEDERAL ROAD DIVISION	PROJ. NO.	SHEET NO.	TOTAL SHEETS
REGION NO. XIII	COLORADO FHP 022-1 (2)	22	
NO REVISIONS			
AS CONSTRUCTED			
REVISED 10-11-72 VOID			

PROFILE	BY	DATE
SURVEYED		
NOTE BOOK		
NO.		
STRUCTURE NOTATIONS CHECKED		

BY	DATE

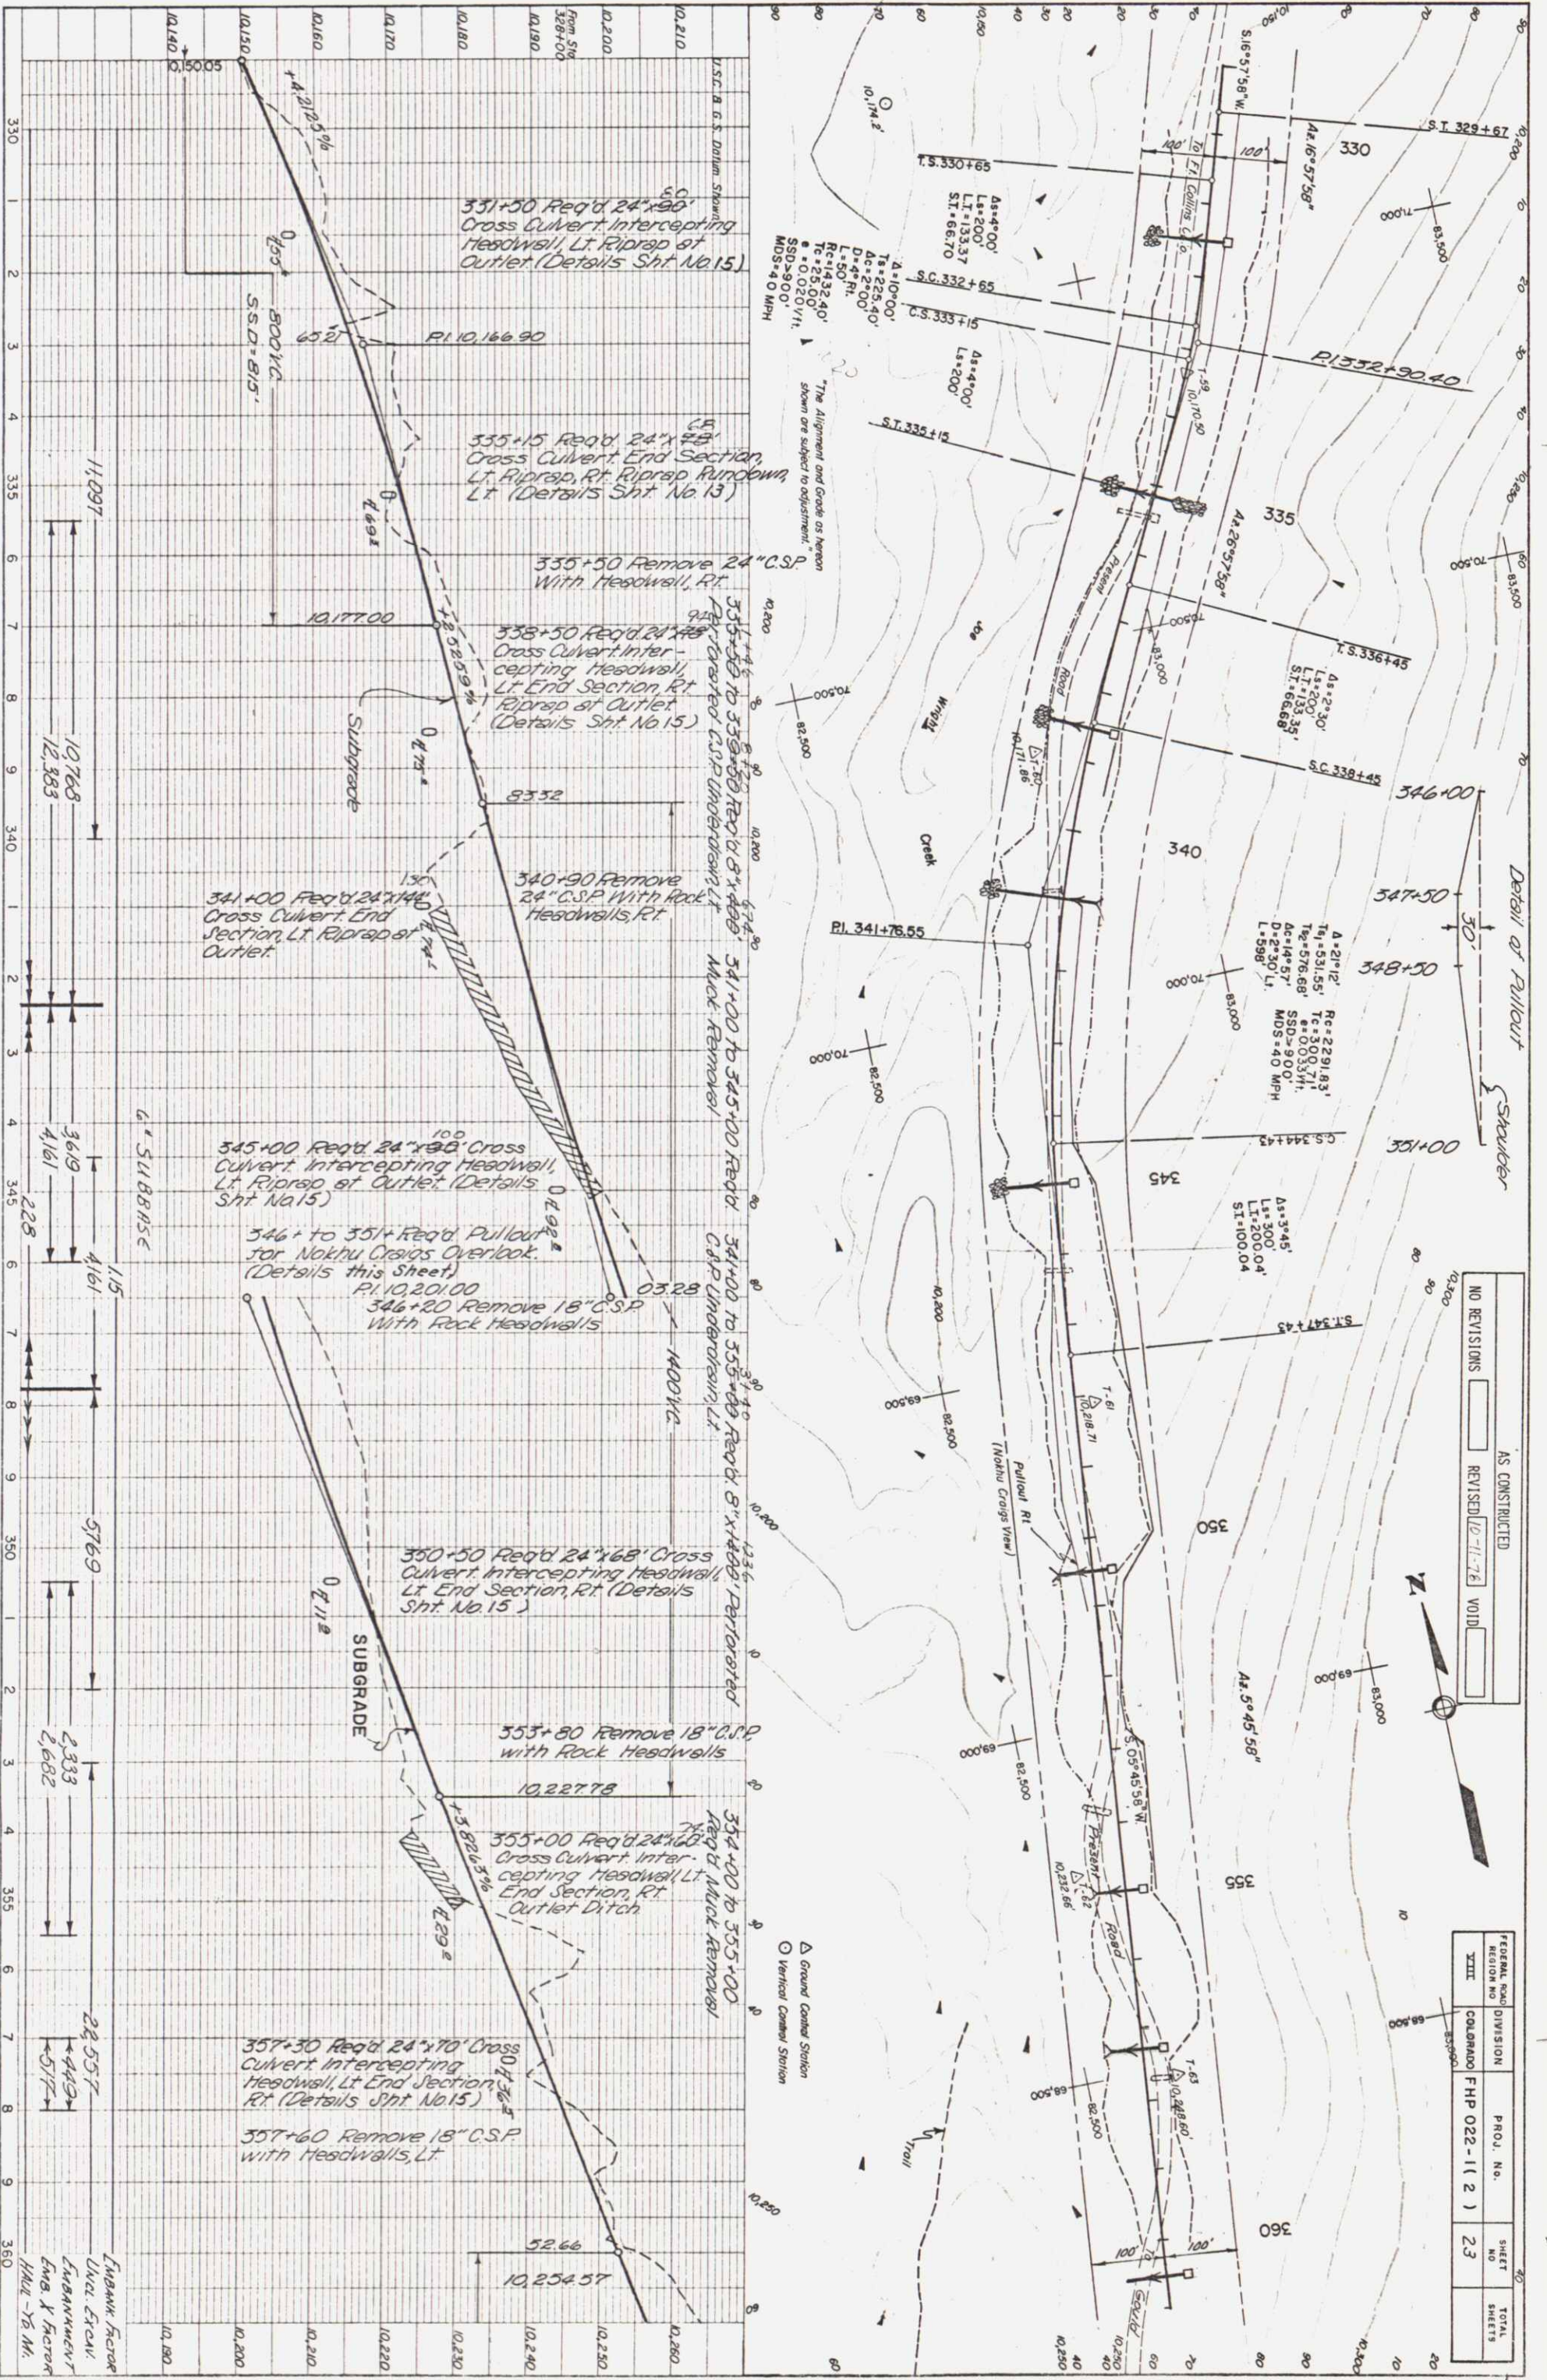

Detail of Pullout

AS CONSTRUCTED

NO REVISIONS

REVISED 10-11-78

VOID

FEDERAL ROAD

REGION NO.

III

DIVISION

COLORADO

PROJ. NO.

FHP 022-1(2)

SHEET

NO.

23

TOTAL

SHEETS

K&E


PLATE 1, PLAN PROFILE

EDWARDS & BIRD CO.

CAMERON PASS 22-1(2)

PROFILE	BY	DATE
SURVEYED		
PLOTTED		
GRADES CHECKED		
BY M. I. NOTED		
NO. _____		
STRUCTURE NOTATIONS CHECKED		

PLAN	BY	DATE
SURVEYED		
PLOTTED		
ALIGNMENT CHECKED		
BY M. I. NOTED		
NO. _____		
PT. OF WAY CHECKED		

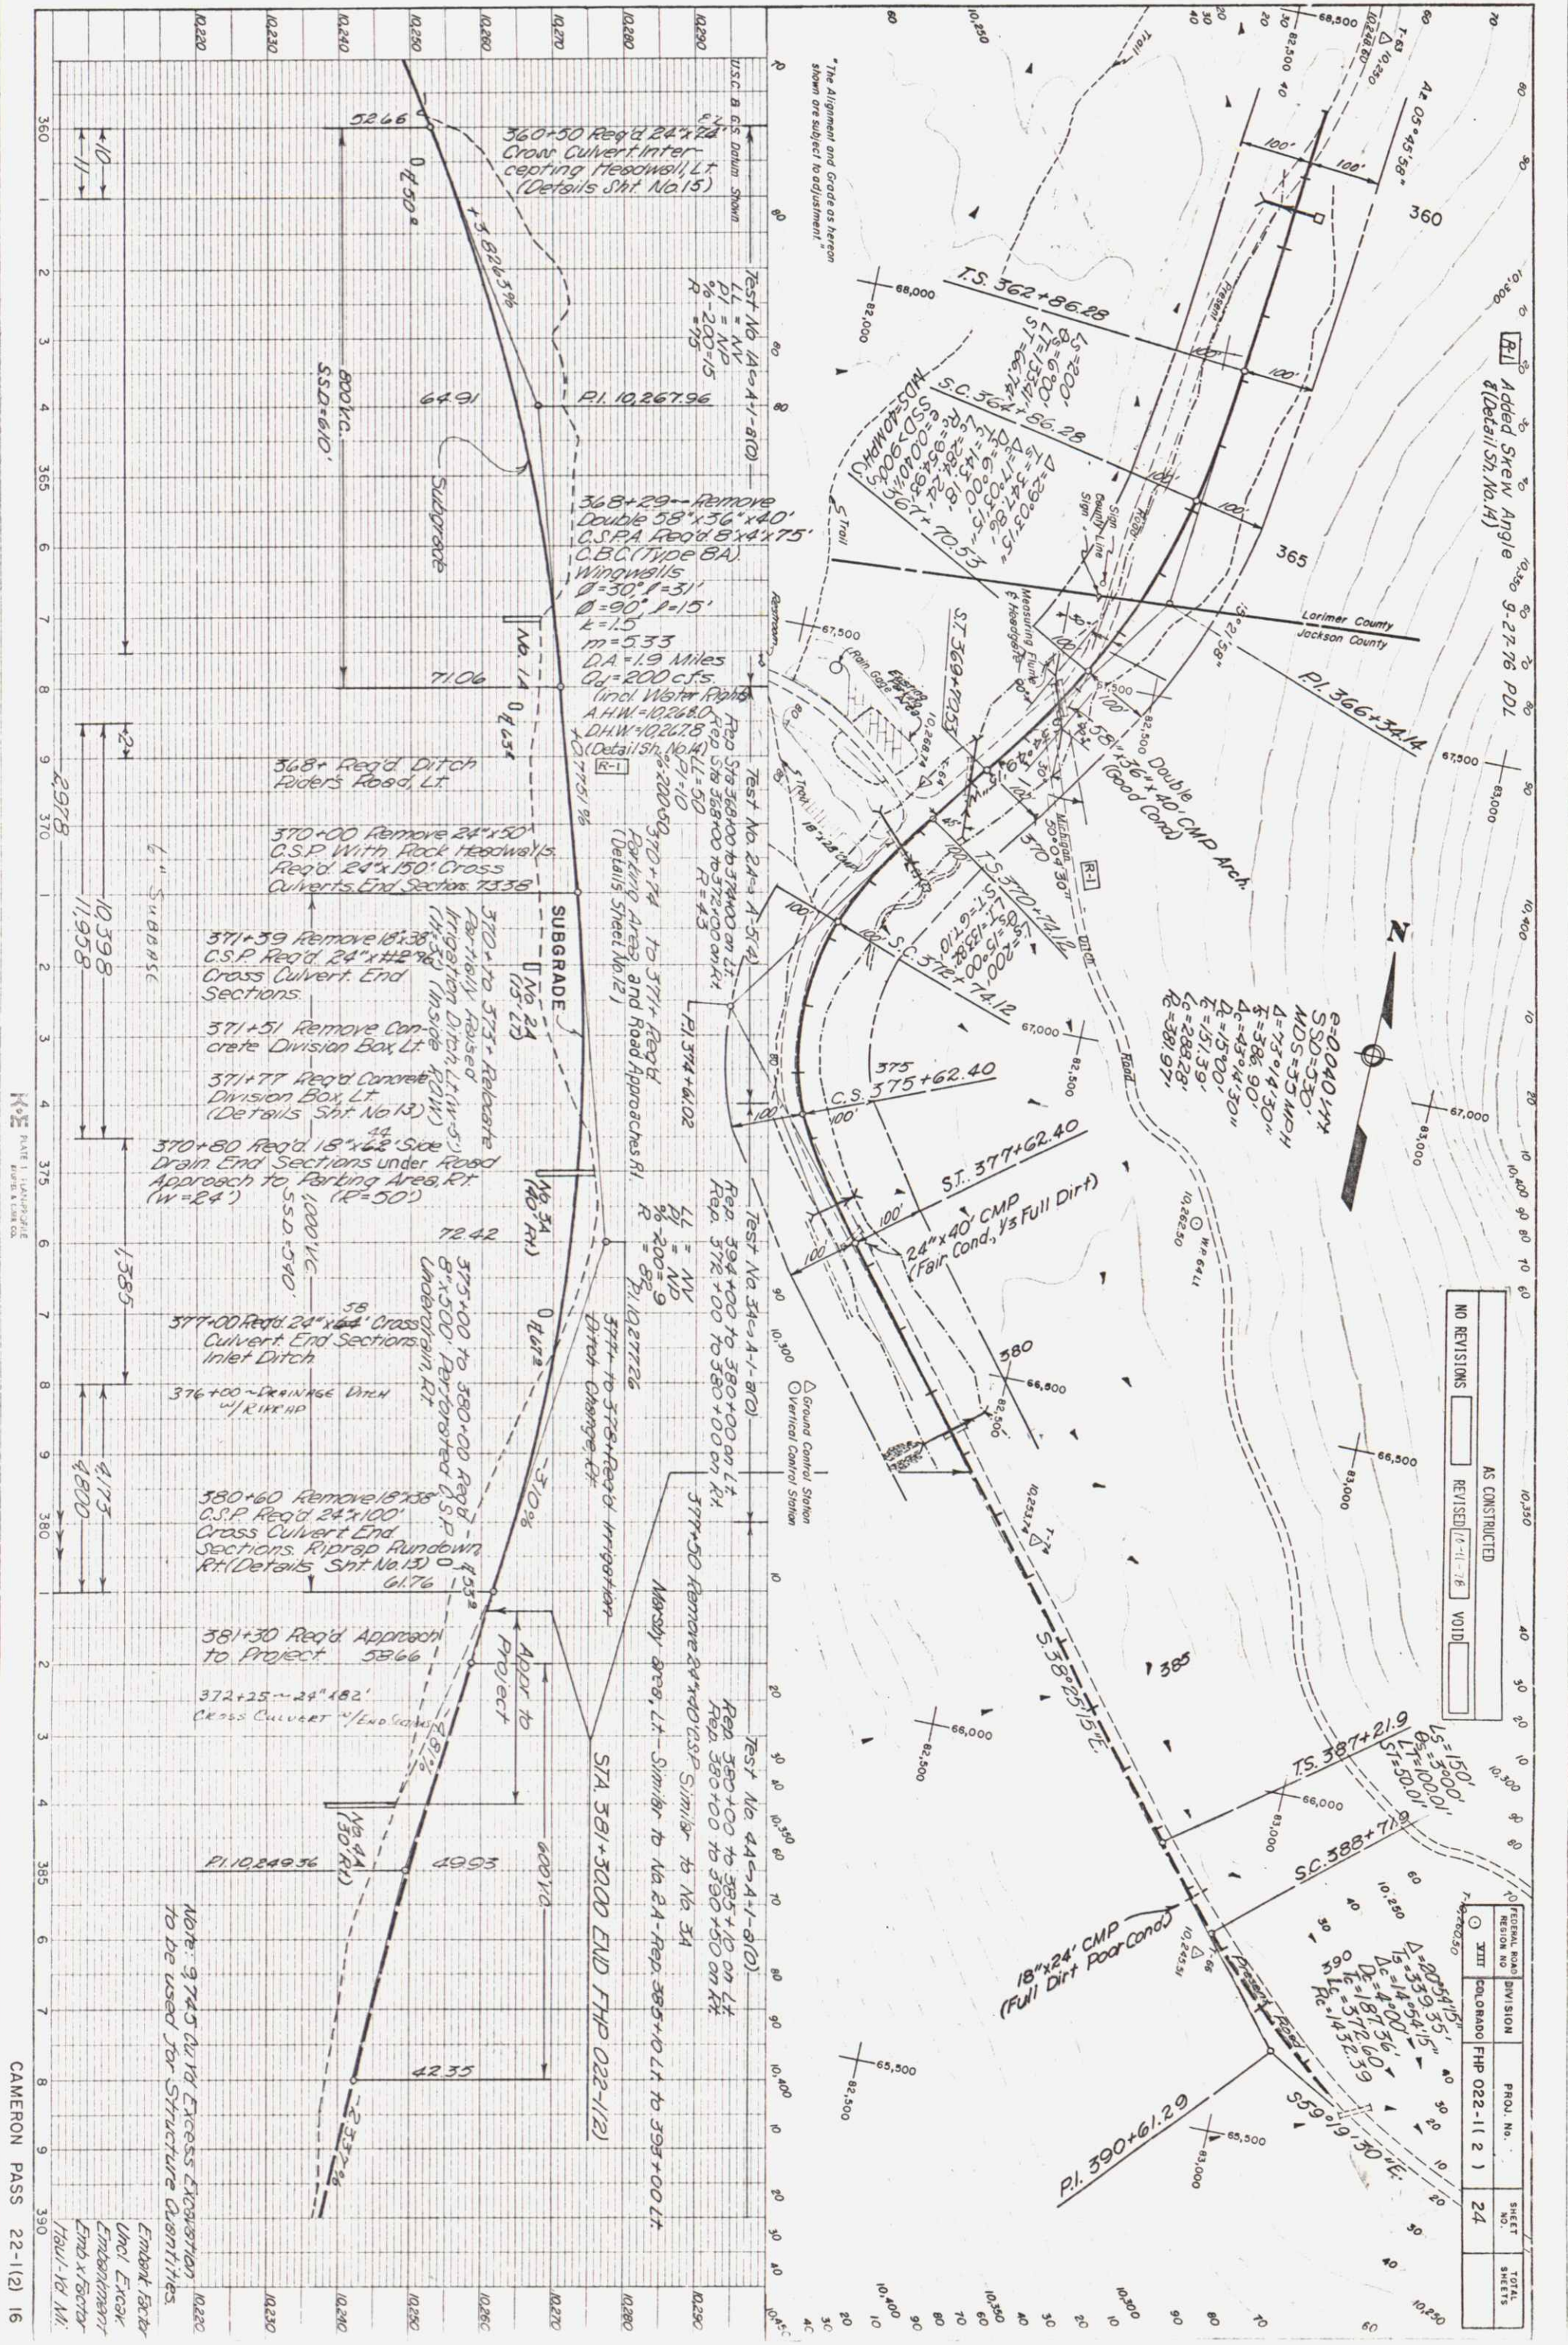

NO REVISIONS	AS CONSTRUCTED
REVISED 11-78	VOID

FEDERAL ROAD DISTRICT NO.	DIVISION	PROJ. NO.	SHEET NO.	TOTAL SHEETS
XIII	COLORADO	FHP 022-1(2)	24	

Note: 9745 and Excess Elevation to be used for Structure Quantities

Embank Factor
Uncl. Fill
Embankment
End Factor
1600-10 Mi.

K&E PLATE 1 1/2" X 11" SCALE