


Right of Way

T. ARNOLD - Design

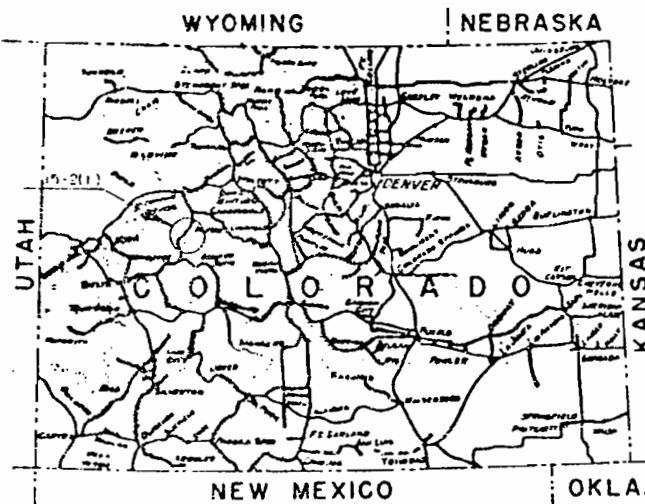

U.S. DEPARTMENT OF COMMERCE
BUREAU OF PUBLIC ROADS

AS CONSTRUCTED

COLORADO FOREST HIGHWAY PROJECT 15-2(I)

MCCLURE PASS

LENGTH 3.416 MILES

CLASS 2

WHITE RIVER & GUNNISON NATIONAL FORESTS
PITKIN & GUNNISON COUNTIES

REGION 9 STATE COLORADO
PROJECT 15-2(I), McClure Pass
SHEET 1 OF SHEETS


INDEX TO SHEETS

SHEET NO.	DESCRIPTION	STATIONING
1	Title Sheet	
2	Typical Sections	
3	Summary (2 Sheets)	
41-47	Plan & Profile	1130+20 to 1310+50
Std. 108	Metal End Sections & Full Gage Tables	
Std. 119	Underdrain	
Std. 121	Rock Structures	
Std. 131	Maintenance Posts and Delineators	
Std. 136	Wire Fences with Steel Posts	
Std. 143	Project Identification Signs	
Std. 157	Bin Type Metal Grubbing	
R9-SP-134	Trash Rocks	

Plans prepared by BPR
Date August, 1964

Description of Project:
Improvement Grading
Roadbed Width 42'
Type Class CC10

Traffic Volume
ADT (1963) 80
ADT (1983) 256
DHV 40
C 65%
T 10%
V 30

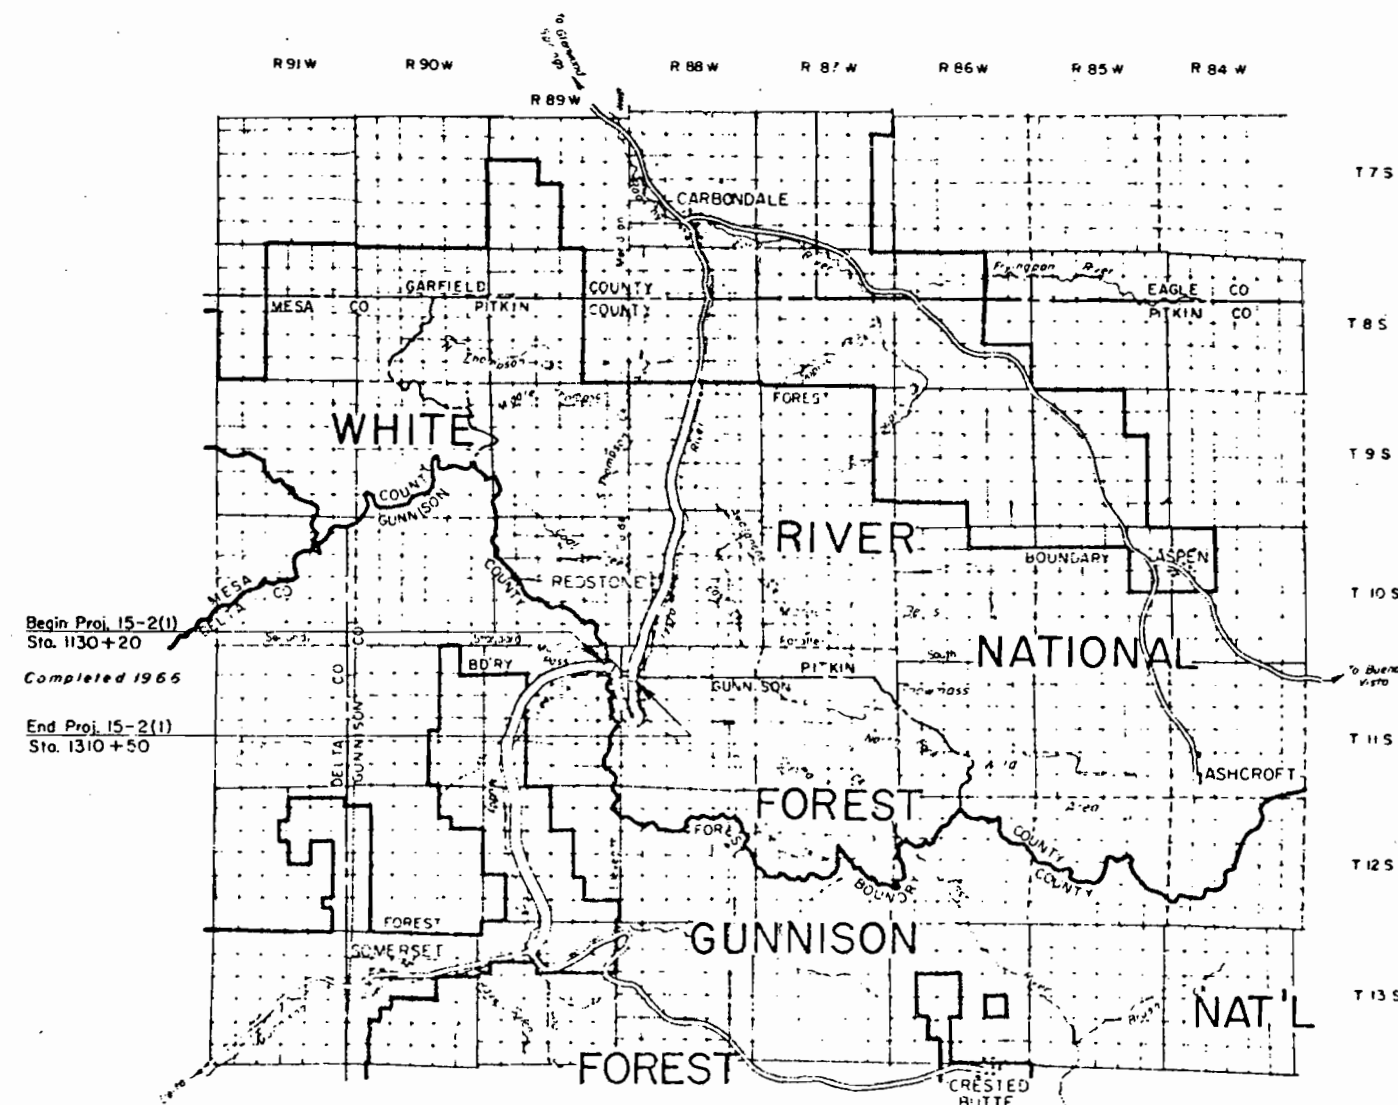

Begin Proj. 15-2(I)
Sta. 1130+20

Completed 1965

End Proj. 15-2(I)
Sta. 1310+50

LEGEND

UNIMPROVED GRADED REINFORCED BASE SURFACE ROAD PLANT CONCRETE
ROAD SURFACE COURSE TREATMENT AND BITUM


FILE COPY
Do Not Remove

FILE COPY

U.S. DEPARTMENT OF COMMERCE
BUREAU OF PUBLIC ROADS
REGION NO 9 DENVER, COLORADO

APPROVED

REGIONAL ENGINEER DATE 1964

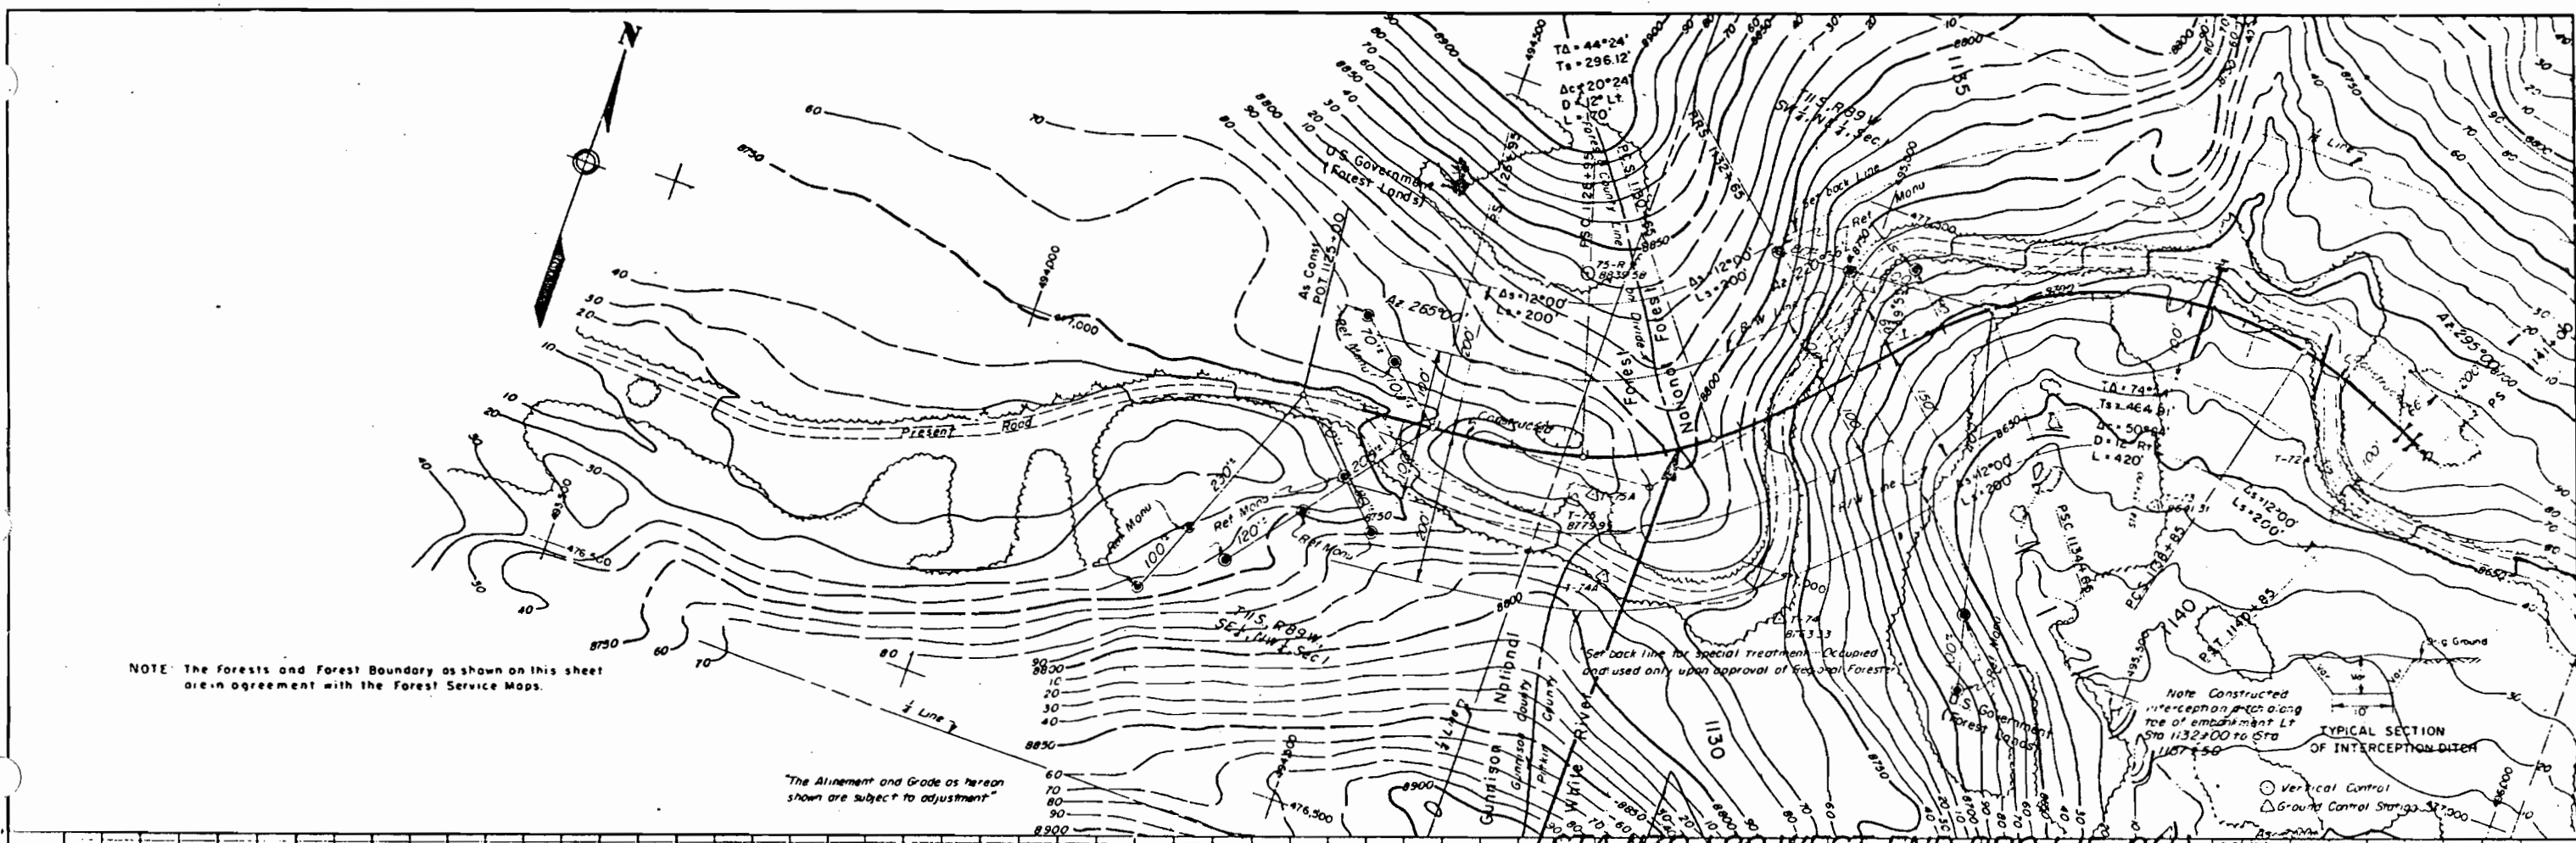

STA 1130+20 WEST END PROJ 15-2(1) 66 CONSTRUCTION

