

# FEDERAL WORKS AGENCY PUBLIC ROADS ADMINISTRATION


## AS CONSTRUCTED PROJECT 35-F

### ROUTE 35 GREENHORN HIGHWAY RYE TO A JCT. WITH NORTH HARDCRABBLE FOREST HIGHWAY NO. 43 33 MILES CLASS 2 COLORADO FOREST HIGHWAY SYSTEM SAN ISABEL NATIONAL FOREST CUSTER & PUEBLO COUNTIES COLORADO


| DIV. | STATE | ROUTE NO. | SECTION | SHEET NO. | TOTAL SHEETS |
|------|-------|-----------|---------|-----------|--------------|
| 9    | COLO. | 35        |         | 1         |              |

#### INDEX TO SHEETS

| SHEET NO.     | DESCRIPTION                   | STATION | STATION |
|---------------|-------------------------------|---------|---------|
| 1             | Title Sheet                   |         |         |
| 2             | Typical Sections              |         |         |
| 3             | Summary                       |         |         |
| 4-9           | Plan & Profile                | 3+823   | 89+00   |
| Rev. 03-30-11 | Content Rubble Masonry Hdws.  |         |         |
| Rev. 03-30-12 | Std. Miscellaneous Structures |         |         |
| 03-30-13      | Std. Maintenance Posts        |         |         |
| Rev. 03-30-14 | Std. Barbed Wire Fence        |         |         |
| Rev. 03-30-15 | Typical Construction Signs    |         |         |
| 1-12          | Cross Sections                | 3+823   | 89+00   |

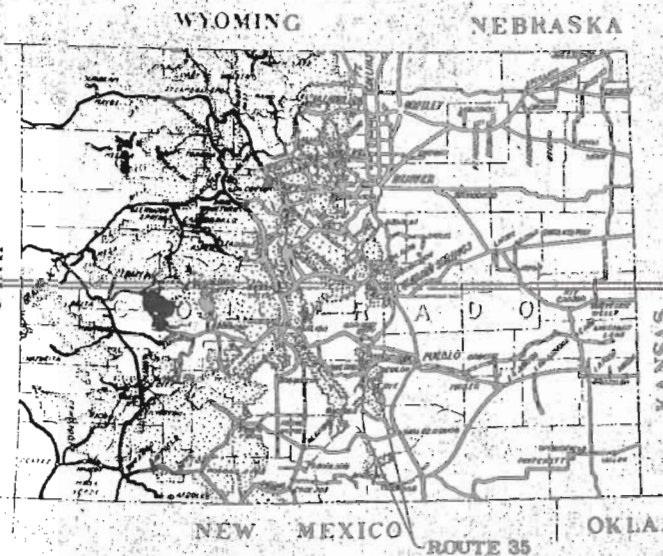


Federal Aid Highway System  
Forest Highway System  
National Forests

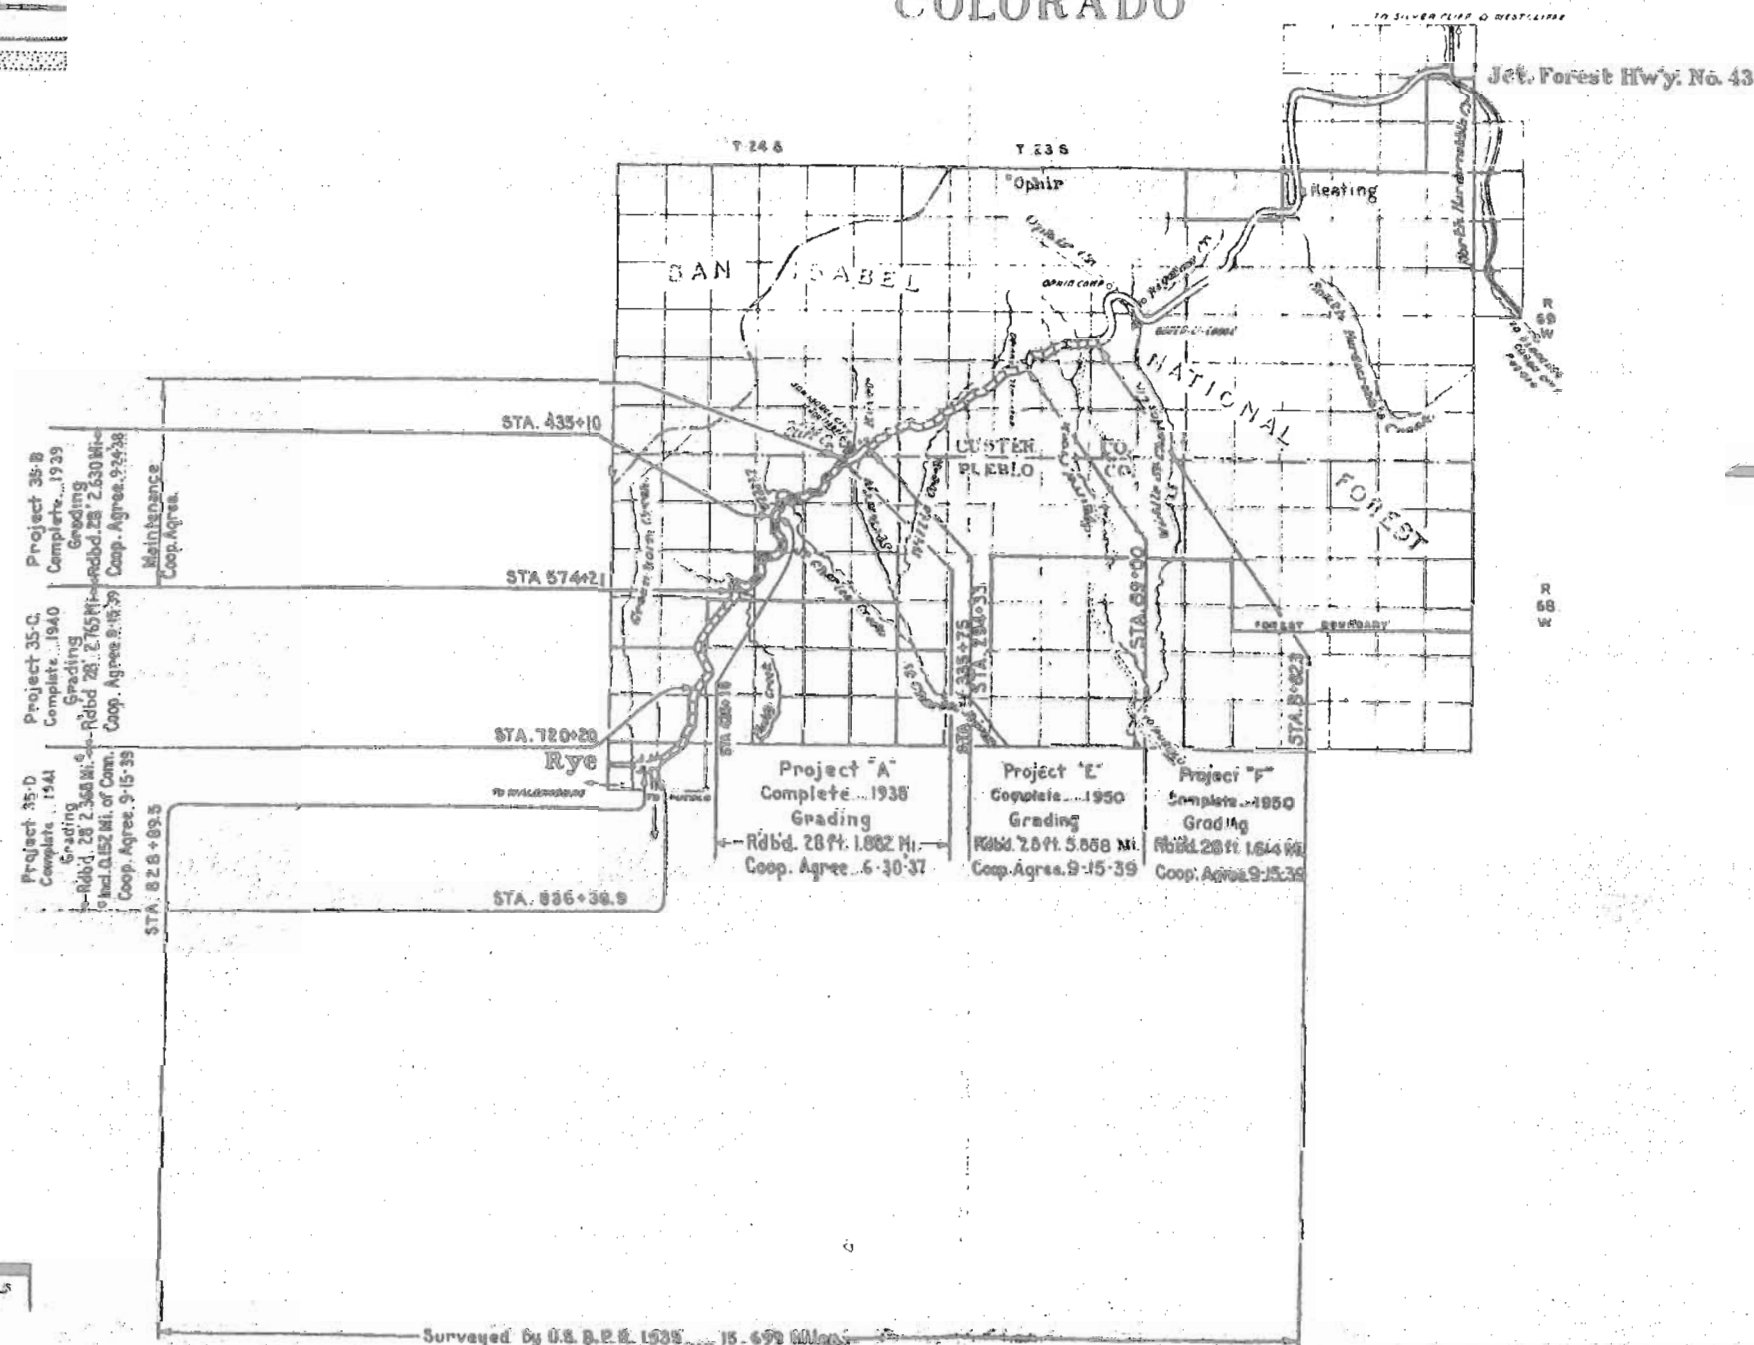

#### INDEX MAP

 Scale Miles



#### LEGEND

|                   |            |        |            |      |                 |              |        |
|-------------------|------------|--------|------------|------|-----------------|--------------|--------|
| EXISTING<br>ROADS | UNIMPROVED | GRADED | PAVEMENTED | BASE | CURB AND GUTTER | INTERCHANGES | TRUCKS |
|-------------------|------------|--------|------------|------|-----------------|--------------|--------|

Surveyed by U.S.P.R.E. 1535 15. 699 Miles

#### FEDERAL WORKS AGENCY PUBLIC ROADS ADMINISTRATION DIVISION 9 DENVER, COLORADO

APPROVED \_\_\_\_\_ DATE \_\_\_\_\_ 19\_\_\_\_

DIVISION ENGINEER  
BY DESIGN ENGINEER

APPROVED \_\_\_\_\_ DATE \_\_\_\_\_ 19\_\_\_\_

DISTRICT ENGINEER

APPROVED \_\_\_\_\_ DATE \_\_\_\_\_ 19\_\_\_\_



REGIONAL FORESTER

APPROVED \_\_\_\_\_ DATE \_\_\_\_\_ 19\_\_\_\_

STATE HIGHWAY ENGINEER  
STATE OF COLORADO




**NORTH END PROJ. 35-F**  
**STA 3+823 NORTH END PROJ. 35-F**  
**1950 CONSTRUCTION**

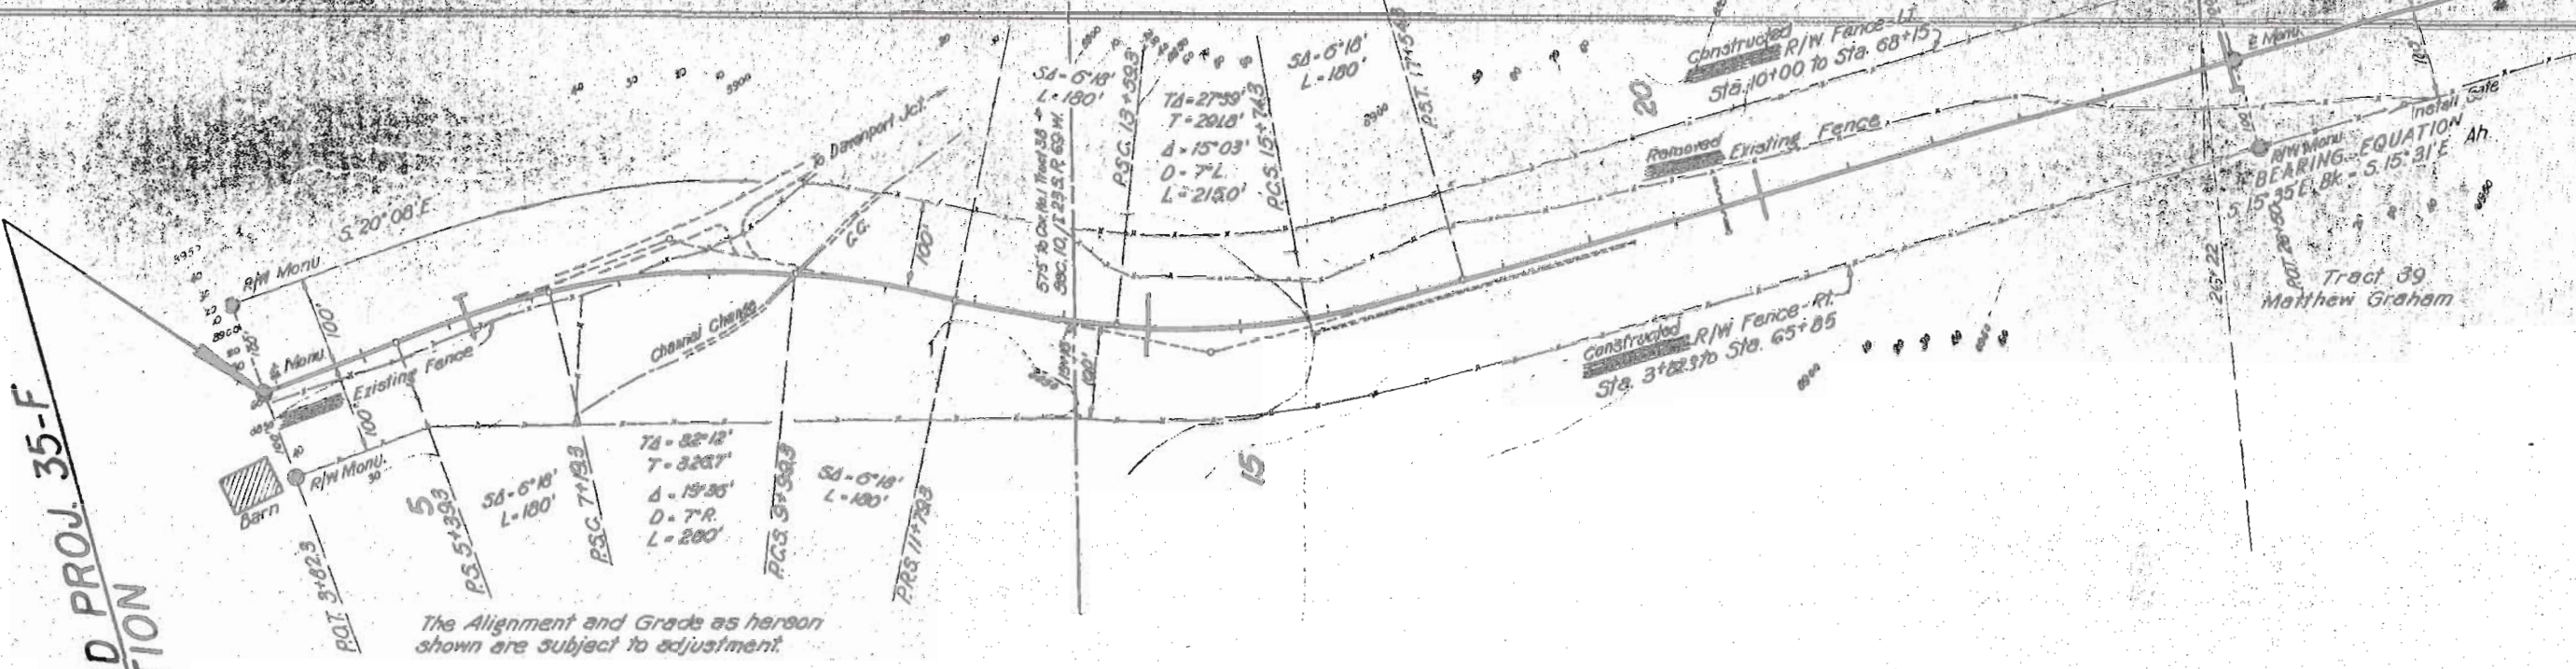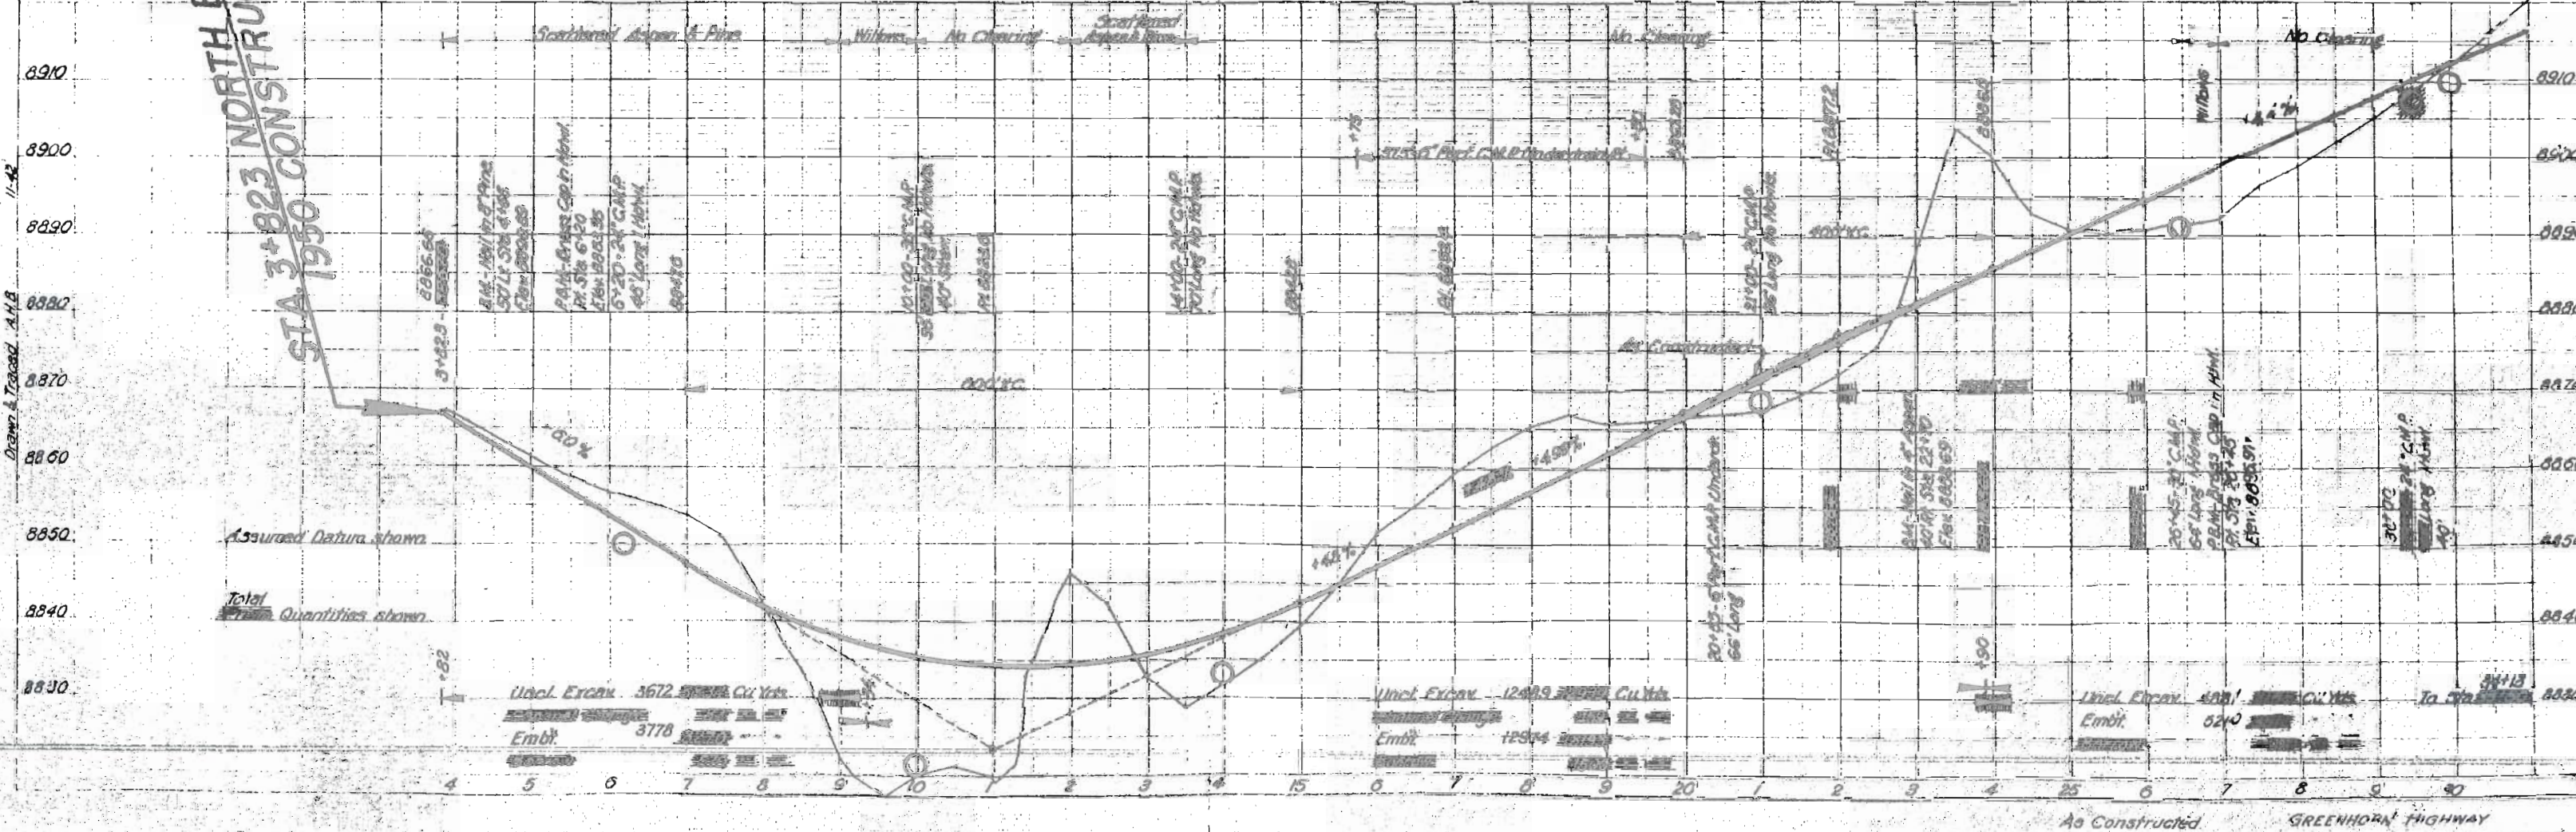




Greenhorn Highway, Sta 30+00 to Sta 65+00  
Sheet 163

PLAN  
R Coffey  
11-42  
Drawn A. Traded A.H.B.

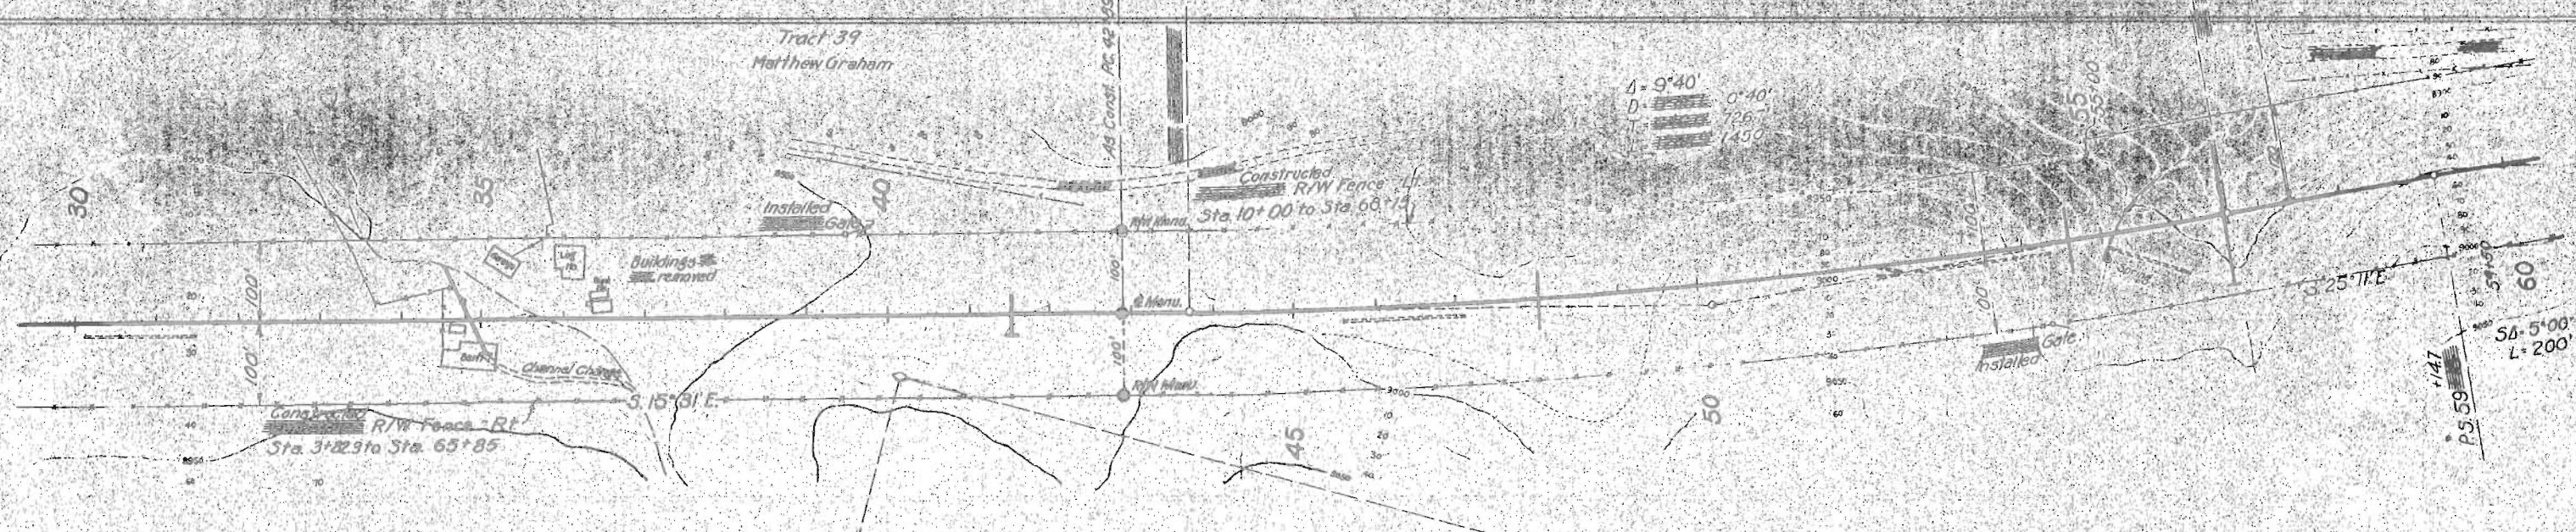

The Alignment and Grade as hereon shown are subject to adjustment.

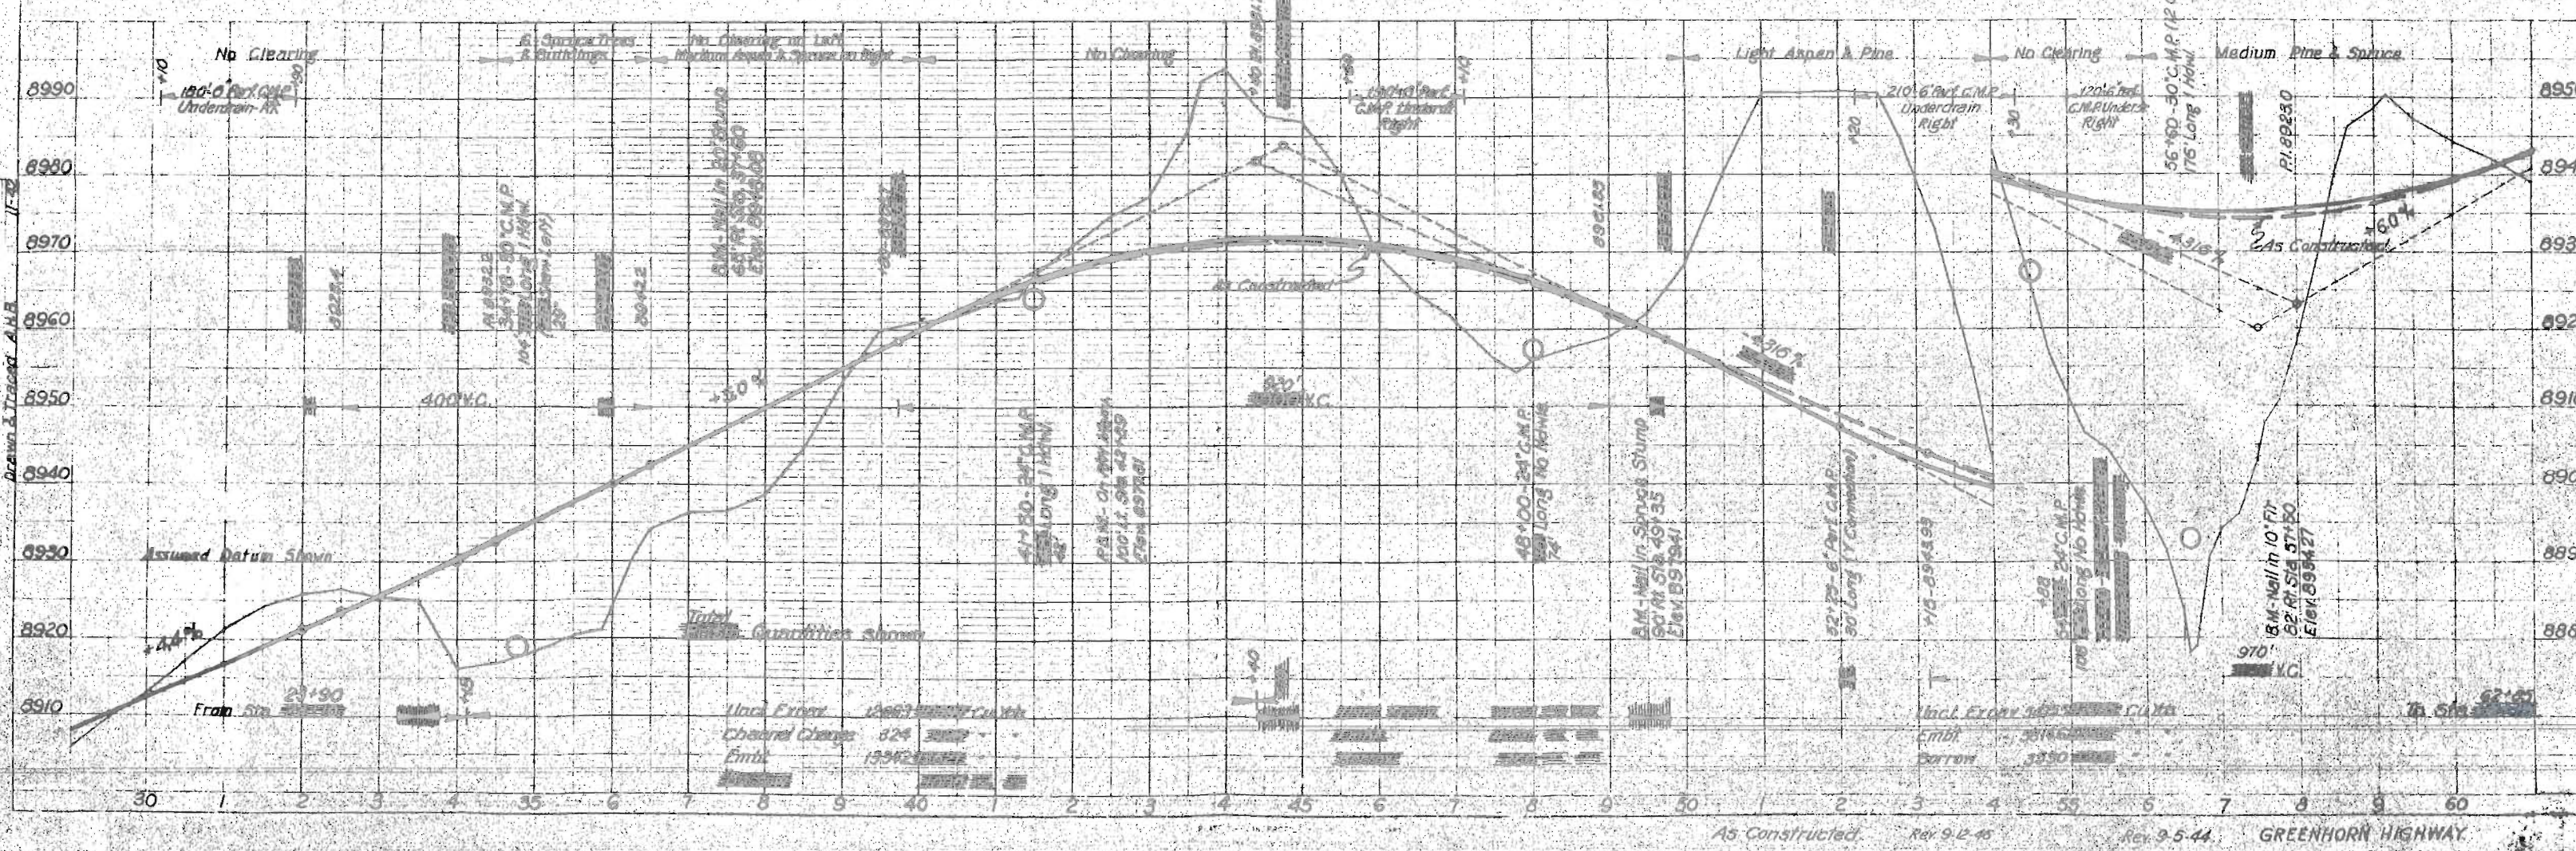


As Constructed Rev 9-2-45 Rev 9-5-44 GREENHORN HIGHWAY



Greenhorn Highway, Colo. 35  
Sta 60+00 to Sta 50+00  
Sheet No. 6

1941  
R. Coffey  
Drawn & Traced A.N.B.  
11-42

9 66 35 28 F

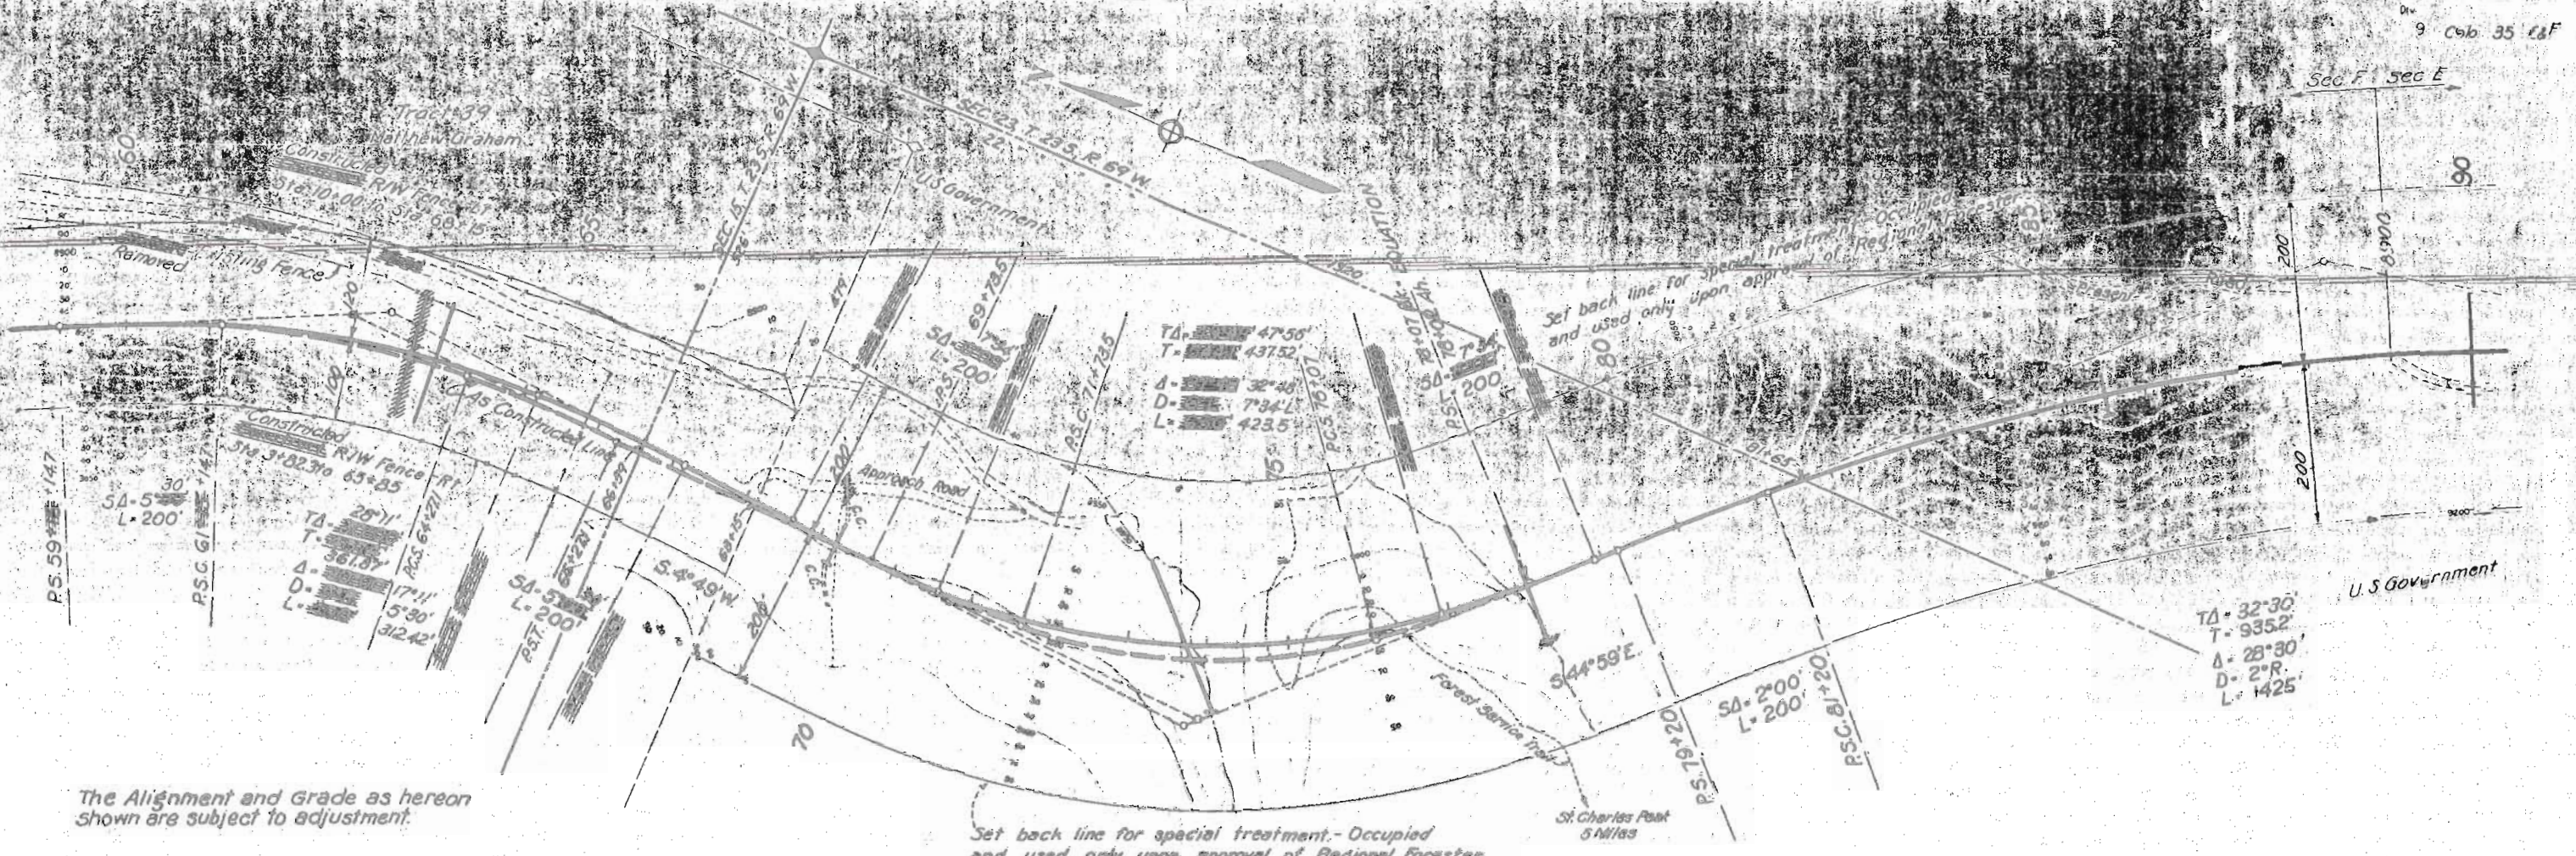

The Alignment and Grade as hereon shown are subject to adjustment.

Set back line for special treatment - Occupied and used only upon approval of Regional Forester

