

Utilities  
Poudre Valley REA elect.  
US West tel.

NOTE: QUANTITIES FROM STA 102+00 TO STA 105+00  
WILL BE PAID FOR UNDER PROJECT SR(CX) 0014(25) -  
SEE SUMMARY OF APPROXIMATE QUANTITIES

|              |         |      |
|--------------|---------|------|
| NO. OF PAGES | 7-20-91 | VOID |
|--------------|---------|------|

|                 |          |                                 |           |              |
|-----------------|----------|---------------------------------|-----------|--------------|
| FEEDBACK REGION | DIVISION | PROJ. NO.                       | SHEET NO. | SHEET TOTALS |
| VIII            | COLO.    | FLH 0014(26)<br>SR(CX) 0014(25) | 50        | 57           |

Site 2~Indian Meadows

PLAN  
Orig. Scale: 1" = 50'



Proj. Line  
 $\Delta_s = 26^\circ 48' 59''$  Rt.  
 $T_s = 246.02'$   
 $E_s = 21.41'$   
 $\Delta_c = 14^\circ 48' 59''$   
 $D_c = 8^\circ 00'$   
 $T_c = 93.12'$   
 $L_c = 185.21'$   
 $R_c = 716.20'$   
 $\theta_s = 6^\circ 00'$   
 $L_s = 150'$   
 $ST = 50.05'$   
 $LT = 100.06'$   
 $e = 0.071' / ft.$   
Trans. = 150', Runout = 24.59'  
M.D.S. = 40 M.P.H.  
S.S.D. = 631'

NW 1/4 SW 1/4 SEC. 35

Sta. 101+00 to 102+00  
Req'd. Approach to Project


Sta. 102+00 Begin SR(CX) 0014(25)  
M.P. 92.725

NE 1/4 SW 1/4 SEC. 35

106+54  
Sta. 105+00 End SR(CX) 0014(25) =  
Begin FLH 0014(26) Site 2-Indian Meadows  
M.P. 92.782

110 (Surv.)

MATCH LINE 112+00 (Surv.)

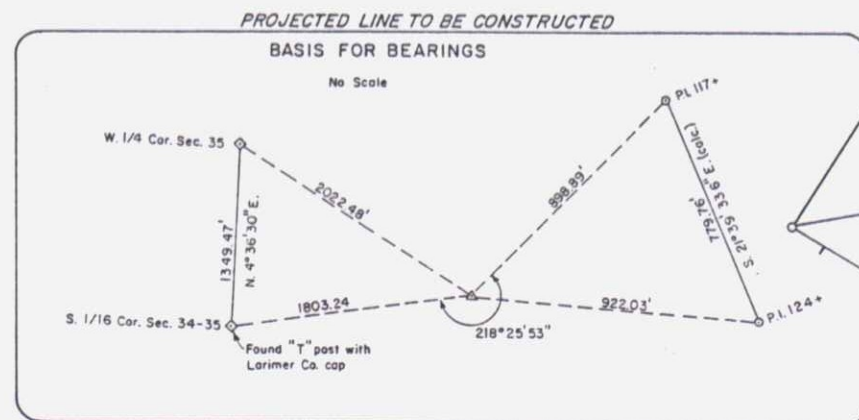

R.O.W. shown for information only - See R.O.W. plans for details.

B.M. 71 ~ 7011.23  
Rebar 44' Lt. 1103+31 (New Base)

P.O.T. 4+48.74

B.M. 7 ~ 7004.80  
Rebar 80' Lt. 1110+35 (New Base)

P.I. 2+65.94


B.M. 6 ~ 7003.25  
Hub & Ad. 1111+40.21 (New Base)

B.M. 5 ~ 7002.38  
Rebar 110' Lt. 1112+57 (New Base)

B.M. 4 ~ 7004.06  
Rebar 119' Rt. 1113+51 (New Base)

|                      |          |              |              |                 |
|----------------------|----------|--------------|--------------|-----------------|
| FED. ROAD<br>SECTION | DIVISION | PROJ. NO.    | SHEET<br>NO. | SHEET<br>TOTALS |
| 1111                 | COLD.    | FLH 0014(26) | 51           | 57              |

NOTE: TOPSOIL SHALL BE STOCKPILED  
IN THE DESIGNATED AREA AS  
DIRECTED BY THE ENGINEER.

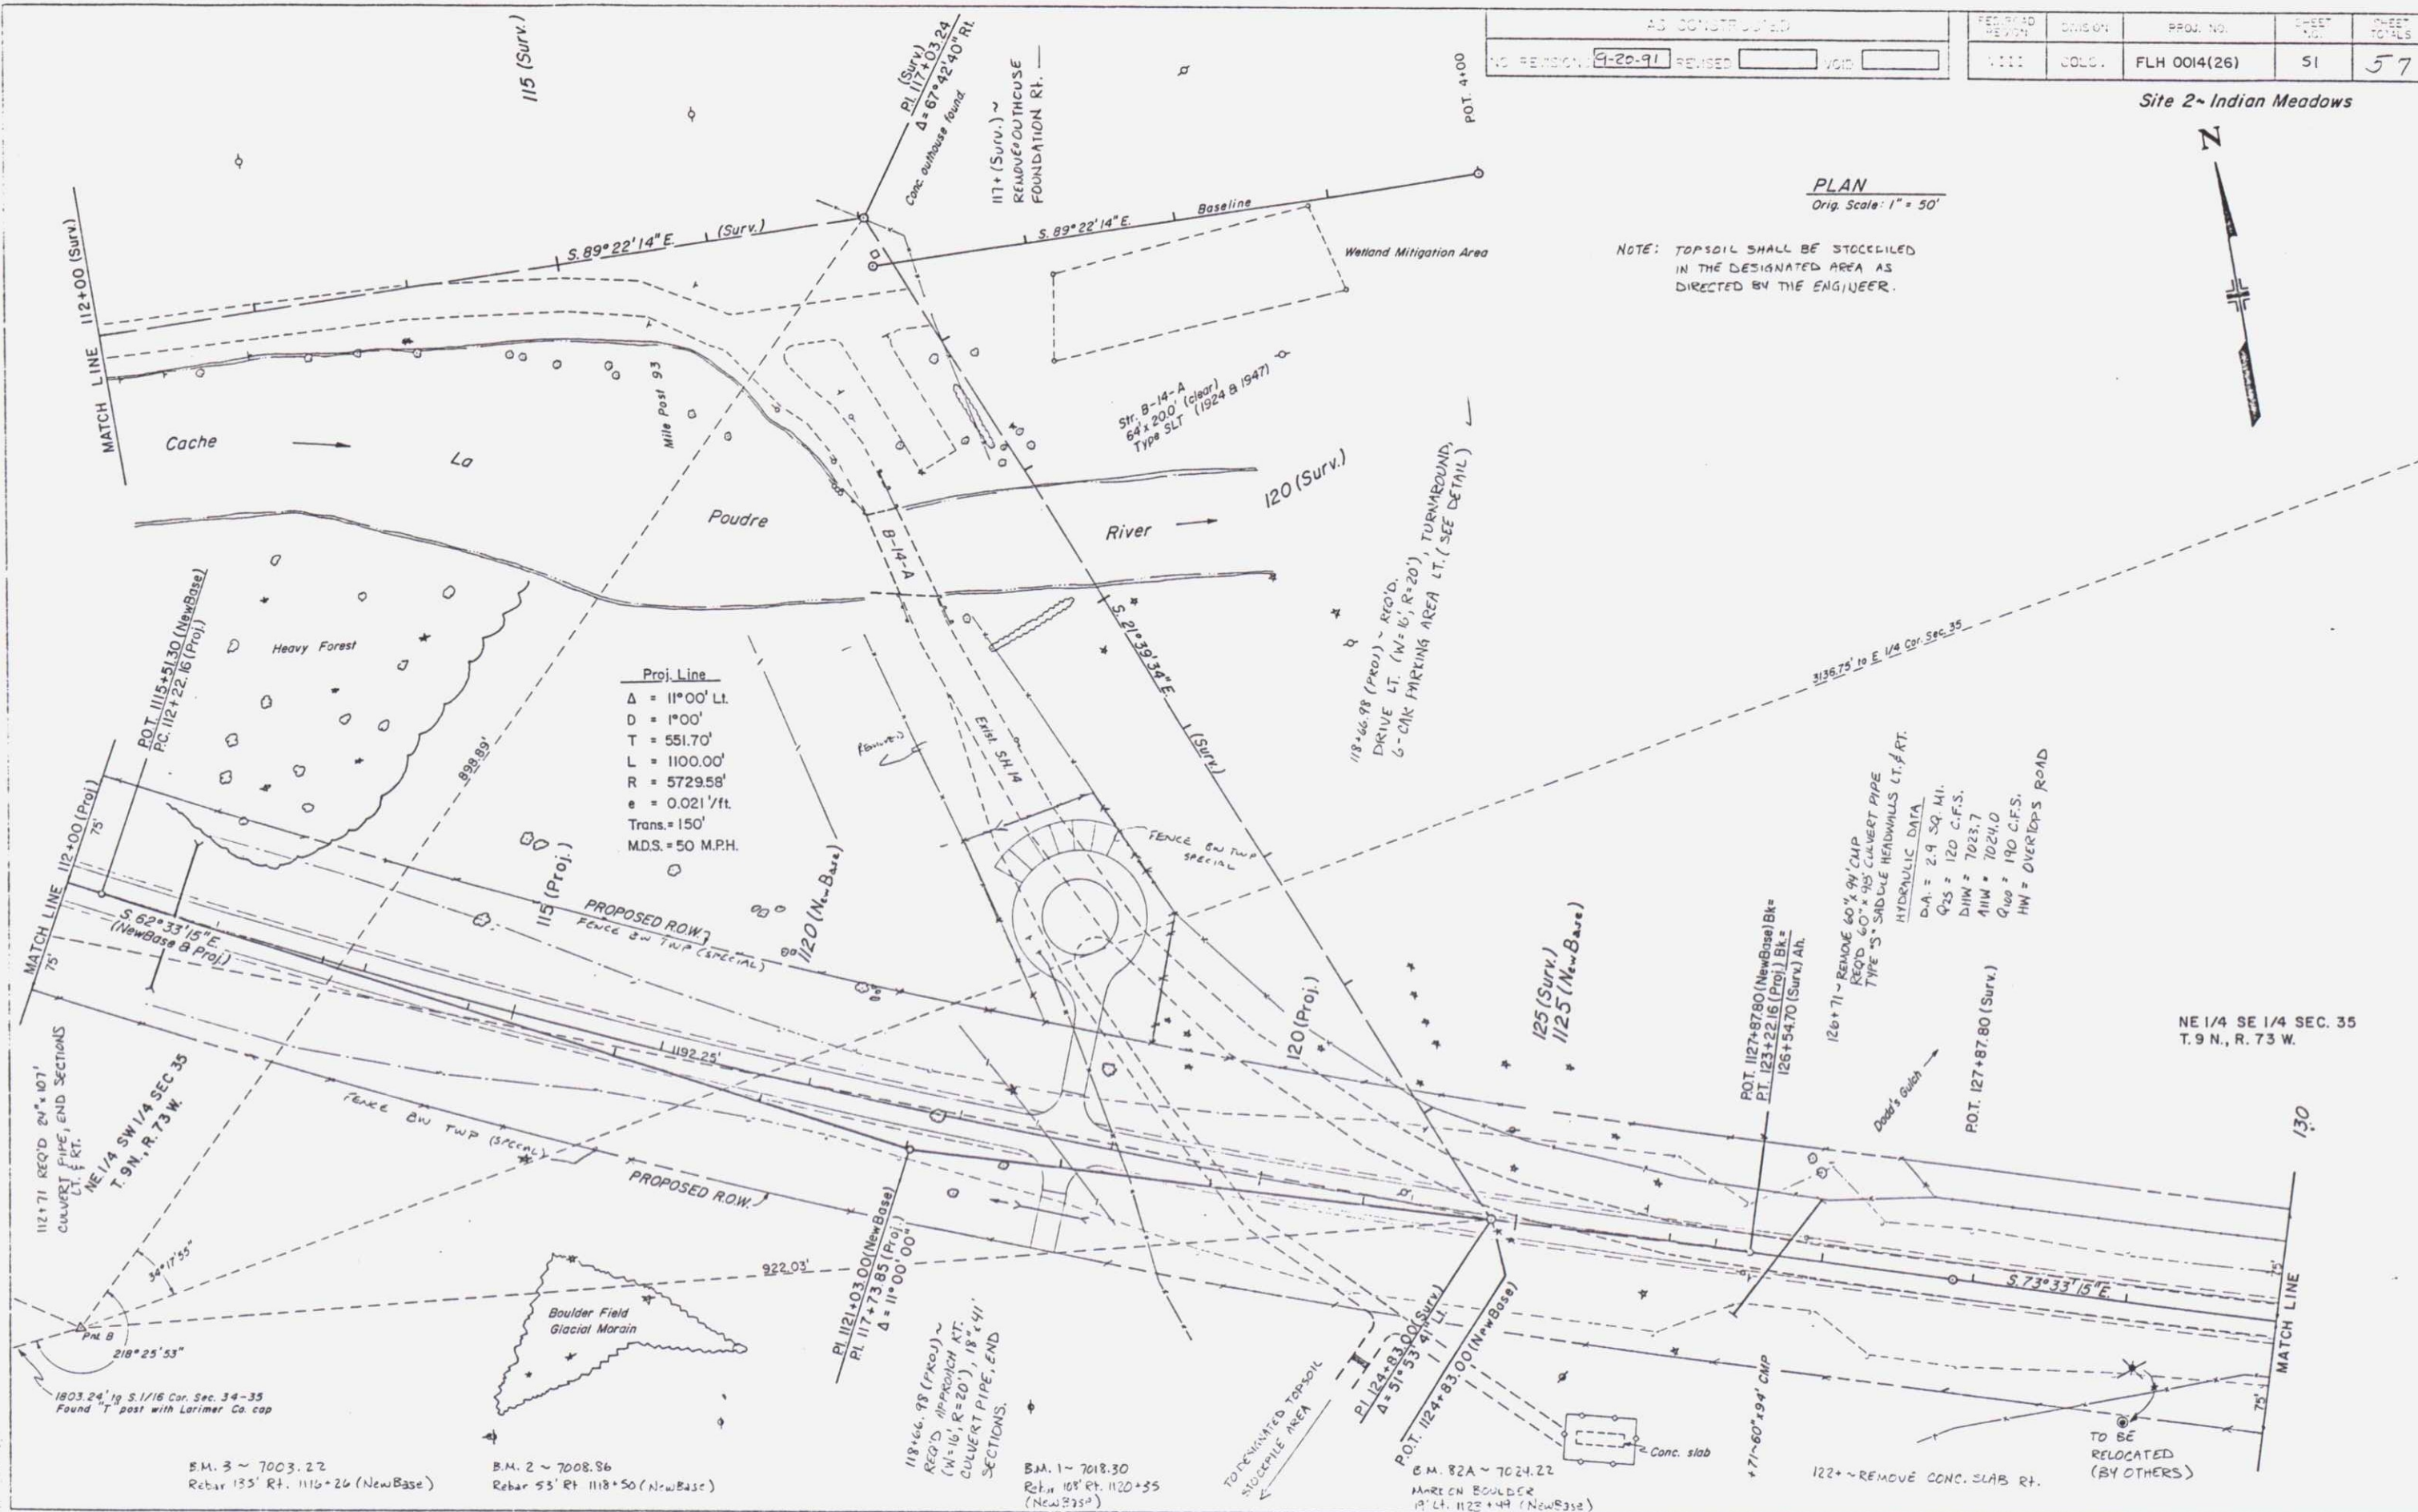


|                |         |         |
|----------------|---------|---------|
| AS CONSTRUCTED |         |         |
| NO REVISIONS   | 9-20-91 | REVISED |
|                |         | VOID    |

| SECTION | DIVISION | PROJECT NO.  | SHEET NO. | SHEET TOTALS |
|---------|----------|--------------|-----------|--------------|
| VIII    | COLO.    | FLH 0014(26) | 52        | 57           |

Site 2~Indian Meadows


PLAN  
Orig. Scale: 1" = 50'

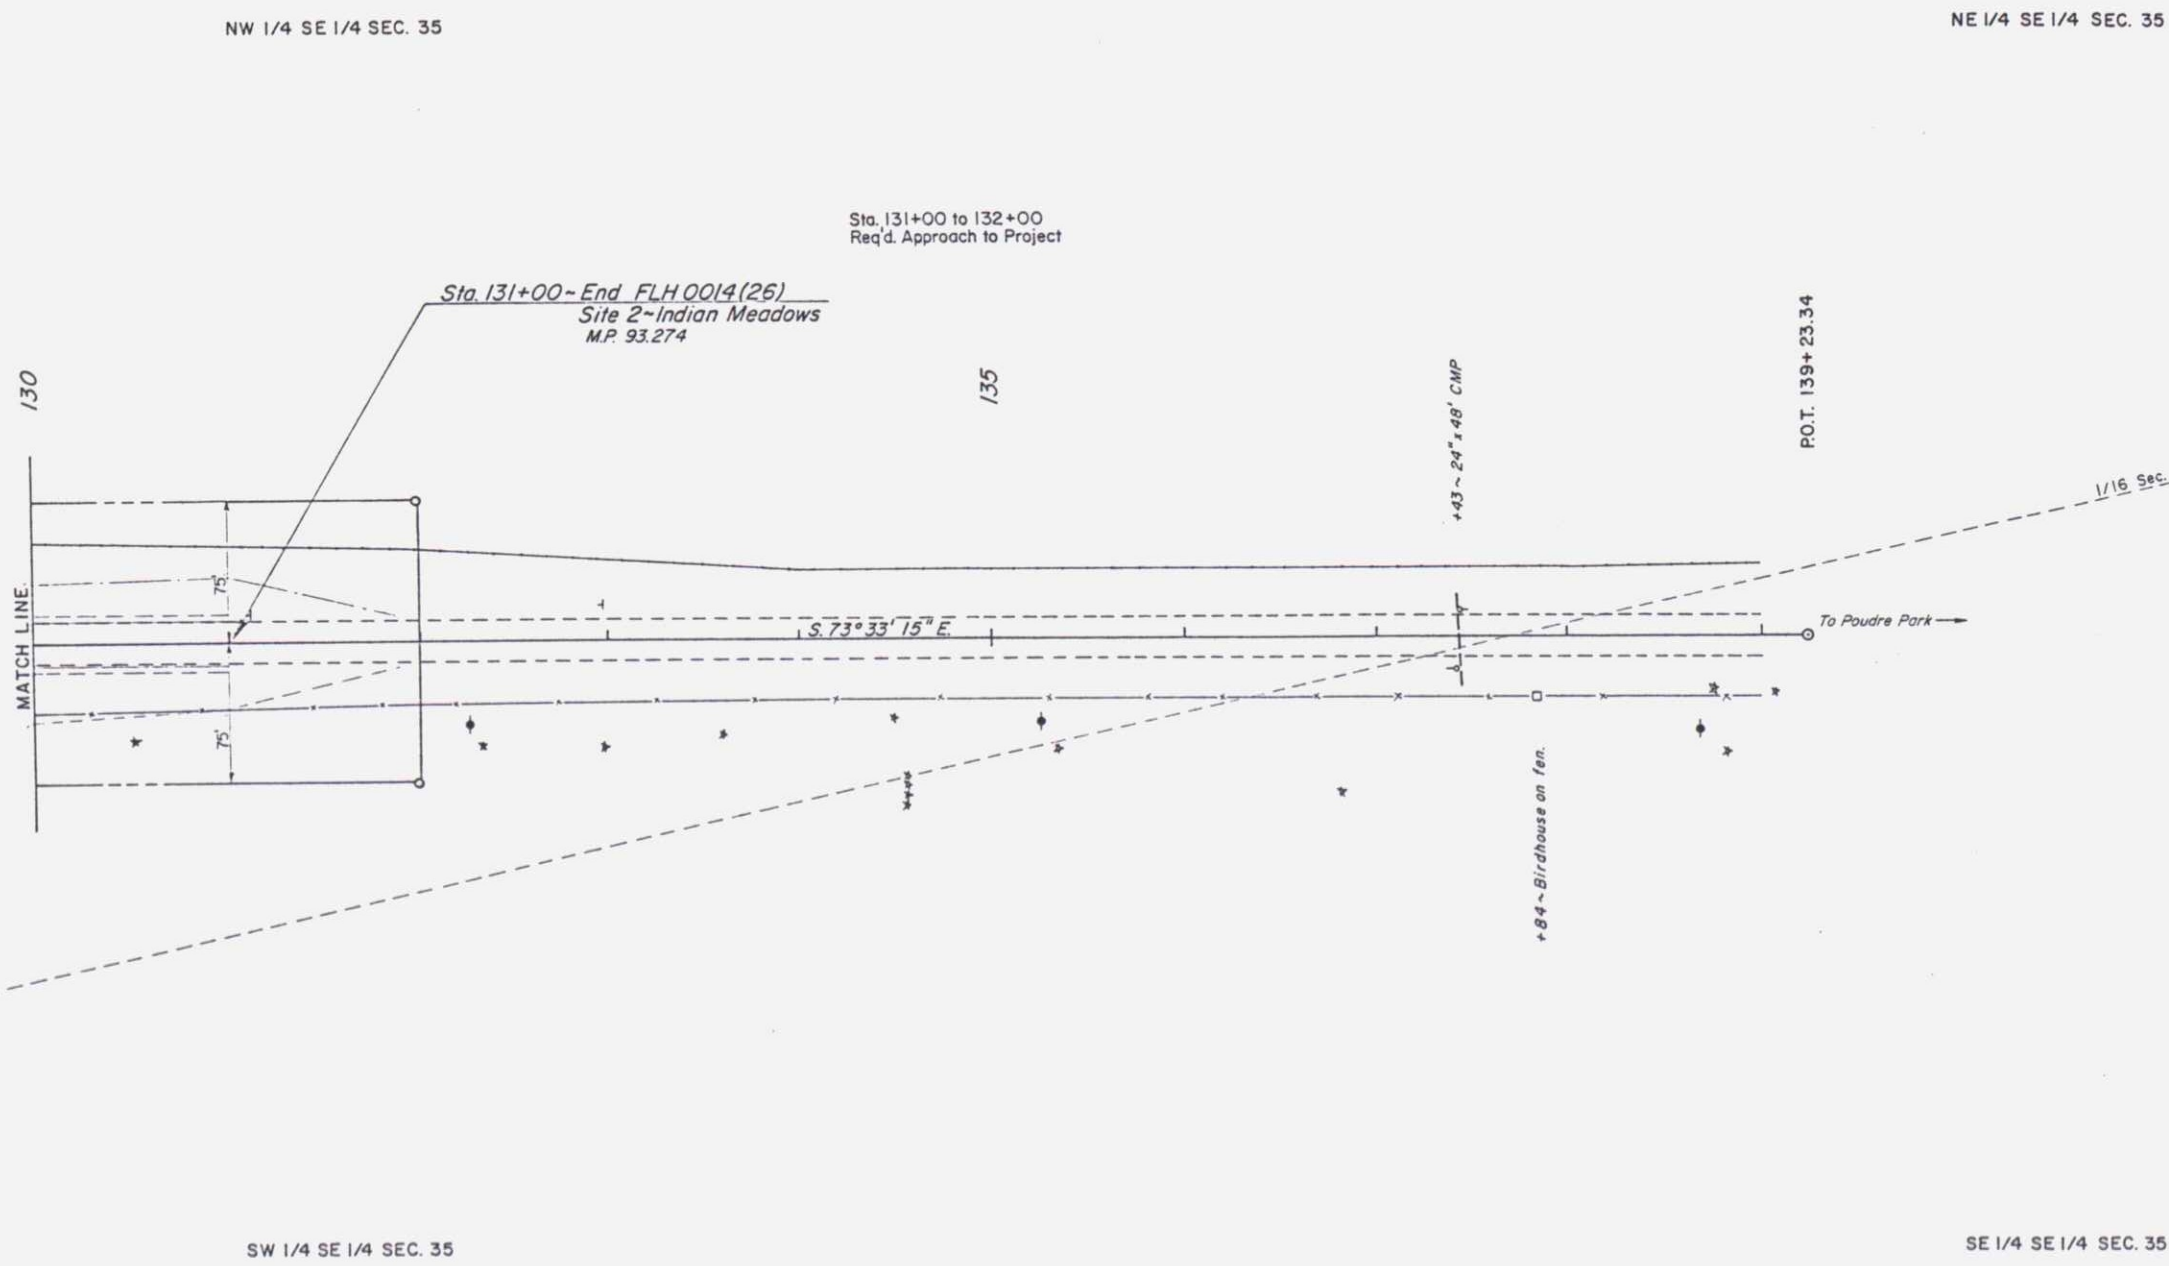

$\Delta = 22^{\circ}39'11''$  Lt.  
 $D = 16^{\circ}00'$   
 $T = 71.73'$   
 $L = 141.58'$   
 $R = 358.10'$   
 $e = 0.074$  1/ft.  
 $\text{Trans.} = 150'$   
 $\text{M.D.S.} = 30 \text{ M.P.H.}$   
 $\text{S.S.D.} = 321'$

Sta. 111+00 to 112+00  
Req'd. Approach to Project

Sta. 104+00 to 105+00  
Req'd. Approach to Project

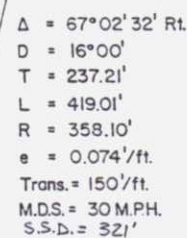

STA. 107+ ~ REQ'D.  
16' x 8' x 87' CBC; HEADWALLS  
& WINGWALLS LT. & RT.  
(SEE DETAILS)

STA. 1071 ~ REQ'D.

$\Delta = 31^{\circ}24'13''$   
 $D = 16^{\circ}00'$   
 $T = 100.67'$   
 $L = 196.27'$   
 $R = 358.10'$   
 $e = 0.074' / \text{ft.}$   
 $\text{Trans.} = 150'$   
 $\text{M.D.S.} = 30 \text{ M.P.H.}$   
 $\text{S.S.D.} = 321'$

B.M. 3 El. 6485.76  
Rebar Rt. Sta. 1114

