


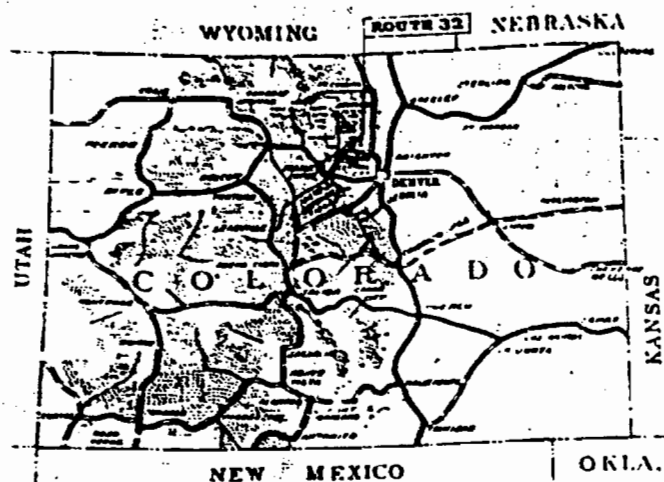


UNITED STATES DEPARTMENT OF AGRICULTURE BUREAU OF PUBLIC ROADS

AS CONSTRUCTED PROJECT 32-C-7 ROUTE 32 BERTHOUD PASS HIGHWAY EMPIRE TO FRASER 30 MILES CLASS 1 COLORADO FOREST HIGHWAY SYSTEM ARAPAHO & PIKE NATIONAL FORESTS CLEAR CREEK & GRAND COUNTIES COLORADO

DIST.	STATE	ROUTE NO.	SECTION	SHEET NO.	TOTAL
3	COLO.	32	C-7	1	1

INDEX TO SHEETS		
SHEET NO.	DESCRIPTION	STATIONING
1	Title Sheet	1-24
2	Typical Sections	
3	Summary	
24-29	Plan & Profile	640-00 750-00
30	Deep Inlets	
Rev. 03-STD-117	Std. Cross Masonry Retain.	
- 129	- Mason. Structures	
- 131	- Maint. Posts & Ref. Plan.	
- 135	- Barbed Wire Fence	
Rev. 03-SP-261	Comp. Box Culv.	
03-STD-143	Typical Signs for Use on Campsr.	
1-20	Cross Sections	640-00 750-00

Federal Aid Highway System
Primary
Secondary
Forest Highway System
National Forests

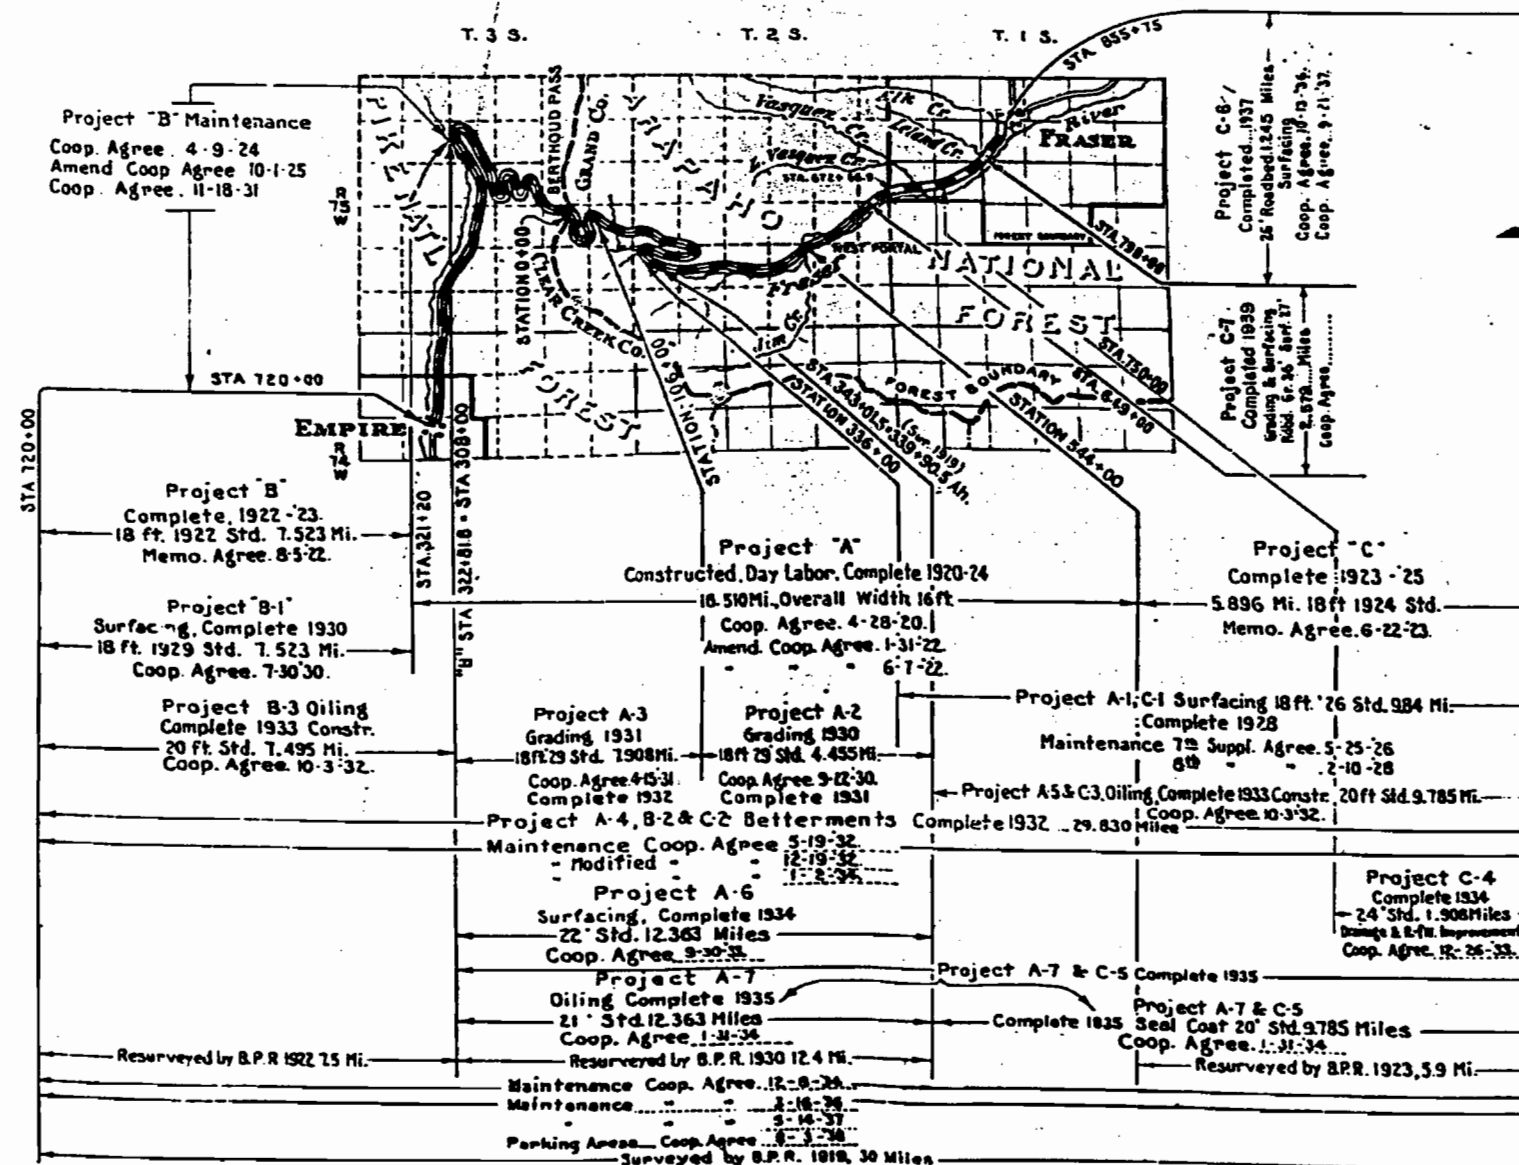

APPROVED _____ DATE _____ 9

ACTING DISTRICT ENGINEER
U.S. BUREAU OF PUBLIC ROADS


APPROVED _____ DATE _____ 10

REGIONAL FORESTER
U.S. FOREST SERVICE

APPROVED _____ DATE _____ 11

STATE HIGHWAY ENGINEER
STATE OF COLORADO


INDEX MAP

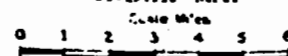


LEGEND

TYPE	SYMBOL	TYPE	SYMBOL	TYPE	SYMBOL	TYPE	SYMBOL
ROAD	—	RAILROAD	—	RAILROAD	—	RAILROAD	—
RAILROAD	—	RAILROAD	—	RAILROAD	—	RAILROAD	—
RAILROAD	—	RAILROAD	—	RAILROAD	—	RAILROAD	—
RAILROAD	—	RAILROAD	—	RAILROAD	—	RAILROAD	—

Drawn & Traced A.M.C. 1-38

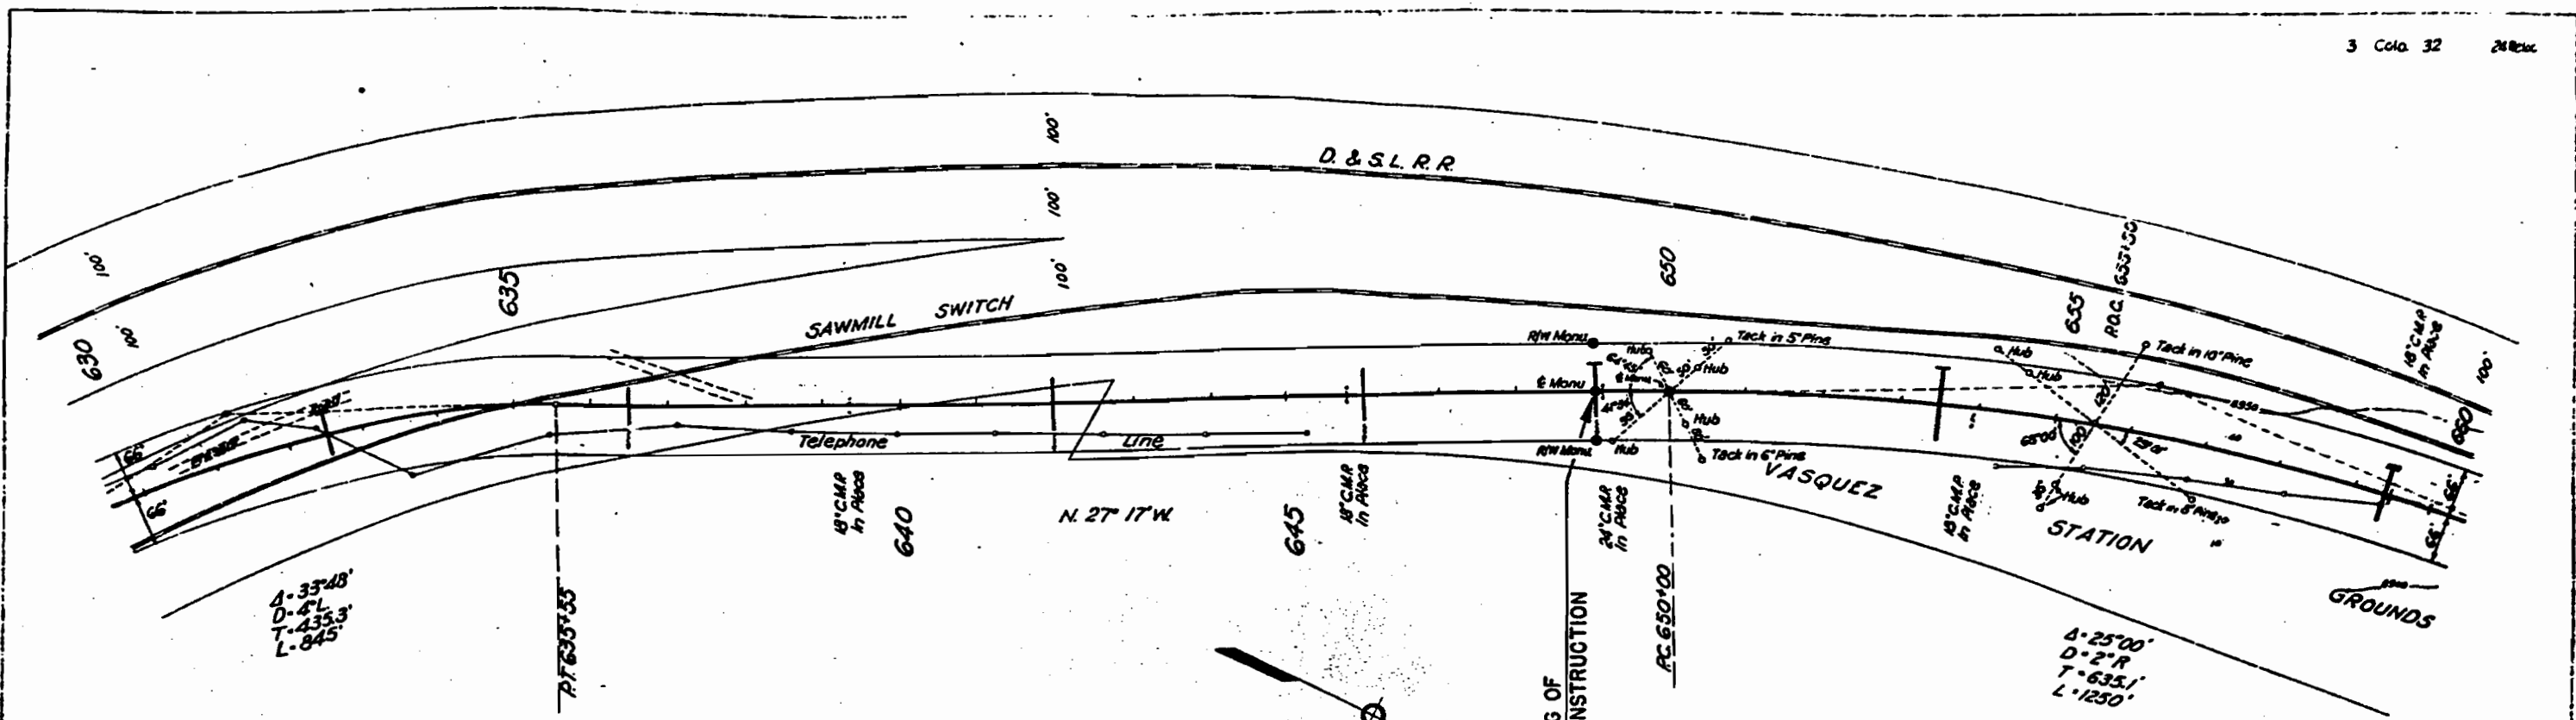


The Alignment and Grade as hereon shown are subject to adjustment

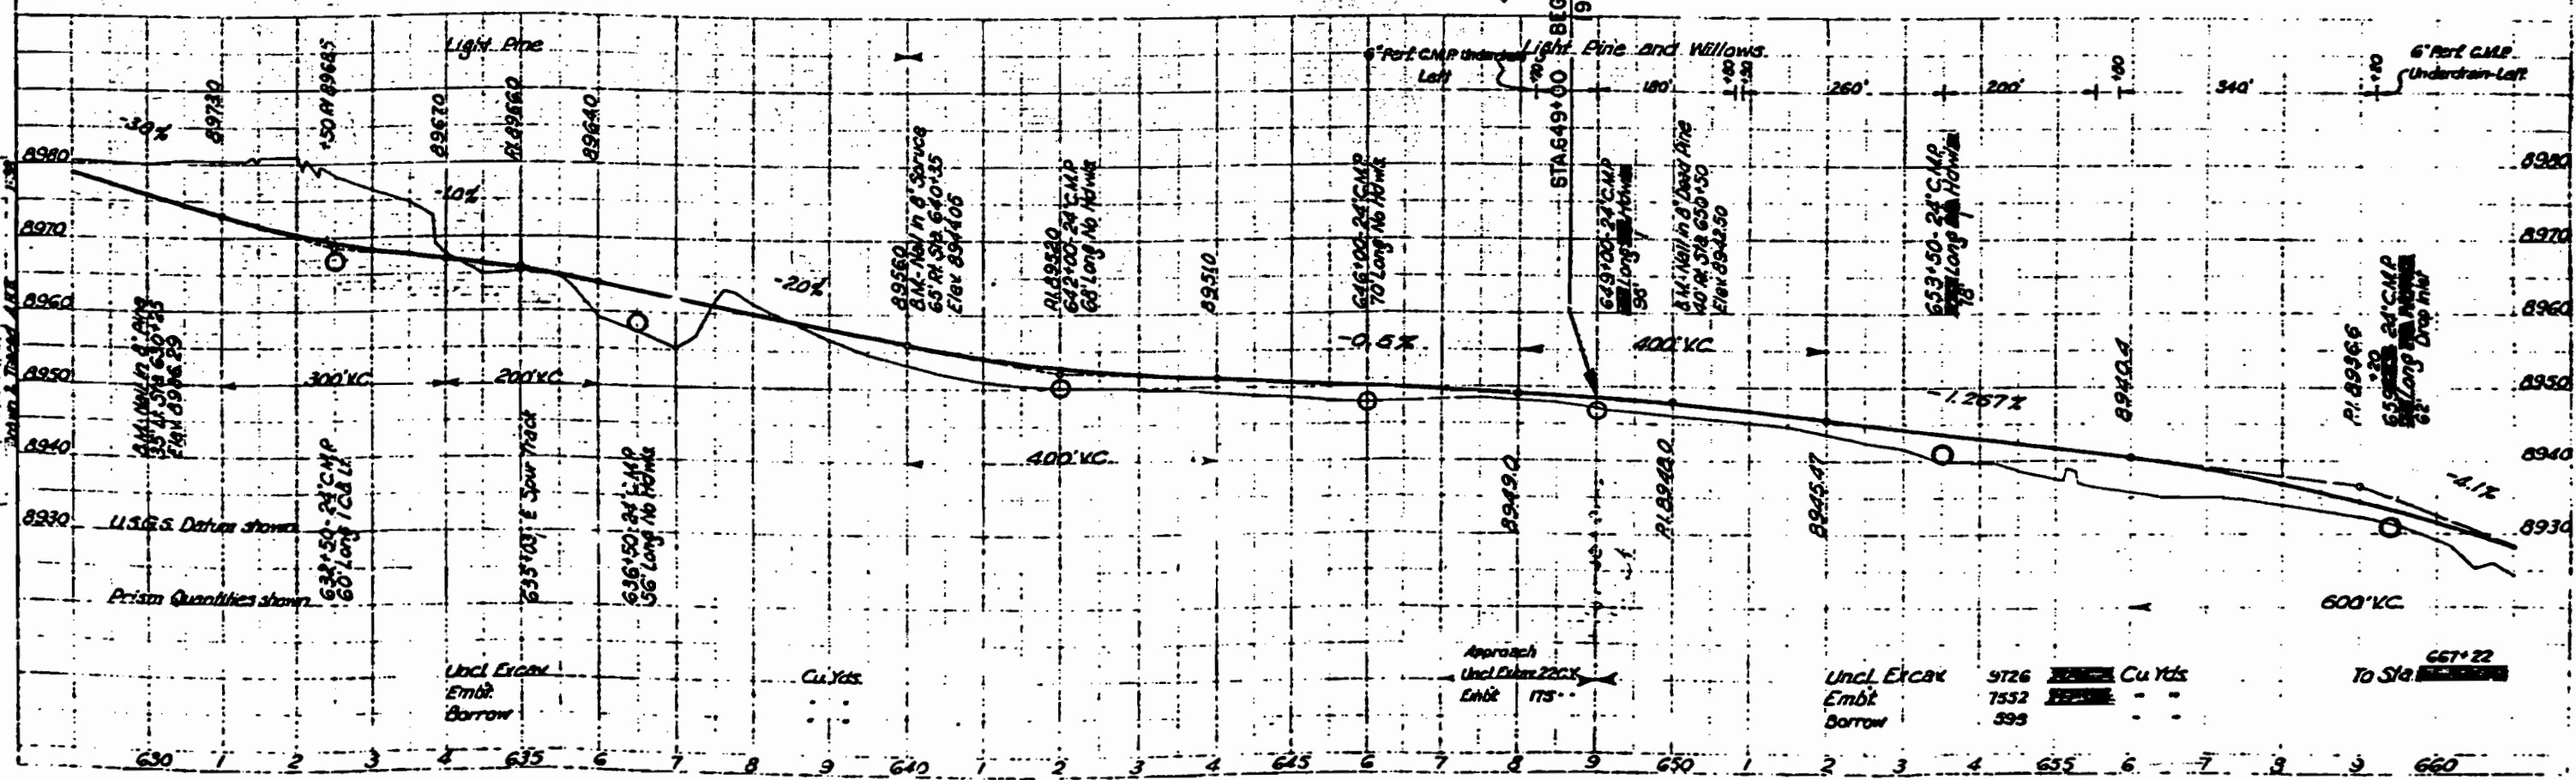


Sheet No. 25 of 26
 The 660+00 to 690+00
 Sheet No. 25 of 26



Scale
 1" = 100'
 1" = 100'

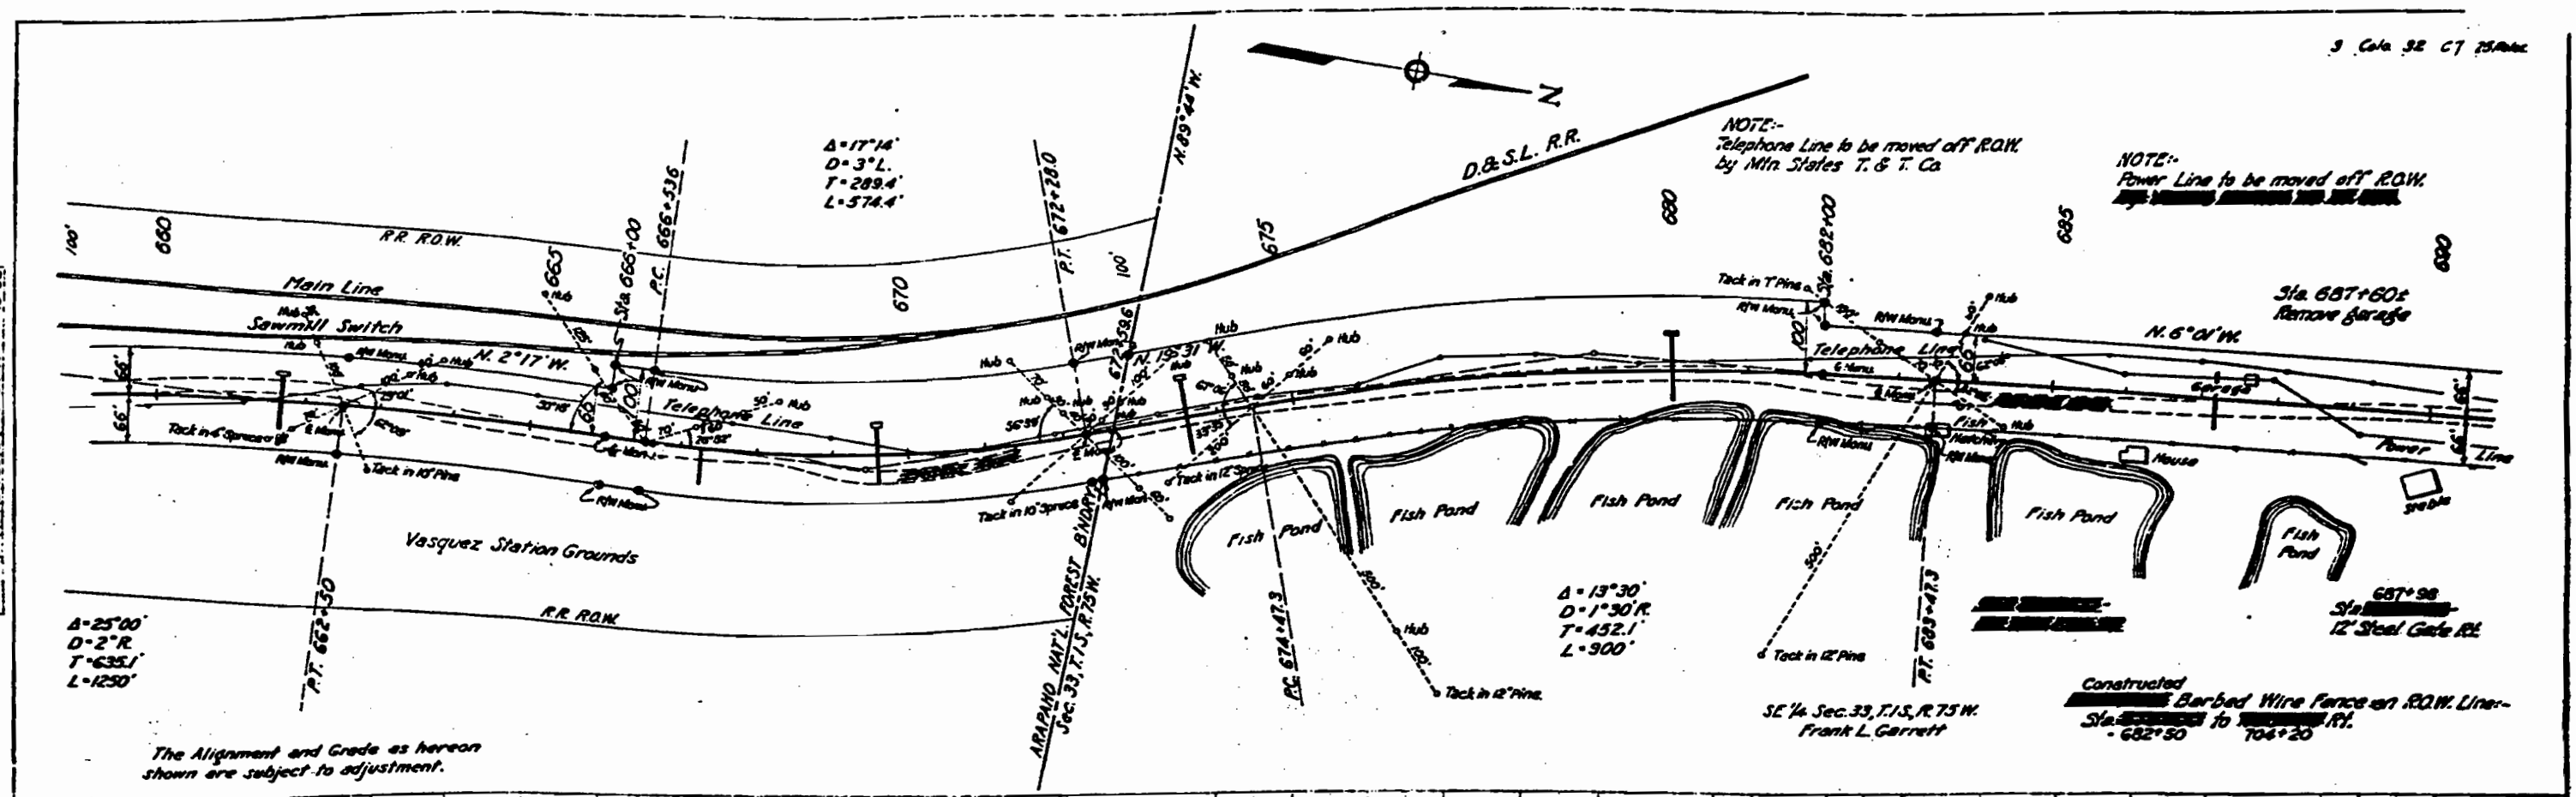

The Alignment and Grade as hereon shown are subject to adjustment.

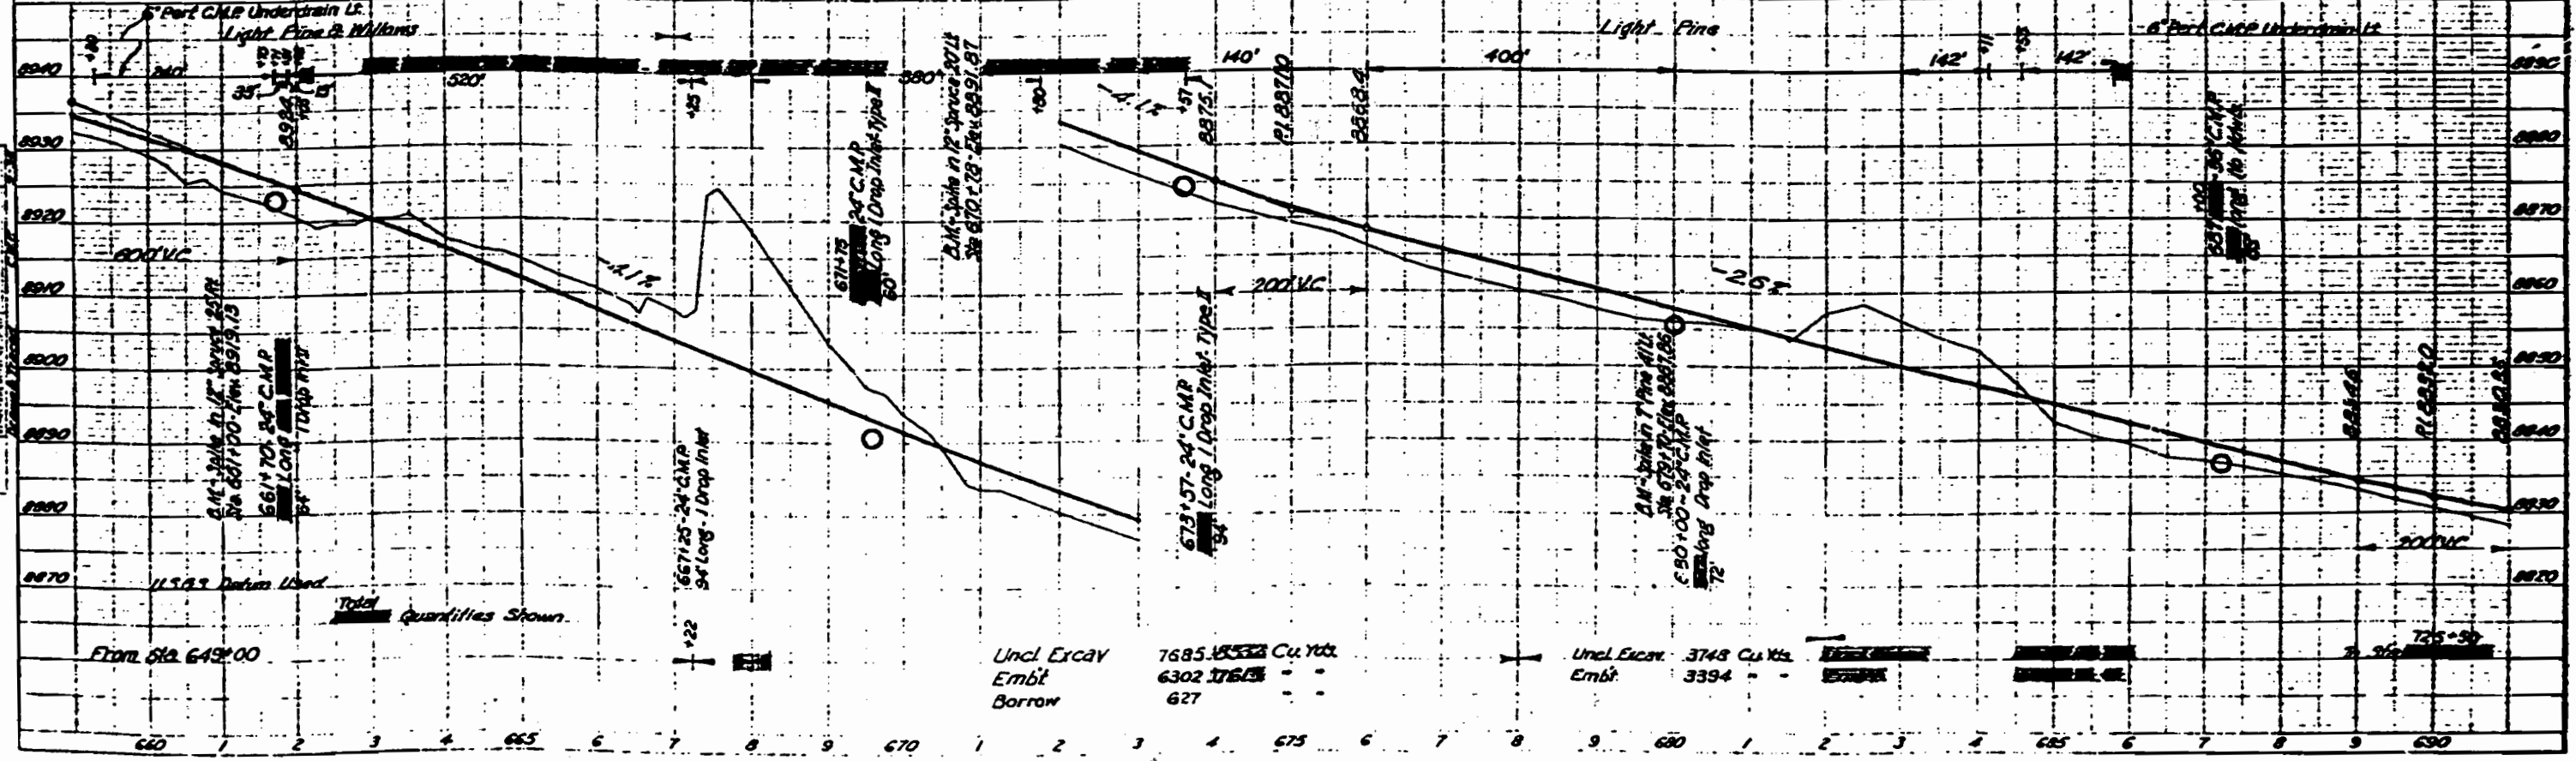

1937 Berthoud Pass Colo. 32
Sta 720+00 to Sta 750+00
Sheet No. 27 Reloc.
S.A.W.
C.M.P.
9-38

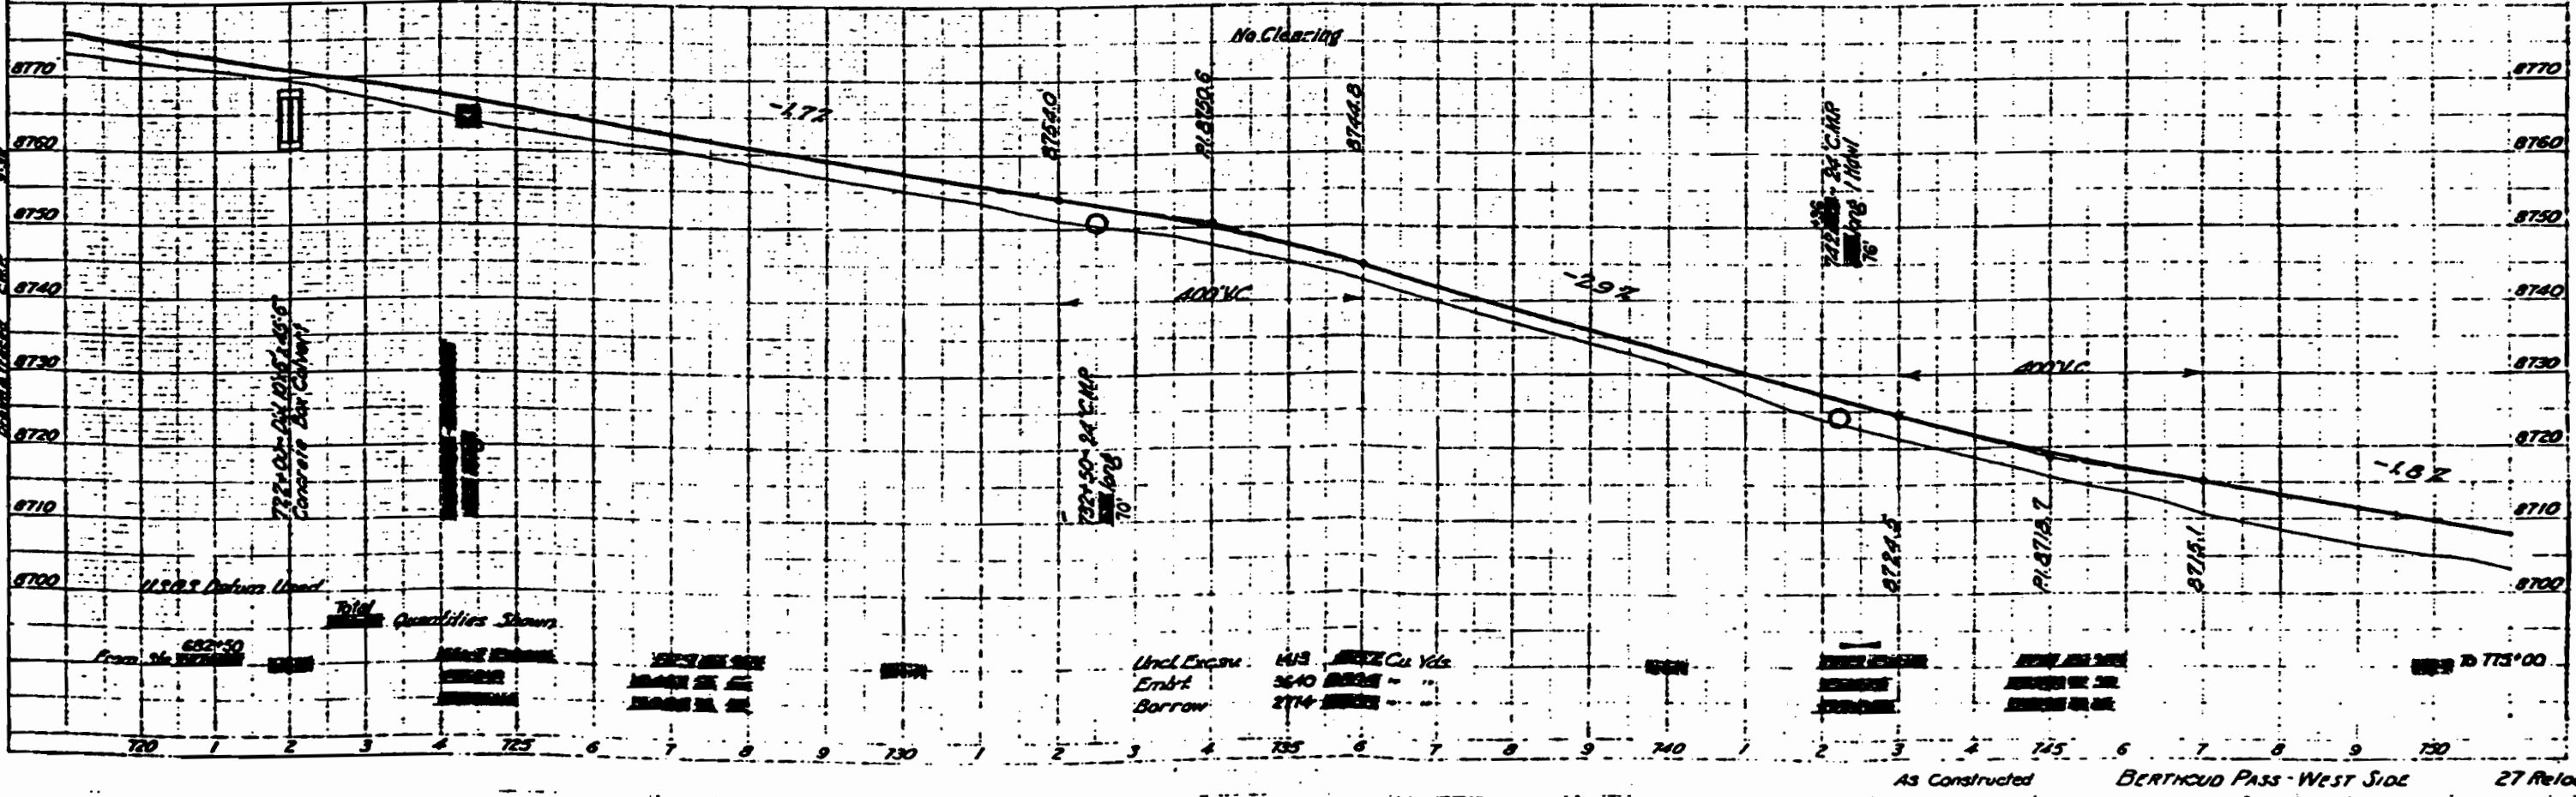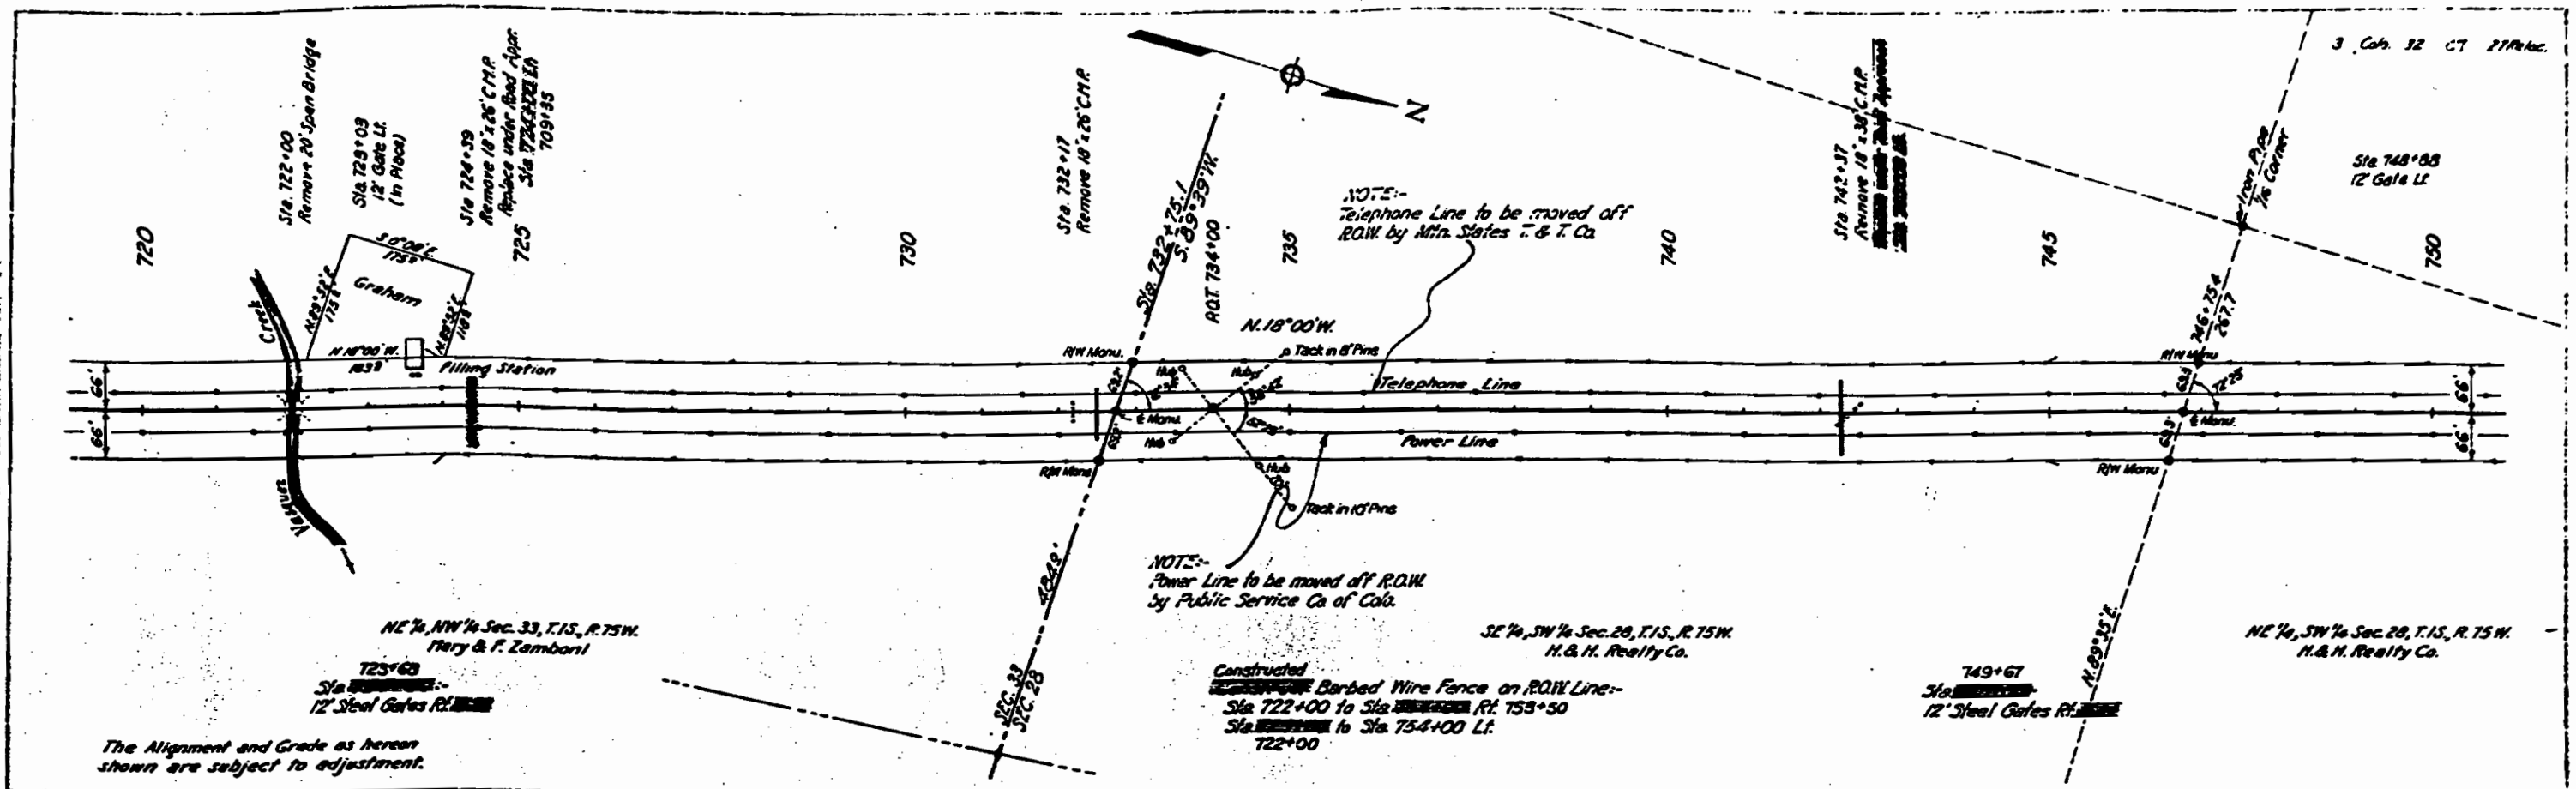

Berthold Pass, C&N 32
Sta 780+00 to Sta 790+00
Sheet No. 29 Relec.

PLAN
Scale
1" = 100'
North Arrow
A.M.S.
Down & Right

PROFILE
Scale
1" = 10'
Vertical Curve
A.M.S.
Down & Right

