WYOMING ROUTE 32 NEBRASKA		
D D D D D D D D D D D D D D D D D D D		
NEW MEXICO OKLA.		
Peccent A.a risphway system (Secondary — forced Highway System — Secondary — Selandar Arrests —		

UNITED STATES DEPARTMENT OF AGRICULTURE BUREAU OF PUBLIC ROADS

PLANS FOR PROPOSED PROJECT 32 LANDSCAPING ROUTE 32 BERTHOUD PASS HIGHWAY EMPIRE TO FRASER 30 MILES CLASS 1

COLORADO FOREST HIGHWAY SYSTEM

ARAPAHO & PIKE NATIONAL FORESTS CLEAR CREEK & GRAND COUNTIES COLORADO

T. 3 S.


CAHEEL AL

INDEX TO SHEETS			
5-77.5		STATION DOWN	
,	Tille sheet	T	
•		1	
J	Sammary Flan Sheet	 	
	Flan Sheet	T	
_			

20 m) that '--- 1 of Street (men of 1417)

: 5010. 32 1

U.S. FOREST LAND MAP NATIONAL FOREST in CLEAR CREEK COUNTY

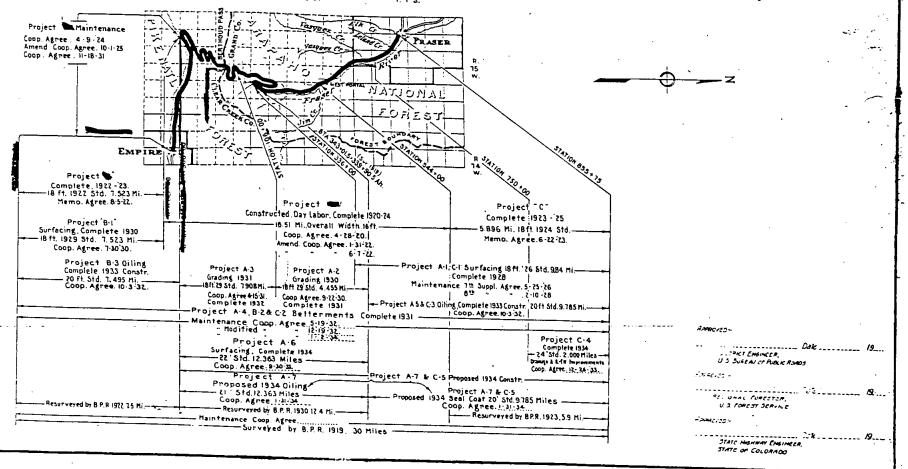

INDEX MAP 2 3 4 Approximate Surveyed | Existing | Grading (Gravel, Broken) | Paring Road


60


887


13


(D)


() () (4)

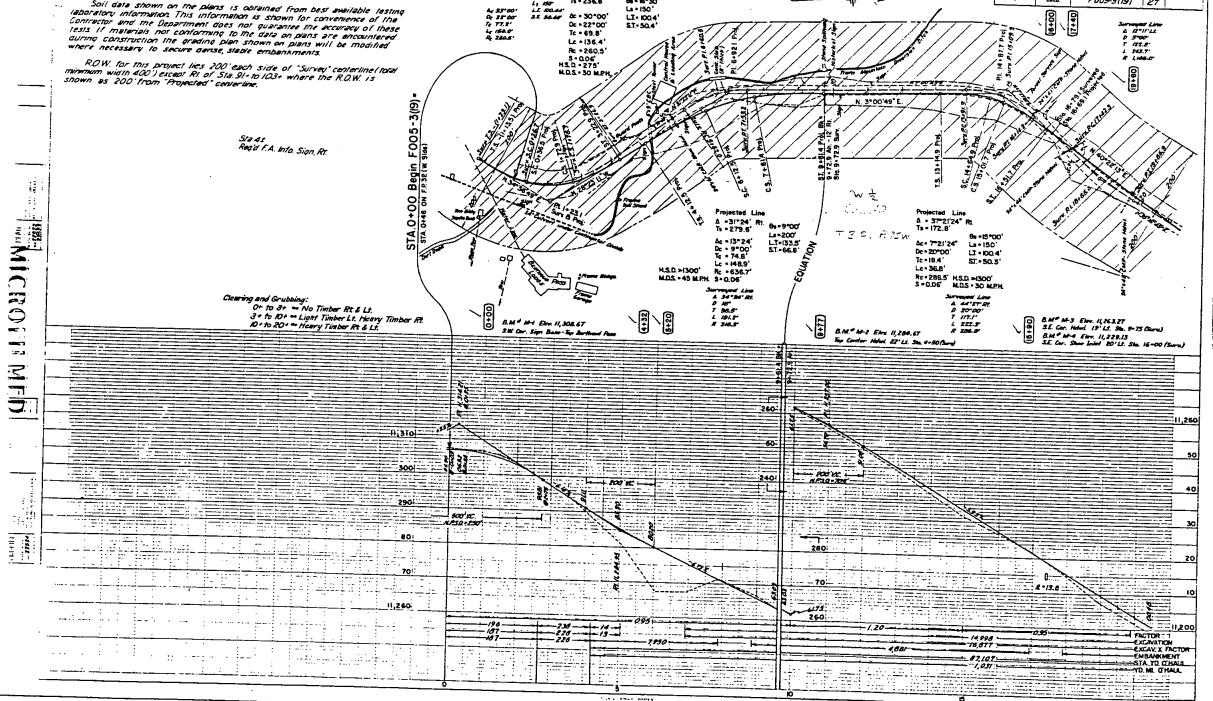


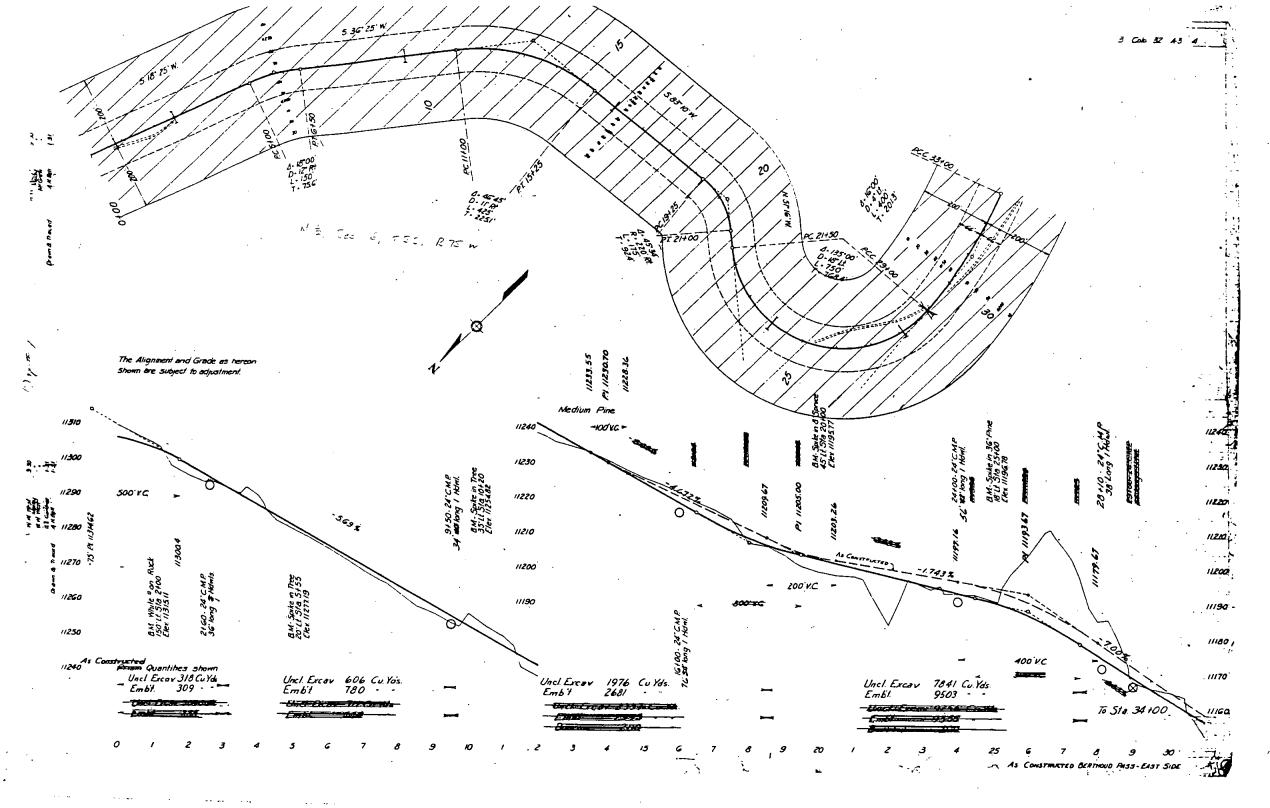


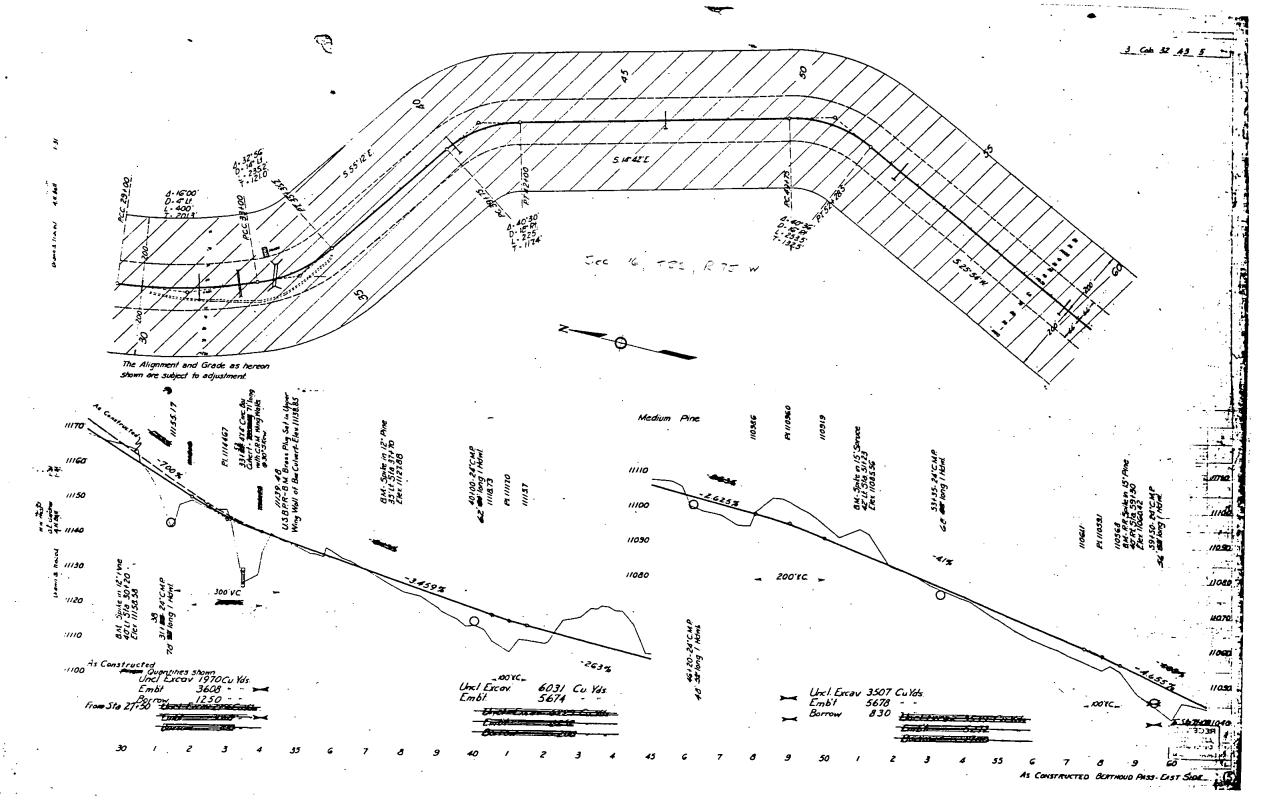


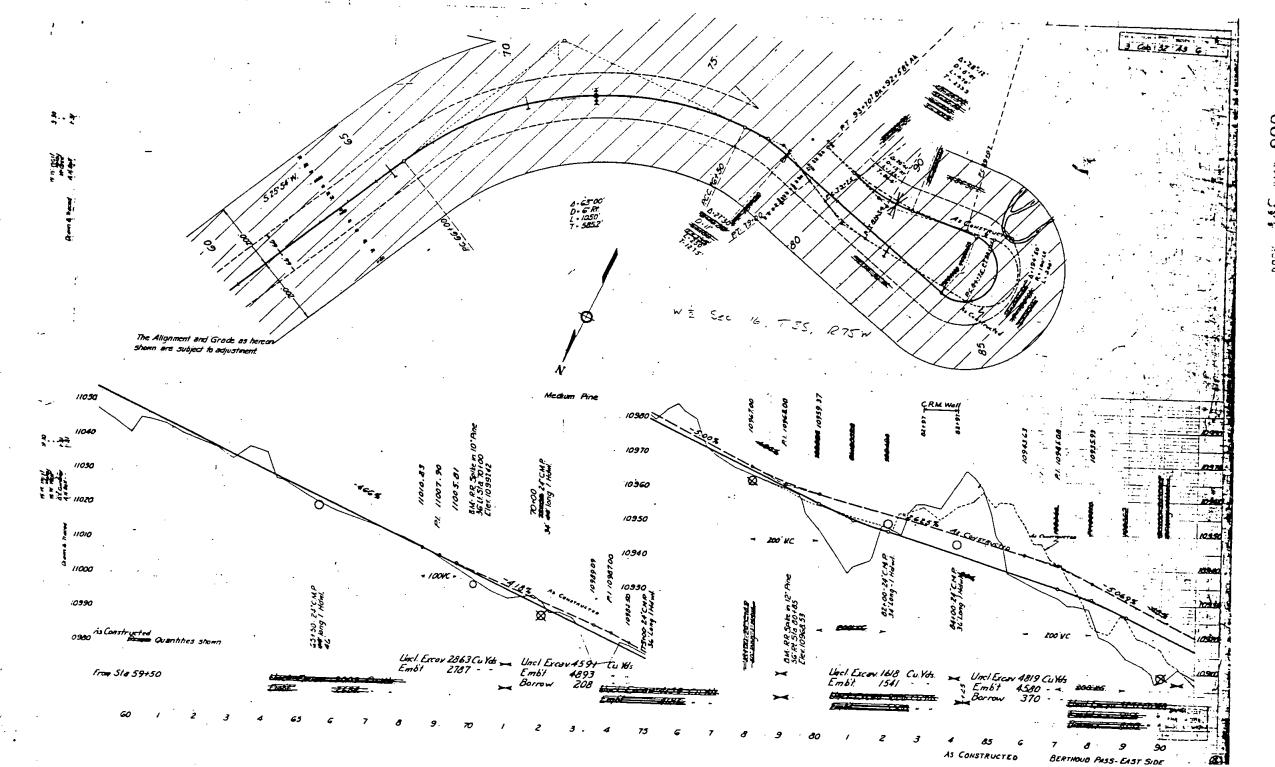


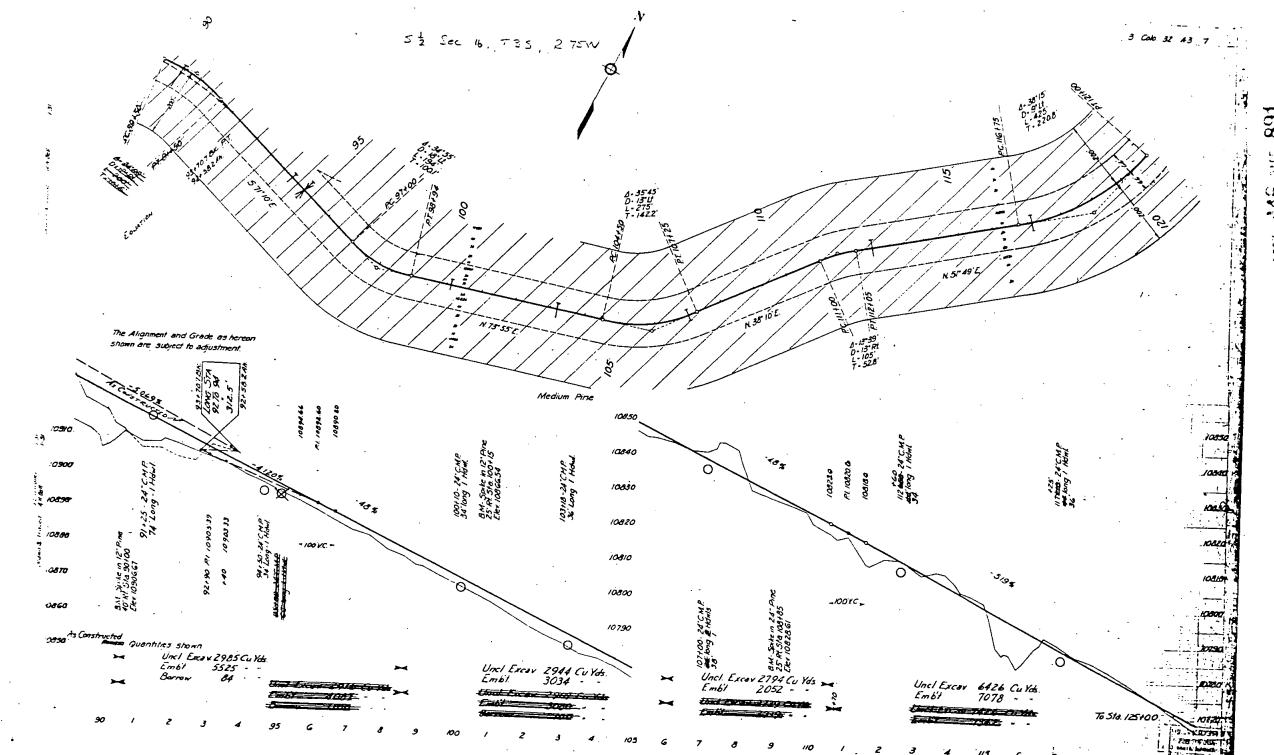


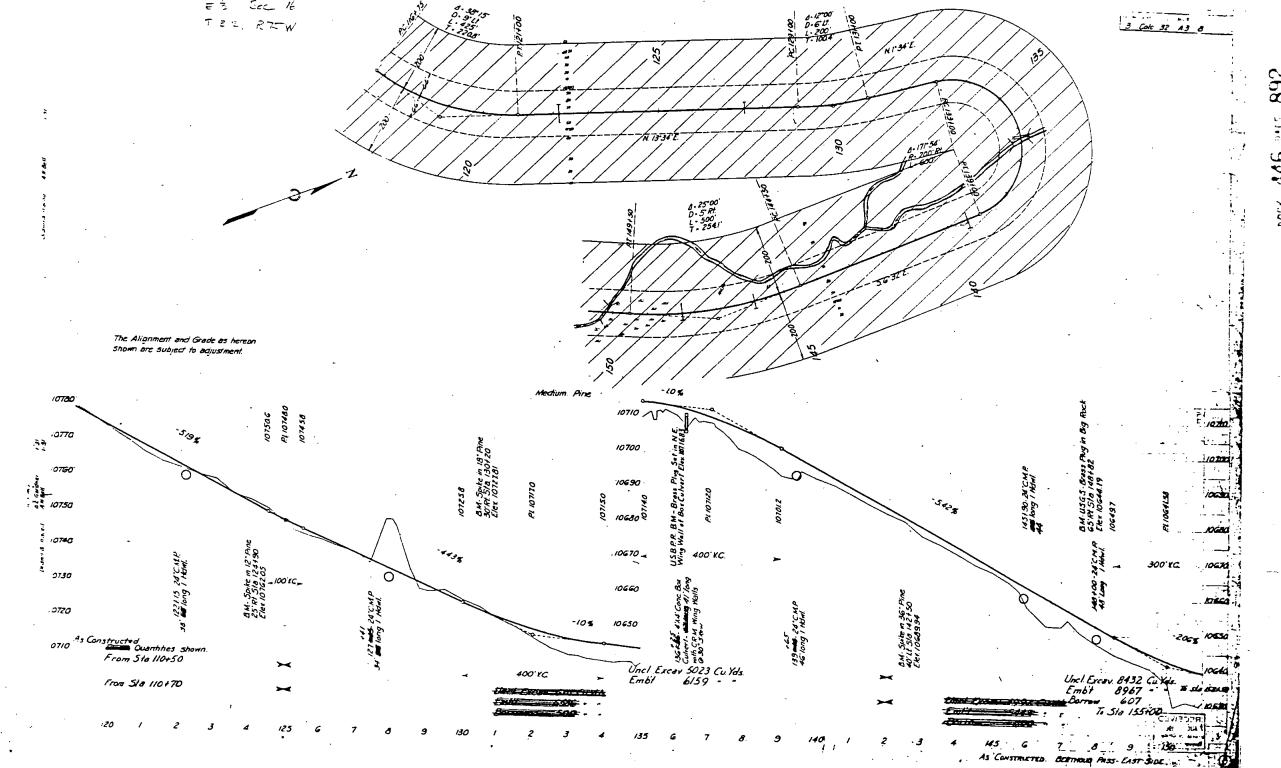


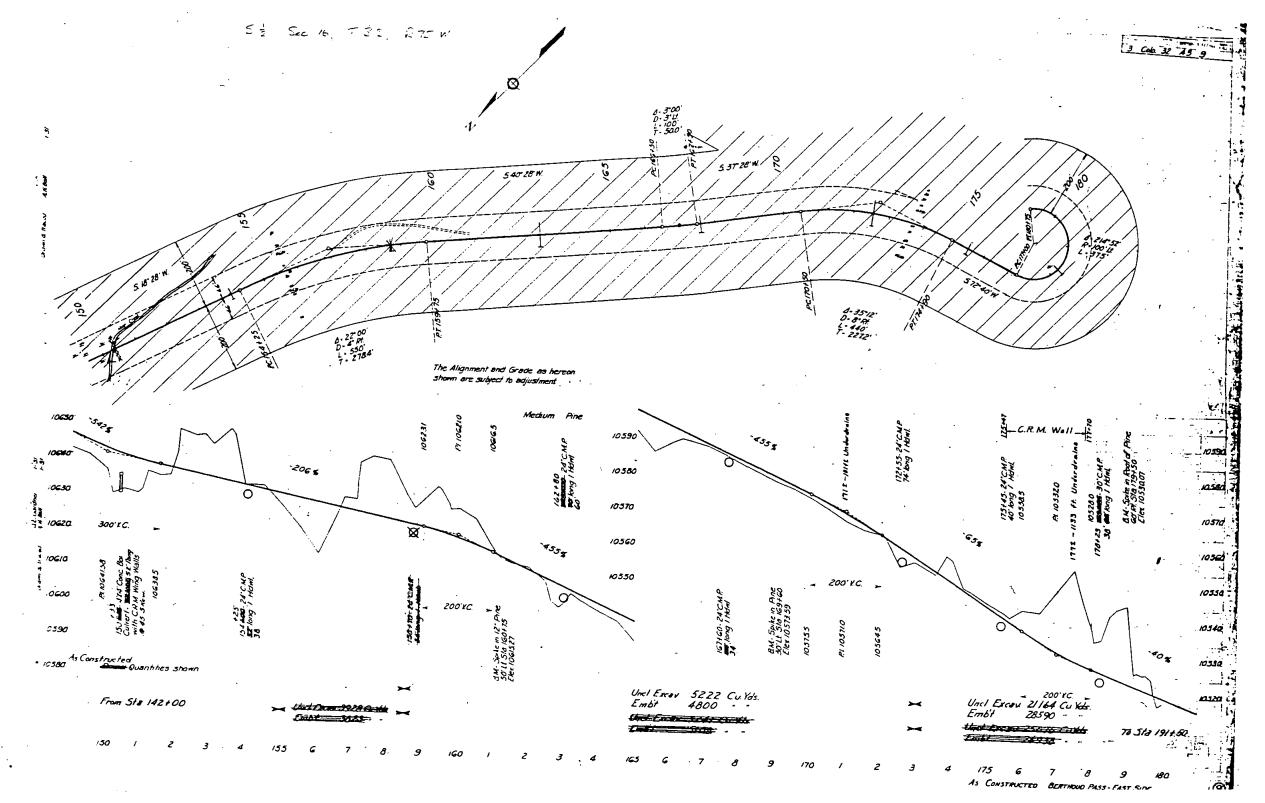


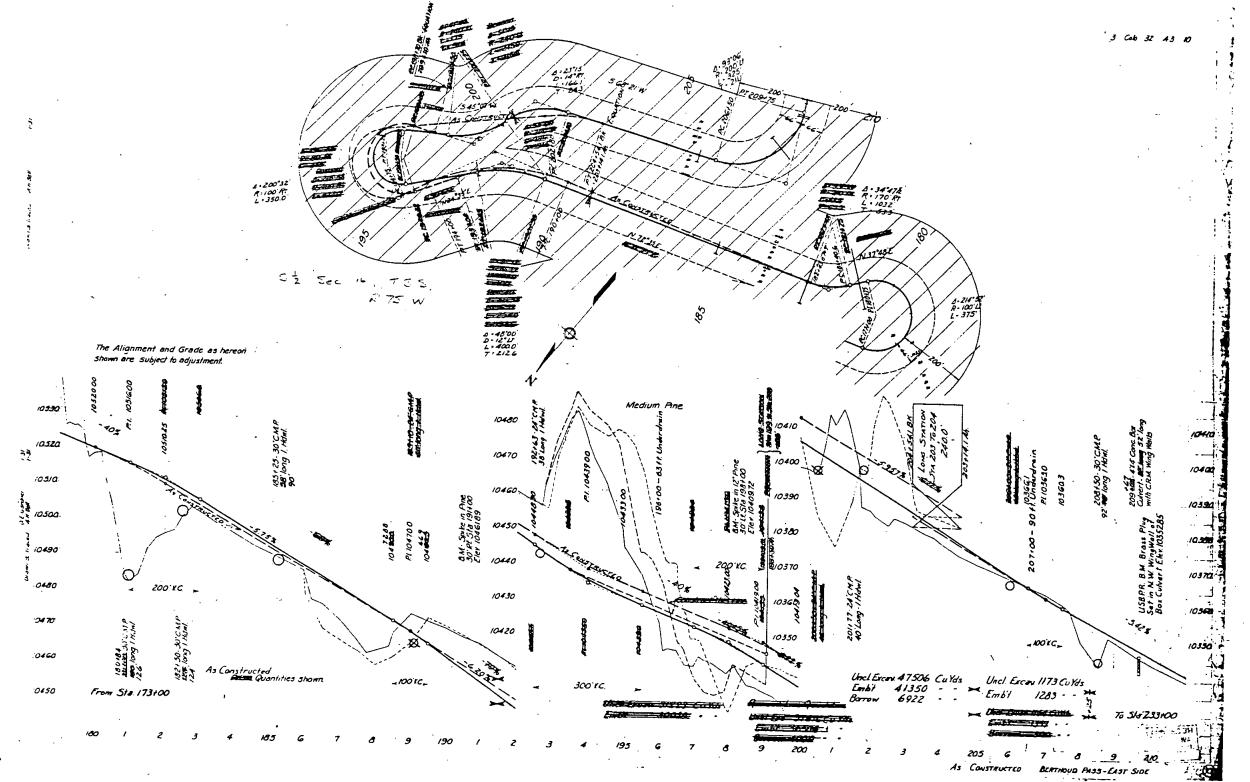


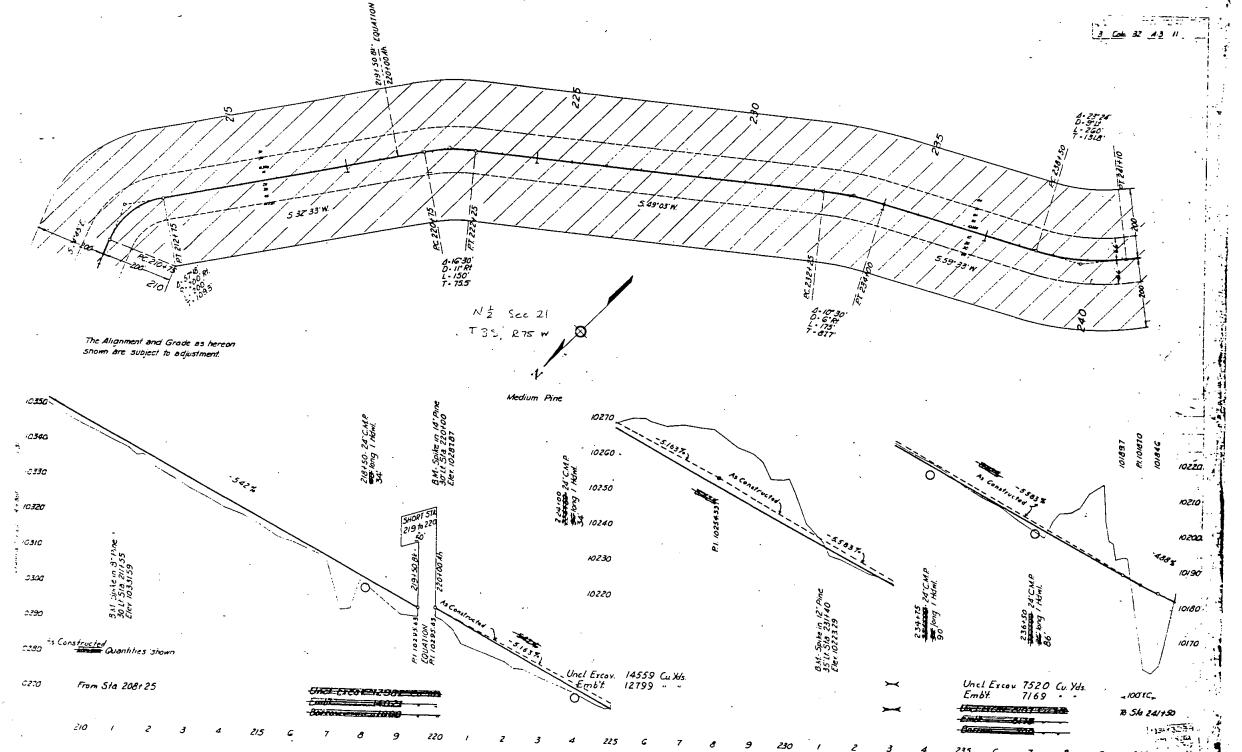

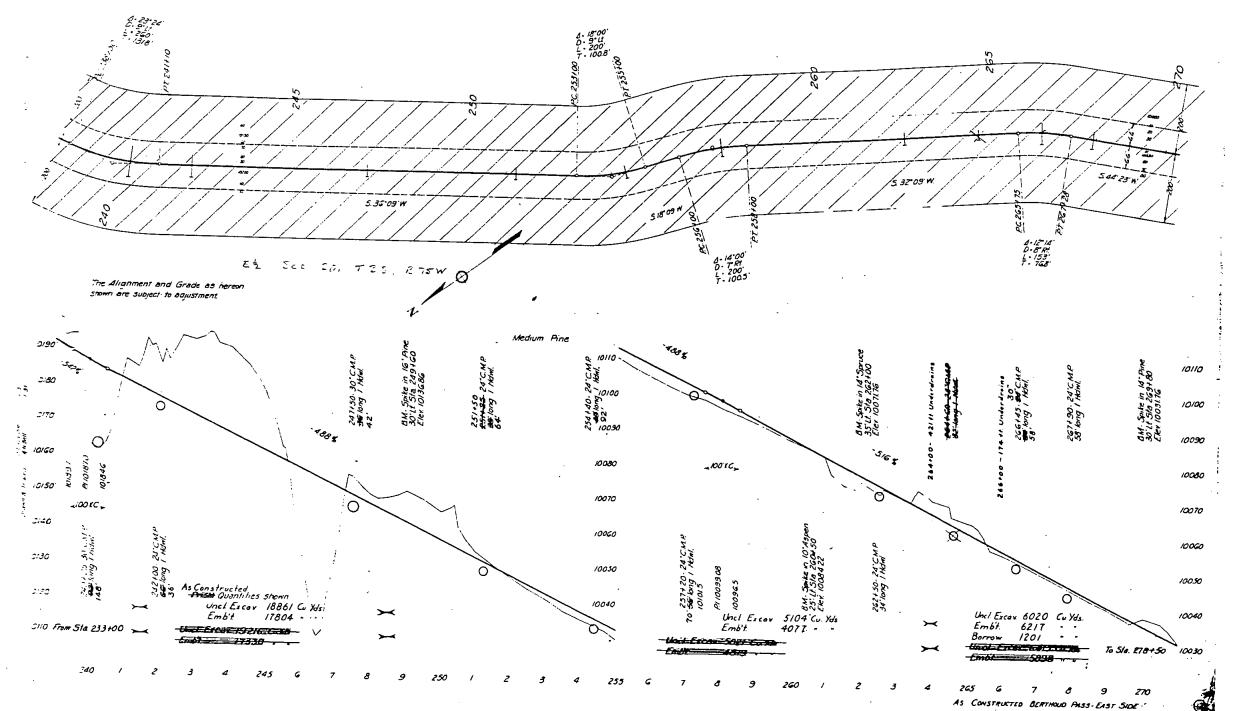

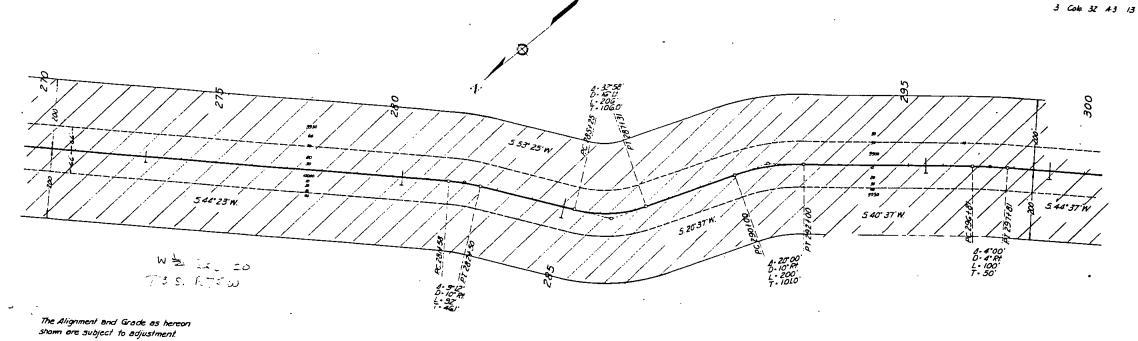

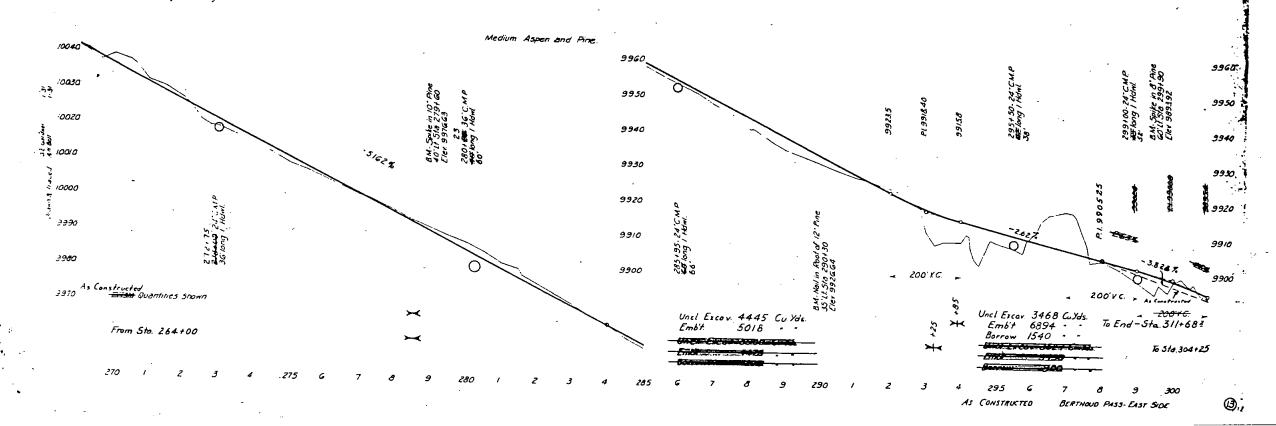

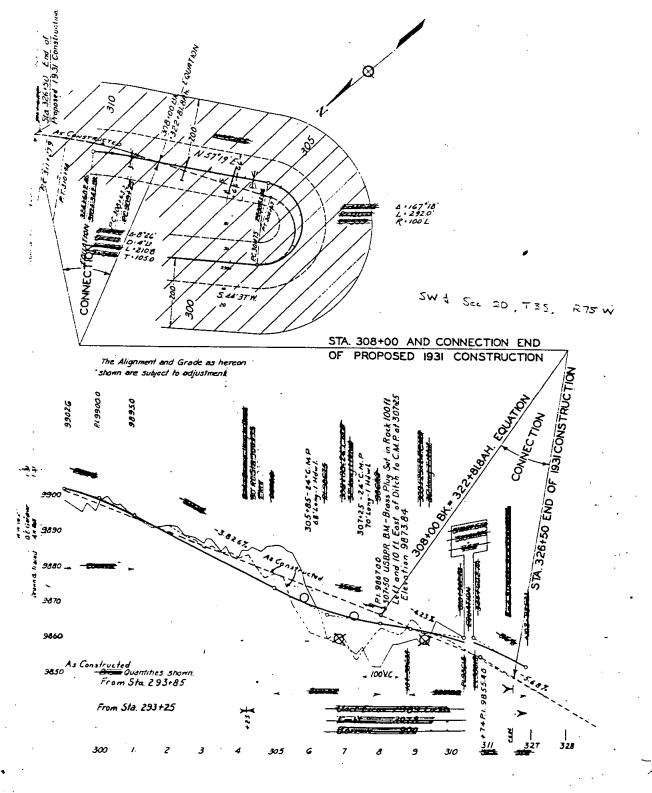

NOTE: ACTUAL GRADES ON PROJECT 32A-3 DIFFER FROM THOSE SHOWN AS AS CONSTRUCTED ON THESE PLANS. THIS DIFFERENCE IS CAUSED BY AN ADJUSTMENT OF B.M.S AFTER CONSTRUCTION WAS COMPLETED.

PERMANENT BENCH MARKS AS SHOWN ON THESE PLANS HAVE BEEN FINALLY ADJUSTED TO

U.S.G.S DATUM

.

AS CONSTRUCTED BERTHOUD PASS-EAST SIDE

