

U.S. West Communication — Telephone  
Citizen Utilities — Gas  
Southern Colorado — Electric  
Power Association

T. 24 S., R. 57 W.  
6th P.M.

AS CONSTRUCTED

NO REVISIONS ☐ REVISED ☐ VOID ☐

FEDERAL ROAD  
REGION NO.  
VIII

DIVISION  
COLORADO

|                     |
|---------------------|
| COMBINED PROJ. NOS. |
| FR OIO-1(19)        |
| BBF OIO-1(20)       |

SHEET NO.

RIGHT OF WAY


FOR INTERSECTION IMPROVEMENTS  
SEE "DETAIL OF INTERSECTION"

## REVISIONS

CHARLES M. ALLISON  
JEAN ALLISON MELVILLE  
515 AMERICAN NAT'L BANK BLDG  
DENVER CO.

TE-18 BOB MAPES  
BOX 410  
WALSBURG CO.

ORIGINAL SCALE: 1"=100'

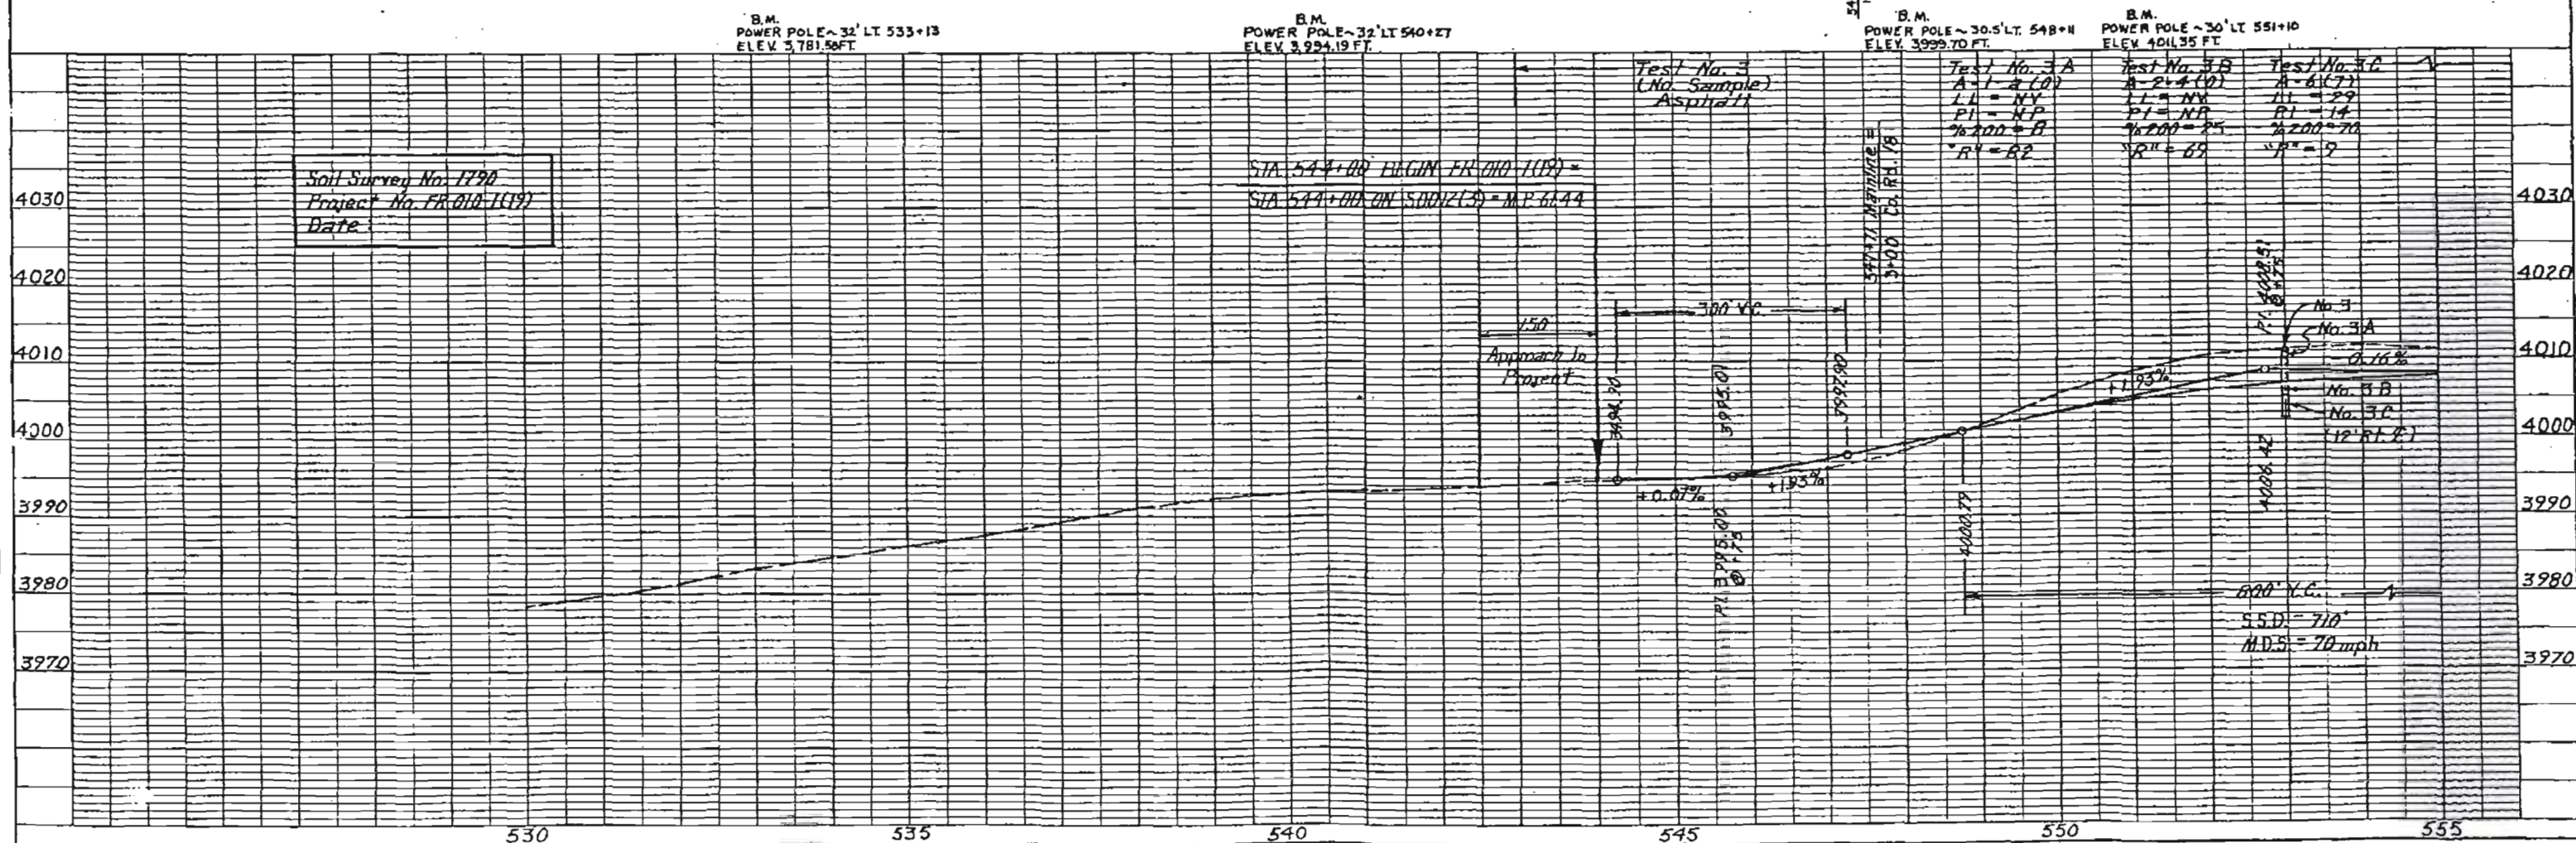



T.24 S., R.57 W., 6th P.M.


|                |         |      |
|----------------|---------|------|
| AS CONSTRUCTED |         |      |
| NO REVISIONS   | REVISED | VOID |

|                         |          |                               |           |
|-------------------------|----------|-------------------------------|-----------|
| FEDERAL ROAD REGION NO. | DIVISION | COMBINED PROJ. NOS.           | SHEET NO. |
| XIII                    | COLORADO | FR 010-1(19)<br>BRF 010-1(20) |           |

RIGHT OF WAY

| REVISIONS |  |
|-----------|--|
|           |  |
|           |  |

DETOUR DETAIL

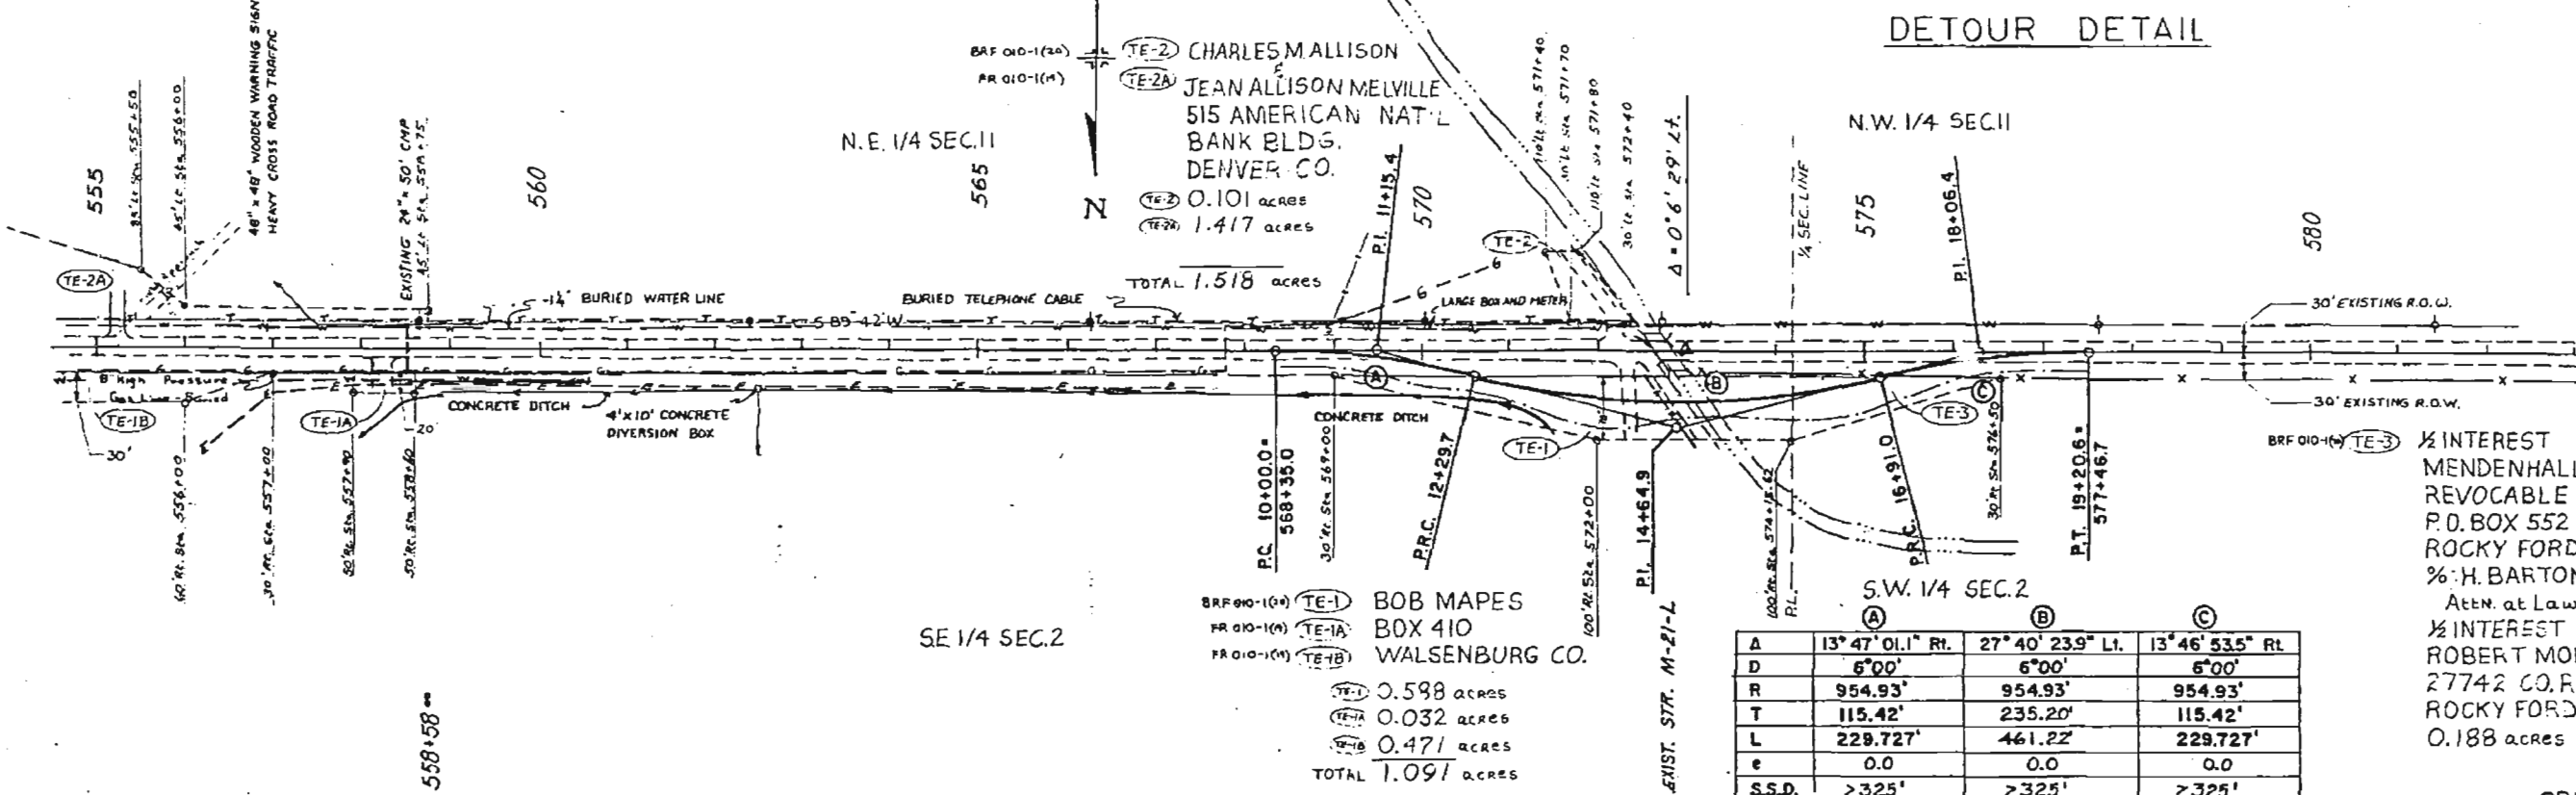

|        | A                 | B                 | C                 |
|--------|-------------------|-------------------|-------------------|
| A      | 13° 47' 01.1" Rt. | 27° 40' 23.9" Lt. | 13° 46' 53.5" Rt. |
| D      | 6° 00'            | 6° 00'            | 6° 00'            |
| R      | 954.93'           | 954.93'           | 954.93'           |
| T      | 115.42'           | 235.20'           | 115.42'           |
| L      | 229.727'          | 461.22'           | 229.727'          |
| e      | 0.0               | 0.0               | 0.0               |
| S.S.D. | >325'             | >325'             | >325'             |
| M.D.S. | 45 M.P.H.         | 45 M.P.H.         | 45 M.P.H.         |

1/2 INTEREST  
MENDENHALL FAMILY  
REVOCABLE TRUST  
P.O. BOX 552  
ROCKY FORD CO.  
% H. BARTON MENDENHALL  
Attn. at Law  
1/2 INTEREST  
ROBERT MORRISON  
27742 CO. RD. 21  
ROCKY FORD CO.  
0.188 acres

ORIGINAL SCALE : 1" = 100'

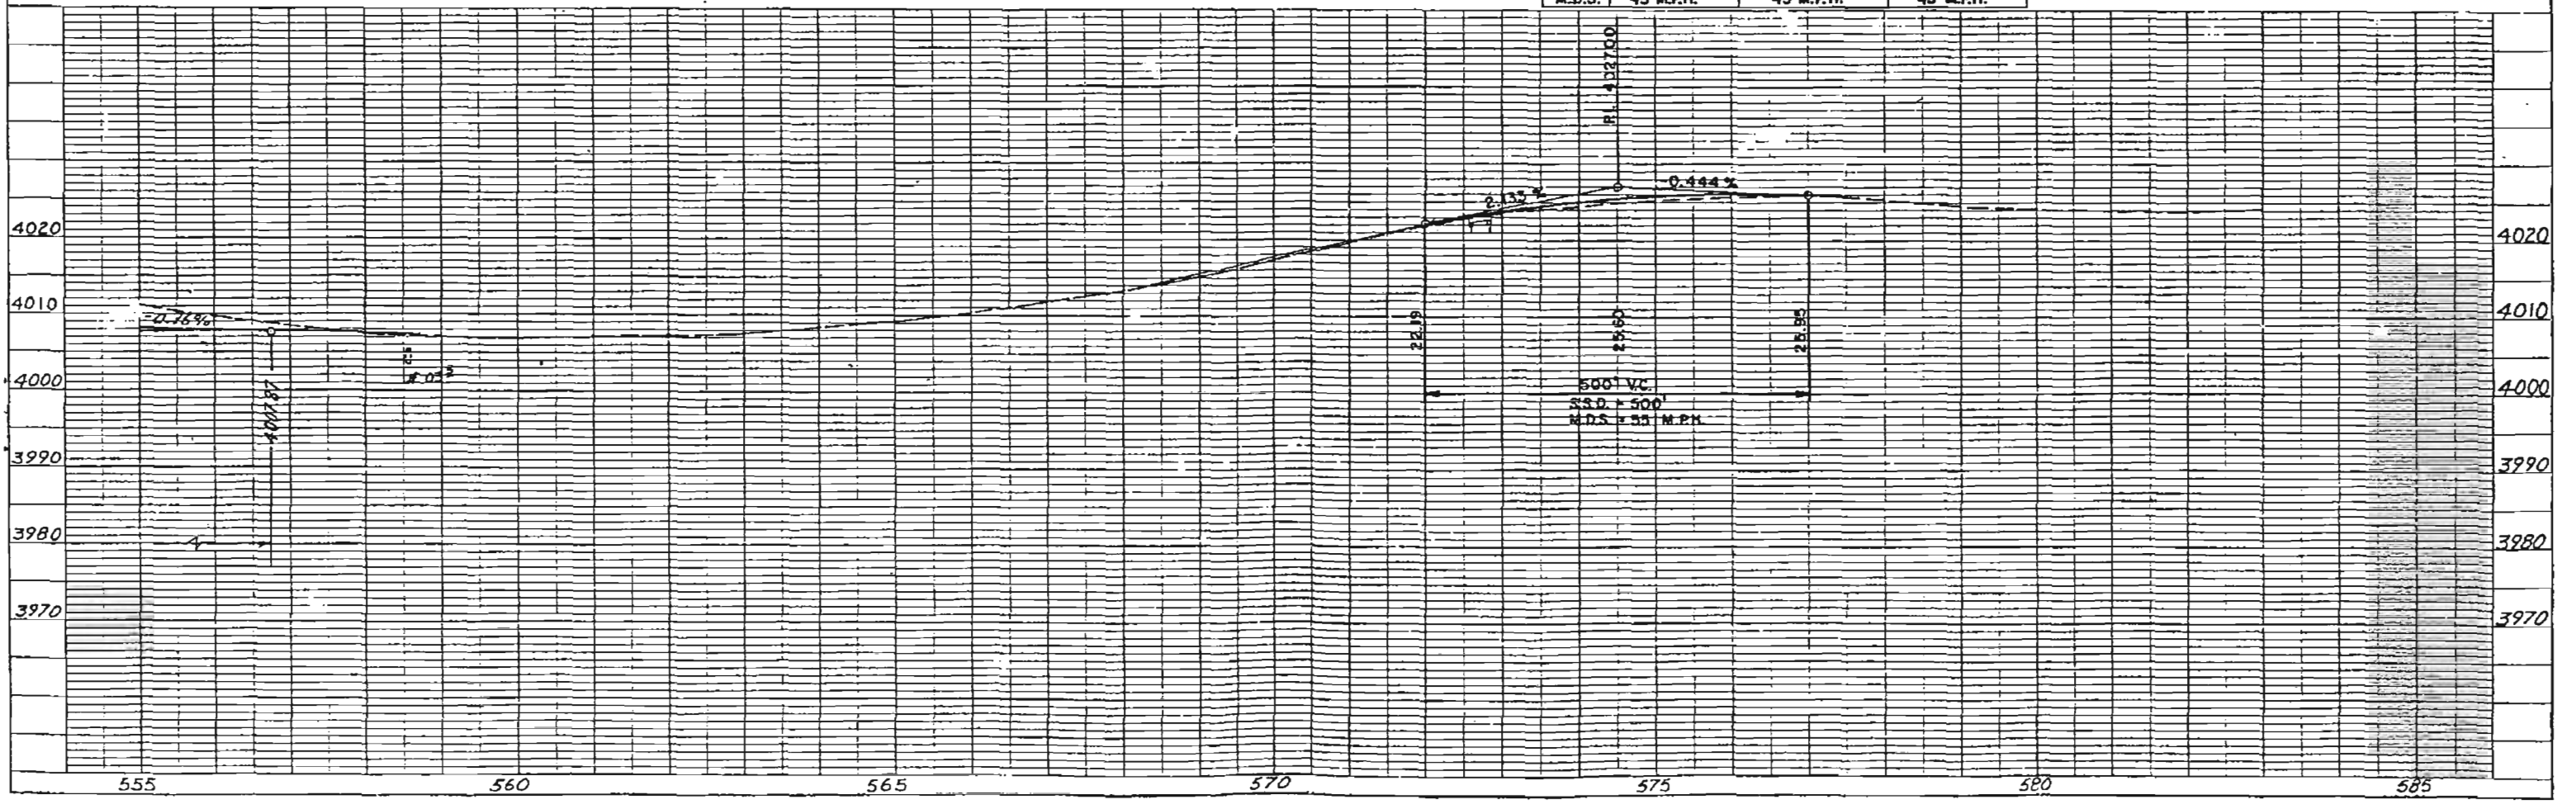

GRAPHED BY: [illegible]  
DATE: 11/1/19

# UTILITIES

- U.S. West Communication — Telephone
- Citizen Utilities — Gas
- Southern Colorado Power Association — Electric

T. 24 S., R. 57 W.  
6th P.M.


|                |         |      |
|----------------|---------|------|
| AS CONSTRUCTED |         |      |
| NO REVISIONS   | REVISED | VOID |

|                         |          |                               |           |
|-------------------------|----------|-------------------------------|-----------|
| FEDERAL ROAD REGION NO. | DIVISION | COMBINED PROJ. NOS.           | SHEET NO. |
| XIII                    | COLORADO | FR 010-1(19)<br>BRF 010-1(20) |           |


| REVISIONS |
|-----------|
|           |
|           |
|           |
|           |

## RIGHT OF WAY


FOR INTERSECTION IMPROVEMENTS  
SEE "DETAIL OF INTERSECTION"

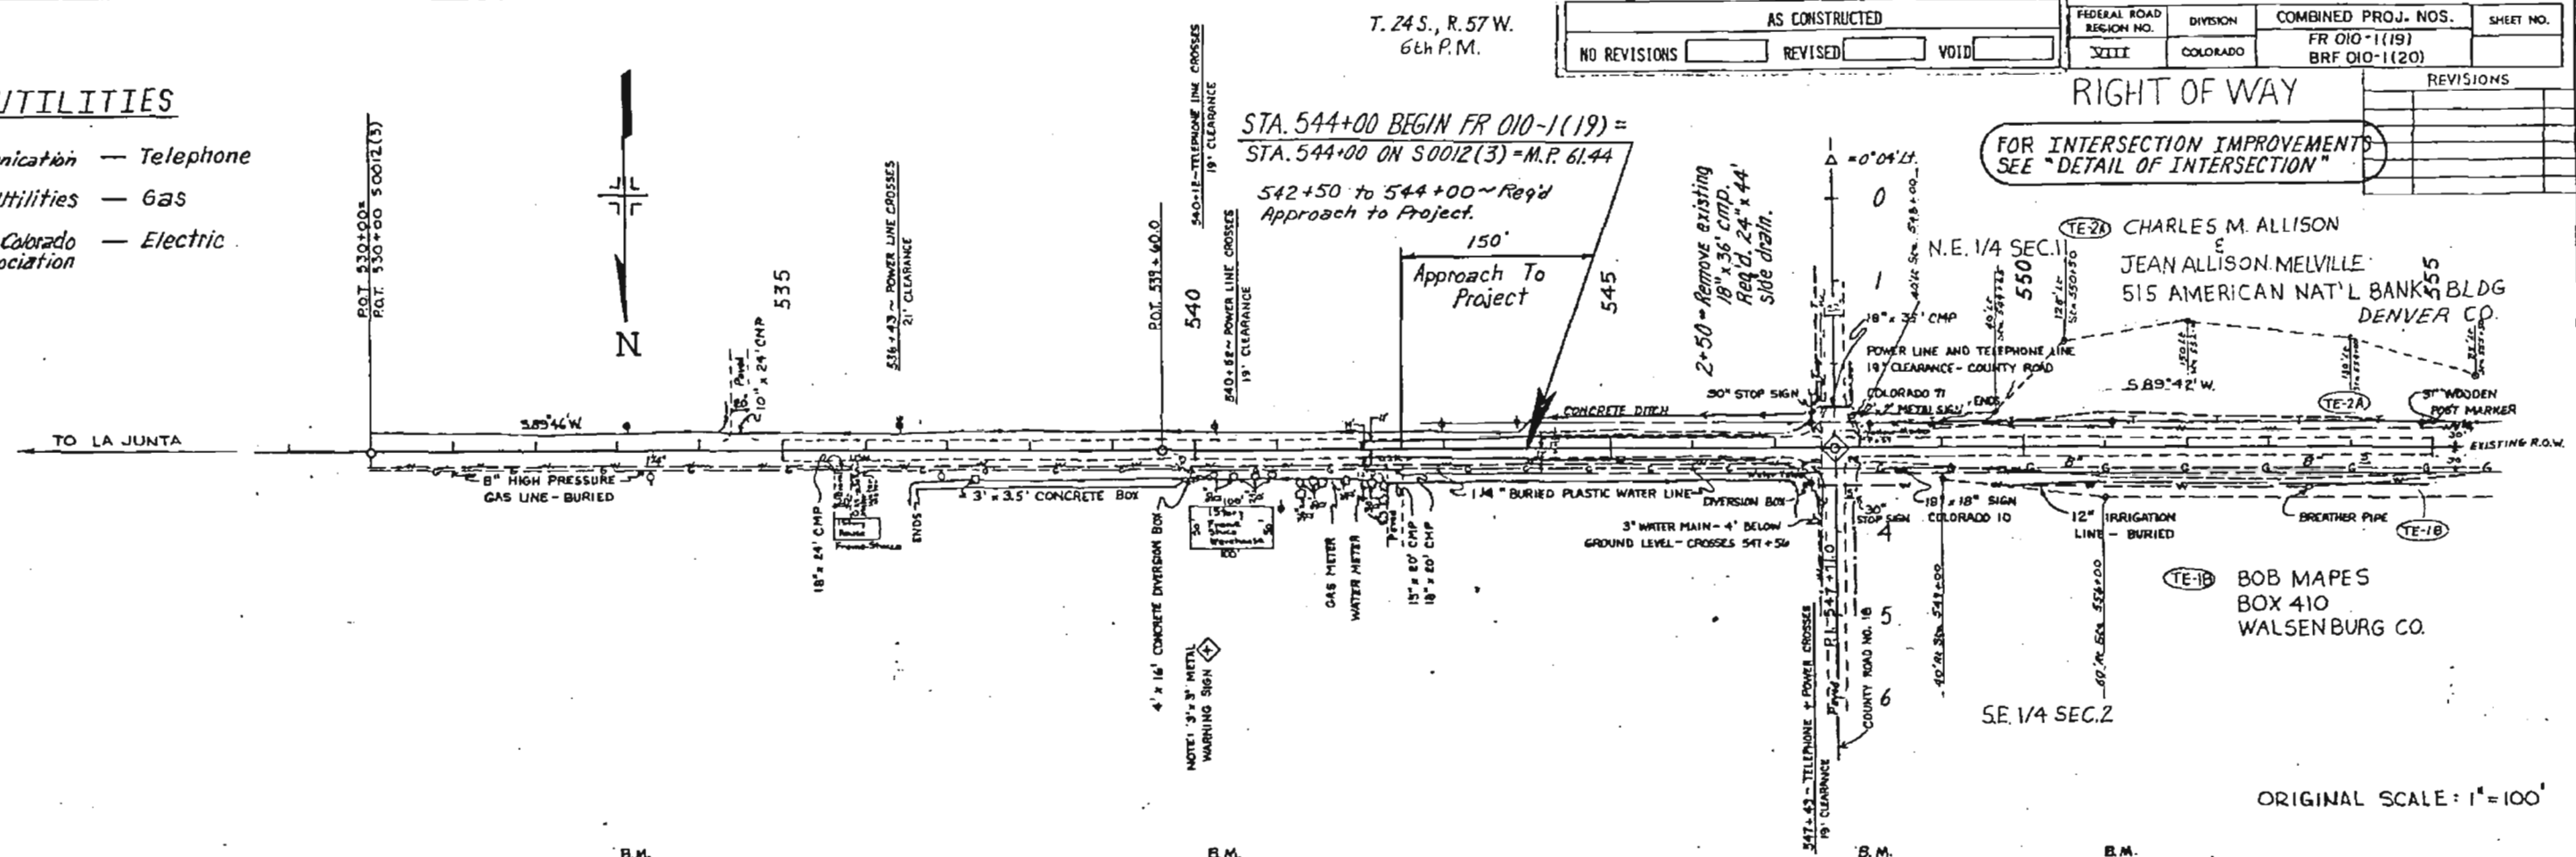

ORIGINAL SCALE: 1" = 100'

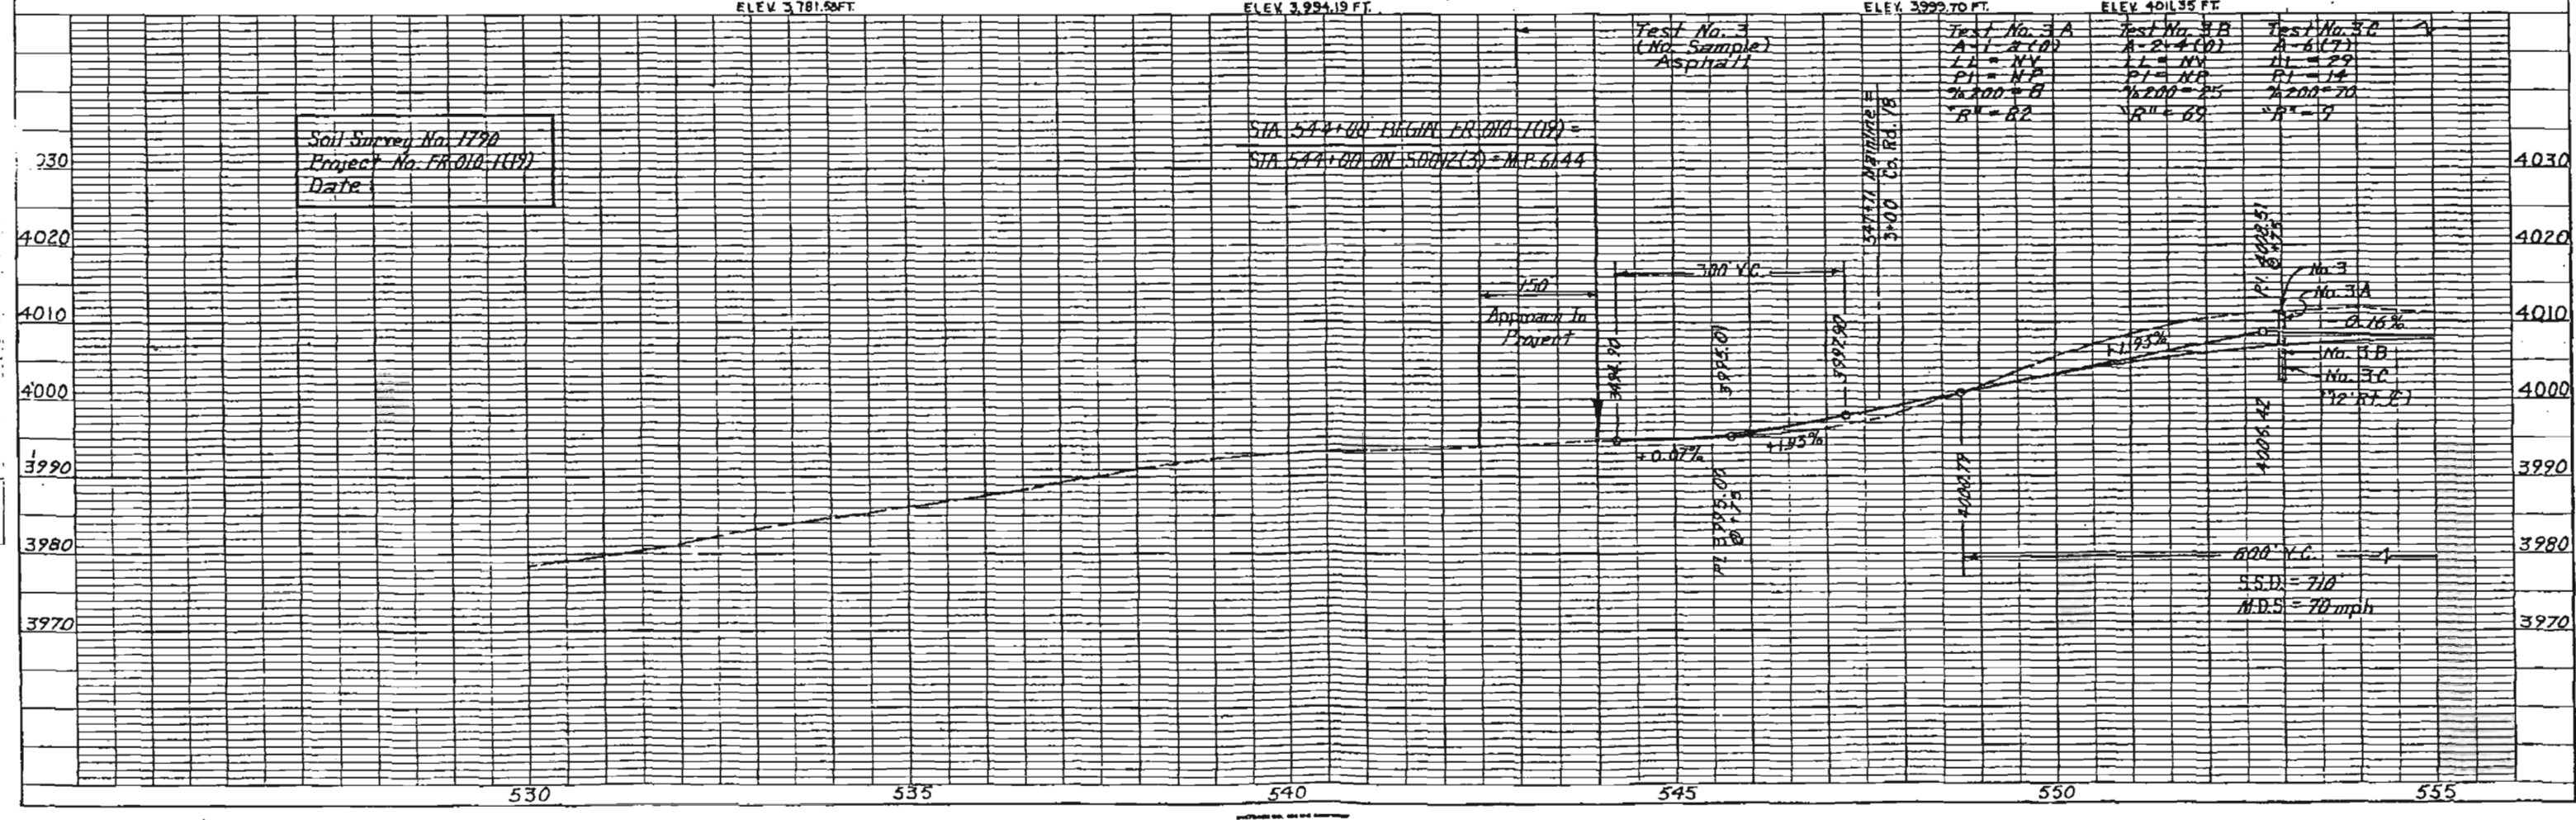

|                                        |          |      |                            |          |                               |  |           |
|----------------------------------------|----------|------|----------------------------|----------|-------------------------------|--|-----------|
| AS CONSTRUCTED                         |          |      | FEDERAL ROAD<br>REGION NO. | DIVISION | COMBINED PROJ. NOS.           |  | SHEET NO. |
| NO REVISIONS                           | REVISION | VOID | VIII                       | COLORADO | FR 010-1(19)<br>BRF-010-1(20) |  |           |
| RIGHT OF WAY                           |          |      |                            |          | REVISIONS                     |  |           |
| STA. 578+00 END BRF 010-1(20) =        |          |      |                            |          |                               |  |           |
| STA. 578+00 ON S 0012 (3) = M.P. 60.80 |          |      |                            |          |                               |  |           |

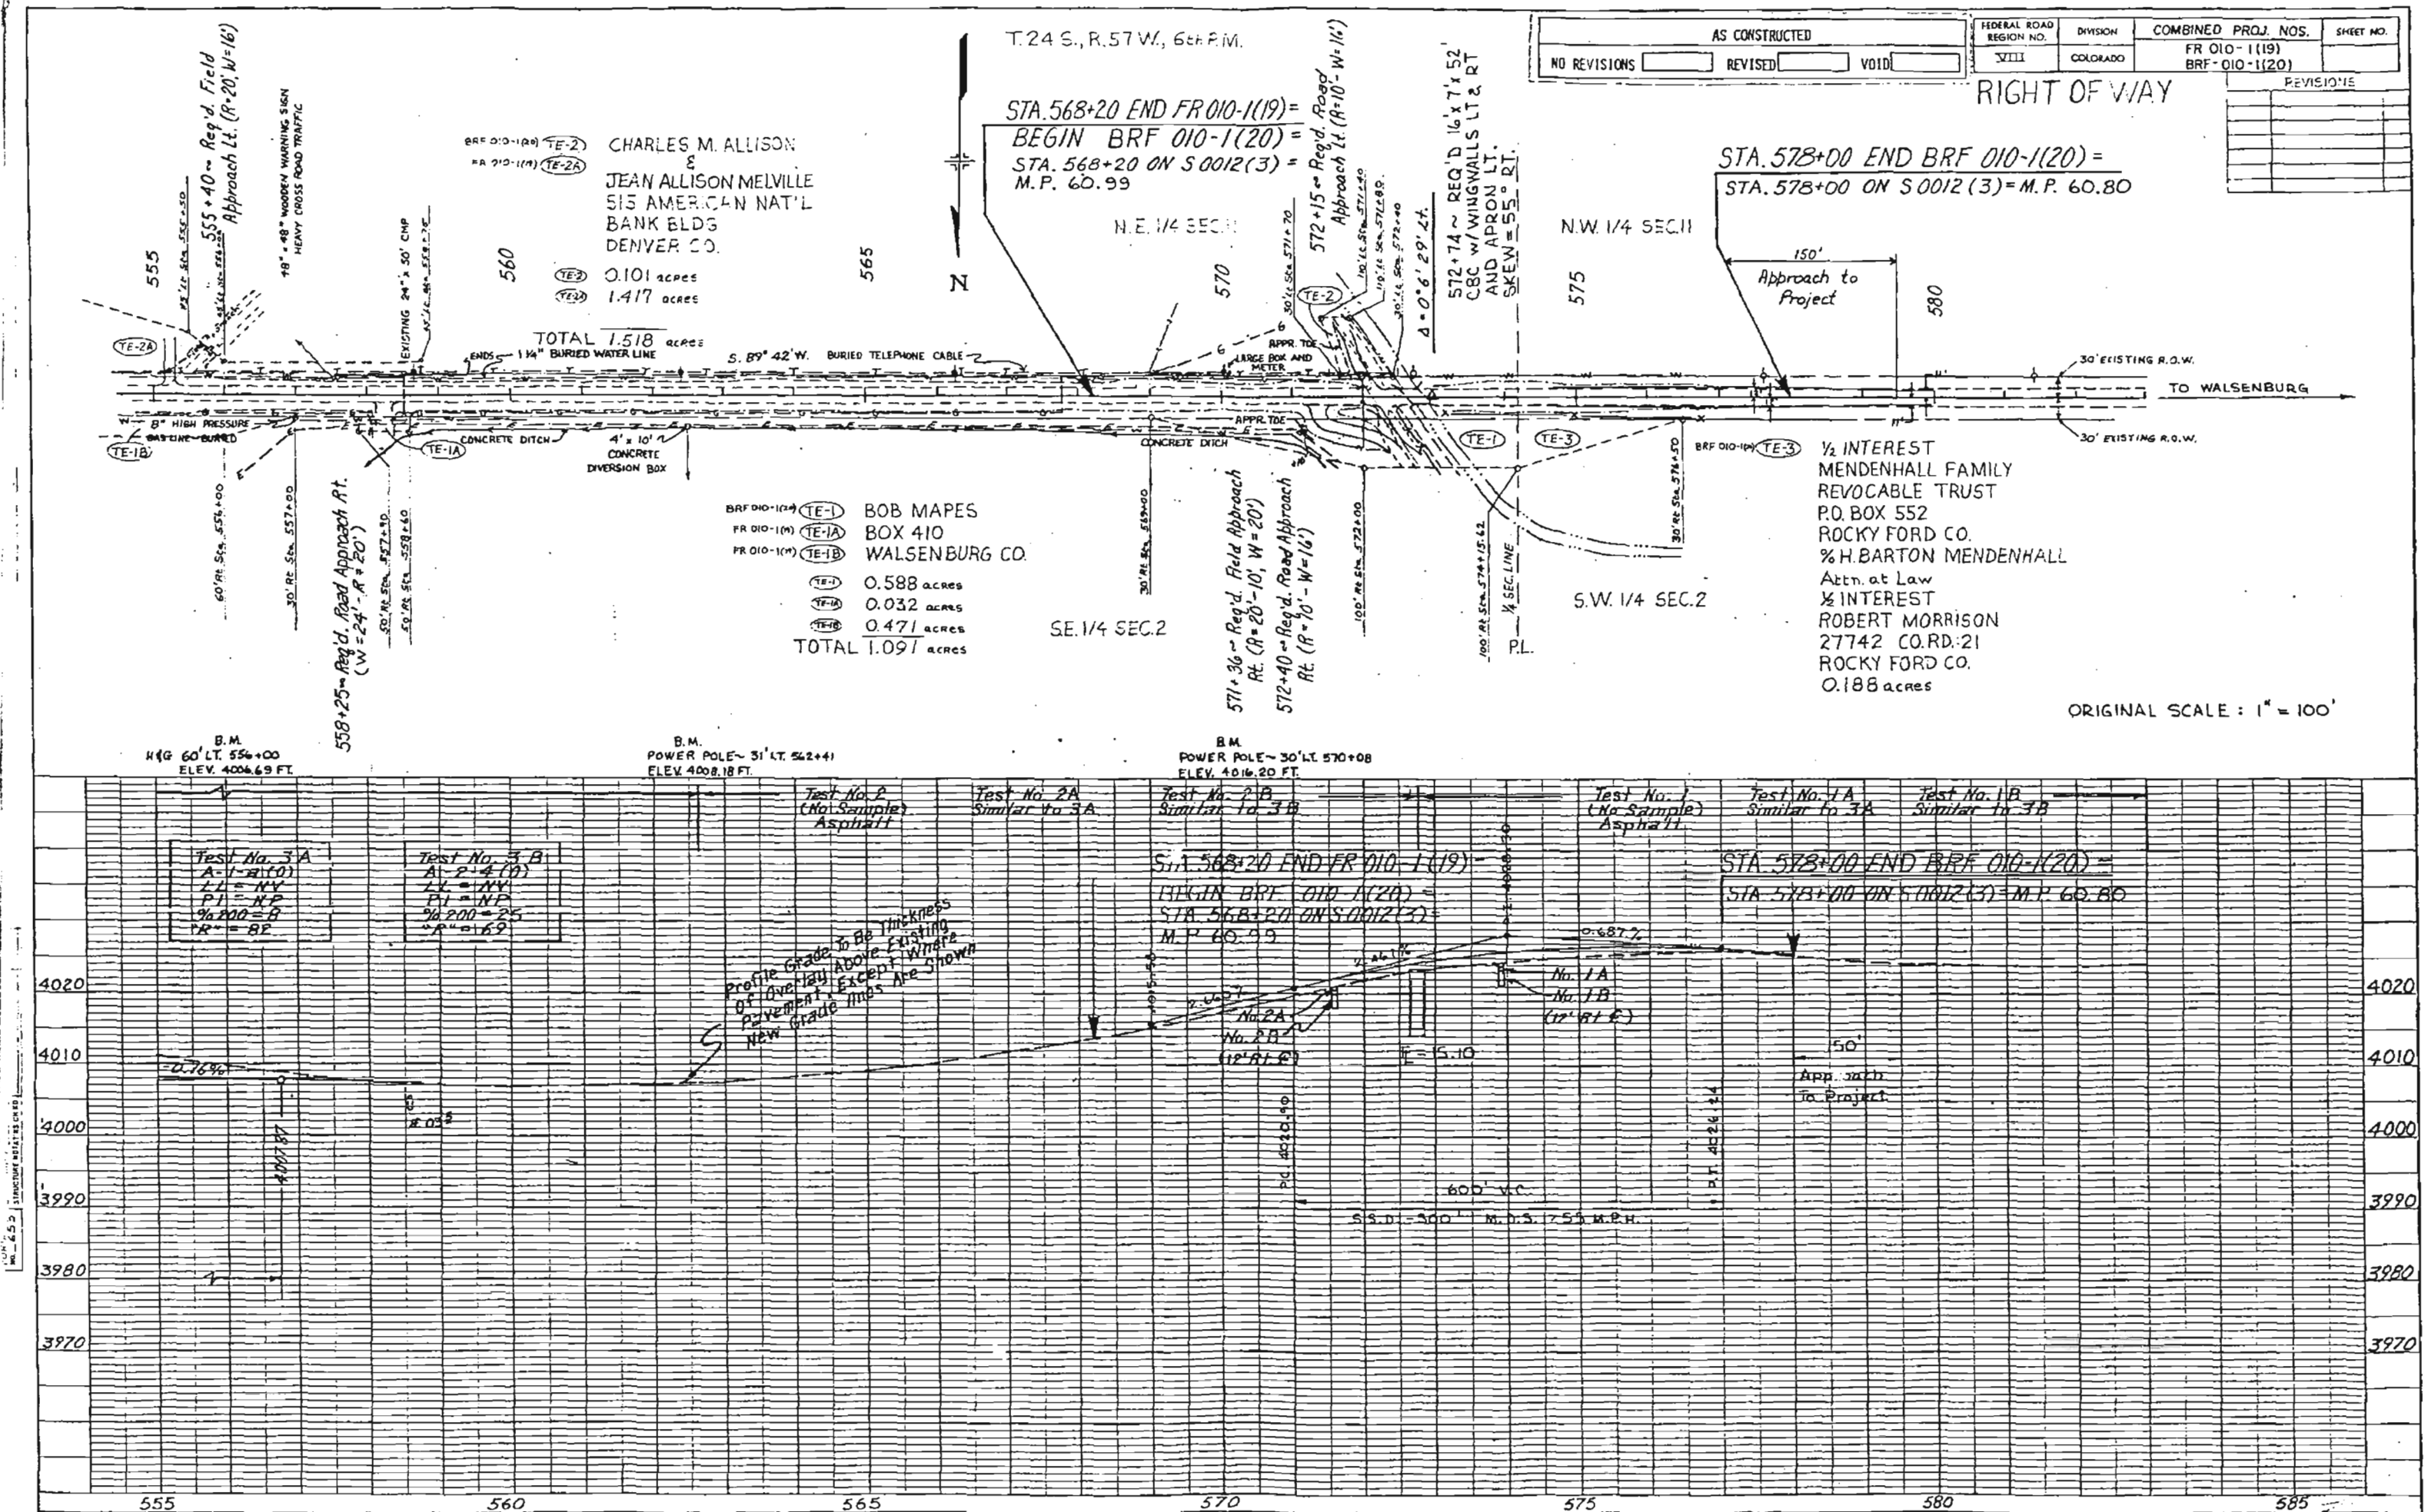

T. 24 S., R. 57 W., 6th P.M.

AS CONSTRUCTED


NO REVISIONS  REVISED  VOID

|                            |          |                               |           |
|----------------------------|----------|-------------------------------|-----------|
| FEDERAL ROAD<br>REGION NO. | DIVISION | COMBINED PROJ. NOS.           | SHEET NO. |
| <u>VII</u>                 | COLORADO | FR 010-1(19)<br>BRF 010-1(20) |           |

RIGHT OF WAY

### REVISIONS

DETOUR DETAIL

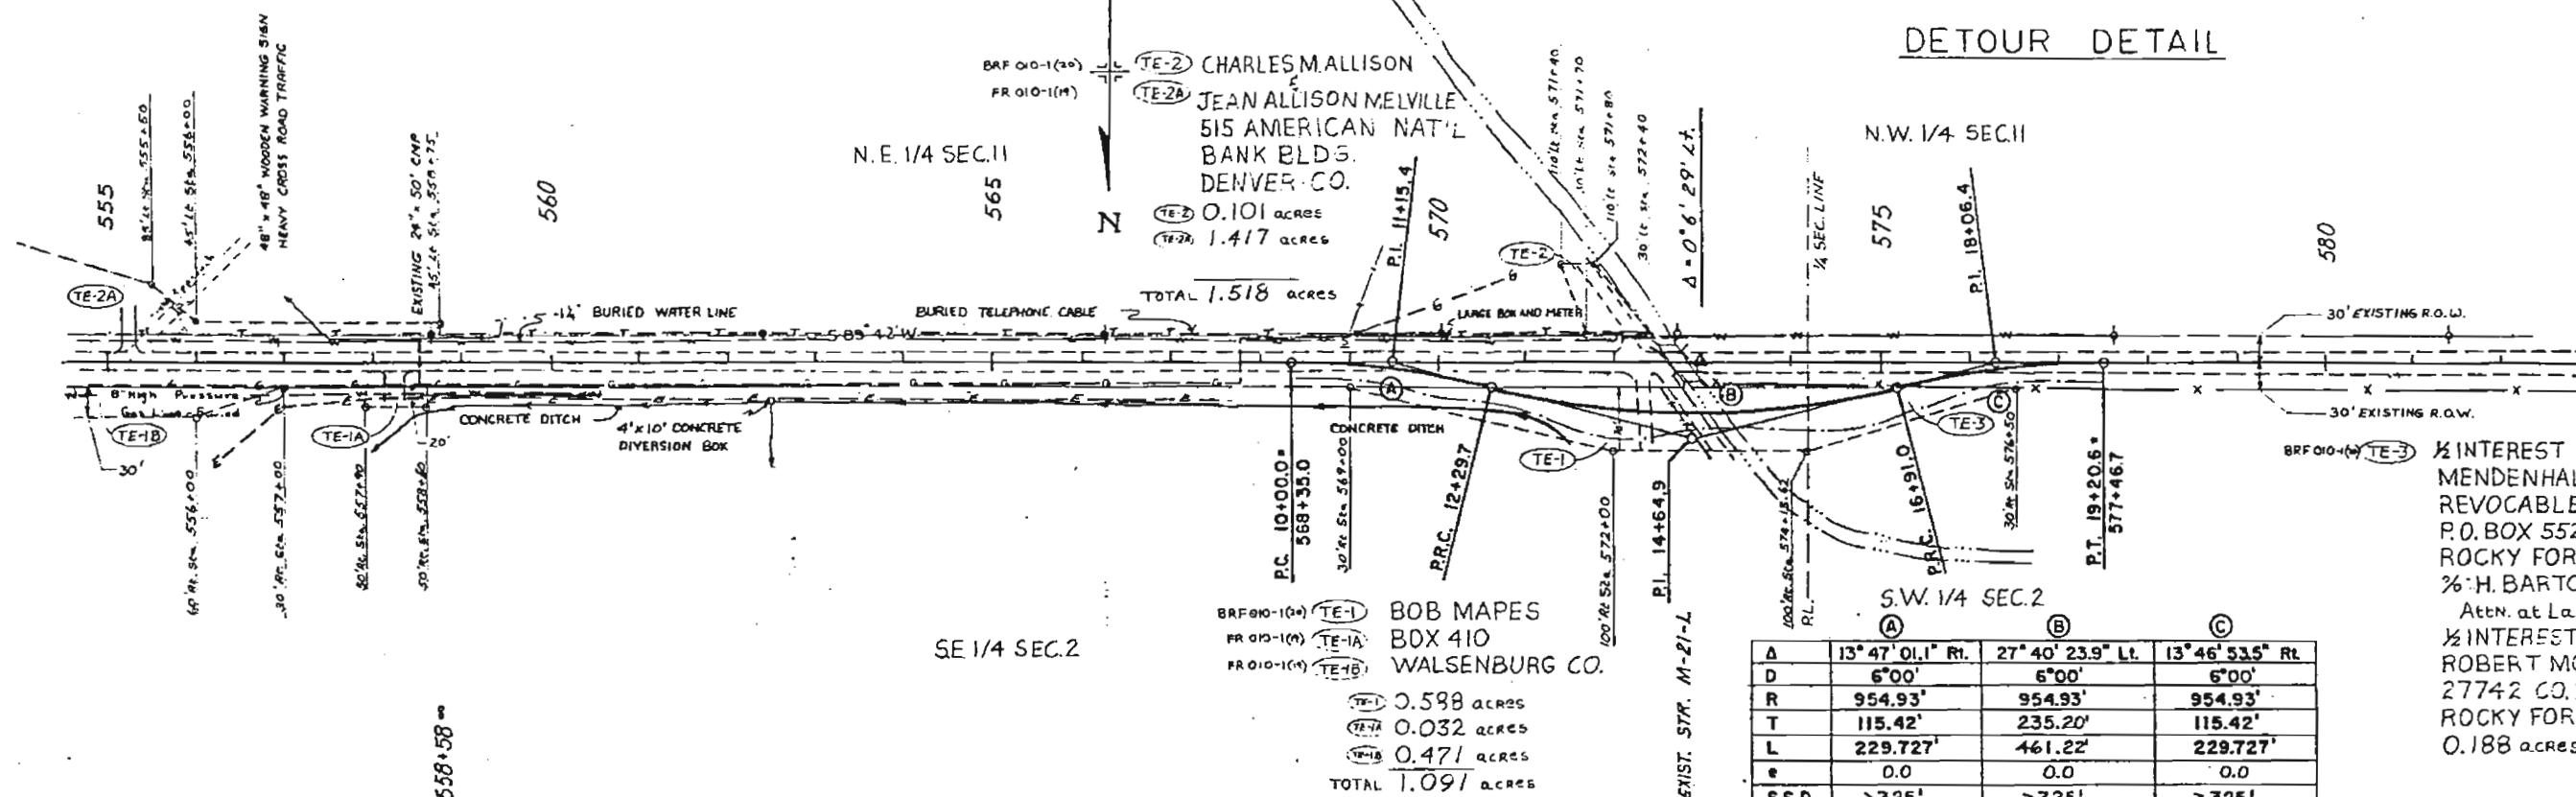

1/2 INTEREST  
MENDENHALL FAMILY  
REVOCABLE TRUST  
P.O. BOX 552  
ROCKY FORD CO.  
% H. BARTON MENDENHALL  
Attn. at Law  
1/2 INTEREST  
ROBERT MORRISON  
27742 CO. RD. 21  
ROCKY FORD CO.  
0.188 ACRES

ORIGINAL SCALE :  $1'' = 100'$

|        | (A)               | (B)               | (C)               |
|--------|-------------------|-------------------|-------------------|
| Δ      | 13° 47' 01.1" Rt. | 27° 40' 23.9" Lt. | 13° 46' 53.5" Rt. |
| D      | 6° 00'            | 6° 00'            | 6° 00'            |
| R      | 954.93'           | 954.93'           | 954.93'           |
| T      | 115.42'           | 235.20'           | 115.42'           |
| L      | 229.727'          | 461.22'           | 229.727'          |
| e      | 0.0               | 0.0               | 0.0               |
| S.S.D. | > 325'            | > 325'            | > 325'            |
| M.D.S. | 45 M.P.H.         | 45 M.P.H.         | 45 M.P.H.         |

