

NO CONSTRUCTED PLANS
RETURN TO LIST. 4 DESIGN

STATE DEPARTMENT OF HIGHWAYS
DIVISION OF HIGHWAYS—STATE OF COLORADO

R.O.M. UNDER FC 014-2(12)
P.E. AND UTILITIES UNDER
FC 014-2(13)

PLAN AND PROFILE OF PROPOSED AS CONSTRUCTED
FEDERAL AID PROJECT NO. FR 014-2(12)

STATE HIGHWAY NO. 14

LARIMER COUNTY

TABULATION OF LENGTH
AND DESIGN DATA

STATION	LINEAR FEET	
	ROADWAY	MAJOR STRUCTURE
STA. 3+0000 BEGIN FR 014-2(12) = STA. 3+0000 ON FC 014-2(12) M.P. 139.420	673.00	67.33
STA. 9+73.00 BEGIN MAJOR STRUCTURE NO. B-17-DJ		
STA. 10+40.33 END MAJOR STRUCTURE NO. B-17-DJ	2660.67	
STA. 36+2100 END FR 014-2(12) = STA. 36+2100 ON FC 014-2(12) M.P. 140.049		
TOTAL	3253.67	67.33
SUMMARY	LIN. FT.	MILES
ROADWAY (NET LENGTH)	3253.67	0.616
MAJOR STRUCTURE	67.33	0.013
PROJECT GROSS LENGTH	3321.00	0.629
DESIGN DATA		
MAXIMUM DEGREE OF CURVE	NA	
MAXIMUM GRADE	1.462%	
MINIMUM SSD HORIZONTAL	> 650	
MINIMUM SSD VERTICAL	> 650	
MAXIMUM DESIGN SPEED	55 MPH	
2004 DESIGN TRAFFIC VOLUME	DHV=1090	
	ADT=9950	

ON PLAN, 1 IN. = 50 FT.
ON PROFILE, 1 IN. = 50 FT. HORIZONTAL
1 IN. = 5 FT. VERTICAL
GRADE LINE ON PROFILE IS SHOWN AS GRADE OF FINISHED ROAD

STA. 3+00 BEGIN FR 014-2(12)
= STA. 3+00 ON FC 014-2(12)
M.P. 139.420



INDEX OF SHEETS

1. TITLE SHEET, PROJECT LOCATION, MAP, LENGTH AND DESIGN DATA AND INDEX OF SHEETS.
2. STANDARD PLANS LIST.
- 3-4. TYPICAL SECTIONS AND GENERAL NOTES.
- 5-7. SUMMARY OF APPROXIMATE QUANTITIES.
- 8-9. STRUCTURE QUANTITIES.
10. SURFACING PLAN.
11. FENCING TABULATION.
12. SCHEDULE OF CONSTRUCTION TRAFFIC CONTROL DEVICES AND TABULATION OF ABANDONED IRRIGATION STRUCTURES AND MODIFY MANHOLE DETAIL.
13. SUMMARY OF EARTHWORK AND TABULATION OF DELINEATORS AND GUARDRAIL.
14. DETOUR DETAIL.
15. DETAIL OF MEDIAN TRANSITION AND PROFILE GRADE.
16. TRAFFIC DATA-TURNING MOVEMENTS.
- 17-24. CONCRETE BOX CULVERT PLANS AND DETAILS.
- 25-27. PLAN AND PROFILE SHEETS.
28. TABULATION OF PAVEMENT MARKINGS.
- 29-30. DETAILS OF FLASHING BEACON.
- 31-32. STRIPING PLAN.

NEW AND REVISED STANDARDS.

P-606-12 GUARD RAIL TYPE 4 CONCRETE BARRIER (9 SHEET) 2-10-83

DIVISION OF HIGHWAYS

APPROVED:

12/1/84
DATE

AS CONSTRUCTED INFORMATION

CONTRACTOR
ENGINEER
PROJECT STARTED
PROJECT COMPLETED
AS CONSTRUCTED PLANS
APPROVED
DATE

SCALE 1 IN. = 50 FT.
SCALE 1 IN. = 5 KILOMETERS

Plan No.	Title	Page
☒ M-100-1	STANDARD SYMBOLS.....	1
☐ M-107-1	TEMPORARY EROSION CONTROL.....	2
☒ M-203-1	APPROACH ROADS, FLARING, CUT SLOPE TREATMENT, BRIDGE & CREST WIDENING.....	3
☒ M-203-2	DITCH TYPES.....	4
☐ M-203-10	SUPERELEVATION OF CURVES - CROWNED HIGHWAYS.....	5
☐ M-203-11	SUPERELEVATION OF CURVES - DIVIDED HIGHWAYS - SHOULDER PIVOT.....	6
☐ M-203-12	SUPERELEVATION OF CURVES - STREETS.....	7
☐ M-203-13	SUPERELEVATION OF CURVES - DIVIDED HIGHWAYS - CENTER PIVOT.....	8
☒ M-206-1	EXCAVATION AND BACKFILL FOR STRUCTURES... (2 SHEETS)	9
☒ M-206-2	EXCAVATION AND BACKFILL FOR BRIDGES.....	11
☐ M-214-1	PLANTING DETAILS.....	12
☐ M-412-1	CONCRETE PAVEMENT JOINTS.....	13
☐ M-504-1	STEEL CRIBBING.....	14
☐ M-506-1	GABIONS AND SLOPE MATRESS.....	15
☐ M-510-1	STRUCTURAL PLATE CULVERT PIPE - H-20 LOADING..... (2 SHEETS)	16
☐ M-601-1	SINGLE CONCRETE BOX CULVERT.....	18
☐ M-601-2	DOUBLE CONCRETE BOX CULVERT.....	19
☐ M-601-3	TRIPLE CONCRETE BOX CULVERT.....	20
☐ M-601-10	HEADWALL FOR PIPE CULVERTS.....	21
☐ M-601-11	TYPE "S" SADDLE HEADWALL FOR PIPE CULVERTS.....	22
☐ M-601-12	HEADWALL, INTERCEPTING HEADWALL AND CULVERT OUTLET PAVING.....	23
☐ M-601-20	WINGWALLS FOR PIPE OR BOX CULVERTS.....	24
☒ M-603-1	METAL CULVERT PIPE - H-20 LOADING..... (12 SHEETS)	25
☒ M-603-2	REINFORCED CONCRETE PIPE.....	27
☐ M-603-3	PRECAST CONCRETE BOX CULVERT.....	28
☐ M-603-10	CONCRETE AND METAL END SECTIONS.....	29
☐ M-604-1	PIPE SEWER IN TRENCH.....	30
☐ M-604-10	INLET, TYPE C.....	31
☐ M-604-11	INLET, TYPE D.....	32
☐ M-604-12	CURB INLET, TYPE R..... (12 SHEETS)	33
☐ M-604-13	CONCRETE INLET, TYPE 13.....	35
☒ M-604-20	MANHOLES.....	36
☒ M-604-21	STEPS FOR MANHOLES & INLETS.....	37
☒ M-606-1	GUARD RAIL, TYPE 3, W-BEAM..... (8 SHEETS)	38
☐ M-606-2	GUARD RAIL, TYPE 3, W-BEAM FOR LOCAL ROADS & STREETS..... (4 SHEETS)	46
☐ M-606-10	GUARD RAIL, TYPE 4, CONCRETE BARRIER, CAST-IN-PLACE.....	50
☐ M-606-11	GUARD RAIL, TYPE 4, CONCRETE BARRIER, PRECAST-PORTABLE.....	51

Plan No.	Title	Page
☒ M-607-1	WIRE FENCES AND GATES..... (2 SHEETS)	52
☐ M-607-2	CHAIN LINK FENCE..... (3 SHEETS)	54
☐ M-607-3	BARRIER FENCE.....	57
☐ M-607-4	DEER FENCE AND GATE..... (2 SHEETS)	58
☐ M-607-10	PICKET SNOW FENCE.....	60
☐ M-608-1	CURB RAMPS.....	61
☐ M-609-1	CURBS AND GUTTERS.....	62
☐ M-611-1	CATTLE GUARD - WELDED GRILL UNITS - 10' THRU 42' ROADWAYS..... (2 SHEETS)	63
☐ M-613-1	HIGHWAY LIGHTING..... (2 SHEETS)	65
☐ M-615-1	EMBANKMENT PROTECTOR, TYPES 3 & 4.....	67
☐ M-615-2	EMBANKMENT PROTECTOR, TYPE 5.....	68
☐ M-616-1	INVERTED SIPHON..... (ALSO USE M-603 OR M-604 AS REQUIRED)	69
☒ M-620-1	FIELD LABORATORY - CLASS 1.....	70
☐ M-620-2	FIELD LABORATORY - CLASS 2.....	71
☐ M-620-11	FIELD OFFICE - CLASS 1.....	72
☐ M-620-12	FIELD OFFICE - CLASS 2.....	73

Plan No.	Title	Page
☒ S-612-1	TYPICAL DELINEATOR INSTALLATIONS..... (4 SHEETS)	75
☒ S-614-1	TYPICAL GROUND SIGN PLACEMENT.....	79
☐ S-614-2	CLASS I GROUND SIGN INSTALLATIONS.....	80
☐ S-614-3	CLASS II GROUND SIGN INSTALLATIONS.....	81
☐ S-614-4	CLASS III SIGNS, LAMINATED ALUMINUM PANELS AND POST SPACING TABLE..... (2 SHEETS)	82
☐ S-614-5	BREAK-AWAY SIGN SUPPORT DETAILS FOR GROUND SIGNS..... (2 SHEETS)	84
☐ S-614-6	CONCRETE FOOTINGS AND SIGN ISLANDS FOR CLASS III SIGNS..... (2 SHEETS)	86
☐ S-614-10	TYPICAL MARKER ASSEMBLY INSTALLATIONS.....	88
☐ S-614-11	MILEPOST SIGN AND INSTALLATION.....	89
☒ S-614-12	STRUCTURE NUMBER INSTALLATION (BRIDGE INFORMATION SHEET).....	90
☐ S-614-13	STANDARD RAILROAD CROSSING SIGNS AND MARKINGS.....	91
☐ S-614-20	TYPICAL POLE MOUNT SIGN INSTALLATION.....	92
☐ S-614-21	CONCRETE BARRIER SIGN POST INSTALLATIONS.....	93
☐ S-614-22	TYPICAL MULTI-SIGN INSTALLATIONS.....	94
☐ S-614-30	INTERSTATE ROUTE MARKERS.....	95
☐ S-614-31	U. S. & COLORADO ROUTE MARKERS.....	96
☐ S-614-32	AUXILIARY MARKERS.....	97
☐ S-614-40	TRAFFIC SIGNAL INSTALLATION DETAILS... (3 SHEETS)	98
☒ S-614-50	TRAFFIC CONTROLS FOR HIGHWAY CONSTRUCTION..... (4 SHEETS)	101
☒ S-614-51	BARRICADES, DRUMS, CONCRETE BARRIER (TEMP) & VERTICAL PANELS.....	105
☒ S-627-1	TYPICAL PAVEMENT MARKINGS..... (3 SHEETS)	106

THE STANDARD PLAN SHEETS INDICATED HEREON BY A
MARKED BOX ARE TO BE USED TO CONSTRUCT THIS
PROJECT.

DEPARTMENT OF HIGHWAYS
STATE OF COLORADO
DIVISION OF HIGHWAYS


STANDARD PLANS LIST

M & S STANDARDS - JANUARY, 1982

TYPICAL SECTION A

STA 3+00 TO STA 7+00


Asphalt Relinquishing Agent

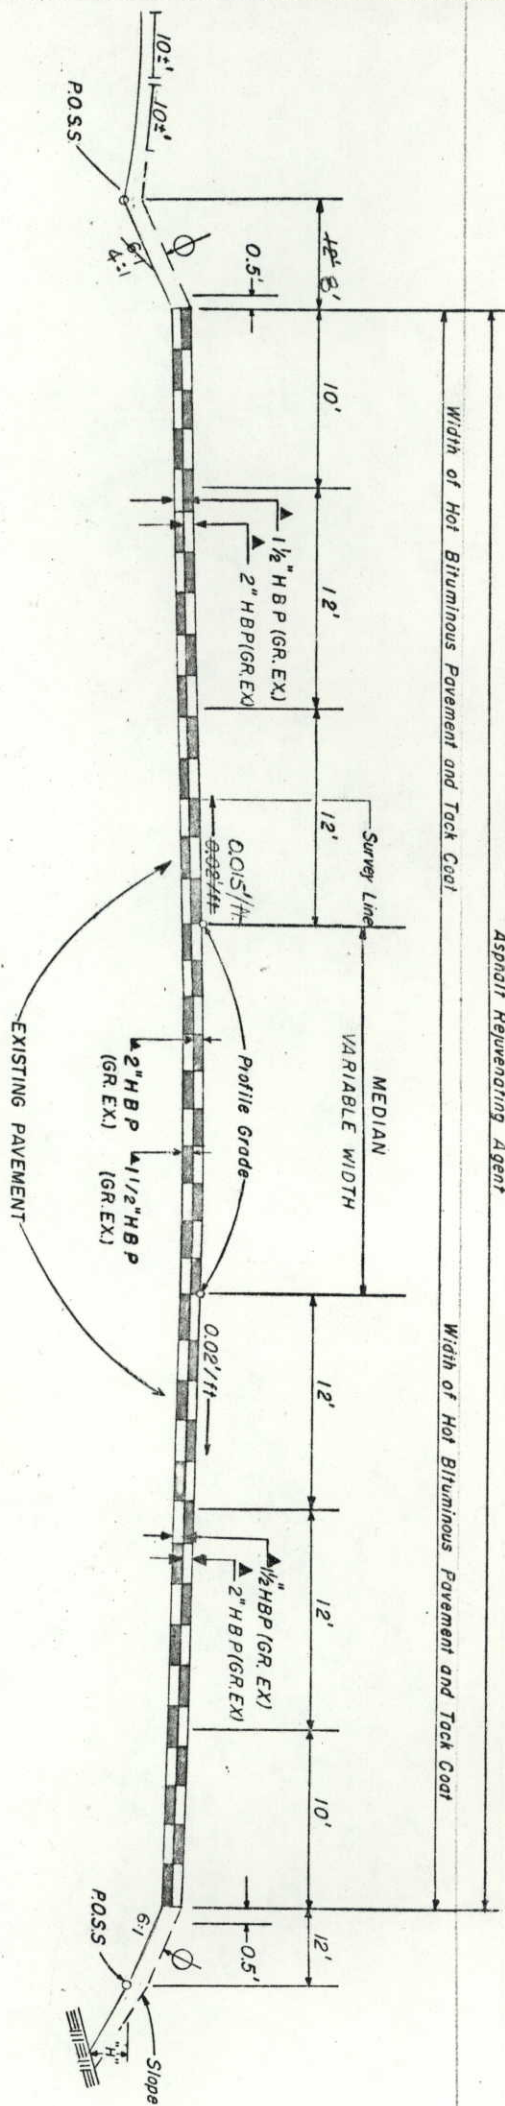


TYPICAL SECTION B

STA 7+00 TO STA 12+40

Asphalt Relinquishing Agent

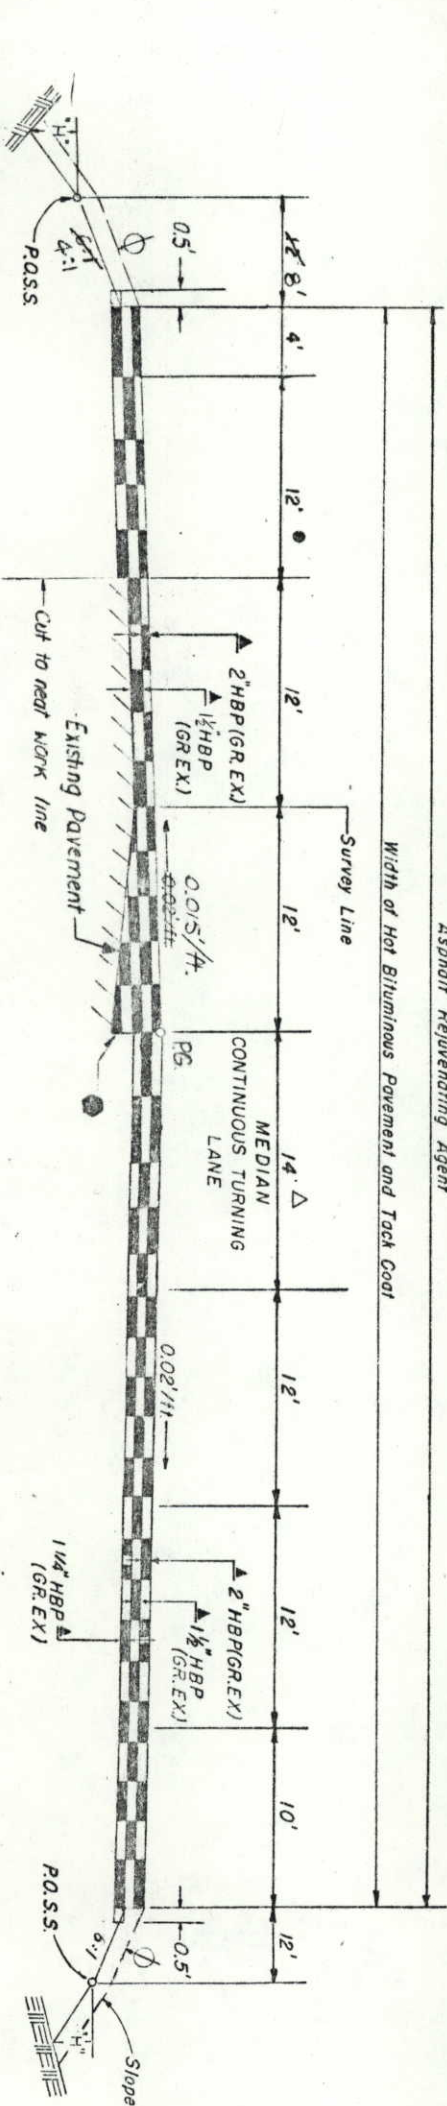

DETOUR TYPICAL SECTION

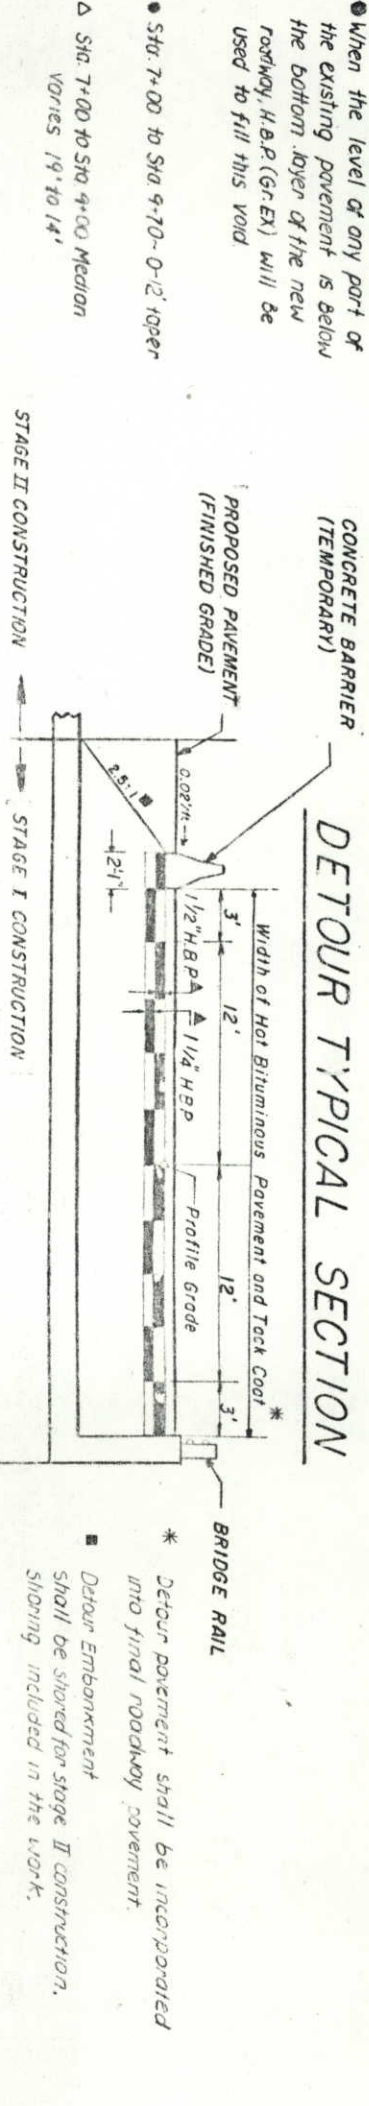

GENERAL NOTES

FOR PRELIMINARY PLAN QUANTITIES OF BITUMINOUS MATERIALS THE FOLLOWING RATES OF APPLICATION WERE USED:
TACK COAT-DILUTED EMUL ASPH. (SLOW SETTING)..... 0.1 GALS./SQ. YD
BITUMINOUS PAVEMENT..... 110 LBS./SQ. YD
DILUTED EMULIFIED ASPHALT FOR TACK COAT SHALL CONSIST OF 1 PART EMULIFIED ASPHALT AND 1 PART WATER.
RATES OF APPLICATION SHALL BE AS DETERMINED BY THE ENGINEER AT THE TIME OF APPLICATION.

THE FOLLOWING SHALL BE FURNISHED WITH EACH BITUMINOUS PAYER.

1. A SKI TYPE DEVICE AT LEAST 30 FEET IN LENGTH.
2. SHORT SKI OR SHOE.

ANY LAYER OF BITUMINOUS PAVEMENT THAT IS TO HAVE A SUCCEEDING LAYER PLACED THEREON SHALL BE COMPLETED FULL WIDTH BEFORE SUCCEEDING LAYER IS PLACED.
ROAD APPROACHES WHICH REQUIRE BITUMINOUS PAVEMENT SHALL HAVE A 1/2" THICKNESS OF H.B.P. PLACED AS FOLLOWS:
PUBLIC APPROACHES INCLUDING COUNTY ROADS AND ENTRANCES TO BUILDINGS OR RESIDENCES SHALL BE PAVED 50 FEET OUT FROM EDGE OF SHOULDER OR TO THE RIGHT OF WAY LINE, WHICHEVER IS LESS. FIELD ENTRANCES SHALL BE PAVED 4 FEET OUT FROM EDGE OF SHOULDER.

DEPTH OF MOISTURE-DENSITY CONTROL FOR THIS PROJECT SHALL BE AS FOLLOWS:

FULL DEPTH OF ALL EMBANKMENTS,
BASES OF CUTS AND FILLS 0.5 FOOT.

EXCAVATION REQUIRED FOR COMPACTION OF BASES OF CUTS AND FILLS WILL BE CONSIDERED AS SUBSIDIARY TO THAT OPERATION AND WILL NOT BE PAID FOR SEPARATELY.

TYPE OF COMPACTION FOR THIS PROJECT WILL BE ASHTO T99

THE MINIMUM THICKNESS OF TOPSOIL SHALL BE 4 INCHES. IT IS ESTIMATED THAT 2.302 CUBIC YARDS OF TOPSOIL WILL BE REQUIRED FOR EACH LINEAL FOOT OF ROADWAY OBTAINED FROM WITHIN 0.5 A.C. LIMITS.

SEEDING, SOIL PREPARATION, FERTILIZING WITH COMMERCIAL FERTILIZER, AND MULCHING WILL BE REQUIRED FOR EACH LINEAL FOOT OF ROADWAY OBTAINED FROM WITHIN 0.5 A.C. LIMITS OF THE FOLLOWING TYPES AND RATES SHALL BE USED:


COMMON NAME	BOTANICAL NAME	RATE PLS./ACRE POUNDS
CRESTED WHEATGRASS	AGROPYRON DESERTORUM	10
WESTERN WHEATGRASS	AGROPYRON SMITHII	5
PAINTER WHEATGRASS	PAINTER WHEATGRASS	10
FOR FALL PLANTING SUBSTITUTE	WINTER WHEAT T. MICHITA TRITICUM AESTIVUM	(1-15)
TOTAL TOTAL PLS./ACRE SEEDING		25.30
WULCHING MATERIAL: NATIVE HAY 1.5 TONS PER ACRE		
COMMERCIAL FERTILIZER RATE LBS./ACRE		
AVAILABLE N 45		
AVAILABLE P 115		

PROJECT TOTALS	(NATIVE)	WTS	(AVAILABLE N)	(AVAILABLE P)
SEEDING	63.3	LBS.	10	TONS
WULCHING	10	TONS	293	LBS.
FERTILIZER	748	LBS.	748	LBS.
SOIL PREPARATION	6.5	ACRES	6.5	ACRES

PERMANENT SIGNING ON THIS PROJECT WILL BE DONE BY STATE FORCES

AS CONSTRUCTED		FED. ROAD REGION	DMSION	PRQL. NO.	SHEET NO.	SHEET TOTALS
NO REVISIONS	REVISED	VI11	COLO.	FR 014-2(12)	4	32

TYPICAL SECTION C ☆

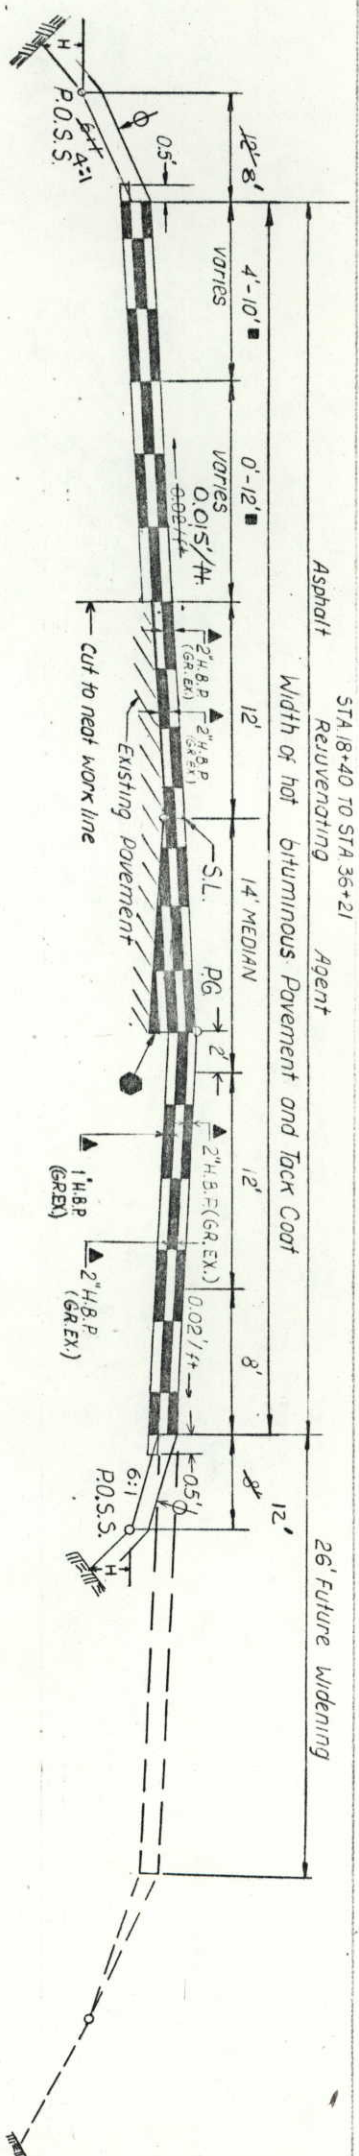

Fill Slopes:
Slope 6:1 where "H" is 4' or less
Slope 4:1 where "H" is greater than 4' and less than 15'

- When the level of any part of the existing pavement is below the bottom layer of the new roadway, H.B.P. (Gr. Ex.) will be used to fill this void.
- ☆ Section from sta 12+40 to sta 18+40 transitions from typical section B to typical section C
- Use 4' shoulder when 12' auxiliary lane is required. See striping plan for details.
- Use 10' shoulder when no auxiliary lane is required. See striping plan for details.
- ▲ Approximate Thickness
- φ Min. 4" Topsoil

FINAL
SUMMARY OF APPROXIMATE QUANTITIES

INDEX	CONTRACT ITEM NO.	CONTRACT ITEM	UNIT	PLAN ROADWAY	AS CONSTR. ROADWAY	PLAN STRUCTURE NO. B-17-DJ	AS CONSTR. STRUCTURE NO. B-17-DJ	PLAN UTILITIES	AS CONSTR. UTILITIES	PLAN PROJECT TOTALS	AS CONSTR. PROJECT TOTALS	DIFF. +/-	% PLAN
X 105	105	CONSTRUCTION STAKES CLEARING AND GRUBBING	Hour L.S.	0	1					0	1	+4	100
X	202	REMOVAL OF STRUCTURES AND OBSTRUCTIONS	L.S. EACH	1	1					1	1	0	100
X	202	REMOVAL OF STRUCTURE	EACH	3	1					3	1	-2	33
X	202	REMOVAL OF PIPE	LIN. FT.	28	152					28	152	+124	543
X	202	Removal of DELINEATOR	Each	30	21					30	21	-9	70
X	202	REMOVAL OF PAVEMENT MARKING	Sq. FT.	2000	795					2000	795	-1,205	40
X	202	REMOVAL OF PORTIONS OF PRESENT STRUCTURE	Each LIN. FT.	3958	3,096	1	1			1	1	0	100
X	203	EMBANKMENT MATERIAL (COMPLETE IN PLACE)	Cu. Yd.	23940	24,189					23,940	24,189	+249	101
X	206	STRUCTURE EXCAVATION	Cu. Yd.	522	490	1710	1,710			2,232	2,200	-32	99
X	206	STRUCTURE BACKFILL (CLASS 2)	Cu. Yd.	509	544	710	710			1,219	1,259	+40	103
X	206	FILTER MATERIAL (CLASS B)	Cu. Yd.			25	25			25	25	0	100
X	207	TOPSOIL (HAUL)	Cu. Yd.	3,510	2,362					3,510	2,362	-1,148	67
X	207	Stockpile Topsoil (HAUL)	Cu. Yd.	3,510	2,362					3,510	2,362	-1,148	67
X	210	RESET MAILBOX STRUCTURE	EACH	4	3					4	3	-1	75
X	210	RESET GROUND SIGN	EACH	1	14					1	14	+13	1,400
X	210	RESET FLASHING BEACON	EACH	1	1					1	1	0	100
X	210	RELAY PIPE (12 INCH) - Deleted	LIN FT	28	0					28	0	-28	0
X	210	RELAY PIPE (18 INCH)	LIN FT	209	327					209	327	+118	156
X	210	ADJUST MANHOLE	EACH					3	2	3	2	-1	67
X	210	MODIFY MANHOLE	EACH					4	4	4	4	0	100
X	212	SEEDING (NATIVE)	LB	163	207					163	207	+44	127
X	212	FERTILIZER (AVAILABLE N)	LB	293	311					293	311	+18	106
X	212	FERTILIZER (AVAILABLE P)	LB	748	794					748	794	+46	106
X	212	SOIL PREPARATION (NATIVE)	ACRE	6.5	6.9					6.5	6.9	+0.4	106
X	213	MULCHING	TON	10	10.35					10	10.35	+0.35	104
X 105	401	MATERIALS TESTING	L.S.	0	1					0	1	+1	-
X	403	HOT BITUMINOUS PAVEMENT (GRADING EX) (HAUL AND ASPHALT)	TON	7807	6,943.40					7807	6,943.40	-863.6	89

SUMMARY OF APPROXIMATE QUANTITIES

AS CONSTRUCTED		FEDERAL BOLD DESIGN NO.	DIVISION	PROJ. NO.	SHEET NO.	TOTAL SHEETS
NO REVISIONS	REVISED <u>10-15-85</u>	VOID	VIII	COLORADO	FR 014 - 2(12)	6
						32

INDEX	CONTRACT	ITEM NO.	CONTRACT ITEM	UNIT	PLAN ROADWAY	AS CONSTR. ROADWAY	PLAN STRUCTURE NO. B-17-DJ	AS CONSTR. STRUCTURE NO. B-17-DJ	PLAN PROJECT TOTALS	AS CONSTR. PROJECT TOTALS	DIFF. + / -	% PLAN
X	411	EMULSIFIED ASPHALT (SLOW-SETTING)	GAL.		3,107	1,846			3,107	1,846	-1,261	59
X	411	ASPHALT REJUVENATING AGENT-(DELETED)	GAL.		786	Ø			786	Ø	-786	Ø
X	502	END PLATE	EACH				76	76				
X	502	STEEL PIPE PILING (10-3/4 INCH X 0.219)	LIN. FT.				1,173	990	1,173	990	-183	84
X	502	STEEL PIPE PILING (10-3/4 INCH X 0.219) CUTOFF	LIN. FT.				Ø	12	Ø	+12	-	-
X	502	STEEL PIPE PILING (12-3/4 INCH X 0.219)	LIN. FT.				2,491	2,198	2,491	2,198	-293	88
X	502	STEEL PIPE PILING (12-3/4 INCH X 0.219) CUTOFF	LIN. FT.				Ø	32	Ø	+32	-	-
X	601	CONCRETE CLASS A (BOX CULVERT)	Cu. Yd.				886	886	886	886	Ø	100
X	602	REINFORCING STEEL	L.B.				129,615	139,290	129,615	139,290	+9,675	107
X	606	GUARD RAIL TYPE 3 (6-3 POST SPACING)	LIN. FT.		450	450			450	450	Ø	100
X	606	END ANCHORAGE TYPE 3E	EACH		4	4			4	4	Ø	100
X	606	BRIDGE RAIL TYPE 3R	LIN. FT.				152	152	152	152	Ø	100
X	607	END POST	EACH		26	15			26	15	-11	58
X	607	CORNER AND LINE BRACE POST	EACH		13	17			13	17	+4	131
X	607	FENCE BARBED WIRE WITH METAL POSTS	LIN. FT.		2340	2,265			2340	2,265	-75	97
X	607	FENCE COMBINATION WIRE WITH METAL POSTS	LIN. FT.		1394	1,426			1394	1,426	+32	102
X	607	16 FOOT GATE	EACH		2	1			2	1	-1	50
X	607	20 FOOT GATE	EACH		3	3			3	3	Ø	100
X	607	24 FOOT GATE TWIN	EACH		2	2			2	2	Ø	100
X	612	Delineator (Type I)	Each		35	42			35	42	+7	120
X	612	Delineator (Type II)	Each		12	35			12	35	+23	275
X	612	Delineator (Type III)	Each		2	2			2	2	Ø	100
X	614	FLAGGING	Hour		2,000	784.5			2,000	784.5	-1,215.5	39
X	614	Traffic Control Supervisor	Day		80	64			80	64	-16	80

SUMMARY OF APPROXIMATE QUANTITIES

AS CONSTRUCTED		FEDERAL ROAD REGION NO.	DIVISION	PROJ. NO.	SHEET NO.	TOTAL SHEETS
NO REVISIONS	REVISED 10-5-85	VOID	VIII	COLORADO	FR 014-2(12)	7
						27

INDEX		CONTRACT		UNIT			PLAN ROADWAY	AS CONSTR. ROADWAY		PLAN STRUCTURE NO. B-17-DJ	AS CONSTR. STRUCTURE NO. B-17-DJ			PLAN PROJECT TOTALS	AS CONSTR. PROJECT TOTALS	DIFF.	% PLAN
BOOK	SHEET	ITEM NO.	ITEM														
X		614	BARRICADE (TYPE 3M-B) (TEMPORARY)	EACH			2	2						2	2	0	100
X		614	CONSTRUCTION TRAFFIC SIGN (PANEL SIZE B)	EACH			17	38						17	38	+21	224
X		614	TRAFFIC CONES (28")	EACH			0	120						0	120	+120	-
X		614	VERTICAL PANEL	EACH			50	38						50	38	-12	76
X		614	VERTICAL PANEL (WITH LIGHT) (FLASHING)	EACH			20	6						20	6	-14	30
X		614	CONCRETE BARRIER (TEMPORARY)	LIN.FT.			302	314						302	314	+12	104
X		617	18 INCH CULVERT PIPE - (DELETED)	LIN.FT.			10	0						10	0	-10	0
X		617	24 INCH CULVERT PIPE - (DELETED)	LIN.FT.			12	0						12	0	-12	0
X		617	30 INCH CULVERT PIPE - (DELETED)	LIN.FT.			6	0						6	0	-6	0
X		617	24 INCH CMP (CLIP)	LIN.FT.			0	6						0	6	+6	-
X		620	FIELD LABORATORY (CLASS 3)	EACH			1	1						1	1	0	100
X		620	SANITARY FACILITY	EACH			1	1						1	1	0	100
X		626	MOBILIZATION	L.S.			0.8	0.8						1	1	0	100
X		627	PAVEMENT MARKING PAINT	GAL.			83	153						83	153	+73	184
			FORCE ACCOUNT														
CMD #1		F/A01	MINOR CONTRACT REVISIONS	F.A.			(14,400.00) 0.8	0						(14,400.00) 1	\$198.55 \$1,801.45		2.5
		F/A02	M.B.E. INCENTIVE PAYMENT	F.A.			(15,000.00) 1							(15,000.00) 1	\$14,992.57 \$19,992.57		300
X		F/A03	FINAL SIGNING (BY STATE FORCES)	F.A.			1	1						1	1	0	100
X		F/A04	ON-THE-JOB TRAINEE	EACH			2	2						2	2	0	100

FINAL STRUCTURE QUANTITIES

AS CONSTRUCTED		FED. ROAD DIVISION	PROJ. NO.	SHEET NO.	TOTAL SHEETS
NO REVISIONS	REVISED	12-25-85	VOID	XIII	CLD.
		FR 014-2(12)	8	32	

INDEX	LOCATION	REMOVAL OF STRUCTURE	UNCLASSIFIED EXCAVATION	STRUCTURE EXCAVATION	STRUCTURE BACKFILL	MANHOLE ADJUST	HOT BITUMINOUS PAVEMENT	RESET MAILBOX STR.	CONCRETE BOX	REINFORCING STEEL	CONCRETE WALL	CULVERT			PIPE		"H" OVER CULV.	END SECTION		MISCELLANEOUS									
												CUBIC YARD	CUBIC YARD	CUBIC YARD	TON	TON		EACH	CL. A		LB.	CUBIC YARD	12"	18"	18"	24"	30"	FT.	EACH
X	-4+00 TO 0+00 0+00 TO 3+00																			174 sq. ft. REMOVAL OF PAVEMENT MARKING.									
	6+74		25					1																					
	7+00																												
	9+52	1																		(MANHOLE) - REMOVED BY UTILITY COMPANY									
	9+730 TO 10+40.3																			(PIPE SUPPORT) REMOVED BY UTILITY COMPANY									
	9+85	1																		REMOVED UNSUITABLE MATERIAL AT C&C (MANHOLE)									
X	10+				490	490	490													REMOVED UNSUITABLE MATERIAL AT C&C (MANHOLE)									
X	10+67	1																		REMOVED UNSUITABLE MATERIAL AT C&C (MANHOLE)									
X	11+28		60.2																	REMOVED UNSUITABLE MATERIAL AT C&C (MANHOLE)									
X	11+84		35			5.0														REMOVED UNSUITABLE MATERIAL AT C&C (MANHOLE)									
X	12+95		16.3			7.4														REMOVED UNSUITABLE MATERIAL AT C&C (MANHOLE)									
X	13+70		20																	REMOVED UNSUITABLE MATERIAL AT C&C (MANHOLE)									
X	13+91		15			4.5														REMOVED UNSUITABLE MATERIAL AT C&C (MANHOLE)									
X	14+36		12.4																	REMOVED UNSUITABLE MATERIAL AT C&C (MANHOLE)									
X	14+60		9.7			3.6														REMOVED UNSUITABLE MATERIAL AT C&C (MANHOLE)									
X	15+27		40.5																	REMOVED UNSUITABLE MATERIAL AT C&C (MANHOLE)									
X	16+21		41.2																	REMOVED UNSUITABLE MATERIAL AT C&C (MANHOLE)									
X	16+21		50																	REMOVED UNSUITABLE MATERIAL AT C&C (MANHOLE)									
	18+08																			REMOVED UNSUITABLE MATERIAL AT C&C (MANHOLE)									
	18+70																			REMOVED UNSUITABLE MATERIAL AT C&C (MANHOLE)									

See Bridge Summary of Quantities for additional quantities

* See Surfacing Plan For Quantity

FINAL STRUCTURE QUANTITIES

AS CONSTRUCTED		FED. ROAD REGION	DIVISION	PROJ. NO.	SHEET NO.	TOTAL SHEETS
NO REVISIONS	REVISED	XIII	CD.	FR 014-2(12)	9	32

INDEX	L O C A T I O N	REMOVAL OF STRUCTURE	UNCLASSIFIED EXCAVATION		STRUCTURE EXCAVATION	STRUCTURE BACKFILL	MANHOLE ADJUST		HOT BITUMINOUS PAVEMENT	RESET MAIL BOX STR.	CONCRETE BOX	STEEL	CONCRETE WALL	CULVERT		PIPE	"H"	OVER CULV.	END SECTION		MISCELLANEOUS
			EXCAVATION	EMB	CL. 2	CL. 2	EACH	TON						PLAN	FINAL	FEET					
X	20+72		35.0	50		Ø	11.2		20					62	62						
X	20+74							1													
X	21+62		58.4	90		21	Ø	10	4.3					Ø	24	Ø					
X	22+70									1											
	24+ TO 31+		Ø	80																	
X	25+89		27.4	65		6	Ø	5	4.3					Ø	24	Ø					(DELETED NEW 30" CULVERT) 20711. FT. ~ REMOVAL OF PIPE
X	25+91																				
X	26+67							1	Ø												
X	30+71								1												
X	34+70																				
X	34+90		52.6			Ø	4.0		1					Ø	22						622 200 SA FT ~ REMOVAL OF PAVEMENT MARKING
X	35+ TO 36+																				
	TOTALS	1	80	356	522	490	509	549	2	4	150	Ø	28	Ø	209	327	Ø	Ø	Ø	Ø	

•-Quantity carried to Surfacing Plan.
▲-Quantity carried to Summary of Earthwork.

SURFACING PLAN

STATION TO STATION	SOURCE	QUANTITY TONS				GRADING EX	
		HOT BITUMINOUS PAVEMENT		MIDDLE LAYER		TOP LAYER	
		WEDGE BETWEEN EXISTING AND NEW ROADWAY AND FILLING MEDIAN PLAN FINAL		BOTTOM LAYER PLAN FINAL		PLAN FINAL	
-4+00 3+00 TO 7+00				114	225	348	464
7+00 TO 9+10		50		60	164	218	965
9+10 TO 11+00	D			127	210	152	201
11+00 TO 15+50	H	98		212	562	355	437
15+50 TO 23+25	K	169		208	589	629	959
23+25 TO 26+00	N	60		61	201	198	802
26+00 TO 29+25	H	71		66	222	222	
29+25 TO 32+00	M	60		61	198	198	
32+00 TO 36+21	D	92		101	319	319	
WEST APPROACH TO PROJECT EAST APPROACH TO PROJECT FROM STRUCTURE QUANTITIES IRREGULARITIES	B	90		152	143	75	90
SUB TOTAL		690	850	1,160	1,356	2,766	3,191
TOTAL					PLAN 7,807	6,943 FINAL *	2967

Note: Stabilization Based on

1. 18th E.D.L.A

2. Regional Factor

3. Serviceability Index

4. R Value

5. W.S.N.(4lane)

W.S.N.(2lane)

243(4lane),324(2 lane)

0.5

2.5

6.0(borrow),18(subgrade)

3.45(overlay),2.0(widening)

3.62(overlay),2.18(widening)

Strength Coefficients

6. Hot Bituminous Pavement

7. Asphalt Mat (Existing)

8. Subbase (Existing)

.44

.26

.10

*NOTE - PROFILE GRADES WERE ADJUSTED TO REDUCE
ASPHALT REQUIRED TO PRODUCE PROPER SURFACE.

AS CONSTRUCTED		FED. ROAD SECTION	DIVISION	REQ. NO.	SHEET NO.	SHEET TOTALS
NO REVISIONS	REVISED	12-15-87	VOID		10	32
		VIII	COLO.	FR 014-2(12)		

FENCING TABULATION

STATION TO STATION	SIDE	REMOVE FENCE LINEAR FEET		COMBINATION WIRE FENCE WITH METAL POSTS LINEAR FEET		BARBED WIRE FENCE WITH METAL POSTS LINEAR FEET		GATES-EACH							
		PLAN	FINAL	PLAN	FINAL	PLAN	FINAL	16 FOOT	18 FOOT	20 FOOT	24 FOOT	24 FOOT	24 FOOT	24 FOOT	24 FOOT
5+89 TO 11+78 7+48 TO 11+78 11+84	RT	740	872 63 13	579	565	940	1007	1	1				1	1	
11+94 TO 21+54 +5+12 15+27		960	927			940	1007			1	1				
21+62 TO 25+79		417	Ø			417	370								
25+99 TO 36+21 25+82 32+71 34+90		1021	803			983	866			1	1				
4+63 TO 6+81 7+16 TO 7+42 7+58 TO 7+75 7+75	LT	218 26 17	235	183 26 17 30	211 16 67 31								Ø	1	
7+75 TO 11+44 11+44 TO 11+48 11+48 TO 13+76 13+05 13+88 TO 15+00 14+51		219 228 112	Ø Ø 103	219 32 212 96	392 144 Ø			1	Ø				1	Ø	
TOTAL		3958	3096	1394	1426	2340	2265	2	1	Ø	Ø	3	3	2	2

REMOVAL OF GATES WILL BE INCLUDED IN REMOVAL OF FENCE ITEM
IT IS ESTIMATED THAT 13 CORNER AND LINE BRACE POSTS AND 26 END POSTS WILL BE REQUIRED FOR THIS PROJECT
ALL END POSTS AND CORNER AND LINE BRACE POSTS SHALL BE METAL

AS CONSTRUCTED
NO REVISIONS
REVISED
VOID

FED. ROAD REGION VII1
DIVISION COLO.
PROJECT NO. FR 014-2(12)
SHEET NO. 11
SHEET TOTALS 32

SCHEDULE OF
CONSTRUCTION TRAFFIC CONTROL
DEVICES

SIGN CODE	LEGEND	DIMENSIONS	PANEL SIZE EACH			MISC. QUANTITIES EACH
			A	B	FINAL	
48 W20-1	Road/Const./ (Dist.)	48" x 48"	3		9	
48 W20-2	Detour (Dist.)	48" x 48"	2		3	
48 W4-2(R)	Rt Lane Transition	48" x 48"	1		1	
48 M4-2(L)	Lt Lane Transition	48" x 48"	1		0	
48 W20-7a	FLAGGER SYMBOL	48" x 48"	2		0	
48 W20-50	BE / PREPARED / TO / STOP	48" x 48"	2		0	
48 R11-2	Road / Closed Detour Arrow Rt.	48" x 30"	1		1	
48 M4-10(R)	Road / Closed Detour Arrow Lt.	48" x 30"	1		1	
48 R11-2	Road / Closed Detour Arrow Lt.	48" x 30"	1		1	
36 R2-1(40)	SPEED / LIMIT / 40	36" x 48"	2		3	
60 G20-2	END / CONSTRUCTION	60" x 24"	2		3	
VERTICAL PANEL						50 36
VERTICAL PANEL (LIGHT) (F)						20 6
CONCRETE BARRIER (TEMP.)						302 314
BARRICADE (3-M8) (TEMP) *						2
TRAFFIC CONES (28")						0 120
Sub-TOTALS			17		29	

SIGN CODE	LEGEND	DIMENSIONS	PANEL SIZE	
			Final	Initial
48 W20-4	ONE / LANE / ROAD	48" x 48"	0 2	
48 W20-5	— LANE / CLOSED	48" x 48"	0 1	
36 R2-1(25)	SPEED / LIMIT / 25	36" x 48"	0 2	
48 W1-3(L)	Double 90° Angle Rt. Arrow	48" x 48"	0 1	
48 W1-3(L)	Double 90° Angle Lt. Arrow	48" x 48"	0 2	
48 W20-7a	FLAGGER / 1500'	48" x 48"	0 1	
Sub-Totals			0 9	
Panel Size B Totals			0 9	17 36


TABULATION OF REMOVAL OF ABANDONED
IRRIGATION STRUCTURES *
(FOR INFORMATION ONLY)

STATION	Structure to be removed	Approximate Size of the Structure
12+01 Rt.	concrete irrigation structure	2' x 3' x 6'
12+02 Rt.	concrete irrigation structure	2' x 3' x 6'
15+00 Rt.	concrete division box	3' x 3' x 10'
15+41 Rt.	concrete irrigation structure	3' x 3' x 8'
24+38 Rt.	concrete division box	3' x 3' x 20'
28+26 Rt.	concrete division box	3' x 3' x 12'
29+91 Rt.	concrete division box	3' x 3' x 9'
32+80 Rt.	concrete irrigation structure	3' x 3' x 4'
32+28 Rt. to 36+ Rt.	concrete pipe	18" x 400'
31+20 Rt.	concrete division box	3' x 3' x 12'

* Paid for as removal of structures and obstructions, L.S.

NO STRUCTURES THESE LOCATIONS.

MODIFY MANHOLE - DETAIL

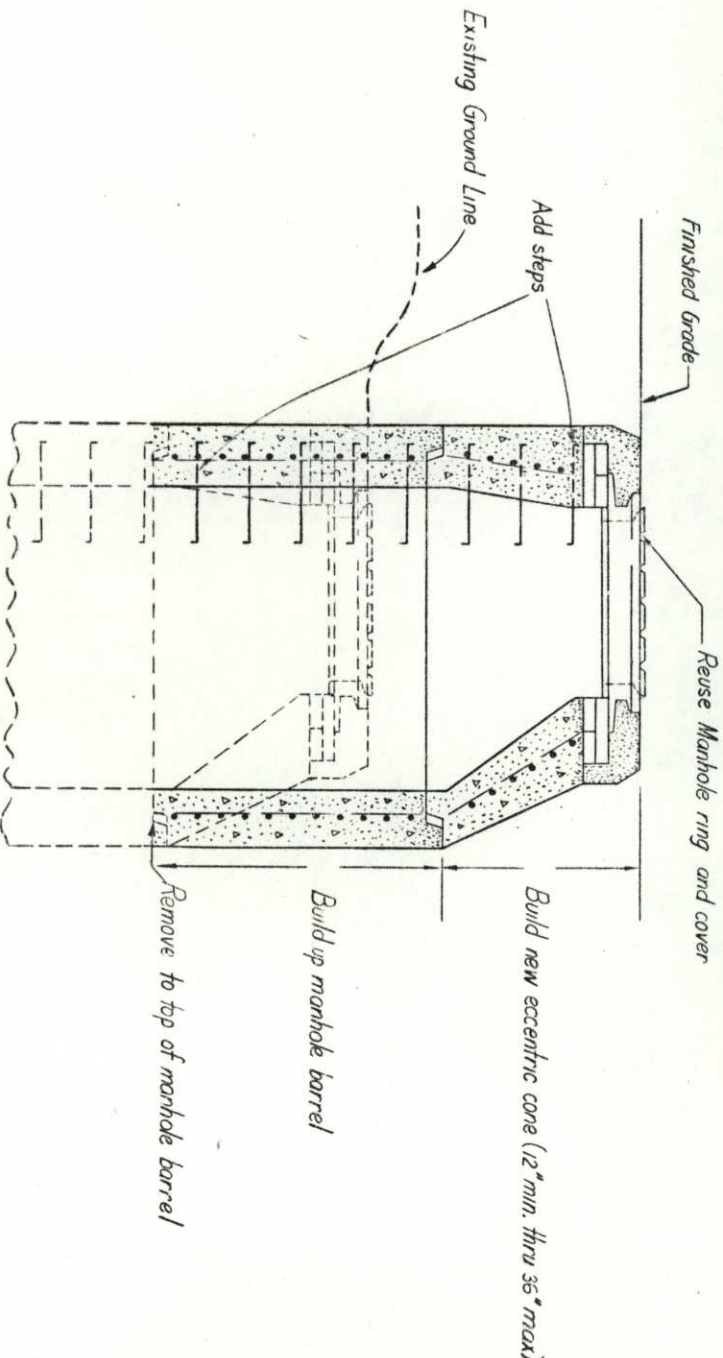

NOTES

52
It is estimated that 10 gallons of pavement marking paint
21 (8 gallons white, 8 gallons yellow) will be required for the
construction detour. The rate of application shall be not
less than 200 per more than 220 sq ft per gallon for
this quantity only. It is further estimated that 1500 sq ft
of pavement marking removal will be required for same.

* 3-M8 barricades to be furnished with flashing warning lights.

SUMMARY OF EARTHWORK QUANTITIES

INDEX	BOOK PAGE SHEET		PROJECT TOTALS	
			PLAN	FINAL
X	X	EMBANKMENT MATERIAL (COMPLETE IN PLACE)	Cu. Yd.	
		ROADWAY	23,480	23,833
		STRUCTURE QUANTITIES AS EMBANKMENT	460	356
		TOTAL FOR PAY QUANTITIES	23,940	24,189
		FOR INFORMATION ONLY *		
		COMPACTION (AASHTO T99)	Cu. Yd.	
		EMBANKMENT (NET)	23,480	
		BASE OF CUTS AND FILLS	4,830	
		STRUCTURE QUANTITIES AS EMBANKMENT (NET)	460	
		TOTAL	28,770	*
		WETTING	Mgal	
		COMPACTION (AASHTO T99)	1,151	
		TOTAL	1,151	*
		ROADWAY QUANTITIES BALANCE (FOR INFORMATION ONLY)	Cu. Yd.	
		Excavation		
		Unclassified (From Cross Sections)	312	
		* Borrow From Undesignated Source	33,204	
		TOTAL	33,516	*
		EMBANKMENT Net		
		ROADWAY (From Cross Sections)	23,480	
		STRUCTURE QUANTITIES AS EMBANKMENT	460	
		TOTAL	23,940	*
		EMBANKMENT x Factor (1.4)	32,872	
		ROADWAY (From Cross Sections)	644	
		STRUCTURE QUANTITIES AS EMBANKMENT		
		TOTAL	33,516	*

* Borrow Material shall have a minimum R value of 60.

TABULATION OF DELINEATORS *

AS CONSTRUCTED				FED. ROAD REGION		DIVISION		PROJ. NO.		SHEET NO.		SHEET TOTALS	
NO REVISIONS	REVISED	VOID		VIII		COLO.		FR 014-2(12)		13		22	

Location	Type I		Type II		Type III	
	LT.	RT.	LT.	RT.	LT.	RT.
-4+00						
Sta. 3+88 to Sta. 7+	1	1	4		0	4
Sta. 7+ to Sta. 12+	5	4	3	7		
Sta. 12+ to Sta. 18+	8	0	0	2	6	7
Sta. 18+ to Sta. 28+	7	13	4	3	4	
Sta. 28+ to Sta. 36+	2	1	0	3	4	0
SUBTOTALS	23	31	2	11	6	16
TOTALS	35	42	12	33	1	1

* It is estimated that 30% removal of delineators were required on this project.



GUARD RAIL

Station	Side	Guard Rail Type 3 6'-3" Post Spacing		End Anchorage Type 3E
		LT.	RT.	
Sta. 8+23 to Sta. 9+73	RT	75'	75'	1
Sta. 8+98 to Sta. 9+73	LT		75'	1
Sta. 10+40 to Sta. 11+15	RT		75'	1
Sta. 10+40 to Sta. 11+90	LT	75'	75'	1
TOTALS		FINAL=450		FINAL=4

▲ Guard rail to be galvanized

PLAN	SURVEYED	BY	DATE
NOTE BOOK	PLOTTED		
No.	ALIGNED		
	ST. OF WAY CHECKED		

PROFILE	SURVEYED	BY	DATE
NOTE BOOK	PLOTTED		
No.	GRADES CHECKED		
	R. M. NOTED		
	STRUCTURE NOTATIONS CHECKED		

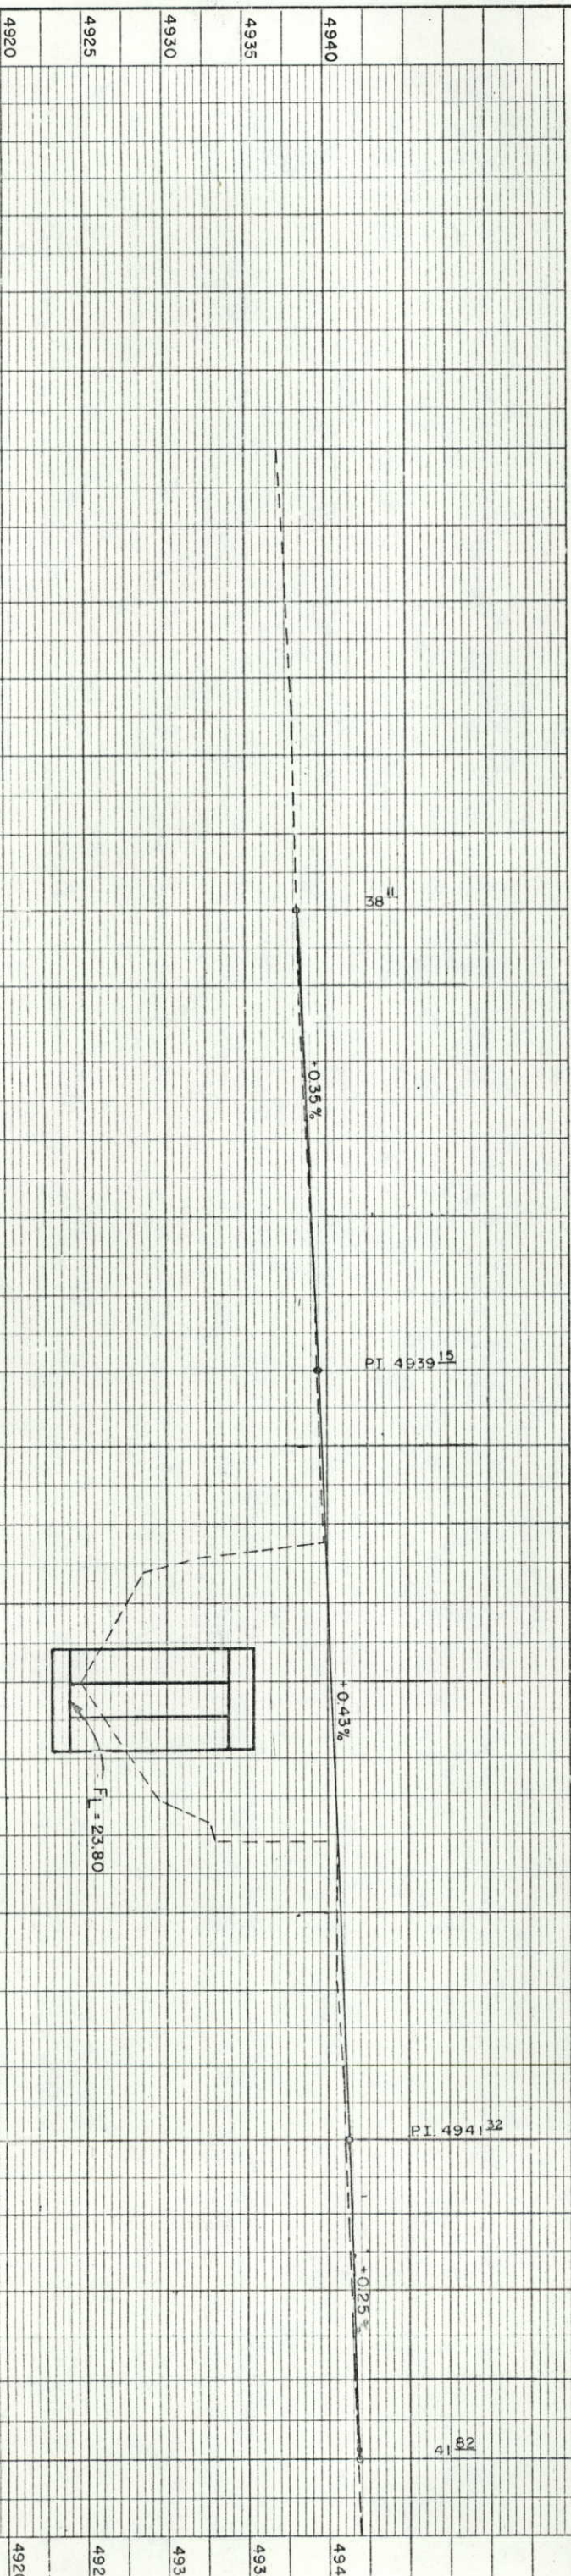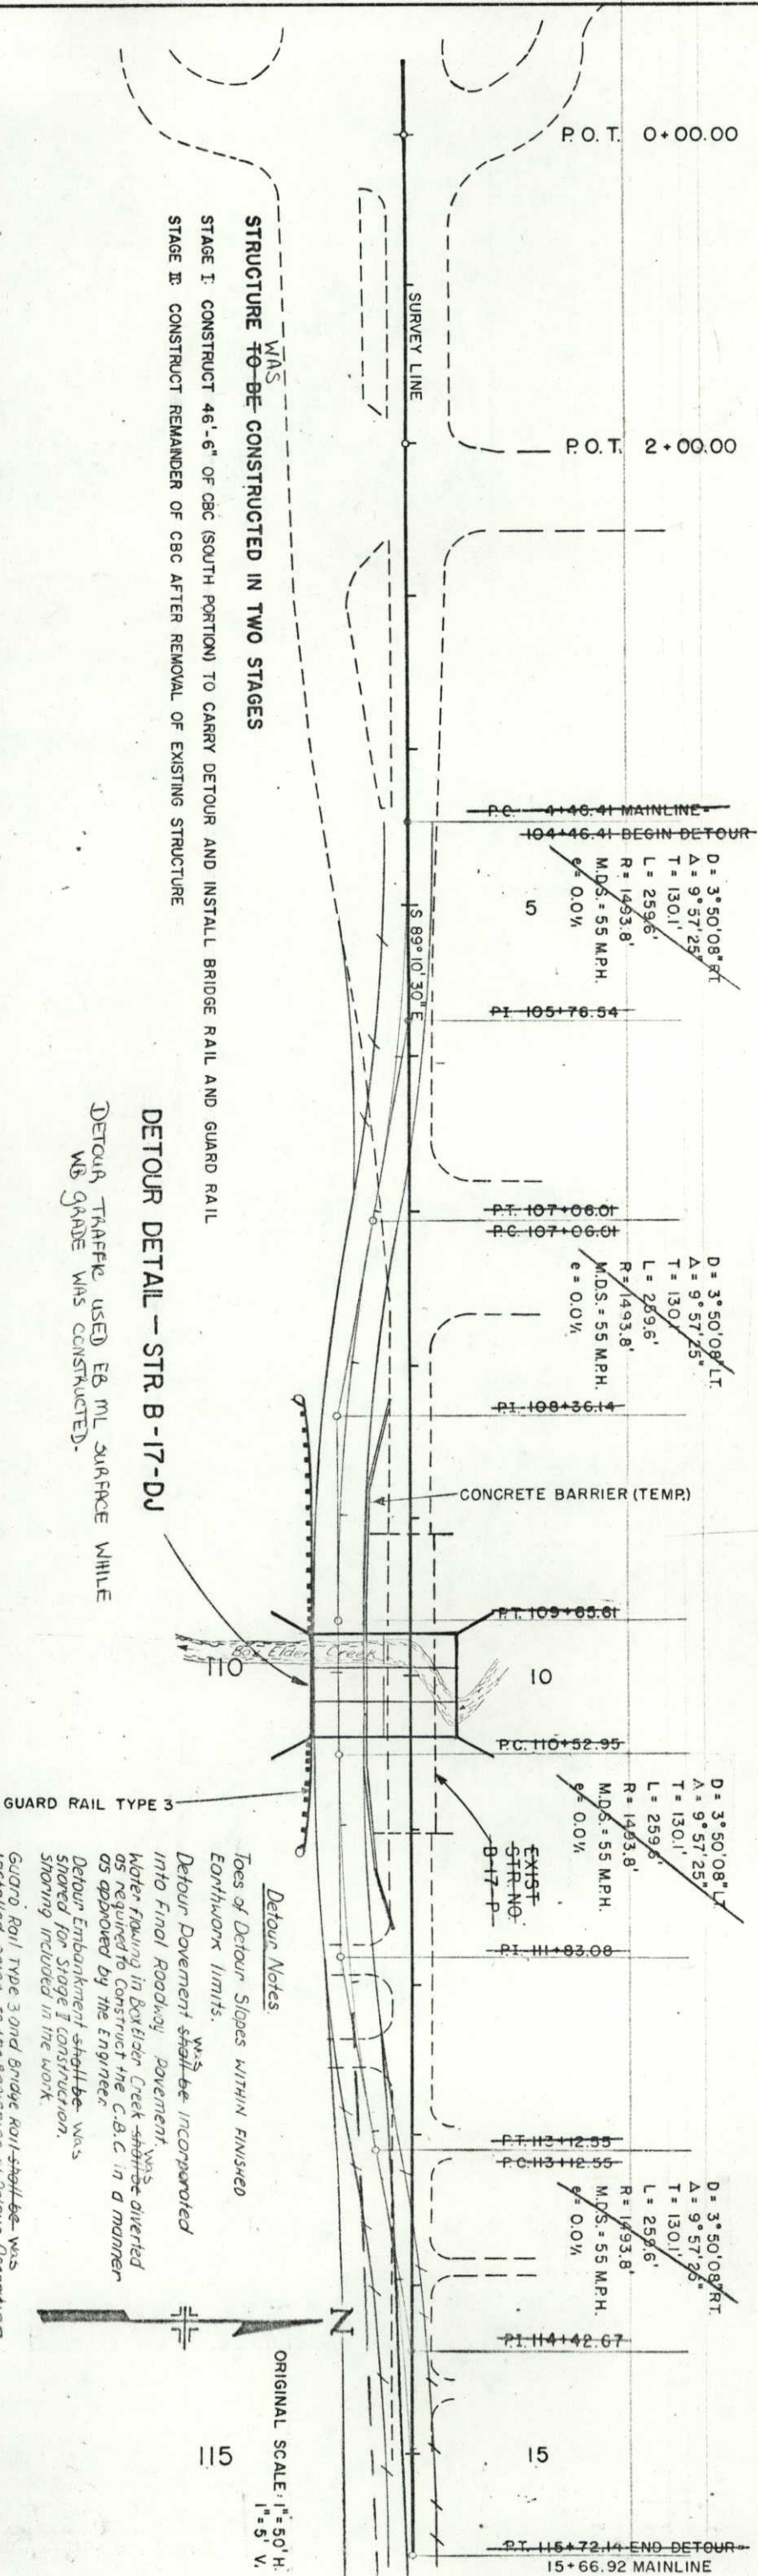


AS CONSTRUCTED	REVISIONS	VOID
NO REVISIONS		

FEDERAL ROAD NO.	DIVISION	PROJECT NO.	SHEET NO.	TOTAL SHEETS
VIII	COLORADO	FR 014-2(12)	14	32

FEDERAL ROAD DISTRICT NO.	DIVISION	PROJ. NO.	SHEET NO.	TOTAL SHEETS
VIII	COLORADO	FR 014 - 2(12)	15	32
AS CONSTRUCTED				
NO REVISIONS				
REVISED				
VOID				

DETAIL OF MEDIAN TRANSITION AND PROFILE GRADE

ORIG. SCALE: 1"=50'

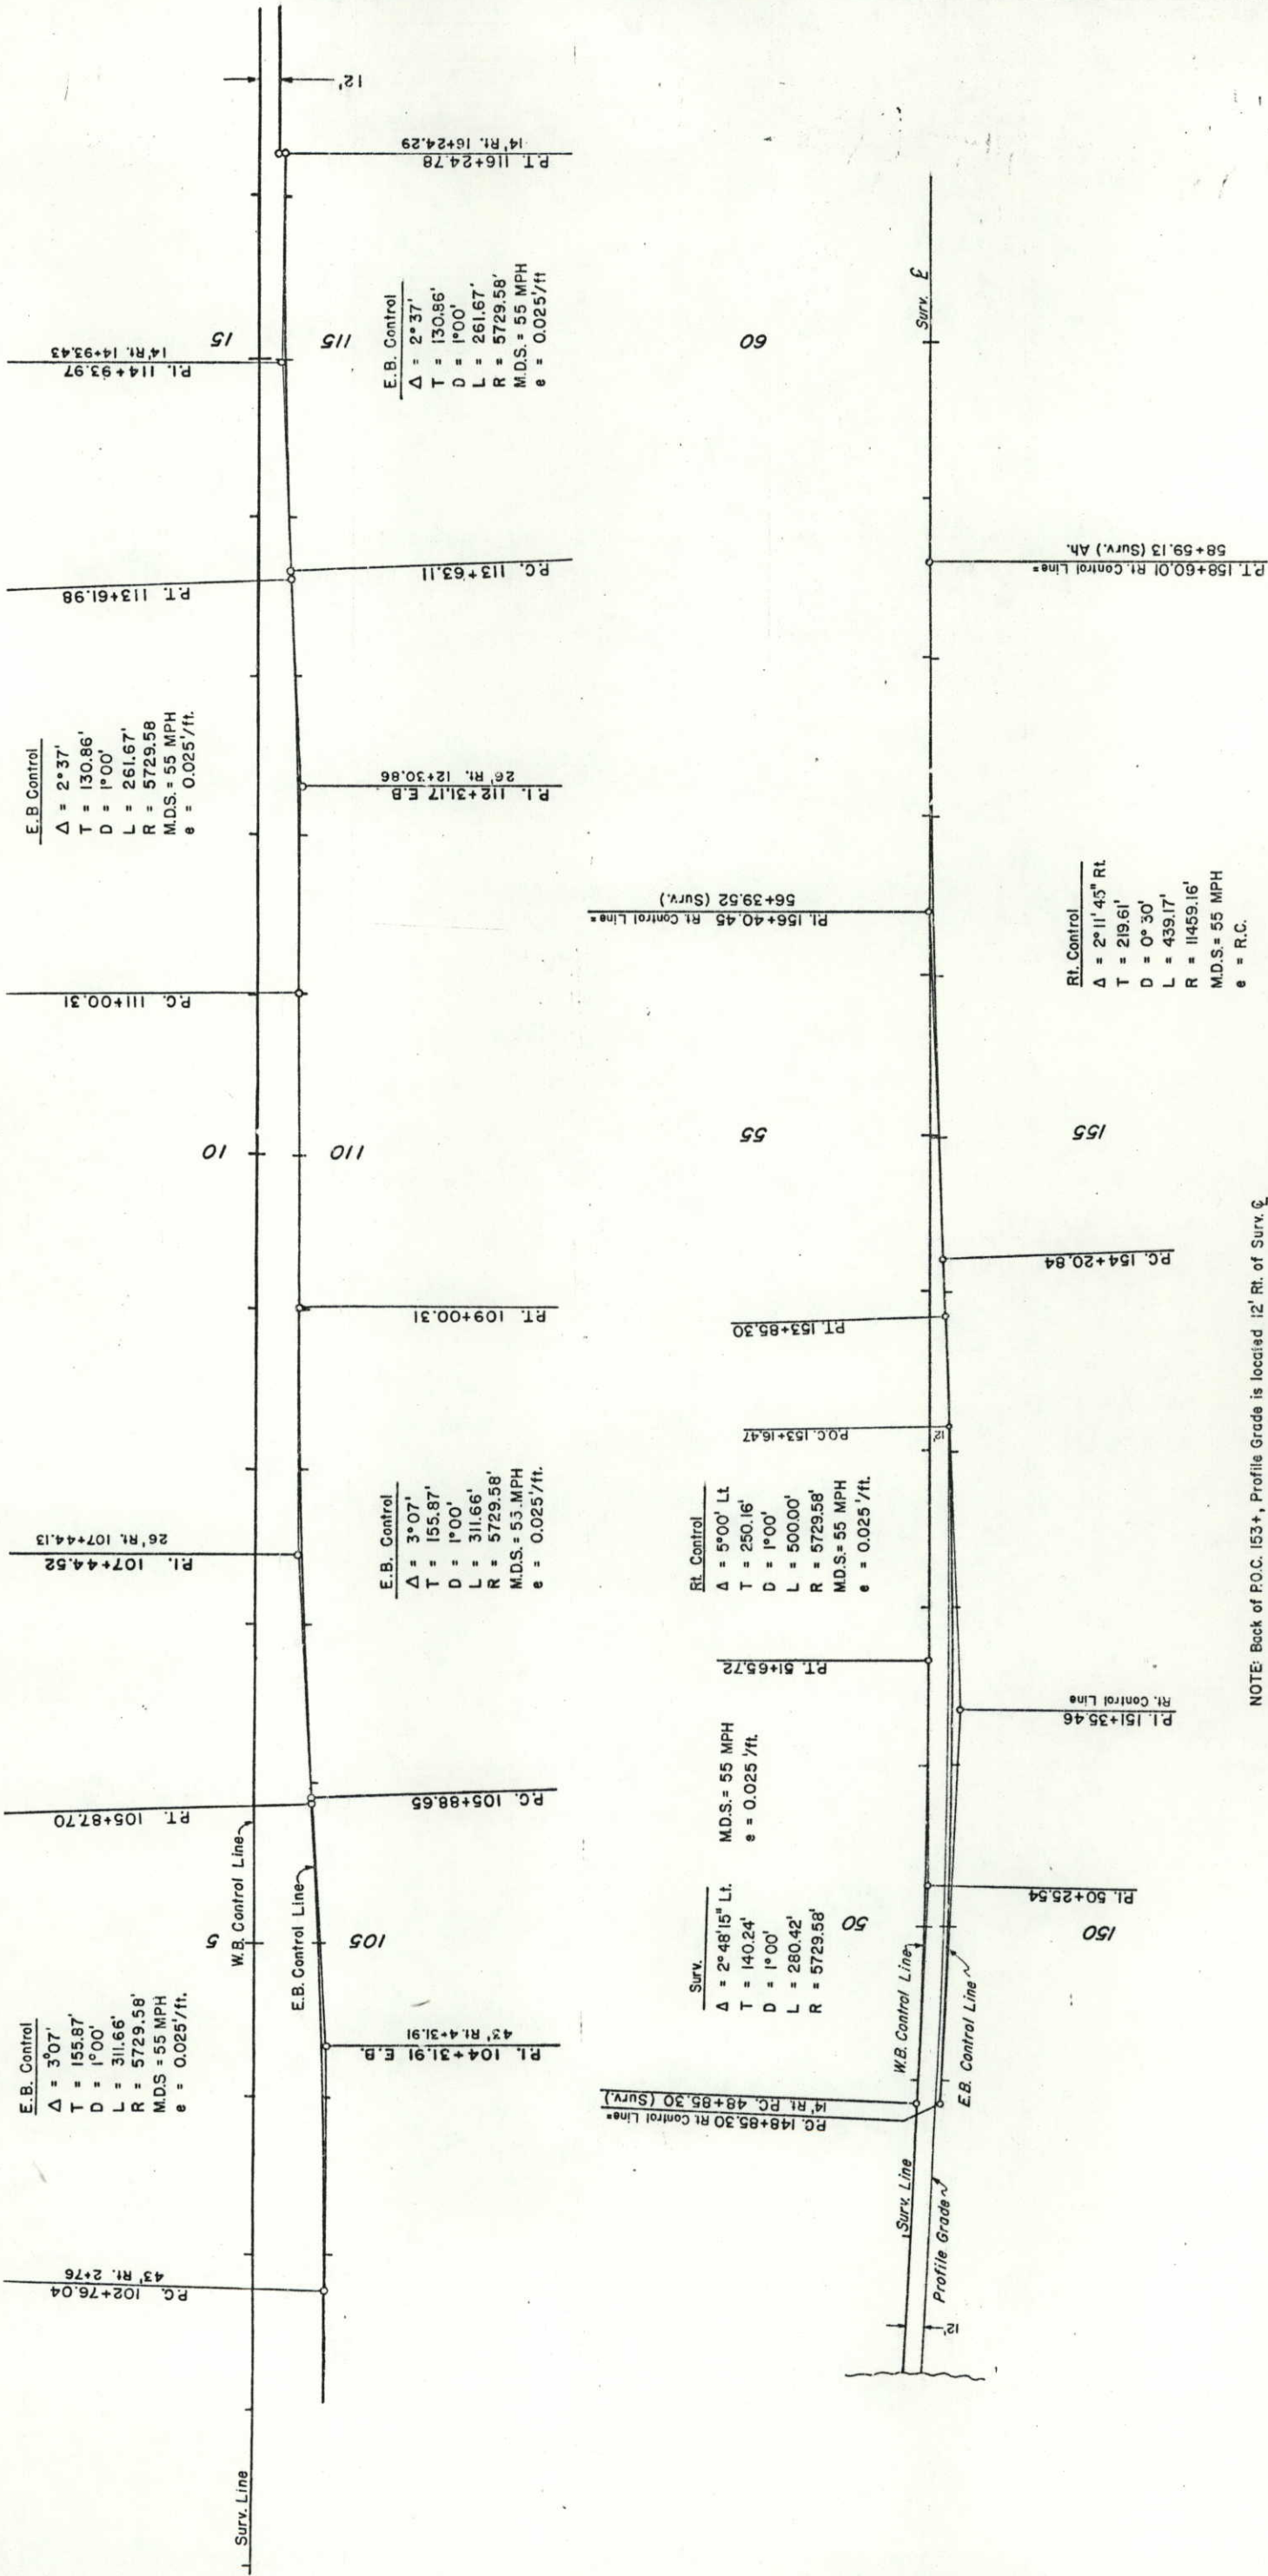

GENERAL NOTES

ALL WORK SHALL BE DONE ACCORDING TO THE STANDARD SPECIFICATIONS OF THE DIVISION OF HIGHWAYS, STATE OF COLORADO, APPLICABLE TO THE PROJECT.
STRUCTURE EXCAVATION AND BACKFILL SHALL BE IN ACCORDANCE WITH STANDARD M-206-1, EXCEPT AS NOTED.
EXPANSION JOINT MATERIAL SHALL MEET AASHTO SPECIFICATION M-213.

GRADE 60-REINFORCING STEEL IS REQUIRED.

THE FOLLOWING TABLE GIVES THE MINIMUM LAP SPlice LENGTH FOR REINFORCING BARS:

BAR SIZE	#4	#5	#6	#7	#8	#9	#10
SPlice LENGTH FOR CLASS A CONCRETE	1'-0"	1'-3"	1'-3"	2'-3"	3'-0"	3'-10"	4'-10"

E.F. = EACH FACE
F.F. = FAR FACE
N.F. = NEAR FACE

FOR STRUCTURE NUMBER INSTALLATION, SEE STANDARD S-614-12.

STATIONS, ELEVATIONS, AND DIMENSIONS CONTAINED IN THESE PLANS ARE CALCULATED FROM A RECENT FIELD SURVEY AND THE "AS CONSTRUCTED" PLANS FOR STRUCTURE NUMBER B-174-P. THE CONTRACTOR SHALL VERIFY ALL DEPENDENT DIMENSIONS IN THE FIELD BEFORE REMOVING PORTIONS OF THE EXISTING STRUCTURE OR DRIVING PILING.

MAXIMUM DESIGN FILL HEIGHT = 5'-0"

DESIGN DATA

CURRENT AASHTO SPECIFICATIONS:

LIVE LOAD: AASHTO HS-20-44 AND INTERSTATE ALTERNATE.
DEAD LOAD: EARTH LOAD = 84 LBS./CU. FT.
EQUIVALENT FLUID PRESSURE = 30 LBS./CU. FT.

REINFORCED CONCRETE:

CLASS A CONCRETE: $f_c = 1,200 \text{ psi}$, $n = 9$

REINFORCING STEEL: $f_s = 24,000 \text{ psi}$

STRUCTURAL STEEL: AASHTO M-183 (ASTM A-36) $f_s = 20,000 \text{ psi}$

DESIGNED BY	UWD	7-82
CHECKED BY	KGS	7-82
QUANTITIES BY	SG	7-82
CHECKED BY	SG	7-82

CROSS REFERENCE DRAWING NUMBER

SECTION OR DETAIL IDENTIFICATION

AS CONSTRUCTED

NO REVISIONS

REVISED 10-15-84

VOID

FEDERAL ROAD DISTRICT NO.	DIVISION	PROJECT NO.	SHEET NO.	TOTAL SHEETS
XIII	COLORADO	FR014-2 (12)	17	22

REVISIONS

BRIDGE STANDARD 0

SUMMARY OF QUANTITIES

Item No.	Description	Unit	PLAN Total	FINAL Total
202	Removal of Portions of Present Structure	Each	1	1
206	Structure Excavation	Cu.Yd.	1710	1710
206	Structure Backfill (Class 2)	Cu.Yd.	710	710
206	Filter Material (Class B)	Cu.Yd.	25	25
502	End Plate	Each	76	76
502	Steel Pipe Piling (10 3/4 inch x 0.219)	Lin.Ft.	1173	990
502	Steel Pipe Piling (12 3/4 inch x 0.219)	Lin.Ft.	2491	2022
502	Steel Pipe Piling (10 3/4 inch x 0.219) cut-off (31' 46')	Lin.Ft.	0	12
502	Steel Pipe Piling (12 3/4 inch x 0.219) cut-off	Lin.Ft.	0	32
601	Concrete Class A (Box Culvert)	Cu.Yd.	886	886
602	Reinforcing Steel	Lb.	129,615	131,290
606	Bridge Rail Type 3R	Lin.Ft.	152	152

- ① Includes ⁹⁵100 cu. yd. Concrete Class A (Box Culvert) to fill pipe piles.
② Includes ¹¹⁶117 cu. yd. for Retaining Walls

BRIDGE DESCRIPTION

3 CELL (21'-3", 21'-3", 21'-3" X 10'-0" X 91'-0")
CONCRETE BOX CULVERT
OVER BOXELDER CREEK
90° 00' 00" SKEN
TYPE 3 BRIDGE RAIL

DIVISION OF HIGHWAYS

GENERAL INFORMATION

SUMMARY OF QUANTITIES

Station 10+00.67

Station

Near Ft. Collins Sec 10 E 15 T 7N R 68W

Designer J. DeLand


Detailer S. Greene

Drawing Number B of 5 Drawings



Approved
J. E. Siebels 8-27-82
DATE

FEDERAL ROAD REGION NO.	DIVISION	PROJ. NO.	SHEET NO.	TOTAL SHEETS
VIII	COLORADO	FR 014-2(12)	18	22

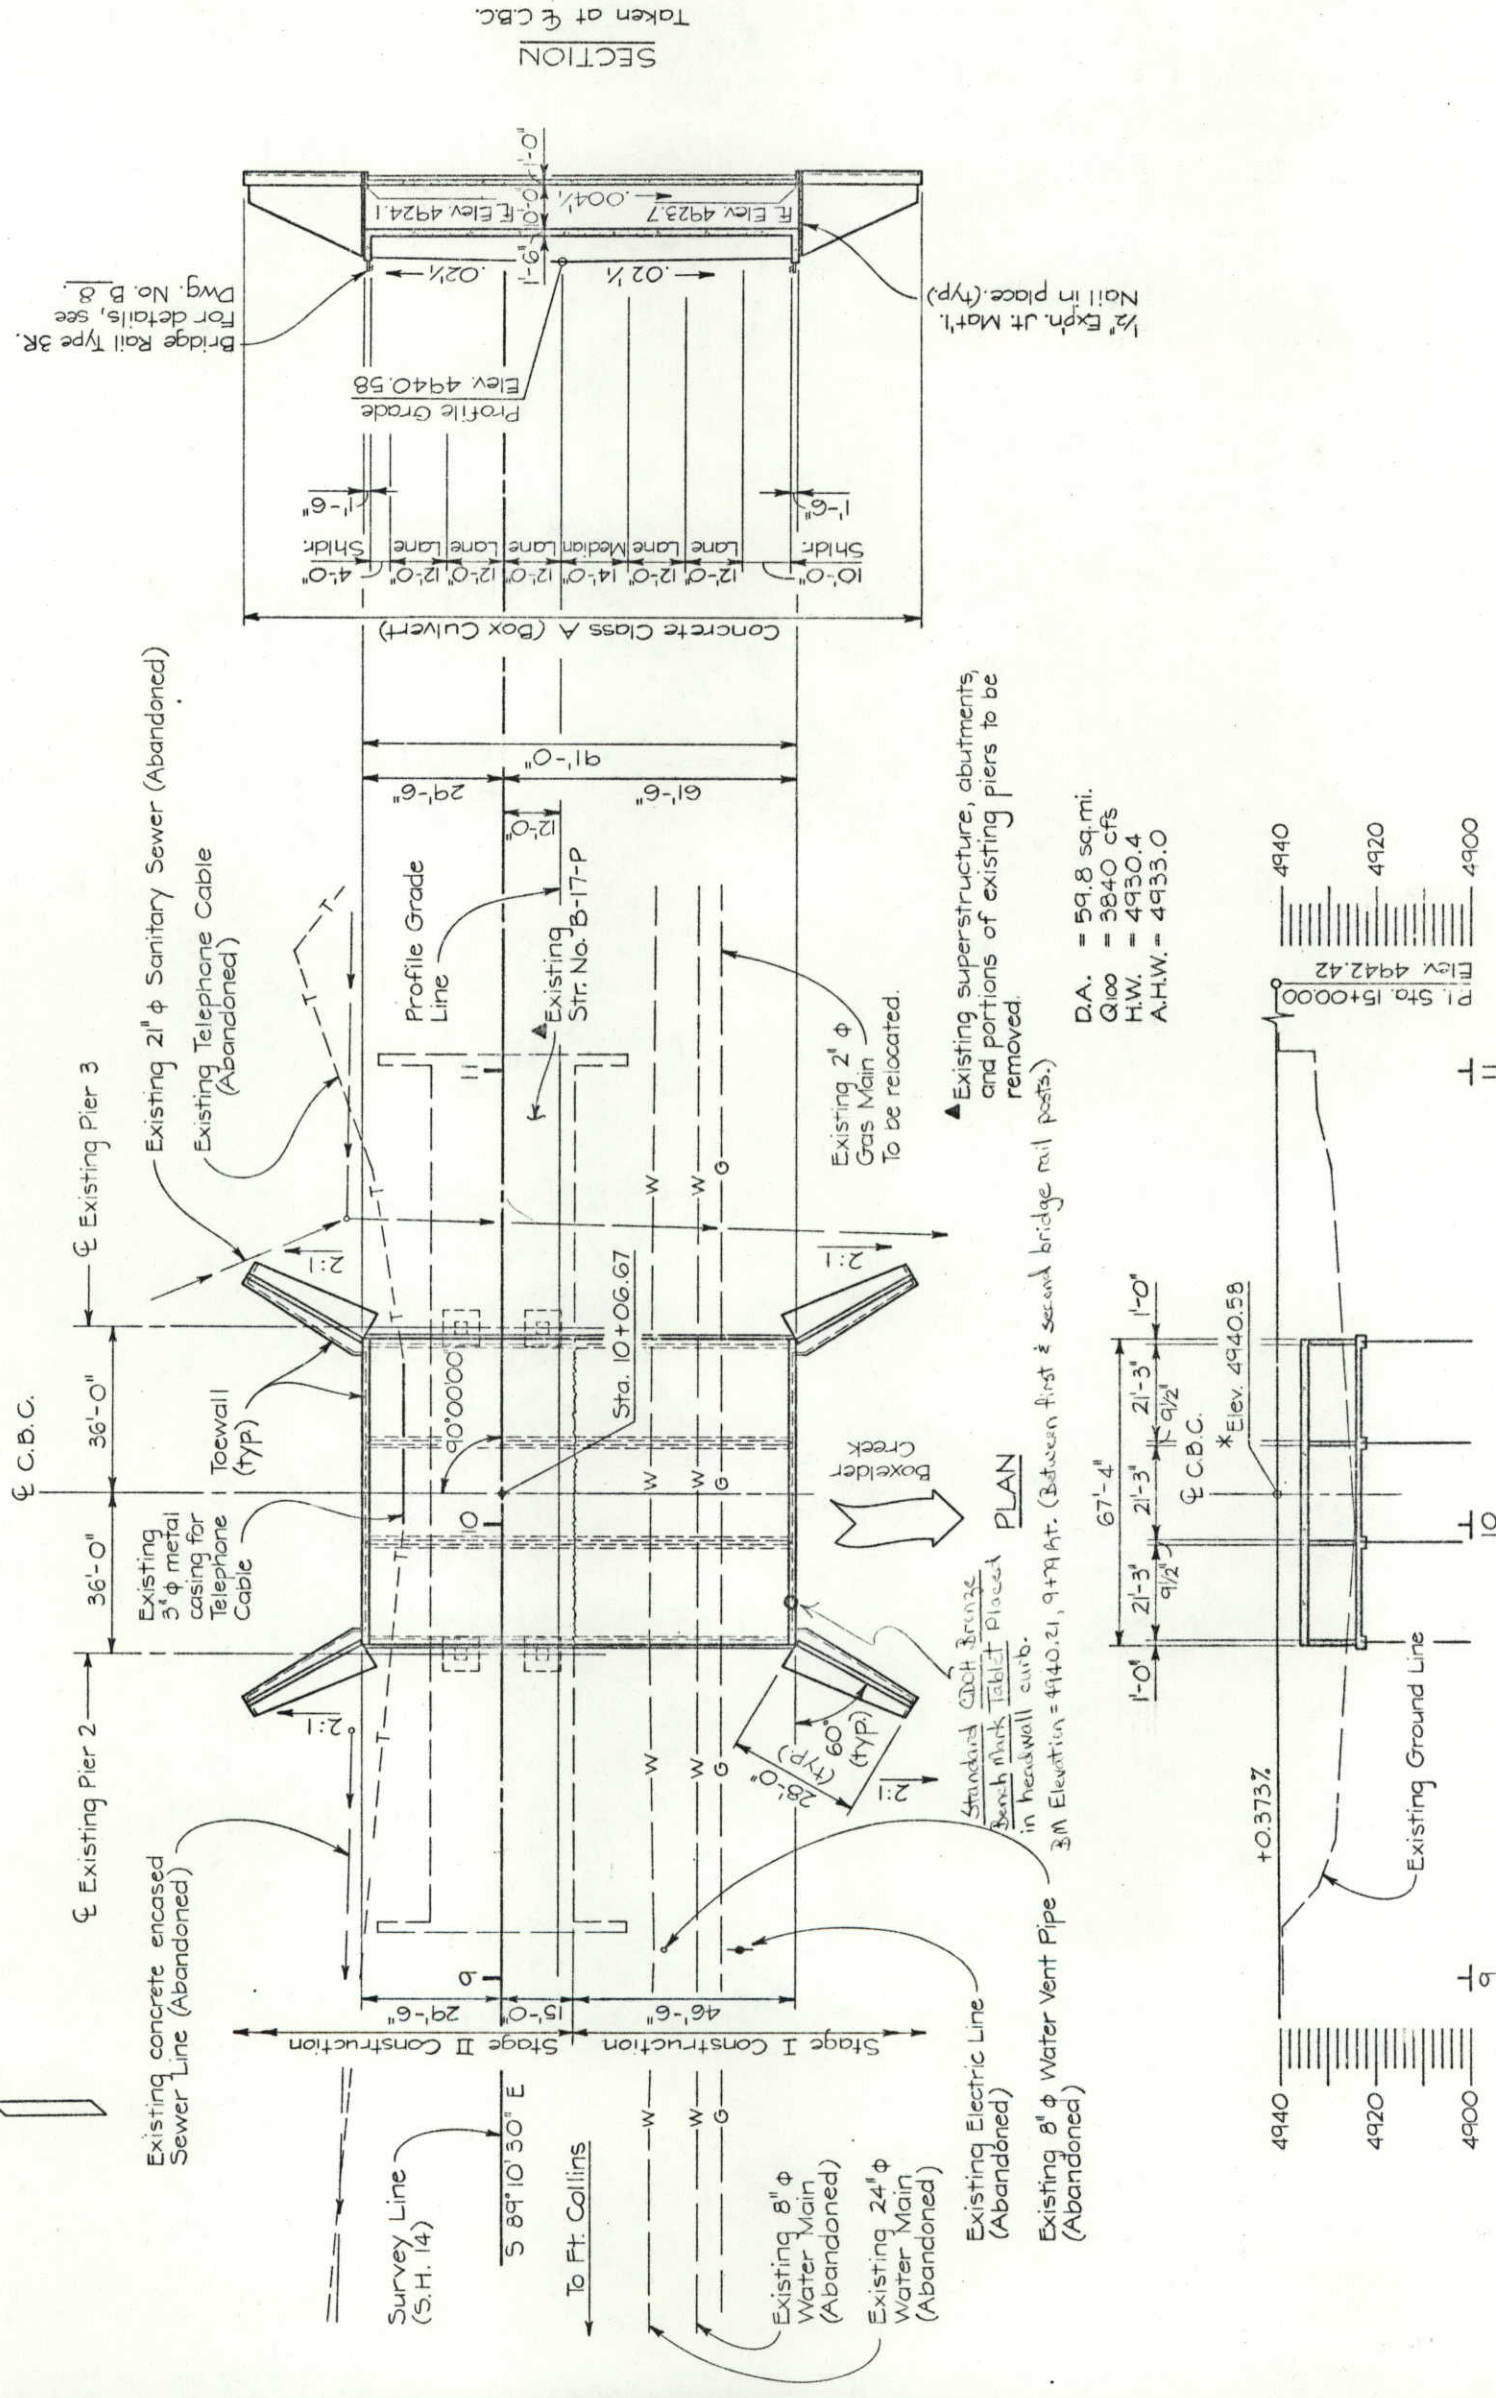[illegible]

INITIAL	DATE	CHECKED BY	JWB	7-82
DESIGNED BY	JMD	1-82	CHECKED BY	KG5
CHECKED BY	MFP	7-82	QUANTITIES BY	SG
DETAILED BY	SG	2-82	CHECKED BY	JMD
				7-82

SECTION
Taken at Profile Grade Line
* Finished Roadway Elevation

Live Loading : HS20-44 and Interstate Alternate

DIVISION OF HIGHWAYS

GENERAL LAYOUT

Designer	J. DeLand	Structure Numbers	B-17-DJ
Detailer	S. Greene		
Drawing Number B 2			of 8 Drawings

Revision Dates (Preliminary State Only)

AS CONSTRUCTED

NO REVISIONS

10-15-82

REVISED

VOID


FED. ROAD
REG. NO.
XIII

DIVISION
COLORADO

PROJECT NO.
FR C14-2(12)

SHEET
NO.
19

TOTAL
SHEETS
32

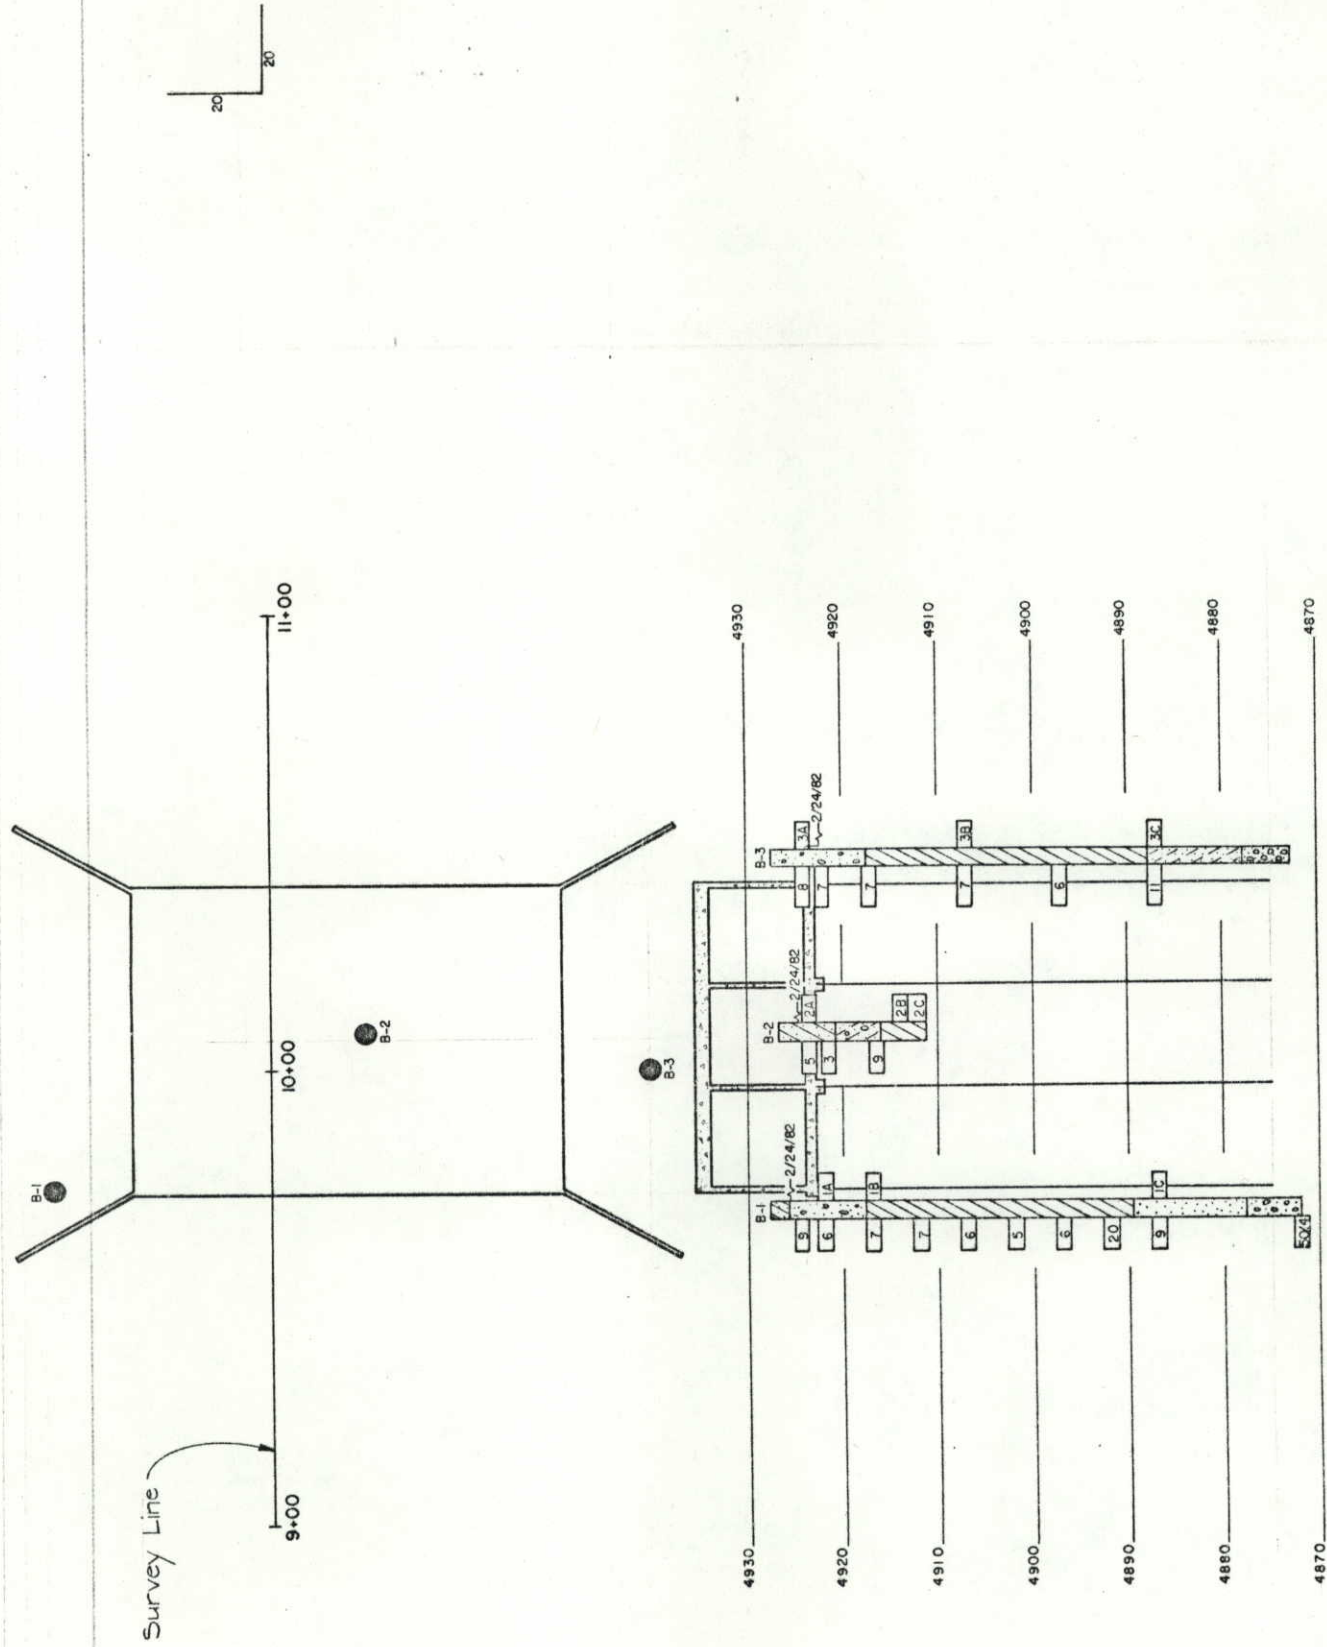


SUMMARY OF TEST RESULTS

Sample No.	Depth (ft)	Classification	Grading Analysis				Atterberg Limits				Unit Weight	Ret. Comp.	Unconf. Comp.	Triaxial Strength	Dis. of Sample
			Gravel	Coarse Sand	Fine Sand	Silt & Clay	Liquid Limit	Plastic Limit	Shrinkage	NP	W	T	P	q	PSI
1A	5.0-6.5	GRAVELLY SAND	22	30	36	12	NV	NP	NP	NP	15.5				
1B	10.0-11.5	CLAY	0	0	5	95	54	22	32	30.1					
1C	40.0-41.5	SANDY CLAY	0	0	5	95	54	22	32	30.1					
2A	2.5-4.0	SANDY CLAY	5	32	43	19	NV	NP	NP	NP	17.9				
2B	12.0-13.5	CLAY	0	0	7	93	44	18	25	25.1					
2C	13.5-15.0	CLAY	0	0	21	79	38	18	20	27.4					
3A	2.5-4.0	GRAVELLY SAND	22	30	36	12	NV	NP	NP	NP	15.5				
3B	19.5-21.0	CLAY	0	0	9	91	43	18	25	27.9					
3C	39.5-41.0	SILTY SAND	0	1	77	22	NV	NP	NP	NP	22.5				

TYPE OF MATERIAL

- ☒ CLAY
- ☒ GRAVELLY SAND
- ☒ SANDY CLAY
- ☒ SANDY GRAVEL
- ☒ SILTY SAND
- ☒ SAND
- ☒ SILTY GRAVELLY SAND

LEGEND

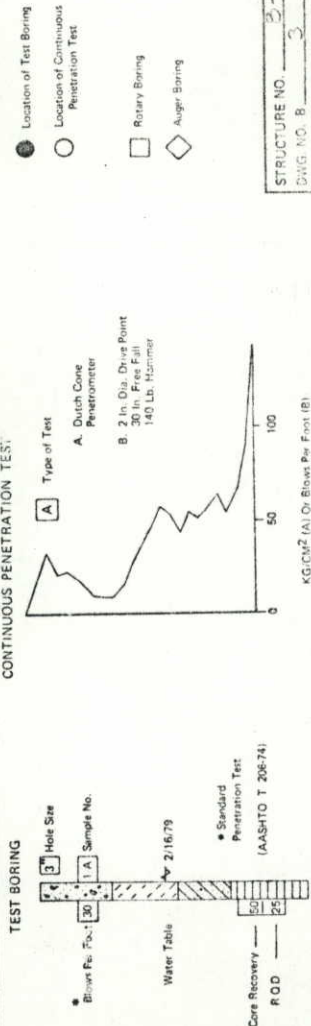

DIVISION OF HIGHWAYS


ENGINEERING GEOLOGY

BOXELDER CREEK

Geologist: LB
Drawn by: TC
Checked by: LB
Date: MAY 4, 1982

DESIGNED BY	JMD	DATE	1-82	CHECKED BY	JWB	7-82
CHECKED BY	MEP	7-82	QUANTITIES BY	SG	7-82	
DETAILED BY	SG	7-82	CHECKED BY	JMD	7-82	

Note:
Pile spacing shown typical
for all retaining walls.

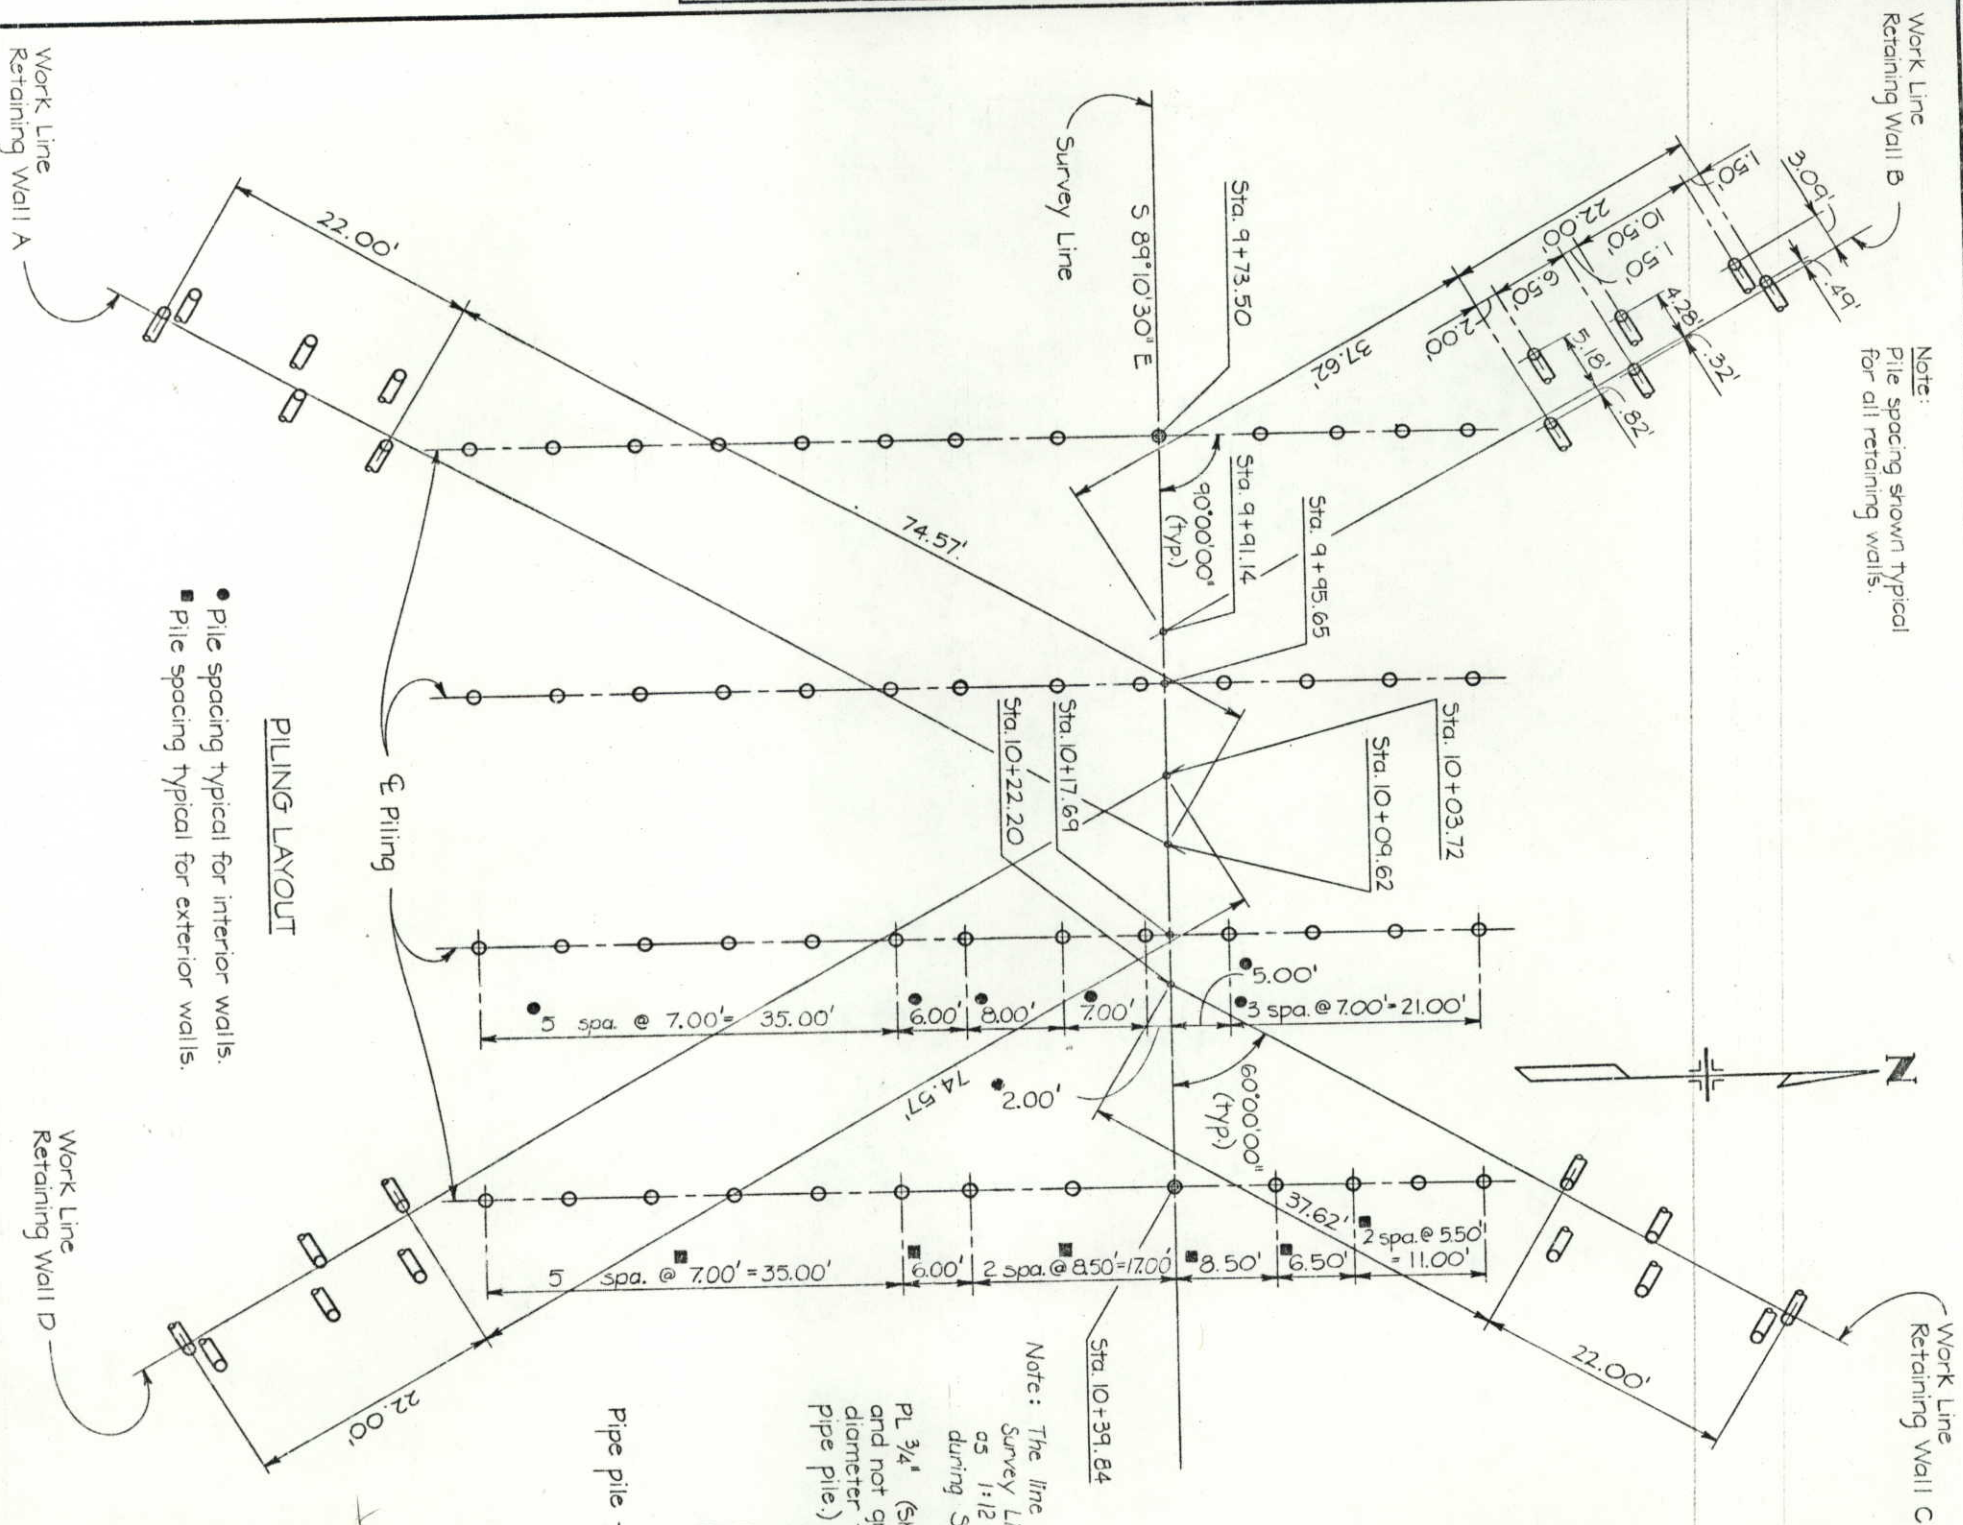


- Pile spacing typical for interior walls.
- Pile spacing typical for exterior walls.

PILING LAYOUT

Note: The line of piles 17' to the south of the Survey Line may be battered as much as 1:12 to facilitate driving these piles during Stage I construction.

PL 3/4" (shall be round and not greater in diameter than the pipe pile.)

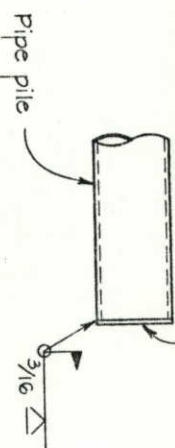


PIPE PILE END PLATE DETAIL

Notes:


- The piling dimensions shown are at the bottom of the concrete.
- C.B.C. piling shall be End Bearing Steel Pipe Piling (12-3/4 inch x 0.219) with a Maximum Pile Load of 68 tons and an Estimated Tip Elevation of 4875.4655.
- Retaining Wall piling shall be End Bearing Steel Pipe Piling (10-3/4 inch x 0.219) with a Maximum Pile Load of 48 tons and an Estimated Tip Elevation of 4875.4281.
- indicates piling to be battered, 1:4 in the direction shown.

EXISTING PIER REMOVAL DETAILS

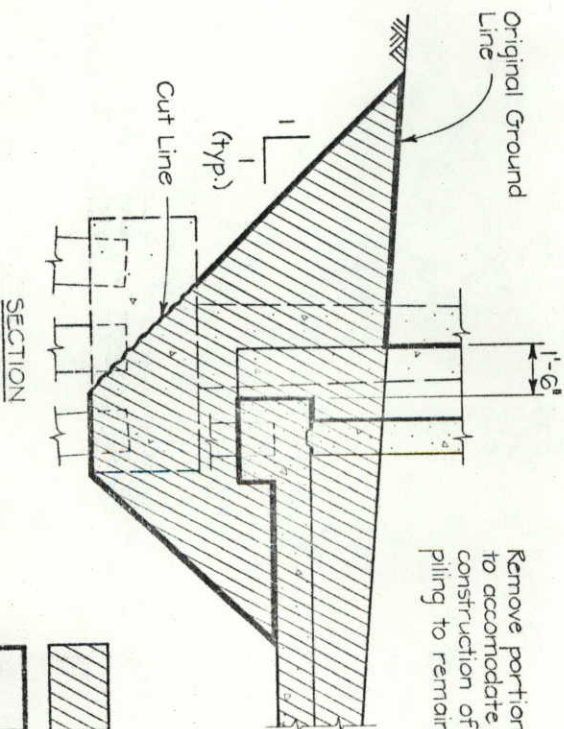

Remove portion of existing pier to accommodate pile driving and construction of C.B.C. Existing piling to remain in place.

PLAN

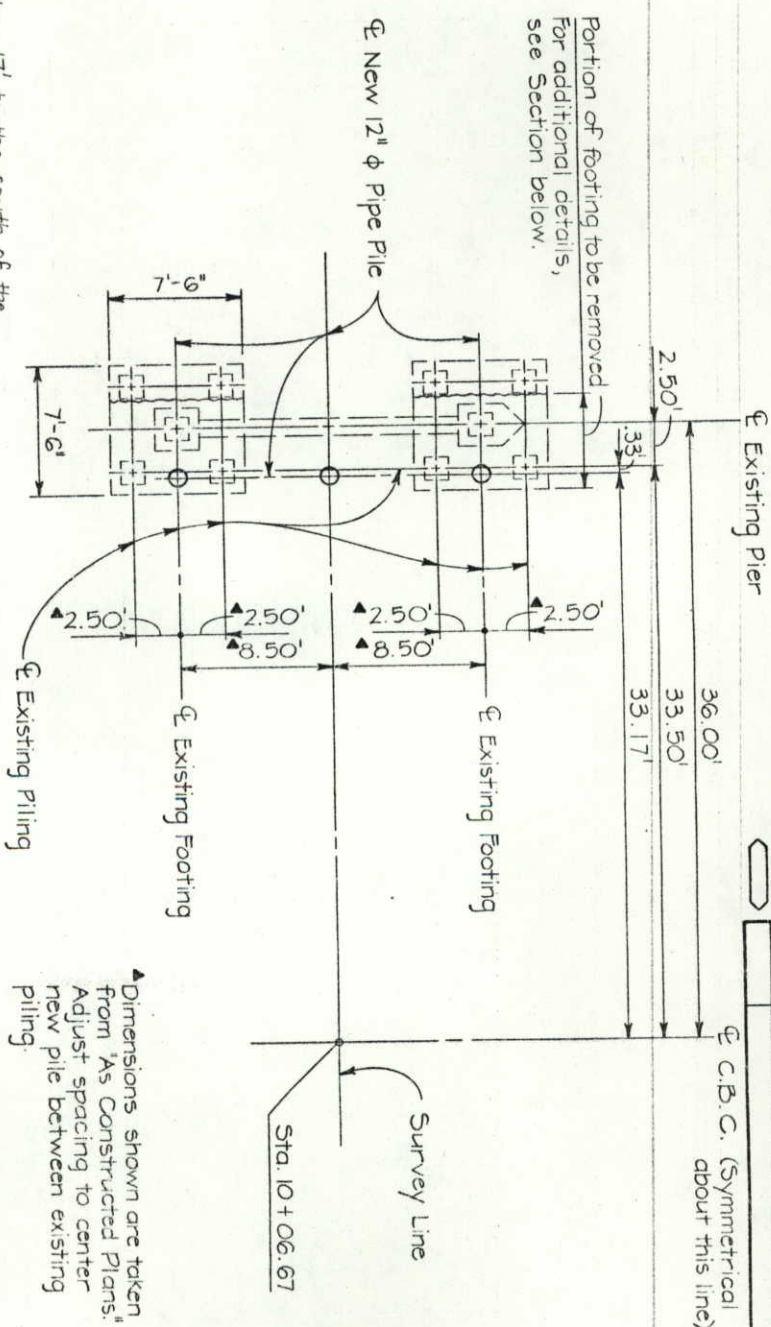

Portion of footing to be removed
For additional details,
see Section below.

AS CONSTRUCTED		
NO REVISIONS	REVISED	VOID


FEDERAL ROAD DISTRICT NO.	DIVISION	PROJ. NO.	SHEET NO.	TOTAL SHEETS
XIII	COLORADO	FR 014-2 (12)	20	32

DIVISION OF HIGHWAYS

PILING LAYOUT AND EXISTING PIER REMOVAL DETAILS

Designer J. DeLong	Structure Numbers	8-17-DJ
Detailer S. Greene	of	2
Drawing Number B 4	Drawings	

DESIGNED BY	INITIAL	DATE	CHECKED BY	JWB 7-82
CHECKED BY	JMD	7-82	QUANTITIES BY	KG 5 7-82
DETAILED BY	SG	7-82	CHECKED BY	JMD 7-82

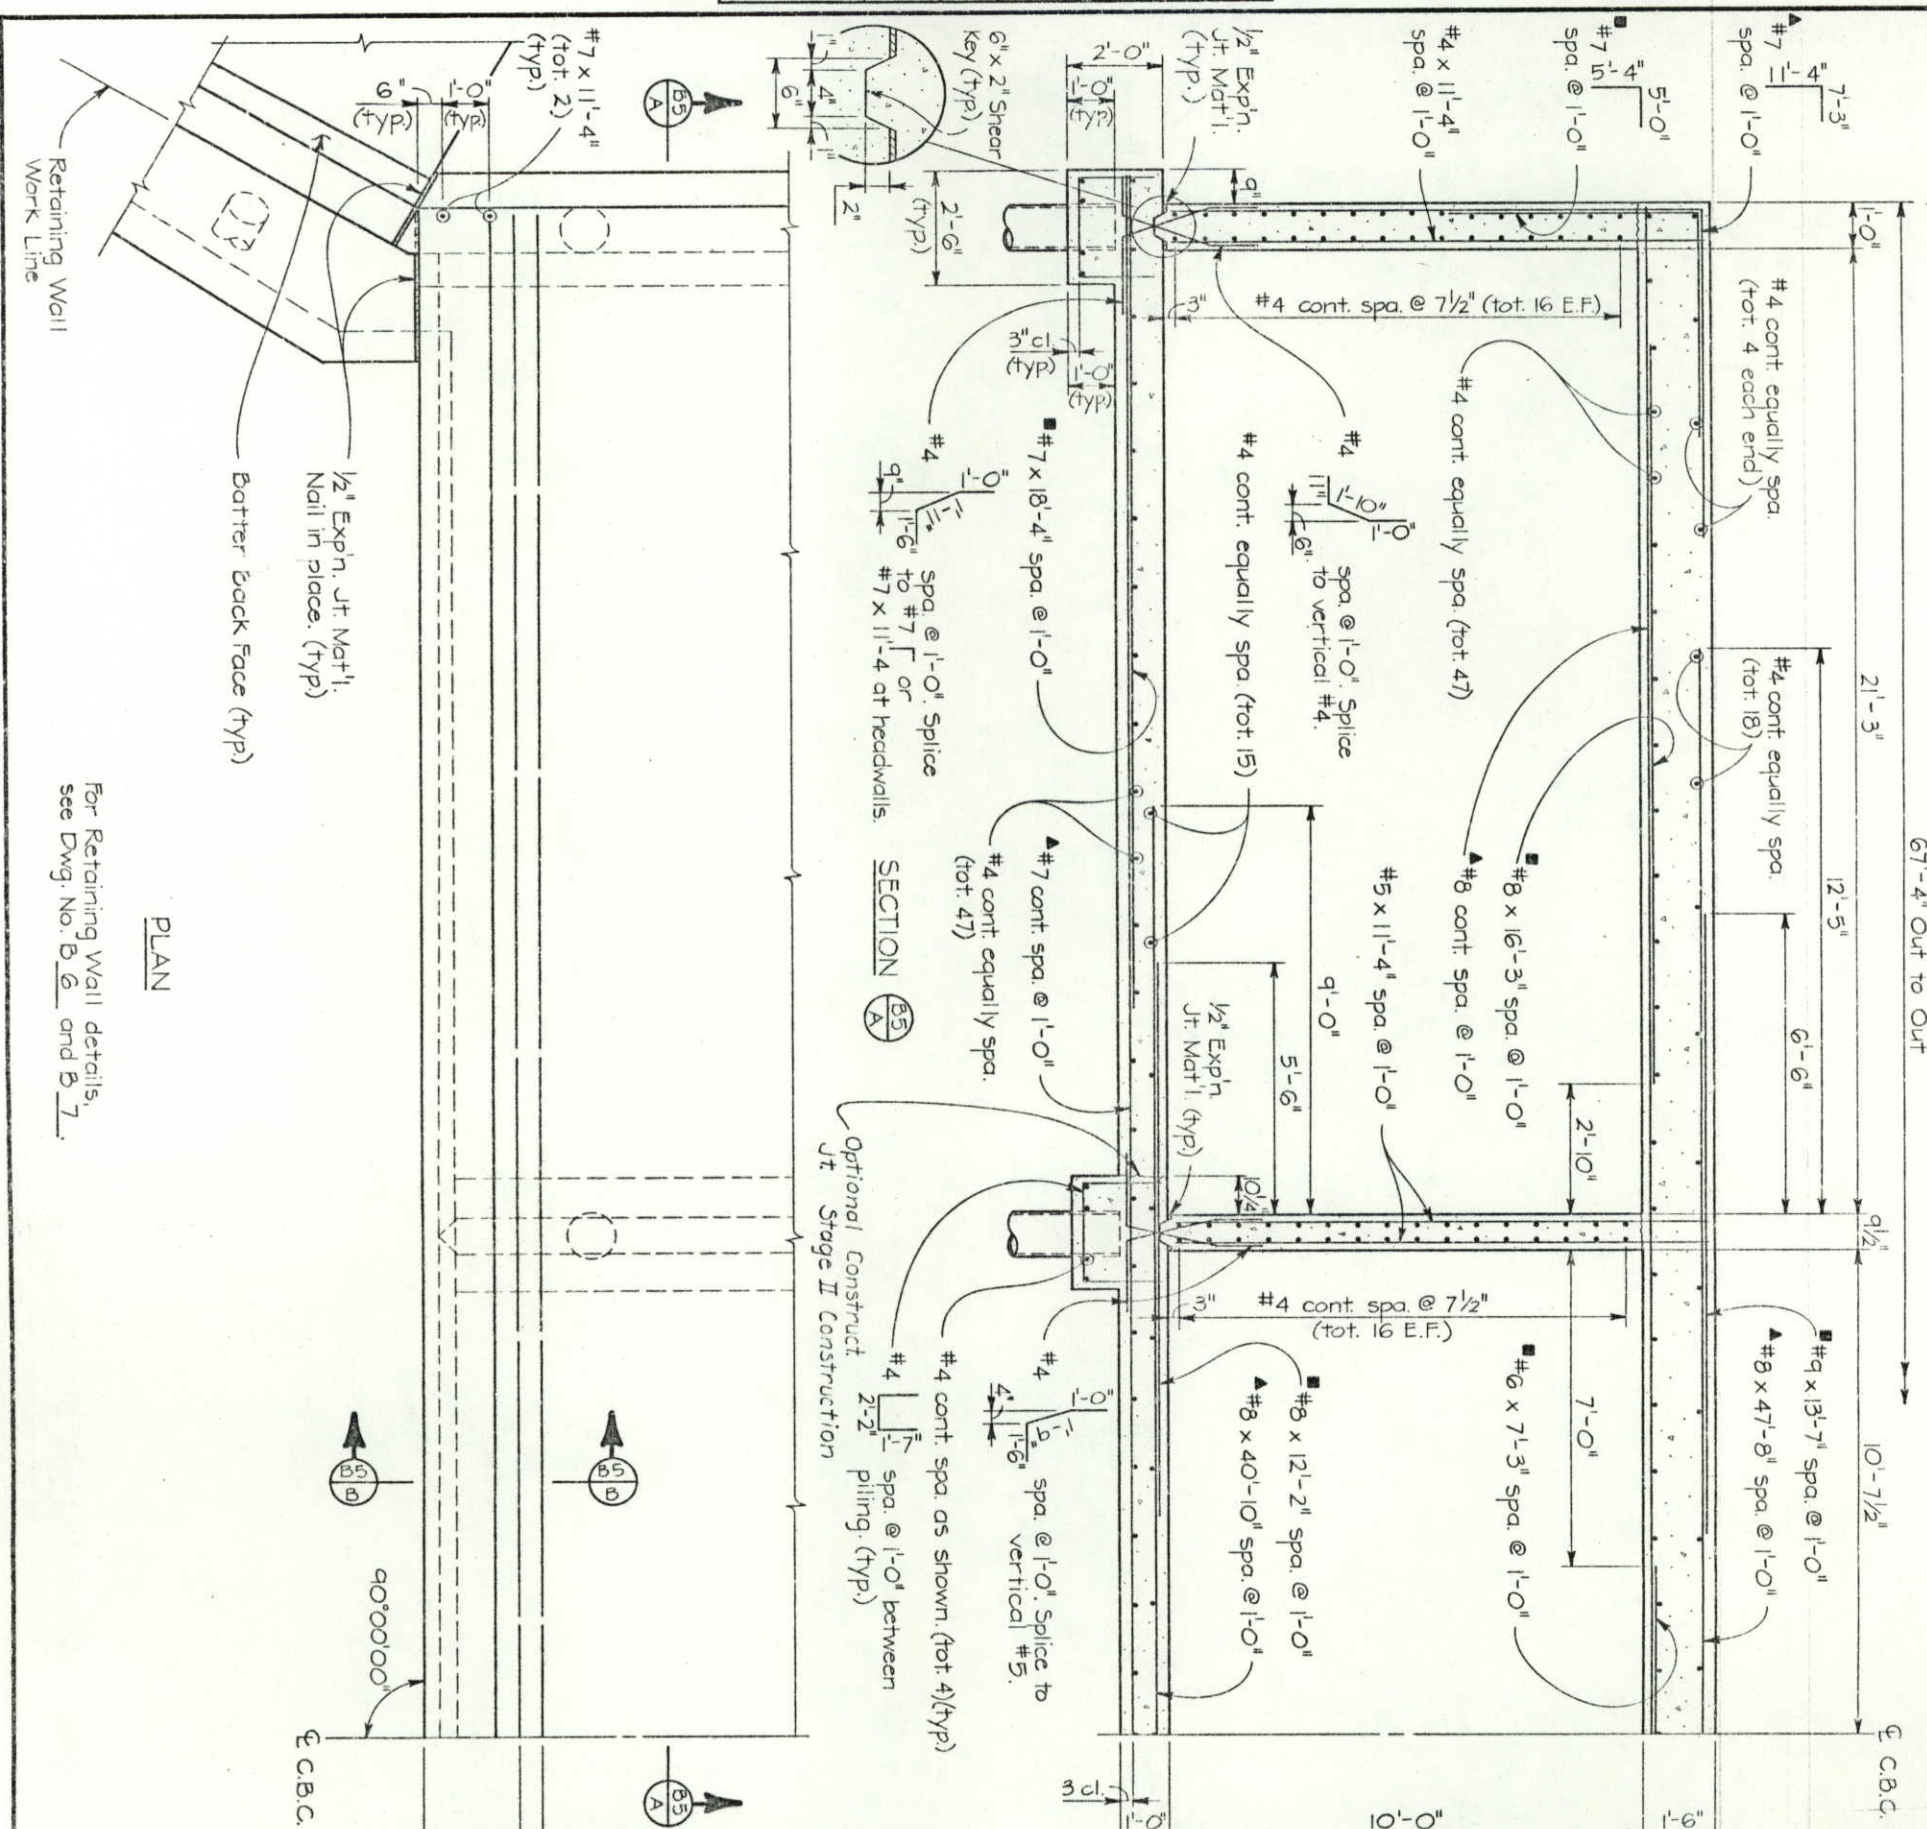


AS CONSTRUCTED	NO REVISIONS	REVISED	VOID
----------------	--------------	---------	------


FEDERAL ROAD DISTRICT NO.	DIVISION	P.O.L. NO.	SHEET NO.	TOTAL SHEETS
XIII	COLORADO	FR 04-2 (12)	21	32

Note: Walls must be supported laterally until after top slab has cured for one day.

REVISIONS				


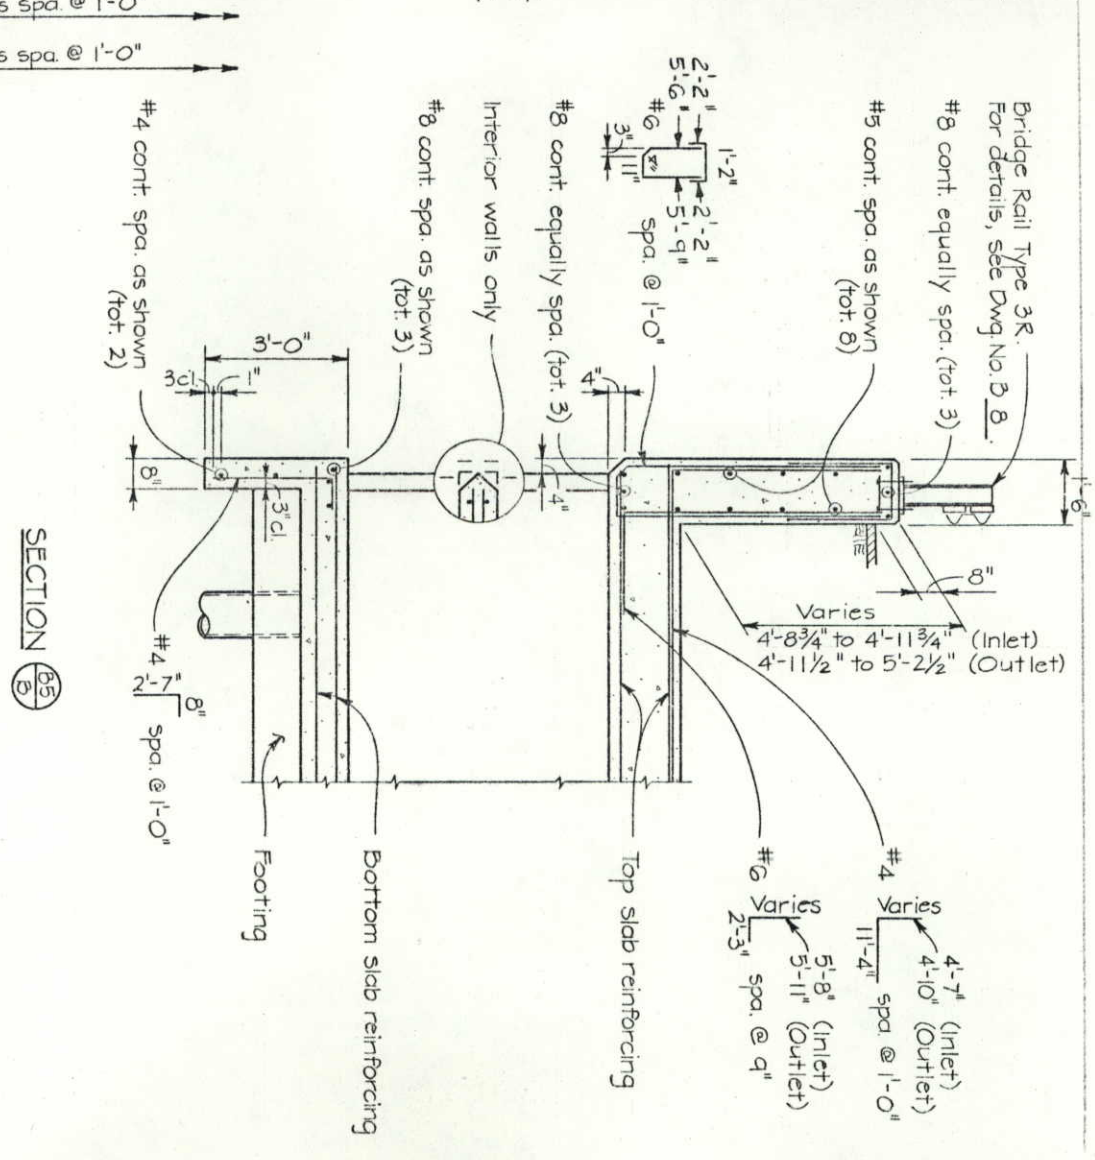


CONSTRUCTION JOINT
Shall be provided as required.

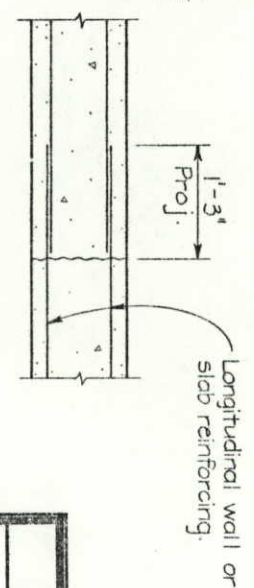


DIVISION OF HIGHWAYS	
TRIPLE CONCRETE BOX CULVERT	
Designer	J. Deland
Detailer	S. Green
Drawing Number	B 5
Structure Number	B-17-DJ
of	8
Drawings	

Revision Dates				

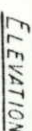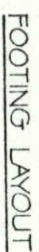[illegible]

PILE FOOTING SECTION
H=4' thru H=22'

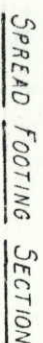

DIVISION OF HIGHWAYS

RETAINING WALL DETAILS


DESIGN DATA:
 AASHTO 1973 UNIT STRESSES EXCEPT AS NOTED.
 $f_c = 12,000$ psi
 $f_s = 20,000$ psi
 $n_s = 10$
 $E_{ARTH} = 120$ pcf, 2' SURCHARGE
 EQUIVALENT FLUID PRESSURE = $\begin{cases} 36 \text{ pcf MAX. FOR DETERMINATION OF} \\ 127 \text{ pcf MIN. FOR DETERMINATION OF} \end{cases}$ TOE PRESSURE.
 HELI PRESSURE.
 EARTH PRESSURE FOR 2:1 UNLIMITED SLOPE AND 1 1/2:1 SLOPE IS
 DETERMINED FROM RANKINE'S FORMULA WITH $\phi = 33^\circ$ 42'.

INITIAL	DATE	CHECKED BY	JWB	7-82
DESIGNED BY	JMD	1-82	KG5	7-82
CHECKED BY	MFP	7-82	SG	7-82
DETAILD BY	SG	7-82	JMD	7-82


FEDERAL ROAD REGION NO.	DIVISION	PROJ. NO.	SHEET NO.	TOTAL SHEETS
VIII	COLORADO	FR O 14-2 (12)	23	32

	AS CONSTRUCTED	
NO REVISIONS	REVISED	VOID


REVISIONS	

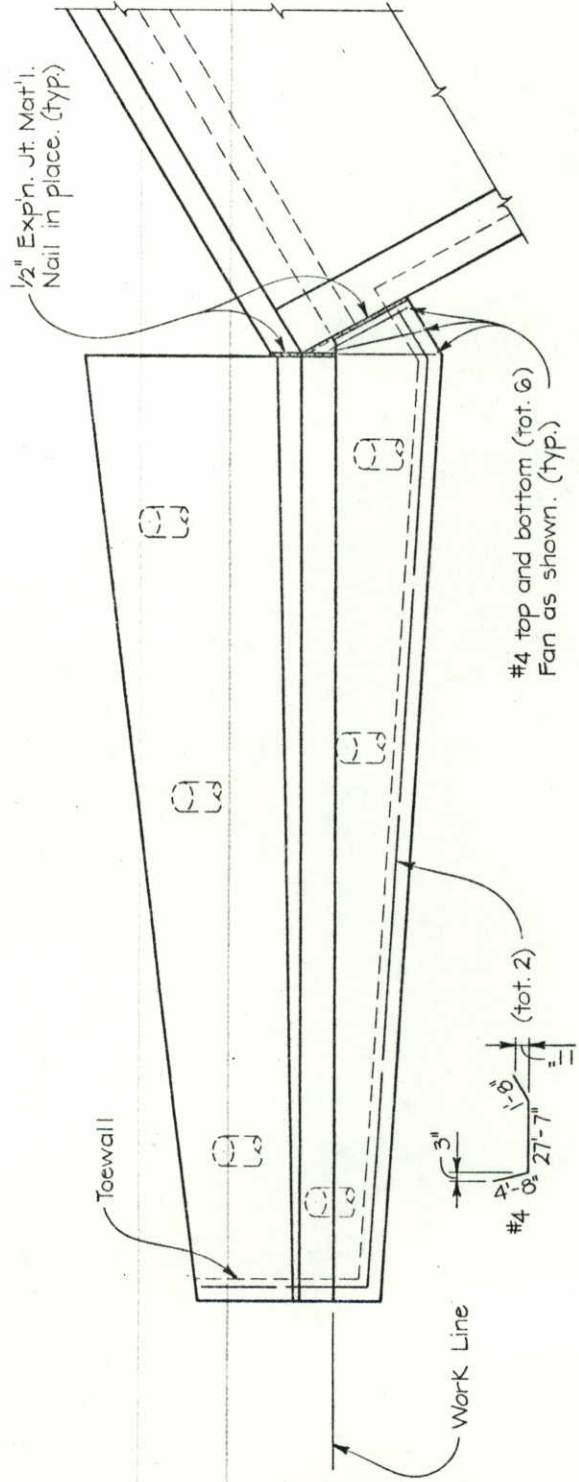

PLAN

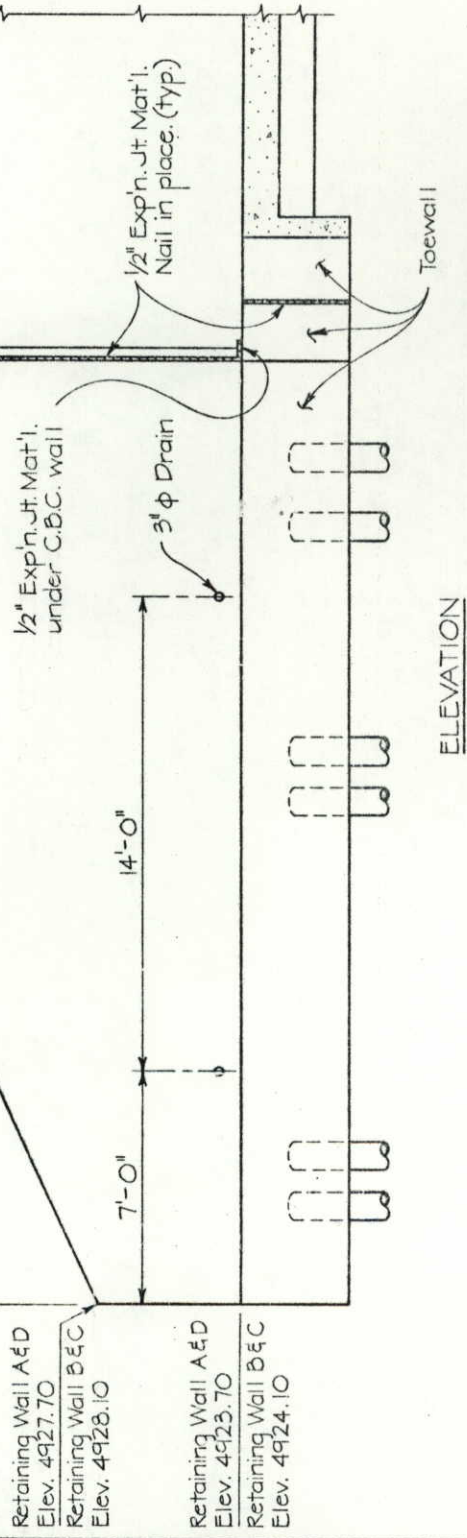

ELEVATION

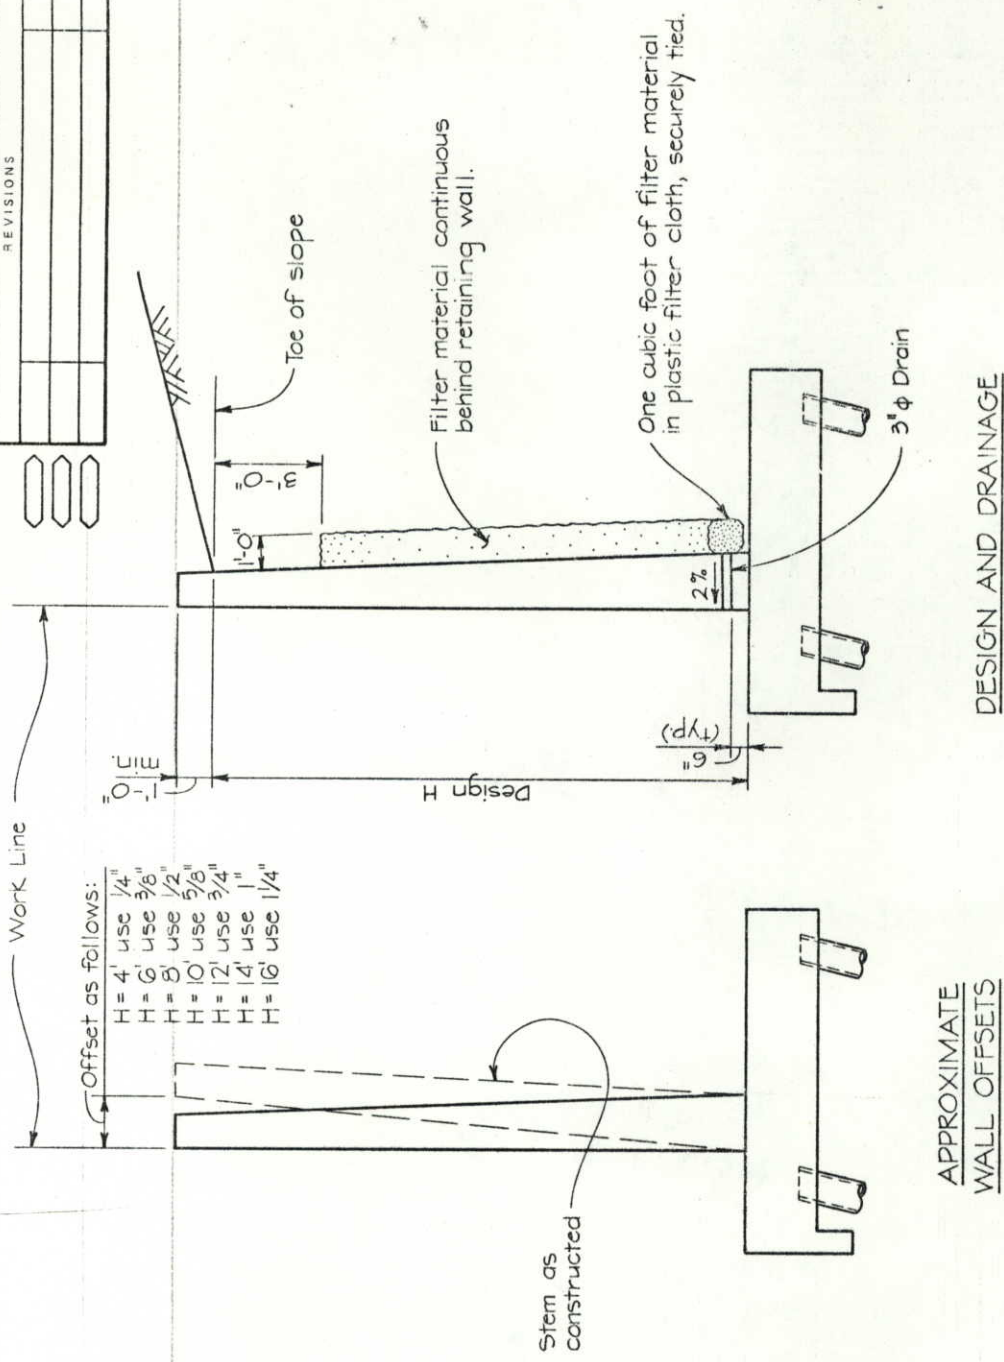

APPROXIMATE
WALL OFFSETS

DESIGN AND DRAINAGE



Note:
For additional retaining wall details,
see Dwg. No. B 6.

DIVISION OF HIGHWAYS

MISCELLANEOUS DETAILS

Designer	J. DeLand	Structure	B-17-DJ
Detailer	S. Greene	Numbers	
Drawing Number B 7		of 8 Drawings	

AS CONSTRUCTED	REVISED	VOID
NO. 15-15-15	10-15-15	
OFFICIAL ROAD NO.	DIVISION	NO. 15-15-15
VIII	FR 014 - 2(12)	26
DATE	NO.	32

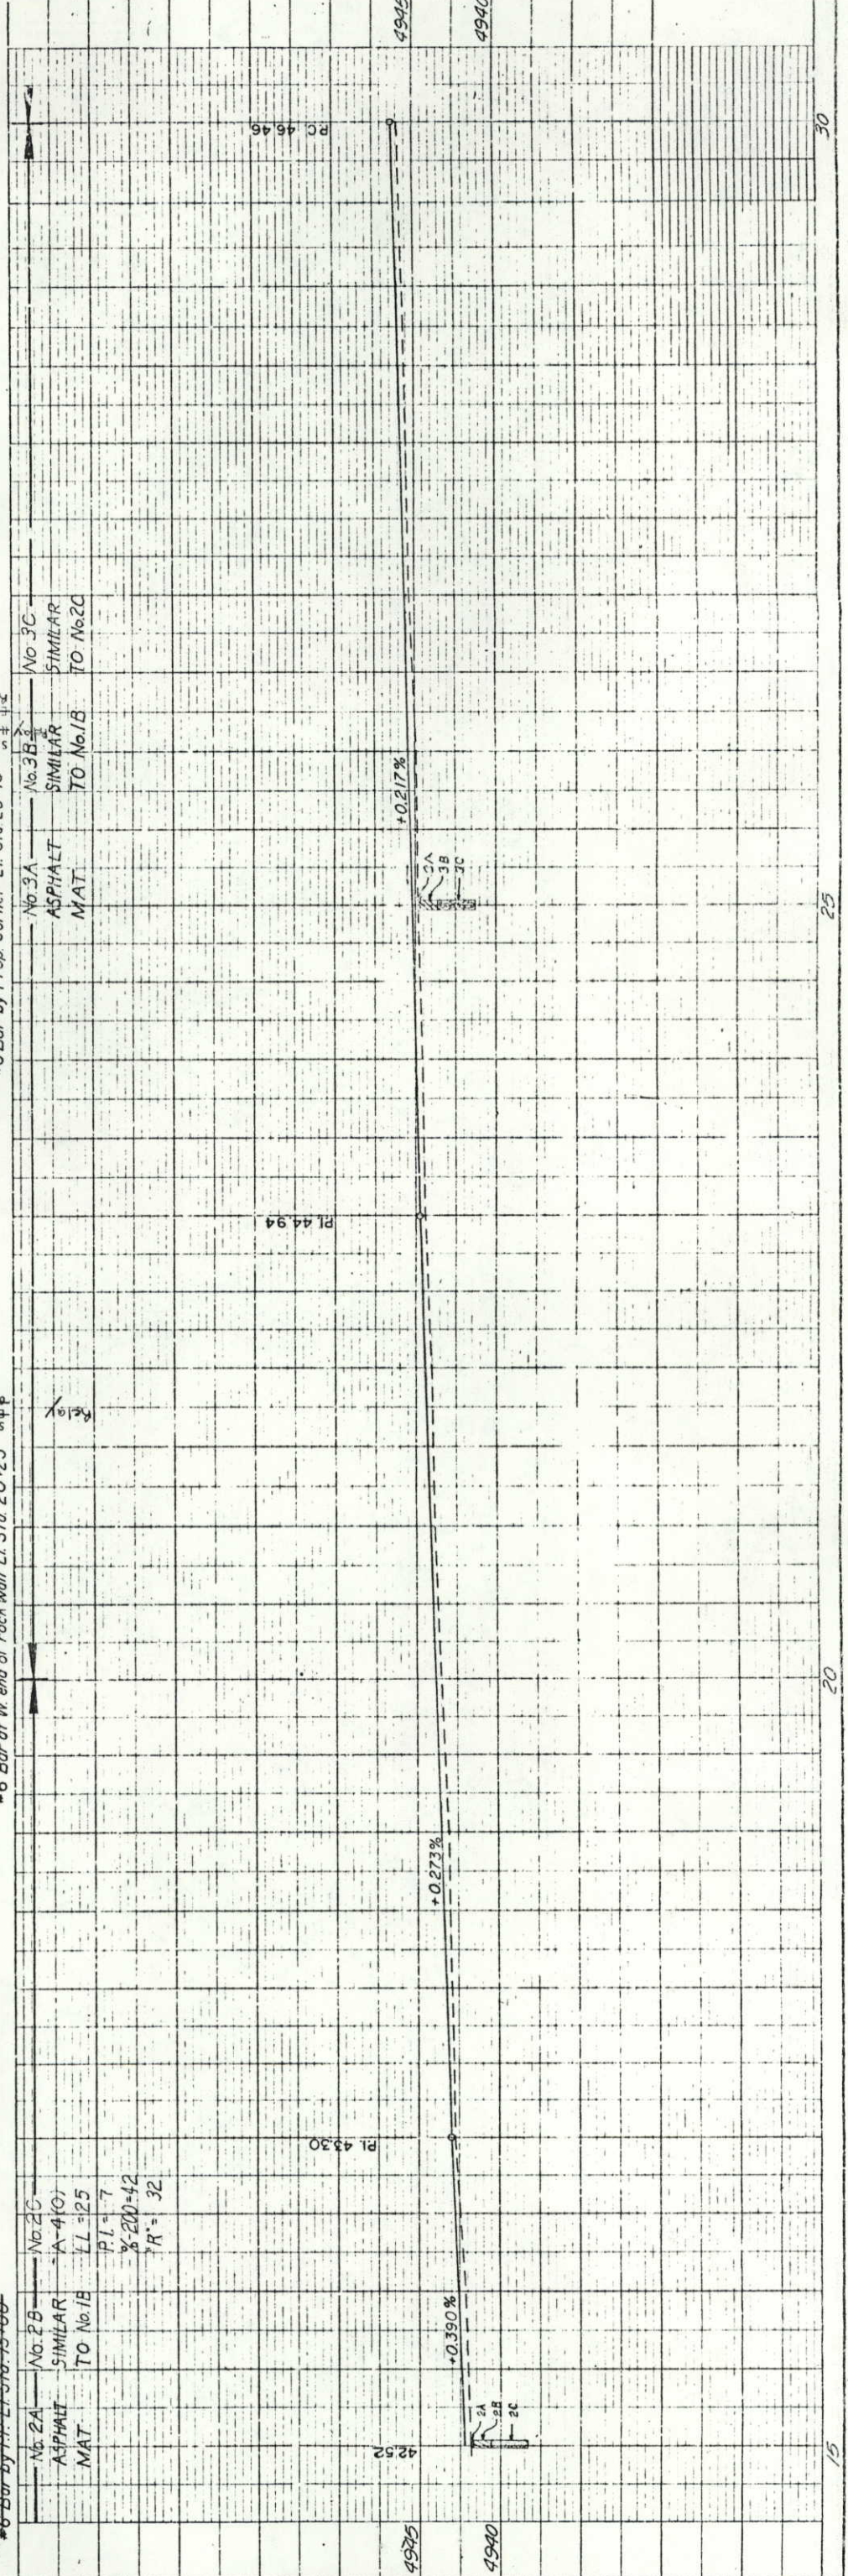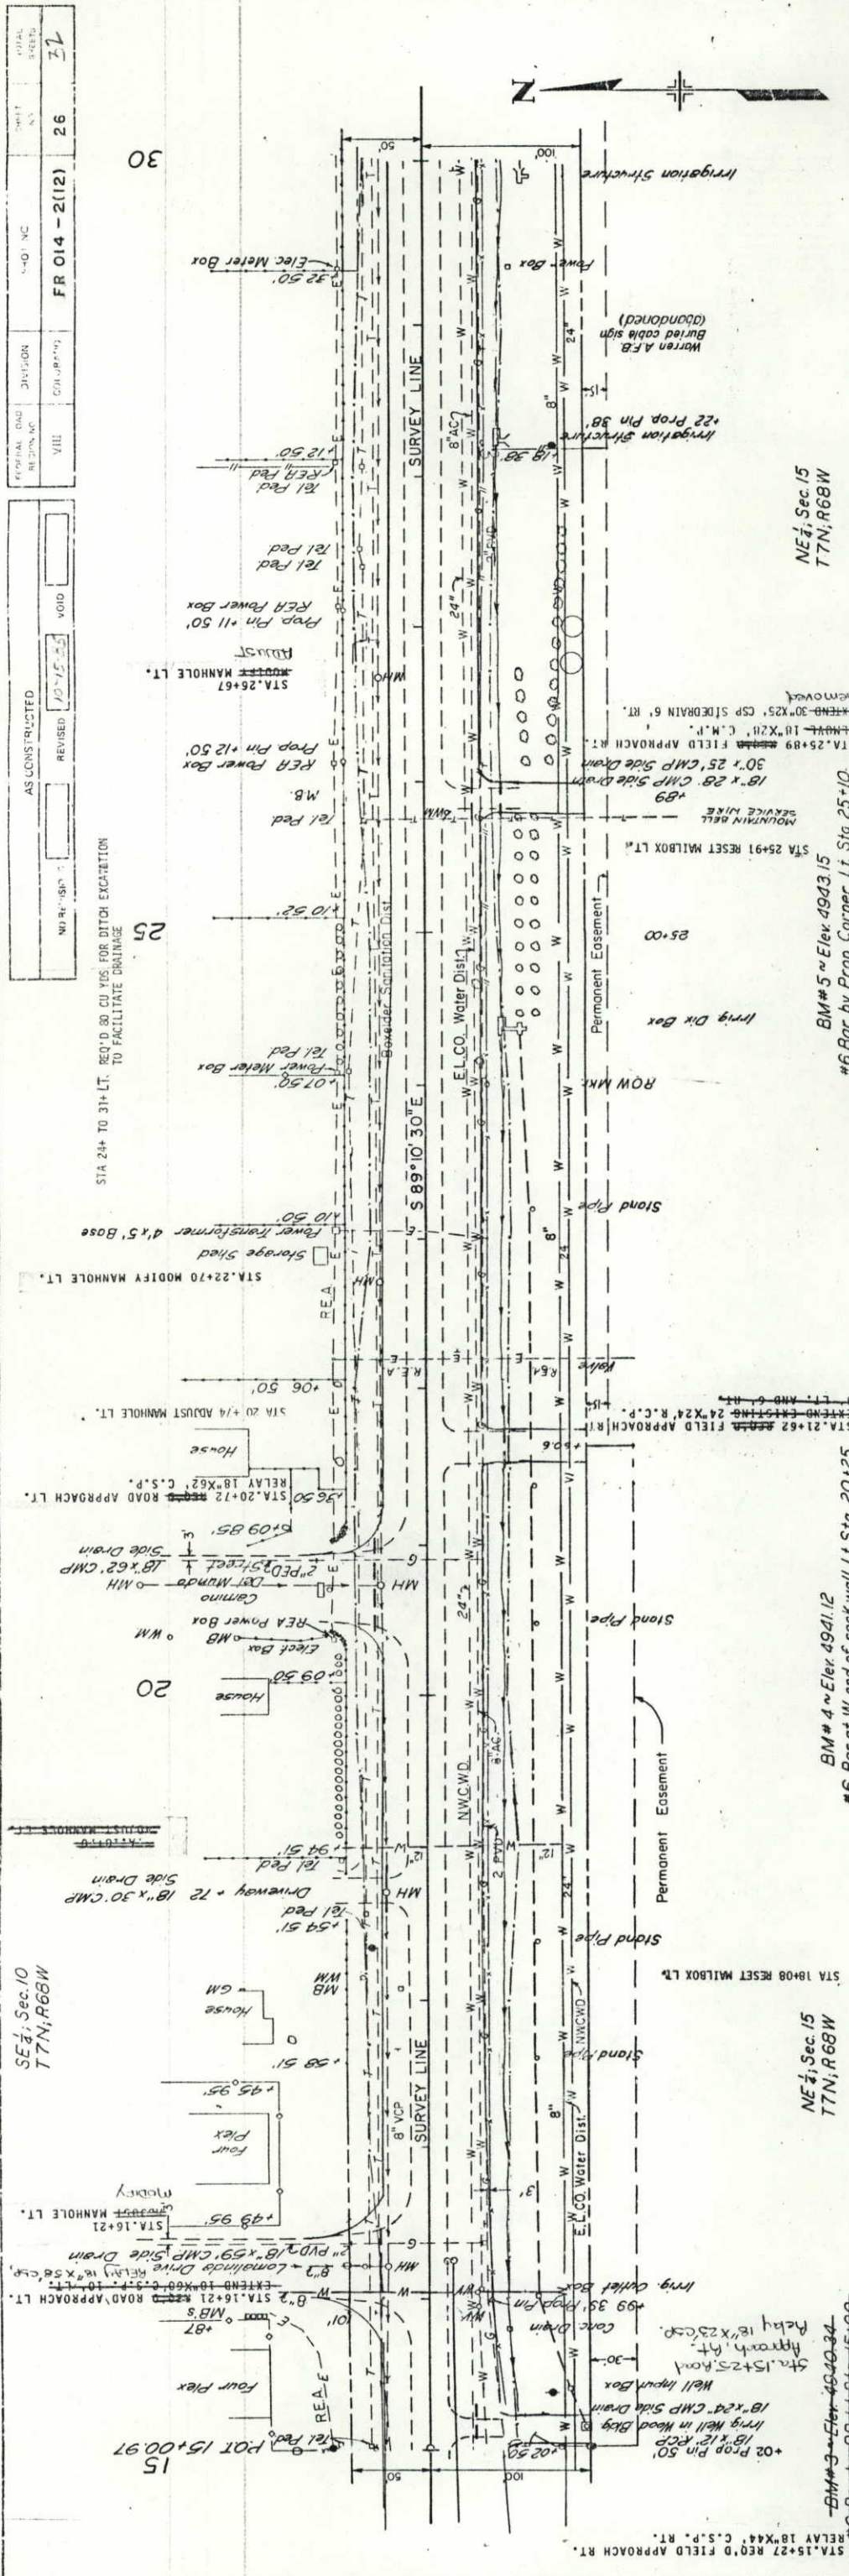


TABULATION OF PAVEMENT MARKINGS

AS CONSTRUCTED		FEDERAL ROAD REGION NO.		DIVISION		PROJ. NO.		SHEET NO.		TOTAL SHEETS	
NO REVISIONS		☐ REVISED ☒ <i>1-7-52</i>		VIII		COLORADO		FR 014 - 2 (12)		28	
		VOID								36	

STATION	LOCATION	PAVEMENT MARKING LINES (Linear Feet)									
		EDGE		LANE	CENTER		CHANNELIZING		CROSSHATCH	GROSS WALK	STOP
		WHITE SOLID 4 INCH	YELLOW SOLID 4 INCH	WHITE BROKEN 5 INCH	YELLOW SOLID 5 INCH	YELLOW BROKEN 5 INCH	WHITE SOLID 10 INCH	YELLOW SOLID 10 INCH	WHITE SOLID 10 INCH	YELLOW SOLID 10 INCH	WHITE SOLID 24 INCH
O+00 TO 9+70	SH 14	1820		1820							
2+60 TO 6+70	SH 14	410		820							
6+70 TO 9+10	SH 14			960					180		
9+10 TO 11+40	SH 14	460		460	460						
11+40 TO 13+55	SH 14	430		505	430						
13+55 TO 16+00	SH 14	245		490	490	245					
16+00 TO 17+00	SH 14	175		50	50	60					
17+00 TO 20+25	SH 14	650		190	650	195					
20+25 TO 21+25	SH 14	200				50					
21+25 TO 33+80	SH 14	2510		2510	2510	115					
33+80 TO 35+80	SH 14	400		200	400						
35+80 TO 38+20	SH 14	480		440	440	240					
38+20 TO 38+50	SH 14	60									
OPP STA 16+00	Lomalinda Dr										40
OPP STA 20+60	Camino Del Mundo										40
OPP STA 38+30	Camino Real Dr										40
PROJECT TOTALS	(LIN FT)	7430	410	3175	7210	5430	905		180		120
PUMP MIX PAINT	(GALS)	23.5	1.3	3.1	28.6	5.3	7.1		1.4		2.2
PAVEMENT MARKING LINES (Linear Feet)											
Edge White 4" Solid											
WB EB											
Detour 3+ to 34+		3060	3272		-314						
Mainline -4 to 42+		4315	4080		10,116		550	230	1954	76	(4 Bus.)
Project Totals = 14,727											
Edge Yellow 4" Solid											
WB EB											
Crosshatch Yellow 5" Broken											
WB EB											
Project Totals = 465											
Mainline -4 to 42+											
Project Totals = 465											

SUMMARY OF PAVEMENT MARKING QUANTITIES			THERMOPLASTIC (SQ. FT.)	MATERIALS	FINAL
COLOR	PAINT (GAL.)				
YELLOW	37			10	52
WHITE	36			21	47
TOTAL	73				99

NOTE:
FOR DETAILS OF PAVEMENT MARKING
LINES AND LINE PLACEMENT, SEE
STANDARD S-627-1

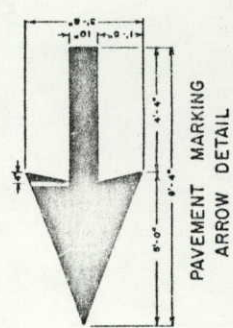

TYPICAL BREAK-AWAY ASSEMBLY DETAILS

TYPICAL BREAK-AWAY ASSEMBLY DETAILS

FEDERAL ROAD REGION NO.	DIVISION	PROJ. NO.	SHEET NO.	TOTAL SHEETS
VIII	COLORADO	FR 14-2(12)	30	32


AS CONSTRUCTED

NO REVISIONS	REVISED	VOID
--------------	---------	------


GENERAL NOTES CONTINUED

5. All electrical materials and workmanship shall conform to the latest requirements of the NEC, NEMA, UL or EIA wherever applicable; the Colorado PUC and any local codes or ordinances which may apply; and the following:
 - a. The Contractor is to provide all necessary wiring within the beacon and from there to the power source provided by the Utility Company. The Utility Company will make the connection with the Contractor's wiring.
 - b. The electrical service between the power source and the flashing beacon shall be underground unless an aerial drop is authorized by the Engineer.
 - c. The "flasher" shall be housed in a suitable enclosure on the utility pole at the power source unless the Engineer directs that the enclosure be mounted on the beacon pipe or that the device may be contained within the signal head itself.
 - d. A suitable enclosure for the flasher shall be in accordance with "a" raintight junction box or can approximately 8"x8"x4", surface mount, with a flanged screw attached cover, and fabricated from not less than 16 gage galvanized steel".
 - e. A built-in radio interference suppression device and a photocell sensor type signal lamp dimmer shall be provided for each flashing beacon.

TYPICAL PIPE ATTACHMENTS

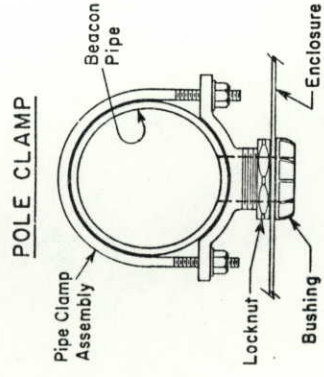

WELDED NIPPLE

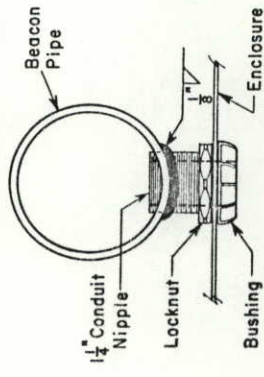

(Note: Weld varies with conduit or nipple wall thickness.)

TYPICAL ELECTRICAL SERVICE DETAILS



NOTES

VIEWS AT ENCLOSURES

VIEW AT POWER SOURCE

FRONT VIEW


POST ANCHOR DETAILS

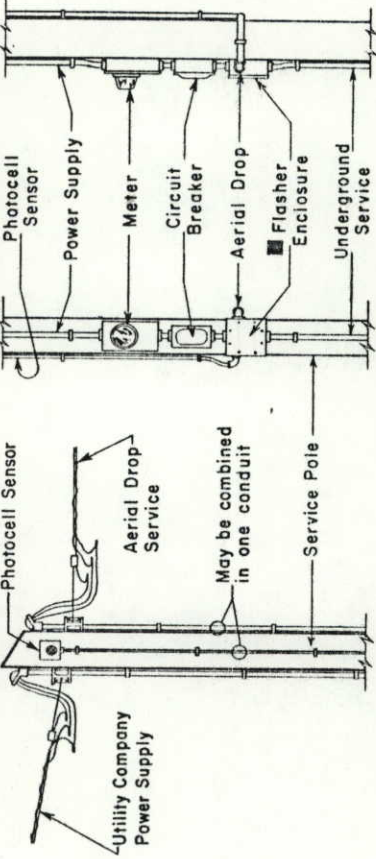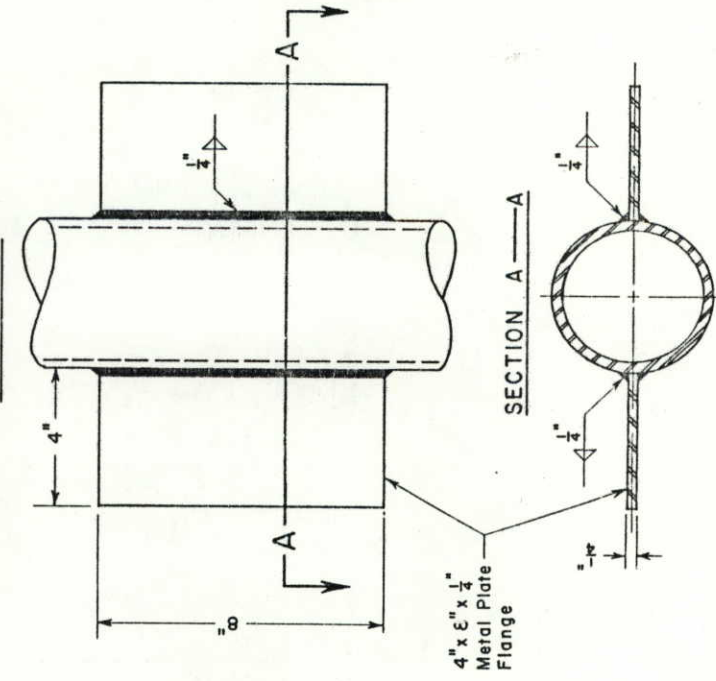


Location and configuration of electrical equipment is diagrammatic only (use any method complying with the General Notes).

- ▲ Existing ground at service pole; otherwise pull thru conduit or attach to conduit and tap off underground.
- Drill and tap pipe for $\frac{1}{4}$ " Round Head Brass Screw, $\frac{3}{4}$ " long, for Ground Lug.
- Provide weep hole with aerial drop service.


UNDERGROUND VIEWS AT POWER SOURCE

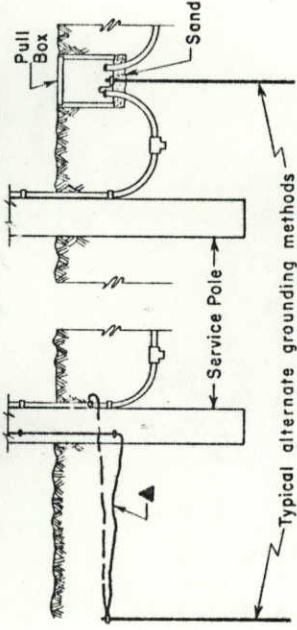


TRENCHING DETAIL

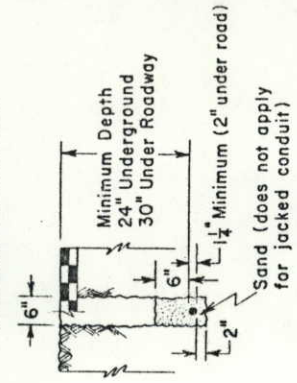


UNDERGROUND VIEWS AT BEACON

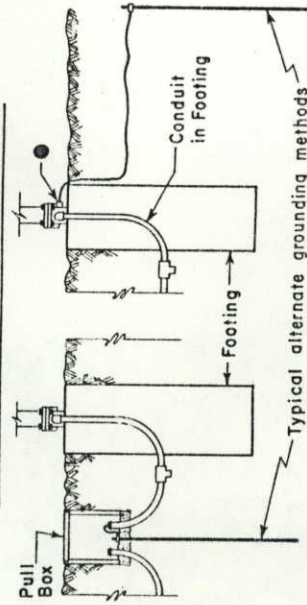


UNDERGROUND CONNECTION

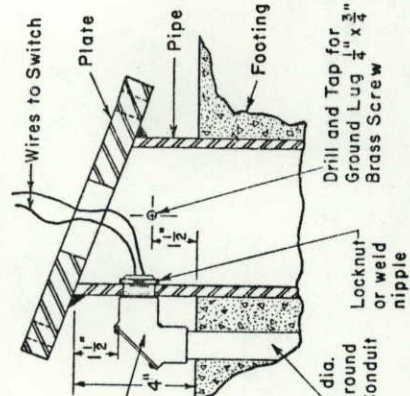

VIEWS AT BEACON

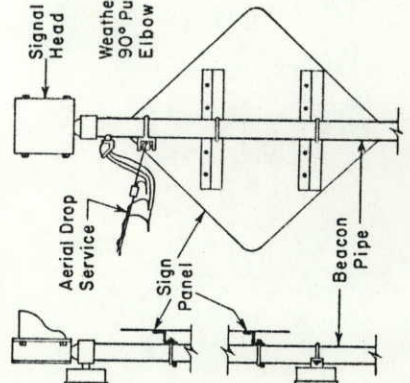

SHIM DETAIL

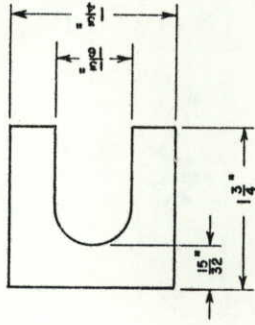

Furnish Two (2) .012"± Thick
and Two (2) .032"± Thick Shims.
Shims shall be fabricated from
Brass Shim Stock or Strip
conforming to ASTM - B 36.

BREAK-AWAY ASSEMBLY BOLTING PROCEDURE

1. Assemble post to footing with bolts — one flat washer on each bolt top and bottom, and one flat washer and the keeper plate between the break-away plates. Use brass shims to plumb the post.
2. Tighten all bolts to a "snug tight" condition with a 12" to 15" wrench to bed washers and to clean bolt threads, then loosen each bolt in turn and retighten in a systematic order to a "snug tight" plus approximately $\frac{1}{8}$ turn.
3. Burr threads at junction with nut using a center punch to prevent nut loosening.



DEPARTMENT OF HIGHWAYS
STATE OF COLORADO
DIVISION OF HIGHWAYS
FLASHING BEACON
AND SIGN
INSTALLATION

FEDERAL ROAD DISTRICT NO.	DIVISION	PROJ. NO.	SHEET NO.	TOTAL SHEETS
VIII	COLORADO	FR 014 - 2(12)	31	32

NO REVISIONS	AS CONSTRUCTED
☐	☒ 2-15-83 VOID

STRIPING PLAN

Orig. Scale 1" = 50'

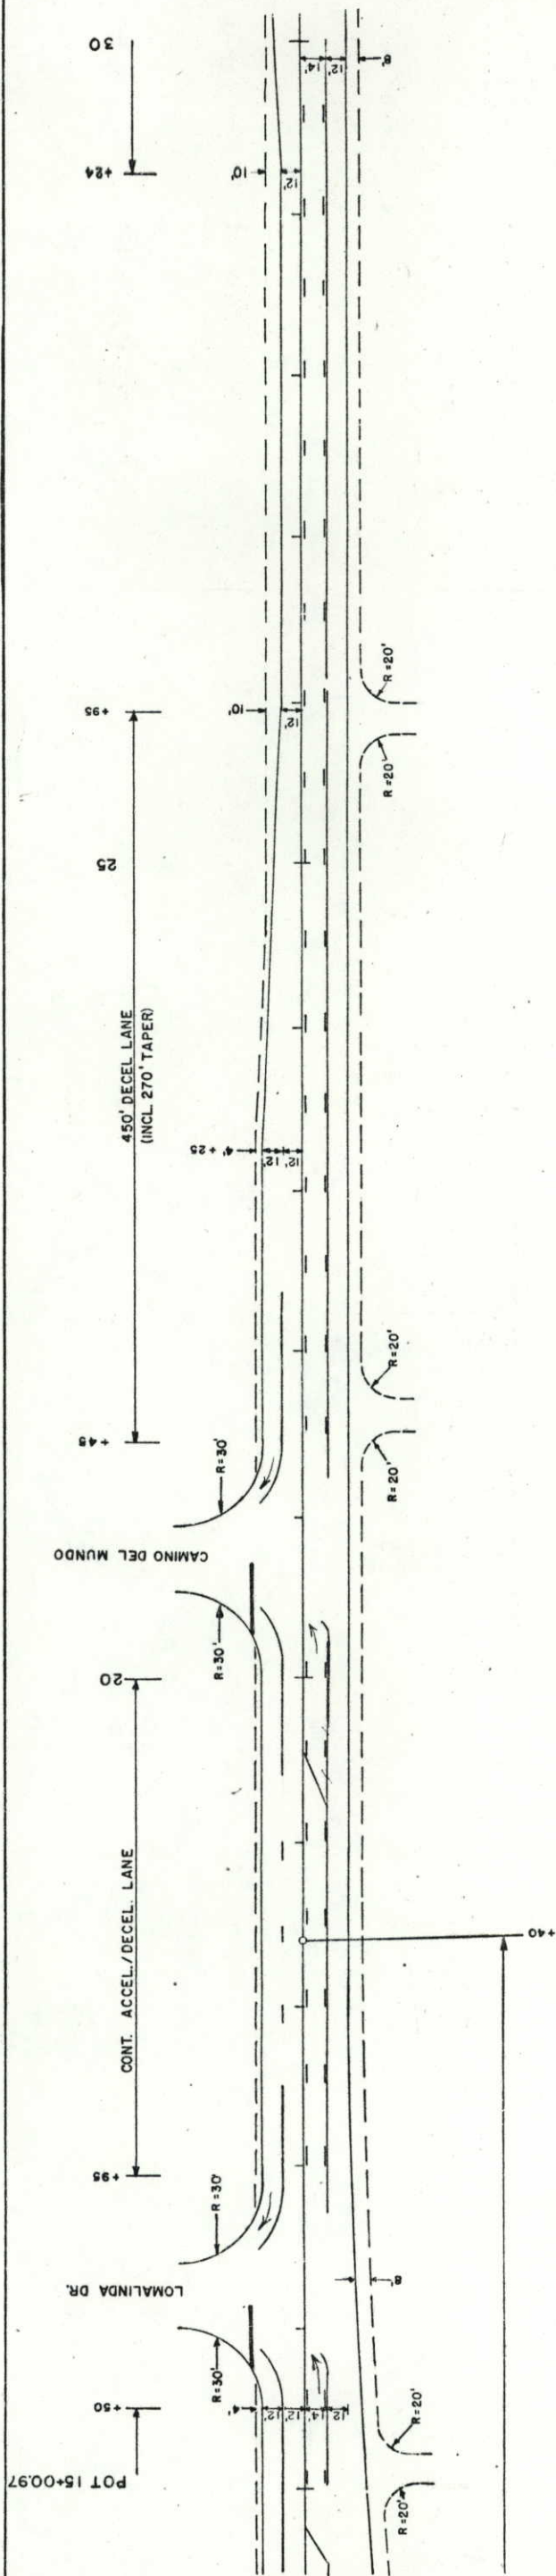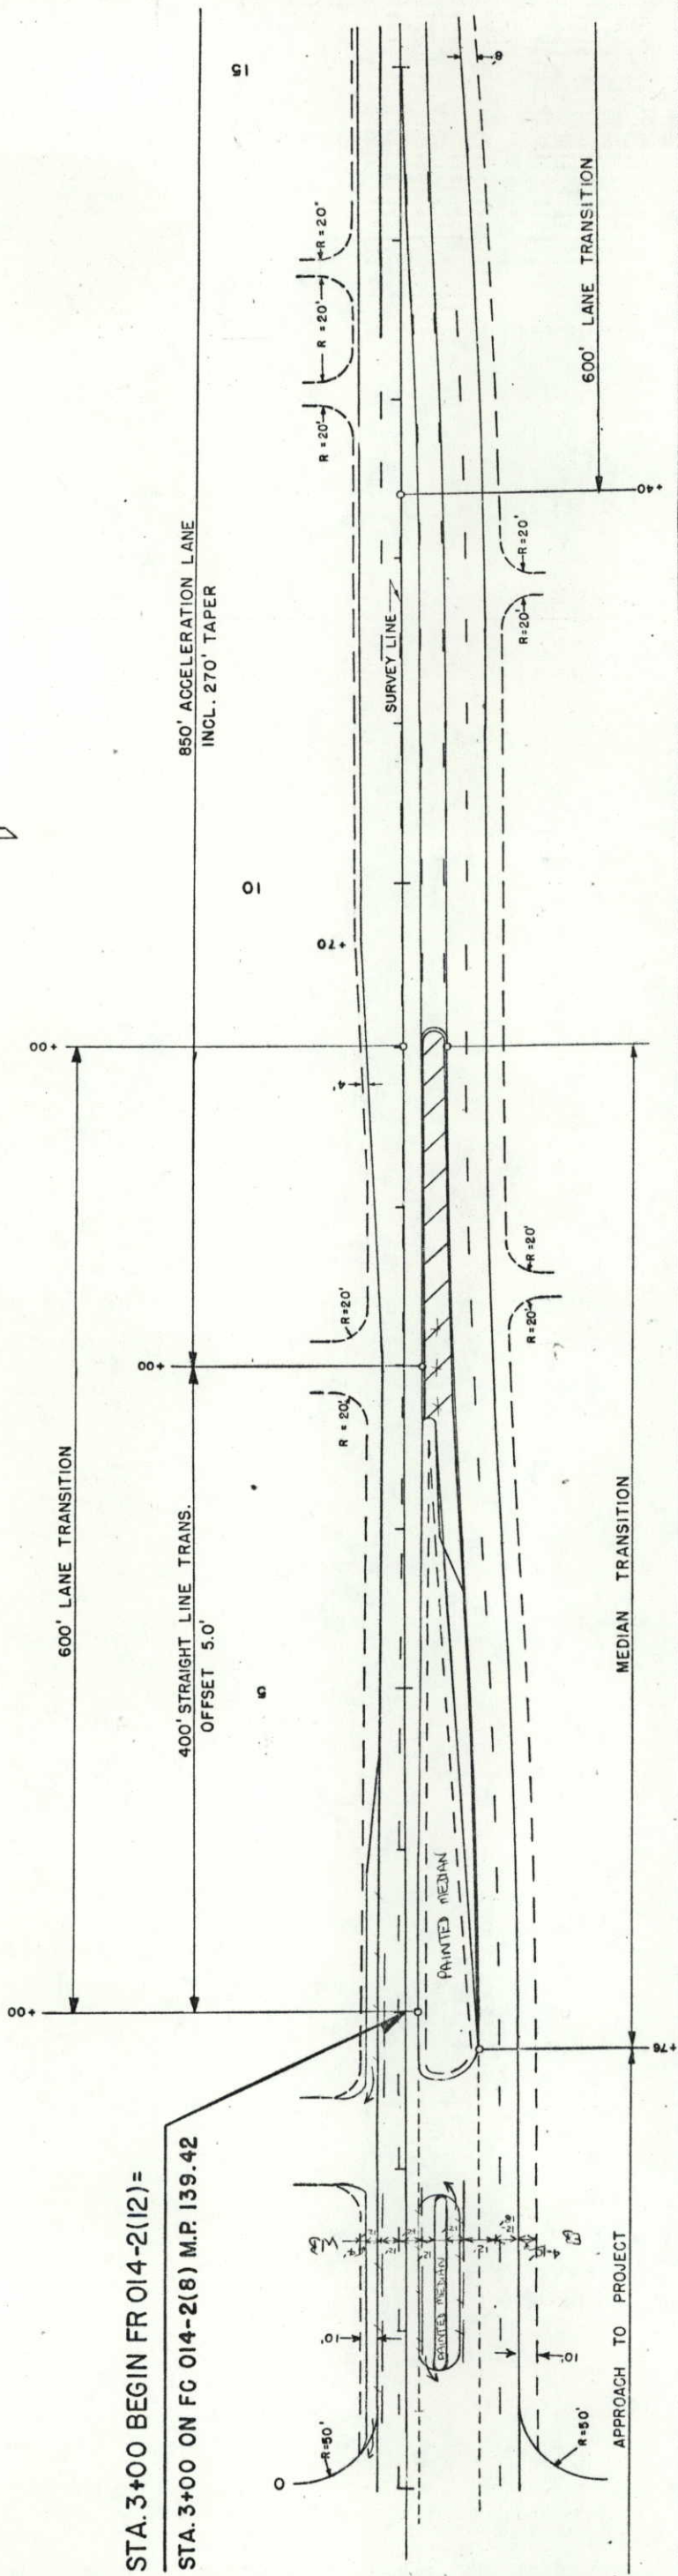

FEDERAL ROAD REGION NO.	DIVISION	PROJ. NO.	SHEET NO.	TOTAL SHEETS
VIII	COLORADO	FR 014-2(12)	32	
AS CONSTRUCTED				
NO REVISIONS				
REVISED				
VOID				

