

# COLORADO

## DEPARTMENT OF HIGHWAYS

PLAN AND PROFILE OF PROPOSED

**FEDERAL AID PROJECT NO. F 006-1(I14)**

**STATE HIGHWAY NO. 3**

**WELD COUNTY**

### INDEX OF SHEETS

- 1 SHEET NO. 1 TITLE SHEET
- 2 TABULATION OF PROPERTIES.
- 3-10 PLAN AND PROFILE SHEETS
- 11 OWNERSHIP MAP

DESCRIPTIONS ON THIS PROJECT CALCULATED  
AND CHECKED BY FIELD FORCES

### SCALES OF ORIGINAL DRAWINGS

ON PLAN 1 IN = 100 FT HORIZONTAL  
ON PROFILE 1 IN = 100 FT VERTICAL  
GRADE LINE ON PROFILE IS SHOWN VS GRADE OF FINISHED ROAD  
GROSS LENGTH OF PROJECT } 23,500 FT = 4.451 MI  
NET LENGTH OF PROJECT }

### RIGHT OF WAY

FEDERAL ROAD DIVISION NO.	DISTRICT	PROJ. NO.	SHEET NO.	TOTAL SHEETS
9	COLORADO	F 006-1(I14)	7	

### RIGHT OF WAY

#### CONVENTIONAL SIGNS

- CENTER LINE
- RIGHT OF WAY LINE
- COUNTY LINE
- TOWNSHIP OR RANGE LINE
- LAND LINES
- RAILROAD
- BARBED WIRE FENCE
- COMBINATION WIRE FENCE
- SNOW FENCE
- TELEPHONE & TELEGRAPH LINES
- POWER LINE
- DETOUR
- PRESENT ROAD (Plan Sheets)

POC STA 1+10.2 = Colo - Wyo STATE LINE  
BEGIN F 006-1(I14)

STA 1605+99.5 END F A P 286-B-R-1  
END WYOMING PROJECT NO. F-73(7)

WYOMING

R67W


R66W

T12N

T12N

T11N

T11N

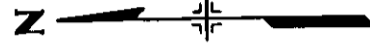

SCALE OF MILES



STA 236+00.0 END F 006-1(I14)

BEGIN F 006-1(I14)

GENERAL NOTES










N.E. 1/4., Sec. 28  
T.12N., R.66W.

FED. ROAD DIST. NO.	STATE	PROJ. NO.	SHEET NO.	TOTAL SHEETS
3	COLO.	F 006-1(14)	5	

RIGHT OF WAY  
Rev. 8-8-55 T.L.K. (Parcel No. 3)  
Rev. 3-6-91 D-4 Add Access Control  
S.W. 1/4., Sec. 28

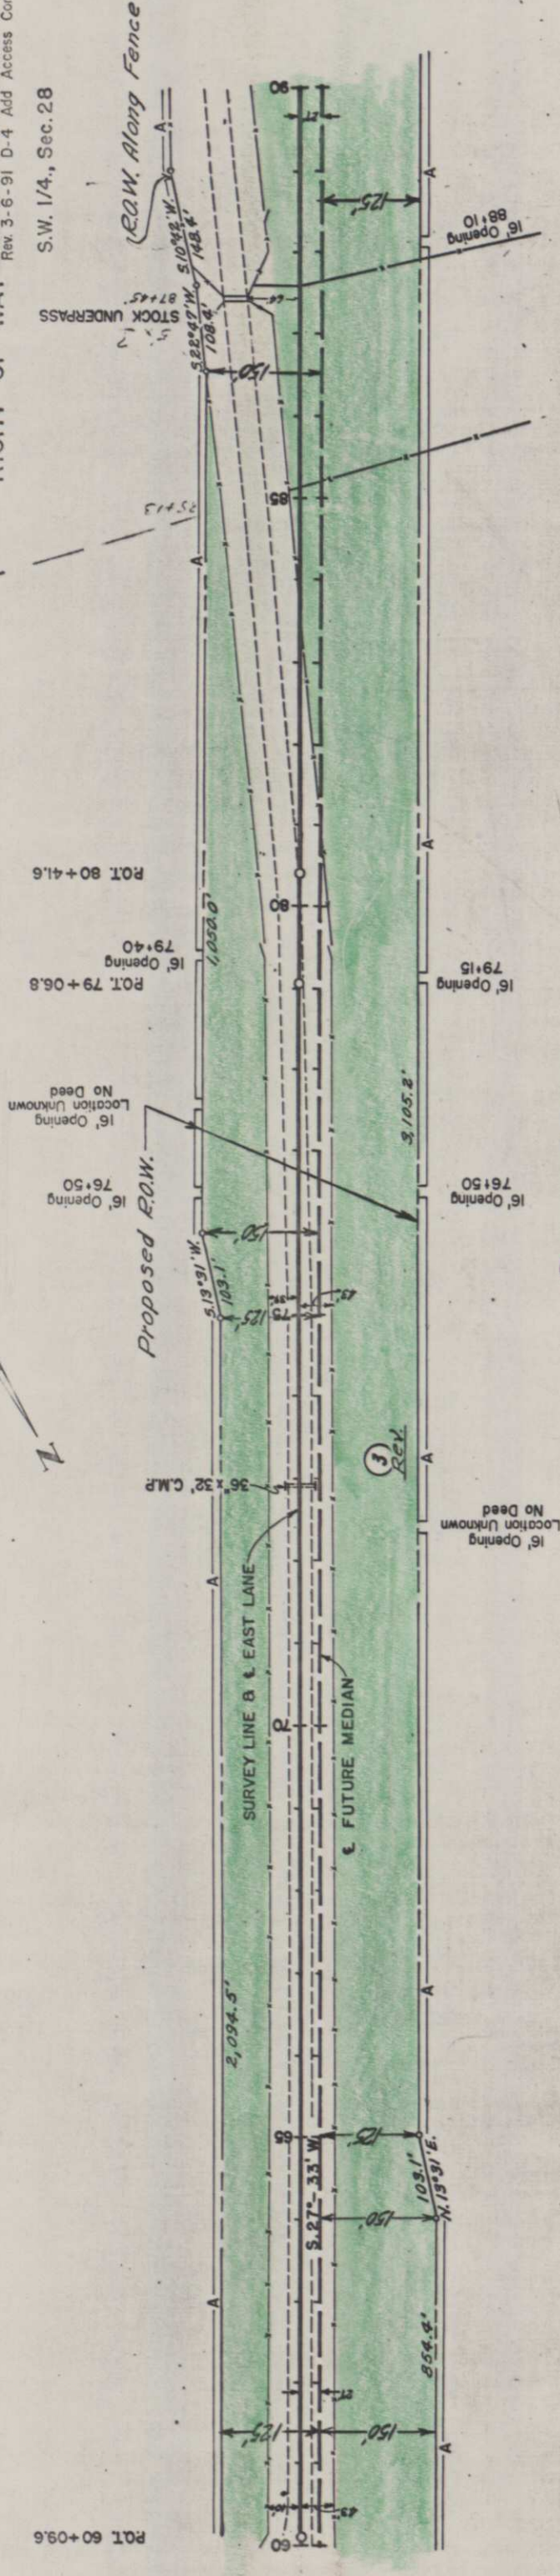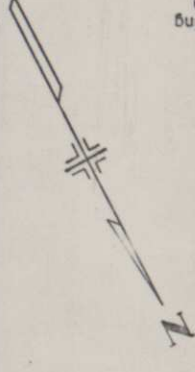

3 WELDON C. BAILEY  
REV. UP BAGGAGE DEPOT  
CHEYENNE, WYO.

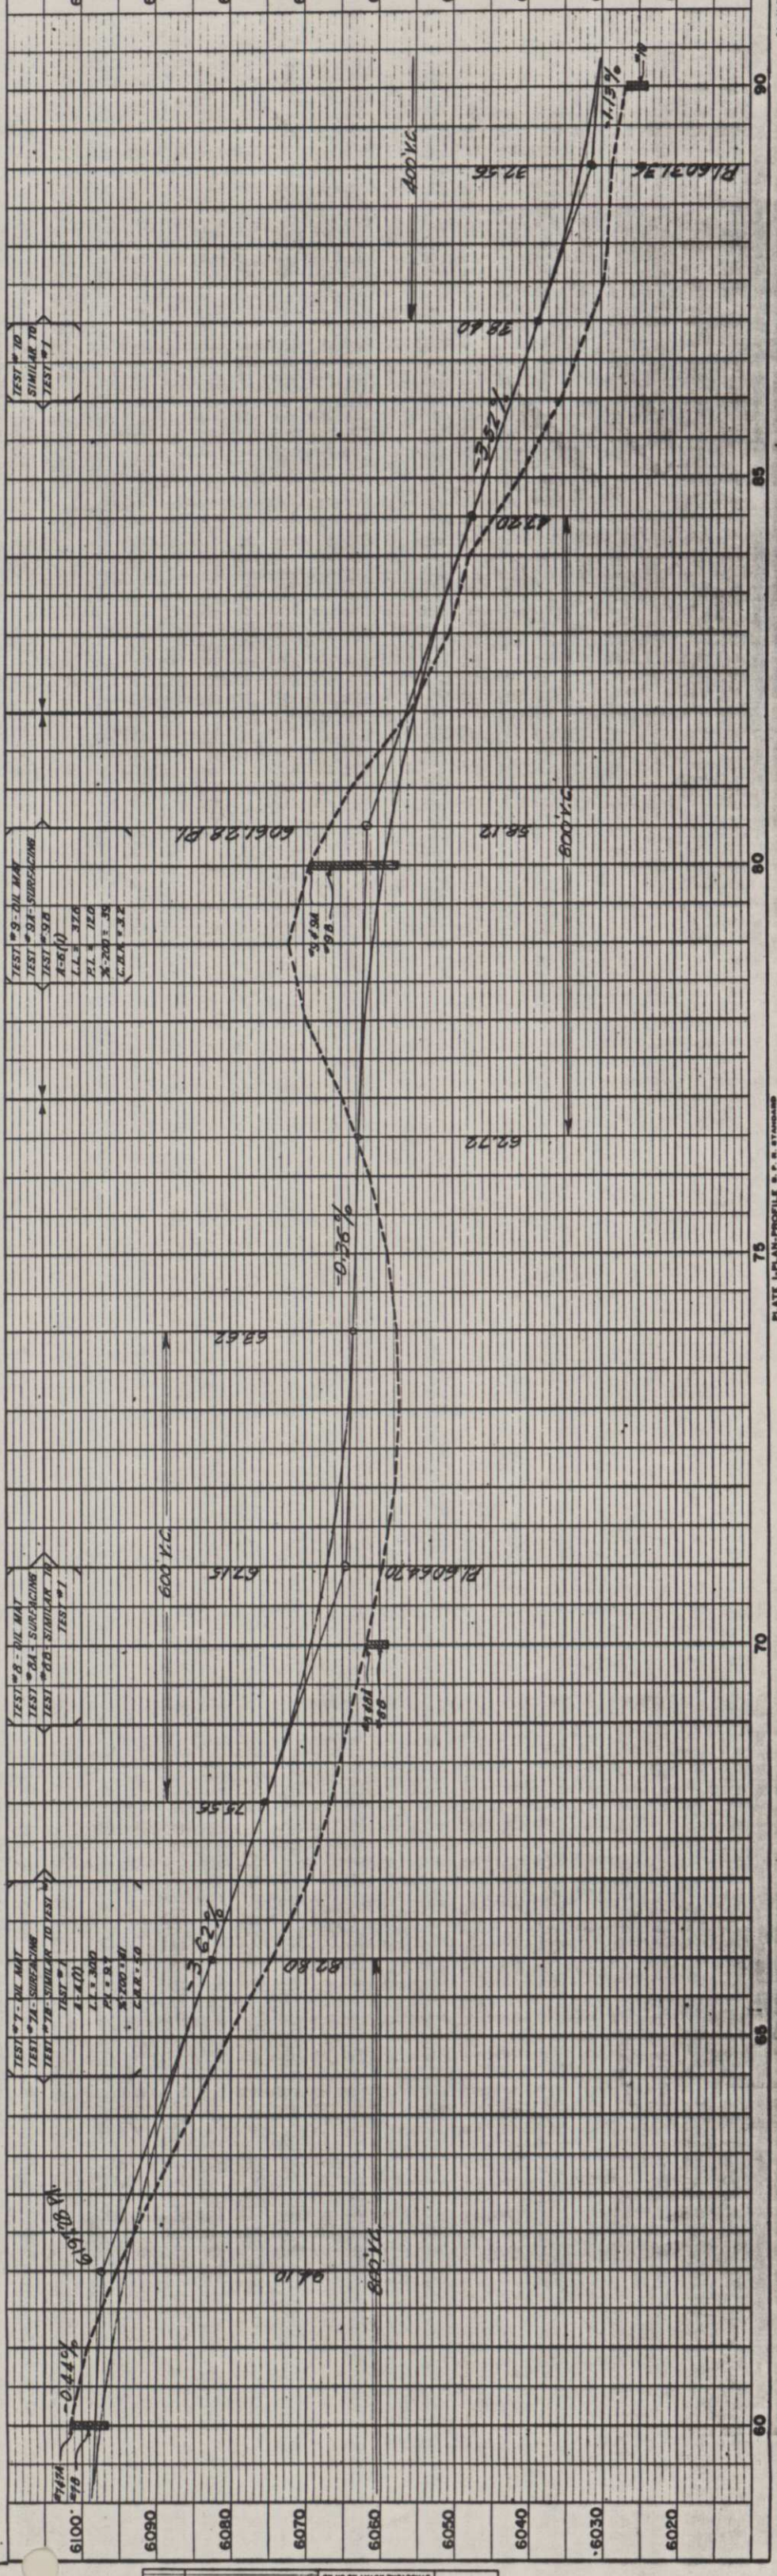

NO.	DATE	BY	REVISION
1	5-28	H.P. Winter	AS BUILT

NO.	DATE	BY	REVISION
1	7-19	H.P. Winter	AS BUILT

NO.	DATE	BY	REVISION
1	7-19	H.P. Winter	AS BUILT

S.W. 1/4, Sec. 28  
T. 12 N., R. 66 W.

3 WELDON C. BAILEY  
Re: U.P. BAGGAGE DEPOT  
CHEYENNE, WYO.

RAT 94+00

R.O.W. Along Fence

RAT 98+50



5 WARREN LIVESTOCK CO.  
CHEYENNE, WYO.

RAT 118+00

N.W. 1/4, Sec. 33

REV. 8-5-55 R.D.M. Parcel 4 Deleted	TOTAL SHEETS
FED. ROAD DIST. NO. 3	6
STATE COLO.	FOOS-11(4)
PROJ. NO.	
SHEET NO.	

RIGHT OF WAY  
Rev. 3-6-51 D-4 Add Access Control

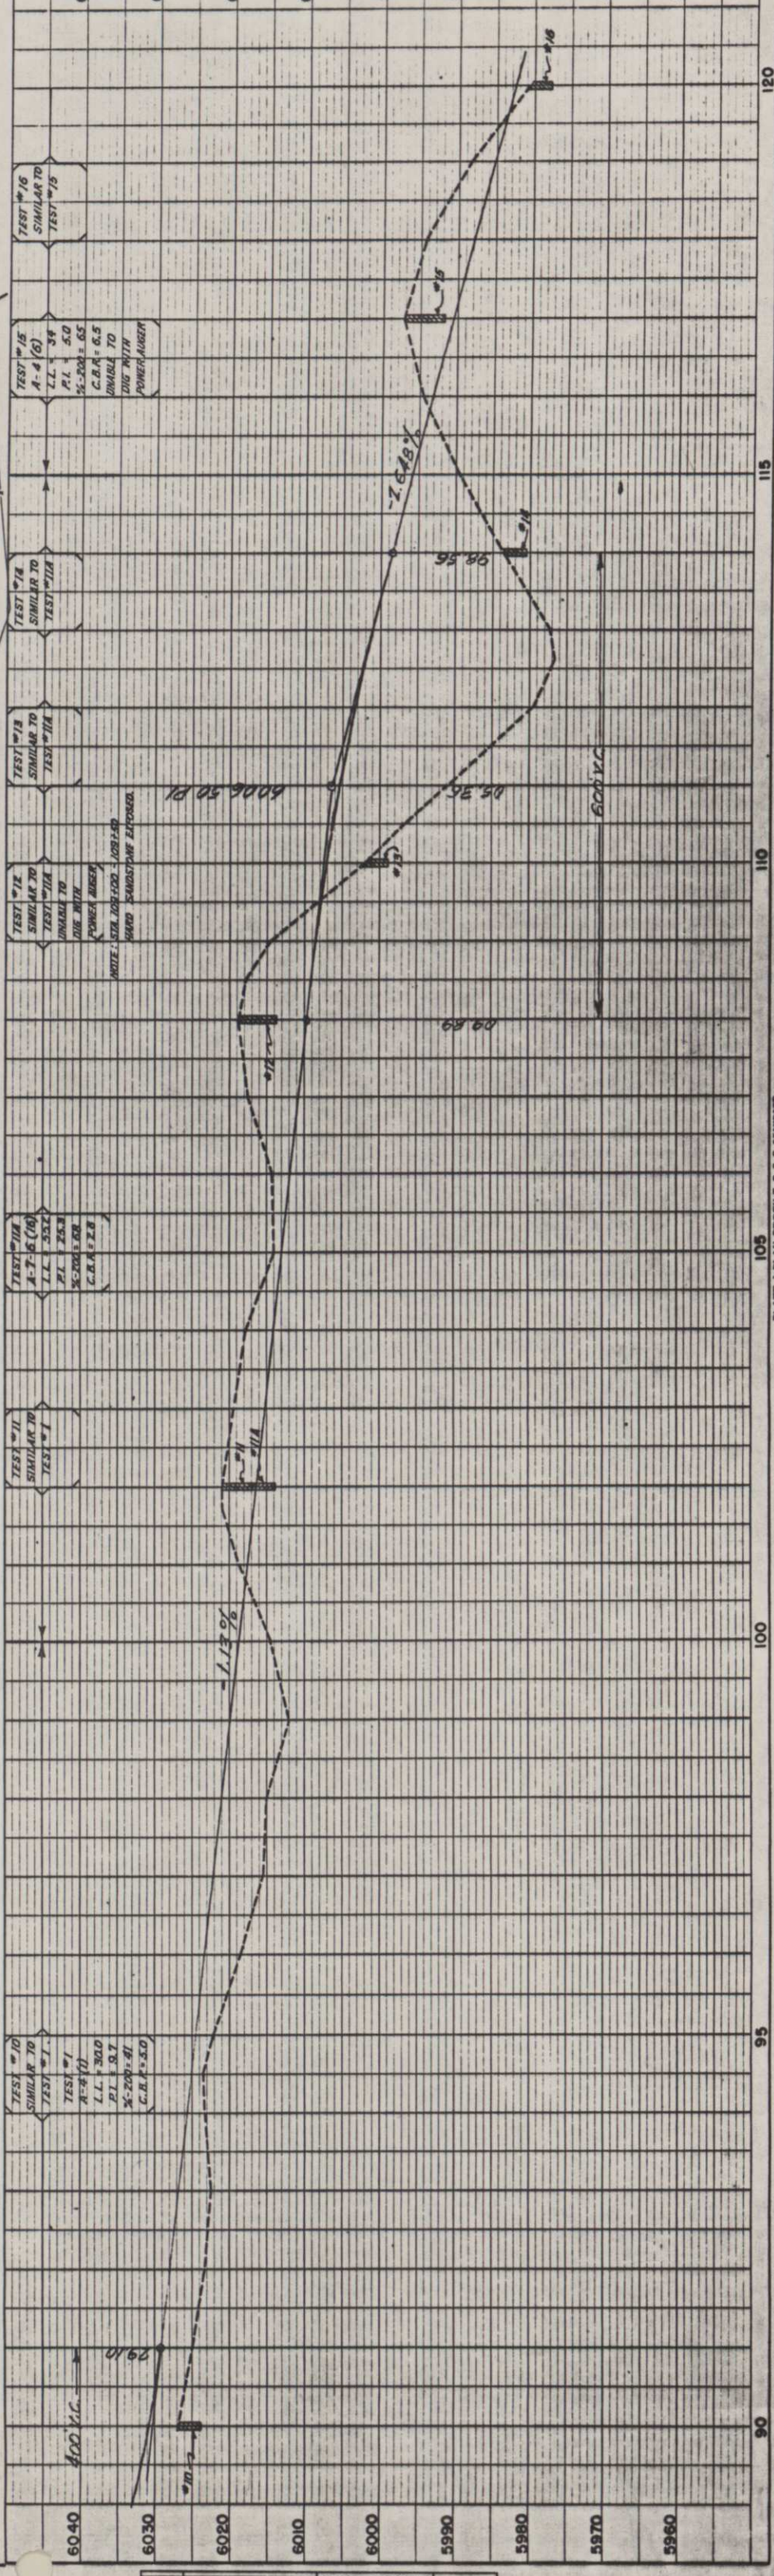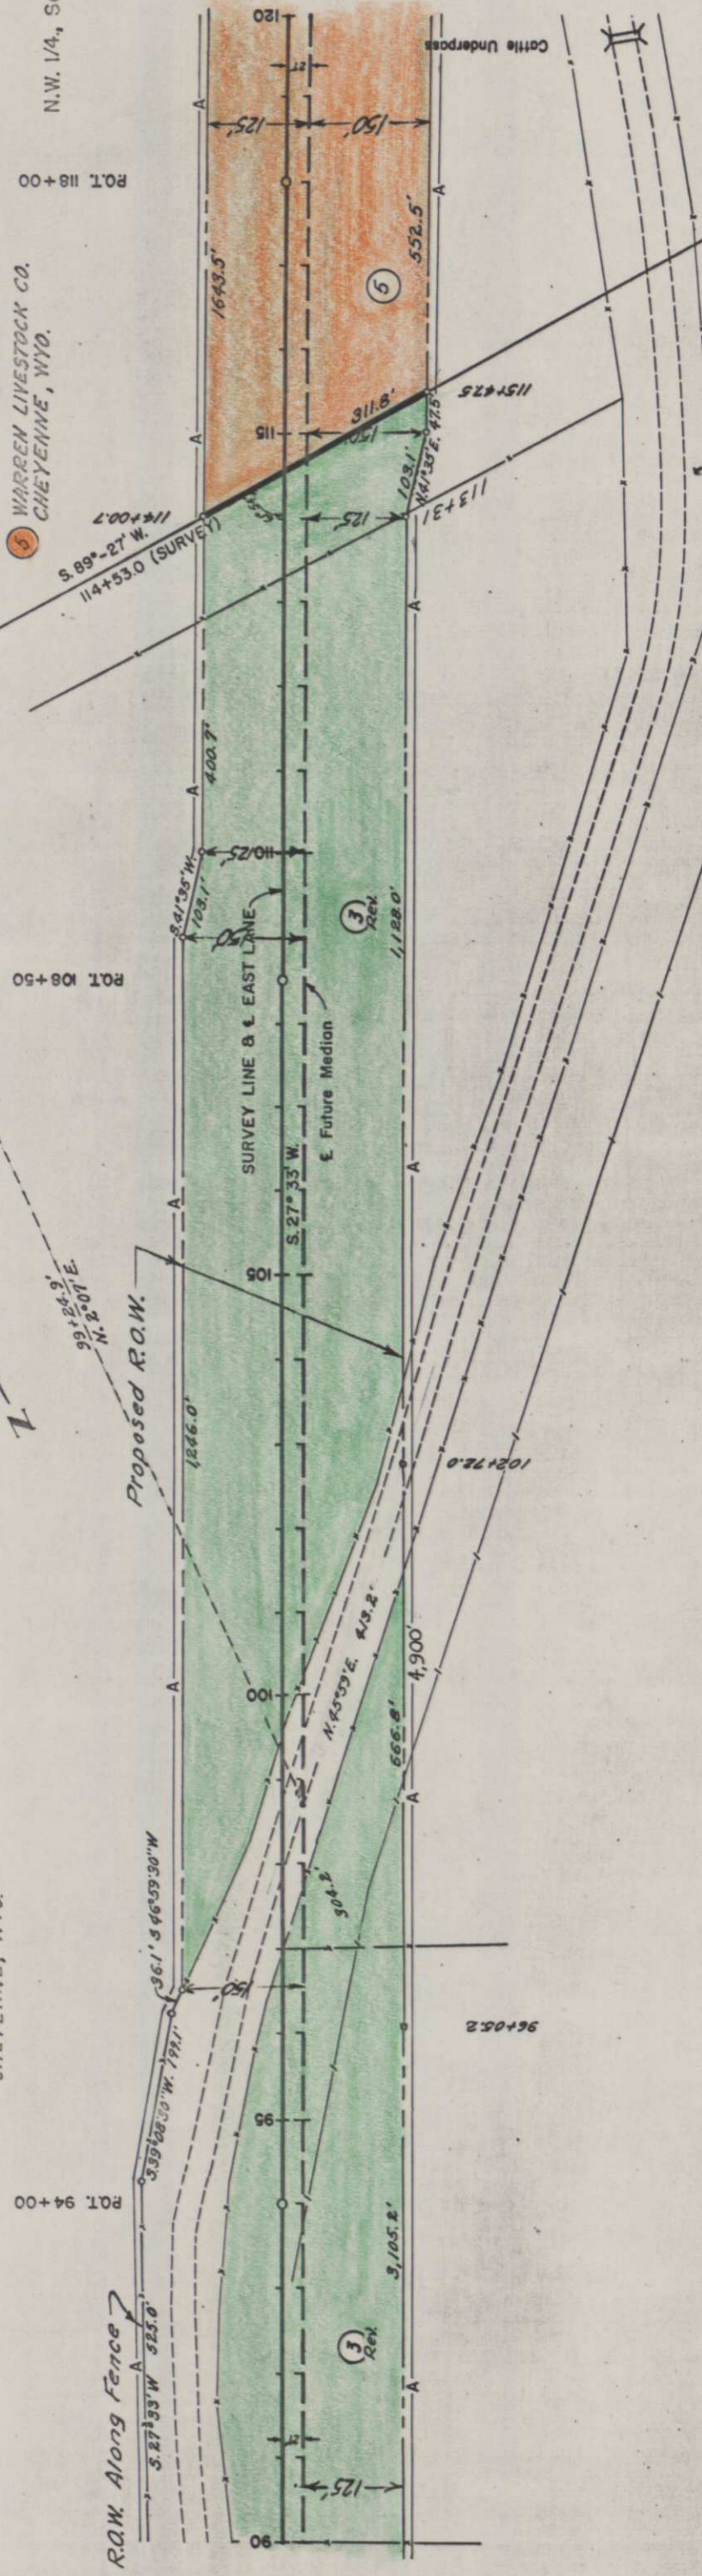

DATE	9-49
BY	H.P. WINTER
CHECKED	H.P. WINTER
PLANNED	
NOTE BOOK	
FLIGHT CHECKED	
PL. OF WAY CHECKED	
NO.	961052

DATE	9-49
BY	H.P. WINTER
CHECKED	H.P. WINTER
STRUCTURE NOTATION CHECKED	
NO. & NOTES	
PLANNED	
FLIGHT CHECKED	
NO.	961052

S.W. 1/4, Sec. 33  
T. 12 N., R. 66 W.


5 WARREN LIVESTOCK CO.  
CHEYENNE, WYO.

N.E. 1/4, Sec. 32


7 STATE OF COLORADO

FED. ROAD DIST. NO.	3
STATE	COLO.
PROJ. NO.	F008-1(4)
SHEET NO.	7
TOTAL SHEETS	

RIGHT OF WAY SURVEY LINE  
 MEDIAN = 24'-25' LT.  
 D = 1'-00"  
 T = 1239.1'  
 L R = 244.1' / 5730.0'  
 LR = 132.6'

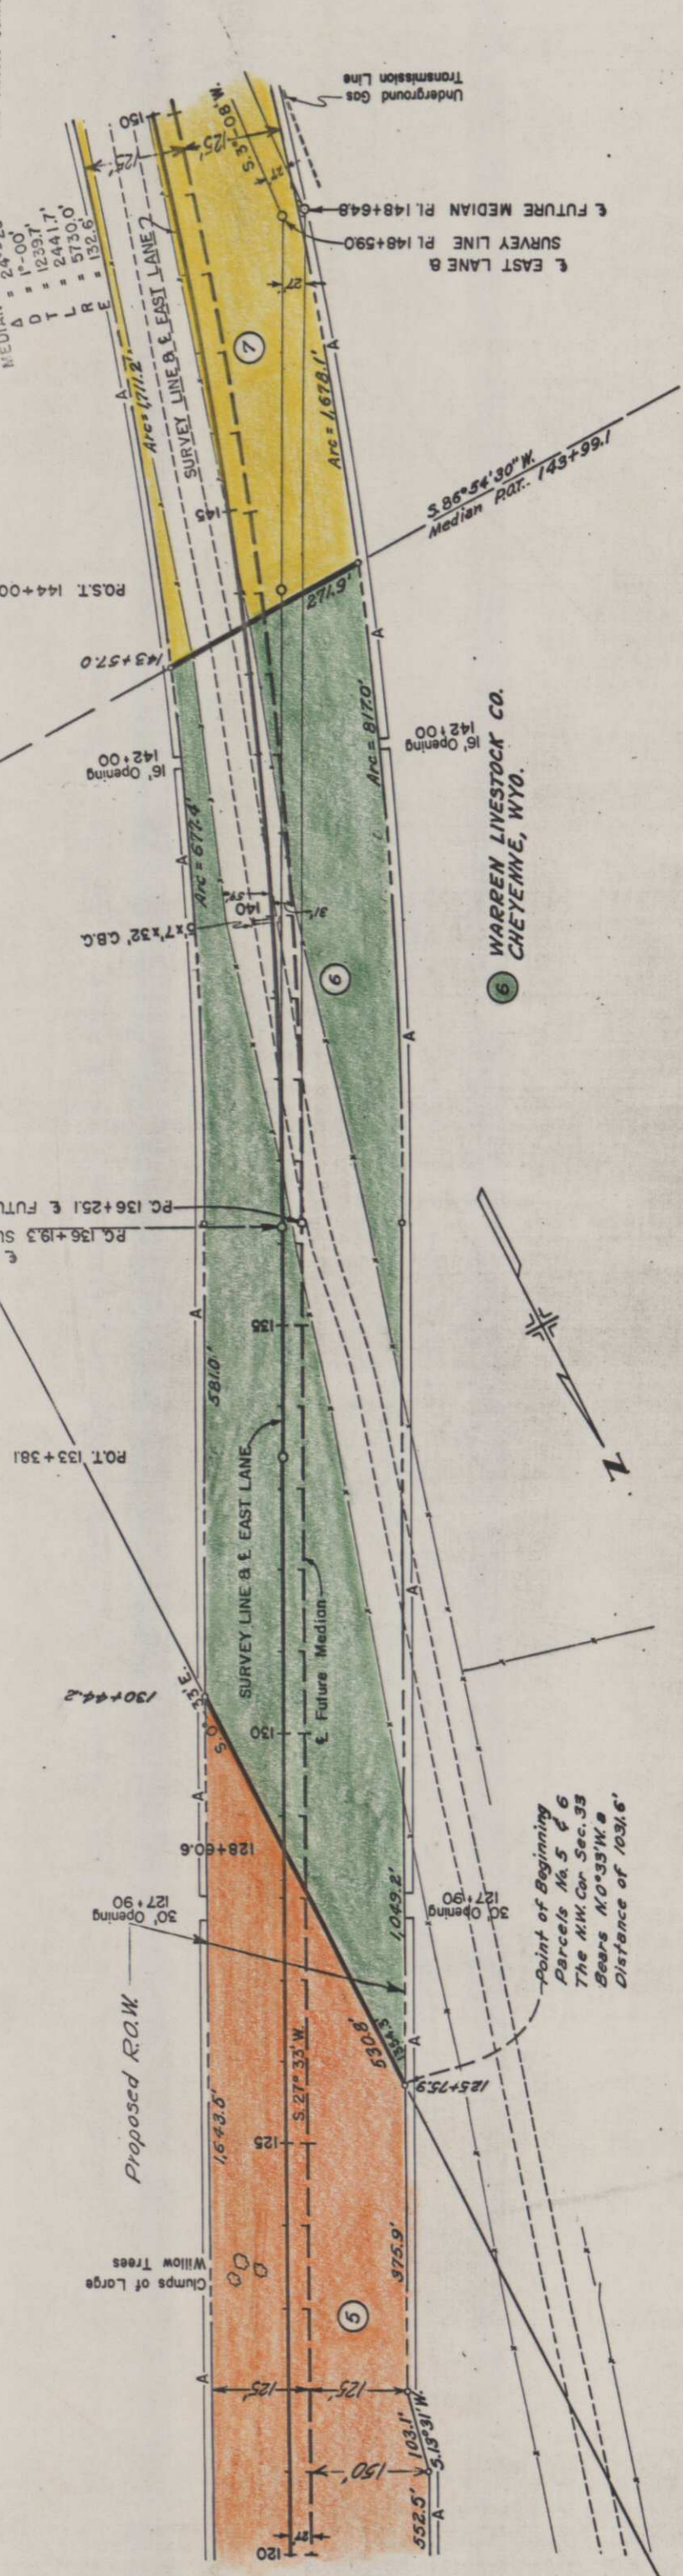

DATE	5-88
DRAWN	H.P. WITTEL
CHECKED	
IN CHARGE	

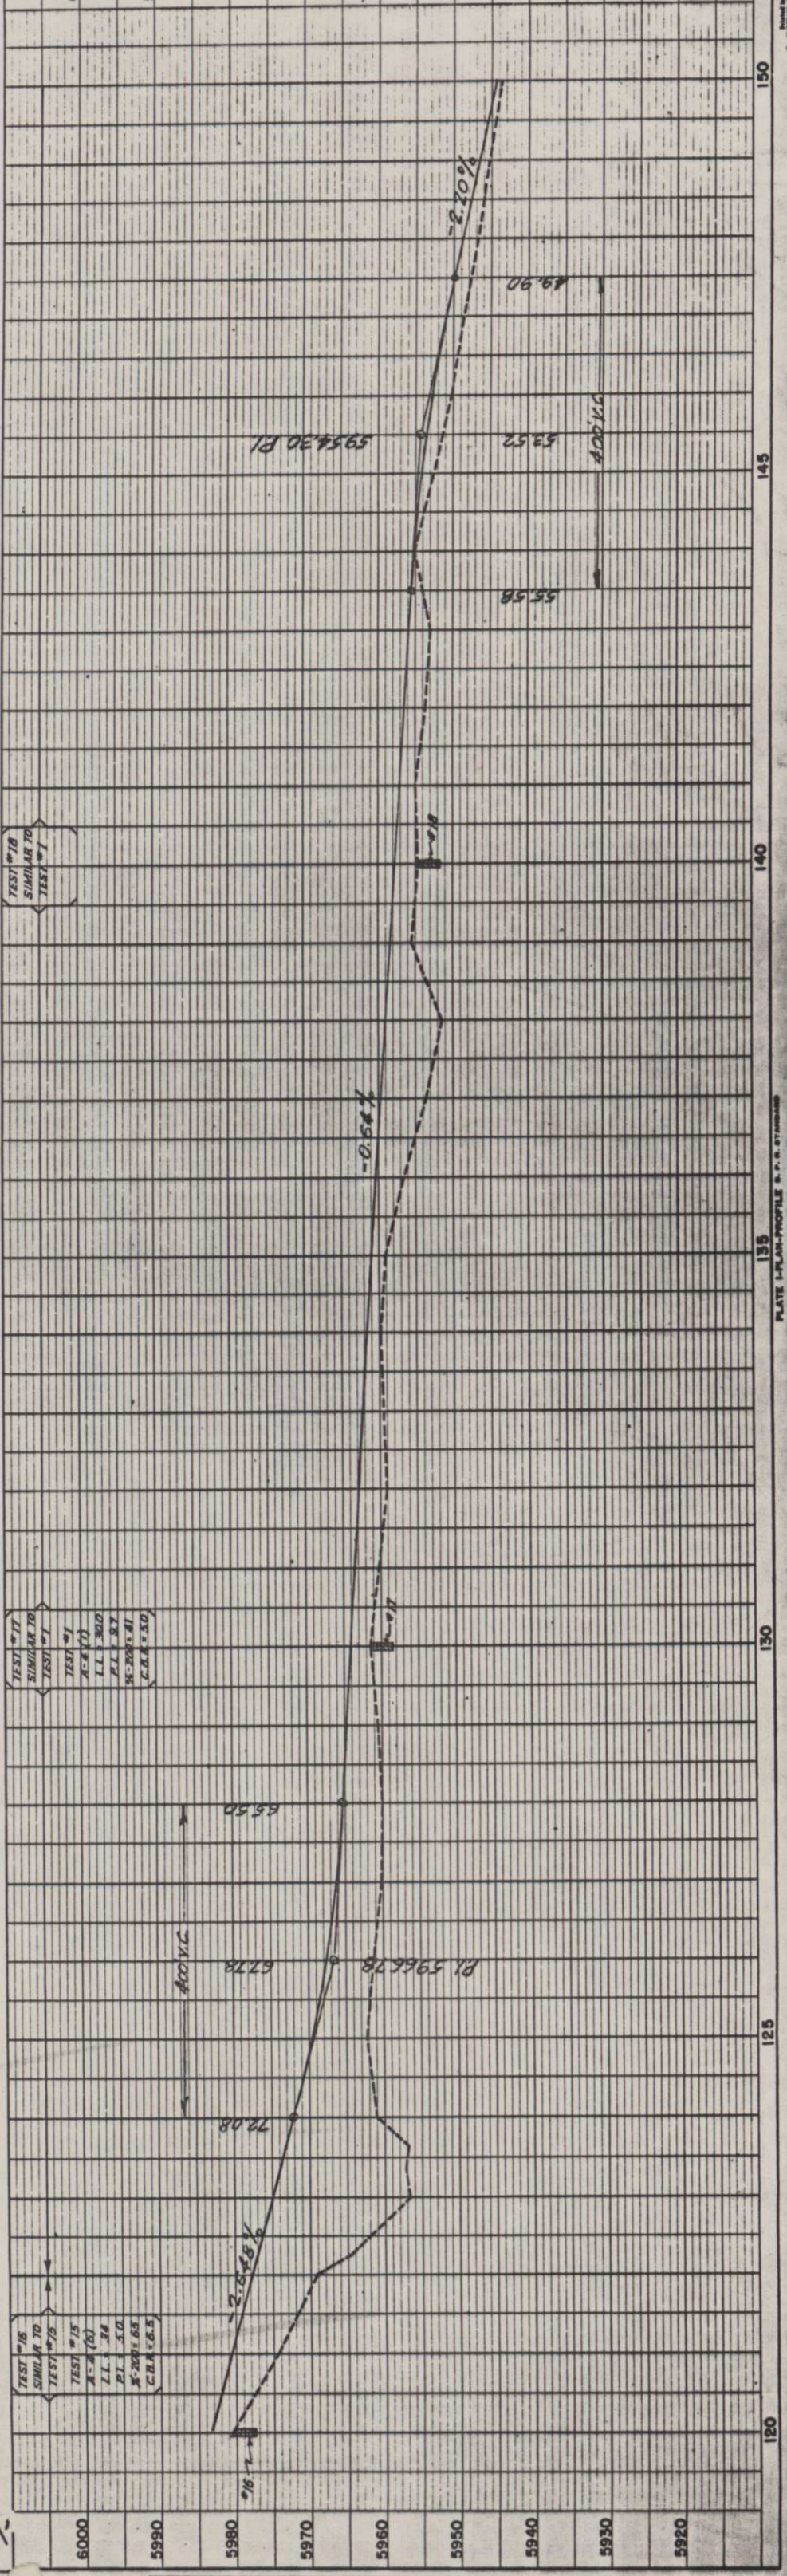

DATE	5-88
DRAWN	H.P. WITTEL
CHECKED	
IN CHARGE	

N.E. 1/4, Sec. 5  
T. 11 N., R. 66 W.

S.E. 1/4, Sec. 32  
T. 12 N., R. 66 W.


FED. ROAD DIST. NO.	3
STATE	COLO.
PROJ. NO.	F 008-1(14)
SHEET NO.	8
TOTAL SHEETS	

RIGHT OF WAY  
REV 3-6-91 D-4 Add Access Control

RO. 177+65.6  
SURVEY LINE  
RO. 177+65.6


RO. 177+65.6  
SURVEY LINE  
RO. 177+65.6

SURVEY & MEDIAN LINE  
Δ = 24°-25' LT.  
D = 1'-00"  
T = 1239.7'  
L = 2441.7'  
R = 5730.0'  
E = 132.6'

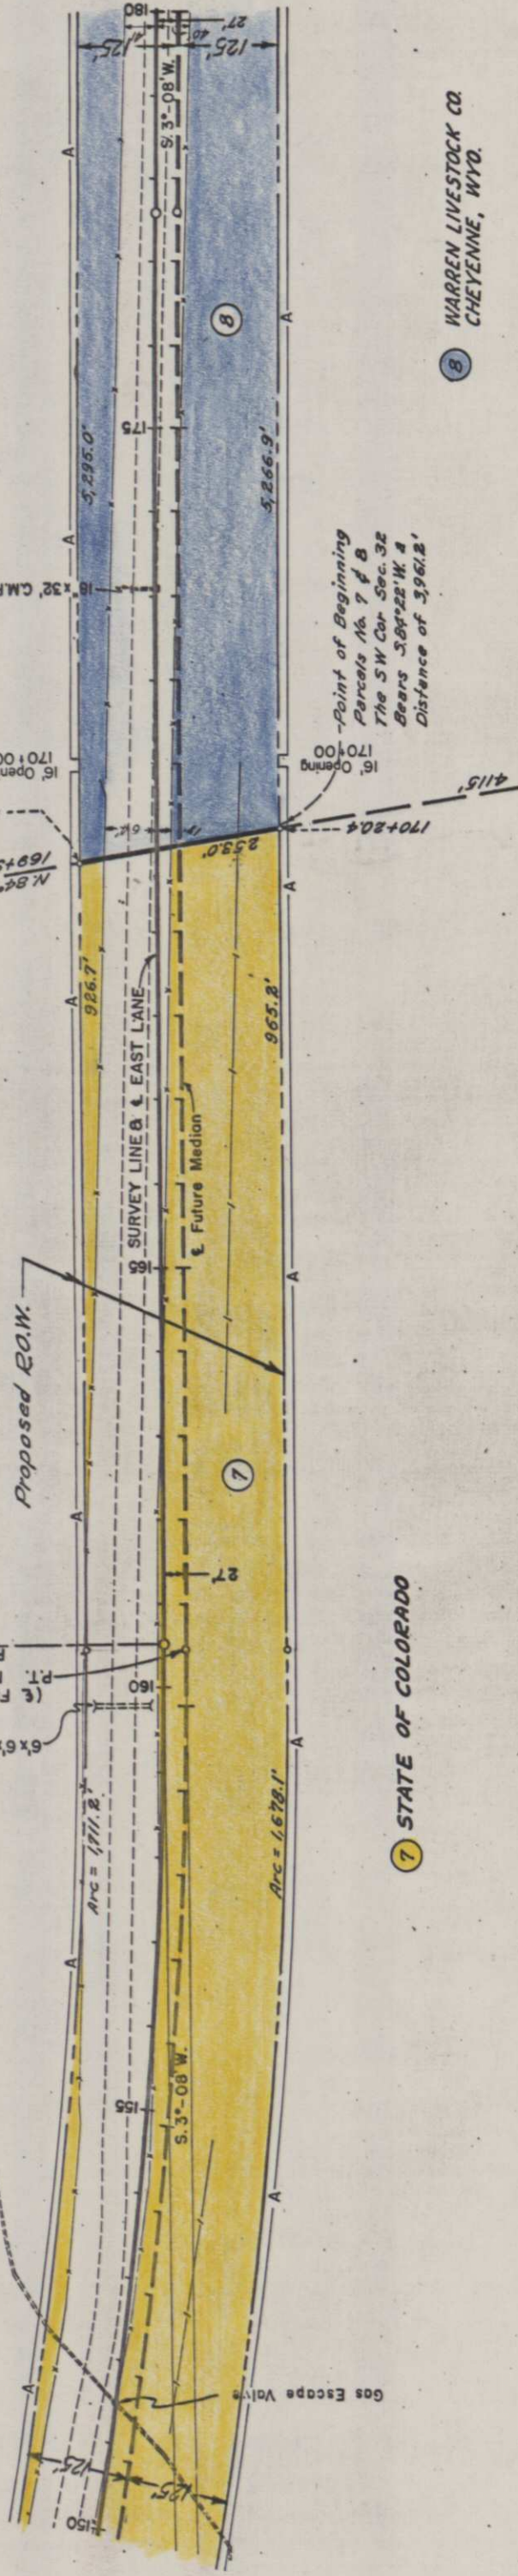

7 STATE OF COLORADO

8 WARREN LIVESTOCK CO  
CHEYENNE, WYO.

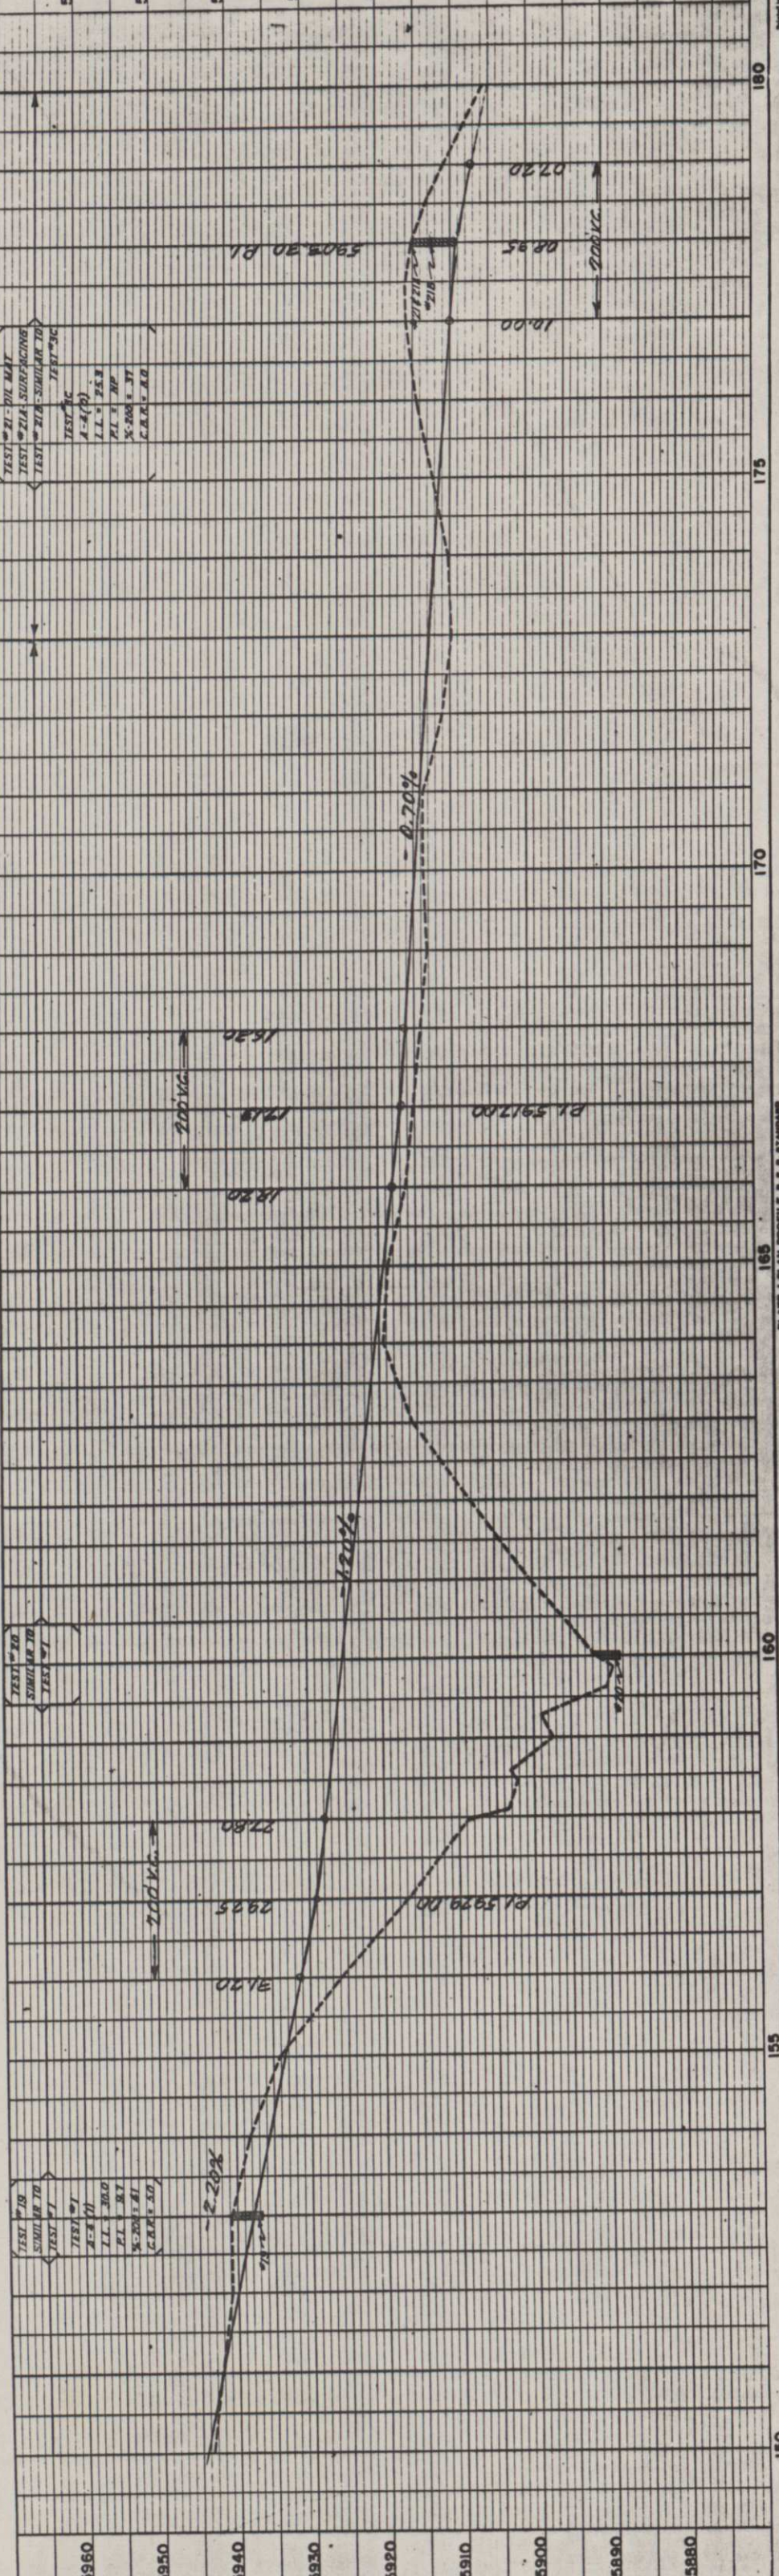

DATE	9-28
BY	H.J. Winter
CHECKED	R.P.
DATE	9-28
BY	H.J. Winter
CHECKED	R.P.

N.E. 1/4, Sec. 5  
T. 11N., R. 66W.

S.E. 1/4, Sec. 5

FED. ROAD DIST. NO.	STATE	PROJ. NO.	SHEET NO.	TOTAL SHEETS
3	COLO.	F006-1(14)	9	


RIGHT OF WAY Rev 3-6-91 D-4 Add Access Control

P.O.T. 191+00 SURVEY LINE  
P.O.T. 204+00 SURVEY LINE

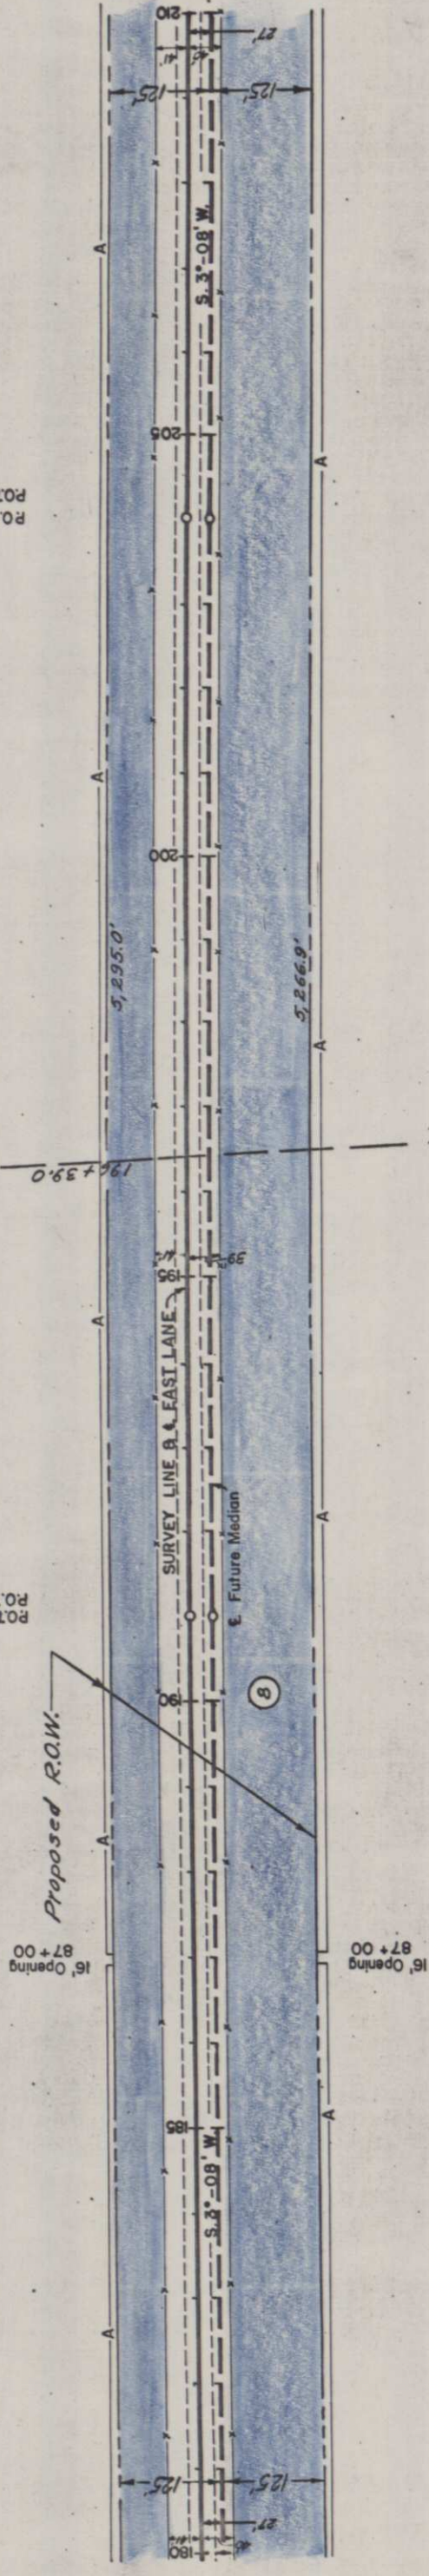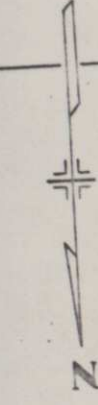

WARREN LIVESTOCK CO.  
CHEYENNE, WYO.

DATE	9-48
PLANNED BY	H.P. Winter
DESIGNED BY	H.P. Winter
CHECKED BY	H.P. Winter
DATE	9-48

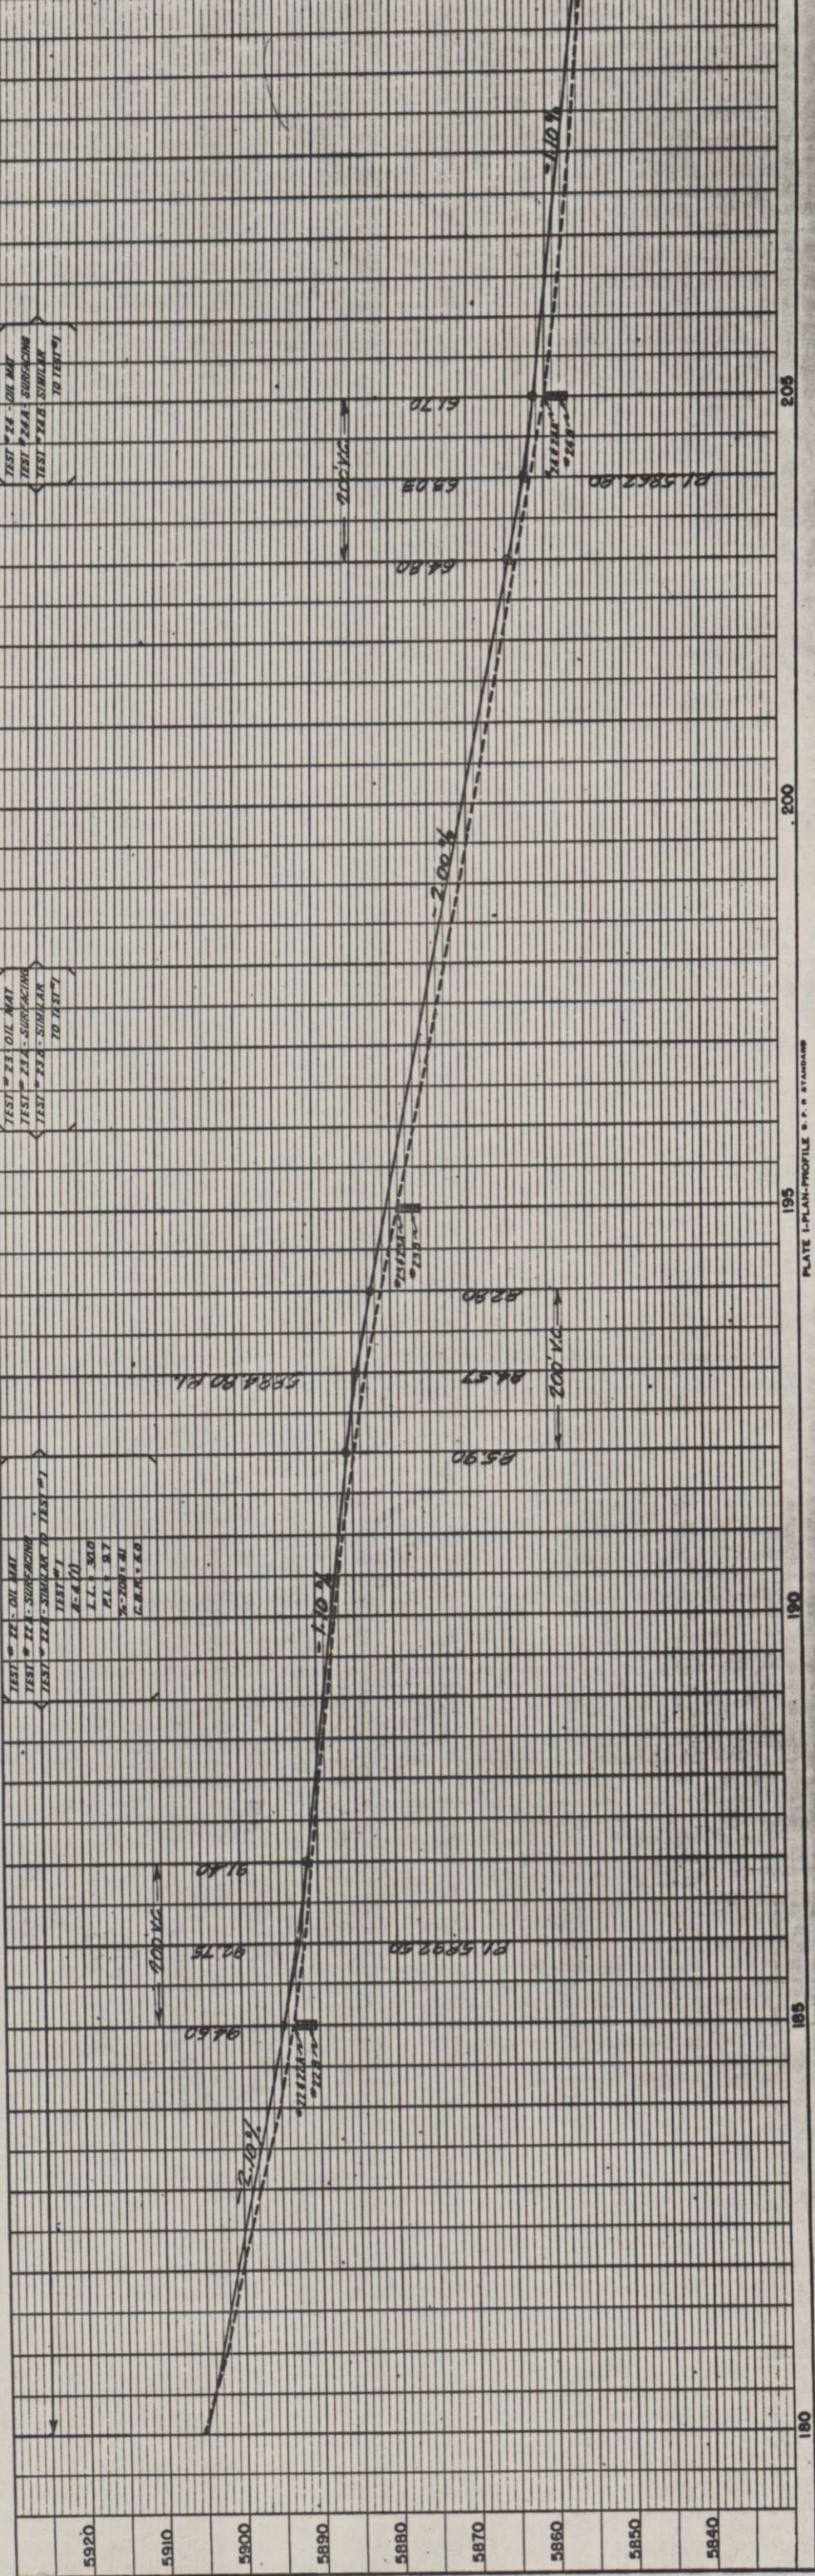


DATE	7-49
PLANNED BY	H.P. Winter
DESIGNED BY	H.P. Winter
CHECKED BY	H.P. Winter
DATE	7-49




FED. ROAD DIST. NO.	STATE	PROJ. NO.	SHEET NO.	TOTAL SHEETS
3	COLO.	F006-1(4)	II	

RIGHT OF WAY OWNERSHIP MAP PLAT

SHOWING CLAIMANTS WITH REGARD TO RIGHT OF WAY FOR PROJECT SPS 3-3-509 ORIGINAL SCALE 1"=400'

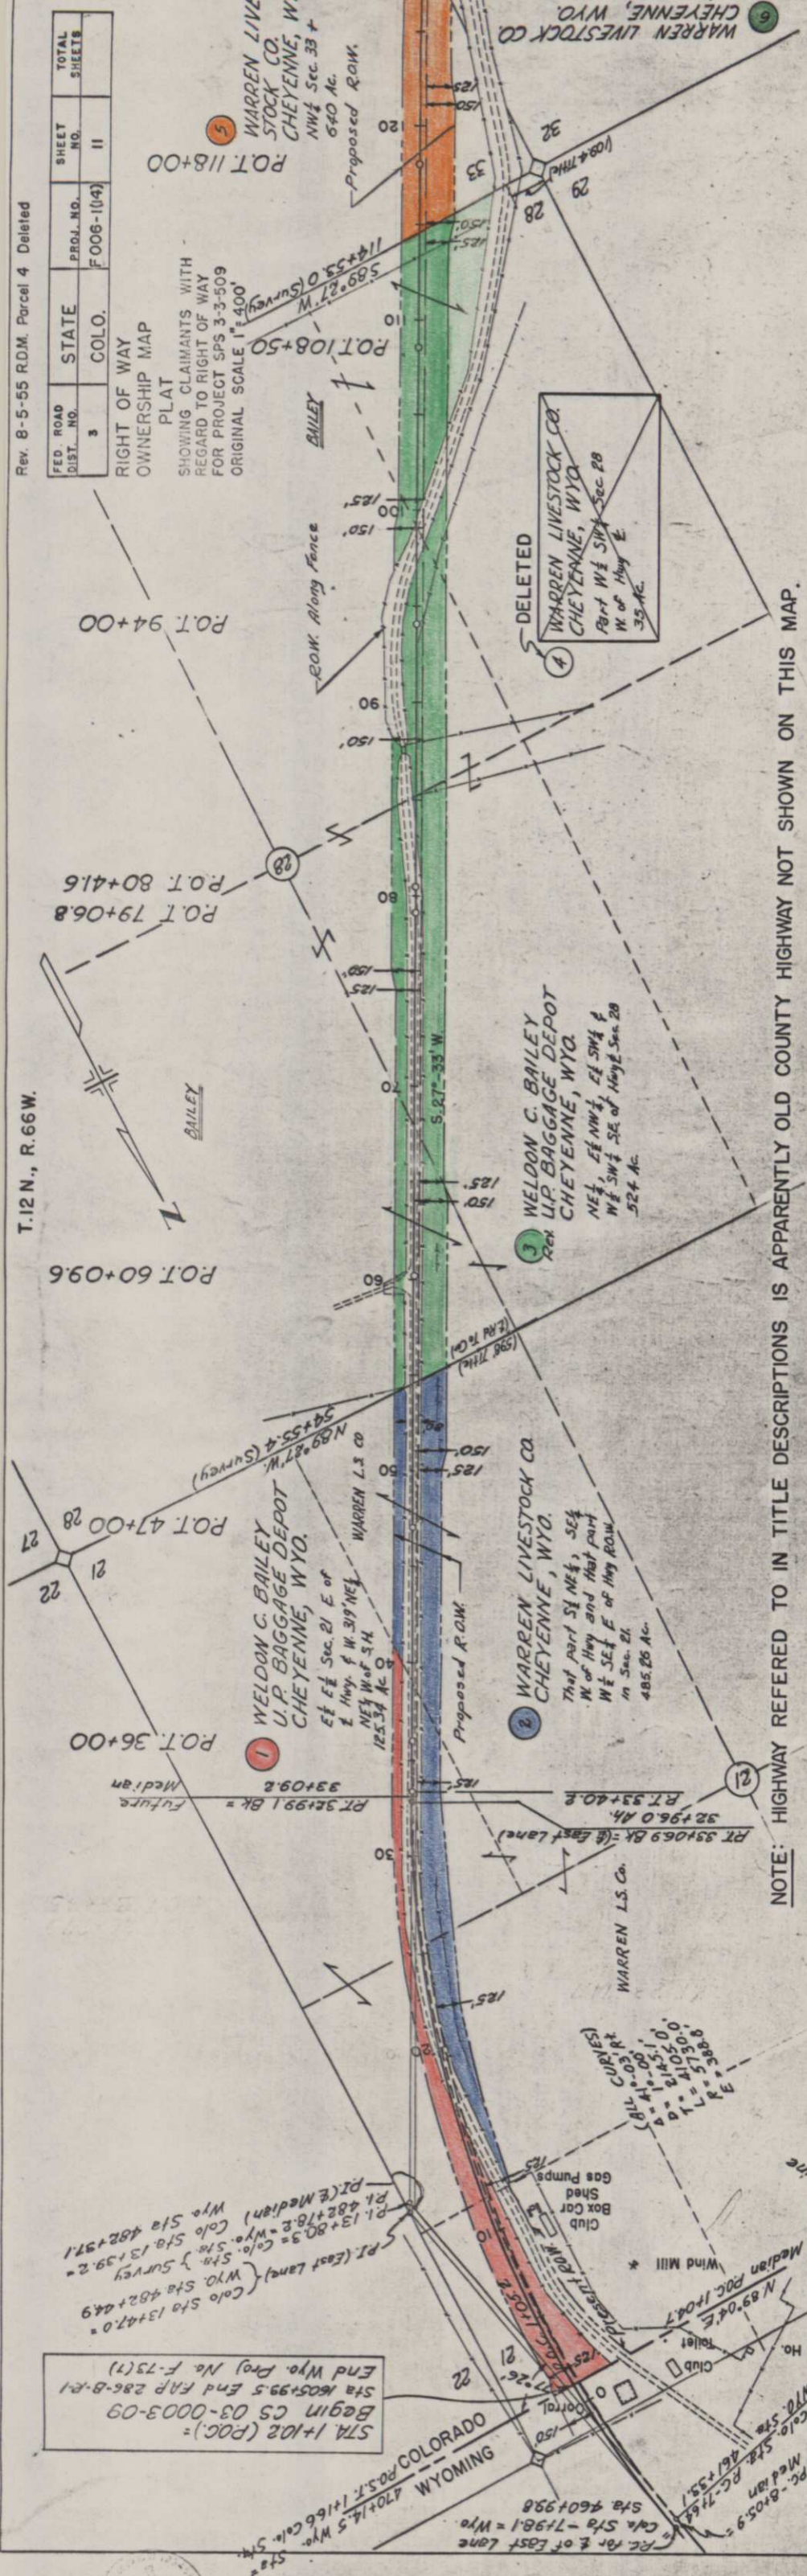

NOTE: HIGHWAY REFERRED TO IN TITLE DESCRIPTIONS IS APPARENTLY OLD COUNTY HIGHWAY NOT SHOWN ON THIS MAP.

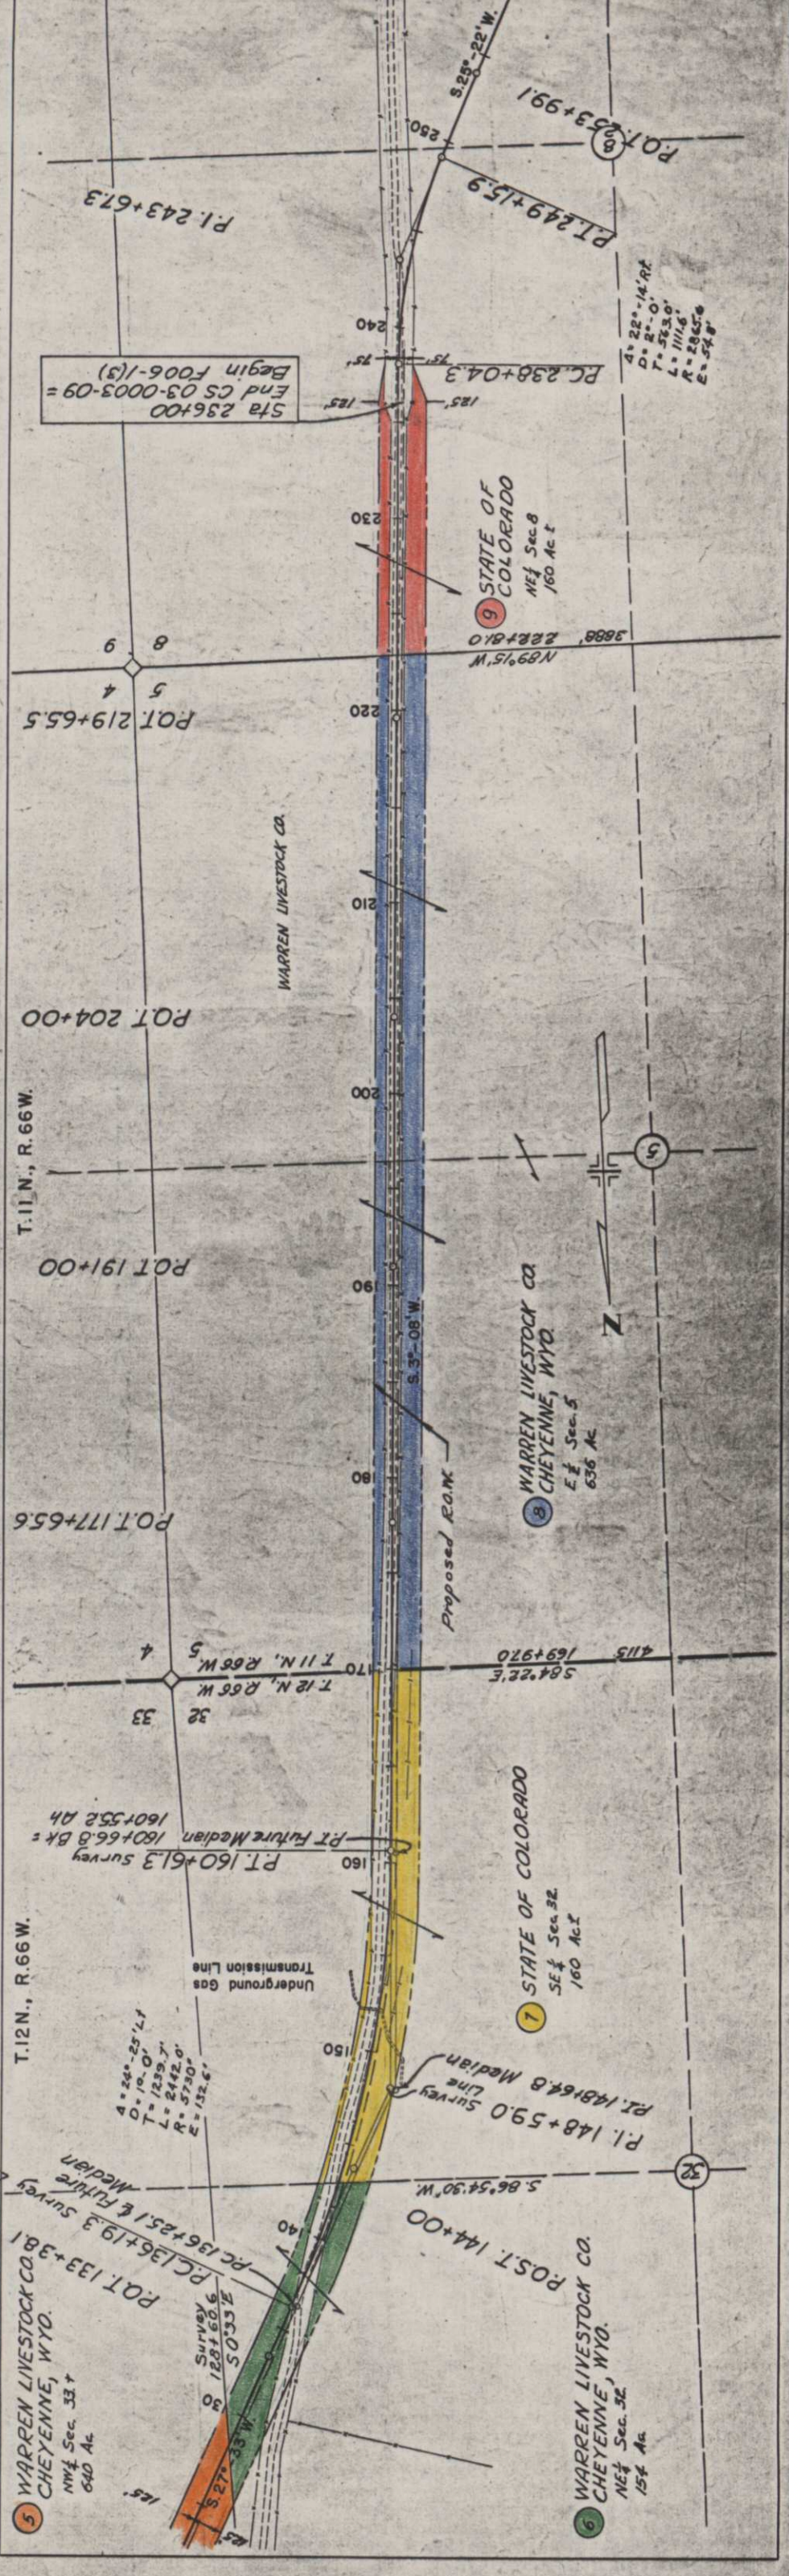

MICROFILMED