

JUL 31 1968

INACTIVE

**DEPARTMENT OF HIGHWAYS
STATE OF COLORADO**

**AS CONSTRUCTED
REVISED DATE DEC 4 1967**

FEDERAL ROAD DISTRICT NO.	DIVISION	PROJECT NO.	SHEET NO.
9	COLORADO	F 017-3(12)	1

INDEX OF SHEETS


- SHEET NO
- TITLE PAGE, SKETCH MAP & TABULATION OF LENGTH AND DESIGN DATA.
 - (No Rev) TYPICAL SECTIONS, GENERAL NOTES.
 - FINAL SUMMARY OF QUANTITIES.
 - TABULATIONS OF: EARTHWORK QUANTITIES, ROADWAY QUANTITIES, STRUCTURE QUANTITIES.
 - (No Rev) SINGLE & DOUBLE CONCRETE BOX CULVERTS (STANDARD M-60I-A SPECIAL FOR THIS PROJECT).
 - ALIGNMENT PLAN & PROFILE SHEET.
215 "AS CONSTRUCTED NO REVISIONS"
314 "VOID by CONSTR."
- M-206-A. EXCAVATION AND BACKFILL FOR STRUCTURES.(2 SHEETS). 3-17-67.
- M-500-A. LETTERS AND FIGURES FOR STRUCTURE NUMBERS. 7-1-65.
- M-60I-C. WINGWALLS FOR CONCRETE BOX CULVERTS-4:1 SIDE SLOPES.(2 SHEETS). 7-17-67, 7-1-65.
- M-607-A. WIRE FENCES AND GATES (2 SHEETS) 12- 8-66, 2-6-67.
- M-614-A. TIMBER BARRICADES 7-1-65
- M-614-IA. CONSTRUCTION IDENTIFICATION SIGNS. 6-19-67.
- M-614-TB. TRAFFIC SIGNING FOR HIGHWAY CONSTRUCTION.(3 SHEETS). 7-12-67, 7-1-65, 7-12-67.

PLAN AND PROFILE OF PROPOSED
FEDERAL AID PROJECT NO. F 017-3(12)
STATE HIGHWAY NO. 8
LINCOLN COUNTY

SCALES OF ORIGINAL DRAWINGS
ON PLAN 1 IN. = 100 FT.
ON PROFILE 1 IN. = 100 FT. HORIZONTAL
1 IN. = 10 FT. VERTICAL
GRADE LINE ON PROFILE IS SHOWN AS GRADE OF FINISHED ROAD


CONTRACTOR: FAST CONSTRUCTION CO.
RESIDENT ENGR: C. O. MYLES
DATE COMPLETED: DECEMBER 4, 1967

CONVENTIONAL SIGNS

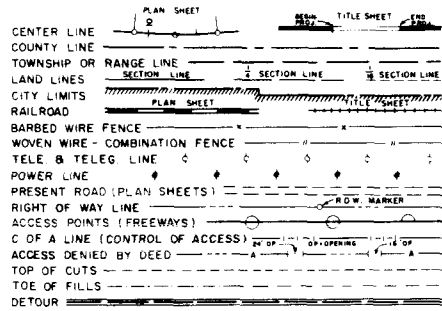

TABULATION OF LENGTH AND DESIGN DATA

STATION	ROADWAY		MAJOR STR. NO.
	LIN. FT.	LIN. FT.	H-22-G
1958+00 BEGIN F 017-3(12) = 1958+00 ON F 017-3(3)		24.0	
1958+24 STR. NO. H-22-G			32.0
1958+56		44.0	
1959+00 END F 017-3(12) = 1959+00 ON F 017-3(3)			
TOTALS	68.0	32.0	
SUMMARY			
ROADWAY	LIN. FT.	MILES	
MAJOR STRUCTURE	68.0	0.013	
NET & GROSS LENGTH	32.0	0.006	
	100.0	0.019	
DESIGN DATA			
MAXIMUM DEGREE OF CURVE	TANGENT		
MAXIMUM GRADE	0.057%		
MINIMUM S.S.D. HORIZONTAL	> 900'		
MINIMUM S.S.D. VERTICAL	> 1300'		
MAXIMUM DESIGN SPEED	70 M.P.H.		

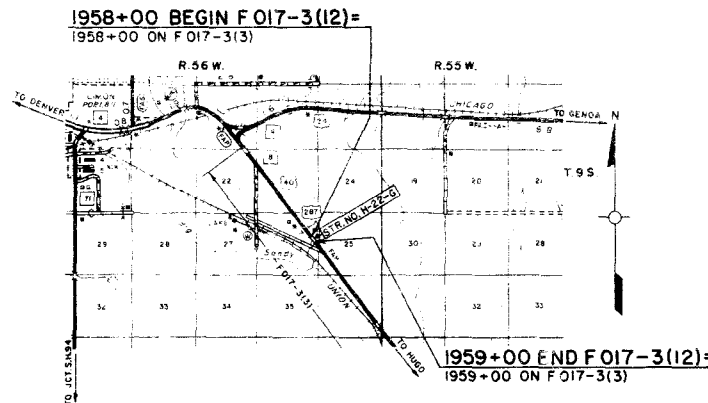

SEE SPECIAL PROVISIONS FOR
NOTICE TO BIDDERS

DEPARTMENT OF HIGHWAYS
STATE OF COLORADO

APPROVED: *[Signature]* 8-15-67
CHIEF ENGINEER DATE

DEPARTMENT OF TRANSPORTATION
FEDERAL HIGHWAY ADMINISTRATION
BUREAU OF PUBLIC ROADS

APPROVED: _____ DATE _____
DIVISION ENGINEER

FEDERAL ROAD REGION NO.	DISTRICT	PROJ. NO.	SHEET NO.	TOTAL SHEETS
8	COLORADO	F 017-3 (12)	2	

TYPICAL SECTION


THE DEPTH AND WIDTH OF THE SIDE DITCH SHALL BE VARIED WHERE NECESSARY IN ORDER TO PROVIDE PROPER DRAINAGE.

EXCAVATION BELOW 6:1 SLOPE AND/OR 10:1 SLOPE WILL NOT BE PERMITTED.

FILL SLOPES:

SLOPE 4:1 WHERE "H" IS 3' OR LESS
 SLOPE 3:1 WHERE "H" IS OVER 3'

IN SPECIAL CASES, SLOPE MAY BE STEEPENED.

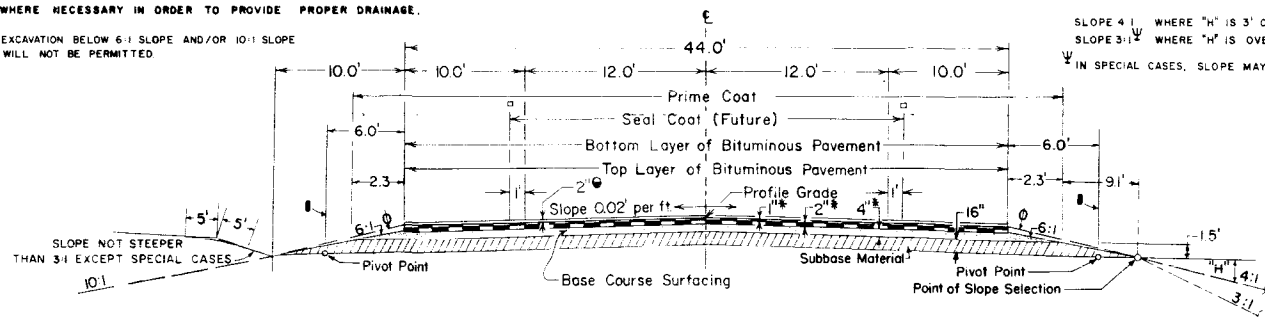

GENERAL NOTES

FOR PRELIMINARY PLAN QUANTITIES OF BITUMINOUS MATERIALS THE FOLLOWING RATES OF APPLICATION WERE USED:

PRIME COAT MC @ 0.40 GALS. PER SQ. YD.
 HOT BITUMINOUS PAVEMENT @ 110 LBS. PER SQ. YD. PER INCH

RATES OF APPLICATION SHALL BE AS DETERMINED BY THE ENGINEER AT THE TIME OF APPLICATION.

ANY LAYER OF BITUMINOUS PAVEMENT THAT IS TO HAVE A SUCCEEDING LAYER PLACED THEREON SHALL BE COMPLETED FULL WIDTH BEFORE SUCCEEDING LAYER IS PLACED.

TYPE OF COMPACTION FOR THIS PROJECT SHALL BE "STANDARD"

- ⊙ FUTURE CONSTRUCTION
- LOCATION OF 3" WIDE SOLID WHITE PAINTED STRIPE
- * APPROXIMATE THICKNESS

MATERIAL SHALL BE PLACED IN SEPARATE COURSES AT THE FOLLOWING RATES PER 100 LIN. FT. OF ROADWAY:

BITUMINOUS PAVEMENT	{	TOP COURSE	27 TONS
		BOTTOM COURSE	54 TONS
BASE COURSE			103 TONS

- ⊙ CONTRACTOR WILL BE REQUIRED TO PLACE A B.C. CLASS 7 TO THIS LINE AFTER COMPLETION OF PAVING OPERATION
- SUPERELEVATION CONTROL LINE

DEPTH OF MOISTURE-DENSITY CONTROL FOR THIS PROJECT SHALL BE AS FOLLOWS:

FULL DEPTH OF ALL EMBANKMENTS

BASE OF CUTS 1 FOOT.

BASE OF FILLS 1 FOOT

FULL DEPTH OF EMBANKMENT SECTIONS USED FOR DITCHES AND CHANNEL CHANGES


EXCAVATION REQUIRED FOR COMPACTION OF BASES OF CUTS AND FILLS WILL BE CONSIDERED AS SUBSIDIARY TO THAT OPERATION AND WILL NOT BE PAID FOR SEPARATELY.

EARTH SLOPES SHALL BE DISCED OR ROUGHENED BY OTHER APPROVED METHODS FOR MULCHING OR EROSION PROTECTION.

IT IS ESTIMATED THAT 250 HOURS OF FLAGGING FOR CONTROLLING TRAFFIC WILL BE REQUIRED FOR THIS PROJECT.

GUARD POSTS WILL BE REMOVED BY STATE FORCES.

DETOUR

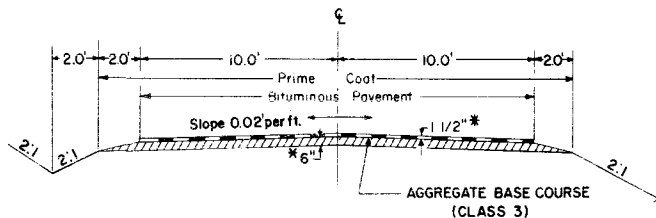

SUMMARY OF APPROXIMATE QUANTITIES

FEDERAL ROAD DISTRICT NO.	DIVISION	PROJ. NO.	SHEET NO.	TOTAL SHEETS
1	COLORADO	F 017-3(12)	3	

CONTRACT ITEM NO.	CONTRACT ITEM	UNIT	ROADWAY	STR. NO. H-22-G	PROJECT TOTALS
202	Removal of Bridge	Each		1	1
202	Removal of Fence	Lin. Ft.	600		600
203	Unclassified Excavation (Complete in Place)	Cu. Yd.	800	200	1,000
206	Structure Excavation (Haul)	Cu. Yd.		120	120
206	Structure Backfill (Class 3) (Haul)	Cu. Yd.		140	140
210	Reset Fence	Lin. Ft.	600		600
304	Aggregate Base Course (Class 3) (Haul)	Ton	800		800
304	Aggregate Base Course (Class 7) (Haul)	Ton	400		400
403	Hot Bituminous Pavement (Grading F) (Haul Asphalt & Hydrated Lime)	Ton	300		300
411	Liquid Asphaltic Material (MC-70)	Gal.	1,000		1,000
601	Concrete (Class Ax)	Cu. Yd.		262	262
602	Reinforcing Steel	Lb.		25,100	25,100
607	Corner and Line Brace Post	Each	2		2
607	Fence Combination Wire and Metal Posts	Lin. Ft.	700		700
614	Flagging	Hour	250		250
620	Field Laboratory	Each	1		1
620	Sanitary Facility	Each	1		1
621	Maintenance of Detours	L. S.	●		●
626	Mobilization	L. S.	●		●
<u>FORCE ACCOUNT</u>					
	Recondition Pit & Pit Area	L. S.	●		●
<u>STATE FORCES</u>					
	Furnishing and Installing Identification Sign	Each	2		2
	Signing and Striping Entire Project (NON-FEDERAL AID)	L. S.	●		●
<u>RIGHT OF WAY</u>					
	Easement (Non-Federal Aid)	L. S.	●		●

FEDERAL ROAD REGION NO.	DISTRICT	PROJ. NO.	SHEET NO.	TOTAL SHEETS
9	COLORADO	F017-3 (12)	4	

SUMMARY OF EARTHWORK QUANTITIES

Unclassified Excavation (From Cross Sections)	170 Cu. Yd.
Additional Unclassified Excavation	500 Cu. Yd.
Estimate for Subsidence	67 Cu. Yd.
TOTAL	737 Cu. Yd.
For Information Only	
Unclassified Excavation (From Cross Sections)	170 Cu. Yd.
Additional Excavation	500 Cu. Yd.
TOTAL	670 Cu. Yd.
Embankment (From Cross Sections)	515 Cu. Yd.
Embankment x Factor	670 Cu. Yd.

QUANTITIES FOR ROADWAY

Item	Unit	Quantity
Removal of Fence	Lin. Ft.	595
Unclassified Excavation (C.I.P.)	Cu. Yd.	670
Reset Fence	Lin. Ft.	595
Aggregate Base Course (Class 3)(Haul)	Ton	758
Aggregate Base Course (Class 7)(Haul)	Ton	391
Hot Bituminous Pavement (Grading F) (Haul Asphalt & Hydrated Lime)	Ton	282
Liquid Asphaltic Material (MC 70)	Gal.	963
Fence Combination Wire With Metal Posts	Lin. Ft.	655
Corner and Line Brace Post	Each	2
Maintenance of Detours	L.S.	●

QUANTITIES FOR STR. NO. H-22-G

Item	Unit	Quantity
Removal of Bridge	Each	1
Unclassified Excavation (C.I.P.)	Cu. Yd.	150
Structure Excavation (Haul)	Cu. Yd.	115
Structure Backfill (Class 3)(Haul)	Cu. Yd.	135
Concrete Class AX	Cu. Yd.	261.65
Reinforcing Steel	Lb.	25,063



SINGLE CONCRETE BOX CULVERT

STANDARD M-60I-A
(JULY 1, 1965)

FED ROAD DIST. NO.	DIVISION	PROJECT NO.	SHEET NO.
9	COLORADO	F 017-3 (12)	5

Dimensions & Quantities (see Wingwall Standard for Wings)

Height of Fill (ft)	Type	Span (ft)	Height (ft)	Walls (ft)	Bar Size & Spacing		No. Bars		Concrete		Steel	
					Top	Bottom	Concrete	Steel	Concrete	Steel		
15	2A	3.0	2.0	4	8	12	4	4	2.12	1.5	1.5	
20	3A	3.0	3.0	7	8	12	4	4	2.32	1.5	1.5	
20	4A	4.0	3.0	7	8	12	4	4	2.32	1.5	1.5	
16	5A	5.0	3.0	8	8	12	4	4	2.32	1.5	1.5	
20	5B	5.0	3.0	8	8	12	4	4	2.32	1.5	1.5	
14	6A	6.0	3.0	8	8	12	4	4	2.32	1.5	1.5	
20	6B	6.0	3.0	10	8	12	4	4	2.32	1.5	1.5	
18	7A	7.0	3.0	9	8	12	4	4	2.32	1.5	1.5	
15	7B	7.0	3.0	10	8	12	4	4	2.32	1.5	1.5	
20	7C	7.0	3.0	11	8	12	4	4	2.32	1.5	1.5	
10	8A	8.0	3.0	10	8	12	4	4	2.32	1.5	1.5	
16	8B	8.0	3.0	11	8	12	4	4	2.32	1.5	1.5	
20	8C	8.0	3.0	12	8	12	4	4	2.32	1.5	1.5	
7	9A	9.0	3.0	10	8	12	4	4	2.32	1.5	1.5	
4	9B	9.0	3.0	11	8	12	4	4	2.32	1.5	1.5	
20	9C	9.0	3.0	12	8	12	4	4	2.32	1.5	1.5	
5	10A	10.0	3.0	12	8	12	4	4	2.32	1.5	1.5	
10	10B	10.0	3.0	13	8	12	4	4	2.32	1.5	1.5	
16	10C	10.0	3.0	14	8	12	4	4	2.32	1.5	1.5	
5	11A	11.0	3.0	12	8	12	4	4	2.32	1.5	1.5	
9	11B	11.0	3.0	13	8	12	4	4	2.32	1.5	1.5	
15	11C	11.0	3.0	14	8	12	4	4	2.32	1.5	1.5	
5	12A	12.0	3.0	12	8	12	4	4	2.32	1.5	1.5	
10	12B	12.0	3.0	13	8	12	4	4	2.32	1.5	1.5	
4	13A	13.0	3.0	12	8	12	4	4	2.32	1.5	1.5	
8	13B	13.0	3.0	13	8	12	4	4	2.32	1.5	1.5	
4	14A	14.0	3.0	12	8	12	4	4	2.32	1.5	1.5	
8	14B	14.0	3.0	13	8	12	4	4	2.32	1.5	1.5	

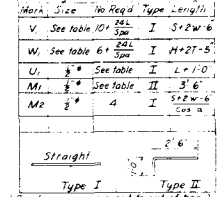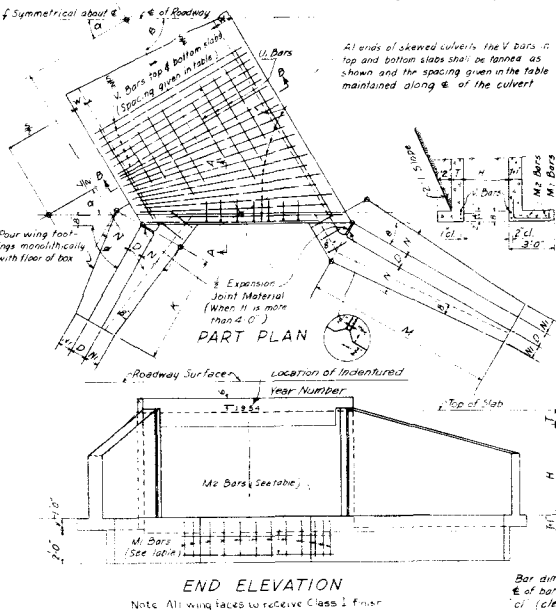

TYPICAL SECTION THROUGH CULVERT

REVISIONS

NO.	DESCRIPTION	DATE
(21)	THIS DRAW. ONLY. JRE	7-21-65

STANDARD M-60I-A



SINGLE CONCRETE BOX CULVERT

STANDARD M-60I-A
(JULY 1, 1965)

FED ROAD DIST. NO.	DIVISION	PROJECT NO.	SHEET NO.
9	COLORADO	F 017-3 (12)	5

Dimensions & Quantities (see Wingwall Standard for Wings)

Height of Fill (ft)	Type	Span (ft)	Height (ft)	Walls (ft)	Bar Size & Spacing		No. Bars		Concrete		Steel	
					Top	Bottom	Concrete	Steel	Concrete	Steel		
10	6A	4.0	3.0	8	8	12	4	4	2.12	1.5	1.5	
16	6B	6.0	3.0	8	8	12	4	4	2.32	1.5	1.5	
20	6C	6.0	3.0	10	8	12	4	4	2.32	1.5	1.5	
10	8A	8.0	3.0	10	8	12	4	4	2.32	1.5	1.5	
16	8B	8.0	3.0	11	8	12	4	4	2.32	1.5	1.5	
20	8C	8.0	3.0	12	8	12	4	4	2.32	1.5	1.5	
10	10A	10.0	3.0	12	8	12	4	4	2.32	1.5	1.5	
16	10B	10.0	3.0	13	8	12	4	4	2.32	1.5	1.5	
20	10C	10.0	3.0	14	8	12	4	4	2.32	1.5	1.5	
5	12A	12.0	3.0	12	8	12	4	4	2.32	1.5	1.5	
10	12B	12.0	3.0	13	8	12	4	4	2.32	1.5	1.5	
15	12C	12.0	3.0	14	8	12	4	4	2.32	1.5	1.5	
5	14A	14.0	3.0	12	8	12	4	4	2.32	1.5	1.5	
10	14B	14.0	3.0	13	8	12	4	4	2.32	1.5	1.5	

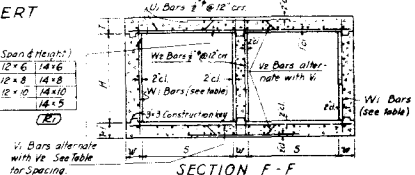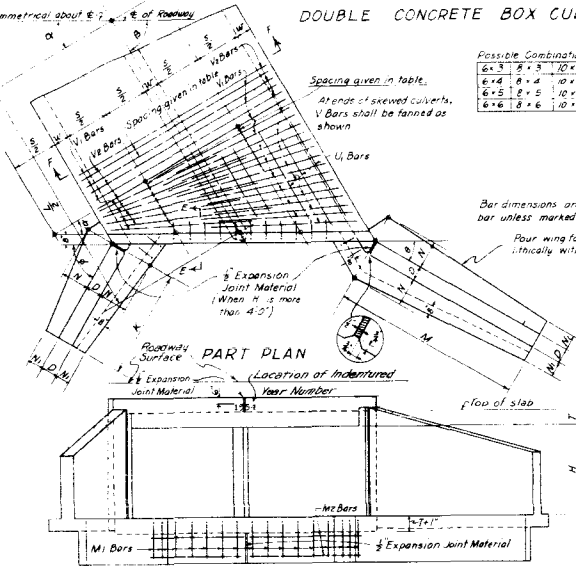

Quantities for one culvert shall be quantity for one lin. ft. of box times L plus quantity for two head walls plus quantities for four wings.

Quantities for one culvert shall be quantity for one lin. ft. of box times L plus quantity for two head walls plus quantities for four wings.

Quantities for one culvert shall be quantity for one lin. ft. of box times L plus quantity for two head walls plus quantities for four wings.

Quantities for one culvert shall be quantity for one lin. ft. of box times L plus quantity for two head walls plus quantities for four wings.



DEPARTMENT OF HIGHWAYS
STATE OF COLORADO
SINGLE AND DOUBLE
CONCRETE BOX CULVERTS
(FOR SIZES SEE TABLE OF POSSIBLE COMBINATIONS)

Designed by: WWD Approved by: J. J. [Signature]
Made by: WWD Bridge Engineer
Checked by: T.J.M. Date: July 1, 1965


FED. ROAD DIST. NO.	DIVISION	PROJ. NO.	SHEET NO.	TOTAL SHEETS
9	COLD	FO17-3(12)	6	

S.W. 4 SEC. 25
T.9S. R.56W.

AS CONSTRUCTED
REVISED DATE **DEC 4 1967**

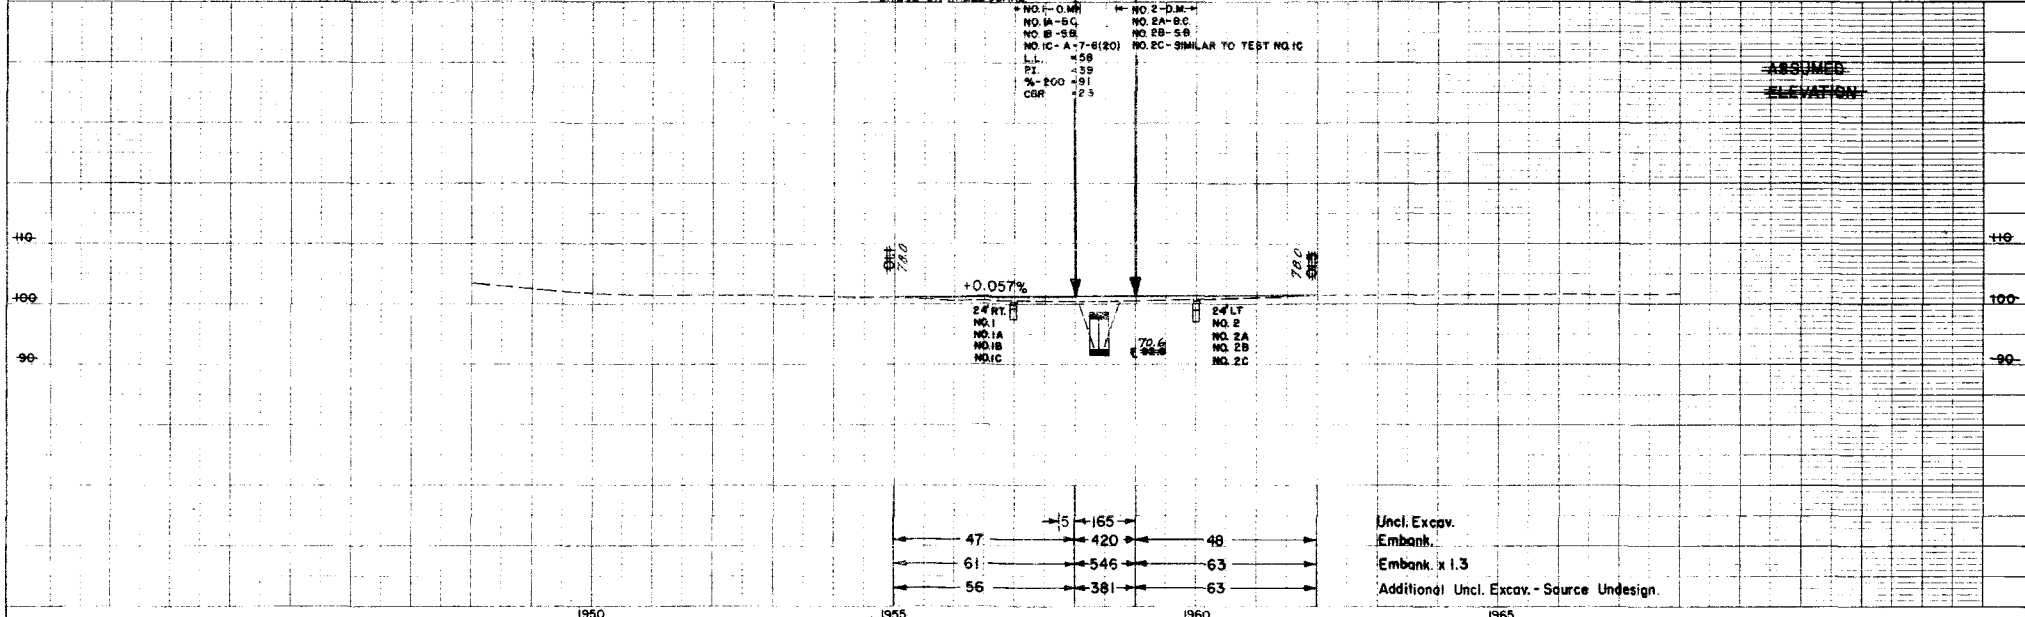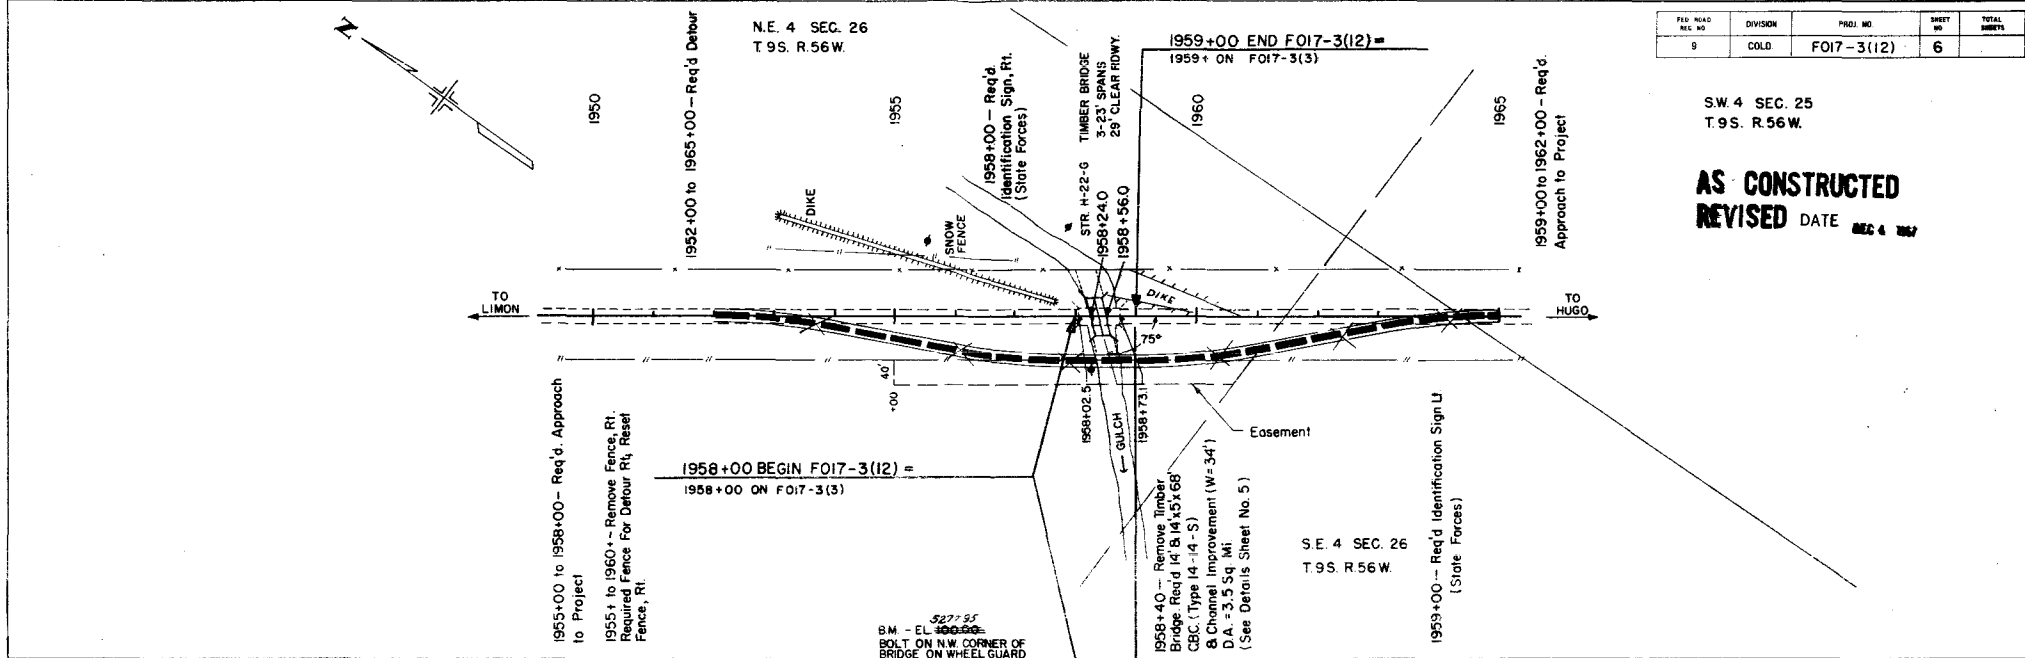

NO. F-0-MH	NO. 2-D.M.
NO. M-5-C	NO. 2A-B-C
NO. B-5-B	NO. 2B-5-B
NO. IC-A-7-6(20)	NO. 2C-SIMILAR TO TEST NO. IC
L.L. = 59	
P.T. = 59	
2+100 = 57	
CBR = 23	

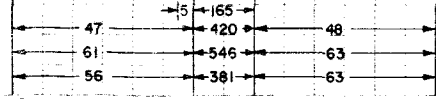

Uncl. Excav.
Embank. x 1.3
Additional Uncl. Excav. - Source Undesign.


STANDARD M-206-A

(JULY 1, 1965)
(SHEET 1 OF 2 SHEETS)


FED. ROAD REGION NO.	DIVISION	PROJECT NO.	SHEET NO.
8	COLO.		

REVISION			
(R-1)	10-20-65	ADDED PIER VIEW	M.R.H.
(R-2)	12-7-66	STR. EXCOV.	M.R.H.
(R-3)	4-25-66	Class 2 Backfill (Trench)	M.R.H.
(R-4)	3-17-67	Conduit, Underdrn, Box	M.R.H.


CONCRETE BOX CULVERTS & WINGWALLS

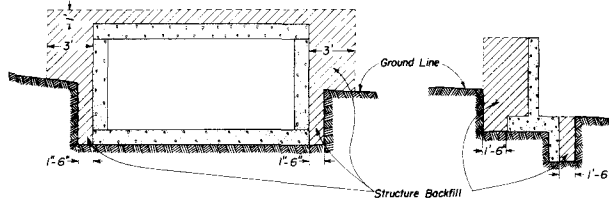

CIRCULAR CONDUIT

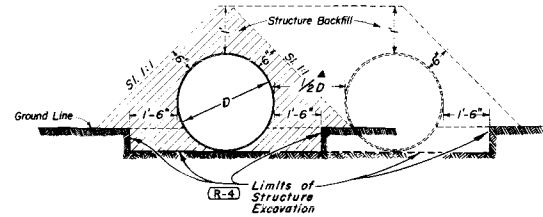


SIPHONS OR CONDUIT IN TRENCH

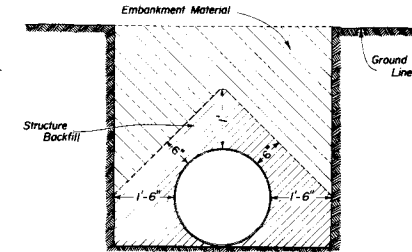


PIERS, ABUTMENTS, RETAINING WALLS ETC.

All material that is to be compacted shall be placed in horizontal layers not more than 6" inches in depth and compacted before the next layer is placed. For Arches, Rigid Frames and Box Culverts the fill shall be tamped up uniformly on both sides of the center of structure to avoid stresses in the structure caused by unsymmetrical loading.

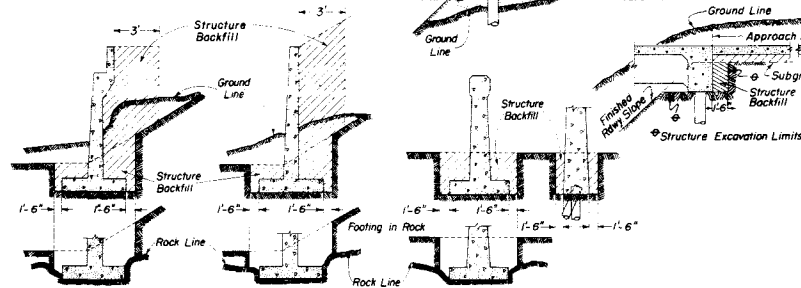

ELLIPTICAL OR ARCH CONDUIT

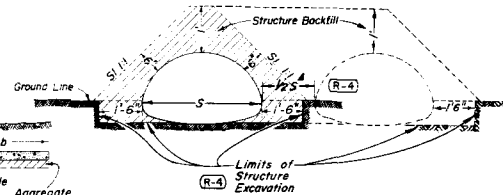

(R-4) NOTES:

When two or more conduits are laid side by side they shall be spaced so that adjacent sides of pipe shall be $\frac{1}{2}$ the Diameter or Span or 3 feet apart whichever is less. Minimum spacing shall not be less than 1 foot. For additional culvert installation details see M Standards for metal, concrete, or structural plate pipe culverts.

(R-4)

GENERAL NOTES

All work shall be done according to the Standard Specifications applicable to the Project.


Where the roadway cross section is in fill, excavation for concrete footings (except those in rock or those on piles) and for box culverts shall be done according to the following:

Embankment shall be built up and compacted to a point one foot above the flowline of the box or the top of the footing. The trench shall then be excavated to accommodate construction of the box or footing.

Excavation and backfill patterns different from those indicated on these sheets will be shown elsewhere on the plans.


(R-4) Excavation for structure installation shall be classified as "Structure Excavation" unless otherwise shown on plans.

HEADWALLS AND END OF CULVERTS

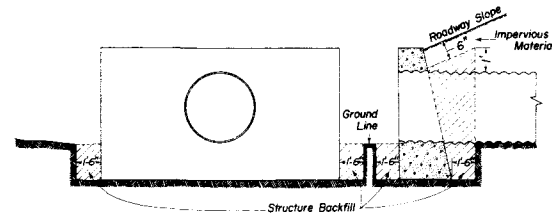


(R-1)

DROP INLETS, DIVISION BOXES, INTERCEPTING HEADWALLS, ETC.

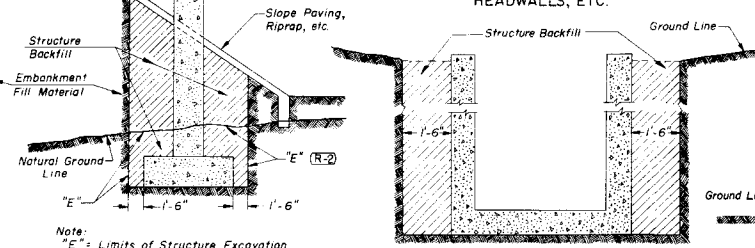

TRENCH FOR PIPE UNDERDRAIN

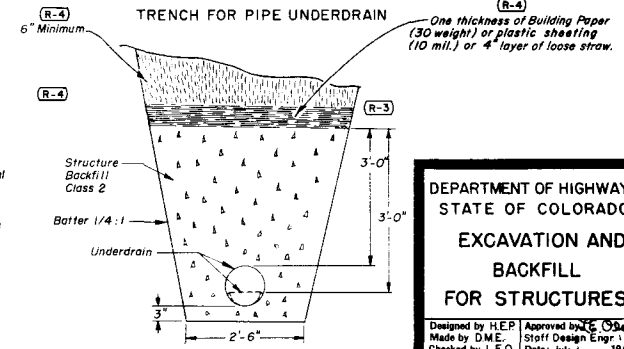

DEPARTMENT OF HIGHWAYS
STATE OF COLORADO
EXCAVATION AND
BACKFILL
FOR STRUCTURES

Designed by H.E.P. | Approved by E.C. O'Brien
Made by D.M.E. | Staff Design Engr.
Checked by L.E.O. | Date: July 1, 1965


STANDARD M-206-A

(SHEET 2)
(JULY 1, 1965)


FEDERAL ROAD REGION NO.	DISTRICT	PROJ. NO.	SHEET NO.	TOTAL SHEETS
9	COLORADO			

REVISIONS:	
(R-1)	3-17-67 I. D. on Pipe Culvert Span or D.M.R.H.


STRUCTURE EXCAVATION MEASUREMENT FOR PIPE CULVERTS

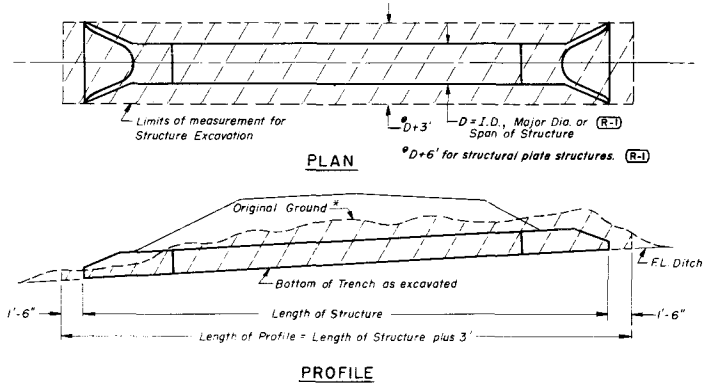


STRUCTURE EXCAVATION MEASUREMENT FOR CONCRETE BOX CULVERTS

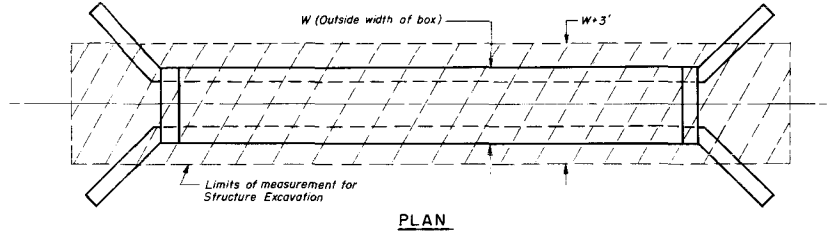



Without Channel Change or Channel Improvement

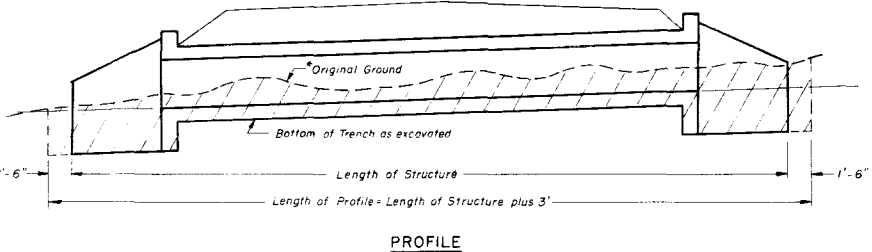

With Channel Change or Channel Improvement

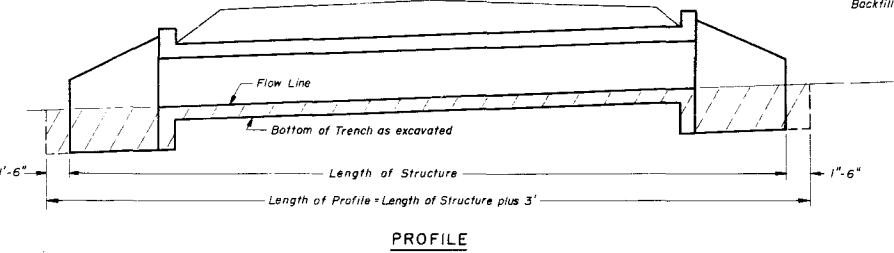

STRUCTURE EXCAVATION MEASUREMENT FOR DIVERSION OR DIVISION BOXES

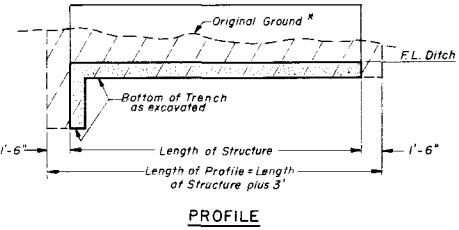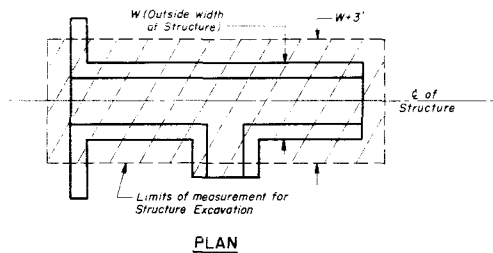

* Along ϕ of Structure

Areas to be used for Structure Excavation computations.

NOTE:
See Sheet 1 for General Notes and Backfilling Details.

DEPARTMENT OF HIGHWAYS
STATE OF COLORADO

EXCAVATION AND BACKFILL FOR STRUCTURES

Designed by: M.R.H. Approved by: S.P. (L.L.W.)
Made by: H.P.B. Staff Design Dept.
Checked by: Date July 1, 1965

STANDARD M-500-A

(JULY 1, 1965)

FED. ROAD DIST. NO.	DIVISION	PROJECT NO.	SHEET NO.
8	COLO.		

1 2 3 4 5 6 7 8 9 0.

A B C D E F G H I J K L


M N O P Q R S T U V W

a f g l J 14 K 11 9 5 0


abcdefghijklmnopqrstuvwxyz

Scale in inches
0 1 2 3


SECTION

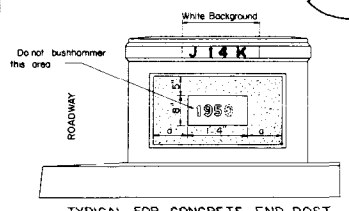


TYPICAL FOR CONCRETE END POST

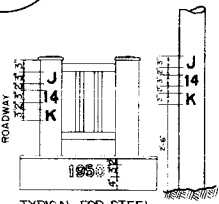

TYPICAL FOR STEEL HANDRAIL END POST

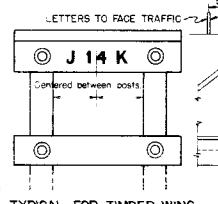

TYPICAL FOR TIMBER WING HANDRAIL

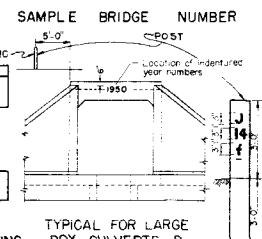

TYPICAL FOR LARGE BOX CULVERTS & STRUCTURES WITHOUT END POSTS

GENERAL NOTES

ALL WORK SHALL BE DONE IN ACCORDANCE WITH THE STANDARD SPECIFICATIONS APPLICABLE TO THE PROJECT. THE SIZE, SHAPE AND SPACING OF THE LETTERS AND FIGURES SHALL BE IN ACCORDANCE WITH THE FULL SIZE SHOWN ON THIS SHEET. ADDITIONAL COPIES OF THIS FULL SIZE SHEET CAN BE OBTAINED FROM THE DEPARTMENT WITHOUT CHARGE.

THE YEAR NUMBERS ARE NECESSARY IN CONCRETE TO BE SHOWN INTO THE MOLD OF THE ENDPOST ON THE RIGHT HAND SIDE OF EACH BRIDGE END AND INTO THE FACE OF THE DOWNSTREAM HEADWALL OF CULVERTS AS SHOWN ON PLAN DETAILS. NUMBERS TO BE MADE OF WOOD, METAL OR OTHER SUITABLE MATERIAL AND ATTACHED TO THE FORMS BEFORE CONCRETE IS POURED. THE YEAR NUMBER OF EACH STRUCTURE SHALL CORRESPOND WITH THE YEAR IN WHICH THE CONCRETE IS MOULDED.

THE STRUCTURE NUMBER SHALL BE STENCILED ON THE RIGHT HAND SIDE OF EACH BRIDGE END AS SHOWN ON THIS STANDARD AND AS SPECIFIED WHERE THE STRUCTURE HAS NO ENDPOSTS THE NUMBER SHALL BE PLACED ON A POST ON THE RIGHT HAND SIDE OF THE ROAD AS SHOWN. FOR SIGN THE NUMBER SHALL BE PLACED ON SIGN POSTS ON THE RIGHT HAND SIDE OF THE ROADWAY.

THE CORRECT NUMBER FOR EACH BRIDGE OR SIGN SHOWN ON THE PLAN SHALL BE UPPER CASE LETTERS. THE NUMBERS FOR MINOR STRUCTURES OF 15 TO 20 FEET CLEAR SPAN SHALL BE LOWER CASE LETTERS. LETTERS FOR BRIDGES SHALL BE LOWER CASE LETTERS. THE NUMBERS FOR MAJOR STRUCTURES OF OVER 20 FEET CLEAR SPAN SHALL BE UPPER CASE LETTERS. THE NUMBERS FOR MINOR STRUCTURES OF 15 TO 20 FEET CLEAR SPAN SHALL BE LOWER CASE LETTERS. LETTERS FOR BRIDGES SHALL BE LOWER CASE LETTERS. THE NUMBERS FOR MAJOR STRUCTURES OF OVER 20 FEET CLEAR SPAN SHALL BE UPPER CASE LETTERS.

A PROPER WHITE BACKGROUND RECTANGULAR IN SHAPE AND EXTENDING THREE INCHES BEYOND THE LIMITS OF THE NUMBER SHALL BE THOROUGHLY DRIED, CLEANED AND PROPERLY SIZED ON TIMBER HANDRAILS THE WHITE PRINT USED ON THE BRIDGE WILL BE SATISFACTORY.

AS SOON AS THE WHITE BACKGROUND HAS DRIED SUFFICIENTLY THE CORRECT STRUCTURE NUMBER SHALL BE CAREFULLY STENCILED WITH EXTERIOR BLACK PAINT AS SPECIFIED IN SECTION 708 - PAINTS, OR AN ACCEPTABLE EQUIVALENT. THE SPACES OF THE STENCILED LETTERS AND FIGURES SHALL BE CAREFULLY FILLED IN BY HAND TO MAKE SOLID BODIES.

SUFFICIENT TIME BETWEEN SUCCESSIVE COATS SHALL BE ALLOWED TO PERMIT THORO DRYING.

THE COST OF PAINTING OF STRUCTURE NUMBERS AND PLACING POSTS FOR STRUCTURE NUMBERS SHALL BE CONSIDERED SUBSIDIARY WORK AND SHALL BE INCLUDED IN THE ORIGINAL CONTRACT ITEMS AND WILL NOT PAID FOR AS STRUCTURE ITEMS.

THE LENGTH OF SPAN OF STRUCTURE SHALL BE MEASURED ALONG CENTER LINE OF ROADWAY. IN CASE OF DOUBLE OR MULTIPLE BOX CULVERTS THE CENTER WALL OR WALLS SHALL BE CONSIDERED AND CLEAR SPAN MEASURED FROM INSIDE OF END WALLS.

IN ADDITION TO THE REQUIREMENTS STATED ABOVE, STRUCTURE NUMBERS FOR HIGHWAYS PASSING UNDER CROSSROADS ARE TO BE PLACED AS FOLLOWS:

(A) FOR STRUCTURES OF 3 OR MORE SPANS, THE STRUCTURE NUMBER SHALL BE STENCILED, FACING TRAFFIC, ON THE OUTSIDE FACE OF THE 2ND COLUMN OF THE RIGHT-HAND ROW.

(B) FOR 2-SPAN STRUCTURES, THE STRUCTURE NUMBER SHALL BE STENCILED, FACING TRAFFIC, ON THE OUTSIDE FACE OF EACH END COLUMN IN THE CENTER PILE.

SAMPLE YEAR NUMBER

REVISIONS

DEPARTMENT OF HIGHWAYS
STATE OF COLORADO

LETTERS AND FIGURES
FOR
STRUCTURE NUMBERS

Designed by _____
Made by _____
Checked by _____

Approved by _____
Bridge Engineer
Date: July 1, 1965


STRUCTURE NO. _____

ICING LAIN

STANDARD M-601-C

(SHEET 1 OF 2 SHEETS)
(JULY 1, 1965)

FED. ROAD RES. NO.	DIVISION	PROJECT. NO.	SHEET NO.
9	COLO.		

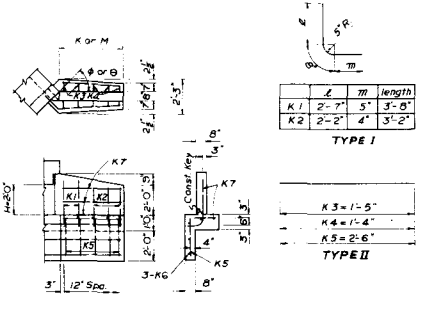

TYPE I

ℓ	m	length
K1	2'-7"	5'-3"-0"
K2	2'-2"	4'-3"-2"


TYPE II

K3	1'-5"
K4	1'-4"
K5	2'-6"

BAR LIST & QUANTITIES FOR ONE WING WHEN H=2'-0"

When θ or φ equals	Number of bars required						Length of bars		Quantities for One Wing	
	K1 Type I	K2 Type I	K3 Type II	K4 Type II	K5 Type II	3-K6 Type II	4-K7 Type II	Concrete Cu.Yd.	Steel Lb.	
22°30'	4	4	4	4	4	9'-10"	7'-8"	1.47	80	
30°	3	3	3	3	3	7'-4"	5'-6"	1.10	59	
37°30'	3	2	3	2	5	6'-7"	4'-8"	0.92	50	
45°	2	2	2	2	4	5'-2"	3'-11"	0.78	45	
52°30'	2	2	2	2	4	5'-1"	3'-5"	0.69	39	
60°	2	2	2	2	4	4'-6"	3'-2"	0.64	37	
67°30'	2	2	2	2	4	4'-0"	2'-11"	0.60	36	

WING DETAIL WHEN H=2'-0"

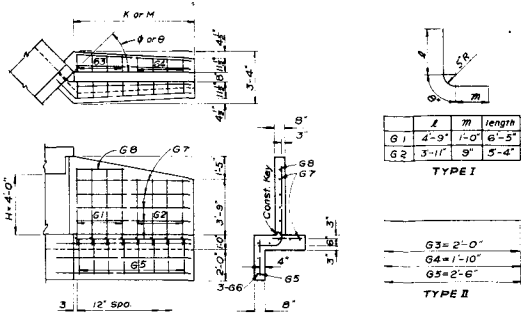

TYPE I

ℓ	m	length
G1	4'-9"	1'-0"
G2	3'-11"	9"


TYPE II

G3	2'-0"
G4	1'-10"
G5	2'-6"

BAR LIST & QUANTITIES FOR ONE WING WHEN H=4'-0"

When θ or φ equals	Number of bars required						Length of bars		Quantities for One Wing	
	G1 Type I	G2 Type I	G3 Type II	G4 Type II	G5 Type II	3-G6 Type II	4-G7 Type II	1-G8 Type II	Concrete Cu.Yd.	Steel Lb.
22°30'	6	9	6	3	15	17'-4"	14'-5"	5'-2"	3.97	219
30°	5	7	5	7	12	13'-2"	10'-11"	4'-2"	3.03	170
37°30'	4	6	4	6	10	10'-10"	8'-11"	3'-2"	2.49	147
45°	4	4	4	4	8	9'-2"	7'-8"	3'-2"	2.15	118
52°30'	3	5	3	5	8	8'-0"	6'-11"	2'-2"	1.96	112
60°	3	4	3	4	7	7'-10"	6'-2"	2'-2"	1.75	98
67°30'	3	3	3	3	6	7'-0"	5'-6"	2'-2"	1.61	88

WING DETAIL WHEN H=4'-0"

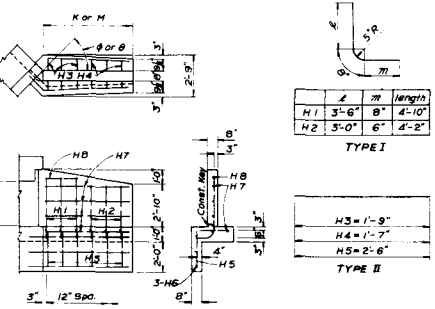

TYPE I

ℓ	m	length
H1	3'-0"	8'-4"-10"
H2	3'-0"	6'-4"-2"


TYPE II

H3	1'-9"
H4	1'-7"
H5	2'-6"

BAR LIST & QUANTITIES FOR ONE WING WHEN H=3'-0"

When θ or φ equals	Number of bars required					Length of bars		Quantities for One Wing		
	H1 Type I	H2 Type I	H3 Type II	H4 Type II	H5 Type II	3-H6 Type II	4-H7 Type II	Concrete Cu.Yd.	Steel Lb.	
22°30'	6	5	6	5	11	13'-2"	10'-8"	5'-2"	2.47	131
30°	5	4	5	4	9	10'-2"	8'-2"	4'-2"	1.91	104
37°30'	4	3	4	3	7	8'-4"	6'-8"	3'-2"	1.57	82
45°	3	3	3	3	6	7'-1"	5'-8"	2'-2"	1.35	70
52°30'	3	3	3	3	6	7'-0"	5'-2"	2'-2"	1.23	68
60°	3	2	3	2	5	6'-2"	4'-8"	2'-2"	1.12	59
67°30'	3	2	3	2	5	5'-4"	4'-2"	2'-2"	1.01	56

WING DETAIL WHEN H=3'-0"

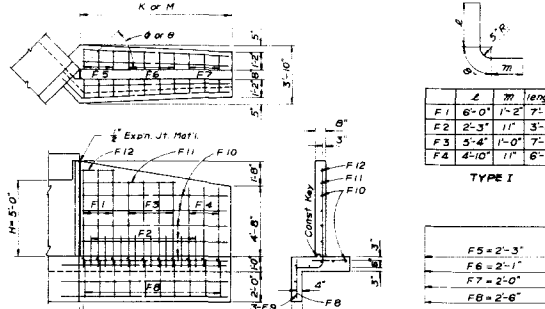

TYPE I

ℓ	m	length
F1	6'-0"	1'-2"
F2	2'-3"	11'
F3	5'-4"	1'-0"
F4	4'-10"	11'

TYPE II

F5	2'-3"
F6	2'-1"
F7	2'-0"
F8	2'-6"

BAR LIST & QUANTITIES FOR ONE WING WHEN H=5'-0"


When θ or φ equals	Number of bars required											Length of bars		Quantities for One Wing	
	F1 Type I	F2 Type I	F3 Type I	F4 Type II	F5 Type II	F6 Type II	F7 Type II	F8 Type II	3-F9 Type II	4-F10 Type II	1-F11 Type II	1-F12 Type II	Concrete Cu.Yd.	Steel Lb.	
22°30'	6	14	7	5	6	7	5	18	20	11	17'-8"	12'-2"	5'-2"	5.61	328
30°	5	11	5	4	5	5	4	14	16	2	13'-8"	9'-2"	4'-2"	4.36	254
37°30'	4	9	4	4	4	4	4	12	13	3	11'-3"	11'-2"	7'-2"	3.58	211
45°	3	8	4	3	3	3	3	10	11	6	9'-0"	6'-2"	2'-2"	3.11	180
52°30'	3	7	3	3	3	3	3	9	10	8	8'-5"	5'-2"	2'-2"	2.72	160
60°	3	6	2	3	3	2	3	8	9	6	7'-8"	4'-2"	2'-2"	2.49	145
67°30'	3	6	3	2	3	2	3	8	9	7	7'-2"	5'-2"	2'-2"	2.33	140

WING DETAIL WHEN H=5'-0"

TABLE SHOWING VALUES OF K & M WHEN β & θ ARE GIVEN

β	α	φ	θ	H=2'-0"		H=3'-0"		H=4'-0"		H=5'-0"		H=6'-0"	
				K	M	K	M	K	M	K	M	K	M
45°	45°	67°30'	22°30'	3'-3"	8'-0"	4'-6"	11'-0"	6'-0"	14'-9"	18'-0"	8'-9"	21'-0"	
60°	30°	60°	30°	3'-6"	6'-0"	5'-0"	8'-6"	6'-8"	11'-3"	8'-0"	14'-0"	8'-3"	16'-0"
75°	15°	52°30'	37°30'	3'-9"	5'-0"	5'-6"	7'-0"	7'-3"	9'-3"	8'-9"	11'-6"	10'-0"	13'-3"
90°	0°	45°	45°	4'-3"	4'-3"	6'-0"	6'-0"	8'-0"	8'-0"	10'-0"	10'-0"	11'-6"	11'-6"
105°	15°	37°30'	52°30'	5'-0"	3'-9"	7'-0"	5'-6"	5'-6"	7'-3"	11'-6"	8'-9"	13'-3"	10'-0"
120°	30°	30°	60°	6'-0"	3'-6"	8'-6"	5'-0"	11'-3"	6'-6"	14'-0"	8'-0"	16'-0"	9'-3"
135°	45°	22°30'	67°30'	8'-0"	3'-3"	11'-0"	4'-6"	14'-9"	6'-0"	18'-0"	7'-6"	21'-0"	8'-9"

B equals the angle between φ of culvert & φ of roadway, α equals the angle between φ of culvert and a normal to φ of roadway & θ are angles between the wingwall and a line parallel with the φ of roadway.
EXAMPLE FOR USING THE ABOVE TABLE: Suppose a stream makes an angle of β=65° with the φ of roadway, then from the table, select the nearest angle, β=60° then α, φ, θ equal 30°, 60° & 30° respectively. If the desired height "H" of culvert is 6'-0", then K & M will be 9'-3" and 16'-0". Locate the WING DETAIL WHEN H=6'-0" on this sheet.

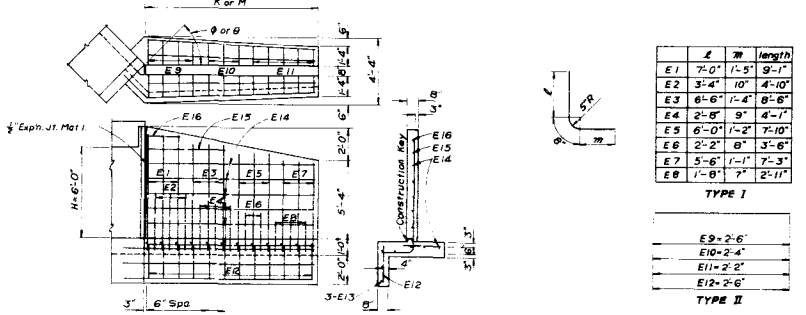

TYPE I

ℓ	m	length
E1	7'-0"	1'-5"
E2	2'-4"	10'
E3	6'-6"	1'-4"
E4	2'-8"	9'
E5	6'-0"	1'-2"
E6	2'-2"	8'
E7	5'-6"	1'-1"
E8	1'-8"	7'

TYPE II

E9	2'-6"
E10	2'-4"
E11	2'-2"
E12	2'-6"

BAR LIST & QUANTITIES FOR ONE WING WHEN H=6'-0"

When θ or φ equals	Number of bars required												Length of bars				Quantities for One Wing	
	E1 Type I	E2 Type I	E3 Type I	E4 Type I	E5 Type I	E6 Type I	E7 Type I	E8 Type I	E9 Type II	E10 Type II	E11 Type II	E12 Type II	3-E13 Type II	4-E14 Type II	1-E15 Type II	1-E16 Type II	Concrete Cu.Yd.	Steel Lb.
22°30'	6	5	5	5	5	5	5	6	7	8	21	24	33	20'-8"	10'-2"	5'-2"	7.30	430
30°	4	4	4	4	4	4	4	5	5	6	16	18	5	15'-8"	7'-2"	3'-2"	5.58	328
37°30'	4	3	3	3	3	3	3	4	4	5	14	15	3	12'-11"	6'-2"	3'-2"	4.60	278
45°	3	3	3	3	3	3	3	4	3	5	12	13	2	12'-2"	5'-2"	2'-2"	3.99	240
52°30'	3	2	2	2	2	2	2	3	4	3	10	12	1	12'-1"	4'-2"	2'-2"	3.47	202
60°	3	2	2	2	2	2	2	3	3	3	10	10	1	10'-10"	4'-11"	2'-2"	3.21	184
67°30'	3	2	2	2	2	2	2	3	3	3	9	9	1	9'-11"	4'-5"	2'-2"	3.04	180

WING DETAIL WHEN H=6'-0"

LOADING DATA INTERSTATE ALTERNATE
AASHTO HS 20 (44)
DEAD LOAD CONCRETE ISOPOUNDS PER CUBIC FOOT
EARTH 84 POUNDS PER CUBIC FOOT

DESIGNING DATA
AASHTO 1963 SURFACE STRESS EXCEPT AS NOTED
Reinforcing Steel fs 20000 lbs. per sq. in.
Structural Steel fs 18000 lbs. per sq. in.
fc 1200 lbs. per sq. in.
n 10

REVISIONS		
(R1)	7-17-67	General Note

GENERAL NOTES

ALL WORK SHALL BE DONE ACCORDING TO THE STANDARD SPECIFICATIONS APPLICABLE TO THE PROJECT.

ALL CONCRETE SHALL BE CLASS "A".

ALL WING SURFACES TO RECEIVE CLASS "A" FINISH.

WING FOOTINGS & FLOOR OF BOX SHALL BE POURED MONOLITHICALLY.

FOOTINGS IN ROCK SHALL BE POURED OUT TO ROCK AND NOT FORMED.

SOUNDING AND DEPTH OF FOOTING SHOWN ARE IN ACCORDANCE WITH THE BEST AVAILABLE DATA AND WHEN DIFFERENT CONDITIONS ARE ENCOUNTERED THE BRIDGE ENGINEER WILL INSPECT AND DETERMINE IF REDESIGN IS NECESSARY.

ALL REINFORCING STEEL SHALL BE INTERMEDIATE GRADE STEEL OF A DEFORMED TYPE. EACH BAR SHALL BE TAGGED WITH THE NUMBER DESIGNATION AND THE STATION NUMBER OF THE PROJECT. SECONDARY BARS WHEN SPLICED SHALL LAP UP DIAMETERS OF THE BAR. DIMENSIONS FOR REINFORCING STEEL NOT SHOWN AS CLEAR SHALL BE TO THE CENTER LINE OF THE BAR. OUT TO OUT DIMENSIONS SHALL BE USED ON BAR BENDING DETAILS.

SUPPORTING SOILS FOR ALL CULVERTS MUST BE COMPOSED OF FIRM AND UNIFORM MATERIAL THROUGHOUT. HORIZONTAL CONSTRUCTION KEYS ARE NOT REQUIRED WHEN FOOTING AND WALL ARE POURED MONOLITHICALLY. ALL CONSTRUCTION KEYS SHOWN BETWEEN FOOTINGS AND WALLS ARE 3" X 3".

STEEL WEIGHTS INCLUDE 1/4% FOR OVERTURN.

EXPANSION JOINT MATERIAL IS TO BE INCLUDED IN THE PRICE OF CLASS "A" CONCRETE AND SHALL CONFORM TO AASHTO SPECIFICATION M-153-52 TYPE II.

FOR CULVERTS REQUIRED AND GOVERNING DIMENSIONS SEE "LIST OF STRUCTURES".

WHEN EXCAVATING FOR FOOTINGS THE FINAL SURFACE ELEVATION SHALL BE UNDISTURBED NATURAL OR COMPACTED SOIL.

DEPARTMENT OF HIGHWAYS
STATE OF COLORADO
WINGWALLS FOR
CONCRETE BOX CULVERTS
4:1 SIDE SLOPES

Across Sta. _____
Near _____ Sec. _____ T. _____ R. _____
Designed by L.O.P. Approved by _____
Made by J.M.H.E.L.S. Bridge Engineer
Checked by A.T.P. Date: July 1, 1965

STANDARD M-601-C


(SHEET 2)
(JULY 1, 1965)

FED. ROAD REG. NO.	DIVISION	PROJECT NO.	SHEET NO.
9	COLO.		

TABLE SHOWING VALUES OF K & M WHEN β & θ ARE GIVEN

β	α	ϕ	θ	H=7'-0"		H=8'-0"		H=9'-0"		H=10'-0"	
				K	M	K	M	K	M	K	M
45°	45°	67°30'	22°30'	10'-0"	23'-9"	11'-0"	26'-9"	12'-3"	29'-6"	13'-6"	32'-3"
60°	30°	60°	30°	10'-6"	18'-3"	11'-9"	20'-6"	13'-0"	23'-9"	14'-3"	24'-9"
75°	15°	52°30'	37°30'	11'-6"	15'-0"	16'-9"	16'-9"	14'-3"	18'-6"	15'-9"	20'-3"
90°	0°	45°	45°	13'-0"	13'-0"	14'-6"	16'-0"	16'-0"	17'-6"	17'-6"	17'-6"
105°	15°	37°30'	52°30'	15'-0"	11'-6"	16'-9"	13'-0"	18'-6"	14'-3"	20'-3"	15'-9"
120°	30°	30°	60°	18'-3"	10'-6"	20'-6"	11'-9"	23'-9"	13'-0"	24'-9"	14'-3"
135°	45°	22°30'	67°30'	23'-9"	10'-0"	26'-9"	11'-0"	29'-6"	12'-3"	32'-3"	13'-6"

β equals the angle between ϕ of culvert and ϵ of roadway, α equals the angle between ϕ of culvert and a normal to ϵ of roadway, ϕ and θ are angles between the wingwall and a line parallel with the ϵ of roadway.
EXAMPLE FOR USING THE ABOVE TABLE: Suppose a stream flows at an angle of 8-65 with ϵ of roadway, then, from the table, select the nearest angle $\beta=60'$, then α , ϵ equal 30°/60°/30° respectively. If the desired height "h" of culvert is 8'-0", then "K" & "M" will be 11'-9" & 20'-6". Locate the WING DETAIL WHEN H=8'-0" on this sheet.

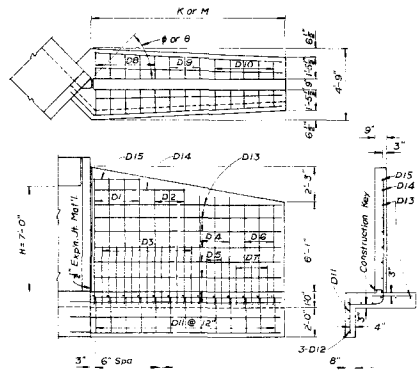

ϵ	M	Length
D1	7'-11"	10'-3"
D2	7'-4"	9'-6"
D3	3'-4"	5'-0"
D4	6'-9"	8'-0"
D5	2'-8"	4'-2"
D6	6'-3"	6'-2"
D7	2'-2"	3'-7"


TYPE I

DB=2'-8"
D9=2'-6"
D10=2'-4"
D11=2'-6"

TYPE II

When θ or ϕ equals	Number of bars required										Length of bars					Quantities for One Wing Concrete Steel Cu.Yd. Lb.	
	D1	D2	D3	D4	D5	D6	D7	D8	D9	D10	D11	3-D12	1-D13	1-D14	1-D15		
22°30'	7	6	12	6	6	5	5	8	7	9	24	27-4	23-5	12-2	6-2	9.62	592
30°	5	5	8	5	5	4	4	6	6	7	19	20-11	17-11	9-2	4-2	7.59	457
37°30'	4	4	8	4	3	3	3	5	5	5	15	17-2	14-6	7-2	3-2	6.07	368
45°	4	3	7	3	2	3	3	5	3	5	13	14-10	12-8	6-2	3-2	5.26	321
52°30'	3	3	6	3	2	3	3	4	4	4	12	13-10	11-2	5-2	2-2	4.66	287
60°	3	3	5	3	3	2	2	4	3	4	11	12-3	10-2	5-2	2-2	4.25	262
67°30'	3	3	5	2	3	2	2	4	3	3	10	11-4	9-8	5-2	2-2	4.05	245

BAR LIST & QUANTITIES FOR ONE WING WHEN H=7'-0"

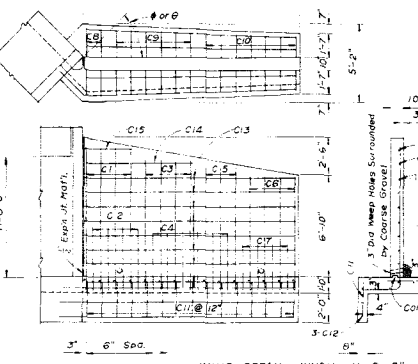

ϵ	M	Length
C1	8'-10"	11'-5"
C2	3'-0"	5'-6"
C3	9'-3"	10'-8"
C4	3'-4"	5'-1"
C5	7'-8"	10'-0"
C6	7'-0"	9'-2"
C7	2'-7"	4'-2"


TYPE I

CB=3'-0"
C9=2'-8"
C10=2'-6"
C11=2'-6"

TYPE II

When θ or ϕ equals	Number of bars required										Length of bars					Quantities for One Wing Concrete Steel Cu.Yd. Lb.
	A1	A2	A3	A4	A5	A6	A7	A8	A9	A10	3-A11	1-A12	1-A13	1-A14		
22°30'	9	16	0	8	16	8	10	12	11	33	36-10	31-0	16-2	8-2	19.74	1224
30°	7	12	6	6	12	6	7	10	8	25	29-2	24-5	12-2	6-2	15.14	930
37°30'	6	10	5	5	10	5	6	8	7	21	23-7	19-1	10-2	5-2	12.39	775
45°	5	9	4	4	8	4	5	7	6	18	19-9	17-2	8-2	4-2	10.71	665
52°30'	5	8	3	4	7	4	5	6	5	16	18-9	15-5	7-2	4-2	9.63	597
60°	4	7	4	3	7	4	4	5	5	15	16-6	13-1	7-2	3-2	8.72	543
67°30'	4	7	3	4	6	3	4	5	5	14	15-2	13-0	6-2	3-2	8.26	515

BAR LIST & QUANTITIES FOR ONE WING WHEN H=10'-0"

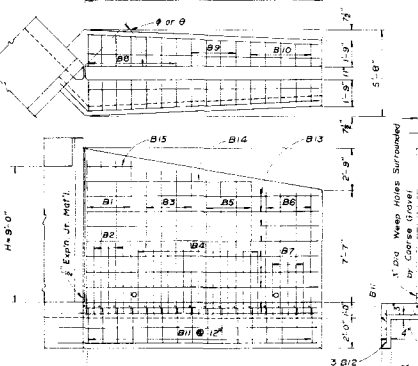

ϵ	M	Length
B1	9'-10"	12'-10"
B2	4'-2"	6'-2"
B3	9'-2"	11'-11"
B4	3'-11"	5'-10"
B5	8'-5"	10'-11"
B6	7'-9"	10'-2"
B7	3'-11"	4'-0"

TYPE I

B8=3'-5"
B9=2'-9"
B10=2'-7"
B11=2'-6"


TYPE II

When θ or ϕ equals	Number of bars required										Length of bars					Quantities for One Wing Concrete Steel Cu.Yd. Lb.
	B1	B2	B3	B4	B5	B6	B7	B8	B9	B10	3-B11	1-B12	1-B13	1-B14		
22°30'	8	7	6	2	6	7	7	5	10	27	30-8	26-5	13-2	7-2	22.53	1422
30°	6	5	5	10	4	6	4	4	7	21	23-7	19-1	10-2	5-2	16.47	1020
37°30'	5	4	4	8	4	4	4	3	6	17	19-5	16-5	8-2	4-2	14.84	927
45°	4	4	4	6	3	4	4	2	5	15	16-6	14-2	7-2	3-2	13.79	874
52°30'	4	3	3	6	3	3	3	2	5	13	15-6	12-8	6-2	4-2	12.49	774
60°	4	3	2	6	3	3	2	2	4	12	13-9	11-5	5-2	3-2	11.50	714
67°30'	3	3	3	5	2	3	2	2	4	11	12-5	10-8	5-2	2-2	10.55	675

BAR LIST & QUANTITIES FOR ONE WING WHEN H=8'-0"

When θ or ϕ equals	Number of bars required										Length of bars					Quantities for One Wing Concrete Steel Cu.Yd. Lb.
	B1	B2	B3	B4	B5	B6	B7	B8	B9	B10	3-B11	1-B12	1-B13	1-B14		
22°30'	7	6	8	16	5	7	7	5	10	30	33-9	29-2	12-2	6-2	15.93	1030
30°	5	5	7	13	6	6	5	10	7	24	27-0	23-5	11-2	4-2	12.82	742
37°30'	4	4	5	10	5	5	4	8	5	19	21-7	18-2	13-2	3-2	11.98	680
45°	4	3	4	9	4	4	3	7	4	16	18-2	15-8	11-2	3-2	10.83	653
52°30'	3	3	4	8	4	4	3	6	4	15	17-0	13-11	10-2	2-2	7.63	453
60°	3	3	4	7	3	3	2	6	3	14	15-1	12-8	9-2	2-2	7.01	406
67°30'	3	2	3	7	2	3	2	5	3	13	13-9	11-10	9-2	2-2	6.81	369

BAR LIST & QUANTITIES FOR ONE WING WHEN H=9'-0"

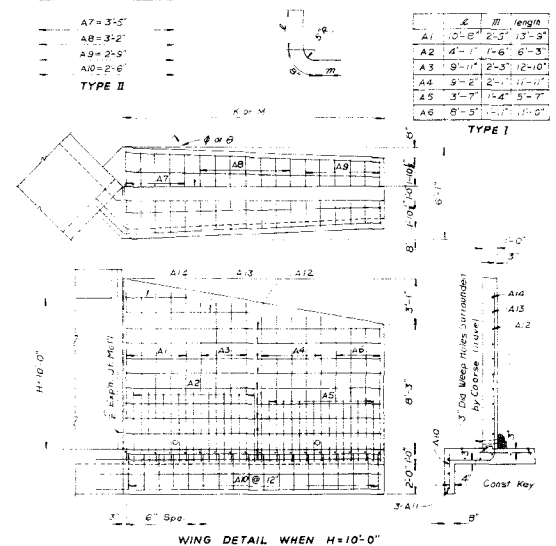

REVISIONS	
No.	Description

DEPARTMENT OF HIGHWAYS
STATE OF COLORADO

WINGWALLS FOR
CONCRETE BOX CULVERTS
4:1 SIDE SLOPES

Across: _____ Sta.: _____

Near: _____ Sec.: _____ T: _____ R: _____

Designed by: C.C.O. Approved by: _____
Made by: J.W.M.E.R.S. Bridge Engineer
Checked by: A.L.T.G.M. Date: July 1, 1965

STANDARD M-607-A


(SHEET 2)
(JULY 1, 1965)

FED. ROAD DIST. NO.	DIVISION	PROJECT NO.	SHEET NO.
9	COLO.		


REVISIONS

NO.	DESCRIPTION	BY
(R-1)	8-2-66 Vert Dims & Gen'l. Notes	M.R.H.
(R-2)	12-8-66 Vert Dims., Std. and Alternate	M.R.H.
(R-3)	2-6-67 Gate and General Notes	M.R.H.


BARBED WIRE GATE

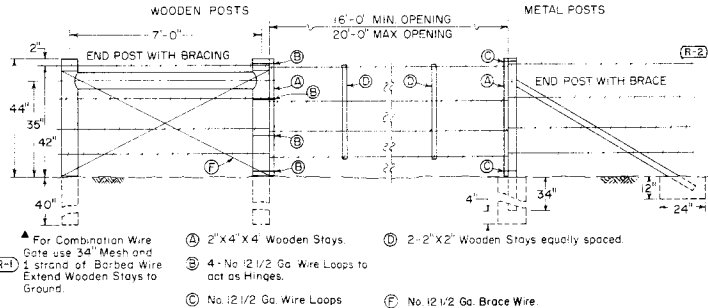

DRIVEWAY GATES

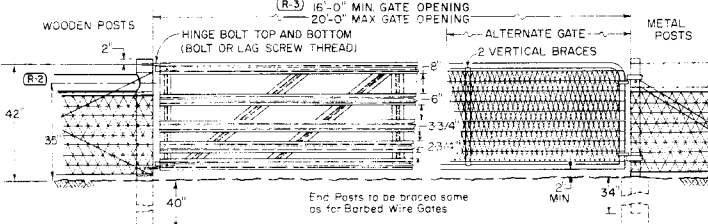


TWIN DRIVEWAY GATES

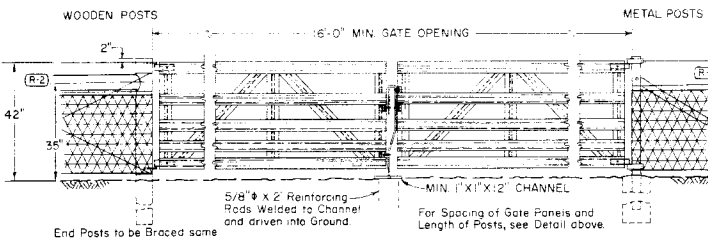


WALK GATE


ALTERNATE WALK GATE

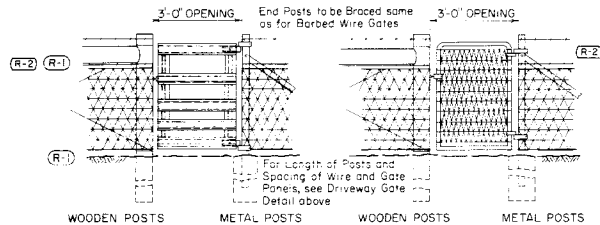


FENCE WIRE TIES

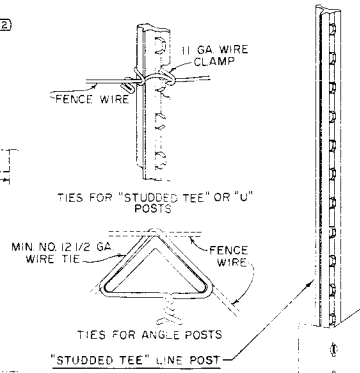

TYPICAL METAL POSTS

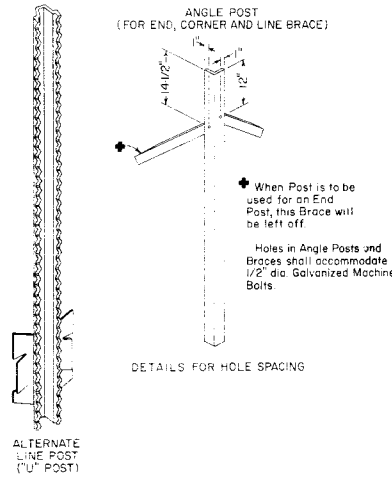

POST POINTING DETAILS

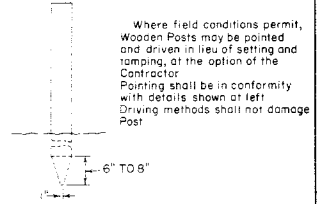

GENERAL NOTES

- All work shall be done in accordance with the Standard Specifications applicable to the Project.
- (R-1) At each location where an electric transmission, distribution or secondary line crosses a wood post fence the Contractor shall furnish and install a ground conforming to Section 9 of the National Electric Safety Code.
- (R-2) Dimensions shown for "Standard" and "Alternate" apply for both wooden and metal post fence.
- (R-3) Posts shall be pointed, double wrapped and tied off at end posts, angle posts and line brace posts. Fence to be continued past their restoration in like manner.
- Fence wire to be added on either road or field side of posts depending on local conditions, i.e. on curves the wire should be placed on the side of the post which would prevent tension on fence ties. This will also apply where wind drift, tumble weeds or other conditions would exert unusual pressure against the wire.
- WOOD POSTS:**
All line posts shall have a min. dia. of four (4) inches & be 6'-6" long. All end, corner, intersection and brace posts shall have a minimum diameter of five (5) inches and be 7'-0" long.
Fence wire will be stapled to wooden posts or tied to metal posts as shown marked on barbed wire or combination wire fence details. Staples shall be No. 9 wire min. or least 1/2" inches long & shall be galvanized.
- METAL POSTS:**
All posts and braces shall be of the types and weights shown or acceptable equivalents.
Posts to be provided in end, corner and gate posts as detailed.
- CORNER POSTS**
Type - 1 1/2" X 2 1/2" X 1/4" Structural Steel Angles.
Weight - 3.6 lbs./lin. ft. Min.
Length - 6'-6" Min.
No. of Braces - 2
- LINE POSTS:**
Type - "Studded Tee" or "U"
Weight - 1.28 lbs./lin. ft. Min. (without Anchor)
Length - 6'-6" Min.
Anchor - Securely fastened with bearing surface sufficient to resist movement of post. Weight - 0.57 lb/Min
- END POSTS**
Type - 2 1/2" X 2 1/2" X 1/4" Structural Steel Angles.
Weight - 3.6 lbs./lin. ft. Min.
Length - 6'-6" Min.
No. of Braces - 1
- BRACES (For Corner, End or Line Brace Posts)**
Type - 2" X 4" X 1/4" Structural Steel Angles.
Weight - 3.08 lbs./lin. ft. Min.
Length - Same as corner and end posts used.
- Posts shall meet requirements of Par. 4.5 of U.S. Dept. of Commerce Commercial Standard B84-S1. Acceptable material includes re-rolled railroad rails.

- ALTERNATES:**
END, CORNER AND LINE BRACE POSTS
Type - 2 1/2" Std. Galvanized Pipe.
Weight - 6.65 lbs./lin. ft. Min.
- BRACES**
Type - 1 3/8" O.D. Tubular Steel with 2 1/2" Brace Band, hinge Bolt and 1 3/8" I.D. Rail End; all Galvanized.
Weight - 1.6 lbs./lin. ft. Min.
Length - 6'-6" Min.

- BARBED WIRE**
Steel barbed wire shall conform to ASTM Designation A 121, 12 1/2 Gauge with Class 1 coating.
Aluminum barbed wire shall conform to ASTM Designation B 211, with alloy 5052-O for the line wire and alloy 5052-H38 for the bars.
- 4" X 4" WIRE MESH**
Wire mesh used in combination wire fence as shown shall be galvanized and conform to the following:
- | | STANDARD | ALTERNATE |
|-----------------------------|-----------------------------|-----------|
| Width | 26" | 34" |
| Weight - Lbs./Lin. Ft. Min. | 0.54 | 0.76 |
| Horizontal Wires | 2 Strands, No. 12 1/2 gage. | |
| Cross Wires | 1 Strand, No. 14 gage. | |
- Fabrication: cross wires to be woven with horizontal wires making a one piece fabric.

- GATES:**
- DRIVEWAY GATES:**
(R-3) Height - approximately 42" (5 panels) --- Width of gate opening - 16'-0" Min.
(R-1) Gates to be of Riveted construction as follows: Min. 4 No. 10 rivets of each right angle connection and where diagonal braces connect to horizontal panels; Min 3 No. 10 rivets where diagonal braces connect to top and bottom panels.
- ALTERNATE DRIVEWAY GATES**
(R-1) Height - 42"
Weight - Not less than 90 lbs. complete with latch and hinges
Width of gate opening - 16'-0"
Gate Frame - 1 1/2" Standard Galvanized Pipe or acceptable equivalent and shall be of all welded construction.
Mesh to be of same construction as shown for 4" x 4" wire mesh except it shall be 2" x 4" mesh 42" high.
- WALK GATES:**
(R-1) Height - approx. 42" (5 panels)
(R-1) Weight - Galvanized Steel, 16 lbs. Min.
(R-1) Weight - Tempered Aluminum, 10 lbs. Min.
Width of gate opening - 3'-0"

- ALTERNATE WALK GATES:**
(R-1) Height - 42"
Weight - Not less than 18 lbs. complete with latch and hinges
Width of gate opening - 3'-0"
Gate Frame - 3/4" I.D. Standard Galvanized Pipe or acceptable equivalent and shall be of all welded construction.
Mesh to be of same construction as shown for Driveway Gate
- Alternate equivalent standard metal gates other than shown will be acceptable subject to the Engineer's approval.
- In lieu of galvanized finish on gate frames, Cadmium Plated pipe or Aluminum painting will be considered to be equivalent.

- LATCHES AND HINGES:**
Galvanized steel or Aluminum of standard make Hinges shall be placed as shown, to prevent theft.
In lieu of standard make latches it will be permissible to use an electro-galvanized chain, eyebolt and snaphook type latch. Eyebolt, chain and snaphook assembly to be secured to latch side of gate. Gate closure effected by wrapping chain around end post and snapping hook into chain.

DEPARTMENT OF HIGHWAYS
STATE OF COLORADO

WIRE FENCES
AND
GATES

Designed by: E.E.O. Approved by: E.E.O.
Made by: T.E.F. Staff Dist. Eng.
Checked by: E.E.O. Date: July 1, 1965

CLASS I BARRICADES (3 RAILS)

STANDARD M-614-A



(JULY 1, 1965)

FEDERAL ROAD REGION NO.	DISTRICT	PROJECT NO.	SHEET NO.
9	COLORADO		




REVISIONS	

GENERAL NOTES


- All work shall be done in accordance with the Standard Specifications applicable to the Project.
- All signs and sign materials shall conform to the standards set forth in the "Manual on Uniform Traffic Control Devices for All Classes of Streets and Highways" published by the Department of Highways and this standard.
- The various types and combinations of approved Signs and Beacons for Barricades required for each project shall be governed by field conditions and subject to approval by the Engineer. All traffic controls shall be placed for best visibility and legibility and maintained in good condition at all times. Oversigning is to be avoided.
- Painting shall conform with Subsection 508.08 of the Standard Specifications. All skids, braces, and posts shall be painted with 2 coats of "Exterior Black Paint". Planking and wings on all barricades shall be painted with 2 coats of "Exterior Black Paint" on all sides before adding reflective strips. Reflective strips shall be "cut" from smooth surface yellow reflective sheeting of a type approved by the Department.
- Each barricade rail shall be striped on the face side only with reflective yellow strips slanting downward at a 45° angle toward the side to which traffic is to turn or pass. See "DETAIL OF RAIL AND WING STRIPING."
- When barricades are designated on plans the portion of the posts below ground line shall either be dipped in or painted with hot creosote oil. The portion of the post above ground line shall be painted with 2 coats of "Exterior Black Paint."
- All skids, braces, and posts shall be nailed together with No. 20d nails. All screws, bolts, nuts, and washers shall be galvanized or cadmium plated. Skids (bases) of movable barricades shall be weighted where necessary to provide stability.
- All timber used shall conform to the Standard Specifications for Miscellaneous Untreated Timber S4S. Timber shall conform to Construction grade Paragraph 123B or 125B of Standard No. 15 Grading & Dressing Rule for West Coast Douglas Fir (1956) or Dense Structural 5B and LL Structural 5B Paragraph 284 or 285 of 1956 Grading Rules for Southern Pine.
- Detachable extension wings for bypassing of construction equipment are permitted. "W" is variable, length shall be adequate to provide closing of borrow pit and/or shoulder as required.
- Alternate materials or other reflective elements on Traffic signs or Barricades will be permitted only after approval of such material by the Department in writing.
- A Flashing Beacon for use on Barricades is a section of a standard traffic signal head or a similar-type device having a yellow lens in the face, which is illuminated by intermittent flashes. Where commercial power is not available, the beacon may be adapted to operate from storage batteries. Each signal unit lens shall have a visible diameter of not less than 8 inches. Each unit complete shall be of such design as to render the lens when illuminated clearly visible to traffic facing the signal at all distances up to 1000 feet under all atmospheric conditions except dense fog. The color of the yellow lens for caution shall be in accordance with Technical Report No. 1 of the Institute of Traffic Engineers. All beacon flashers shall be equipped with filters for suppression of radio interference. The illuminating element in a flashing yellow beacon shall be flashed at a rate of not less than 50 times nor more than 60 times per minute. The illuminated period of each flash shall be not less than half and not more than two-thirds of the total cycle. The use of Flashing Beacons will be governed by field conditions. Flashing Beacons when warranted generally should be operated continuously throughout the 24 hours of the day. Warrant for Flashing Beacons may be found in Sec 36 of the "Manual on Uniform Traffic Control Devices for Streets and Highways" published by the U.S. Department of Commerce, Bureau of Public Roads, June, 1961 (or latest revision).
- Flashers are portable, power-operated, lens-directed, enclosed lights, illuminated by rapid intermittent flashes of short duration. Flashers may be used in connection with barricades when approved by the Engineer. An array of random flashers which tends to obscure rather than delineate the traveled way will not be permitted. The use of flashers on a job will be governed by Sec 5D of the "Manual on Uniform Traffic Control Devices for Streets and Highways" published by the U.S. Department of Commerce, Bureau of Public Roads, June, 1961 (or latest revision). The color of the light emitted by a flasher shall be yellow.
- Flashing Beacons and Flashers, when used, shall be positioned above the top rail of the barricades to produce the most effective results.
- Barricades used as "Traffic Controls for Highway Construction" are not to be paid for separately.
- Barricades will be paid for separately when designated on plans as bid items.
- For additional general information on control of traffic through work areas refer to the "Manual on Uniform Traffic Control Devices for Streets and Highway", Part V, published by the U.S. Department of Commerce, Bureau of Public Roads, June, 1961 (or latest revision).

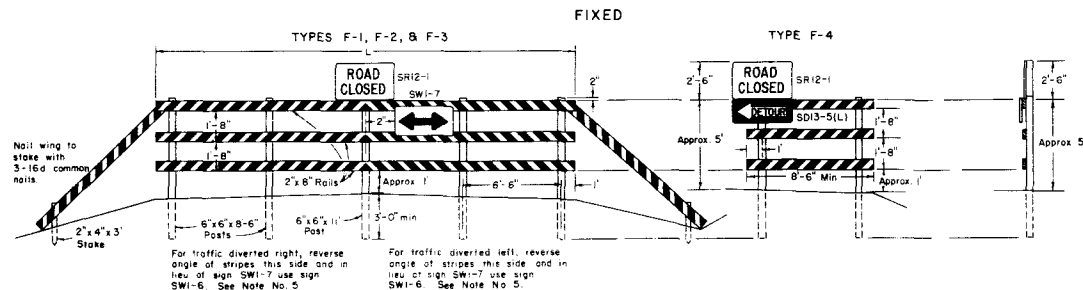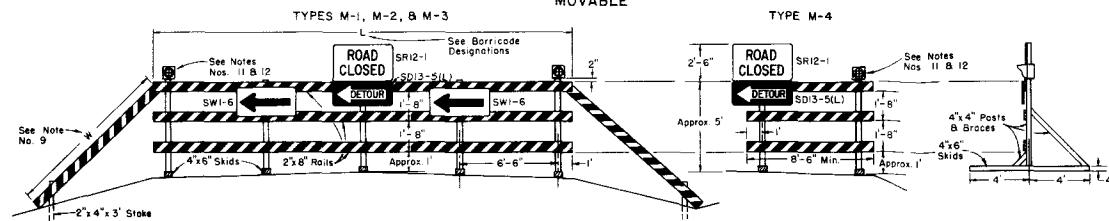


CLASS II BARRICADE (1 RAIL)

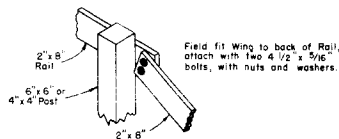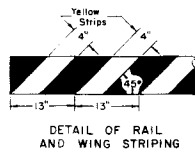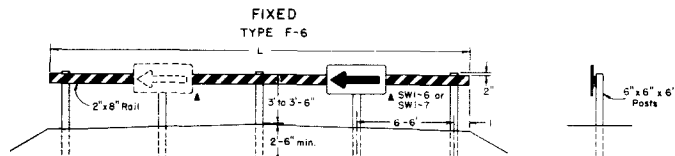

REAR VIEW OF BARRICADE SHOWING WING ATTACHED (See Note No. 9)

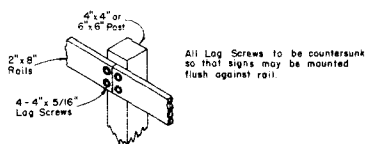

METHOD OF ATTACHING PLANKING TO POSTS AT JOINTS

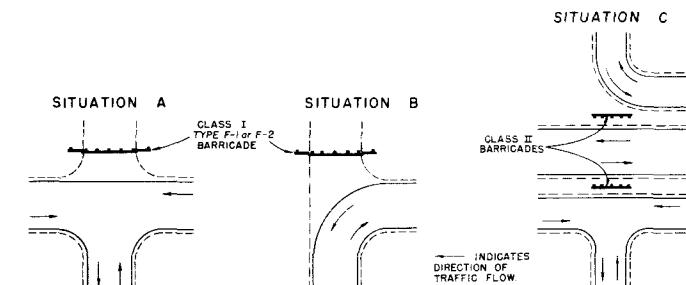

BARRICADE DESIGNATIONS					
Class	Type		Roadway Width	L	Description
	Movable	Fixed			
I	M-1	F-1	26'-34'	28'	Barricade complete with SR12-1 sign and SW1-6 or SW1-7 signs as required.
I	M-2	F-2	35'-44'	41'	Barricade complete with SR12-1 sign and SW1-6 or SW1-7 signs as required.
I	M-3	F-3	Variable	28'	Barricade (without extension wings) complete with SR12-1 sign and SW1-6 or SW1-7 signs as required.
I	M-4	F-4	Variable	Variable 8'-6" min.	Wing Barricade (signs only as appropriate).
II	-	F-6	Variable	28'	Barricade complete with appropriate signs.

DEPARTMENT OF HIGHWAYS
STATE OF COLORADO

TIMBER BARRICADES

Designed By: D R W
Made By: J L S
Checked By: J B


Approved By: [Signature]
Date: JULY 1, 1965

TYPICAL SIGNS STANDARD M-614-IA


(JULY 1, 1965)

FEDERAL ROAD REGION NO.	DISTRICT	PROJ. NO.	SHEET NO.	TOTAL SHEETS
3	COLORADO			

INTERSTATE SYSTEM

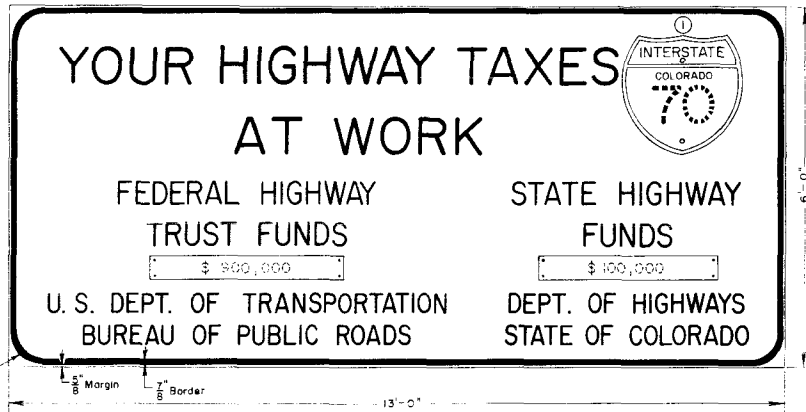


PRIMARY & SECONDARY SYSTEM

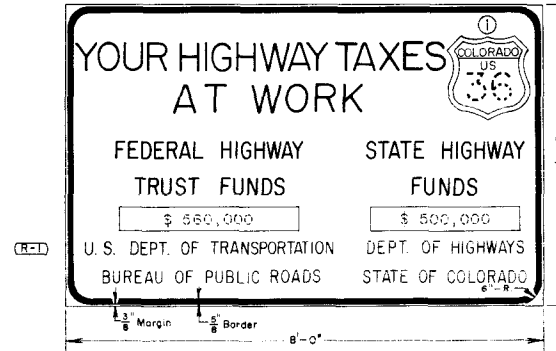

REVISIONS				
NO.	DATE	BY	REVISION	INITIALS
(R-1)	5-25-67	Rev. Gen.	Note 5 Sign Legend	G.W.F.
(R-2)	6-19-67	Note	regarding number posts	G.W.F.

INSTALLATION DETAIL

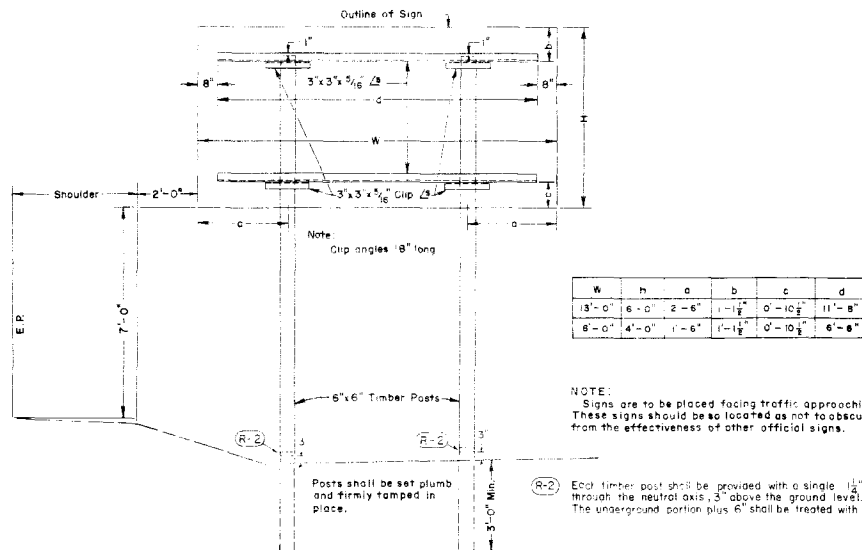

GENERAL NOTES

All work shall be done in accordance with the Standard Specifications applicable to the project.

Signs shall be made of 3/4" Plywood or other material approved by the Department.

When a third governmental agency is participating its official name should be included centrally in lines 6 and 7.

Posts shall be 6" X 6" S 4 S timber or other material approved by the Department and shall be painted white.

Signs are to be non-reflectORIZED, black letters, numerals, and border on plain white background. Route Marker plaques to be the appropriate standard colors, non-reflectORIZED.

(R-1) Layout of signs will be furnished by the Traffic Engineering Section, indicating the details as to letter size, symbols, spacing, figure for amount of funds, etc. which are required for these signs.

These signs will be furnished and installed by State Forces.

(1) Applicable Interstate, U.S. Shield or State Route Shield.

DEPARTMENT OF HIGHWAYS
STATE OF COLORADO
CONSTRUCTION
IDENTIFICATION
SIGNS

Designed by B.F.R. Approved by *[Signature]*
Made by D.J.B. Traffic Engineer
Checked by M.R.N. Date: July 1, 1965

STANDARD M-614-TB


(SHEET 2 OF 3 SHEETS)

(JULY 1, 1965)

FEDERAL ROAD DISTRICT NO.	DIVISION	PROJECT NO.	SHEET NO.
9	COLORADO		
REVISIONS			


REGULATORY SIGNS

See Note No. 9

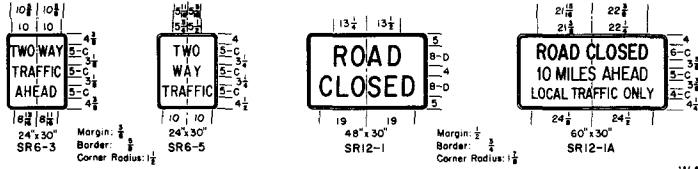

WARNING SIGNS

See Note No. 10

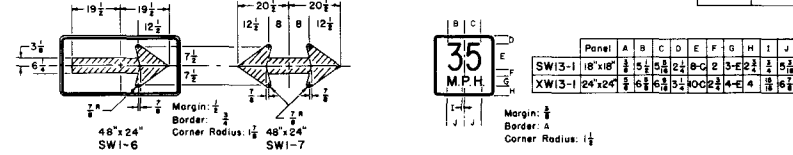

WARNING SIGNS

See Note No. 10




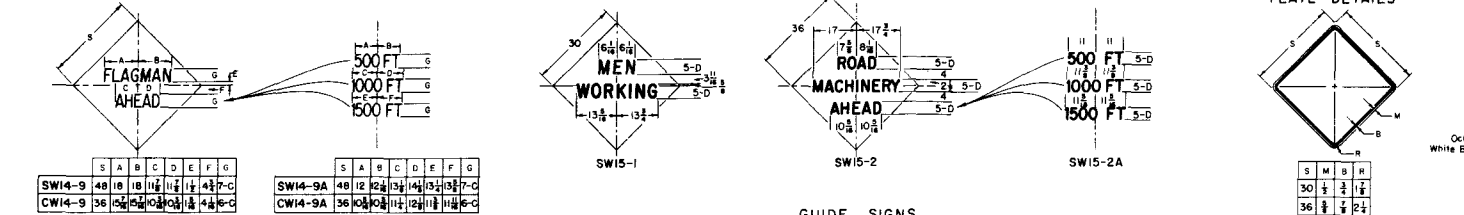


PLATE DETAILS

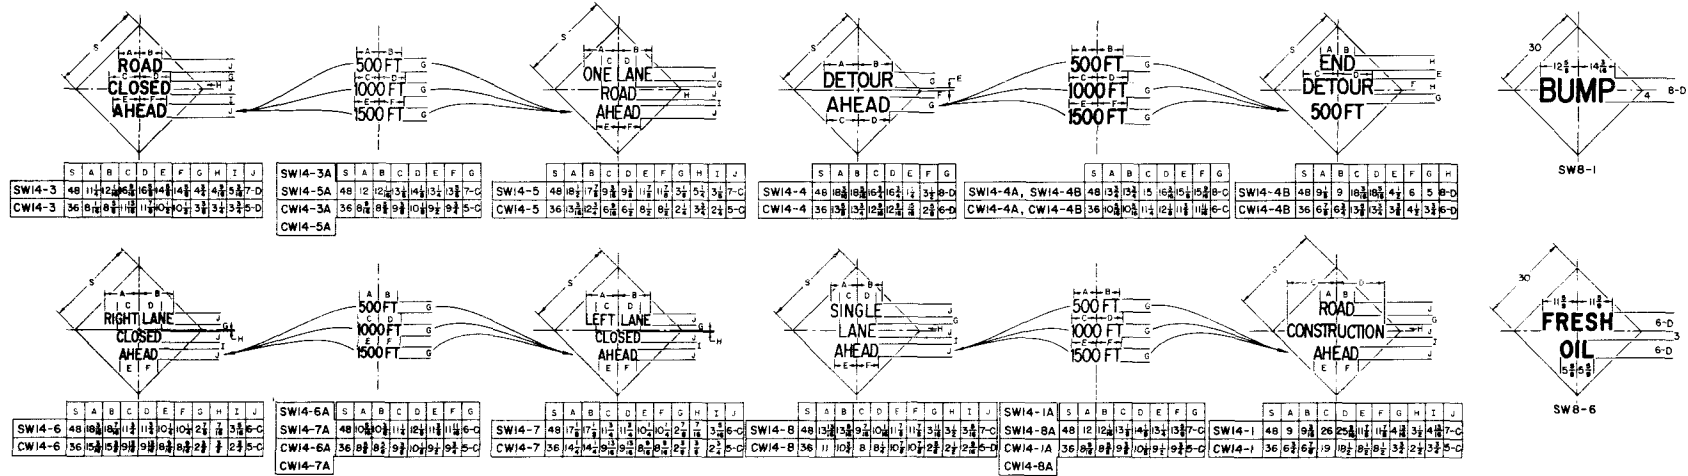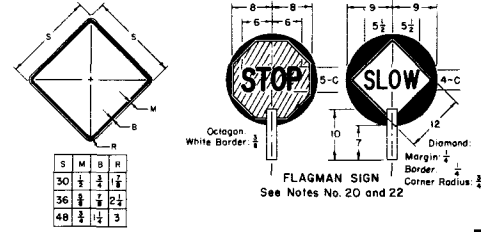

GUIDE SIGNS

See Note No. 11

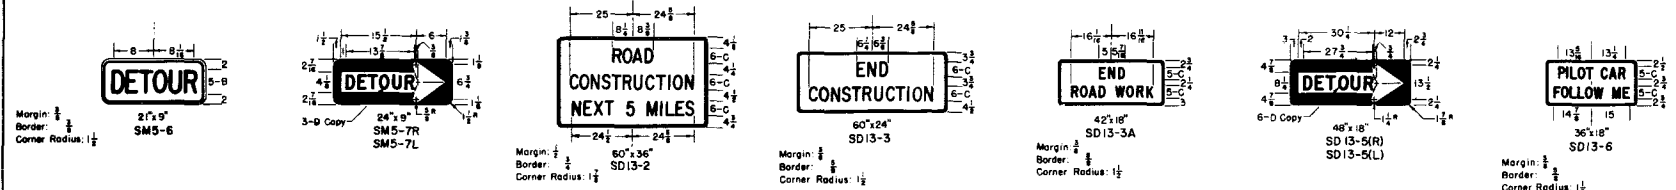

NOTES:
SEE SHEET 1 FOR TYPICAL SIGNING AND SIGN PLACEMENT
SEE SHEET 3 FOR GENERAL NOTES APPLICABLE TO SHEETS 1 AND 2.
ALL DIMENSIONS THAT ARE NOT LABELED ARE IN INCHES.

DEPARTMENT OF HIGHWAYS
STATE OF COLORADO

TRAFFIC SIGNING
FOR HIGHWAY
CONSTRUCTION

Designed By: D.R.W.
Made By: H.B.D.
Checked By: J.B.

Approved By: [Signature]
Date: AUGUST 9, 1965.

STANDARD M-614-TB

(SHEET 3 OF 3 SHEETS)

(JULY 1, 1965)

FEDERAL ROAD DISTRICT NO.	DIVISION	PROJECT NO.	SHEET NO.
9	COLORADO		

REVISIONS	
(R-1) 7-12-67	Acced. Note 23 G.W.F.

GENERAL NOTES

- All work shall be done in accordance with: (a) the Standard Specifications applicable to the Project, and (b) the "Manual on Uniform Traffic Control Devices for all Classes of Streets and Highways" published by the Department of Highways.
- Where traffic is maintained through or over any part of the Project the Contractor will be required to mark all hazards within the limits of the Project (including connecting roads) with well-maintained Barricades, Warning, and Guide Signs. All Barricades and Signs shall be moved, added to, changed or removed as required during the progress of construction and removed entirely when the Project is completed.
- Where traffic is prohibited from the Project the Detour will be marked by the Department except that the Contractor shall provide, erect and maintain Barricades, complete, (when required) at the ends of the Project, ends of the Detour and connecting roads. All U.S. or State Route Markers required for the Project will be furnished and installed by the Department. The location and positioning of Warning Signs, Barricades, and Regulatory Signs shall be as recommended by the appropriate District Engineering Forces of the Department.
- Work on the Project shall not be started until all required signs are in place and approved by the Engineer. Where speed control appears necessary such speed control shall be requested from the Engineer by the Contractor. Control of speed through a construction zone may be achieved by Advisory Speed plates in conjunction with Warning Signs (SW13-1) for use with 30" Warning Signs and XW13-1 for use with 36" and 48" Warning Signs. The Advisory Speed plate is to be posted only at those locations where the safe speed is lower than the imposed Regulatory speed limit.
- All Signs and Barricades shall be placed for best visibility and legibility, maintained in good condition and kept clean and free of dirt at all times. Contractor's and Engineer's vehicles and equipment must be parked so that signs and barricades are visible to approaching traffic at all times.
- Where two identical signs are used for dual posting they are to be staggered on the two sides of the roadway for a minimum distance of 75' to avoid a tunneling effect.
- Examples for marking Projects, as shown on Sheet 1, are typical of signs required and are subject to alteration to fit actual conditions encountered in the field. Locations for control devices are to be stated by the Engineer. In all cases Warning signs are to be placed well in advance of the hazard, the distance depending on topography and existing approach speeds. Additional markings and any special signs required for the guidance and protection of traffic will be placed as required on the Project at the Contractor's expense.
- Desirable sizes for signs are shown on Sheet 1 of this Standard. Larger or smaller signs are to be stated by the Engineer. In all cases Warning signs are to be placed well in advance of the hazard, the distance depending on topography and existing approach speeds. Additional markings and any special signs required for the guidance and protection of traffic will be placed as required on the Project at the Contractor's expense.
- Signs with the prefix "R" in the sign code are Regulatory signs and as such impose legal compulsions or restrictions on drivers and should only be used as authorized by the Engineer.
- Signs with the prefix "W" in the sign code are Warning signs and are used to alert traffic to existing or potentially hazardous conditions.
- Signs with the prefix "D" or "M" in the sign code are Guide signs. Those with the prefix "D" convey general information and those with the prefix "M" are used for marking the traffic route.
- All signs shall be reflectorized unless otherwise specified on plans. Regulatory and Guide signs (unless otherwise specified) shall have a screen processed black legend and border on a white flexible reflective sheeting, non-exposed lens background. The back side of Regulatory and Guide signs shall be painted with two coats of "Exterior Sign White Paint." Warning signs shall have a screen processed black legend and border on a highway yellow flexible reflective sheeting, non-exposed lens background. The back side of Warning signs shall be painted with two coats of "Federal Yellow Synthetic Sign Enamel."
- Painting for wood surfaces shall conform with Section 508 of the Standard Specifications.
- Posts for regulatory, warning, and guide signs will normally be 4"x4" or 6"x6" and shall conform to the Standard Specifications for Untreated Timber-S4S. Timber shall conform to Construction grade Paragraph 123B or 125B of Standard No. 15 Grading & Dressing Rules for West Coast Douglas Fir (1956) or Dense Structural 5B and LL Structural 5B Paragraph 284 or 285 of 1956 Grading Rules for Southern Pine. Posts shall be painted with one coat of "White Wood Primer" and one coat of "Outside White Paint."
- Sign panels furnished by the Contractor for use only during construction may be fabricated from plywood, aluminum, steel or other suitable material but shall be stable and durable enough to meet other requirements of this Standard.
- All material shall be sound and durable. Barricades, signs, symbols, and lettering shall be of good workmanship. Uneven lettering will not be accepted.
- Alternate methods of processing signs or the substitution of symbols or other reflecting elements for painted symbols will be permitted only after approval by the Department.
- Torches and Lanterns shall be either of the fuel-burning or battery-powered type approved by the Department. Particular care shall be taken to protect all signs and barricades from smoke and smudge.
- Barricades, Flashing Beacons and Flashers - Refer to appropriate "M" Standard (Timber Barricades) for details.
- Flagman Sign - This sign shall have a black painted background on both sides to form a contrast for the octagonal Stop sign and the diamond Warning sign. The "STOP" sign shall be fabricated by reverse screen process using transparent red paint on smooth surface silver reflective sheeting. The "SLOW" side of the Flagman Sign shall be black process paint on smooth surface yellow reflective sheeting. Handle to be grooved on one side to indicate reading of sign to Flagman.
- Sign "A": This is the first advance warning sign and shall be placed 1,500 feet ahead of Barricade or project terminal. Postings are required on both sides of the roadway on divided highways. Dual posting is required where warranted on two-lane, two-way highways.
Sign "B": This is the second advance warning sign and shall be placed 1,000 feet ahead of barricade or project terminal. Postings are required on both sides of the roadway on divided highways and singly on two-lane, two-way highways.
Sign "C": This is the third advance warning sign in cases where barricades are used and shall be placed 500 to 750 feet ahead of barricade or potentially hazardous condition. Postings are required on both sides of the roadway on divided highways and singly on two-lane, two-way highways.
Sign "D": SD13-2 - This sign shall be placed to mark the beginning of a Project of more than 2 miles in extent where traffic is maintained through the project. It shall be placed singly and near the beginning of construction.
Sign "E": SD13-3 - This sign shall be placed to mark the end of the Project. It shall be placed singly and may be placed opposite barricade if desirable.
Sign "F": Construction identification signs shall be furnished and installed by the Department on all Federal-Aid and Forest Highway Projects where actual construction is in progress and visible to highway users. These signs should be located so as not to obscure or detract from the effectiveness of other official signs. Where two or more projects are contiguous the appropriate data may be included in one set of signs. Refer to appropriate "M" Standard (Identification Signs) for sign details.
Signs A through F shall be furnished, installed and maintained by the Department.
- When Flags are used in lieu of the Flagman Sign, they shall be a minimum of 18"x18", made of a good grade of bright red material, and fastened securely to a staff of approximately 3 foot length. The free edge should be weighted to insure that the flag will hang vertically, even in heavy winds.
- Each timber post shall be provided with a single hole drilled through the neutral axis normal to the roadway 3" above the ground level. The holes shall be 1/4" Ø for 6"x6" and 1" Ø for 4"x4" timber posts. The underground portion plus 6" shall be treated with creosote.

SPECIAL NOTE: Requirements of this Standard are optional to those of Standard M-614-TA through 12-31-65. Following that date Standard M-614-TA will be obsolete.

DEPARTMENT OF HIGHWAYS
STATE OF COLORADO

TRAFFIC SIGNING
FOR HIGHWAY
CONSTRUCTION

Designed By D.R.W. Approved By J.L.S.
Made By J.L.S. Traffic Engineer
Checked By J.B. Date 2/25/57 G. 1965